

~~JANUARY 12, 1995~~ SEPT

~~OCTOBER 1994~~


AS-BUILT

CONSTRUCTION DOCUMENTS CLASS I CONSTRUCTION

MARIPOSA BASIN PHASE II IMPROVEMENTS

INDEX OF DRAWINGS

TITLE	SHEET NO.	
R- COVER SHEET	COVER	1
PHASING PLAN	PH	2
EXISTING CONDITIONS AND REMOVAL PLAN	R	3
COORDINATE LAYOUT AND SCHEDULE	L-1	4
LAYOUT PLAN	L-2	5
TYPICAL FIELD ENLARGEMENT AND SITE AMENITIES SCHEDULE	L-3	6
IRrigating AND DRAINAGE PLAN	R-C-1	7
IRrigating AND DRAINAGE DETAILS	R-C-2	8
IRrigating AND DRAINAGE DETAILS	RC-2.1	8.5
IRrigating AND DRAINAGE DETAILS	I-1	9
ATHLETIC FIELDS WATER MANAGEMENT GUIDE, NOTES AND LEGEND	I-2	10
IRrigating AND DRAINAGE DETAILS	I-3	11
IRrigating AND DRAINAGE DETAILS	I-4	12
IRrigating DETAILS	I-5	13
PLANTING PLAN	P-1	14
PLANTING DETAILS/PAVILION PLANS AND DETAILS	SD-1	15
PLANTING DETAILS	SD-2	16
PLANTING DETAILS	SD-3	17
SITE DETAILS	SD-4	18
SITE DETAILS	SD-5	19
SITE DETAILS	SD-6	20
ELECTRICAL SITE PLAN	E-1	21
R-AS BUILT GRADES	R-AS BUILT GRADES	22
RAY BACA NOTES RE. LINE LAYOUT		23

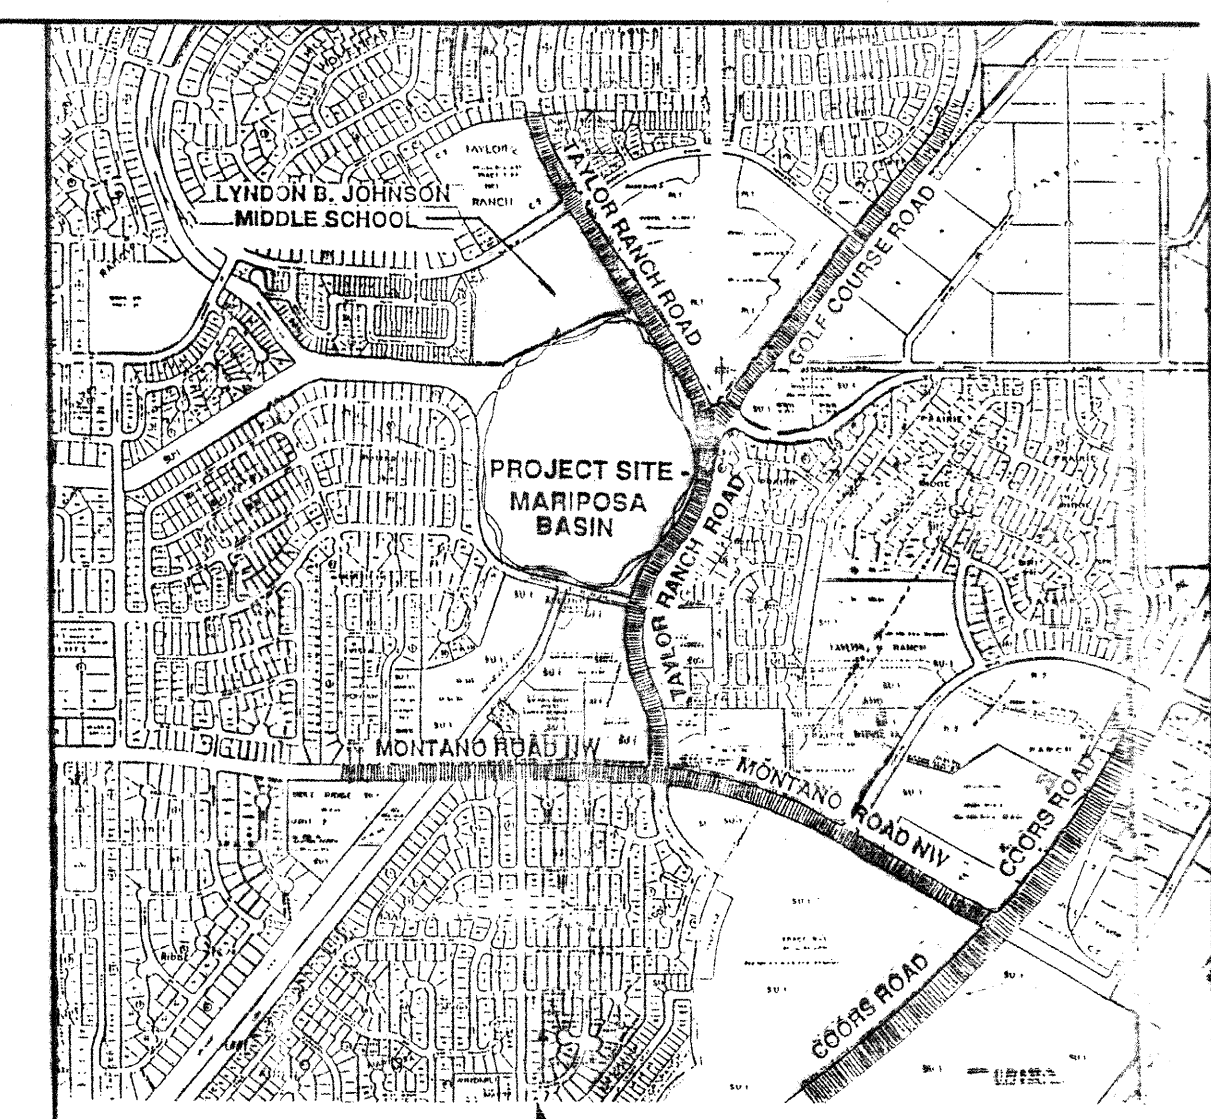


VICINITY MAP NORTH D-11-Z, D-12-Z, E-11-Z, E-12-Z

- ALL WORK TO BE IN ACCORDANCE WITH CITY OF ALBUQUERQUE STANDARD SPECIFICATIONS, 1986 EDITION (AS UPDATED WITH REVISION #4), OR PER ATTACHED SPECIFICATIONS.
- THE WATER SYSTEMS DIVISION (857-8200) SHALL BE NOTIFIED (5) FIVE WORKING DAYS IN ADVANCE OF ANY WORK WHICH MAY AFFECT EXISTING PUBLIC WATER FACILITIES. THE CONTRACTOR SHALL ALSO COORDINATE FOR VALVE OPERATION FOR WATER SHUTOFF.
- (3) THREE WORKING DAYS PRIOR TO BEGINNING CONSTRUCTION CONTRACTOR SHALL SUBMIT TO THE CONSTRUCTION COORDINATION DIVISION A DETAILED CONSTRUCTION SCHEDULE. REFER TO SECTION 19 OF THE CITY OF ALBUQUERQUE STANDARD SPECIFICATIONS.
- (2) TWO WORKING DAYS PRIOR TO CONSTRUCTION THE CONTRACTOR SHALL OBTAIN A BARRICADING PERMIT FROM THE CONSTRUCTION COORDINATION DIVISION. CONTRACTOR SHALL NOTIFY BARRICADE ENGINEER (768-2551) PRIOR TO OCCUPYING AN INTERSECTION. SEE SECTION 19 OF THE CITY OF ALBUQUERQUE STANDARD SPECIFICATIONS.
- ALL STREET STRIPING ALTERED OR DESTROYED SHALL BE REPLACED IN KIND BY CONTRACTOR TO LOCATION AND IN KIND AS EXISTING OR AS INDICATED BY THIS PLAN SET.
- THE CONTRACTOR SHALL CONTACT NEW MEXICO ONE CALL SYSTEM PHONE: 260-1990, TO LOCATE UNDERGROUND UTILITIES 2 WORK DAYS PRIOR TO BEGINNING EXCAVATION.
- THE CONTRACTOR SHALL CONTACT TRAFFIC ENGINEERING OPERATIONS 764-1599 FOR REMOVAL AND REPLACEMENT OF TRAFFIC SIGNS.
- THE CONTRACTOR SHALL PROTECT ALL EXISTING UTILITIES, UNLESS NOTED OTHERWISE. ANY DAMAGE TO EXISTING UTILITIES SHALL BE REPAIRED AT THE CONTRACTOR'S EXPENSE.
- ALL EXISTING IMPROVEMENTS ARE TO REMAIN, UNLESS SPECIFICALLY NOTED TO BE REMOVED. CONTRACTOR SHALL REPAIR ANY CONTRACTOR-CAUSED DAMAGE, AS DETERMINED BY THE ENGINEER TO EXISTING IMPROVEMENTS TO THE SATISFACTION OF THE OWNER AT THE CONTRACTOR'S EXPENSE.
- PRIOR TO CONSTRUCTION THE CONTRACTOR SHALL CHECK ALL DIMENSIONS, HORIZONTAL AND VERTICAL, AND SHALL ENSURE AND VERIFY THE HORIZONTAL AND VERTICAL LOCATION OF ALL CONSTRUCTIONS. SHOULD A CONFLICT EXIST, THE CONTRACTOR SHALL NOTIFY THE ENGINEER PRIOR TO BEGINNING CONSTRUCTION SO THAT CONFLICT CAN BE RESOLVED WITH THE MINIMUM AMOUNT OF DELAY.
- FOR PURPOSES OF THIS PROJECT THE TERM ENGINEER SHALL REFER TO EITHER THE OWNER'S EMPLOYEE OR THE LANDSCAPE ARCHITECT RESPONSIBLE FOR CONSTRUCTION INSPECTION OF THE PROJECT.
- ALL REFERENCES TO COMPACTED BACKFILL OR COMPACTED SUBGRADE SHALL MEAN SOIL COMPACTED TO 95% OF MAXIMUM DENSITY AS DETERMINED BY ASTM D-1557 UNLESS OTHERWISE NOTED.
- CONTRACTOR SHALL NOTIFY THE ENGINEER NOT LESS THAN SEVEN (7) DAYS PRIOR TO STARTING WORK. THE CONTRACTOR SHALL TAKE NECESSARY MEASURES TO PROTECT THE PRESERVATION OF SURVEY MONUMENTS. CONTRACTOR SHALL NOT DISTURB PERMANENT SURVEY MONUMENTS WITHOUT THE CONSENT OF THE ENGINEER AND SHALL NOTIFY THE ENGINEER AND BEAR THE EXPENSE OF REPLACING ANY THAT MAY BE DISTURBED. PERMISSION FOR REPLACEMENT SHALL BE DONE ONLY BY THE CITY OF ALBUQUERQUE SURVEY SECTION. WHEN A CHANGE IS MADE IN THE FINISH ELEVATION OF THE PAVEMENT OF ANY ROADWAY IN WHICH A PERMANENT SURVEY MONUMENT IS LOCATED, CONTRACTOR SHALL, AT HIS OWN EXPENSE, ADJUST THE MONUMENT COVER TO NEW GRADE, UNLESS OTHERWISE SPECIFIED.

1 2 3 4 5 6 7 8 9 10 11 12 13 14 15
26-14000-193 01197

APPROVAL OF AS BUILT DRAWINGS
CHIEF CONSTRUCTION ENGINEER
Russell R. Loh
DATE 11-30-97

REV.	SHEETS	CITY ENGINEER	DATE	USER DEPARTMENT	DATE	USER DEPARTMENT	DATE
APPROVAL FOR REVISIONS							
LANDSCAPE ARCHITECT'S SEAL				APPROVED FOR CONSTRUCTION			
PROJECT NO. 4000.93				R-COVER SHEET R-1 OF 22			

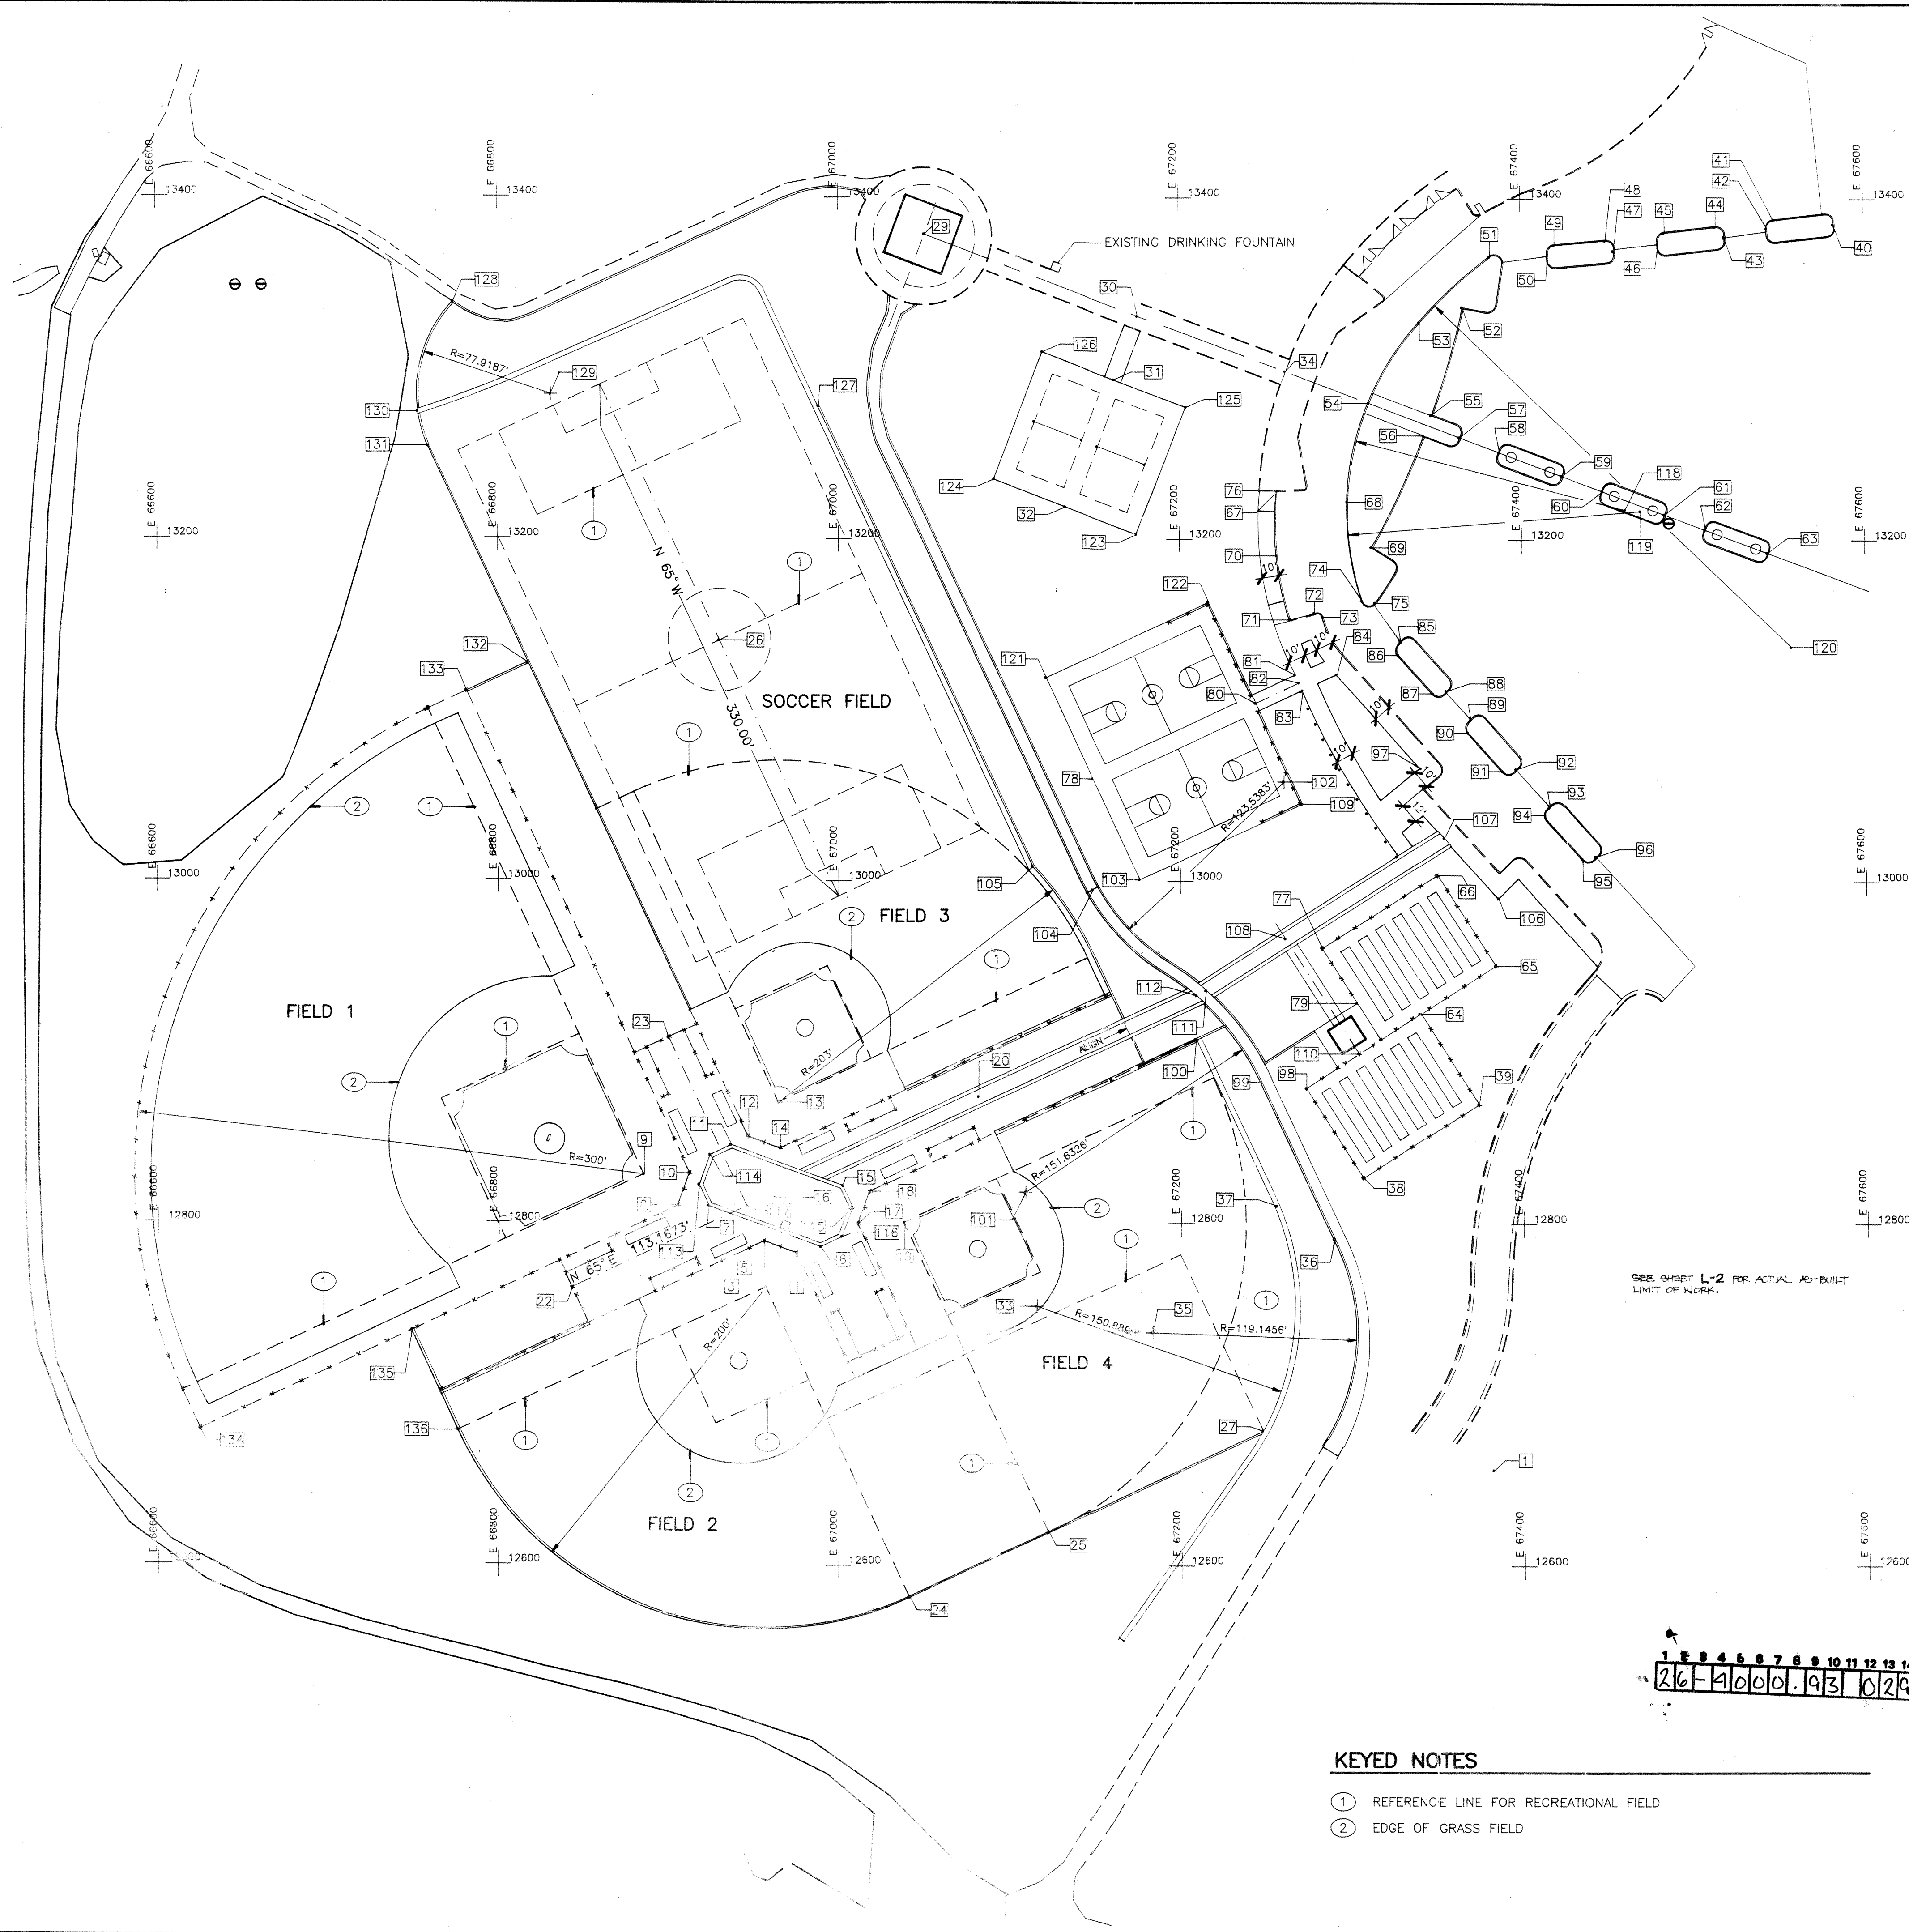

COORDINATE SCHEDULE

POINT			
1	X=67381.7648, Y=12655.3457	69	X=67312.4412, Y=13195.2991
2	X=67287.6729, Y=12666.7503	70	X=67257.3051, Y=13190.1542
3	X=66957.2903, Y=12762.5752	71	X=67264.9110, Y=13152.9359
4	X=66975.2301, Y=12782.6541	72	X=67278.9094, Y=13156.6913
5	X=66956.4336, Y=12789.4874	73	X=67284.2052, Y=13154.3985
6	X=66989.3558, Y=12786.0937	74	X=67307.0332, Y=13163.9743
7	X=66923.8469, Y=12809.9089	75	X=67314.3917, Y=13162.7285
8	X=66905.9877, Y=12810.0837	76	X=67247.0429, Y=13228.7050
9	X=66885.9088, Y=12828.0235	77	X=67283.1510, Y=12960.7379
10	X=66912.8210, Y=12828.8801	78	X=67149.2587, Y=13059.8828
11	X=66936.9646, Y=12845.5106	79	X=67303.5780, Y=12928.6952
12	X=66946.9521, Y=12850.3293	80	X=67244.4795, Y=13104.1321
13	X=66964.8920, Y=12870.4082	81	X=67267.9310, Y=13120.5436
14	X=66965.7486, Y=12843.4960	82	X=67270.0536, Y=13116.0164
15	X=67002.3190, Y=12821.7516	83	X=67272.1607, Y=13111.4821
16	X=66963.0932, Y=12815.7388	84	X=67292.2345, Y=13120.8104
17	X=67611.4760, Y=12799.5725	85	X=67329.7262, Y=13139.7412
18	X=67018.3093, Y=12818.3689	86	X=67328.3497, Y=13132.4593
19	X=67038.3882, Y=12800.4291	87	X=67348.4335, Y=13110.0267
20	X=67082.0763, Y=12873.5155	88	X=67356.2053, Y=13111.4170
21	X=67141.7776, Y=12574.7621	89	X=67370.5169, Y=13094.4692
22	X=66843.4047, Y=12762.1112	90	X=67369.0278, Y=13087.1379
23	X=66900.2110, Y=12907.9693	91	X=67388.9676, Y=13064.6685
24	X=67041.8825, Y=12581.3456	92	X=67396.7212, Y=13065.9440
25	X=67122.9804, Y=12619.1996	93	X=67416.2223, Y=13043.5915
26	X=66930.1450, Y=13140.4972	94	X=67413.5550, Y=13039.2604
27	X=67247.7441, Y=12678.5388	95	X=67434.5454, Y=13013.7441
28	X=67218.0325, Y=12638.5864	96	X=67442.2668, Y=13014.9496
29	X=67050.5306, Y=13378.3327	97	X=67341.0732, Y=13066.2796
30	X=67176.4220, Y=13330.8925	98	X=67273.7274, Y=12878.7858
31	X=67162.1633, Y=13293.7149	99	X=67246.9583, Y=12862.3706
32	X=67133.5156, Y=13219.0202	100	X=67209.1500, Y=12907.4474
33	X=67115.6376, Y=12751.4474	101	X=67109.1037, Y=12818.0244
34	X=67262.6000, Y=13298.4178	102	X=67261.0133, Y=13058.2566
35	X=67183.2569, Y=12736.1426	103	X=67176.6511, Y=13000.9366
36	X=67289.8319, Y=12790.5194	104	X=67149.0113, Y=12994.8403
37	X=67256.2587, Y=12810.1705	105	X=67113.7180, Y=13008.4655
38	X=67307.0384, Y=12826.5329	106	X=67386.3728, Y=12990.1455
39	X=67374.4967, Y=12869.5373	107	X=67354.8051, Y=13025.3937
40	X=67582.6411, Y=13385.0651	108	X=67261.9069, Y=12966.1580
41	X=67548.0426, Y=13387.6839	109	X=67271.8719, Y=13045.1859
42	X=67544.1508, Y=13383.0101	110	X=67304.7706, Y=12898.9203
43	X=67519.2003, Y=13377.7246	111	X=67214.9266, Y=12936.2015
44	X=67514.2522, Y=13383.7584	112	X=67209.4985, Y=12932.9922
45	X=67484.4134, Y=13380.3537	113	X=66918.1198, Y=12822.1787
46	X=67480.6983, Y=13373.8083	114	X=66924.4841, Y=12839.6851
47	X=67454.7591, Y=13369.5546	115	X=67008.0953, Y=12809.3764
48	X=67449.9559, Y=13375.7537	116	X=67001.7310, Y=12791.8700
49	X=67420.0319, Y=13372.9304	117	X=66945.9510, Y=12809.9765
50	X=67416.1493, Y=13366.5438	118	X=67460.5136, Y=13217.9592
51	X=67382.1688, Y=13365.8052	119	X=67469.5428, Y=13217.1742
52	X=67366.0474, Y=13336.3655	120	X=67556.9553, Y=13137.5130
53	X=67341.0809, Y=13327.4256	121	X=67121.8662, Y=13118.8290
54	X=67310.9978, Y=13280.1798	122	X=67217.0871, Y=13163.0783
55	X=67347.7943, Y=13273.0814	123	X=67173.1861, Y=13198.3257
56	X=67343.3675, Y=13261.2141	124	X=67091.4998, Y=13235.1345
57	X=67364.3329, Y=13260.0814	125	X=67204.1791, Y=13277.6006
58	X=67387.4158, Y=13251.3829	126	X=67120.1475, Y=13309.8293
59	X=67423.5980, Y=13237.7482	127	X=66988.4313, Y=13278.0606
60	X=67447.3046, Y=13228.8148	128	X=66773.9373, Y=13338.4939
61	X=67483.4869, Y=13215.1801	129	X=66831.3851, Y=13284.3837
62	X=67507.1935, Y=13206.2466	130	X=66753.2581, Y=13273.7979
63	X=67543.3500, Y=13192.6000	131	X=66759.1766, Y=13253.7998
64	X=67340.8479, Y=12922.3200	132	X=66817.9090, Y=13126.8142
65	X=67384.4763, Y=12950.6172	133	X=66781.4465, Y=13110.3356
66	X=67350.6093, Y=13003.7423	134	X=66624.5322, Y=12678.7092
67	X=67257.2574, Y=13228.1806	135	X=66748.6745, Y=12736.6548
68	X=67298.6159, Y=13222.1487	136	X=66776.0607, Y=12677.9829

NOTES

- COORDINATE SYSTEM, DEVELOPED BY THE CITY OF ALBUQUERQUE, SURVEY SECTION (768-3612).
- CONTRACTOR TO MEET WITH CITY OF ALBUQUERQUE, SURVEY SECTION REPRESENTATIVE PRIOR TO STAKING, FOR PRECISE LOCATION OF CONTROL POINTS AND CONFIRMATION OF COORDINATE SYSTEM.


IN BENCH MARK AREA

- CONTROL POINTS FOR THE CITY OF ALBUQUERQUE, SURVEY SECTION. SURVEY OF MARIPOSA BASIN, 1994:
CP101-#5 REBAR, ALONG NORTH BIKE PATH, APPROXIMATELY 230' SW OF PEDESTRIAN ENTRANCE, SOUTH OF SCHOOL.
X=67110.020878, Y=14005.598348
CP102-#5 REBAR, ON TOP OF WEST SIDE OF DRAINAGE CHANNEL AT THE POINT WHERE THE CHANNEL BENDS TO THE SE.
X=66401.861594, Y=12782.949272
CP103-6 OD NAIL, ON PATH ALONG EAST SIDE OF THE PARK, APPROXIMATELY 290' SOUTH EAST OF THE BOTTOM OF THE ENTRANCE DRIVE.
X=67381.764834, Y=12655.345734

KEYED NOTES

- REFERENCE LINE FOR RECREATIONAL FIELD
- EDGE OF GRASS FIELD

Campbell Okuma Perkins Associates, Inc.
1339 Pacheco No. 8
Albuquerque, NM 87102
(505) 242-9928

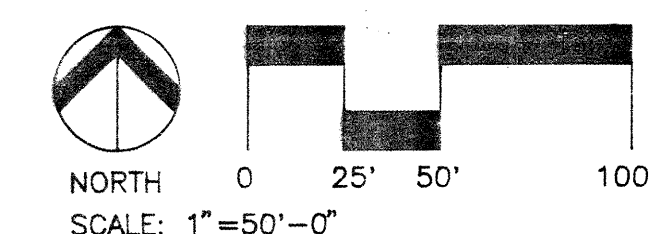

CITY OF ALBUQUERQUE PARKS AND GENERAL SERVICES DEPARTMENT DESIGN AND DEVELOPMENT DIVISION					
TITLE: MARIPOSA BASIN PHASE II IMPROVEMENTS COORDINATE LAYOUT AND SCHEDULE					
APPROVALS	ENGINEER	DATE	APPROVALS	ENGINEER	DATE
DRC CHAIRMAN	<i>[Signature]</i>	10/3/94	WATER	<i>[Signature]</i>	
TRANSPORTATION	<i>[Signature]</i>	10/3/94	WASTE WATER		
HYDROLOGY	<i>[Signature]</i>	10/24/94			
PARKS/GEN. SVC.	<i>[Signature]</i>	11/1/94			
PROJECT NO.	4000.93	MAP NO.		SHEET	L-1 OF 21




GENERAL LAYOUT NOTES


- THE COORDINATE SYSTEM FOR THE LAYOUT WAS DEVELOPED BY THE SURVEY SECTION, CITY OF ALBUQUERQUE. FOR COORDINATE SCHEDULE SEE SHEET # L-1.
- CONTRACTOR SHALL MEET WITH CITY OF ALBUQUERQUE, SURVEY SECTION REPRESENTATIVE PRIOR TO STAKING, FOR ADDITIONAL INFORMATION ON THE PRECISE LOCATIONS OF CONTROL POINTS AND CONFIRMATION OF COORDINATE SYSTEM.
- COORDINATE SLEEVING UNDER ALL RIGID SURFACES AND STRUCTURES WITH IRRIGATION PLAN. INCLUDE SLEEVING FOR ELECTRICAL SERVICE AS NECESSARY.
- ALL MEASUREMENTS ARE TO CENTERLINES UNLESS OTHERWISE NOTED.
- CONTRACTOR SHALL APPLY GRAFFITI-RESISTANT COATINGS ON EXTERIOR SURFACES INCLUDING THE FOLLOWING:
RETAINING WALLS, PAVILION COLUMNS, HANDICAP SIGNAGE,
ALL SITE AMENITIES LISTED IN SCHEDULE SHEET L-3.

KEYED LAYOUT NOTES


- INSTALL MAIN SHADE STRUCTURE 36'X36'. SEE SITE AMENITIES SCHEDULE SHEET L-3.
- INSTALL CONCRETE SIDEWALK PER COA STD. DWG. #2720. JOINTS: EXPANSION JOINTS @ 20'-0" OC, CONTROL JOINTS @ 5'-0" OC.
- INSTALL CONCRETE PAVING HANDICAP RAMP TO HC PARKING. SEE SHEET SD-5, DETAIL #3.
- INSTALL HANDICAP PARKING SIGNS. POLE SIGNS TO BE 12" X 18" HEAVY GAUGE ALUMINUM, 3" DIAMETER GALVANIZED POLE WITH 12" DIAMETER X 18" DEEP CONCRETE FOOTING. SIGNS AS SUPPLIED BY ALBUQUERQUE SIGN CO. (505) 294-7446. LOCATE SIGNS AT THE CENTERLINE OF EACH PARKING SPACE. (TYP. 1 OF 6). SEE SHEET SD-5, SHEET #2.
- INSTALL SAND VOLLEYBALL COURTS WITH WOOD EDGING. SEE SHEET# SD-3.
- INSTALL CONCRETE MEDIAN CURB PER COA STD. DWG. #2415.
- INSTALL AUTO ACCESS CONTROL FENCE, 1' FROM EDGE OF SIDEWALK. APPROXIMATE LENGTH: 250 LF.
- INSTALL ASPHALT PAVEMENT PER COA STD. DWG. #2406.
- INSTALL CONCRETE BASKETBALL COURTS. SEE SHEET# SD-0F.
- INSTALL 10'-0" CHAIN LINK FENCE. APPROXIMATE LENGTH: 170 LF.
- INSTALL 4'-0" CHAIN LINK FENCE WITH GATES. SEE SHEET# SD-4. APPROXIMATE LENGTH: 500 LF.
- INSTALL SHADE STRUCTURE 16'X16' AND PICNIC TABLES FOR HORSESHOE AREA. PICNIC TABLES - 2 OF MODEL #H4001 AND 1 OF MODEL #H4003, SEE SITE AMENITIES SCHEDULE, SHEET L-3. SEE SHEET SD-2, DETAIL 1.
- HORSESHOE AREA. SEE SHEET# SD-2.
- INSTALL CONCRETE SIDEWALK PER COA STD. DWG. FOR SCORING PATTERN SEE SHEET# SD-5.
- PLAZA. SEE SHEET# SD-5.
- INSTALL DRINKING FOUNTAIN. CONNECT TO EXISTING LINE AT EXISTING DRINKING FOUNTAIN. SEE SITE AMENITIES SCHEDULE, SEE SHEET I-3 AND I-4.
- INSTALL TRASH RECEPTACLE. SEE SITE AMENITIES SCHEDULE SHEET L-3.
- DUGOUT AREA. FOR ENLARGEMENT OF INFIELD INCLUDING DUGOUTS, SEE SHEET# L-3. FOR SITE FURNISHINGS RELATED TO THE DUGOUTS, SEE SITE AMENITIES SCHEDULE SHEET L-3. SEE DETAIL 1 OF SD-6.
- CONCRETE MOW CURB ADJACENT TO EXISTING ASPHALT PATH. MOW CURB PER COA STD. DETAIL #2720. SAW OUT WALK AND PATCH WITH ASPHALT AS REQUIRED.
- INSTALL BLEACHER. SEE SITE AMENITIES SCHEDULE, SHEET # L-3. SEE DETAIL 8 OF SD-4.
- MAJOR/MINOR FIELD. FOR ENLARGEMENT OF INFIELD WITH DIMENSIONS, SEE SHEET# L-3.
- INSTALL STABILIZED CRUSHED STONE PAVEMENT. SEE SHEET# SD-5.
- INSTALL SKINNED INFIELD: STABILIZED CLAY MIXTURE, SEE SPECIFICATIONS.
- INSTALL CHAIN LINK FENCING. FOR SIZE, SEE FIELD ENLARGEMENT, SHEET #L-3.
- NOT USED.
- INSTALL CONCRETE MOW CURB PER COA STD. DWG. #2726.
- INSTALL CONCRETE PLAZA PER COA STD. DWG. #2720. FOR SCORING PATTERN SEE SHEET # SD-5.
- TREE WELL. TYPICAL. SEE SHEET SD-5.
- REFERENCE LINE ONLY.
- EDGE OF SEEDING. SEE PLANTING PLAN, SHEET P-1.
- LIMIT OF ASPHALT PAVING.
- CONCRETE RETAINING WALL, SEE DETAIL 5 OF SHEET SD-1.
- CONCRETE SWALE, SEE SHEET # C-2.
- CIRCULAR OPENING IN THE CONCRETE WITH 8 FOOT DIAMETER, TYPICAL.
- PROTECT EXISTING DRAIN.
- INSTALL 18" WIDE CONCRETE EDGER AT CHAIN LINK FENCE. SEE DETAIL 2, SHEET SD-2.
- 12" MOW CURB.

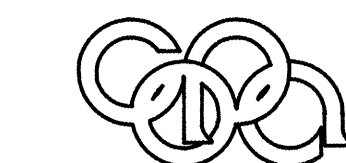

Campbell Okuma Perkins Associates, Inc.
Landscape Architecture and Site Planning
418 Central S.E. 87102 Albuquerque, NM 87102
(505) 242-9928
1339 Pocheco No. 8 Santa Fe, NM 87501
(505) 962-8399

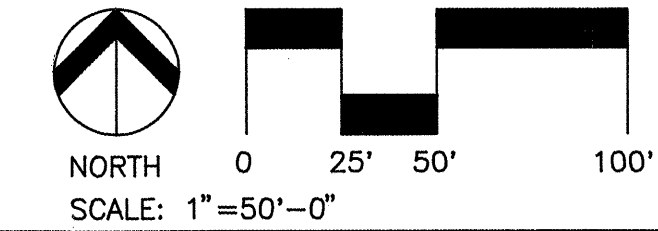

CITY OF ALBUQUERQUE PARKS AND GENERAL SERVICES DEPARTMENT DESIGN AND DEVELOPMENT DIVISION					
TITLE: MARIPOSA BASIN PHASE II IMPROVEMENTS LAYOUT PLAN					
APPROVALS	ENGINEER	DATE	APPROVALS	ENGINEER	DATE
DRC CHAIRMAN	<i>[Signature]</i>	10/31/94	WATER	<i>[Signature]</i>	
TRANSPORTATION	<i>[Signature]</i>	10/21/94	WASTE WATER		
HYDROLOGY	<i>[Signature]</i>	10/21/94			
PARKS/GEN. SVCS	<i>[Signature]</i>	10/1/94			
PROJECT NO.	4000.93	MAP NO.			
SHEET 5 OF 21			L-2		

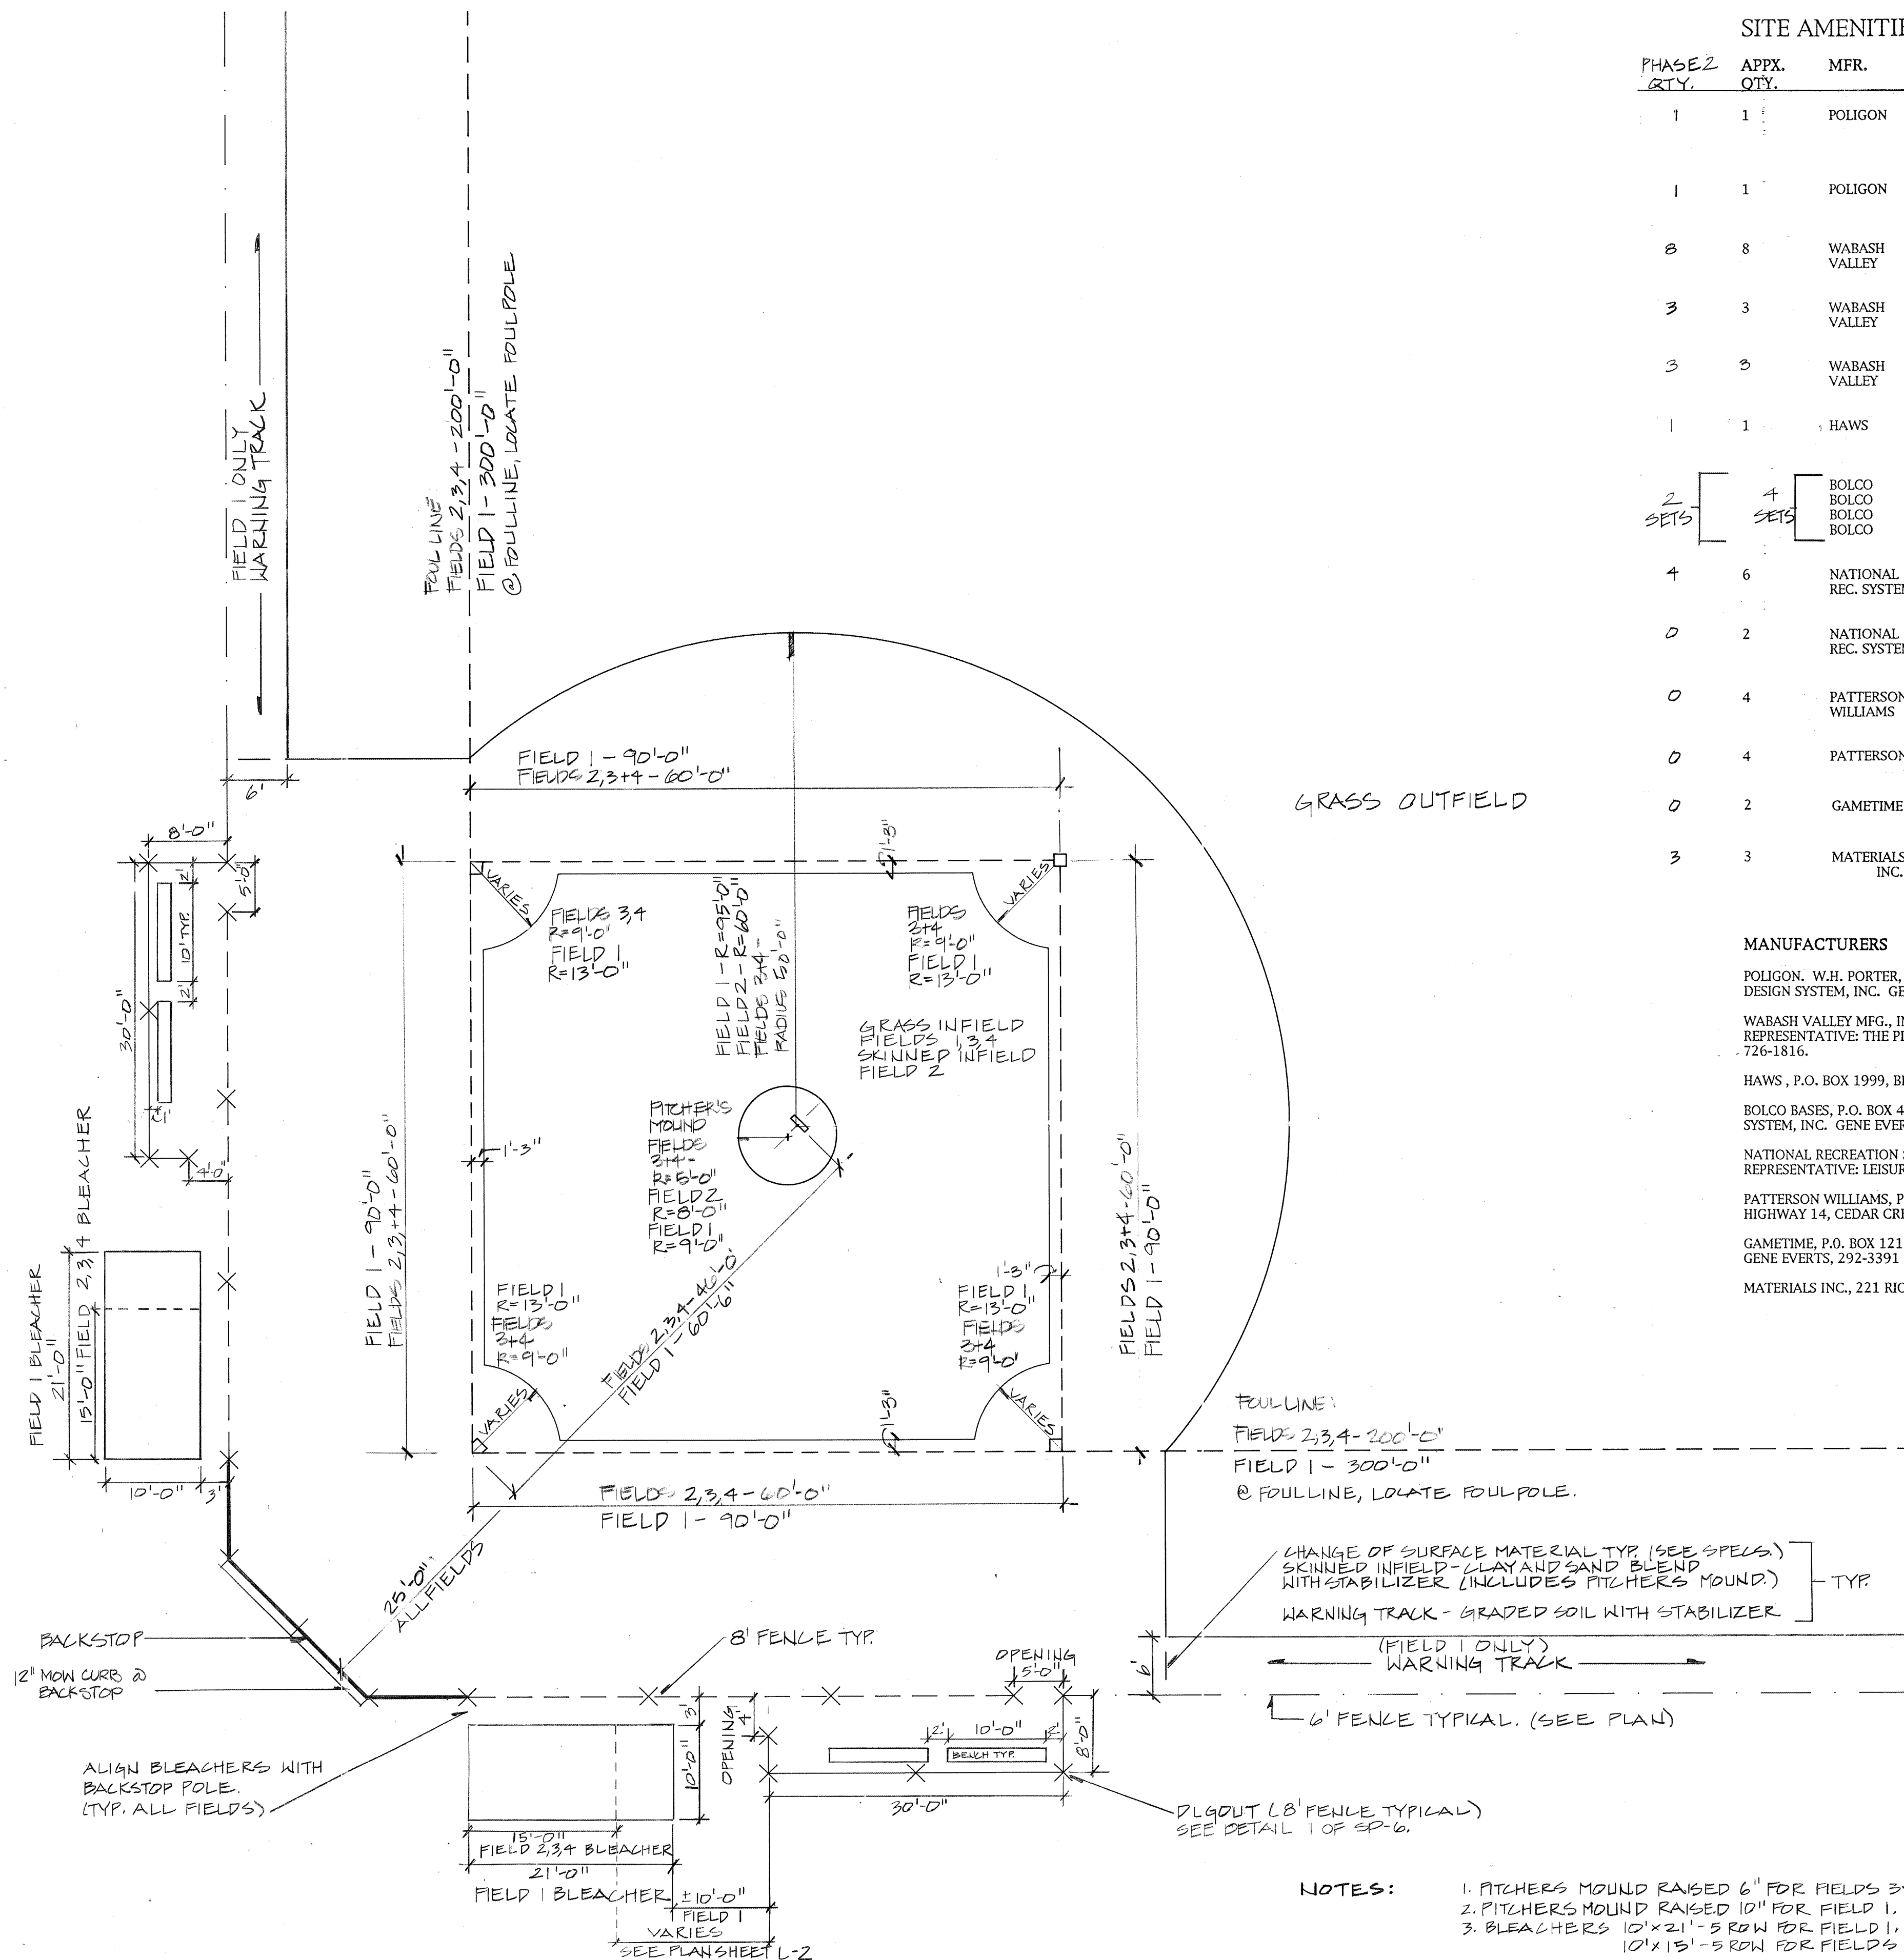

SITE AMENITIES -

PHASE 2 QTY.	APPX. QTY.	MFR.	MODEL #	DESCRIPTION
1	1	POLIGON	HEX-36M	METAL SHADE STRUCTURE WITH PITCHED ROOF WITH CUPOLA. COLOR: BLUE. 36' X 36'. SEE SHEET #SP-1, DETAIL # 1, 3, 4, 7
1	1	POLIGON	SQ-16M-4C	METAL SHADE STRUCTURE WITH PITCHED ROOF. COLOR: BLUE. 16' X 16'. SEE SHEET #SP-1, DETAIL # 2, 4, 7, AND 1/50-2.
8	8	WABASH VALLEY	S557	10' DELUXE PLAYER BENCH - IN-GROUND. METAL SEAT AND SUPPORTS. COLOR: BLACK FRAME WITH BLUE SEATS.
3	3	WABASH VALLEY	H4003	46" SQUARE TABLE, IN-GROUND WITH 3 SEATS. METAL SEAT AND SUPPORTS. COLOR: BLACK FRAME WITH BLUE SEATS.
3	3	WABASH VALLEY	H4001	46" SQUARE TABLE, IN-GROUND WITH 4 SEATS. METAL SEAT AND SUPPORTS. COLOR: BLACK FRAME WITH BLUE SEATS.
1	1	HAWS	3380	DRINKING FOUNTAIN. HANDICAP ACCESSIBLE. COLOR 001 - BLUE. OR APPROVED EQUAL.
2 SETS	4 SETS	BOLCO	100-ML	MAJOR LEAGUE MODEL BASE, 3 STAKES AND 3 ANCHOR PLATES W/ 3 BASES
		BOLCO	205-BA	BASE ANCHOR
		BOLCO	300-AS	HOME PLATE. SHEET #SP-1, DETAIL # 4
		BOLCO	490-CC	PITCHER'S PLATE. SHEET #SP-1, DETAIL # 7
4	6	NATIONAL REC. SYSTEMS	N-0515G	BLEACHER. 5 ROW HIGH X 15' LONG ALUMINUM BLEACHER. SEE SHEET #SP-4, DETAIL # 8
0	2	NATIONAL REC. SYSTEMS	N-0521G	BLEACHER. 5 ROW HIGH X 21' LONG ALUMINUM BLEACHER.
0	4	PATTERSON WILLIAMS	#1525-14	4 1/2" OD SCHEDULE 40 GALV. STEEL PIPE. SINGLE 6 FOOT OFFSET BASKETBALL UPRIGHT WITH 1/4" GALV. STEEL BACKBOARDS
0	4	PATTERSON	#8131	DOUBLE-RING GOAL. RING WITH CHAIN NET
0	2	GAMETIME	#739	VOLLEYBALL NET.
3	3	MATERIALS INC.	#TR 3329-III	RICONADA III LITTER RECEPTACLE WITH DARK GRAY INTEGRAL COLOR #8084. 1 LB/SACK. AVAILABLE DAVIS COLORS REP. SAM PRINCE 1-800-356-4848.

MANUFACTURERS

POLIGON, W.H. PORTER, INC., 4240 N 136TH AVENUE, HOLLAND, MI 49424, 1-616-399-1963. LOCAL REPRESENTATIVE: LEISURE DESIGN SYSTEM, INC. GENE EVERTS, 292-33911 OR 1-800-543-2232.

WABASH VALLEY MFG., INC. P.O. BOX 5 - ST. RD. 15 NORTH, SILVER LAKE, IN 46982, 1-800-253-8619. LOCAL REPRESENTATIVE: THE PLAYWELL GROUP, JEFF POPENOE, 2225-J WYOMING NE, SUITE 203, ALBUQUERQUE, NM 87112, 1-800-726-1816.

HAWS, P.O. BOX 1999, BERKELEY, CA 94701, (415) 525-5801. LOCAL REPRESENTATIVE: 299-5674.

BOLCO BASES, P.O. BOX 489, 610 JEFFERSON, COOKEVILLE, TN 38503, 1-800-251-6857. LOCAL REPRESENTATIVE: LEISURE DESIGN SYSTEM, INC. GENE EVERTS, 292-33911 OR 1-800-543-2232.

NATIONAL RECREATION SYSTEMS, INC., 5021 INVESTMENT DRIVE, PO BOX 11487, FORT WAYNE, IN 46858-1487. LOCAL REPRESENTATIVE: LEISURE DESIGN SYSTEM, INC. GENE EVERTS, 292-33911 OR 1-800-543-2232.


PATTERSON WILLIAMS, P.O. BOX 4040, SANTA CLARA, CA 95056-4040. LOCAL REPRESENTATIVE: EXERPLAY, INC. 12127 NORTH HIGHWAY 14, CEDAR CREST, NEW MEXICO 87008 (505) 281-0151.

GAMETIME, P.O. BOX 121, FORT PAYNE, ALABAMA, (205) 845-5610. LOCAL REPRESENTATIVE: LEISURE DESIGN SYSTEM, INC. GENE EVERTS, 292-33911 OR 1-800-543-2232.


MATERIALS INC., 221 RIO RANCHO DRIVE, SE, RIO RANCHO, NEW MEXICO 87124. RON T. ROMERO, (505) 891-8888.

NOTES:

- PITCHERS MOUND RAISED 6" FOR FIELDS 3+4.
- PITCHERS MOUND RAISED 10" FOR FIELD 1.
- BLEACHERS 10' X 21' - 5 ROW FOR FIELD 1, 10' X 15' - 5 ROW FOR FIELDS 2, 3, 4.

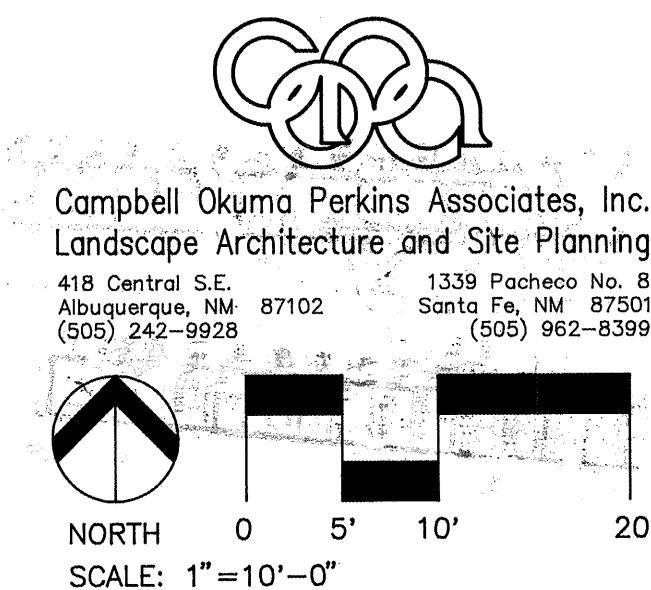

CITY OF ALBUQUERQUE PARKS AND GENERAL SERVICES DEPARTMENT DESIGN AND DEVELOPMENT DIVISION					
TITLE: MARIPOSA BASIN PHASE II- IMPROVEMENTS TYPICAL FIELD ENLARGEMENTS					
APPROVALS	ENGINEER	DATE	APPROVALS	ENGINEER	DATE
DRC CHAIRMAN	B. J. Bailey	10/31/94	WATER	N/A	BALE
TRANSPORTATION	N/A	10/21/94	WASTE WATER	"	"
HYDROLOGY	N/A	10/21/94			
PARKS/GEN. SVC.	N/A	11/1/94			
PROJECT NO. 4000-93	MAP NO.		SHEET 6 OF 21		

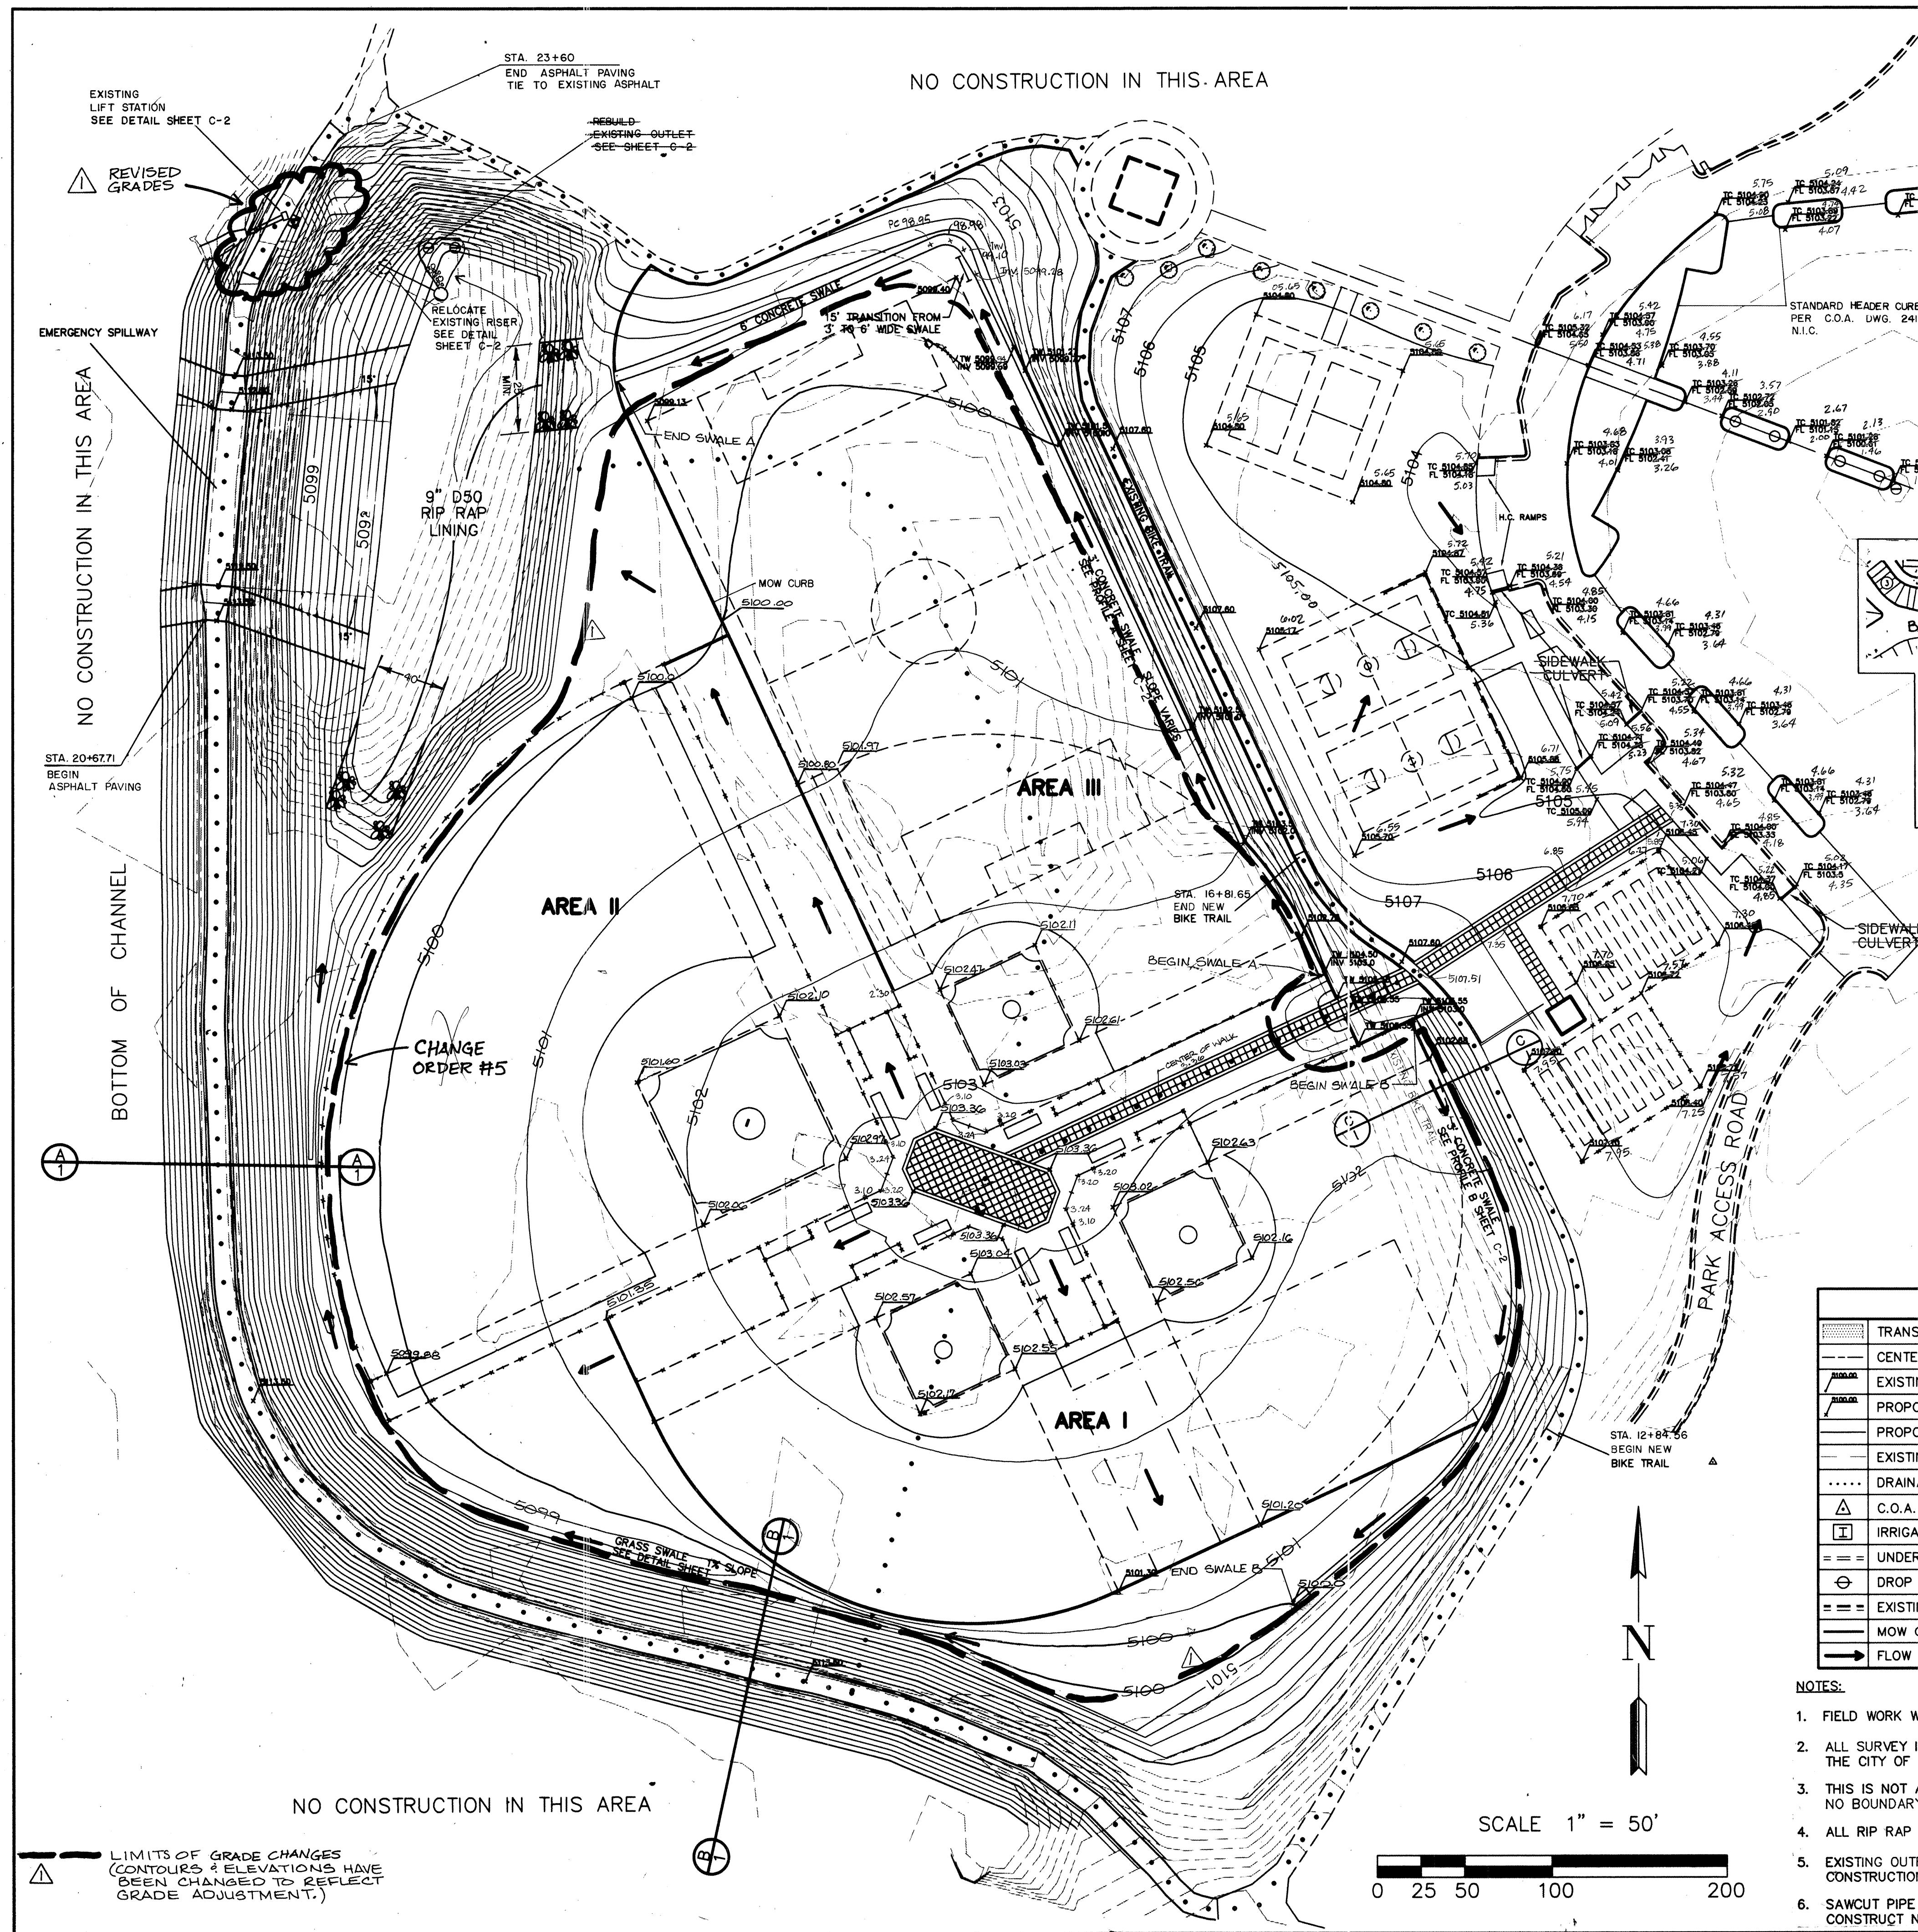

HYDROLOGY NOTES

SITE DESCRIPTION

Existing Condition: The site is currently an undeveloped 15.28 acre tract with a cover of natural vegetation, which lies inside the Mariposa Basin, an existing flood detention facility. Phase I of this project was completed in 1993; this submittal is for Phase II which includes most of the remaining land within the basin which has not yet been developed for park purposes. Proposed development includes relocating the existing 4 foot berm along the westside channel to a total height of 8.5 feet, and adding 1 adult baseball/softball field and 3 youth baseball fields in the currently undeveloped area. These fields will have grassed outfields. Areas between the fields as well as the infield trim will consist of compacted base course material. Volleyball, horseshoe and basketball courts will be constructed in the 3.21-acre area between the low berm that runs through the northeast side of the site and the existing parking lot. Concrete sidewalks and asphalt paved trails are also included in this phase.

DRAINAGE

On-site drainage will follow constructed swales (as shown on plan) and which are located between the proposed fields. The 12.07 acres with the baseball fields were divided into three drainage areas to be identified as Areas I, II, and III on the drainage plan. Area I will drain to a ponding area in the south-east portion of the Mariposa Basin. Areas II and III will drain to the north-west corner of Area III. The remaining 3.21 acres which consists of the volleyball, horseshoe, and basketball court area will drain into the existing parking lot and therefore do not directly contribute to the detention pond. Off-site drainage and runoff will not be part of the drainage calculation in Phase II. (For more information on off-site drainage and runoff, refer to the Master Plan Report and Phase I drawings.)

Hydrologic data computations are in accordance with the City of Albuquerque Development Process Manual (DPM), Section 22.2 Hydrology. The results are as follows:

The Time of Concentration (t_c) was calculated from the most remote portion of any basin within the site and was determined to be less than 0.2 hours. Therefore 0.2 hours was assumed as per DPM. This results in a time to peak (t_p) of 0.13 hours.

PRECIPITATION - ZONE 1

NOAA Atlas 2, Volume IV

100 yr. - 6 hr. rain = 2.20 inches
10 yr. - 6 hr. rain = 1.90 inches

LAND TREATMENT

ON-SITE (site area = 12.07 acres)

Sub-Area	Area (Acres)	%A	%B	%C	%D
I	3.04	0	50	45	5
II	7.23	0	57	38	5
III	1.80	0	85	10	5

EXCESS PRECIPITATION (in.)

Zone	Land Treatment B	Land Treatment C	Land Treatment D
Zone 1	0.67	0.22	0.44
Zone 1	0.99	0.44	1.24
Zone 1	1.97	0.44	1.24

PEAK DISCHARGE (cfs/acre)

Zone	Land Treatment B	Land Treatment C	Land Treatment D
Zone 1	2.03	0.76	0.76
Zone 1	2.87	1.49	1.49
Zone 1	4.37	2.89	2.89

RUN-OFF RESULTS


Sub-Area	Peak Flow (cfs)		Runoff Volume (acre-ft)	
	100 yr.	10 yr.	100 yr.	10 yr.
I	7.68	3.63	0.223	0.094
II	17.83	8.27	0.517	0.214
III	4.02	2.50	0.115	0.044

SWALE HYDRAULICS

	n=0.023 grass swale	n=0.014 concrete swale
	3' Concrete Swale	6' Concrete Swale
n - Value	0.014	0.014
Wetted Depth (ft.)	0.30	0.80
Perimeter (ft.)	3.06	6.12
Flow Area (sq. ft.)	0.45	1.80
Top Width (ft.)	3.00	6.00
Hydraulic Depth (ft.)	0.15	0.30
Velocity (ft./sec.)	2.12	3.35
Computed Discharge (cfs)	0.95	6.02
10-yr Peak Discharge (cfs)	1.25*	2.50*
100-yr Peak Discharge (cfs)	2.01*	4.02*

* The peak flow will be concentrated at the lower end of the basin, therefore reduced Q's were used at the upper reaches of the swale. (Q's were reduced 50%)

** Q's were reduced in this basin due to there being three individual grass swales accommodating the basin.

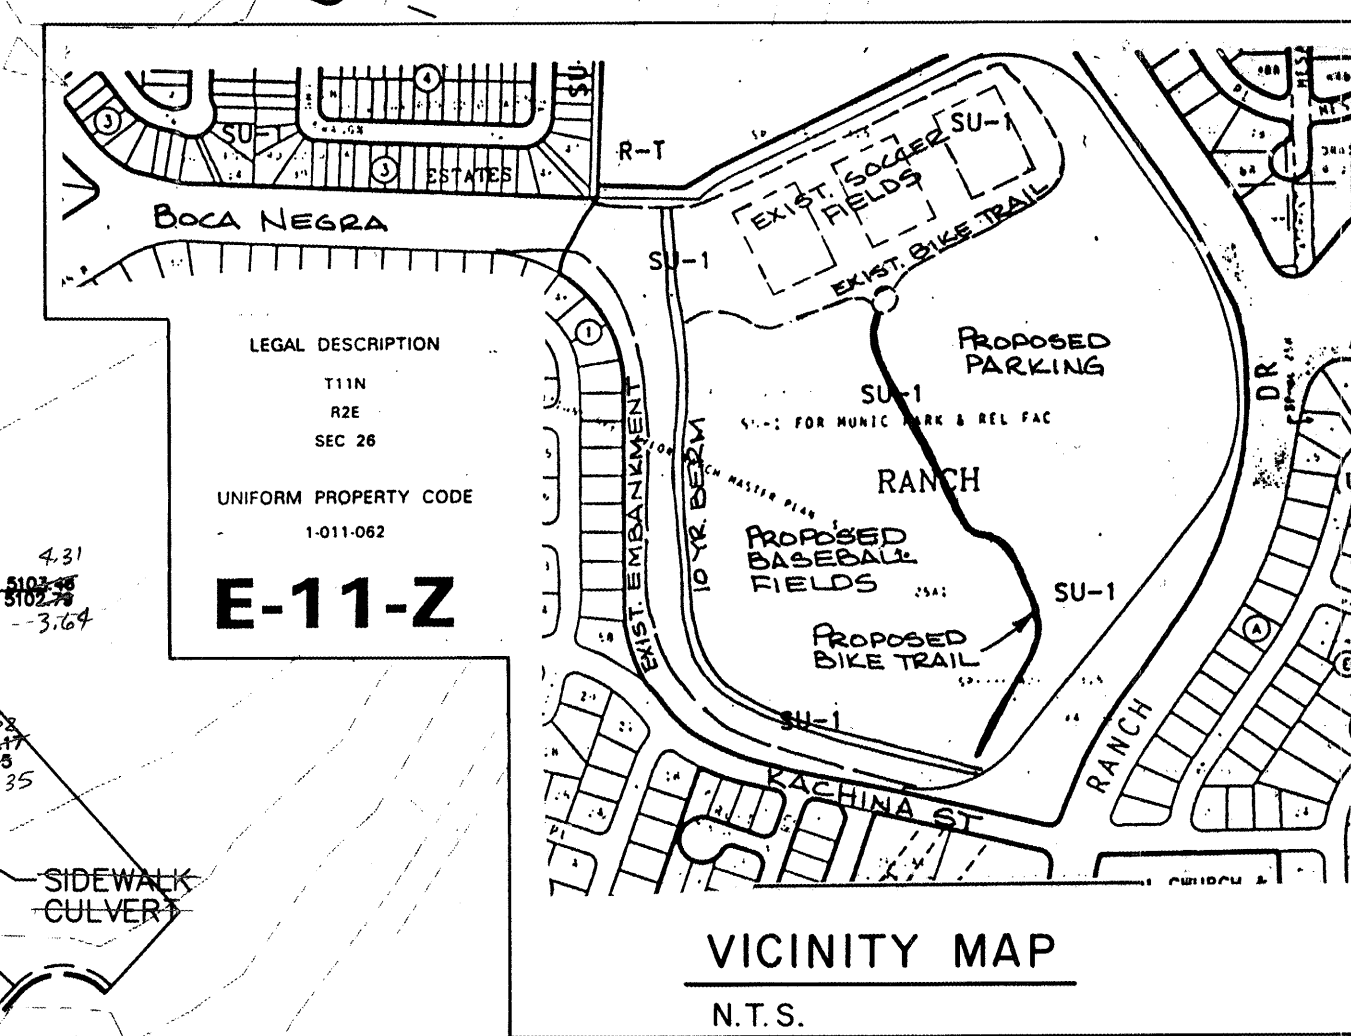

LEGAL DESCRIPTION

MARIPOSA BASIN
WITHIN SECTION 23 & 26
TOWNSHIP 11 NORTH, RANGE 2 EAST
NEW MEXICO PRINCIPAL MERIDIAN
CITY OF ALBUQUERQUE
BERNALILLO COUNTY, NEW MEXICO
APRIL, 1994

LEGEND	
[Symbol]	TRANSITION AREA
[Symbol]	CENTERLINE OF SWALE
[Symbol]	EXISTING ELEVATION
[Symbol]	PROPOSED ELEVATION
[Symbol]	PROPOSED CONTOURS
[Symbol]	EXISTING CONTOURS
[Symbol]	DRAINAGE DIVIDE
[Symbol]	C.O.A. PROJECT CONTROL POINT
[Symbol]	IRRIGATION CONTROL BOX
[Symbol]	UNDERGROUND DRAINAGE PIPE
[Symbol]	DROP INLET
[Symbol]	EXISTING CURB AND GUTTER
[Symbol]	MOW CURB
[Symbol]	FLOW ARROW

NOTES:

1. FIELD WORK WAS COMPLETED ON APRIL 21, 1994.
2. ALL SURVEY INFORMATION AS SHOWN WAS COMPLETED BY THE CITY OF ALBUQUERQUE.
3. THIS IS NOT A BOUNDARY SURVEY. NO BOUNDARY DATA SHOWN IS FROM HEREON.
4. ALL RIP RAP IS 9" D50
5. EXISTING OUTFALL STRUCTURE TO REMAIN PROTECTED DURING CONSTRUCTION AND ASSURE POSITIVE DRAINAGE FROM PIPE.
6. SAWCUT PIPE AND DISPOSE EXISTING OUTFALL STRUCTURE. CONSTRUCT NEW STRUCTURE PER DETAILS SHEET C-2.



Campbell Okuma Perkins Associates, Inc.
Landscape Architecture and Site Planning
418 Central S.E.
Albuquerque, NM 87102
(505) 242-9025

APPROVALS	ENGINEER	DATE	APPROVALS	ENGINEER	DATE
D.R.C. Chair	B.G.A.	10/31/94	WATER		
TRANS. DEV.			WASTE WATER		
HYDROLOGY					
OTHER			OTHER		

CITY OF ALBUQUERQUE MARIPOSA BASIN GRADING and DRAINAGE PLAN

Resource Technology, Inc.
ENGINEERS AND ENVIRONMENTAL SCIENTISTS
2129 Osuna Road NE, Suite 200
Albuquerque, NM 87113
(505) 345-3115












JOB NO.
4000.93

SHEET NO.
7 OF 20

DESIGNED BY: ED. DRAWN BY: T.B. CHECKED BY: ED. DATE: AUG 1994




REVISED: 12/6/94

R-C1 12/6/94

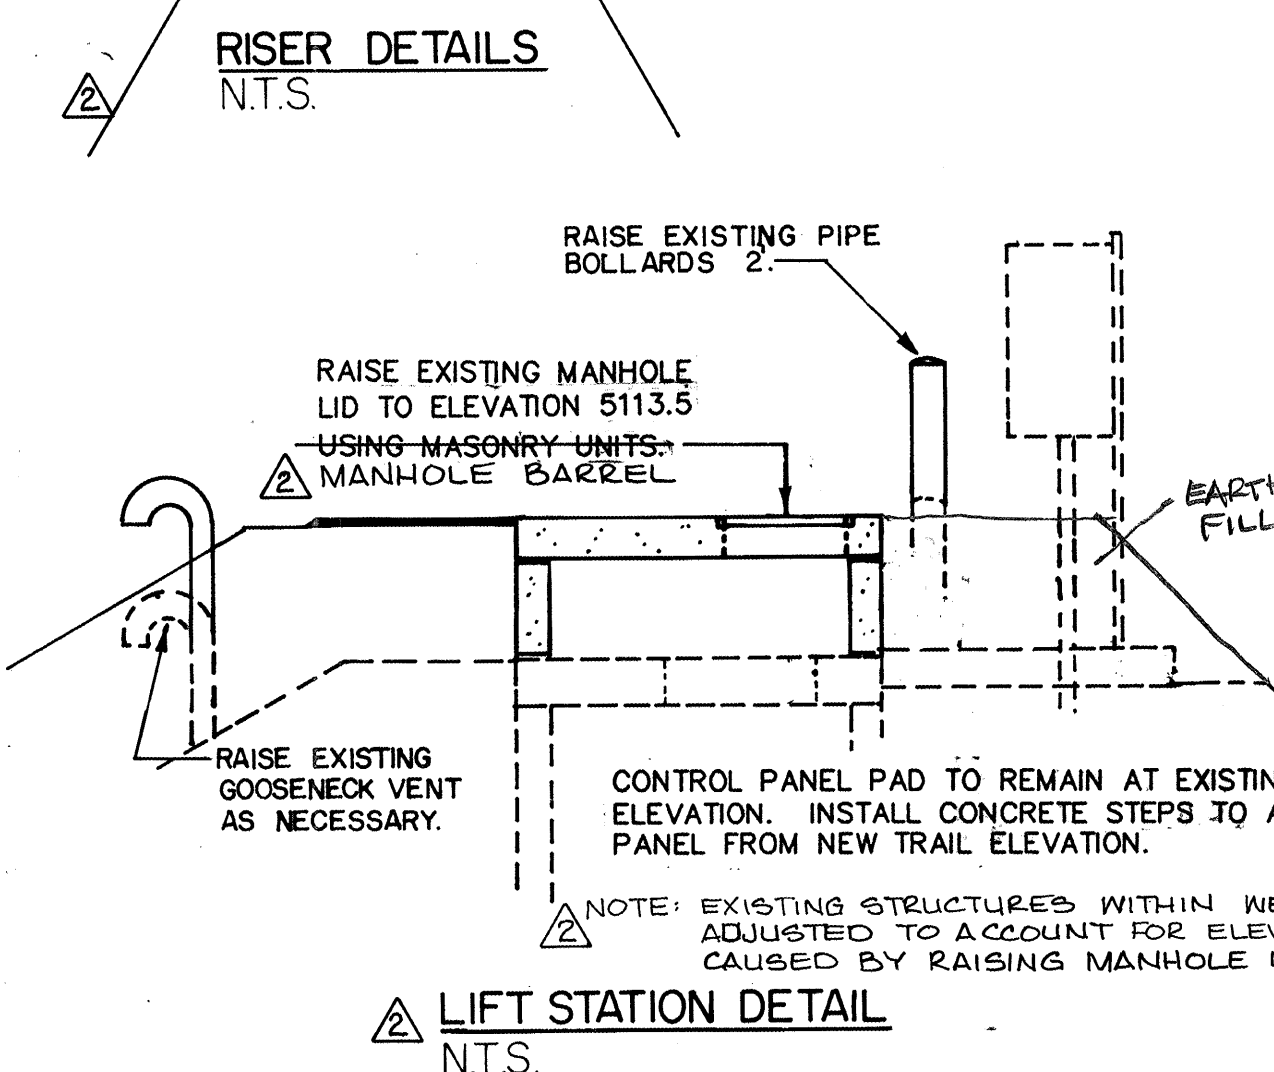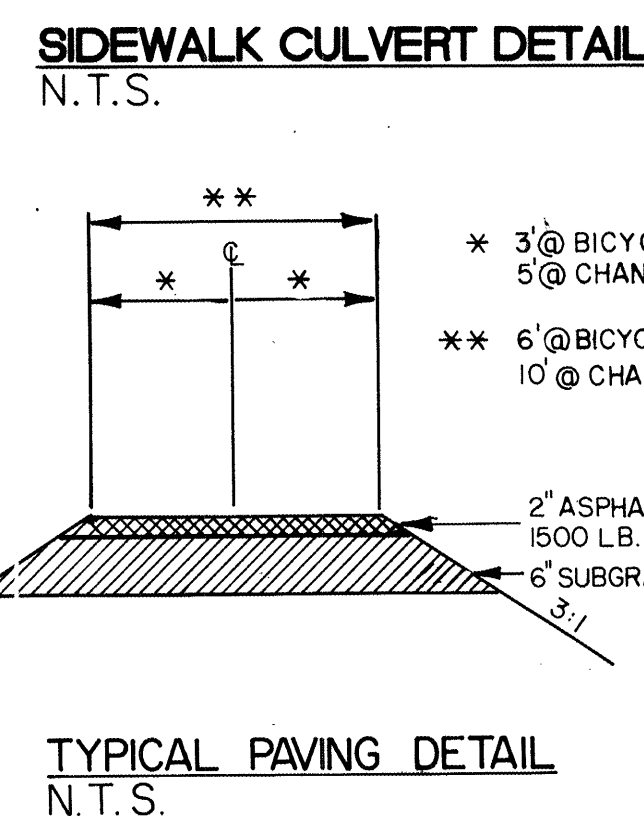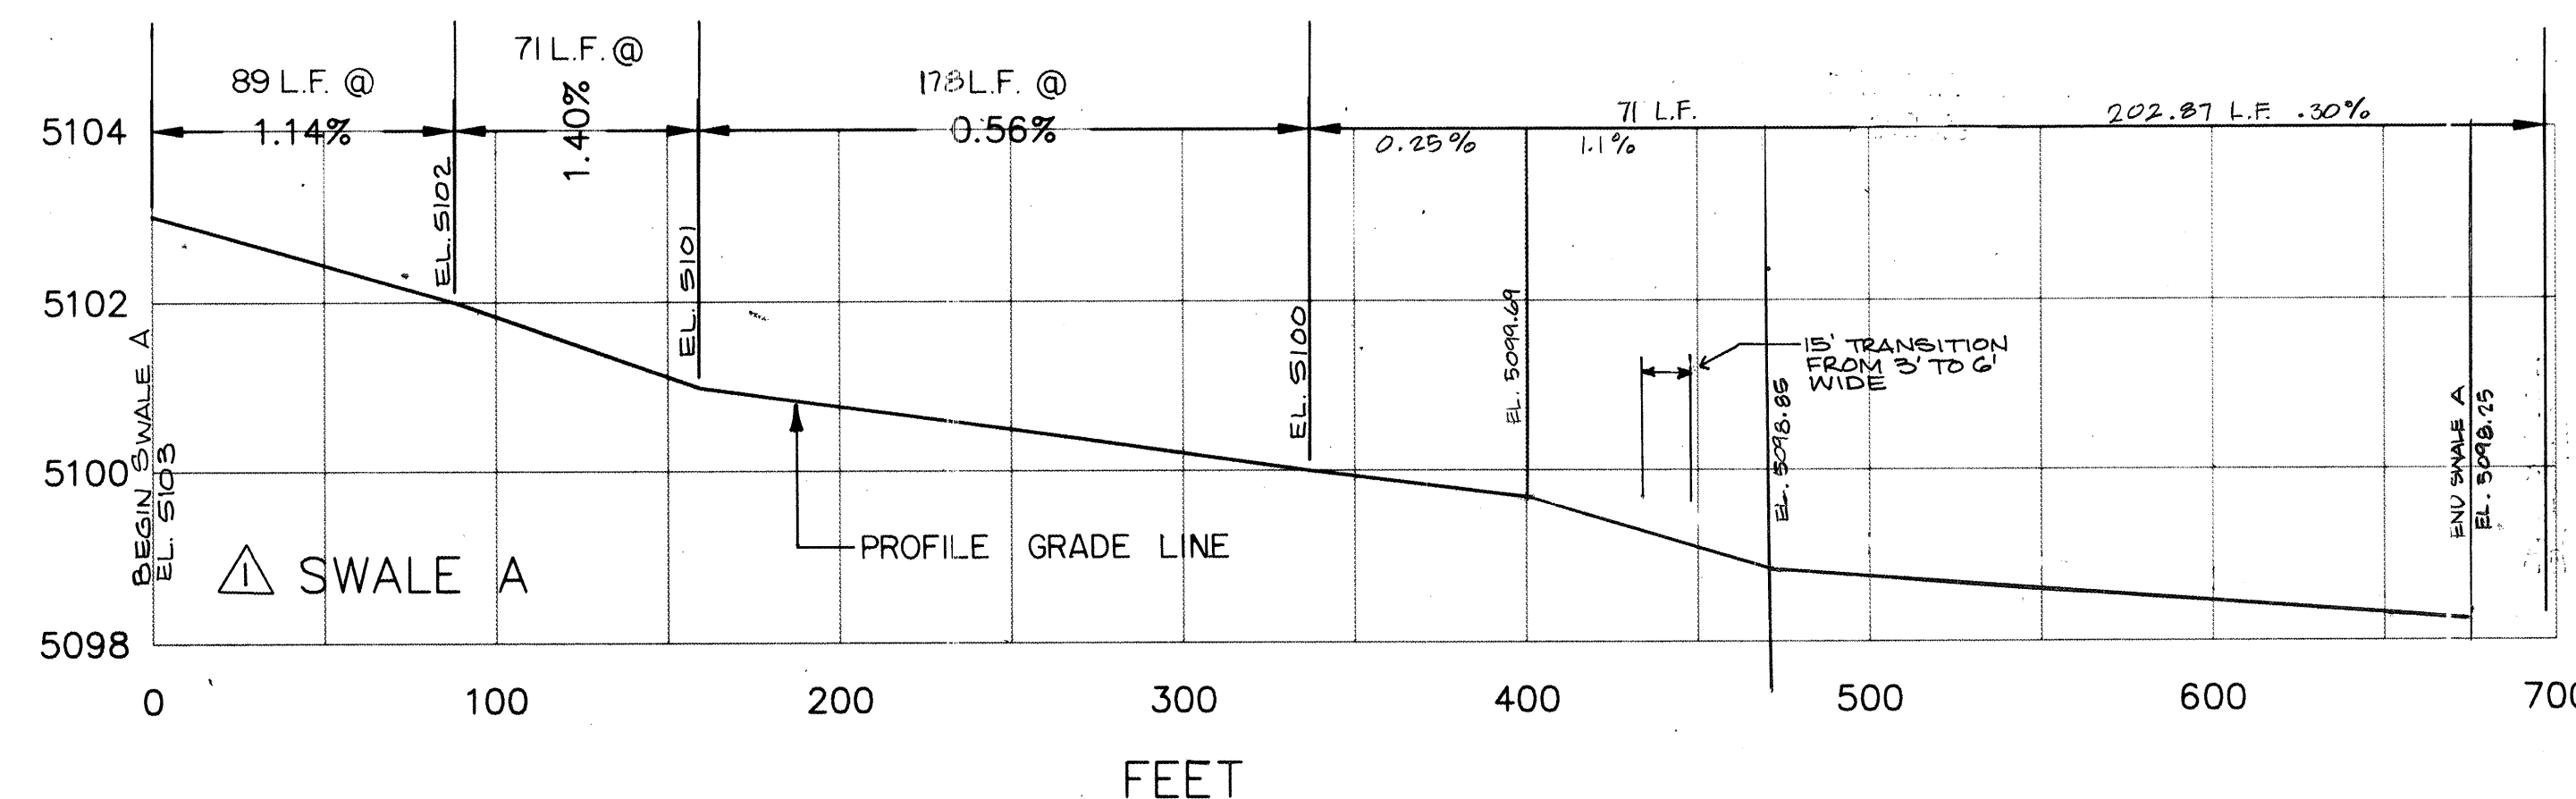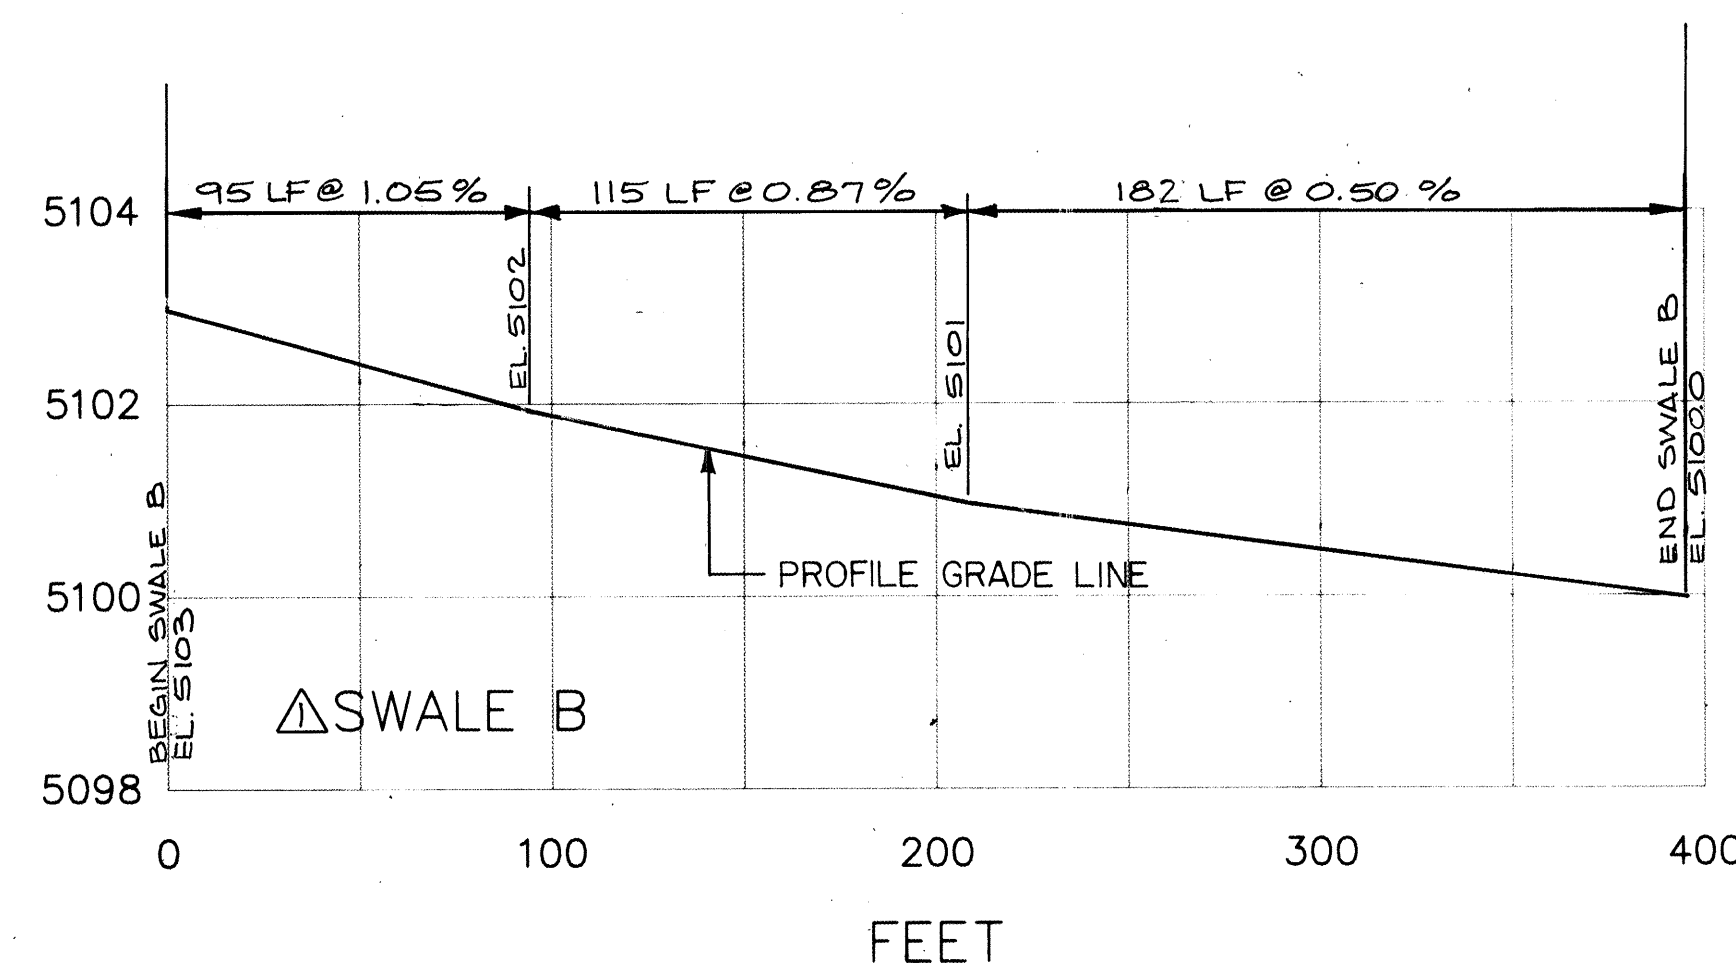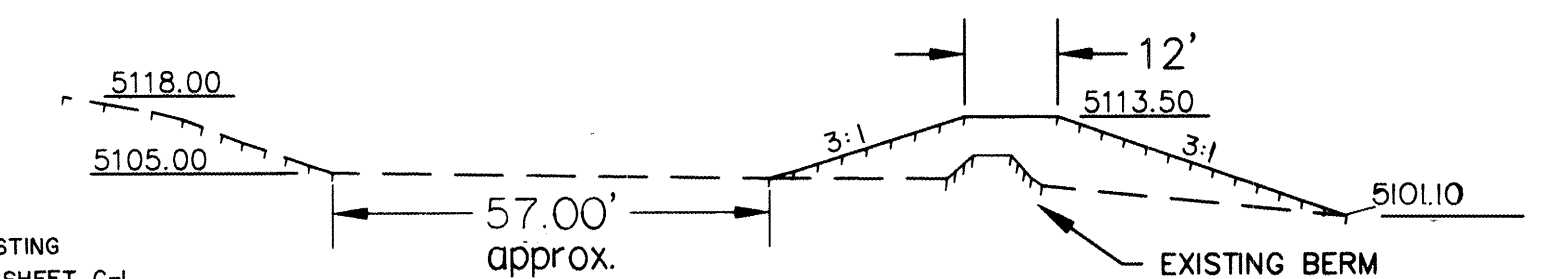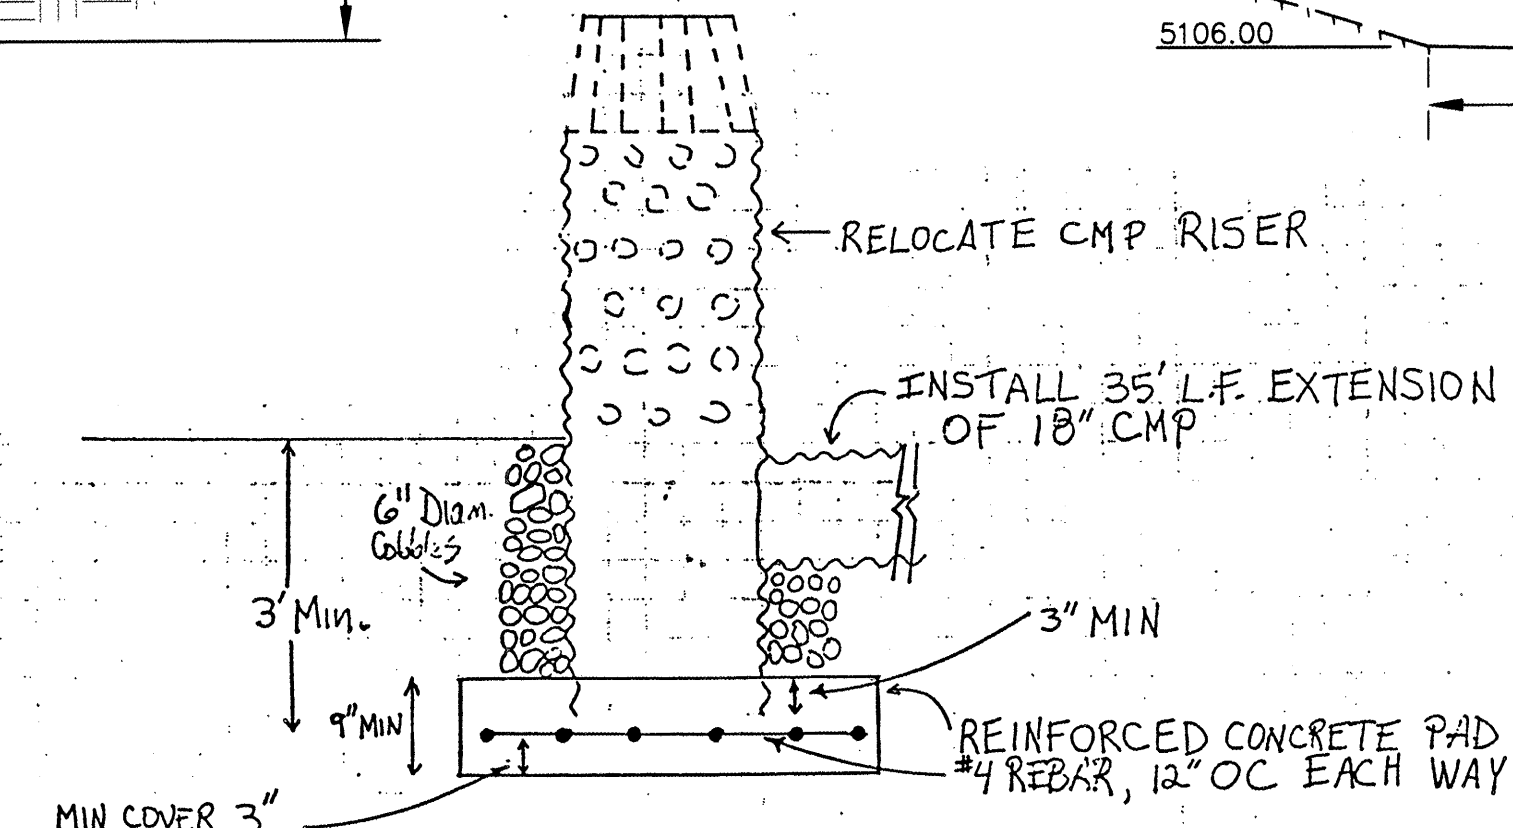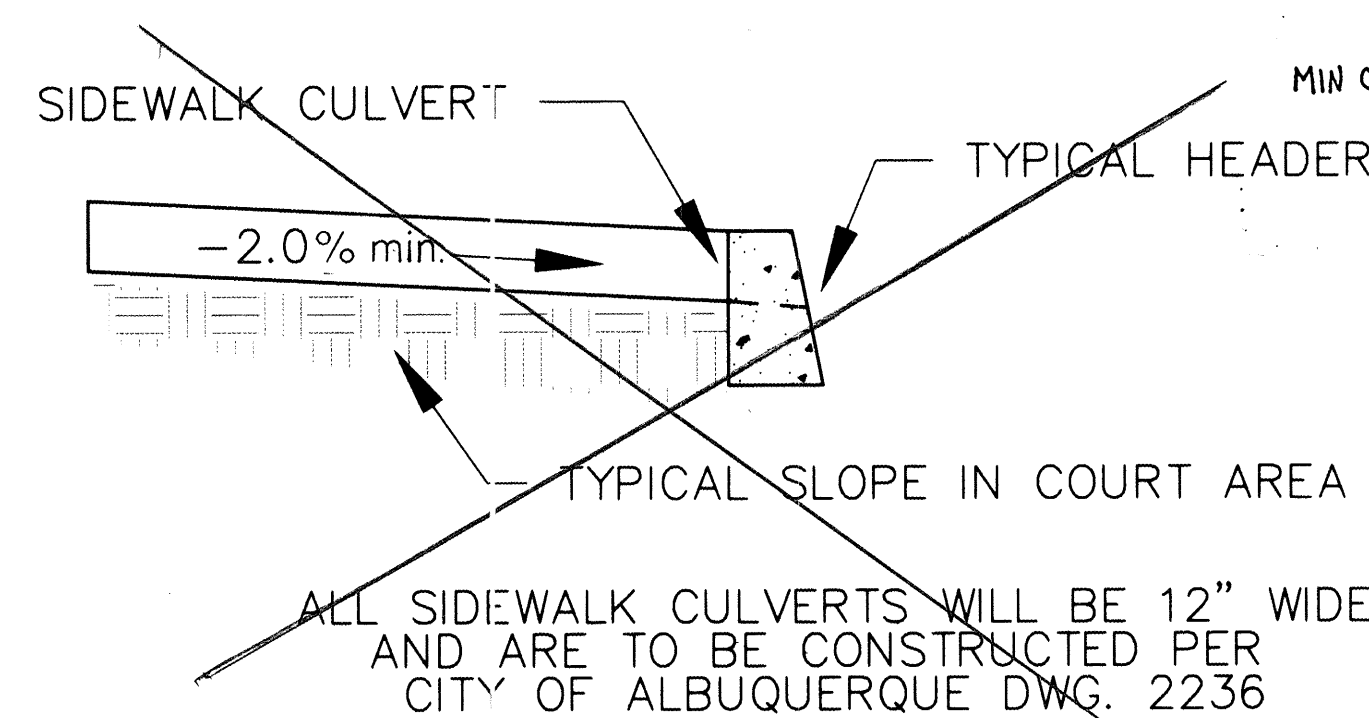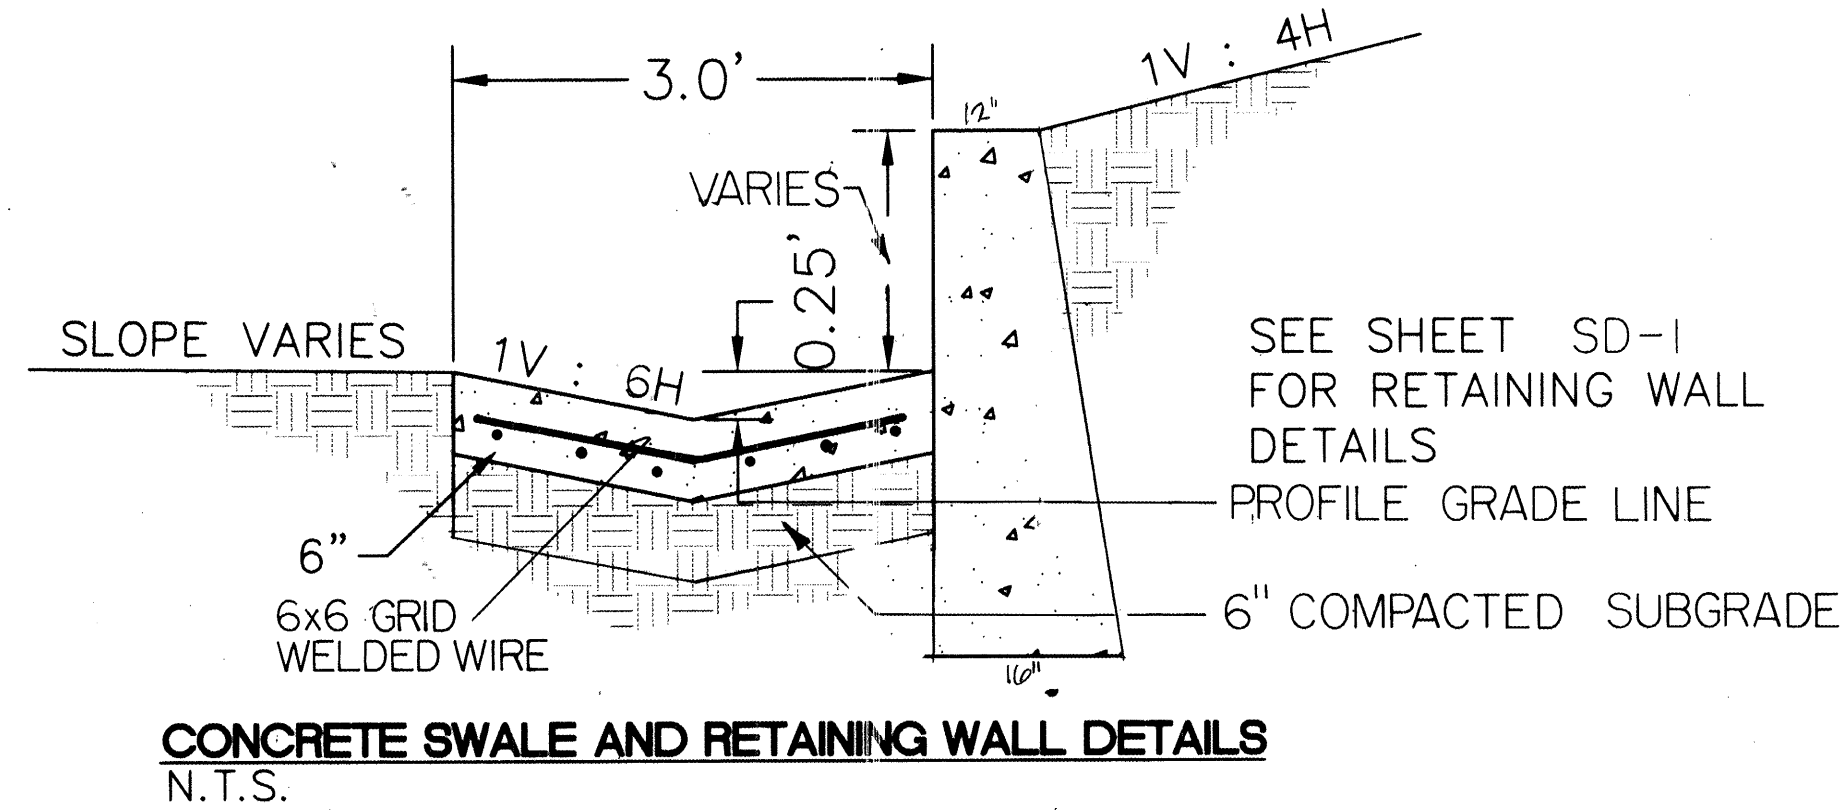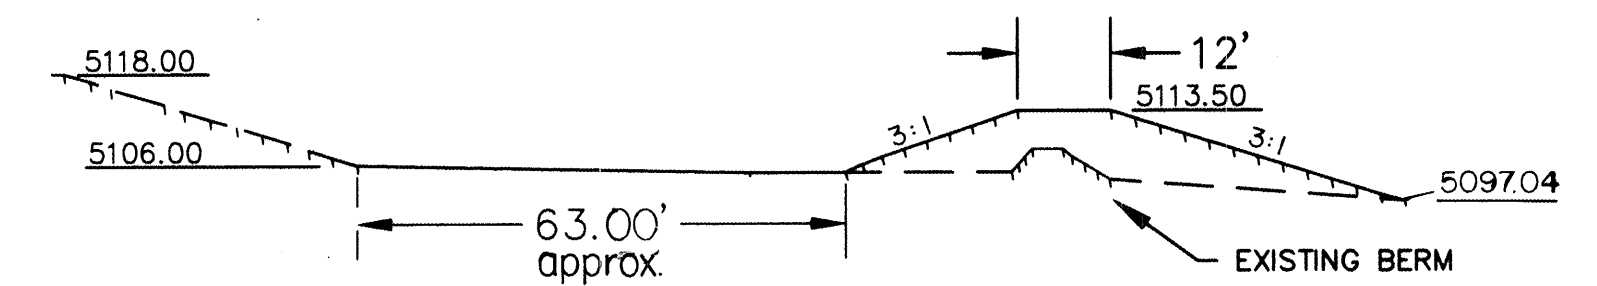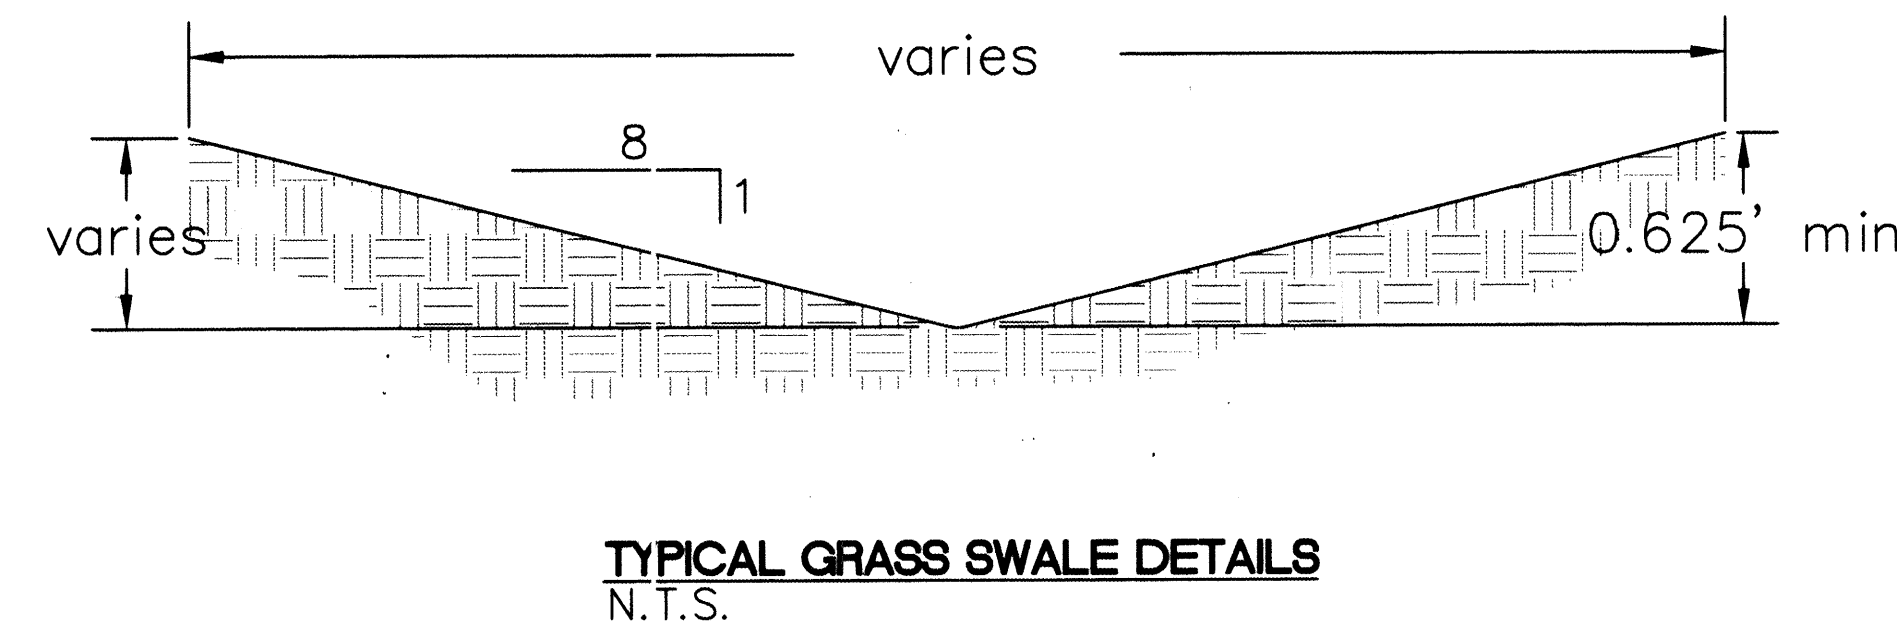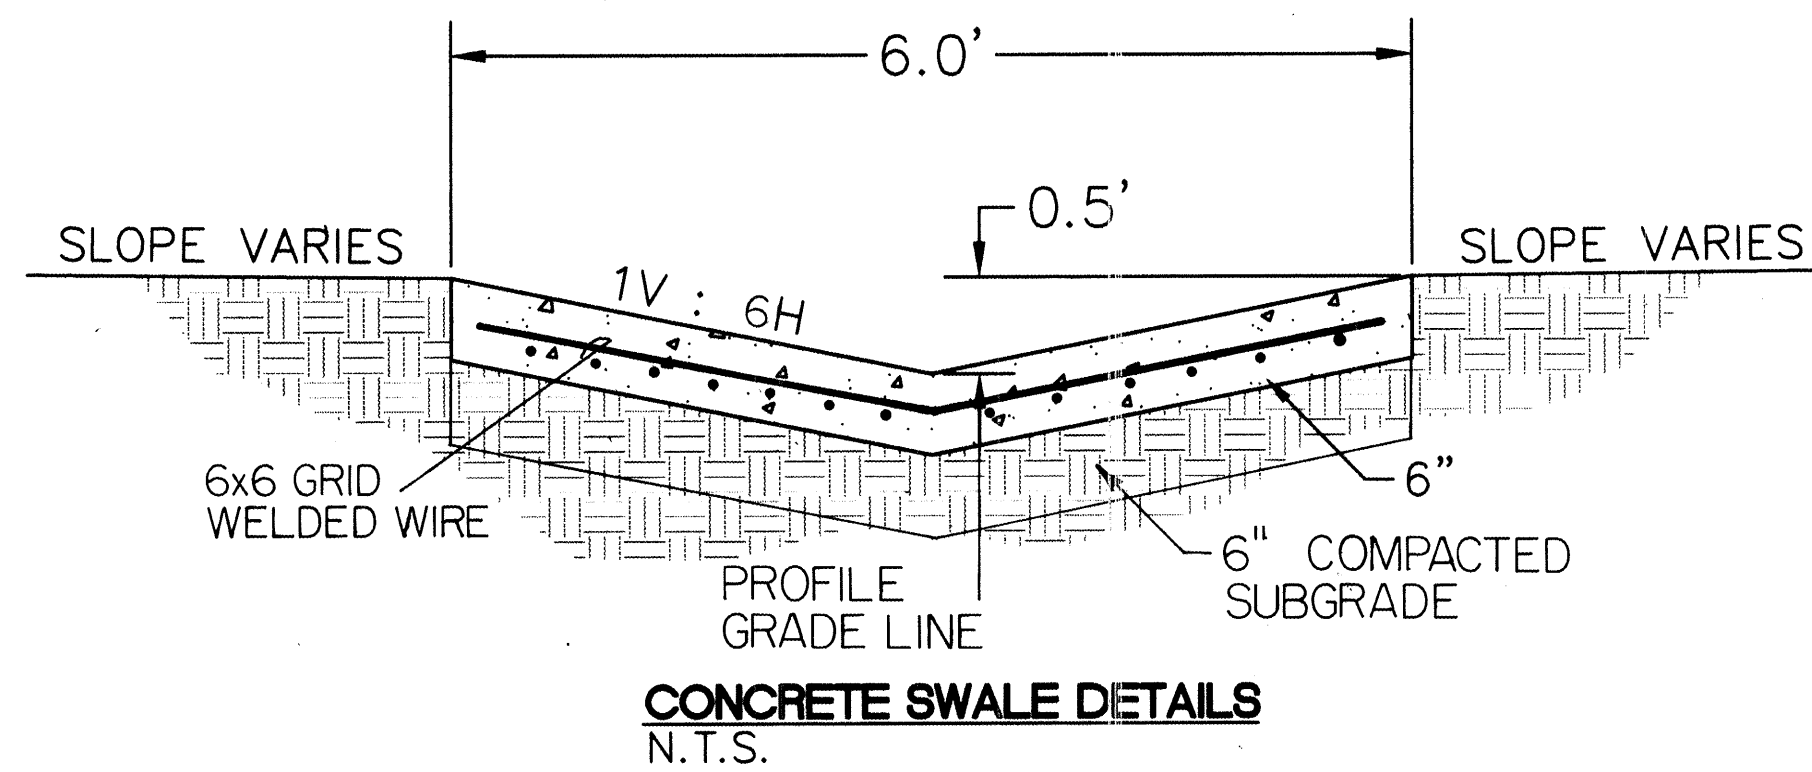


APPROVALS	ENGINEER	DATE	APPROVALS	ENGINEER	DATE
D.R.C. Chair			WASTE WATER		
TRANS. DEV.					
HYDROLOGY					
OTHER			OTHER		

26-14000-93-0697					
------------------	--	--	--	--	--

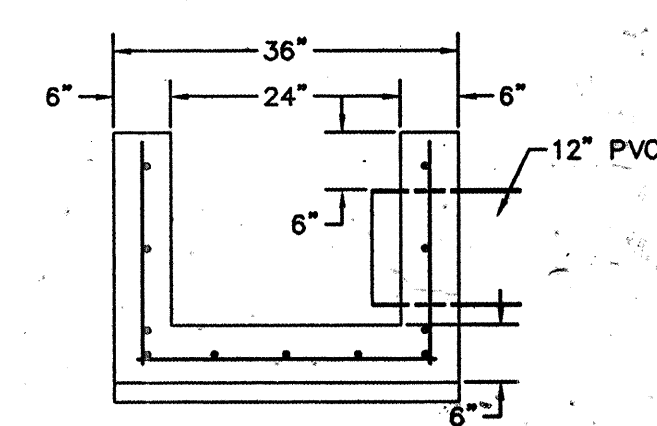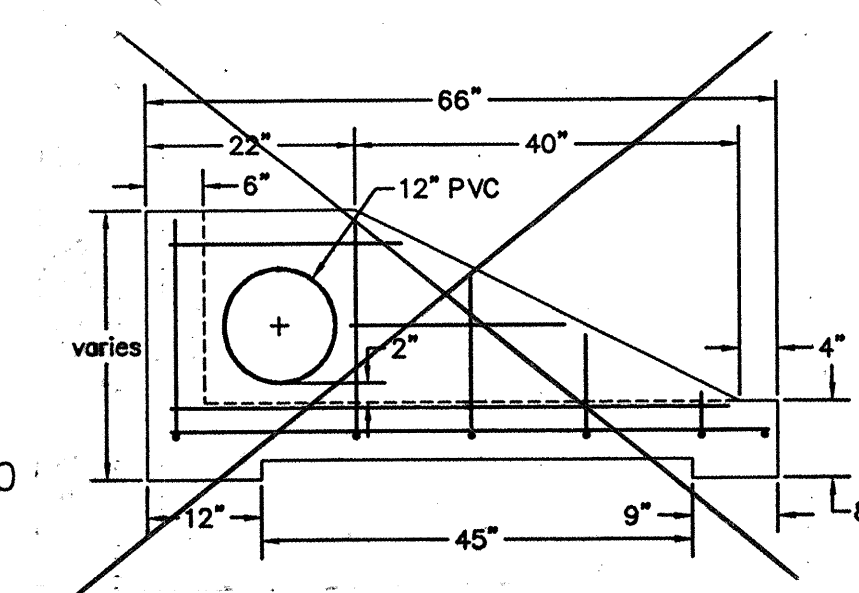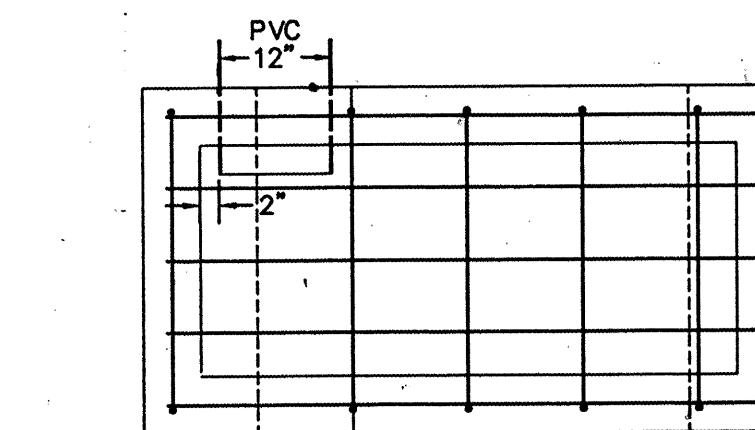

Campbell Okuma Perkins Associates, Inc.
Landscape Architecture and Site Planning
418 Central S.E.
Albuquerque, NM 87102
(505) 242-9928

CITY OF ALBUQUERQUE		MARIPOSA BASIN		GRADING and DRAINAGE DETAILS	
DESIGNED BY: ED.		DRAWN BY: T.A.		CHECKED BY: ED.	
DATE: JULY 1994		DATE: JULY 1994		DATE: JULY 1994	

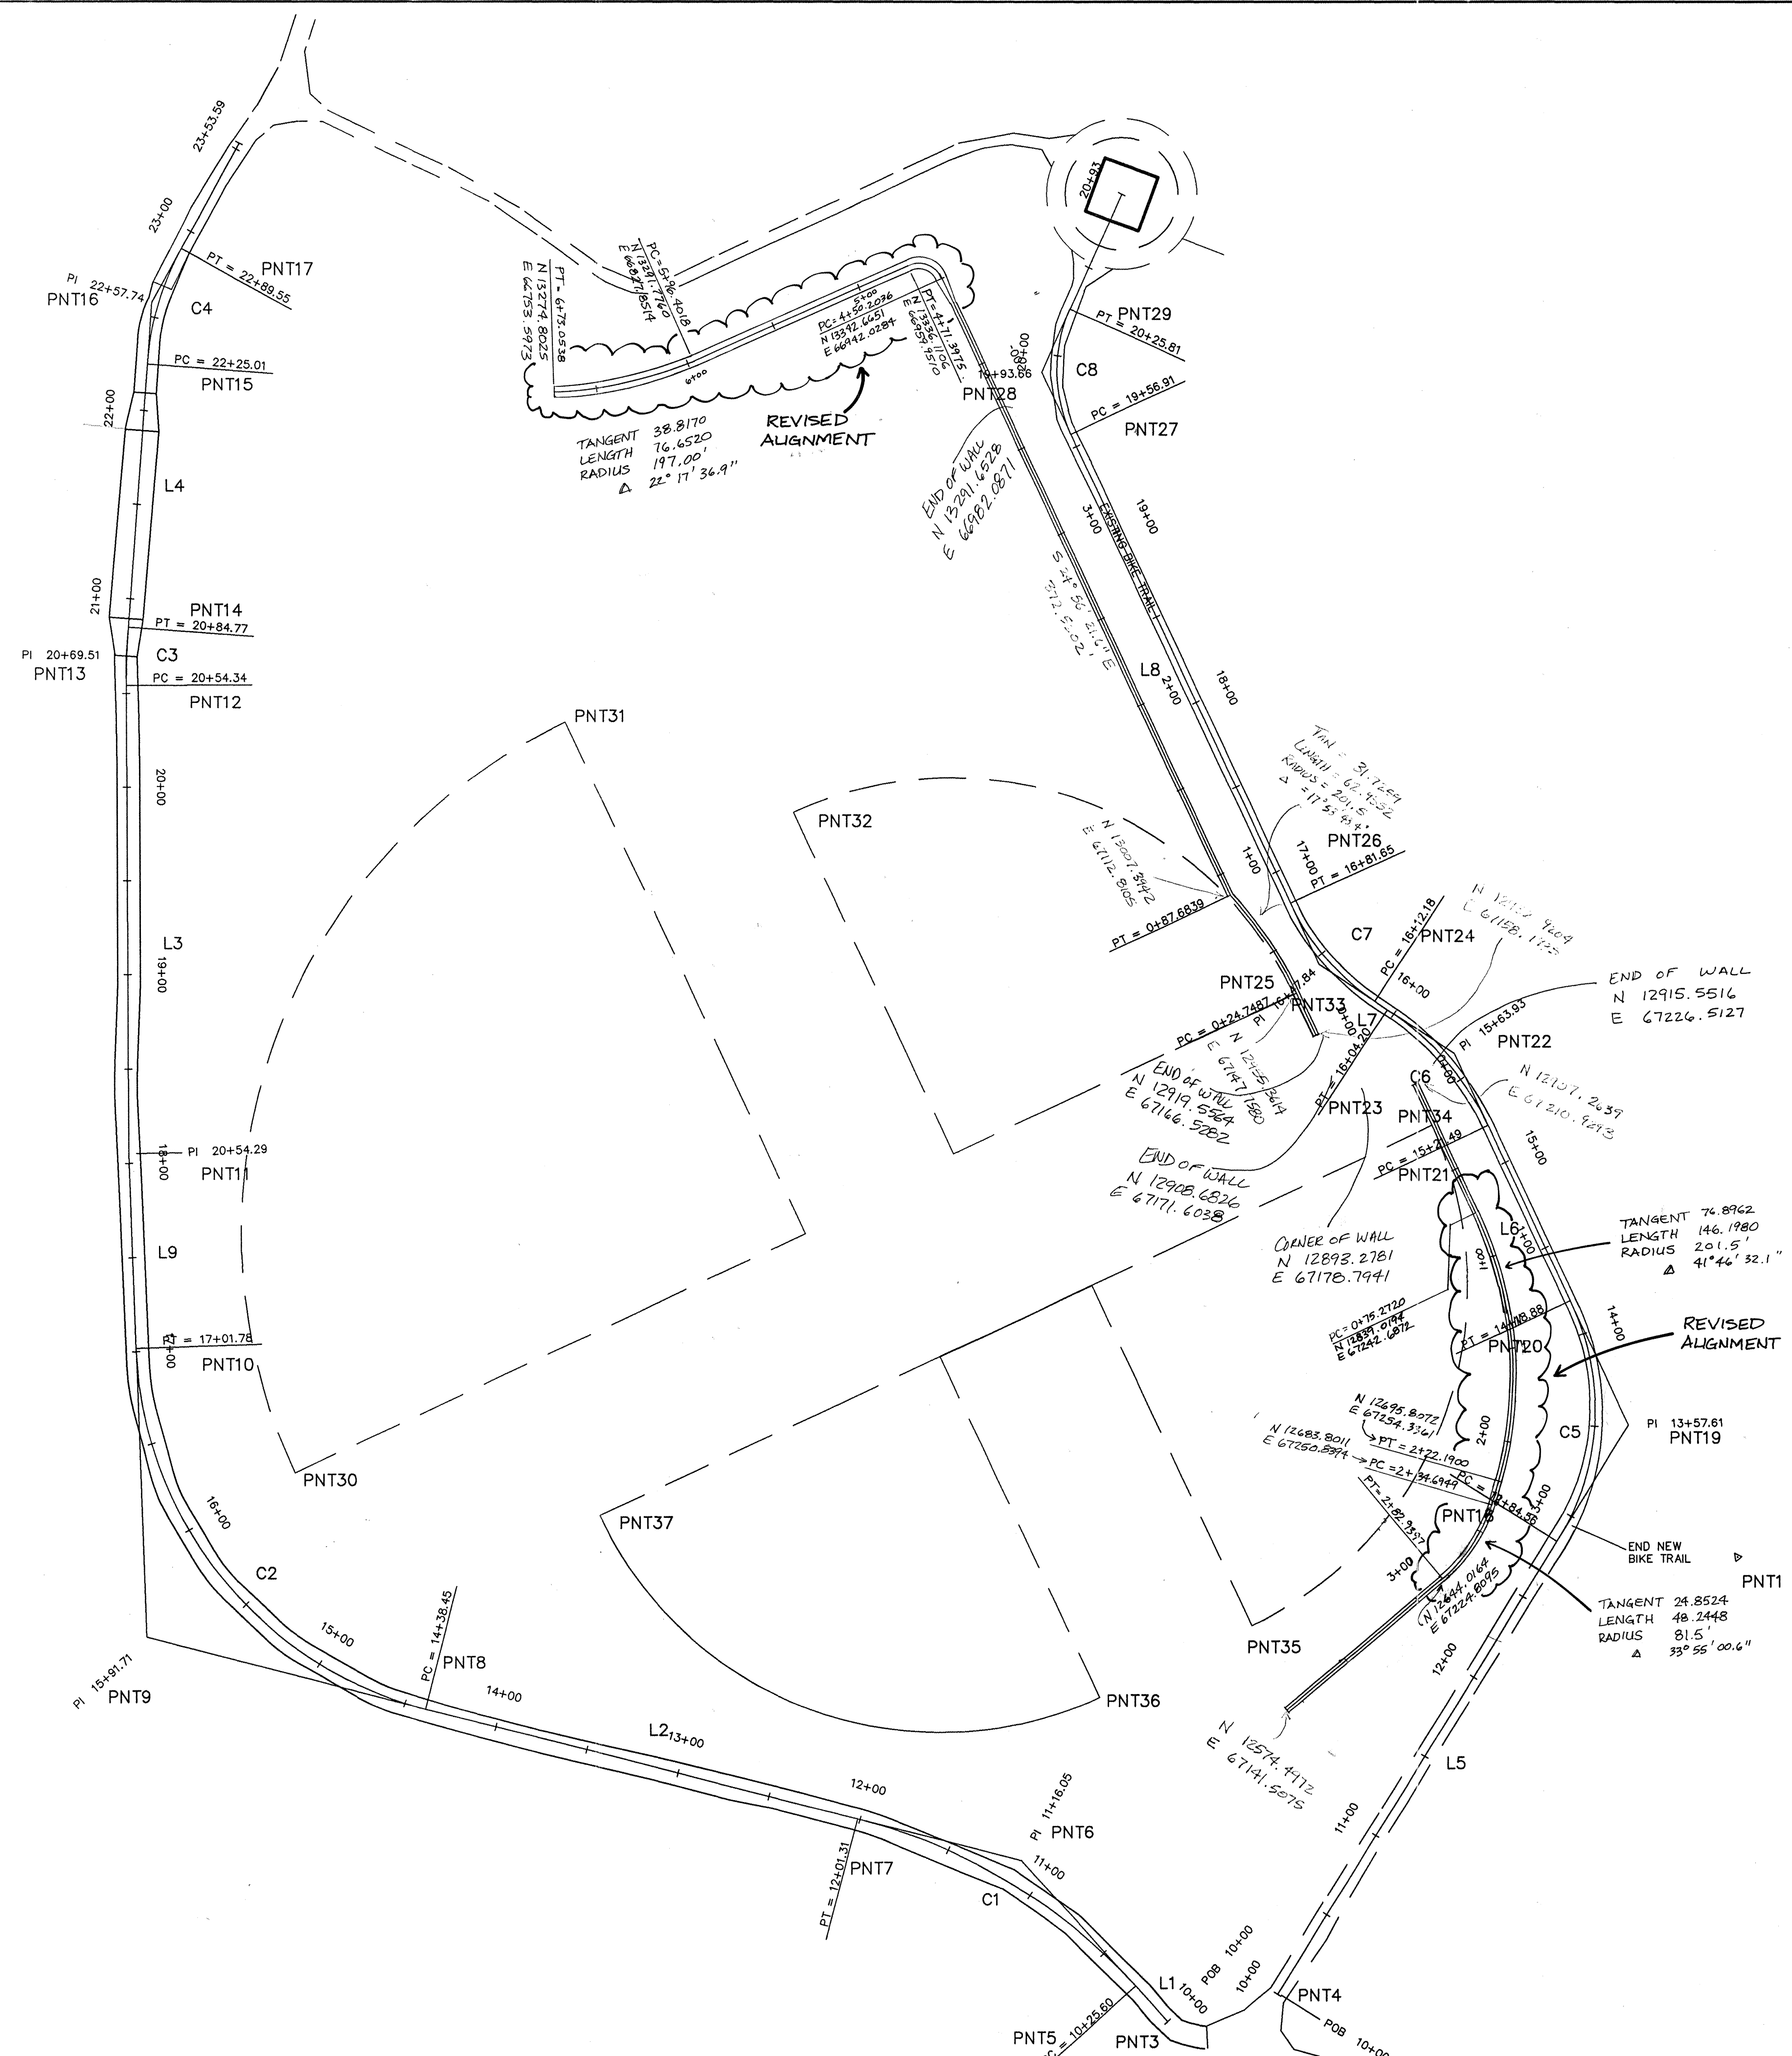

CURVE TABLES

CURVE	RADIUS	LENGTH	TANGENT	DELTA	STATION
C1	300	175.70	90.45	33° 33' 26"	11+16.05
C2	205	263.33	153.35	73° 35' 53"	15+91.79
C3	400	30.43	15.22	4° 21' 33"	20+69.51
C4	150	64.54	32.78	24° 39' 09"	22+57.74
C5	132	134.32	73.05	56° 40' 32"	13+57.61
C6	150	82.71	42.44	31° 35' 39"	15+63.93
C7	125	69.47	35.66	31° 50' 30"	16+47.84
C8	80	68.90	36.75	49° 20' 53"	19+93.66


LINE	BEARING	DIST.
L1	N 41° 55' 00" W	25.60
L2	N 75° 28' 26" W	237.14
L3	N 00° 07' 31" W	248.89
L4	N 04° 14' 03" E	140.24
L5	N 31° 39' 14" E	284.56
L6	N 25° 01' 18" W	102.61
L7	N 56° 36' 57" W	7.98
L8	N 24° 59' 22" W	275.26
L9	N 01° 52' 33" W	103.66

POINT	X COORD.	Y COORD.
PNT1	X = 67381.7648	Y = 12655.3457
PNT2	X = 67588.6635	Y = 12911.5963
PNT3	X = 67077.7093	Y = 12407.1526
PNT4	X = 67136.2259	Y = 12421.4114
PNT5	X = 67060.6045	Y = 12426.2051
PNT6	X = 67000.1774	Y = 12493.5126
PNT7	X = 66912.6160	Y = 12516.2001
PNT8	X = 66683.0534	Y = 12575.6808
PNT9	X = 66534.6014	Y = 12614.1453
PNT10	X = 66529.5817	Y = 12767.4173
PNT11	X = 66526.1885	Y = 12871.0251
PNT12	X = 66525.6448	Y = 13119.9180
PNT13	X = 66525.6115	Y = 13135.1420
PNT14	X = 66526.7355	Y = 13150.3245
PNT15	X = 66537.0895	Y = 13290.1795
PNT16	X = 66539.5095	Y = 13322.8675
PNT17	X = 66555.3435	Y = 13351.5663
PNT18	X = 67285.5572	Y = 12663.6352
PNT19	X = 67323.8939	Y = 12725.8196
PNT20	X = 67292.9957	Y = 12792.0155
PNT21	X = 67249.5966	Y = 12884.9934
PNT22	X = 67231.6471	Y = 12923.4482
PNT23	X = 67196.2117	Y = 12946.7994
PNT24	X = 67189.5503	Y = 12951.1891
PNT25	X = 67159.7773	Y = 12970.8089
PNT26	X = 67144.8357	Y = 13003.1836
PNT27	X = 67028.5505	Y = 13252.6793
PNT28	X = 67013.0097	Y = 13285.9837
PNT29	X = 67028.1528	Y = 13319.4708
PNT30	X = 66614.0645	Y = 12701.1353
PNT31	X = 66759.0206	Y = 13099.8680
PNT32	X = 66880.2998	Y = 13051.6378
PNT33	X = 67146.1216	Y = 12995.0004
PNT34	X = 67219.6178	Y = 12885.0213
PNT35	X = 67122.9804	Y = 12619.1995
PNT36	X = 67041.8824	Y = 12581.3456
PNT37	X = 66766.0607	Y = 12677.9830

Campbell Okuma Perkins Associates, Inc.
Landscape Architecture and Site Planning
418 Central S.E. Albuquerque, NM 87102 (505) 242-9928
1339 Pacheco No. 8 Santa Fe, NM 87505 (505) 982-8399

26-14000-93 1079H

NO. DATE		REVISIONS		BY	CHKD
CITY OF ALBUQUERQUE MARIPOSA BASIN SITE LAYOUT					
Resource Technology, Inc. ENGINEERS AND ENVIRONMENTAL SCIENTISTS 2129 Osuna Road NE, Suite 200 Albuquerque, NM 87113 (505) 345-3115				JOB NO. 94 - 110 SHEET NO. C2.1	
REVISED JAN 10, 1995					

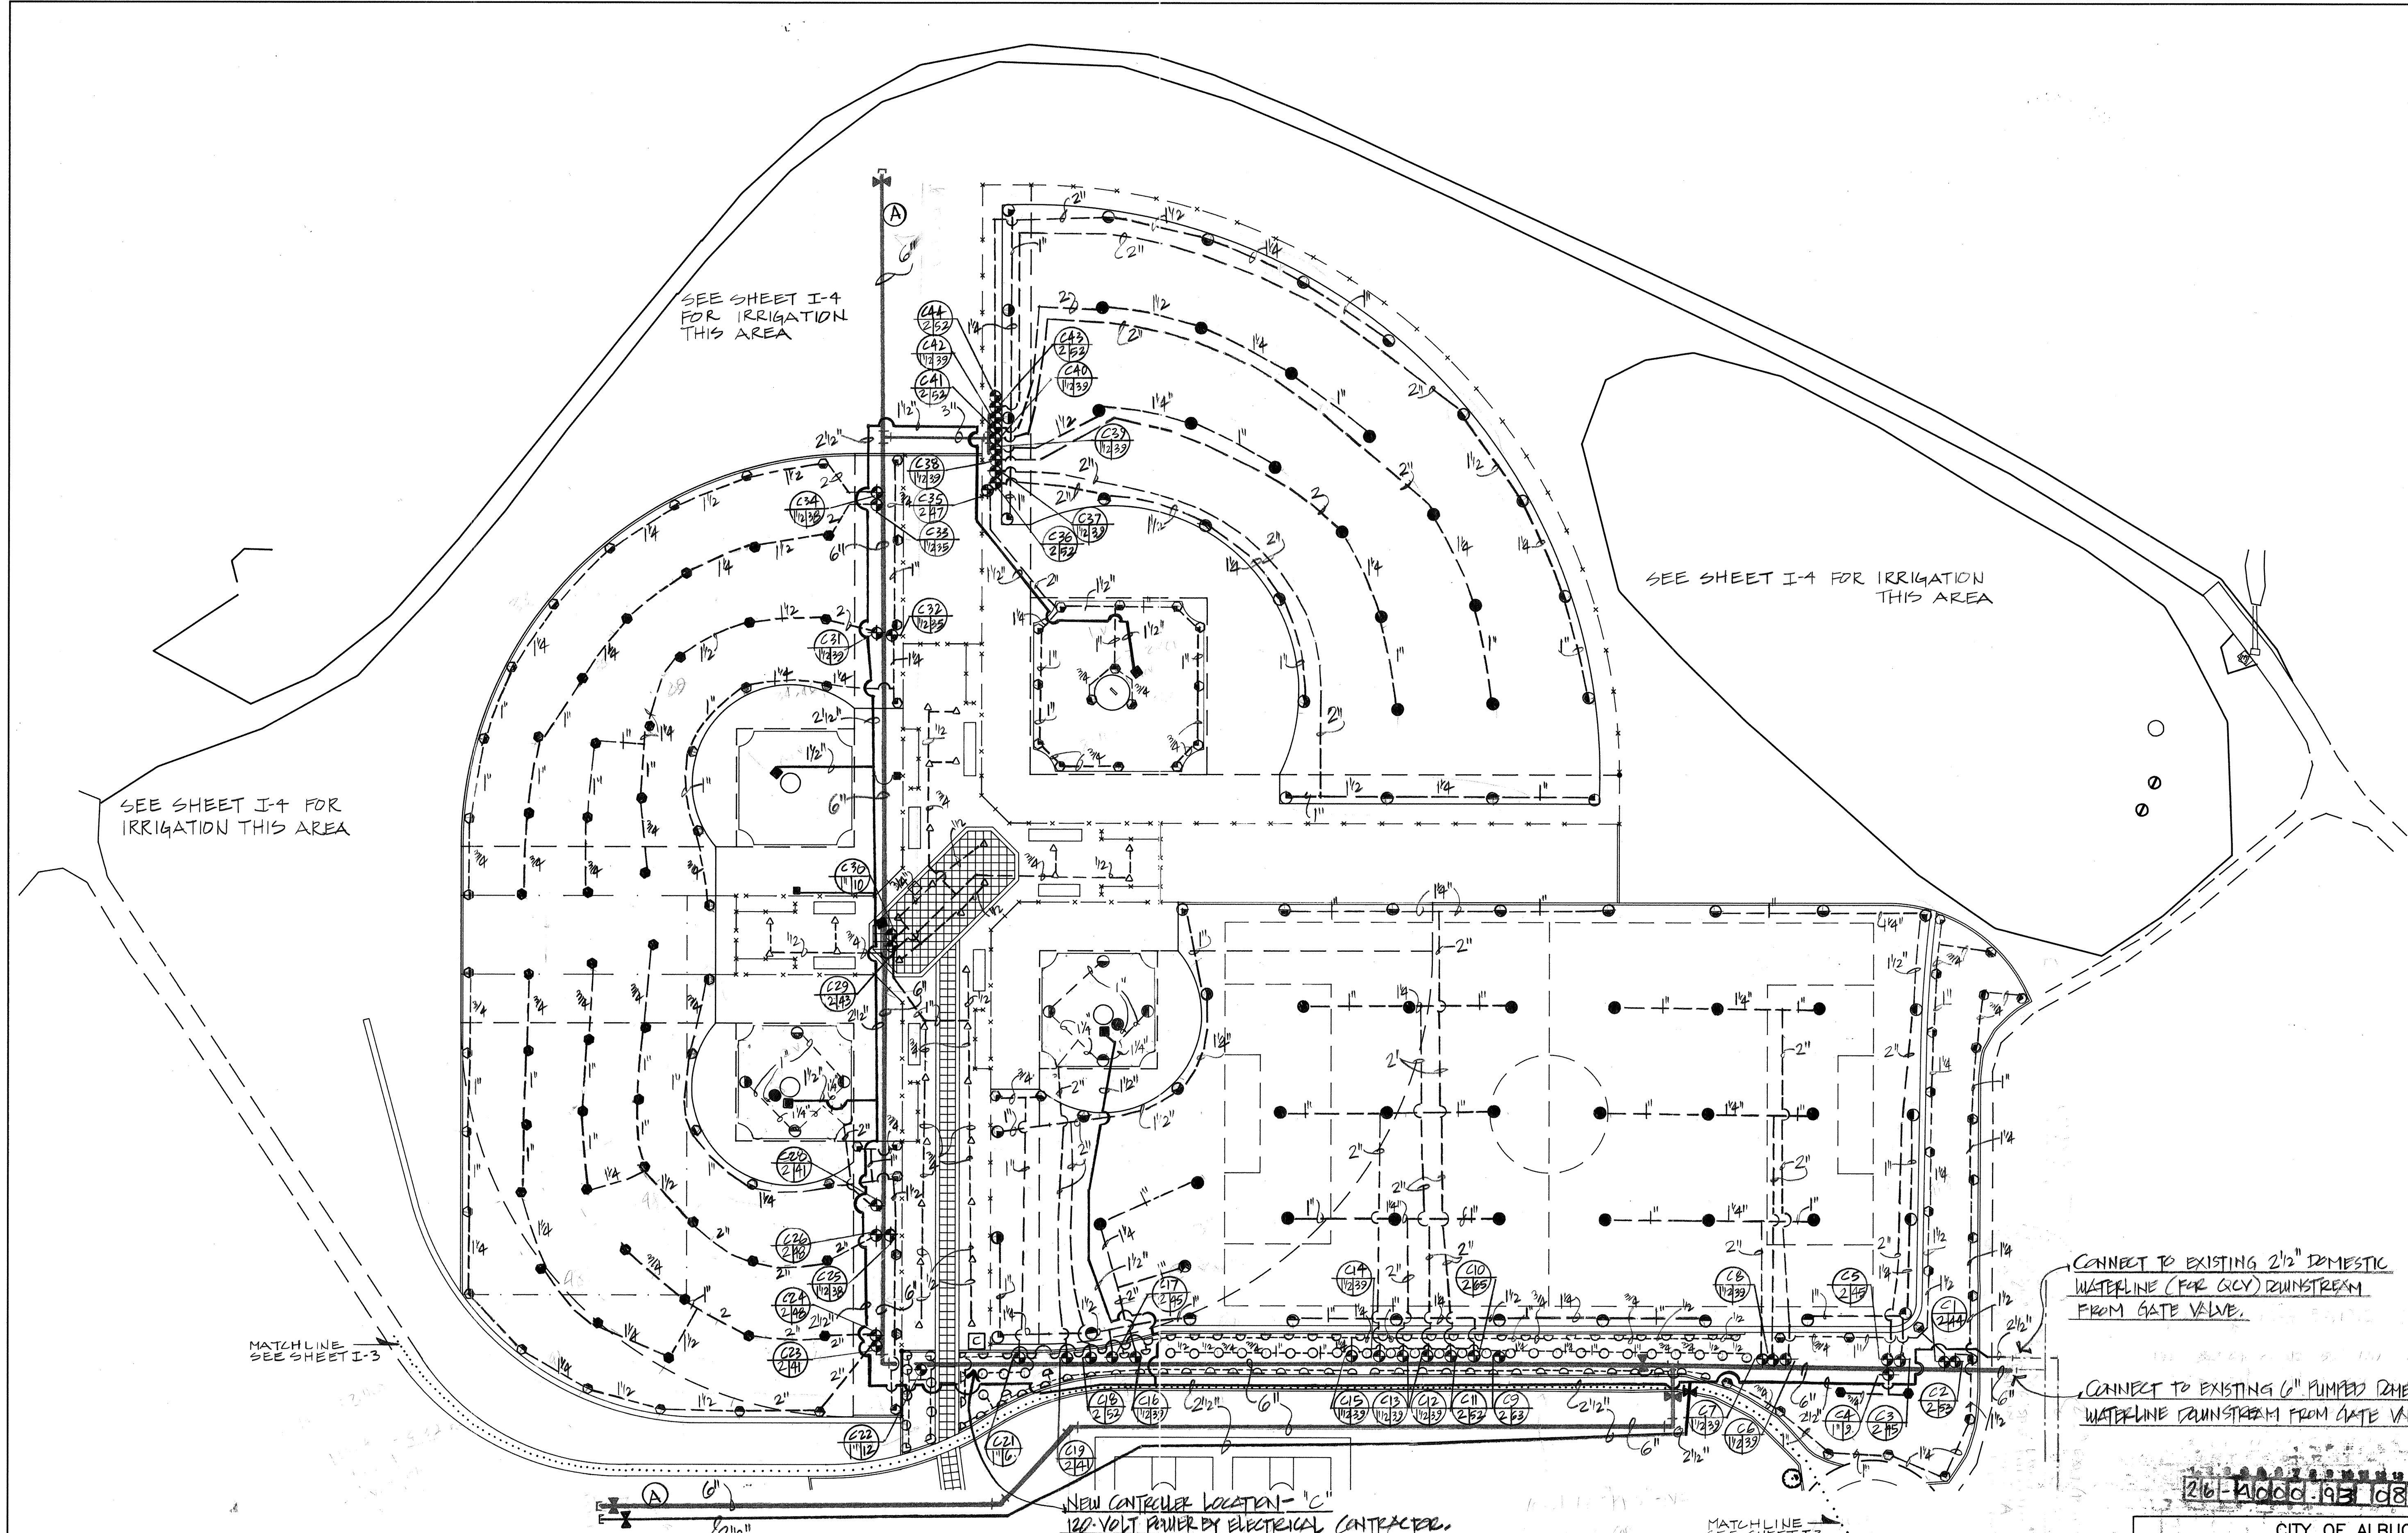

SEE SHEET I-3 FOR IRRIGATION THIS AREA

CONNECT TO EXISTING 2 1/2" DOMESTIC WATERLINE (FOR GCV) DOWNSTREAM FROM GATE VALVE.


CONNECT TO EXISTING 6" PUMPED DOMESTIC WATERLINE DOWNSTREAM FROM GATE VALVE.

NEW CONTROLLER LOCATION - 1" 120-VOLT POWER BY ELECTRICAL CONTRACTOR.

Coates Irrigation Consultants Inc.

4300 NORTH MILLER ROAD, 104 SCOTTSDALE ARIZONA, 85251 UNITED STATES
(602) 481-0682 FAX: (602) 481-0939

Campbell Okuma Perkins Associates, Inc.
Landscape Architecture and Site Planning
418 Central S.E. Albuquerque, NM 87102
(505) 242-9928
1339 Pacheco No. 8 Santa Fe, NM 87501
(505) 962-8399

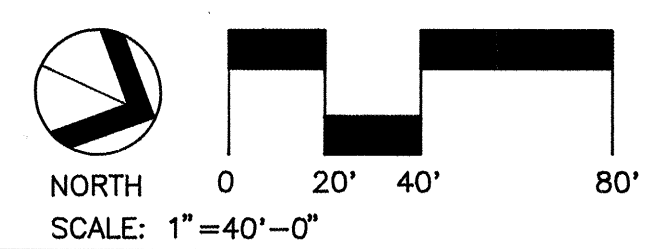

CITY OF ALBUQUERQUE PARKS AND GENERAL SERVICES DEPARTMENT DESIGN AND DEVELOPMENT DIVISION					
TITLE: MARIPOSA BASIN PHASE II- IMPROVEMENTS IRRIGATION PLAN - ATHLETIC FIELDS					
APPROVALS	ENGINEER	DATE	APPROVALS	ENGINEER	DATE
DRC CHAIRMAN	<i>[Signature]</i>	10/31/94	WATER	<i>[Signature]</i>	11/1/94
TRANSPORTATION	<i>[Signature]</i>	10/31/94	WASTE WATER	<i>[Signature]</i>	11/1/94
HYDROLOGY	<i>[Signature]</i>	10/31/94			
PARKS/GEN. SVC.	<i>[Signature]</i>	11/1/94			
PROJECT NO.	4000.93	MAP NO.			
			SHEET 9 OF 21		

NO.		DATE		REVISIONS/REMARKS		BY	LANDSCAPE ARCHITECT'S SEAL		SURVEY INFORMATION		BENCH MARK		AS BUILT INFORMATION	
									FIELD NOTES				CONTRACTOR	
						NO.			BY	DATE			WORK STAKED BY	
													INSPECTORS APPROVAL	
													DATE:	
													DATE:	
													FIELD VERIFICATION BY	
													DATE:	
													DRAWING CORRECTED BY	
													DATE:	
													MICRO-FILM INFORMATION	
													RECORDED BY	
													DATE:	
													NO.	

WATER MANAGEMENT GUIDE

PROGRAM NO.	VALVE NO.	VALVE SYMBOL	VALVE MANUF. AND MODEL NO.	VALVE SIZE	GPM / VALVE	HEAD MANUF. AND MODEL NO. (RB = RAINBIRD)	HEAD QTY. / VALVE	HEAD INLET SIZE	DEGREE OF ARC	RADIUS	GPM	PSI	PER HOUR	HEAD SYMBOL
10	C1		RB 200-PES-B	2"	44	TORO S700C-PC-4.5-LA	11	3/4"	180	42'	4.23	50	.77	
10	C2		RB 200-PES-B	2"	53	TORO S700C-PC-4.5-LA	14	3/4"	180	42'	4.23	50	.77	
10	C3		RB 200-PES-B	2"	45	TORO 642-02-42	4	1"	360	42'	4.23	50	.96	
10	C4		RB 100-PES-B	1"	9	TORO S700C-FC-4.5-LA	2	3/4"	180	55'	12.9	50	.38	
1	C5		RB 200-PES-B	2"	45	TORO 642-02-42	4	1"	360	42'	4.23	50	.96	
4	C6		RB 150-PES-B	1 1/2"	39	TORO 644-02-42	3	1"	360	55'	12.9	50	.48	
4	C7		RB 150-PES-B	1 1/2"	39	TORO 644-02-42	3	1"	360	55'	12.9	50	.48	
4	C8		RB 150-PES-B	1 1/2"	39	TORO 644-02-42	3	1"	360	55'	12.9	50	.48	
15	C9		RB 200-PES-B	2"	63	RB 1804-12F-PRS-VC	25	1/2"	360	12'	2.6	30	2.0	
1	C10		RB 200-PES-B	2"	65	TORO 642-02-42	5	1"	360	55'	12.9	50	.96	
2	C11		RB 200-PES-B	2"	52	TORO 642-02-42	4	1"	360	55'	12.9	50	.96	
5	C12		RB 150-PES-B	1 1/2"	39	TORO 644-02-42	3	1"	360	55'	12.9	50	.48	
5	C13		RB 150-PES-B	1 1/2"	39	TORO 644-02-42	3	1"	360	55'	12.9	50	.48	
5	C14		RB 150-PES-B	1 1/2"	39	TORO 644-02-42	3	1"	360	55'	12.9	50	.48	
15	C15		RB 150-PES-B	1 1/2"	39	RB 1804-12H-PRS-VC	41	1/2"	180	12'	1.3	30	2.0	
6	C16		RB 150-PES-B	1 1/2"	39	TORO 644-02-42	3	1"	360	55'	12.9	50	.48	
2	C17		RB 200-PES-B	2"	45	TORO 642-02-42	4	1"	360	55'	12.9	50	.96	
2	C18		RB 200-PES-B	2"	52	TORO 642-02-42	5	1"	360	55'	12.9	50	.96	
3	C19		RB 200-PES-B	2"	41	TORO 640-02-40	4	1"	108	53'	10.2	50	.96	
15	C20		RB 100-PES-B	1"	4	RB 1804-15G-PRS-VC	4	1/2"	90	15'	.93	30	1.83	
11	C21		RB 100-PES-B	1"	6	TORO S700C-PC-VC	2	3/4"	90	35'	2.11	50	.77	
16	C22		RB 100-PES-B	1"	12	RB 1804-15H-PRS-VC	9	1/2"	180	15'	1.85	30	1.83	
11	C23		RB 200-PES-B	2"	41	TORO S700C-PC-4.5-LA	10	3/4"	180	42'	4.23	50	.77	
12	C24		RB 200-PES-B	2"	48	TORO S700C-FC-4.5-LA	11	3/4"	360	43'	4.23	50	.38	
12	C25		RB 150-PES-B	1 1/2"	38	TORO S700C-PC-4.5-LA	11	3/4"	180	42'	4.23	50	.77	
12	C26		RB 200-PES-B	2"	48	TORO S700C-PC-4.5-LA	11	3/4"	360	43'	4.23	50	.38	
16	C27		RB 100-PES-B	1"	4	RB 1804-15G-PRS-VC	4	1/2"	90	15'	.93	30	1.83	
3	C28		RB 200-PES-B	2"	4	TORO 640-02-40	4	1"	108	53'	10.2	50	.96	
17	C29		RB 200-PES-B	2"	43	RB 1402	78	1/2"	NA	NA	.55	40	NA	
17	C30		RB 100-PES-B	1"	10	RB 1402	18	1/2"	NA	NA	.55	40	NA	
12	C31		RB 150-PES-B	1 1/2"	39	TORO S700C-FC-4.5 LA	9	3/4"	360	43'	4.23	50	.38	
13	C32		RB 150-PES-B	1 1/2"	35	TORO S700C-PC-4.5 LA	9	3/4"	180	42'	4.23	50	.77	
13	C33		RB 150-PES-B	1 1/2"	35	TORO S700C-PC-4.5 LA	8	3/4"	360	43'	4.23	50	.38	
14	C34		RB 150-PES-B	1 1/2"	38	TORO S700C-PC-4.5 LA	9	3/4"	180	42'	4.23	50	.77	
14	C35		RB 200-PES-B	2"	47	TORO S700C-PC-4.5 LA	15	3/4"	360	43'	4.23	50	.77	
3	C36		RB 200-PES-B	2"	52	TORO 640-02-42	4	1"	192	55'	12.9	50	.96	
8	C37		RB 150-PES-B	1 1/2"	39	TORO 642-02-42	4	1"	180	55'	12.9	50	.96	
6	C38		RB 150-PES-B	1 1/2"	39	TORO 642-02-42	3	1"	360	55'	12.9	50	.48	
6	C39		RB 150-PES-B	1 1/2"	39	TORO 644-02-42	3	1"	360	55'	12.9	50	.48	
6	C40		RB 150-PES-B	1 1/2"	38	TORO 644-02-42	3	1"	360	55'	12.9	50	.48	
7	C41		RB 200-PES-B	2"	52	TORO 642-02-42	4	1"	360	55'	12.9	50	.96	
8	C42		RB 150-PES-B	1 1/2"	39	TORO 642-02-42	4	1"	180	55'	12.9	50	.96	
9	C43		RB 200-PES-B	2"	52	TORO 642-02-42	4	1"	180	55'	12.9	50	.96	
9	C44		RB 200-PES-B	2"	52	TORO 642-02-42	4	1"	180	55'	12.9	50	.96	

IRRIGATION LEGEND

SPRINKLER HEAD ASSEMBLY, TORO 640 SERIES					SEE DETAIL 2709
MODEL NO.	ARC	RADIUS	GPM	PSI	
641-02-40	90 DEG	50'	6.7	50	
640-02-40	108 DEG	53'	10.2	50	
642-02-42	180 DEG	55'	12.9	50	
640-02-42	192 DEG	55'	12.9	50	
643-02-42	270 DEG	55'	12.9	50	
644-02-42	360 DEG	55'	12.9	50	
SPRINKLER HEAD ASSEMBLY, TORO SUPER 700 C SERIES, 3" POP-UPS					SEE DETAIL 2709
MODEL NO.	RADIUS	GPM	PSI		
S700-PC-2.0-LA	35'	2.11	50		
S700-PC-4.5-LA	42'	4.23	50		
S700-PC-4.5-LA	43'	4.23	50		
SPRINKLER HEAD ASSEMBLY, RAINBIRD 1804-PRS-VC-SERIES, 4" POP-UPS					SEE DETAIL 2709
MODEL NO.	RADIUS	GPM	PSI		
15Q	15'	0.93	30		
15H	15'	1.85	30		
12Q	12'	0.65	30		
12H	12'	1.30	30		
12F	12'	2.60	30		
BUBBLER HEAD ASSEMBLY, (3 PER SYMBOL) RAINBIRD 1402, PRESSURE COMPENSATING BUBBLER					
△ .55 GPM @ 40 PSI					SEE DETAIL 2710-A
— SOLVENT WELD CAP, LINE SIZE					2710-B
□ AUTOMATIC CONTROLLER, MOTOROLA MIR-5000 - I (MSI-3T-OKR) WITH 48 STATIONS, RADIO CONTROLLED RECEIVER/TRANSMITTER AND ANTENNA IN STRONG BOX NO. S8-24-DDS CABINET					SEE DETAIL
⬢ AUTOMATIC VALVE ASSEMBLY, RAINBIRD PES-B-SERIES, UNLESS NOTED OTHERWISE ON WATER MANAGEMENT GUIDE					SEE DETAIL 2703
--- EXISTING PIPING TO REMAIN					
--- LATERAL PIPING, SCH. 40 PVC, SIZE AS SHOWN ON PLAN, SIZES NOT INDICATED ON PLAN SHALL BE .75"					
--- SUBMAIN PIPING TO QUICK-COUPERS, SCH. 40 PVC, SIZE AS SHOWN ON PLAN					
— IRRIGATION MAIN LINE, CLASS 200, SDR-21, O-RING GASKET END PVC, SIZE AS SHOWN ON PLAN					
===== SCH. 40 PVC SLEEVING, PIPE SLEEVES 2 SIZES LARGER THAN PIPE TO BE ENCLOSED; WIRE SLEEVES 2"					
⊙ AIR RELEASE VALVE ASSEMBLY, CRISPIN A-20 SIZE 2"					SEE DETAIL 2705
⊗ ISOLATION VALVE ASSEMBLY, PEGLER 708-A, O-RING, IRON BODY GATE VALVE WITH 2" OPERATING NUT, SIZE AS SHOWN ON PLAN					SEE DETAIL 2707
■ QUICK COUPLING VALVE ASSEMBLY, RAINBIRD 33DRC, SIZE .75"					SEE DETAIL 2708

NOTES:

- PER WRITTEN SPECIFICATIONS THE CONTRACTOR SHALL FLAG PROPOSED TREE AND SHRUB LOCATIONS. THE CONTRACTOR SHALL ALSO FLAG PROPOSED BUBBLER LOCATIONS. ALL PROPOSED PIPING ROUTES SHALL BE PAINTED ONTO THE GROUND SURFACE. ALL FLAGGED LOCATIONS AND PAINTED PIPING ROUTES SHALL BE PAINTED ONTO THE GROUND SURFACE. ALL FLAGGED LOCATIONS AND PAINTED PIPING ROUTES SHALL BE INSPECTED AND APPROVED BY THE OWNER PRIOR TO EXCAVATION. THE CONTRACTOR SHALL PROVIDE ALL MATERIALS, LABOR, EQUIPMENT, ETC., AS NEEDED TO MEET OWNERS APPROVAL AT NO ADDITIONAL COST TO THE OWNER.
- THE CONTRACTOR SHALL INSTALL ALL PROPOSED SLEEVE PIPING PRIOR TO PAVING OPERATIONS
- THE CONTRACTOR SHALL COORDINATE ALL SUBCONTRACTORS SO AS TO PREVENT DAMAGE TO INSTALLED IMPROVEMENTS AS CONSTRUCTION PROGRESSES. ADDITIONAL COSTS THAT MAY ARISE AS A RESULT OF THE CONTRACTORS LACK OF COORDINATION SHALL BE BORNE BY THE CONTRACTOR
- ALL 24-VOLT WIRE SHALL BE NO.12 AWG
- ALL EXPANSION LOOPS AT 24-VOLT VALVE LOCATIONS SHALL EXTEND 36" ABOVE FINISH GRADE
- ALL PIPING AND IRRIGATION ASSEMBLIES SURROUNDING SOCCER FIELD MOW STRIPS SHALL BE INSTALLED AS SHOWN ON DETAIL.
- ALL IRRIGATION EQUIPMENT DOWN-STREAM OF SOLVENT WELD CAPS SHALL BE INSTALLED BY THE CONTRACTOR SEE NOTE F FOR EXCEPTION.
- THE WATER MANAGEMENT GUIDE SHALL NOT BE USED NOR IS IT INTENDED FOR USE IN ESTABLISHING EQUIPMENT QUANTITIES.
- DURING CONSTRUCTION THE CONTRACTOR SHALL PROTECT EXISTING IRRIGATION EQUIPMENT FROM DAMAGE DURING CONSTRUCTION. REPAIRS TO DAMAGED EQUIPMENT SHALL BE MADE AT THE CONTRACTORS EXPENSE AND TO THE SATISFACTION OF THE OWNER.
- THE CONTRACTOR SHALL COORDINATE INSTALLATION OF ALL PROPOSED IRRIGATION WITH PROPOSED AND EXISTING UTILITIES AND IMPROVEMENTS SUCH AS BUT NOT LIMITED TO DEPTH OF BURY, ROUTES, LOCATIONS, GRADES, ETC.
- THE CONTRACTOR SHALL COORDINATE WITH PARKS MANAGEMENT PRIOR TO CONNECTING TO OWNER'S PIPING, PULL BOXES, ELECTRICAL SLEEVES, ETC.
- ALL PROPOSED OR EXISTING STRUCTURES SUCH AS BUT NOT LIMITED TO PUMPS, FILTER, VALVES, ELECTRICAL EQUIPMENT, ETC. WHICH ARE SHOWN ON PLANS ARE SCHEMATIC, ACTUAL QUANTITIES AND LOCATIONS WILL VARY. THE CONTRACTOR SHALL LOCATE ANY SUCH UTILITY STRUCTURE PRIOR AND DURING CONSTRUCTION TO PREVENT DAMAGE TO SAME.
- THE CONTRACTOR SHALL SEQUENTIALLY WIRE VALVES TO CONTROLLERS. (STATION C-1 TO STATION ONE C-2 TO STATION TWO, ETC.) THE CONTRACTOR SHALL LABEL ALL WIRES AT VALVE, PULL BOX AND CONTROLLER LOCATIONS WITH 3M STD-09 WIRE MARKER TAPE. LABELS SHALL IDENTIFY VALVE NUMBER, PULL BOX LETTER AND CONTROLLER LETTER.
- THE EXISTING BOOSTER PUMP STATION IS SET AT 300 GPM AT A 20 PSI BOOST. THIS NEW DESIGN AND PHASE REQUIRES THE PUMP STATION BE UPGRADED TO 450 GPM AT 25 PSI BOOST WITH THE CONTROL PACKAGE FOR A DEMAND FLOW SYSTEM. THIS WILL REQUIRE AN AUTOMATIC CONTROL PANEL AND CONTROL VALVE SIZED AS REQUIRED ON THE DISCHARGE PIPE OF THE SYSTEM AND A 3" BY-PASS VALVE WITH THE RETURN PIPING MANIFOLD TO THE 6" MAIN LINE. ALL THE ABOVE GROUND PIPING SHALL BE METAL PIPING. ALL PIPING, ELECTRICAL AND POWER SHALL BE AS PER LOCAL CODE.
- ALL MAIN LINE FITTINGS SHALL BE DUCTILE IRON RUBBER RING TYPE WITH THREADED TAPS AS PER PLANS.
- CONTRACTOR SHALL INSTALL NO SPRINKLER HEADS AS A PART OF PHASE II WORK. CONTRACTOR IS TO INSTALL SPRINKLER HEADS AND POSITION EACH SPRINKLER RISER SO THAT CAP IS 6" TO 10" BELOW FINISH GRADE PRIOR TO FINAL CAP ACCEPTANCE. CONTRACTOR SHALL INSTALL IRRIGATION BUBBLER HEADS TO TREES PROPOSED FOR INSTALLATION AS A PART OF PHASE II.


1 2 3 4 5 6 7 8 9 10 11 12 13 14 15
26-4000-95 0997

Coates Irrigation Consultants Inc.

4300 NORTH MILLER ROAD. 104 SCOTTSDALE ARIZONA 85251 UNITED STATES (602) 481-0682 FAX: (602) 481-0939

Campbell Okuma Perkins Associates, Inc. Landscape Architecture and Site Planning 418 Central S.E. Albuquerque, NM 87102 (505) 242-9928 1339 Pacheco No. 8 Santa Fe, NM 87501 (505) 962-8399

CITY OF ALBUQUERQUE PARKS AND GENERAL SERVICES DEPARTMENT DESIGN AND DEVELOPMENT DIVISION					
TITLE: MARIPOSA BASIN PHASE II- IMPROVEMENTS ATHLETIC FIELDS WATER MANAGEMENT GUIDE/ NOTES AND LEGENDS					
APPROVALS	ENGINEER	DATE	APPROVALS	ENGINEER	DATE
DRC CHAIRMAN	<i>[Signature]</i>	10/21/94	WATER	<i>[Signature]</i>	10/21/94
TRANSPORTATION	<i>[Signature]</i>	10/21/94	WASTE WATER	"	"
HYDROLOGY	<i>[Signature]</i>	10/21/94			
PARKS/GEN. SVC.	<i>[Signature]</i>	10/21/94			
PROJECT NO. 4000.93	MAP NO.	SHEET 12 OF 10	DATE: 9/94 DATE: 9/94 DATE: 9/94		

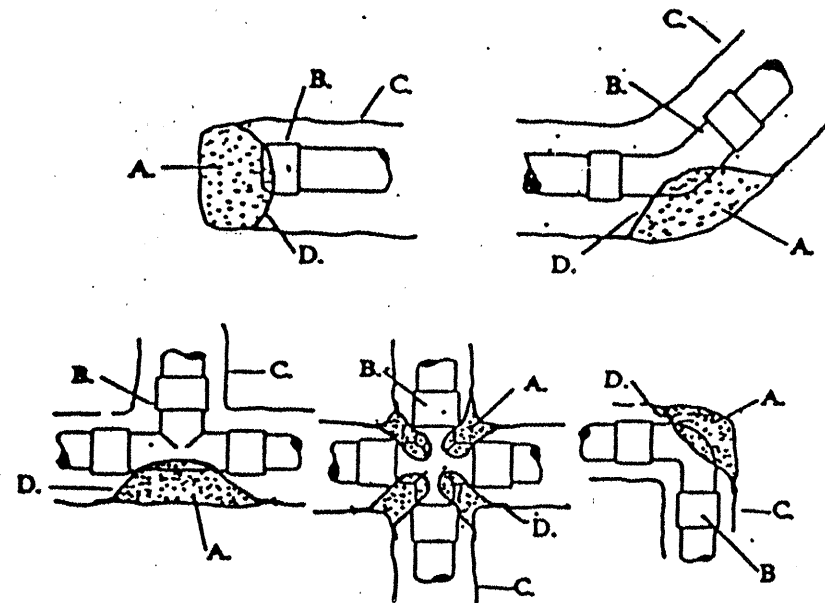


GENERAL NOTES

1. PVC FITTINGS SHALL BE PROTECTED FROM CONCRETE BY PLACING 10 MIL. PLASTIC SHEETING BETWEEN CONCRETE AND FITTING.

CONSTRUCTION NOTES

- A. CONCRETE THRUST BLOCK PLACED AGAINST SOLID UNDISTURBED SOIL. (SEE SECTION 101).
- B. PVC FITTING.
- C. PIPE TRENCH.
- D. 10 MIL. PLASTIC SHEETING.

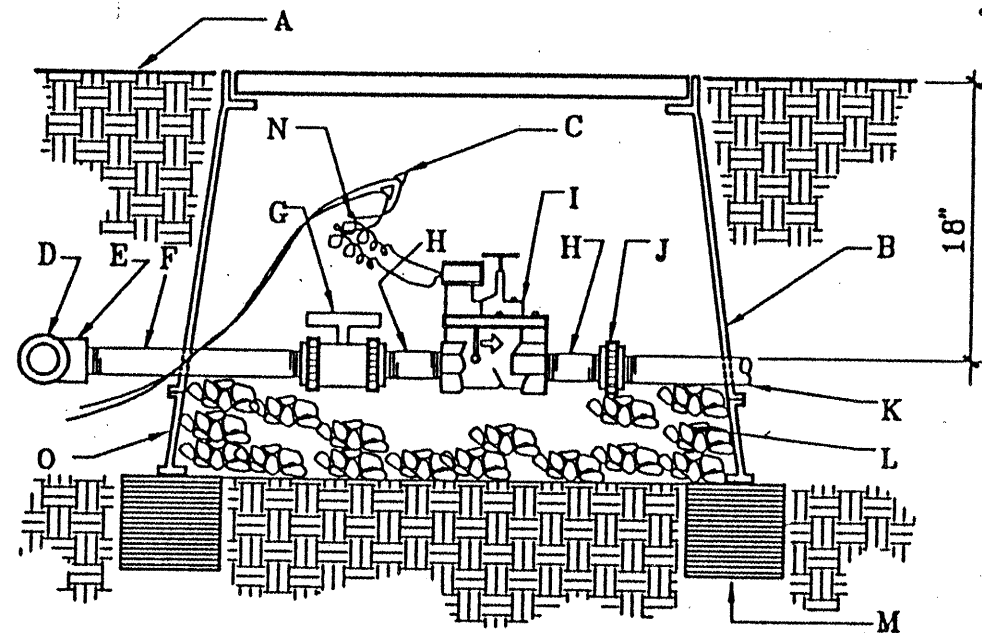


GENERAL NOTES:

1. INSTALL AN 8"X8"X16" SOLID CMU BLOCK AT EACH END OF THE VALVE BOX.
2. WASH ROCK SHALL BE INSTALLED FLUSH WITH BOTTOM OF PIPE AND VALVE.

CONSTRUCTION NOTES:

- A. FINISH GRADE.
- B. BROOKS PRODUCTS INC., 1730 PB-18 BODY (ABS) VALVE BOX WITH 1730 BOLT DOWN COVER (ABS) AND ONE 8" EXTENSION.
- C. 3M SCOTCHLOK CONNECTORS.
- D. IRRIGATION MAINLINE.
- E. IRRIGATION MAINLINE SERVICE TEE OR ELL.
- F. SCHEDULE 80 PVC 12" NIPPLE.
- G. SPEARS TRUE UNION SCHEDULED 80 PVC BALL VALVE.
- H. SCHEDULE 80 PVC 4" NIPPLE.
- I. ELECTRIC VALVE. REFERENCE THE DRAWING FOR SIZE.
- J. SPEARS SCHEDULE 80 PVC UNION.
- K. LATERAL LINE.
- L. 1" DIAMETER WASHED ROCK.
- M. 8"X8"X16" SOLID CMU BLOCK.
- N. 24" WIRE EXPANSION COIL.

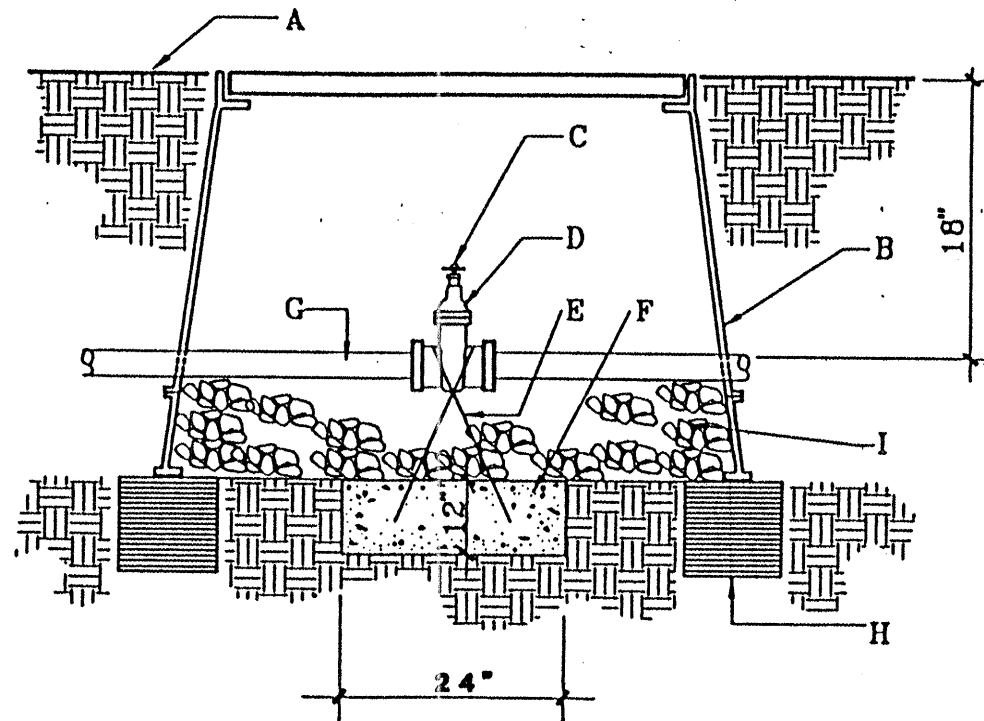


GENERAL NOTES:

1. INSTALL AN 8"X8"X16" CMU BLOCK AT EACH CORNER OF THE VALVE BOX.

CONSTRUCTION NOTES:

- A. FINISH GRADE.
- B. BROOKS PRODUCTS INC., 525 SERIES SCREW TYPE PLASTIC VALVE BOX WITH TOP, BOTTOM, AND COVER.
- C. 2" OPERATING NUT.
- D. PEGLER VALVE, 1/2-60 SIZE PER SCHEDULE.
- E. NO. 4 REBAR.
- F. THRUST BLOCK 4000 PSI CONCRETE PLACED AGAINST UNDISTURBED SOIL.
- G. IRRIGATION MAINLINE.
- H. 8"X8"X16" CMU BLOCK.
- I. 1" DIAMETER WASHED ROCK.

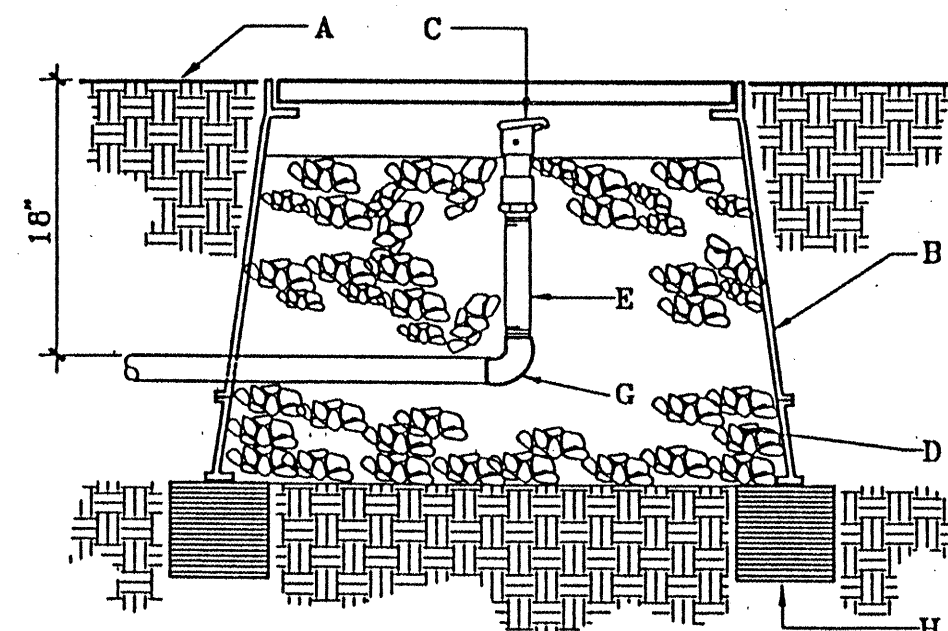


GENERAL NOTES:

1. INSTALL AN 8"X8"X16" SOLID CMU BLOCK AT EACH CORNER OF THE VALVE BOX.
2. INSTALL 1" DIAMETER WASHED ROCK BELOW THE VALVE BOX. EXTEND WASHED ROCK UP TO COLLAR OF QUICK COUPLER VALVE.
3. INSTALL A GATE VALVE IMMEDIATELY UPSTREAM OF QUICK COUPLER VALVE.

CONSTRUCTION NOTES:

- A. FINISH GRADE.
- B. BROOKS PRODUCTS INC., 525 SERIES SCREW TYPE PLASTIC VALVE BOX WITH TOP, BOTTOM, AND COVER. WHEN QUICK COUPLER VALVE IS INSTALLED IN PLAYING FIELD USE 4" PIPE WITH PLASTIC LID.
- C. RAINBIRD 33 DRC QUICK COUPLER VALVE.
- D. 1" DIAMETER WASHED ROCK.
- E. 12" SCH. 80 PVC RISER.
- F. IRRIGATION MAINLINE.
- G. SCHEDULE 40 PVC ELL SXT.
- H. 8"X8"X16" SOLID CMU BLOCK.

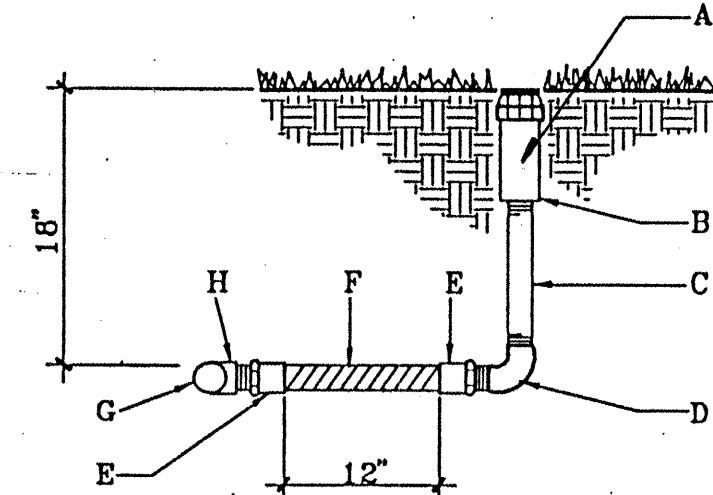

GENERAL NOTES:

1. THIS DETAIL SHALL BE USED FOR POP-UP SHRUB SPRAY, POP-UP LAWN SPRAY, GEAR DRIVEN AND ROTARY SPRINKLER HEADS.
2. LATERAL LINE PRESSURE TESTING SHALL BE COMPLETED PRIOR TO INSTALLATION OF FLEX PIPE ASSEMBLY. LATERAL LINE TESTING SHALL BE ACCOMPLISHED BY INSTALLING A PLUG IN THE OUTLET OF LATERAL LINE TEES AND ELLS.
3. TOP OF SPRINKLER HEAD SHALL BE SET FLUSH WITH FINISH GRADE.

CONSTRUCTION NOTES:

- A. FINISH GRADE.
- B. SPRINKLER HEAD (REFERENCE THE DRAWINGS FOR TYPE).
- C. SCH. 80 PVC NIPPLE. LENGTH VARIES DEPENDING UPON SIZE OF SPRINKLER HEAD.
- D. SCH. 40 PVC THREADED ELL.
- E. SCH. 40 PVC MIP ADAPTER.
- F. PVC FLEXIBLE VINYL PIPE STD. IPS FROM AGRICULTURAL PRODUCTS INC. (818-768-3303).
- G. LATERAL PIPE.
- H. SCH. 40 PVC SXSXT TEE OR SXT ELL.

NO HEADS TO BE INSTALLED AS A PART OF PHASE II WORK. INSTALL A GALVANIZED CAP AND POSITION CAP 2'-10" BELOW FINISH GRADE.


2704 THRUST BLOCKS I-5

2703 ELECTRICAL VALVE I-5

2702 MAINLINE ISOLATION VALVE I-5

2708 QUICK COUPLER VALVE I-5

2709 SPRINKLER HEAD WITH FLEX ASSEMBLY I-5

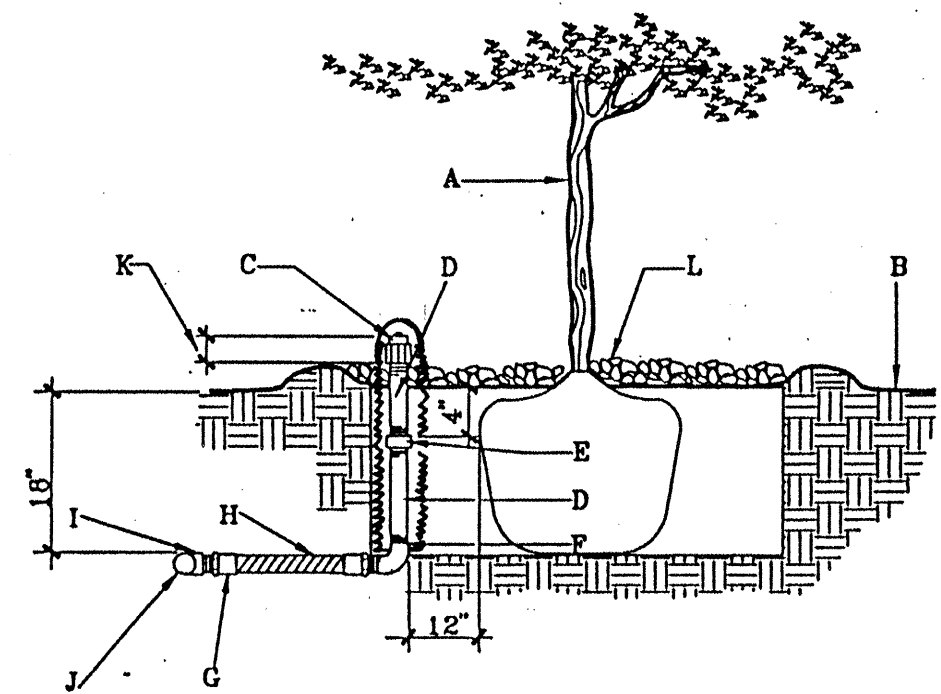


GENERAL NOTES:


1. PROVIDE 3 BUBBLERS PER TREE. INSTALL EACH BUBBLER IN 4" CORRUGATED, PERFORATED DRAIN TUBING. SEE DETAIL 2702-B THIS SHEET.
2. LATERAL LINE PRESSURE TESTING SHALL BE COMPLETED PRIOR TO INSTALLATION OF FLEX PIPE ASSEMBLY. LATERAL LINE TESTING SHALL BE ACCOMPLISHED BY INSTALLING A PLUG IN THE OUTLET OF LATERAL LINE TEES AND ELLS.
3. BUBBLERS ARE TO BE EQUALLY SPACED AROUND TREE TRUNK.

CONSTRUCTION NOTES:

- A. TREE.
- B. FINISH GRADE.
- C. BUBBLER HEAD (REFERENCE IRRIGATION LEGEND). TYPICAL, 1 OF 3.
- D. SCH. 80 PVC NIPPLE.
- E. SCH. 40 PVC THREADED COUPLER.
- F. SCH. 40 PVC THREADED ELL.
- G. SCH. 40 PVC MIP ADAPTER.
- H. PVC FLEXIBLE VINYL PIPE, STD., IPS FROM AGRICULTURAL PRODUCTS INC. (818-768-3303).
- I. SCH. 40 PVC SXSXT TEE OR SXT ELL.
- J. LATERAL PIPE.
- K. TOP OF BUBBLER LEVEL WITH TOP OF BARK MULCH OR MAX. 1" ABOVE MATERIAL AT FINISHED GRADE (SEE PLANTING PLAN).
- L. REFERENCE PLANTING PLAN. MATERIAL VARIES.

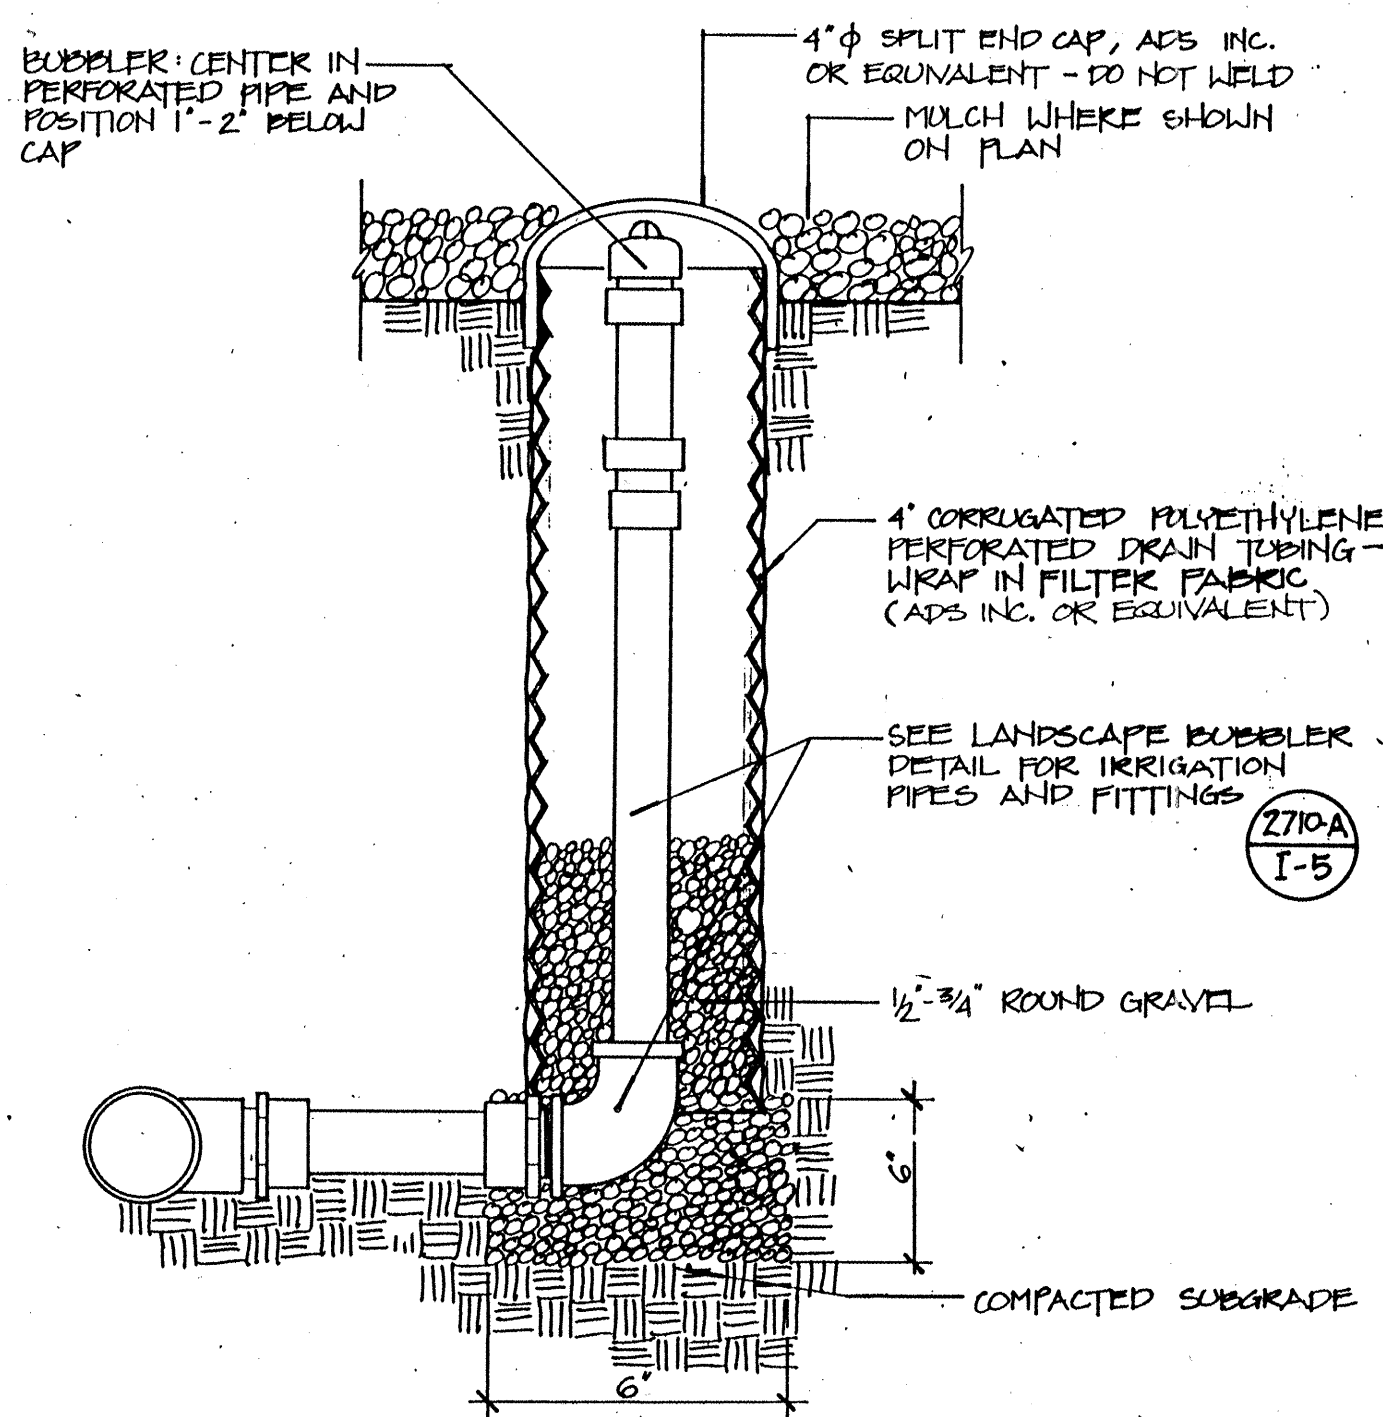

2710-B ENLARGEMENT - BUBBLER HEAD AT TREE I-5

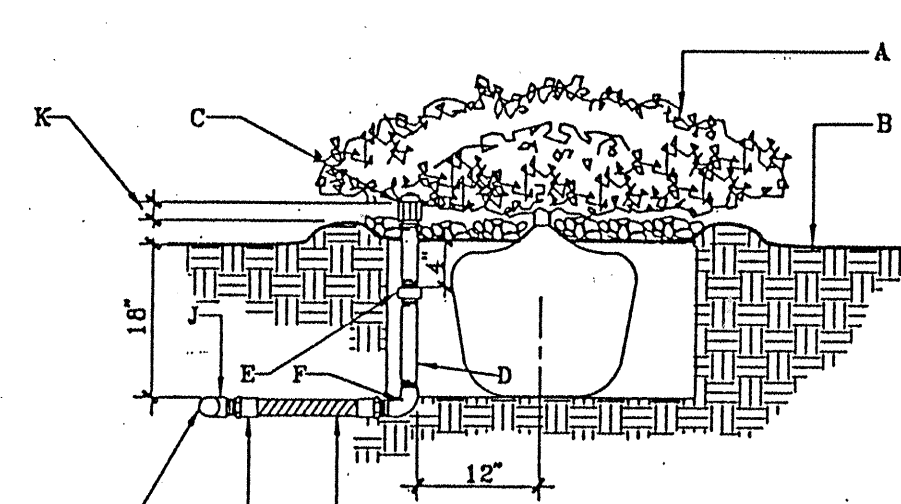

GENERAL NOTES:

1. LATERAL LINE PRESSURE TESTING SHALL BE COMPLETED PRIOR TO INSTALLATION OF FLEX PIPE ASSEMBLY. LATERAL LINE TESTING SHALL BE ACCOMPLISHED BY INSTALLING A PLUG IN THE OUTLET OF LATERAL LINE TEES AND ELLS.
2. EMITTER SHALL ALWAYS BE INSTALLED ON THE UPHILL SIDE OF THE SHRUB.


CONSTRUCTION NOTES:

- A. SHRUB.
- B. FINISH GRADE.
- C. DRIP EMITTER. (REFERENCE IRRIGATION LEGEND).
- D. SCH. 80 PVC NIPPLE.
- E. SCH. 40 PVC THREADED COUPLER.
- F. SCH. 40 PVC THREADED ELL.
- G. SCH. 40 PVC MIP ADAPTER.
- H. PVC FLEXIBLE VINYL PIPE STD. IPS FROM AGRICULTURAL PRODUCTS INC. (818-768-3303).
- I. LATERAL PIPE.
- J. SCH. 40 PVC SXSXT TEE OR SXT ELL.
- K. TOP OF EMITTER LEVEL WITH TOP OF BARK MULCH OR MAX. 1" ABOVE TOP OF MATERIAL AT FINISHED GRADE (SEE PLANTING PLAN).

2711 NOT A PART OF PHASE II WORK DRIp EMITTER AT SHRUB I-5

2710-A BUBBLER HEAD AT TREE I-5


1 2 3 4 5 6 7 8 9 10 11 12 13 14 15
26-14000.93 11097

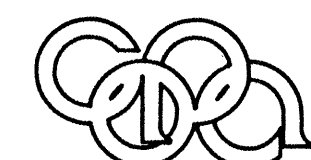


Campbell Okuma Perkins Associates, Inc.
Landscape Architecture and Site Planning
418 Central S.E.
Albuquerque, NM 87102
(505) 242-9928


1339 Pacheco No. 8
Santa Fe, NM 87501
(505) 962-8399

CITY OF ALBUQUERQUE PARKS AND GENERAL SERVICES DEPARTMENT DESIGN AND DEVELOPMENT DIVISION					
TITLE: MARIPOSA BASIN PHASE II IMPROVEMENTS IRRIGATION DETAILS					
APPROVALS	ENGINEER	DATE	APPROVALS	ENGINEER	DATE
DRC CHAIRMAN	10/21/94	10/21/94	WATER	10/21/94	
TRANSPORTATION	10/21/94	10/21/94	WASTE WATER		
HYDROLOGY	10/21/94	10/21/94			
PARKS/GEN. SVC.	10/21/94	10/21/94			
PROJECT NO. 4000.93			MAP NO.	SHEET 15 OF 21	

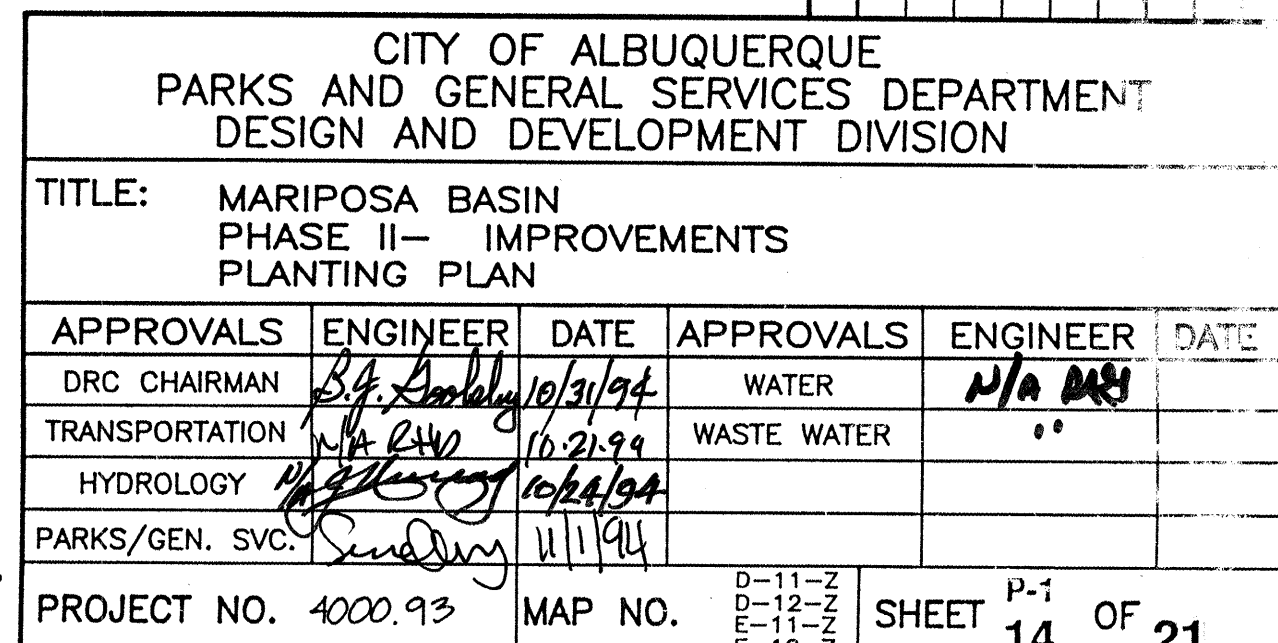

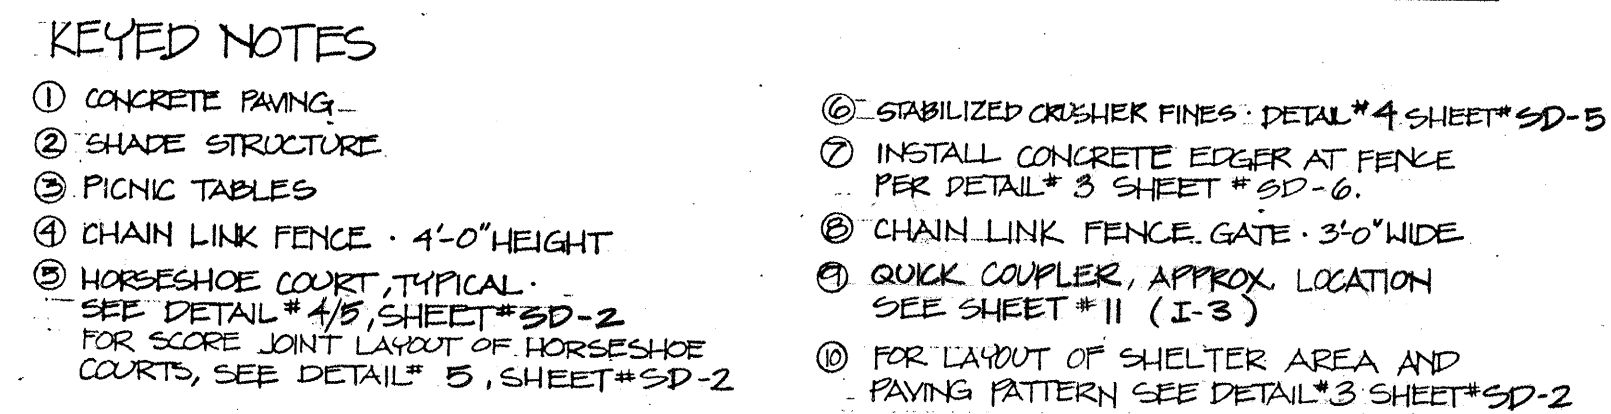


SCALE: 1" = 20'-0"

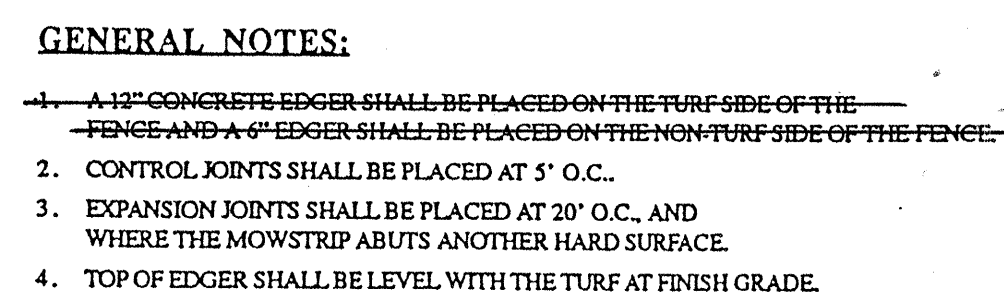

CONSTRUCTION NOTES:


- A. FINISH GRADE.
- B. TOOLED EDGE.
- C. #3 REBAR, HORIZONTAL AND CONTINUOUS.
- D. MATERIAL VARIES. (REFERENCE THE DRAWINGS).
- E. 4000 PSI CONCRETE EDGER WITH BRUSH FINISH. (SEE SECTION 101).
- F. 6" SUBGRADE COMPACTION. (SEE SECTION 301).
- G.
- H. CONTROL JOINT.
- I. POST

NTS

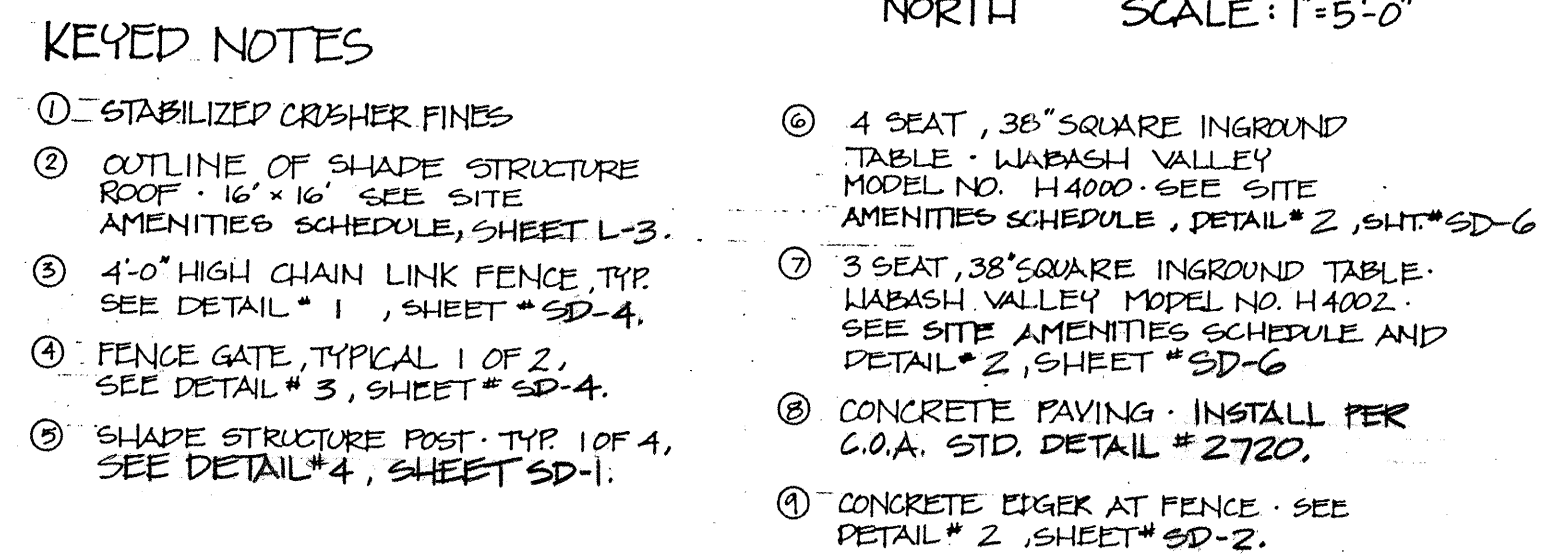


PLAN



SCALE: 1" = 5'-0"

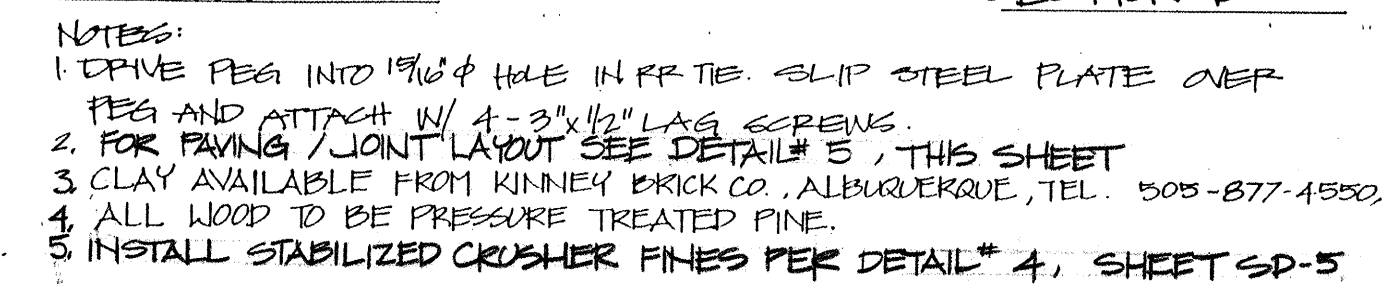

PLAN AND SECTIONS
NTS

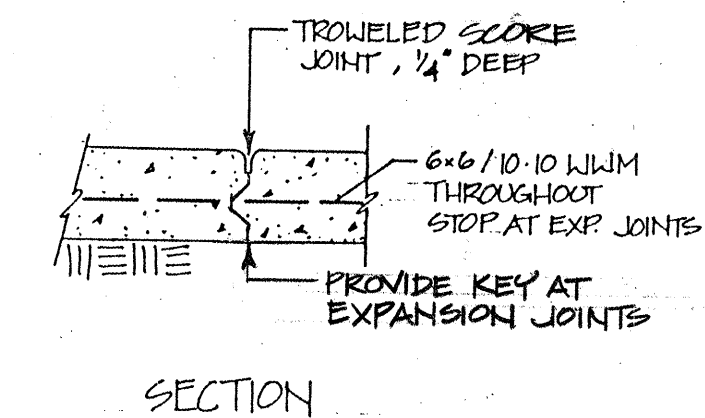

PLAN
NTS

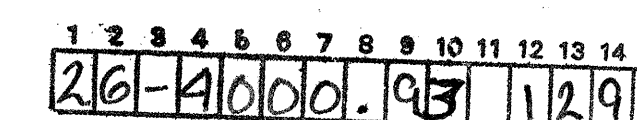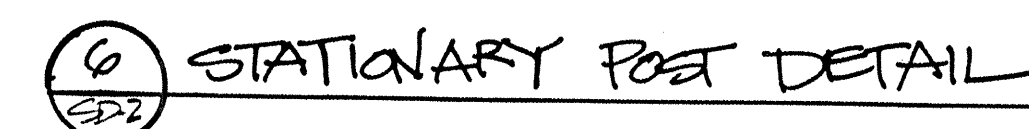

Campbell Okuma Perkins Associates, Inc.
Landscape Architecture and Site Planning
418 Central S.E. 1339 Pacheco No. 8
Albuquerque, NM 87102 Santa Fe, NM 87501
(505) 242-9928 (505) 962-8399

CITY OF ALBUQUERQUE					
PARKS AND GENERAL SERVICES DEPARTMENT					
DESIGN AND DEVELOPMENT DIVISION					
TITLE: MARIPOSA BASIN PHASE II IMPROVEMENTS SITE DETAILS					
APPROVALS	ENGINEER	DATE	APPROVALS	ENGINEER	DATE
DRC CHAIRMAN	<i>B. J. Bradley</i>	10/21/94	WATER	<i>NLA EAL</i>	
TRANSPORTATION	<i>NLA CVO</i>	10/21/94	WASTE WATER		
HYDROLOGY	<i>NLA JCH</i>	10/21/94			
PARKS/GEN. SVC.	<i>Smiley</i>	11/1/94			
PROJECT NO. 4000.93			MAP NO.		SD-2 D-11Z D-12Z E-11Z E-12Z SHEET 16 OF 21

CHAIN LINK FENCE
SD-4 NTS

- # CHAIN LINK FENCE
- 1 TENSION BAND 15" O.C. MAXIMUM
 - 2 3/16" X 5/8" X 40" STRETCH BAR
 - 3 CORNER/END POST SCH. 40
 - 4 CONCRETE FOOTING
 - 5 1 5/8" O.D. TOP RAIL
 - 6 COMPRESSION BRACE
 - 7 9 GAUGE X 2" MESH FABRIC, TOP AND SELVAGES KNUCKLED UNDER AND WRAPPED FOR SAFETY
 - 8 TRUSS ROD WITH TURNBUCKLE
 - 9 7 GAUGE BOTTOM TENSION WIRE WITH HOG RINGS
 - 10 CONCRETE MOWSTRIP, EXPANSION JOINTS @ 20'-0" O.C.
SEE PLAN SET FOR TYPICAL. ALL FENCES EXCEPT WHERE DESIGNATED OTHERWISE.
 - 11 COMPACTED SUBGRADE

- NOTES:**
1. FOOTING DEPTH TO INCLUDE MOWSTRIP
 2. FENCE TO INCLUDE BOTTOM RAIL IN DUGOUT AREAS. SEE DETAIL THIS SHEET

3 CHAIN LINK FENCE - GATE
SD-4 NTS

- CHAIN LINK FENCE - GATE**
- ① CHAIN LINK GATE SIZE VARIES, SEE PLAN. SEE SPECIFICATIONS FOR ACCEPTABLE HARDWARE. WELD FRAME.
- ② DIAGONAL CROSS BRACING TRUSS RODS
- ③ END POST
- ④ CONCRETE MOWSTRIP, EXPANSION JOINTS @ 20'-0" O.C. SEE DETAIL 3 ON SHEET 50-6.
- ⑤ COMPACTED SUBGRADE
- ⑥ CONCRETE FOOTING

FOOTING LEGEND		
GATE LEAF WIDTH	POST SIZE	FOOTING SIZE
UP TO 4'	2.875" O.D.	24" X 12"
UP TO 6'	2.875" O.D.	24" X 12"
UP TO 8'	4.0" O.D.	36" X 16"

6 FOUL POLE.
SD-4 NTS

- FOUL POLE**
- ① GALVANIZED CAP
 - ② 4.0" O.D. GALVANIZED POST.
 - ③ CHAIN LINK FENCE
 - ④ CONCRETE MOWSTRIP, EXPANSION JOINTS @ 20'-0" O.C.
 - ⑤ CONCRETE FOOTING, FOR 4.0" O.D. POST AND 15'-0" FOUL POLE, FOOTING SIZE TO BE 5'-0" X 1'-6".

GENERAL NOTES

PAINTING. PREPARE POST FOR PAINTING WITH A VINEGAR WASH AND A GALVANIZED PRIMER COAT. FOUL POLE SHALL RECEIVE 2 COATS OF EXTERIOR QUALITY ENAMEL. COLOR: ORANGE

FOR FENCE HEIGHT SEE PLANS.

2 CHAIN LINK FENCE - BACKSTOP
SD-4 NTS

- ## CHAIN LINK FENCE - BACKSTOP
- ### KEYED NOTES
- | | |
|---|---|
| ① | 1.66" O.D. GALVANIZED PIPE, SCH. 40 |
| ② | 9 GAUGE X 2" MESH GALVANIZED FABRIC |
| ③ | 4" STANDARD GALVANIZED POST |
| ④ | CONCRETE FOOTING - FOR 4.0" O.D. POST,
AND 20" HIGH BACKSTOP, FOOTING SIZE TO BE
6'-0" X 1'-8". |
| ⑤ | CONCRETE MOWSTRIP, EXPANSION JOINTS @ 20'-0" O.C. |
| ⑥ | 8'-0" HIGH CHAIN LINK FENCE |

GENERAL NOTES
ALL RAILS TO BE WELDED
ALL WELDS TO BE PRIMED AND PAINTED WITH AIR DRY ALUMINUM
SEE FENCING SPECIFICATIONS FOR HARDWARE REQUIREMENTS

- ① MEMENTHIN METAL SPIKE THROUGH WOOD & CONCRETE
- ② 8-36 DA. KID ANKOR BOLT, TYP.
- ③ TREATED WOOD BLOCKS, DOWEL & SPIKE TOGETHER.
- ④ HIDE PLATE, POLCO. SEE SPACS AND SHEET ATTACHMENT LIST, SHEET #11
- ⑤ CONCRETE FOOTING
- ⑥ COMPACTED SUBGRADE.

4 HOME PLATE
SD-4

5 PLAYERS BENCH
SD-4

- 10'-0" LONG STRAIGHT LEG PLAYER'S BENCH
- SUPPORT POST CONCRETE FOOTING

- PLAYER'S BENCH
- SUPPORT POST
- CRUSHER FINES
SEE PLAN
- CONCRETE FOOTING
- COMPACTED
SUBGRADE

NOTE: SEE SHEET L-3 -
SITE AMENITIES SCHEDULE
FOR MANUFACTURER


- NOTES:
- BLEACHERS AS MANUFACTURED BY NANCAL RECREATION SYSTEMS INC.,
5021 INVESTMENT DRIVE, P.O. BOX 11407, IRVING, TEXAS, TX 75014-07,
MODEL # H-01066. LOCAL REPRESENTATIVE: LEISURE DESIGN SYSTEMS, INC.,
CONTACT: GENE EVERTS, (505) 212-3391.

8 BLEACHERS-PLAN AND ANCHOR DETAIL
SD-4

- ① PITCHING RUBBER, BOLCO, SEE'S SPECS AND SITE AMENITIES LIST, SHEET # L1.
- ② 3-3/8" DIA. x 6" ANCHOR BOLTS, FREEBES IN WOOD BLOCK W/ TOP OF BOLT FILLED W/ TOP OF WOOD.
- ③ TREATED WOOD BLOCK - 3 1/2" x 7 1/2" x 24"
- ④ CONCRETE FOOTING
- ⑤ COMPACTED SUBGRADE


7
SD-4

PITCHER'S PLATE

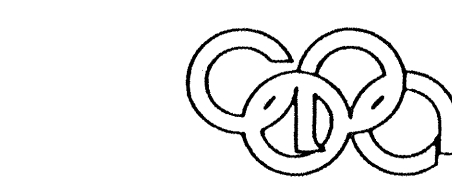

Campbell Okuma Perkins Associates, Inc.
Landscape Architecture and Site Planning
418 Central S.E. 1339 Pacheco No. 8
Albuquerque, NM 87102 Santa Fe, NM 87501
(505) 242-9928 (505) 962-8399

CITY OF ALBUQUERQUE				
PARKS AND GENERAL SERVICES DEPARTMENT				
DESIGN AND DEVELOPMENT DIVISION				
TITLE: MARIPOSA BASIN PHASE II-A IMPROVEMENTS SITE DETAILS				
APPROVALS	ENGINEER	DATE	APPROVALS	ENGINEER
DRC CHAIRMAN	<i>B.G. Sordley</i>	<i>10/21/94</i>	WATER	<i>W/A RJA</i>
TRANSPORTATION	<i>N/A RJA</i>	<i>10-21-99</i>	WASTE WATER	
HYDROLOGY	<i>W. Sordley</i>	<i>10/26/94</i>		
PARKS/GEN. SVCS.	<i>See Only</i>	<i>4/1/1994</i>		
PROJECT NO. 4000.93		MAP NO.	0-11-Z 0-12-Z 0-11-Z 0-12-Z	SD-4 18 OF 2

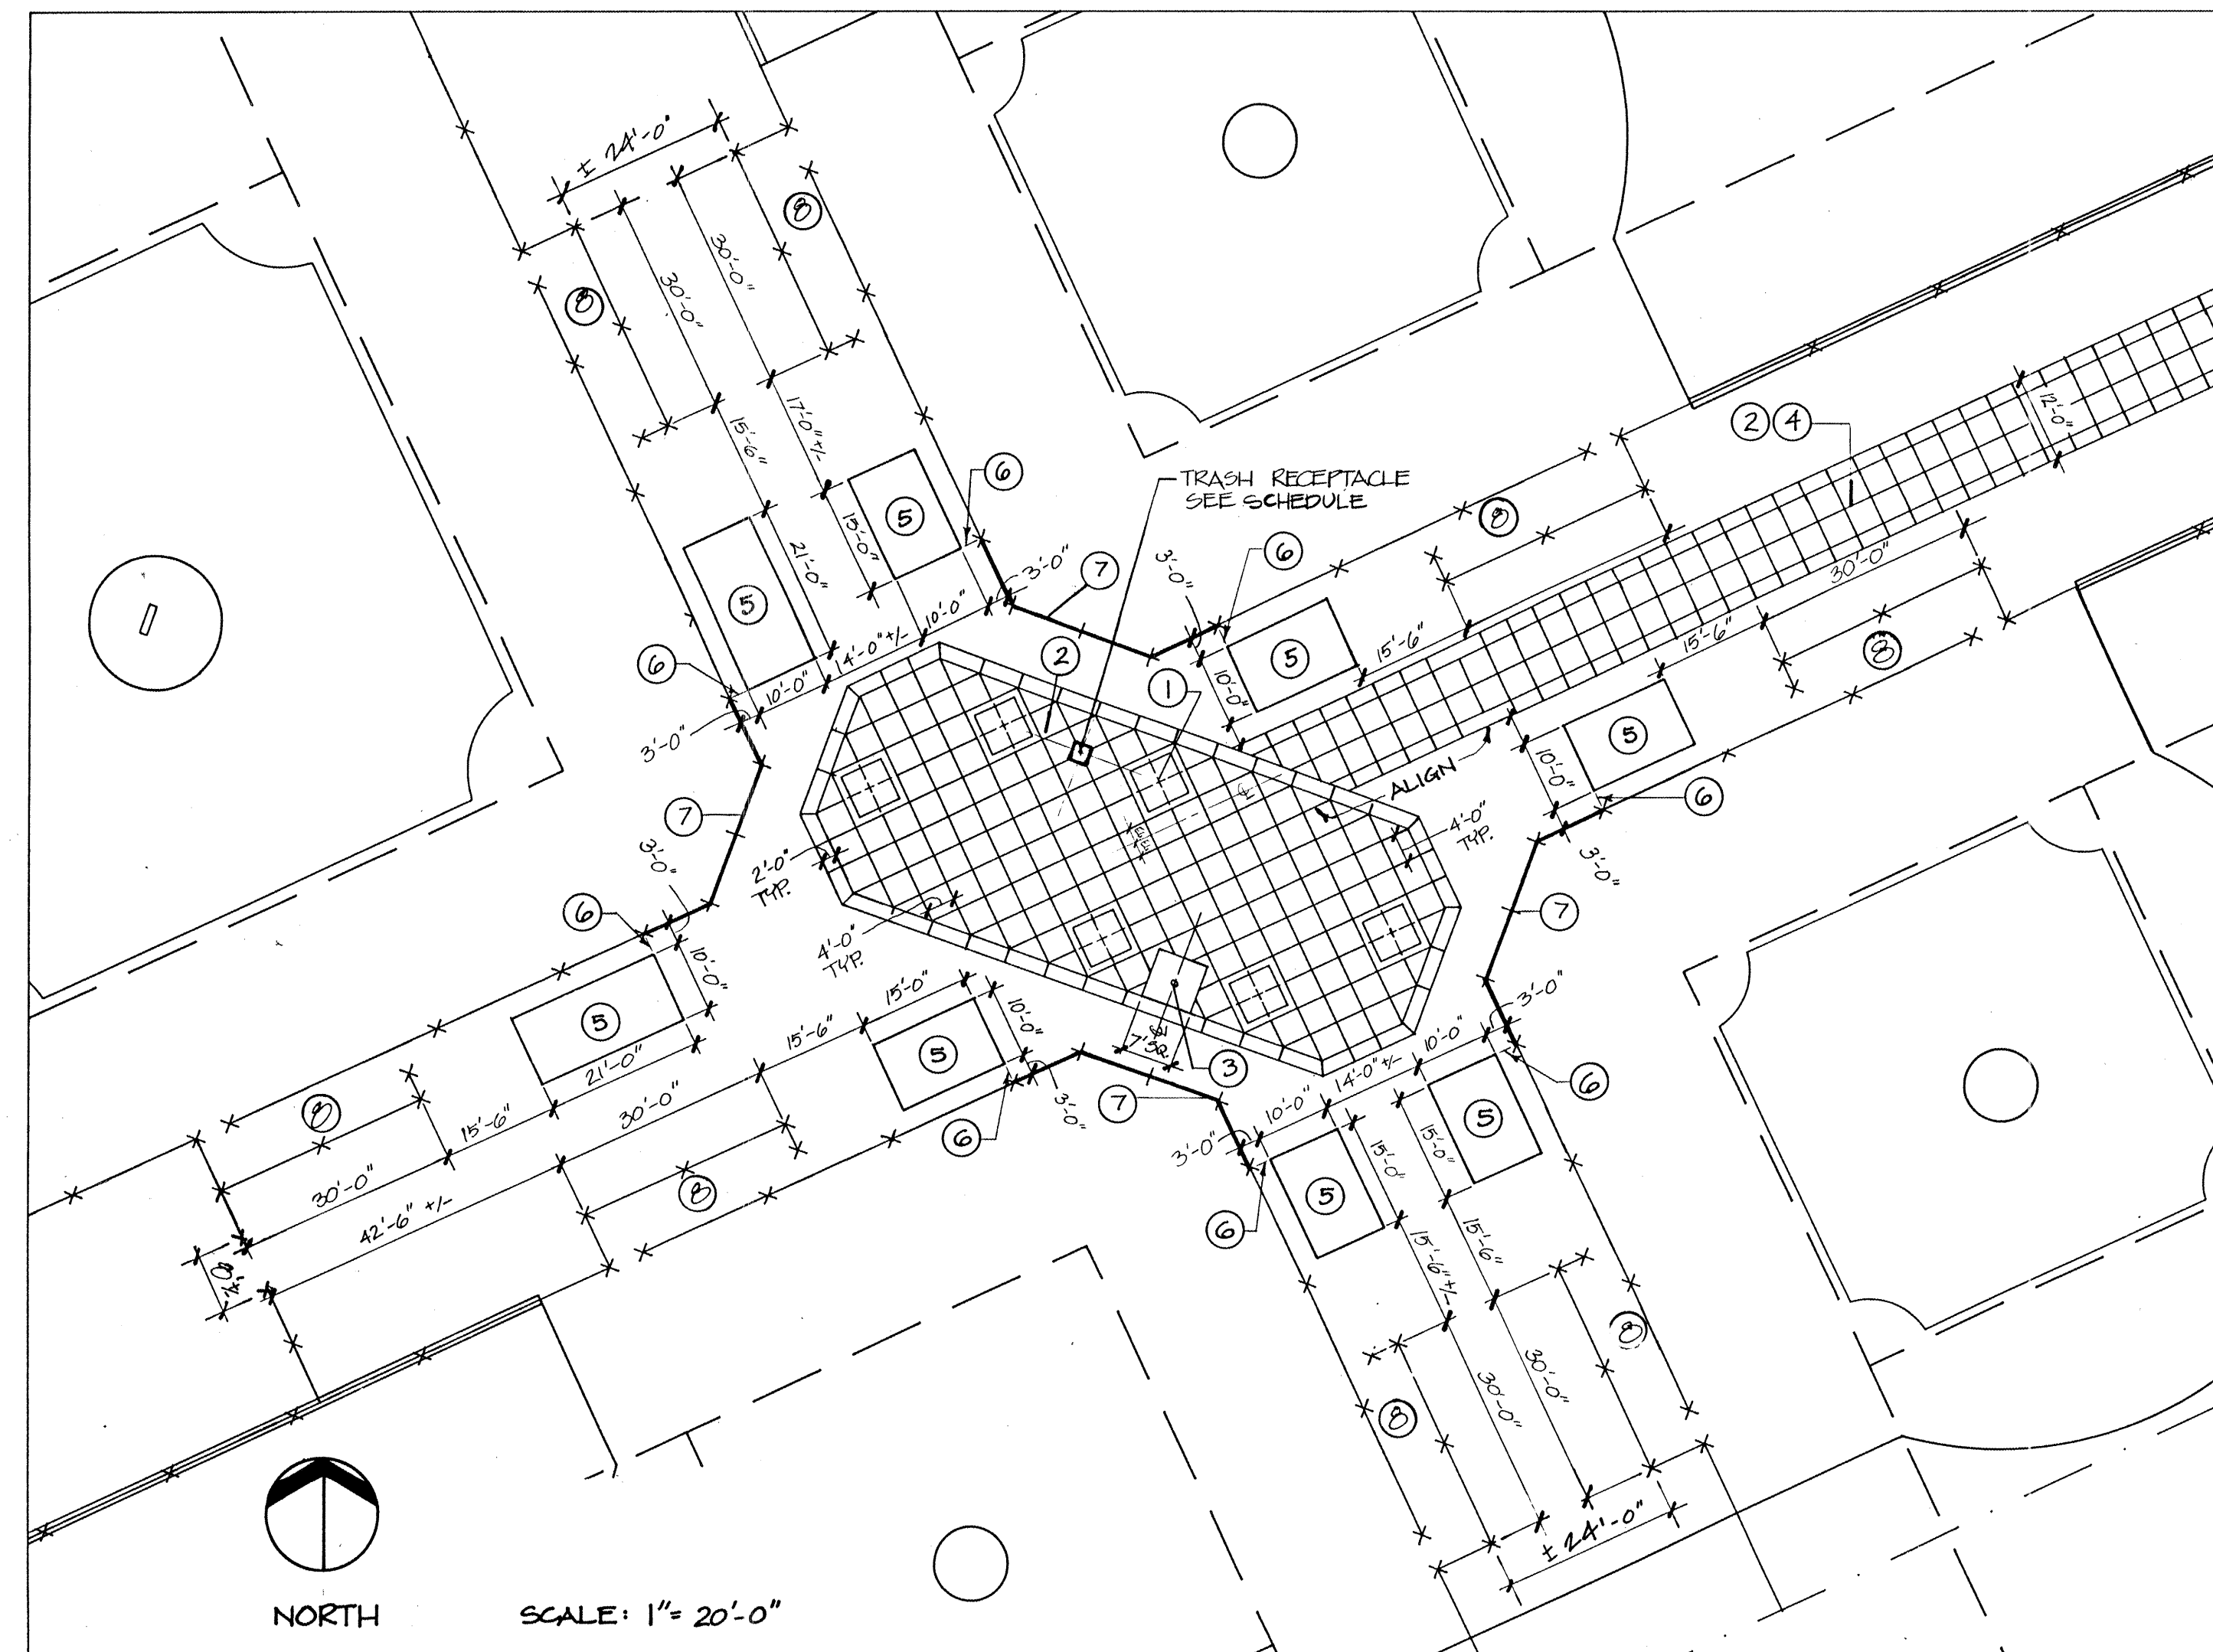

KEYED NOTES:


- ① TREE WELL, TYPICAL 1 OF 6, 6'-0" SQUARE, CENTER IN PAVING PATTERN AT LOCATIONS SHOWN.
- ② PAVING PATTERN TO BE 4'-0" SQUARE, ALIGN AS SHOWN.
- ③ DRINKING FOUNTAIN LOCATION, SEE DETAIL *6, SHEET *SD-5
- ④ 12'-0" WIDE CONCRETE WALK
- ⑤ BLEACHERS, SEE SCHEDULE AND DETAIL *8, SHEET *SD-4
- ⑥ ALIGN BLEACHER LOCATIONS WITH OUTER POSTS ON BACKSTOP, TYPICAL.
- ⑦ BACKSTOP
- ⑧ DUGOUT

GENERAL NOTES:

1. FOR COORDINATE POINTS SEE
COORDINATE POINTS ARE TO DOMINATE DIMENSIONS SHOWN

PLAZA AREA LAYOUT PLAN

INSTALLATION: DRIVE #5 REBAR (3' LONG) INTO EACH HOLE UNTIL FLUSH W/ TOP OF BUMPER

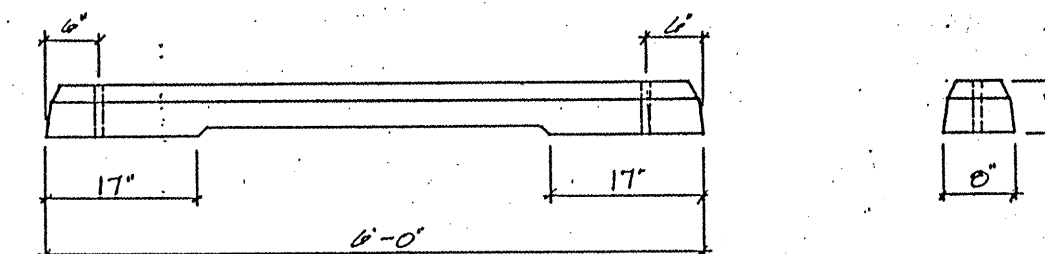


CONCRETE SPECIFICATIONS: 4000 28 DAY COMPRESSIVE STRENGTH (MIN.)
4-7% ENTRAINED AIR
MILD STEEL REINFORCING AS REQUIRED
POLYPROPYLENE FIBER SECONDARY REINFORCING

FORM: SMOOTH SURFACE FIBERGLASS
COLOR: GREY
FINISH: SMOOTH AS CAST.
WEIGHT: 230 LBS.

MANUFACTURER: AS PROVIDED BY MATERIALS INC., OR APPROVED EQUAL.
(505) 891-8888


6'-0" PRECAST PARKING BUMPER

NTS

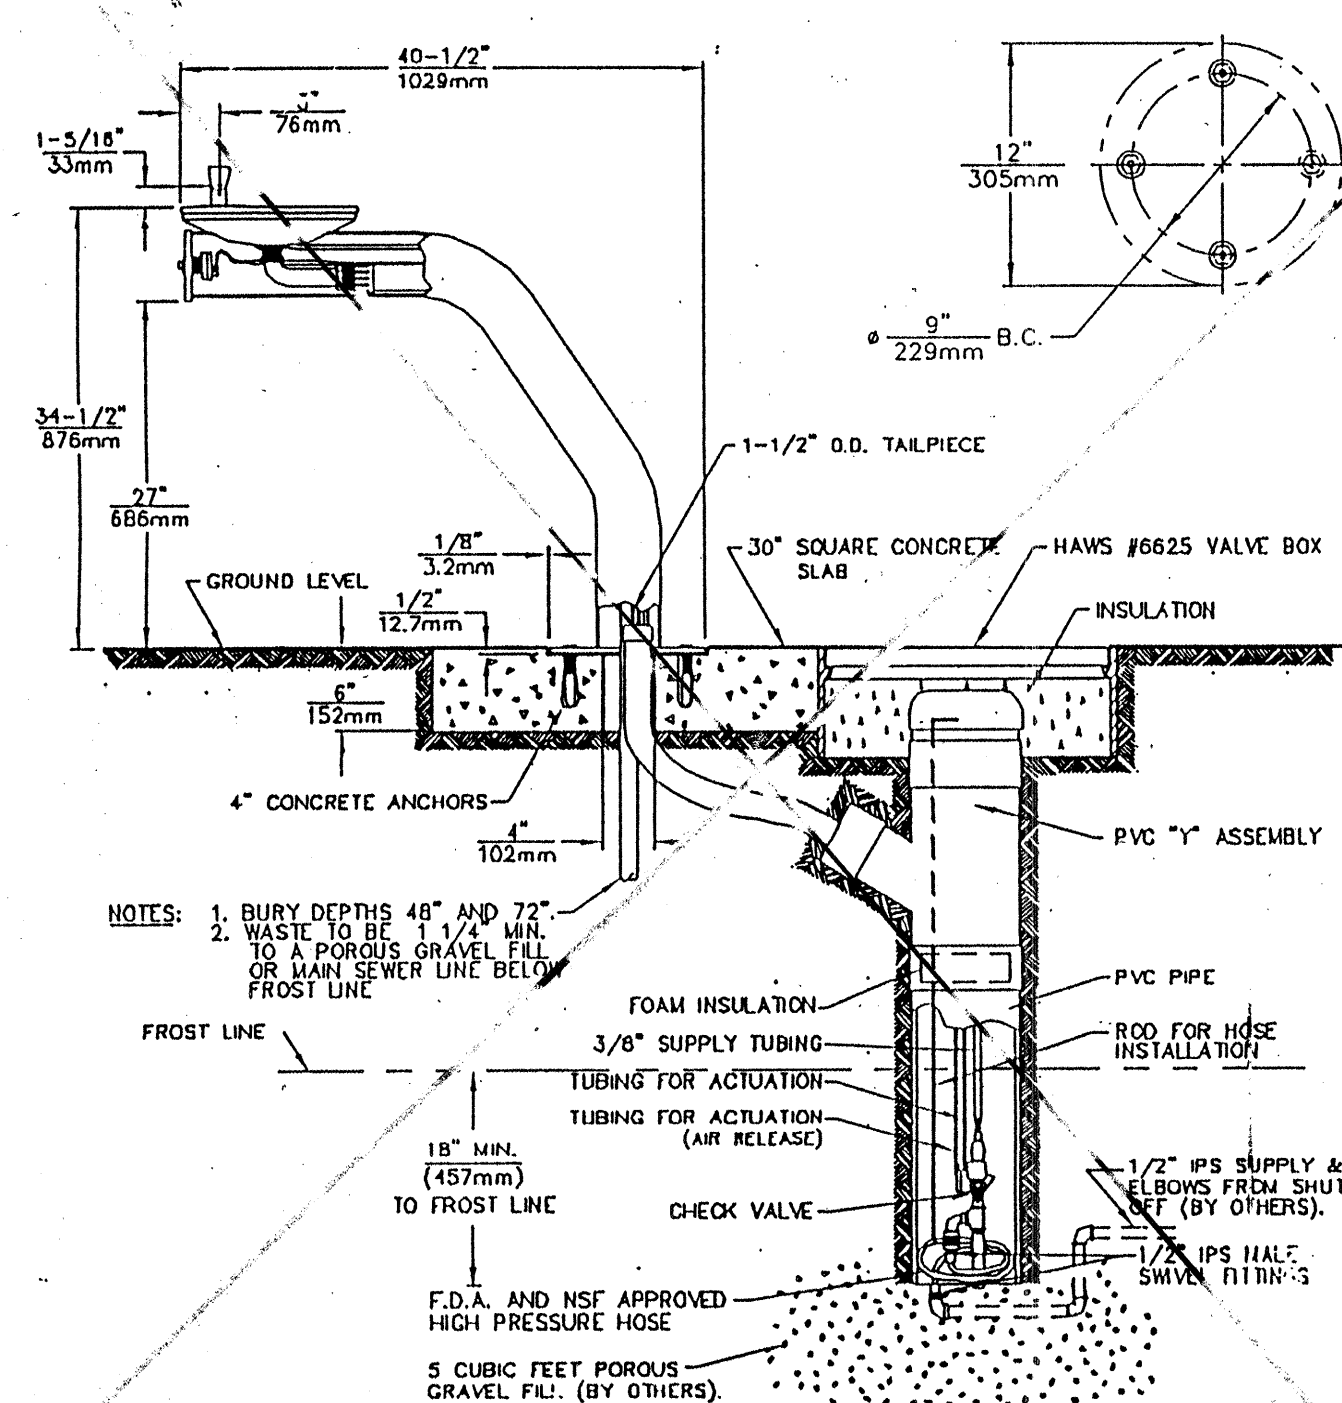


DRINKING FOUNTAIN

SECTION
NTS

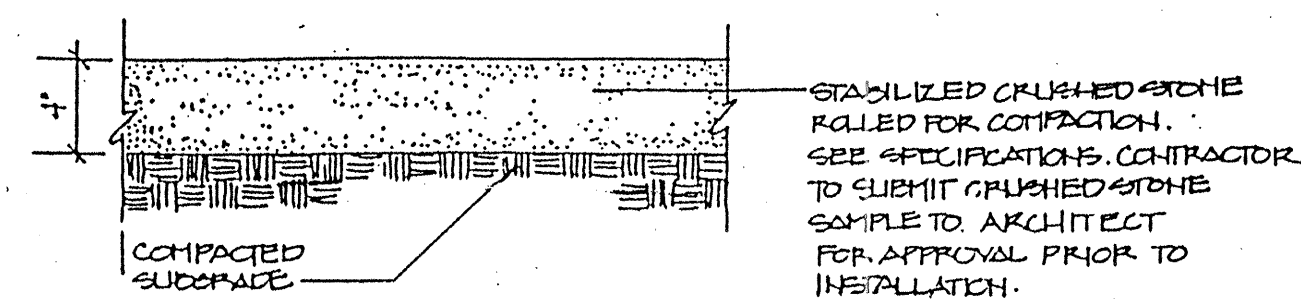


STABILIZED CRUSHED STONE PAVEMENT

SCALE 1 1/2"=1'-0"

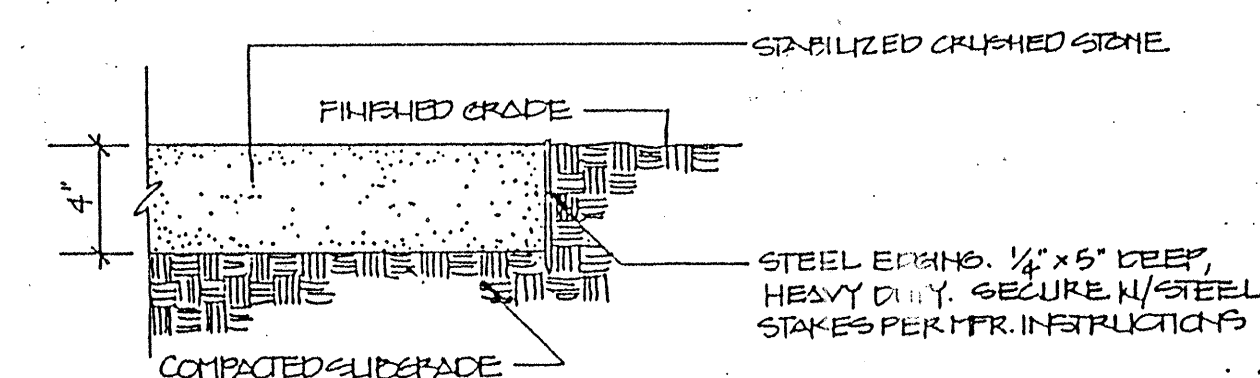


STEEL EDGING

SCALE 1 1/2"=1'-0"

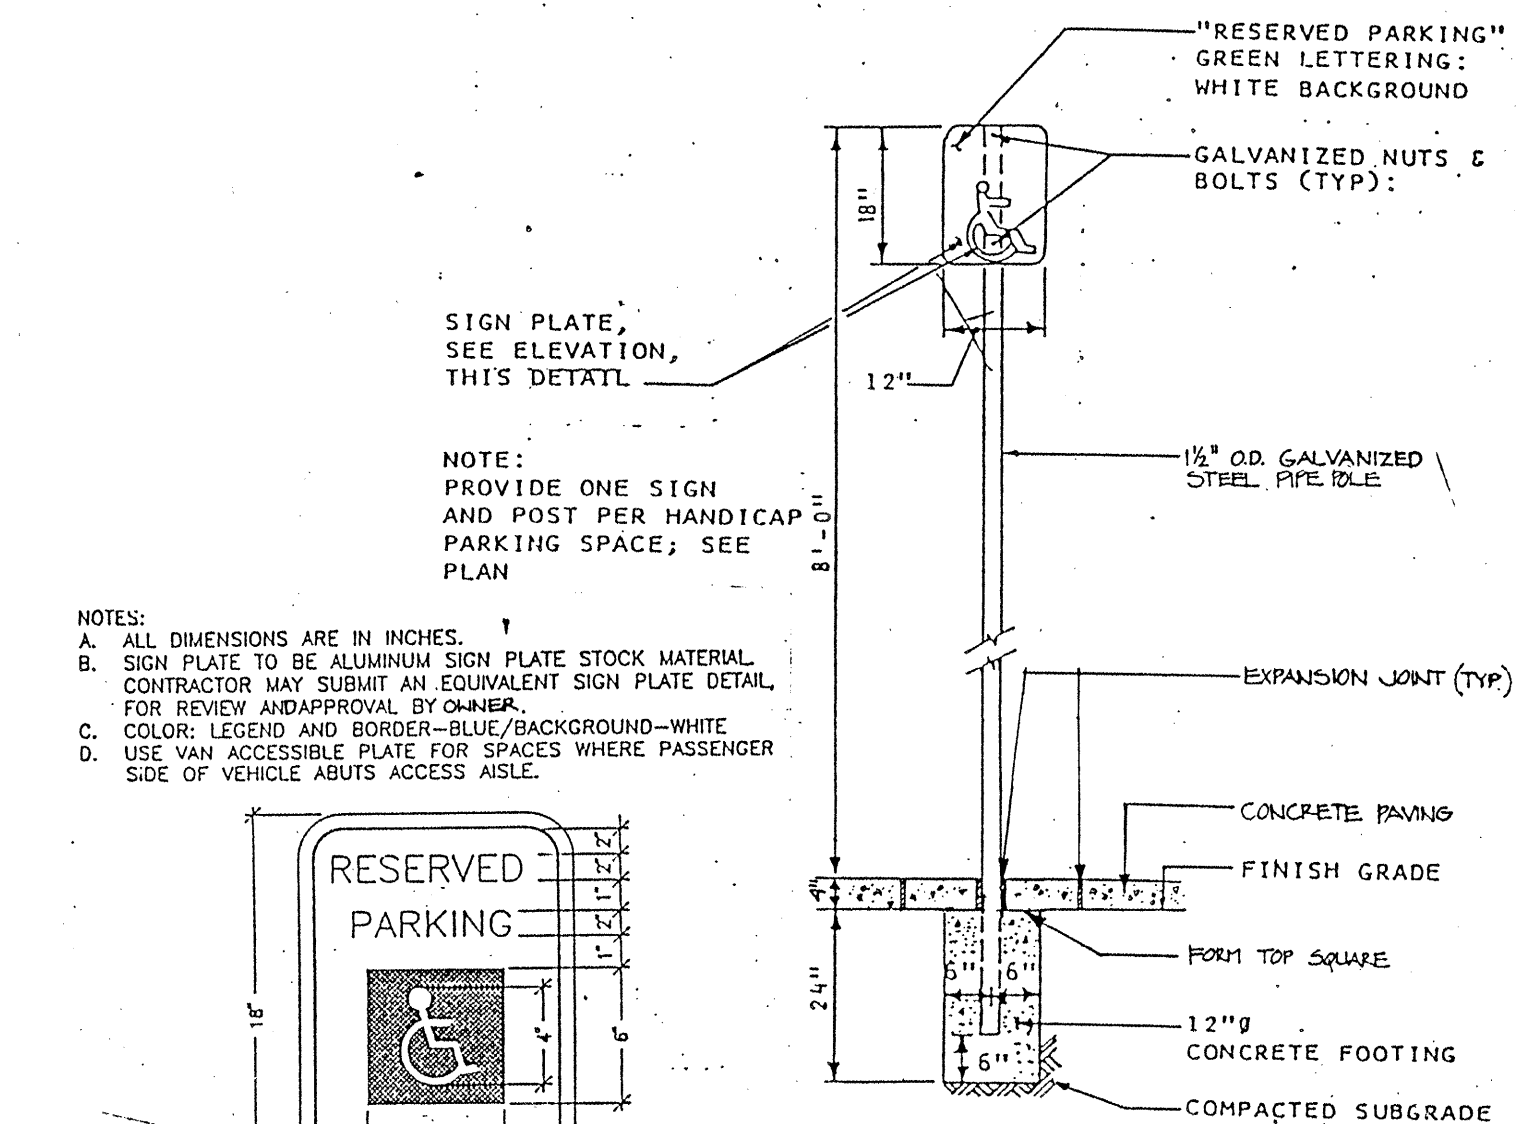

NOTES:


- A. ALL DIMENSIONS ARE IN INCHES.
- B. SIGN PLATE TO BE ALUMINUM SIGN PLATE STOCK MATERIAL CONTRACTOR MAY SUBMIT AN EQUIVALENT SIGN PLATE DETAIL FOR REVIEW AND APPROVAL BY OWNER.
- C. COLOR: LEGEND AND BORDER—BLUE/BACKGROUND—WHITE
- D. USE VAN ACCESSIBLE PLATE FOR SPACES WHERE PASSENGER SIDE OF VEHICLE ABUTS ACCESS AISLE.

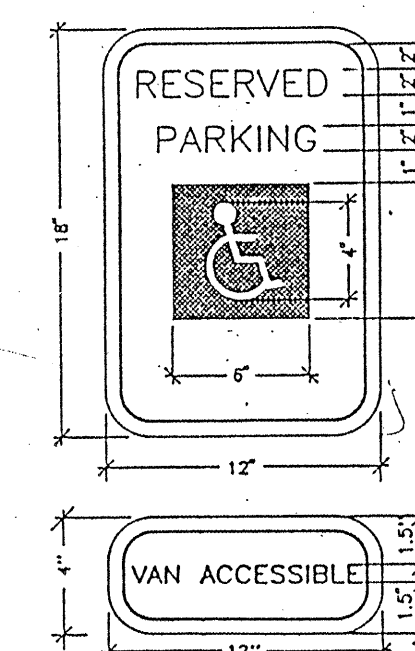

ELEVATION


HANDICAP PARKING SIGNAGE

NTS

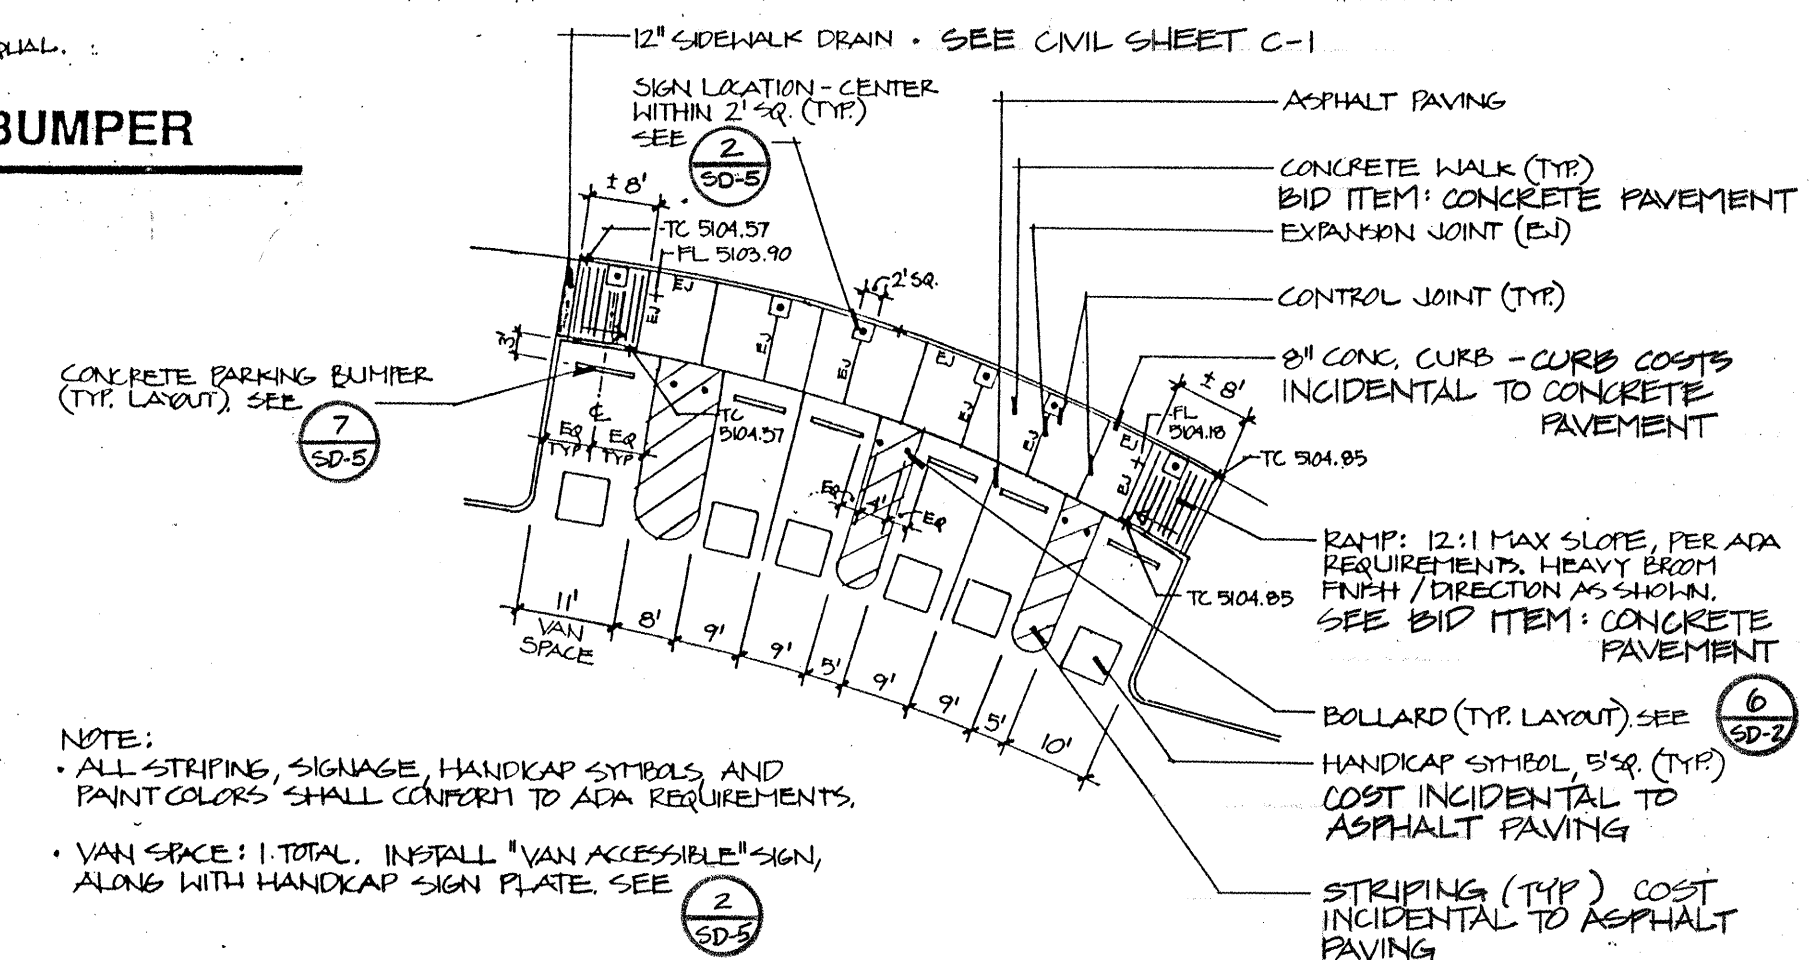

HANDICAP PARKING LAYOUT

PLAN
NTS

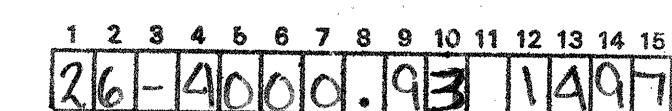


CITY OF ALBUQUERQUE
PARKS AND GENERAL SERVICES DEPARTMENT
DESIGN AND DEVELOPMENT DIVISION

TITLE: MARIPOSA BASIN
PHASE II IMPROVEMENTS
SITE DETAILS

APPROVALS	ENGINEER	DATE	APPROVALS	ENGINEER	DATE
DRC CHAIRMAN	<i>B. J. Kooling</i>	<i>10/31/94</i>	WATER	<i>N/A RWH</i>	
TRANSPORTATION	<i>N. P. CHO</i>	<i>10-21-94</i>	WASTE WATER	"	
HYDROLOGY	<i>N. P. CHO</i>	<i>10/26/94</i>			
PARKS/GEN. SVCS	<i>Shindler</i>	<i>11/1/94</i>			
PROJECT NO.	4000.93	MAP NO.	0-11-Z 0-12-Z 0-11-Z 0-12-Z	SHEET	SD-5 19 OF 21

Campbell Okuma Perkins Associates, Inc.
Landscape Architecture and Site Planning
418 Central S.E. 1339 Pacheco No. 8
Albuquerque, NM 87102 Santa Fe, NM 87501
(505) 242-9928 (505) 962-8399

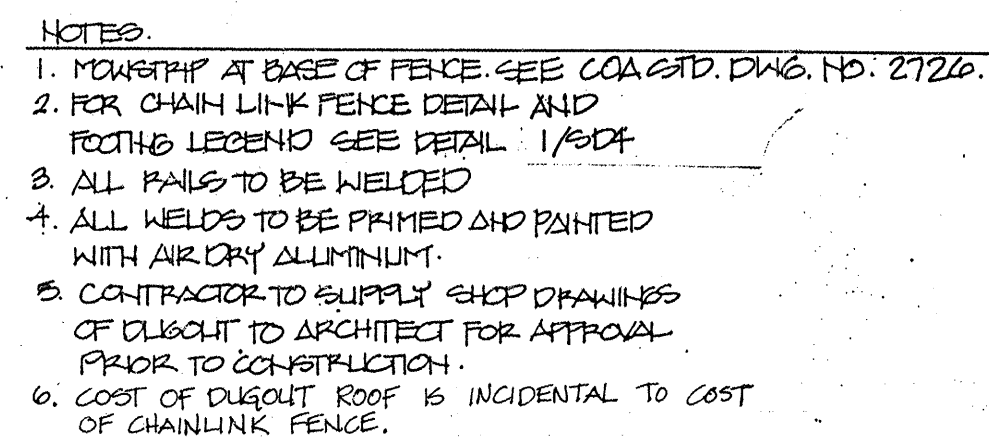

GENERAL NOTES:

1. CONTROL JOINTS SHALL BE PLACED AT 5' O.C..
2. EXPANSION JOINTS SHALL BE PLACED AT 20' O.C., AND WHERE THE MOWSTRIP ABUTS ANOTHER HARD SURFACE.
3. TOP OF MOWSTRIP SHALL BE LEVEL WITH THE FINISH GRADE.

CONSTRUCTION NOTES:

- A. FINISH GRADE.
- B. SOD OR SEEDED TURF (REFERENCE THE DRAWING).
- C. #3 REBAR, HORIZONTAL AND CONTINUOUS.
- D. MATERIAL VARIES (REFERENCE THE DRAWING).
- E. 4000 PSI CONCRETE MOWSTRIP. (SEE SECTION 101).
- F. SUBGRADE COMPACTED TO 95%. (SEE SECTION 301).
- G. TOOLED EDGE. (TYP.)

TYPICAL SECTION FOR
32 FT. OR 40 FT. ESTATE TYPE STREET

FLEXIBLE PAVEMENT SECTION

DWG 2406
NTS

- GENERAL NOTES:
1. ESTATE TYPE STREET SECTION TO BE USED ONLY WHEN PERMITTED IN THE APPROVED DRAINAGE PLANS.
 2. RIGHT-OF-WAY REQUIREMENTS TO BE ESTABLISHED BY THE CITY DESIGNER. SIDEWALK CONTINGULATION, DRAINAGE REQUIREMENTS & OTHER APPURTENANCE LOCATIONS, SHALL BE APPROVED ON AN INDIVIDUAL SITE BASIS AND SHALL BE SHOWN ON THE PROJECT CONSTRUCTION PLANS.
 3. ALL ASPHALT CONCRETE PAVEMENT SHALL COMPLY WITH SECTION 116.
 4. INDIVIDUAL PAVEMENT SECTIONS APPLICABLE TO RESIDENTIAL STREETS SERVING 30 LOTS OR LESS UNLESS AUTHORIZED BY THE CITY ENGINEER. STREETS SERVING MORE THAN 30 LOTS SHALL BE DESIGNED AS ARTERIAL/COLLECTOR STREETS IN ACCORDANCE WITH CDA DIST. VOL. 3, SECTION 13, STREET DESIGN.

- CONSTRUCTION NOTES:
- A. ASPHALT CONCRETE PAVEMENT.
 - B. COMPACTED SUBGRADE, 95% COMPACTION
 - C. COMPACTED SUBGRADE, 90% COMPACTION
 - D. MOUNTABLE CURB ESTATE TYPE.
 - E. THEORETICAL FACE OF CURB OR FLOWLINE.
 - F. PROJECT DESIGNED SWALE.
 - G. SIDEWALK.

WG 2406
NTS

1	2	3	4	5	6	7	8	9	10	11	12	13	14	15
2	6	-	4	0	0	0	.	9	3			1	5	9

CITY OF ALBUQUERQUE
PARKS AND GENERAL SERVICES DEPARTMENT
DESIGN AND DEVELOPMENT DIVISION

TITLE: MARIPOSA BASIN
PHASE II IMPROVEMENTS
SITE DETAILS

APPROVALS	ENGINEER	DATE	APPROVALS	ENGINEER	DATE
DRC CHAIRMAN	<i>B.A. Smith</i>	10/31/94	WATER	<i>N/A RDR</i>	
TRANSPORTATION	<i>M.A. Datto</i>	10-21-94	WASTE WATER	<i>ti</i>	
HYDROLOGY	<i>M. J. Kelly</i>	10/26/94			
PARKS/GEN. SVC.	<i>Tim Dwyer</i>	11/1/94			
PROJECT NO. 4000.93	MAP NO.	D-11-1 D-11-2 D-11-3 D-11-4 D-11-5 D-11-6 D-11-7 D-11-8 D-11-9 D-11-10 D-11-11 D-11-12	SHEET 50-60	OF 21	

Campbell Okuma Perkins Associates, Inc.
Landscape Architecture and Site Planning
418 Central S.E. Albuquerque, NM 87102
(505) 242-9928

1339 Pacheco No. 8 Santa Fe, NM 87501
(505) 962-8399

DESIGNED BY: COPA	DATE:
DRAWN BY: WBT	DATE: 9-16-94
CHECKED BY: WCB	DATE: 10-11-94

