

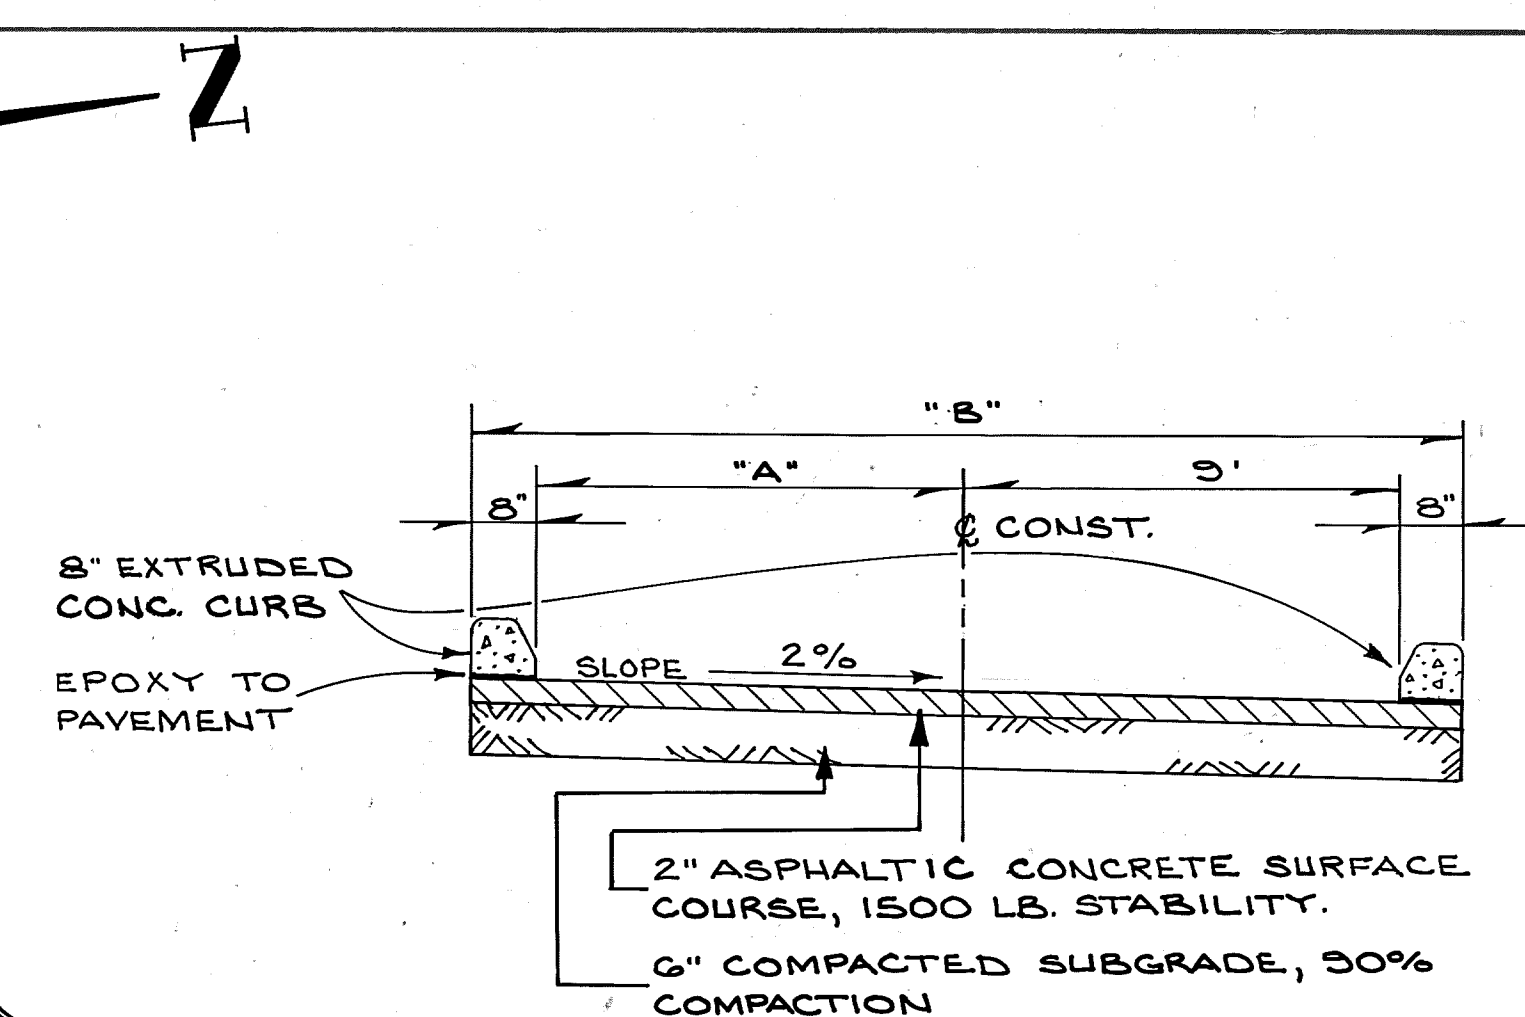
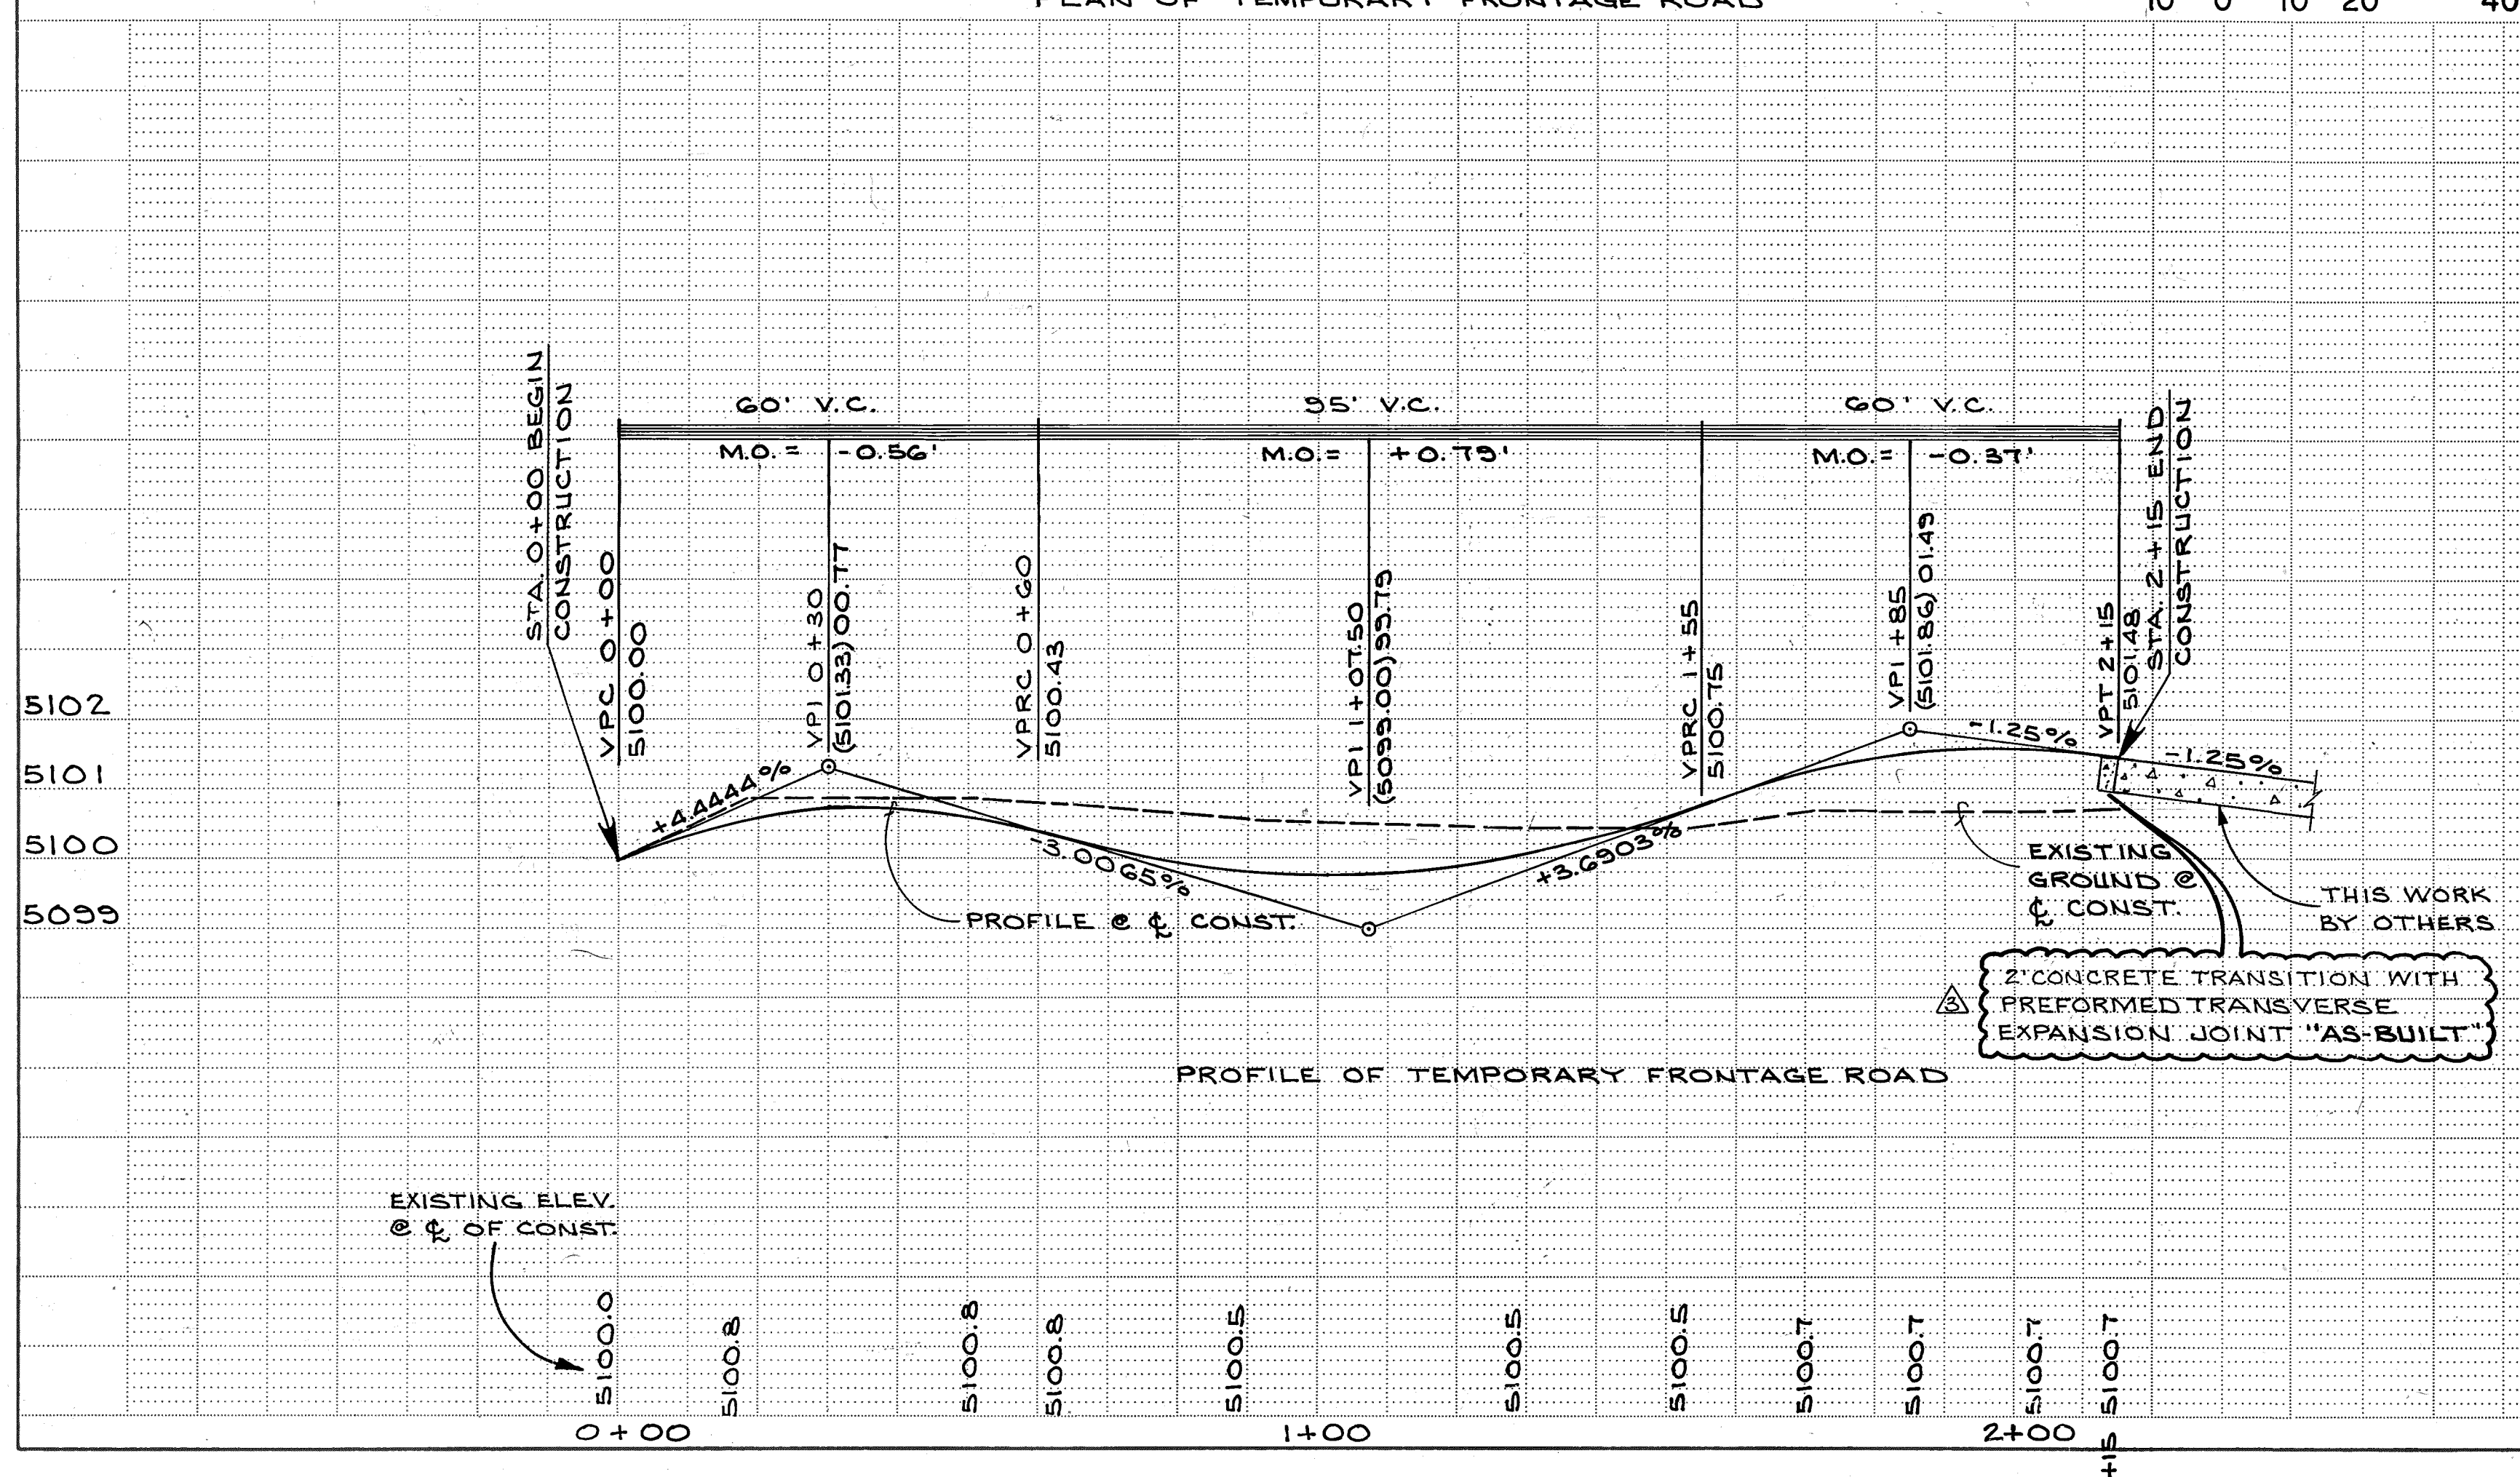


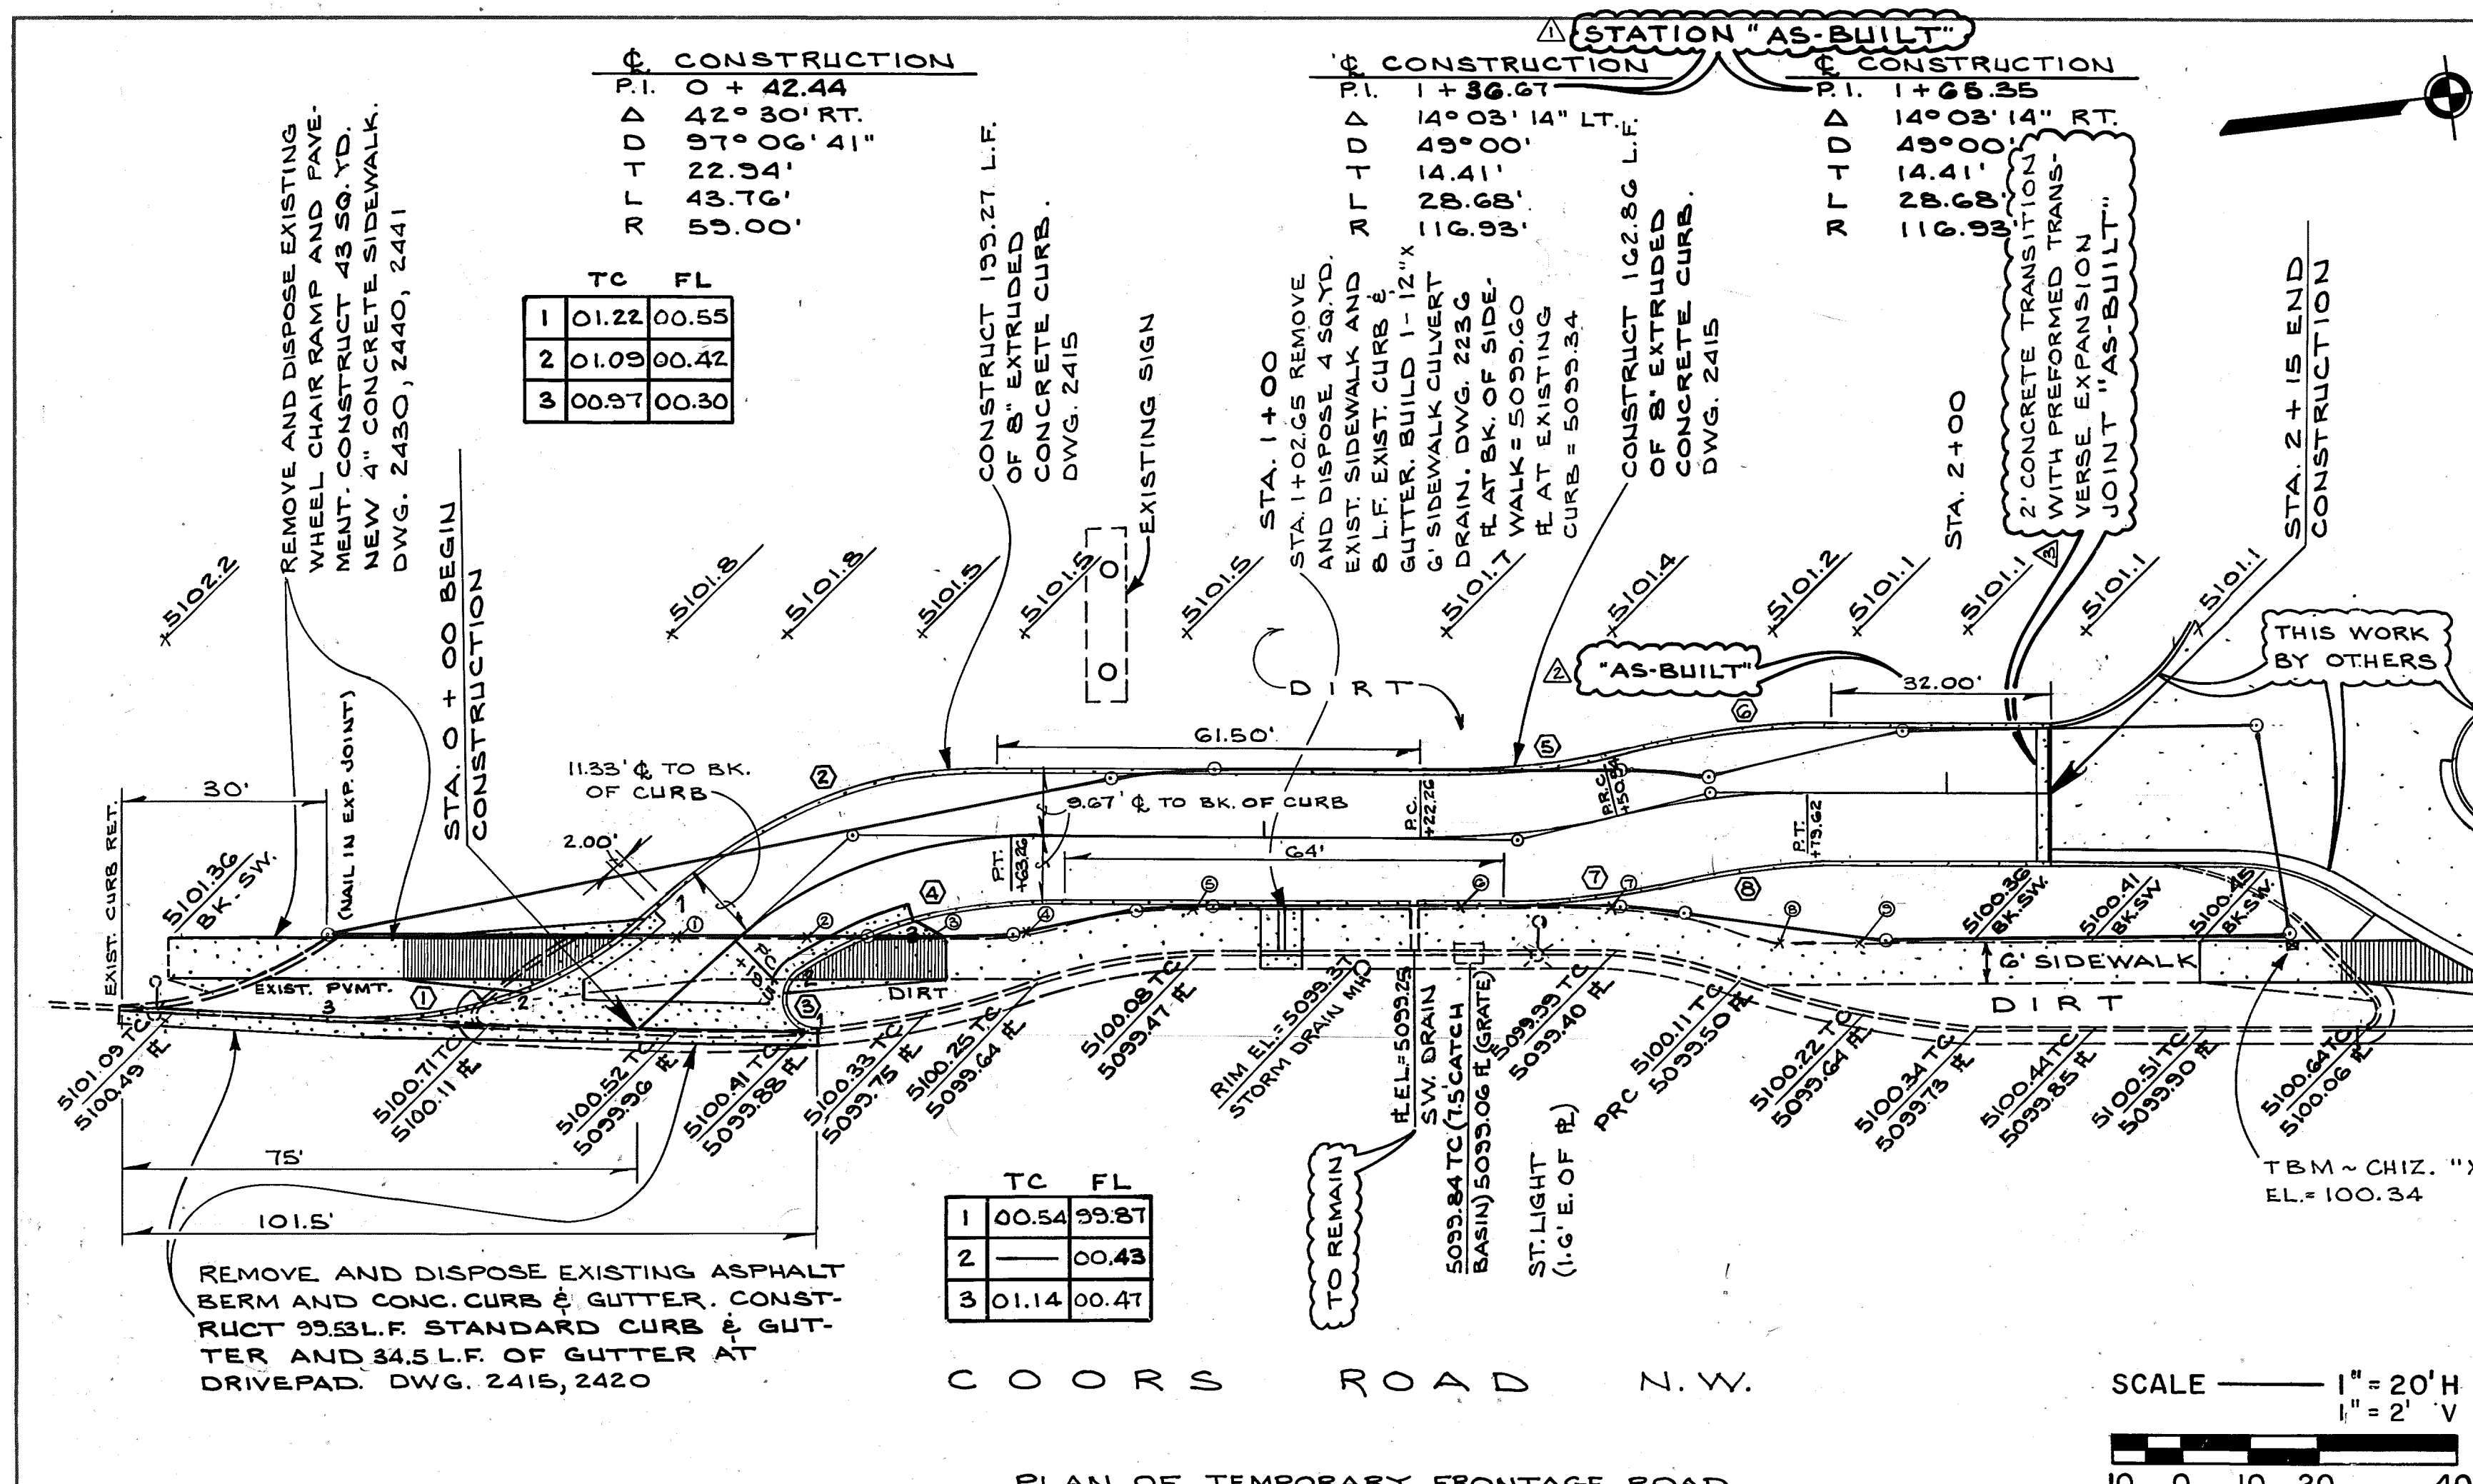

TEMPORARY PAVEMENT SECTION
NOT TO SCALE

STA. 0 + 00	TO STA. 0 + 19.50
"A" = 19.50'	"B" = 21.00'
STA. 0 + 19.50	TO STA. 0 + 63.26
TRANSITION	
STA. 0 + 63.26	TO STA. 1 + 22.26
"A" = 3.00'	"B" = 13.33'
STA. 1 + 22.26	TO STA. 1 + 83.00
TRANSITION	
STA. 1 + 83.00	TO STA. 2 + 15.00
"A" = 11.20'	"B" = 21.53'

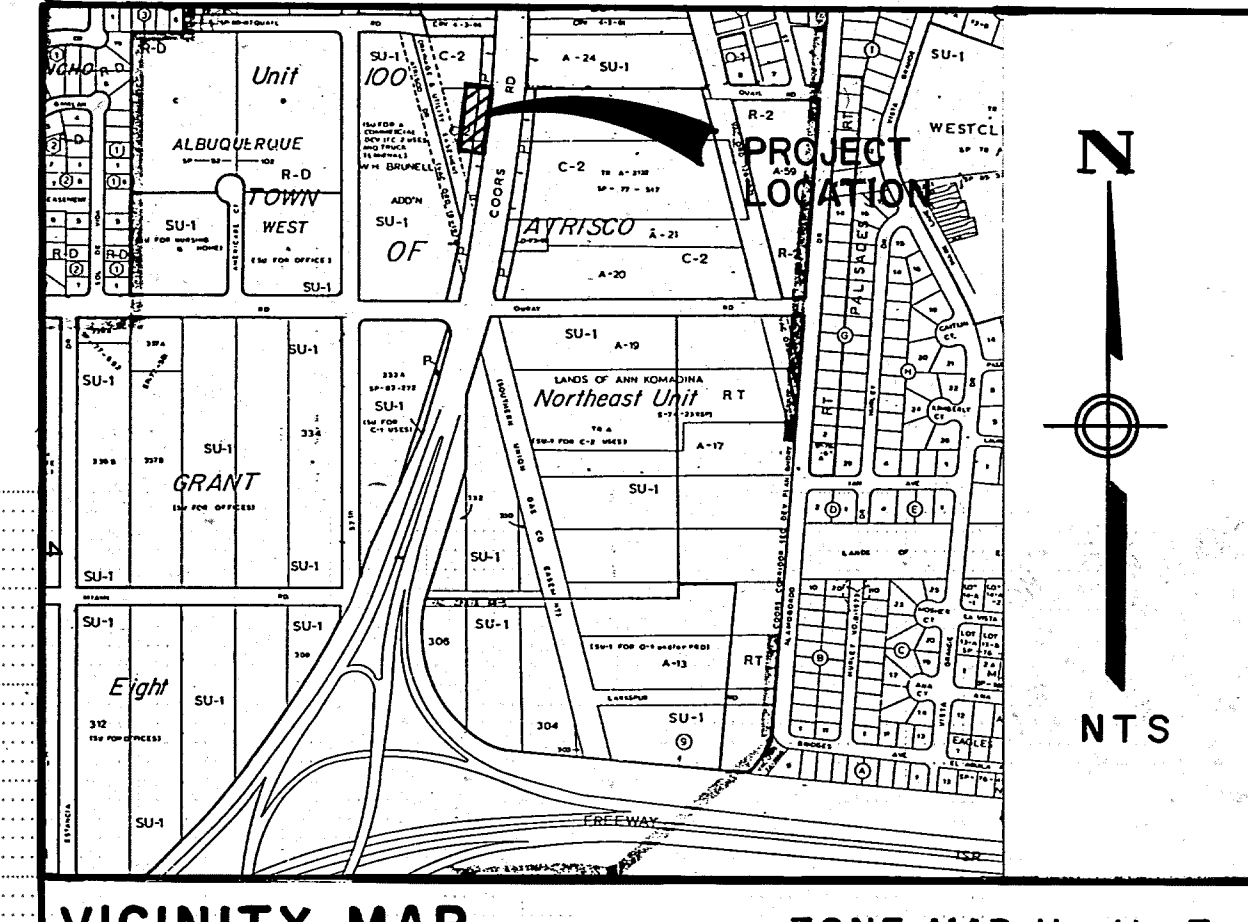

EXISTING ELEVATIONS

NUMBER	ELEV.	DESCRIPTION
1	5100.36	BACK OF SIDEWALK
2	5100.74	"
3	5100.56	"
4	5100.41	"
5	5100.17	"
6	5100.00	"
7	5100.10	"
8	5100.28	"
9	5100.28	"

CURVE TABLE

NUMBER	Δ	R. RADIUS	LENGTH	LONG. CHORD BRG.	LONG. CHORD LENGTH
1	42° 30'	68.00'	50.44'	N. 17° 06' 24" W.	49.23'
2	42° 30'	68.00'	50.44'	N. 17° 06' 24" W.	49.23'
3	137° 30'	5.00'	12.00'	N. 72° 53' 36" E.	9.32'
4	42° 30'	50.00'	37.03'	N. 17° 06' 24" W.	36.24'
5	14° 03' 14"	107.93'	26.47'	N. 2° 53' 01" W.	26.41'
6	14° 03' 14"	125.93'	30.89'	N. 2° 53' 01" W.	30.81'
7	14° 03' 14"	125.93'	30.89'	N. 2° 53' 01" W.	30.81'
8	14° 03' 14"	107.93'	26.47'	N. 2° 53' 01" W.	26.41'

GENERAL NOTES

- ALL WORK DETAILED ON THESE DRAWINGS TO BE PERFORMED UNDER THIS CONTRACT SHALL, EXCEPT AS OTHERWISE NOTED, BE CONSTRUCTED IN ACCORDANCE WITH THE CITY OF ALBUQUERQUE STANDARD SPECIFICATIONS FOR PUBLIC WORKS CONSTRUCTION, 1986. REFERENCES MADE TO STANDARD DRAWINGS ARE TO THAT SECTION OF THE SPECIFICATIONS WHICH INCLUDES MISCELLANEOUS STANDARD DETAILS.
- LOCATION OF UTILITIES ARE APPROXIMATE. IT IS THE RESPONSIBILITY OF THE CONTRACTOR TO LOCATE ALL PERTINENT UTILITIES IN THE FIELD. CALL ONE CALL SYSTEM, INC., AT 260-1990 TWO WORKING DAYS BEFORE ANY EXCAVATION.
- PRIOR TO CONSTRUCTION, THE CONTRACTOR SHALL EXCAVATE AND VERIFY THE HORIZONTAL AND VERTICAL LOCATIONS OF ALL OBSTRUCTIONS. SHOULD A CONFLICT EXIST, THE CONTRACTOR SHALL NOTIFY THE ENGINEER SO THAT THE CONFLICT CAN BE RESOLVED WITH MINIMUM AMOUNT OF DELAY.
- THREE (3) WORKING DAYS PRIOR TO BEGINNING CONSTRUCTION, THE CONTRACTOR SHALL SUBMIT TO THE CONSTRUCTION COORDINATION DIVISION A DETAILED CONSTRUCTION SCHEDULE. TWO (2) WORKING DAYS PRIOR TO CONSTRUCTION THE CONTRACTOR SHALL OBTAIN A BARRICADE PERMIT FROM THE CONSTRUCTION COORDINATION DIVISION. CONTRACTOR SHALL NOTIFY BARRICADE ENGINEER (768-2551) PRIOR TO WORK IN PUBLIC RIGHT OF WAY.

ALL STREET STRIPING ALTERED OR DESTROYED SHALL BE REPLACED IN KIND BY CONTRACTOR TO LOCATION AND IN KIND AS EXISTING.

ALL PAVEMENT MARKINGS OR OTHER TRAFFIC CONTROL DEVICES INCLUDING TRAFFIC CONTROL CONDUIT, ADVERSELY AFFECTED BY CONSTRUCTION SHALL BE PLACED IN PRECONSTRUCTION CONDITION. THESE COSTS SHALL BE INCIDENTAL TO THE PROJECT.

THE CONTRACTOR SHALL COORDINATE TRAFFIC CONTROL WITH THE CONSTRUCTION COORDINATOR OF THE CITY OF ALBUQUERQUE PUBLIC WORKS DEPARTMENT.

APPROVED FOR CONSTRUCTION
CITY ENGINEER
11-3-92

Resource Technology, Inc.
ENGINEERS & ENVIRONMENTAL SCIENTISTS
2129 OSUNA NE - SUITE 300, ALBUQUERQUE, NEW MEXICO 87113
TELEPHONE - (505) 345-3115

CITY OF ALBUQUERQUE
PUBLIC WORKS DEPARTMENT
ENGINEERING GROUP

TITLE: COORS RD. WEST FRONTAGE ROAD AT QUAIL RD. (TEMP.)

APPROVALS	ENGINEER	DATE	APPROVALS	ENGINEER	DATE
DRG CHAIRMAN	Reggie A. Green	9/8/92	WATER	NA	8/92
TRANSPORTATION	Dwight L. Gamm	9/4/92	WASTE WATER	NA	8/92
HYDROLOGY	John J. Jorgensen	9/3/92			

DESIGNED BY	D.S.D.	DATE	8/92
DRAWN BY	G.M.K.	DATE	8/92
CHECKED BY	E.V.D.	DATE	9/92

PROJECT NO. 4006.91 MAP NO. H-11 SHEET 1 OF 1