

RECONSTRUCTION AND REHABILITATION
OF THE COAL AVENUE BRIDGE
AND SECOND STREET , S.W.



LOCATION MAP
ZONE ATLAS MAP K-14-Z

I HEREBY CERTIFY THAT THIS PROJECT WAS CONSTRUCTED
IN GENERAL CONFORMANCE WITH THE PLANS AND SPECIFICATIONS
SHOWN HEREON AND THAT THESE DRAWINGS HAVE BEEN REVISED
IN ACCORDANCE WITH INFORMATION PROVIDED BY THE CONTRACTOR
AND CITY INSPECTION PERSONNEL.

Carlos G. Padilla
CARLOS G. PADILLA P.E. No. 11040

10/24/95
DATE

APPROVAL OF AS BUILT DRAWINGS
CHIEF CONSTRUCTION ENGINEER
Chen Chang
DATE 11/2/95

GENERAL NOTES

- ALL WORK DETAILED ON THESE PLANS SHALL BE PERFORMED IN ACCORDANCE WITH THE CITY OF ALBUQUERQUE STANDARD SPECIFICATIONS, PUBLIC WORKS CONSTRUCTION, 1986 (REFERRED TO HEREIN AS "STANDARD SPECIFICATIONS"), WITH THE EXCEPTION OF CERTAIN ITEMS OF BRIDGE WORK. SEE NOTE 1, SHEET 2.
- CONTRACTOR SHALL COORDINATE WITH THE WATER SYSTEMS DIVISION THREE (3) WORKING DAYS PRIOR TO INITIATING ANY WORK AFFECTING EXISTING PUBLIC WATER UTILITIES.
- TWO (2) WORKING DAYS PRIOR TO ANY EXCAVATION CONTRACTOR MUST NOTIFY NEW MEXICO ONE CALL SYSTEM, (505) 260-1990, FOR LOCATION OF EXISTING UNDERGROUND UTILITIES. THE LOCATION OF EXISTING UNDERGROUND UTILITIES ARE SHOWN IN AN APPROXIMATE WAY ONLY. IT IS THE CONTRACTOR'S RESPONSIBILITY TO CONTACT THE LINE LOCATING SERVICE FOR EXACT LINE LOCATIONS.
- PRIOR TO CONSTRUCTION, THE CONTRACTOR SHALL EXCAVATE AND VERIFY THE HORIZONTAL AND VERTICAL LOCATIONS OF ALL POTENTIAL OBSTRUCTIONS. SHOULD A CONFLICT EXIST, THE CONTRACTOR SHALL NOTIFY THE ENGINEER SO THAT THE CONFLICT CAN BE RESOLVED WITH A MINIMUM DELAY.
- ALL GAS, ELECTRIC, TELEPHONE LINES, CABLE, AND APPURTENANCES ENCOUNTERED DURING CONSTRUCTION THAT REQUIRE RELOCATION, SHALL BE RELOCATED BY THE RESPONSIBLE UTILITY COMPANY. CONTRACTOR SHALL BE RESPONSIBLE FOR COORDINATION OF ALL NECESSARY UTILITY ADJUSTMENTS.
- IT WILL BE THE CONTRACTOR'S RESPONSIBILITY TO PROTECT AND MAINTAIN IN SERVICE ALL EXISTING UTILITIES UNLESS OTHERWISE INDICATED ON THE PLANS
- BACKFILL COMPACTION IN STREET AREAS SHALL BE ACCORDING TO SPECIFIED STREET USE.
- ALL TRENCH BACKFILL OUTSIDE OF STREET AREAS SHALL BE COMPACTED TO A MINIMUM OF 90% MAXIMUM DENSITY AS DETERMINED BY ASTM D-1557, OR ASTM D-698 AS REQUIRED BY THE TYPE OF SOIL ENCOUNTERED.
- WHEN ABUTTING NEW PAVEMENT TO EXISTING, SAWCUT EXISTING PAVEMENT TO STRAIGHT EDGE AND AT A RIGHT ANGLE, OR AS APPROVED BY THE PROJECT ENGINEER, TO REMOVE ANY OR ALL CRACKED PAVEMENT.
- SIDEWALKS AND WHEELCHAIR RAMPS SHALL BE CONSTRUCTED WITHIN THE CURB RETURNS WHEREVER A NEW CURB RETURN IS CONSTRUCTED FOR ALL DRIVES INTERSECTING PUBLIC RIGHT-OF-WAY.
- IF THE CURB IS DEPRESSED FOR A DRIVE PAD OR A HANDICAP RAMP, THE DRIVEPAD OR RAMP SHALL BE CONSTRUCTED PRIOR TO ACCEPTANCE OF THE CURB AND GUTTER.
- ALL WORK ON THIS PROJECT SHALL BE PERFORMED IN ACCORDANCE WITH APPLICABLE FEDERAL, STATE AND LOCAL LAWS, RULES, AND REGULATIONS CONCERNING CONSTRUCTION SAFETY AND HEALTH.
- CONTRACTOR SHALL MAINTAIN ACCESS TO ADJACENT PROPERTIES DURING CONSTRUCTION.
- THE CONTRACTOR WILL BE REQUIRED TO CONFINE HIS WORK WITHIN THE CONSTRUCTION LIMITS AND/OR PUBLIC RIGHT-OF-WAY TO PRESERVE EXISTING VEGETATION AND PRIVATE PROPERTY. OVERNIGHT PARKING OF CONSTRUCTION EQUIPMENT SHALL NOT OBSTRUCT DRIVEWAYS OR DESIGNATED TRAFFIC LANES.
- A DISPOSAL SITE FOR ALL EXCESS EXCAVATED MATERIAL, ASPHALTIC PAVING, CONCRETE CURB AND SIDEWALKS, ETC., SHALL BE OBTAINED BY THE CONTRACTOR IN COMPLIANCE WITH APPLICABLE ENVIRONMENTAL REGULATIONS AND APPROVED BY THE PROJECT ENGINEER, ALL COSTS INCURRED IN OBTAINING A DISPOSAL SITE AND HAUL THERETO SHALL BE CONSIDERED INCIDENTAL TO THE PROJECT AND NO SEPARATE MEASUREMENT OR PAYMENT SHALL BE MADE.

GENERAL NOTES

- A SURVEY OF THE PROJECT SITE TO INCLUDE PHOTOGRAPHS OR VIDEO SHALL BE MADE BY THE CONTRACTOR AND THE ENGINEER PRIOR TO COMMENCING WORK. ANY PAVEMENT, CURB AND GUTTER, SIDEWALK, LANDSCAPING, UTILITIES, OR OTHER ITEMS IDENTIFIED BY THE ENGINEER THAT ARE DAMAGED OR DESTROYED DURING THE COURSE OF THE WORK SHALL BE REPLACED AT THE CONTRACTOR'S EXPENSE, SUCH REPAIR OR REPLACEMENT WORK SHALL BE PERFORMED IN ACCORDANCE WITH THE CONTRACT DOCUMENTS.
- THE EXISTING 4" GAS LINE IN SECOND STREET WILL BE REPLACED BY GAS COMPANY PERSONNEL. THE CONTRACTOR IS RESPONSIBLE FOR COORDINATING WITH THE GAS COMPANY OF N.M. TO FACILITATE THE REPLACEMENT. THE CONTRACTOR'S COORDINATION EFFORTS SHALL BE INCIDENTAL TO COMPLETION OF THE WORK AND NO ADJUSTMENTS TO PAYMENT OR CONTRACT TIME WILL BE ALLOWED.
- THE CONTRACTOR SHALL EXERCISE CARE TO AVOID DISTURBING EXISTING UNDERGROUND UTILITIES. IT SHALL BE THE CONTRACTOR'S RESPONSIBILITY TO COORDINATE WITH THE UTILITY COMPANIES IN ORDER TO PREVENT ANY SERVICE DISRUPTION.
- PRIOR TO BEGINNING CONSTRUCTION THE CONTRACTOR SHALL INSTALL A TEMPORARY CONSTRUCTION CHAIN LINK FENCE AS SHOWN ON SHEET 3. THE CONTRACTOR SHALL TAKE DUE CARE TO ENSURE THAT CONSTRUCTION DEBRIS IS CONTAINED WITHIN THE CONFINES OF THE CONSTRUCTION FENCING AND IS NOT ALLOWED TO FALL ON ADJACENT PROPERTY. THE TEMPORARY CONSTRUCTION FENCING WILL BE INCIDENTAL TO CONSTRUCTION AND NO SEPARATE MEASUREMENT OR PAYMENT WILL BE MADE THEREFOR. FENCING SHALL BE REMOVED AT THE COMPLETION OF CONSTRUCTION OPERATIONS.

INDEX OF SHEETS

1	OF	25	COVER SHEET AND LOCATION MAP
2	OF	25	GENERAL NOTES AND SPECIAL PROVISIONS
3	OF	25	COAL AVENUE LAYOUT PLANS
4	OF	25	COAL AVENUE CONCRETE RIGID FRAME REPLACEMENT DETAILS
5	OF	25	COAL AVENUE REPAIR DETAILS AT ABUTMENT NO. 2
6	OF	25	PHOTO SHEET NO. 1
7	OF	25	PHOTO SHEET NO. 2
8	OF	25	PHOTO SHEET NO. 3
9	OF	25	REINFORCING BAR SCHEDULE
10	OF	25	2ND STREET PLAN AND PROFILE - STA. 1+90.84 TO STA. 2+80.00
11	OF	25	2ND STREET PLAN AND PROFILE - STA. 2+80.00 TO STA. 6+00.00
12	OF	25	2ND STREET UTILITY PLAN AND PROFILE - STA. 1+90.84 TO STA. 2+80.00
13	OF	25	2ND STREET UTILITY PLAN AND PROFILE - STA. 2+80.00 TO STA. 6+00.00
14	OF	25	2ND STREET JOINT LAYOUT AND DETAILS - STA. 0+00 TO STA. 6+00.00
15	OF	25	SIGNING AND CONSTRUCTION TRAFFIC CONTROL STANDARDS
16	OF	25	TYPICAL TRAFFIC CONTROL & SIGNING EXAMPLES (REF. M.U.T.C.D.)
17	OF	25	CONSTRUCTION SEQUENCING
18	OF	25	CONSTRUCTION SIGNING LAYOUT - PHASE I
19	OF	25	CONSTRUCTION SIGNING LAYOUT - PHASE II
20	OF	25	CONSTRUCTION SIGNING LAYOUT - PHASE III
21	OF	25	CONSTRUCTION SIGNING LAYOUT - PHASE IV
22	OF	25	CONSTRUCTION SIGNING LAYOUT - PHASE V
23	OF	25	ELASTOMERIC EXPANSION JOINT SEALS FOR BRIDGES, BJS-001
24	OF	25	ELASTOMERIC EXPANSION JOINT SEALS FOR BRIDGES, BJS-003
25	OF	25	STANDARD JOINT DETAILS SERIAL LJD-001

REV.	SHEETS	CITY ENGINEER	DATE	USER DEPARTMENT	DATE	USER DEPARTMENT	DATE
APPROVAL OF REVISIONS							

PLANS PREPARED UNDER DIRECTION OF: <i>Chen Chang</i>	AVID ENGINEERING, INC. Civil • Structural • Transportation 8100 Sequoia St. NE - Suite 102 Albuquerque, NM 87109 - (505) 261-5301	APPROVED FOR CONSTRUCTION <i>[Signature]</i> CITY ENGINEER
DATE: _____	PROJECT NO. 4018.91	SHEET 1 OF 25

GENERAL NOTES

1. ALL WORK TO BE PERFORMED UNDER CONTRACT SHALL BE DONE IN ACCORDANCE WITH THE CITY OF ALBUQUERQUE STANDARD SPECIFICATIONS FOR PUBLIC WORKS CONSTRUCTION, 1984 EDITION, AS MODIFIED BY THE CONTRACT SPECIAL PROVISIONS AND SUPPLEMENTAL TECHNICAL SPECIFICATIONS EXCEPT THAT CONSTRUCTION ACTIVITIES ASSOCIATED WITH THE CONSTRUCTION/REHABILITATION OF THE BRIDGE SHALL IN PART BE GOVERNED BY THE NEW MEXICO STATE HIGHWAY DEPARTMENT STANDARD SPECIFICATIONS FOR ROAD AND BRIDGE CONSTRUCTION, 1984 EDITION, AS LISTED BELOW. IN CASE A CONFLICT OCCURS BETWEEN SPECIFICATIONS, THE MORE STRINGENT SPECIFICATIONS SHALL APPLY. BRIDGE WORK ASSOCIATED WITH THE COMPLETION OF THE ITEMS LISTED BELOW SHALL BE PERFORMED IN ACCORDANCE WITH THE CORRESPONDING SECTIONS OF THE NEW MEXICO STATE HIGHWAY AND TRANSPORTATION DEPARTMENT STANDARD SPECIFICATIONS FOR ROAD AND BRIDGE CONSTRUCTION, 1984 EDITION, AND THE SUPPLEMENTAL TECHNICAL SPECIFICATIONS.

ITEM NO.

GOVERNING NMSHTD STANDARD SPECIFICATIONS/SUPPLEMENTAL TECHNICAL SPECIFICATIONS

202001

SECTION 202 REMOVAL OF STRUCTURES AND OBSTRUCTIONS

451045

S.T.S. CONCRETE REMOVAL & REPAIRS

504010, 504015& 504016

SECTION 504.01 THRU 504.03 STEEL REINFORCEMENT (INCIDENTAL TO CONCRETE)

509050

SECTION 503.03& & 503.03& PORTLAND CEMENT CONCRETE SECTION 509.01 & 509.03 THRU 509.05 CONCRETE STRUCTURES S.T.S. PORTLAND CEMENT CONCRETE S.T.S. CONCRETE STRUCTURES

509904

S.T.S. SPECIAL SURFACE FINISH ON EXISTING CONCRETE

510090

S.T.S. REMOVE AND RESET BRIDGE RAILING

515005

S.T.S. ELASTOMERIC EXPANSION JOINT SEALS

516530

S.T.S. PENETRATING WATER REPELLANT TREATMENT

516545

S.T.S. PIER AND ABUTMENT REPAIR

516548

S.T.S. EPOXY INJECTION

INCIDENTAL

SECTION 509.037(e) SPECIAL SURFACE FINISH FOR NEW CONCRETE SURFACES

SECTION 615 PAINT S.T.S. PROTECTIVE COATING OF NEW STEEL BRIDGE RAILING AND MISCELLANEOUS STRUCTURAL STEEL, TYPE 2

NEW MEXICO STATE HIGHWAY DEPARTMENT STANDARD SPECIFICATIONS INCORPORATED HEREIN SHALL BE INTERPRETED USING THE FOLLOWING LIST. REFERENCES LISTED TO THE RIGHT ARE TO REPLACE THOSE ON THE LEFT WHERE THOSE ON THE LEFT APPEAR IN THE TEXT.

REFERENCE

REPLACE WITH

NEW MEXICO STATE HIGHWAY DEPARTMENT PROJECT MANAGER CHIEF HIGHWAY ADMINISTRATOR DEPARTMENT MATERIALS LABORATORY BUREAU BRIDGE ENGINEER STATE

- CITY OF ALBUQUERQUE - ENGINEER - PUBLIC WORKS DIRECTOR - CITY - CITY MATERIALS LAB - ENGINEER - CITY

2. CONCRETE FOR STRUCTURAL CAST-IN-PLACE CONCRETE: ALL CONCRETE SHALL CONFORM TO CITY OF ALBUQUERQUE STANDARD SPECIFICATIONS FOR PUBLIC WORKS CONSTRUCTION AS MODIFIED IN THE SUPPLEMENTAL TECHNICAL SPECIFICATIONS. CHAMFER ALL EXPOSED EDGES 3/4 IN" UNLESS NOTED OTHERWISE ON DETAILS.

3. REINFORCING BARS SHALL CONFORM TO A.A.S.H.T.O. SPECIFICATION M-31, GRADE 60-UNLESS NOTED OTHERWISE ON THE DETAILS. DIMENSIONS REFER TO CENTERLINE OF BARS UNLESS NOTED OTHERWISE ON THE DETAILS.

4. BRIDGE SEATS: AFTER COMPLETION OF THE RIGID FRAME REPLACEMENT, ABUTMENT NO. 2 BACKWALL REPAIR AND OTHER MISCELLANEOUS REPAIRS, TOP SURFACE OF ALL BRIDGE SEATS SHALL BE THOROUGHLY CLEANED OF ALL DIRT, CONCRETE AND OTHER DEPOSITED MATERIAL.

5. SPECIAL FINISH FOR CONCRETE SURFACES: THE OUTSIDE FACE OF NEW CURB AND SIDEWALK, SOFFIT OF THE SIDEWALK SLAB, EXPOSED SURFACES OF THE RIGID FRAME REPLACEMENT, RETAINING WALLS, ABUTMENT NO. 2 BACKWALL REPAIR AND ALL EXISTING SURFACES CONTAINING THE SPECIAL FINISH THAT ARE REMOVED DURING THE REPAIR PROCESS, SHALL RECEIVE A SPECIAL SURFACE FINISH IN ACCORDANCE WITH THE REQUIREMENTS OF SECTION 509.037 (e) FOR NEW SURFACES AND IN ACCORDANCE WITH THE SUPPLEMENTAL TECHNICAL SPECIFICATION - SPECIAL SURFACE FINISH ON EXISTING SURFACES. THE BASIC COLOR OF THE FINISH TO BE FLAGSTONE BROWN, ADJUSTED AS NECESSARY TO MATCH THE COLOR OF THE EXISTING FINISH. TRIAL COLOR SAMPLES ARE TO BE PREPARED AND APPROVED BY THE ENGINEER PRIOR TO APPLICATION OF THE FINISH.

6. JOINT FILLERS: ALL PREFORMED BITUMINOUS JOINT FILLER SHALL CONFORM TO A.A.S.H.T.O. SPECIFICATION M-213. COST OF ALL JOINT FILLER IN PLACE IS INCIDENTAL TO THE COMPLETION OF THE WORK AND NO DIRECT PAYMENT WILL BE MADE THEREFOR.

7. VERIFICATION OF EXISTING STRUCTURE: CONTRACTOR SHALL VERIFY IN THE FIELD, ALL DIMENSIONS, ELEVATIONS AND DETAILS PERTAINING TO THE EXISTING STRUCTURE WHICH WILL BE INVOLVED IN THE NEW CONSTRUCTION AND NOTIFY THE ENGINEER OF ANY DISCREPANCIES BEFORE PROCEEDING WITH THE WORK.

8. PAINT: ALL EXISTING CURB AND SIDEWALK PLATES AND THOSE AREAS THAT ARE PEELING ON THE STEEL BEAMS IN SPAN NO. 17 SHALL BE CLEANED AND REPAINTED IN CONFORMANCE WITH THE REQUIREMENTS OF THE SUPPLEMENTAL TECHNICAL SPECIFICATION FOR PROTECTIVE COATING OF NEW STEEL RAILING AND MISCELLANEOUS STRUCTURAL STEEL, TYPE 2. COST OF CLEANING AND REPAINTING IS INCIDENTAL TO THE COMPLETION OF THE WORK AND NO DIRECT PAYMENT WILL BE MADE THEREFOR.

9. CARE SHALL BE TAKEN DURING ALL REMOVAL OPERATIONS TO PREVENT DAMAGE TO PORTIONS OF THE STRUCTURES THAT ARE TO REMAIN IN PLACE. COMPACTED FILL UNDER PORTIONS OF SIDEWALK, CURB & GUTTER, AND CONCRETE PAVEMENT THAT IS TO REMAIN MUST NOT BE DISTURBED. ANY DAMAGE TO MEMBERS BEING RETAINED, CAUSED BY THE CONTRACTOR'S OPERATIONS SHALL BE SATISFACTORILY REPAIRED AT NO COST TO THE OWNER.

10. ANY EXISTING REINFORCING BARS THAT ARE NOTED OR DETAILED TO REMAIN IN NEW CONSTRUCTION SHALL BE CLEANED OF ALL LOOSE RUST, DIRT, CONCRETE, OR OTHER MATERIAL THAT WOULD INHIBIT BOND. COST OF SUCH CLEANING SHALL BE CONSIDERED INCIDENTAL TO THE WORK AND NO DIRECT PAYMENT SHALL BE MADE THEREFOR.

(GENERAL NOTES CONTINUED)

11. EXISTING CRACKED AND DETERIORATED CURBS AND SIDEWALKS AT EXPANSION JOINTS SHALL BE REPAIRED BY EPOXY INJECTION AS DIRECTED BY THE ENGINEER. AT THOSE LOCATIONS WHERE DETERIORATION HAS PROGRESSED TO THE EXTENT THAT EPOXY INJECTION IS NOT FEASIBLE, THE DETERIORATED AREAS SHALL BE REPAIRED BY REMOVING AND REPLACING UNSOUND CONCRETE WITH NEW MATERIAL. SUCH REPAIRS SHALL BE PERFORMED AND PAID FOR AS, "PIER AND ABUTMENT REPAIR."

12. ALL NEW APPROACH PAVEMENT SLAB JOINTS SHALL BE SEALED AND ALL EXISTING JOINTS TO REMAIN SHALL BE RESEALED IN ACCORDANCE WITH SECTION 107 OF THE STANDARD SPECIFICATIONS. SEE SHEET 14 FOR SILICONE SEALANT DETAIL.

13. CAUTION DURING SIDEWALK AND CURB REMOVALS: ONE ELECTRICAL CONDUIT AND ONE FIRE ALARM CONDUIT ARE EMBEDDED IN BOTH THE SIDEWALK AND CURB. CONCRETE REMOVAL AND CONSTRUCTION OPERATIONS MUST BE PERFORMED IN SUCH A MANNER TO PREVENT DAMAGE OR DISRUPTION OF SERVICE PROVIDED BY THESE CONDUITS. CONDUITS SHALL BE CLEANED AND EMBEDDED IN THE NEW CONCRETE.

14. REMOVAL OF CONCRETE SIDEWALK AND CURB ON EAST APPROACH FOR INSTALLATION OF NEW 3/4" JOINTS SHALL BE ACCOMPLISHED IN ACCORDANCE WITH SUPPLEMENTAL TECHNICAL SPECIFICATIONS FOR CONCRETE REMOVAL AND REPAIR. COST OF REMOVAL, INCLUDING SAWCUTTING, HAULING, CLEANUP AND APPURTENANCES NECESSARY TO COMPLETE THE WORK SHALL BE INCLUDED IN THE UNIT PRICE BID FOR STRUCTURAL CONCRETE.

15. A PENETRATING WATER REPELLANT TREATMENT IS TO BE APPLIED TO THE FOLLOWING CONCRETE SURFACES AFTER EPOXY INJECTION AND EXPANSION JOINT REPLACEMENT.
A. TOP OF DECK SLAB
B. TOP AND SLOPING FACE OF BRIDGE SIDEWALK AND CURB

16. CONCRETE PAVEMENT SPALL REPAIRS SHALL BE MADE IN ACCORDANCE WITH SUPPLEMENTAL TECHNICAL SPECIFICATIONS FOR CONCRETE REMOVAL AND REPAIRS.

17. THE AREAS SHOWN ON THE PHOTO SHEETS, WHICH REQUIRE REPAIR, WERE IDENTIFIED DURING FIELD INSPECTIONS MADE IN OCTOBER OF 1990. ESTIMATED QUANTITIES, BASED UPON THESE INSPECTIONS, WILL IN ALL PROBABILITY BE DIFFERENT AT THE TIME OF ACTUAL CONSTRUCTION.

DESIGN DATA

DESIGN IS IN ACCORDANCE WITH A.A.S.H.T.O. SPECIFICATIONS, DATED 1989 AND INTERIM SPECIFICATIONS.

REINFORCED CONCRETE:
fc = 4000 PSI @ 28 DAYS
fc = 1600 PSI, fs = 24,000 PSI

EARTH PRESSURE:
36 p.c.f. EQUIVALENT FLUID PRESSURE. 2 FT. SURCHARGE

BRIDGE STRUCTURE

ESTIMATED QUANTITIES

ITEM NO.	ITEM	UNIT	SUPER-STRUCTURE	RIGID FRAME REPLACEMENT	SUB-STRUCTURE	APPROACHES	TOTAL
202001	REMOVAL OF STRUCTURES & OBSTRUCTIONS	L.S.					L.S.
451045	CONCRETE PAVEMENT SPALL REPAIR	S.Y.				4	4
452020	SEALING CONCRETE PAVEMENT JOINTS	L.F.				1,585	1,585
452025	RESEALING CONCRETE PAVEMENT JOINTS	L.F.				1,430	1,430
504010	REINFORCING BARS, GRADE 40	LB.		470	50		520
504015	REINFORCING BARS, GRADE 60	LB.		9,160	160	320	9,640
504016	REPLACEMENT OF REINFORCING BARS, GRADE 60	LB.				680	680
509050	STRUCTURAL CONCRETE	C.Y.		98	1	6	105
509904	SPECIAL SURFACE FINISH ON EXISTING CONCRETE	S.F.			100		100
510090	REMOVE AND RESET BRIDGE RAILING	L.F.	80				80
515005	ELASTOMERIC EXPANSION JOINT SEAL	L.F.	857				857
516530	PENETRATING WATER REPELLANT TREATMENT	S.Y.	5,592				5,592
516545	PIER AND ABUTMENT REPAIR	S.F.	60		160		220
516548	EPOXY INJECTION	GAL.	3		3		6
0205.01	FILL, BORROW, HAUL & COMPACTION	C.Y.		420			420
0337.04	CONCRETE PAVEMENT - 8" THICK w/FLY ASH, COMPLETE IN PLACE	S.Y.		178		538	716
0343.05	EXISTING PAVEMENT, CONCRETE, MORE THAN 4" SAW CUT, REMOVE & DISPOSE, COMPLETE	S.Y.		85		538	623

THIS ITEM CONSISTS OF REMOVAL OF THE RIGID FRAME STRUCTURE, SIDEWALK AND CURB THAT MUST BE REMOVED IN CONJUNCTION WITH RIGID FRAME AND THE DESIGNATED PORTION OF ABUTMENT NO. 2 BACKWALL AND ADJACENT SIDEWALK. SEE DETAILS ON SHEET NO. 5.

* REINFORCING QUANTITIES SHOWN ARE FOR CONTRACTOR'S INFORMATION ONLY. COST FOR REINFORCING SHALL BE INCLUDED IN THE UNIT PRICE OF CONCRETE.

** QUANTITIES SHOWN FOR SEALING AND RESEALING CONCRETE PAVEMENT JOINTS ARE FOR CONTRACTOR'S INFORMATION ONLY. COST OF JOINT SEALING IS TO BE CONSIDERED INCIDENTAL AND NO DIRECT PAYMENT WILL BE MADE THEREFOR.

SUPPLEMENTAL TECHNICAL SPECIFICATIONS

PORTLAND CEMENT CONCRETE

CONCRETE STRUCTURES

ELASTOMERIC EXPANSION JOINT SEALS

PENETRATING WATER REPELLANT TREATMENT

SPECIAL SURFACE FINISH ON EXISTING CONCRETE

PROTECTIVE COATING OF NEW STEEL BRIDGE RAILING AND MISCELLANEOUS STRUCTURAL STEEL, TYPE 2 SECTION 615-B (11/1/90)

REMOVE AND RESET BRIDGE RAILING

PIER AND ABUTMENT REPAIR

CONCRETE REMOVAL AND REPAIRS (01/21/85)

EPOXY INJECTION (10/04/89)

DRAWINGS REQUIRED

SHT. NO.

2 GENERAL NOTES AND ESTIMATED QUANTITIES

3 LAYOUT PLAN

4 CONCRETE RIGID FRAME REPLACEMENT DETAILS

5 REPAIR DETAILS AT ABUTMENT NO. 2 & MISCELLANEOUS DETAILS

6 PHOTO SHEET NO. 1

7 PHOTO SHEET NO. 2

8 PHOTO SHEET NO. 3

9 REINFORCING BAR SCHEDULE

16 & 17 ELASTOMERIC EXPANSION JOINT SEALS FOR BRIDGES SERIAL BJS-001, & 003

18 STANDARD JOINT DETAILS SERIAL LJD-001

INCIDENTAL ITEMS

1. PREFORMED BITUMINOUS JOINT FILLER.

2. SPECIAL SURFACE FINISH FOR NEW CONCRETE SURFACES.

3. SAWCUTTING CONCRETE FOR REMOVAL OPERATIONS.

4. CLEANING EXISTING REINFORCING BARS FOR RETENTION IN NEW CONCRETE.

5. CLEANING AND REPAINTING ALL SIDEWALK AND CURB PLATES AND PEELING AREAS ON STEEL BEAMS IN SPAN NO. 17.

6. DRILLING AND EPOXYING REBARS.

7. SEALING AND RESEALING CONCRETE PAVEMENT JOINTS.

NOTE:

ITEMS LISTED ABOVE ARE ONLY A GENERAL DESCRIPTION OF THE REQUIRED WORK AND MATERIALS, AND MAY NOT BE COMPLETE.

THIS LIST DOES NOT INCLUDE ANY INCIDENTAL WORK OR MATERIAL REQUIRED BY SPECIAL PROVISIONS, SERIALS (STANDARD DETAILS) SUPPLEMENTAL SPECIFICATIONS OR THE STANDARD SPECIFICATIONS.

SCOPE OF WORK

COAL AVENUE OVERPASS AND APPROACHES

A. REMOVE RIGID FRAME STRUCTURE, REPLACE WITH RETAINING WALLS AND FILL. SEE SHEET 4.

B. REMOVE AND REPLACE ALL BRIDGE EXPANSION JOINTS (18 TOTAL). PAINT CURB AND SIDEWALK PLATES.

C. REMOVE AND REPLACE APPROACH PAVEMENT SLABS AND REPAIR PAVEMENT SPALLS AS DESIGNATED ON SHEET 3.

D. EPOXY INJECT CRACKS IN SUPERSTRUCTURE AND SUBSTRUCTURE. REPAIR CONCRETE SPALLS AND AREAS OF DELAMINATION. SEE PHOTO SHEETS 6 THROUGH 8.

E. REMOVE AND REPLACE NORTH END OF ABUTMENT NO. 2 BACKWALL. INSTALL NEW JOINTS IN SIDEWALK AND CURB EAST OF ABUTMENT NO. 2. SEE SHEET 5.

F. APPLY PENETRATING WATER REPELLANT TREATMENT TO AREAS DESIGNATED IN GENERAL NOTE 15.

26-4018.91 0296

AS BUILT INFORMATION

CONTRACTOR MOORE & CONAET CONTEL

WORKS BY MOORE & CONAET DATE 6/9/94

INSPECTIONS ACCEPTANCE BY C.O.A. DATE 9/1/95

VERIFICATION BY C.O.A. DATE 9/1/95

DESIGNED BY AVID ENG. DATE 10/1/95

DRAWN BY H. Smith

RECORDED BY DATE

NO.

BENCH MARKS

NE Corner Lead & Third Streets

B.M. 3-K14 Elev. 4050.564

SW Corner Lead & Broadway

B.M. 5-K14A Elev. 4965.213

SURVEY INFORMATION

FIELD NOTES

NO.

DATE

BY

ENGINEER'S SEAL

BY

REMARKS

DESIGN

NO.

DATE

DESIGNED BY D. Spring

DATE 8/91

DRAWN BY H. Smith

DATE 8/91

CHECKED BY DATE 5/92

CITY OF ALBUQUERQUE
PUBLIC WORKS DEPARTMENT
ENGINEERING GROUP


TITLE: COAL AVENUE OVERPASS REHABILITATION
GENERAL NOTES & ESTIMATED QUANTITIES



APPROVALS	ENGINEER	DATE	APPROVALS	ENGINEER	DATE
DRC CHAIRMAN	R. Smith	10-9-92	WATER	H. Smith	4-22-92
TRANSPORTATION	D. Smith	6-17-92	WASTE WATER	H. Smith	"
HYDROLOGY	J. Smith	4-22-92			

PROJECT NO. 4018.91

MAP NO. K-14N

SHEET 2 OF 26





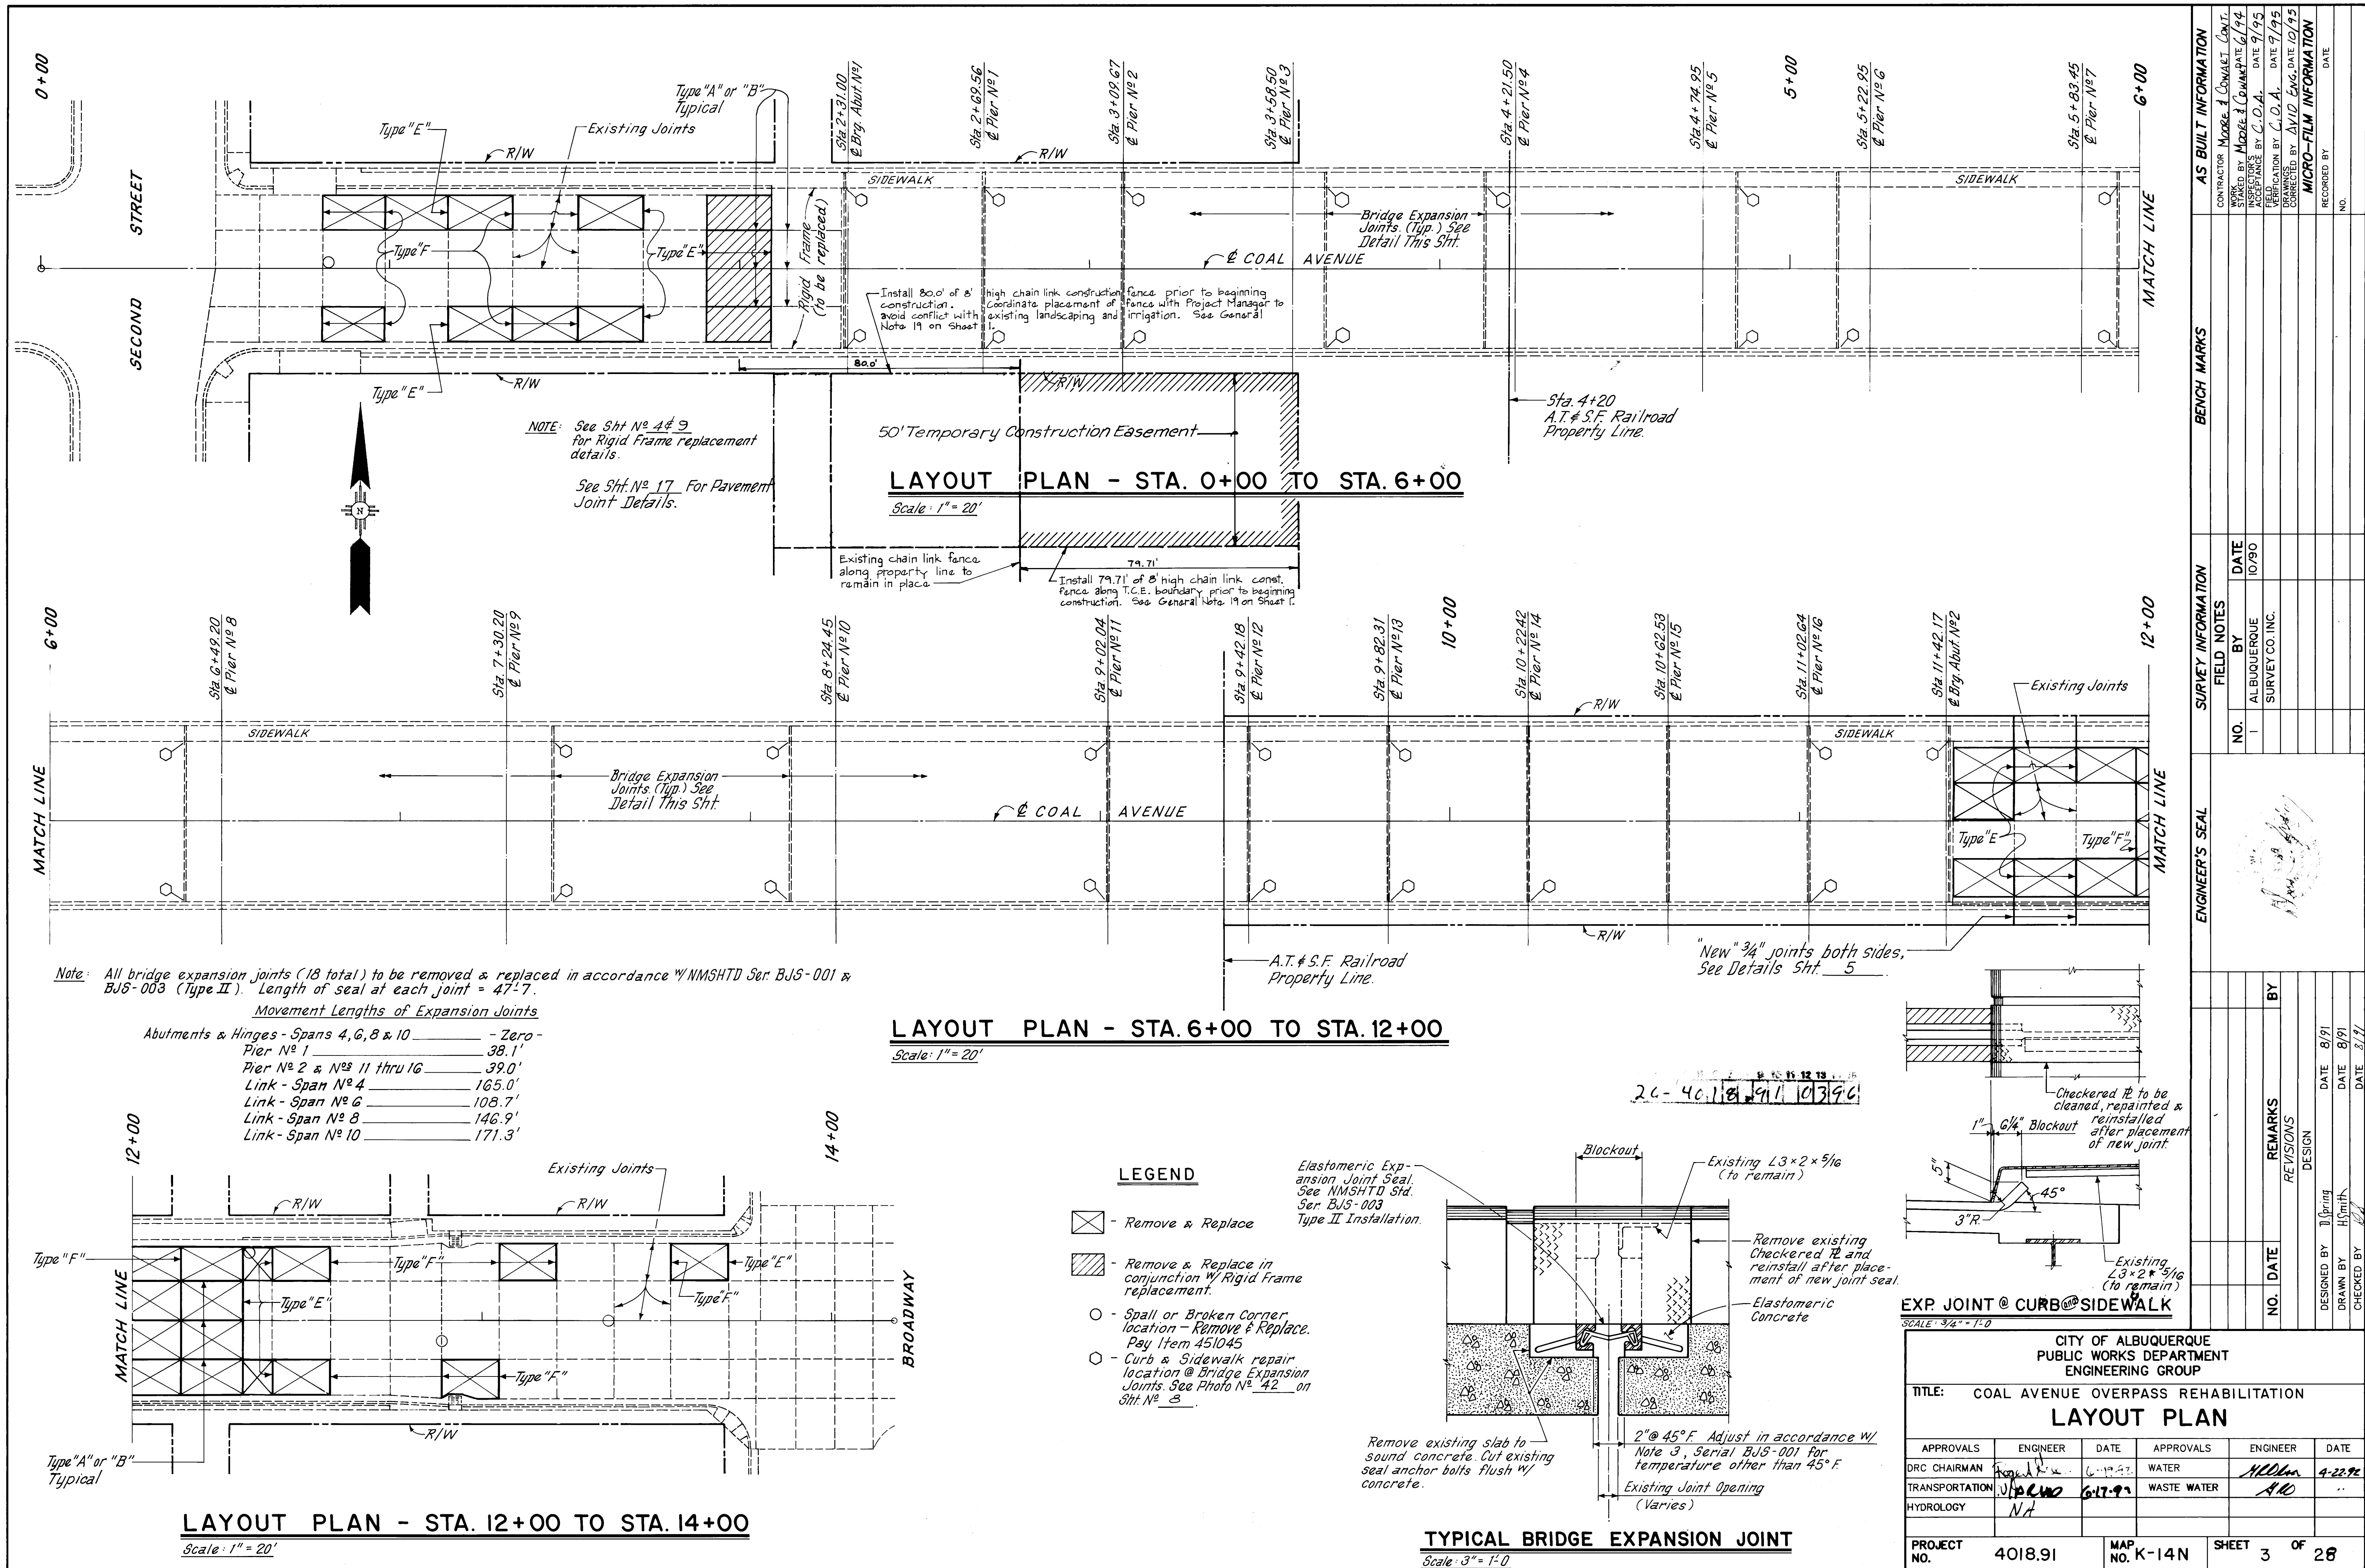


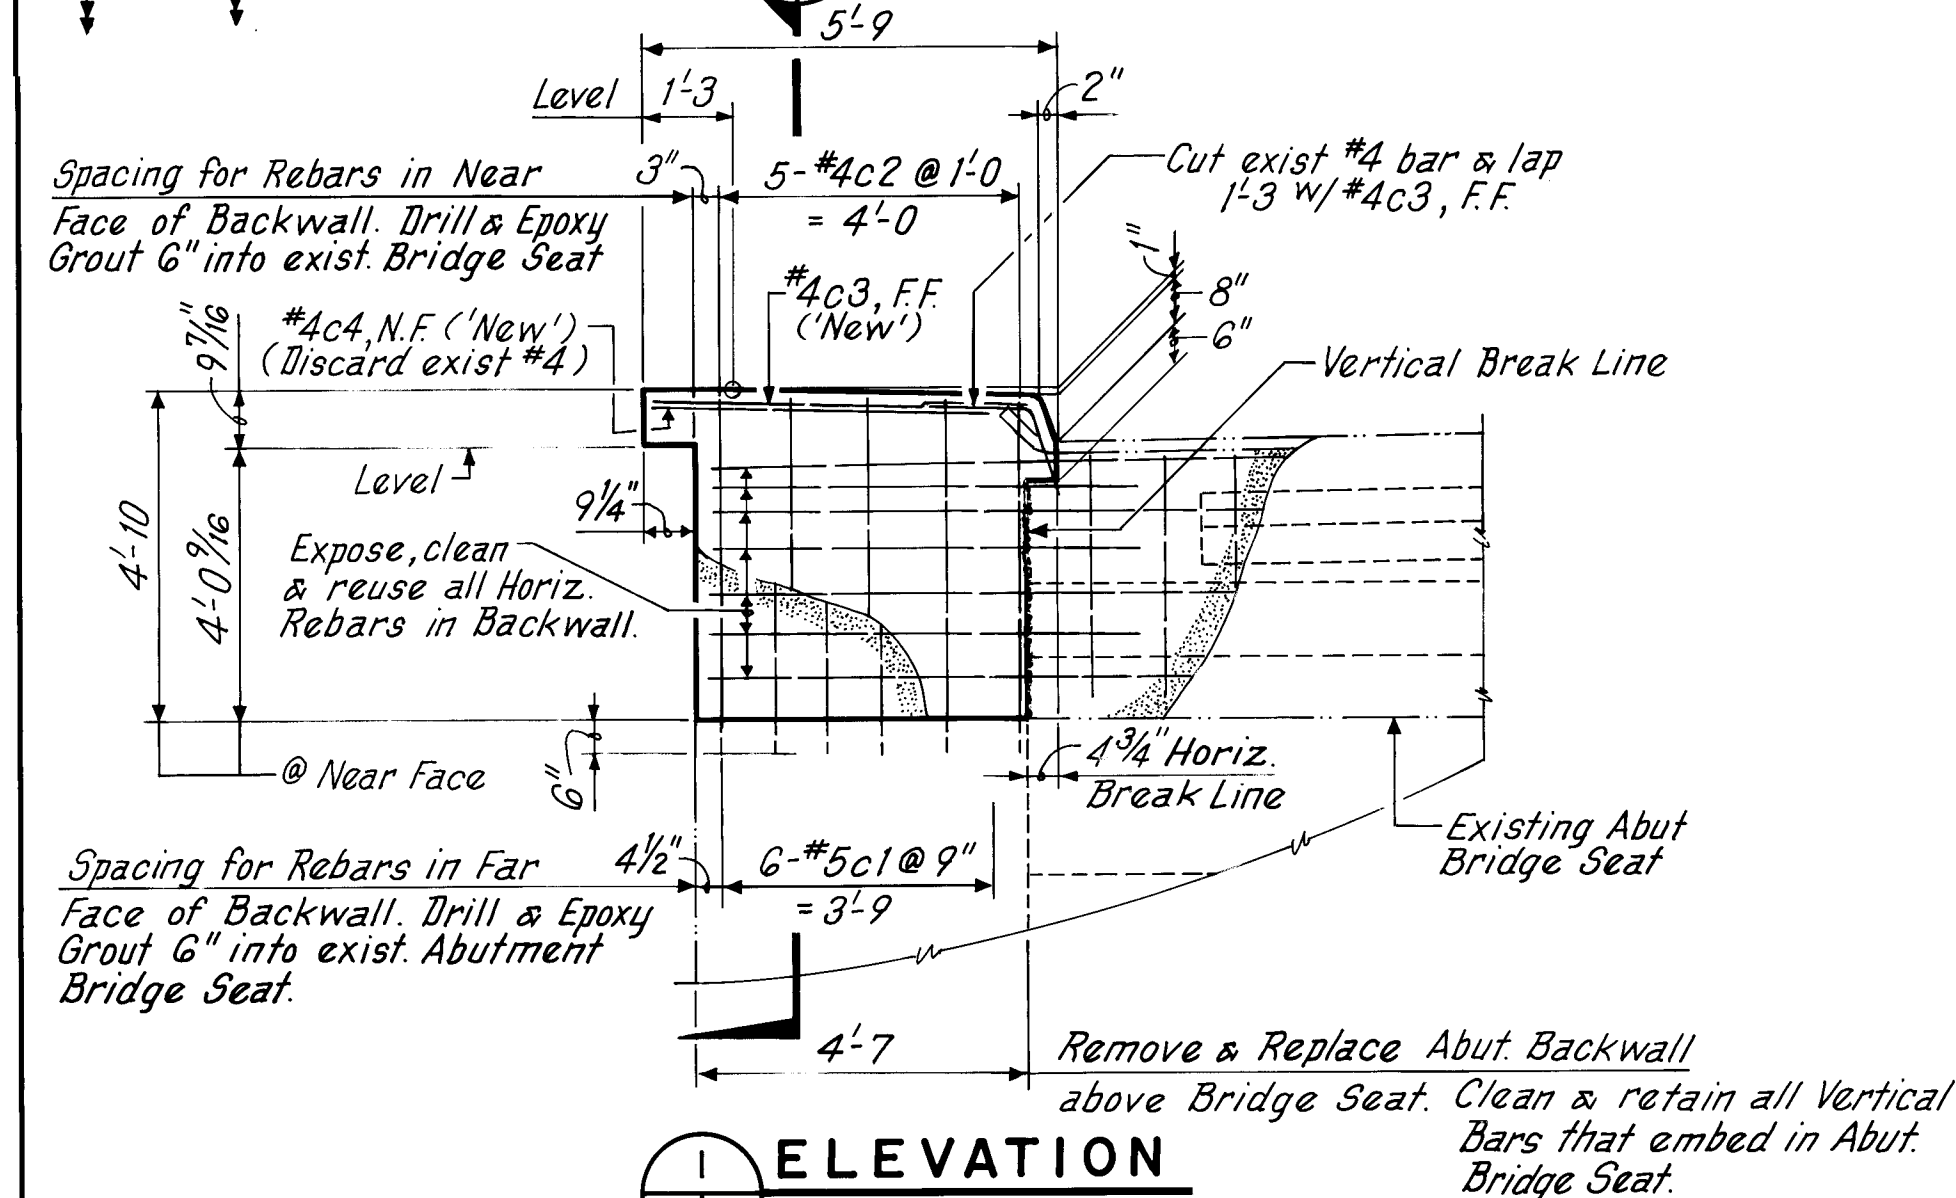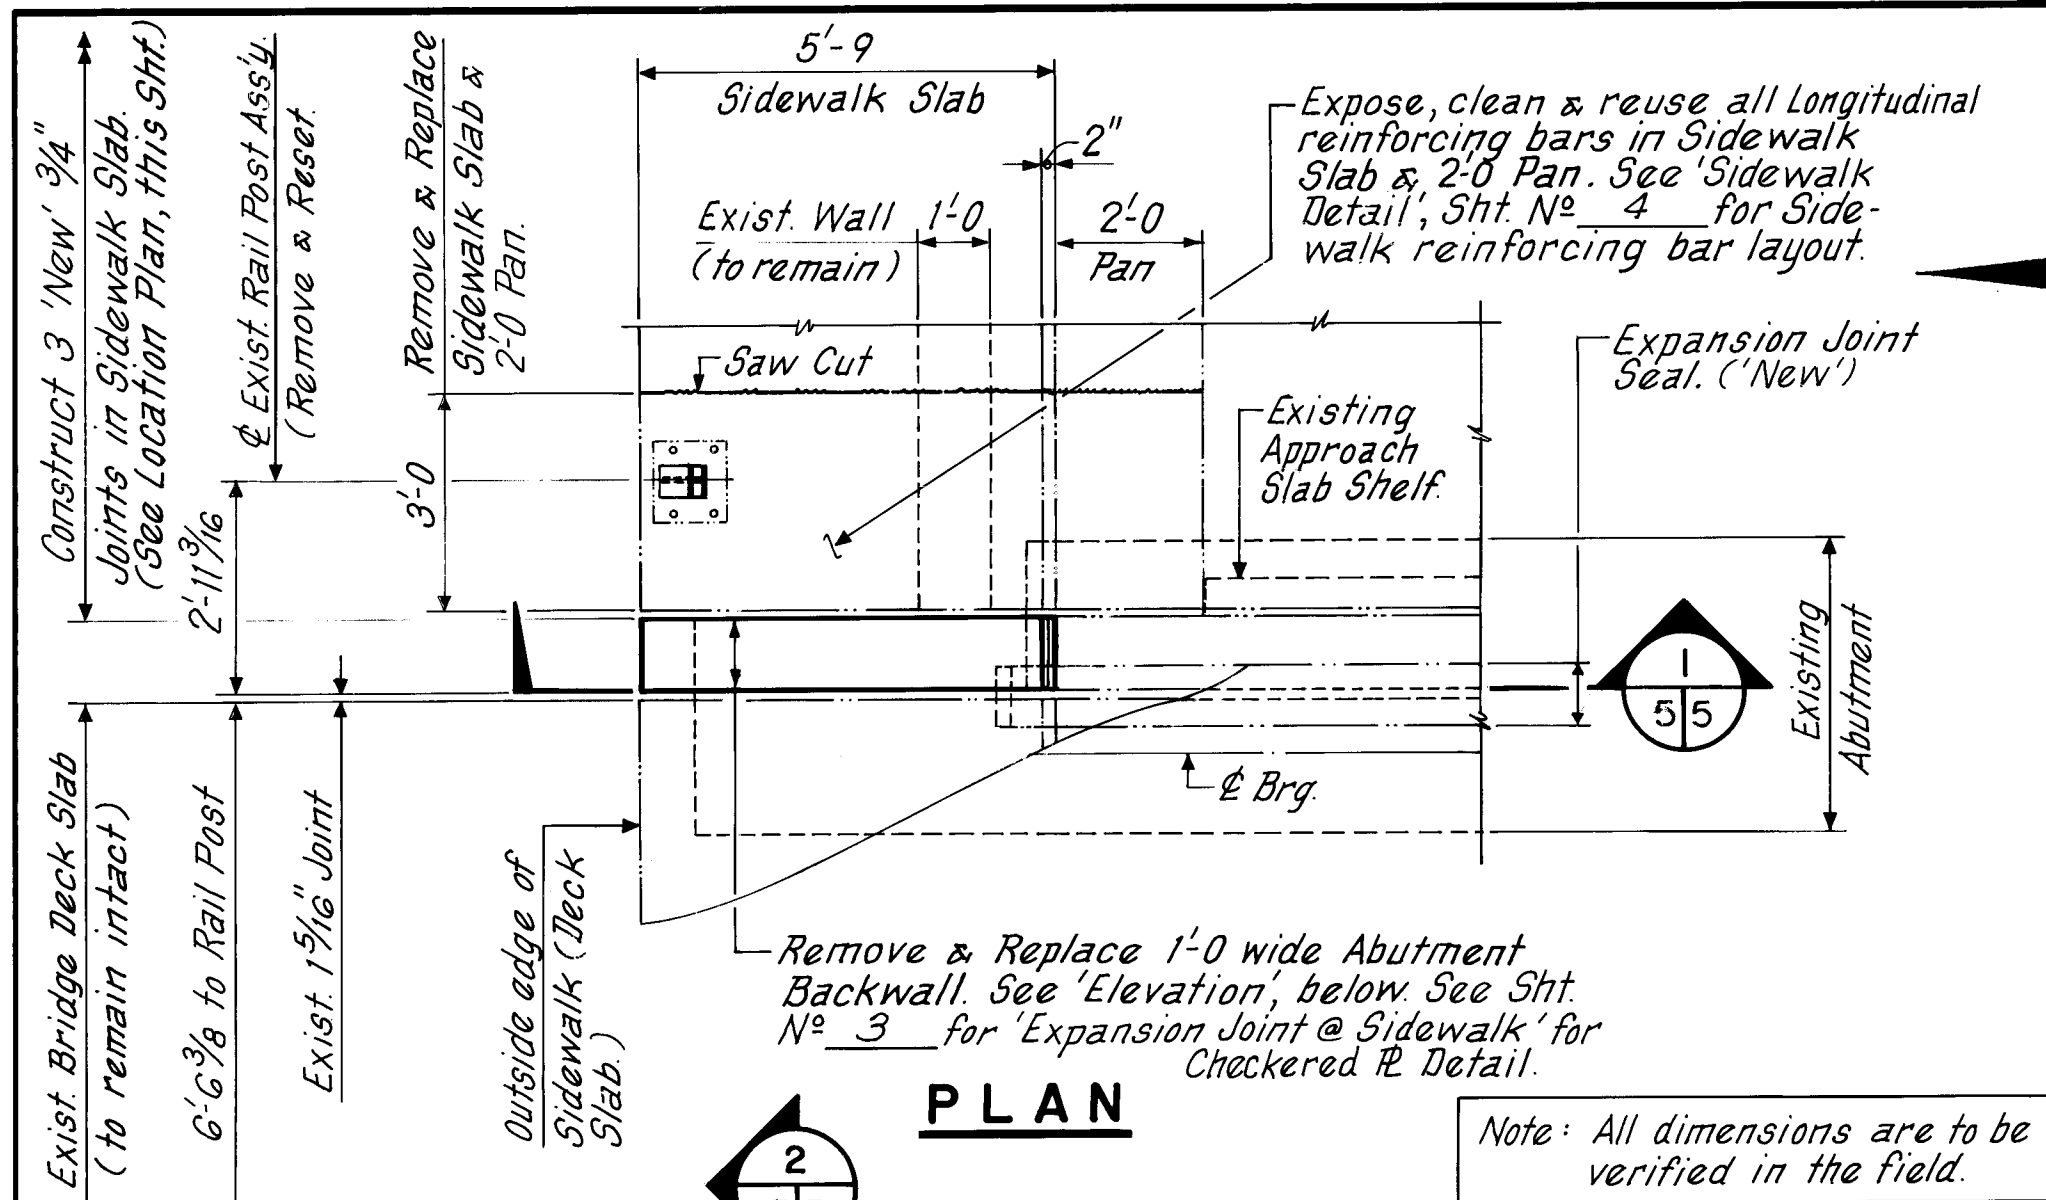

BACKWALL REPAIR DETAILS @ ABUTMENT N° 2

Scale: 3/8" = 1'-0"

(NORTH SIDE, ONLY.)

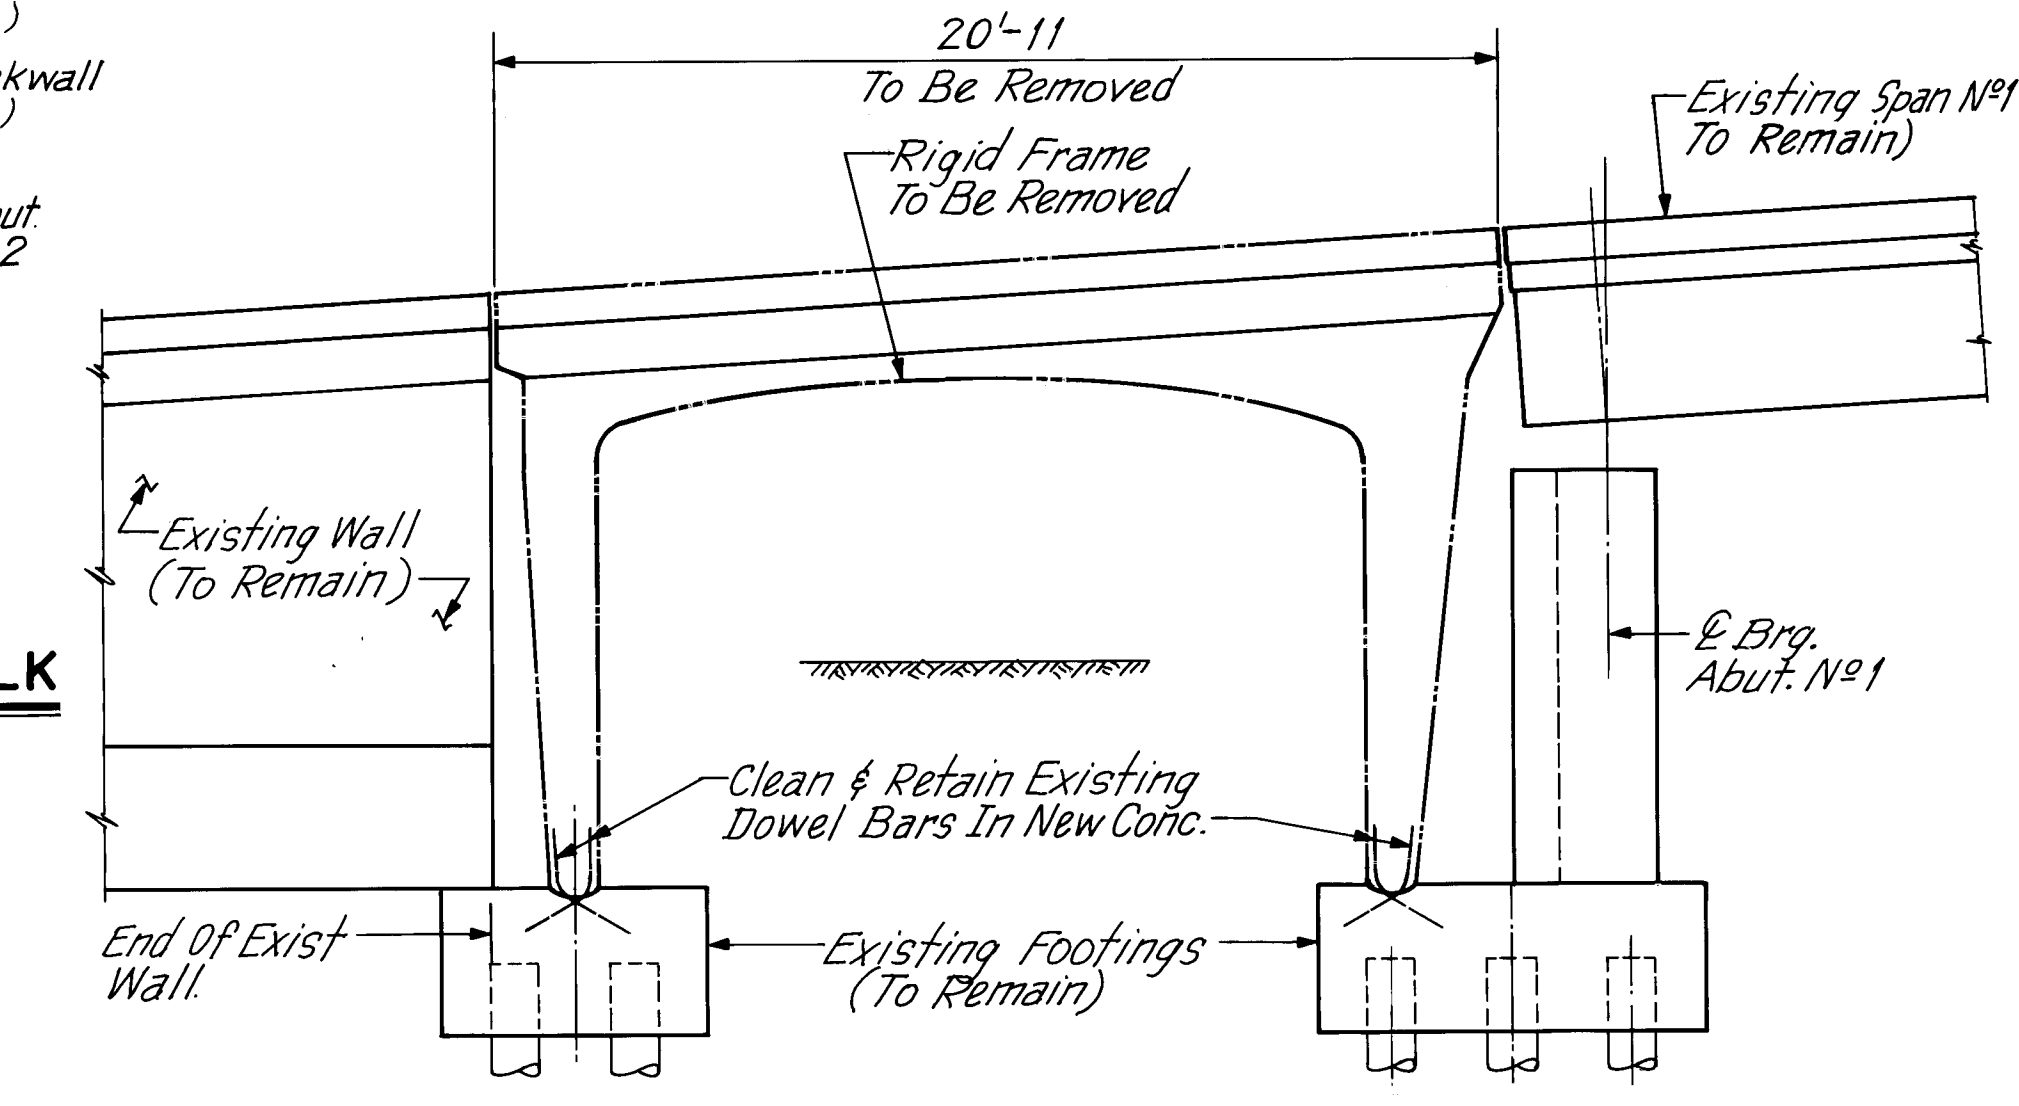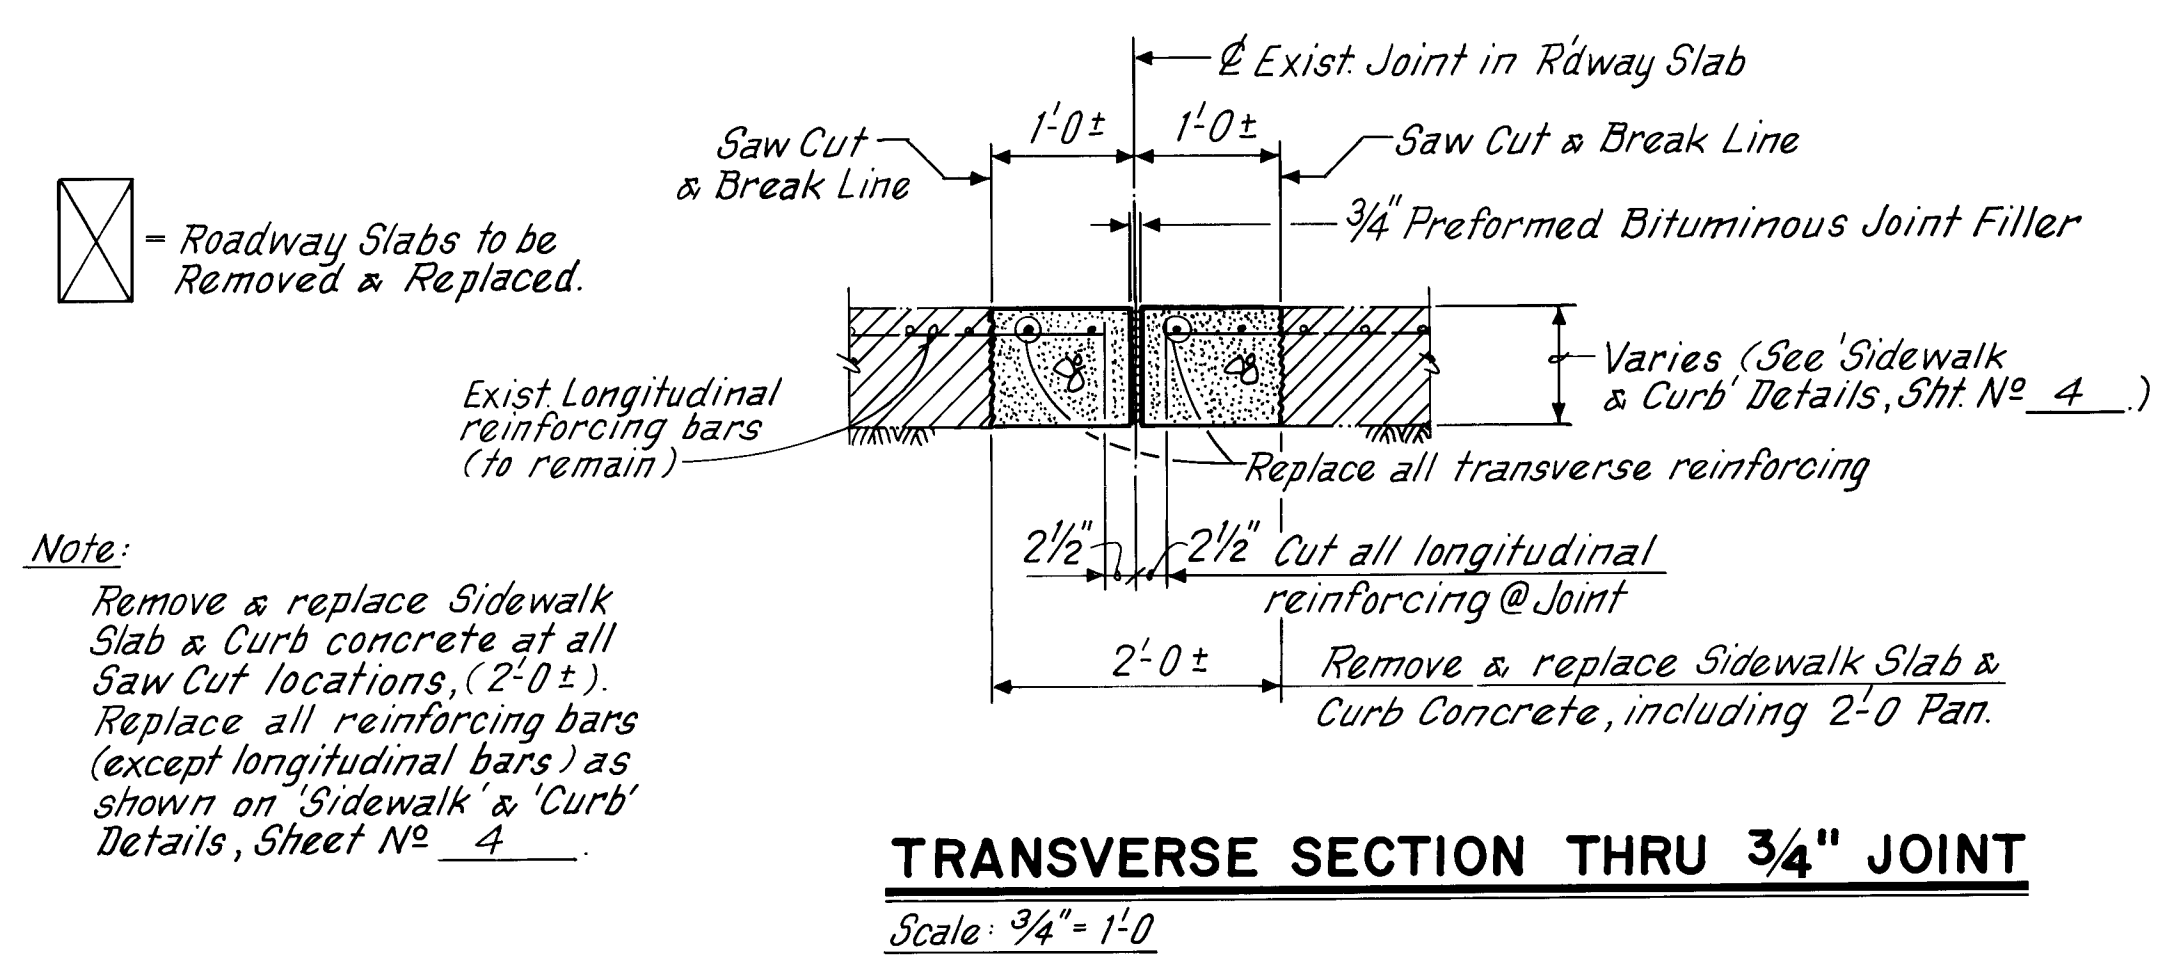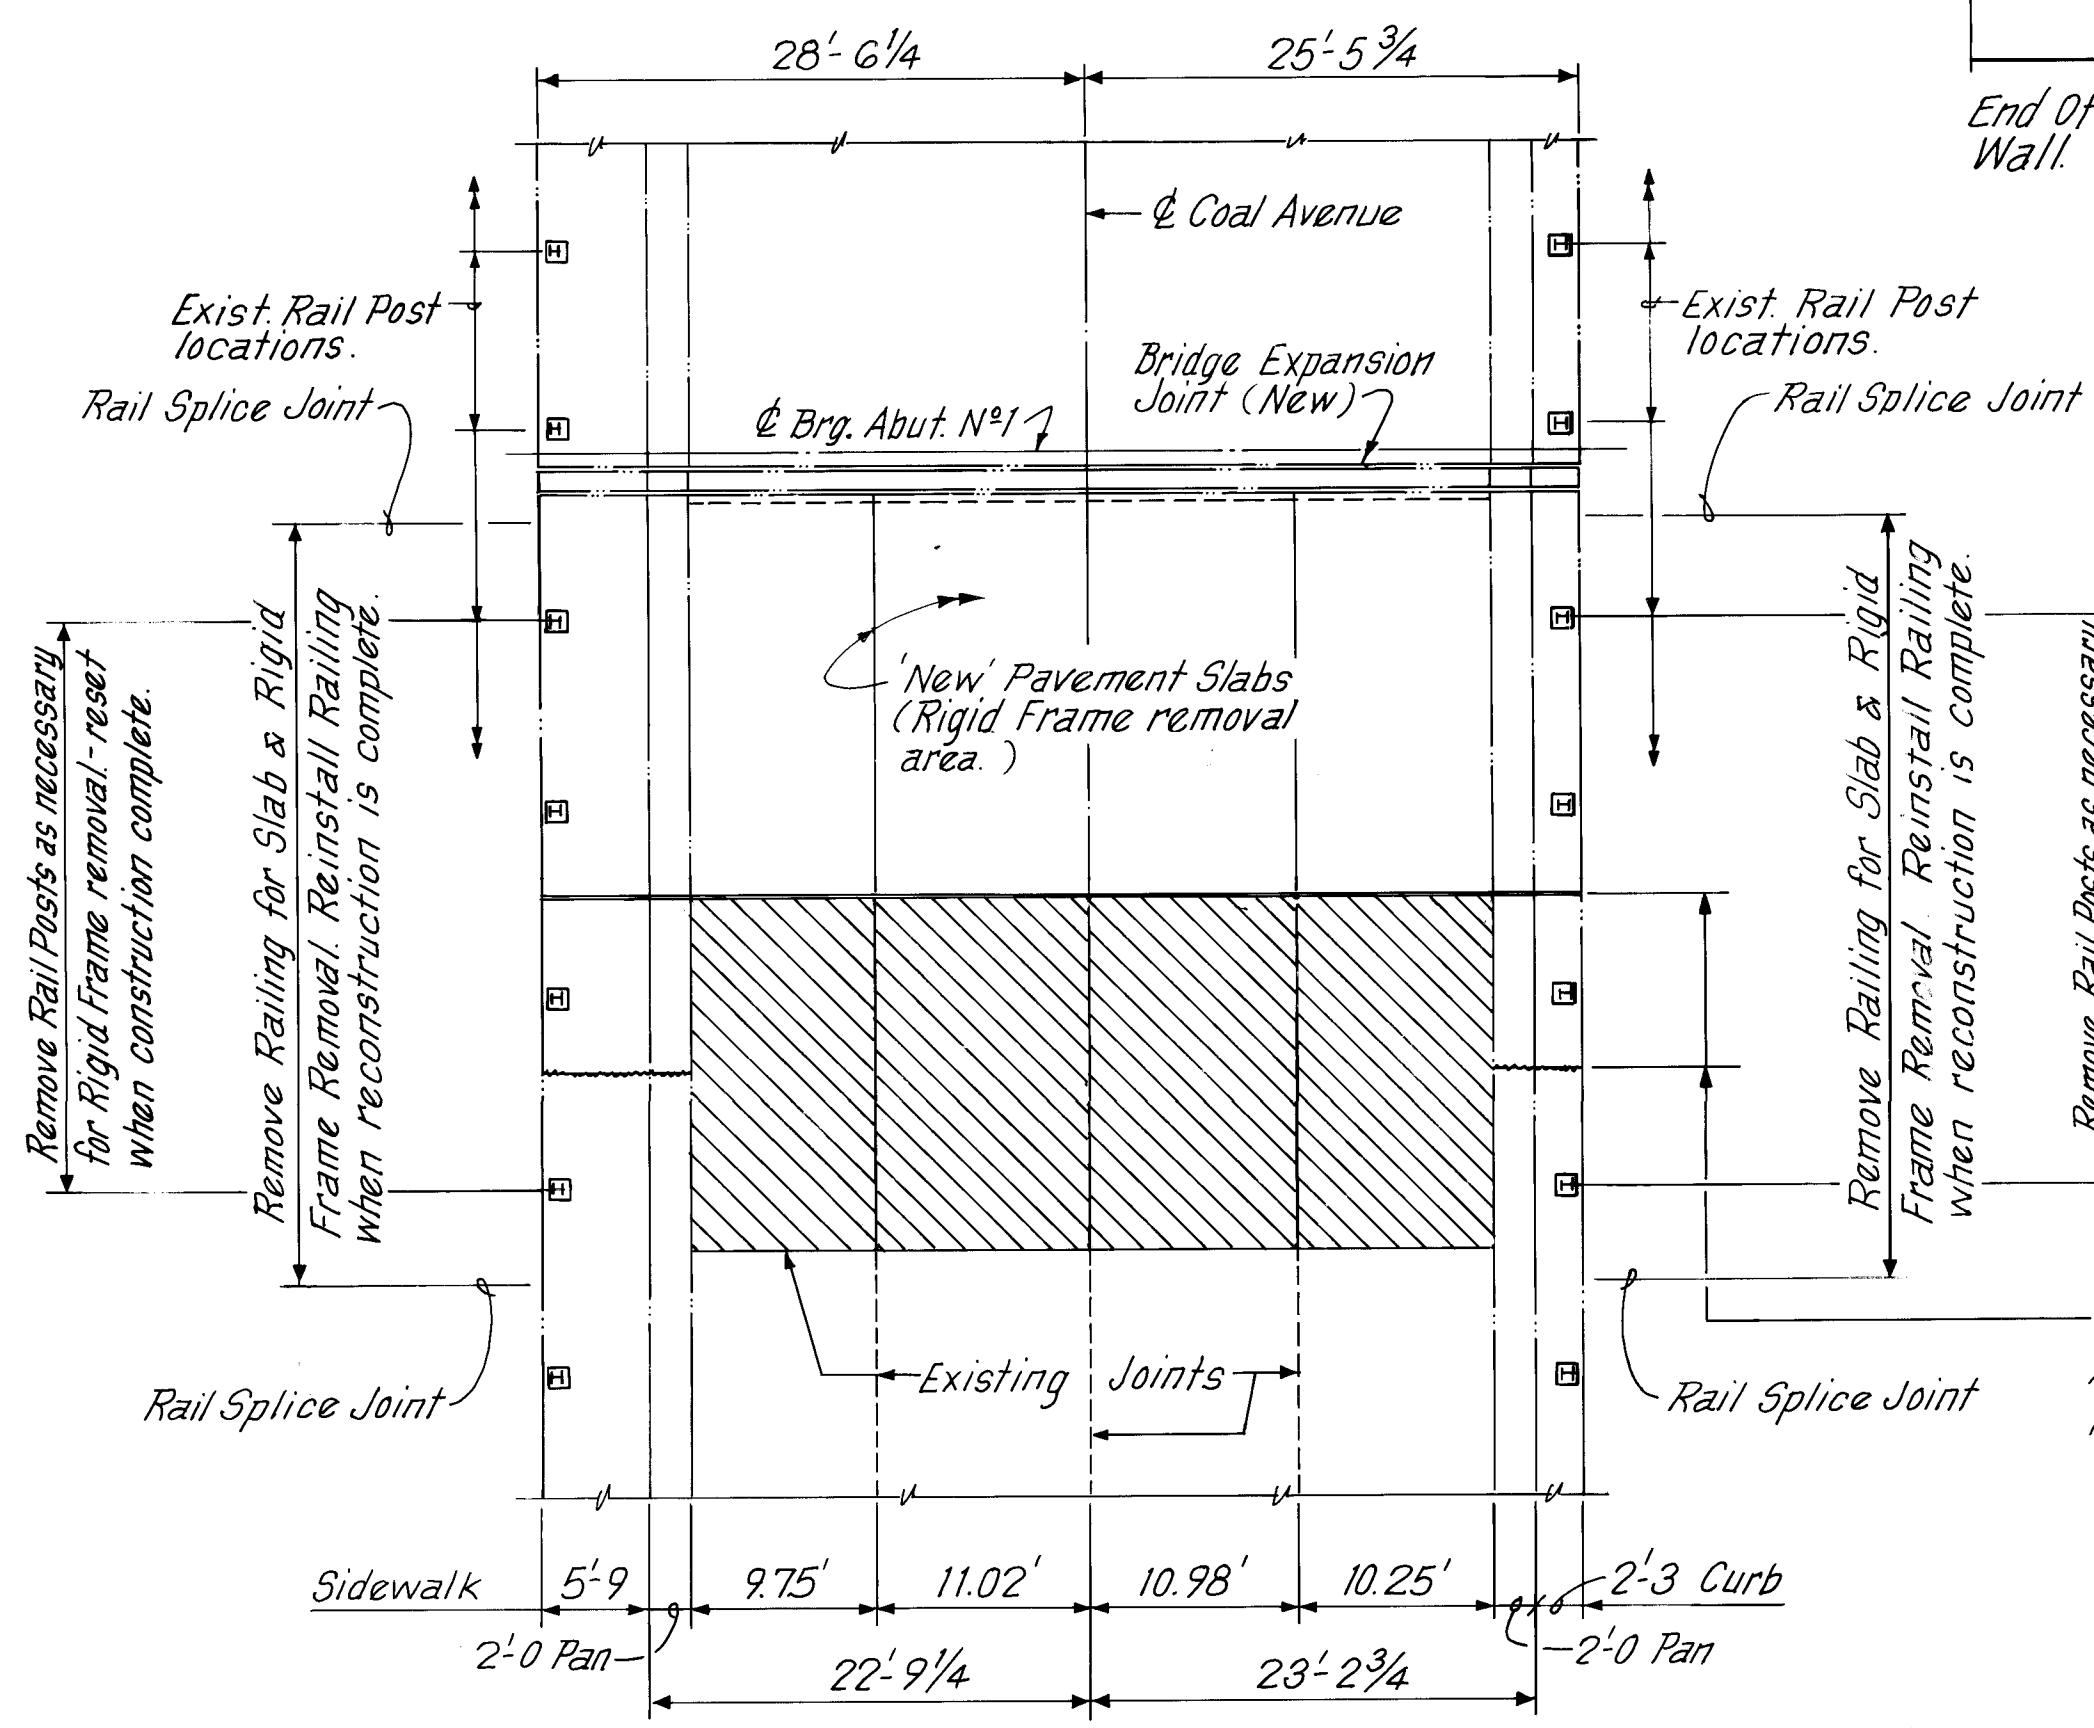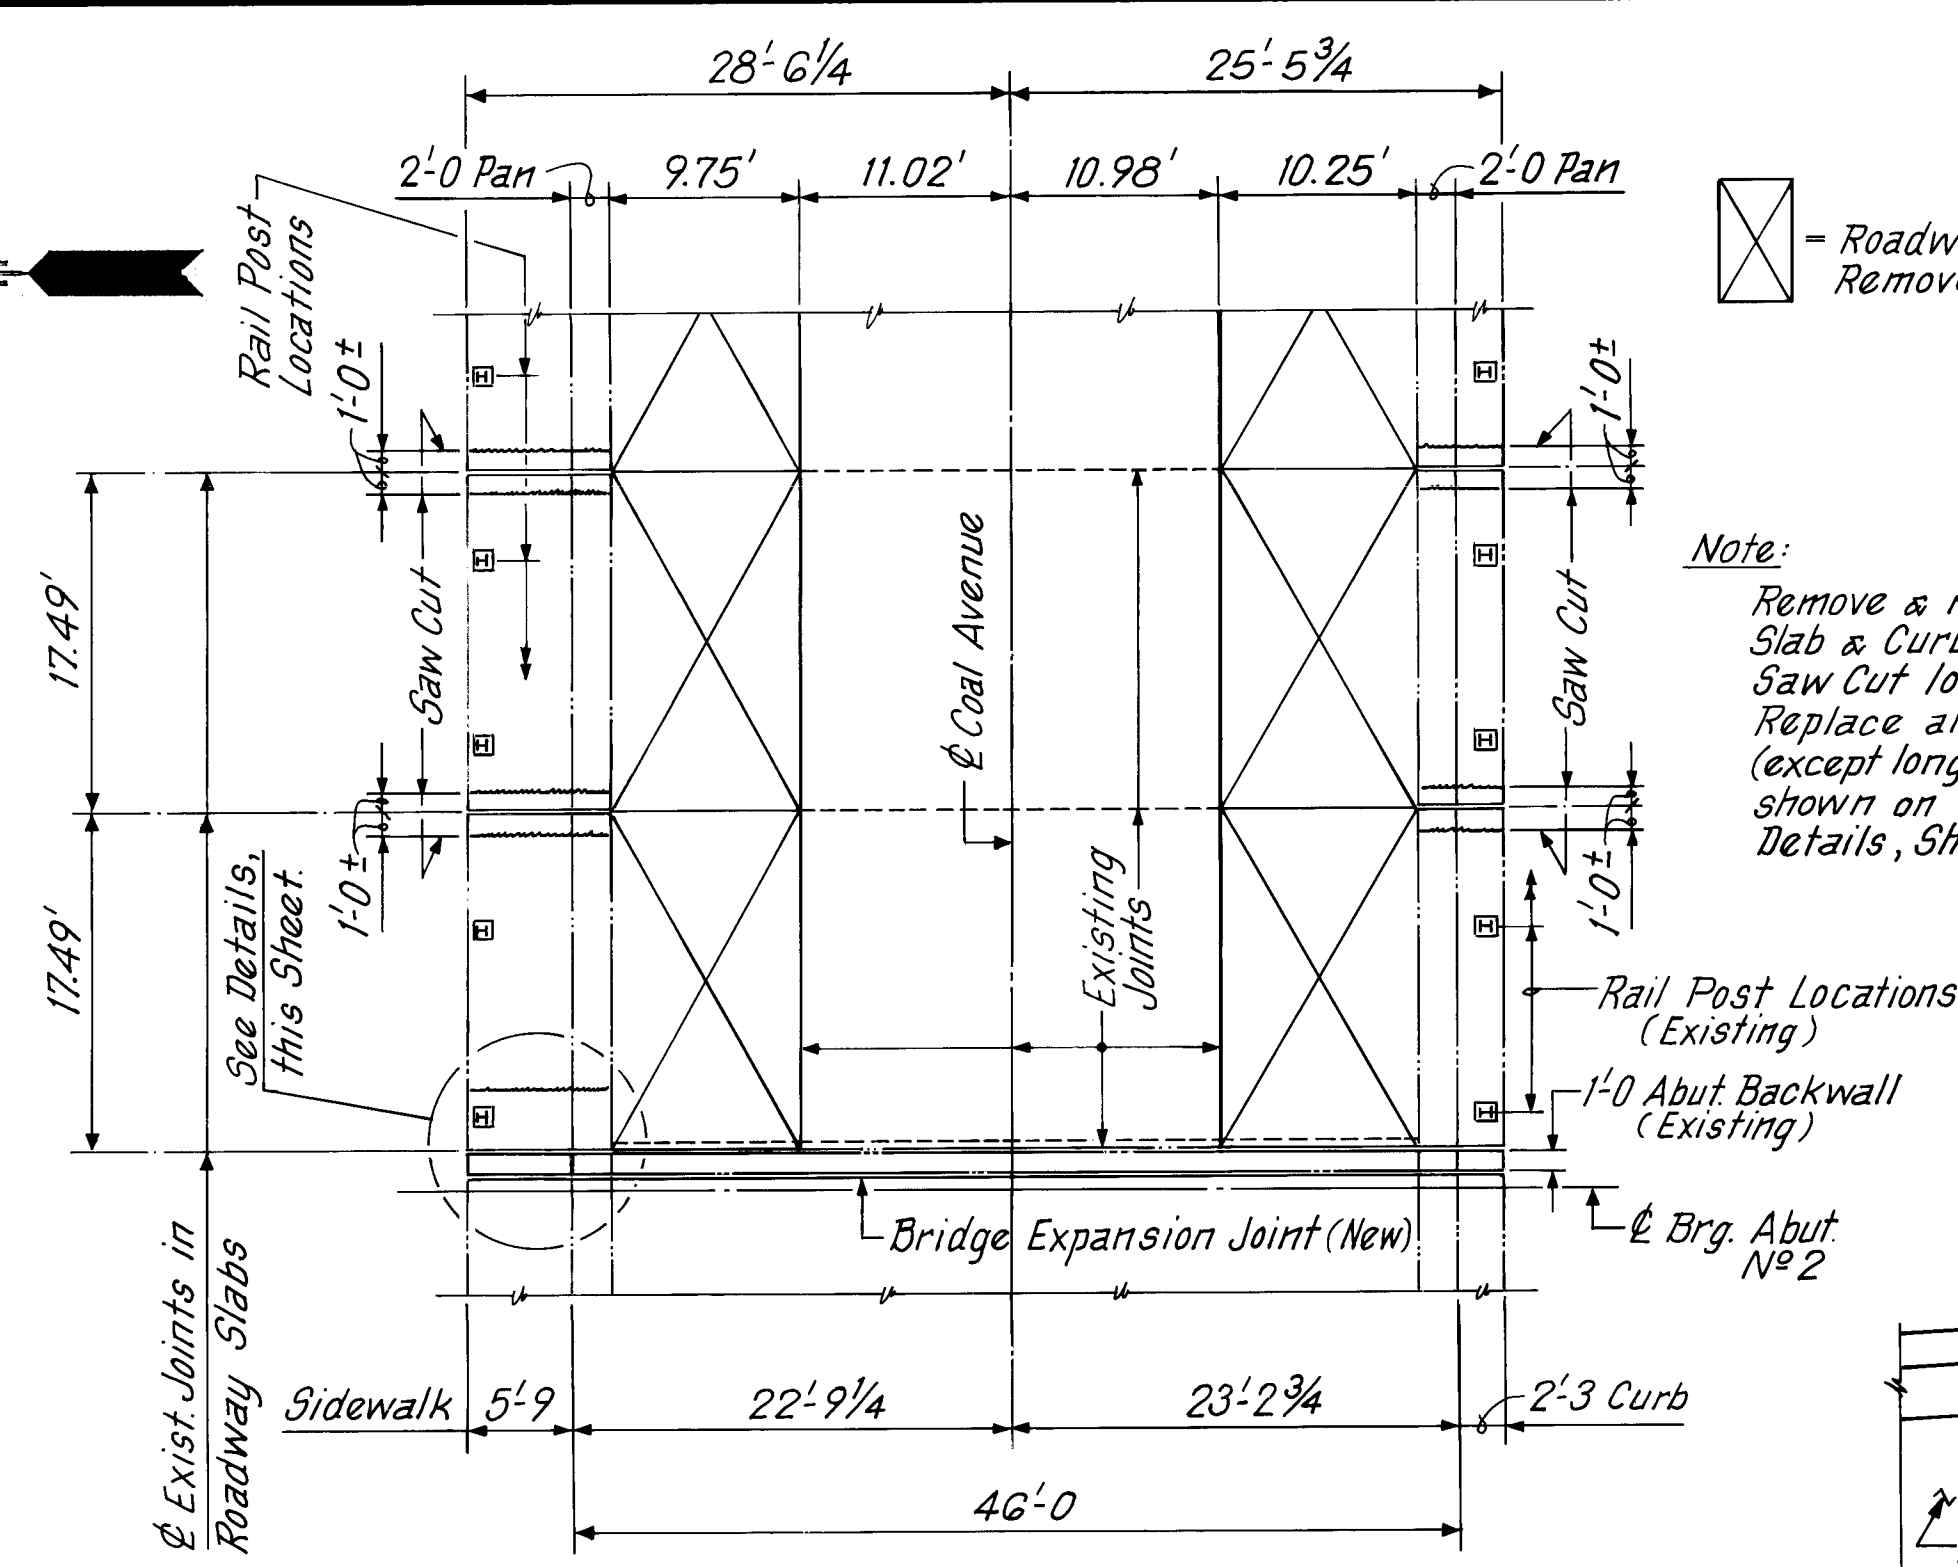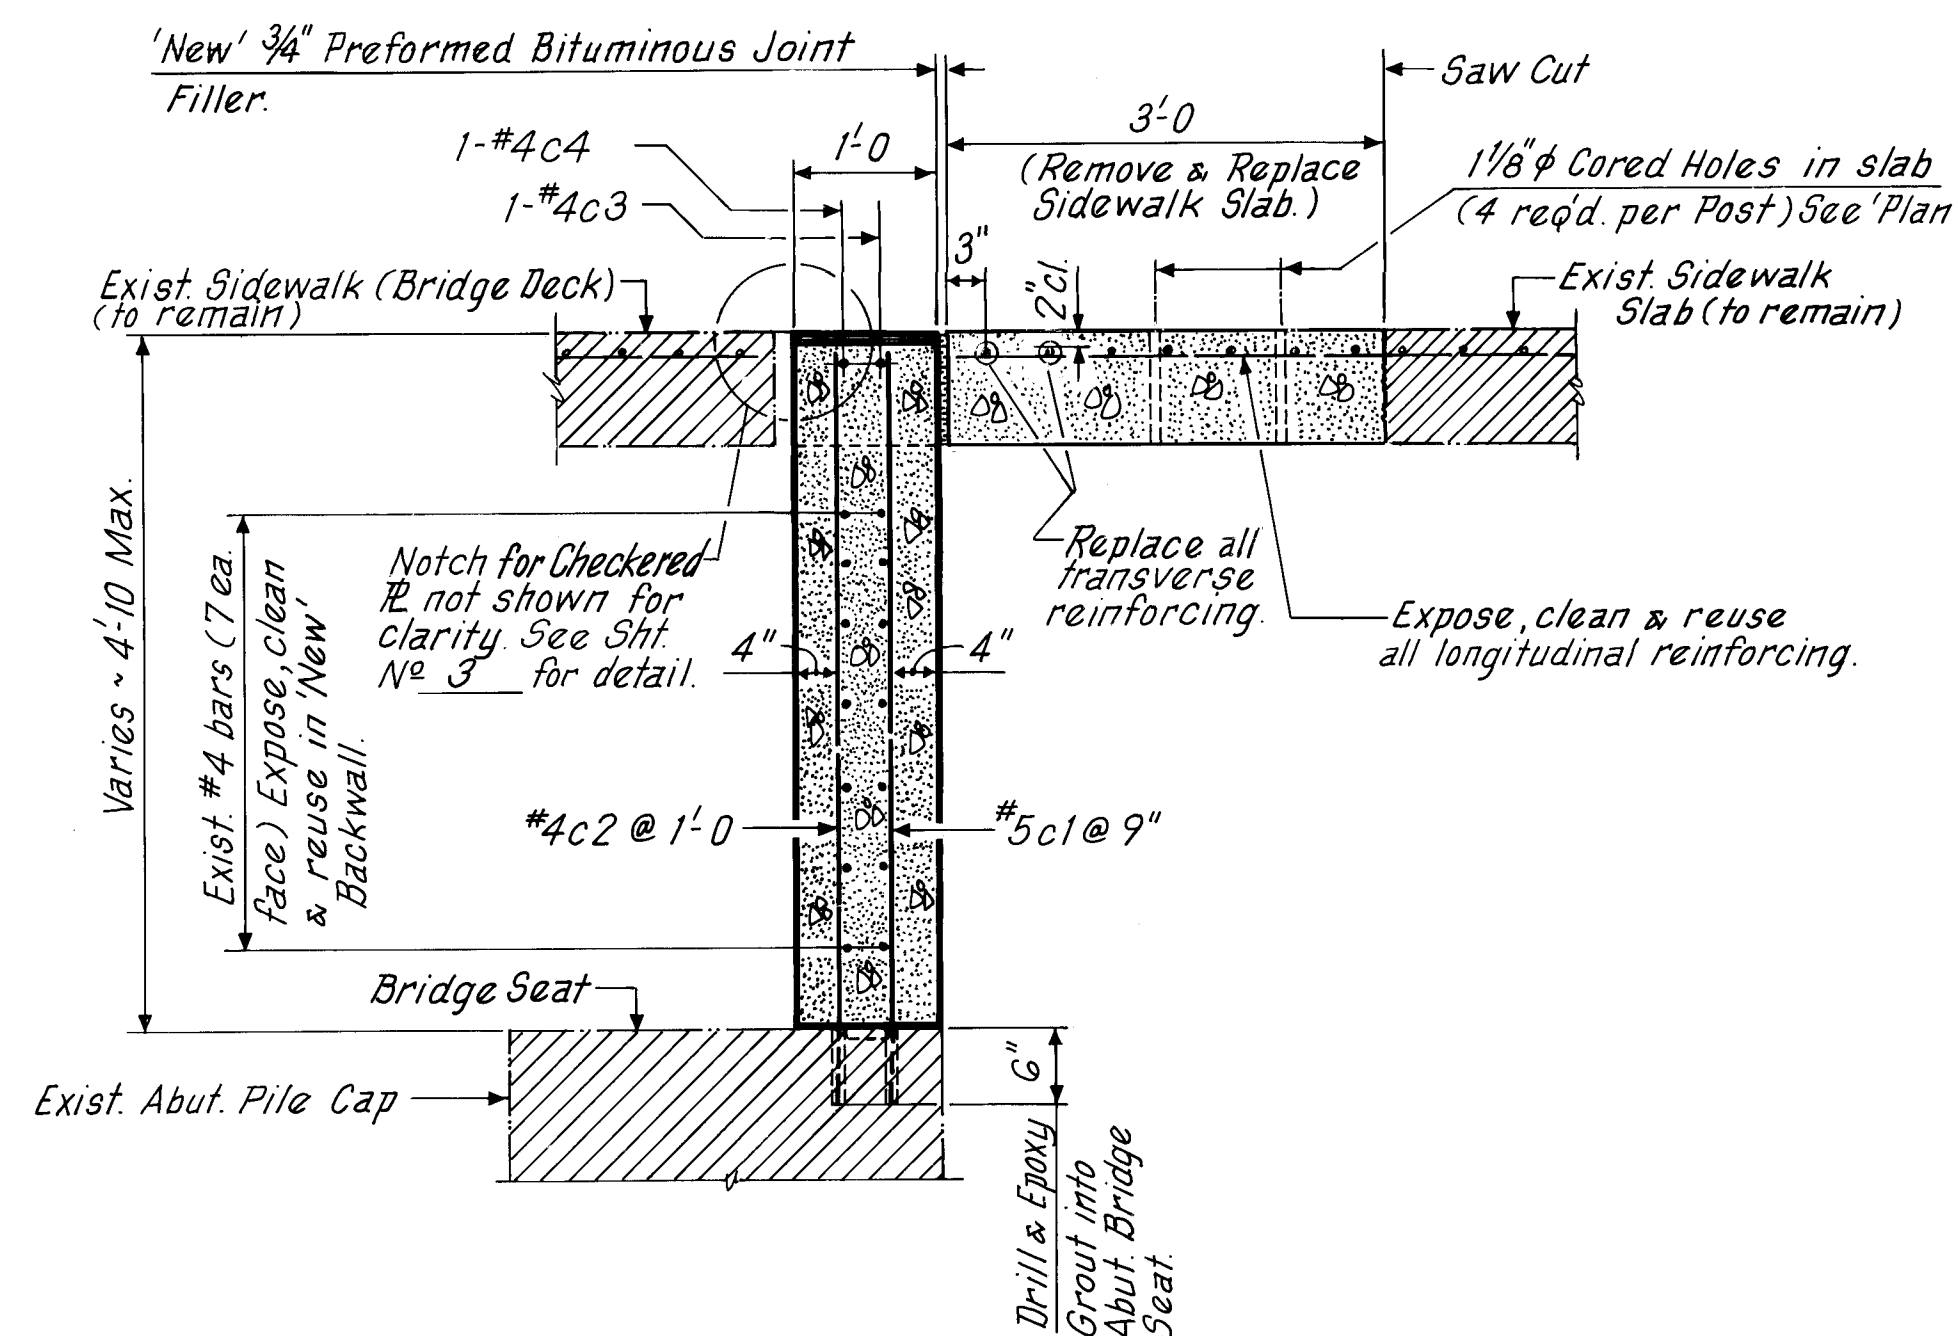

AS BUILT INFORMATION			BENCH MARKS		
CONTRACTOR	MOORE & CONWAY	DATE	NO.	DATE	NO.
WORK	STAKED BY MOORE & CONWAY	DATE	1	10/90	
APPROVED	BY C.O.A.	DATE			
DESIGNED	BY C.O.A.	DATE			
DRAWN	BY C.O.A.	DATE			
CHECKED	BY C.O.A.	DATE			
RECORDED	BY C.O.A.	DATE			
MICRO-FILM INFORMATION					
NO.					

SURVEY INFORMATION			ENGINEER'S SEAL		
NO.	1	DATE	BY	DATE	DATE
ALBUQUERQUE		10/90			
SURVEY CO. INC.					
REVISIONS					
NO.		DATE	DESIGN	DATE	DATE
		8/91			
		8/91			
		8/91			

CITY OF ALBUQUERQUE PUBLIC WORKS DEPARTMENT ENGINEERING GROUP					
TITLE: COAL AVENUE OVERPASS REHABILITATION REPAIR DETAILS @ ABUTMENT N° 2 AND MISCELLANEOUS DETAILS					
APPROVALS	ENGINEER	DATE	APPROVALS	ENGINEER	DATE
DRC CHAIRMAN			WATER		
TRANSPORTATION			WASTE WATER		
HYDROLOGY					
PROJECT NO.	4018.91	MAP NO.	K-14N	SHEET	5 OF 26



PHOTO N°1
ABUTMENT N°1
Southend



PHOTO N°2
ABUTMENT N°1
Southend - Eastside



PHOTO N°3
PIER N°1
Between Southerly Beams

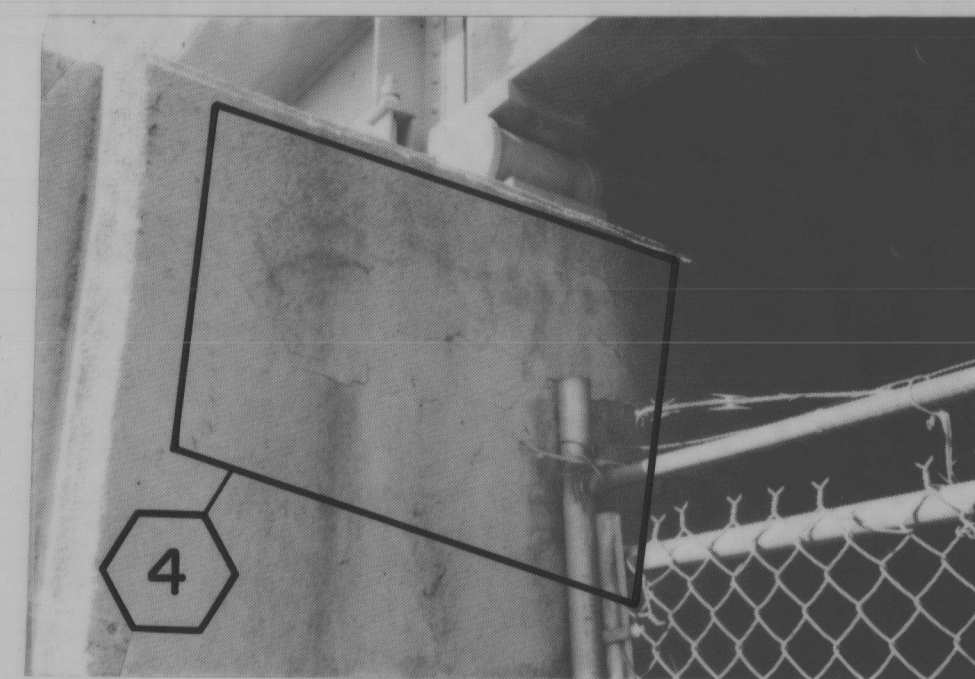


PHOTO N°4
PIER N°2
Westside - Southend

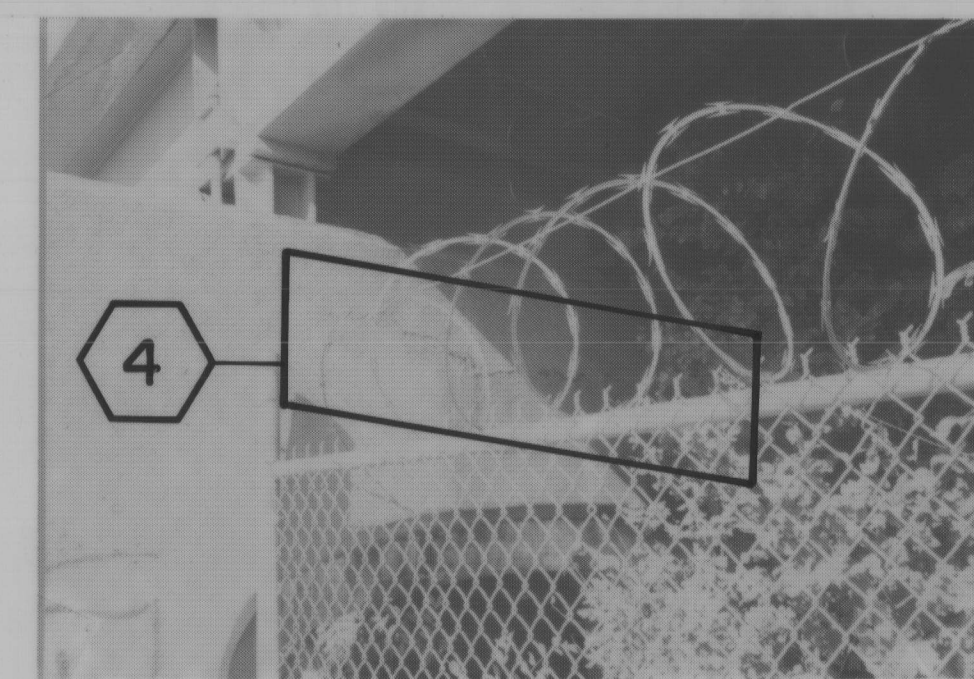


PHOTO N°5
PIER N°2
Eastside - Southend

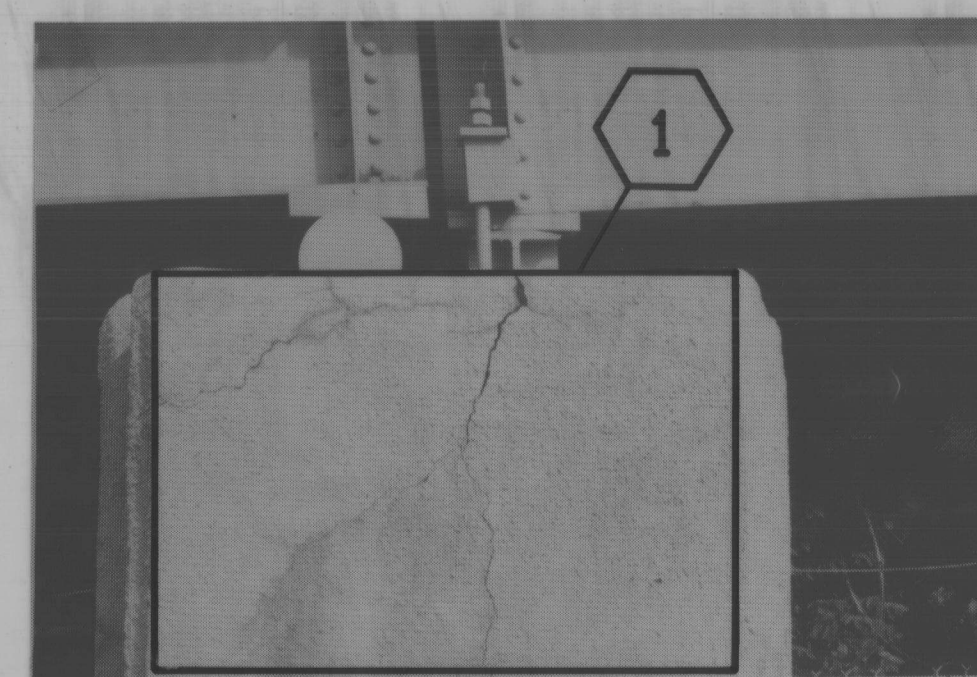


PHOTO N°6
PIER N°2
Southend



PHOTO N°7
PIER N°3
Southend

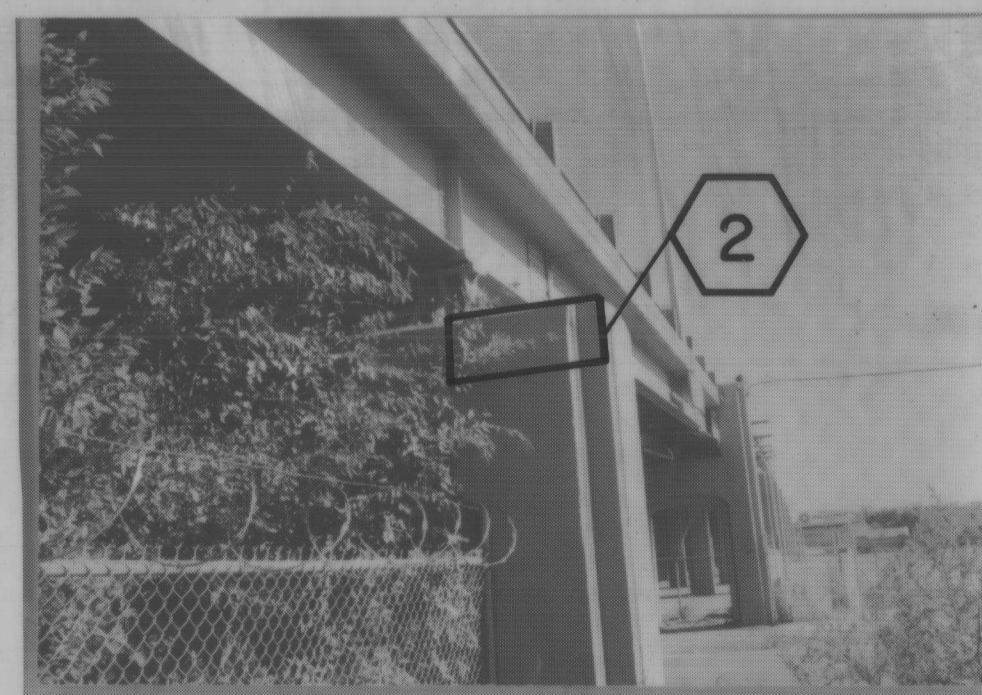


PHOTO N°8
PIER N°3
Westside - Southend



PHOTO N°9
PIER N°5
Eastside - 2ND Column from Northend

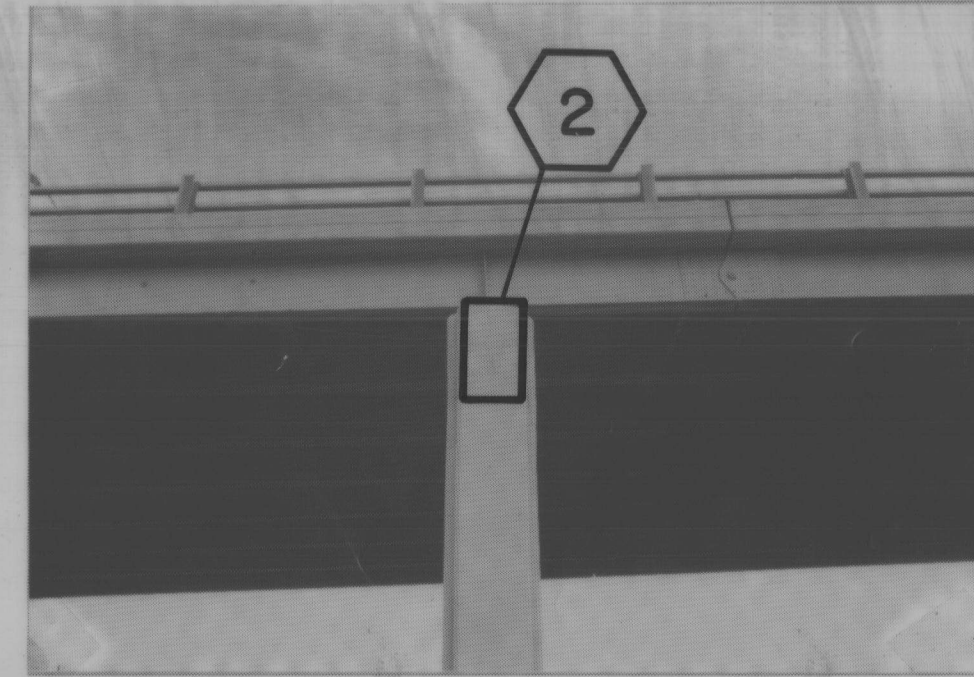


PHOTO N°10
PIER N°7
Southend

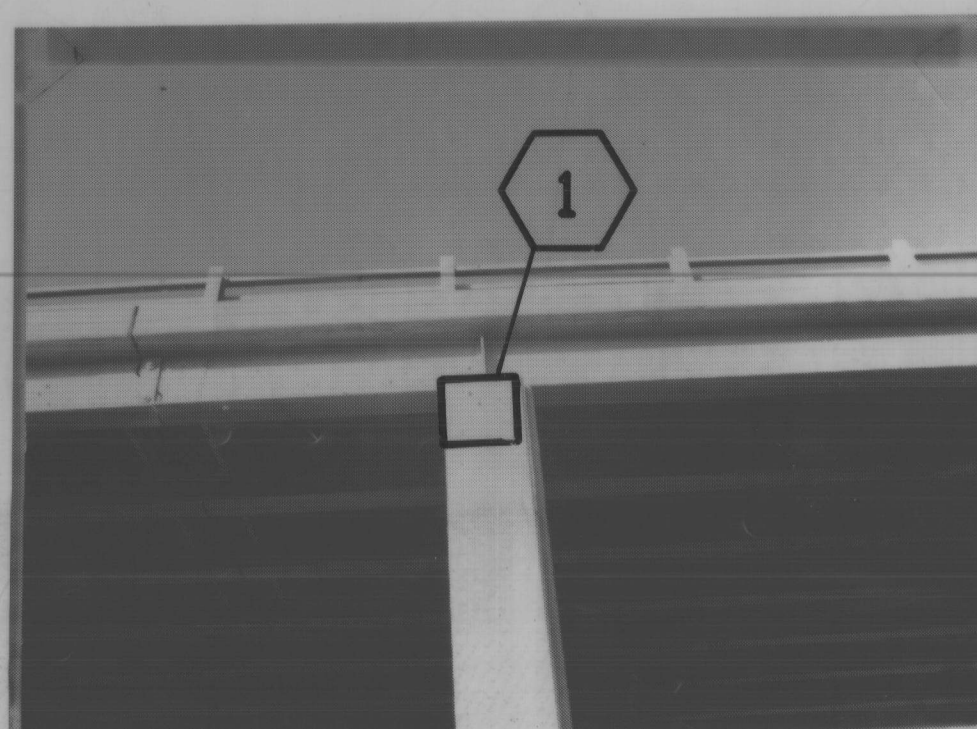


PHOTO N°11
PIER N°10
Southend

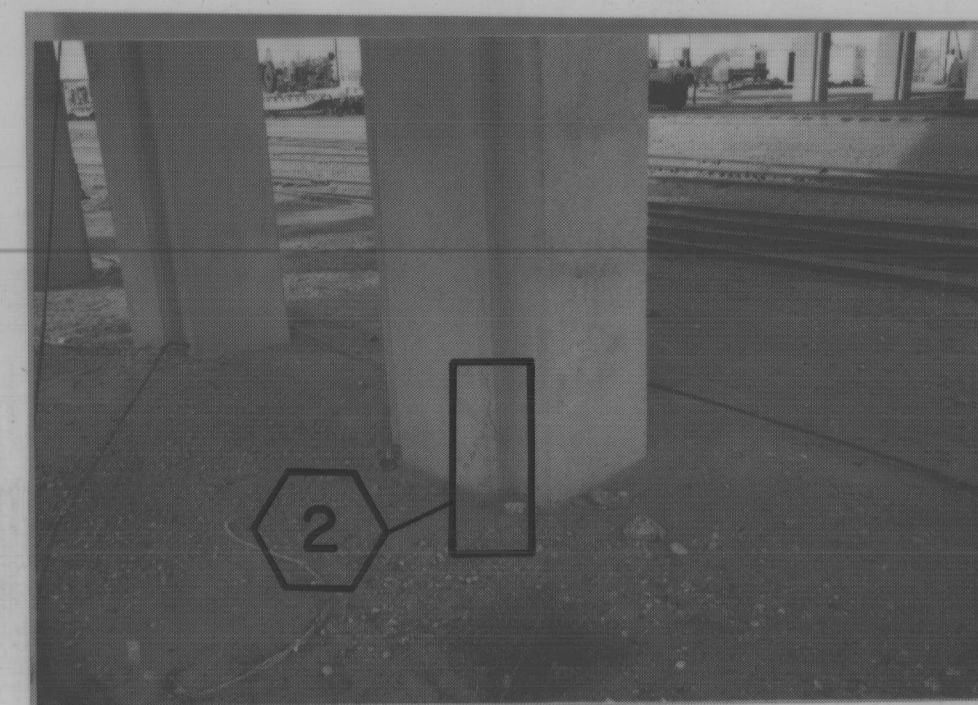


PHOTO N°12
PIER N°10
Eastside - 2ND Column from Northend

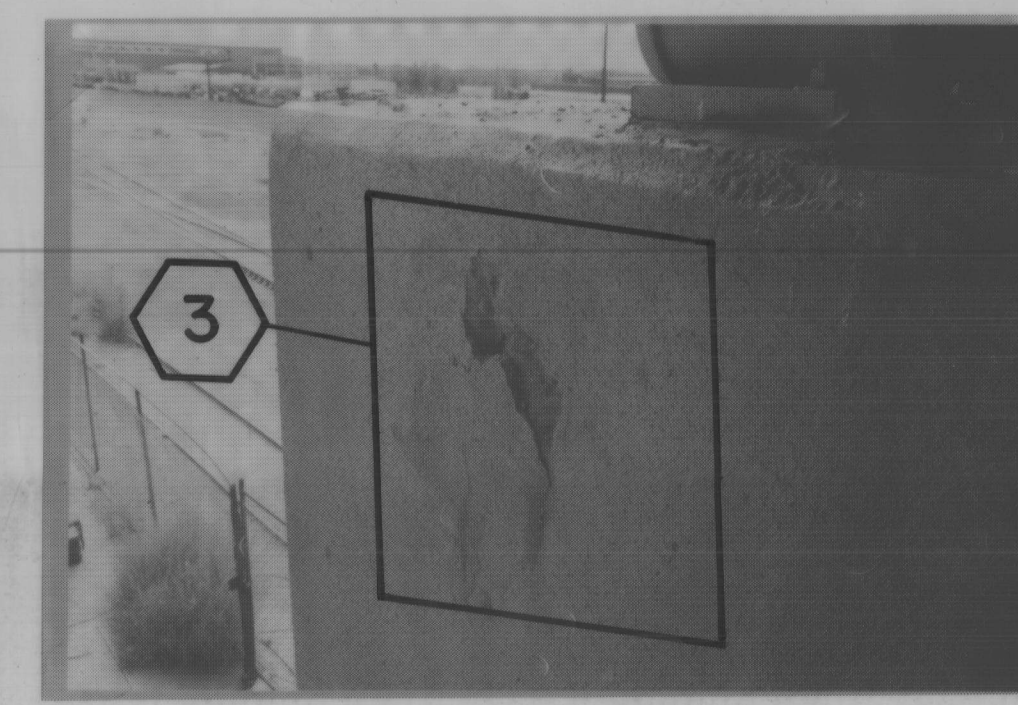


PHOTO N°13
PIER N°12
Eastside - Southend



PHOTO N°14
PIER N°12
Eastside - North Column

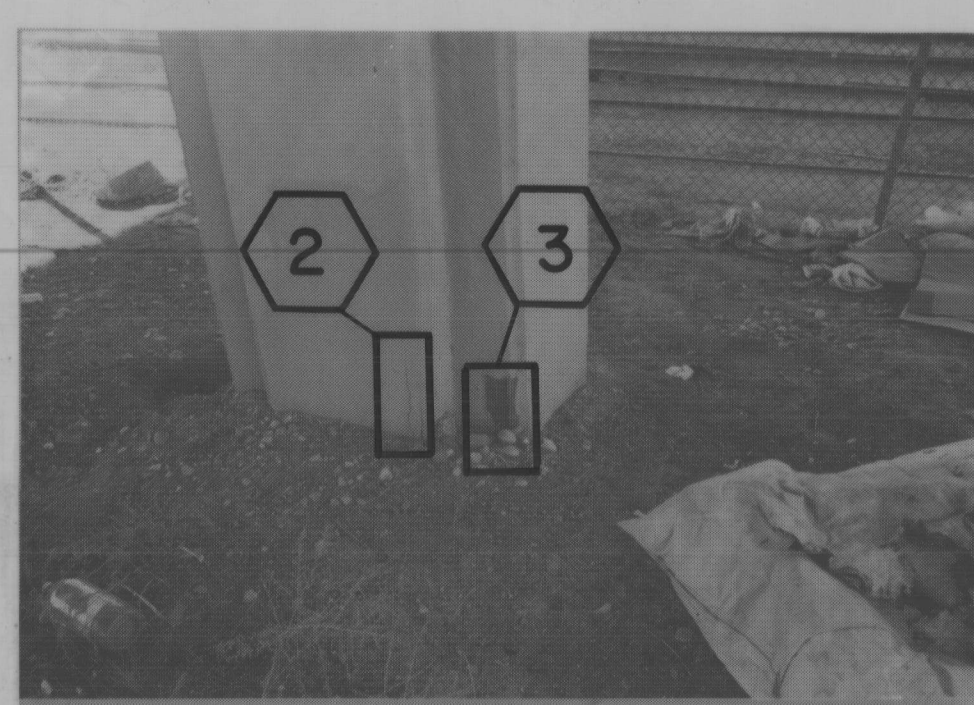


PHOTO N°15
PIER N°12
Eastside - 2ND Column from Northend

LEGEND FOR PHOTO SHEETS

- SYMBOL 1 - Remove spalling concrete, epoxy inject cracks, patch in accordance with Special Provisions For Pier And Abutment Repair.
- SYMBOL 2 - Epoxy inject cracks.
- SYMBOL 3 - Remove spalling concrete, patch in accordance with Special Provisions For Pier And Abutment Repair.
- SYMBOL 4 - Remove unsound concrete, epoxy inject cracks, patch in accordance with Special Provisions For Pier And Abutment Repair.
- SYMBOL 5 - Clean and repaint in accordance with Special Provision For Protective Coating of New Steel Bridge Railing and Miscellaneous Structural Steel, Type 2.

1 2 3 4 5 6 7 8 9 10 11 12 13 14 15
26-4018.91 9/1 0696

CITY OF ALBUQUERQUE PUBLIC WORKS DEPARTMENT ENGINEERING GROUP					
TITLE: COAL AVENUE OVERPASS REHABILITATION PHOTO SHEET N° 1					
APPROVALS	ENGINEER	DATE	APPROVALS	ENGINEER	DATE
DRC CHAIRMAN	Reyes	6-19-92	WATER	N/A	AD
TRANSPORTATION	N/A	6-17-92	WASTE WATER		
HYDROLOGY	NA				
PROJECT NO.	4018.91	MAP NO. K-14N	SHEET 6	OF 25	

ENGINEER'S SEAL		SURVEY INFORMATION		BENCH MARKS		AS BUILT INFORMATION	
NO.		FIELD NOTES		CONTRACTOR MOORE & CONRAD		WORK STARTED BY MOORE & CONRAD DATE 6/94	
1		ALBUQUERQUE SURVEY CO. INC.		DATE 9/95		DATE 9/95	
				FIELD VERIFICATION BY C.O.A.		DATE 9/95	
				DRAWINGS CORRECTED BY AVID ENG.		DATE 10/95	
				MICRO-FILM INFORMATION		RECORDED BY	
				NO.		DATE	



PHOTO Nº 16
PIER Nº 12
Eastside - 2ND Column from Southend



PHOTO Nº 17
PIER Nº 12
Westside - 2ND Column from Southend

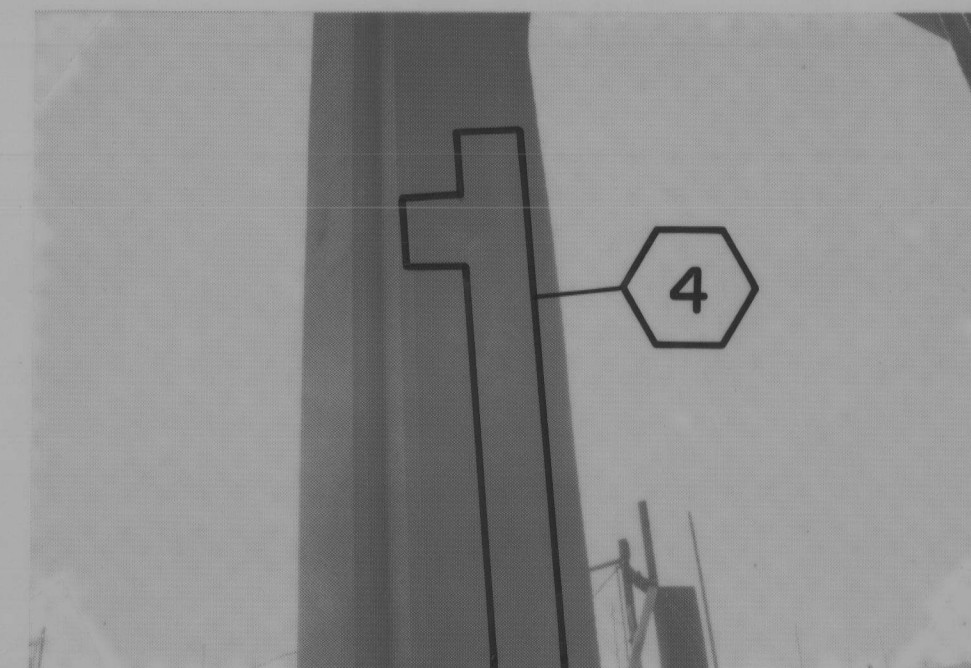


PHOTO Nº 18
PIER Nº 12
Northside - South Column

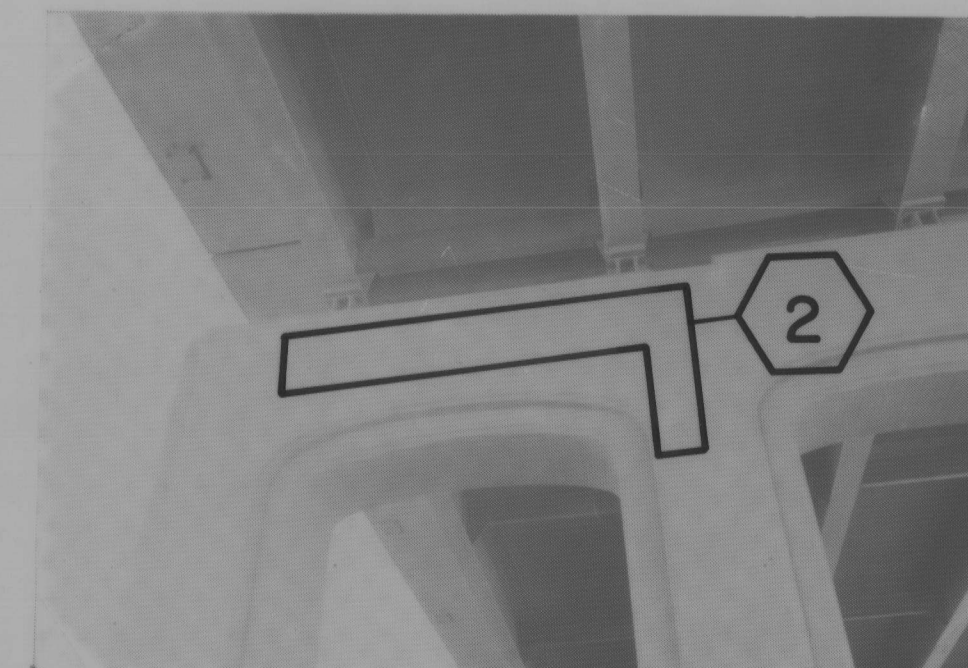


PHOTO Nº 19
PIER Nº 13
Westside - Northend

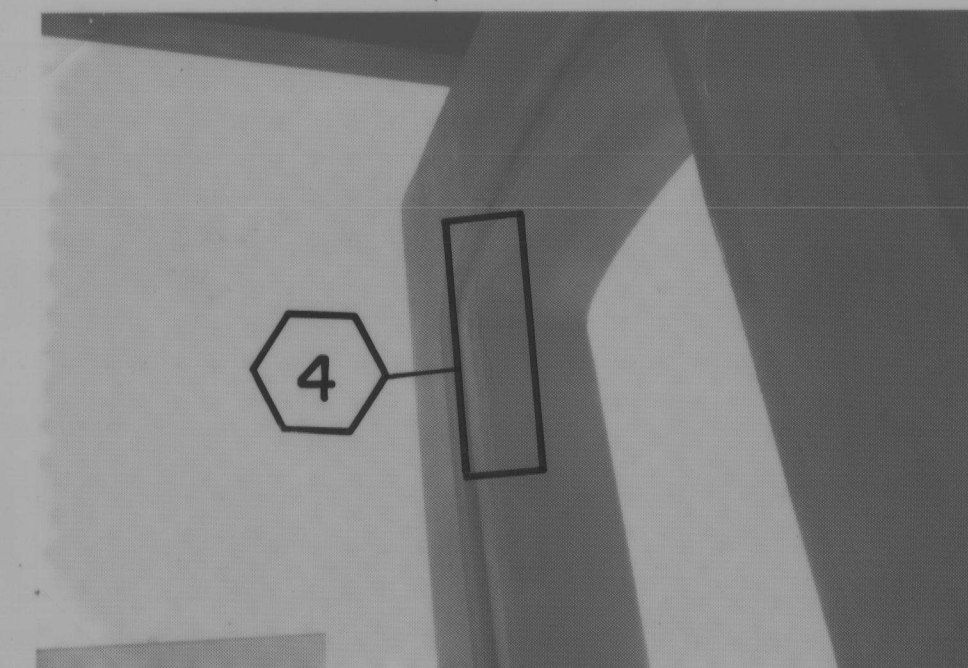


PHOTO Nº 20
PIER Nº 13
Eastside - South Column

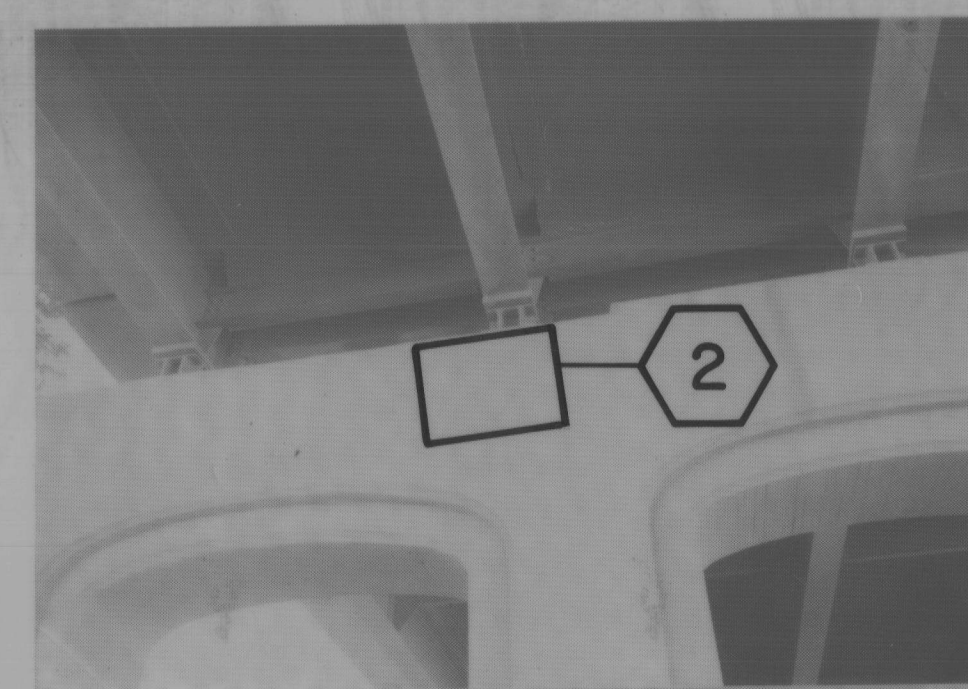


PHOTO Nº 21
PIER Nº 14
Westside



PHOTO Nº 22
PIER Nº 14
Westside - South Column

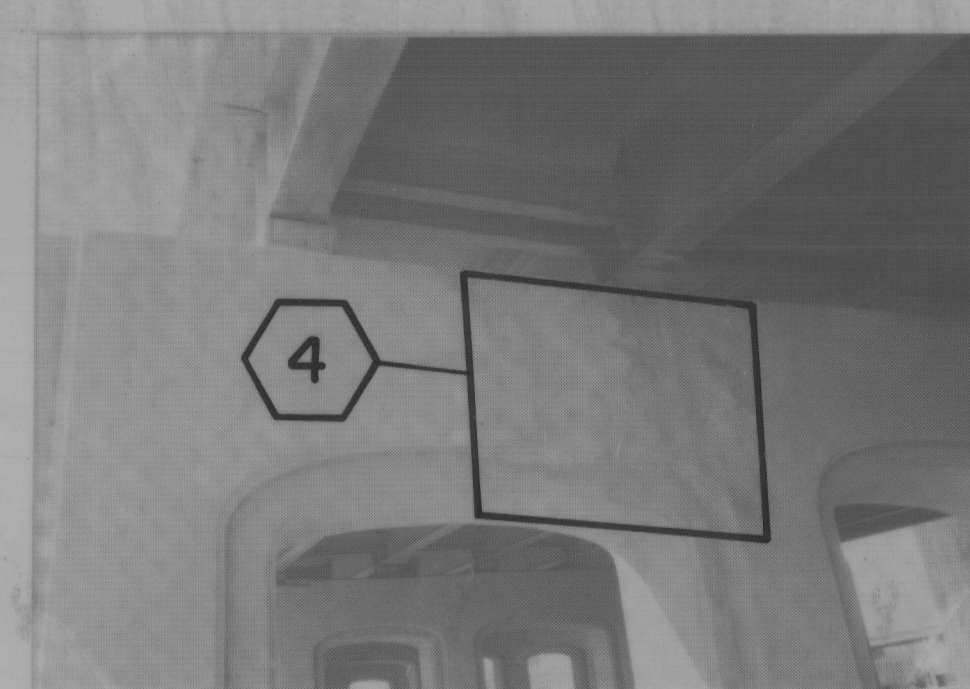


PHOTO Nº 23
PIER Nº 14
Eastside - Southend



PHOTO Nº 24
PIER Nº 14
Southend

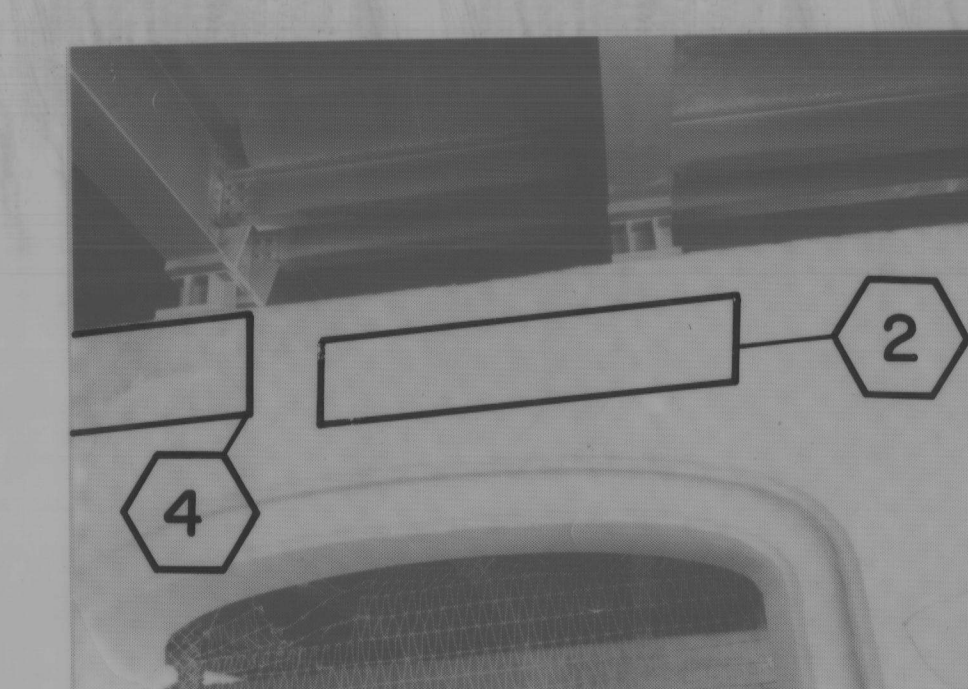


PHOTO Nº 25
PIER Nº 15
Westside - Middle Bay

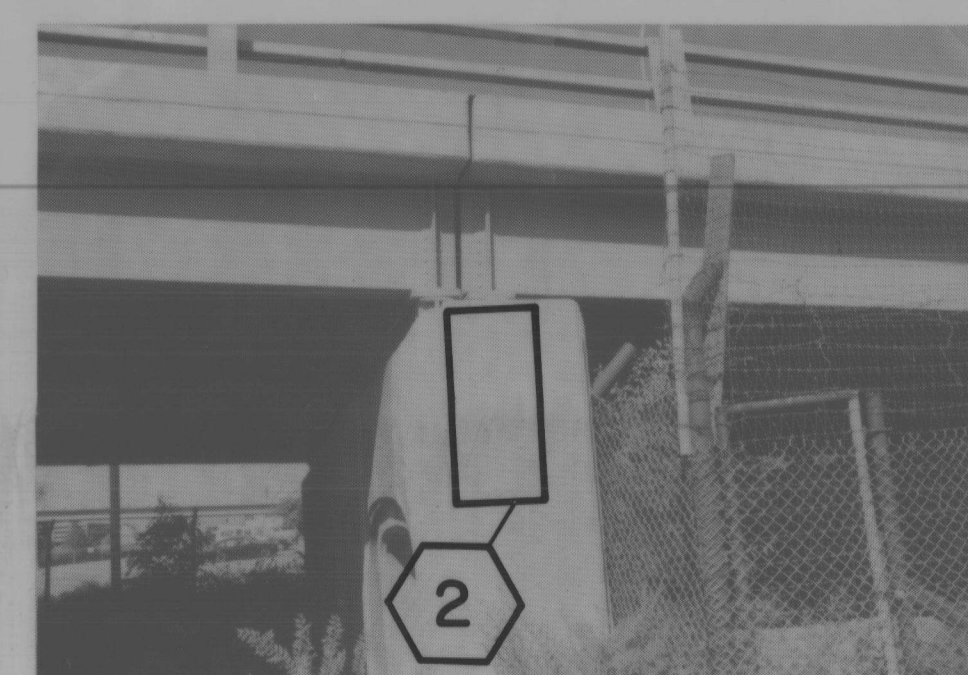


PHOTO Nº 26
PIER Nº 15
Southend

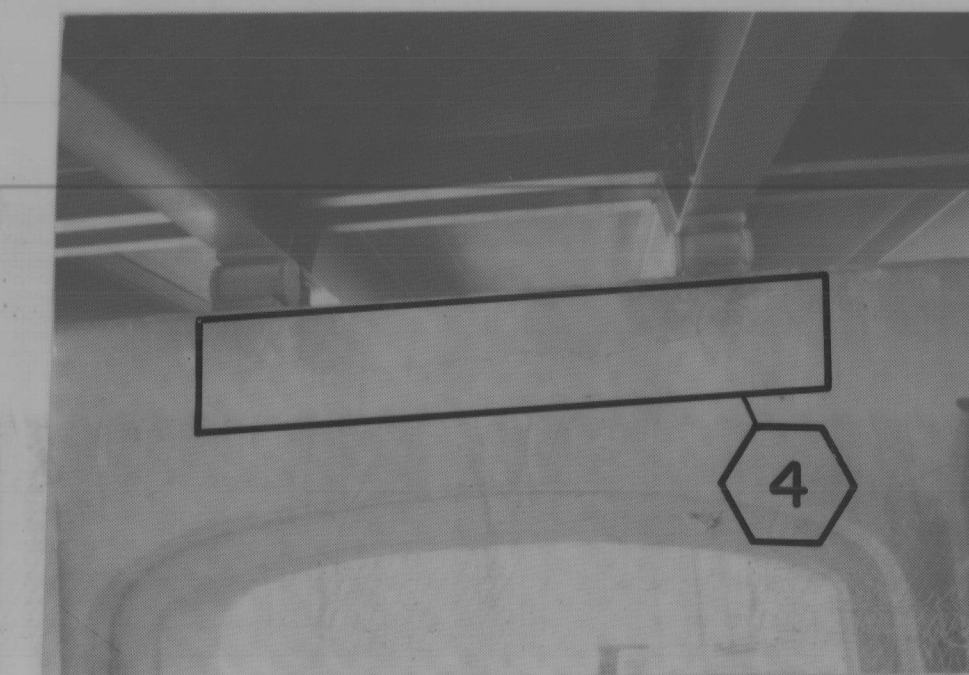


PHOTO Nº 27
PIER Nº 15
Eastside - Middle Bay (Similar cracking next Bay to North.)

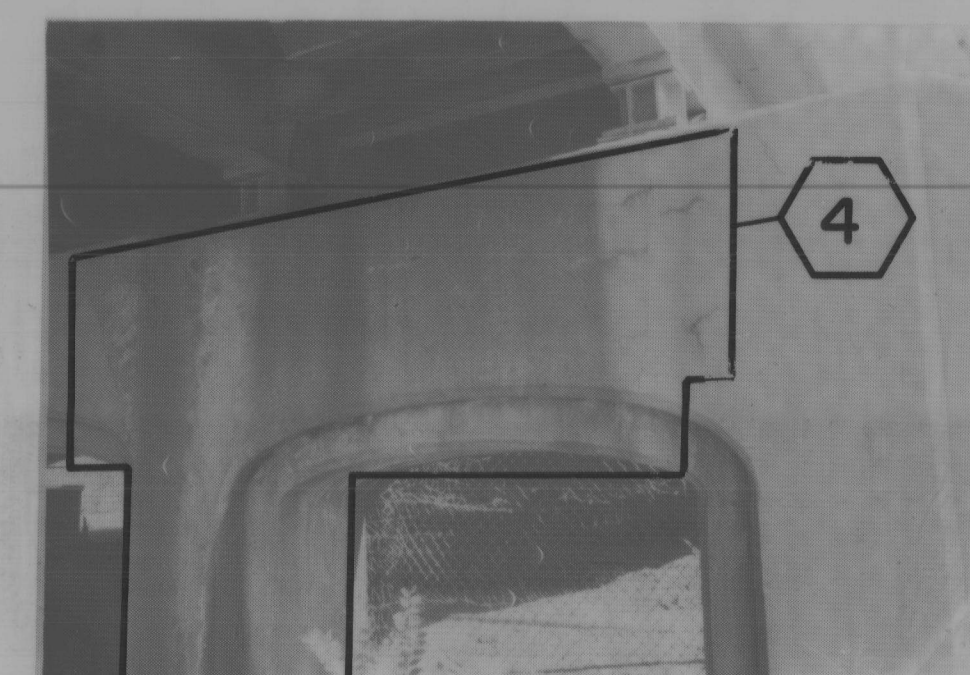


PHOTO Nº 28
PIER Nº 15
Westside - South Bay

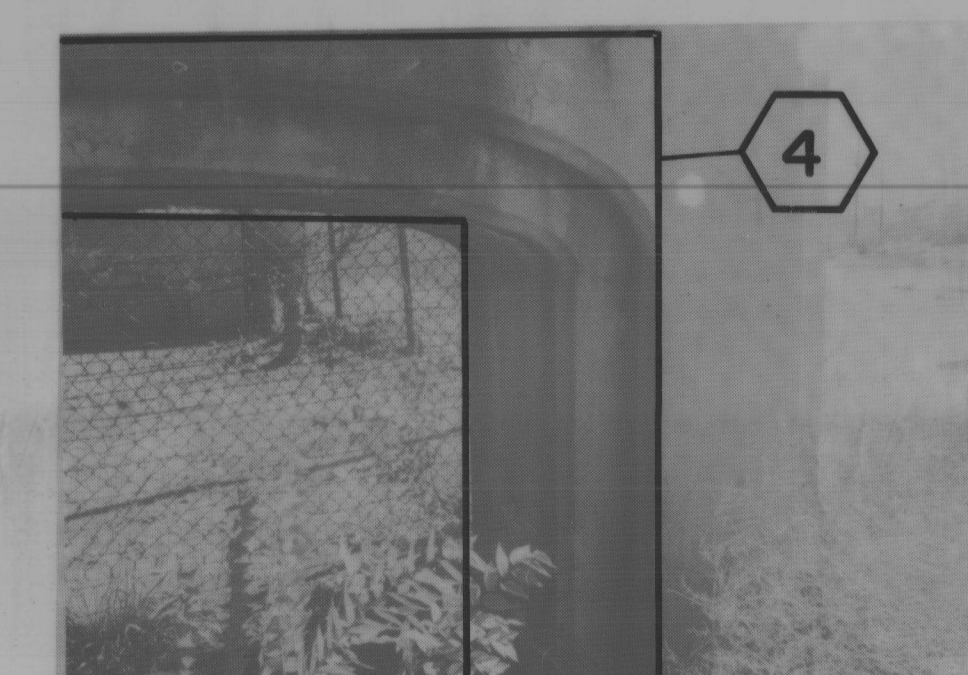


PHOTO Nº 29
PIER Nº 15
Westside - South Column

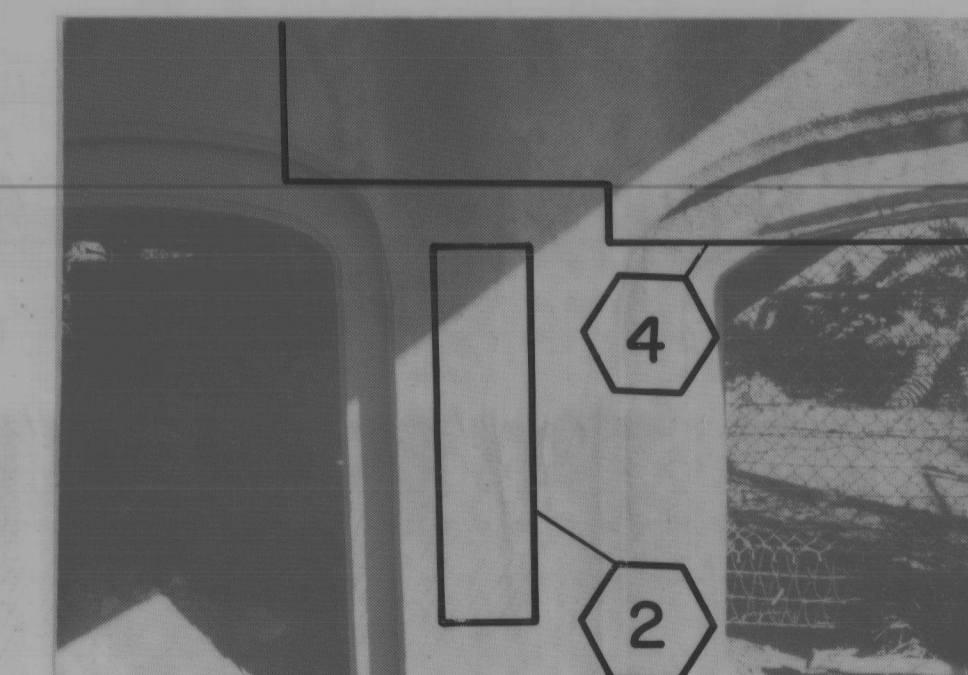


PHOTO Nº 30
PIER Nº 15
Westside - 2ND Column from Southend

NOTE: SEE SHT. 6 FOR LEGEND.

1 2 3 4 5 6 7 8 9 10 11 12 13 14 15
26-4018.91 91 0796

CITY OF ALBUQUERQUE PUBLIC WORKS DEPARTMENT ENGINEERING GROUP					
TITLE: COAL AVENUE OVERPASS REHABILITATION PHOTO SHEET Nº 2					
APPROVALS	ENGINEER	DATE	APPROVALS	ENGINEER	DATE
DRC CHAIRMAN	Roger A. Green	6-19-92	WATER	N/A	N/A
TRANSPORTATION	N/A	6-17-92	WASTE WATER	N/A	N/A
HYDROLOGY	N/A				
PROJECT NO.	4018.91	MAP NO.	K-14N	SHEET	7 OF 25

ENGINEER'S SEAL		SURVEY INFORMATION		BENCH MARKS		AS BUILT INFORMATION	
NO. 1		DATE 10/90		CONTRACTOR Moore & Cowart, Contra.		WORK STARTED BY Moore & Cowart, Contra. DATE 6/94	
BY ALBUQUERQUE SURVEY CO. INC.		DATE 10/90		ACCEPTANCE BY C.O.A. DATE 9/95		FIELD OBSERVATION BY C.O.A. DATE 9/95	
REVISIONS		DATE 8/91		DRAWINGS BY AVID ENG. DATE 10/95		CORRECTED BY AVID ENG. DATE 10/95	
DESIGNED BY T. Spring		DATE 8/91		MICRO-FILM INFORMATION		RECORDED BY	
DRAWN BY H. Smith		DATE 8/91		NO.		DATE	
CHECKED BY		DATE 8/91					

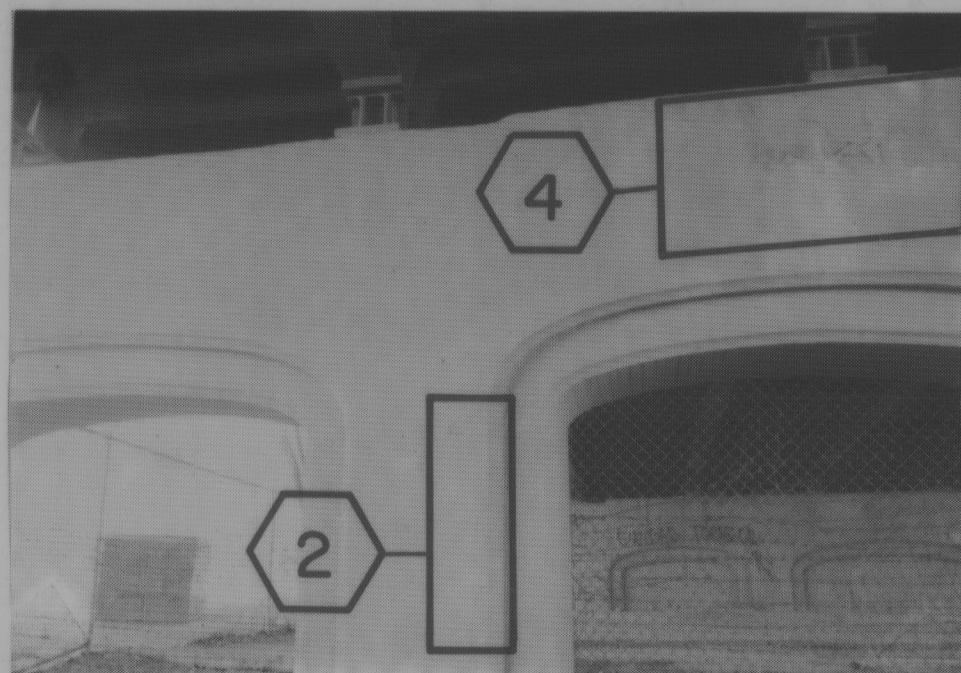


PHOTO No 31
PIER No 15

Westside - Second Column From North

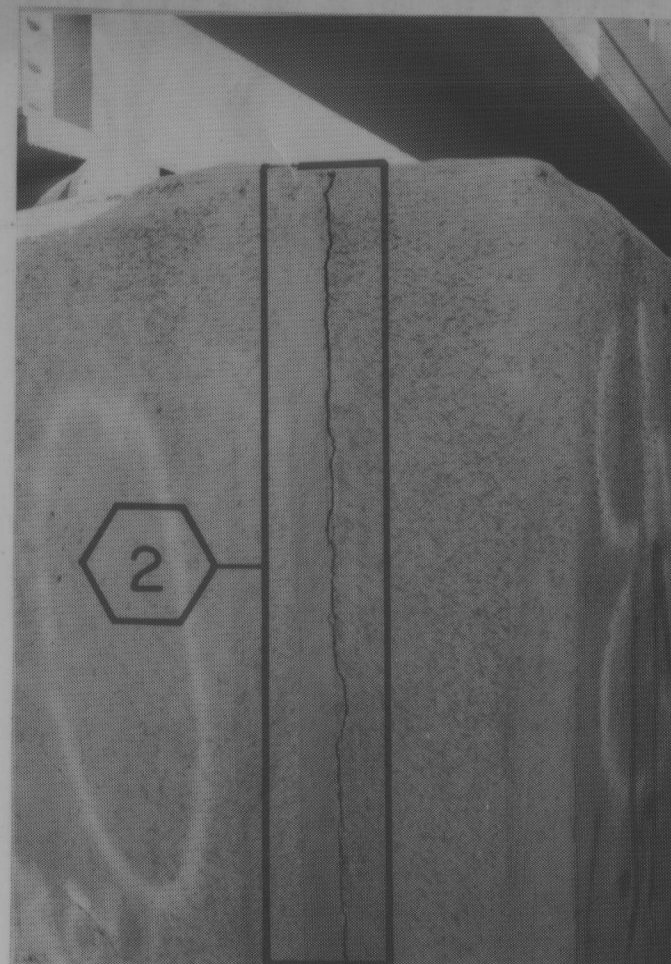


PHOTO No 32
PIER No 16

Westside, Southend

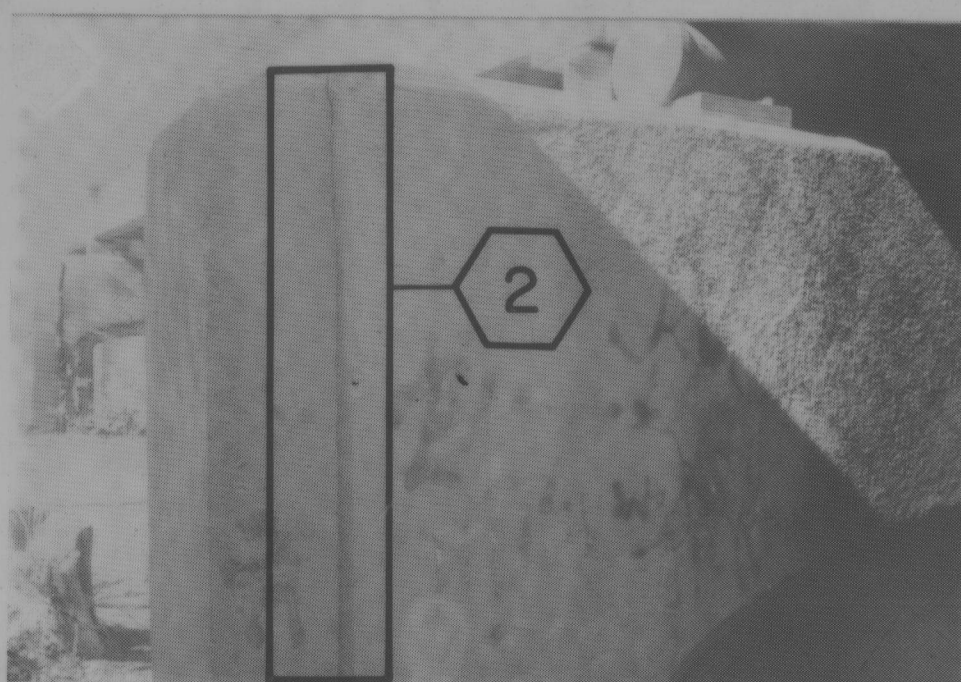


PHOTO No 33
PIER No 16

Eastside, Southend

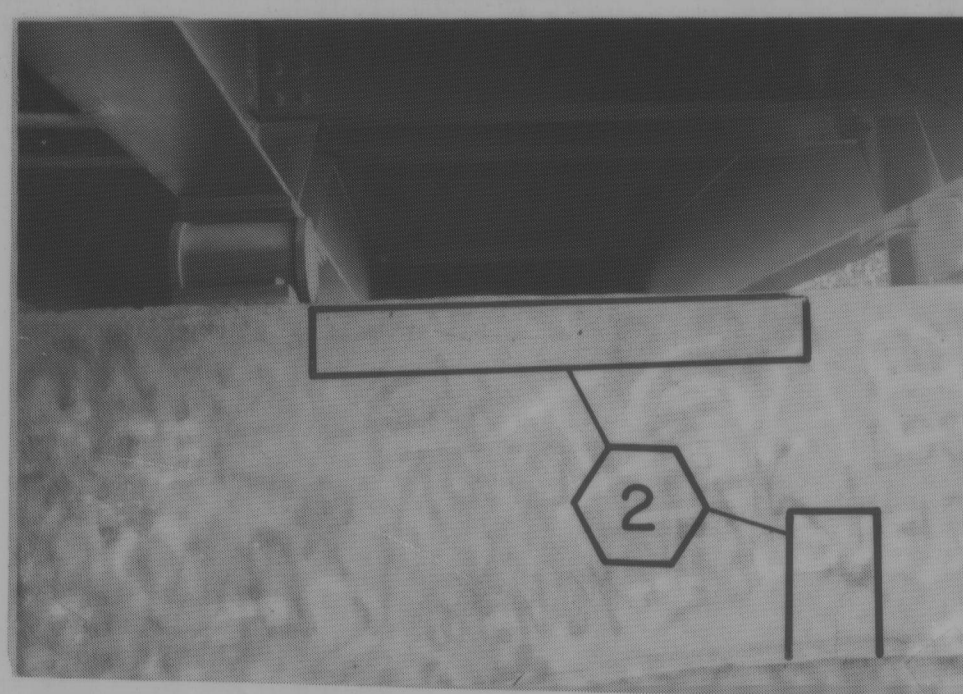


PHOTO No 34
PIER No 16

Eastside Between Northerly Beams



PHOTO No 35
PIER No 16

Westside, Southend

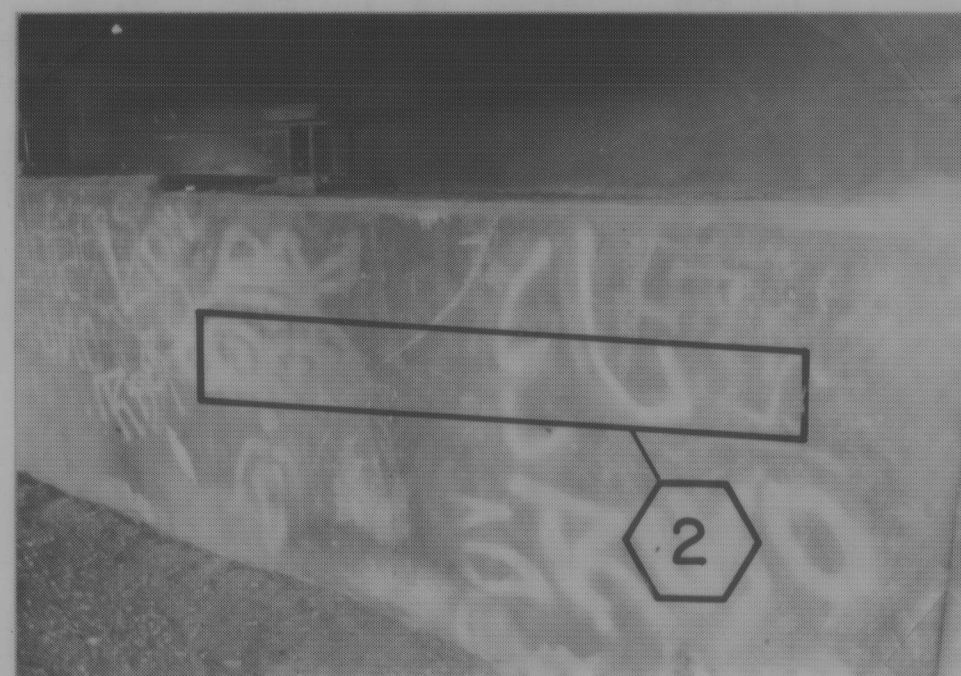


PHOTO No 36
ABUTMENT No 2

Crack About 8' Long - Southend



PHOTO No 37
ABUTMENT No 2

Eastside - Backwall At Northend



PHOTO No 38
ABUTMENT No 2

Backwall At Northend

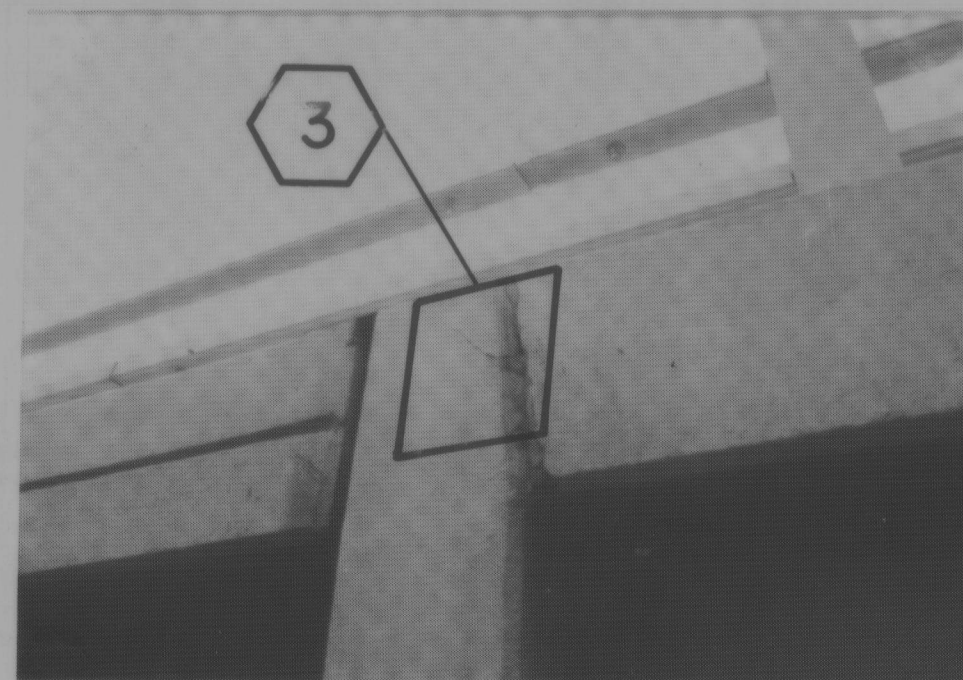


PHOTO No 39
ABUTMENT No 2

Backwall At Southend

NOTE: SEE SHT. 6 FOR LEGEND.

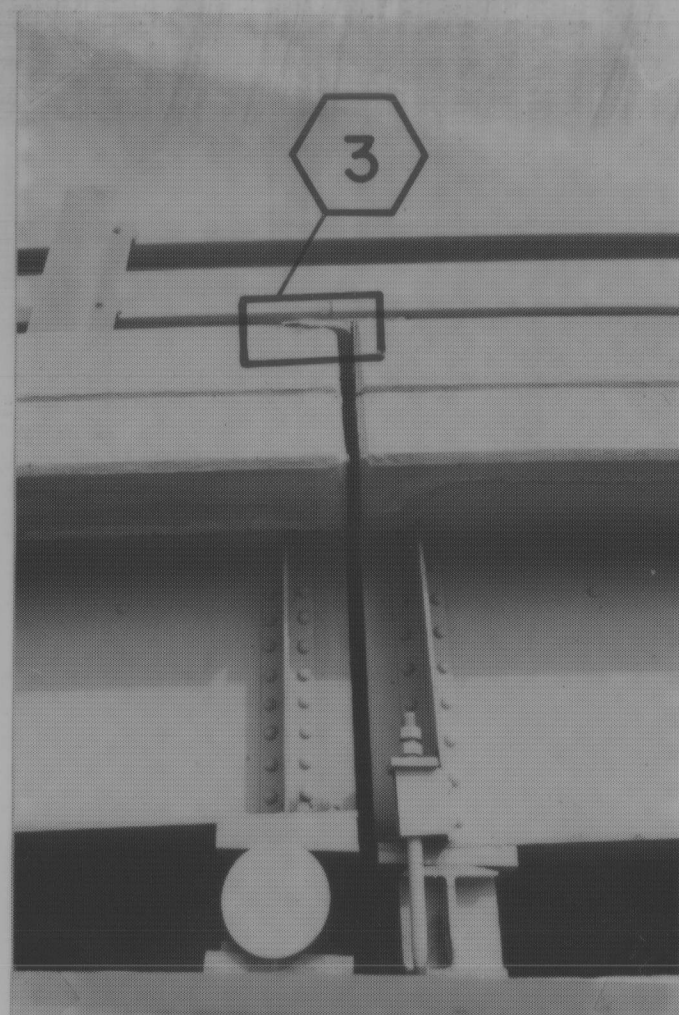


PHOTO No 40
PIER No 2

Joint - Southside Pier No 2



PHOTO No 41

Typical Joint Deterioration See
Replacement Details Sht. 3

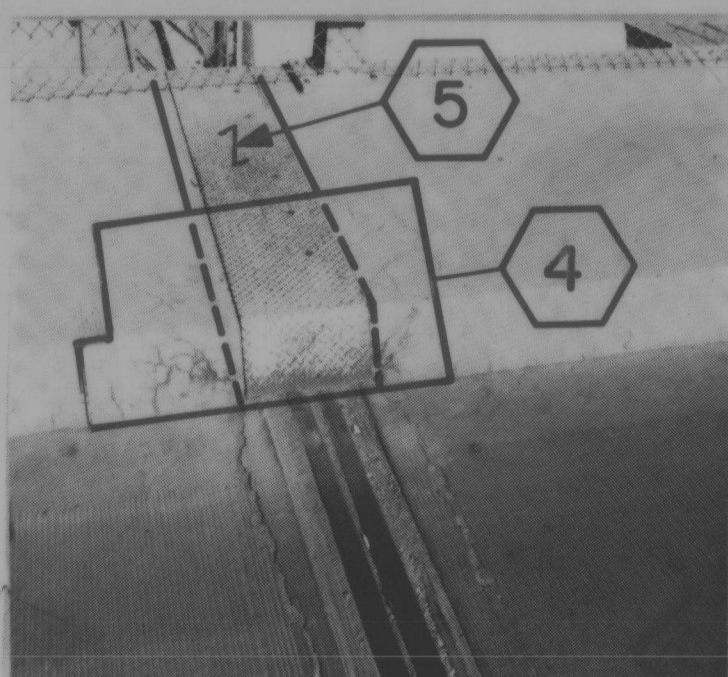


PHOTO No 42

Expansion Joint @ Sidewalk
See Sht. 3 For Locations
To Be Repaired, Paint All
Curb & Sidewalk Plates.

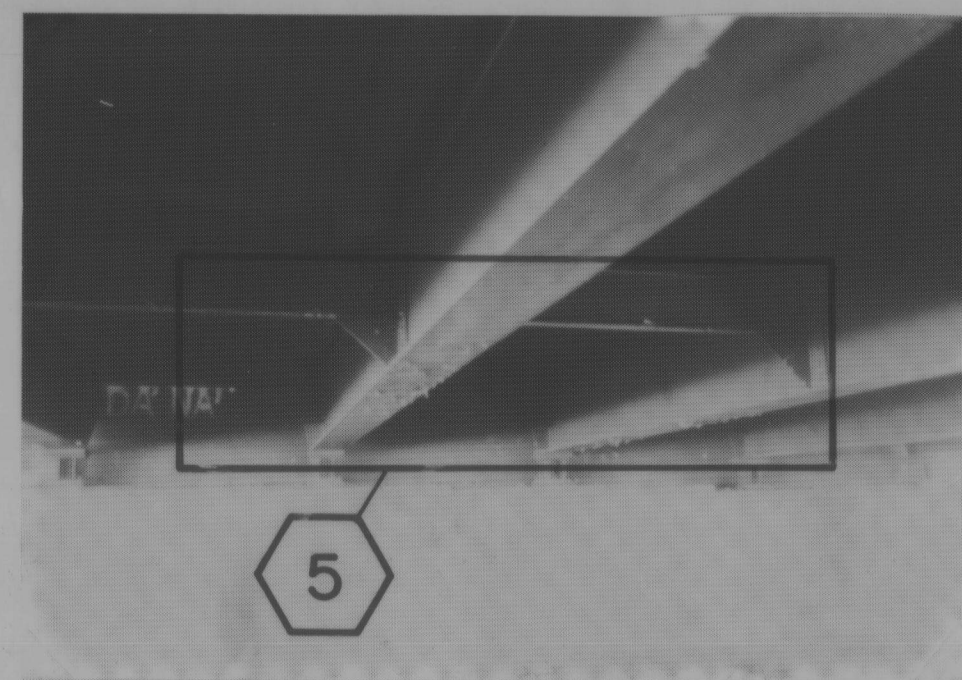


PHOTO No 43
SPAN No 17

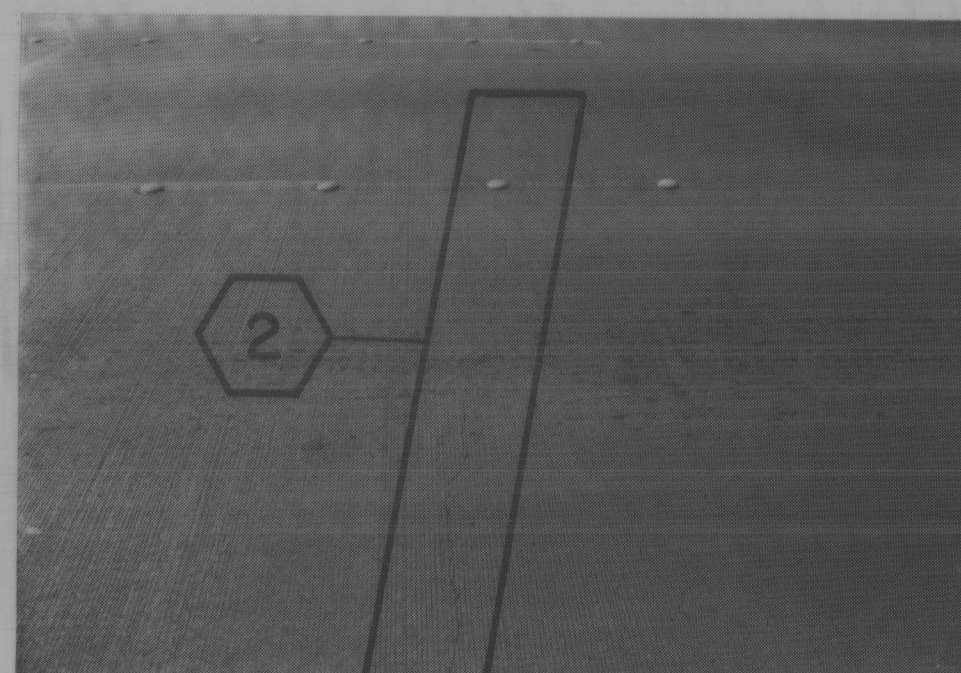


PHOTO No 44

Typical Slab Crack - Epoxy Inject
Cracks In Slabs, Sidewalks And Curbs.

AS BUILT INFORMATION			BENCH MARKS			SURVEY INFORMATION			ENGINEER'S SEAL		
CONTRACTOR	MOORE & COMPANY	DATE	NO.	BY	DATE	NO.	BY	DATE	NO.	BY	DATE
INSPECTOR'S	ALBUQUERQUE	10/90	1	ALBUQUERQUE	10/90	1	ALBUQUERQUE	10/90	1	ALBUQUERQUE	10/90
ACCEPTANCE BY	C.O.A.	DATE	1	SURVEY CO. INC.	DATE	1	SURVEY CO. INC.	DATE	1	SURVEY CO. INC.	DATE
VERIFICATION BY	C.O.A.	DATE	1	SURVEY CO. INC.	DATE	1	SURVEY CO. INC.	DATE	1	SURVEY CO. INC.	DATE
DESIGNED BY	ALVID ENG.	DATE	1	SURVEY CO. INC.	DATE	1	SURVEY CO. INC.	DATE	1	SURVEY CO. INC.	DATE
RECORDED BY	ALVID ENG.	DATE	1	SURVEY CO. INC.	DATE	1	SURVEY CO. INC.	DATE	1	SURVEY CO. INC.	DATE
NO.	3333	DATE	1	SURVEY CO. INC.	DATE	1	SURVEY CO. INC.	DATE	1	SURVEY CO. INC.	DATE

CITY OF ALBUQUERQUE PUBLIC WORKS DEPARTMENT ENGINEERING GROUP					
TITLE: COAL AVENUE OVERPASS REHABILITATION					
PHOTO SHEET No 3					
APPROVALS	ENGINEER	DATE	APPROVALS	ENGINEER	DATE
DRC CHAIRMAN	Robert Green	6-19-92	WATER	N/A	N/A
TRANSPORTATION	NA	6-17-92	WASTE WATER	N/A	N/A
HYDROLOGY	NA				
PROJECT NO.	4018.91	MAP NO.	K-14N	SHEET	8 OF 25








REINFORCING BAR SCHEDULE

MARK	TYPE	SIZE	NO.	LENGTH	A	B	MARK	TYPE	SIZE	NO.	LENGTH	A	B	MARK	TYPE	SIZE	NO.	LENGTH	A	B	MARK	TYPE	SIZE	NO.	LENGTH	A	B
RIGID FRAME REPLACEMENT							BACKWALL REPAIR - ABUTMENT NO. 2																				
a1	3	#6	48	6'-2	4'-4		* c1	1	#5	6	5'-1																
a2	1	#5	100	3'-6			* c2	1	#4	5	5'-1																
a3	1	#4	2	51'-0			c3	1	#4	1	5'-3																
a4	1	#4	28	49'-0			c4	1	#4	1	4'-10																
a5	1	#5	100	6'-8			SIDEWALK BARS																				
a6	3	#4	50	3'-0	1'-11		b2	2	#5	9	6'-6	5'-3	3														
* a7	1	#5	47	5'-6			b3	1	#4	3	3'-0																
* a8	1	#4	47	5'-3			b4	3	#4	4	2'-3	1'-6															
a9	1	#4	1	44'-6			b5	1	#4	3	2'-6																
a10	4	#4	45	2'-3			b6	7	#4	3	3'-6	1'-1	1'-1														
a11	1	#4	26	7'-9			b7	6	#7	8	3'-10	1'-4	0'-7														
a12	1	#6	12	19'-6			b9	1	#4	1	2'-6																
a13	1	#4	12	19'-6			NEW 3/4" JTS. IN SIDEWALK & CURB - EAST OF ABUT. NO. 2																				
a14	5	#7	42	8'-6			SIDEWALK BARS																				
a15	8	#8	52	8'-0			b2	2	#5	12	6'-6	5'-3	3														
a16	1	#4	40	2'-4			b3	1	#4	4	3'-0																
a17	1	#4	40	19'-6			b4	3	#4	4	2'-3	1'-6															
a18	}	#8	4 ea.	INCRE. OF 1 1/8"			b5	1	#4	4	2'-6																
thru							b6	7	#4	4	3'-6	1'-1	1'-1														
a30							b7	6	#7	12	3'-10	1'-4	0'-7														
a31	}	#4	4 ea.	INCRE. OF 1 1/2"			b9	1	#4	4	2'-6																
thru							CURB BARS																				
a40							b3	1	#4	4	3'-0																
* a41	1	#5	6	6'-3			b4	3	#4	4	2'-3	1'-6															
a42	2	#5	3	6'-3	5'-3	3	b5	1	#4	4	2'-6																
a43	2	#5	2	3'-3	1'-9	3	b6	7	#4	4	3'-6	1'-1	1'-1														
a44	1	#4	2	5'-0			b7	6	#7	12	3'-10	1'-4	0'-7														
⦿ SIDEWALK							b9	1	#4	4	2'-6																
b1	1	#4	19	19'-6			CURB BARS																				
b2	2	#5	58	6'-6	5'-3	3	b3	1	#4	4	3'-0																
b3	1	#4	14	3'-0			b4	3	#4	4	2'-3	1'-6															
b4	3	#4	20	2'-3	1'-6		b5	1	#4	4	2'-6																
b5	1	#4	14	2'-6			b9	1	#4	4	2'-6																
b6	7	#4	14	3'-6	1'-1	1'-1	b11	3	#6	8	3'-9	1'-7															
b7	6	#7	47	3'-10	1'-4	0'-7	b12	2	#4	4	3'-0	1'-10	1/2														
b8	3	#7	24	2'-6	1'-5		b13	2	#5	8	3'-0	1'-10	3														
b9	1	#4	8	2'-6																							
⦿ CURB																											
b1	1	#4	13	19'-6																							
b3	1	#4	14	3'-0																							
b4	3	#4	20	2'-3	1'-6																						
b5	1	#4	14	2'-6																							
b9	1	#4	8	2'-6																							
b10	3	#6	22	2'-3	1'-5																						
b11	3	#6	37	3'-9	1'-7																						
b12	2	#4	14	3'-0	1'-10	1/2																					
b13	2	#5	36	3'-0	1'-10	3																					

MINIMUM BEND RADII TO C OF BAR									
DESCRIPTION	#3	#4	#5	#6	#7	#8	#9	#10	#11
MAIN REINFORCEMENT	1 1/16"	1 3/8"	2 3/16"	2 5/8"	3 1/16"	3 1/2"	5 1/16"	6"	6 1/16"
STIRRUPS & TIES	1 1/8"	1 1/2"	1 7/8"	2 5/8"	3 1/16"	3 1/2"			

NOTE: DIMENSIONS ARE OUT TO OUT OF BARS
+ = EPOXY-COATED BARS
* = GRADE 40 BARS




BAR TYPES

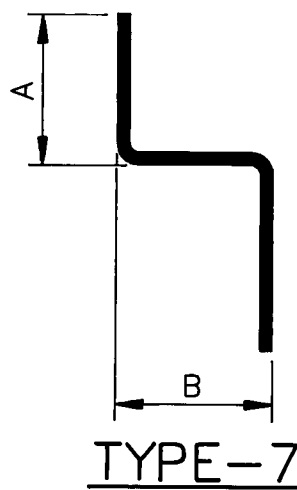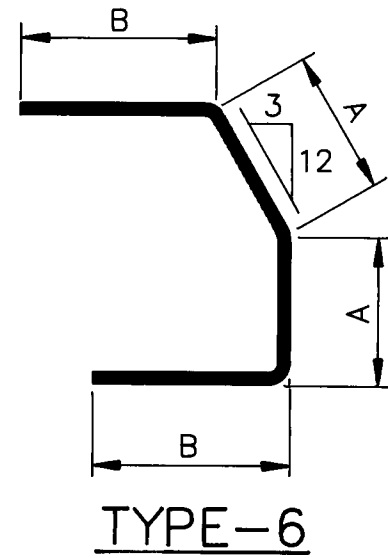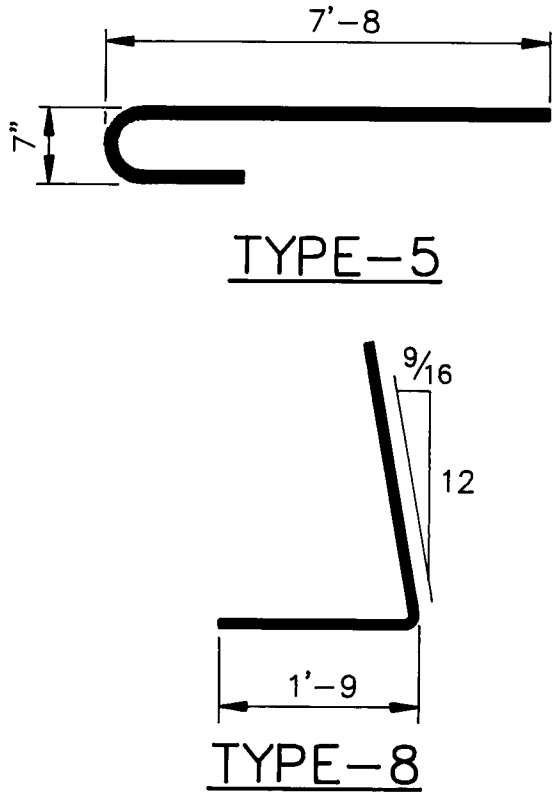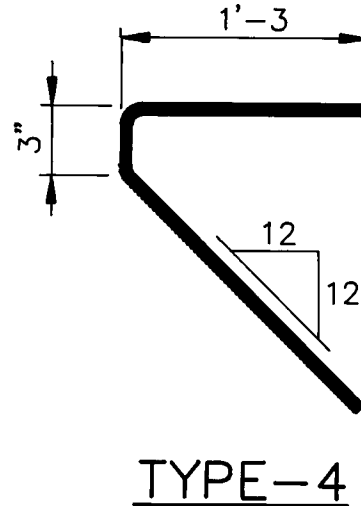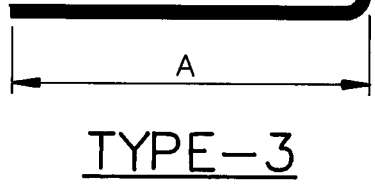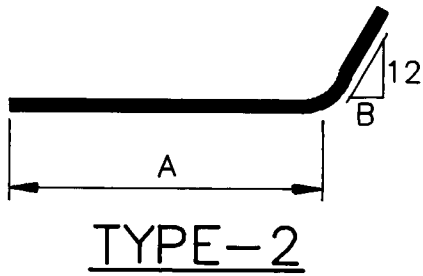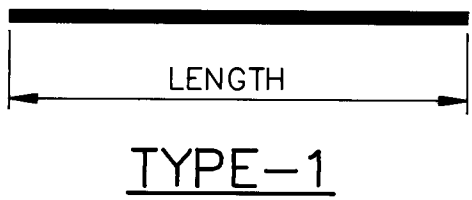

24-4018.911 0996


CITY OF ALBUQUERQUE PUBLIC WORKS DEPARTMENT ENGINEERING GROUP					
TITLE: COAL AVENUE OVERPASS REHABILITATION REINFORCING BAR SCHEDULE					
APPROVALS	ENGINEER	DATE	APPROVALS	ENGINEER	DATE
DRC CHAIRMAN	<i>[Signature]</i>	6-17-96	WATER	N/A	N/A
TRANSPORTATION	<i>[Signature]</i>	6-17-96	WASTE WATER	N/A	N/A
HYDROLOGY	N/A				
PROJECT NO.	4018.91	MAP NO. K-14N	SHEET	9	OF 25

AS BUILT INFORMATION		BENCH MARKS		SURVEY INFORMATION		ENGINEER'S SEAL		REVISIONS		DESIGNED BY		DRAWN BY		CHECKED BY	
CONTRACTOR: Moore & Conner Const.	WORK STARTED BY: Moore & Conner Const.	DATE: 10/90	ALBUQUERQUE	DATE: 10/90	DATE: 10/90	DATE: 10/90	DATE: 10/90	DATE: 10/90	DATE: 10/90	DATE: 10/90	DATE: 10/90	DATE: 10/90	DATE: 10/90	DATE: 10/90	DATE: 10/90
VERIFICATION BY: C.O.A.	DATE: 9/95	DATE: 9/95	DATE: 9/95	DATE: 9/95	DATE: 9/95	DATE: 9/95	DATE: 9/95	DATE: 9/95	DATE: 9/95	DATE: 9/95	DATE: 9/95	DATE: 9/95	DATE: 9/95	DATE: 9/95	DATE: 9/95
MICRO-FILM INFORMATION		RECORDED BY		DATE		NO.		NO.		NO.		NO.		NO.	

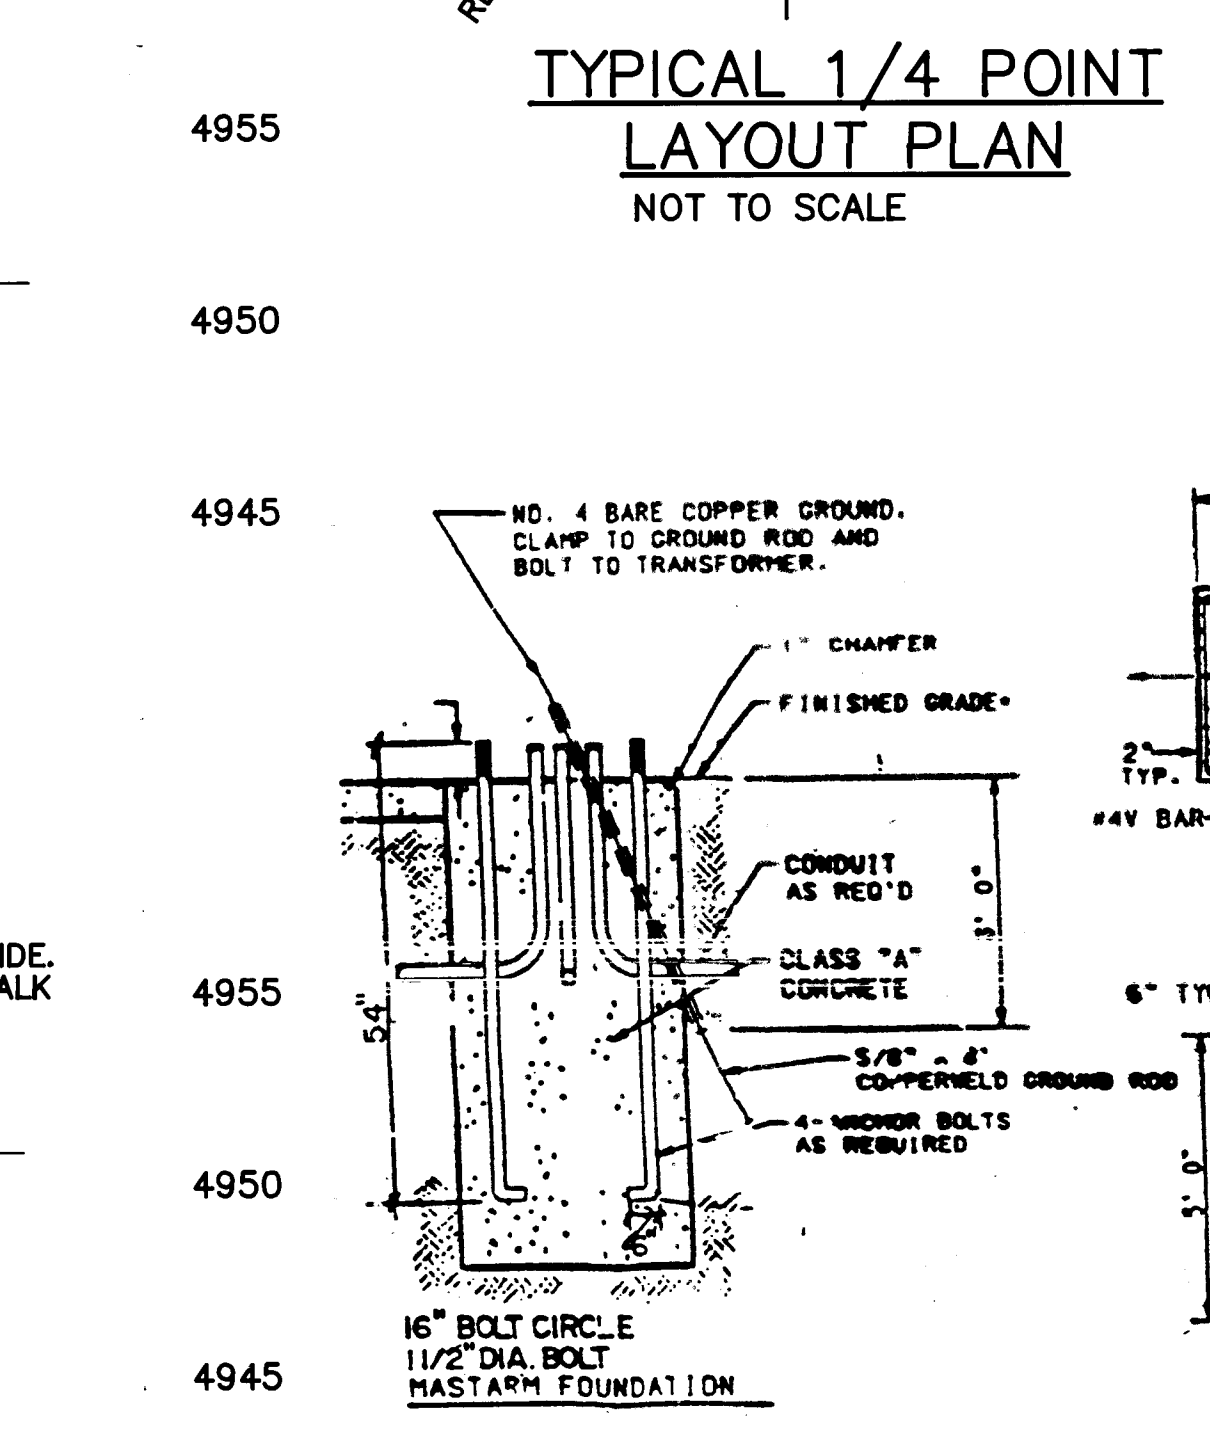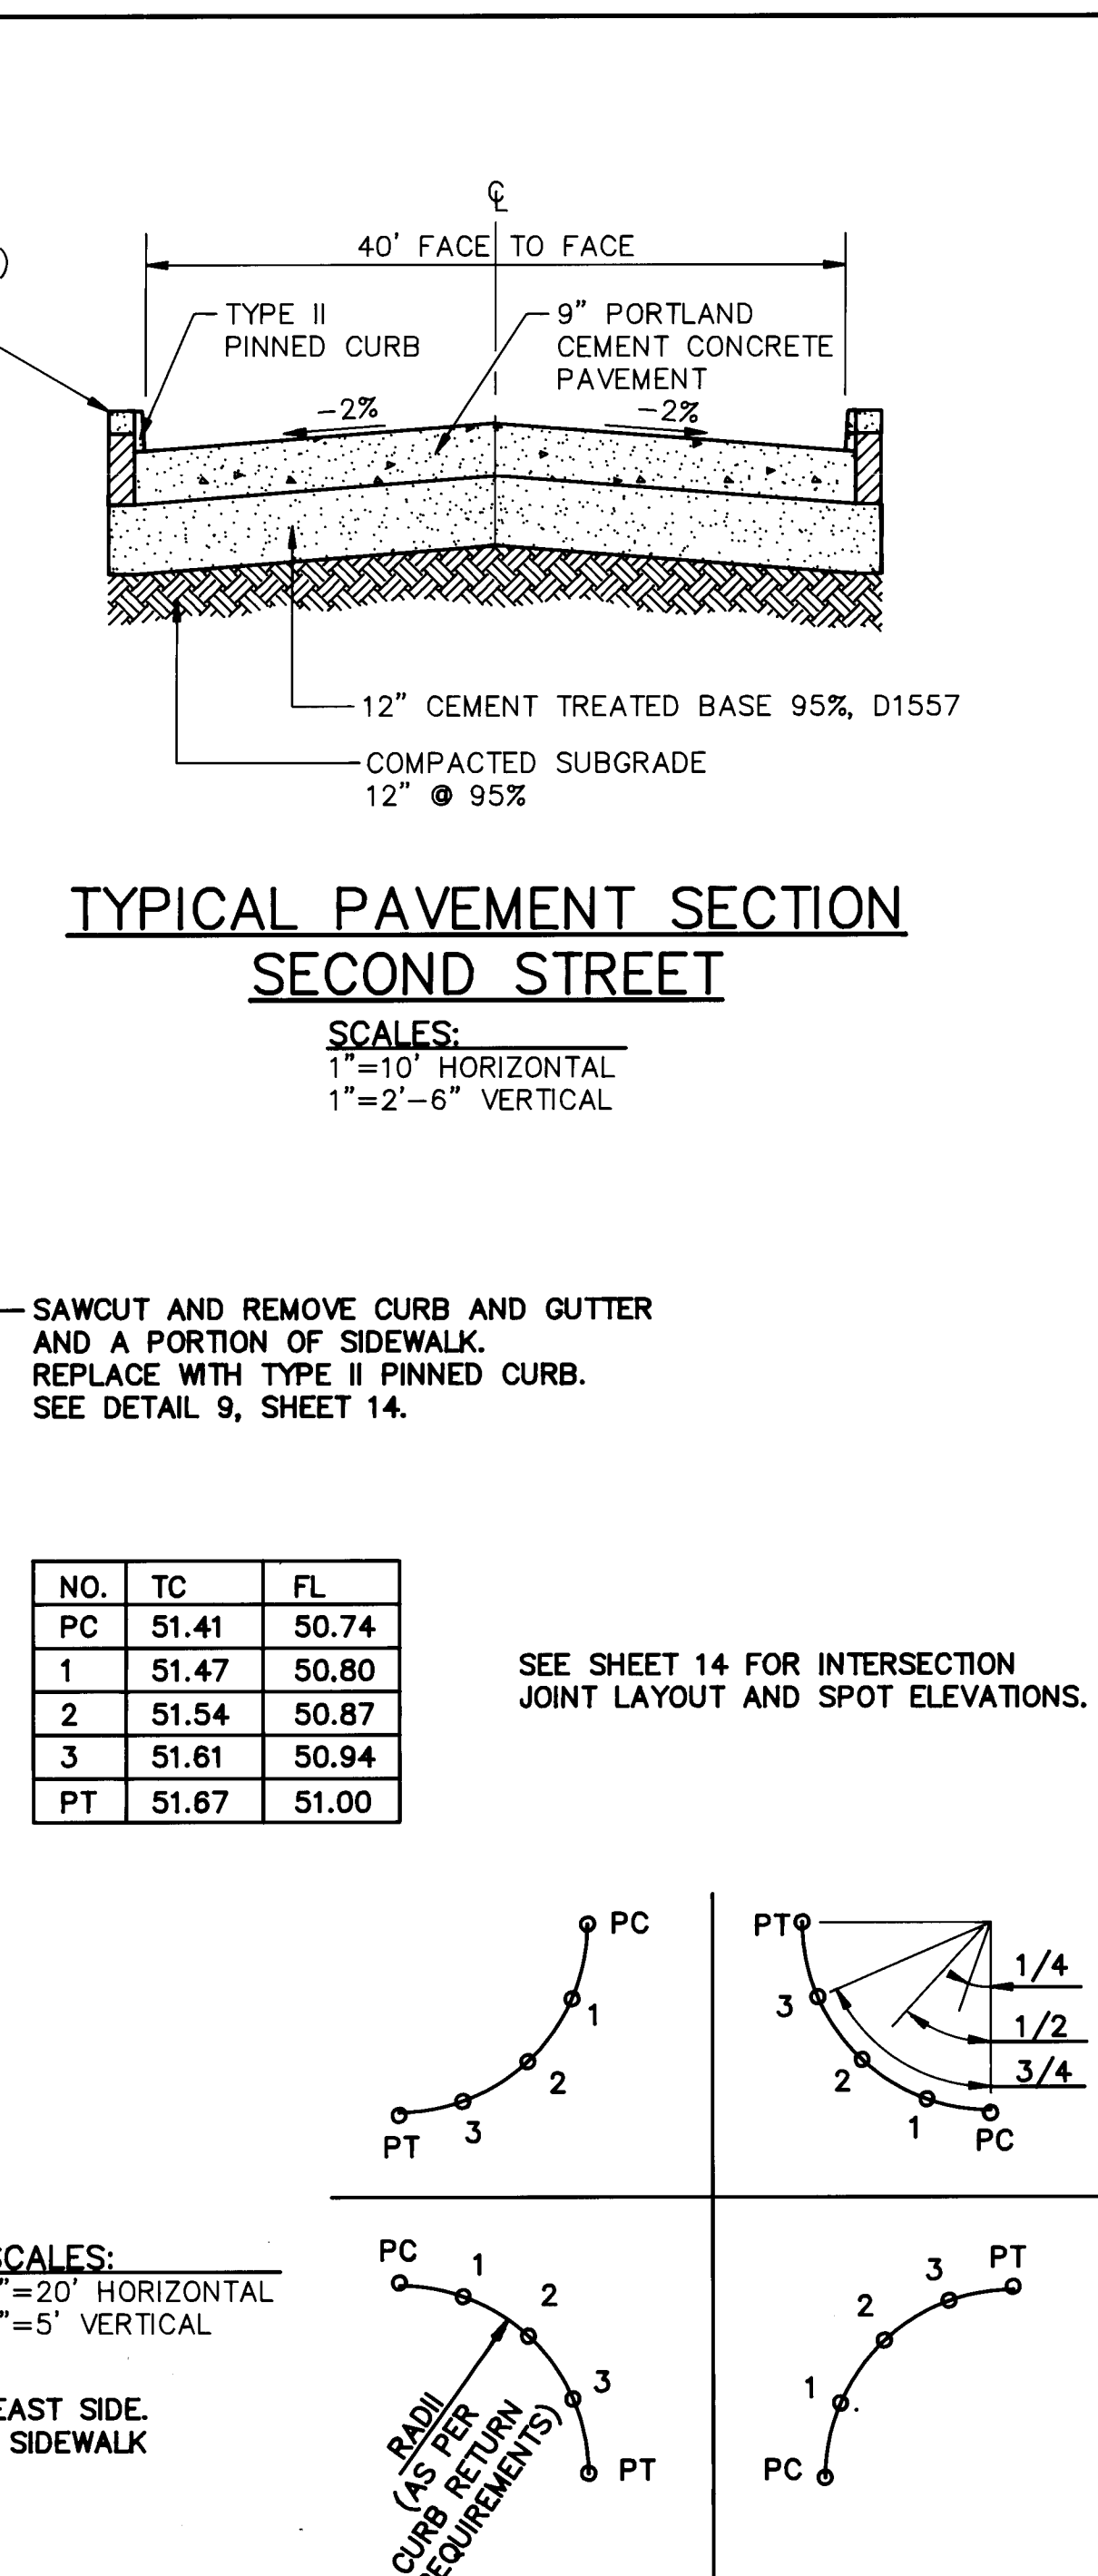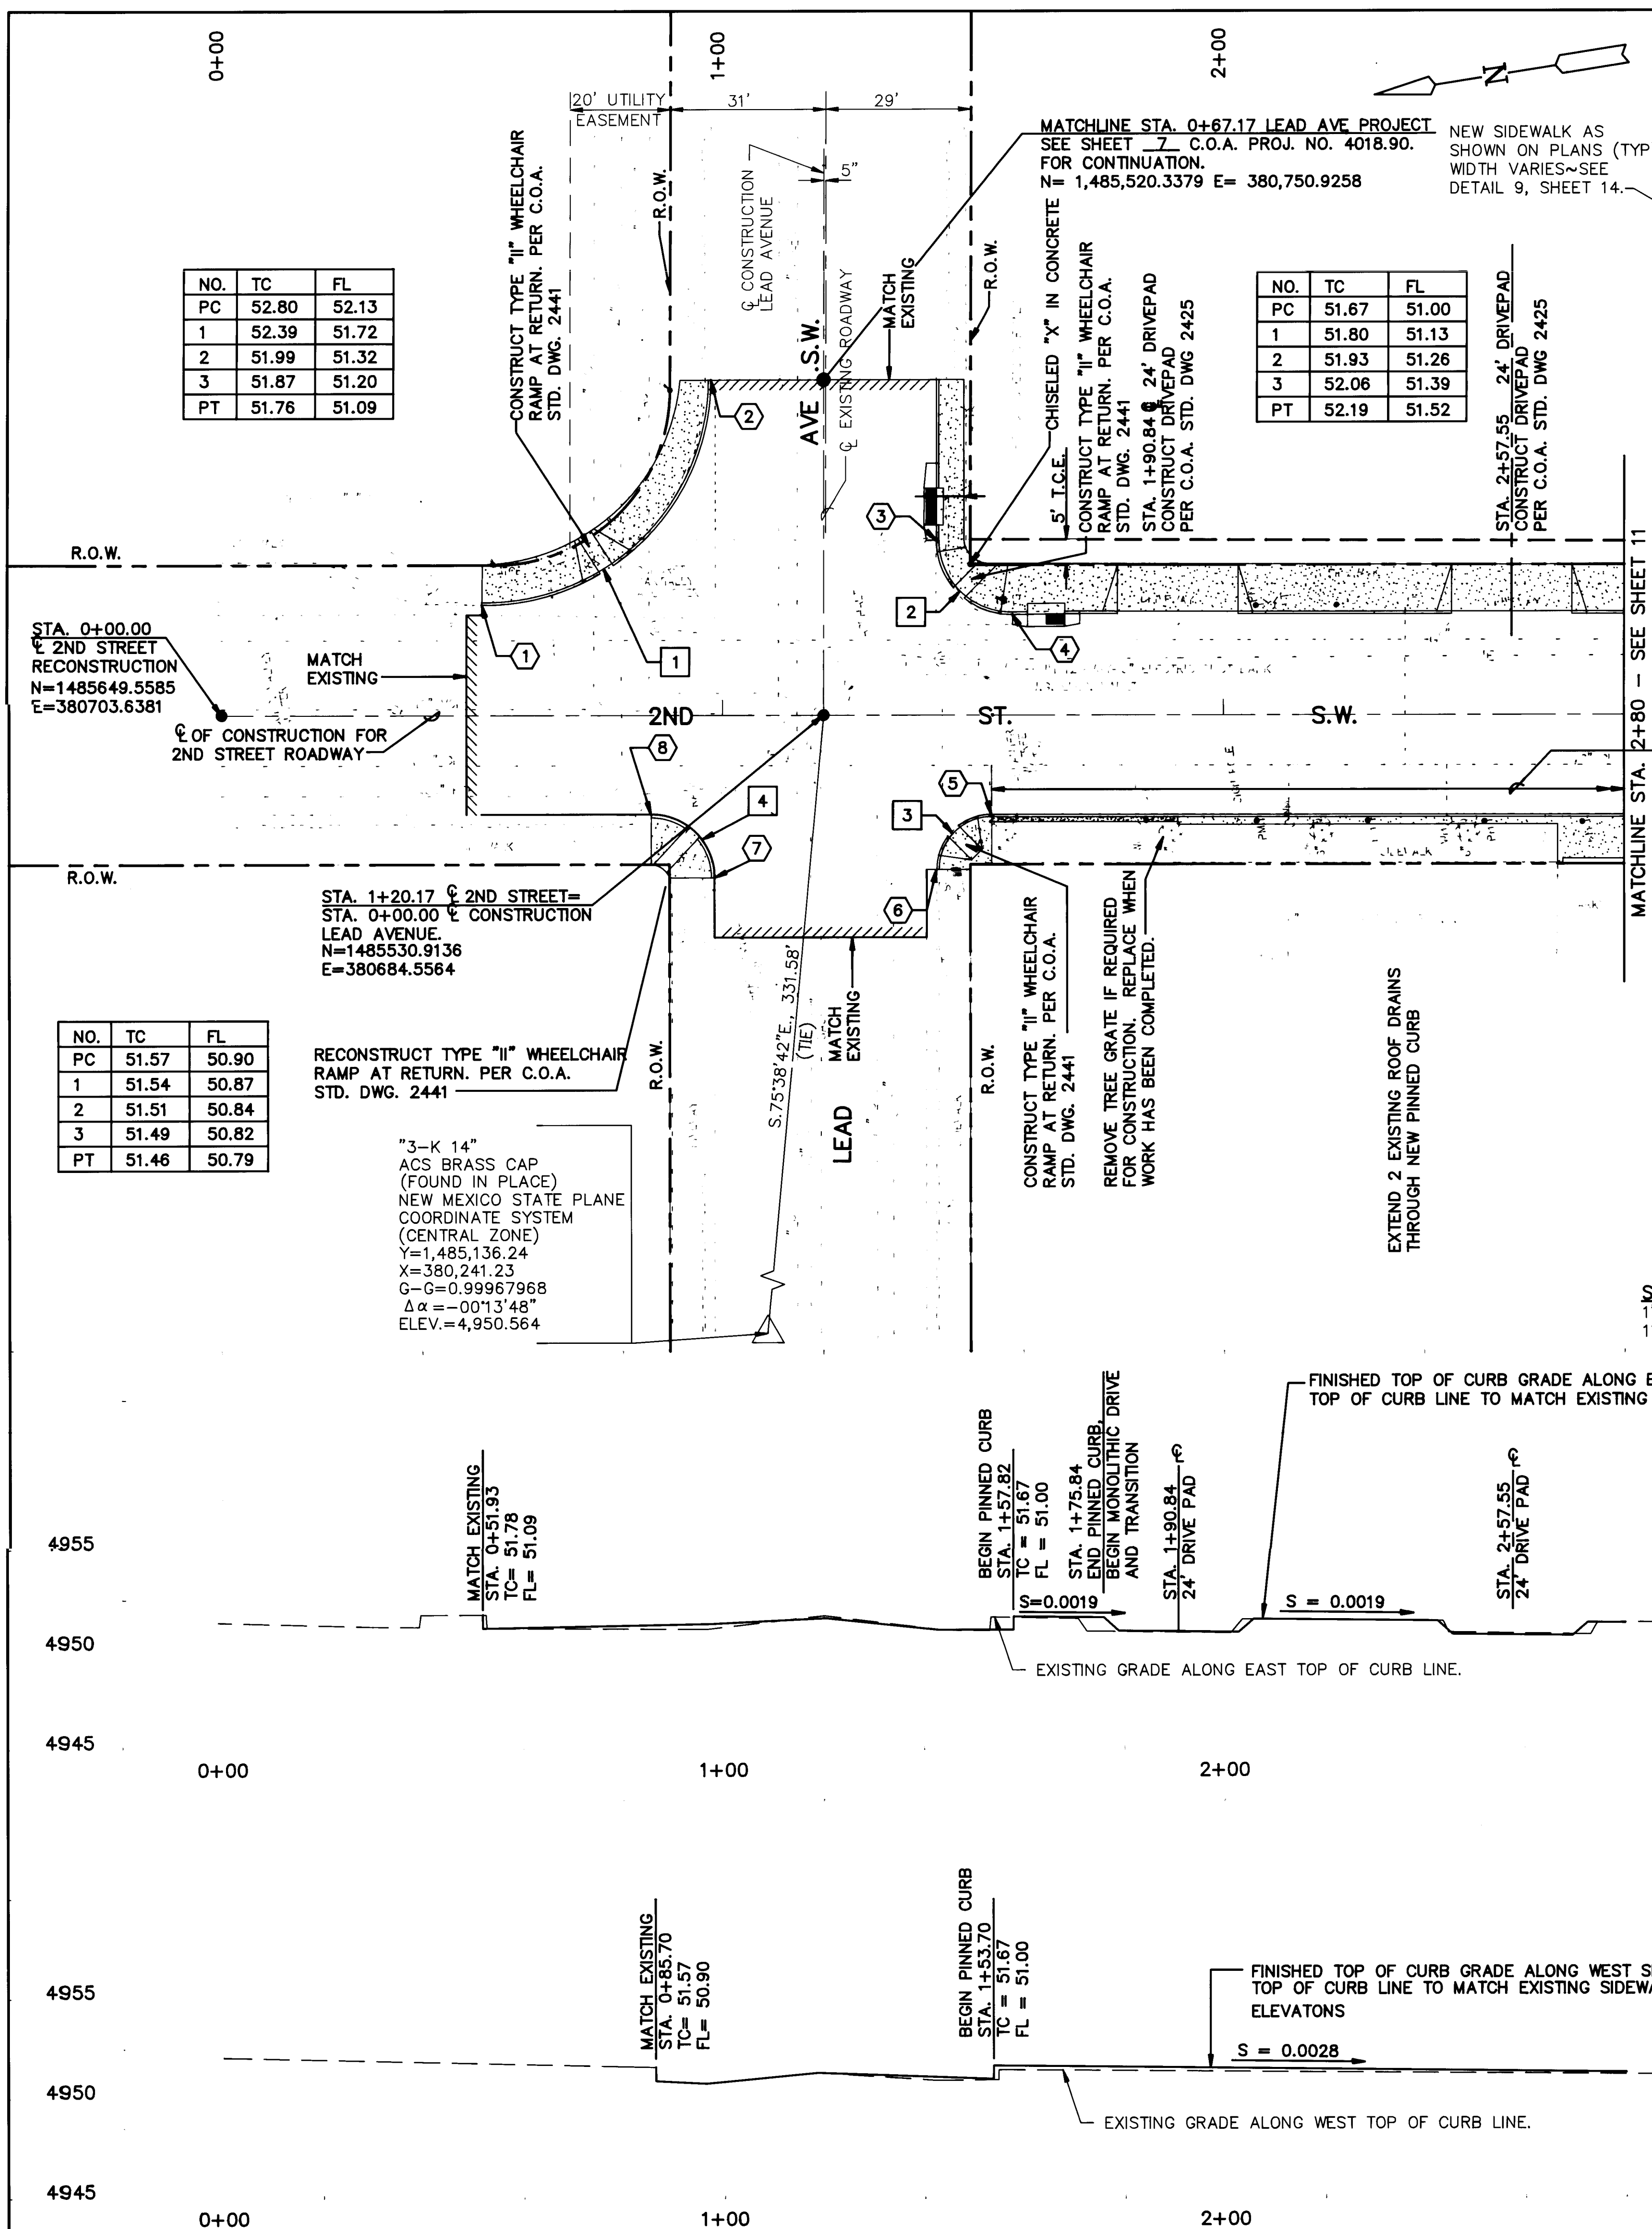

L E G E N D		NOTES		AS BUILT INFORMATION																																																									
POWER POLE POWER POLE (METAL/H.V.) ANCHOR LIGHT POLE PARKING METER GUARD POST TRAFFIC SIGN CABLE TELEVISION BOX ELECTRIC BOX TRAFFIC CONTROL BOX TRAFFIC SIGNAL LIGHT TELEPHONE RISER GAS METER GAS VALVE FIRE HYDRANT WATER METER WATER VALVE WATER FAUCET DROP INLET SPRINKLER VACCUUM BREAKER SIGNAL BOX SPRINKLER CONTROL VALVE CLEAN OUT MANHOLE (STORM) MANHOLE (SANITARY) MANHOLE (ELECTRIC) MANHOLE (TELEPHONE) MANHOLE (UNDETERMINED) TRAFFIC SIGNAL BOX TREE (DECIDUOUS) TREE (EVERGREEN) YUCCA CONCRETE TRANSFORMER PAD OVERHEAD ELECTRIC CABLE LIMIT OF CONSTRUCTION CURB AND GUTTER (NEW) LIMITS OF NEW CONCRETE SIDEWALK AND/OR DRIVEPAD T.C.E. TEMPORARY CONSTRUCTION EASEMENT		1. Ⓢ CONSTRUCTION BASED UPON A "BEST FIT" LINE BETWEEN EXISTING CURBS ON SECOND STREET BETWEEN LEAD AND COAL AVENUES 2. COORDINATES SHOWN HEREON ARE GROUND COORDINATES. 3. Ⓢ CONSTRUCTION NOT ASSOCIATED WITH Ⓢ OF R.O.W. ⬡ OFFSET STATIONING <table><thead><tr><th colspan="2"></th><th>STATION</th><th>OFFSET</th></tr></thead><tbody><tr><td>1</td><td>PT</td><td>OPP. STA. 0+51.93</td><td>22.11' LT.</td></tr><tr><td>2</td><td>PC</td><td>OPP. STA. 0+97.57</td><td>67.17' LT.</td></tr><tr><td>3</td><td>PT</td><td>OPP. STA. 1+42.62</td><td>35.10' LT.</td></tr><tr><td>4</td><td>PC</td><td>OPP. STA. 1+57.82</td><td>20.12' LT.</td></tr><tr><td>5</td><td>PT</td><td>OPP. STA. 1+53.70</td><td>19.90' RT.</td></tr><tr><td>6</td><td>PC</td><td>OPP. STA. 1+42.69</td><td>30.95' RT.</td></tr><tr><td>7</td><td>PT</td><td>OPP. STA. 0+96.38</td><td>34.35' RT.</td></tr><tr><td>8</td><td>PC</td><td>OPP. STA. 0+83.87</td><td>21.85' RT.</td></tr></tbody></table> ⬡ FACE OF CURB CURVE DATA <table><thead><tr><th>DELTA</th><th>RADIUS</th><th>LENGTH</th><th>TANGENT</th></tr></thead><tbody><tr><td>1</td><td>90°54'16"</td><td>45.00'</td><td>71.40' 45.72'</td></tr><tr><td>2</td><td>90°41'33"</td><td>15.00'</td><td>23.74' 15.18'</td></tr><tr><td>3</td><td>90°19'19"</td><td>11.00'</td><td>17.34' 11.06'</td></tr><tr><td>4</td><td>90°01'52"</td><td>12.50'</td><td>19.64' 12.51'</td></tr></tbody></table> 26-4018.91 1096				STATION	OFFSET	1	PT	OPP. STA. 0+51.93	22.11' LT.	2	PC	OPP. STA. 0+97.57	67.17' LT.	3	PT	OPP. STA. 1+42.62	35.10' LT.	4	PC	OPP. STA. 1+57.82	20.12' LT.	5	PT	OPP. STA. 1+53.70	19.90' RT.	6	PC	OPP. STA. 1+42.69	30.95' RT.	7	PT	OPP. STA. 0+96.38	34.35' RT.	8	PC	OPP. STA. 0+83.87	21.85' RT.	DELTA	RADIUS	LENGTH	TANGENT	1	90°54'16"	45.00'	71.40' 45.72'	2	90°41'33"	15.00'	23.74' 15.18'	3	90°19'19"	11.00'	17.34' 11.06'	4	90°01'52"	12.50'	19.64' 12.51'	CONTRACTOR MOORE & COMPANY CORP. WORK STARTED BY MOORE & COMPANY DATE 6/94 ACCEPTANCE BY C.O.A. DATE 9/95 PERMIT BY C.O.A. DATE 9/95 DRAWINGS PREPARED BY DAVID ENG. DATE 10/95 CORRECTED BY DAVID ENG. DATE 10/95 MICRO-FILM INFORMATION RECORDED BY DATE	
		STATION	OFFSET																																																										
1	PT	OPP. STA. 0+51.93	22.11' LT.																																																										
2	PC	OPP. STA. 0+97.57	67.17' LT.																																																										
3	PT	OPP. STA. 1+42.62	35.10' LT.																																																										
4	PC	OPP. STA. 1+57.82	20.12' LT.																																																										
5	PT	OPP. STA. 1+53.70	19.90' RT.																																																										
6	PC	OPP. STA. 1+42.69	30.95' RT.																																																										
7	PT	OPP. STA. 0+96.38	34.35' RT.																																																										
8	PC	OPP. STA. 0+83.87	21.85' RT.																																																										
DELTA	RADIUS	LENGTH	TANGENT																																																										
1	90°54'16"	45.00'	71.40' 45.72'																																																										
2	90°41'33"	15.00'	23.74' 15.18'																																																										
3	90°19'19"	11.00'	17.34' 11.06'																																																										
4	90°01'52"	12.50'	19.64' 12.51'																																																										
		BENCH MARKS		SURVEY INFORMATION																																																									
		THE STATION IS A STANDARD ALBUQUERQUE CITY BRASS CAP MARKED "3-K14". THE STATION IS LOCATED BEHIND THE CURB IN THE NORTHEAST QUADRANT OF THE INTERSECTION OF THIRD ST. AND LEAD AVE. SW ELEV. = 4950.56 (SECOND ORDER)		FIELD NOTES																																																									
		DATE BY NO.		NO. BY DATE																																																									
				</																																																									

MATCHLINE STA. 2+80 - SEE SHEET 10

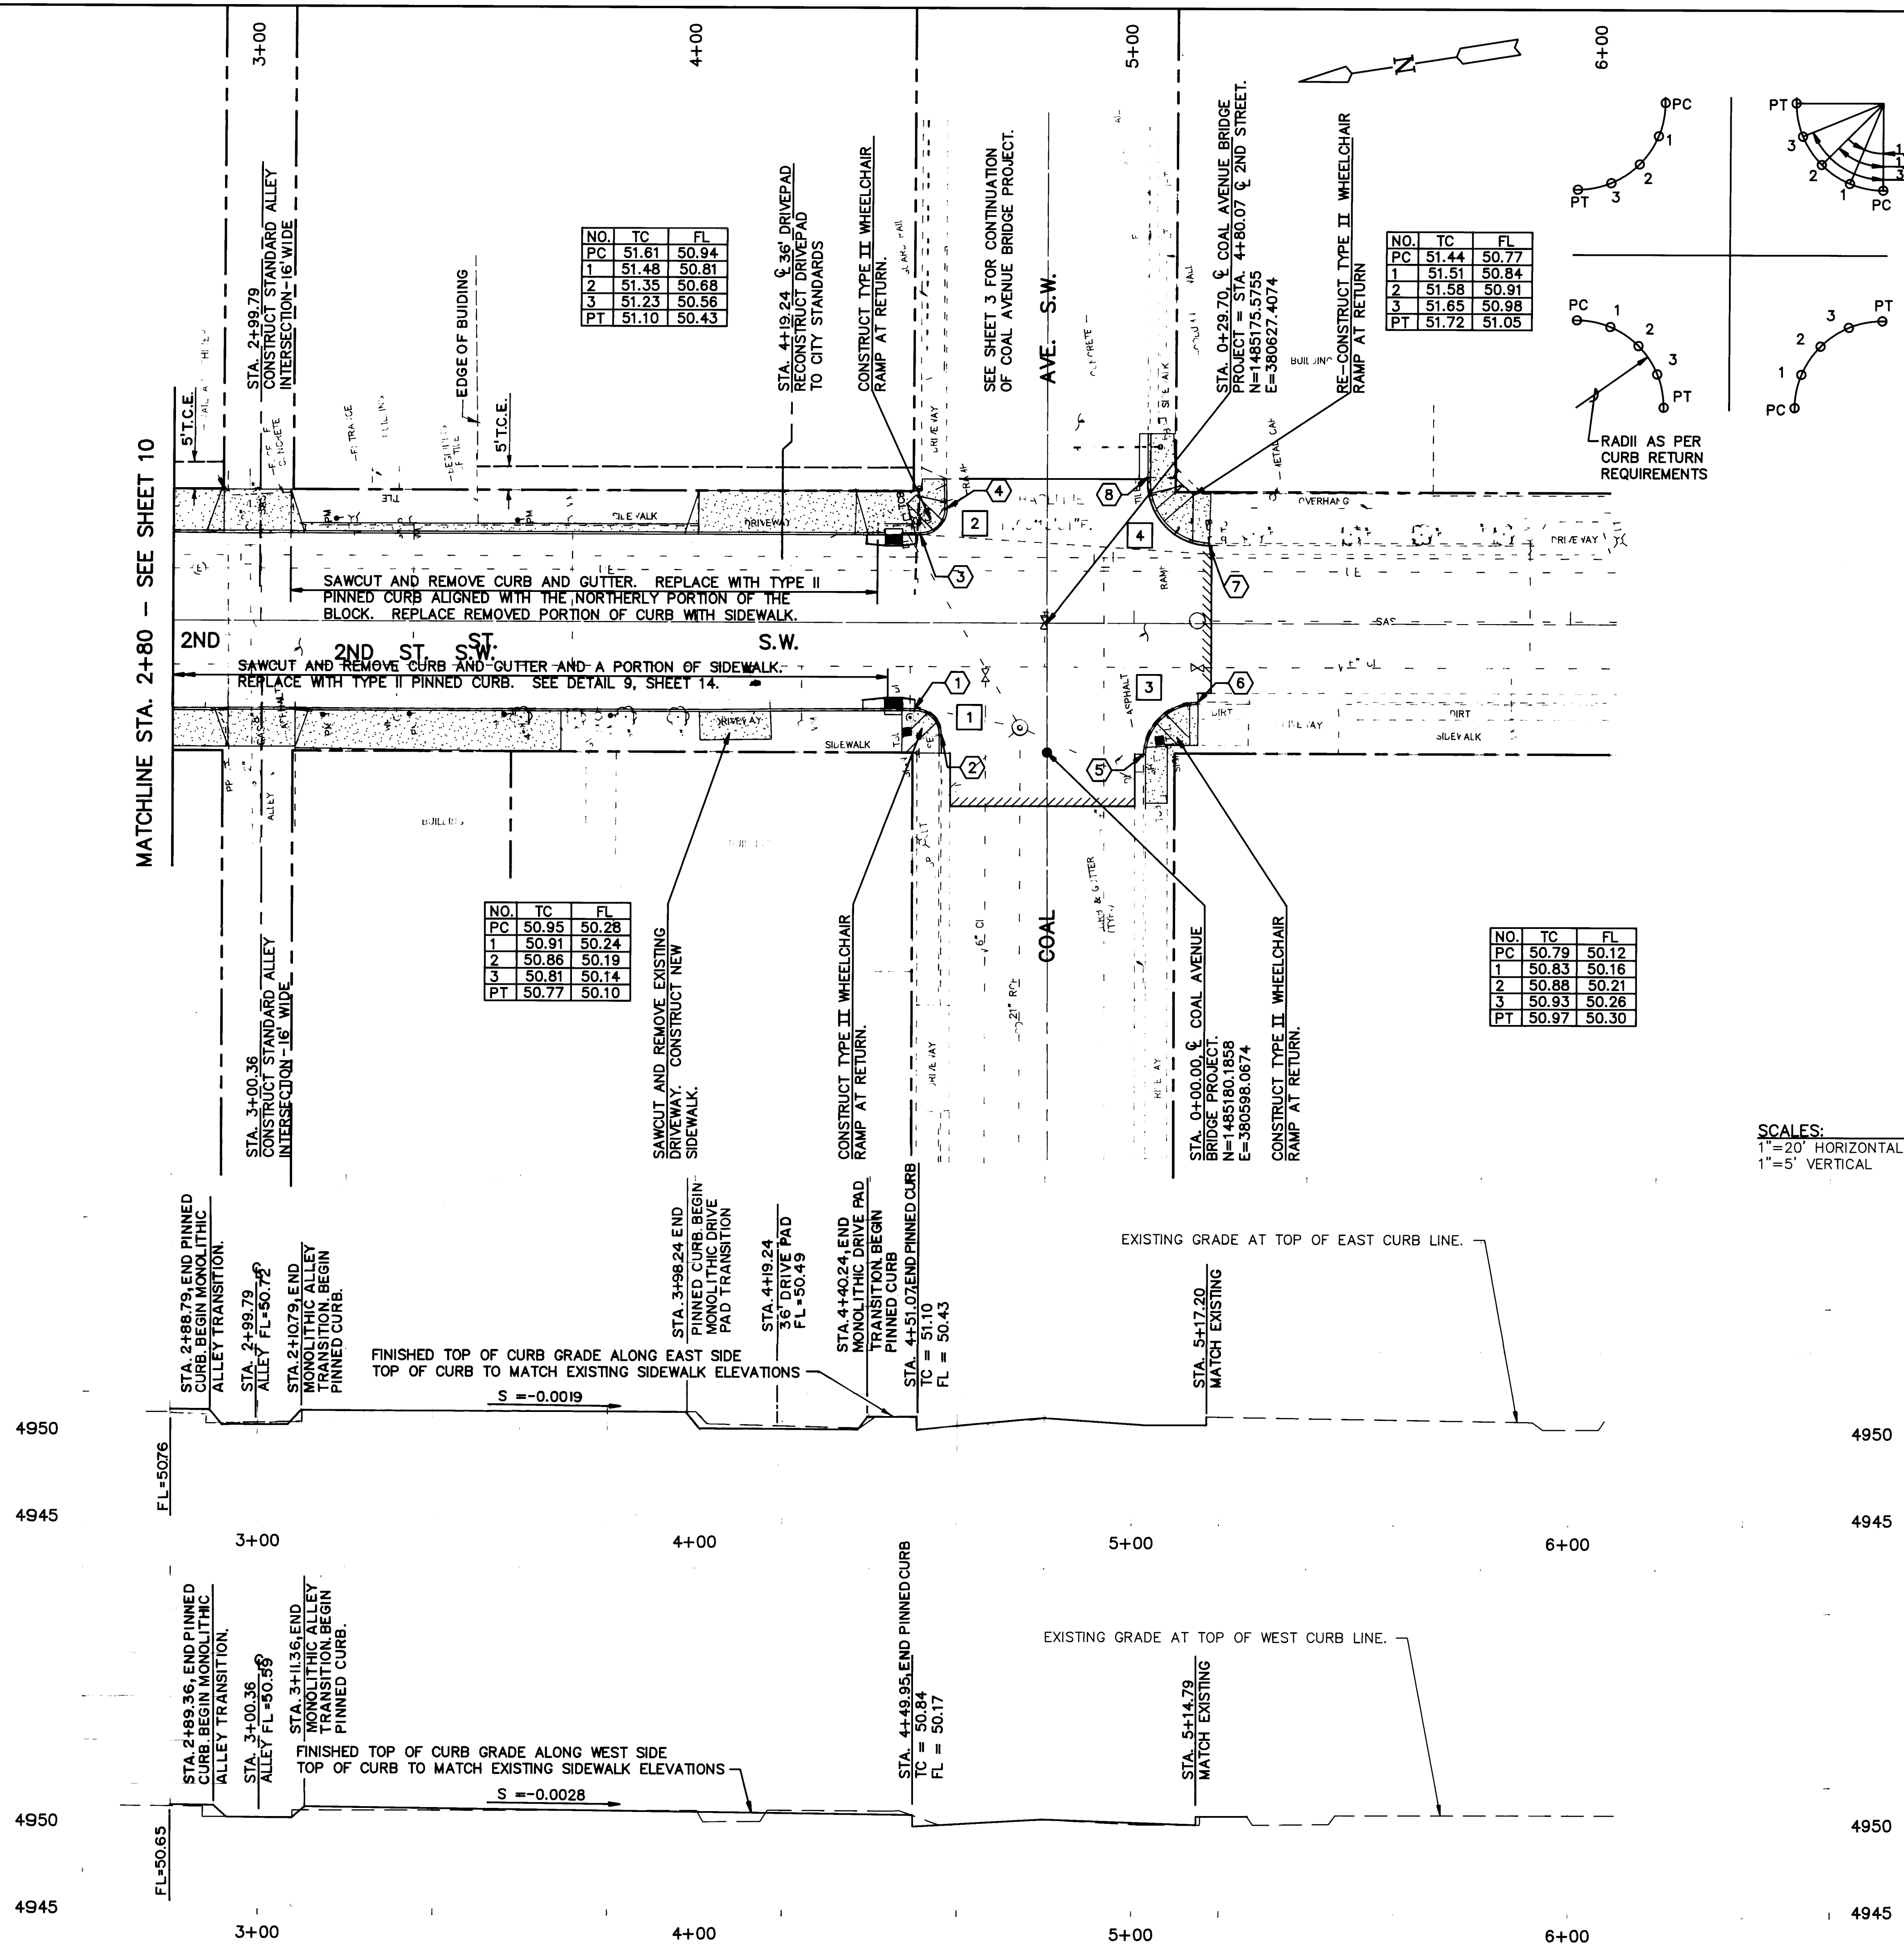

SCALES:
1"=20' HORIZONTAL
1"=5' VERTICAL

LEGEND

- POWER POLE
- POWER POLE (METAL/H.V.)
- ANCHOR
- LIGHT POLE
- PARKING METER
- GUARD POST
- TRAFFIC SIGN
- CABLE TELEVISION BOX
- ELECTRIC BOX
- TRAFFIC CONTROL BOX
- TRAFFIC SIGNAL LIGHT
- TELEPHONE RISER
- GAS METER
- GAS VALVE
- FIRE HYDRANT
- WATER METER
- WATER VALVE
- WATER FAUCET
- DROP INLET
- SPRINKLER
- VACUUM BREAKER
- SIGNAL BOX
- SPRINKLER CONTROL VALVE
- CLEAN OUT
- MANHOLE (STORM)
- MANHOLE (SANITARY)
- MANHOLE (ELECTRIC)
- MANHOLE (TELEPHONE)
- MANHOLE (UNDETERMINED)
- TRAFFIC SIGNAL BOX
- TREE (DECIDUOUS)
- TREE (EVERGREEN)
- YUCCA
- CONCRETE
- TRANSFORMER PAD
- OVERHEAD ELECTRIC CABLE
- LIMIT OF CONSTRUCTION
- CURB AND GUTTER (NEW)
- LIMITS OF NEW CONCRETE SIDEWALK AND/OR DRIVEPAD
- T.C.E. TEMPORARY CONSTRUCTION EASEMENT

NOTES

- CONSTRUCTION BASED UPON A "BEST FIT" LINE BETWEEN EXISTING CURBS ON SECOND STREET BETWEEN LEAD AND COAL AVENUES
- COORDINATES SHOWN HEREON ARE GROUND COORDINATES.
- CONSTRUCTION NOT ASSOCIATED WITH C.O.A. OF R.O.W.

OFFSET STATIONING

STATION		OFFSET	
1	PC	OPP. STA. 4+49.95	19.66' RT
2	PT	OPP. STA. 4+55.99	25.66' RT
3	PT	OPP. STA. 4+51.07	20.14' LT
4	PC	OPP. STA. 4+57.06	26.31' LT
5	PC	OPP. STA. 5+02.30	30.06' RT
6	PT	OPP. STA. 5+14.79	18.03' RT
7	PC	OPP. STA. 5+17.56	17.87' LT
8	PT	OPP. STA. 5+03.04	32.35' LT

FACE OF CURB CURVE DATA

DELTA	RADIUS	LENGTH	TANGENT
1 90°27'18"	6.00'	9.47'	6.05'
2 91°36'40"	6.00'	9.59'	6.17'
3 87°50'09"	12.50'	19.16'	12.04'
4 90°00'10"	14.50'	22.78'	14.50'

AS BUILT INFORMATION

CONTRACTOR	Model 1	DATE	8/91
WORK STARTED BY	Model 1	DATE	8/91
FIELD ACCEPTANCE BY	C.O.A.	DATE	9/91
FIELD CORRECTION BY	C.O.A.	DATE	9/91
DRAWINGS CORRECTED BY	Model 1	DATE	10/91
RECORDED BY	Model 1	DATE	

BENCH MARKS

THE STATION IS A STANDARD ALBUQUERQUE CITY BRASS CAP MARKED "3-K14". THE STATION IS LOCATED BEHIND THE CURB IN THE NORTHEAST QUADRANT OF THE INTERSECTION OF THIRD ST. AND LEAD AVE. SW. ELEV. = 4950.56 (SECOND ORDER)

SURVEY INFORMATION

NO.	DATE	BY
1	10/90	ALBUQUERQUE SURVEY CO. INC.

ENGINEER'S SEAL




REVISIONS

NO.	DATE	REMARKS	BY
1	8/91	DESIGN	TJM
2	8/91	DESIGN	KHK
3	8/91	DESIGN	CD

26-4018.91 1196

20/90027.13CD1/13PP2.DWG/4-3-92/MRL

CITY OF ALBUQUERQUE PUBLIC WORKS DEPARTMENT ENGINEERING GROUP					
TITLE: RECONSTRUCTION AND REHABILITATION OF THE COAL AVENUE BRIDGE AND 2ND STREET, S.W. PAVING PLAN AND PROFILE STA. 2+80 TO STA. 6+00					
APPROVALS	ENGINEER	DATE	APPROVALS	ENGINEER	DATE
DRC CHAIRMAN			WATER	H. Olson	4-22-92
TRANSPORTATION			WASTE WATER	ALL	
HYDROLOGY					
PROJECT NO.	4018.91	MAP NO.	K-14N	SHEET	11 OF 25

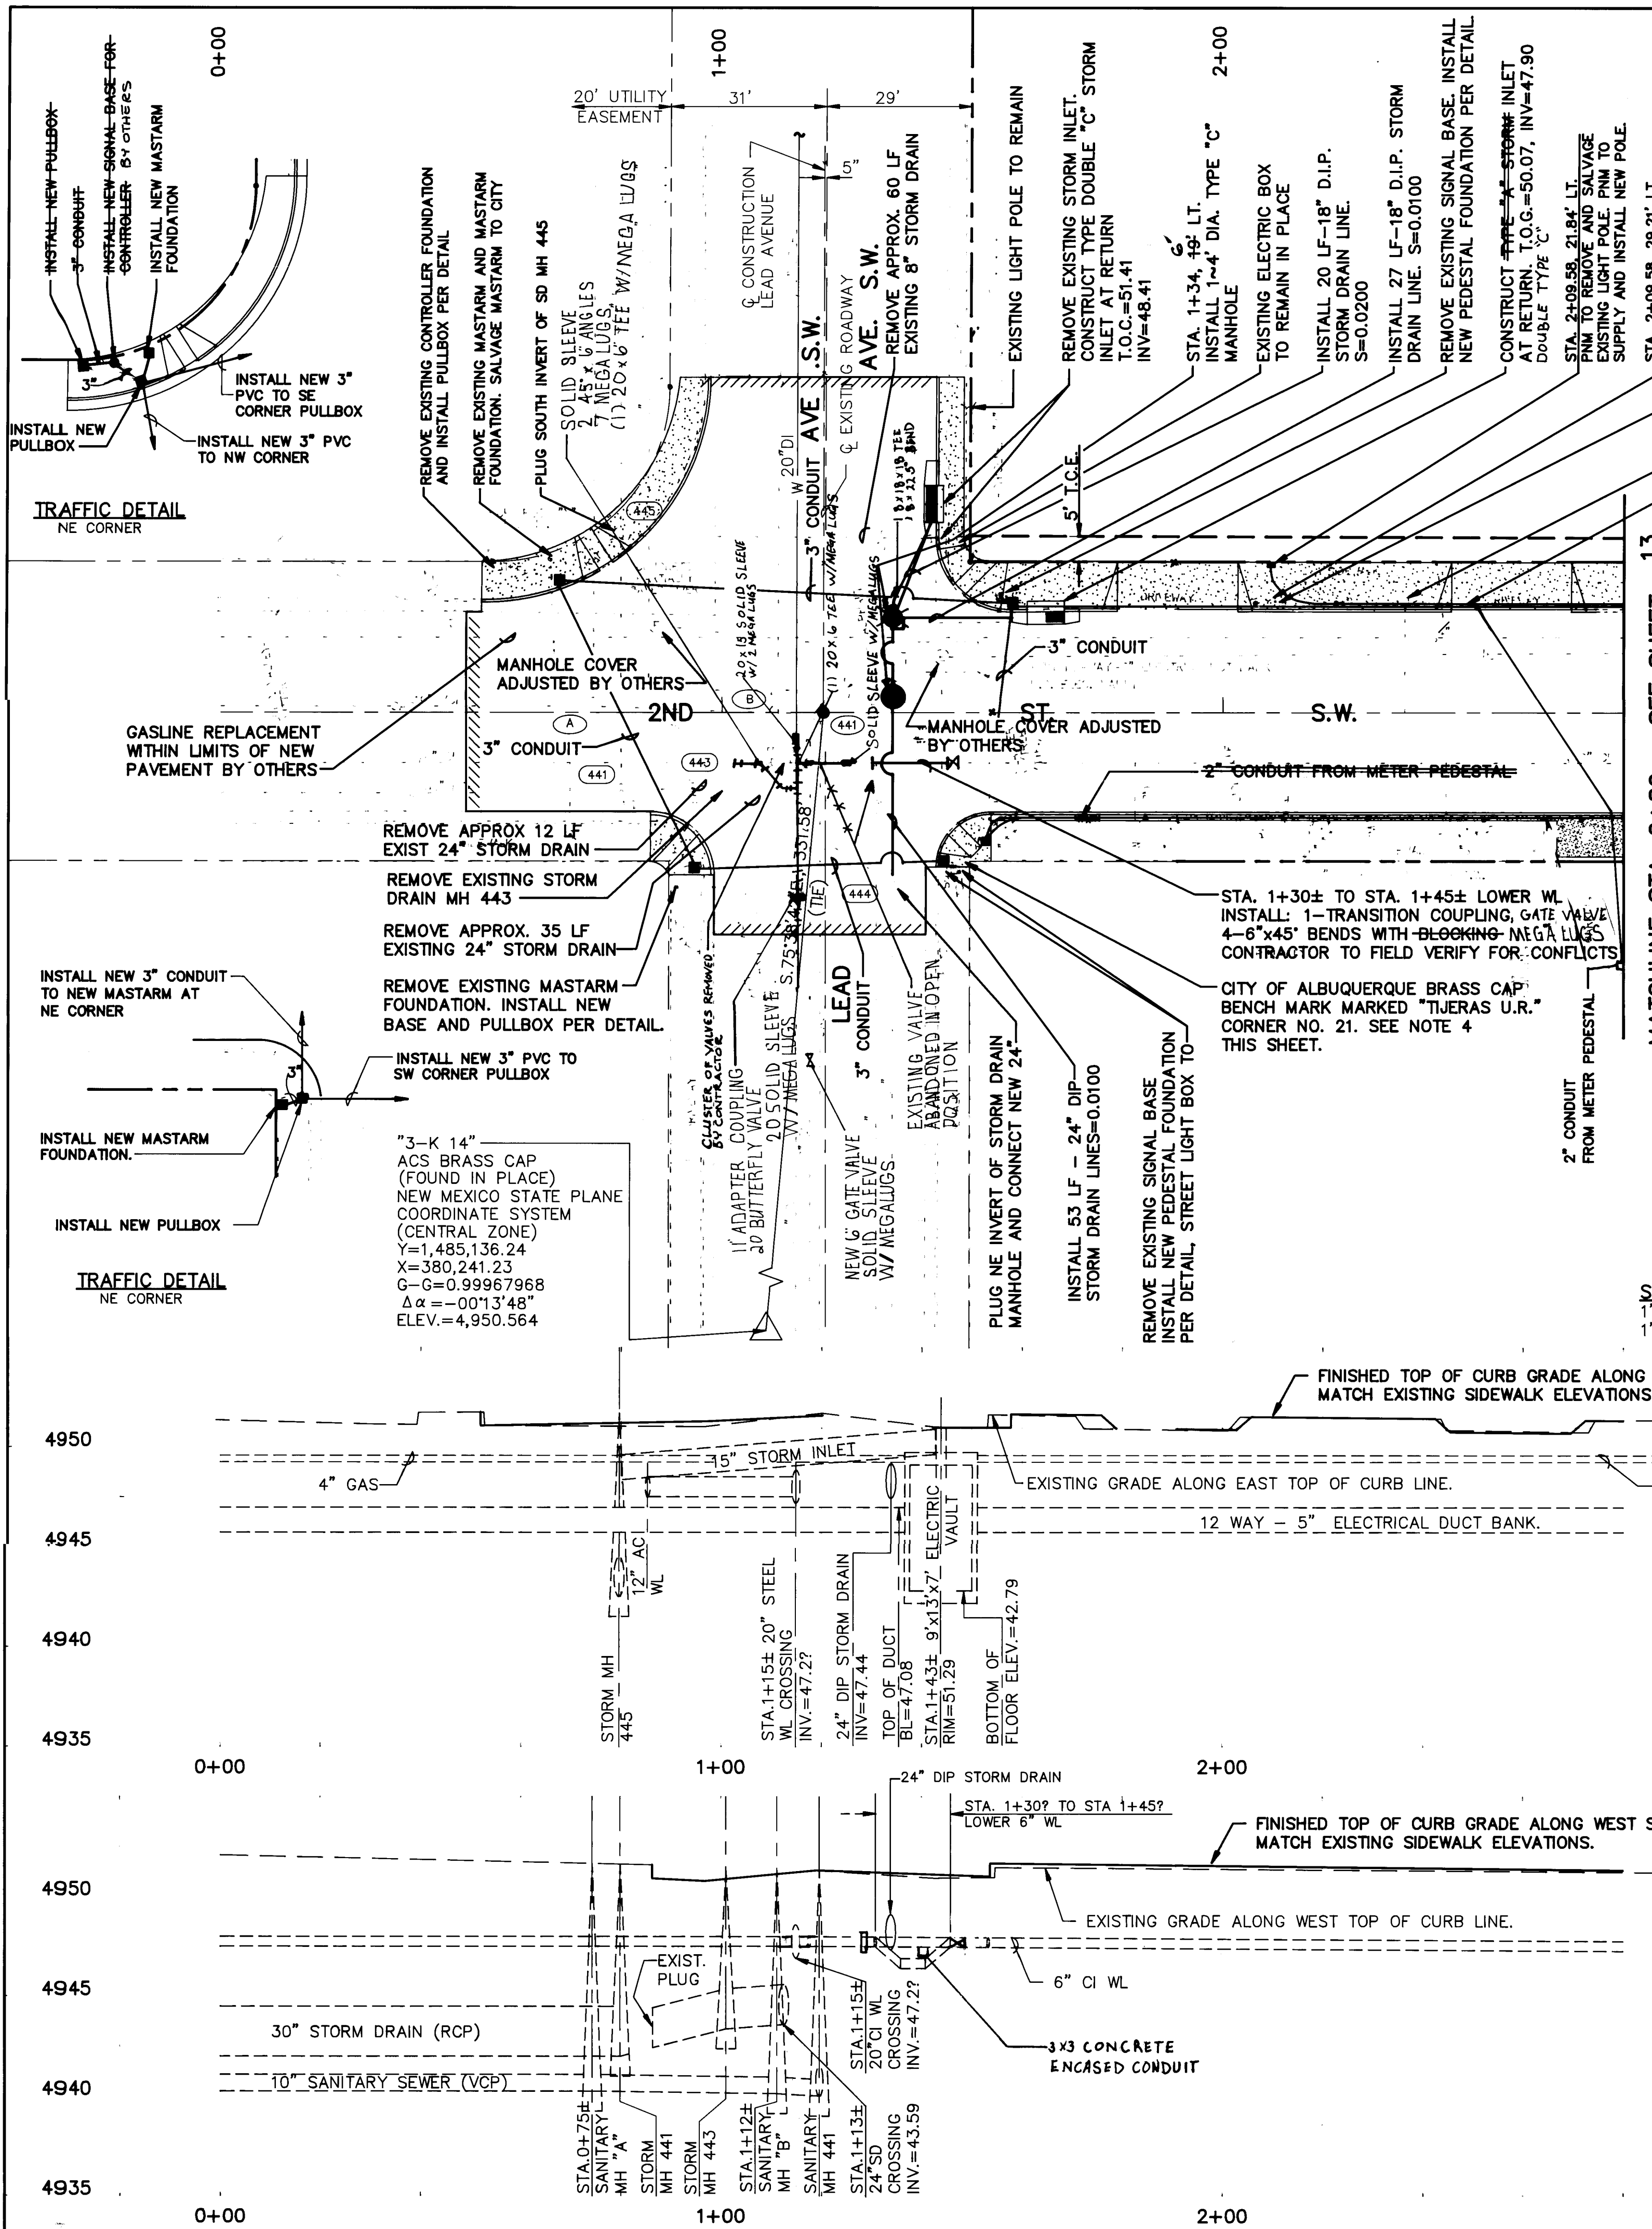


SCALES:
1"=20' HORIZONTAL
1"=5' VERTICAL

NOTICE TO CONTRACTOR:
IT IS THE INTENTION OF AT&T COMMUNICATIONS TO
INSTALL A 4" CONDUIT FOR AN INTERCONTINENTAL
FIBER OPTIC LINE ALONG THE EAST SIDE OF 2ND
STREET PRIOR TO THIS CONTRACT. FIELD VERIFICATION
OF THE LINE WILL BE REQUIRED.

NOTE:

- 1) LOCATIONS OF NEW SIGNAL FOUNDATIONS AND PULL BOXES ARE SCHEMATIC AND SHOULD BE LOCATED OUT OF THE PEDESTRAIN PATH AND AT THE BACK OF SIDEWALK WHEREVER POSSIBLE. THE LOCATIONS ARE TO BE SET IN THE FIELD BY THE CITY TRAFFIC ENGINEER. CONTRACTOR SHALL CONTACT T.E. IN ORDER TO HAVE LOCATION VERIFIED PRIOR TO CONSTRUCTION
- 2) CONTRACTOR SHALL MAINTAIN EXISTING SIGNAL SYSTEM UNTIL ALL NEW FOUNDATIONS ARE IN PLACE. CONTRACTOR SHALL GIVE T.E. 1 WEEK NOTICE AS TO WHEN NEW CONDUITS AND FOUNDATIONS WILL BE IN PLACE. T.E. WILL THEN REMIRE & RELOCATE THE SIGNAL EQUIPMENT. CONTRACTOR WILL THEN BE REQUIRED TO REMOVE ALL EXISTING CONDUITS & FOUNDATIONS.

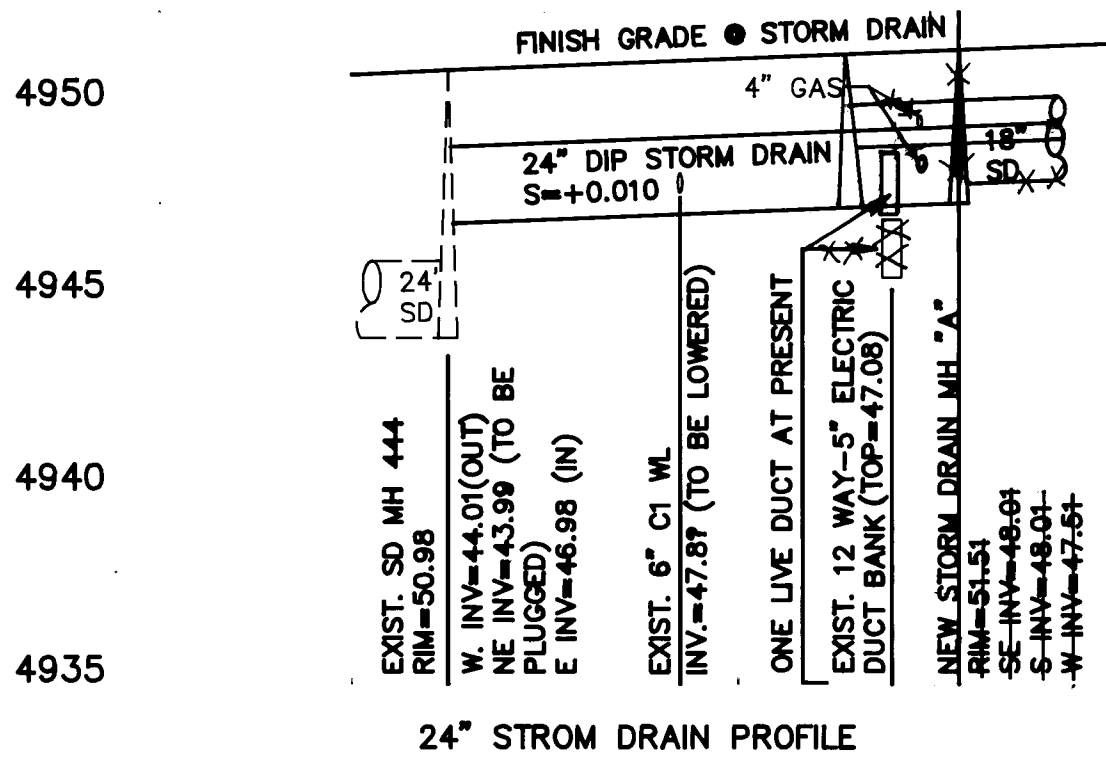

24" STROM DRAIN PROFILE

LEGEND

POWER POLE
POWER POLE (METAL/H.V.)
ANCHOR
LIGHT POLE
PARKING METER
GUARD POST
TRAFFIC SIGN
CABLE TELEVISION BOX
ELECTRIC BOX
TRAFFIC CONTROL BOX
TRAFFIC SIGNAL LIGHT
TELEPHONE RISER
GAS METER
GAS VALVE
FIRE HYDRANT
WATER METER
WATER VALVE
WATER FAUCET
DROP INLET
SPRINKLER
VACCUUM BREAKER
SIGNAL BOX
SPRINKLER CONTROL VALVE

NOTES

1. ALL EXISTING MANHOLES, PULLBOXES AND VALVE BOXES WITHIN THE CONSTRUCTION LIMITS SHALL BE ADJUSTED TO THE NEW FINISH GRADE AS PART OF THE PAVING OPERATIONS.
2. TWO WORKING DAYS PRIOR TO ANY EXCAVATION, CONTRACTOR MUST CONTACT NEW MEXICO ONE-CALL SYSTEM, (505) 260-1990, FOR LOCATION OF EXISTING UTILITIES.
3. LOCATION OF EXISTING VALVE COVERS AND MANHOLE COVERS WERE DETERMINED BY FIELD SURVEY. CONTRACTOR TO FIELD VERIFY ACTUAL ALIGNMENT OF VALVES AFTER EXCAVATION.
4. THE CONTRACTOR SHALL CONTACT THE CITY SURVEYOR FOURTEEN (14) DAYS IN ADVANCE OF CONSTRUCTION WHICH MAY DISTURB EXISTING CITY SURVEY MONUMENTS. CONTACT DANNY MONTANO AT 768-3612.
5. CITY OF ALBUQUERQUE PERSONNEL TO REMOVE AND REPLACE PARKING METER HEADS. CONTRACTOR SHALL CONTACT THE CITY OF ALBUQUERQUE PARKING DIVISION FOR METER HEAD REMOVAL AND REPLACEMENT.
6. REMOVE PARKING METER POSTS ALONG WEST SIDE OF SECOND STREET PRIOR TO SAWCUTTING. REPLACE AFTER NEW CONSTRUCTION.
7. REMOVE PARKING METER POSTS FROM EAST SIDE OF SECOND STREET. SALVAGE TO CITY.
8. TOP OF GRATE (T.O.G.) AND INVERT (INV) ELEVATIONS ARE INTENDED TO BE MEASURED TO CENTERLINE OF GRATE(S).

TOP OF FOUNDATION SHALL
BE LEVEL AND FLUSH WITH
HIGHEST ADJACENT SIDEWALK
GRADE →

PLAN

DAVIT TYPE STREET LIGHT FOUNDATION
AT BACK OF SIDEWALK


SEE C.O.A. STANDARD DWG. NO. 2530
FOR HARDWARE AND REINFORCEMENT

20/90027.13CD4/13PPIUC.DWG/11-10-93/JDM
CITY OF ALBUQUERQUE
PUBLIC WORKS DEPARTMENT
ENGINEERING GROUP

TITLE:	RECONSTRUCTION AND REHABILITATION OF THE COAL AVENUE BRIDGE AND 2ND STREET, S.W. UTILITY PLAN AND PROFILE STA.1+90.84 TO STA 2+80
--------	--

APPROVALS	ENGINEER	DATE	APPROVALS	ENGINEER
DRC CHAIRMAN	<i>R. J. Lapley</i>	12-20-93	WATER	<i>W. B. Ken</i>
TRANSPORTATION	<i>J. Ward</i>	12-22-93	WASTE WATER	<i>H. Miller</i>
HYDROLOGY	<i>J. Curstine</i>	12-6-93		

PROJECT NO.	4018.91	MAP NO.	K-14N	SHEET 12 OF 2
-------------	---------	---------	-------	---------------

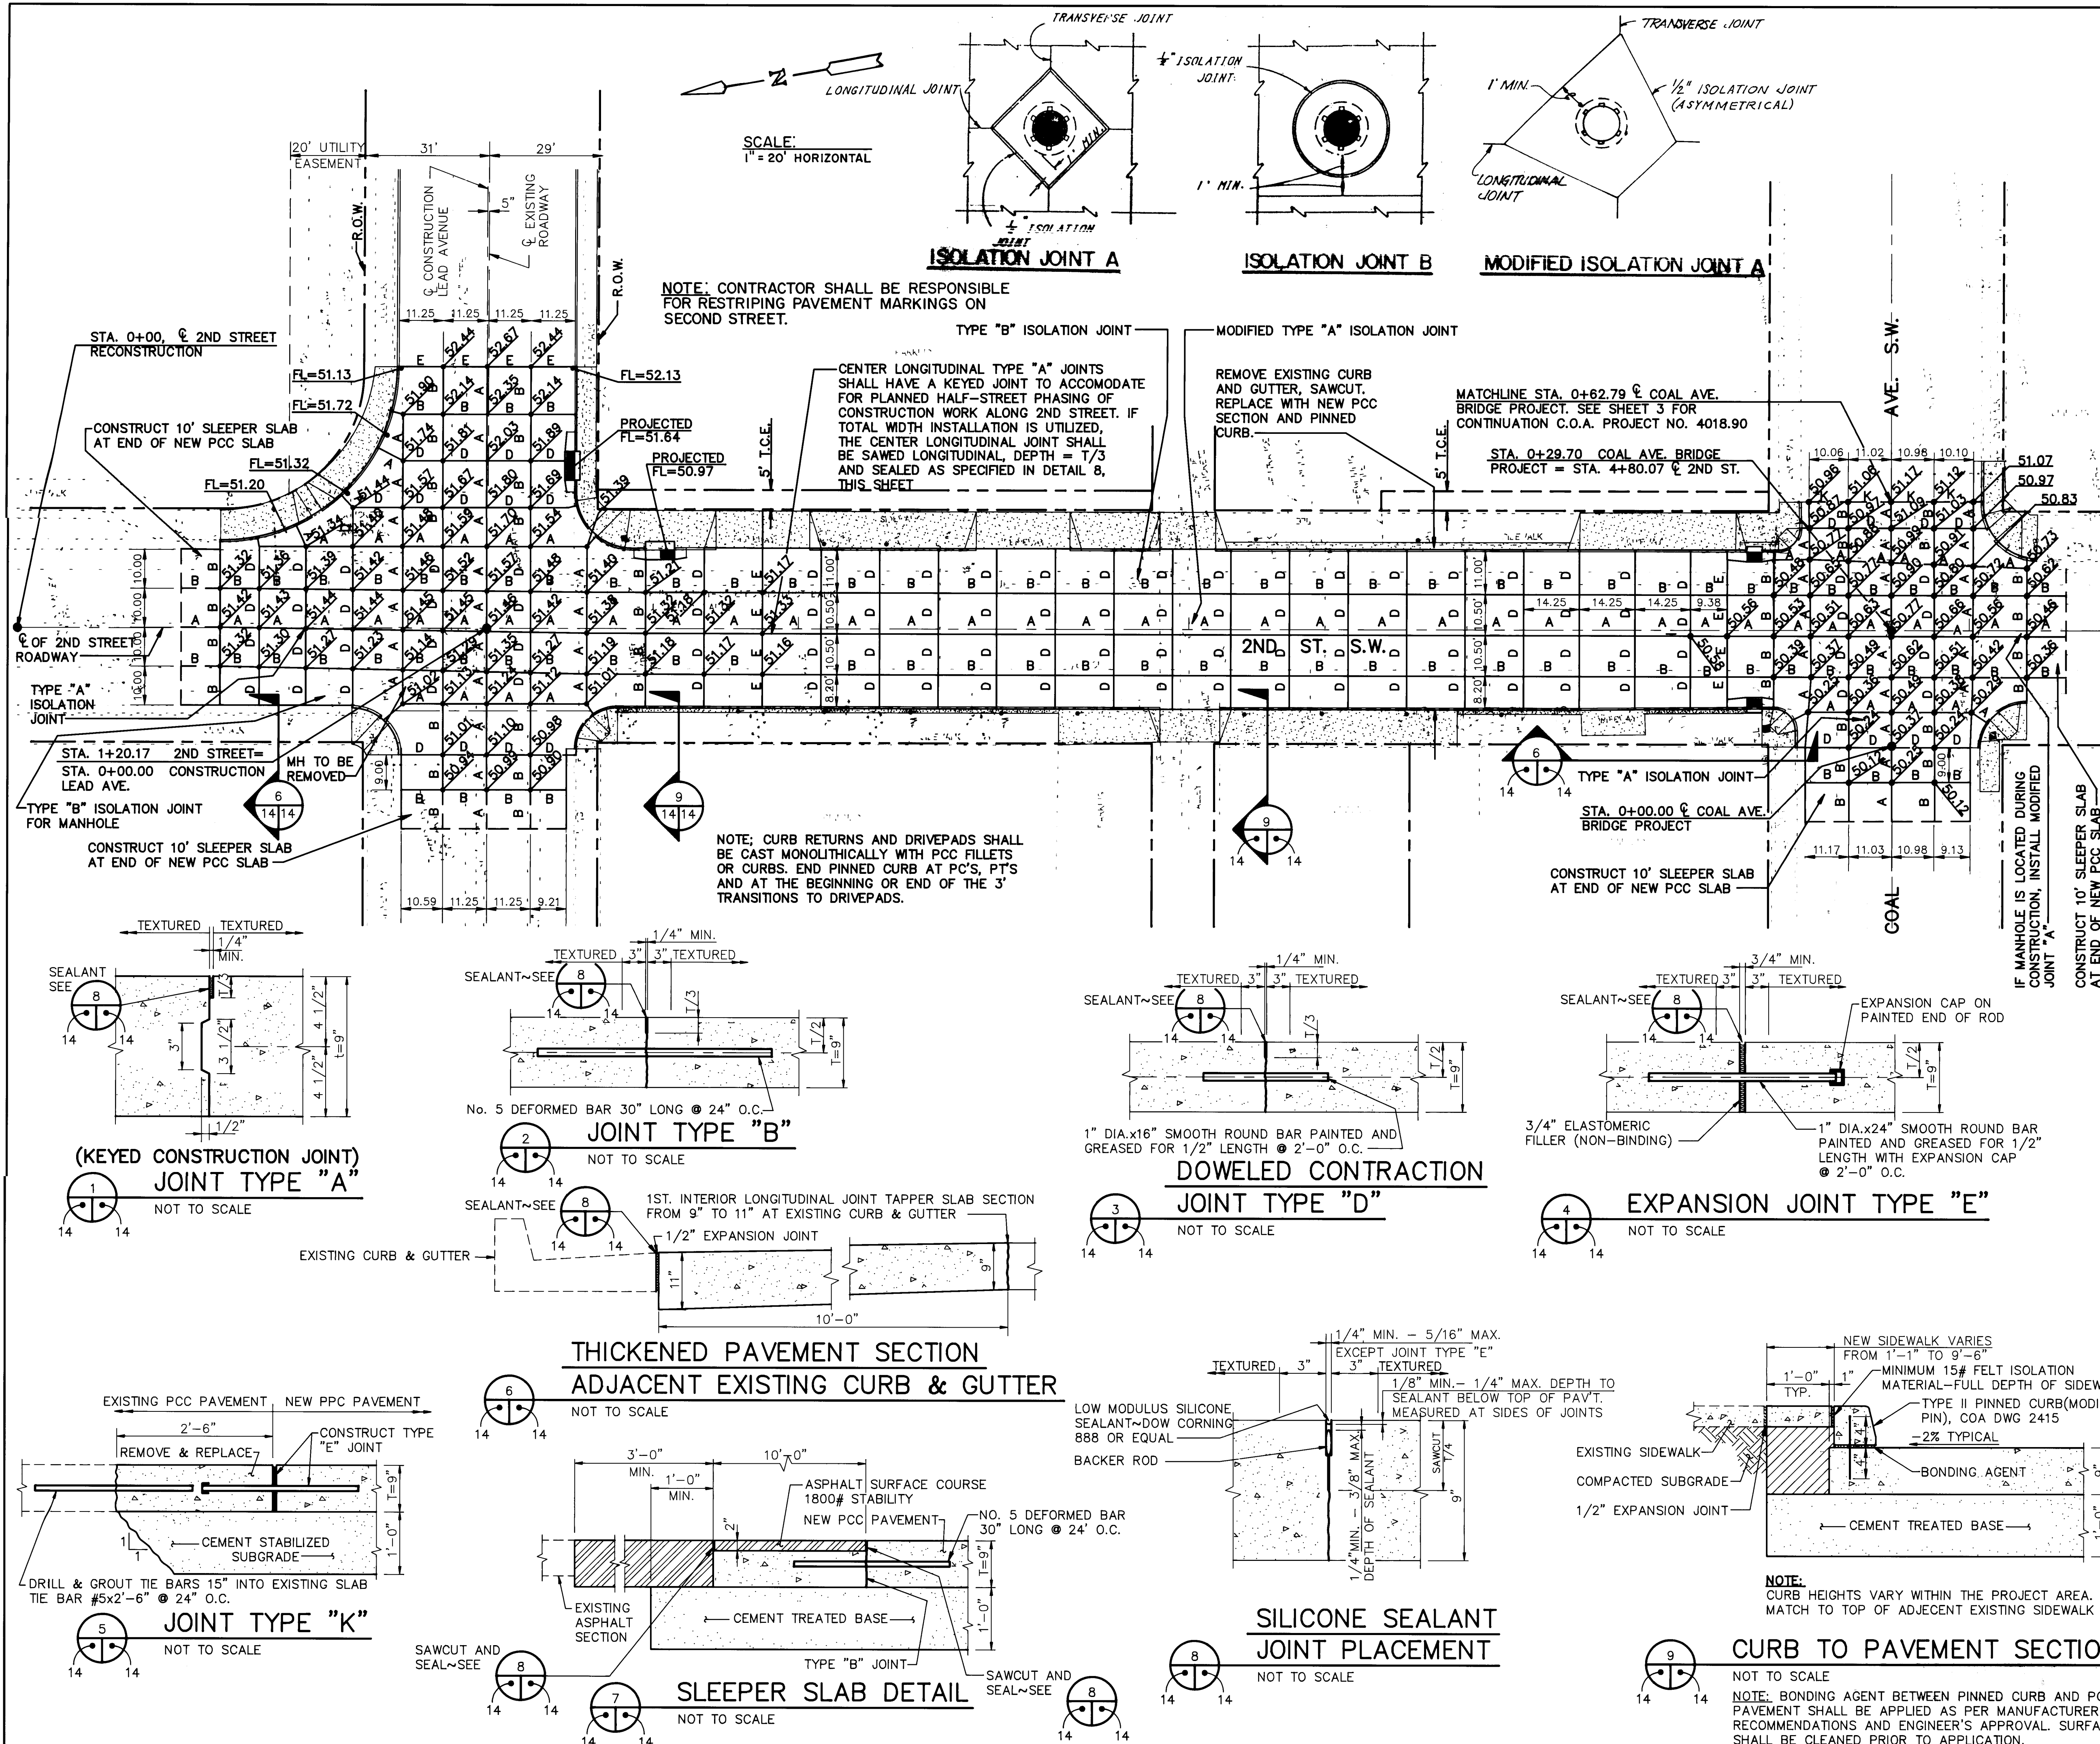

NOTES

1. THE CONTRACTOR SHALL SCHEDULE CONCRETE WORK SO THAT END OF DAYS PAVING ENDS AT A DEFINED CONTRACTION JOINT.

2. CONTRACTOR SHALL SUBMIT A JOINT PLAN FOR REVIEW AND AUTHORIZATION FOR CONSTRUCTION BY THE ENGINEER. NO PCC PAVEMENT CONSTRUCTION SHALL BEGIN WITHOUT AN AUTHORIZED JOINT PLAN.

LEGEND

POWER POLE

POWER POLE (METAL/H.V.)

ANCHOR

LIGHT POLE

PARKING METER

GUARD POST

TRAFFIC SIGN

CABLE TELEVISION BOX

ELECTRIC BOX

TRAFFIC CONTROL BOX

TRAFFIC SIGNAL LIGHT

TELEPHONE RISER

GAS METER

GAS VALVE

FIRE HYDRANT

WATER METER

WATER VALVE

WATER FAUCET

DROP INLET

SPRINKLER

VACUUM BREAKER

SIGNAL BOX

SPRINKLER CONTROL VALVE

CLEAN OUT

MANHOLE (STORM)

MANHOLE (SANITARY)

MANHOLE (ELECTRIC)

MANHOLE (TELEPHONE)

MANHOLE (UNDETERMINED)

TRAFFIC SIGNAL BOX

TREE (DECIDUOUS)

TREE (EVERGREEN)

YUCCA

CONCRETE

TRANSFORMER PAD

OVERHEAD ELECTRIC CABLE

CURB AND GUTTER (NEW)

LIMITS OF NEW CONCRETE SIDEWALK AND/OR DRIVEPAD

XXX

T.C.E.

FINISH ELEVATION

TEMPORARY CONSTRUCTION EASEMENT

AS BUILT INFORMATION

CONTRACTOR: **MOORE & CONWAY CONSULTING**

WORK STARTED BY: **MOORE & CONWAY CONSULTING**

DATE: **12/14/93**

INSPECTED BY: **C.O.A.**

DATE: **12/14/93**

FIELD LOCATION BY: **C.O.A.**

DATE: **12/14/93**

DRAWN BY: **DAVID ENL**

DATE: **12/14/93**

MICRO-FILM INFORMATION

RECORDED BY: **NO.**

DATE: **NO.**

BENCH MARKS

THE STATION IS A STANDARD ALBUQUERQUE CITY BRASS CAP MARKED "3-K14". THE STATION IS LOCATED BEHIND THE CURB IN THE NORTHEAST QUADRANT OF THE INTERSECTION OF THIRD ST. AND LEAD AVE. SW.

ELEV. = 4950.56 (SECOND ORDER)

SURVEY INFORMATION

FIELD NOTES

DATE: **12/14/93**

BY: **NO.**

NO.:

ENGINEER'S SEAL

REVISIONS

NO. DATE

DESIGNED BY: **CD/TJM**

DATE: **11/91**

DRAWN BY: **TJM/KHK**

DATE: **11/91**

CHECKED BY: **CD**

DATE: **11/91**

CITY OF ALBUQUERQUE

PUBLIC WORKS DEPARTMENT

ENGINEERING GROUP

TITLE: **RECONSTRUCTION AND REHABILITATION OF THE COAL AVENUE BRIDGE AND 2ND STREET, S.W. CONCRETE PAVEMENT JOINT LAYOUT & DETAILS STA. 0+00 TO STA. 6+00**

APPROVALS

ENGINEER: **DAVID ENL**

DATE: **12-20-93**

APPROVALS

ENGINEER: **ALLAN**

DATE: **12-7-93**

TRANSPORTATION

DATE: **12-20-93**

WASTE WATER

DATE: **12-7-93**

HYDROLOGY

DATE: **12-20-93**

PROJECT NO. **4018.91**

MAP NO. **K-14N**

SHEET **14** OF **25**

CONSTRUCTION TRAFFIC CONTROL GENERAL NOTES

1. CONTRACTOR MUST OBTAIN FROM CONSTRUCTION COORDINATION AN EXCAVATION/BARRICADING PERMIT BEFORE ENGAGING IN ANY CONSTRUCTION, MAINTENANCE OR REPAIR WORK IN ANY OF THE CITY OF ALBUQUERQUE'S RIGHTS-OF-WAY. EMERGENCY WORK THAT WOULD PRESERVE LIFE OR PROPERTY IS EXCLUDED WITH THE UNDERSTANDING, THAT A PERMIT SHALL BE OBTAINED WITHIN 24 TO 48 HOURS.

2. CONTRACTOR SHALL AT THE TIME OF PERMIT REQUEST, SUBMIT FOR APPROVAL BY CONSTRUCTION COORDINATION, A TRAFFIC CONTROL PLAN DETAILING ALL EXISTING TOPOGRAPHY SUCH AS LANE WIDTHS, DRIVEWAYS, AND BUSINESS/RESIDENTIAL ACCESSES. THE TRAFFIC CONTROL PLAN SHALL INCLUDE ALL PHASES OF WORK AND SCHEDULES INVOLVED IN THE CONSTRUCTION PROJECT. ANY SEPARATE PHASES OF A CONSTRUCTION PROJECT SHALL BE GIVEN AN INDIVIDUAL PERMIT EACH. BLANKET PERMITS WILL NOT BE ISSUED.

3. THESE TYPICAL TRAFFIC CONTROL PLANS DO NOT REFLECT THE EXISTING TOPOGRAPHY SUCH AS DRIVEWAYS, LANE WIDTHS, AND BUSINESS/RESIDENTIAL ACCESSES. EVERY LOCATION THAT REQUIRES CONSTRUCTION TRAFFIC CONTROL SHALL HAVE A DETAILED TRAFFIC CONTROL PLAN SHOWING ALL EXISTING TOPOGRAPHY.

4. CONSTRUCTION SHALL NOT BEGIN UNLESS A TRAFFIC CONTROL PLAN HAS BEEN APPROVED AND VERIFIED BY CONSTRUCTION COORDINATION.

5. CONSTRUCTION COORDINATION SHALL BE NOTIFIED 48 HOURS PRIOR TO ANY TRAFFIC CONTROL CHANGES NEEDED BY CONTRACTOR, THAT WERE NOT PREVIOUSLY APPROVED. THESE TRAFFIC CONTROL CHANGES SHALL BE REQUESTED IN WRITING ACCOMPANIED WITH A TRAFFIC CONTROL PLAN REFLECTING SUCH CHANGES.

6. ALL CONSTRUCTION TRAFFIC CONTROL DEVICES SHALL COMPLY TO THE MANUAL ON UNIFORM TRAFFIC CONTROL DEVICES (MUTCD), LATEST EDITION. IT IS THE RESPONSIBILITY OF THE CONTRACTOR TO INSTALL, SERVICE AND MAINTAIN ALL TRAFFIC CONTROL DEVICES. TRAFFIC CONTROL DEVICES SHALL NOT BE REMOVED OR ALTERED IN ANY WAY WITHOUT THE APPROVAL OF CONSTRUCTION COORDINATION, PER SECTION 6A-4 OF THE MUTCD, LATEST EDITION.

7. THE CONSTRUCTION TRAFFIC CONTROL INITIAL SET-UP SHALL BE BY AN AMERICAN TRAFFIC SAFETY SERVICES ASSOCIATION (ATSSA) CERTIFIED WORKSITE TRAFFIC SUPERVISOR. THE MAINTENANCE AND SERVICING SHALL ALSO BE DONE BY AN ATSSA CERTIFIED WORKSITE TRAFFIC SUPERVISOR OR EQUIVALENT.

8. CONTRACTOR IS RESPONSIBLE TO MAINTAIN AND SERVICE ALL TRAFFIC CONTROL DEVICES 24 HOURS A DAY, 7 DAYS A WEEK THROUGHOUT LENGTH OF PROJECT. CONTRACTOR IS RESPONSIBLE THAT ALL TRAFFIC CONTROL DEVICES COMPLY WITH THE MUTCD, LATEST EDITION.

9. ALL ADVANCE WARNING SIGNS SHALL BE DOUBLE INDICATED WHENEVER THERE ARE MULTI-LANE TRAFFIC IN ANY ONE GIVEN DIRECTION AND THERE IS SUFFICIENT MEDIAN SPACE.

10. ALL BARRICADES IN ALL TAPERS AND TANGENTS SHALL BE PLACED APART, A DISTANCE MEASURED IN FEET, EQUAL TO THAT OF THE POSTED SPEED LIMIT. NO EXCEPTIONS UNLESS APPROVED BY CONSTRUCTION COORDINATION PER MUTCD SECTION 6A-4.

11. CONTRACTOR SHALL NOT BEGIN WORK BEFORE 8:30 A.M. OR END WORK AFTER 4:00 P.M. WITHOUT THE APPROVAL OF CONSTRUCTION COORDINATION.

12. CONTRACTOR IS RESPONSIBLE TO PROVIDE CONSTRUCTION COORDINATION, A WEEKLY LOG OF DAILY INSPECTIONS OF BARRICADE AND MAINTENANCE SCHEDULES ON PROJECTS THAT ARE OVER ONE WEEK DURATION.

13. EQUIPMENT OR MATERIALS SHALL NOT BE STORED WITHIN 15 FEET OF A TRAVELLED TRAFFIC LANE DURING NON-WORKING HOURS WITHOUT THE APPROVAL OF CONSTRUCTION COORDINATION.

14. CONTRACTOR SHALL PROVIDE AND MAINTAIN A SAFE AND ADEQUATE MEANS OF CHANNELIZING PEDESTRIAN TRAFFIC AROUND AND THROUGH THE CONSTRUCTION AREA.

15. CONTRACTOR IS RESPONSIBLE FOR OBLITERATION OF ANY CONFLICTING STRIPING AND RESPONSIBLE FOR ALL TEMPORARY STRIPING.

16. CONTRACTOR SHALL MAINTAIN ACCESS TO ALL FACILITIES, BUSINESSES AND/OR RESIDENTS AT ALL TIMES.

17. CONTRACTOR SHALL PROVIDE ACCESS SIGNS FOR BUSINESSES LOCATED WITHIN THE CONSTRUCTION AREA UNDER THE SUPERVISION OF CONSTRUCTION COORDINATION. EACH ACCESS SIGN SHALL HAVE 5 INCH, WHITE OPAQUE LETTERING ON BLUE REFLECTORIZED BACKGROUND. ACCESS SIGNS SHALL BE CONSIDERED INCIDENTAL TO THE BID AND NOT PART OF THE CONTRACT UNLESS OTHERWISE STATED. NO MORE THAN 3 BUSINESSES SHALL BE LISTED ON A ACCESS SIGN. SHOPPING CENTERS AND MALLS SHALL BE LISTED AS SUCH.

18. ALL ADVANCE WARNING SIGNS SHALL MEET THE MINIMUM REFLECTIVE INTENSITY REQUIREMENTS SET FORTH BY THE CITY OF ALBUQUERQUE. CONSTRUCTION COORDINATION SHALL DETERMINE ALL REQUIREMENTS AND APPROVE OR DISAPPROVE ANY ADVANCE WARNING SIGN PER SECTION 6A-4 OF THE MUTCD, LATEST EDITION.

19. 24 HOURS PRIOR TO OCCUPANCY OR CLOSING OF A RIGHT-OF-WAY, CONTRACTOR SHALL NOTIFY: POLICE, FIRE DEPARTMENT, SCHOOLS, HOSPITALS, TRANSIT AUTHORITY, BUSINESSES AND/OR RESIDENTS THAT WILL BE AFFECTED BY THE CONSTRUCTION.

20. ANY FIELD ADJUSTMENTS SHALL BE APPROVED BY CONSTRUCTION COORDINATION.

21. EXCAVATIONS SHALL BE PLATED, TEMPORARILY PATCHED OR RESURFACED PRIOR TO OPENING OF TRAFFIC. A MINIMUM OF 11 FEET SHALL BE PROVIDED FOR TRAFFIC IN ANY GIVEN DIRECTION. CONTRACTOR IS RESPONSIBLE FOR ANY WORK INVOLVED IN SATISFYING THESE REQUIREMENTS.

22. CONTRACTOR SHALL AT ALL TIMES COMPLY WITH THE FOLLOWING:
1. STANDARDS AND REQUIREMENTS SET FORTH IN THE MANUAL ON UNIFORM TRAFFIC CONTROL DEVICES, LATEST EDITION.
2. THE CITY OF ALBUQUERQUE TRAFFIC CODE, LATEST EDITION.
3. SECTION 19 OF THE CITY OF ALBUQUERQUE'S STANDARD SPECIFICATIONS FOR PUBLIC WORK CONSTRUCTION, AS WELL AS OTHER SECTIONS.

23. FAILURE TO COMPLY WITH ANY OF THE ABOVE MENTIONED, WILL BE ADEQUATE CAUSE TO CEASE ALL WORK ON ANY CONSTRUCTION PROJECT. WORK WILL NOT RESUME UNTIL ALL REQUIREMENTS ARE ADDRESSED AND APPROVED BY CONSTRUCTION COORDINATION.

24. ALL TRAFFIC CONTROL DEVICES SHALL BE KEPT IN NEW-CLEAN CONDITION. WASHING OF EQUIPMENT IS INCIDENTAL TO ITS PLACEMENT AND MAINTENANCE.

25. TRAFFIC CONTROL STANDARDS APPLY ONLY WHERE THE CONSTRUCTION TRAFFIC CONTROL PLANS ARE NOT SPECIFIC.


PROJECT CONSTRUCTION TRAFFIC CONTROL GENERAL NOTES

1. SEE SHEET 17 FOR SEQUENCING AND SPECIAL SIGNS FOR TRAFFIC CONTROL.

2. ANY MODIFICATIONS OR CHANGES TO TRAFFIC CONTROL SHALL CONFORM WITH THE CITY OF ALBUQUERQUE TYPICAL TRAFFIC CONTROL LAYOUTS AND THE LATEST EDITION OF THE M.U.T.C.D., AND APPROVED BY THE ENGINEER.


3. THIS PROJECT'S TRAFFIC CONTROL REQUIRES SIGNALIZATION MODIFICATIONS AND EQUIPMENT. INSTALLATION AND MODIFICATIONS SHALL BE COORDINATED WITH THE CITY OF ALBUQUERQUE. ALL SIGNALIZATION EQUIPMENT AS INDICATED IN THE TRAFFIC CONTROL PLANS SHALL BE INCLUDED IN THE LUMP SUM BID PRICE FOR TRAFFIC CONTROL AND NO ADDITIONAL PAYMENT WILL BE MADE THEREFORE.

SIGN FACE DETAILS

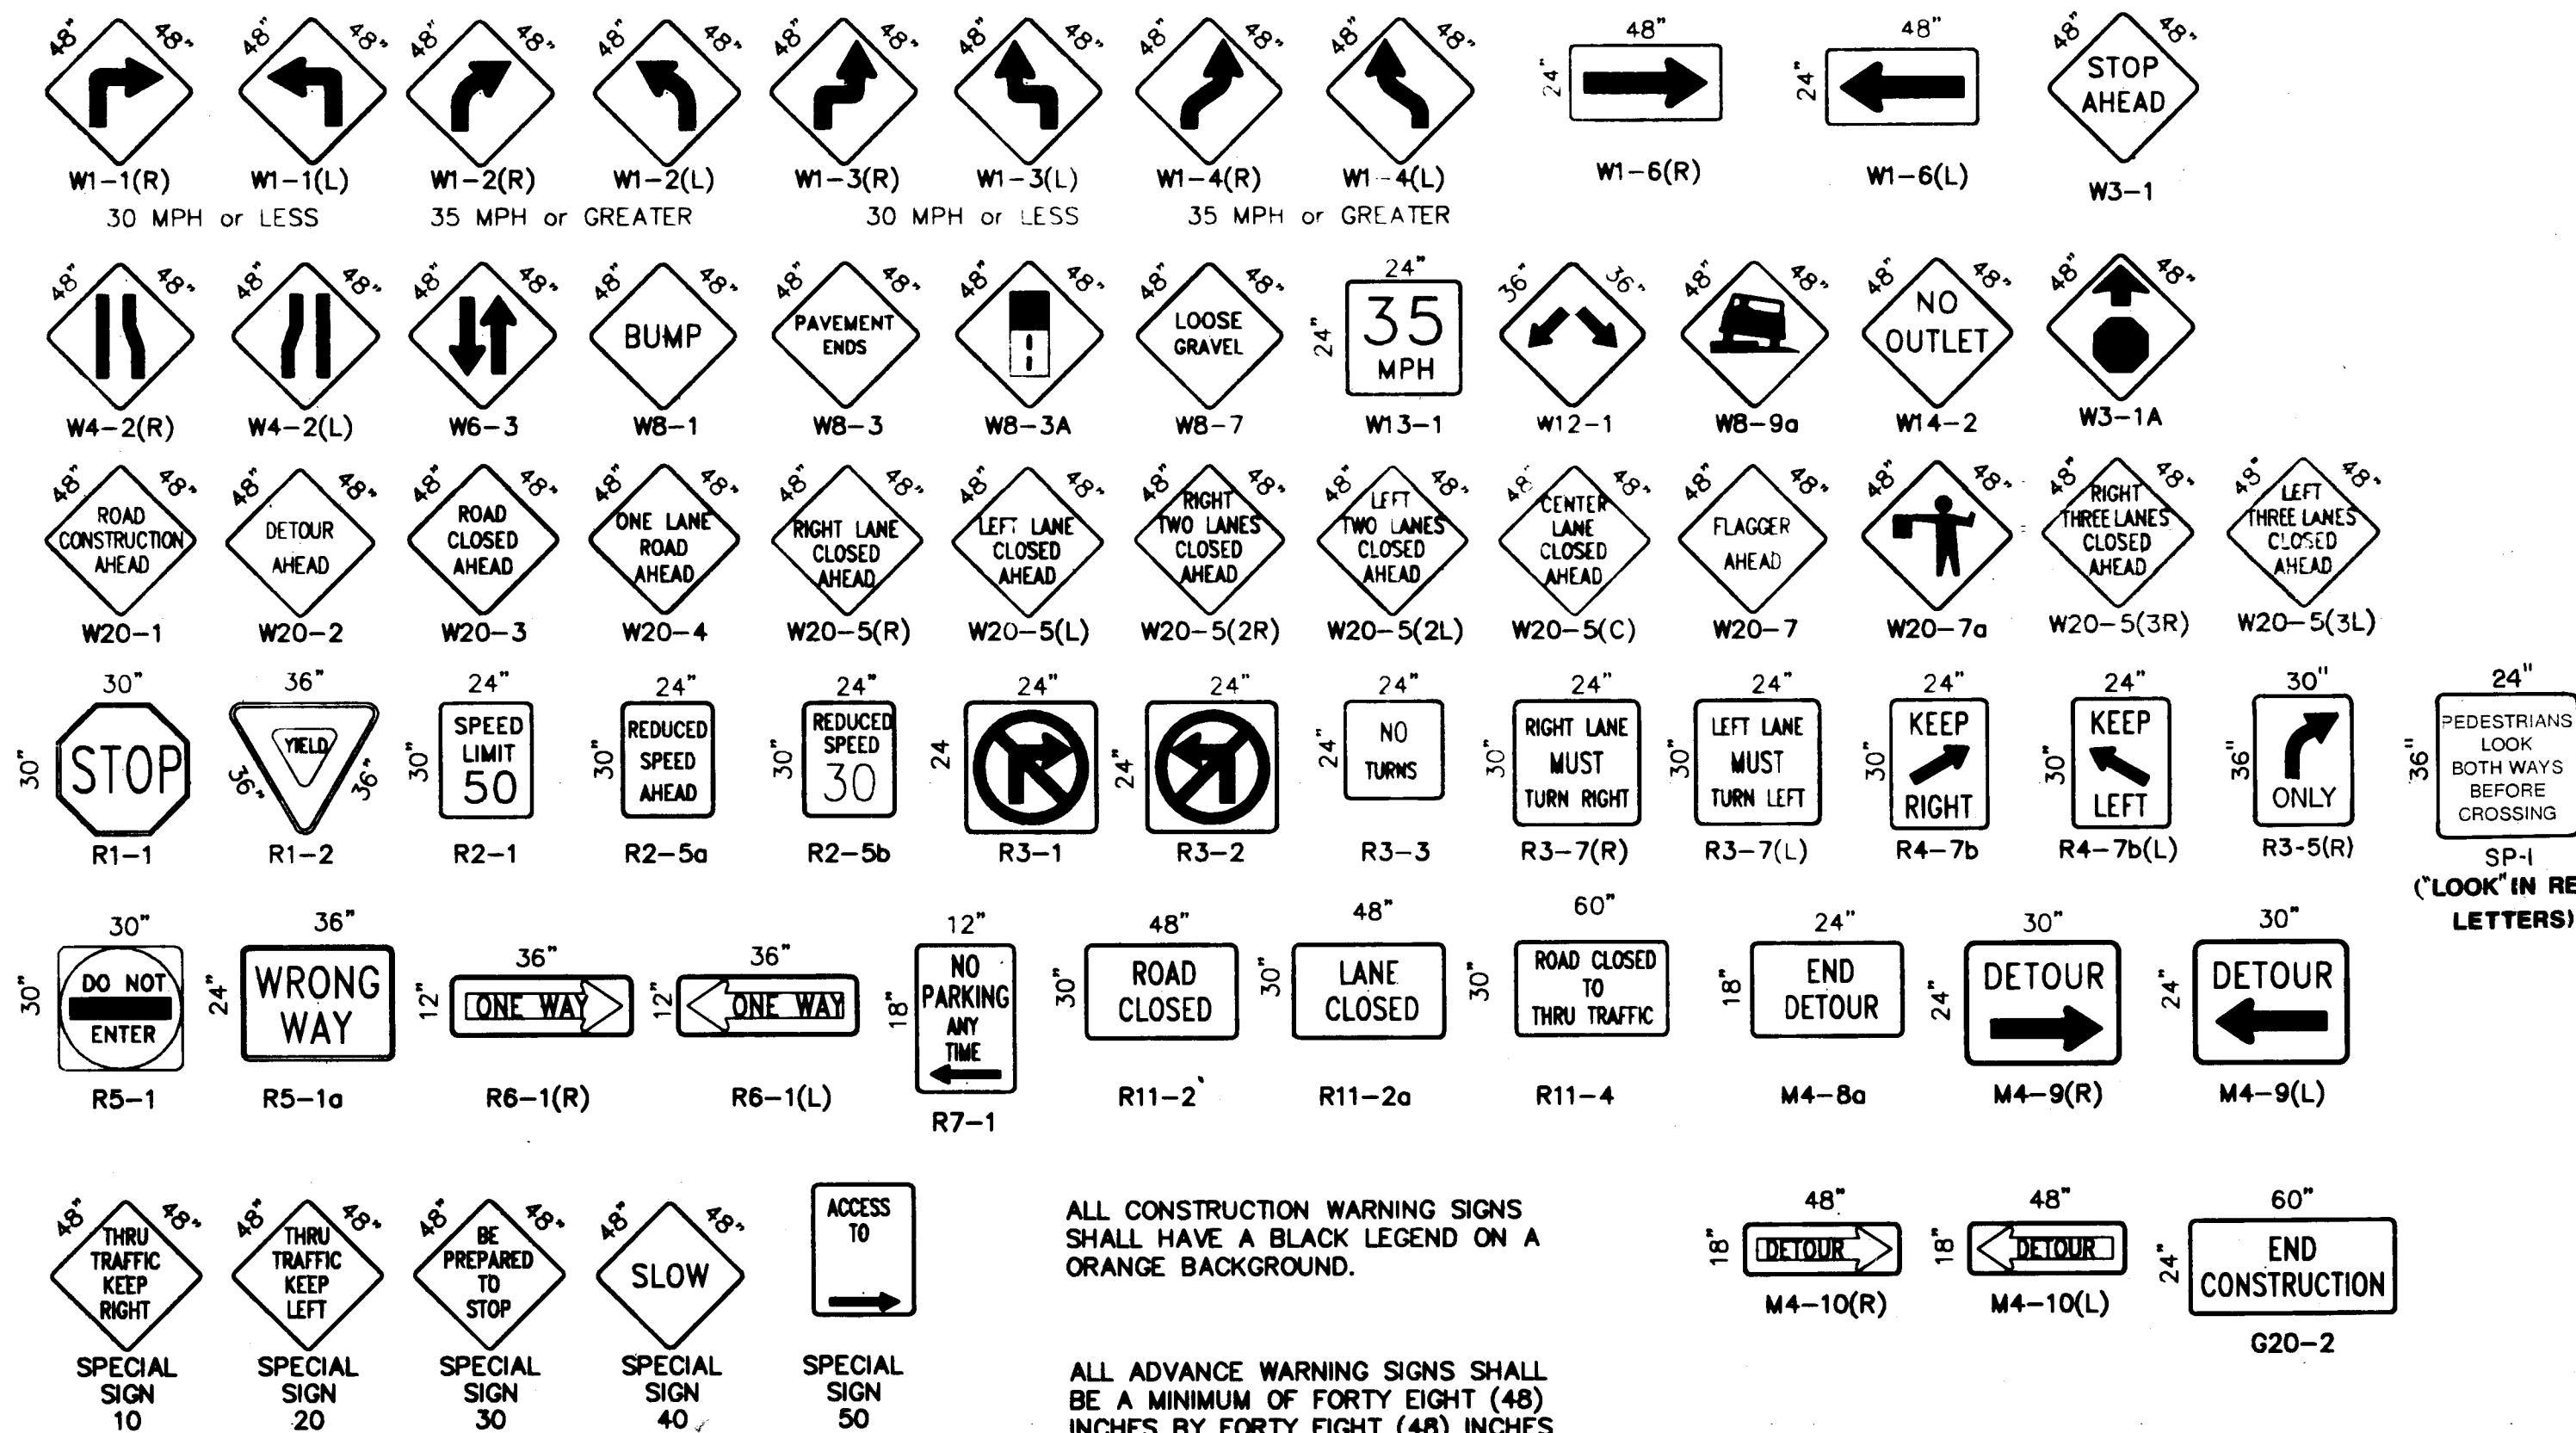

ALL CONSTRUCTION WARNING SIGNS SHALL HAVE A BLACK LEGEND ON A ORANGE BACKGROUND.

ALL ADVANCE WARNING SIGNS SHALL BE A MINIMUM OF FORTY EIGHT (48) INCHES BY FORTY EIGHT (48) INCHES IN SIZE AND SHALL HAVE ONE WARNING LIGHT.

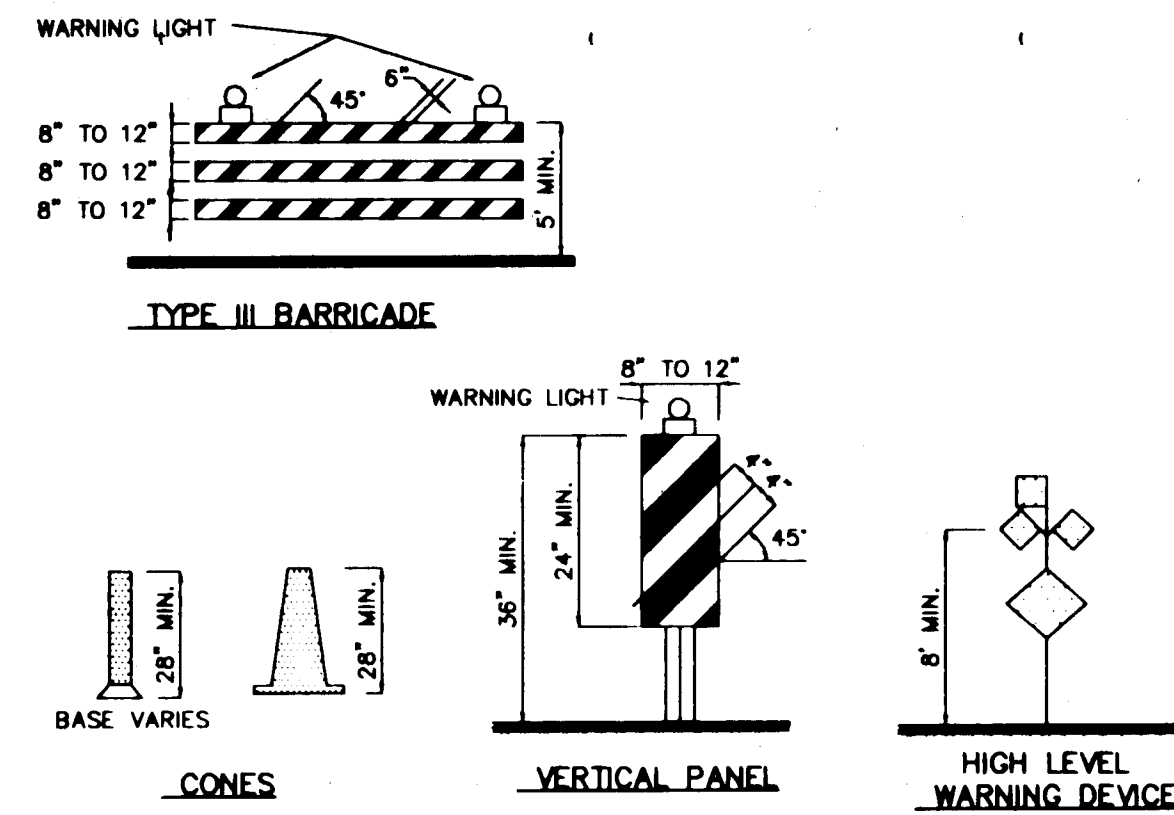

LEGEND

- WORK AREA
- BARRICADE - TYPE I, TYPE II, OR BARREL
- BARRICADE - TYPE III
- VERTICAL PANEL
- WARNING SIGN
- DISTANCE BETWEEN SIGNS - A DISTANCE MEASURED IN FEET EQUAL TO A VALUE OF TEN TIMES THE SPEED LIMIT OF THE STREET
- FLAGMAN POSITION
- SPACING BETWEEN BARRICADES - A DISTANCE MEASURED IN FEET EQUAL TO THE SPEED LIMIT OF THE STREET
- TAPER LENGTH - SEE CHART BELOW
- THE TANGENT LENGTH IS EQUAL TO THE TAPER LENGTH FOR A GIVEN STREET.

TAPER REQUIREMENTS

SPEED LIMIT (MPH)	TAPER LENGTH (FEET)			MINIMUM NUMBER OF DEVICES FOR TAPER	MAXIMUM DEVICE SPACING IN FEET	
	10' LANE	11' LANE	12' LANE		ALONG TAPER	AFTER TAPER
20	70	75	80	5	20	20
25	105	115	125	6	25	25
30	150	165	180	7	30	30
35	205	225	245	8	35	35
40	270	295	320	9	40	40
45	450	495	540	13	45	45
50	500	550	600	13	50	50
55	550	605	660	13	55	55

RECOMMENDED SIGN SPACING FOR ADVANCE WARNING SIGN SERIES

SPEED MILES PER HOUR	MINIMUM DISTANCE BETWEEN SIGNS	FROM LAST SIGN TO TAPER
0-20	10 X SPEED LIMIT	10 X SPEED LIMIT
25-30	10 X SPEED LIMIT	10 X SPEED LIMIT
30-35	10 X SPEED LIMIT	10 X SPEED LIMIT
40-45	10 X SPEED LIMIT	10 X SPEED LIMIT
50-60	10 X SPEED LIMIT	10 X SPEED LIMIT

TAPER CRITERIA


TYPE OF TAPER	TAPER LENGTH
UPSTREAM TAPER:	
MERGING TAPER	L MINIMUM
SHIFTING TAPER	1/2 L MINIMUM
SHOULDER TAPER	1/2 L MINIMUM
TWO-WAY TRAFFIC TAPER	100 FEET MAXIMUM
DOWNSIDE TAPERS	100 FEET PER LANE

TAPER LENGTH COMPUTATION






SPEED LIMIT	
40 MPH OR LESS	$L = \frac{WS^2}{60}$
45 MPH OR GREATER	$L = W \times S$
L = TAPER LENGTH	
W = WIDTH OF OFFSET IN FEET	
S = POSTED SPEED OR OFF-PEAK 85-PERCENTILE SPEED IN MPH	

SP-1
(LOOK IN RED LETTERS)

CITY OF ALBUQUERQUE PUBLIC WORKS DEPARTMENT ENGINEERING GROUP					
TITLE: RECONSTRUCTION OF THE COAL AVE BRIDGE AND 2nd STREET S.W.					
SIGNING AND CONSTRUCTION TRAFFIC CONTROL STANDARDS					
APPROVALS	ENGINEER	DATE	APPROVALS	ENGINEER	DATE
DRC CHAIRMAN			WATER		
TRANSPORTATION			WASTE WATER		
HYDROLOGY					
PROJECT NO.	4018.91	MAP NO.	K-14	SHEET OF	15 25

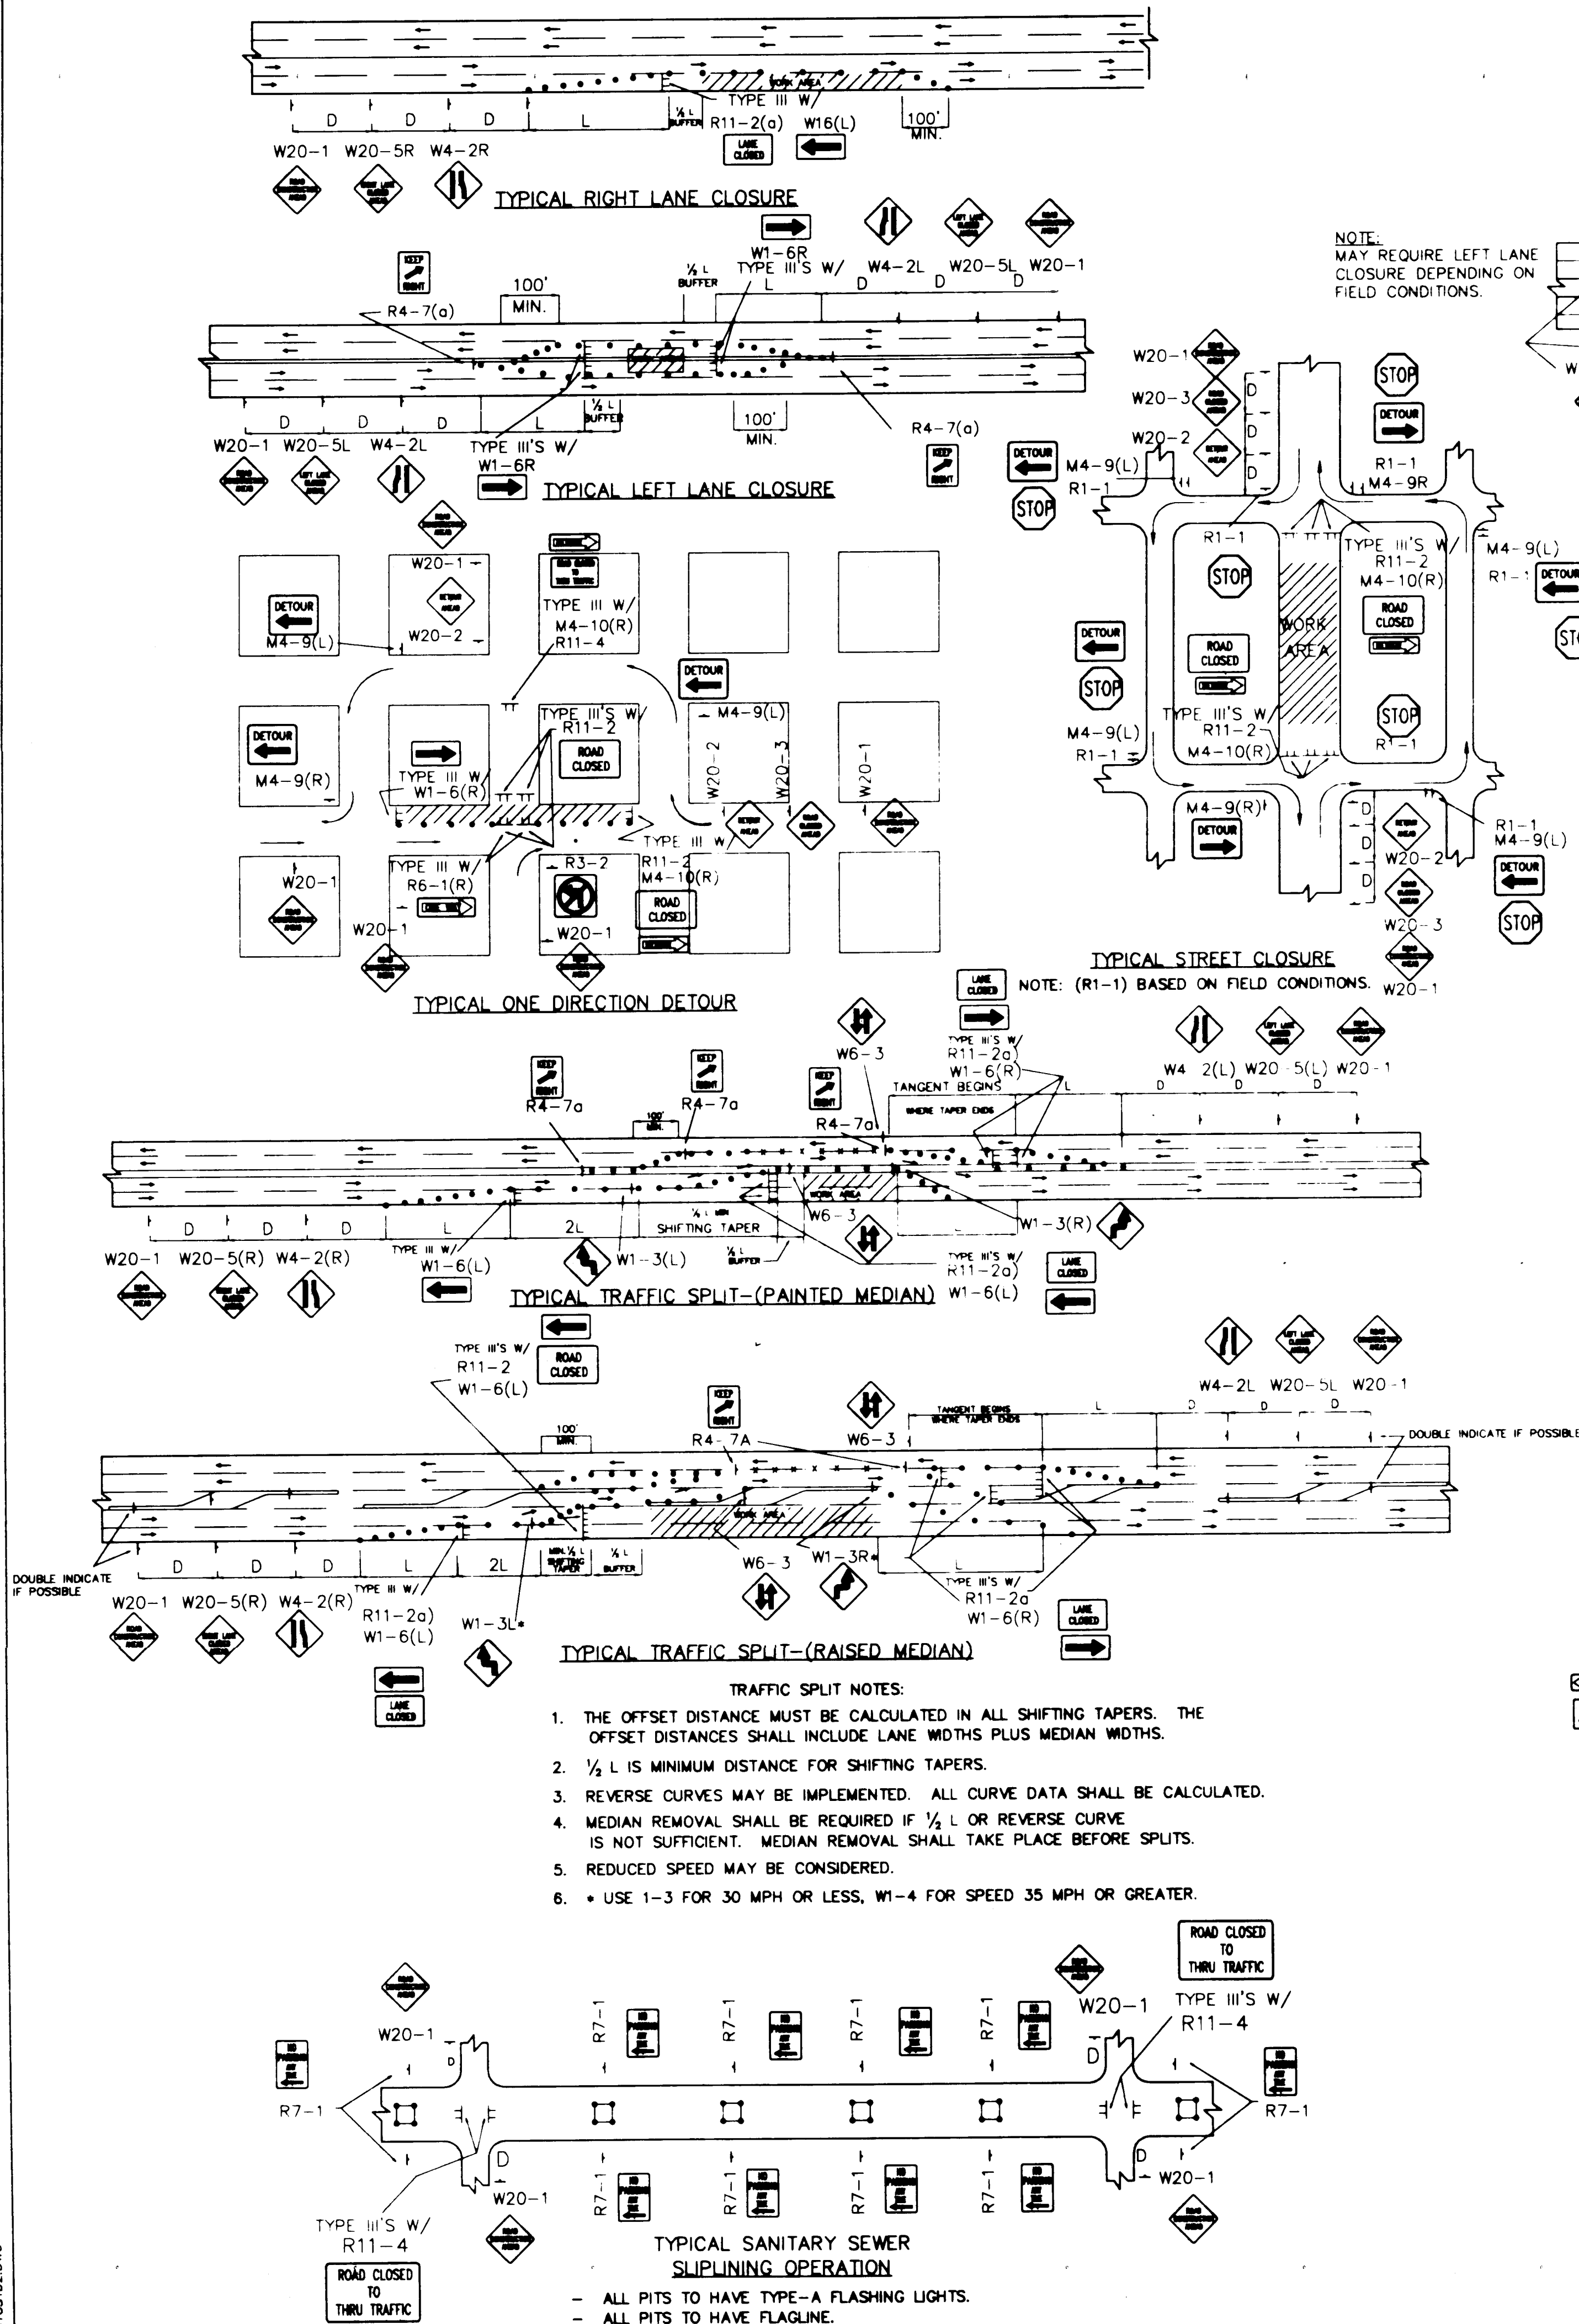

NOTE:
MAY REQUIRE LEFT LANE
CLOSURE DEPENDING ON
FIELD CONDITIONS.

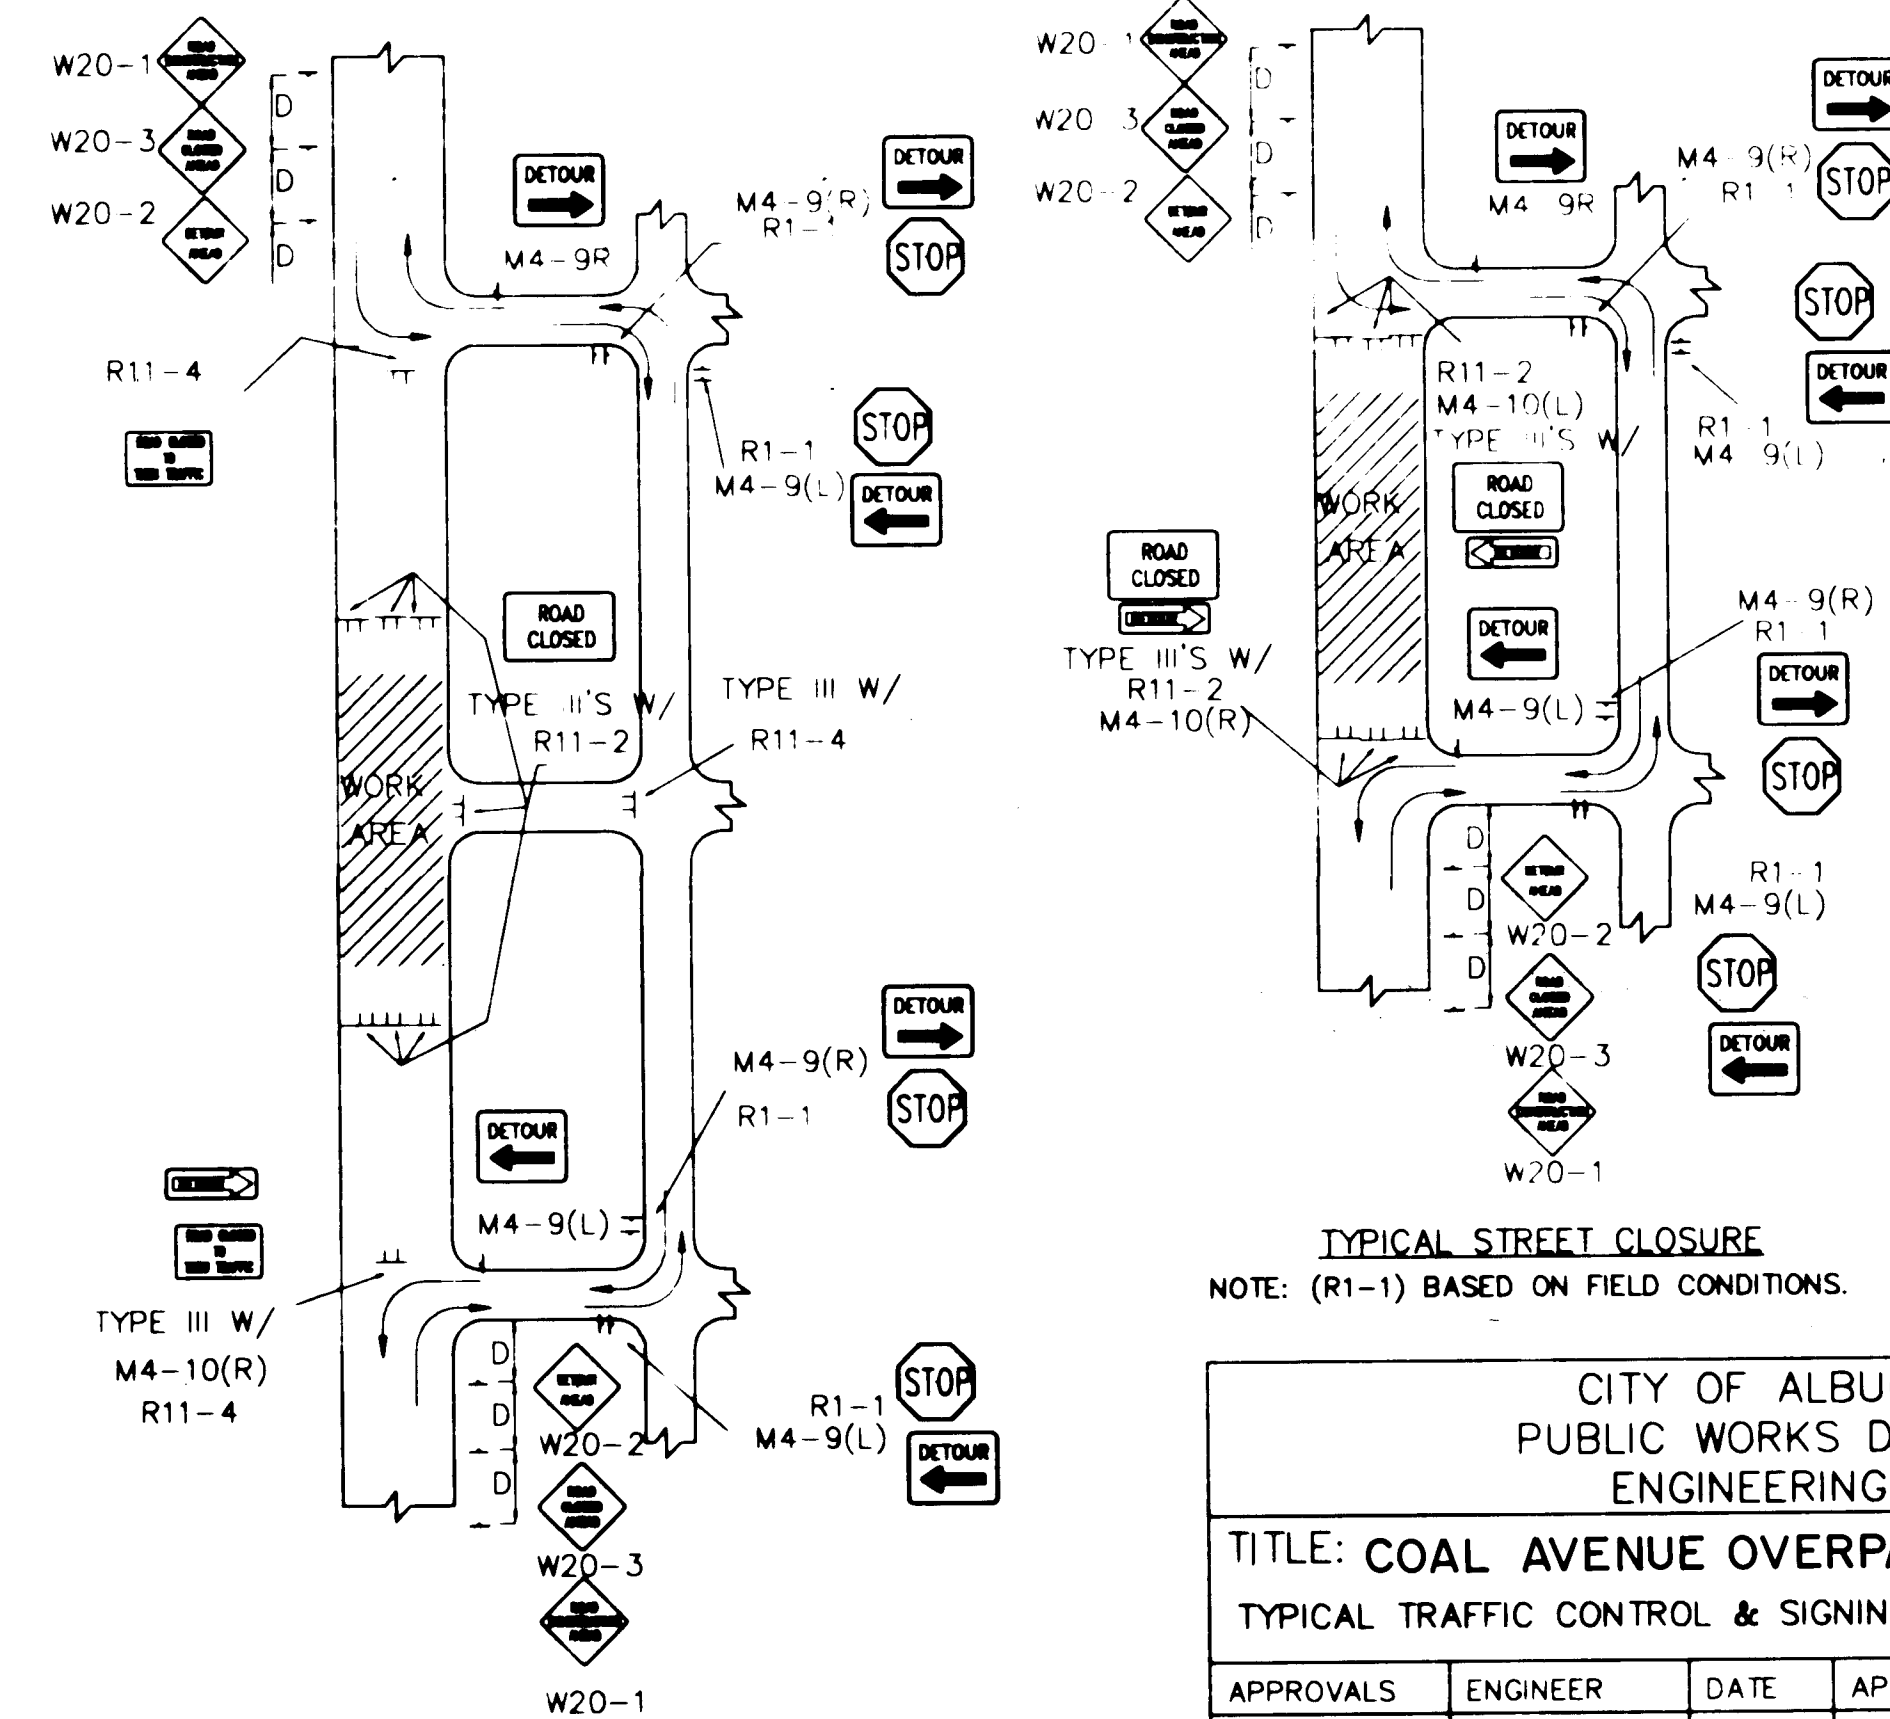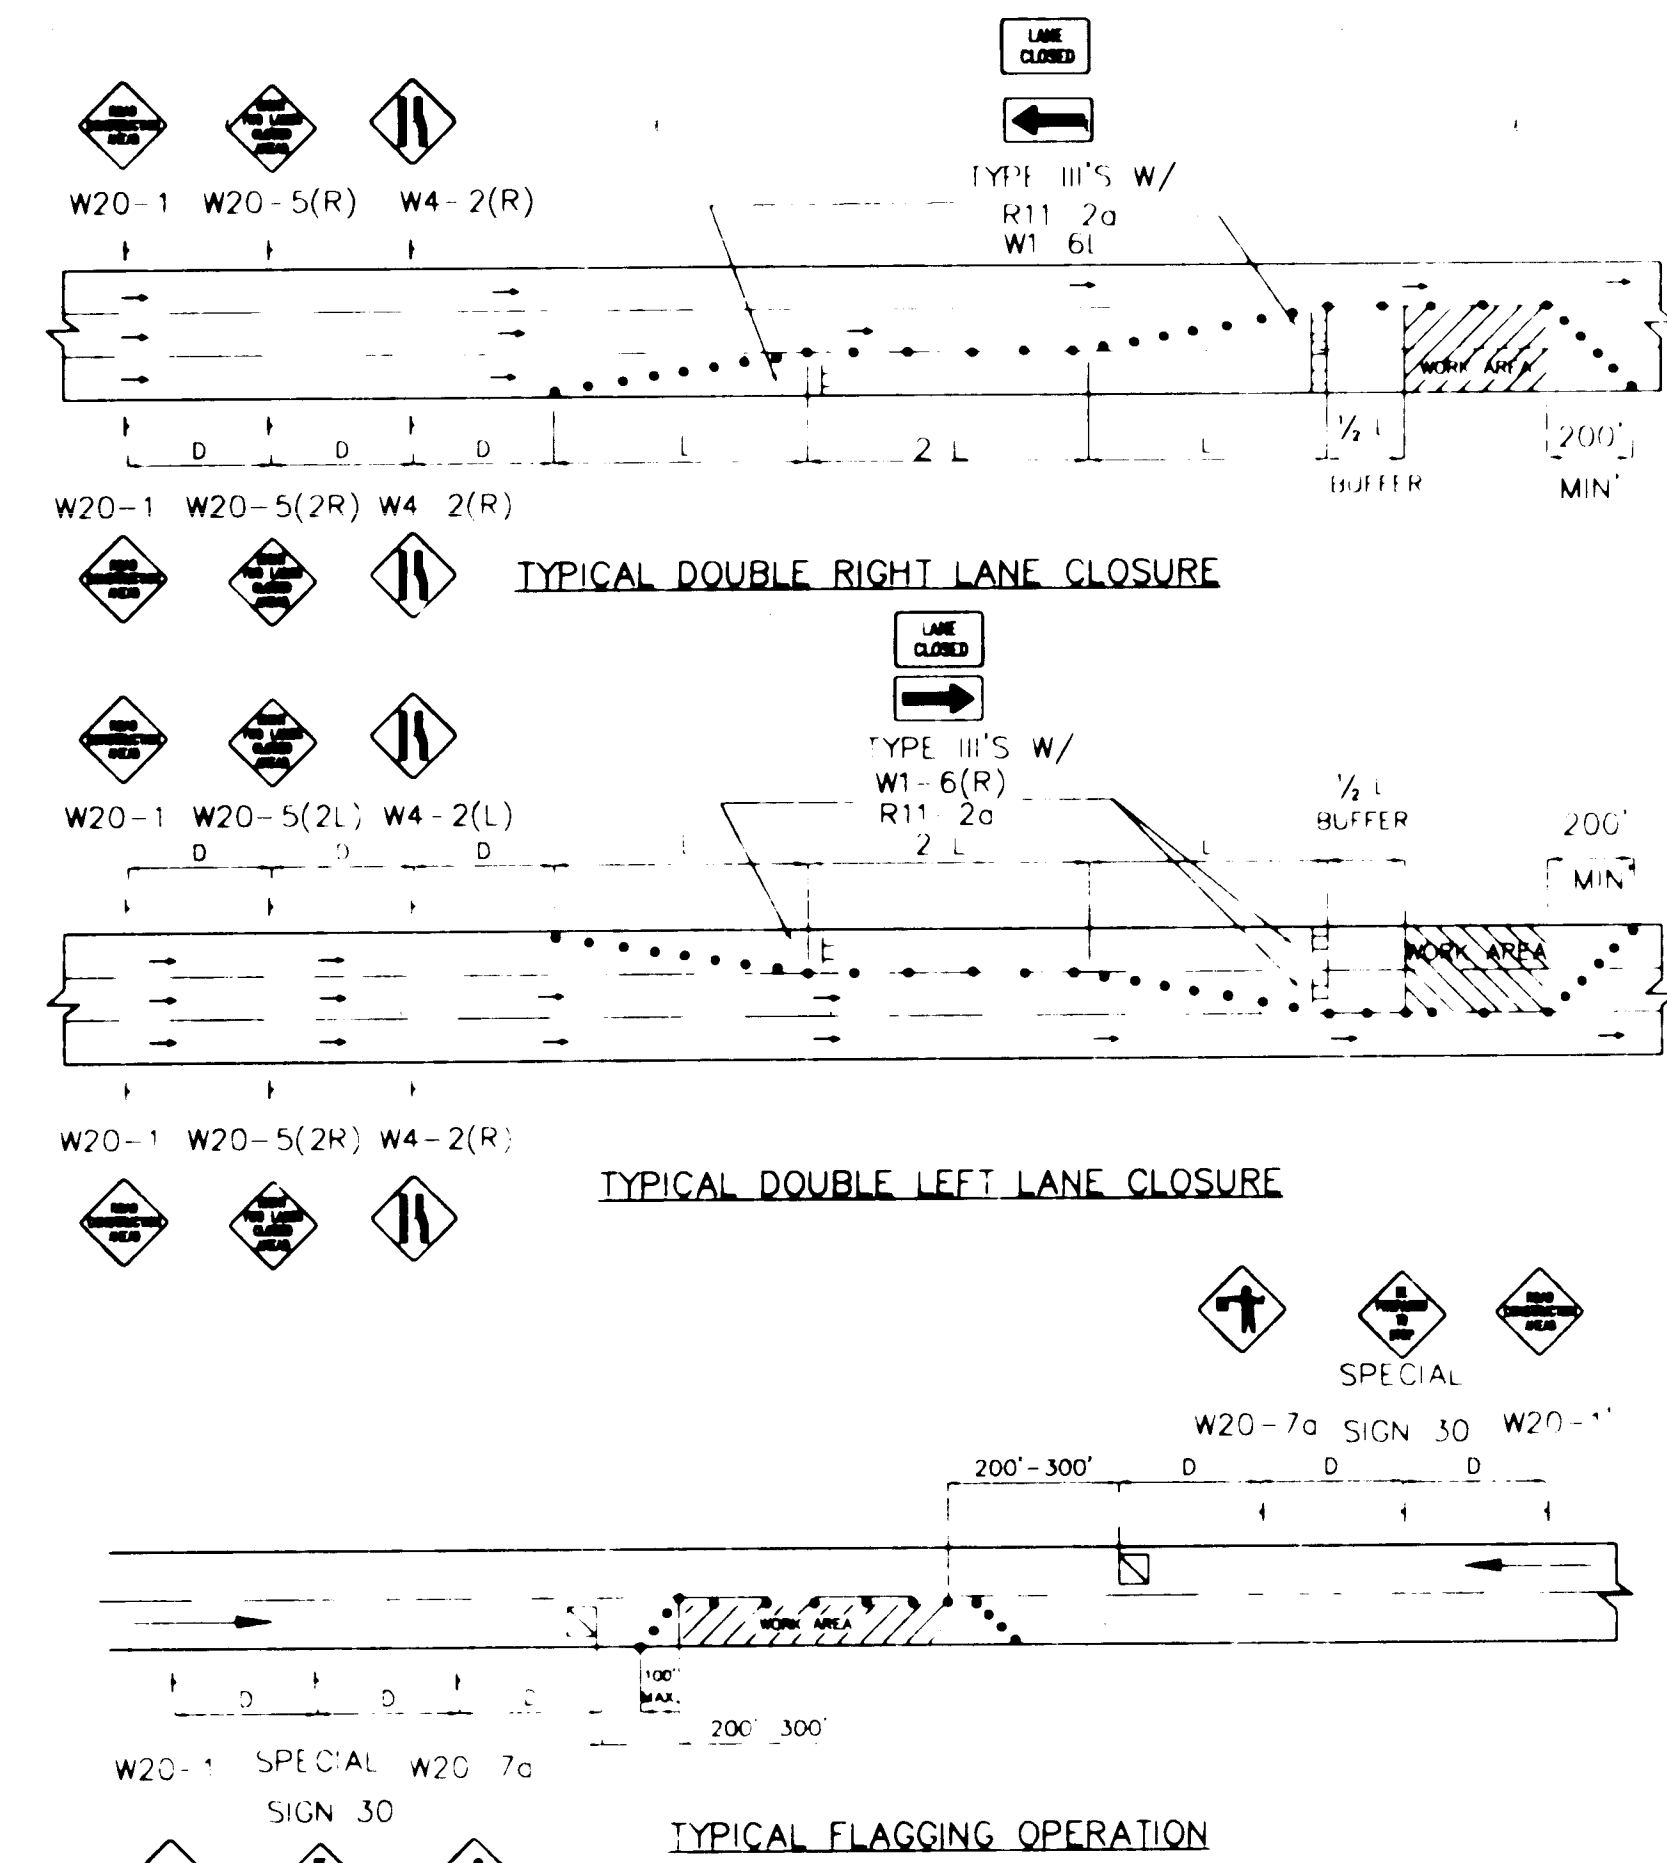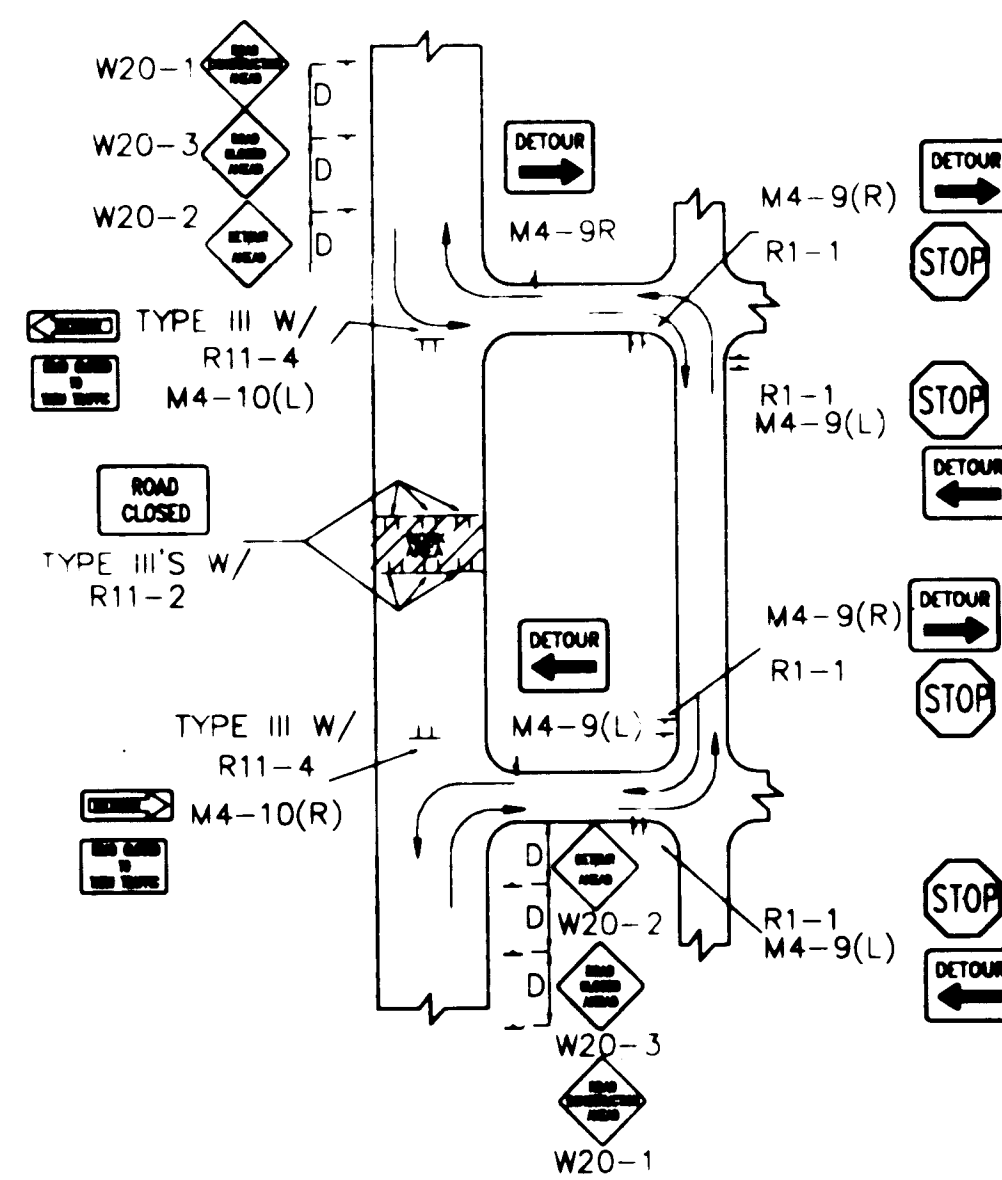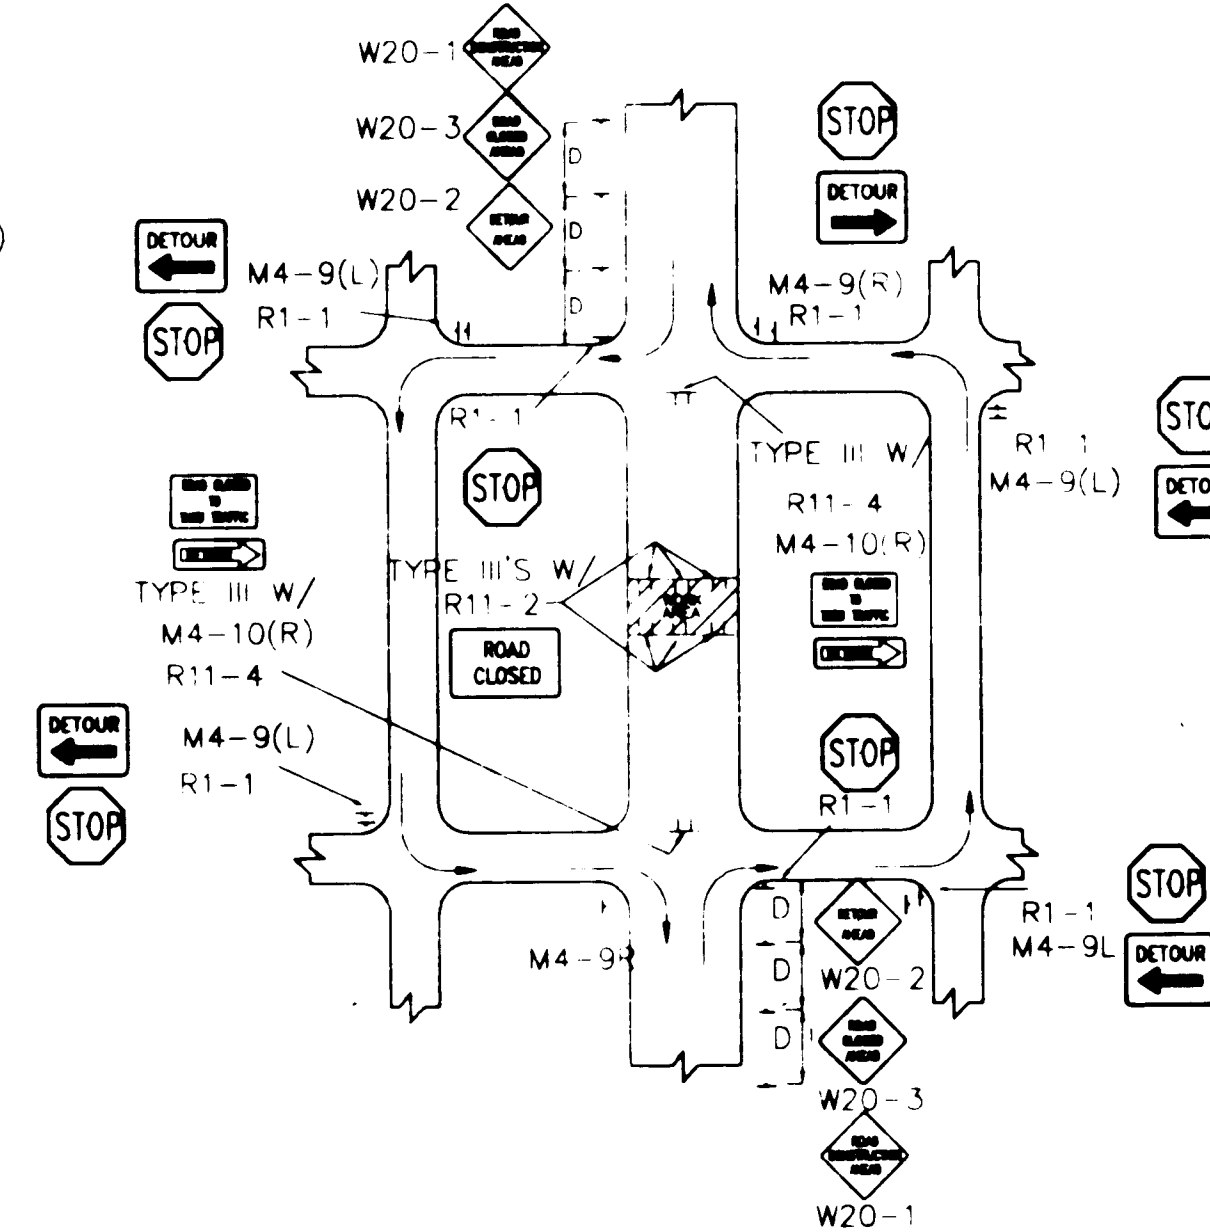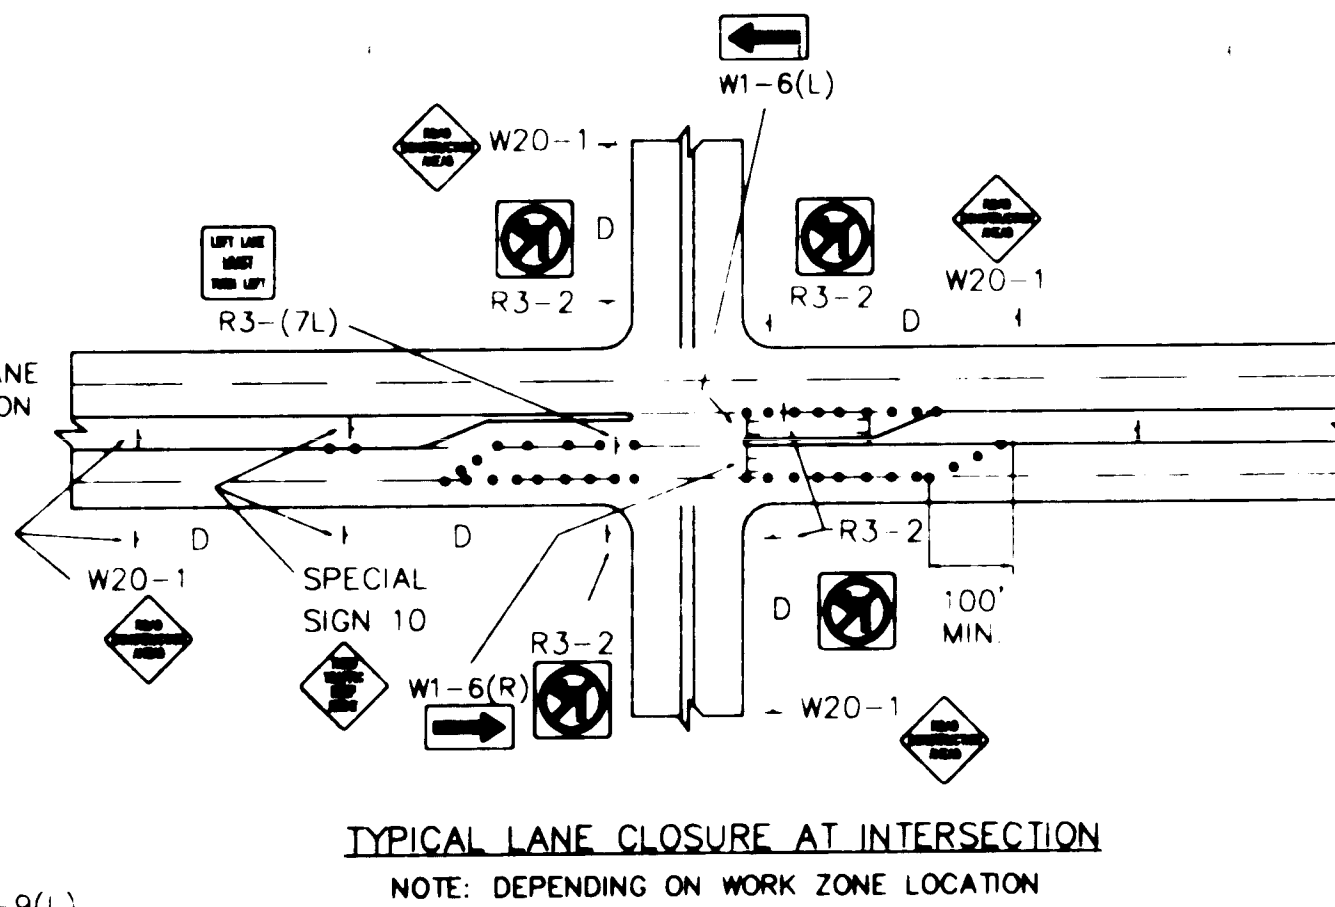

TYPICAL STREET CLOSURE

NOTE: (R1-1) BASED ON FIELD CONDITIONS.

20 40 80 120 160 200

AS BUILT INFORMATION			BENCH MARKS			SURVEY INFORMATION			ENGINEER'S SEAL																										
CONTRACT NO.	DATE	BY	CONTRACT NO.	DATE	BY	NO.	DATE	NO.	DATE	NO.	DATE																								
CONTRACT NO. 4018.91	DATE 11/15/91	BY [Signature]	CONTRACT NO. 4018.91	DATE 11/15/91	BY [Signature]	NO. 16	DATE 11/15/91	NO. 16	DATE 11/15/91	NO. 16	DATE 11/15/91																								
CITY OF ALBUQUERQUE PUBLIC WORKS DEPARTMENT ENGINEERING GROUP TITLE: COAL AVENUE OVERPASS REHABILITATION TYPICAL TRAFFIC CONTROL & SIGNING EXAMPLES (REF. M.U.T.C.D.) <table border="1"> <thead> <tr> <th>APPROVALS</th> <th>ENGINEER</th> <th>DATE</th> <th>APPROVALS</th> <th>ENGINEER</th> <th>DATE</th> </tr> </thead> <tbody> <tr> <td>DRC CHAIRMAN</td> <td></td> <td></td> <td>WATER</td> <td></td> <td></td> </tr> <tr> <td>TRANSPORTATION</td> <td></td> <td></td> <td>WASTE WATER</td> <td></td> <td></td> </tr> <tr> <td>HYDROLOGY</td> <td></td> <td></td> <td></td> <td></td> <td></td> </tr> </tbody> </table> PROJECT NO. 4018.91 MAP NO. K-14N SHEET 16 OF 25												APPROVALS	ENGINEER	DATE	APPROVALS	ENGINEER	DATE	DRC CHAIRMAN			WATER			TRANSPORTATION			WASTE WATER			HYDROLOGY					
APPROVALS	ENGINEER	DATE	APPROVALS	ENGINEER	DATE																														
DRC CHAIRMAN			WATER																																
TRANSPORTATION			WASTE WATER																																
HYDROLOGY																																			

CONSTRUCTION SEQUENCING

- PHASE I: (See Sheet 3)
- 1. CLOSE COAL AVE BRIDGE TO TRAFFIC.
 - 2. REDUCE COAL AVE TO ONE LANE AT 2nd ST.
 - 3. REDUCE LEAD AVE TO TWO LANES AT BROADWAY BLVD..
 - 4. PROVIDE FOR TWO-WAY TRAFFIC (TWO LANES WESTBOUND/ONE LANE EASTBOUND) ACROSS LEAD AVE BRIDGE.
 - 5. SIGNALIZATION MODIFICATIONS AT LEAD AVE/BROADWAY BLVD TO ACCOMMODATE RIGHT TURN.
 - A. PLACE TEMPORARY 3-SECTION SIGNAL HEAD ASSEMBLIES "S1" & "S2" (SEE SHEET 3 OF 7) ON TYPE I POLES MOUNTED ON MOVABLE CONCRETE FOUNDATIONS AND CONNECT TO EXISTING SIGNAL POLE LOCATED ON SOUTHEAST CORNER OF INTERSECTION.
 - B. CONTRACTOR SHALL PROVIDE FOR AN OFF DUTY POLICE OFFICER TO CONTROL TRAFFIC WHILE SIGNAL MODIFICATIONS ARE BEING PERFORMED.
- ALL WIRING CONNECTIONS, CONTROLLER PROGRAMMING AND SIGNAL TIMING SHALL BE PERFORMED BY THE CITY OF ALBUQUERQUE. CONTRACTOR SHALL NOTIFY MR. KEVIN BRODERICK (291-6220) 48 HOURS PRIOR TO PERFORMING ANY SUCH WORK ON THE SIGNAL TO COORDINATE CITY OF ALBUQUERQUE PERSONNEL TO BE PRESENT.
- 6. DETOUR COAL AVE TRAFFIC NORTH ON 2nd ST, THEN EAST ON LEAD AVE OVER THE BRIDGE (ONE LANE). PROVIDE RIGHT TURN AT BROADWAY BLVD, THEN SOUTH ON BROADWAY BLVD TO COAL AVE.
 - 7. CONSTRUCT/REHABILITATE COAL AVE BRIDGE.


- PHASE II: (See Sheet 4)
- 1. REDUCE COAL AVE TO ONE LANE AT 2nd ST (SOUTHERN LANE).
 - 2. REDUCE LEAD AVE TO ONE LANE AT 2nd ST (NORTHERN LANE).
 - 3. REDUCE 2nd ST TO ONE LANE AT COAL AVE (WESTERN LANE).
 - 4. CONSTRUCT EASTERN HALF OF 2nd ST BETWEEN COAL AVE & LEAD AVE, SE QUADRANT OF LEAD AVE/2nd ST, AND NE QUADRANT OF COAL AVE/2nd ST.

- PHASE III: (See Sheet 5)
- 1. REDUCE COAL AVE TO ONE LANE AT 2nd ST (SOUTHERN LANE).
 - 2. REDUCE LEAD AVE TO ONE LANE AT 2nd ST (NORTHERN LANE).
 - 3. REDUCE 2nd ST TO ONE LANE AT COAL AVE (EASTERN LANE).
 - 4. CONSTRUCT WESTERN HALF OF 2nd ST BETWEEN COAL AVE & LEAD AVE, SW QUADRANT OF LEAD AVE/2nd ST, AND NW QUADRANT OF COAL AVE/2nd ST.


- PHASE IV: (See Sheet 6)
- 1. REDUCE COAL AVE TO ONE LANE AT 2nd ST (NORTHERN LANE).
 - 2. REDUCE LEAD AVE TO ONE LANE AT 2nd ST (SOUTHERN LANE).
 - 3. REDUCE 2nd ST TO ONE LANE AT COAL AVE (EASTERN LANE).
 - 4. CONSTRUCT NW QUADRANT OF LEAD AVE/2nd ST AND SW QUADRANT OF COAL AVE/2nd ST.


- PHASE V: (See Sheet 7)
- 1. REDUCE COAL AVE TO ONE LANE AT 2nd ST (NORTHERN LANE).
 - 2. REDUCE LEAD AVE TO ONE LANE AT 2nd ST (SOUTHERN LANE).
 - 3. REDUCE 2nd ST TO ONE LANE AT COAL AVE (WESTERN LANE).
 - 4. CONSTRUCT NE QUADRANT OF LEAD AVE/2nd ST AND SE QUADRANT OF COAL AVE/2nd ST.

AS BUILT INFORMATION		BENCH MARKS		SURVEY INFORMATION		ENGINEER'S SEAL		NO. DATE		REMARKS		BY		DESIGN		DRAWN BY		CHECKED BY	
CONTRACTOR	MOORE & COMPANY			FIELD NOTES															
WORK ORDER	DATE			BY	DATE														
INSPECTORS	DATE																		
ACCEPTANCE BY	DATE																		
VERIFICATION BY	DATE																		
DRAWINGS	DATE																		
MICRO-FILM INFORMATION																			
RECORDED BY																			
DATE																			
NO.																			

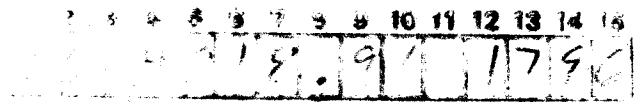

AVID ENGINEERING, INC.
Civil • Structural • Transportation
6100 Seagull St. NE - Suite 102
Albuquerque, NM 87109 - (505) 881-5357

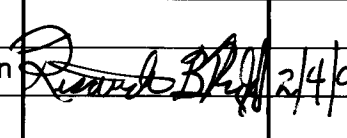CITY OF ALBUQUERQUE PUBLIC WORKS DEPARTMENT ENGINEERING GROUP					
TITLE: RECONSTRUCTION OF THE COAL AVE BRIDGE AND 2nd STREET S.W. CONSTRUCTION SEQUENCING					
APPROVALS	ENGINEER	DATE	APPROVALS	ENGINEER	DATE
D.R.C. Chair		2/4/14	Water		
Transportation			Waste Water		
Hydrology					
PROJECT NO. 401891		MAP NO. K-14		SHEET 17 OF 25	

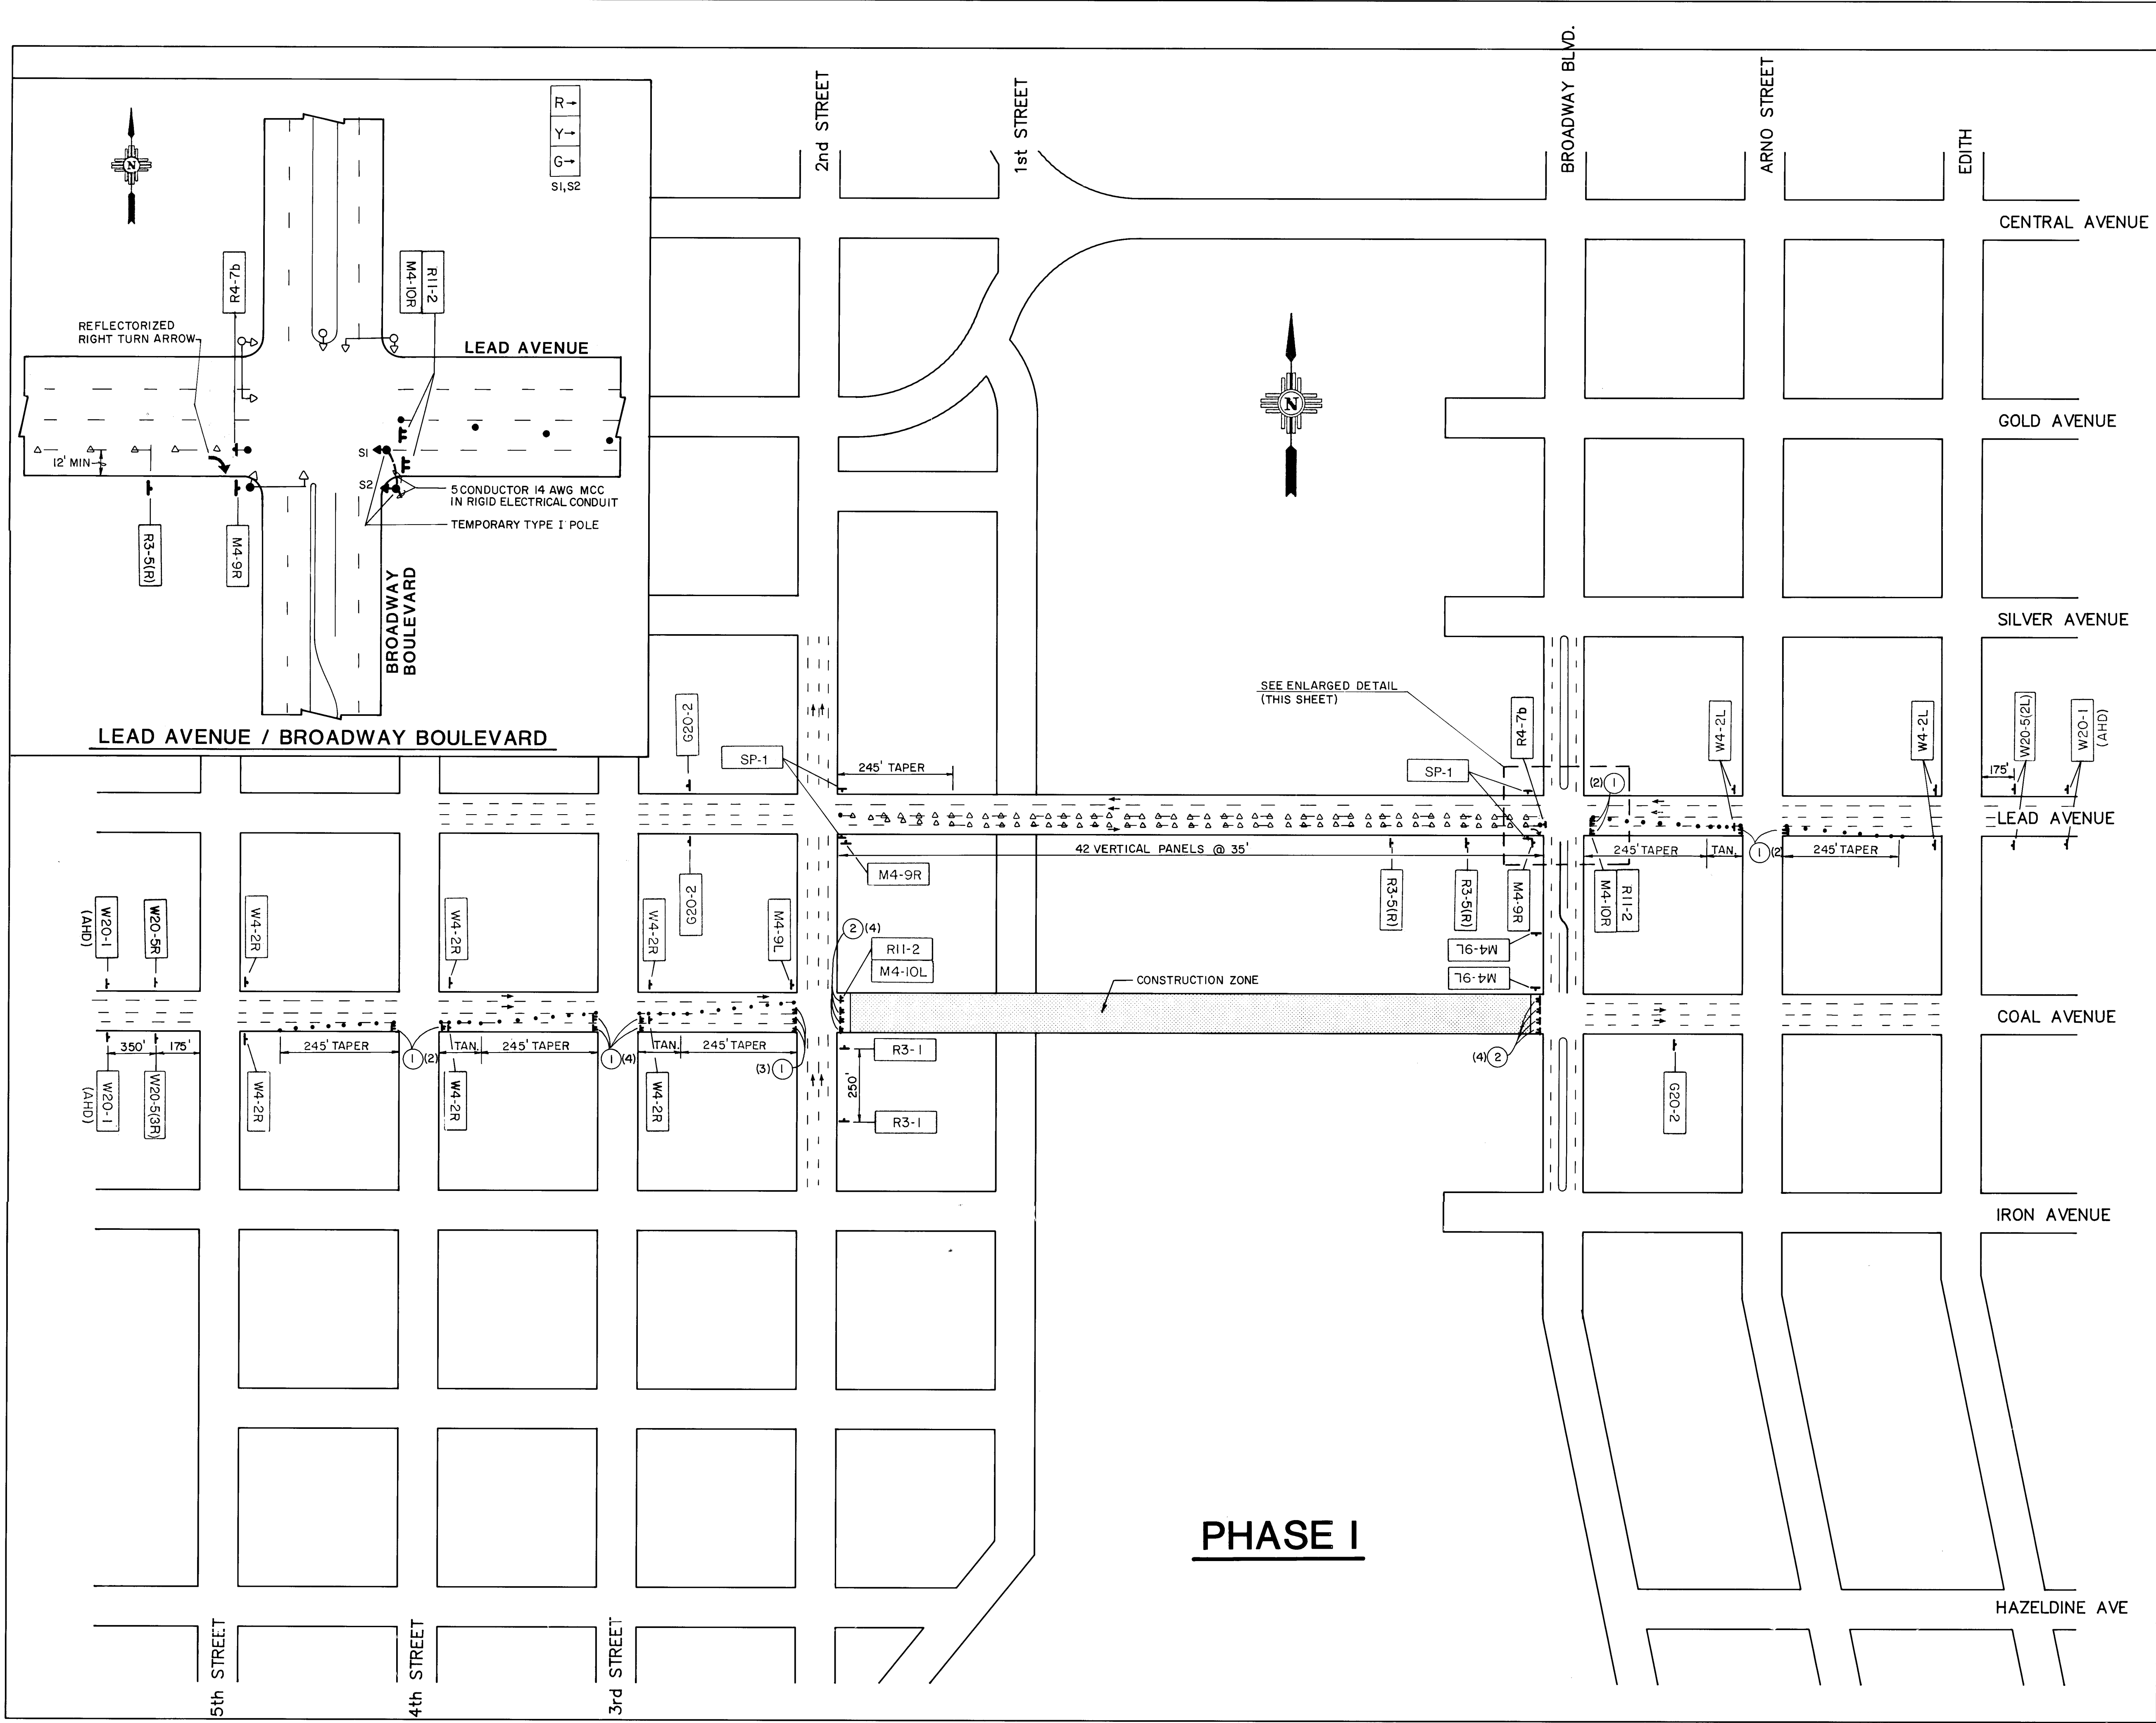

PHASE I

- LEGEND**
- CONSTRUCTION ZONE
 - TYPE III BARRICADE
 - TRAFFIC SIGN
 - TYPE I BARRICADE**
 - VERTICAL PANEL
 - DIRECTION OF TRAVEL


- KEYED NOTES**
- ① TYPE III BARRICADES (#) W/R11-2a
 - ② TYPE III BARRICADES (#) W/R2-11

AVID ENGINEERING, INC.
Civil • Structural • Transportation
6100 Seagull St. NE - Suite 102
Albuquerque, NM 87109 - (505) 881-5337

20-4018.91-1896

CITY OF ALBUQUERQUE PUBLIC WORKS DEPARTMENT ENGINEERING GROUP					
TITLE: RECONSTRUCTION OF THE COAL AVE BRIDGE AND 2nd STREET S.W. CONSTRUCTION SIGNING LAYOUT - PHASE I					
APPROVALS	ENGINEER	DATE	APPROVALS	ENGINEER	DATE
D.R.C. Chair			Water		
Transportation			Waste Water		
Hydrology					
PROJECT NO.	4018.91	MAP NO.	K-14	SHEET	18 OF 25

AS BUILT INFORMATION		BENCH MARKS		SURVEY INFORMATION		ENGINEER'S SEAL		DESIGN	
CONTRACTOR	Model & Construct	DATE		FIELD NOTES	NO.	DATE		NO.	DATE
INSPECTOR	Model & Construct	DATE		BY				REMARKS	BY
ACCEPTANCE BY	C.O.A.	DATE							
VERIFICATION BY	C.O.A.	DATE							
DRAWN BY		AVID ENG.		DATE				DESIGNED BY	DATE
MICRO-FILM INFORMATION		RECORDED BY		DATE				DRAWN BY	DATE
								CHECKED BY	DATE

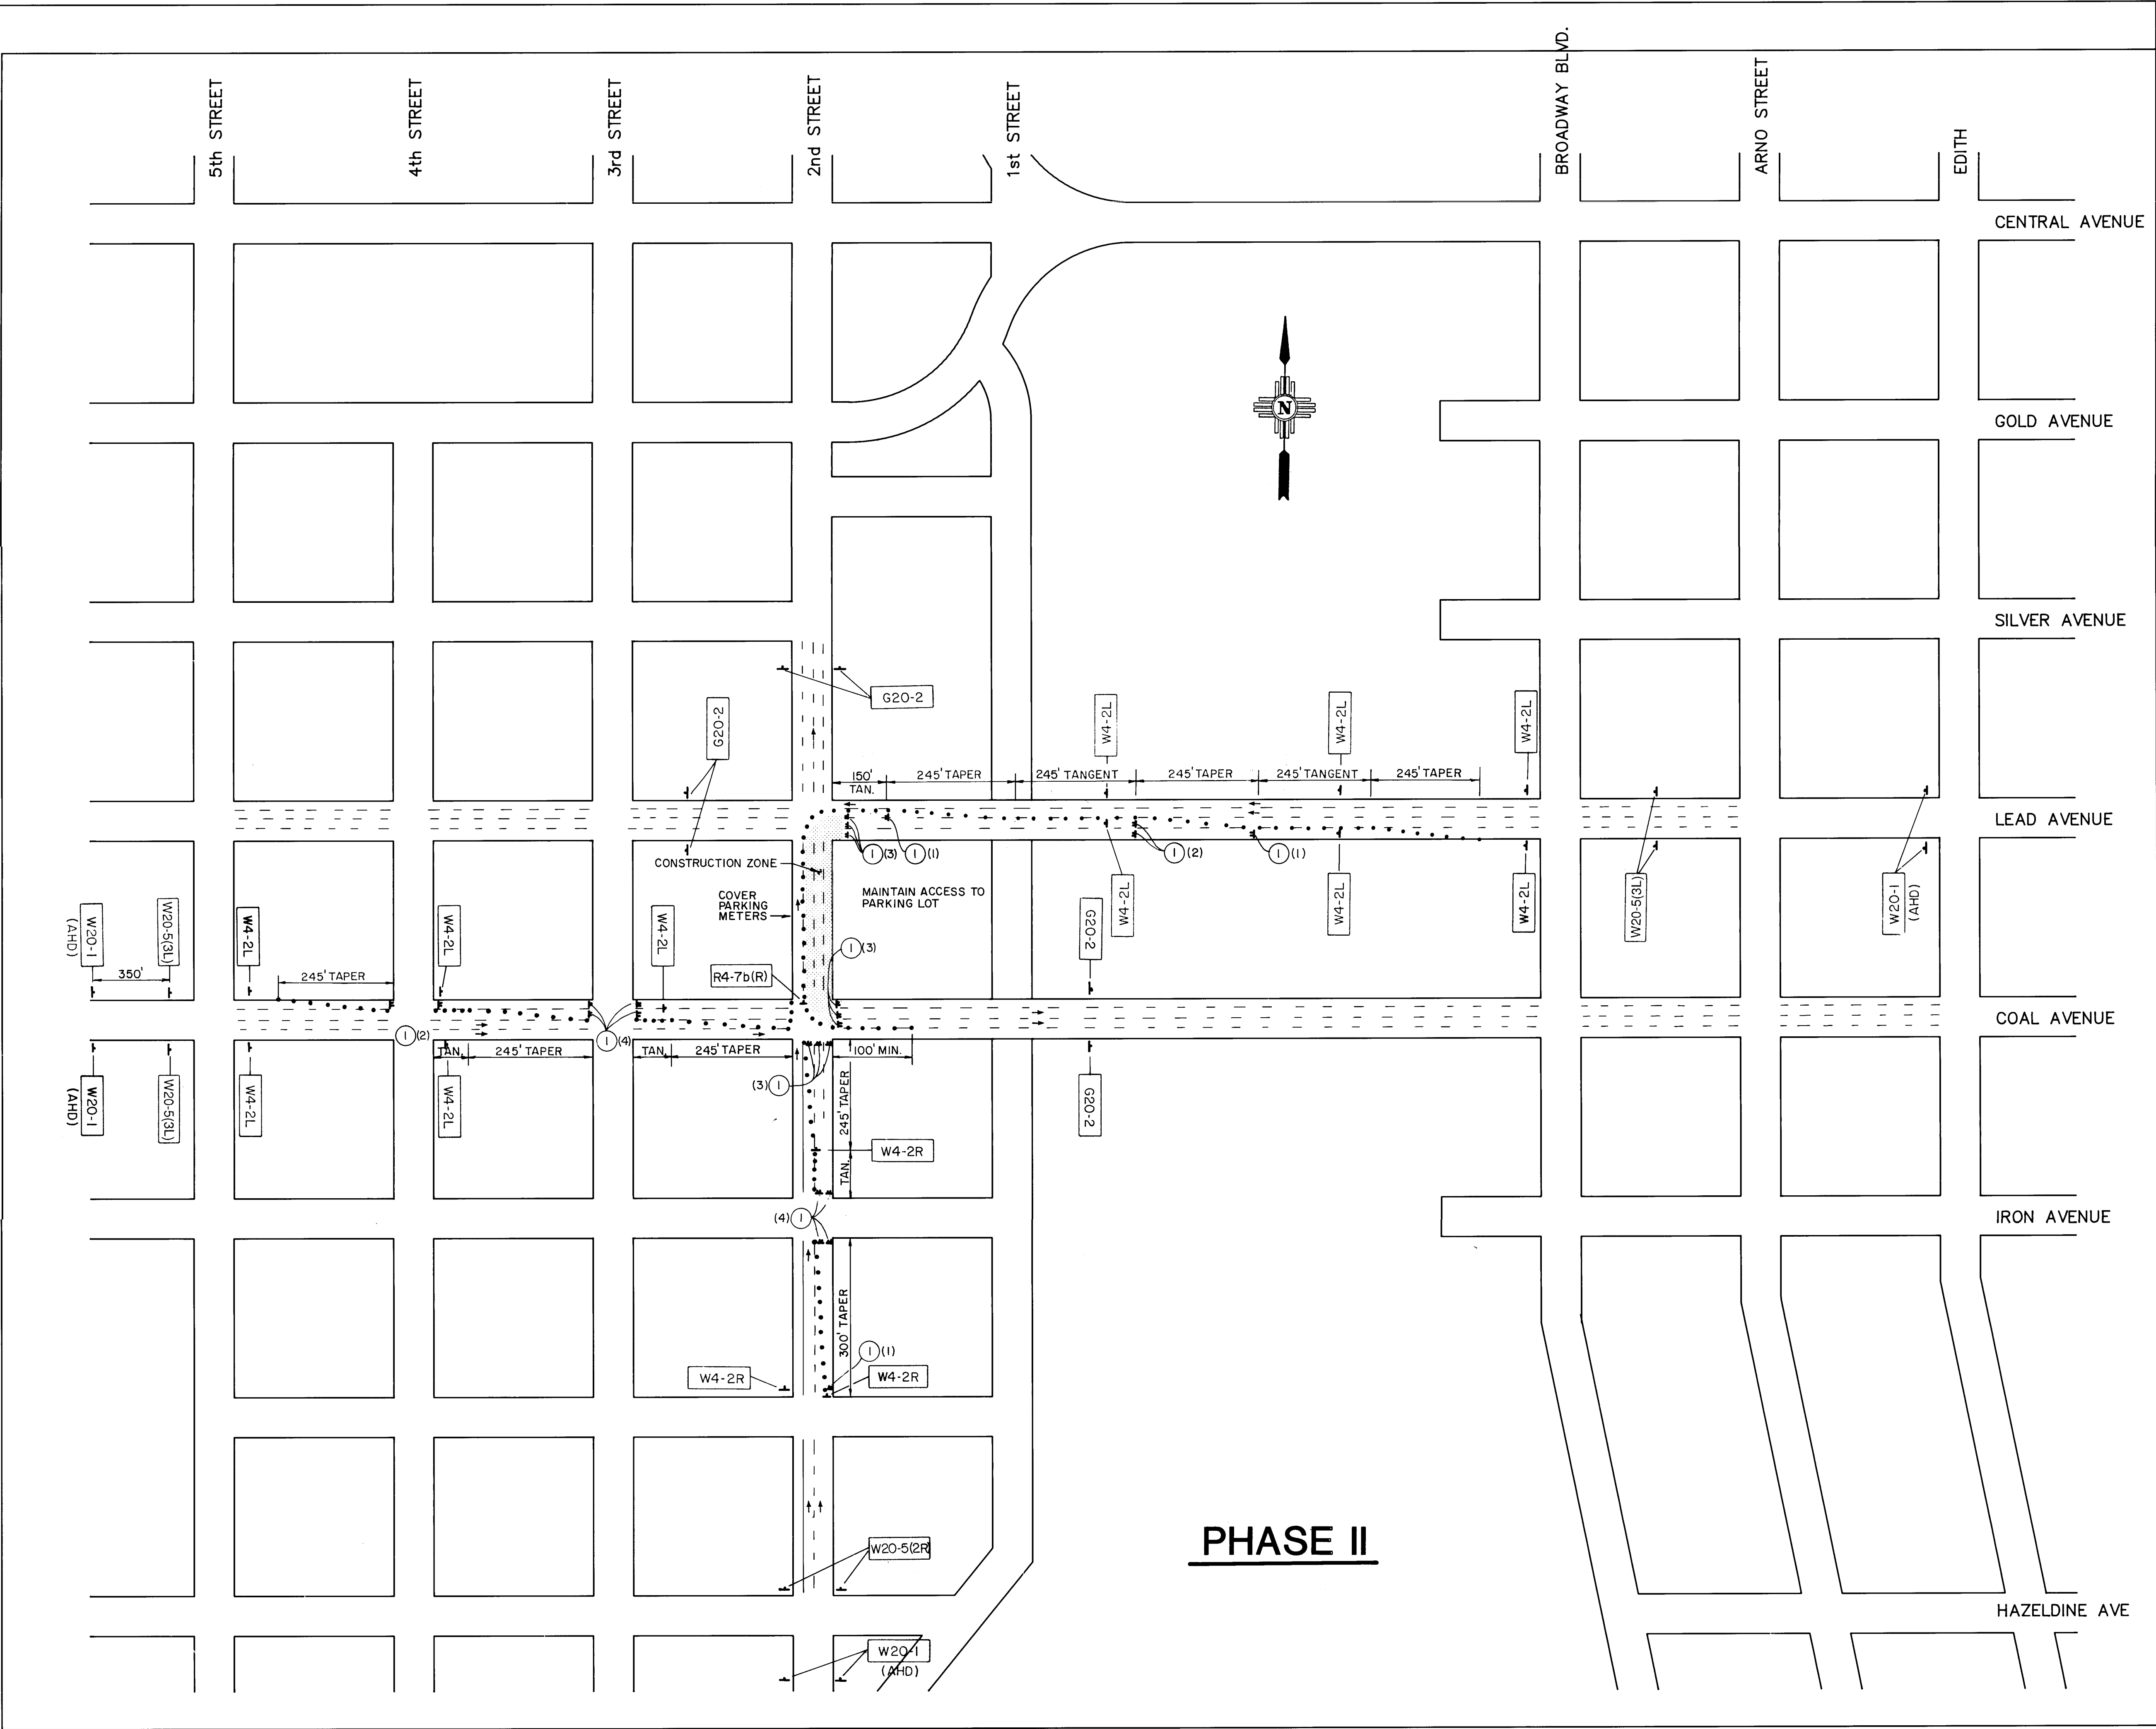

PHASE II

- LEGEND**
- CONSTRUCTION ZONE
 - TYPE III BARRICADE
 - TRAFFIC SIGN
 - TYPE I BARRICADE**
 - VERTICAL PANEL
 - DIRECTION OF TRAVEL


KEYED NOTES

① TYPE III BARRICADES (#) W/R11-2a

26-4018.91 1996

AVID ENGINEERING, INC.
Civil • Structural • Transportation
6100 Seagull St. NE - Suite 102
Albuquerque, NM 87109 - (505) 881-5357

CITY OF ALBUQUERQUE PUBLIC WORKS DEPARTMENT ENGINEERING GROUP					
TITLE: RECONSTRUCTION OF THE COAL AVE BRIDGE AND 2nd STREET S.W. CONSTRUCTION SIGNING LAYOUT - PHASE II					
APPROVALS	ENGINEER	DATE	APPROVALS	ENGINEER	DATE
D.R.C. Chair			Water		
Transportation	R. P. P. P.	2/3/94	Waste Water		
Hydrology					
PROJECT NO. 4018.91		MAP NO. K-14		SHEET 19 OF 25	

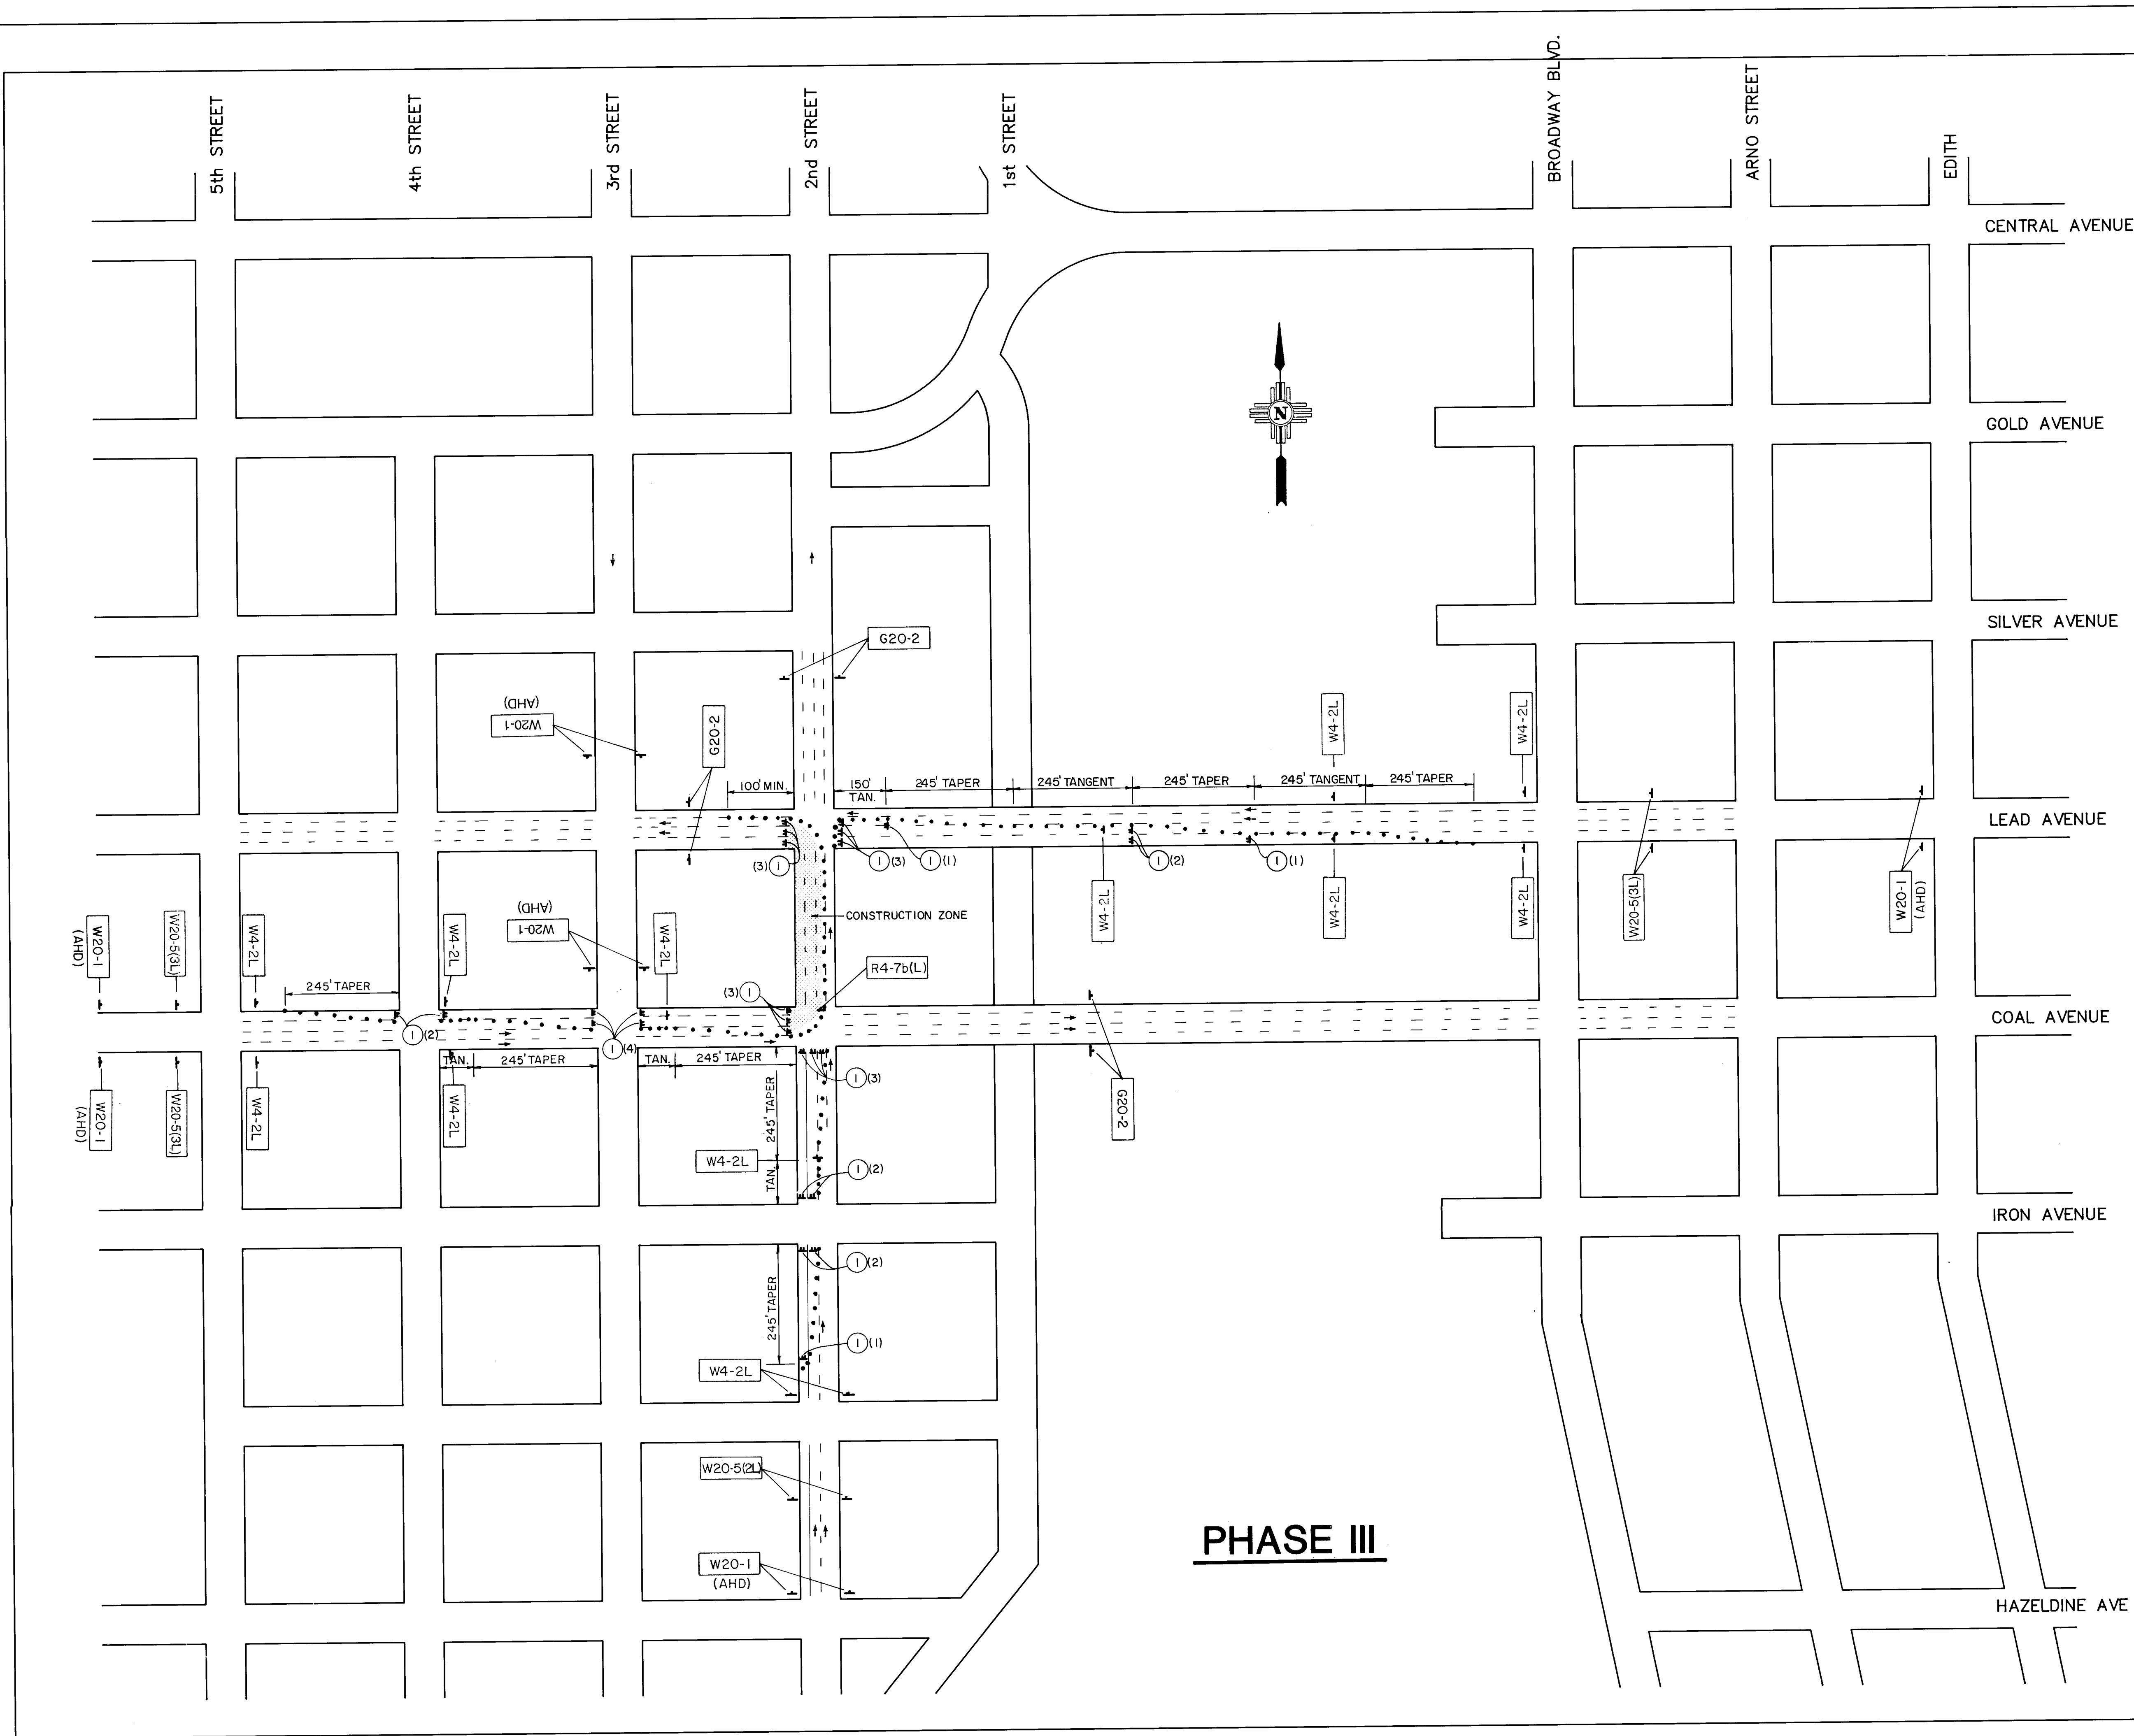

LEGEND

- CONSTRUCTION ZONE
- TYPE III BARRICADE
- TRAFFIC SIGN
- TYPE I BARRICADE**
- VERTICAL PANEL
- DIRECTION OF TRAVEL

KEYED NOTES

① TYPE III BARRICADES (#) W/R11-2a

AS BUILT INFORMATION

CONTRACTOR	MOORE & CHAMBERLAIN	DATE	10/11/94
WORK	RECONSTRUCTION OF THE COAL AVE BRIDGE AND 2nd STREET S.W.	DATE	10/11/94
INSPECTOR'S	DATE	DATE	DATE
FIELD	DATE	DATE	DATE
VERIFICATION BY	DATE	DATE	DATE
CORRECTED BY	DATE	DATE	DATE
MICRO-FILM INFORMATION			
RECORDED BY	NO.	DATE	

SURVEY INFORMATION

FIELD NOTES		DATE
NO.	BY	

ENGINEER'S SEAL

24-4018.91 10 11 20916

AVID ENGINEERING, INC.
Civil • Structural • Transportation
6100 Seagull St. NE - Suite 102
Albuquerque, NM 87109 - (505) 881-5357


NO.	DATE	REMARKS	BY
		DESIGN	
		DRAWN BY	
		CHECKED BY	

CITY OF ALBUQUERQUE
PUBLIC WORKS DEPARTMENT
ENGINEERING GROUP

TITLE: RECONSTRUCTION OF THE COAL AVE BRIDGE AND 2nd STREET S.W.
CONSTRUCTION SIGNING LAYOUT - PHASE III

APPROVALS	ENGINEER	DATE	APPROVALS	ENGINEER	DATE
D.R.C. Chair			Water		
Transportation		2/4/94	Waste Water		
Hydrology					

PROJECT NO. 4018.91 MAP NO. K-14 SHEET 20 OF 25

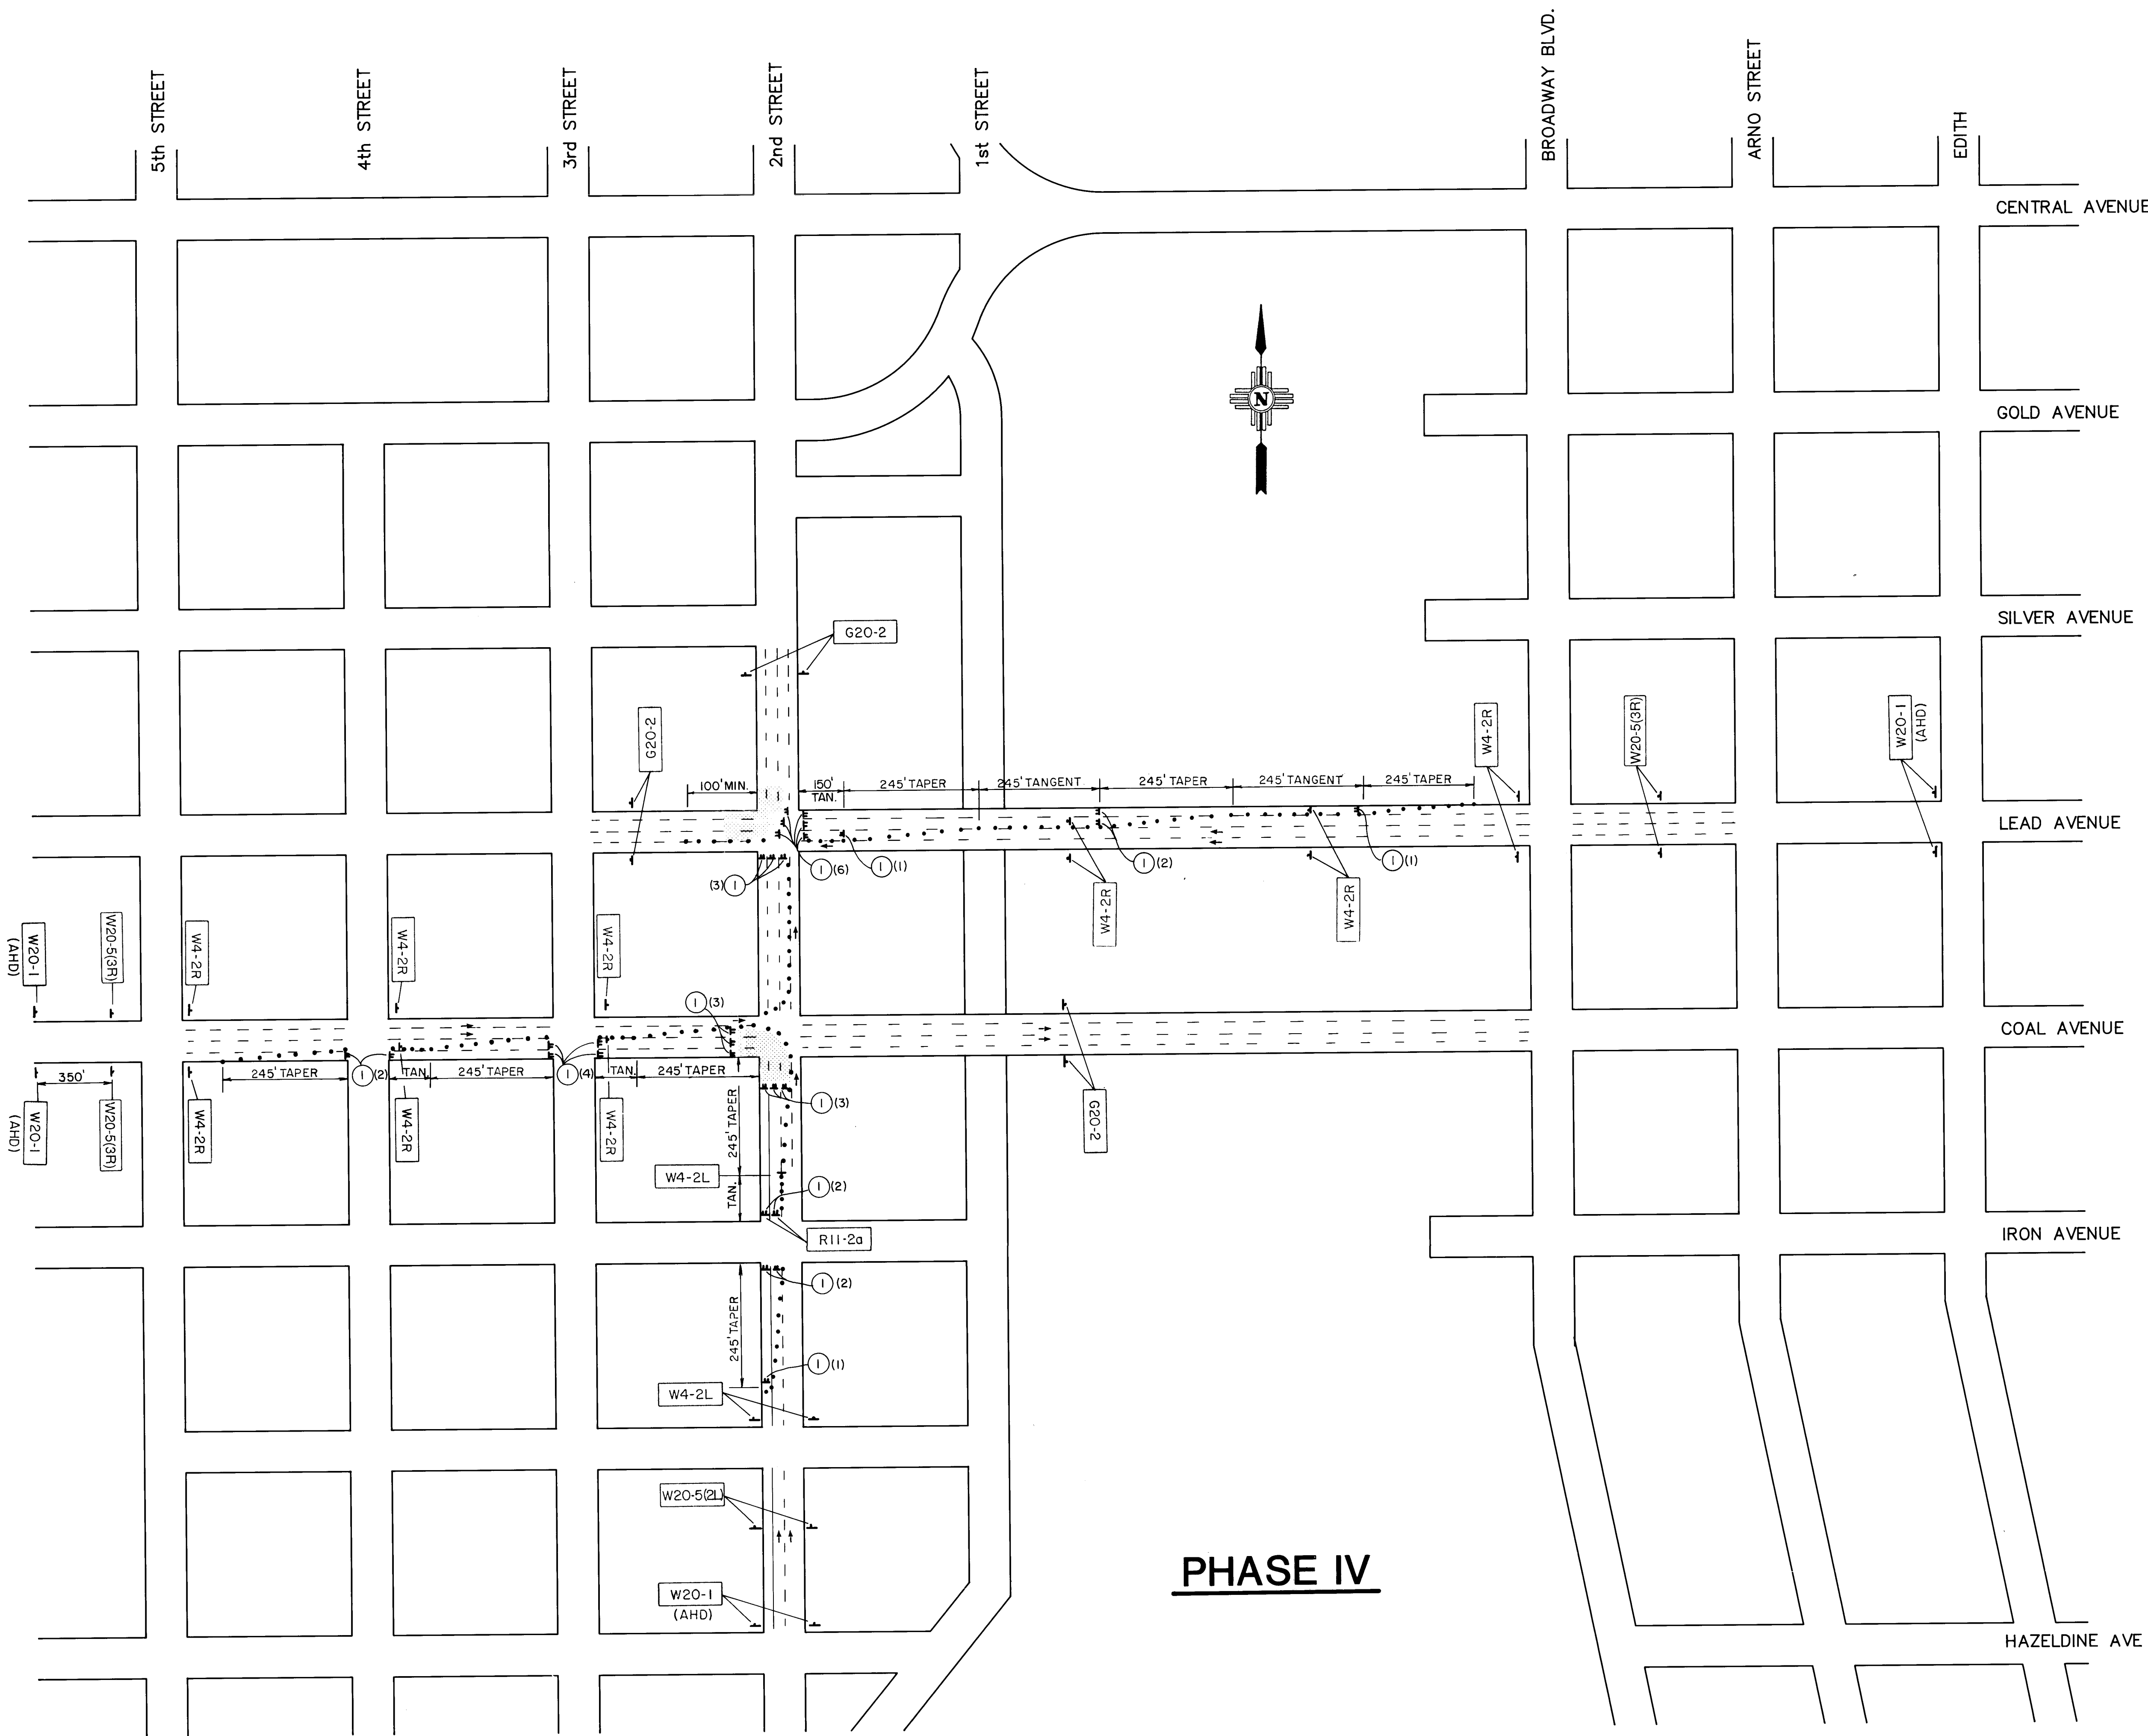

- LEGEND**
- CONSTRUCTION ZONE
 - TYPE III BARRICADE
 - TRAFFIC SIGN
 - TYPE I BARRICADE**
 - VERTICAL PANEL
 - DIRECTION OF TRAVEL


KEYED NOTES

① TYPE III BARRICADES (#) W/R11-2a

24-4018.91 2196

AVID ENGINEERING, INC.
Civil • Structural • Transportation
6100 Seagull St. NE - Suite 102
Albuquerque, NM 87109 - (505) 881-5357

CITY OF ALBUQUERQUE PUBLIC WORKS DEPARTMENT ENGINEERING GROUP					
TITLE: RECONSTRUCTION OF THE COAL AVE BRIDGE AND 2nd STREET S.W. CONSTRUCTION SIGNING LAYOUT - PHASE IV					
APPROVALS	ENGINEER	DATE	APPROVALS	ENGINEER	DATE
D.R.C. Chair			Water		
Transportation	RB	2/4/94	Waste Water		
Hydrology					
PROJECT NO. 4018.91		MAP NO. K-14		SHEET 21 OF 25	

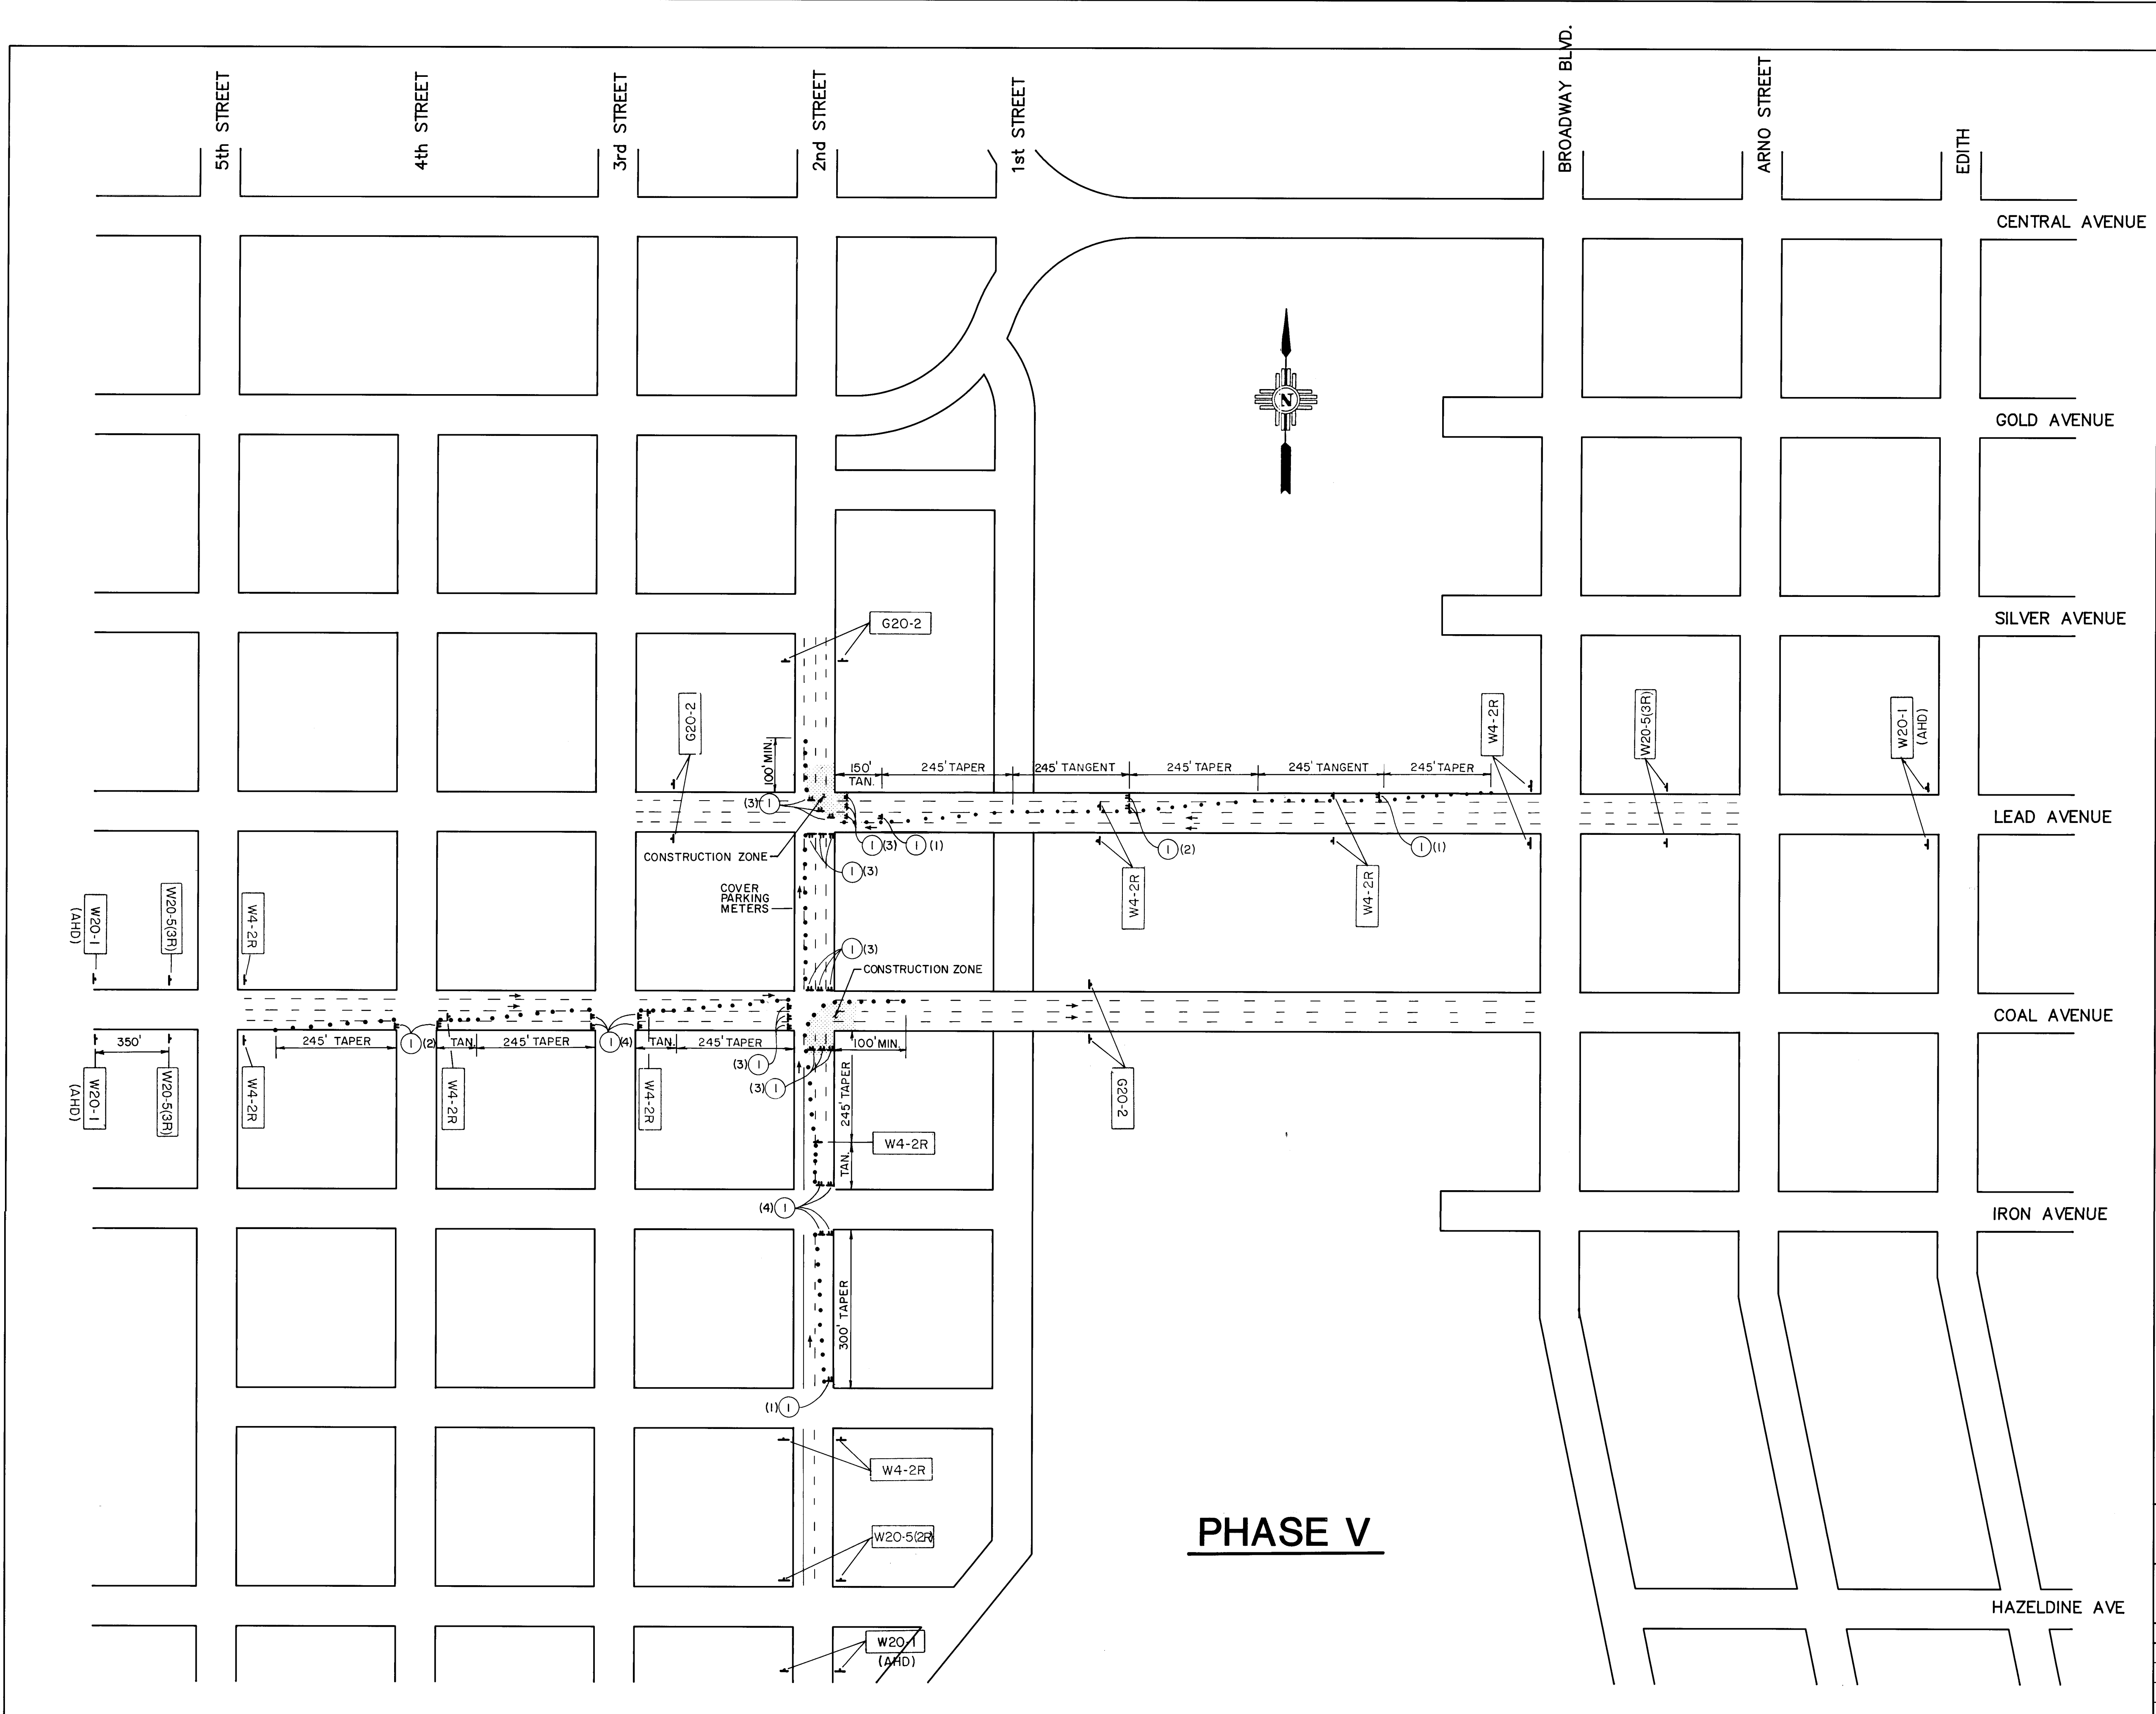

- LEGEND**
- CONSTRUCTION ZONE
 - TYPE III BARRICADE
 - TRAFFIC SIGN
 - TYPE I BARRICADE**
 - VERTICAL PANEL
 - DIRECTION OF TRAVEL

KEYED NOTES

1 TYPE III BARRICADES (#) W/R11-2a

AS BUILT INFORMATION			BENCH MARKS			SURVEY INFORMATION			ENGINEER'S SEAL			NO. DATE			REMARKS			DESIGN			DESIGNED BY			DRAWN BY			CHECKED BY		
CONTRACTOR	MOORE & COMPANY	DATE	1/1/94	INSPECTOR	MOORE & COMPANY	DATE	1/1/94	ACCEPTANCE BY	C.O.A.	DATE	1/1/94	VERIFICATION BY	C.O.A.	DATE	1/1/94	DRAWINGS	BY AVID ENG.	DATE	1/1/94	MICRO-FILM INFORMATION	RECORDED BY	DATE							

20-4018.91-2296

AVID ENGINEERING, INC.
Civil • Structural • Transportation
6100 Seagull St. NE - Suite 102
Albuquerque, NM 87109 - (505) 881-3357

CITY OF ALBUQUERQUE PUBLIC WORKS DEPARTMENT ENGINEERING GROUP					
TITLE: RECONSTRUCTION OF THE COAL AVE BRIDGE AND 2nd STREET S.W. CONSTRUCTION SIGNING LAYOUT - PHASE V					
APPROVALS	ENGINEER	DATE	APPROVALS	ENGINEER	DATE
D.R.C. Chair			Water		
Transportation	2/2/94	2/4/94	Waste Water		
Hydrology					
NO.		4018.91	MAP NO.		K-14
			SHEET		22
					25

DESIGNED BY: S.J.M. 1/90 CHECKED BY: S.J.M. 1/90
DETAILED BY: J.A.K. 1/90 CHECKED BY: E.R.D. 1/90

TABLE OF ALLOWABLE MOVEMENT LENGTHS AND ACCEPTABLE JOINT SEALS									
SKEW	MOVEMENT LENGTH (FEET)				MANUFACTURER			JOINT MOVEMENT (IN.)	* "A" (DIMENSION @ MID TEMP T ₀) (IN.)
	CONCRETE BRIDGE		STEEL BRIDGE		WATSON-BOMAN AND ACME "STRIP SEAL" MODEL NO.	D.S. BROWN CO., INC. "STEEFLEX" MODEL NO.	STRUCTURAL ACCESSORIES INC. "ONFLEX" MODEL NO.		
	SEVERE CLIMATE (-10° TO 120°F) T ₀ = 55°F	MODERATE CLIMATE (20° TO 120°F) T ₀ = 70°F	SEVERE CLIMATE (-30° TO 120°F) T ₀ = 45°F	MODERATE CLIMATE (0° TO 120°F) T ₀ = 60°F					
0° to 15°	0-427	0-556	0-342	0-427	SE-400	400L	40SEQ	0 TO 4	2
15° to 30°	0-442	0-575	0-354	0-442	SE-400	400L	40SEQ	0 TO 4	2
30° to 45°	0-493	0-642	0-395	0-493	SE-400	400L	40SEQ	0 TO 4	2

* MAXIMUM "A" IS EQUAL TO TOTAL JOINT MOVEMENT

GENERAL NOTES

- WORKMANSHIP AND MATERIALS SHALL CONFORM TO NEW MEXICO STATE HIGHWAY AND TRANSPORTATION DEPARTMENT STANDARD SPECIFICATIONS FOR ROAD AND BRIDGE CONSTRUCTION, 1984 EDITION, APPLICABLE SUPPLEMENTAL SPECIFICATIONS AND SPECIAL PROVISIONS.
- JOINT SEALS SHALL BE INSTALLED IN ACCORDANCE WITH MANUFACTURER'S RECOMMENDATIONS. SEALS HAVING EQUAL PERFORMANCE CHARACTERISTICS TO THOSE SHOWN MAY BE SUBSTITUTED IF THE ENGINEER'S WRITTEN APPROVAL IS OBTAINED AT LEAST TWO WEEKS PRIOR TO THE DAY OF THE BID OPENING.
- JOINT SEAL SIZES ARE BASED ON AN INSTALLATION TEMPERATURE OF T₀ (DEGREES F, MIDPOINT TEMPERATURE) AND JOINT MOVEMENTS FOR A RANGE OF TEMPERATURES AS NOTED IN THE TABLE ON THIS SHEET. FOR INSTALLATION TEMPERATURES BELOW T₀ INCREASE DIMENSION "A" BY THE AMOUNT SHOWN BELOW. FOR INSTALLATION TEMPERATURE ABOVE T₀ DECREASE DIMENSION "A" BY THE AMOUNT SHOWN BELOW.

FOR CONCRETE BRIDGES:

$$\text{CHANGE IN "A"} = 0.000072 \times L \times \cos \theta \times \Delta T$$

FOR STEEL BRIDGES:

$$\text{CHANGE IN "A"} = 0.000078 \times L \times \cos \theta \times \Delta T$$

WHERE:

CHANGE IN "A" IS IN INCHES.

L = MOVEMENT LENGTH IN FEET (SEE SUPERSTRUCTURE DETAILS)

θ = SKEW ANGLE

ΔT = CHANGE IN TEMPERATURE FROM T₀ IN DEGREES F.


EXAMPLE: (CONCRETE BRIDGE IN SEVERE CLIMATE T₀ = 55°F)

FOR T = 73°F, L = 100 FT, θ = 28°


CONCRETE BRIDGE, ΔT = 73° - 55° = 18°F

CHANGE IN "A" = 0.000072 X 100 X 0.8829 X 18
= 0.1144 INCHES: SAY 1/8 INCH

- UNLESS OTHERWISE SPECIFIED, EITHER TYPE I OR TYPE II JOINTS MAY BE INSTALLED AT THE OPTION OF THE CONTRACTOR.
- UNLESS OTHERWISE SPECIFIED ON THE PLANS, ALL STRUCTURES SHALL BE CONSIDERED TO BE SUBJECTED TO A SEVERE CLIMATE.

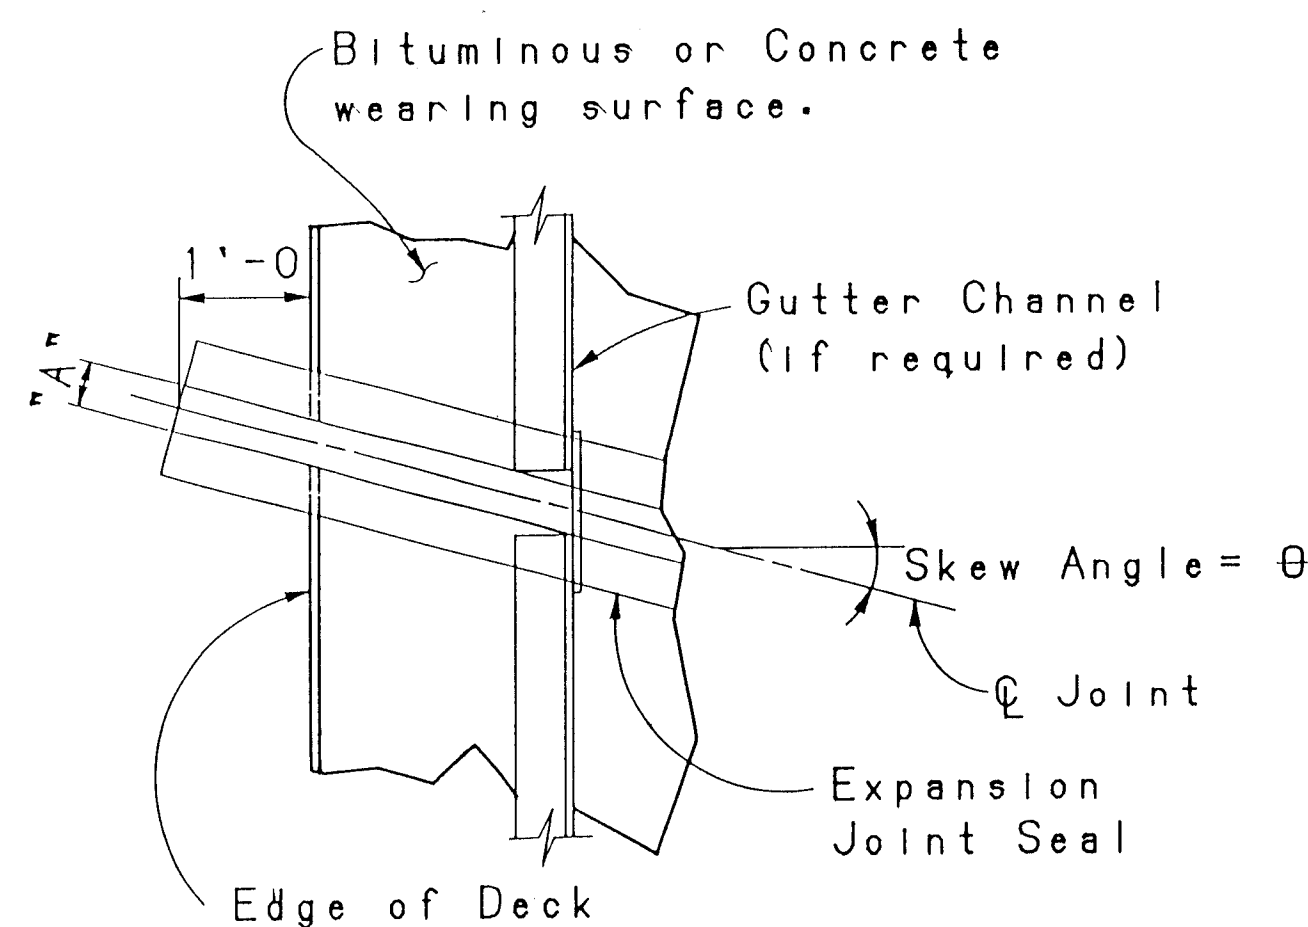


PART PLAN - SKEWED JOINT
WITH METAL RAILING

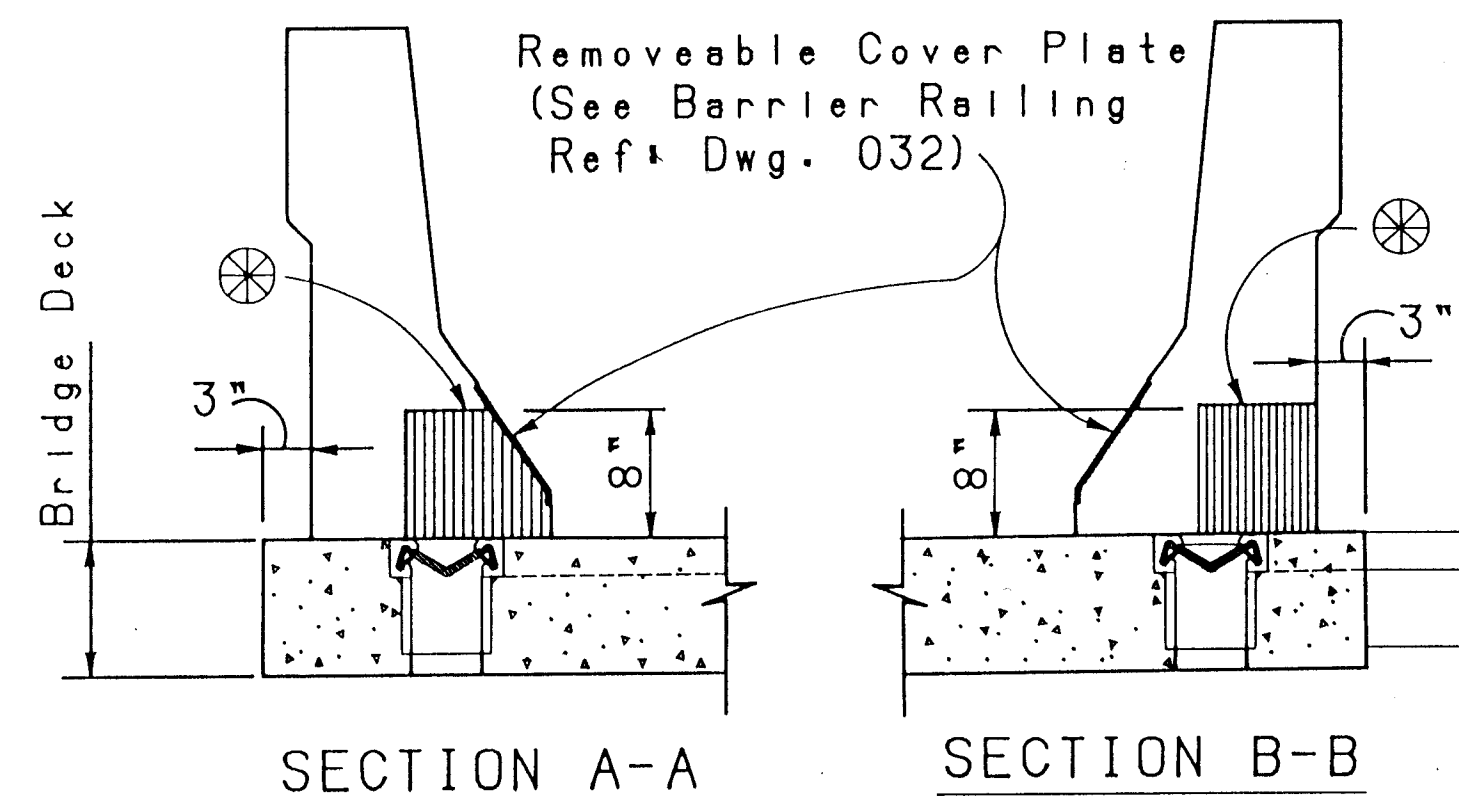

SIMILAR DETAIL FOR CURB AND SIDEWALK.

⊗ Recess in base of wall barrier.

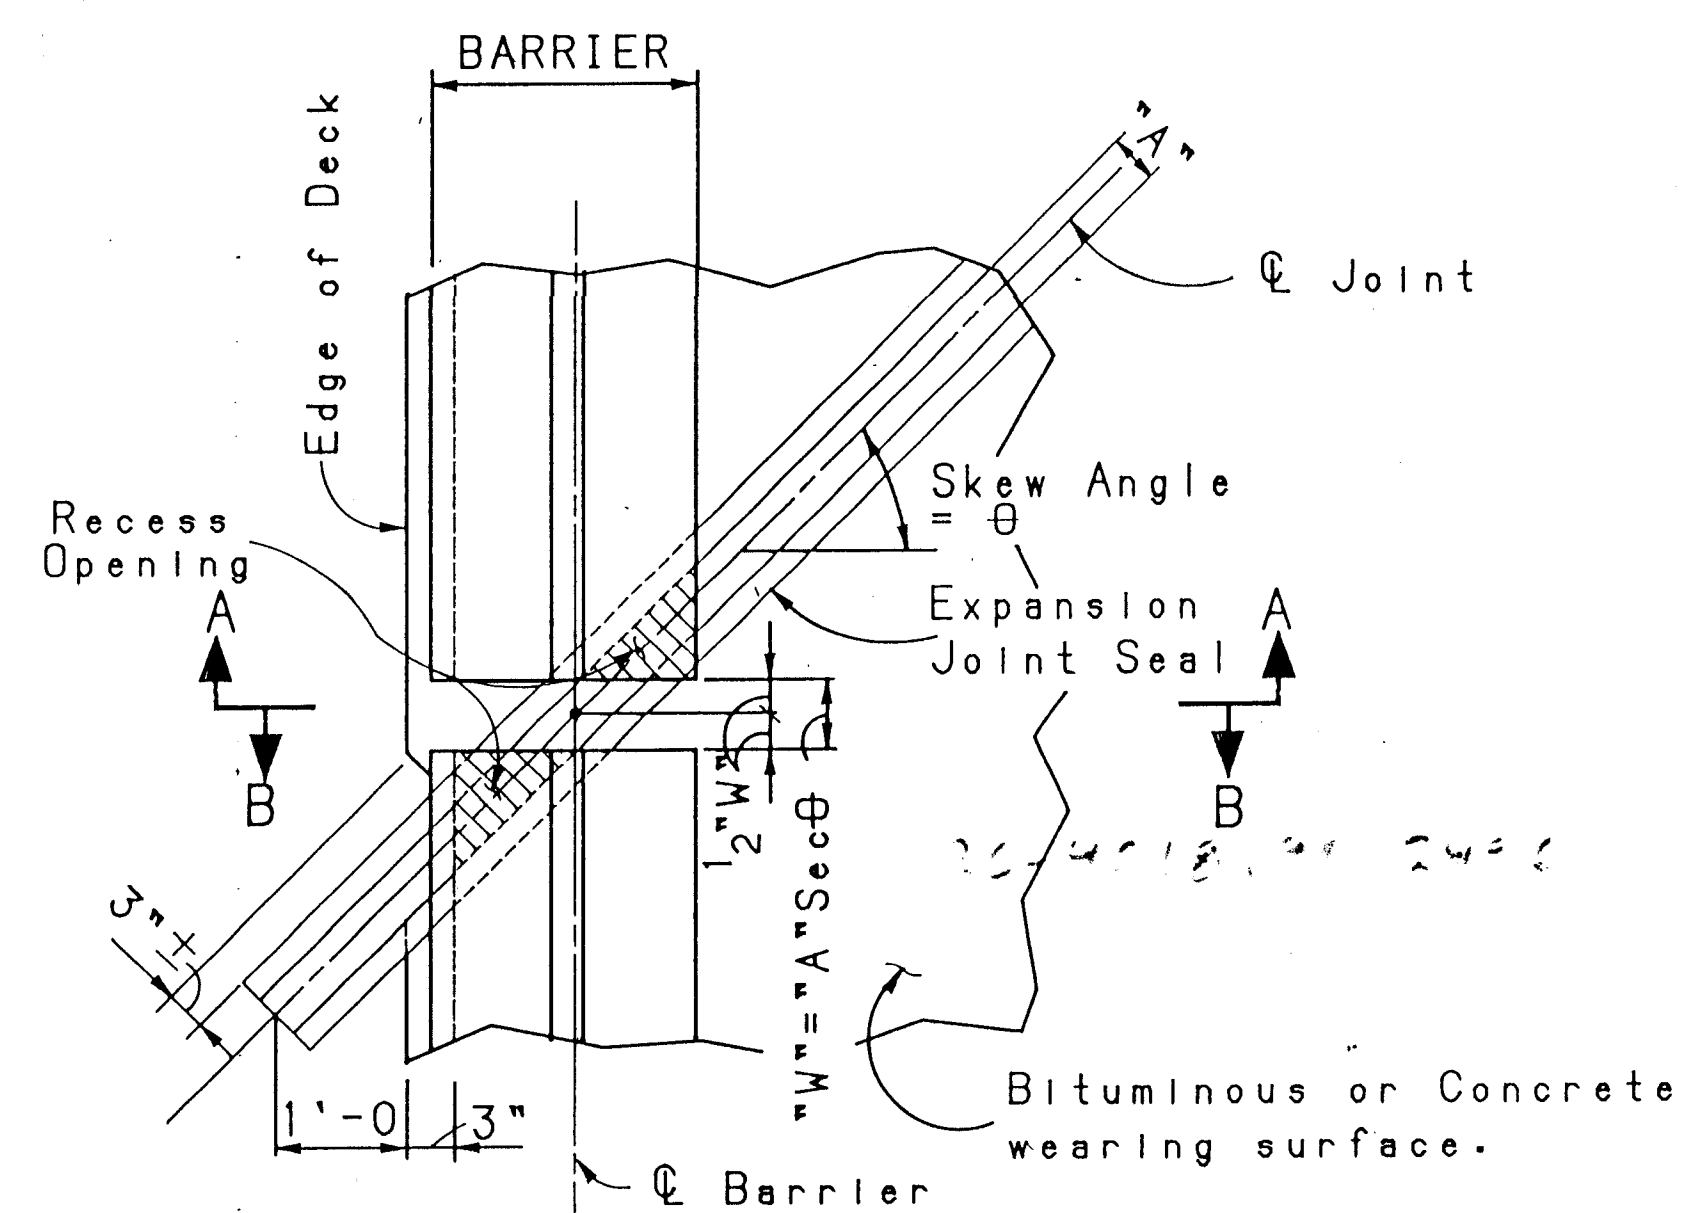


PART PLAN-SKEW JOINT
WITH CONCRETE BARRIER RAILING

24-4018.91 2396


6			
5			
4			
3			
2			
1	GENERAL REVISIONS	1/90	ERD
NO.	DESCRIPTION	DATE	BY
REVISIONS (OR CHANGE NOTICES)			
NEW MEXICO STATE HIGHWAY AND TRANSPORTATION DEPARTMENT			
ELASTOMERIC EXPANSION JOINT SEALS FOR BRIDGES GENERAL DATA			
LAYOUT BY	APPROVAL	DATE	
DRAWN BY J.A.K. 1/90	RECOMMENDED	DATE	
CHECKED BY S.J.M. 1/90	APPROVED	DATE	
DESIGN BUREAU OFFICE			
SERIAL BJS-001-01			

DESIGNED BY: E.R.D. 12/89 CHECKED BY: S.J.M. 1/90
 DETAILED BY: J.A.K. 12/89 CHECKED BY: E.R.D. 1/90

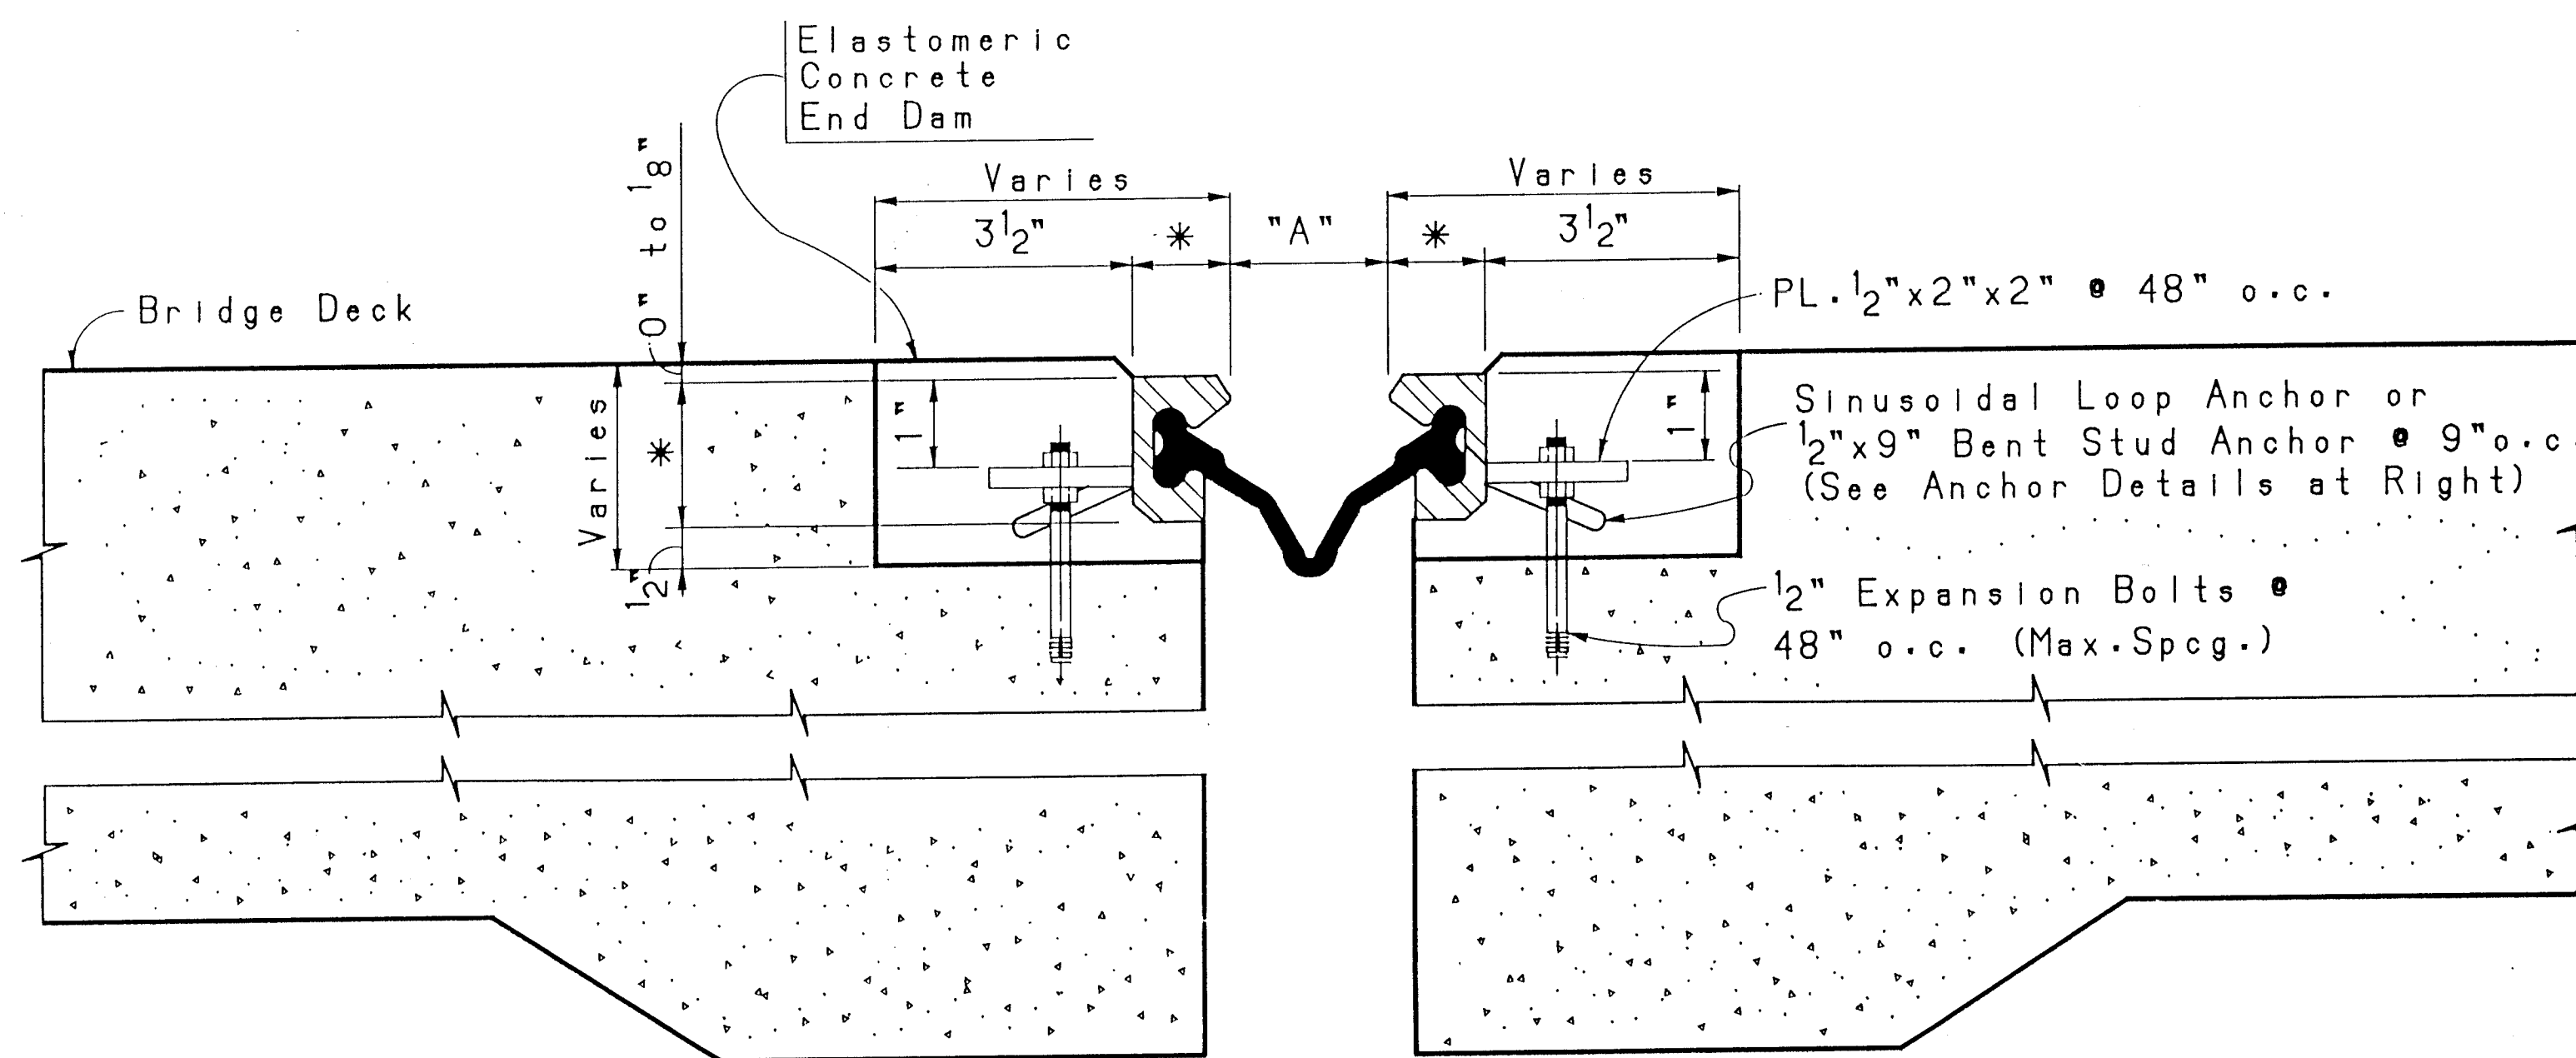

ERECTION DETAIL (ALTERNATE 1)

*Dimension of retainer bar varies with manufacturer.


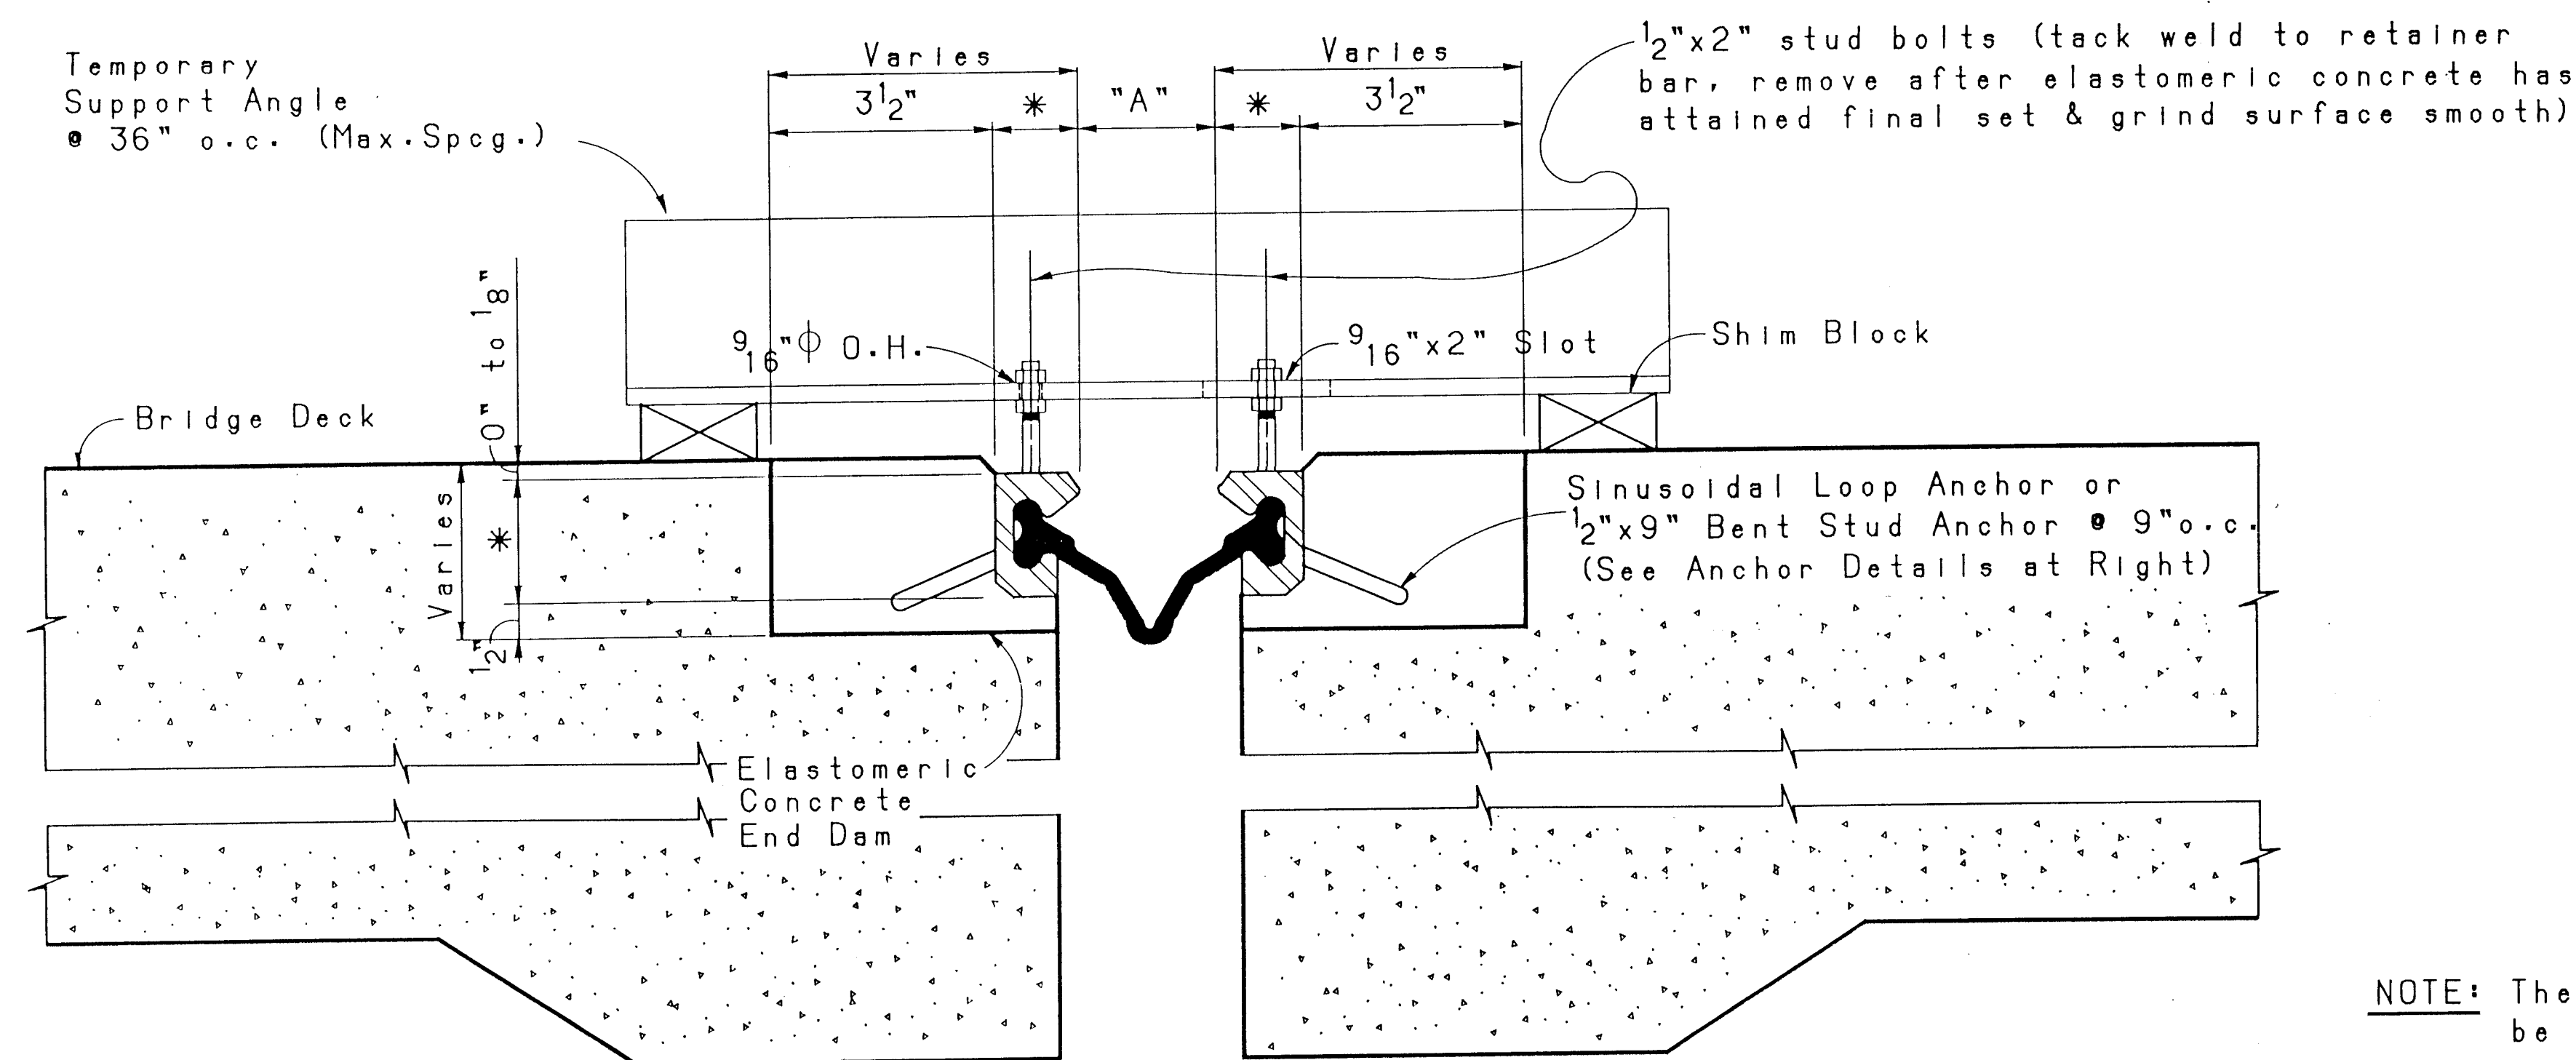


ERECTION DETAIL (ALTERNATE 2)

NOTE: The temporary support angle shall be secured in position so as to provide for lateral and vertical adjustment of the retainer bars and permit final finishing of the elastomeric concrete surface as approved by the project manager.

GENERAL NOTES


1. TYPE II INSTALLATION SHALL CONSIST OF A STEEL RETAINING BAR AND ANCHORAGE SYSTEM, AN ELASTOMERIC STRIP SEAL AND AN ELASTOMERIC CONCRETE END DAM. THE ANCHORAGE SYSTEM SHALL BE OF A CONTINUOUS SINUSOIDAL TYPE, BENT STUD ANCHOR, OR AN APPROVED EQUAL.
2. SEE SERIAL BJS-001 AND BJS-002 FOR APPROPRIATE SEAL MODEL NUMBERS AND DIMENSION "A".

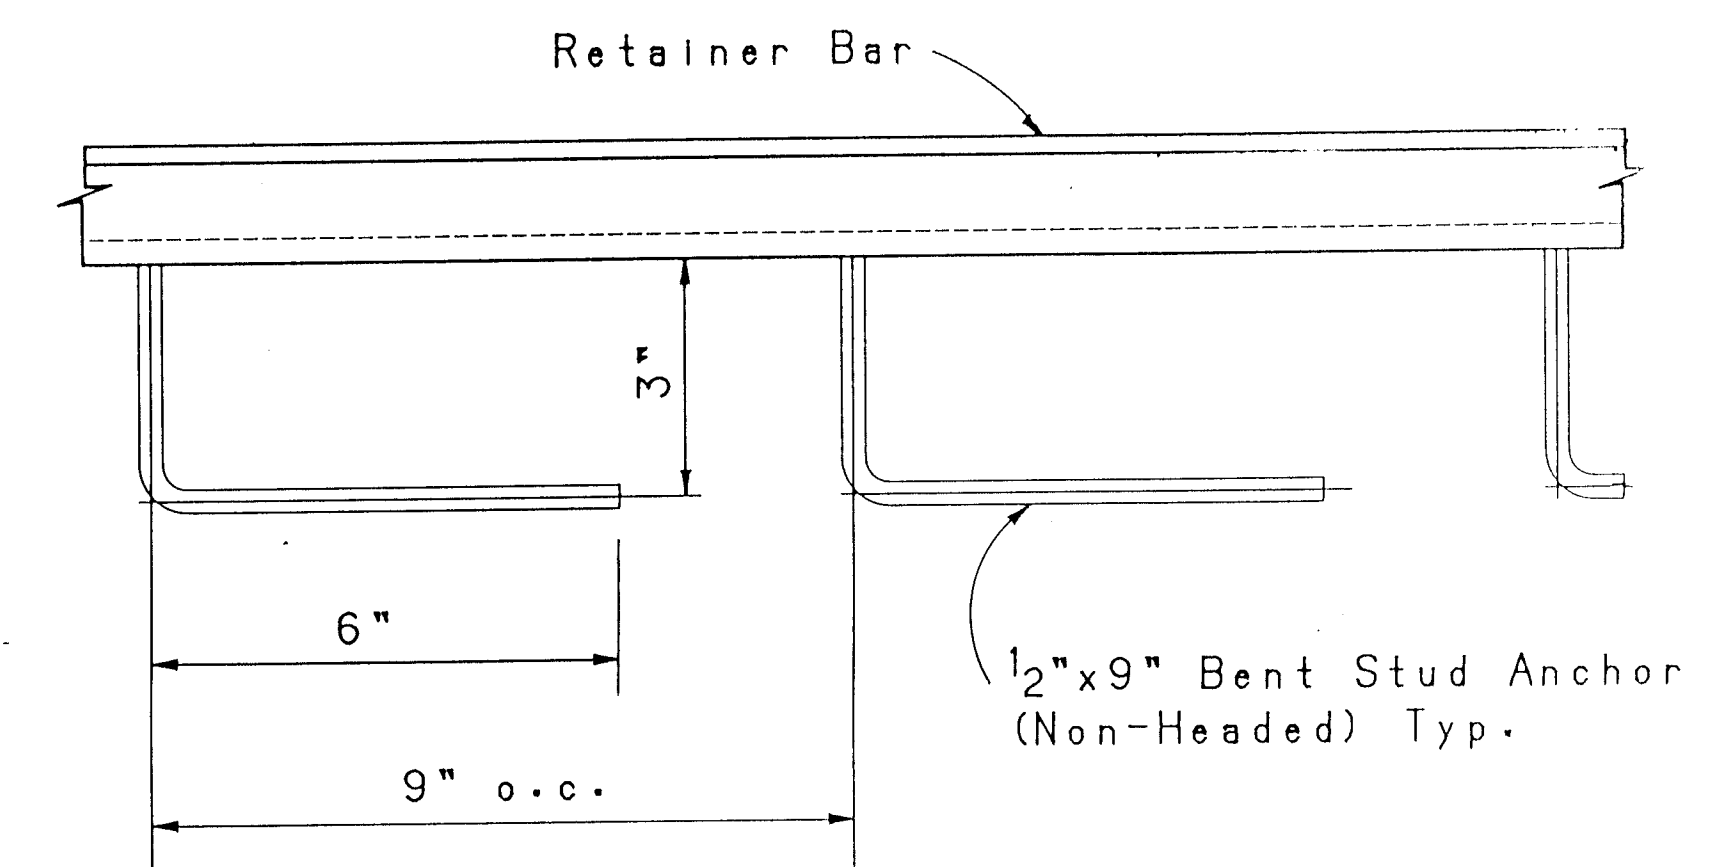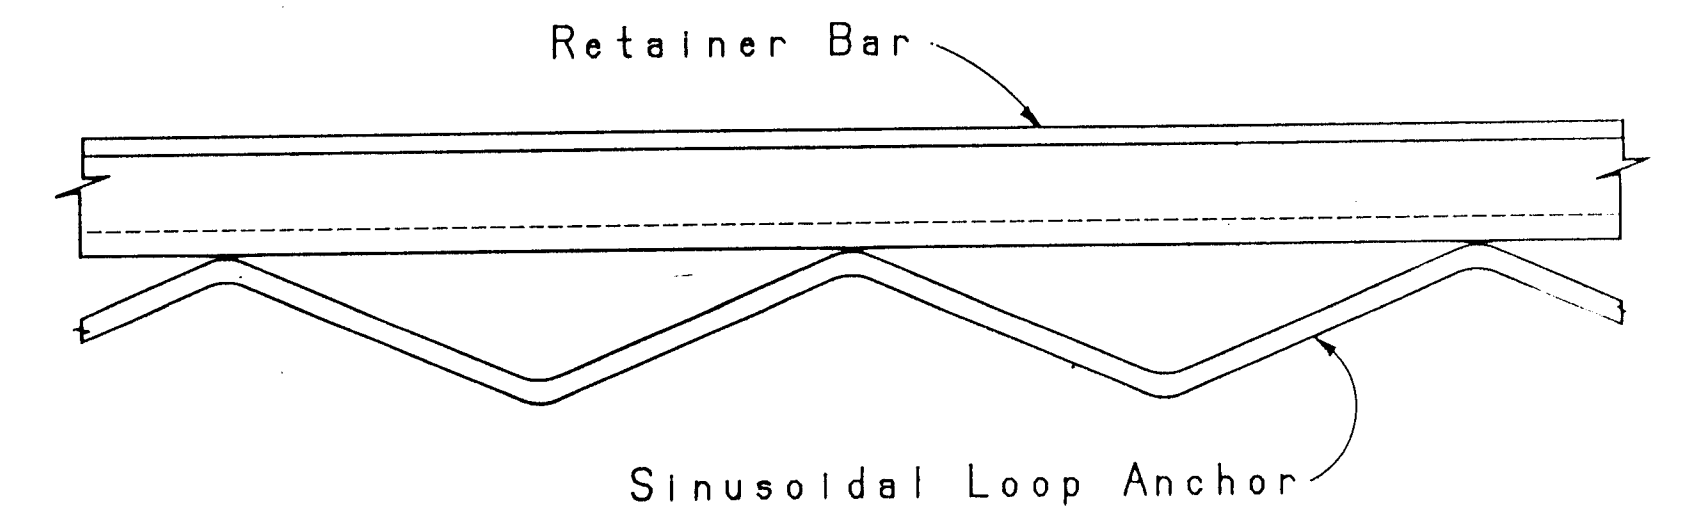

PERMISSIBLE ANCHOR DETAILS

20-4018.91 2496

6			
5			
4			
3			
2			
1	GENERAL REVISIONS	1/90	ERD
NO.	DESCRIPTION	DATE	BY
REVISIONS (OR CHANGE NOTICES)			
NEW MEXICO STATE HIGHWAY AND TRANSPORTATION DEPARTMENT			
ELASTOMERIC EXPANSION JOINT SEALS FOR BRIDGES TYPE II INSTALLATION			
LAYOUT BY:	APPROVAL	DATE	
DRAWN BY: J.A.K. 12/89	RECOMMENDED	BRIDGE ENGINEER	9/25/90
CHECKED BY:	APPROVED	DESIGN BUREAU CHIEF	6-13-90
SERIAL BJS-003-01			

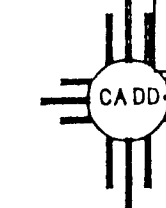

GENERAL NOTES

- ONE-HALF THE LENGTH OF ALL NO. 10 SMOOTH DOWEL BARS SHALL BE COATED WITH ONE COAT OF LEAD OR TAR PAINT. THE COATED HALF SHALL BE GREASED BEFORE PLACEMENT OF CONCRETE.
- IN ALL CASES, DOWELS IN TRANSVERSE JOINTS ARE TO BE PARALLEL TO CENTER LINE OF LANE.
- EXPANSION JOINTS SHALL BE CONSTRUCTED AT THE DIRECTION OF THE ENGINEER. NUMBER AND LOCATION OF EXPANSION JOINTS WILL BE DEPENDENT UPON EXPANSIVE QUALITY OF CONCRETE AGGREGATES AND THE AMBIENT TEMPERATURE, AS PER PORTLAND CEMENT CONCRETE ASSOCIATION DESIGN AND CONTROL OF CONCRETE MIXTURES MANUAL, (12th EDITION, 1979).
- SEALANT RESERVOIR, JOINT SHAPE FACTOR, AND BACKER ROD, IF REQUIRED, SHALL BE AS RECOMMENDED BY THE MANUFACTURER OF THE JOINT FILLER USED.
- WORKMANSHIP AND MATERIALS SHALL CONFORM TO THE NEW MEXICO STATE HIGHWAY AND TRANSPORTATION DEPARTMENT SPECIFICATIONS FOR ROAD AND BRIDGE CONSTRUCTION, LATEST EDITION, AND SUPPLEMENTAL SPECIFICATIONS AND SPECIAL PROVISIONS.
- WHEN NEW CONCRETE PAVEMENT ABUTS AN EXISTING CONCRETE PAVEMENT THE TRANSVERSE JOINT SHALL BE DOWELED WITH COATED, SMOOTH, GRADE 60, NO. 10, DOWEL BARS, 16 IN. LONG, SPACED AT 12 IN. CENTER TO CENTER. THE TRANSVERSE FACE OF THE EXISTING PCCP SHALL BE DRILLED TO ACCEPT ONE-HALF OF THE DOWEL LENGTH. THE DRILL HOLES SHALL BE LOCATED SUCH THAT THE DOWEL BARS WILL BE AT MID DEPTH OF THE THINNER OF THE TWO ABUTTING SLABS. THE DRILL HOLES SHALL BE A DIAMETER THAT WILL PROVIDE A CLOSE FIT FOR THE DOWELS. THE DOWELS SHALL BE EPOXIED INTO THE DRILLED HOLES. THE FREE HALF OF THE DOWEL BARS SHALL BE COATED WITH ONE COAT OF LEAD OR TAR PAINT. THE COATED HALF SHALL BE GREASED BEFORE PLACEMENT OF CONCRETE.
- WHEN A NEW LANE OF CONCRETE PAVEMENT IS BUILT ADJACENT TO AN EXISTING LANE OF CONCRETE PAVEMENT THE LONGITUDINAL JOINT SHALL BE TIED WITH GRADE 40, NO. 5, DEFORMED STEEL BARS 30 IN. LONG, SPACED AT 30 INCHES CENTER TO CENTER. THE LONGITUDINAL FACE OF THE EXISTING PCCP SHALL BE DRILLED TO ACCEPT ONE HALF OF THE TIE BAR LENGTH. THE DRILL HOLES SHALL BE LOCATED SUCH THAT THE TIE BARS WILL BE AT MID DEPTH OF THE THINNER OF THE TWO ADJOINING SLABS. THE DRILL HOLES SHALL BE A DIAMETER THAT WILL PROVIDE A CLOSE FIT FOR THE TIE BARS. THE TIE BARS SHALL BE EPOXIED INTO THE DRILLED HOLES.
- INITIAL SAWCUT FOR CRACK CONTROL PURPOSES SHALL BE 1/8" TO 1/4" IN WIDTH.
- NO ADJUSTMENT OF THE JOINT LAYOUT PLAN SHALL BE DONE WITHOUT APPROVAL BY THE CENTRAL LAB.

JOINT TYPE "A"

KEYED LONGITUDINAL CONSTRUCTION JOINT WITH TIEBARS

JOINT TYPE "E"

TRANSVERSE DOWELLED EXPANSION JOINT

JOINT TYPE "B"

SAWED LONGITUDINAL JOINT WITH TIEBARS

JOINT TYPE "F"

TRANSVERSE DOWELLED CONSTRUCTION JOINT

JOINT TYPE "C"

KEYED LONGITUDINAL CONSTRUCTION JOINT

NOTE: TYPE "F" JOINTS ARE TO BE USED AT E.O.P. & B.O.P. AND AT END OF DAYS PAVING, UNLESS DAYS PAVING ENDS AT AN EXPANSION JOINT. IF THE DISTANCE FROM THE LAST JOINT TO BE SAWED TO THE TYPE "F" JOINT REQUIRED WOULD BE LESS THAN 10', THE DISTANCE BETWEEN THE LAST TWO JOINTS TO BE SAWED SHALL BE ADJUSTED SO THAT THE DISTANCE BETWEEN JOINTS WILL NOT BE LESS THAN 10'.

JOINT TYPE "D"


TRANSVERSE DOWELLED SAWED CONTRACTION JOINT

BUTT JOINT


CONCRETE TO ASPHALT

PLAN OF JOINT LOCATION


* APPLIES FOR HIGH PERCENTAGE OF TRUCK TRAFFIC

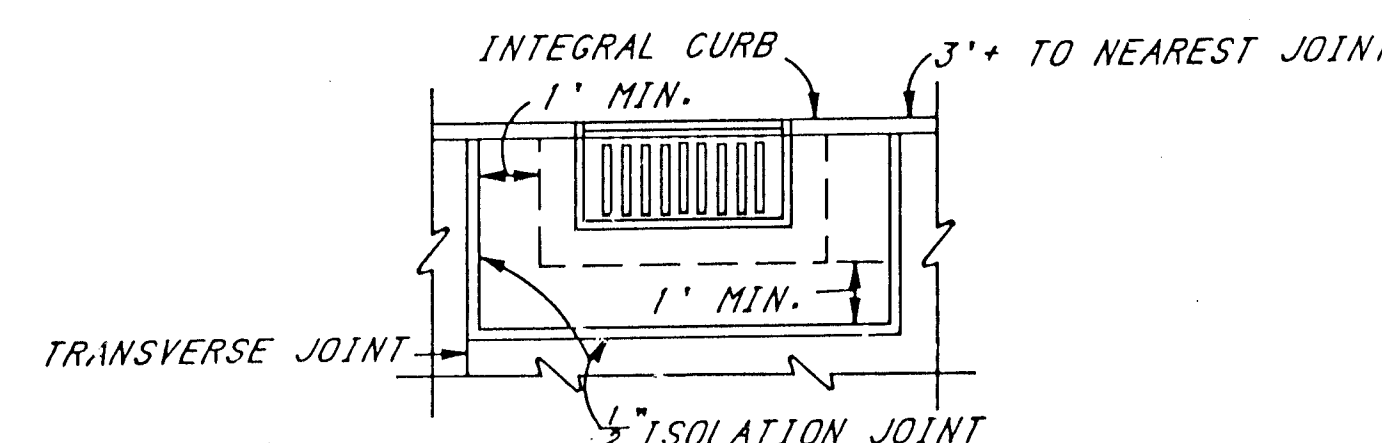


DRAINAGE INLET

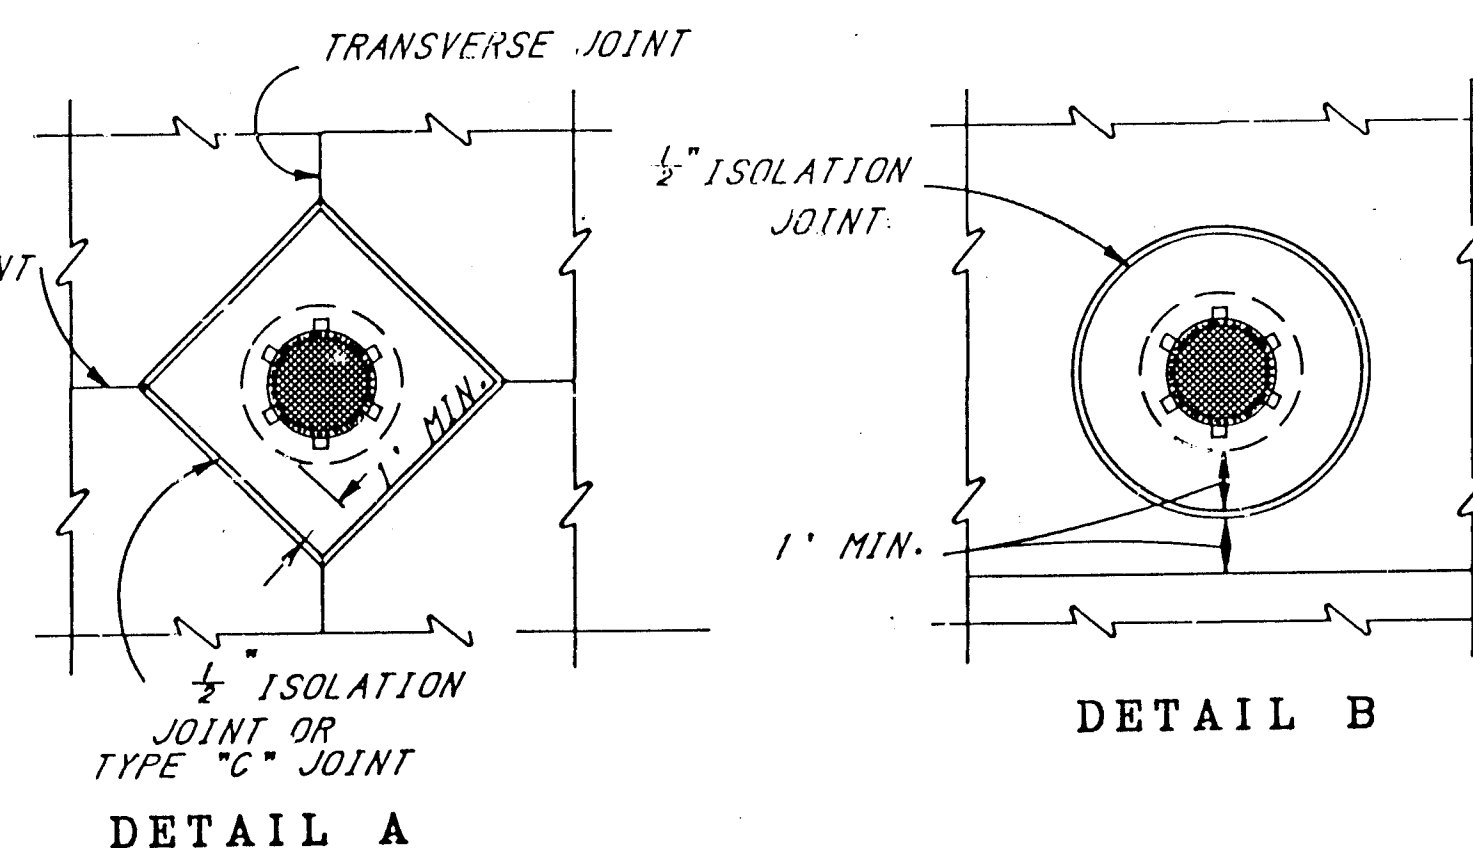

MANHOLE COVERS

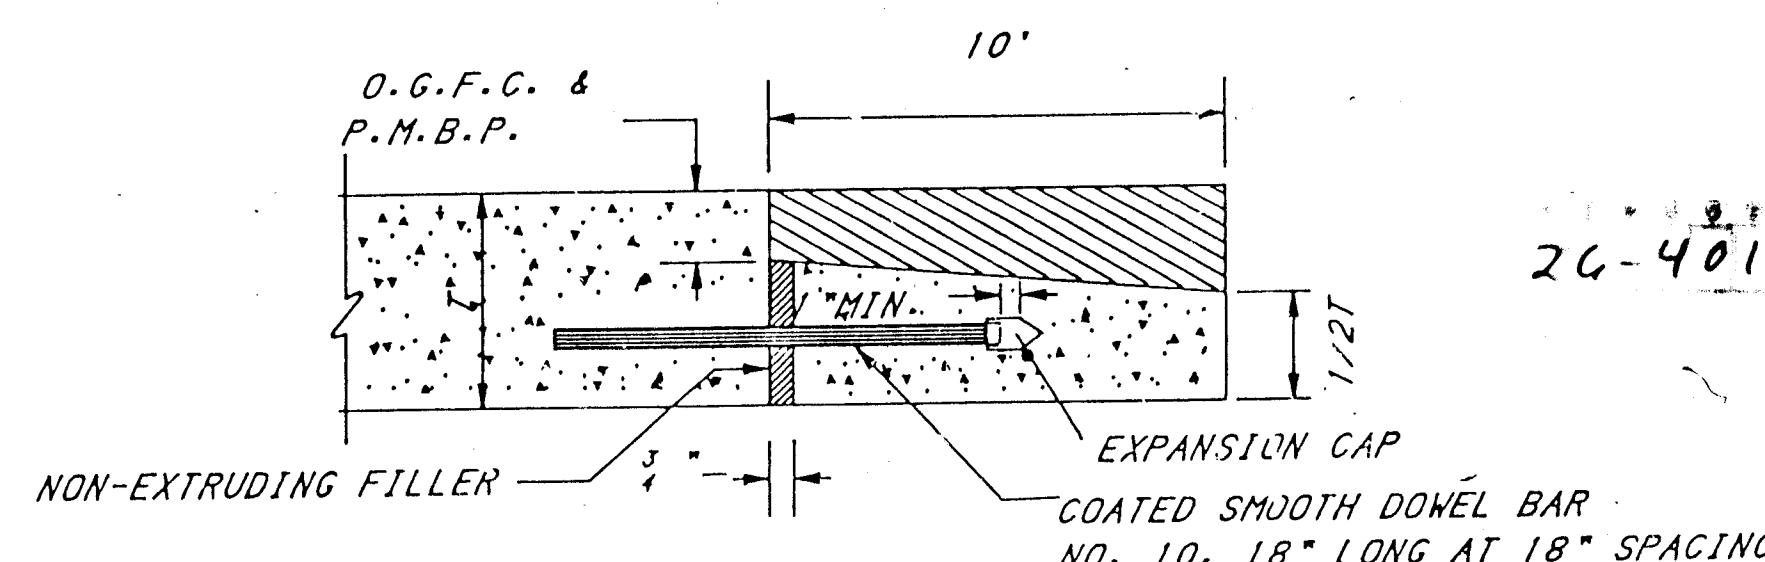


TRANSITION JOINT

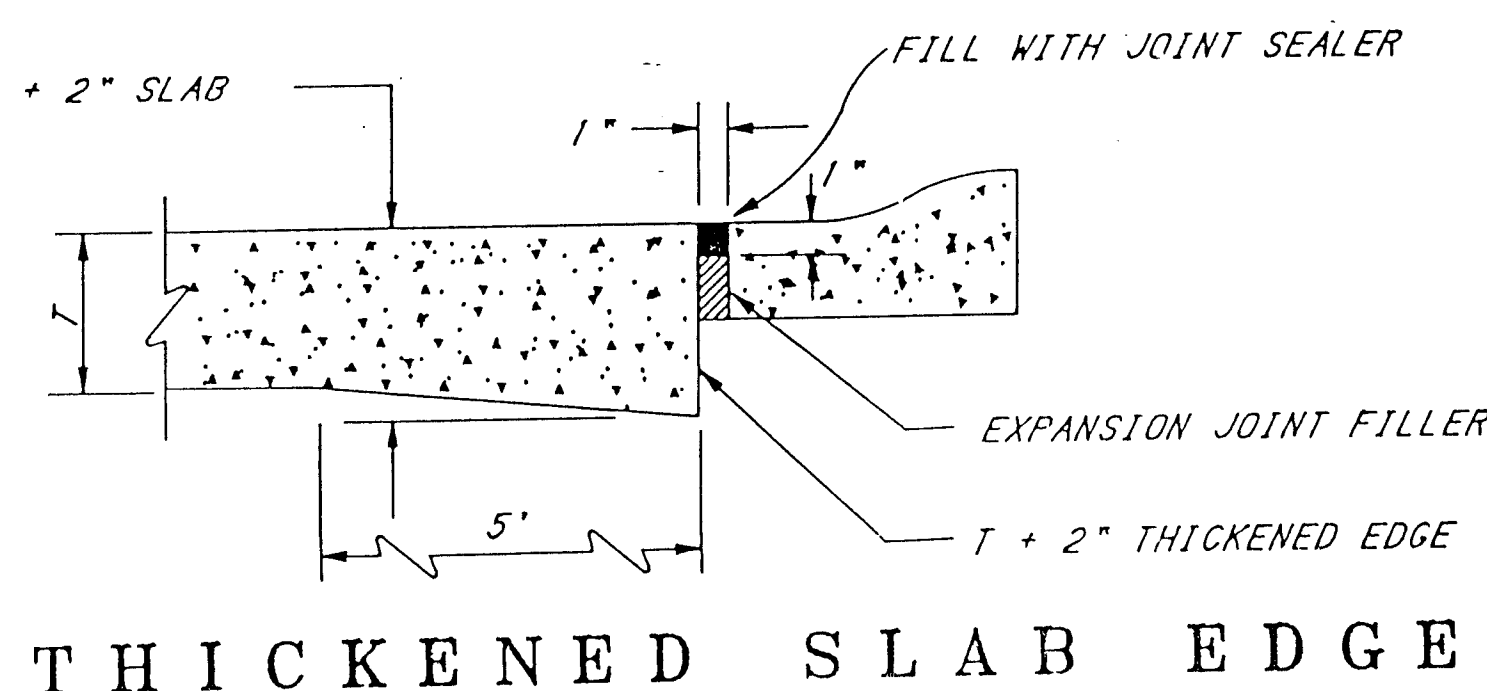

THICKENED SLAB EDGE

3			
2			
1	ADDED NOTE NO. 9	11-19-87	RS
NO.	DESCRIPTION	DATE	BY
REVISIONS (OR CHANGE NOTICES)			
NEW MEXICO STATE HIGHWAY DEPARTMENT			
STANDARD JOINT DETAILS			
APPROVAL <i>[Signature]</i> ENGINEER DATE 4/29/88			
APPROVED <i>[Signature]</i> ENGINEER OF DESIGN DATE 5/1/88			
SERIAL NO. LJD-001-10			

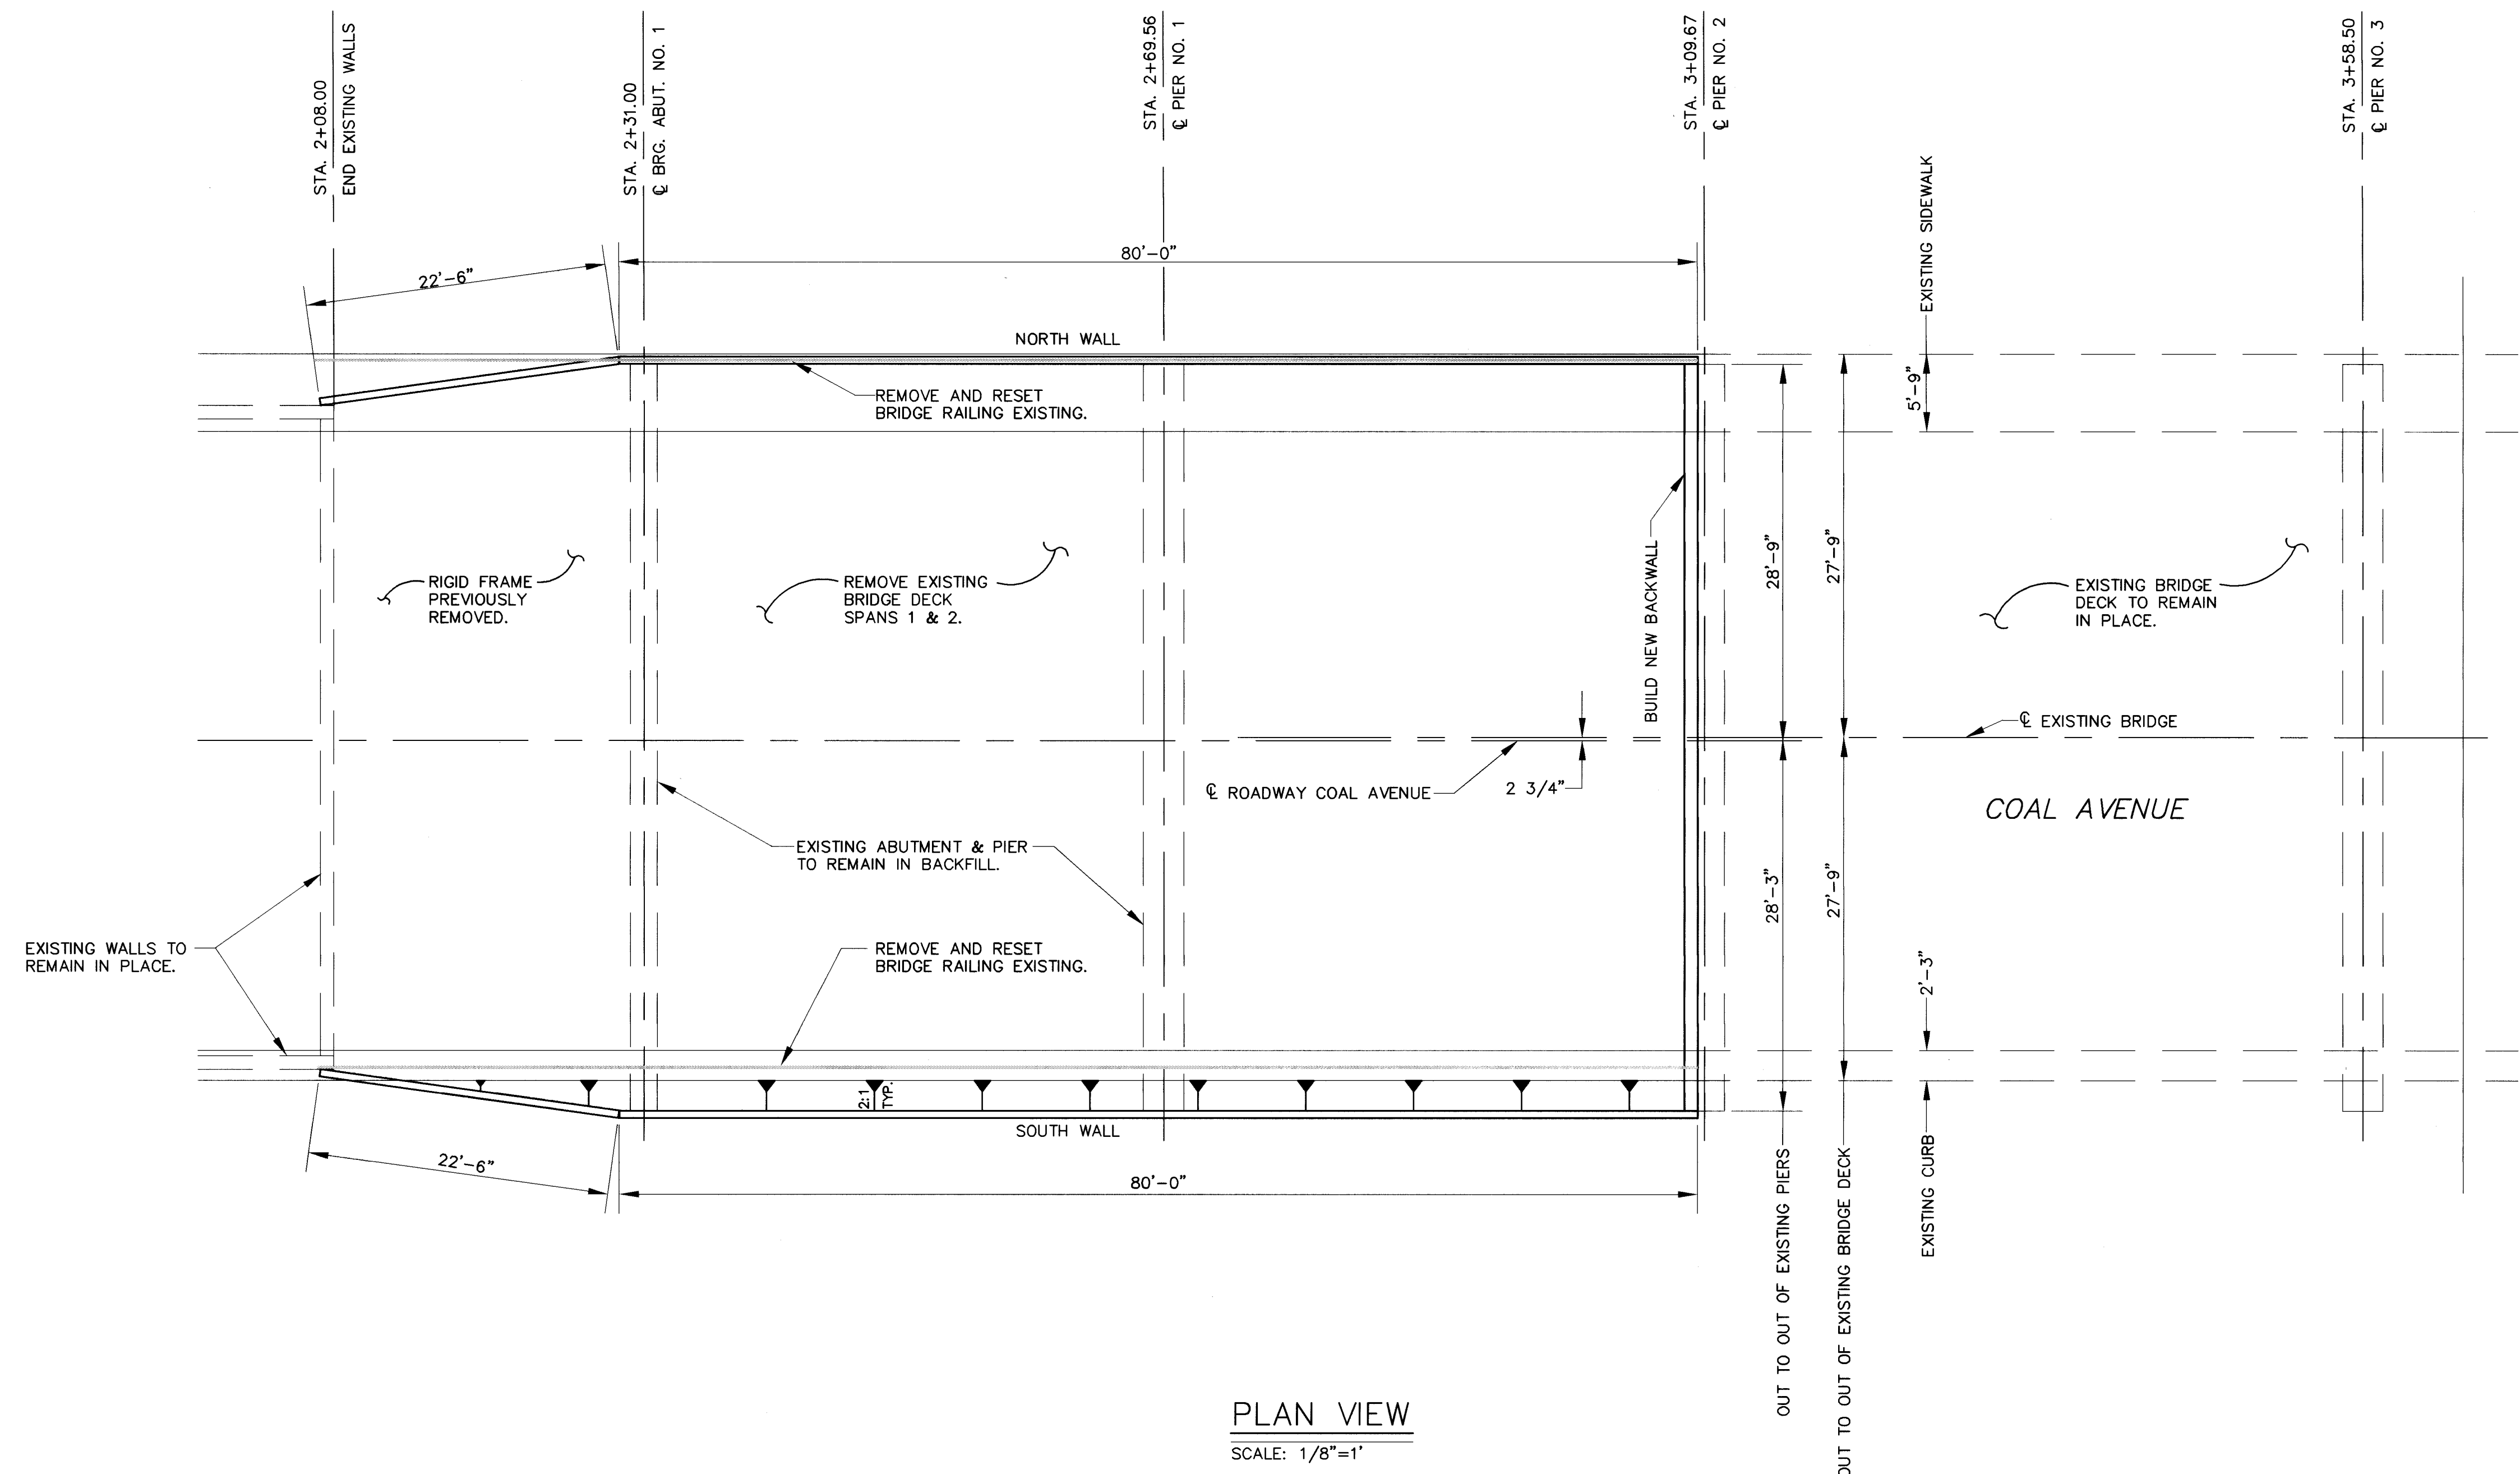

PLAN VIEW
SCALE: 1/8"=1'

GENERAL NOTES


1. ALL CONSTRUCTION SHALL CONFORM TO THE REQUIREMENTS CONTAINED IN THE NEW MEXICO STATE HIGHWAY AND TRANSPORTATION DEPARTMENT SPECIAL PROVISIONS FOR EARTH RETAINING STRUCTURES WITH SOIL REINFORCEMENT SECTION 768, REVISED JUNE 12, 1992, AND THE PROJECT PLANS & SPECIFICATIONS.
2. M.S.E. WALL SHALL RECEIVE AN EXPOSED AGGREGATE FINISH.
3. THE OUTSIDE FACE AND SOFFIT OF THE NEW CURB AND SIDEWALK, AND THE EXPOSED FACE OF NEW CONCRETE AT PIER NO. 2 SHALL RECEIVE A SPECIAL SURFACE FINISH AS SPECIFIED IN NOTE 5 ON SHEET 2 OF THE PLANS.

AVID ENGINEERING, INC.
Civil • Structural • Transportation
6100 Seagull St. NE Suite 102
Albuquerque, NM 87109 (505) 881-5357


1ST STREET S.W.

CITY OF ALBUQUERQUE PUBLIC WORKS DEPARTMENT ENGINEERING GROUP					
TITLE: COAL AVENUE OVERPASS REHABILITATION M.S.E. WALL LOCATION PLAN					
APPROVALS	ENGINEER	DATE	APPROVALS	ENGINEER	DATE
D.R.C. Chair			Water		
Transportation			Waste Water		
Hydrology					
PROJECT NO.	4018.91	MAP NO.	K-14N	SHEET	1 OF 2


SURVEY INFORMATION			BENCH MARKS			AS BUILT INFORMATION		
FIELD NOTES								
NO.	BY	DATE				CONTRACTOR	WORK	DATE
							STAGED BY	DATE
							ACCEPTANCE BY	DATE
							FIELD LOCATION BY	DATE
							DRAWINGS	DATE
							CORRECTED BY	DATE
						MICRO-FILM INFORMATION		
							RECORDED BY	DATE
							NO.	

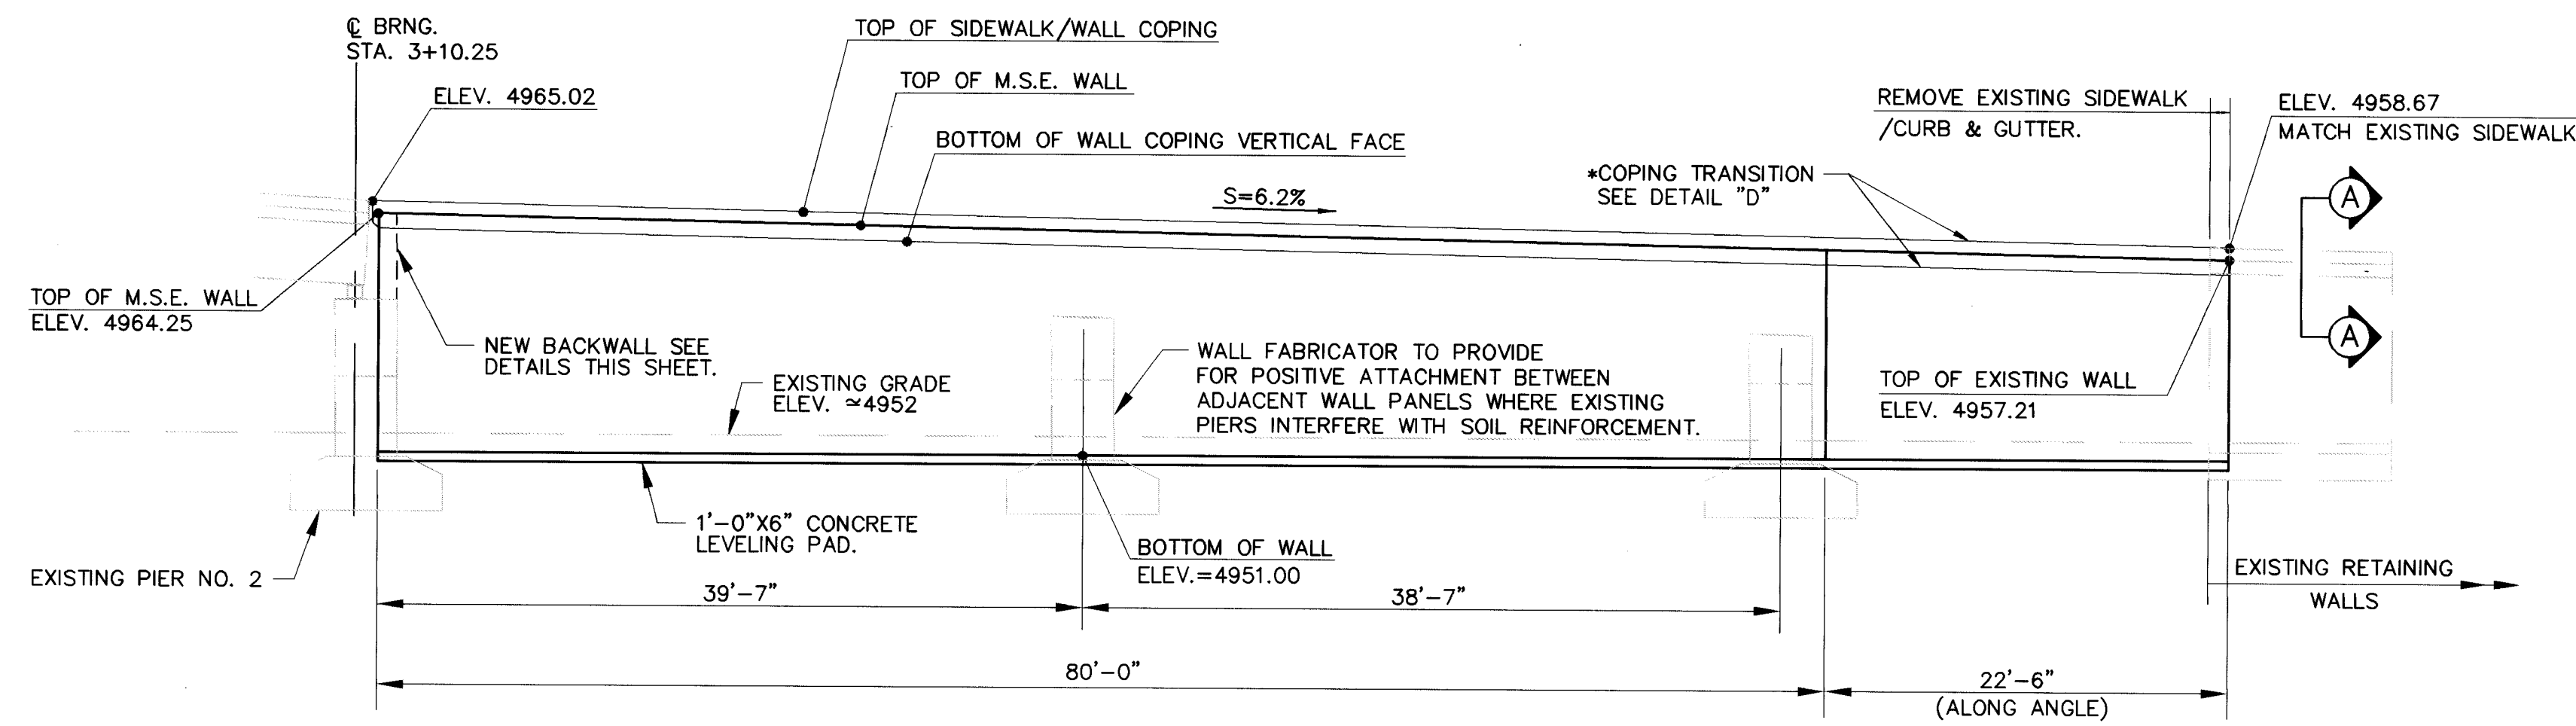


NORTH WALL ELEVATION
SCALE: 1/8"=1'

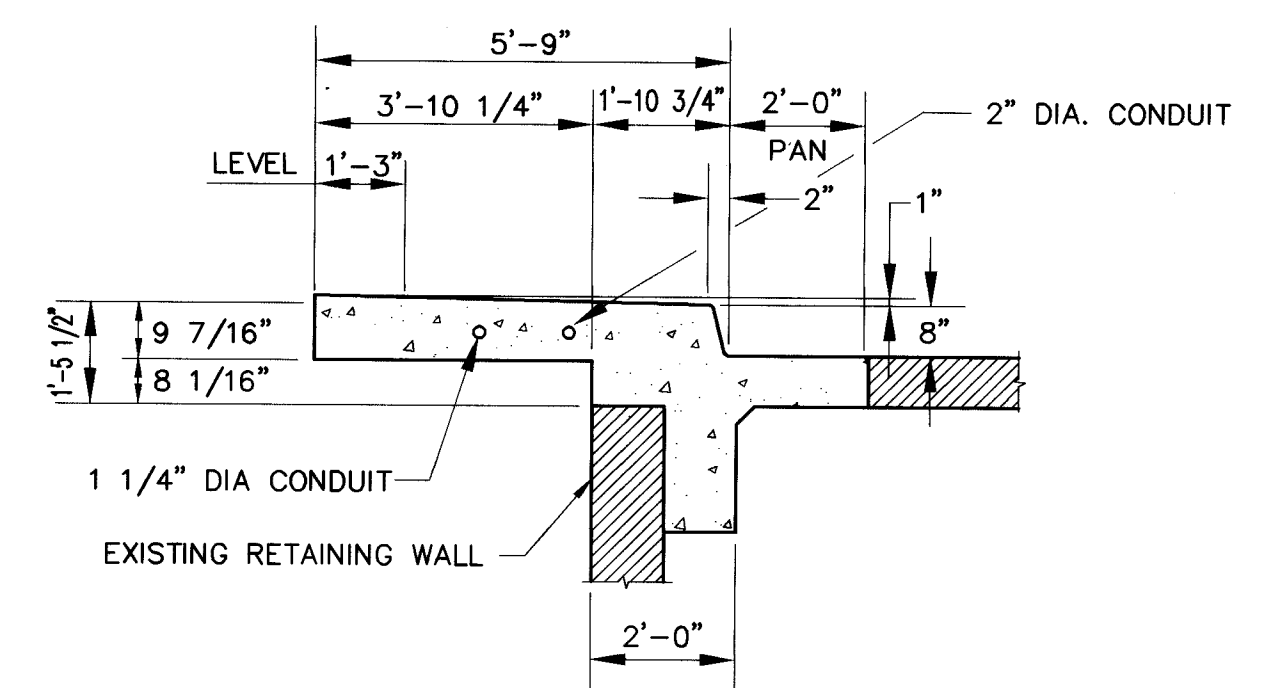


SECTION A-A (EXISTING)

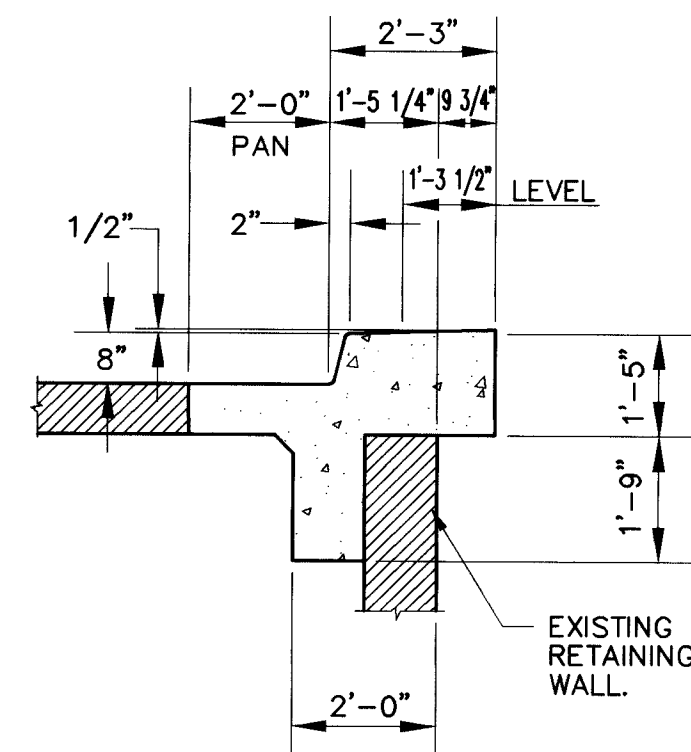


SECTION B-B (EXISTING)

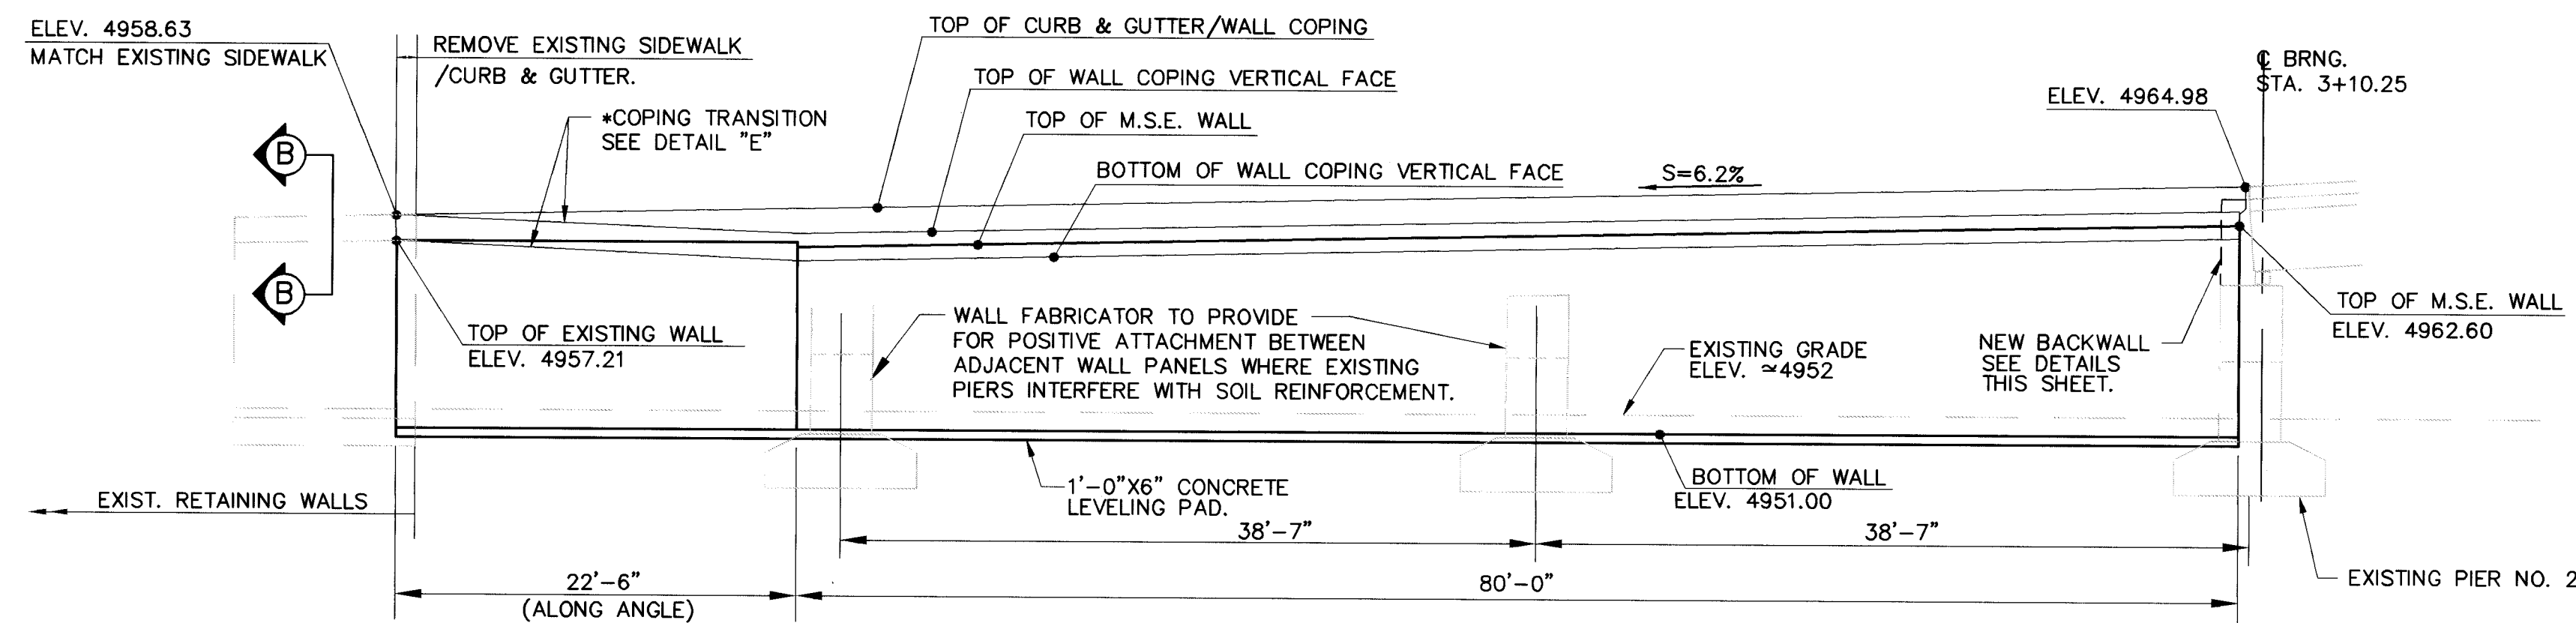


SOUTH WALL ELEVATION
SCALE: 1/8"=1'

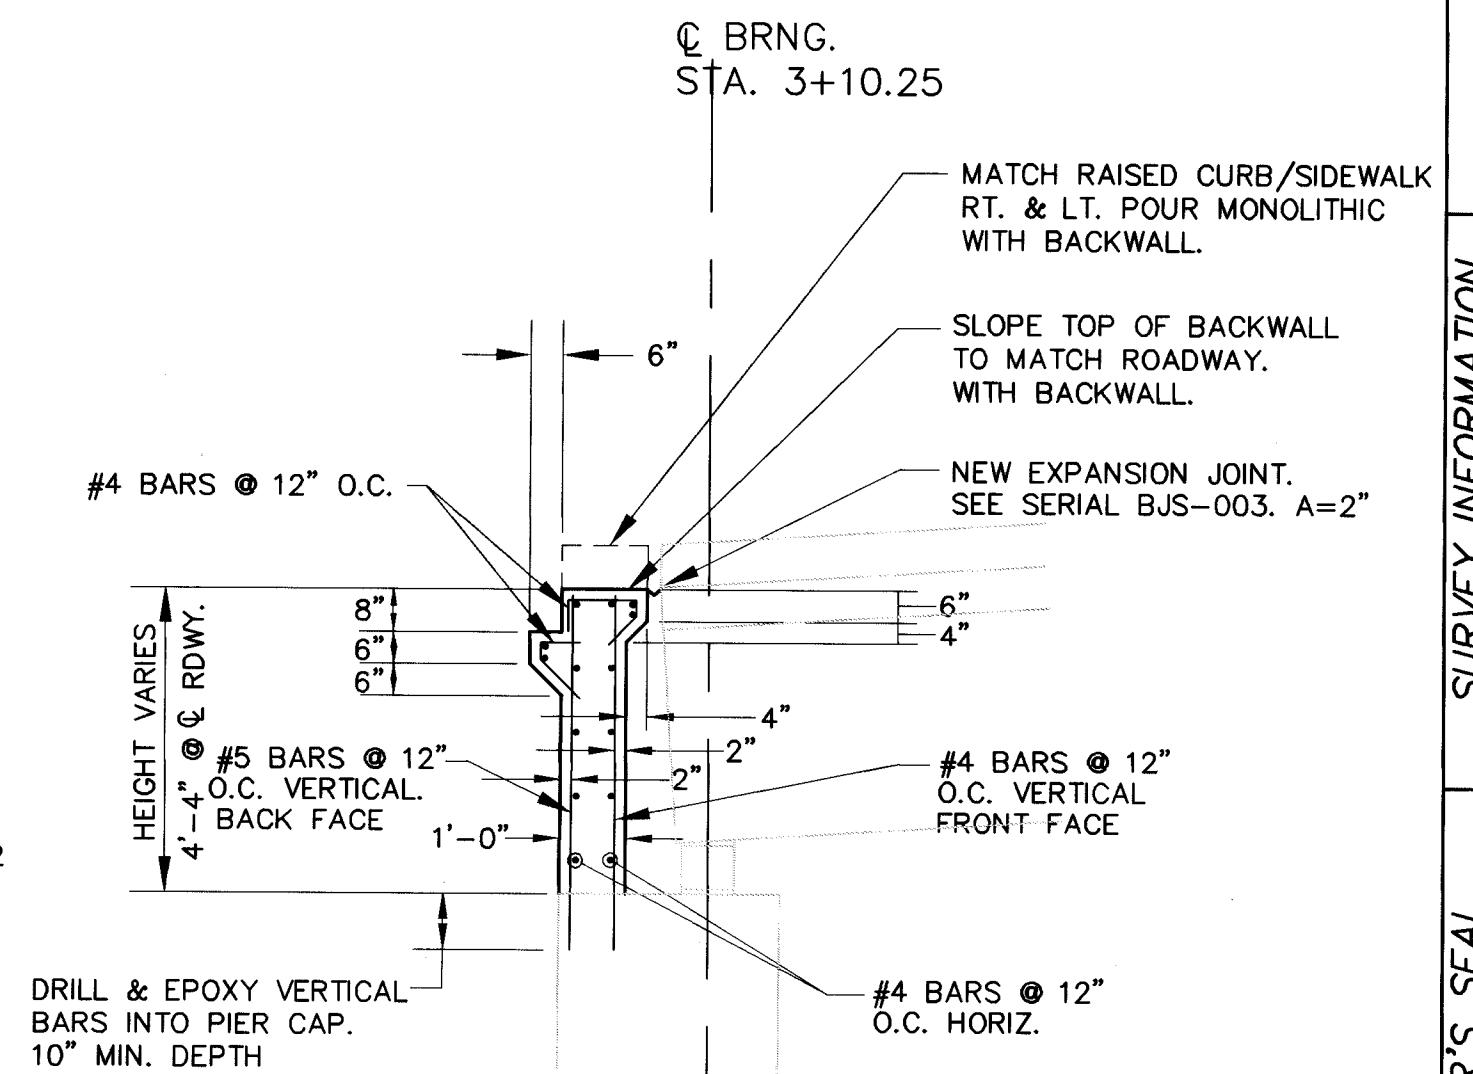


SECTION C-C (AT PIER NO. 2)
SCALE: 3/8"=1'

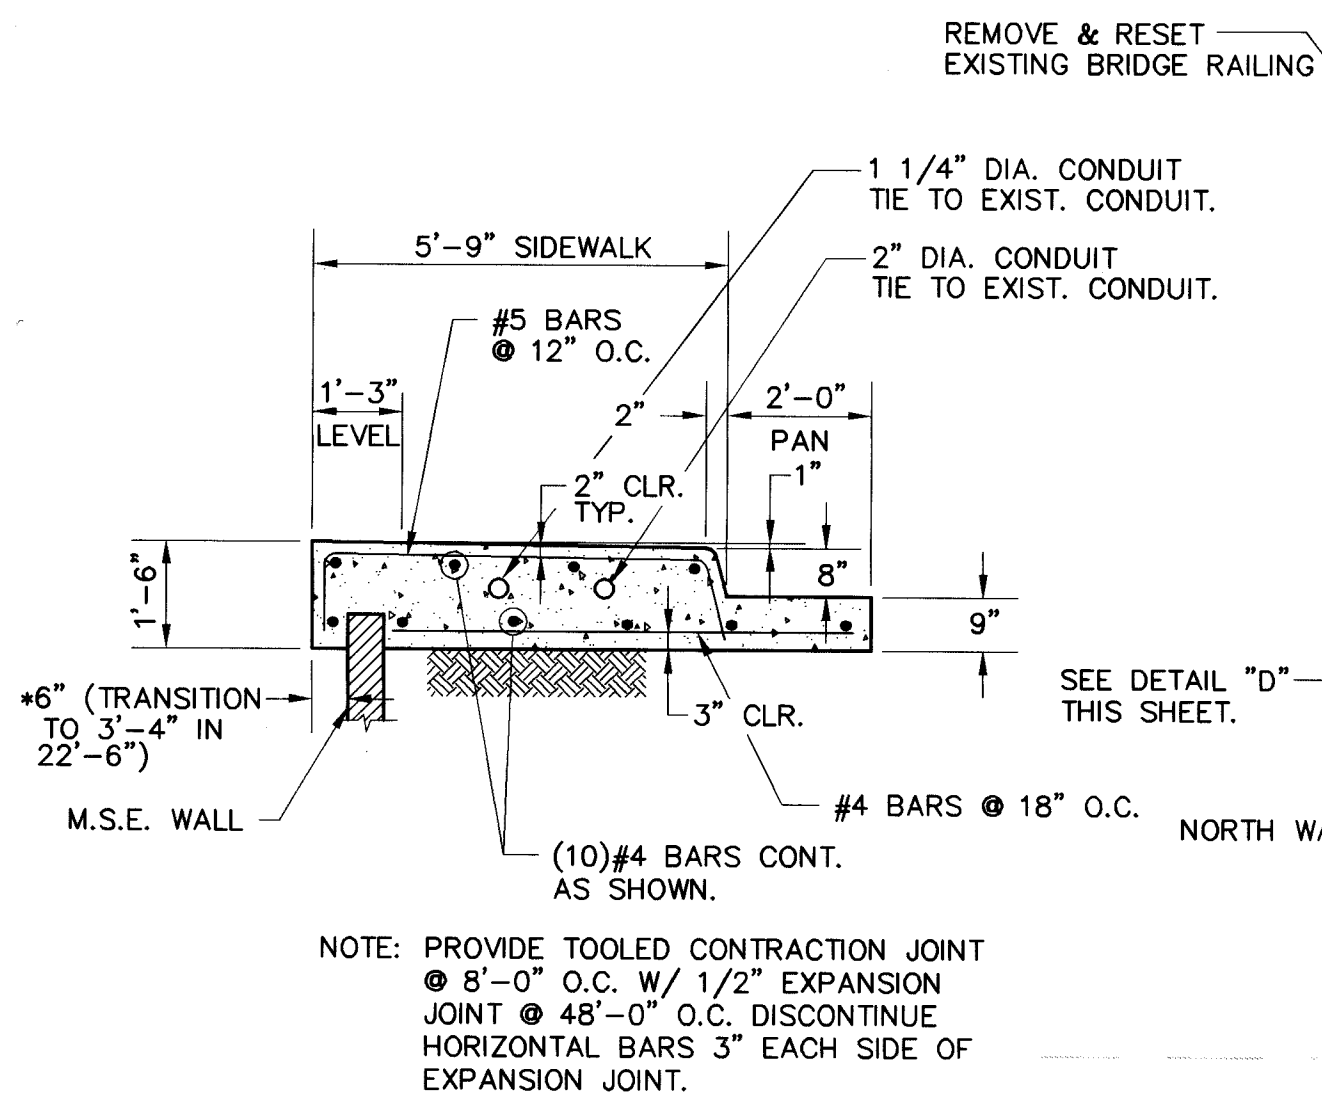

DETAIL "D" - (SIDEWALK/WALL COPING)

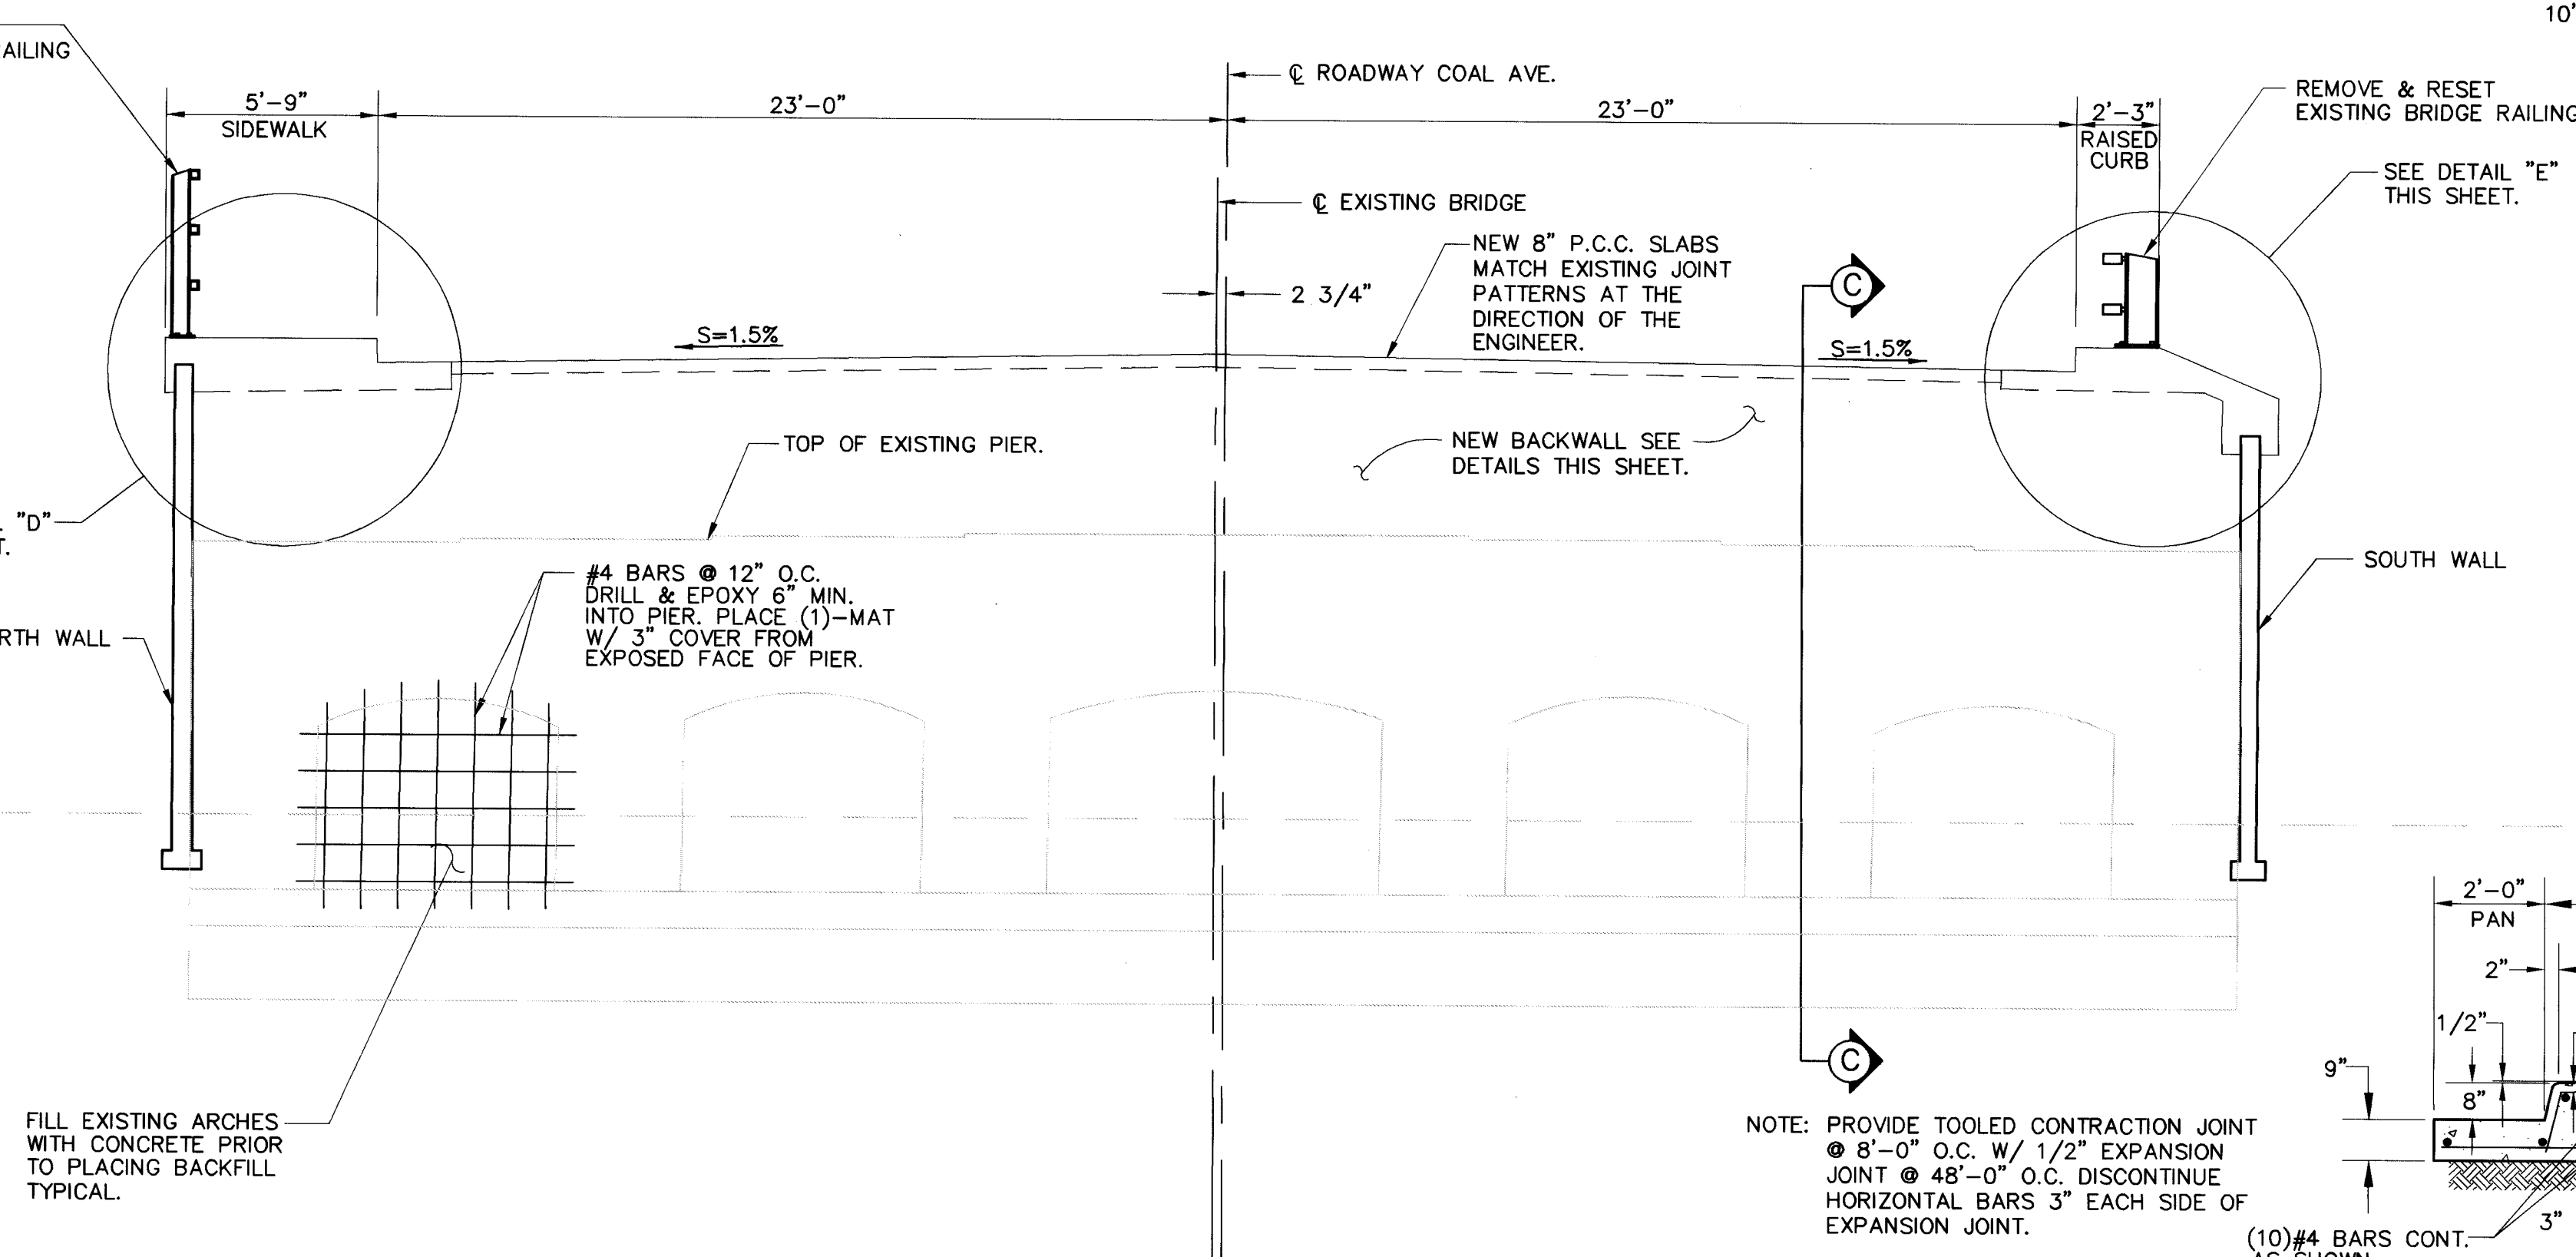

TYPICAL SECTION AT PIER NO. 2
SCALE: 1/4"=1' (LOOKING UPSTATION)

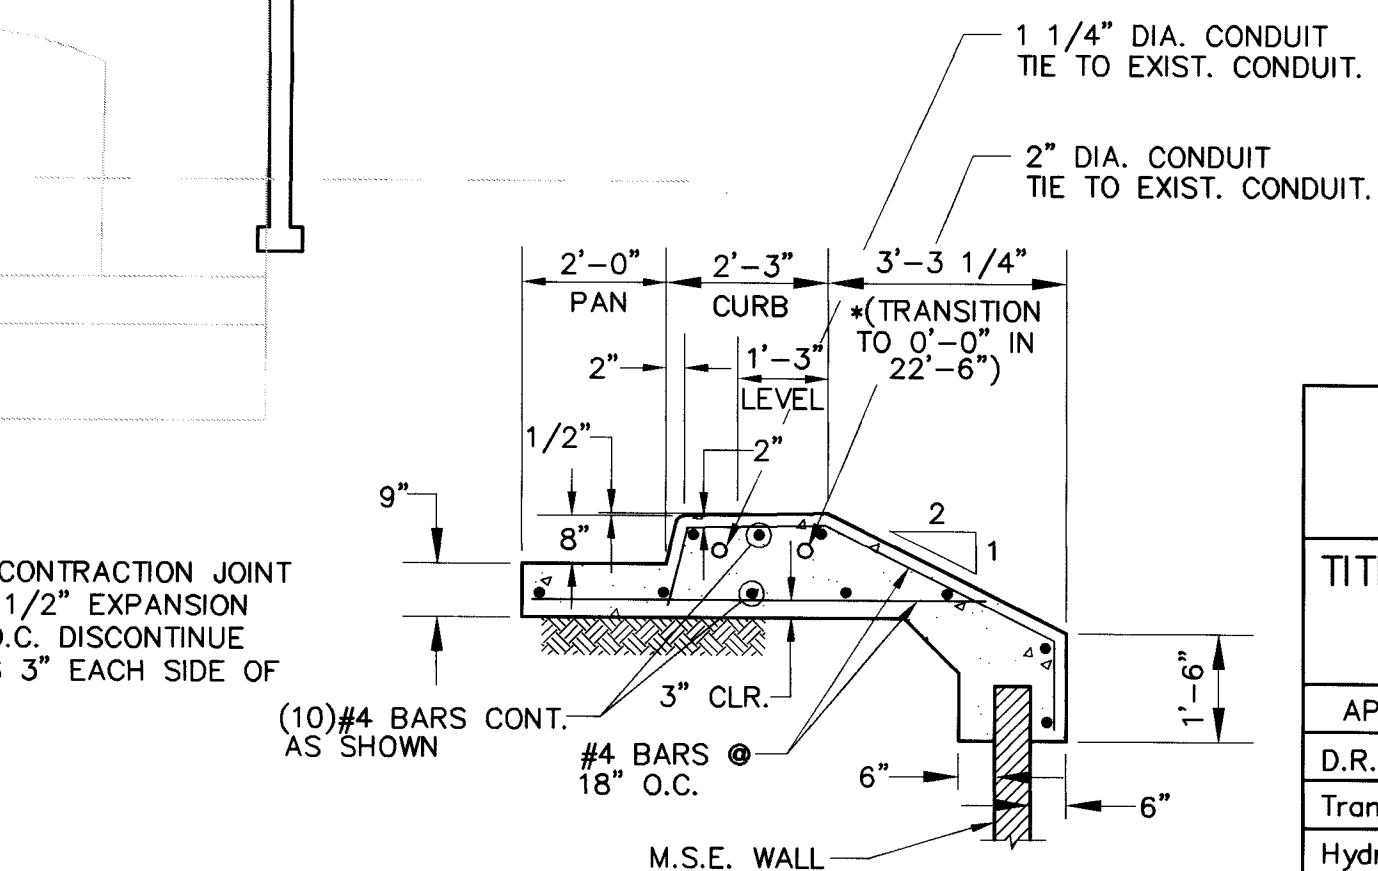


DETAIL "E" - (CURB & GUTTER/WALL COPING)

AVID ENGINEERING, INC.
Civil • Structural • Transportation
6100 Seagull St. NE - Suite 102
Albuquerque, NM 87109 - (505) 881-5357

CITY OF ALBUQUERQUE PUBLIC WORKS DEPARTMENT ENGINEERING GROUP					
TITLE: COAL AVENUE REHABILITATION M.S.E. WALL ELEVATIONS					
APPROVALS	ENGINEER	DATE	APPROVALS	ENGINEER	DATE
D.R.C. Chair			Water		
Transportation			Waste Water		
Hydrology					
PROJECT NO. 4018.91		MAP NO. K-14N		SHEET 2 OF 2	

AS BUILT INFORMATION		BENCH MARKS		SURVEY INFORMATION		ENGINEER'S SEAL	
CONTRACTOR	DATE	NO.	BY	NO.	BY	NO.	BY
WORK	DATE						
STAGED BY	DATE						
APPROVED BY	DATE						
FIELD	DATE						
ADJUSTMENT	DATE						
APPROVAL	DATE						
DESIGNED BY	DATE						
DRAWN BY	DATE						
CHECKED BY	DATE						
RECORDED BY	DATE						
NO.							

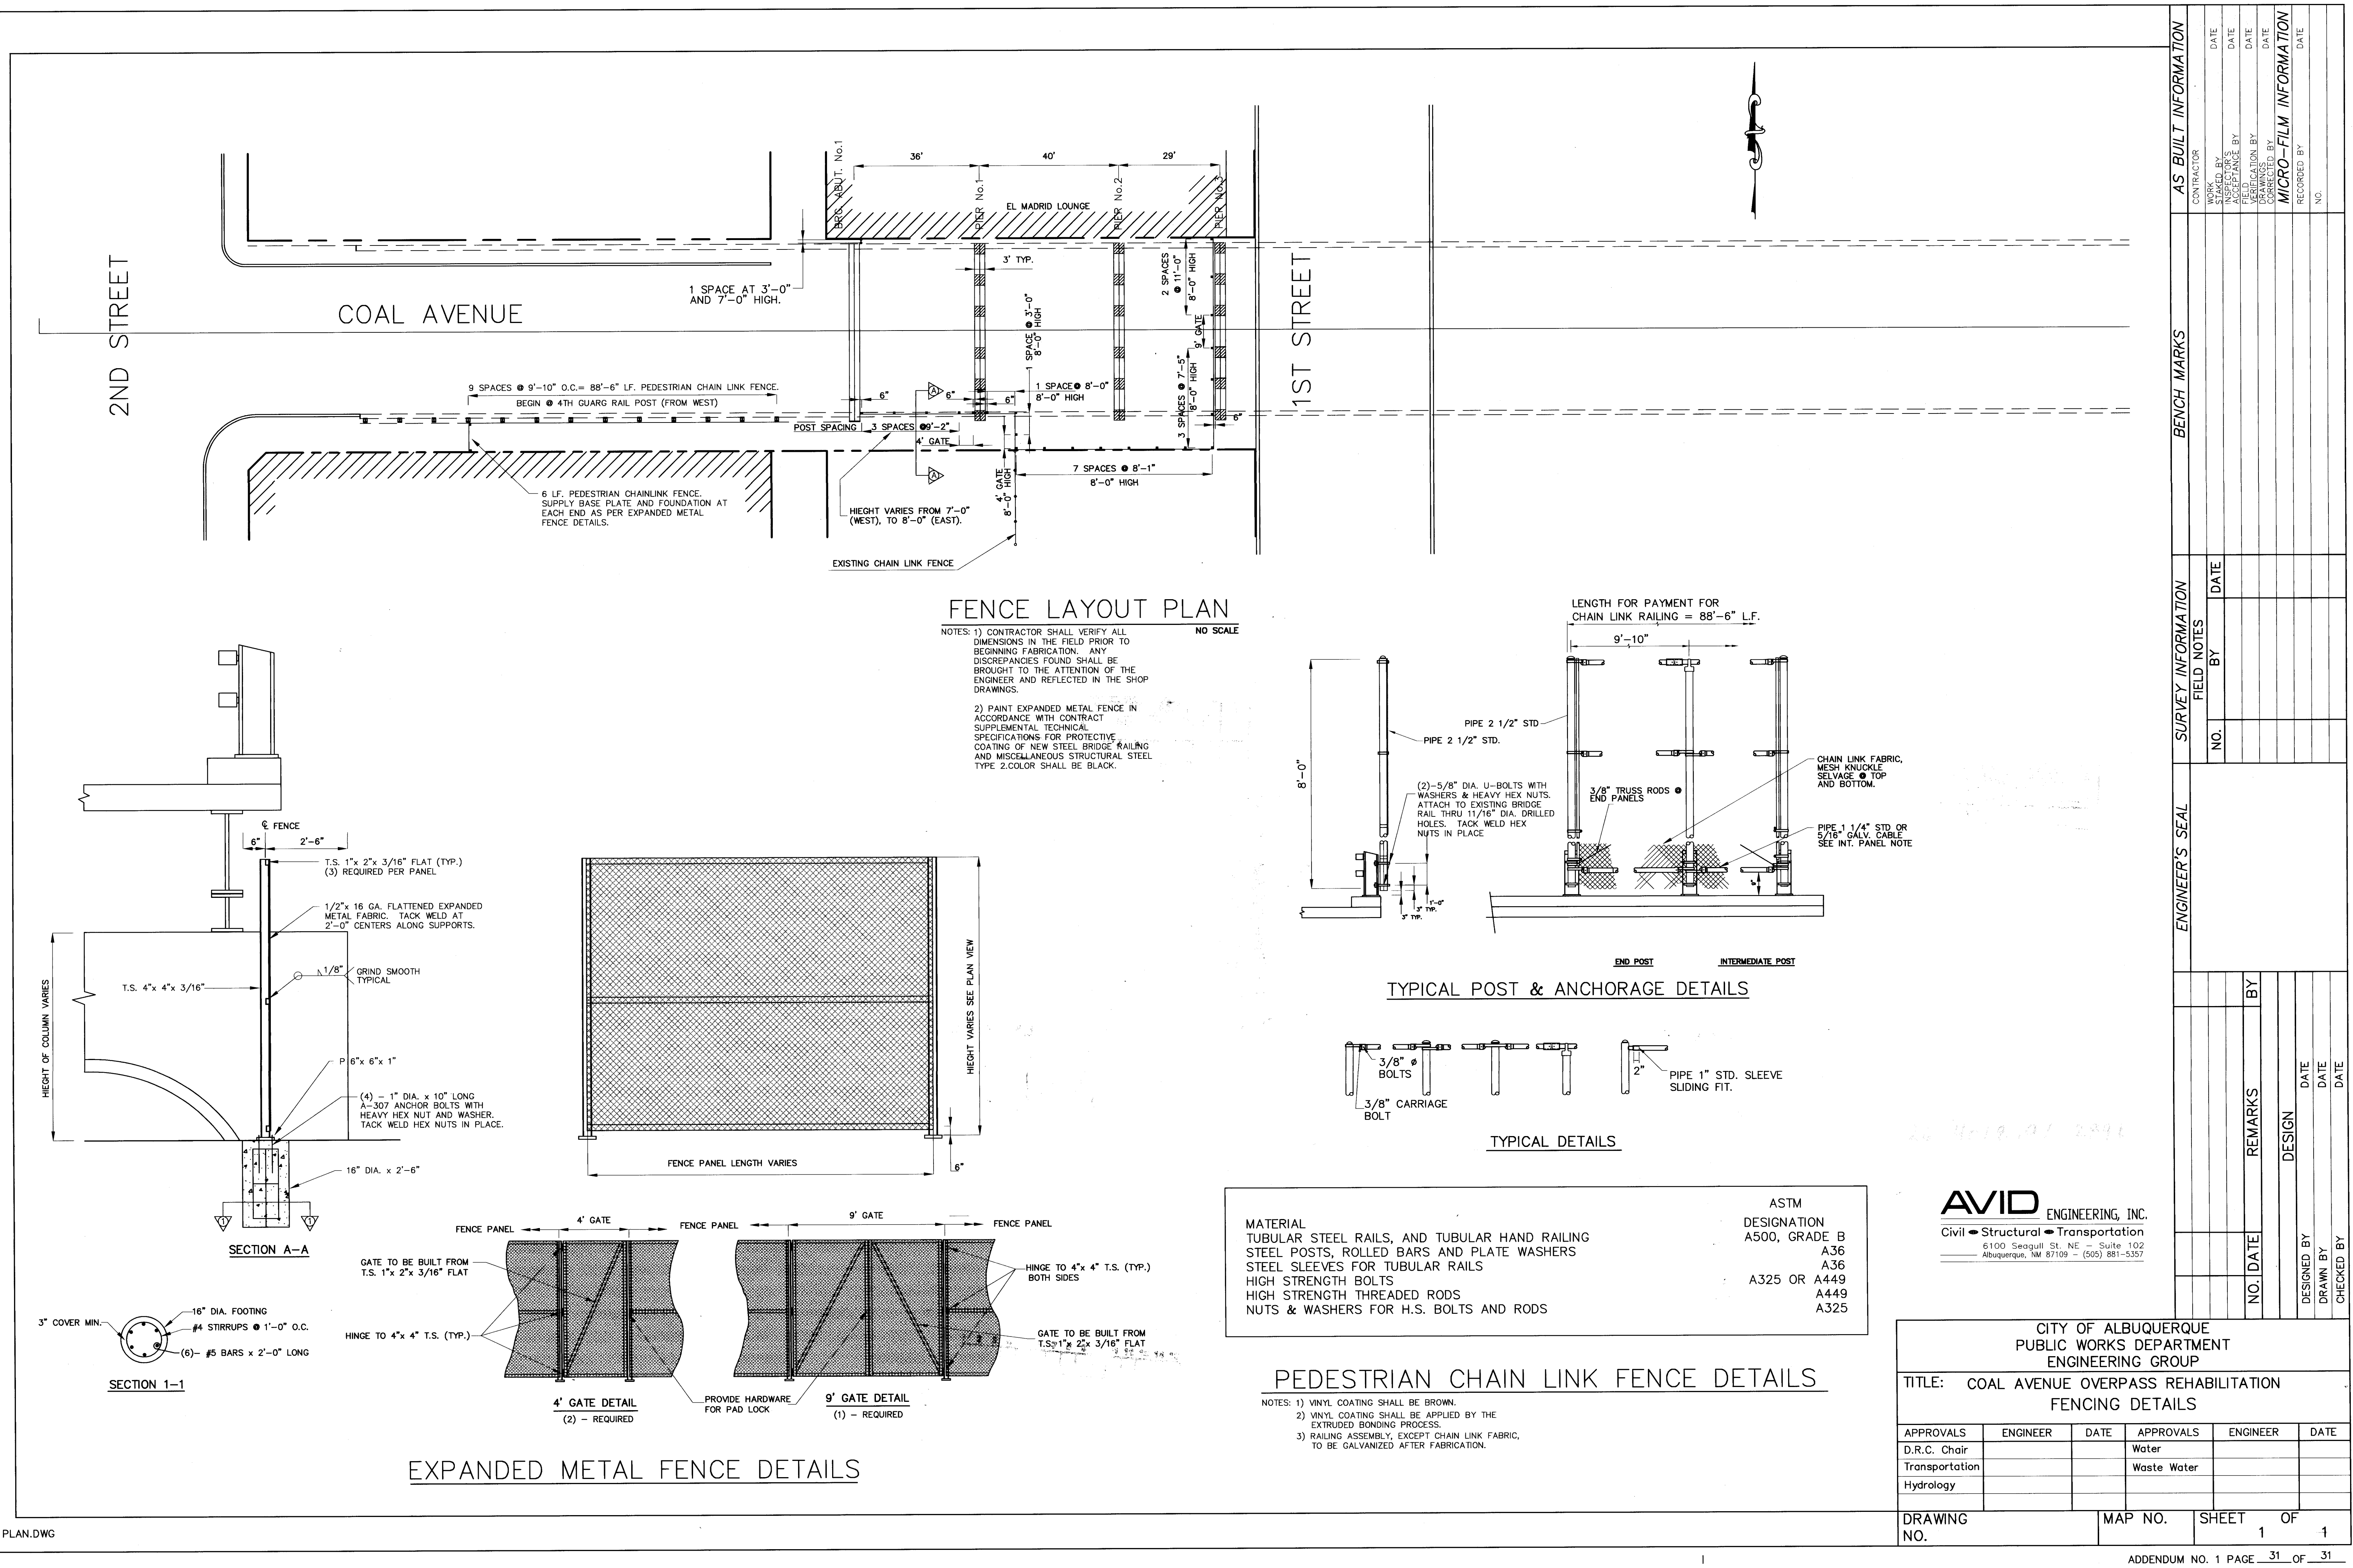

AS BUILT INFORMATION		BENCH MARKS		SURVEY INFORMATION		ENGINEER'S SEAL		REMARKS		DESIGN		DRAWN BY		CHECKED BY	
CONTRACTOR	WORK	NO.	DATE	NO.	DATE	NO.	DATE	NO.	DATE	NO.	DATE	NO.	DATE	NO.	DATE
	BY														
	INSPECTOR'S														
	ACCEPTANCE BY														
	DATE														
	VEGETATION BY														
	DATE														
	CRANES														
	OPERATED BY														
	DATE														
	MICRO-FILM INFORMATION														
	RECORDED BY														
	NO.														