


CITY OF ALBUQUERQUE
NEW MEXICO



DIP SECTION
CROSSING REPLACEMENT
TESUQUE DRIVE AT MARIPOSA ARROYO

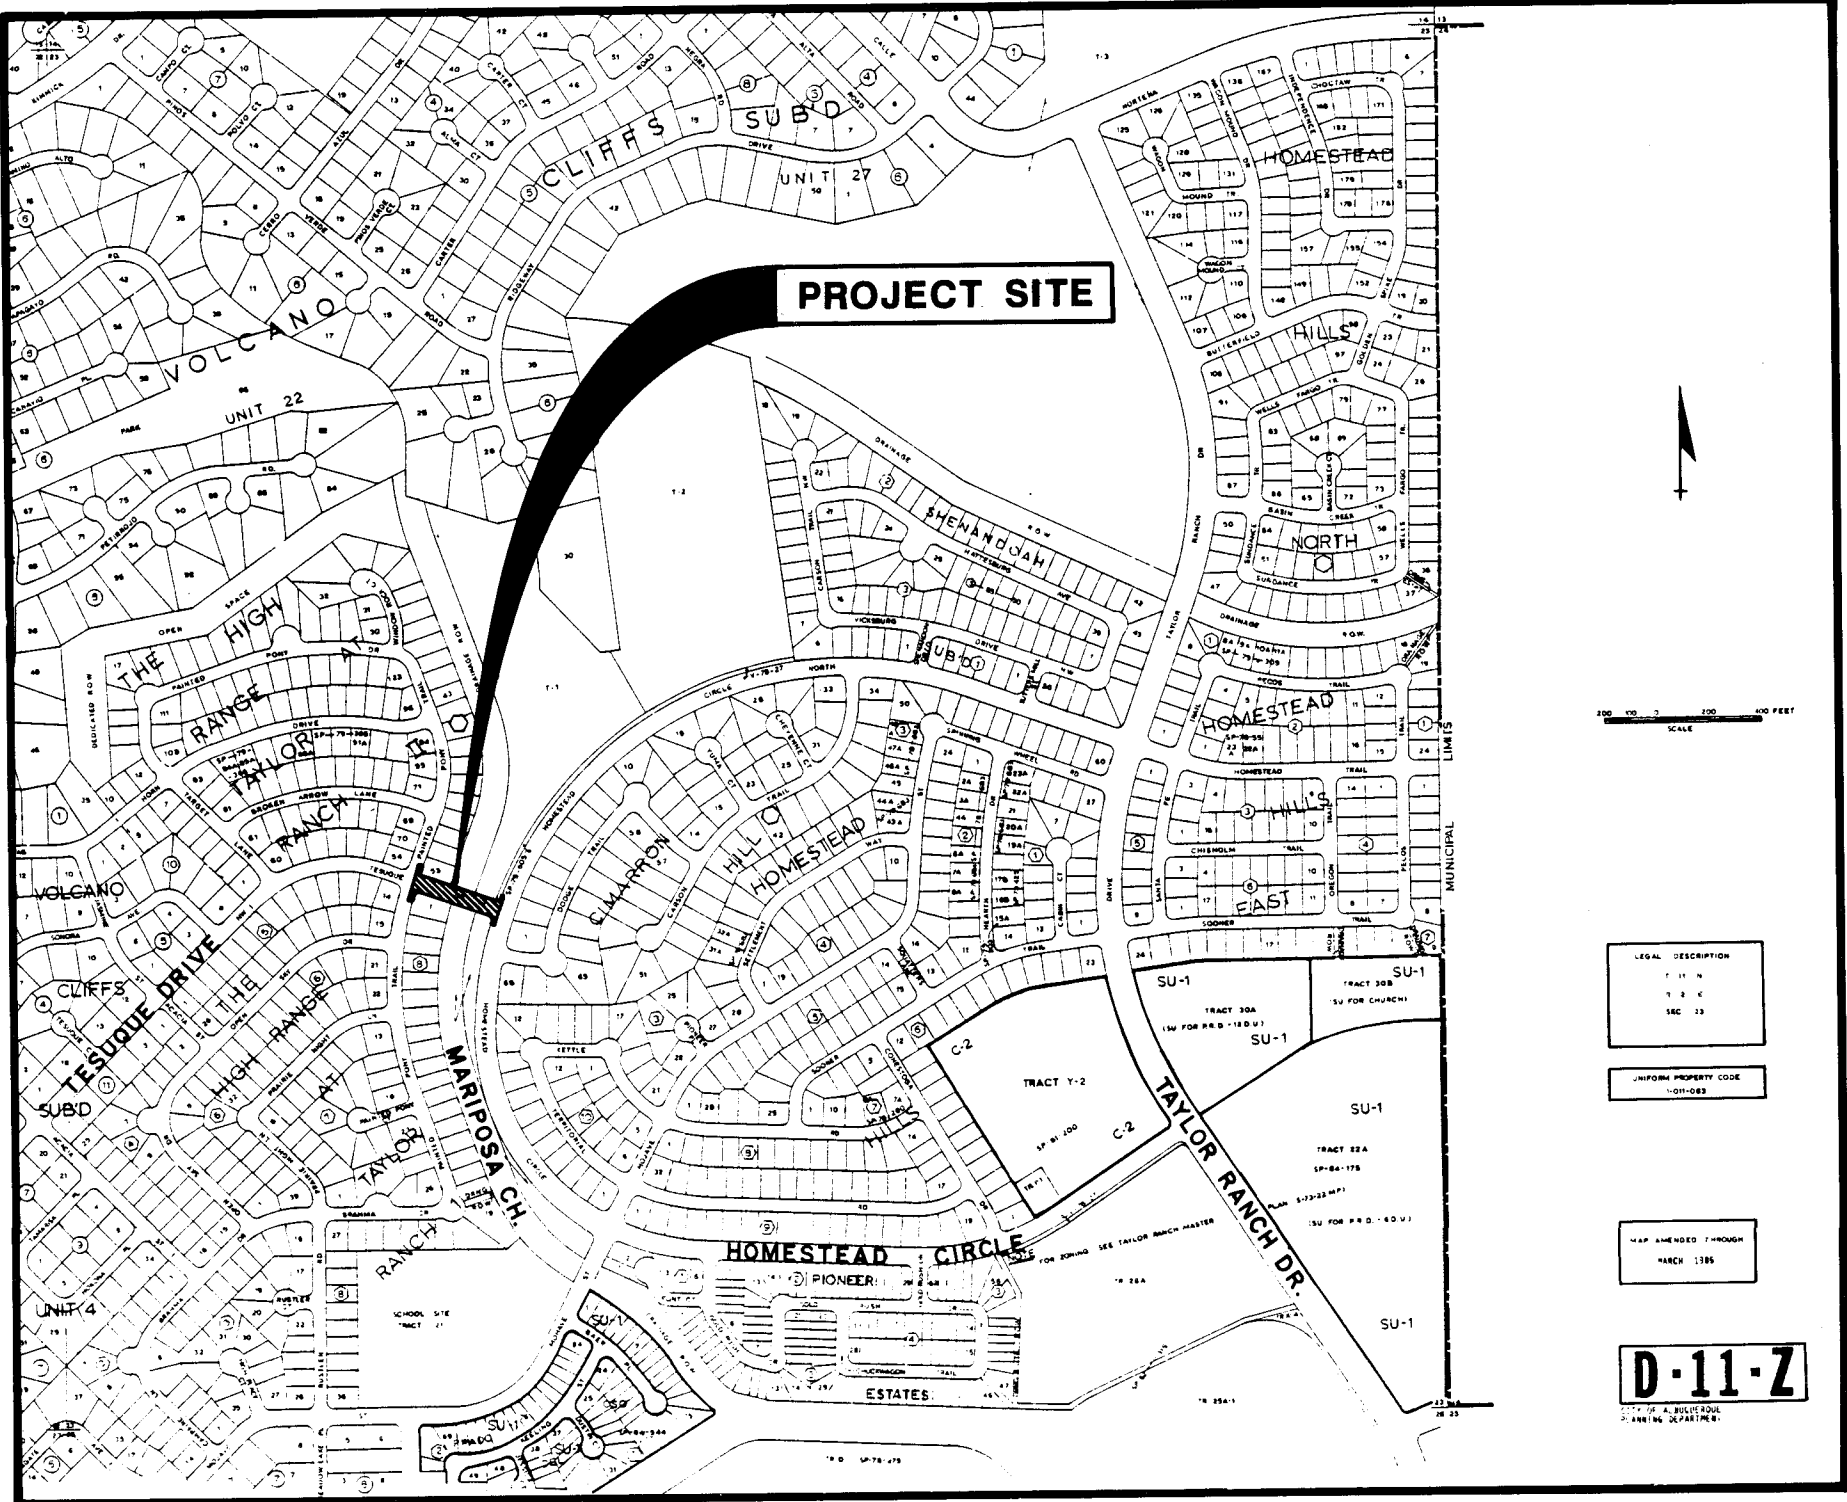

LOCATION MAP
ZONE ATLAS MAP D-11-Z

GENERAL NOTES

- ALL WORK DETAILED ON THESE PLANS, EXCEPT BRIDGE WORK, TO BE PERFORMED UNDER CONTRACT, UNLESS STATED OTHERWISE OR PROVIDED FOR HEREON. SHALL BE CONSTRUCTED IN ACCORDANCE WITH THE CITY OF ALBUQUERQUE STANDARD SPECIFICATIONS, PUBLIC WORKS CONSTRUCTION, 1986 (REFERRED TO HEREIN AS "STANDARD SPECIFICATIONS"). SEE SHEET 8 OF 18, GENERAL NOTES, FOR BRIDGE SPECIFICATIONS.
- CONTRACTOR WILL BE ALLOWED TO CLOSE TESUQUE DRIVE AT PAINTED PONY TRAIL AND AT HOMESTEAD CIRCLE UPON DEVELOPING AN APPROVED TRAFFIC CONTROL PLAN THAT INCLUDES A DETOUR WITH APPROPRIATE SIGNING. THIS PLAN IS TO BE APPROVED BY THE CONSTRUCTION COORDINATOR.
- CONTRACTOR SHALL COORDINATE WITH THE WATER SYSTEMS DIVISION THREE (3) WORKING DAYS PRIOR TO INITIATING ANY WORK AFFECTING EXISTING PUBLIC WATER UTILITIES.
- TWO (2) WORKING DAYS PRIOR TO ANY EXCAVATION, CONTRACTOR MUST CONTACT NEW MEXICO ONE-CALL SYSTEM, (505)269-1990, FOR LOCATION OF EXISTING UTILITIES. THE LOCATION OF EXISTING UNDERGROUND UTILITIES ARE SHOWN IN AN APPROXIMATE WAY ONLY. IT IS CONTRACTOR'S RESPONSIBILITY TO CONTACT THE LINE LOCATING SERVICE FOR EXACT LINE LOCATION.
- PRIOR TO CONSTRUCTION, THE CONTRACTOR SHALL EXCAVATE AND VERIFY THE HORIZONTAL AND VERTICAL LOCATIONS OF ALL POTENTIAL OBSTRUCTIONS. SHOULD A CONFLICT EXIST, THE CONTRACTOR SHALL NOTIFY THE ENGINEER SO THAT THE CONFLICT CAN BE RESOLVED WITH A MINIMUM DELAY.
- ALL GAS, ELECTRIC, TELEPHONE LINES, CABLE, AND APPURTENANCES ENCOUNTERED DURING CONSTRUCTION THAT REQUIRE RELOCATION, SHALL BE RELOCATED BY THE RESPONSIBLE UTILITY COMPANY. CONTRACTOR SHALL BE RESPONSIBLE FOR COORDINATION OF ALL NECESSARY UTILITY ADJUSTMENTS.
- IT WILL BE THE CONTRACTOR'S RESPONSIBILITY TO PROTECT AND MAINTAIN IN SERVICE ALL EXISTING UTILITIES.
- BACKFILL COMPACTION IN STREET AREAS SHALL BE ACCORDING TO SPECIFIED STREET USE.
- ALL TRENCH BACKFILL OUTSIDE OF STREET AREAS SHALL BE COMPACTED TO A MINIMUM OF 90% MAXIMUM DENSITY AS DETERMINED BY ASTM D-1557.
- WHEN ABUTTING NEW PAVEMENT TO EXISTING, SAWCUT EXISTING PAVEMENT TO A STRAIGHT EDGE AND AT A RIGHT ANGLE, OR AS APPROVED BY THE PROJECT ENGINEER, TO REMOVE ANY BROKEN OR CRACKED PAVEMENT.
- TACK COAT REQUIREMENTS SHALL BE DETERMINED BY THE PROJECT ENGINEER.
- SIDEWALKS AND WHEELCHAIR RAMPS SHALL BE CONSTRUCTED WITHIN THE CURB RETURNS WHEREVER A NEW CURB RETURN IS CONSTRUCTED FOR ALL DRIVES INTERSECTING PUBLIC RIGHT-OF-WAY.

INDEX OF SHEETS

SHEET NO.	DESCRIPTION
1)	COVER SHEET
2)	TYPICAL CHANNEL SECTIONS
3)	TYPICAL ROADWAY SECTIONS
4)	MARIPOSA CHANNEL PLAN & PROFILE
5)	TESUQUE DRIVE PLAN & PROFILE
6)	STORM DRAIN PLAN & PROFILE
7)	TESUQUE DRIVE UTILITY RELOCATIONS
8)	BRIDGE GENERAL NOTES & ESTIMATED QUANTITIES
9)	BRIDGE PLAN & PROFILE
10)	TYPICAL BRIDGE SECTIONS
11)	CONCRETE BRIDGE DECK DETAILS
12)	SUPERSTRUCTURE BEAM DETAILS
13)	ABUTMENT & WINGWALL DETAILS
14)	PIER DETAILS
15)	UPSTREAM CHANNEL HEADWALL DETAILS
16) - 18)	IMPACT STILLING BASIN DETAILS
	ROADWAY CROSS SECTIONS


I HEREBY CERTIFY THAT THIS PROJECT WAS CONSTRUCTED IN GENERAL CONFORMANCE WITH THE PLANS AND SPECIFICATIONS SHOWN HEREON AND THAT THESE DRAWINGS HAVE BEEN REVISED IN ACCORDANCE WITH INFORMATION PROVIDED BY THE CITY OF ALBUQUERQUE PUBLIC WORKS DEPARTMENT.

James V. Domenick
JAMES V. DOMENICK, P.E. No. 7643
6/10/91
DATE

GENERAL NOTES CONT.

- IF CURB IS DEPRESSED FOR A DRIVE PAD OR A HANDICAP RAMP, THE DRIVE PAD OR RAMP SHALL BE CONSTRUCTED PRIOR TO ACCEPTANCE OF THE CURB AND GUTTER.
- ALL WORK ON THIS PROJECT SHALL BE PERFORMED IN ACCORDANCE WITH APPLICABLE FEDERAL, STATE, AND LOCAL LAWS, RULES, AND REGULATIONS CONCERNING CONSTRUCTION SAFETY AND HEALTH.
- CONTRACTOR SHALL MAINTAIN ACCESS TO ADJACENT PROPERTIES DURING CONSTRUCTION.
- THE CONTRACTOR WILL BE REQUIRED TO CONFINE HIS WORK WITHIN THE CONSTRUCTION LIMITS AND/OR PUBLIC RIGHT-OF-WAY TO PRESERVE EXISTING VEGETATION AND PRIVATE PROPERTY. OVERNIGHT PARKING OF CONSTRUCTION EQUIPMENT SHALL NOT OBSTRUCT DRIVEWAYS OR DESIGNATED TRAFFIC LANES.
- A DISPOSAL SITE FOR ALL EXCESS EXCAVATED MATERIAL, ASPHALTIC PAVING, CONCRETE CURBS AND SIDEWALKS, ETC., SHALL BE OBTAINED BY THE CONTRACTOR IN COMPLIANCE WITH APPLICABLE ENVIRONMENTAL REGULATIONS AND APPROVED BY THE PROJECT ENGINEER. ALL COSTS INCURRED IN OBTAINING A DISPOSAL SITE AND HAUL THERETO SHALL BE CONSIDERED INCIDENTAL TO THE PROJECT AND NO SEPARATE MEASUREMENT OR PAYMENT SHALL BE MADE.


SEE SHEET 2 FOR CONTINUATION OF GENERAL NOTES.

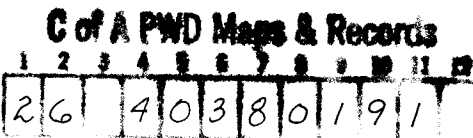

SCANNED BY
BY LASON

REV.	SHEETS	CITY ENGINEER	DATE	USER	DEPT.	DATE	USER	DEPT.	DATE
APPROVAL OF REVISIONS									

PLANS PREPARED UNDER DIRECTION OF: <i>James V. Domenick</i>	AVID ENGINEERING, INC. Civil • Structural • Transportation 6100 Seagull Street NE • Suite 102 Albuquerque, NM 87109 • (505) 881-5357	APPROVED FOR CONSTRUCTION <i>Russell B. Underhill</i> CITY ENGINEER
DATE: 10/23/90	PROJECT NO. 4038	SHEET 1 OF 18

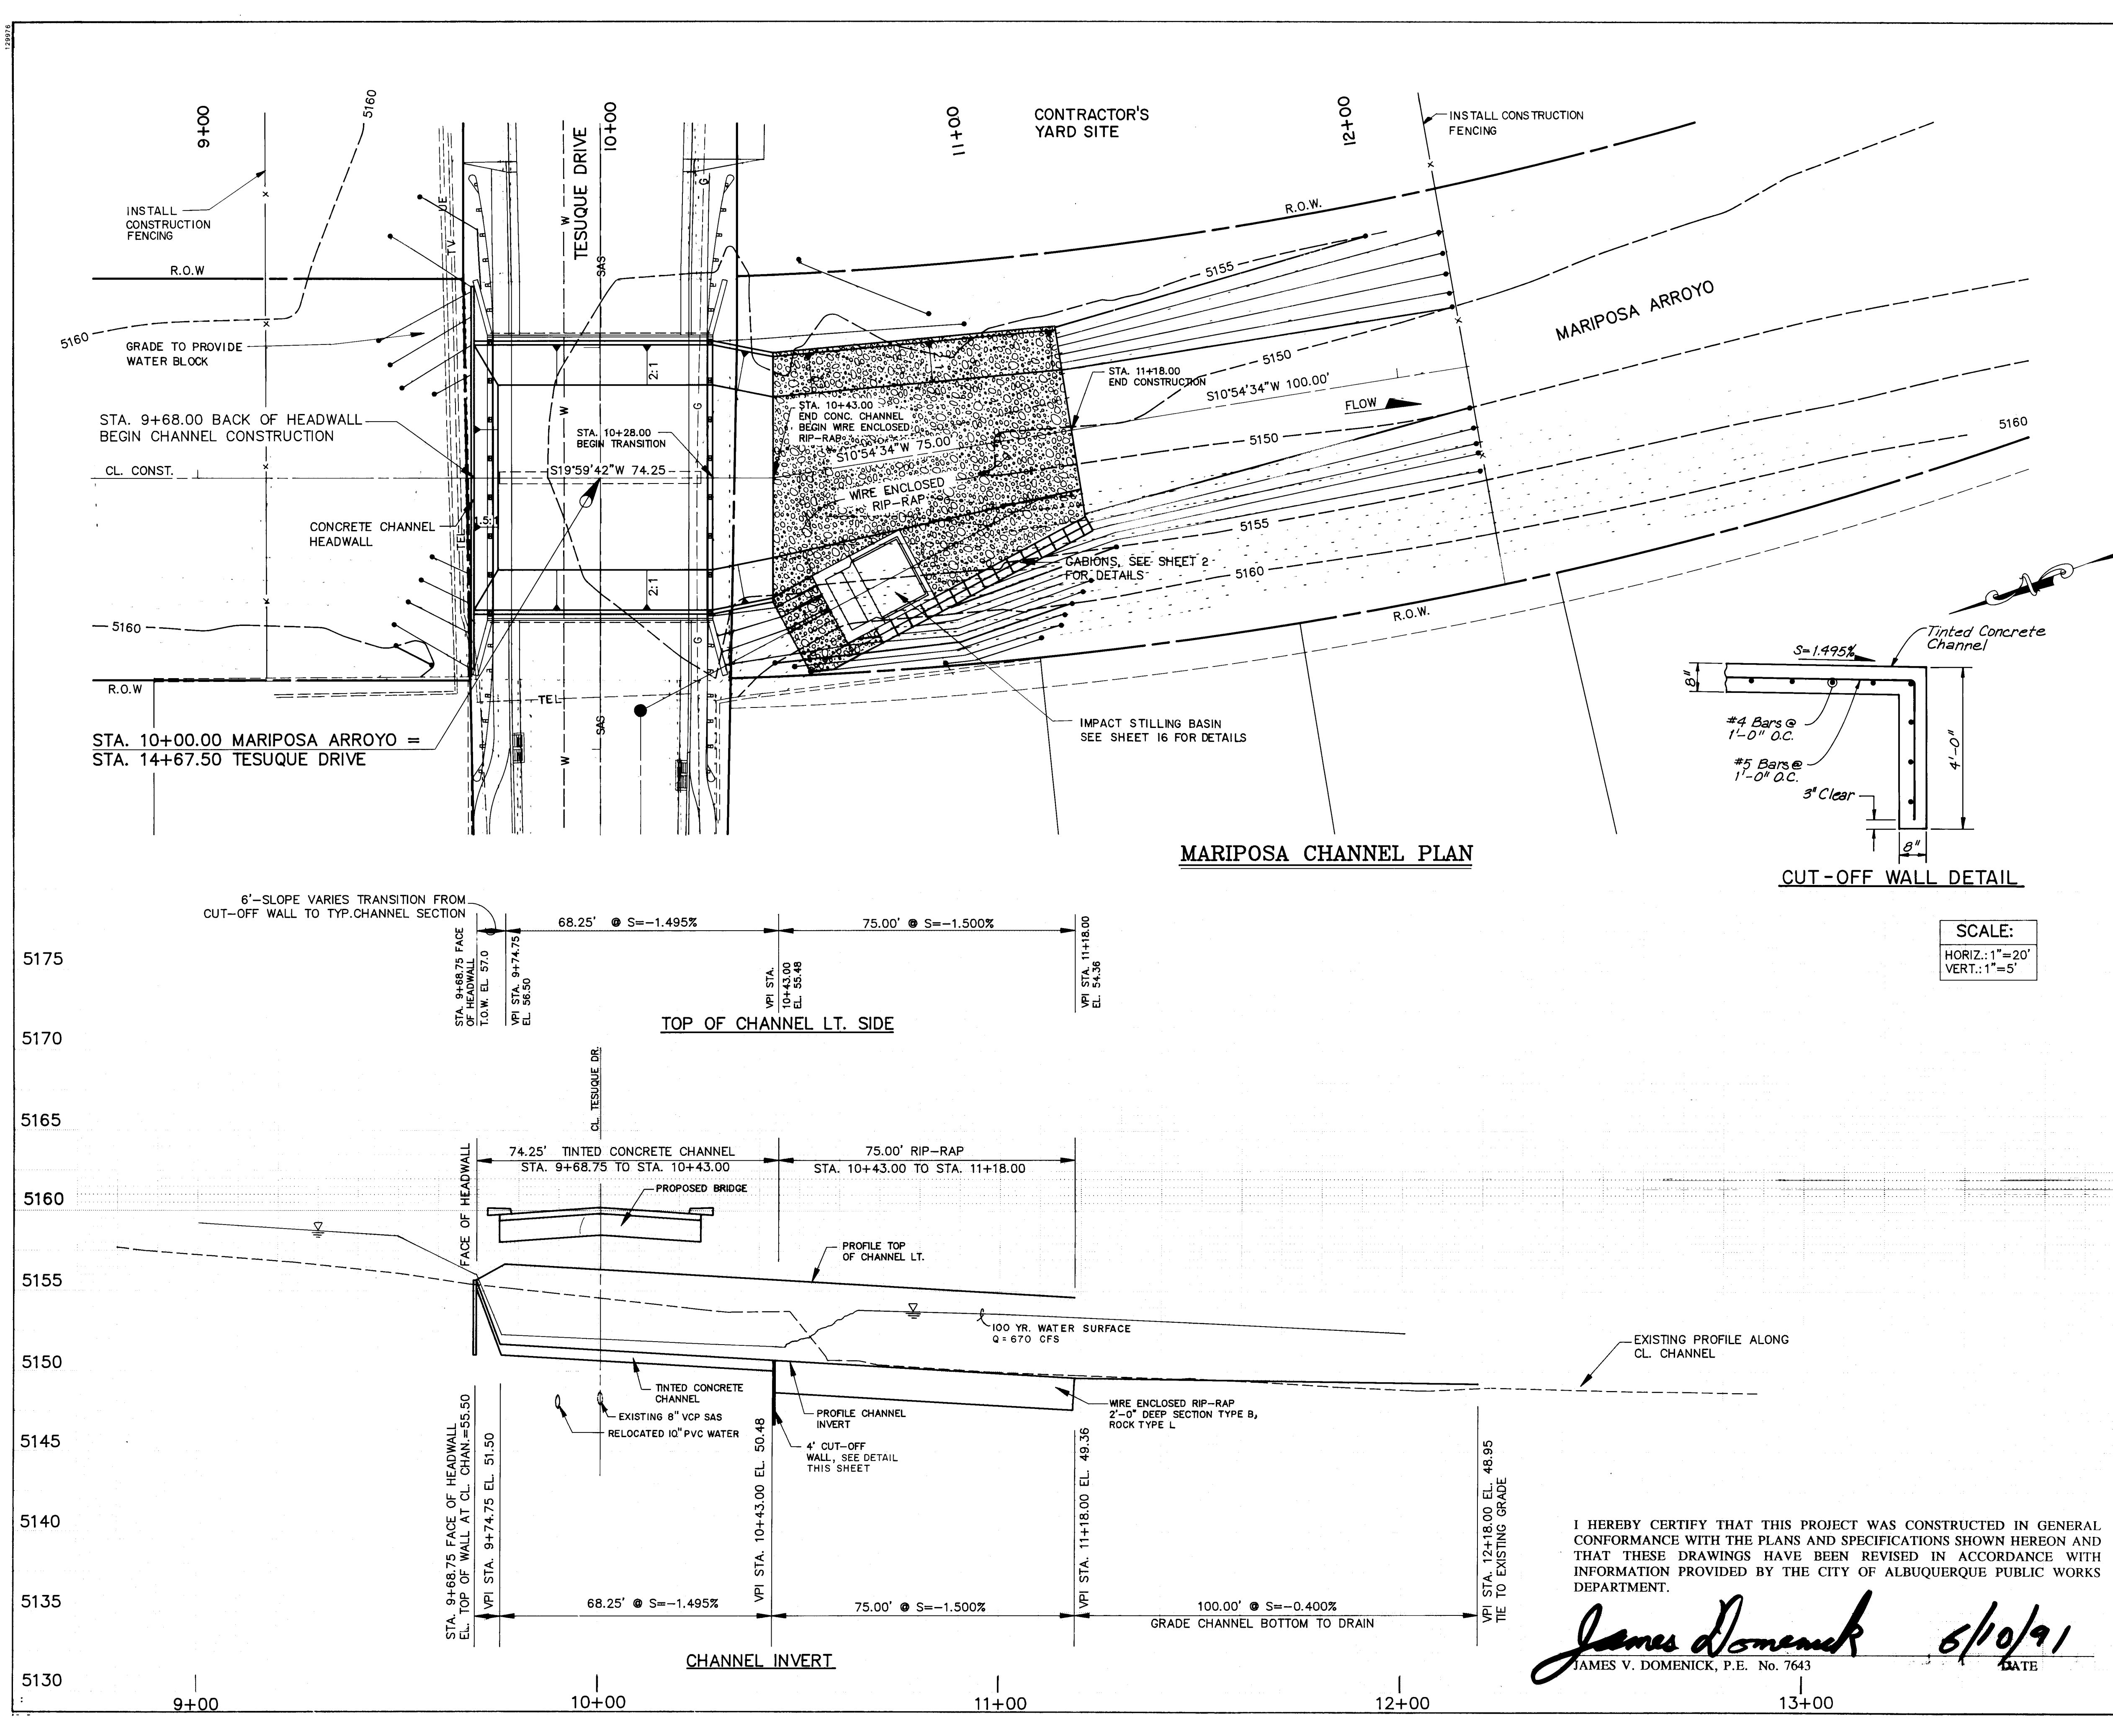


MARIPOSA CHANNEL PLAN

CUT-OFF WALL DETAIL

I HEREBY CERTIFY THAT THIS PROJECT WAS CONSTRUCTED IN GENERAL CONFORMANCE WITH THE PLANS AND SPECIFICATIONS SHOWN HEREON AND THAT THESE DRAWINGS HAVE BEEN REVISED IN ACCORDANCE WITH INFORMATION PROVIDED BY THE CITY OF ALBUQUERQUE PUBLIC WORKS DEPARTMENT.

James V. Domenick 6/10/91
JAMES V. DOMENICK, P.E. No. 7643 DATE

AS BUILT INFORMATION		BENCH MARKS		SURVEY INFORMATION		ENGINEER'S SEAL	
MOORE & CONRAD CONTR.		ACS BRASS CAP "4-D-11", LOCATED APPX. 700' SOUTH WEST OF RADIUS POINT OF CUL-DE-SAC AT END OF RIDGEWAY DR. STA. IS A 3/4" ALUM. CAP SET FLUSH IN LAVA OUTCROP STAMPED "4-D-11, 1986". TRIG. EL. 5261.00		FIELD NOTES BY: NC DATE: 7/90 EAST. CONDITIONS SURVEY BY HUGG SURVEYING INC.		<i>James V. Domenick</i> 10/23/90	
DATE: 5/91		DATE: 5/91		DATE: 5/91		DATE: 5/91	
DRAWING NO. 4038		MAP NO. D-11		SHEET 4 OF 18		REVISIONS	
APPROVALS		ENGINEER		DATE		APPROVALS	
D.R.C. Chair		<i>R. Kane</i>		11-1-90		Water	
Trans. Dev		<i>R. Kane</i>		10-19-90		Waste Water	
Hydrology		<i>R. Kane</i>		10-01-90		Parks & Rec.	
DESIGNED BY: JVD		DRAWN BY: RB		CHECKED BY: JVD		DATE: 7/90	
CITY OF ALBUQUERQUE PUBLIC WORKS DEPARTMENT ENGINEERING GROUP		TITLE: TESUQUE DRIVE AT MARIPOSA ARROYO MARIPOSA CHANNEL PLAN & PROFILE		DATE: 7/90		DATE: 9/90	

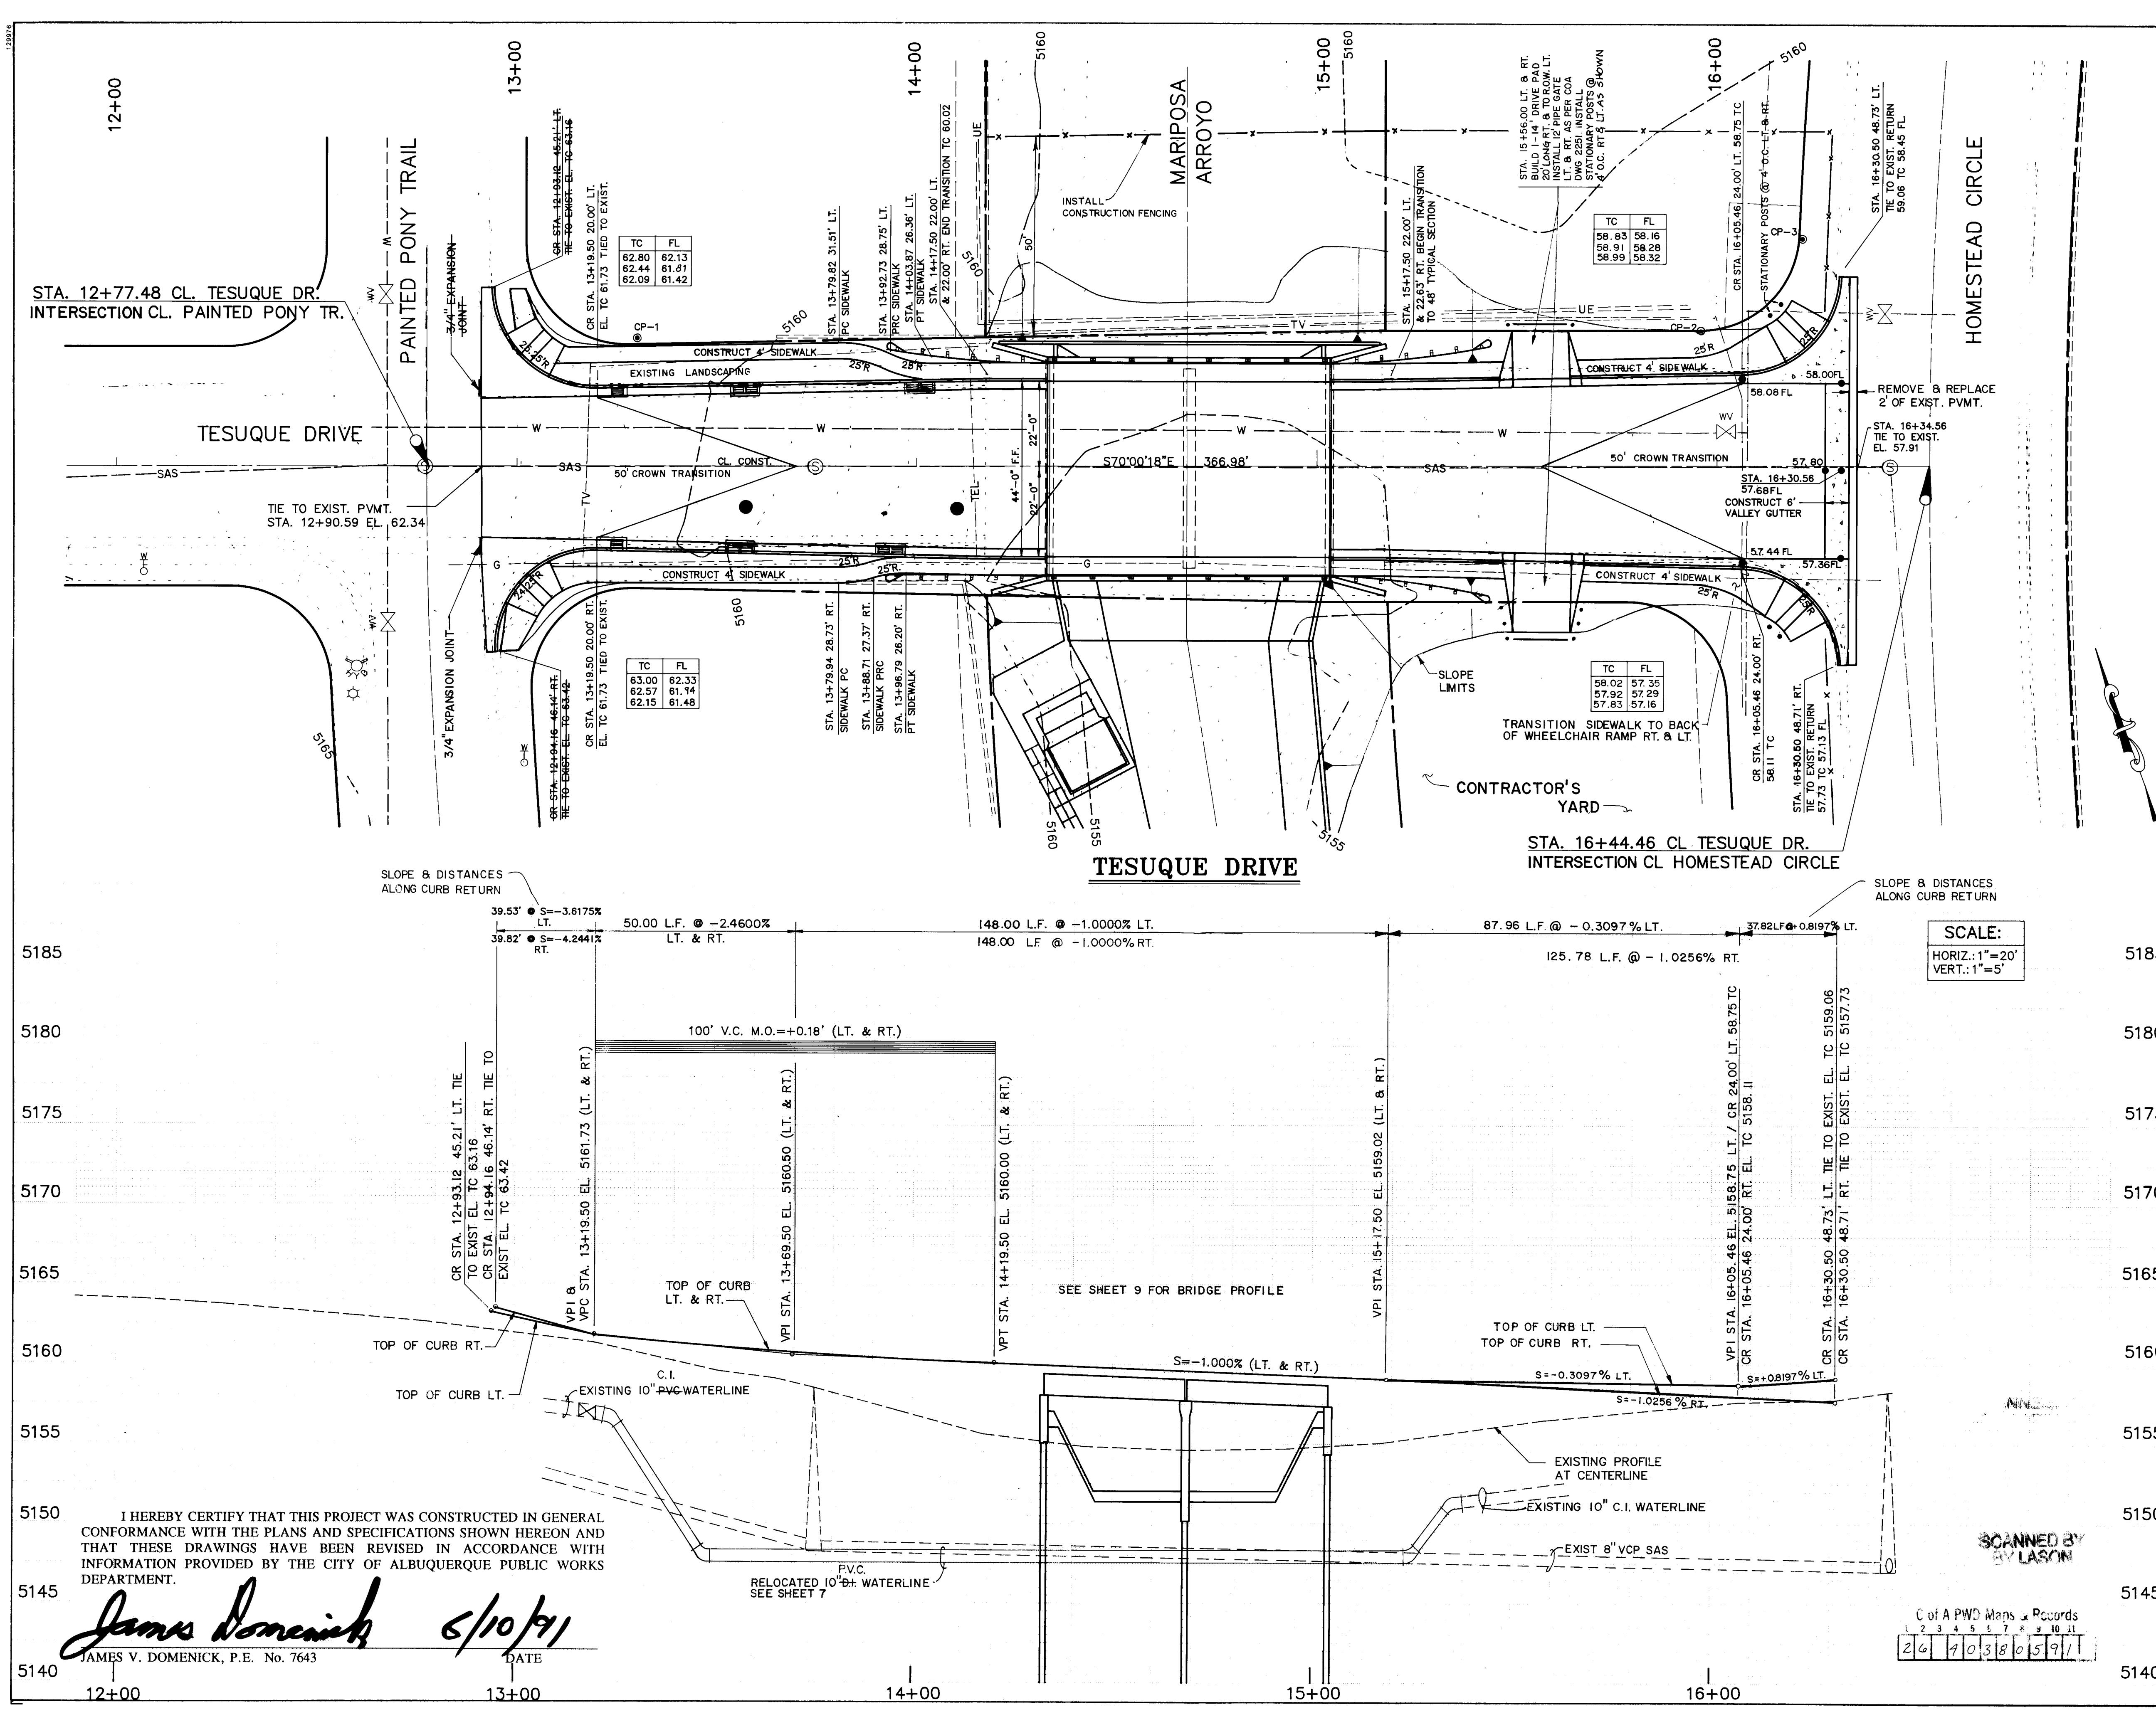

LEGEND

INDEX CONTOUR

INTERMEDIATE CONTOUR

RIGHT-OF-WAY LINE

EXISTING UTILITY EASEMENT LINE

EXISTING CURB & GUTTER

EXISTING RETAINING WALL

EXISTING SAS MANHOLE

EXISTING GATE VALVE

EXISTING FIRE HYDRANT

EXISTING WATER METER

EXISTING LIGHT POLE

PROPOSED SPOT ELEVATION

STANDARD WHEELCHAIR RAMP TO BE CONSTRUCTED

PROPOSED STORM DRAIN MH

DROP INLET TO BE CONSTRUCTED

VALLEY GUTTER

SURVEY CONTROL POINTS

CP1 - CAP LS NO. 7002
N. 10,099.89
E. 9,811.83

CP2 - CAP LS NO. 5817
N. 10,010.30
E. 10,062.55

CP3 - CAP LS NO. 5817
N. 10,024.22
E. 10,094.27

STA. 14+67.50 TESUQUE DR.
(CENTER OF BRIDGE)
N. 10,022.20
E. 9,930.53

STA. 12+77.48 TESUQUE DR.
(INTERSECTION W/ PAINTED PONY TR.)
N. 10,087.18
E. 9,751.96

NOTES

1.) REMOVE EXISTING C&G AND SIDEWALK STA. 12+93.74 45.22' LT. TO STA. 16+29.98 48.21' LT. & STA. 12+94.69 46.11' RT. TO STA. 16+29.85 48.11' RT.

2.) REMOVE EXISTING CONCRETE DIP SECTION

3.) TRANSITION FLOWLINE OF CURB & GUTTER FLOWLINE. TRANSITION LENGTH TO BE 30 LINEAR FEET ON EITHER SIDE OF THE BRIDGE. TRANSITION ELEVATIONS ARE AS FOLLOWS:

STATION	TC	FL	EL
14+02.00	60.20	59.53	60.05
14+08.00	60.15	59.48	59.98
14+14.00	60.10	59.43	59.92
14+20.00	60.06	59.39	59.86
14+26.00	60.01	59.34	59.79
14+32.00	59.96	59.29	59.73
15+03.00 RT.	59.24	58.57	59.01
LT.	59.24	58.57	59.01
15+09.00 RT.	59.17	58.50	58.95
LT.	59.17	58.51	58.95
15+15.00 RT.	59.09	58.42	58.90
LT.	59.09	58.45	58.90
15+21.00 RT.	58.98	58.31	58.83
LT.	58.91	58.34	58.83
15+27.00 RT.	58.92	58.25	58.80
LT.	58.99	58.32	58.80
15+33.00 RT.	58.86	58.19	58.76
LT.	58.97	58.30	58.76

AVID ENGINEERING, INC.
Civil • Structural • Transportation
8100 Seagull St. NE - Suite 102
Albuquerque, NM 87109 - (505) 881-5357

AS BUILT INFORMATION

DATE: 6/10/91
BY: JAMES V. DOMENICK
C.O.A. DATE: 5/91

BENCH MARKS

ACS BRASS CAP "4-D-11", LOCATED APPX. 700' SOUTH WEST OF RADIUS POINT OF CUL-DE-SAC AT END OF RIDGEWAY DR. STA. IS A 3/4" ALUM. CAP SET FLUSH IN LAVA OUTCROP STAMPED "4-D-11, 1986".
TRIG. EL. 5261.00

SURVEY INFORMATION

FIELD NOTES
NO. 1
BY: HUGG SURVEYING INC.
DATE: 7/90

ENGINEER'S SEAL

REVISIONS

NO.	DATE	REMARKS
1	7/90	DESIGN
2	7/90	DESIGN
3	7/90	DESIGN
CITY OF ALBUQUERQUE
PUBLIC WORKS DEPARTMENT
ENGINEERING GROUP

TITLE:
TESUQUE DRIVE AT MARIPOSA ARROYO
TESUQUE DRIVE PLAN & PROFILE

APPROVALS	ENGINEER	DATE	APPROVALS	DATE
D.R.C. Chair	R. Kane	11-1-90	Water	10-19-90
Trans. Dev	R. Kane	10-19-90	Waste Water	10-19-90
Hydrology	R. Kane	10-19-90	Parks & Rec.	10-19-90


DRAWING NO.
4038

MAP NO.


SHEET
5

OF
18

RECORD DRAWING

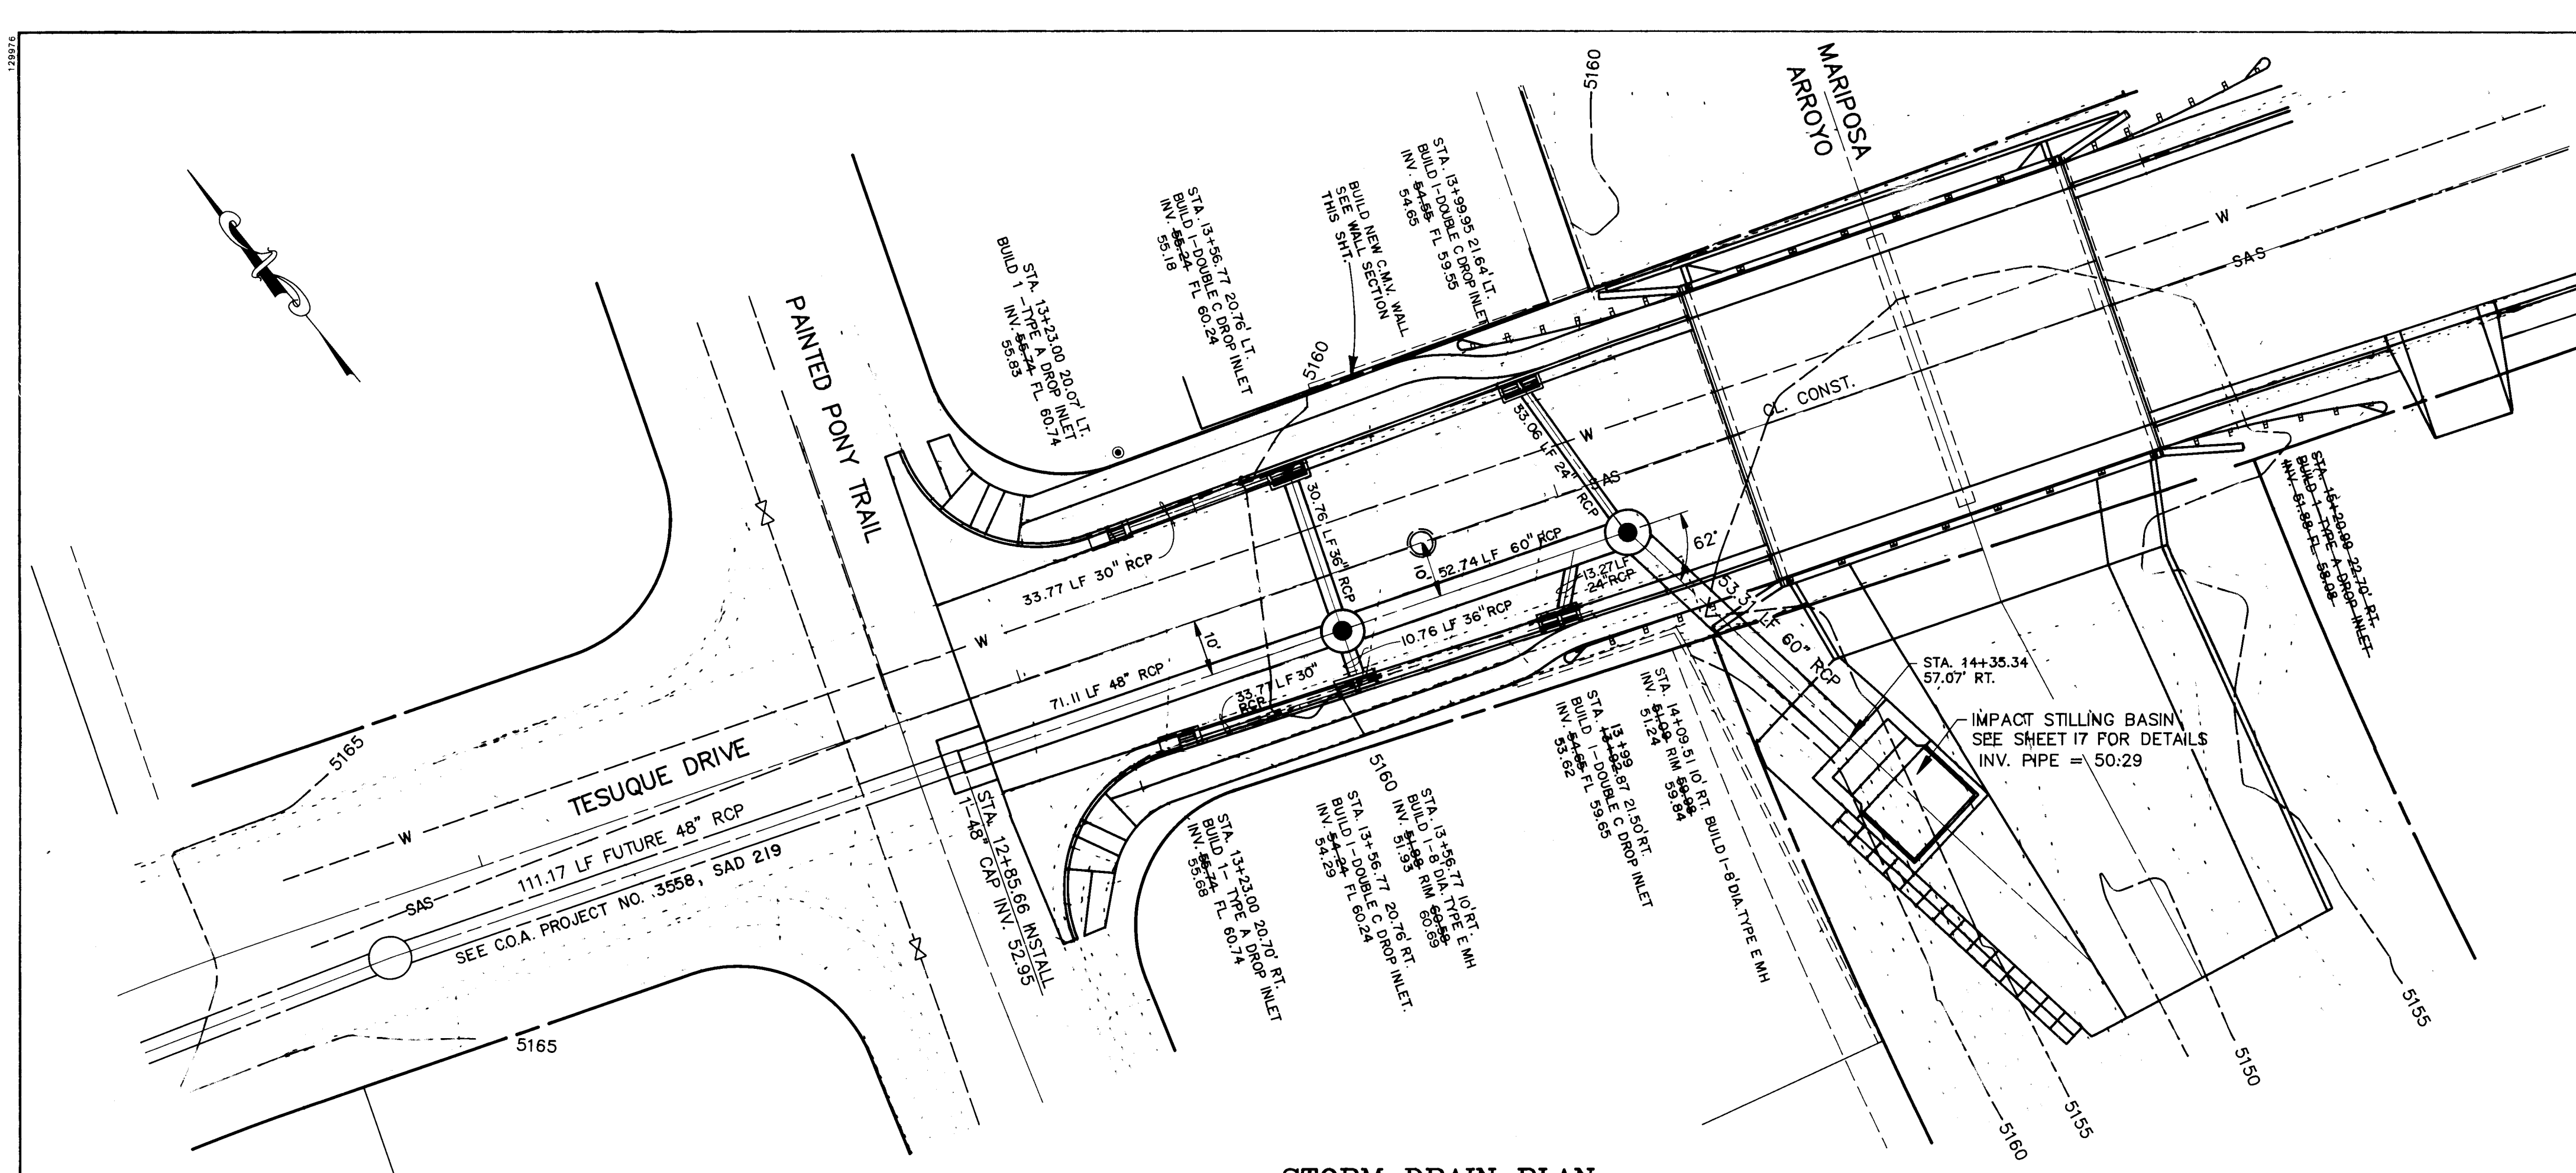


STORM DRAIN PLAN

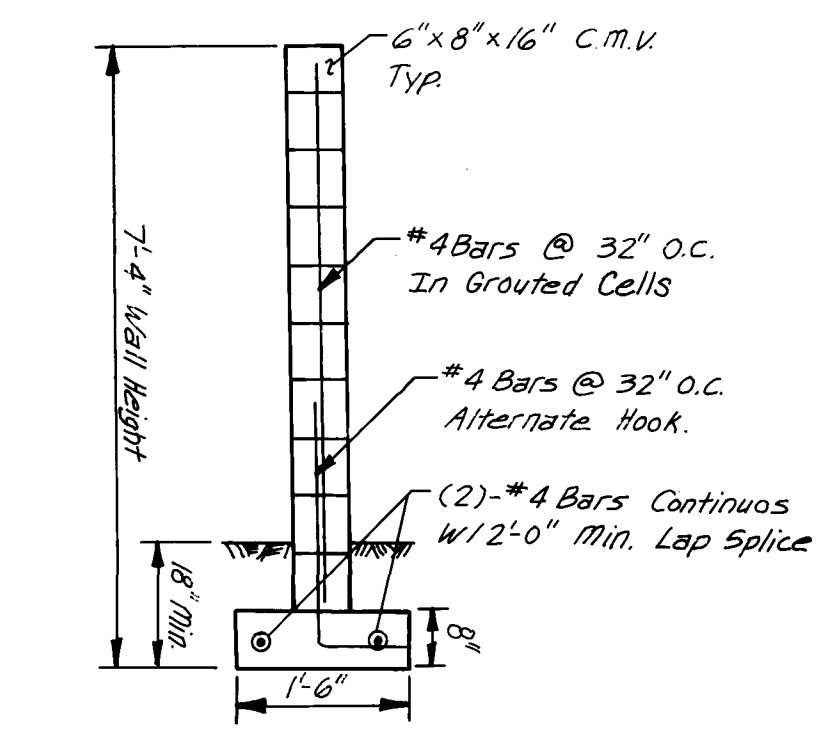

- LEGEND**
- PROPOSED DROP INLET
 - PROPOSED STORM DRAIN MANHOLE
 - PROPOSED STORM DRAIN
- NOTES**
- BEDDING TO BE TYPE B. THE TRENCH SIDES SHALL BE SLOPED TO PROVIDE NOT LESS THAN O.D. OF PIPE PLUS 16" AT INVERT OF PIPE.
 - STATIONS AND OFFSETS SHOWN FOR DROP INLETS ARE CENTER OF DROP INLET AT FACE OF CURB CL. CONST.
 - USE 3/4" PLYWOOD CAP ON 48" RCP AT STA. 12+85.66. CAP IS INCIDENTAL TO THE PIPE FOR PAYMENT.
 - ALL RCP IS TO BE CLASS III
 - CONNECTION OF 24" RCP LATERAL TO 60" RCP TO BE INCIDENTAL TO COST OF PIPE.

SCALE:
HORIZ.: 1"=20'
VERT.: 1"=5'

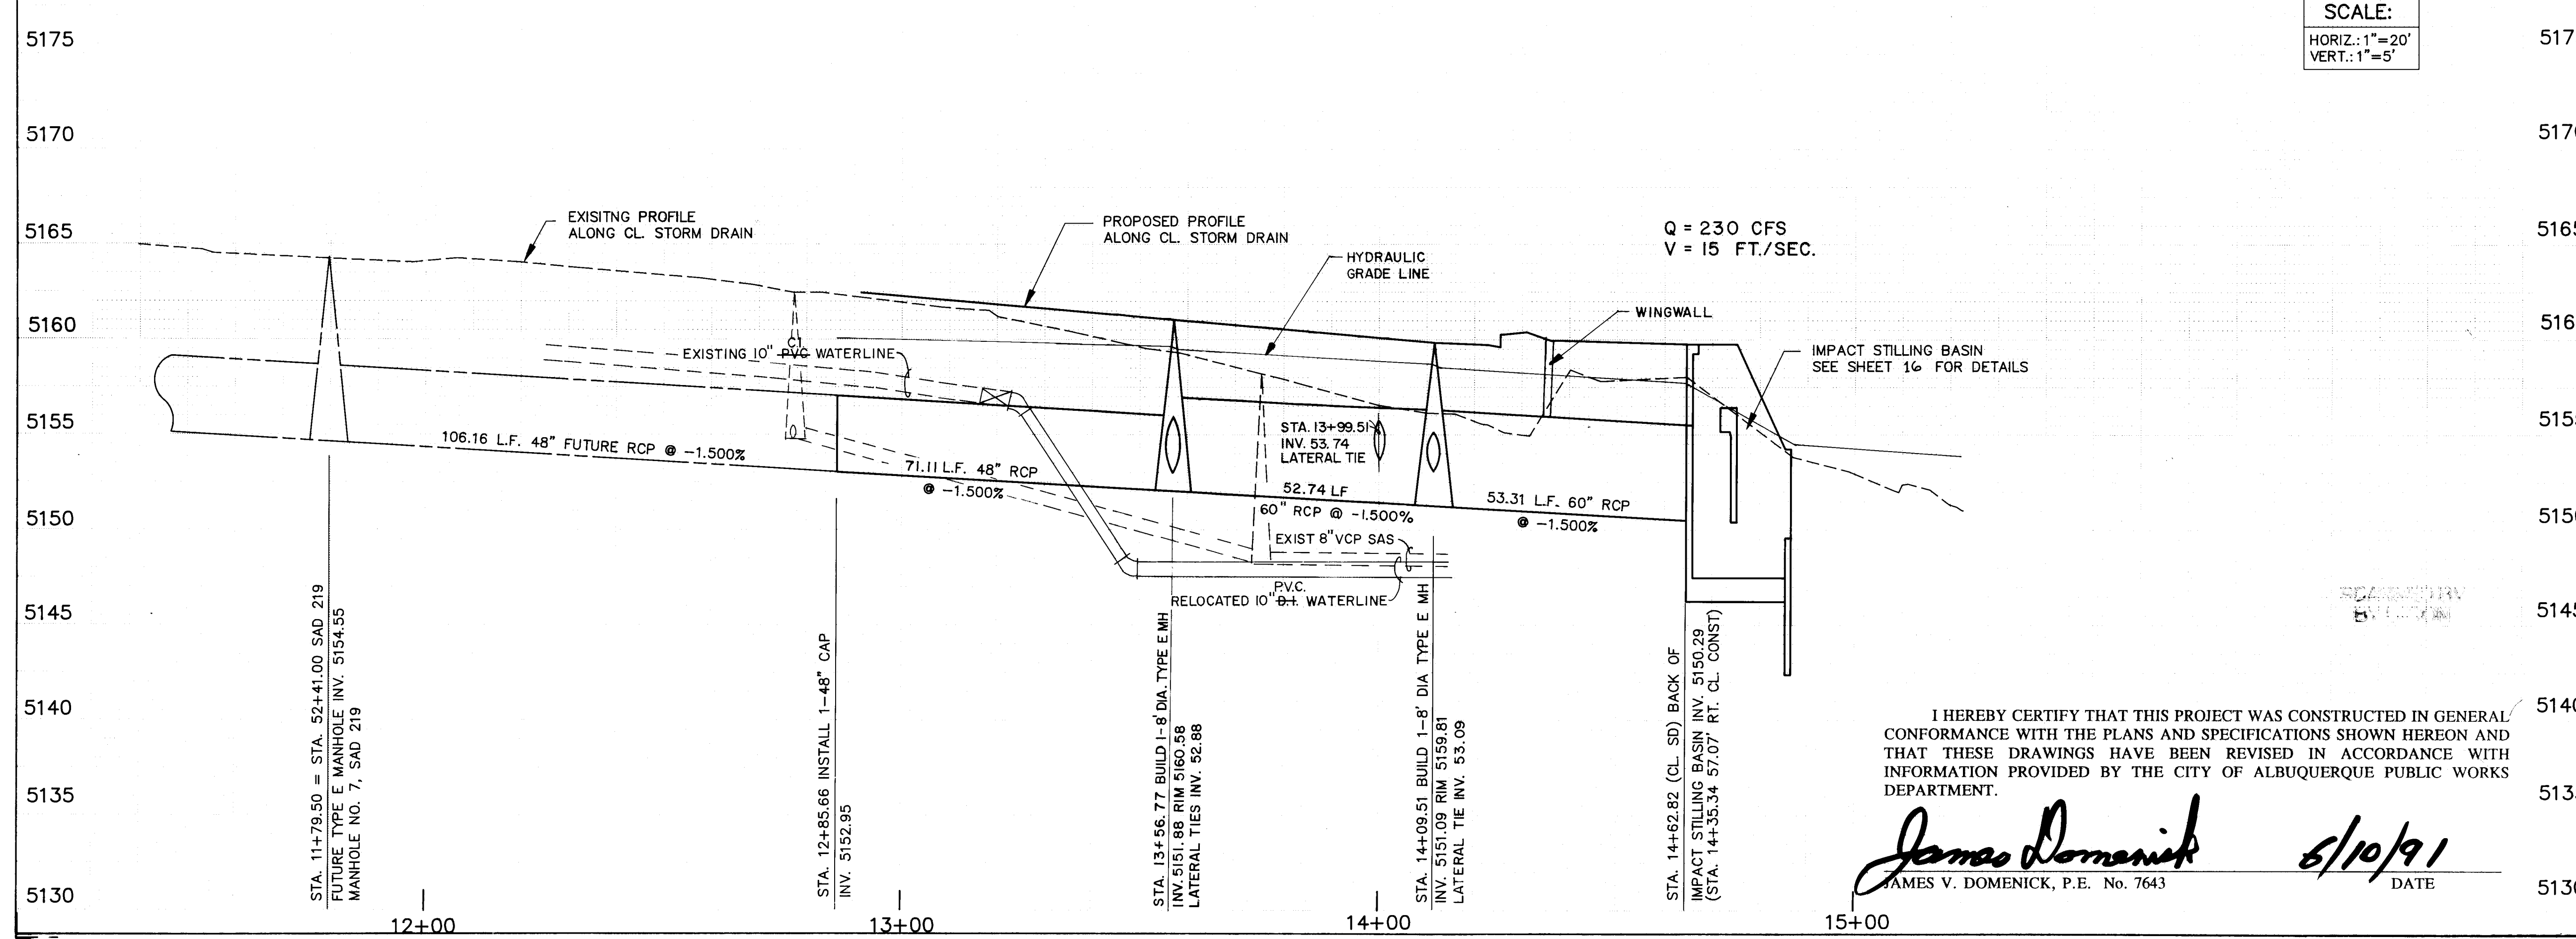

I HEREBY CERTIFY THAT THIS PROJECT WAS CONSTRUCTED IN GENERAL CONFORMANCE WITH THE PLANS AND SPECIFICATIONS SHOWN HEREON AND THAT THESE DRAWINGS HAVE BEEN REVISED IN ACCORDANCE WITH INFORMATION PROVIDED BY THE CITY OF ALBUQUERQUE PUBLIC WORKS DEPARTMENT.



James V. Domenick 6/10/91
JAMES V. DOMENICK, P.E. No. 7643 DATE

C of A PWD Maps & Records

1	2	3	4	5	6	7	8	9	10	11	12
2	6	7	0	3	8	0	6	9	1	1	2


AVID ENGINEERING, INC.
Civil • Structural • Transportation
6100 Seagull St. NE - Suite 102
Albuquerque, NM 87109 - (505) 881-5357

CITY OF ALBUQUERQUE PUBLIC WORKS DEPARTMENT ENGINEERING GROUP					
TITLE: TESUQUE DRIVE AT MARIPOSA ARROYO STORM DRAIN PLAN & PROFILE					
APPROVALS	ENGINEER	DATE	APPROVALS	DATE	DATE
DRC Chair	R. W. Kane	11-1-90	Water	R. W. Kane	10-12-90
Trans. Dev	R. W. Kane	10-19-90	Waste Water	R. W. Kane	10-12-90
Hydrology	R. W. Kane	10-01-90	Parks & Rec.	R. W. Kane	10-19-90
DESIGNED BY: RB DRAWN BY: RB CHECKED BY: JMD					
DRAWING NO. 4038 MAP NO. D-11 SHEET 6 OF 18					

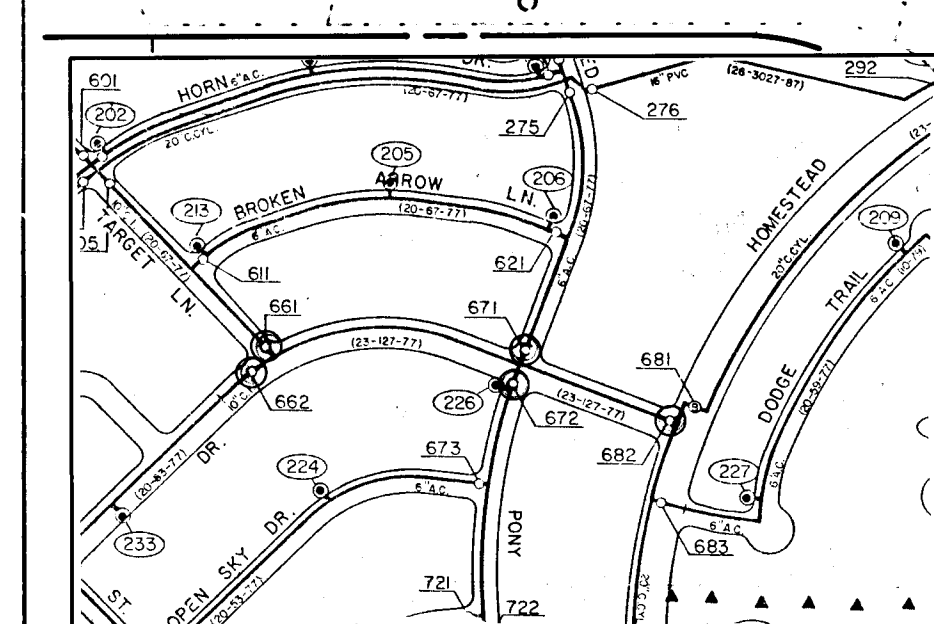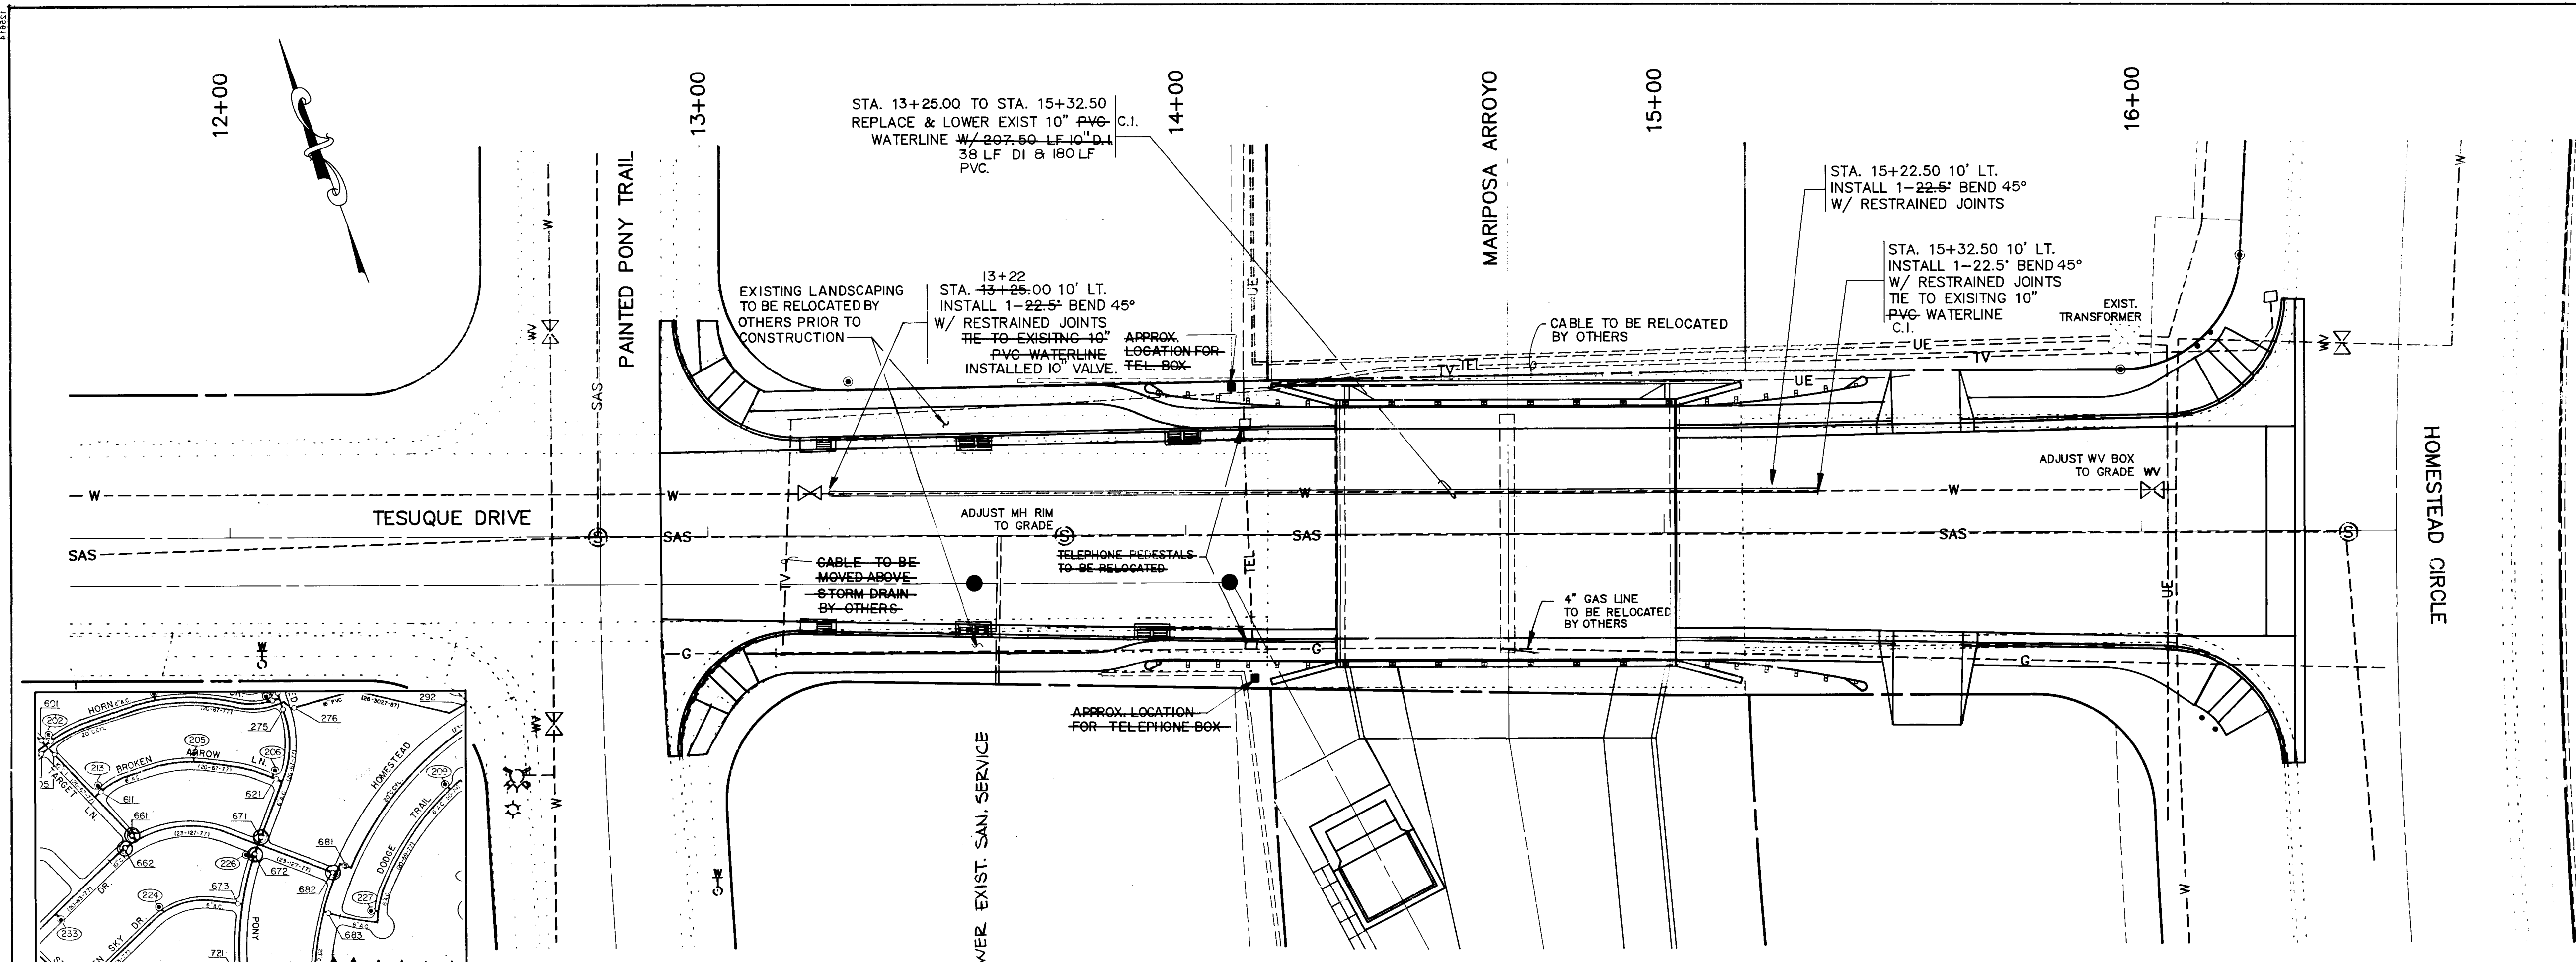

- VALVE SHUT-OFF PLAN
- 1.) THE CONTRACTOR SHALL NOTIFY THE CITY OF ALBUQUERQUE WATER SYSTEMS DIVISIONS @ 857-8200, A MIN. OF 3 WORKING DAYS PRIOR TO COMMENCEMENT OF ANY WORK AFFECTING ANY EXISTING WATERLINES.
 - 2.) WHEN RELOCATING THE EXISTING 10" WATERLINE IN TESUQUE DR. A CITY WATER REPRESENTATIVE SHALL CLOSE VALVES NOS. 661, 662, 671, 672 & 682. THERE WILL BE SERVICES AFFECTED BY THIS SHUT-OFF

5180
5175
5170
5165
5160
5155
5150
5145
5140
5135

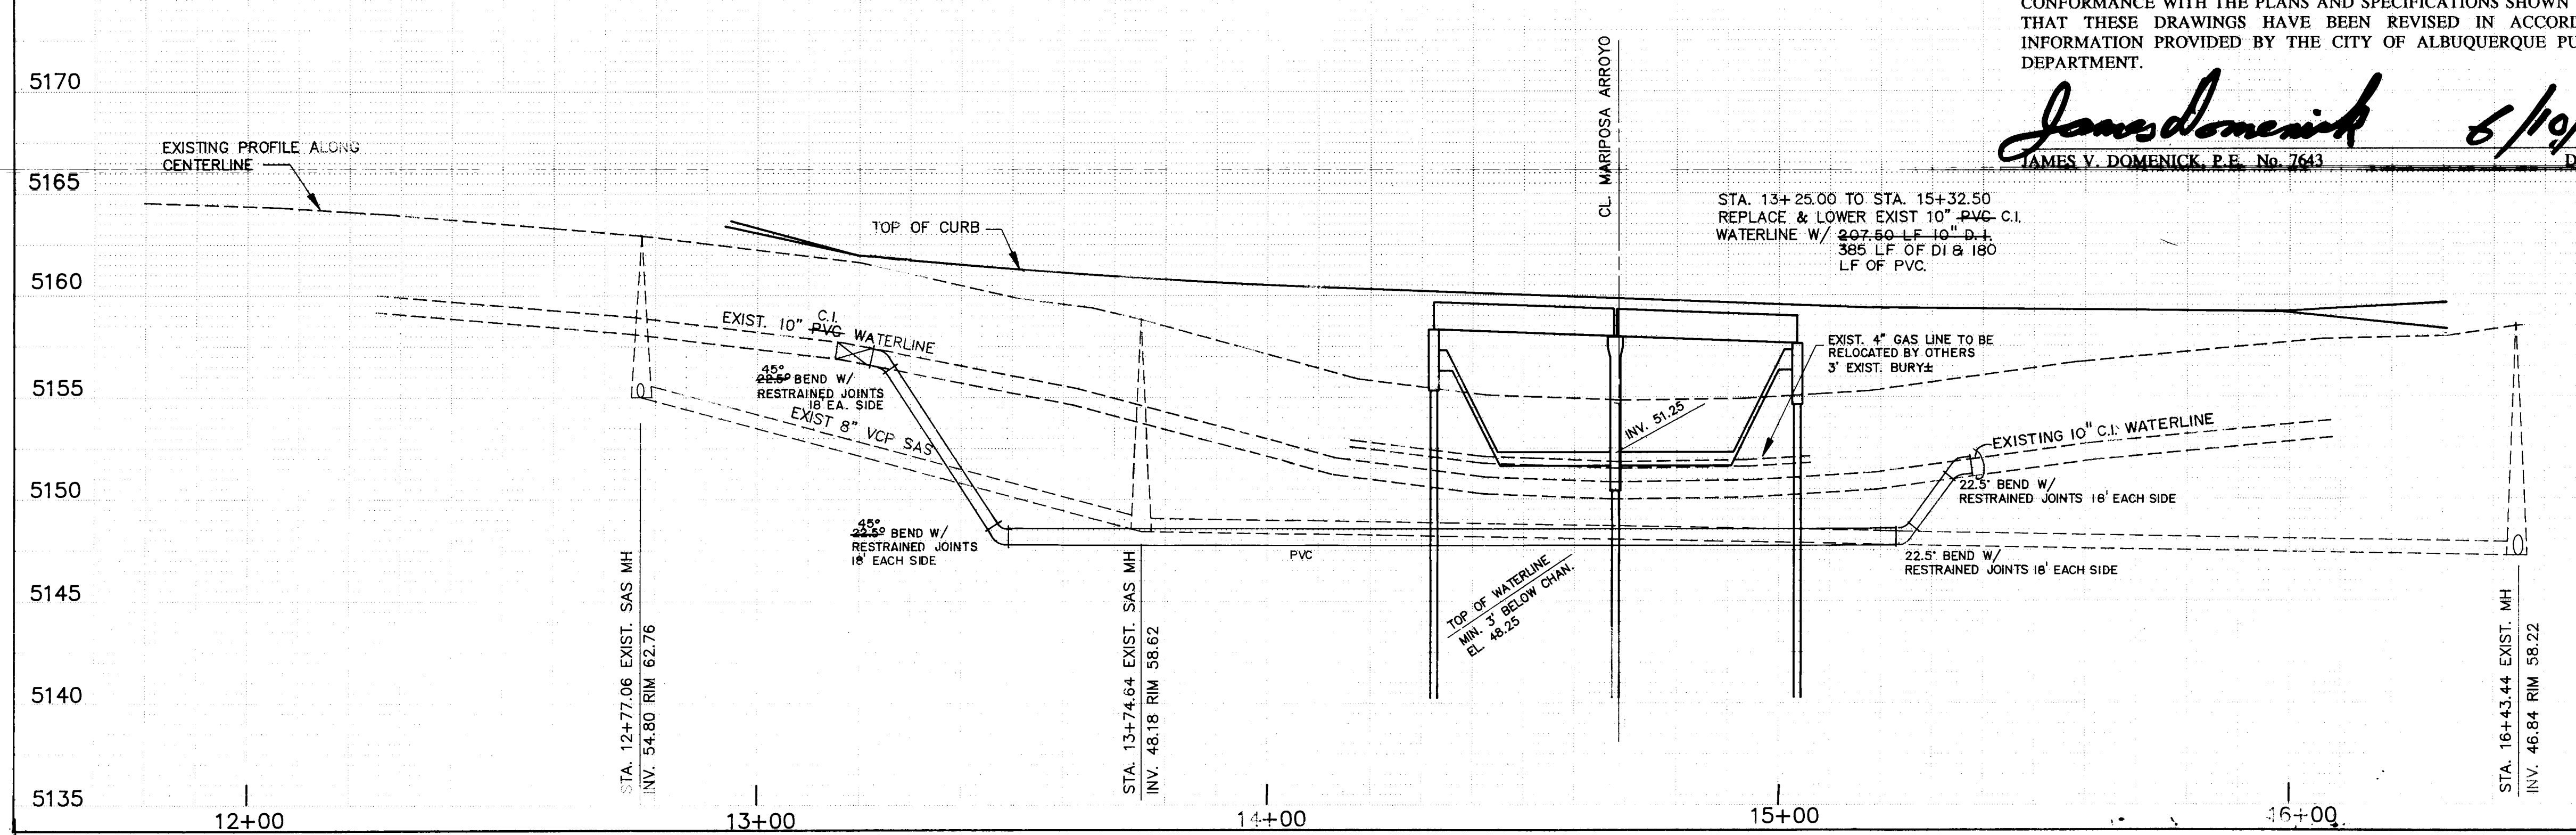

I HEREBY CERTIFY THAT THIS PROJECT WAS CONSTRUCTED IN GENERAL CONFORMANCE WITH THE PLANS AND SPECIFICATIONS SHOWN HEREON AND THAT THESE DRAWINGS HAVE BEEN REVISED IN ACCORDANCE WITH INFORMATION PROVIDED BY THE CITY OF ALBUQUERQUE PUBLIC WORKS DEPARTMENT.

James V. Domenick 6/10/91
JAMES V. DOMENICK, P.E. No. 7643 DATE

SCALE
HORIZ.: 1"=20'
VERT.: 1"=5'

- LEGEND
- SAS --- EXISTING SANITARY SEWER
 - W --- EXISTING WATER LINE
 - G --- EXISTING GAS LINE
 - T --- EXISTING TELEPHONE LINE
 - UE --- EXISTING UNDERGROUND ELECTRICAL LINE
 - TV --- EXISTING CABLE TV LINE
 - ⊙ EXISTING SAS MANHOLE
 - ⊕ EXISTING GATE VALVE
 - ⊕ EXISTING FIRE HYDRANT
 - ⊕ EXISTING WATER METER

- NOTES
- 1.) THE LOCATION OF UNDERGROUND UTILITY LINES IS APPROXIMATE ONLY. IT IS THE CONTRACTOR'S RESPONSIBILITY TO CONTACT NEW MEXICO ONE CALL SYSTEM (505) 260-1990 TWO (2) WORKING DAYS PRIOR TO ANY EXCAVATION.
 - 2.) THE RELOCATION OF EXISTING UTILITIES BESIDES WATER AND SANITARY SEWER IS THE RESPONSIBILITY OF THE RESPECTIVE UTILITY COMPANIES.
 - 3.) THE CONTRACTOR WILL COORDINATE WITH USWEST FOR THE TIMING OF THE CABLE AND BOX RELOCATION. CONTACT PERSON: BECKY OLESON (505) 245-8894.
 - 4.) CABLE TV LINE IN EXISTING CHANNEL TO BE RELOCATED BY JONES INTERCABLE. CONTRACTOR SHALL COORDINATE THE RELOCATION.
 - 5.) THE PUBLIC SERVICE COMPANY SHALL BE CONTACTED PRIOR TO ANY EXCAVATION IN THE VICINITY OF THE TWO POWER LINES TO NORTH OF THE EXISTING DIP SECTION. CONTACT PERSON: JIM VANN (505) 948-3426. BASED ON AVAILABLE INFORMATION, THE UNDERGROUND ELECTRIC LINES NORTH OF THE BRIDGE ARE AT LEAST 10' DEEP, AND THEREFORE SHOULD NOT CONFLICT WITH THE CHANNEL. THE LINE LOCATED APPROX. 18" WITHIN NORTH EDGE OF EXIST CONC. IS AT LEAST 9' DEEP BUT MAY CONFLICT WITH THE HEADWALL.

AS BUILT INFORMATION			BENCH MARKS			SURVEY INFORMATION			ENGINEER'S SEAL		
CONTRACTOR	MOORE & CONANT	DATE	NO.	BY	DATE	NO.	BY	DATE	NO.	BY	DATE
INSPECTOR	DATE	DATE	1	EXIST. COND.	7/90	1	EXIST. COND.	7/90	1	EXIST. COND.	7/90
FIELD ENGINEER	DATE	DATE	1	BY HUGS SURVEYING	7/90	1	BY HUGS SURVEYING	7/90	1	BY HUGS SURVEYING	7/90
VERIFICATION BY C.O.A.	DATE	DATE	1	IN LAVA OUTCROP	4-D-11, 1986	1	IN LAVA OUTCROP	4-D-11, 1986	1	IN LAVA OUTCROP	4-D-11, 1986
DATE	DATE	DATE	1	TRIG. EL. 5261.00		1	TRIG. EL. 5261.00		1	TRIG. EL. 5261.00	
RECORDED BY	NO.	DATE	1	REMARKS	DESIGN	1	REMARKS	DESIGN	1	REMARKS	DESIGN
DESIGNED BY	RB	DATE	1	NO. DATE	DESIGN	1	NO. DATE	DESIGN	1	NO. DATE	DESIGN
DRAWN BY	RB	DATE	1	NO. DATE	DESIGN	1	NO. DATE	DESIGN	1	NO. DATE	DESIGN
CHECKED BY	JVO	DATE	1	NO. DATE	DESIGN	1	NO. DATE	DESIGN	1	NO. DATE	DESIGN

CITY OF ALBUQUERQUE PUBLIC WORKS DEPARTMENT ENGINEERING GROUP					
TITLE: TESUQUE DRIVE AT MARIPOSA ARROYO TESUQUE DRIVE UTILITY RELOCATIONS					
APPROVALS	ENGINEER	DATE	APPROVALS	ENGINEER	DATE
DRC Chair	R.W. Kane	10-19-90	Water	R.W. Kane	10-19-90
Trans. Dev	R.W. Kane	10-19-90	Waste Water	R.W. Kane	10-19-90
Hydrology	R.W. Kane	10-19-90	Parks & Rec.	R.W. Kane	10-19-90

DRAWING NO. 4038 MAP NO. D-11 SHEET 7 OF 18

RECORD DRAWING

	SHEET NO.
BRIDGE GENERAL NOTES & ESTIMATED QUANTITIES	8
BRIDGE PLAN & PROFILE	9
TYPICAL BRIDGE SECTIONS	10
CONCRETE BRIDGE DECK DETAILS	11
SUPERSTRUCTURE BEAM DETAILS	12
ABUTMENT & WINGWALL DETAILS	13
PIER DETAILS	14

METAL BARRIER MATERIALS AND PLACEMENT PROCEDURES
CITY OF ALBUQUERQUE DWG. 2610

METAL BARRIER (BREAKAWAY) TYPE "C" END ANCHORAGE
(WOOD POSTS) CITY OF ALBUQUERQUE DWG.2635

1. WORKMANSHIP AND MATERIALS SHALL CONFORM TO THE NEW MEXICO STATE HIGHWAY AND TRANSPORTATION DEPARTMENT STANDARD SPECIFICATIONS FOR ROAD AND BRIDGE CONSTRUCTION, 1989 EDITION.
2. CONCRETE FOR STRUCTURAL CAST-IN-PLACE CONCRETE USE CLASS A. CHAMFER ALL EXPOSED EDGES OF CONCRETE STRUCTURES 3/4 INCH UNLESS NOTED OTHERWISE ON THE DETAILS.
3. REINFORCING BARS, ALL REINFORCING BARS SHALL CONFORM TO AASHTO M-31, GRADE 60, UNLESS NOTED OTHERWISE ON THE DETAILS. DIMENSIONS REFER TO CENTERLINE OF BAR UNLESS NOTED OTHERWISE ON THE DETAILS.
4. STRUCTURAL STEEL TO BE CARBON STEEL CONFORMING TO AASHTO SPECIFICATIONS M-183 UNLESS NOTED OTHERWISE ON THE DETAILS. SHOP PLANS MUST BE APPROVED BY THE ENGINEER BEFORE FABRICATION IS STARTED.
5. FOUNDATION DATA SHOWN ON THE PLANS ARE FOR DESIGNERS ONLY. THE ENGINEER IS NOT RESPONSIBLE FOR ANY INTERPRETATIONS OR ASSUMPTIONS MADE BY THE CONTRACTOR BASED ON THIS INFORMATION.
6. CONTRACTOR SHALL VERIFY IN THE FIELD ALL DIMENSIONS, ELEVATIONS AND DETAILS PERTAINING TO ANY EXISTING STRUCTURES WHICH WILL BE INVOLVED IN THE NEW CONSTRUCTION BEFORE PROCEEDING WITH THE NEW WORK.
7. ALL PERFORMED JOINTS MUST BE IN ACCORDANCE WITH THE NEW MEXICO STATE HIGHWAY AND TRANSPORTATION DEPARTMENT STANDARD SPECIFICATIONS M-213. COST OF JOINT FILLER IS INCIDENTAL TO THE COMPLETION OF THE WORK AND NO DIRECT PAYMENT WILL BE MADE THEREFORE.
8. METAL BRIDGE RAILING POSTS AND TUBES SHALL RECEIVE ONE PRIME COAT OF RED LEAD IN CONFORMANCE WITH SECTION 615 OF THE STANDARD SPECIFICATIONS AND TWO COATS OF PAINT CONFORMING TO AASHTO M-70, TYPE 1, CLASS B. PAINT COLOR SAMPLES SHALL BE SUBMITTED TO THE CITY FOR APPROVAL.
9. BEAMS SHALL CONFORM TO CITY OF ALBUQUERQUE STANDARD SPECIFICATIONS SECTION 512, PRECAST PRESTRESSED CONCRETE MEMBERS.
10. DECK SLAB SURFACE TEXTURE SHALL CONSIST OF A BROOMED FINISH APPLIED TO THE PLASTIC CONCRETE FOLLOWED BY GROOVING OF THE HARDENED CONCRETE. GROOVING SHALL BE DONE IN ACCORDANCE WITH THE NEW MEXICO STATE HIGHWAY AND TRANSPORTATION DEPARTMENT STANDARD SPECIFICATIONS AS MODIFIED BY APPROPRIATE SUPPLEMENTAL SPECIFICATIONS OR SPECIAL PROVISIONS, EXCEPT THAT THE LINSEED OIL AND MINERAL SPIRITS MIXTURE SHALL NOT BE APPLIED TO THE GROOVED SURFACE. GROOVING OF HARDENED CONCRETE SHALL BE CONSIDERED INCIDENTAL TO CONSTRUCTION AND NO DIRECT PAYMENT WILL BE MADE THEREFORE.

DESIGN IS IN ACCORDANCE WITH AASHTO SPECIFICATIONS 1989 EDITION AND
CURRENT INTERIMS.

DESIGN STRESSES: STRUCTURAL STEEL-AASHTO M-183, FS=20,000. PSI FY=36,000 PSI

REINFORCED CONCRETE:
SUPERSTRUCTURE: F'C=4,000. PSI AT 28 DAYS
FC=1,200. PSI FS=24,000. PSI
SUBSTRUCTURE: F'C=4,000. PSI AT 28 DAYS
FC=1,200. PSI FS=24,000. PSI GRADE 60
N=9 FS=20,000. PSI GRADE 40

LIVE LOAD: HS-20-44

WEARING SURFACE: 30 PSF ALLOWANCE FOR FUTURE WEARING SURFACE.

HORIZONTAL EARTH PRESSURE: 30 LBS./CU. FT. EQUIVALENT FLUID PRESSURE
AND 2 FT. SURCHARGE.

WIND VELOCITY: 80 MPH

MAXIMUM COMPUTED PILE LOAD.

ABUT. NO. 1 27.1 TONS
PIER NO. 1 37.1 TONS
ABUT. NO. 2 27.1 TONS

PRESTRESSED CONCRETE:
BEAMS: FCI (MIN. COMP. STRENGTH OF CONCRETE AT TIME OF INITIAL PRESTRESS)
=4,750 P.S.I.
F'C=5,500 P.S.I.
N=7, 1 1/2" DIA. HIGH TENSILE STRENGTH 7 WIRE STRANDS
INITIAL PRESTRESS=28,910 LBS/STRAND
F'S=41,300 LBS/STRAND, FY=35,100 LBS/STRAND
FSE=23,170 LBS/STRAND, PRESTRESS LOSS=5,750 LBS/STRAND

SPECIFICATION FOR AUGER-PRESSURE GROUTED PILING INSTALLATION

[illegible]

1. ELASTOMERIC BEARING PAD
2. NON-SHRINK GROUT FOR VOIDED SLAB
3. PREFORMED BITUMINOUS JOINT FILLER
4. EMBEDDED AND ATTACHED STRUCTURAL STEEL
(INCLUDING LATERAL TIE BOLTS)
5. SIDEWALK CULVERTS

NOTE:

- 1) ITEMS LISTED ABOVE SHALL BE INCIDENTAL TO THE COST OF OTHER ITEMS FOR THE COMPLETION OF THE WORK AND NO DIRECT PAYMENT WILL BE MADE THEREFORE. THIS LIST DOES NOT INCLUDE ANY INCIDENTAL WORK OR MATERIAL REQUIRED BY STANDARD DRAWINGS, SUPPLEMENTAL SPECIFICATIONS, OR THE STANDARD SPECIFICATIONS.
- 2) STEEL PLATE COVERS ON SIDEWALK CULVERTS TO BE PAINTED THE SAME COLOR AS THE BRIDGE RAILING. "INDIA TAN" WELLBORN Q5-38T OR APPROVED EQUAL.

SCANNED BY
BY LASON

2	6		4	0	3	8	0	8	9	1	
---	---	--	---	---	---	---	---	---	---	---	--


AVID ENGINEERING, INC.
Civil • Structural • Transportation
6100 Seagull St. NE - Suite 102
Albuquerque, NM 87109 - (505) 881-5357

I HEREBY CERTIFY THAT THIS PROJECT WAS CONSTRUCTED IN GENERAL CONFORMANCE WITH THE PLANS AND SPECIFICATIONS SHOWN HEREON AND THAT THESE DRAWINGS HAVE BEEN REVISED IN ACCORDANCE WITH INFORMATION PROVIDED BY THE CITY OF ALBUQUERQUE PUBLIC WORKS DEPARTMENT.

James V. Domenick 6/10/91
JAMES V. DOMENICK, P.E. No. 7643 DATE


CITY OF ALBUQUERQUE PUBLIC WORKS DEPARTMENT ENGINEERING GROUP					
TITLE: TESUQUE DRIVE AT MARIPOSA ARROYO BRIDGE GENERAL NOTES & ESTIMATED QUANTITIES					
APPROVALS	ENGINEER	DATE	APPROVALS	ENGINEER	DATE
D.R.C. Chair	<i>[Signature]</i>	11-1-90	Water	<i>R.W. Kane</i>	10-19-90
Transportation	<i>[Signature]</i>	10-19-90	Waste Water	<i>R.W. Kane</i>	10-19-90
Hydrology	<i>[Signature]</i>	10-01-90	Parks & Rec.	<i>[Signature]</i>	10-19-90
DRAWING NO. 4038	MAP NO. D-11		SHEET 8		NO. 18

RECORD DRAWING

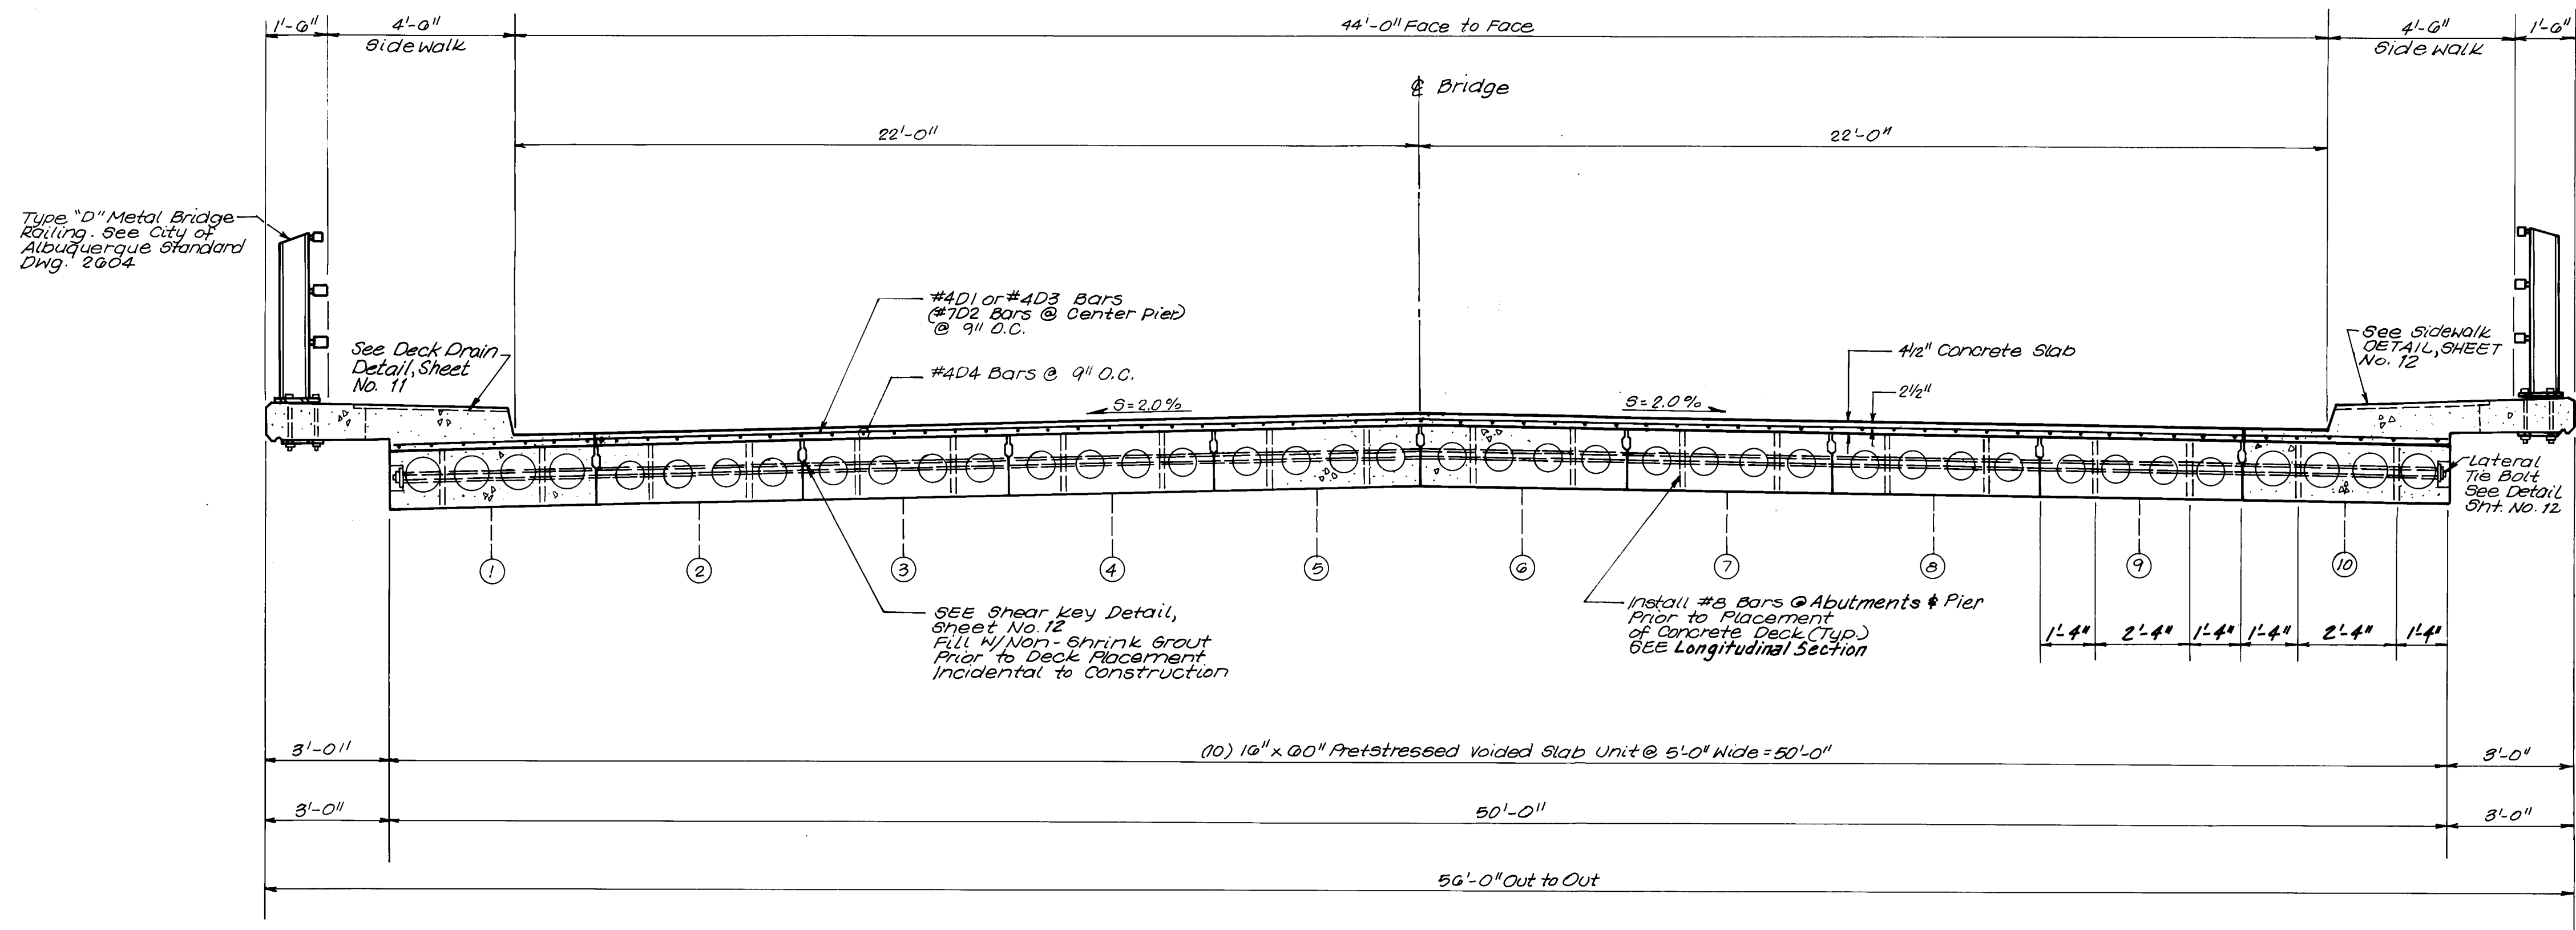

TRANVERSE SECTION

No Scale

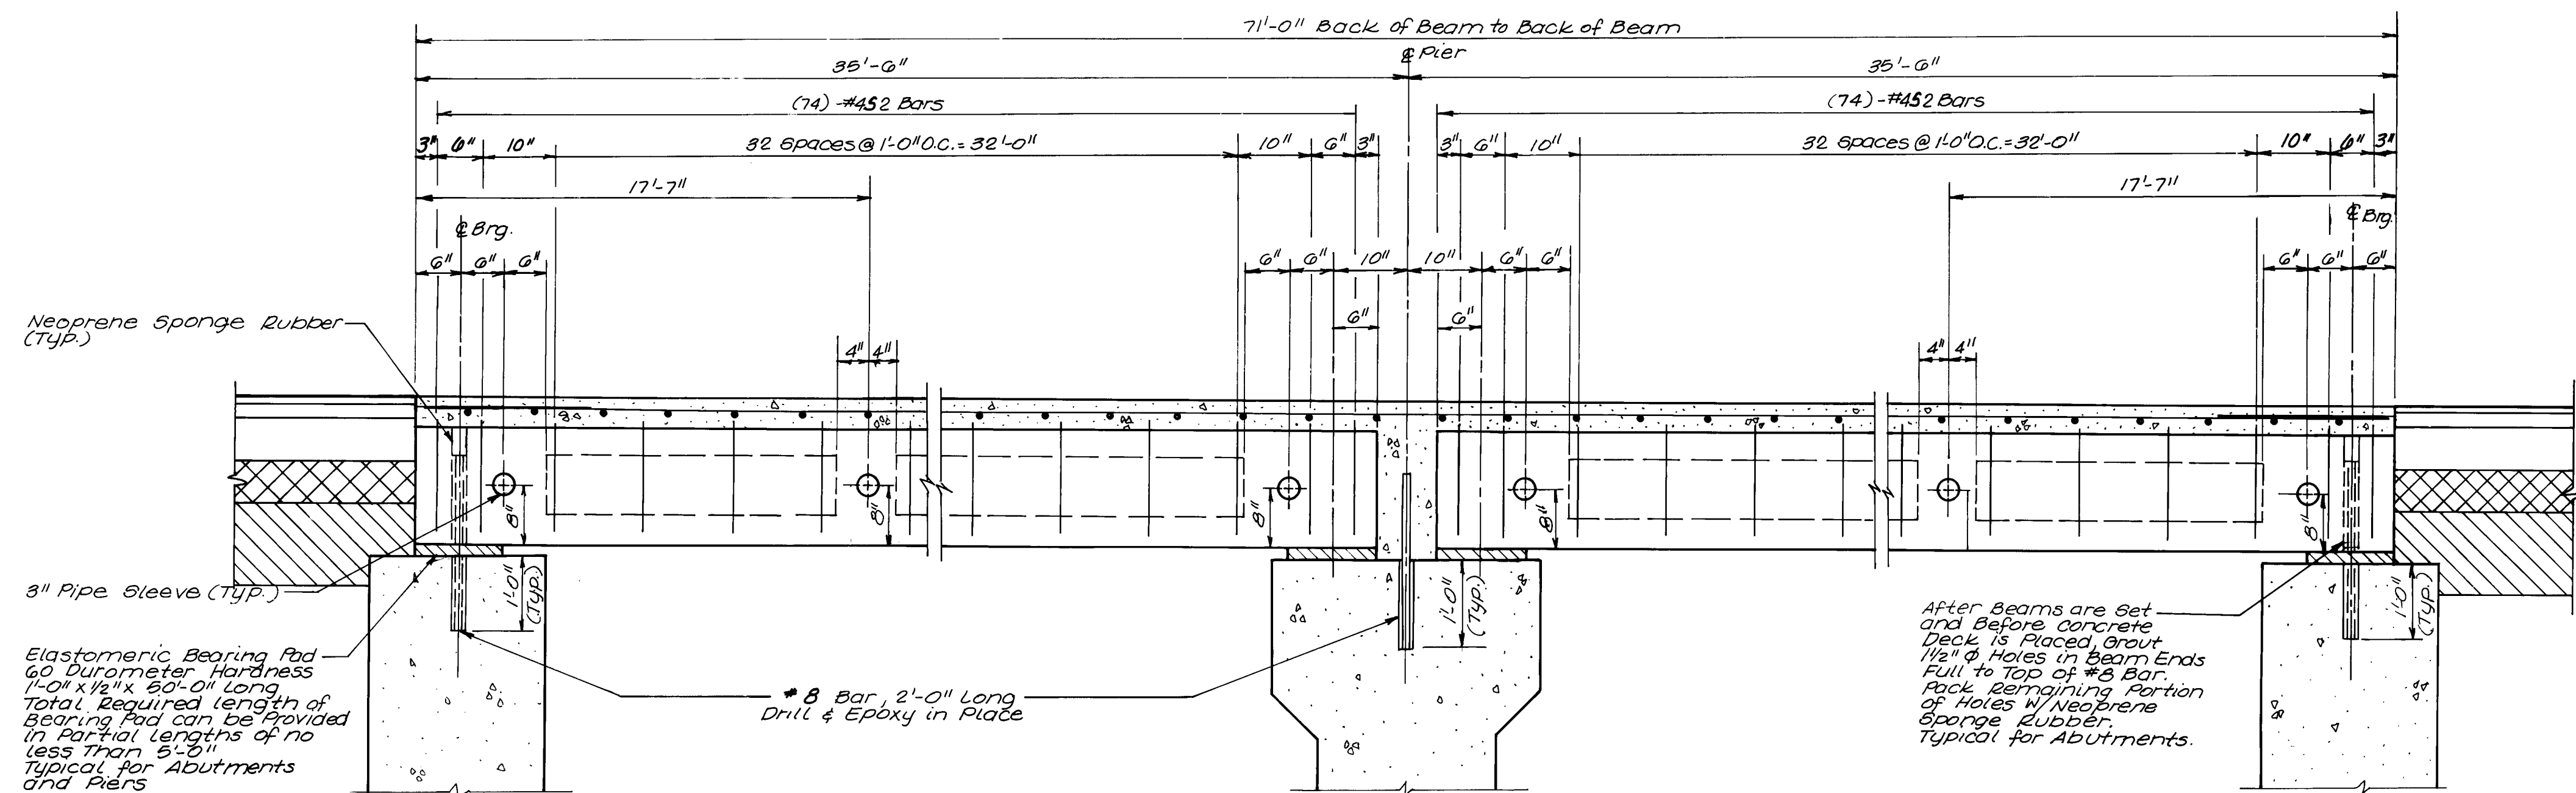

LONGITUDINAL SECTION

No Scale

I HEREBY CERTIFY THAT THIS PROJECT WAS CONSTRUCTED IN GENERAL CONFORMANCE WITH THE PLANS AND SPECIFICATIONS SHOWN HEREON AND THAT THESE DRAWINGS HAVE BEEN REVISED IN ACCORDANCE WITH INFORMATION PROVIDED BY THE CITY OF ALBUQUERQUE PUBLIC WORKS DEPARTMENT.

James V. Domenick, P.E. No. 7643
6/10/91
DATE

SCANNED BY
BY IASON


1 of 4 Maps & Records
26 40 38 10 9 11

AVID ENGINEERING, INC.
Civil • Structural • Transportation
6100 Seagull Street NE • Suite 102
Albuquerque, NM 87109 • (505) 881-5357

CITY OF ALBUQUERQUE
PUBLIC WORKS DEPARTMENT
ENGINEERING GROUP


TITLE:					
TESUQUE DRIVE AT MARIPOSA ARROYO TYPICAL BRIDGE SECTIONS					
APPROVALS	ENGINEER	DATE	APPROVALS	ENGINEER	DATE
D.R.C. Chair	R. W. Kane	11-1-90	Water	R. W. Kane	10-12-90
Trans. Dev	R. W. Kane	10-19-90	Waste Water	R. W. Kane	10-19-90
Utility Dev	R. W. Kane	10-19-90	Parks & Rec.	R. W. Kane	10-19-90
Hydrology	R. W. Kane	10-19-90			
DRAWING NO.	4038	MAP NO.	D-11	SHEET	10 OF 18

RECORD DRAWING

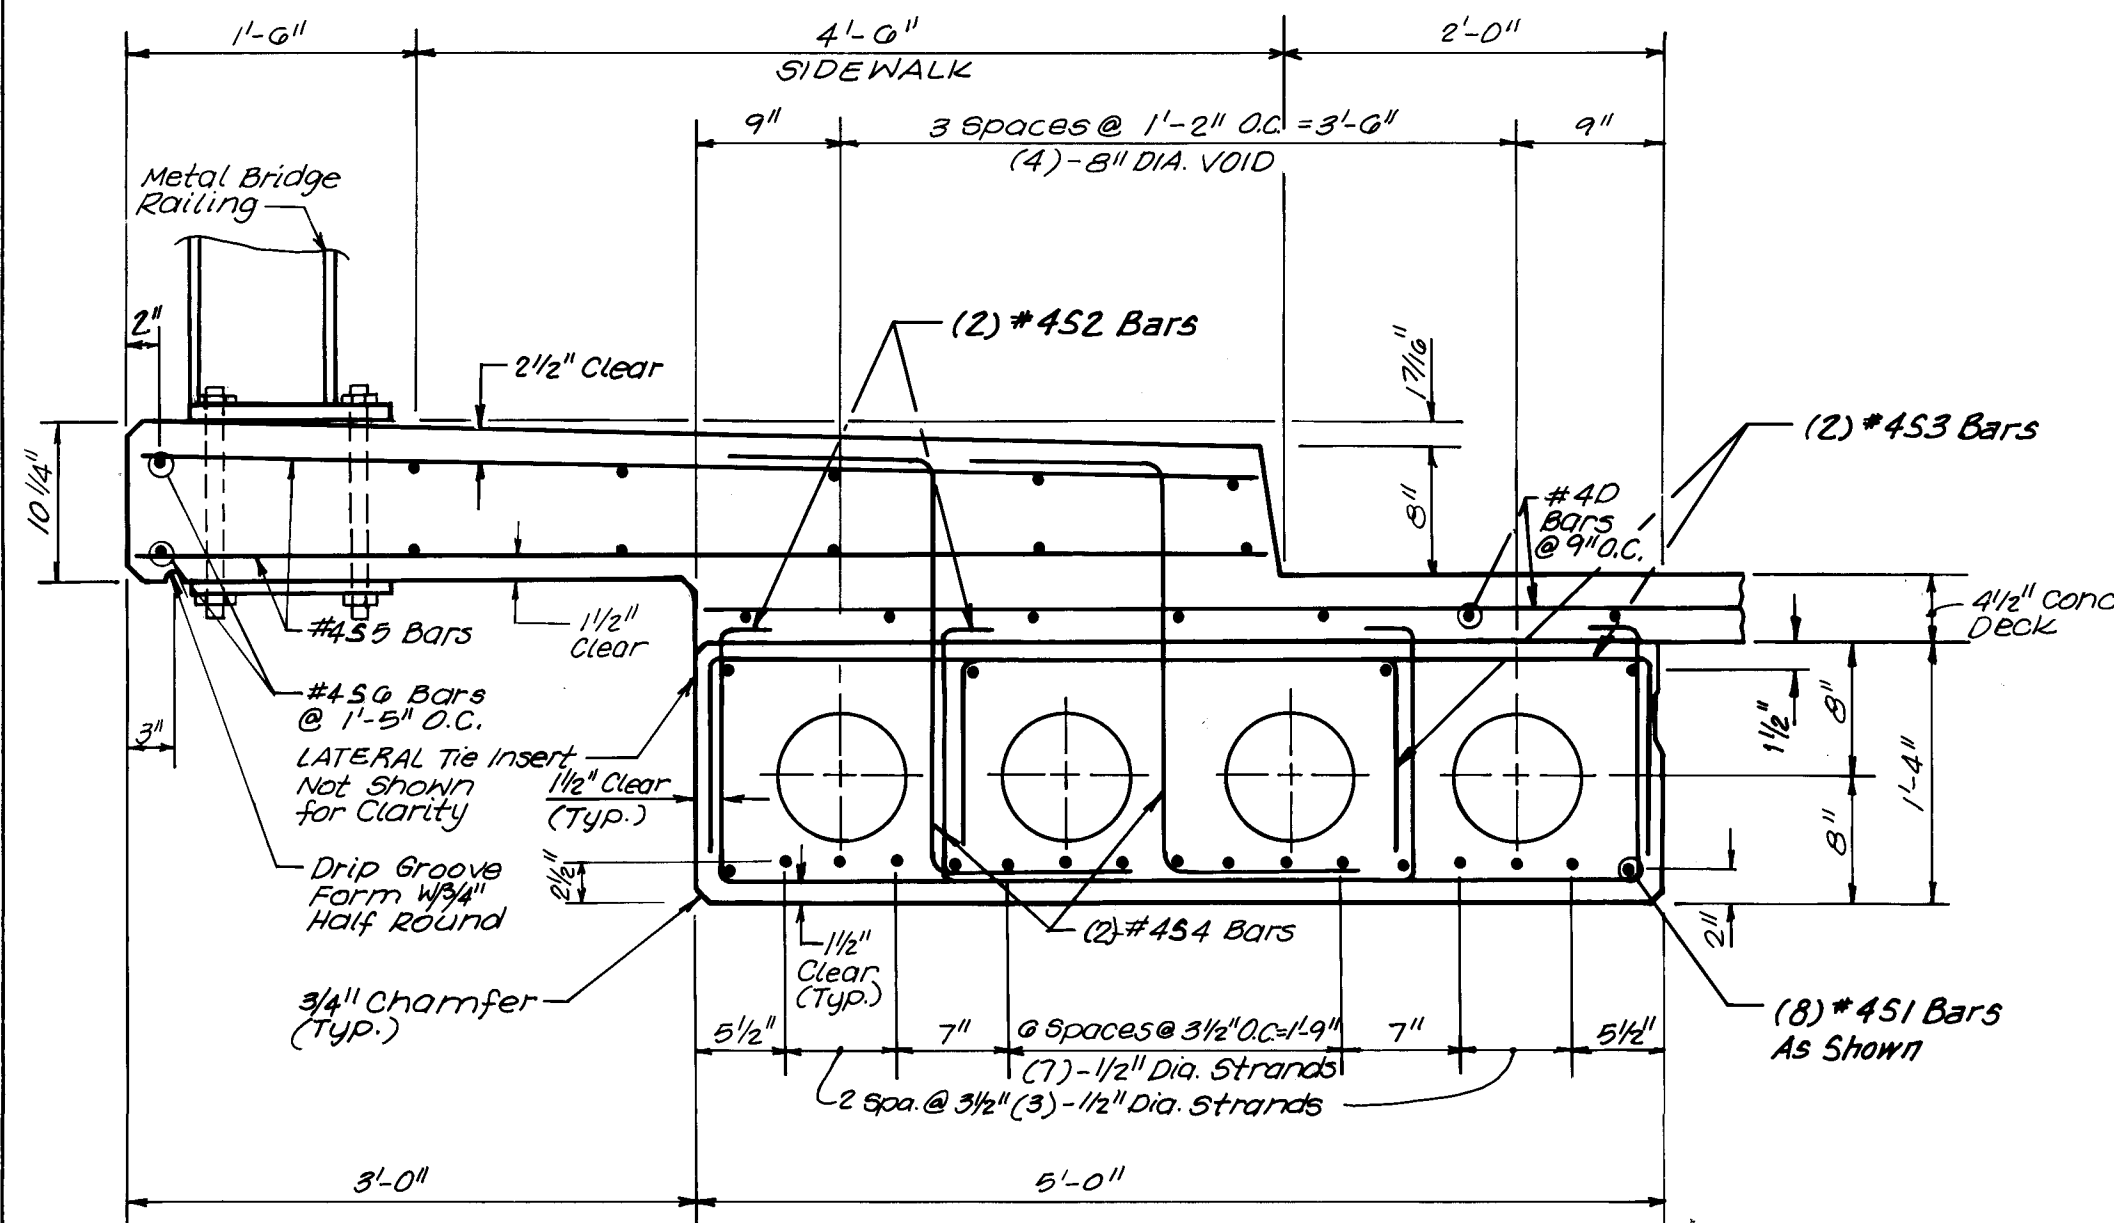


SIDEWALK & EXTERIOR BEAM DETAILS

No Scale

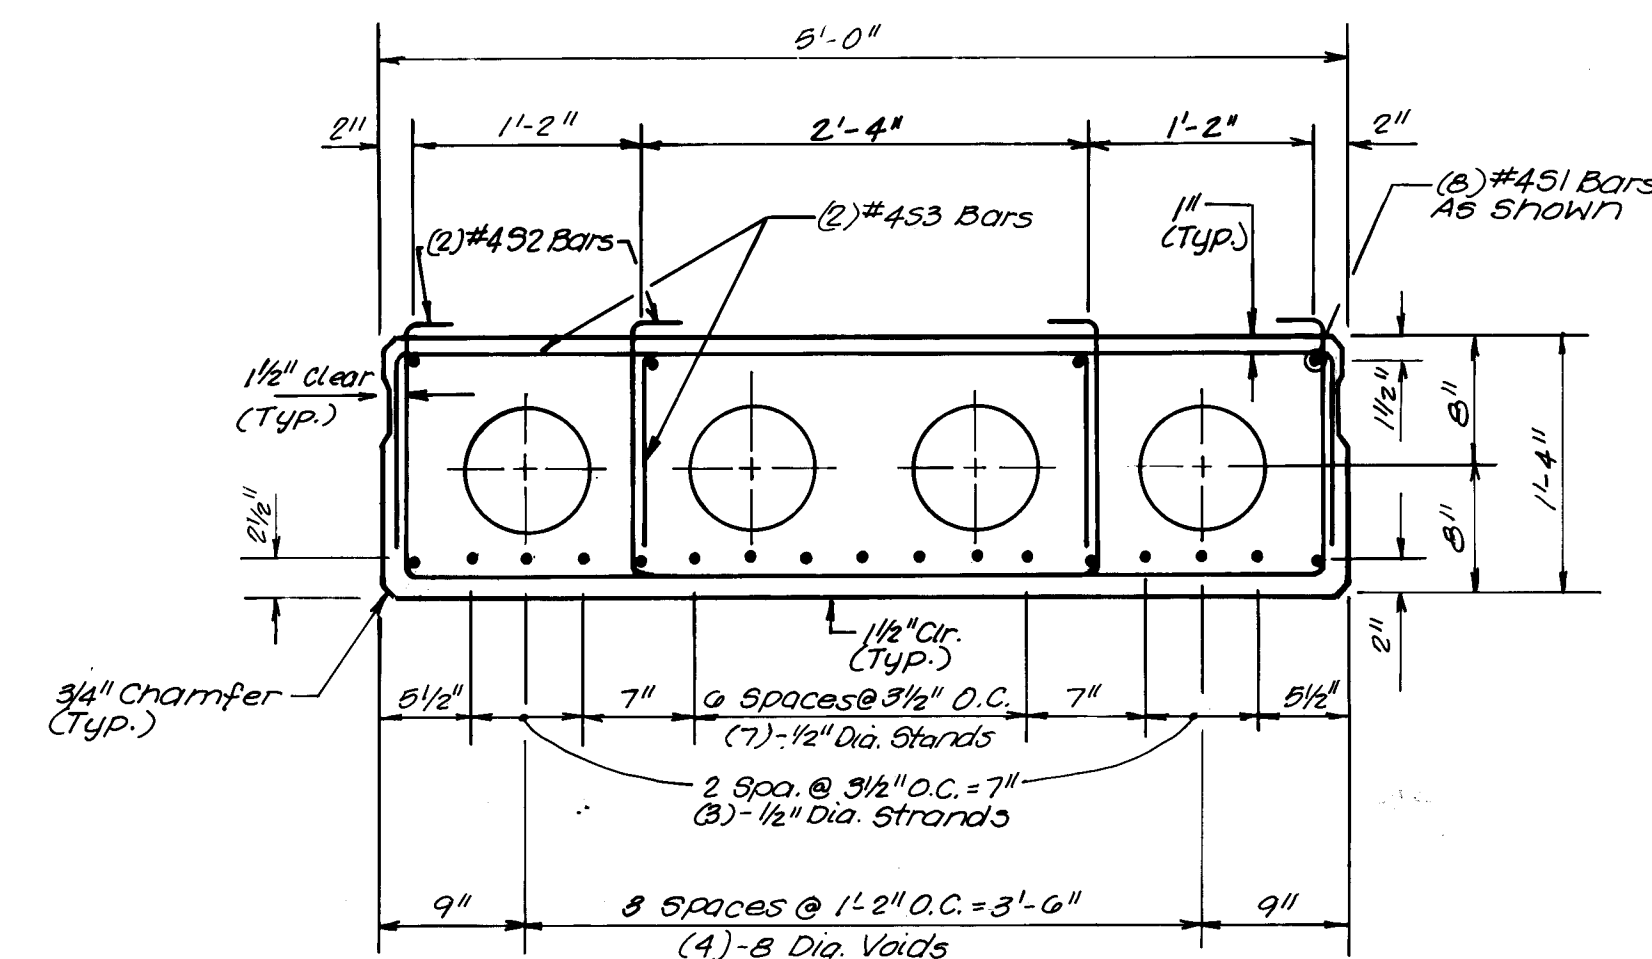

TYPICAL INTERIOR BEAM DETAIL

No Scale

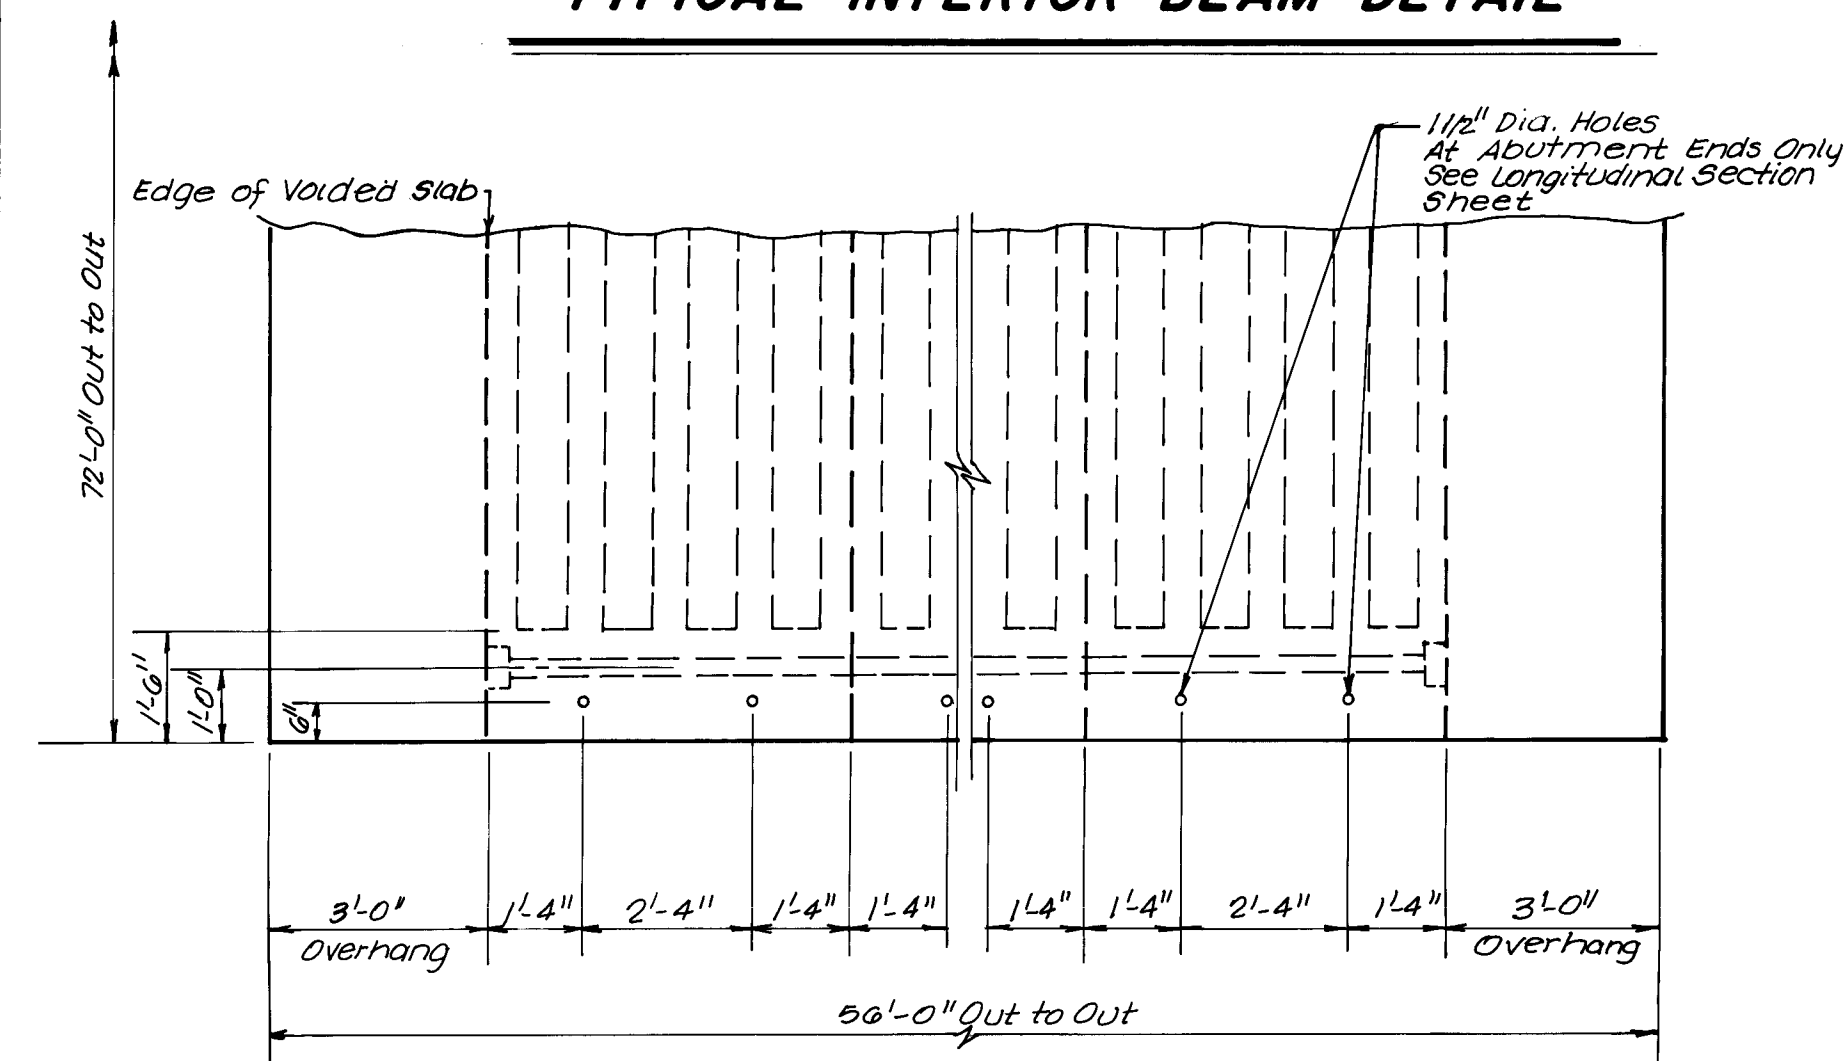

PLAN VIEW

No Scale


* ESTIMATED QUANTITIES FOR ONE EXTERIOR BEAM AND BEAM DATA							
BEAM TYPE	CONCRETE	REINFORCING STEEL	EMBEDDED STRUCT. STEEL**	WEIGHT	CAMBER	DEAD LOAD DEFLECTION	REMARKS
10" x 60"	6.9 CY	238 LBS	2992 LBS	110 LBS	1/4"	1/4"	

* Quantities are for Exterior Beam only And do Not Include Quantities for Concrete Deck & Sidewalk.


** Incidental to Construction.

REINFORCING STEEL REQUIRED FOR ONE EXTERIOR BEAM				
BAR	TYPE	SIZE	LENGTH	NUMBER
451	1	4	34'-8"	16
452	2	4	6'-8"	148
453	3	4	5'-7"	148
454	4	4	3'-8"	148
455	1	4	5'-8"	148
456	1	4	36'-6"	20

(4) - Required

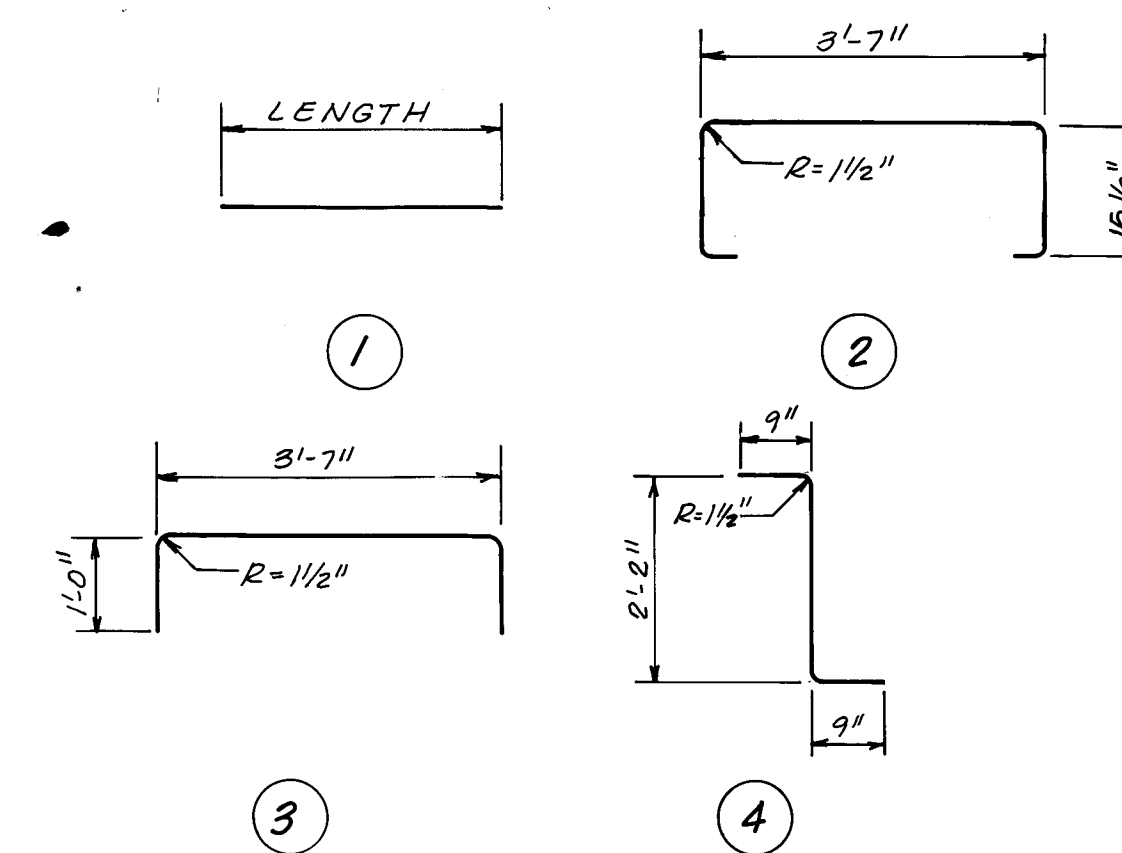


BAR BENDING DIAGRAM

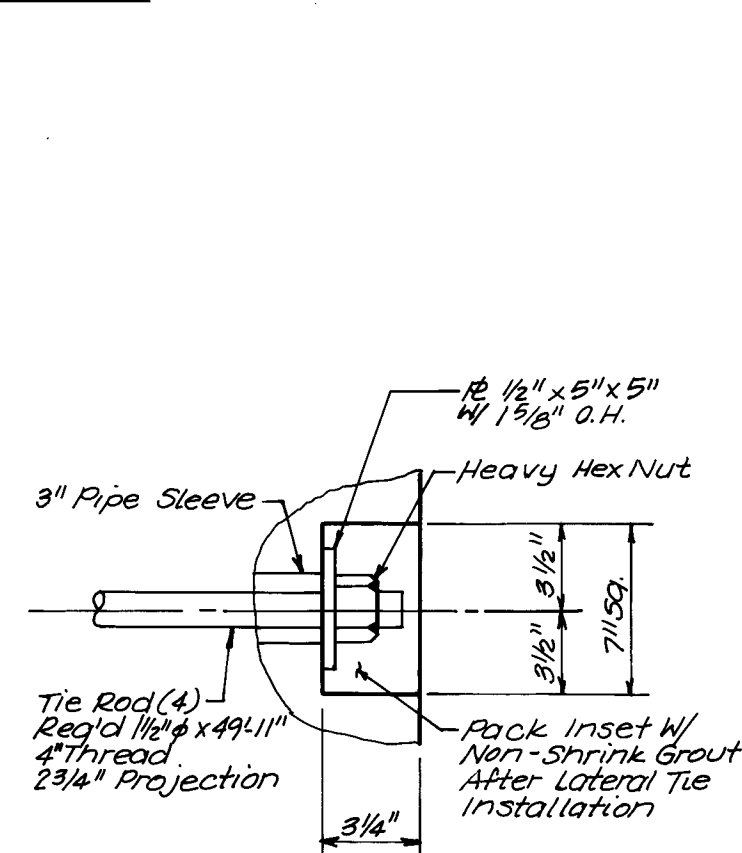


LATERAL TIE & INSET

No Scale

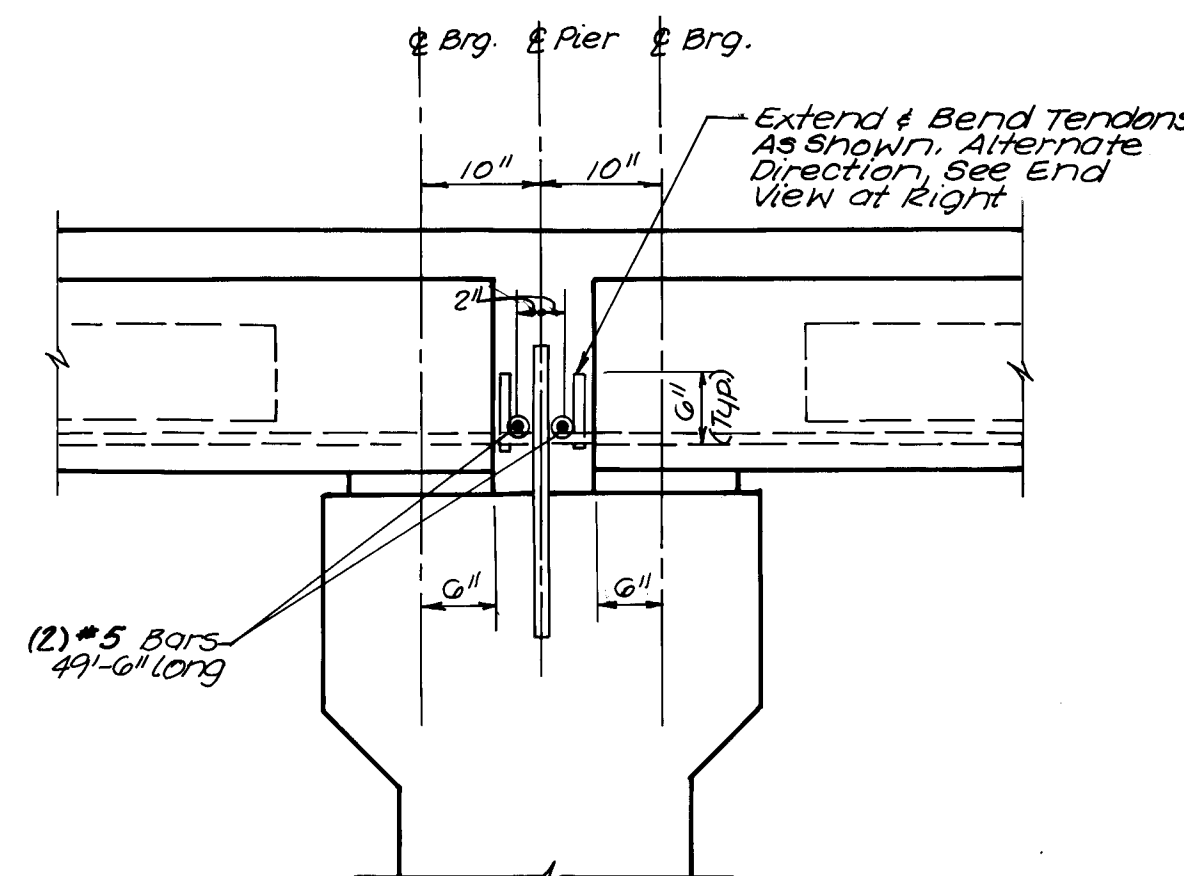

ELEVATION

No Scale

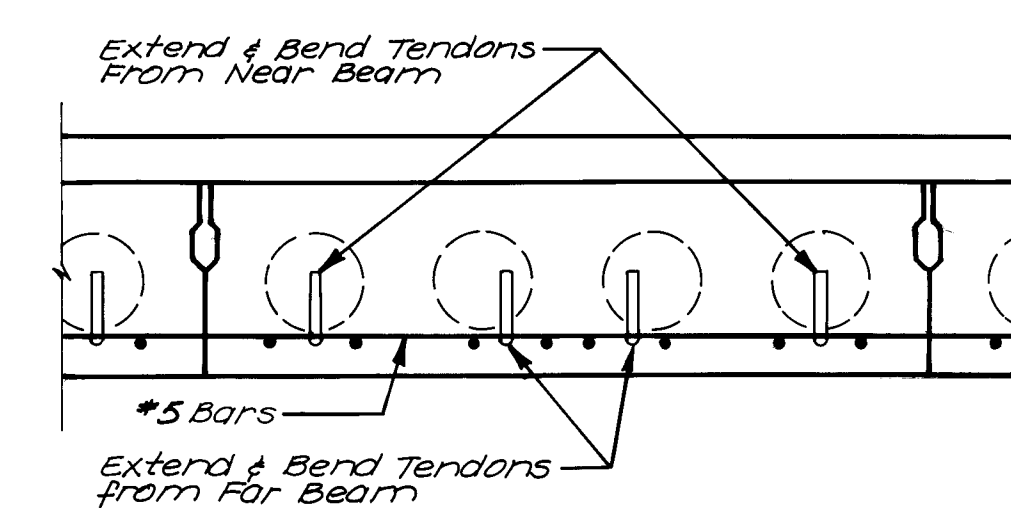

END VIEW

PIER CONNECTION DETAIL


No Scale

ESTIMATED QUANTITIES FOR ONE INTERIOR BEAM AND BEAM DATA							
BEAM TYPE	CONCRETE	REINFORCING STEEL	EMBEDDED STRUCT. STEEL	WEIGHT	CAMBER	DEAD LOAD DEFLECTION	REMARKS
10" x 60"	6.9 CY	238 LBS	1582 LBS	102 LB	1/4"	1/4"	

(16) - Required

REINFORCING STEEL REQUIRED FOR ONE INTERIOR BEAM				
BAR	TYPE	SIZE	LENGTH	NUMBER
451	1	4	34'-8"	16
452	2	4	6'-8"	148
453	3	4	5'-7"	148

(16) Required

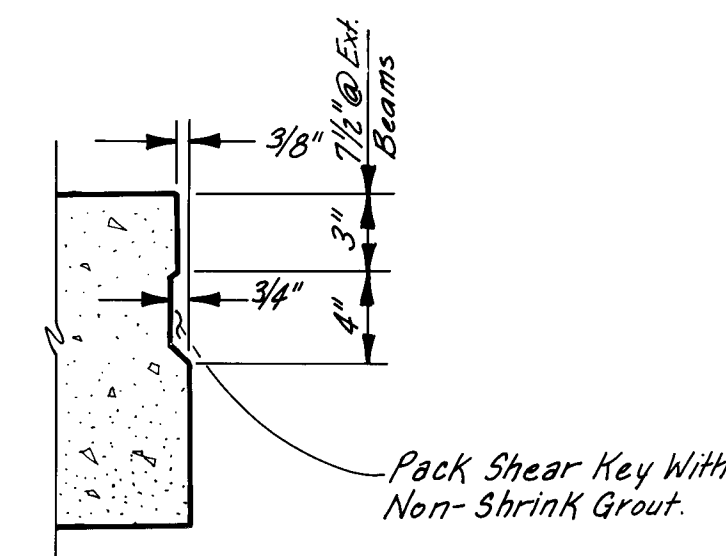

SHEAR KEY DETAIL

I HEREBY CERTIFY THAT THIS PROJECT WAS CONSTRUCTED IN GENERAL CONFORMANCE WITH THE PLANS AND SPECIFICATIONS SHOWN HEREON AND THAT THESE DRAWINGS HAVE BEEN REVISED IN ACCORDANCE WITH INFORMATION PROVIDED BY THE CITY OF ALBUQUERQUE PUBLIC WORKS DEPARTMENT.

James V. Domenick
JAMES V. DOMENICK, P.E. No. 7643
DATE 6/10/91

SCANNED BY LASON

24 40381291

CITY OF ALBUQUERQUE
PUBLIC WORKS DEPARTMENT
ENGINEERING GROUP

TITLE: TESUQUE DRIVE AT MARIPOSA ARROYO SUPERSTRUCTURE BEAM DETAILS					
APPROVALS	ENGINEER	DATE	APPROVALS	ENGINEER	DATE
D.R.C. Chair	<i>R. W. Kane</i>	11-1-90	Water	<i>R. W. Kane</i>	10-19-90
Trans. Dev	<i>R. W. Kane</i>	10-19-90	Waste Water	<i>R. W. Kane</i>	10-19-90
Hydrology	<i>R. W. Kane</i>	11-01-90	Parks & Rec.	<i>R. W. Kane</i>	10-19-90
DRAWING NO.	4038	MAP NO.	D-11	SHEET	12 OF 18

RECORD DRAWING

James V. Domenick
JAMES V. DOMENICK, P.E. No. 7643

①

Length



PLAN VIEW OF PILE

ELEVATION AT ABUTMENT NO.2
NO SCALE



SECTION AT WINGWALL




AVID ENGINEERING, INC.
Civil • Structural • Transportation
6100 Seagull Street NE • Suite 102
Albuquerque, NM 87109 • (505) 881-5357


TITLE: **TESUQUE DRIVE AT MARIPOSA ARROYO
ABUTMENT & WINGWALL DETAILS**

DRAWING NO.	4038	MAP NO.	D-II	SHEET	13	OF	18
-------------	------	---------	------	-------	----	----	----


RECORD DRAWING

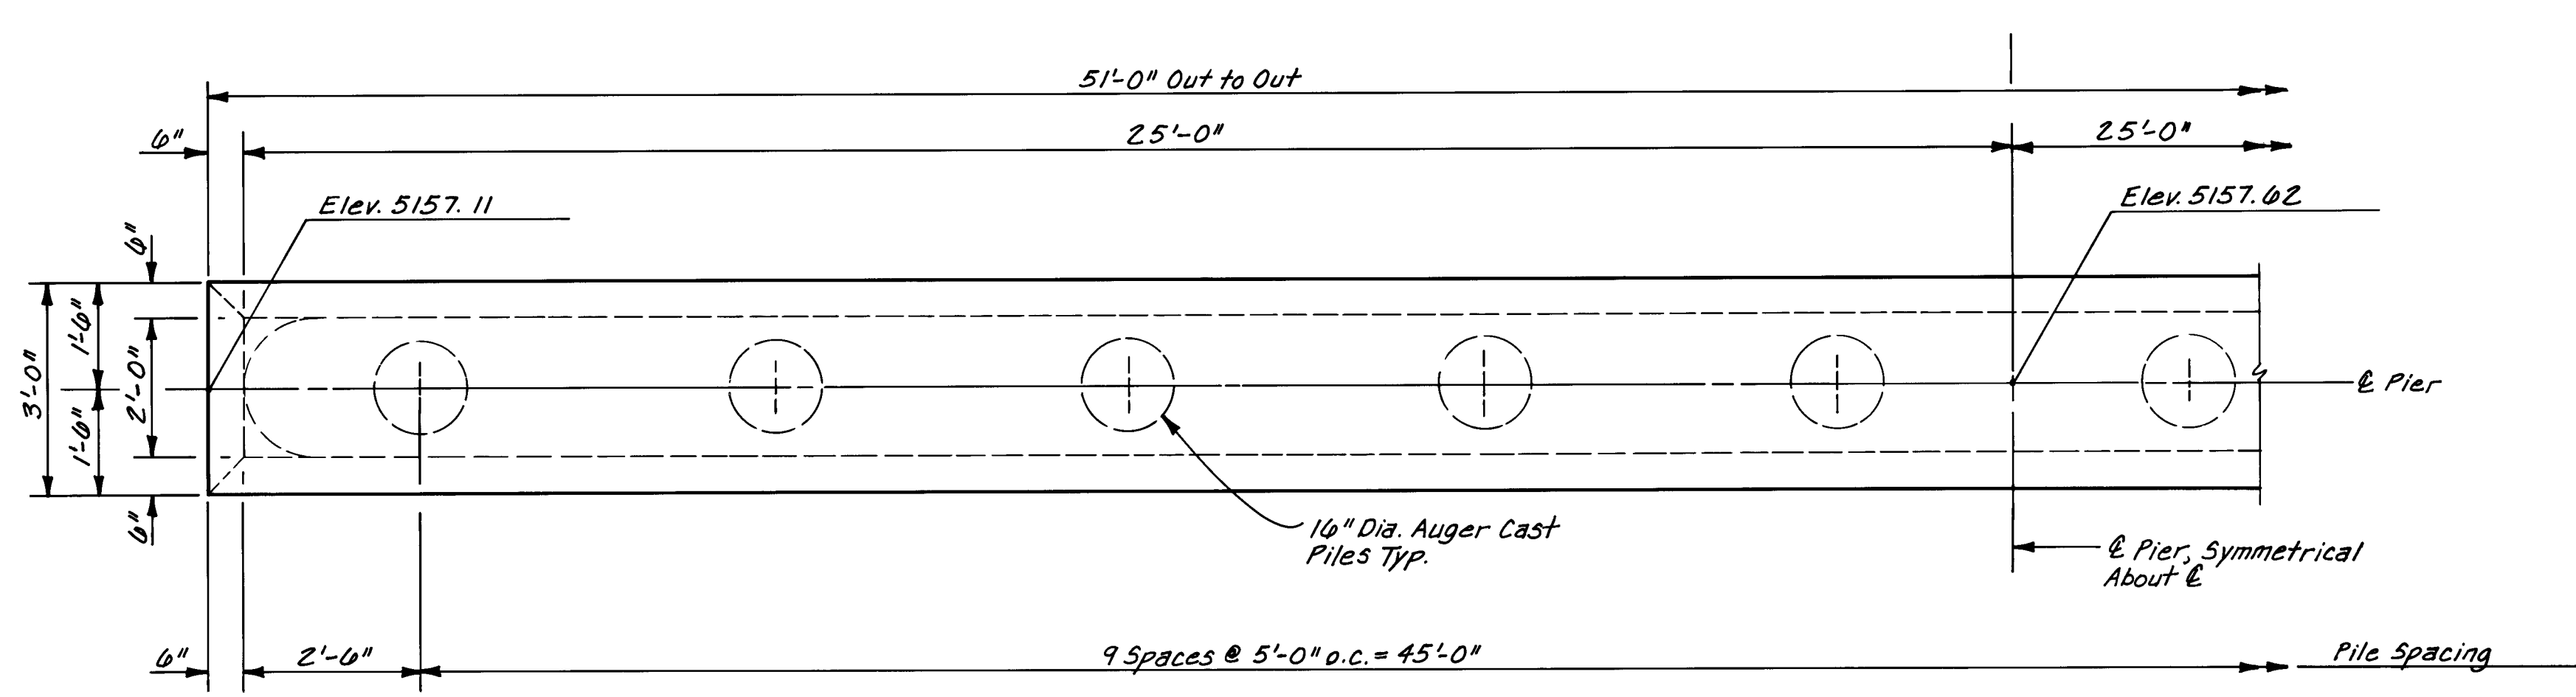


PIER PLAN

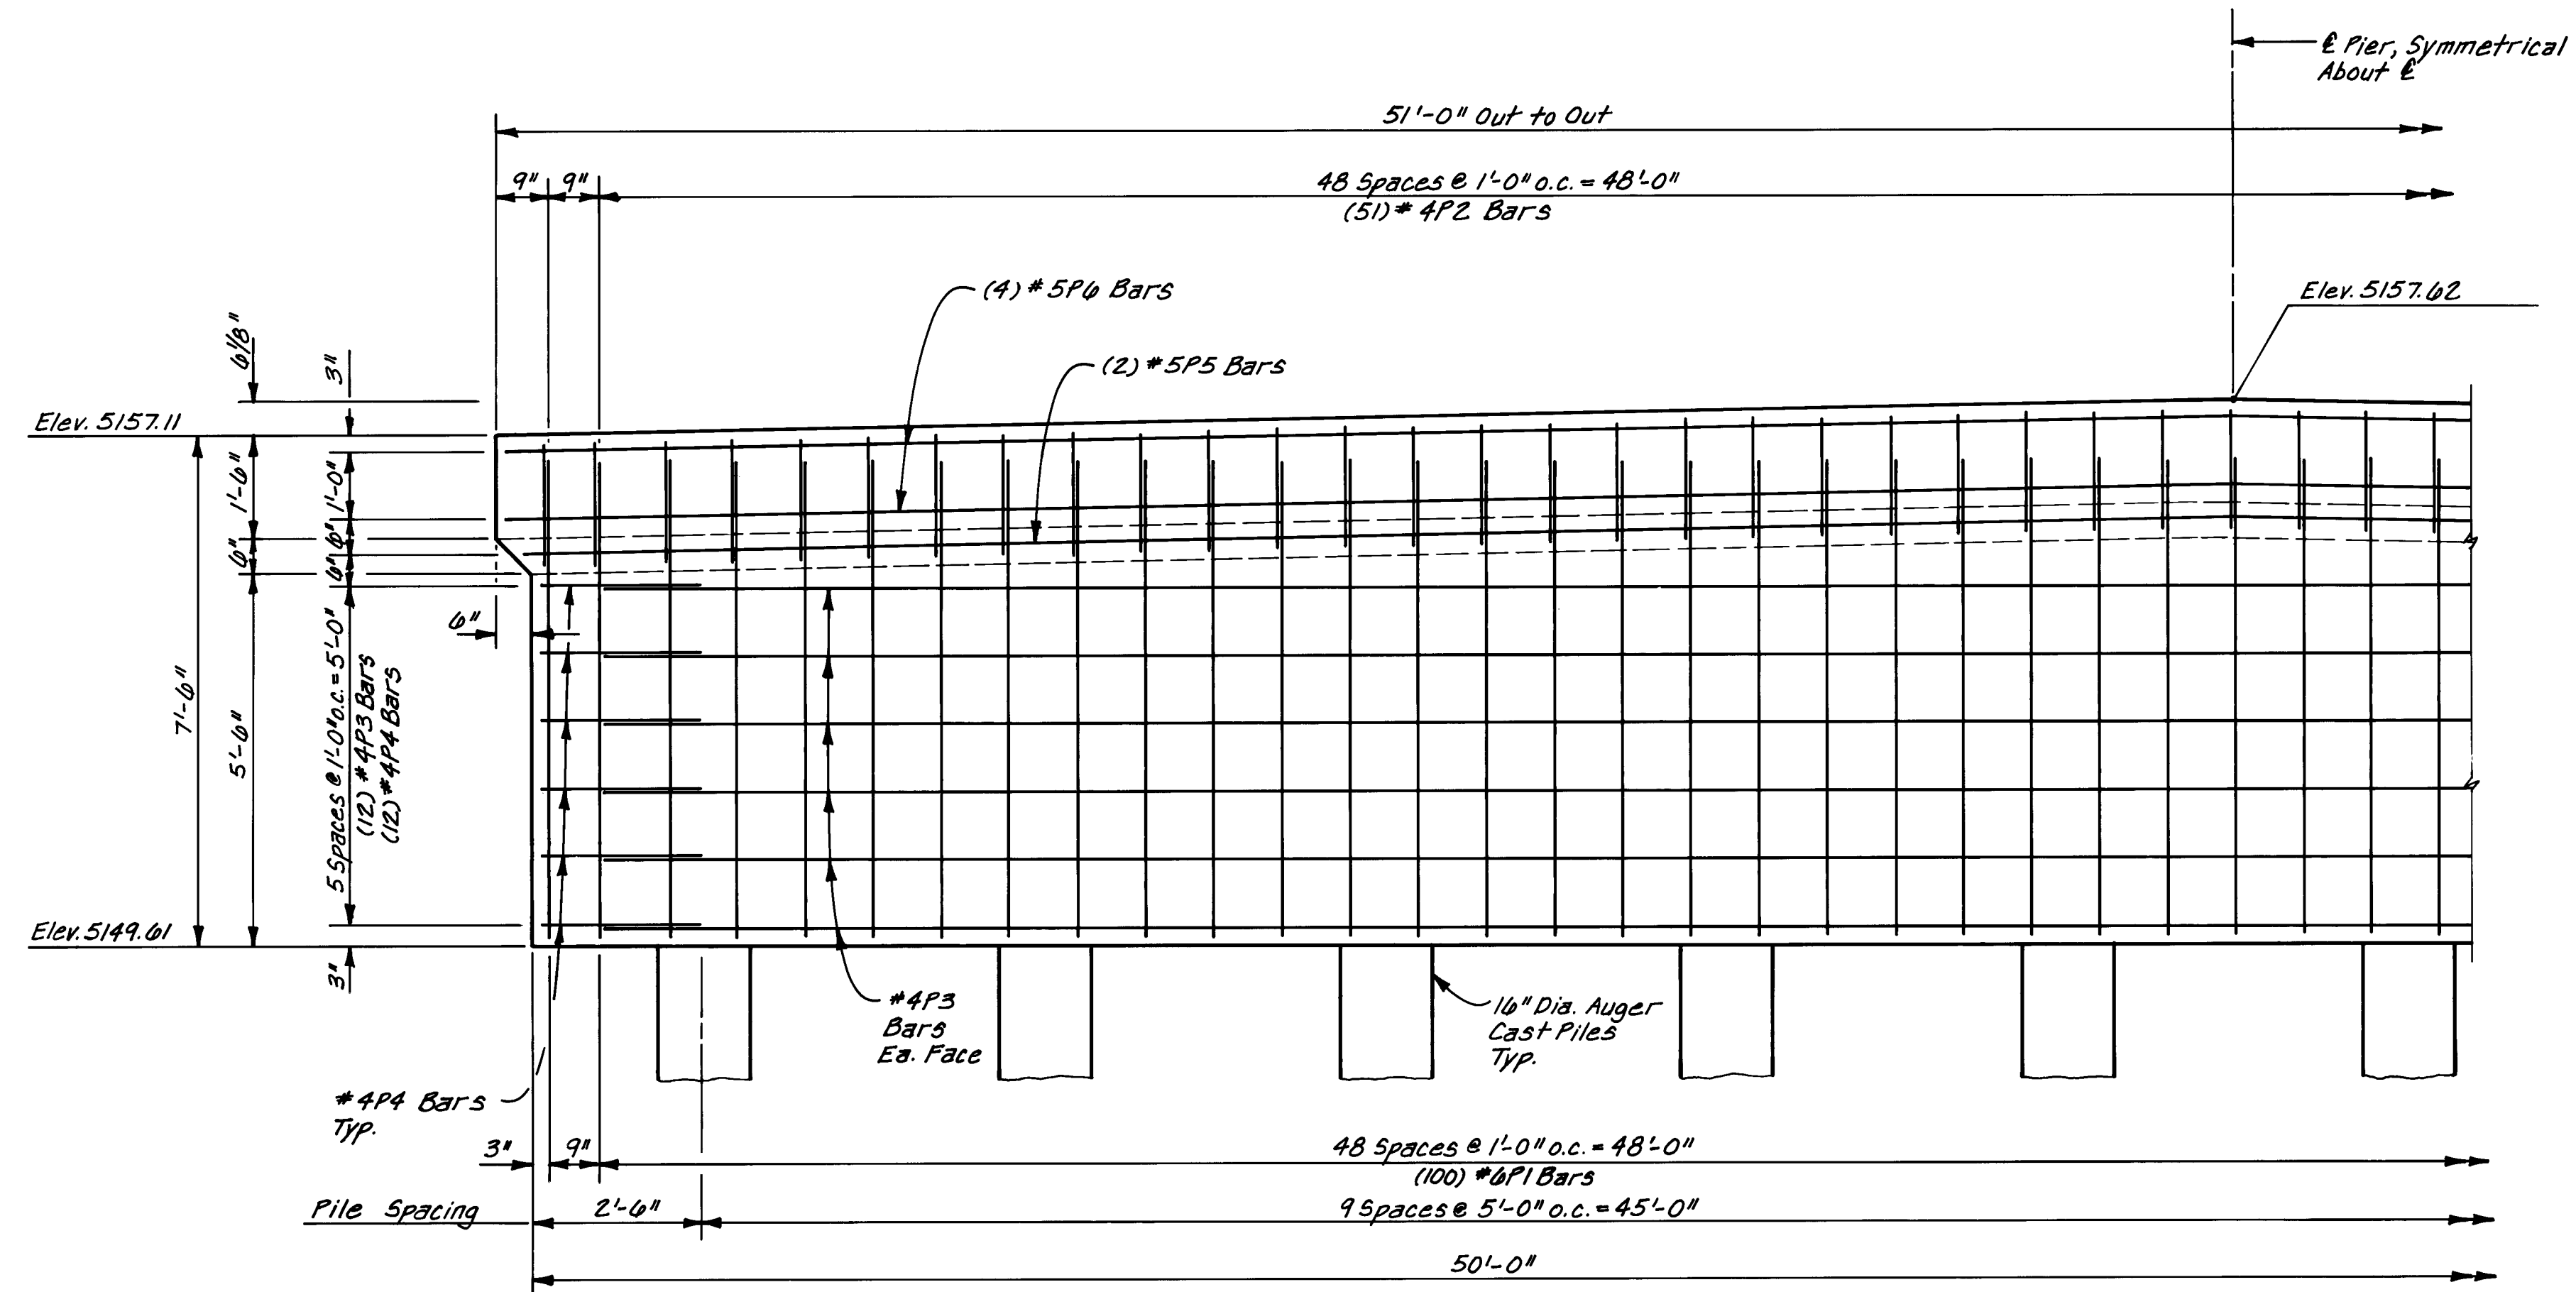


PIER ELEVATION

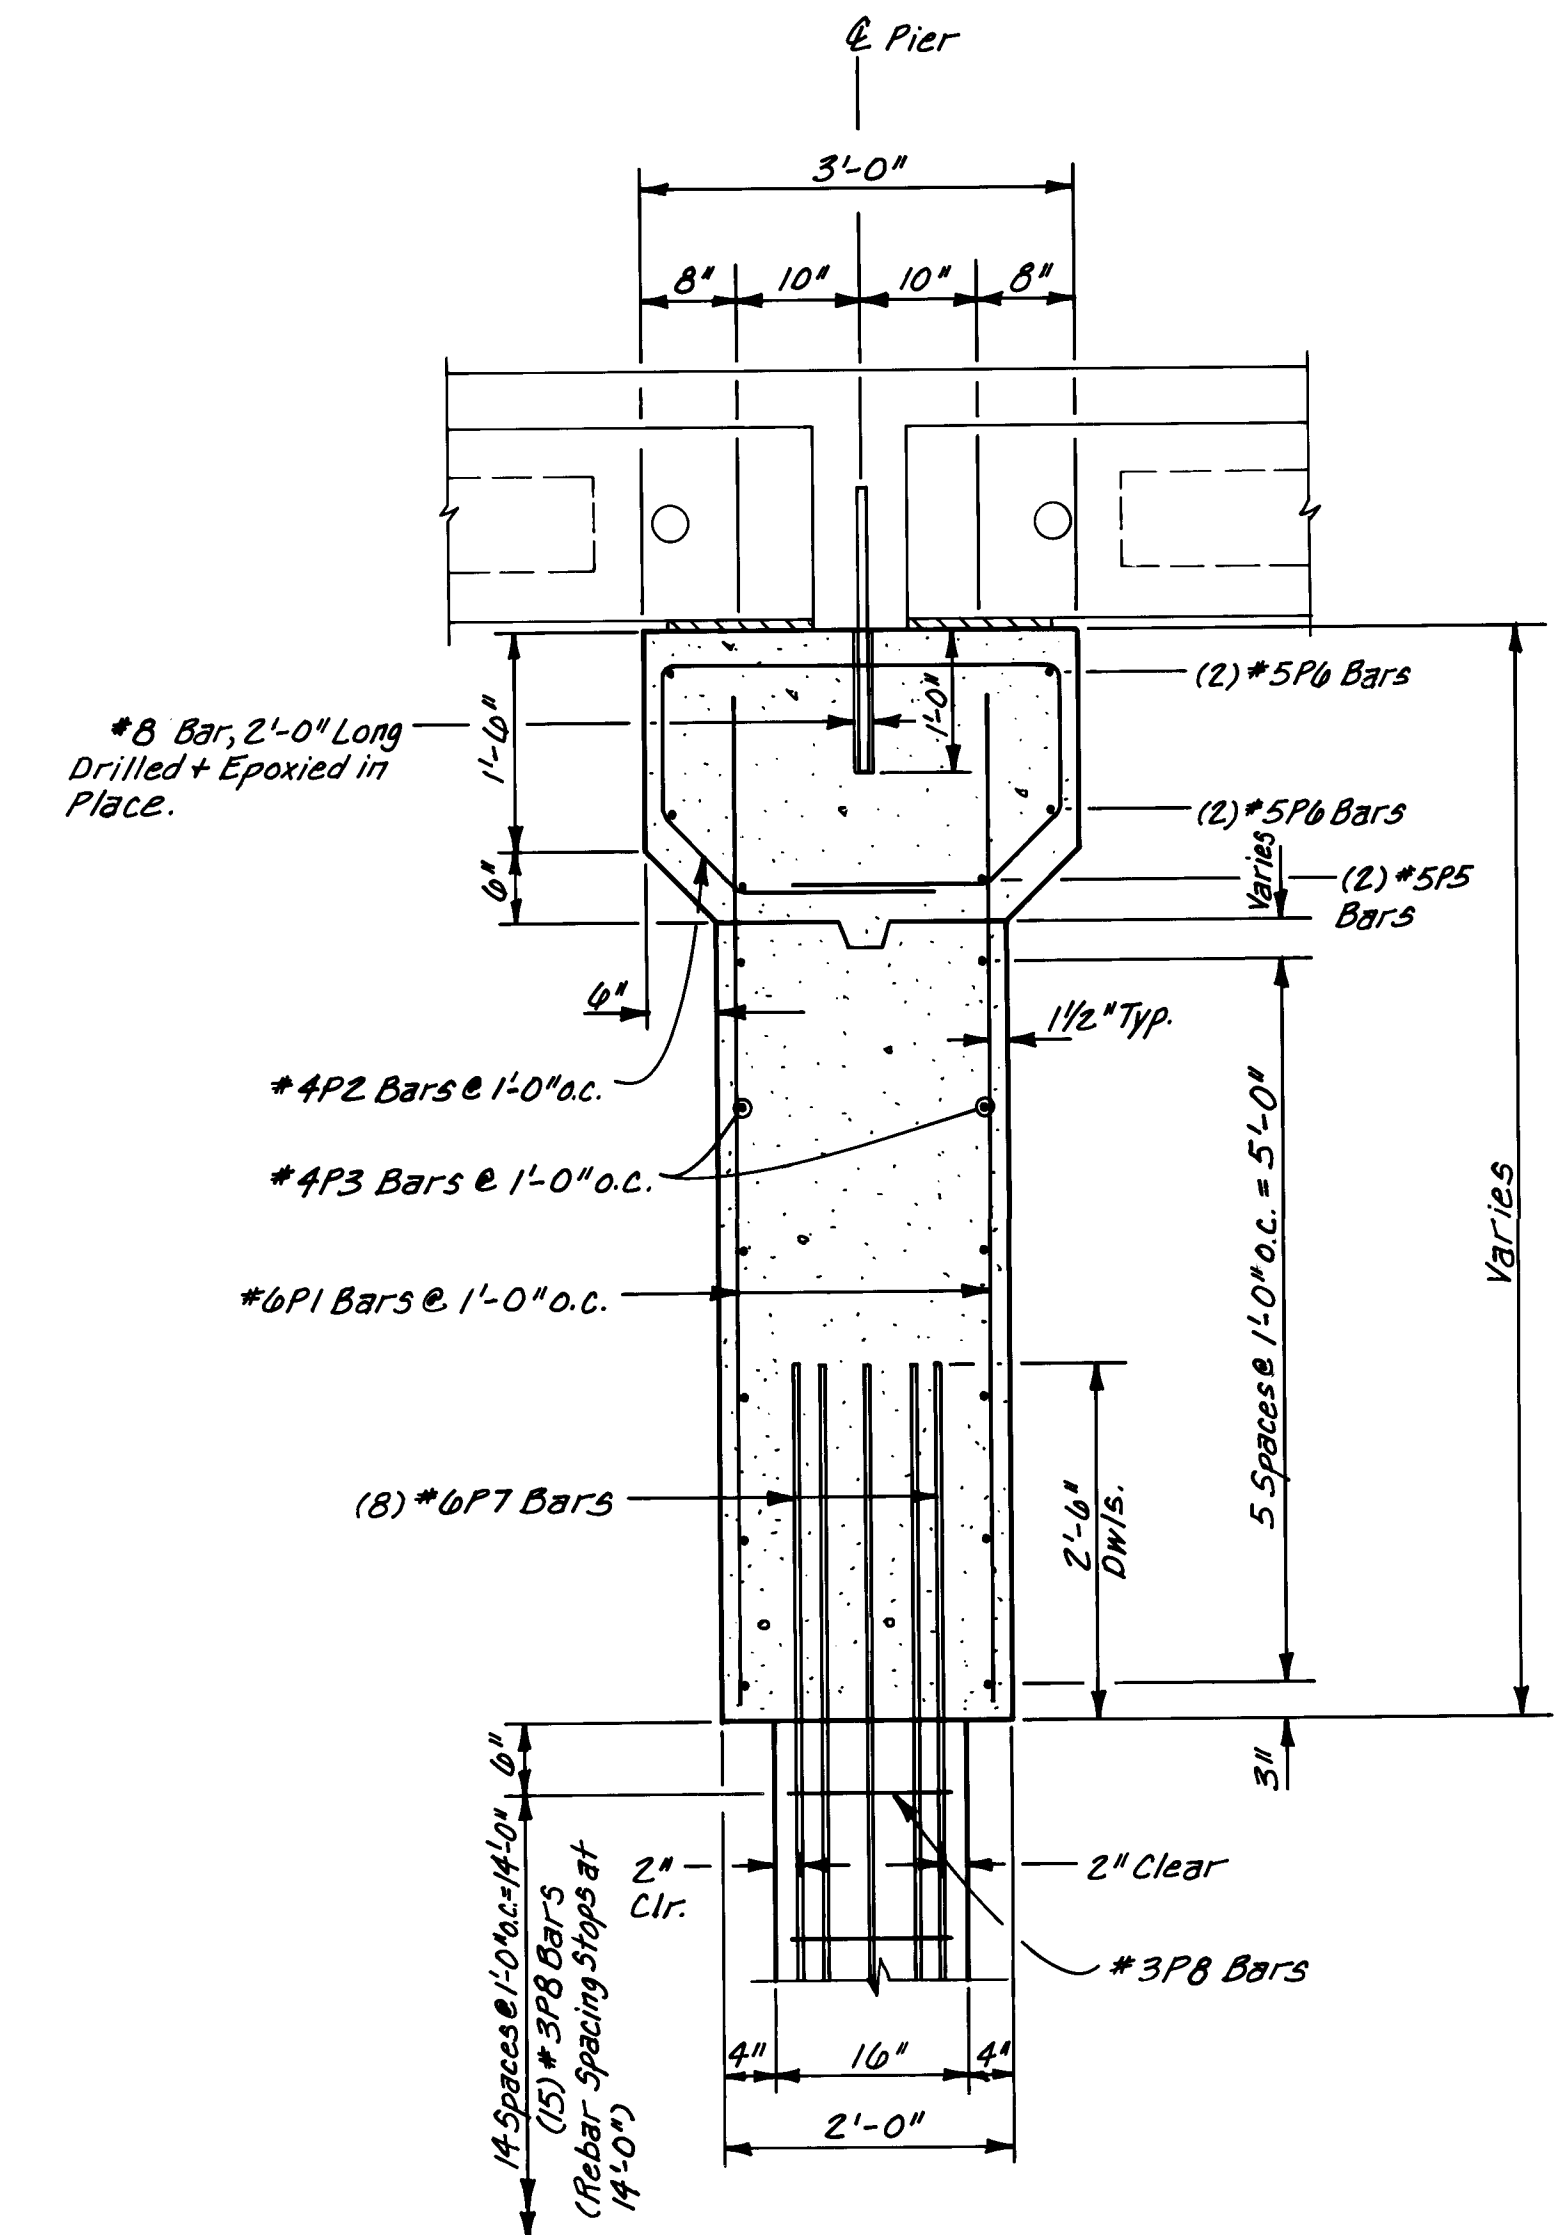

SECTION AT PIER

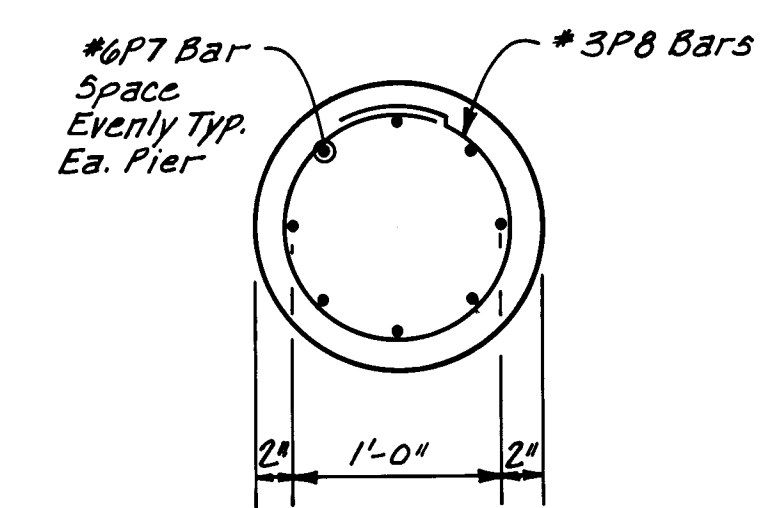

PLAN VIEW OF PILE

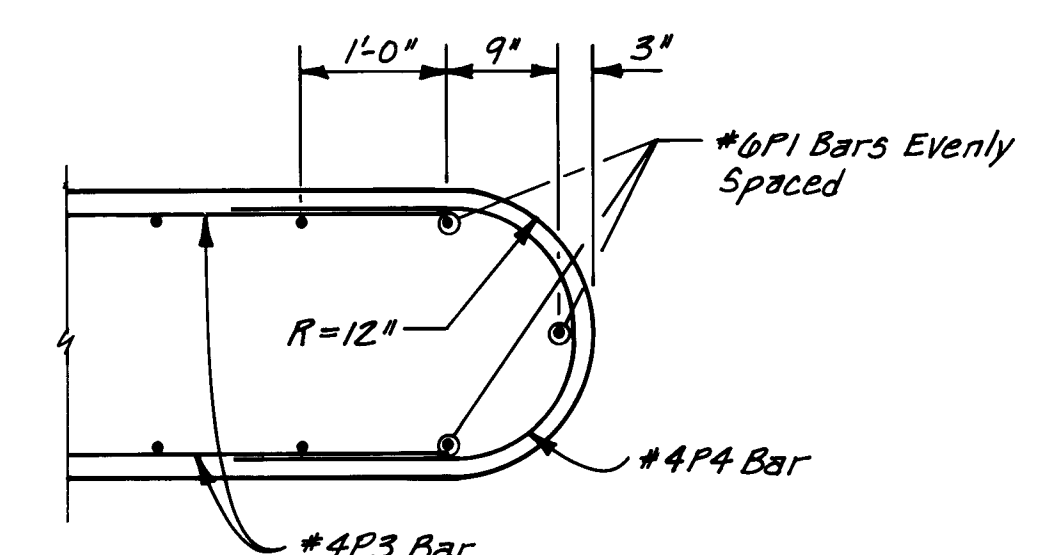

DETAIL "A"

REINFORCING STEEL FOR PIER


REGULAR GRADE 60 BARS				
BAR	TYPE	SIZE	LENGTH	NO. REQ'D
#6P1	1	6	7'-0"	100
#4P2	2	4	9'-0"	51
#4P3	1	4	48'-0"	12
#4P4	3	4	5'-9"	12
#5P5	1	5	50'-0"	2
#5P6	1	5	50'-8"	4
#6P7	1	6	*17'-0"	80
#3P8	4	3	4'-5"	150

I HEREBY CERTIFY THAT THIS PROJECT WAS CONSTRUCTED IN GENERAL CONFORMANCE WITH THE PLANS AND SPECIFICATIONS SHOWN HEREON AND THAT THESE DRAWINGS HAVE BEEN REVISED IN ACCORDANCE WITH INFORMATION PROVIDED BY THE CITY OF ALBUQUERQUE PUBLIC WORKS DEPARTMENT.

James V. Domenick 6/10/91
JAMES V. DOMENICK, P.E. No. 7643 DATE



AVID ENGINEERING, INC.
Civil • Structural • Transportation
6100 Seagull Street NE • Suite 102
Albuquerque, NM 87109 • (505) 881-5357

CITY OF ALBUQUERQUE PUBLIC WORKS DEPARTMENT ENGINEERING GROUP				
TITLE: TESUQUE DRIVE AT MARIPOSA ARROYO PIER DETAILS				
APPROVALS	ENGINEER	DATE	APPROVALS	ENGINEER
D.R.C. Chair	<i>Randy Kane</i>	11-1-90	Water	<i>R.W. Kane</i>
Trans. Dev.	<i>R. D. Kane</i>	10-19-90	Waste Water	<i>R.W. Kane</i>
Utility Dev.	<i>M. Allen</i>	11-01-90	Parks & Rec.	<i>D. S. Kane</i>
Hydrology				
DRAWING NO.	4038	MAP NO.	D-11	SHEET OF 14 18

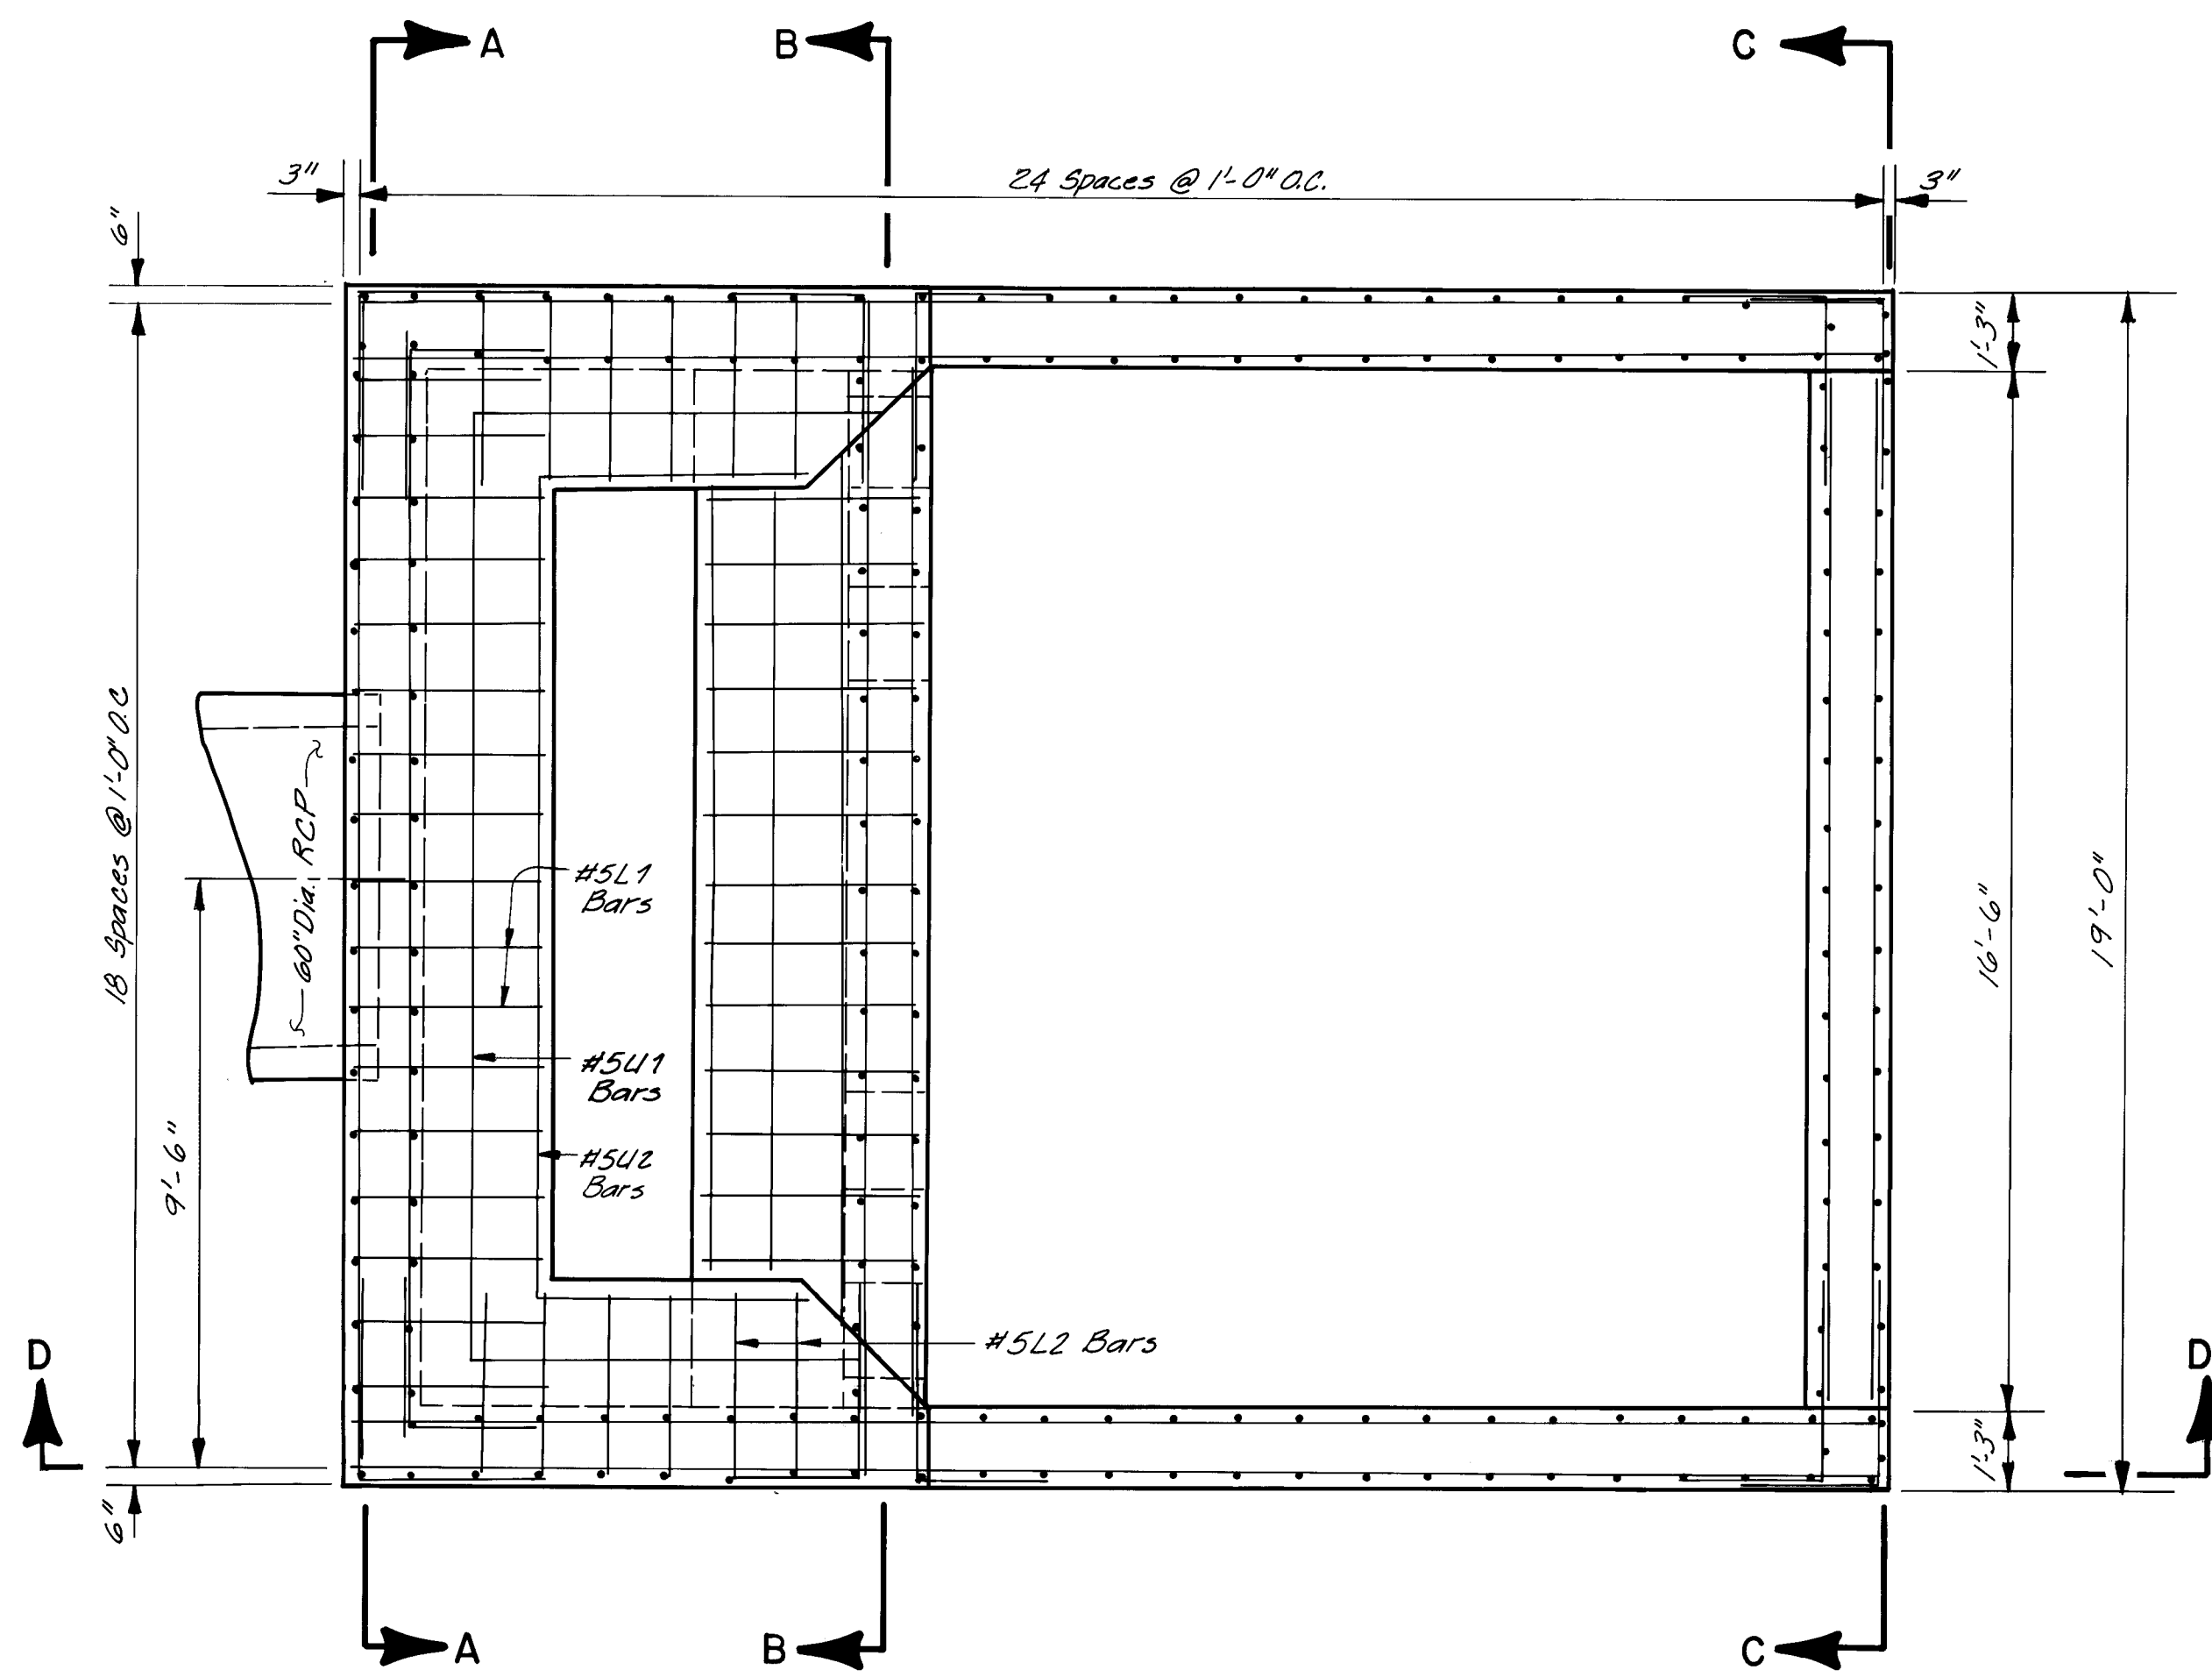


PLAN VIEW - IMPACT STILLING BASIN


BAR BENDING DIAGRAM

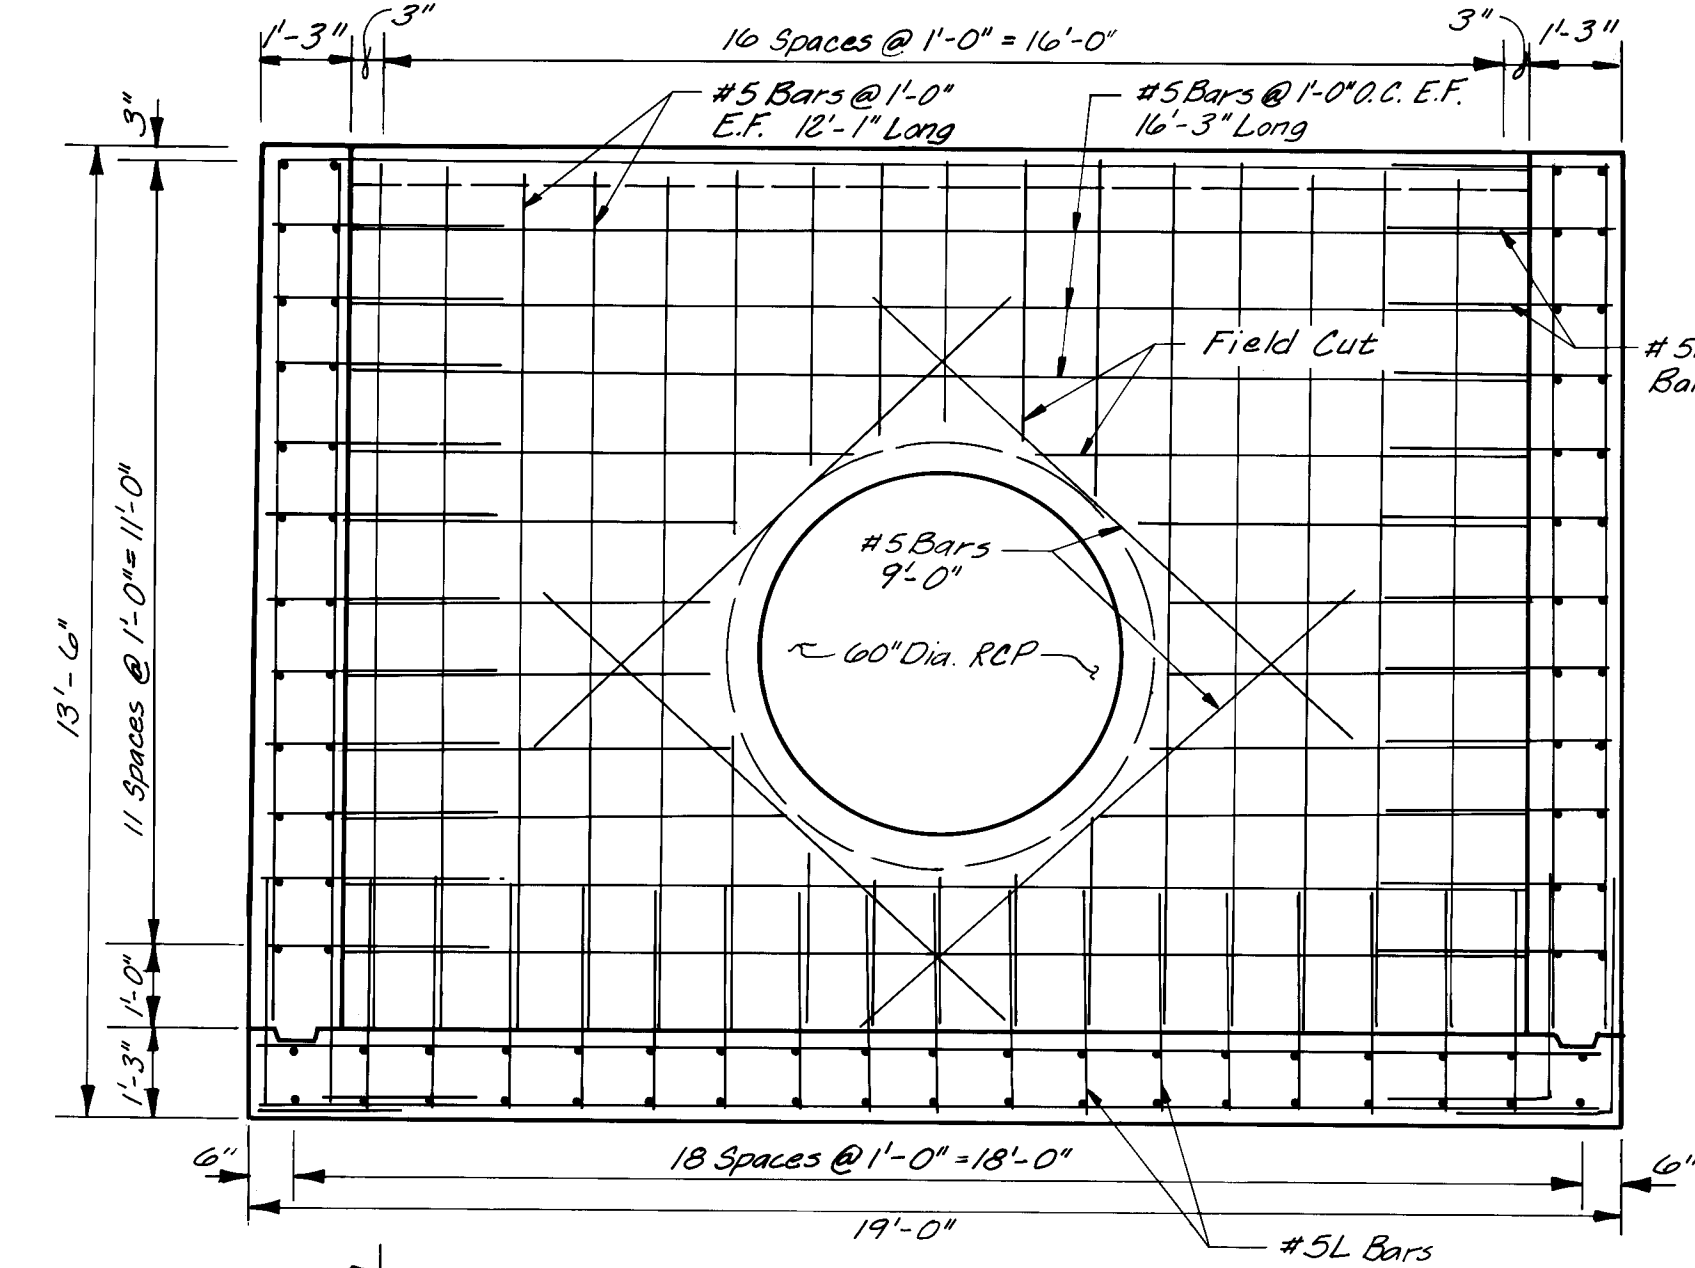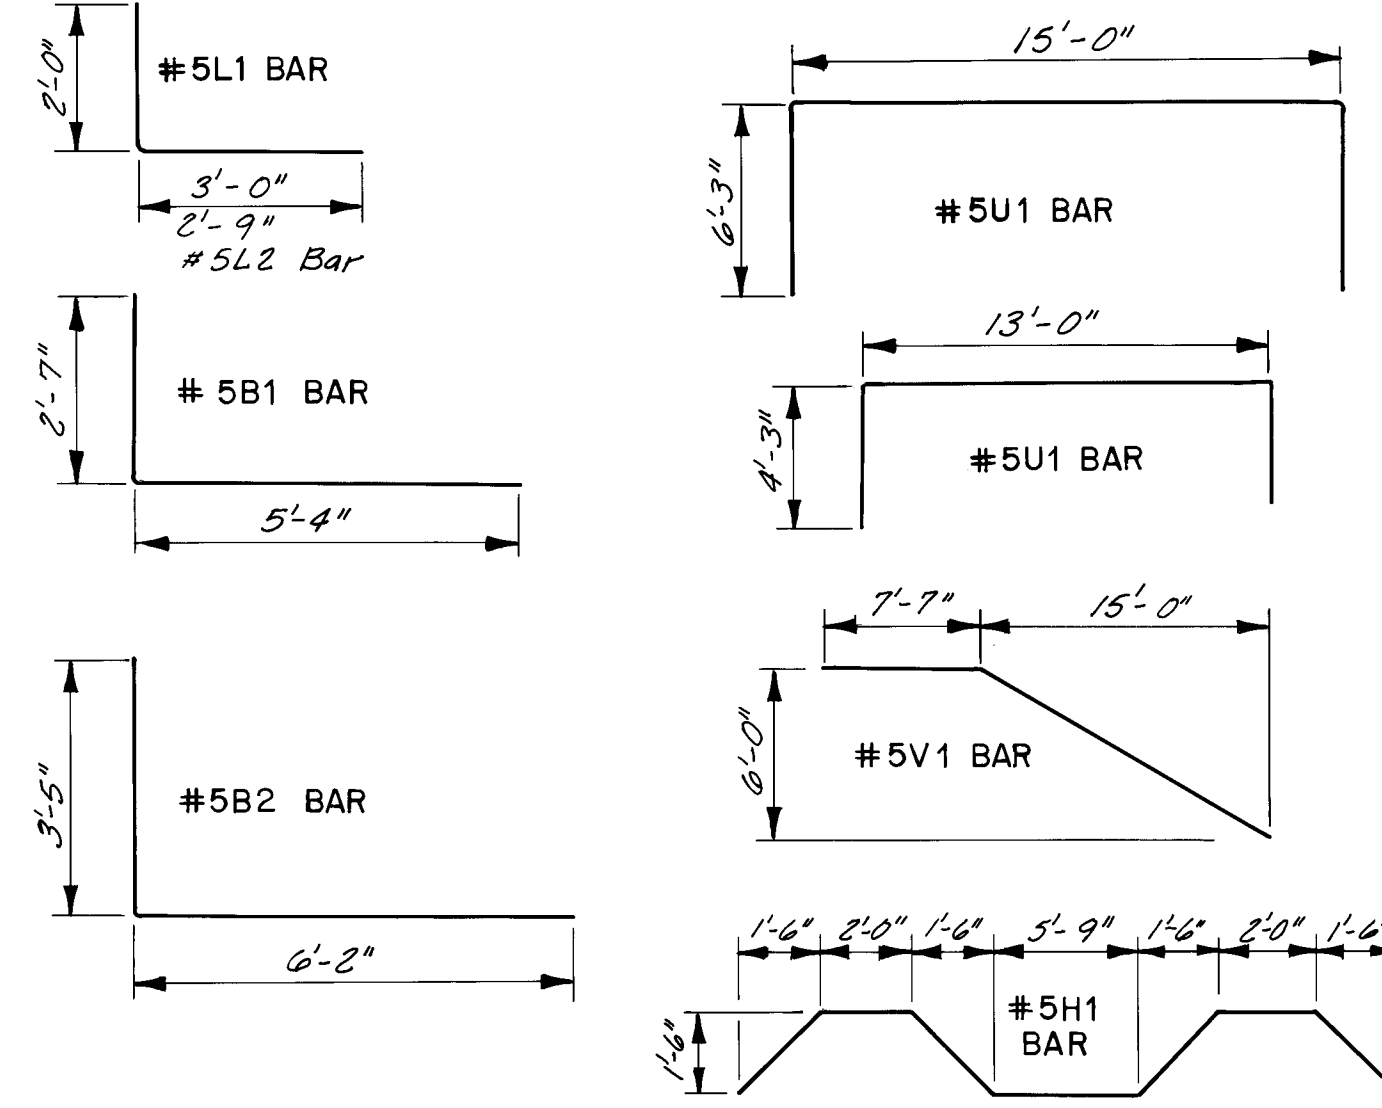


SECTION A-A

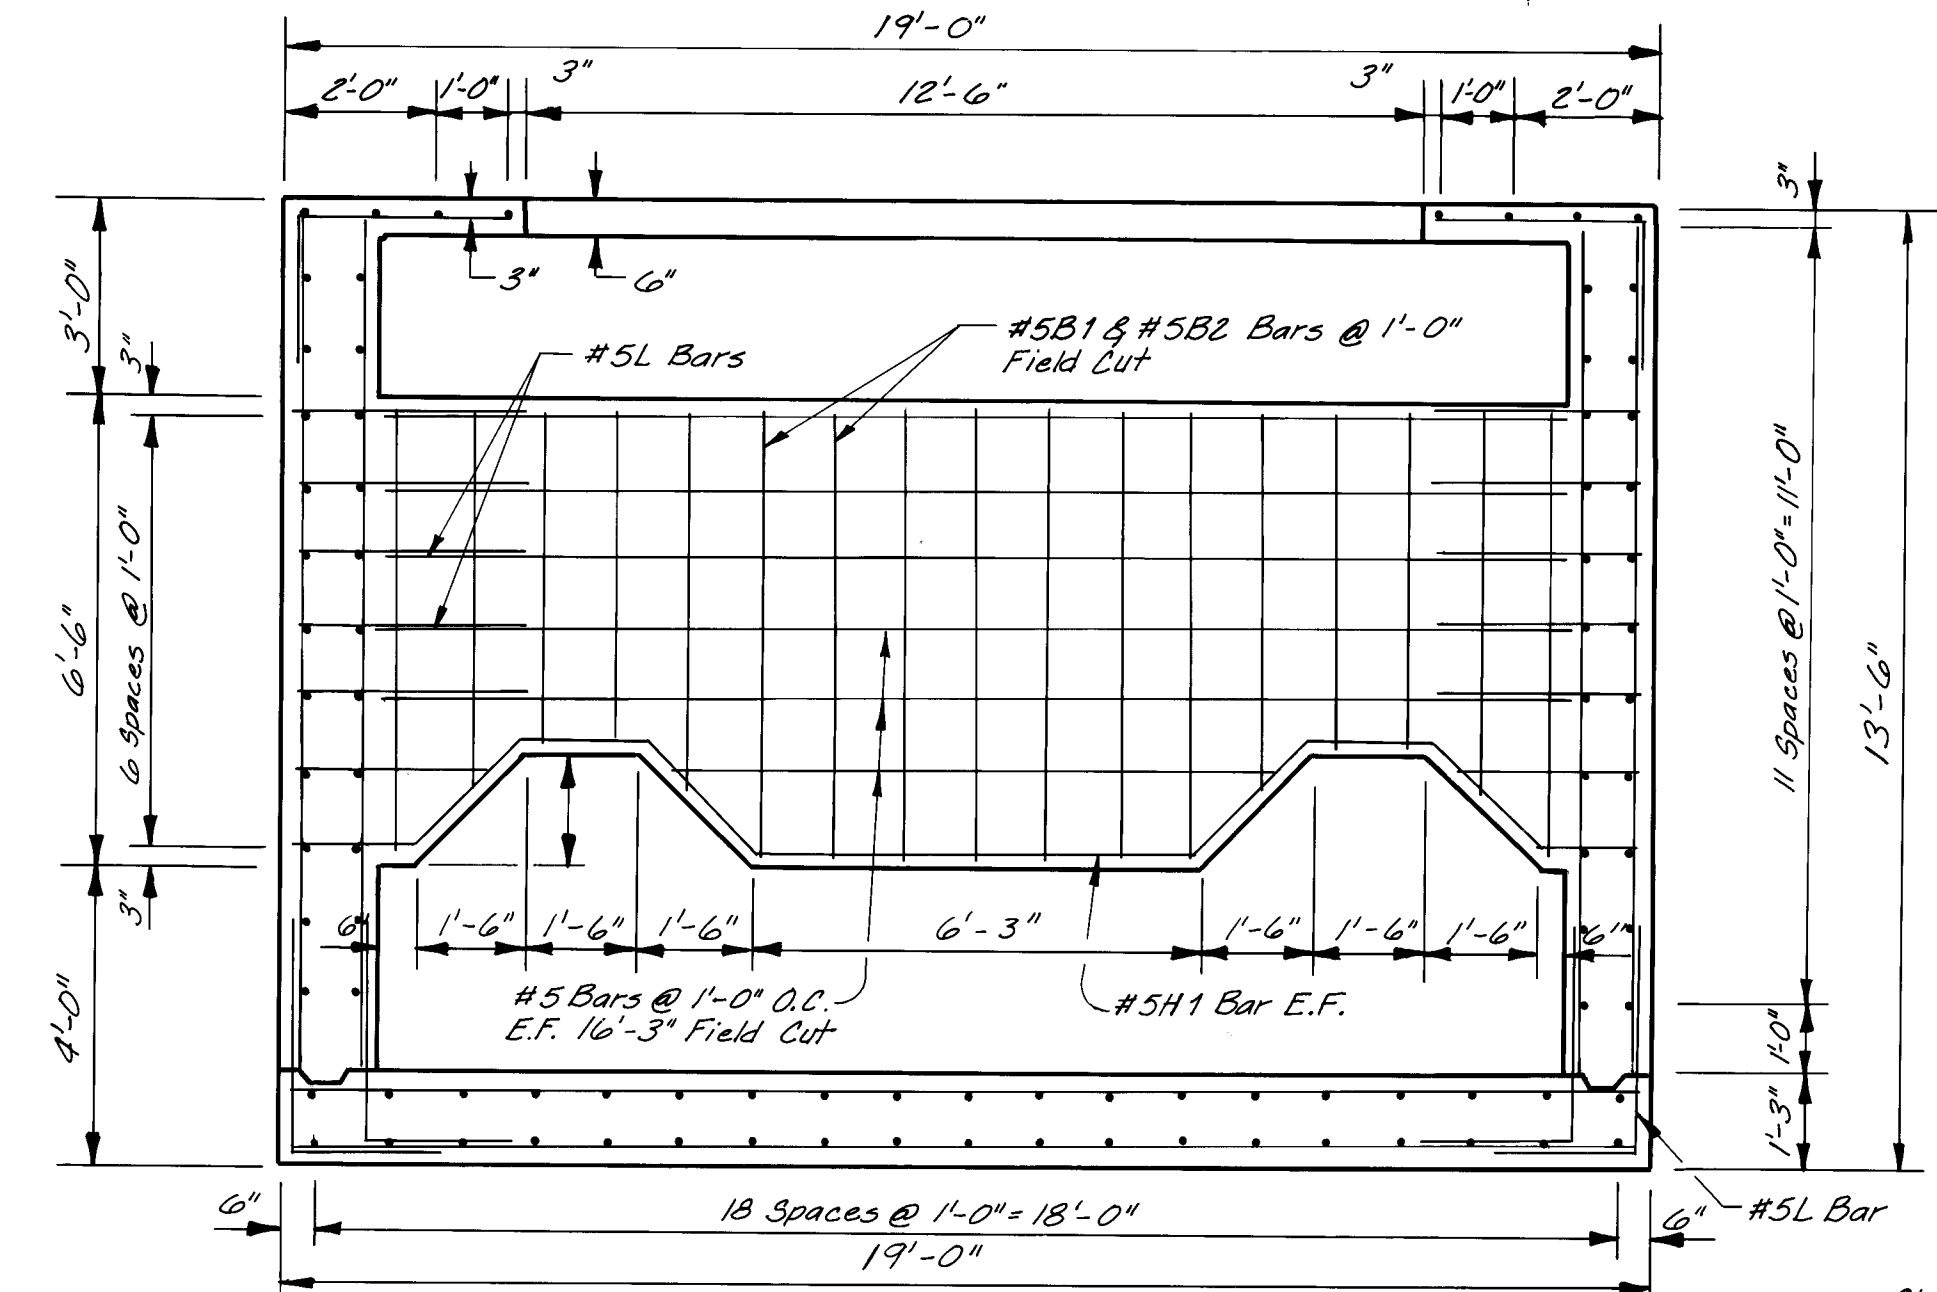


SECTION B-B

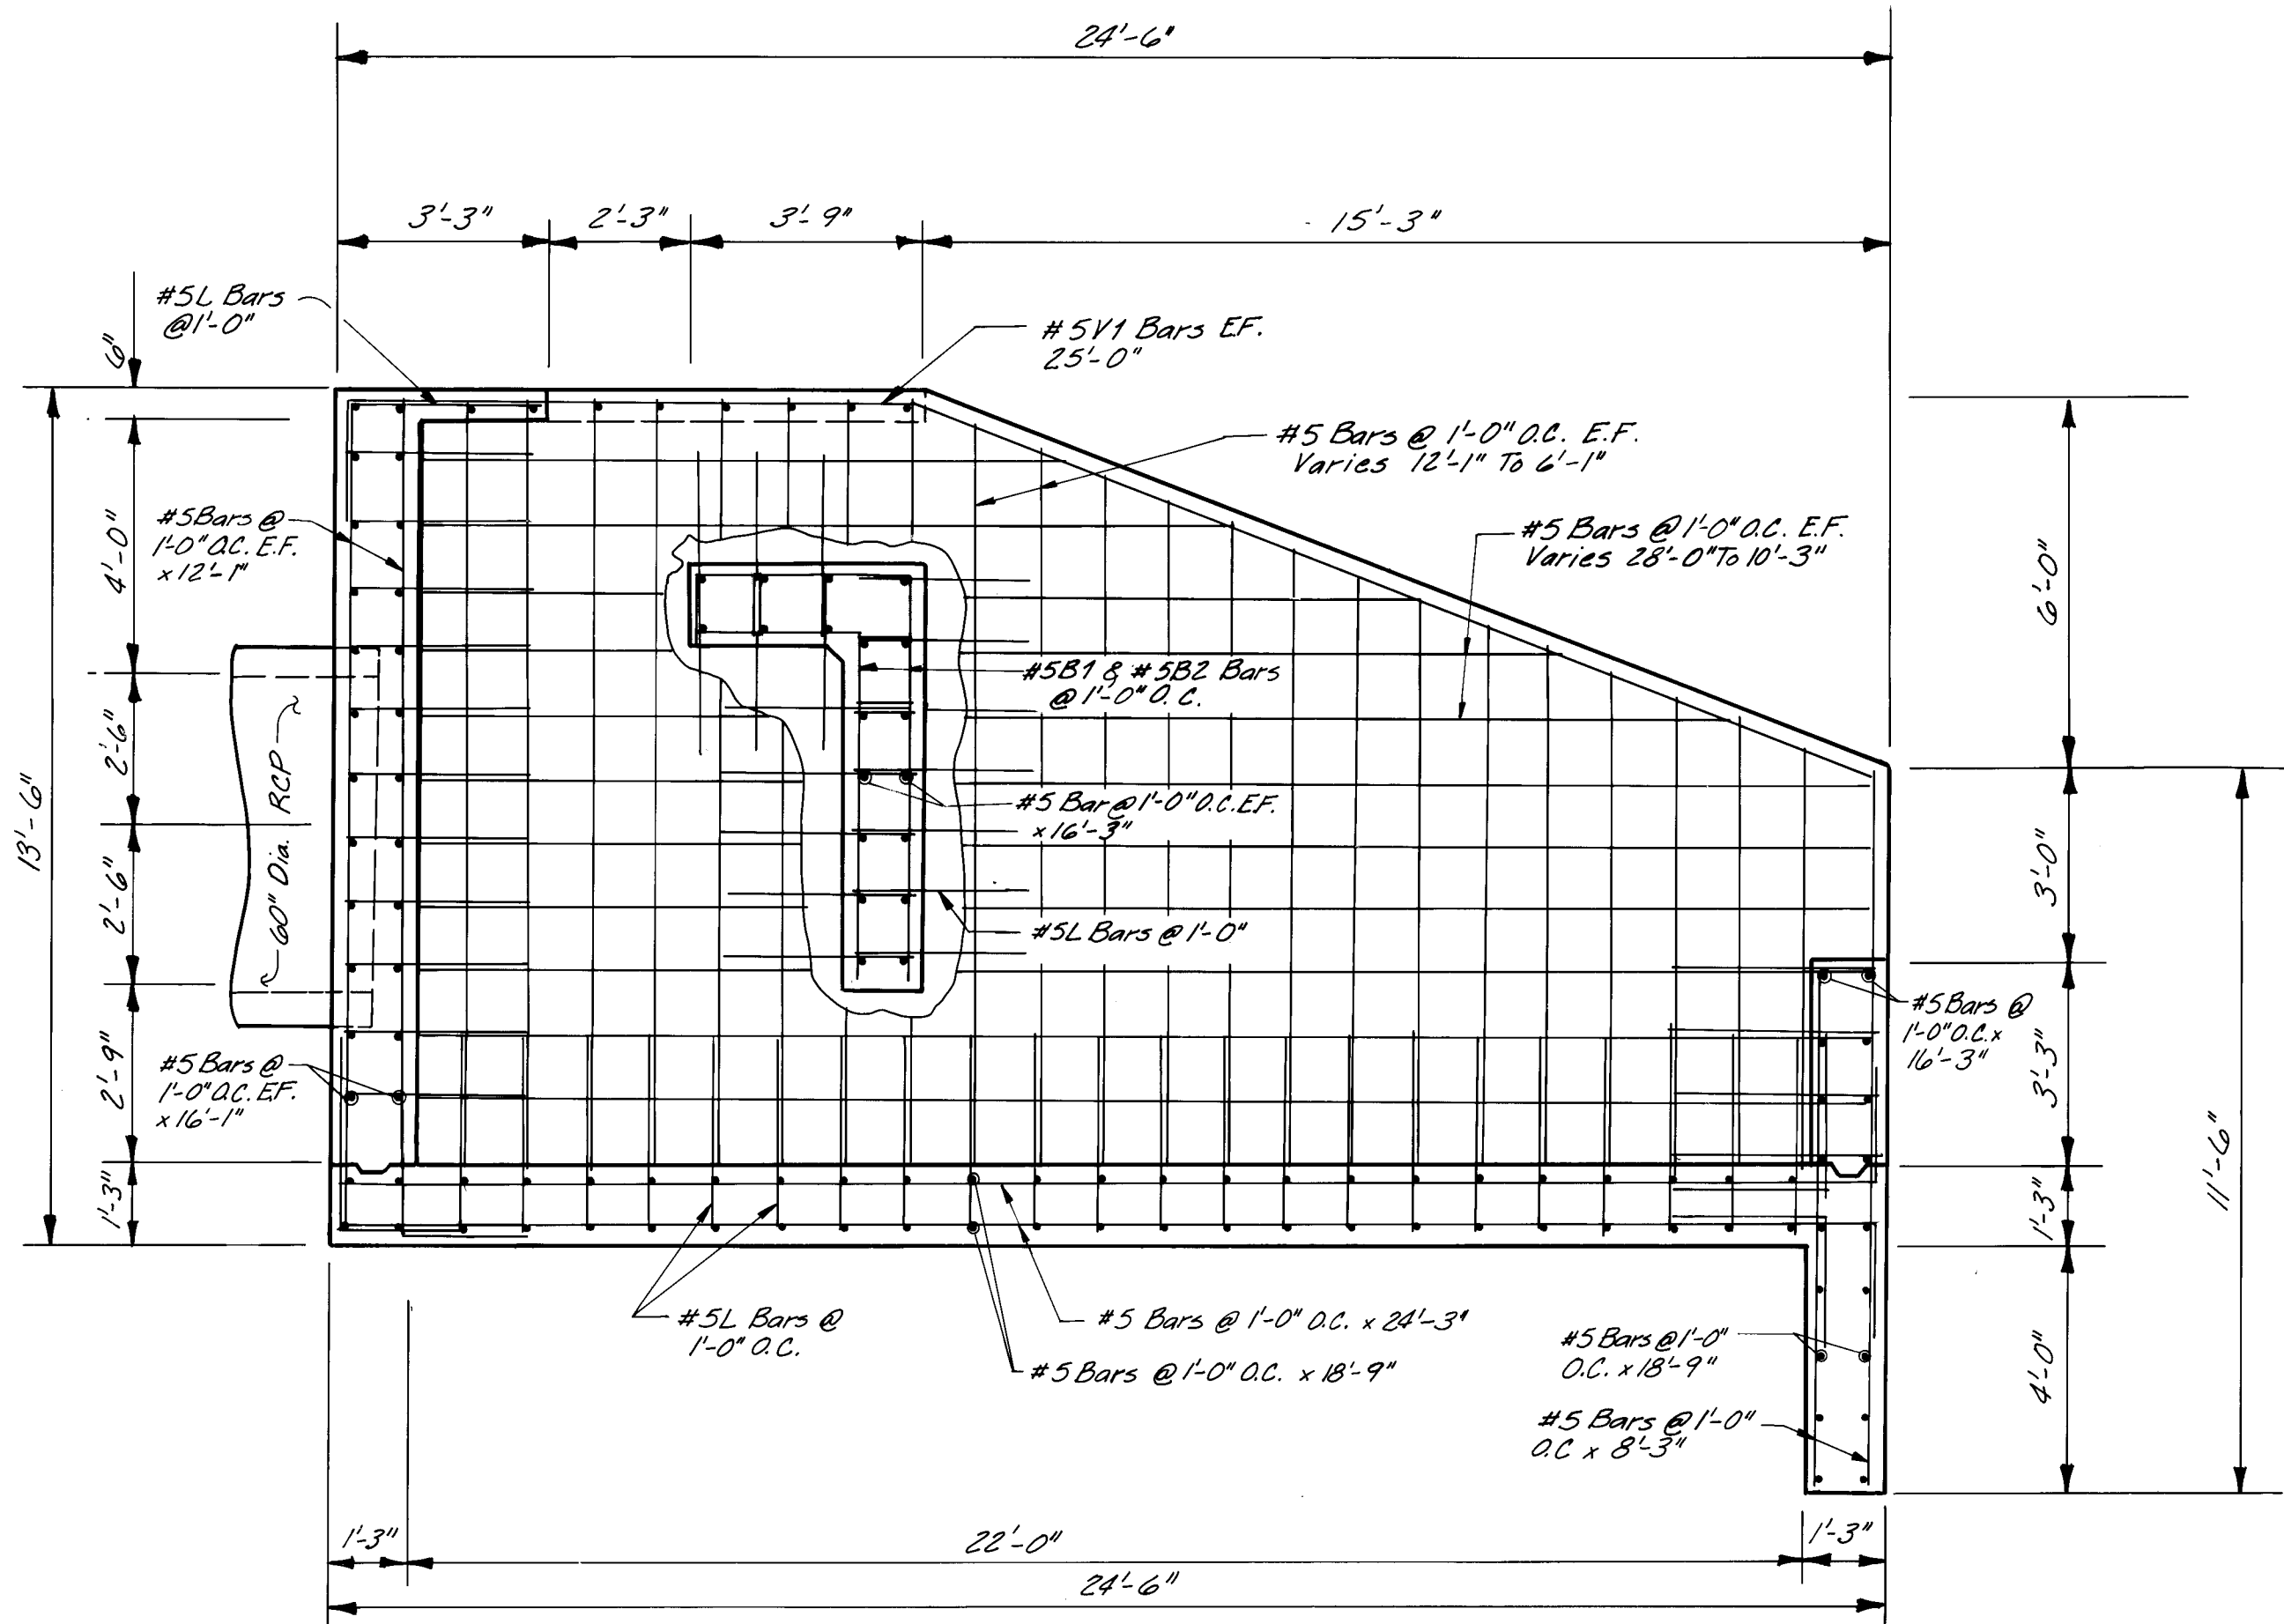

SECTION D-D

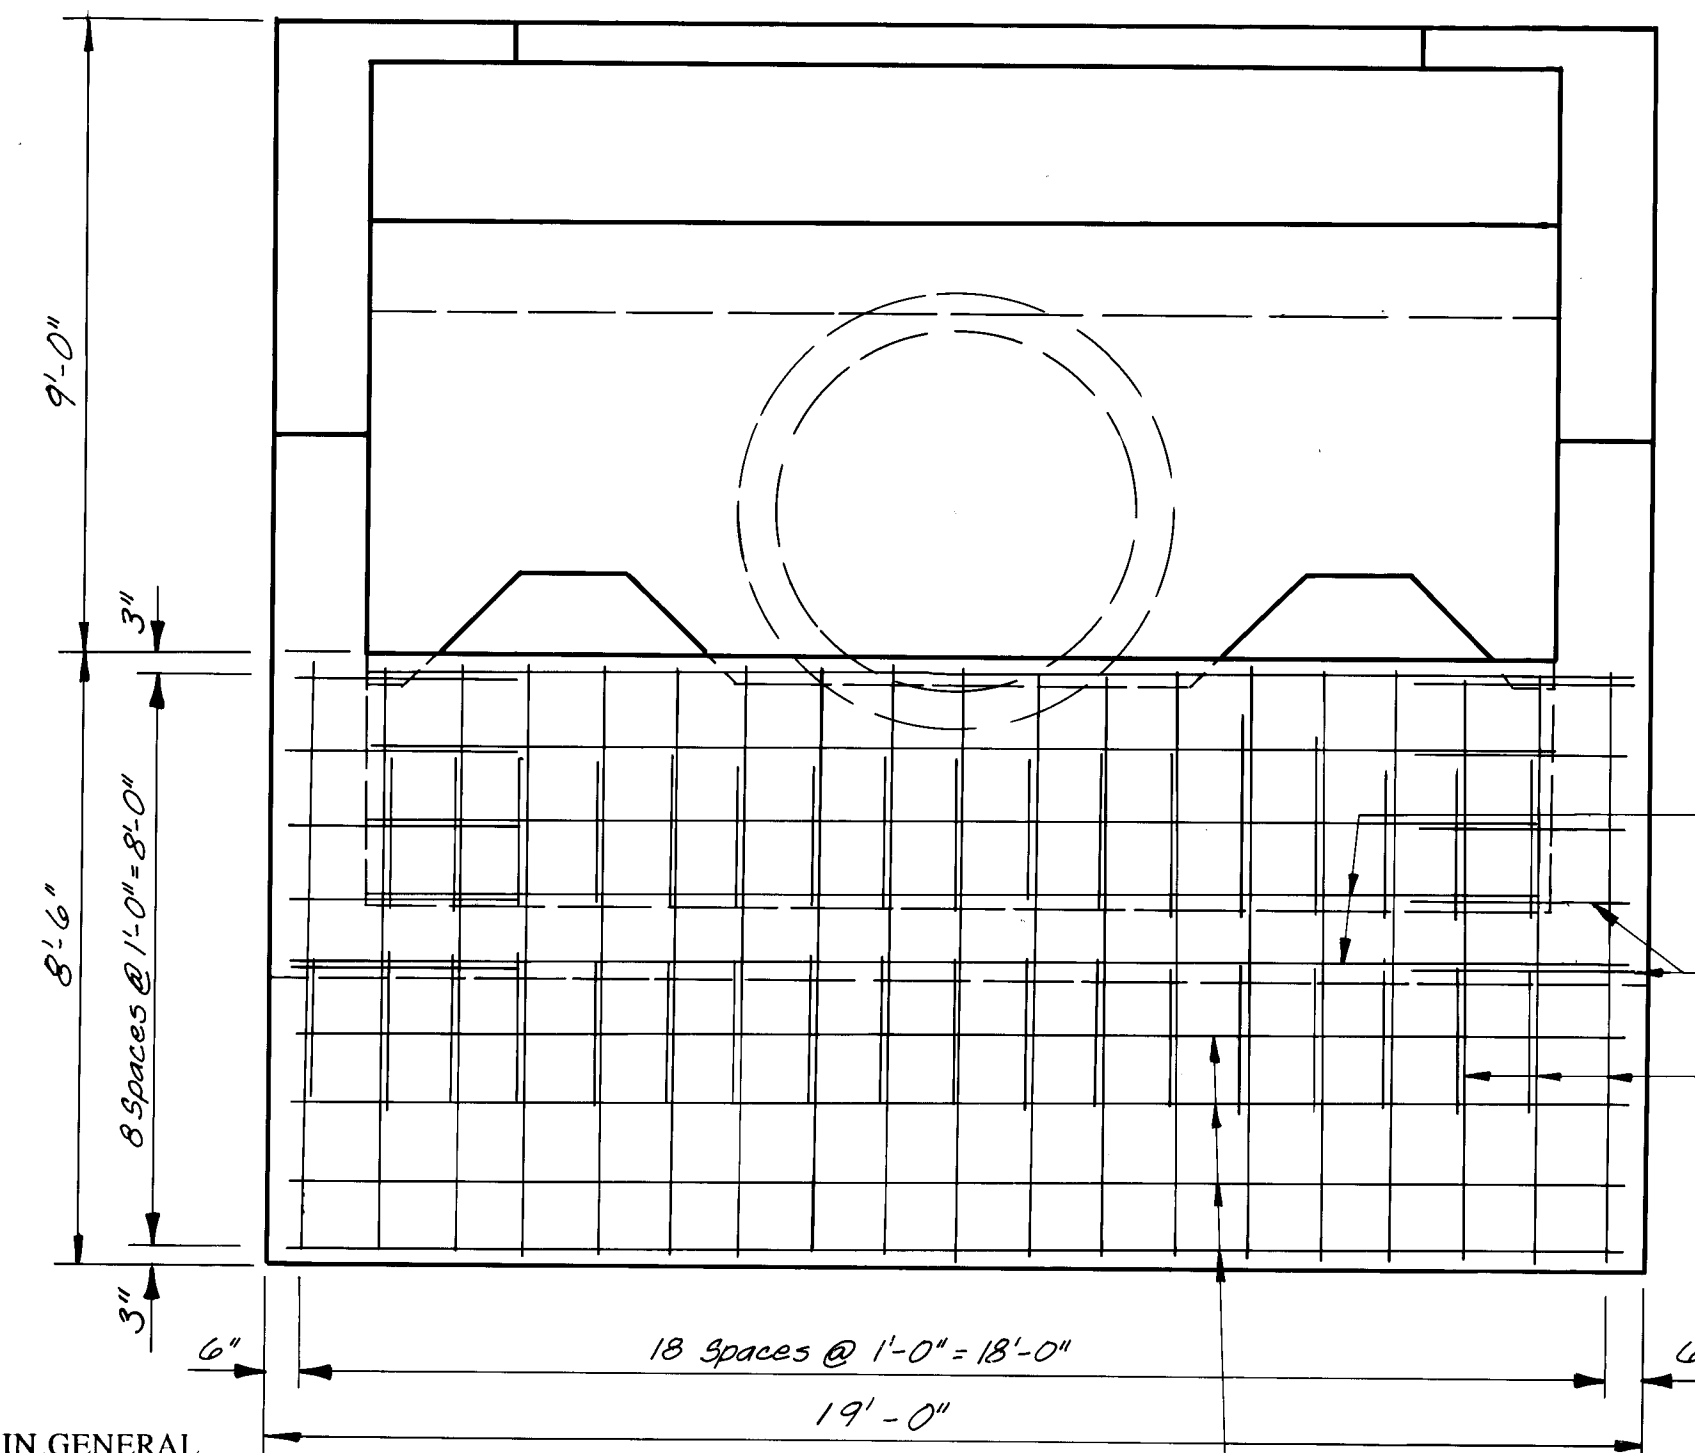

SECTION C-C

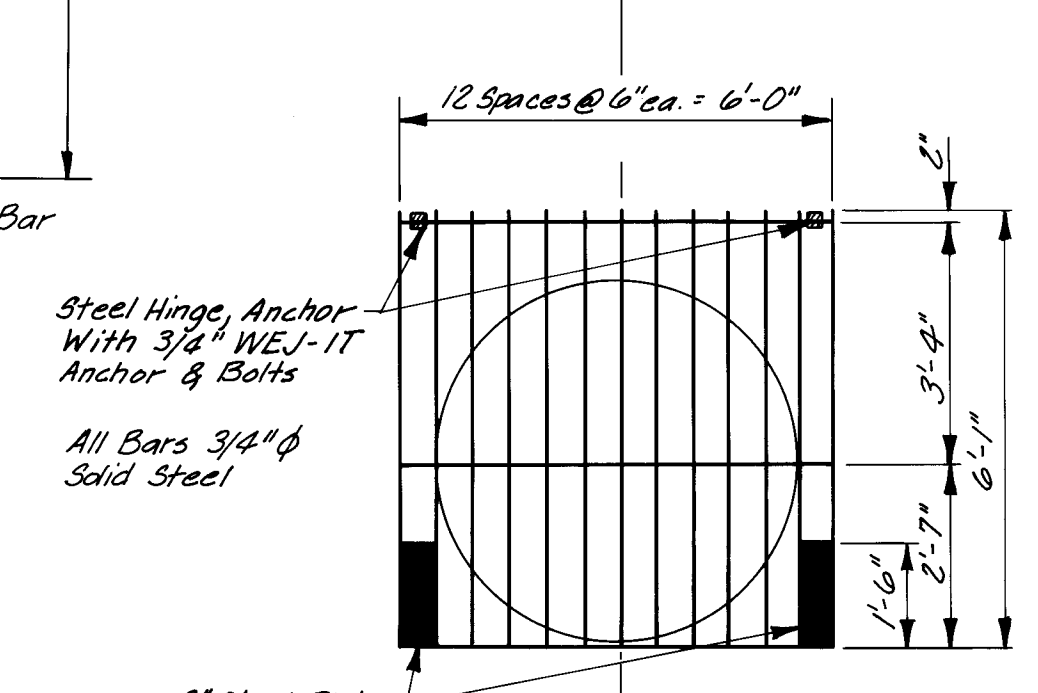

SAFETY GRATE DETAIL
Note: Cost of Grate is Incidental To The Concrete.

AVID ENGINEERING, INC.
Civil • Structural • Transportation
6100 Seagull St. NE - Suite 102
Albuquerque, NM 87109 - (505) 881-5357



CITY OF ALBUQUERQUE PUBLIC WORKS DEPARTMENT ENGINEERING GROUP				
TITLE: TESUQUE DRIVE AT MARIPOSA ARROYO IMPACT STILLING BASIN DETAILS				
APPROVALS	ENGINEER	DATE	APPROVALS	ENGINEER
D.R.C. Chair	Roy & Green	11-1-90	Water	R.W. Kane
Transportation	R.W. Kane	10-19-90	Waste Water	R.W. Kane
Hydrology	R.W. Kane	11-01-90	Parks & Rec.	D. Scina
DRAWING NO.	4038	MAP NO.	D-11	SHEET 17 OF 18

I HEREBY CERTIFY THAT THIS PROJECT WAS CONSTRUCTED IN GENERAL CONFORMANCE WITH THE PLANS AND SPECIFICATIONS SHOWN HEREON AND THAT THESE DRAWINGS HAVE BEEN REVISED IN ACCORDANCE WITH INFORMATION PROVIDED BY THE CITY OF ALBUQUERQUE PUBLIC WORKS DEPARTMENT.

James V. Domenick
JAMES V. DOMENICK, P.E. No. 7643

6/10/91
DATE

ORIGINAL				
SURVEY	SURVEYED	BY	DATE	
NOTE BOOK	PLOTTED			
	TEMPLATE			
	AREAS			
NO	AREAS CHECKED			
	NO			

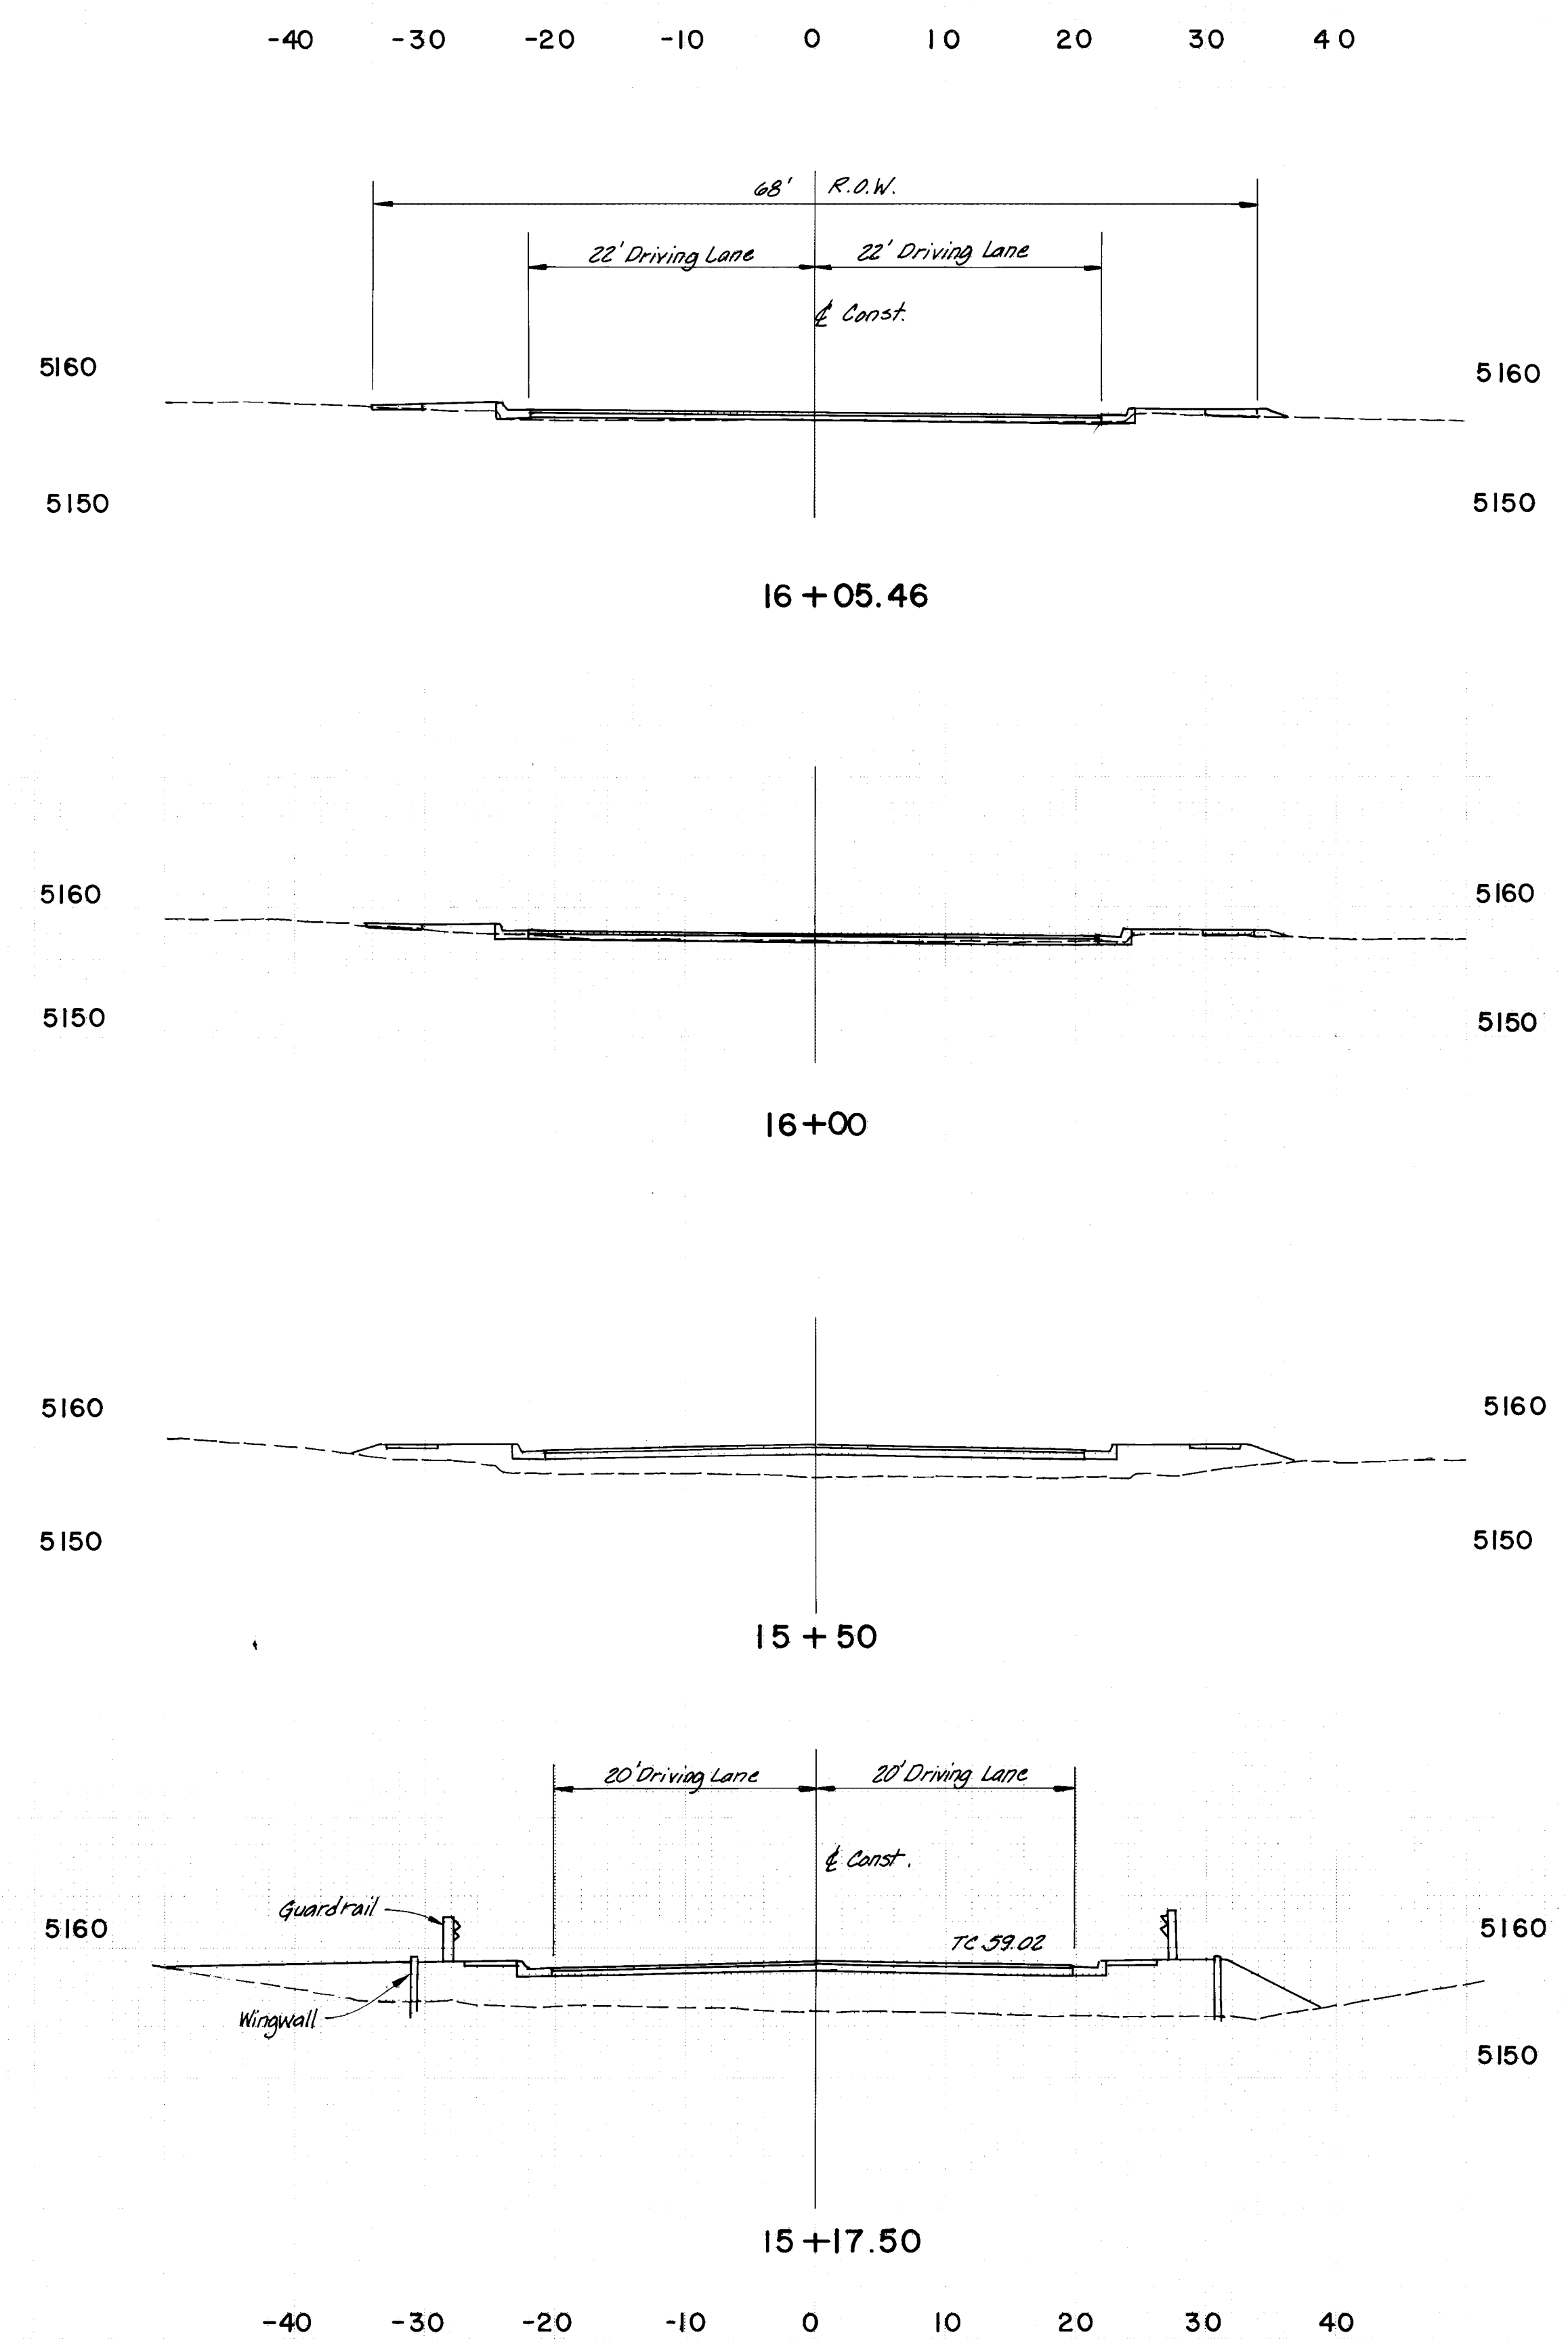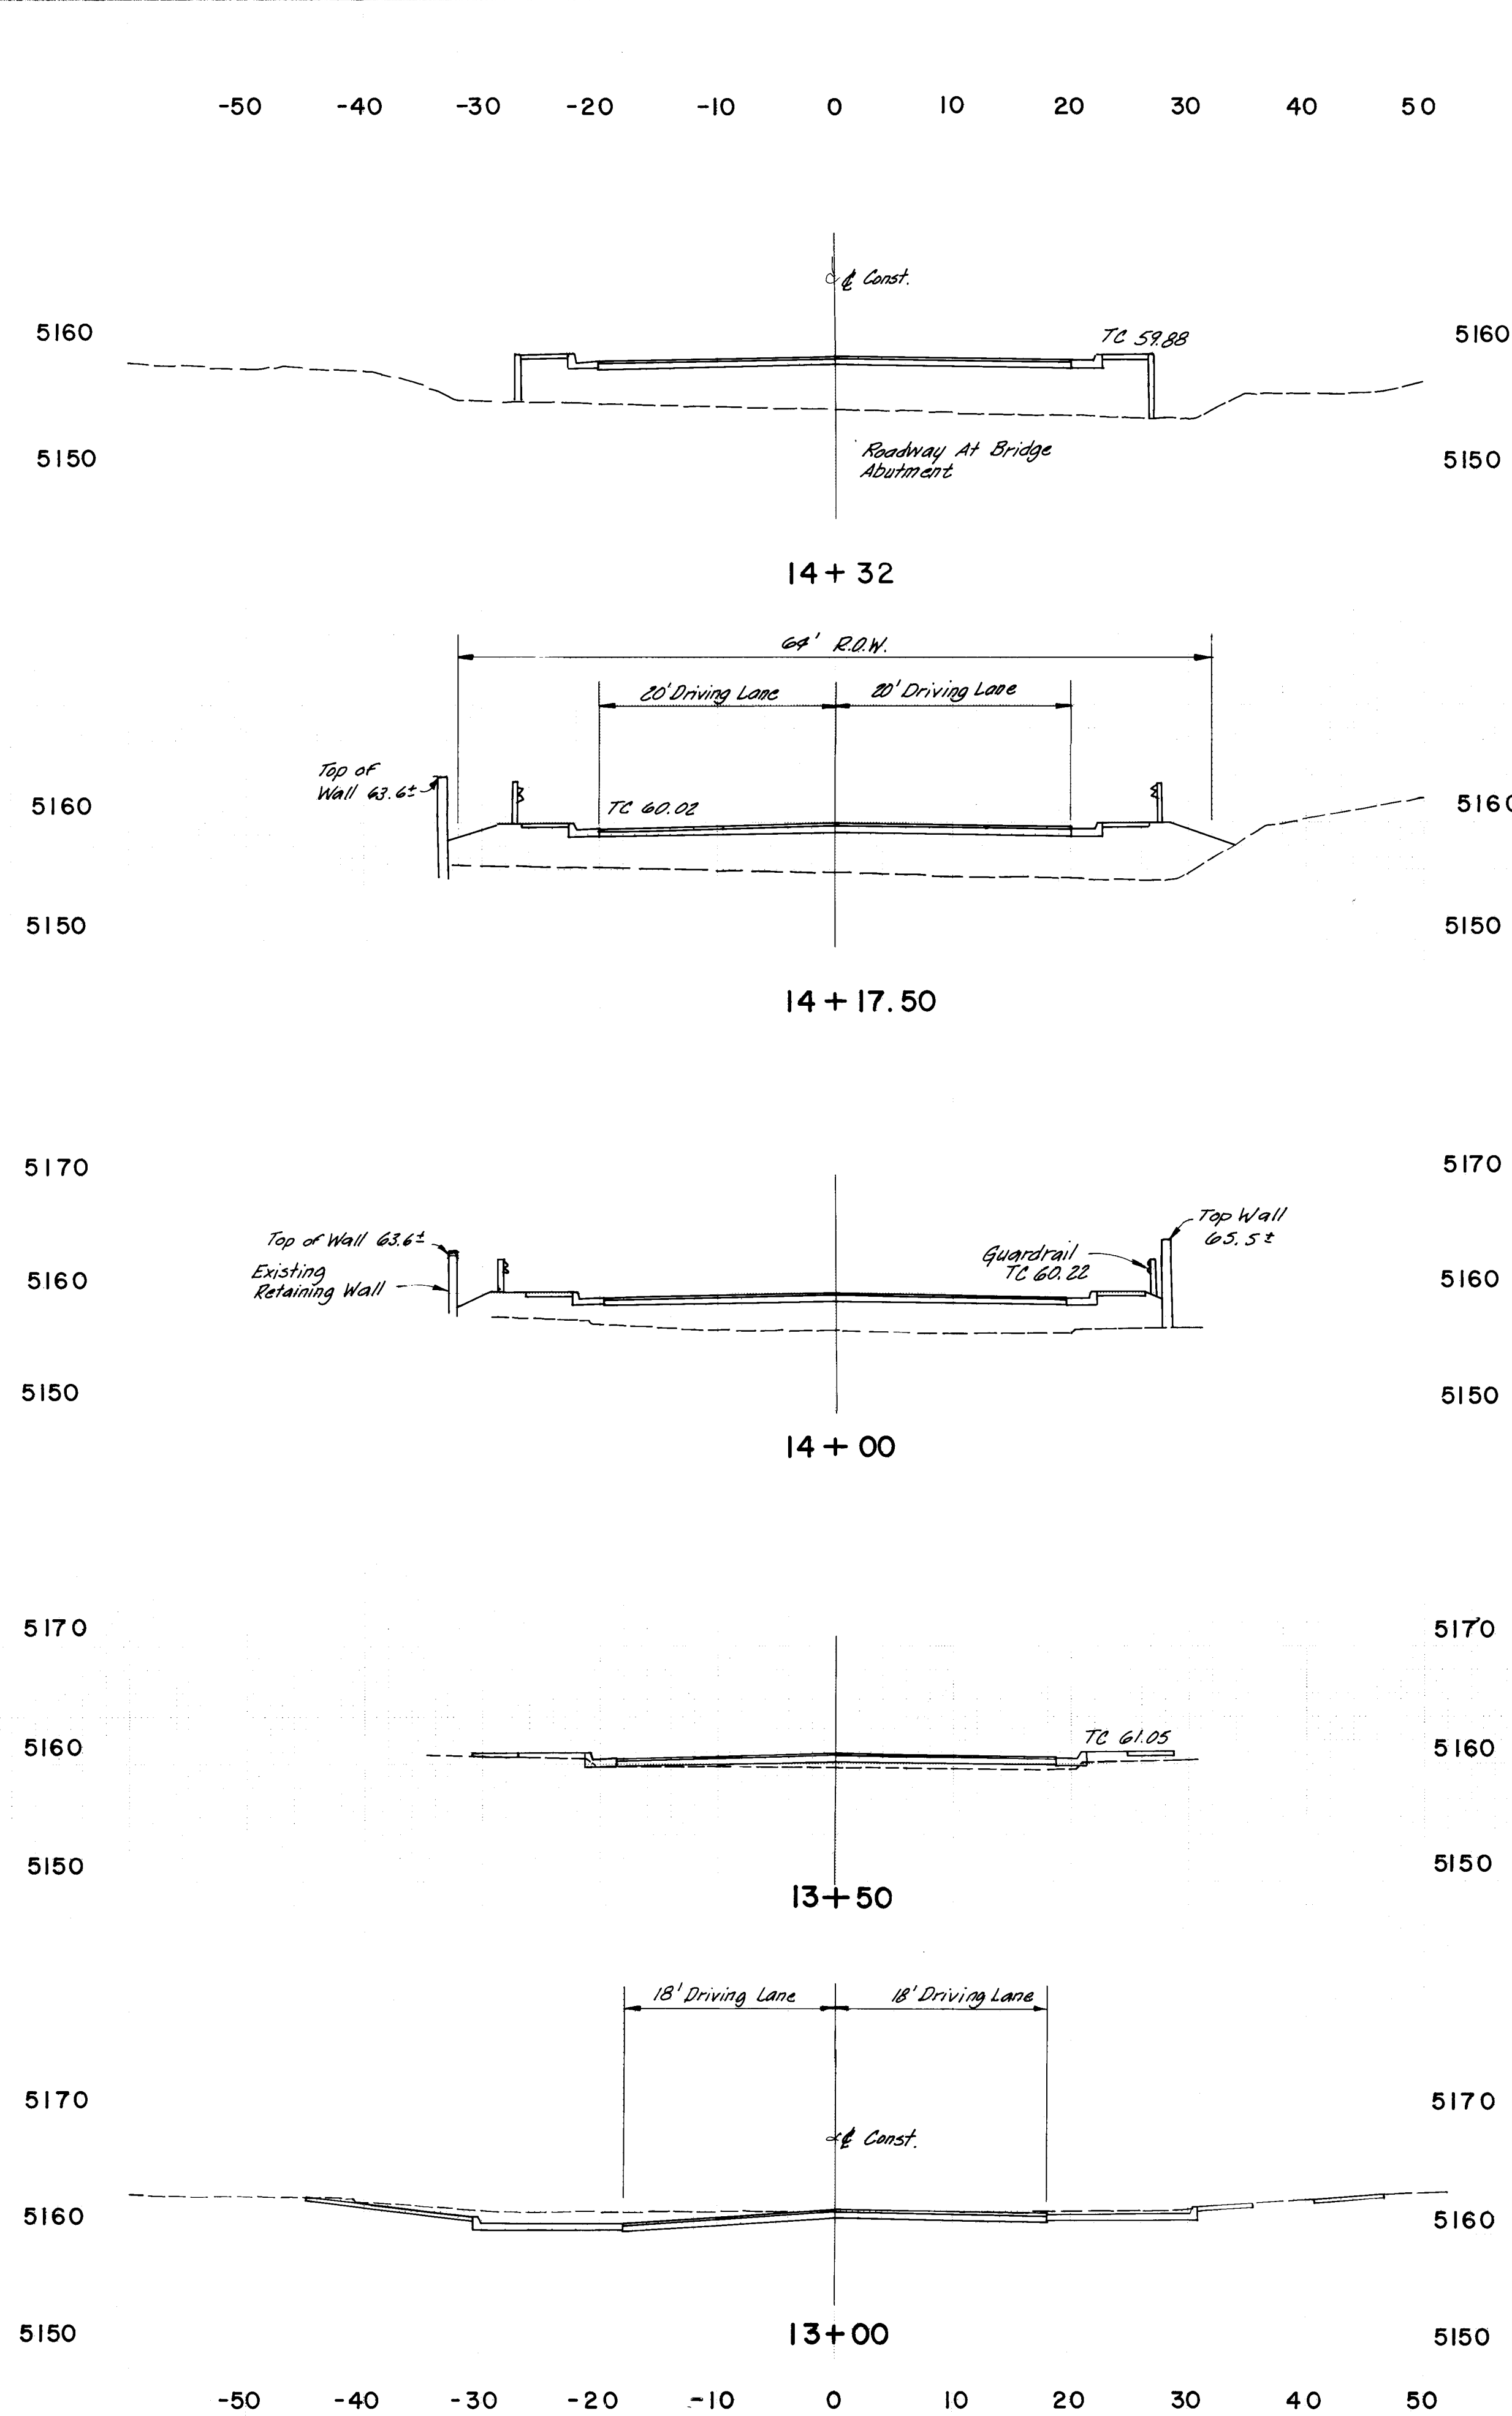

I HEREBY CERTIFY THAT THIS PROJECT WAS CONSTRUCTED IN GENERAL CONFORMANCE WITH THE PLANS AND SPECIFICATIONS SHOWN HEREON AND THAT THESE DRAWINGS HAVE BEEN REVISED IN ACCORDANCE WITH INFORMATION PROVIDED BY THE CITY OF ALBUQUERQUE PUBLIC WORKS DEPARTMENT.


James V. Domenick 8/10/91
JAMES V. DOMENICK, P.E. No. 7643 DATE

Scale:
 Horiz: $1'' = 10'$
 Vert: $1'' = 10'$

SCANNED BY
BY LASON

4 TWD Maps & Records

	4	5	6	7	8	9	10	11	12
26	40	38	18	91					





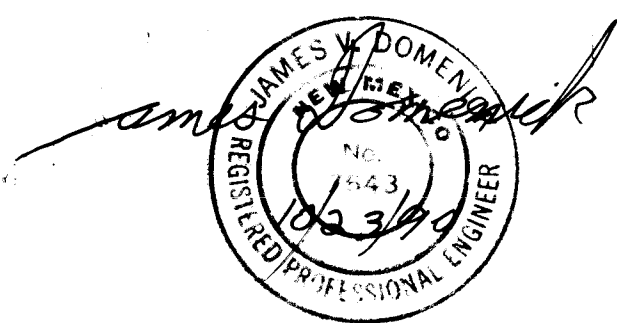


CITY OF ALBUQUERQUE PUBLIC WORKS DEPARTMENT ENGINEERING GROUP			
TITLE: TESUQUE DRIVE AT MARIPOSA ARROYO ROADWAY CROSS-SECTIONS			
DRAWING NO.	4038	MAP NO. D-11	SHEET 18 NO. 18

RECORD DRAWING

ORIGINAL SURVEY NOTE BOOK NO.	SURVEYED PLOTTED DATE AREAS CHECKED	BY	DATE
--	--	----	------

FINAL SURVEY NOTE BOOK NO.	SURVEYED AREA TEMPLATE AREAS CHECKED	BY	DATE
-------------------------------------	---	----	------

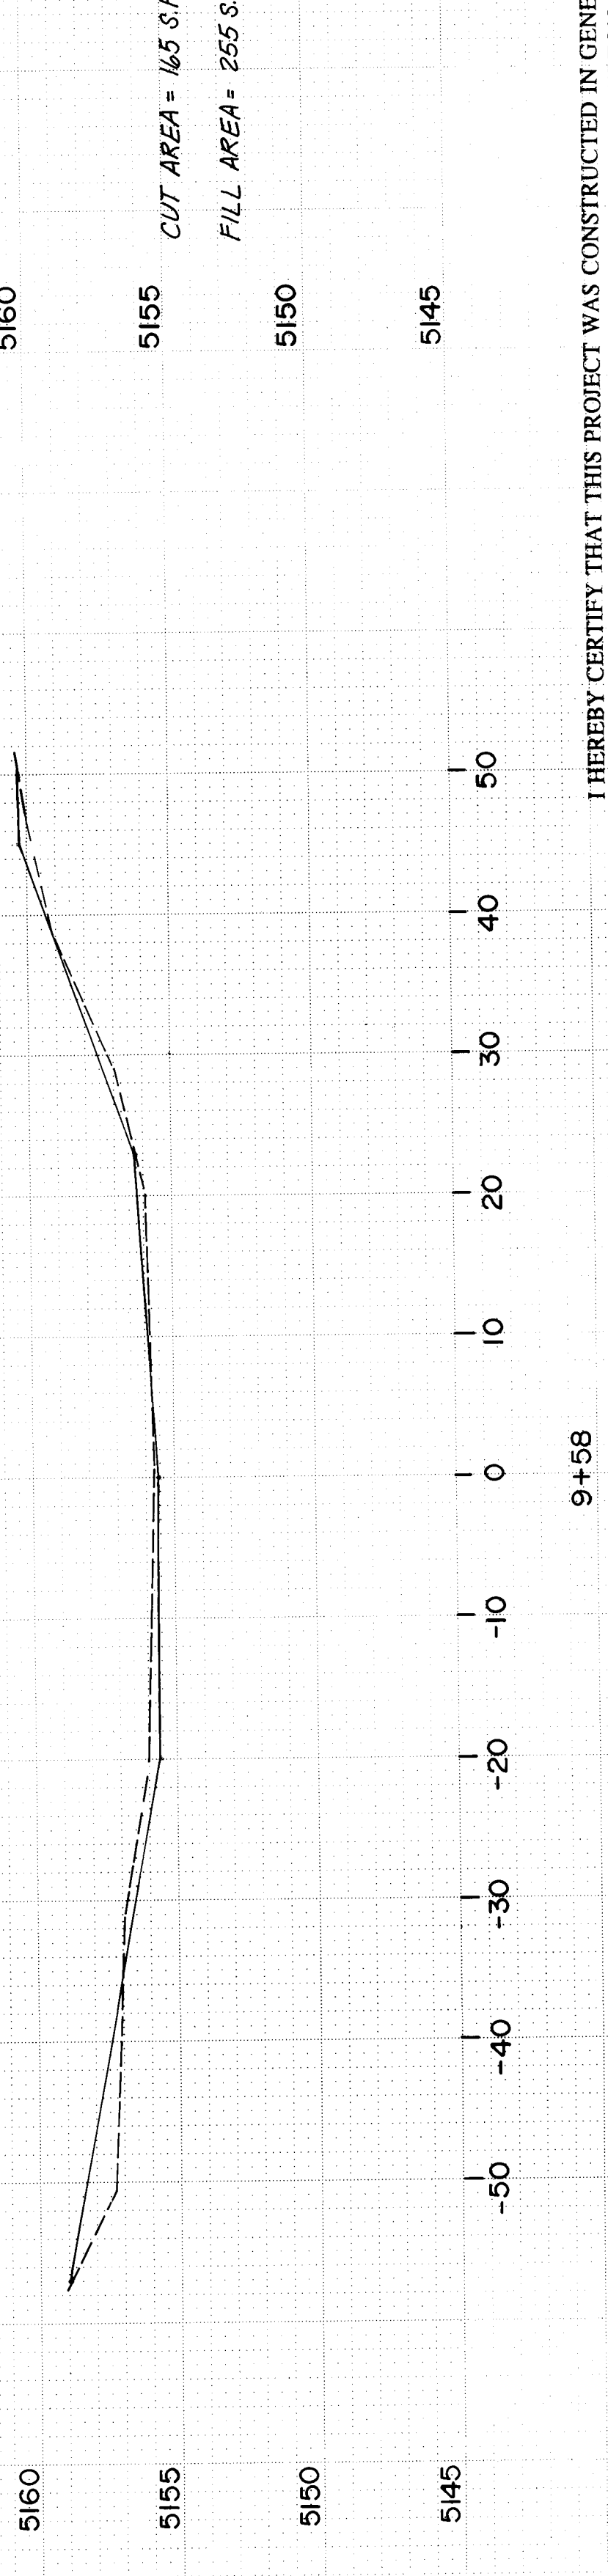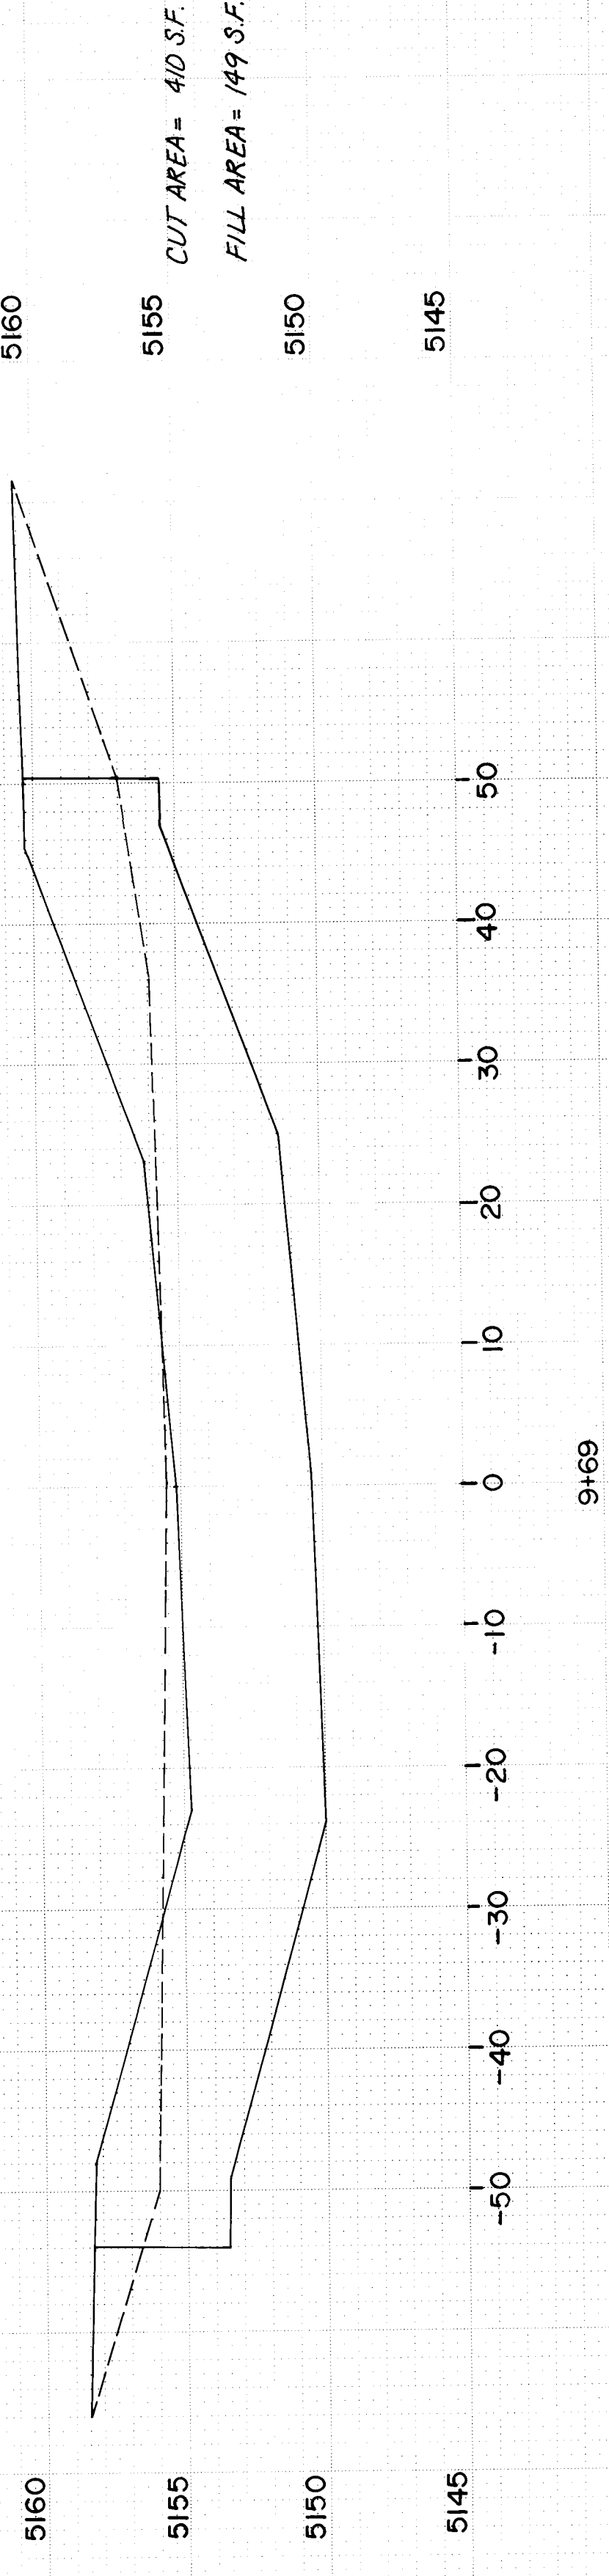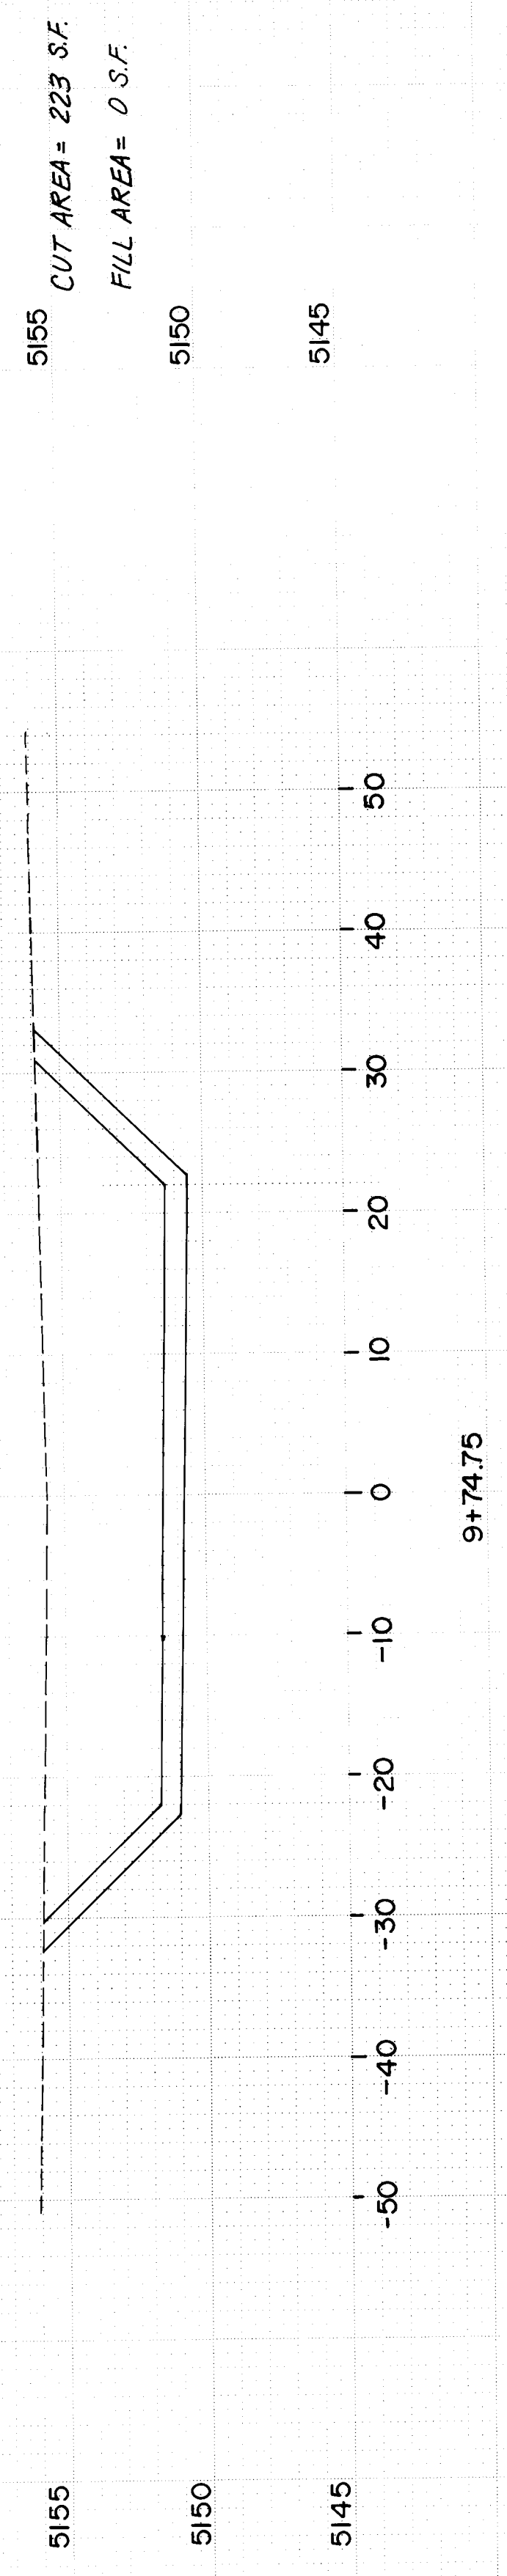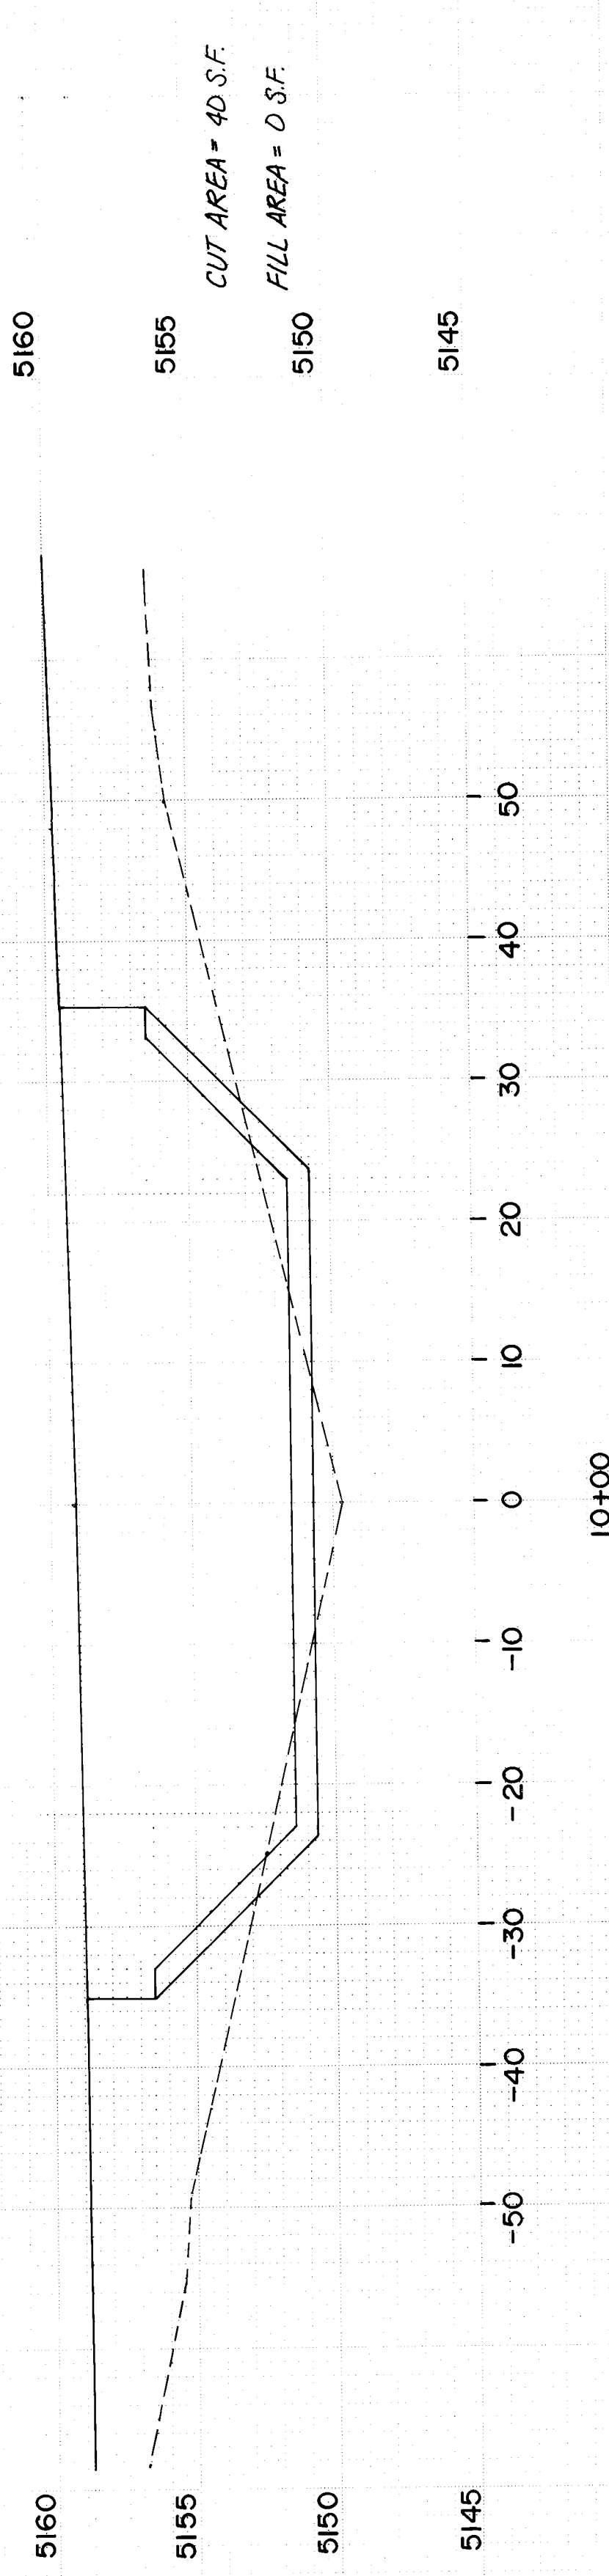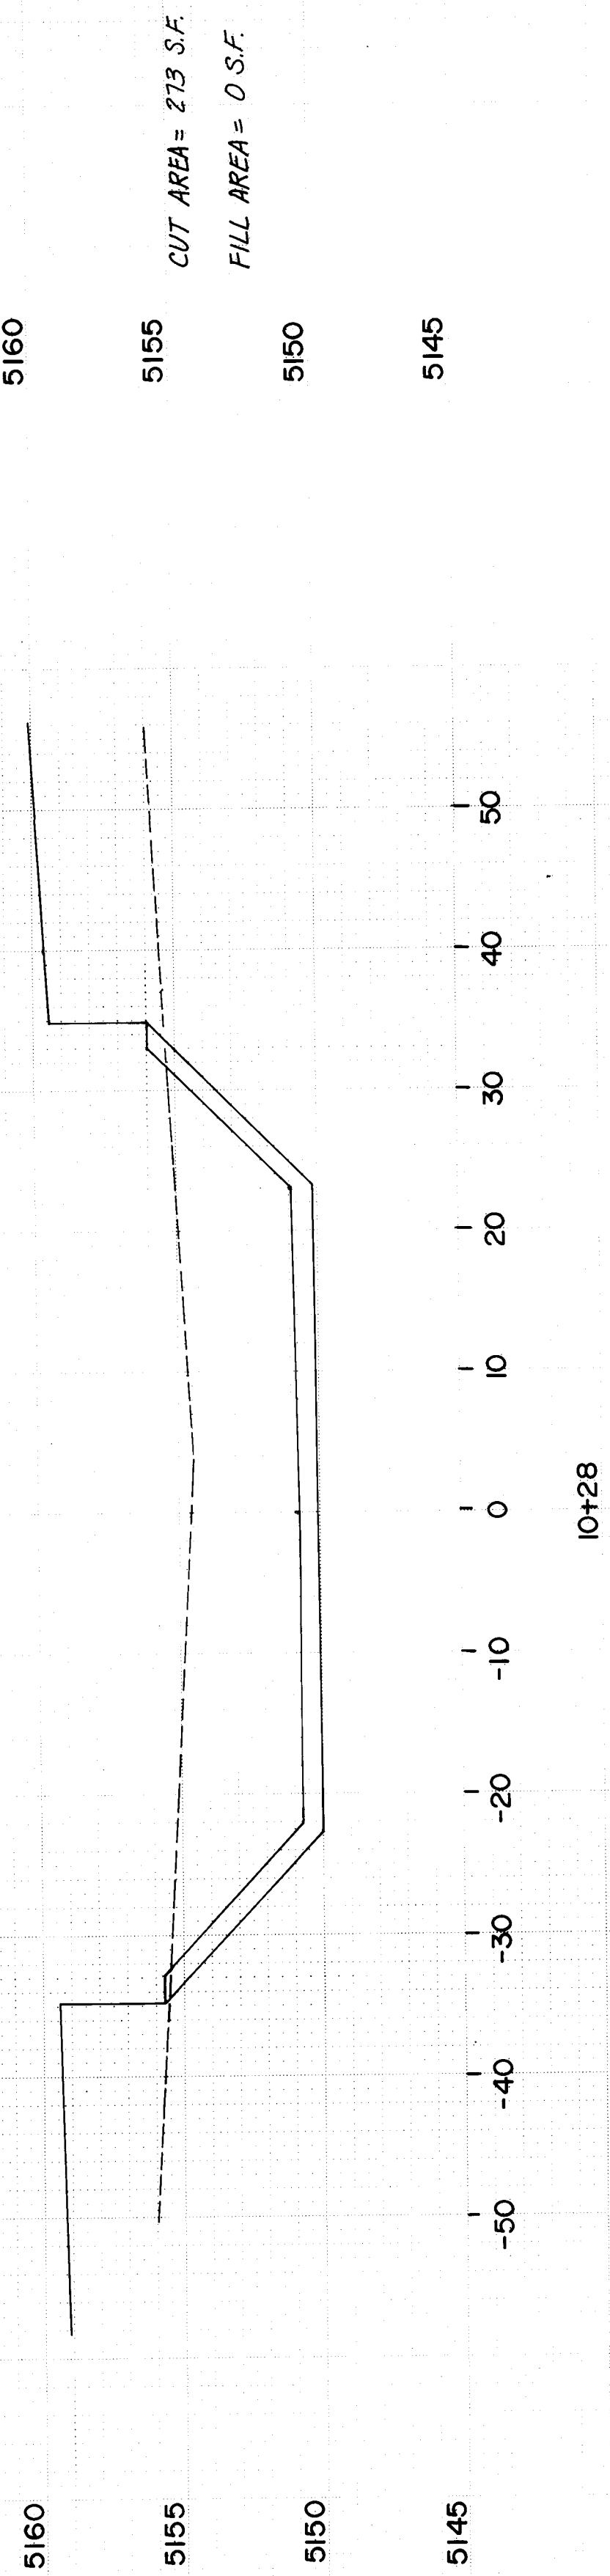

C of A PWD Maps & Records
26 4038 1991

SH-19

I HEREBY CERTIFY THAT THIS PROJECT WAS CONSTRUCTED IN GENERAL CONFORMANCE WITH THE PLANS AND SPECIFICATIONS SHOWN HEREON AND THAT THESE DRAWINGS HAVE BEEN REVISED IN ACCORDANCE WITH INFORMATION PROVIDED BY THE CITY OF ALBUQUERQUE PUBLIC WORKS DEPARTMENT.

James V. Domenick
JAMES V. DOMENICK, P.E. No. 7643
DATE 6/27/91

ORIGINAL	SURVEYED	BY	DATE
SURVEY	AREA		
NOTE BOOK	TEMPLATE		
NO.	AREAS CHECKED		


FINAL	SURVEYED	BY	DATE
SURVEY	AREA		
NOTE BOOK	TEMPLATE		
NO.	AREAS CHECKED		

5160

5155

5150

5145

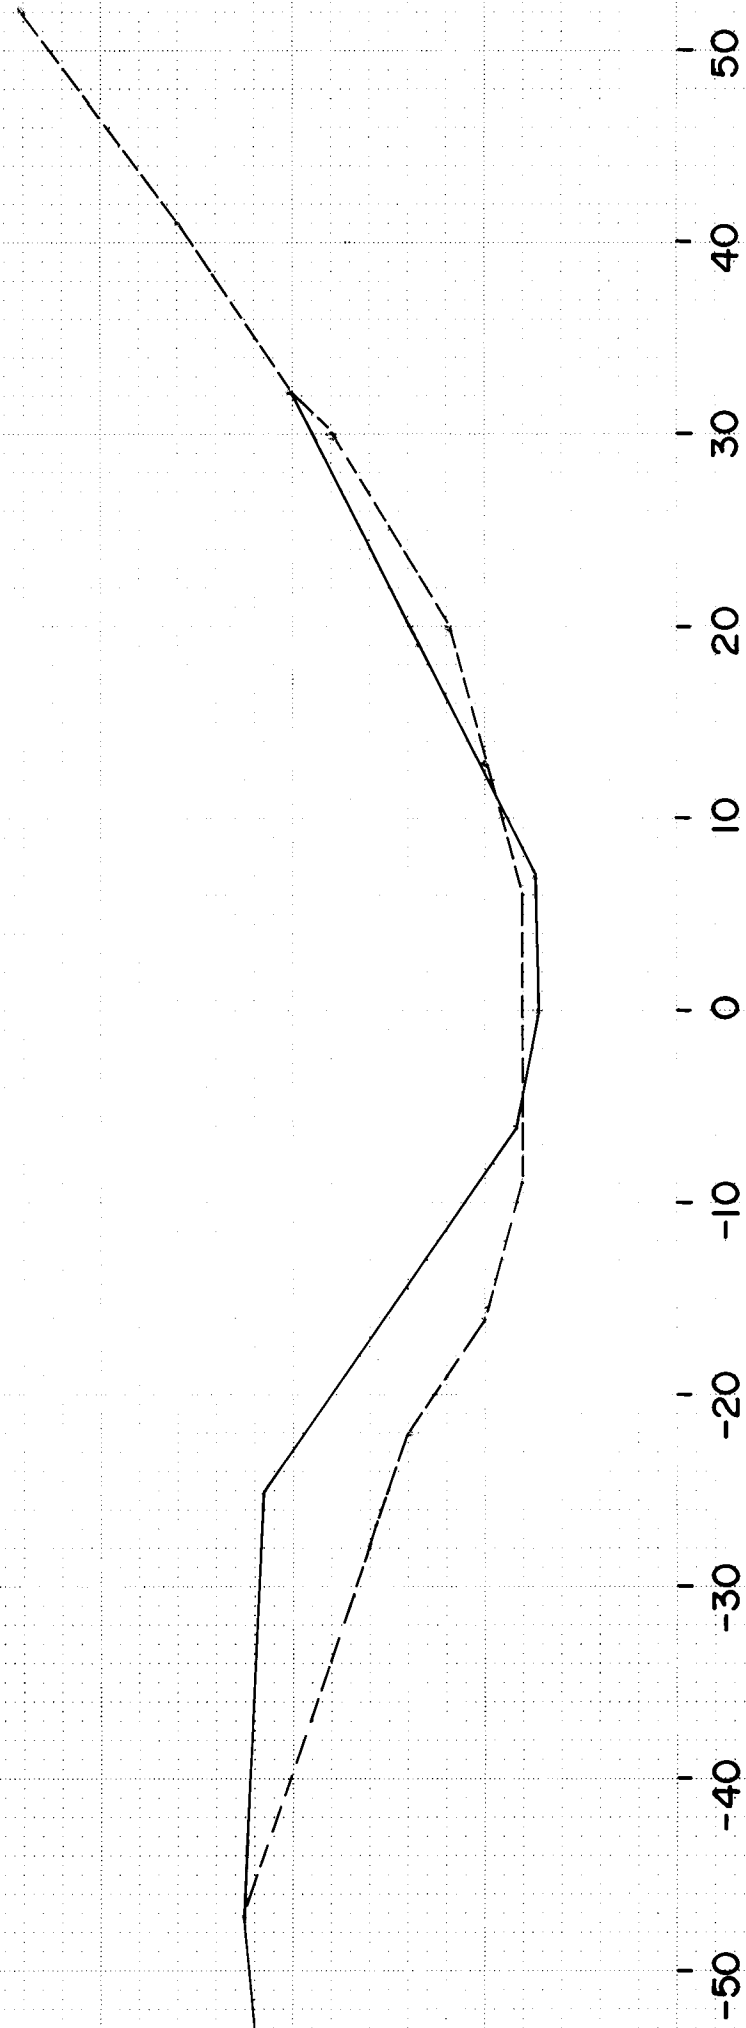


CUT AREA = 5 S.F.
FILL AREA = 90 S.F.

5160

5155

5150

5145

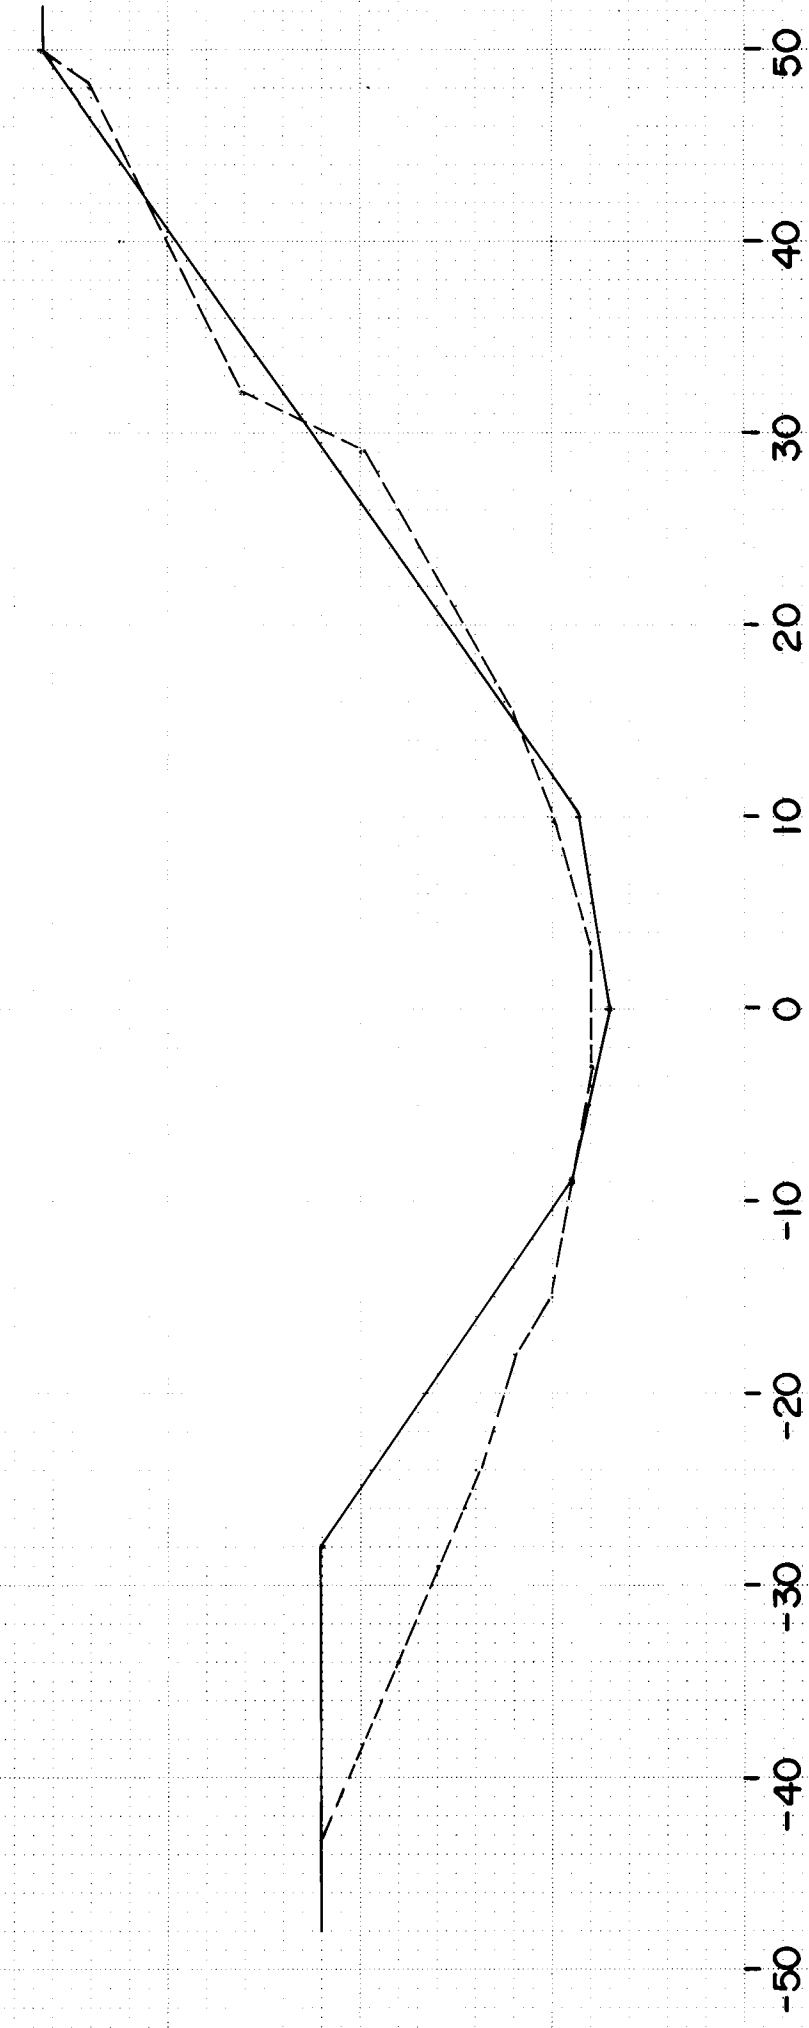

CUT AREA = 15 S.F.
FILL AREA = 81 S.F.

5160

5155

5150

5145




CUT AREA = 27 S.F.
FILL AREA = 65 S.F.

5160

5155

5150

5145

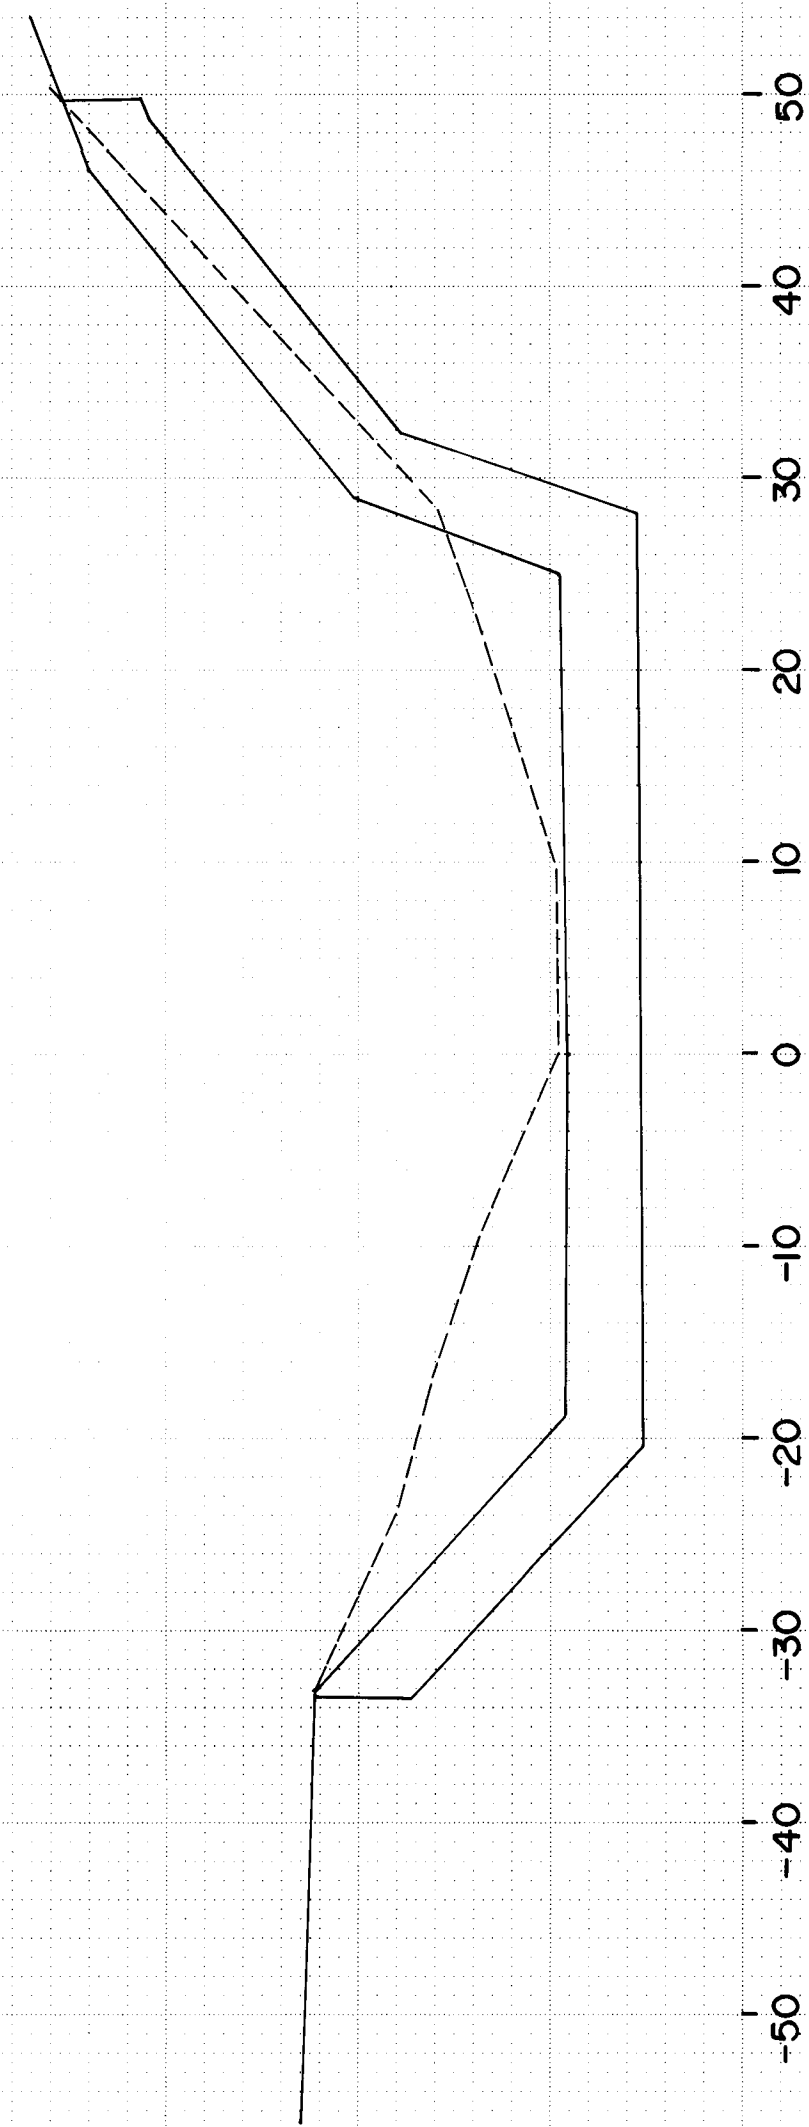


CUT AREA = 267 S.F.
FILL AREA = 28 S.F.

5160

5155

5150

5145

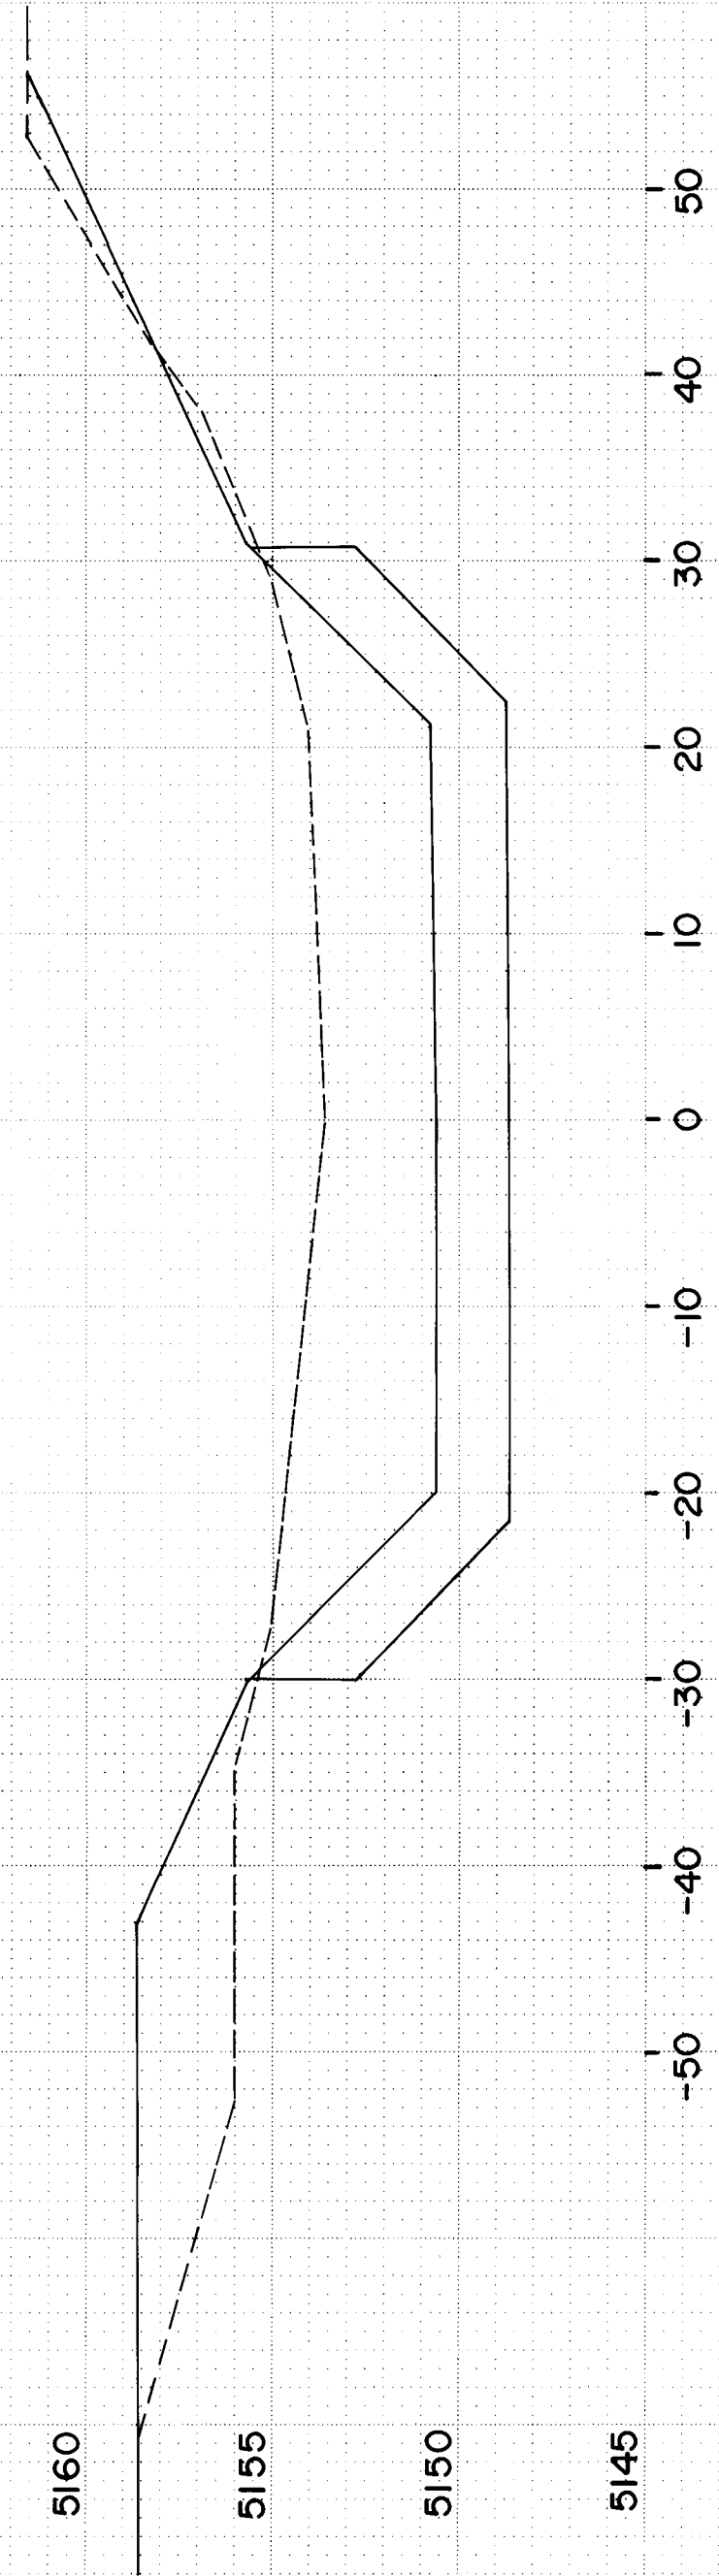

CUT AREA = 312 S.F.
FILL AREA = 68 S.F.

C of A PWD Maps & Records
26 40382091 SH 20

I HEREBY CERTIFY THAT THIS PROJECT WAS CONSTRUCTED IN GENERAL CONFORMANCE WITH THE PLANS AND SPECIFICATIONS SHOWN HEREON AND THAT THESE DRAWINGS HAVE BEEN REVISED IN ACCORDANCE WITH INFORMATION PROVIDED BY THE CITY OF ALBUQUERQUE PUBLIC WORKS DEPARTMENT.

James V. Domenick
JAMES V. DOMENICK, P.E. No. 7643
DATE 5/27/91

ORIGINAL	SURVEYED	BY	DATE
SURVEY	PLOTTED		
NOTE BOOK	AREAS		
NO.	AREAS CHECKED		

FINAL	SURVEYED	BY	DATE
SURVEY	TEMPLATE		
NOTE BOOK	AREAS		
NO.	AREAS CHECKED		

6160

6155

6150

6145

CUT AREA = 36 S.F.

FILL AREA = 75 S.F.

6160

6155

6150

6145

13+50

5160

5155

5150

5145

CUT AREA = 2 S.F.

FILL AREA = 110 S.F.

5160

5155

5150

5145

13+00

26 403812191

SH. 21

I HEREBY CERTIFY THAT THIS PROJECT WAS CONSTRUCTED IN GENERAL CONFORMANCE WITH THE PLANS AND SPECIFICATIONS SHOWN HEREON AND THAT THESE DRAWINGS HAVE BEEN REVISED IN ACCORDANCE WITH INFORMATION PROVIDED BY THE CITY OF ALBUQUERQUE PUBLIC WORKS DEPARTMENT.

James V. Domenick 6/27/91
JAMES V. DOMENICK, P.E. No. 7643

DATE