


WATER & SEWER SERVICE LOTS 14-36
BARTOLO AVE. SW & BARTOLO CT. SW

BERNALILLO COUNTY – SOUTH VALLEY

MARCH 1990

PROJECT LOCATION

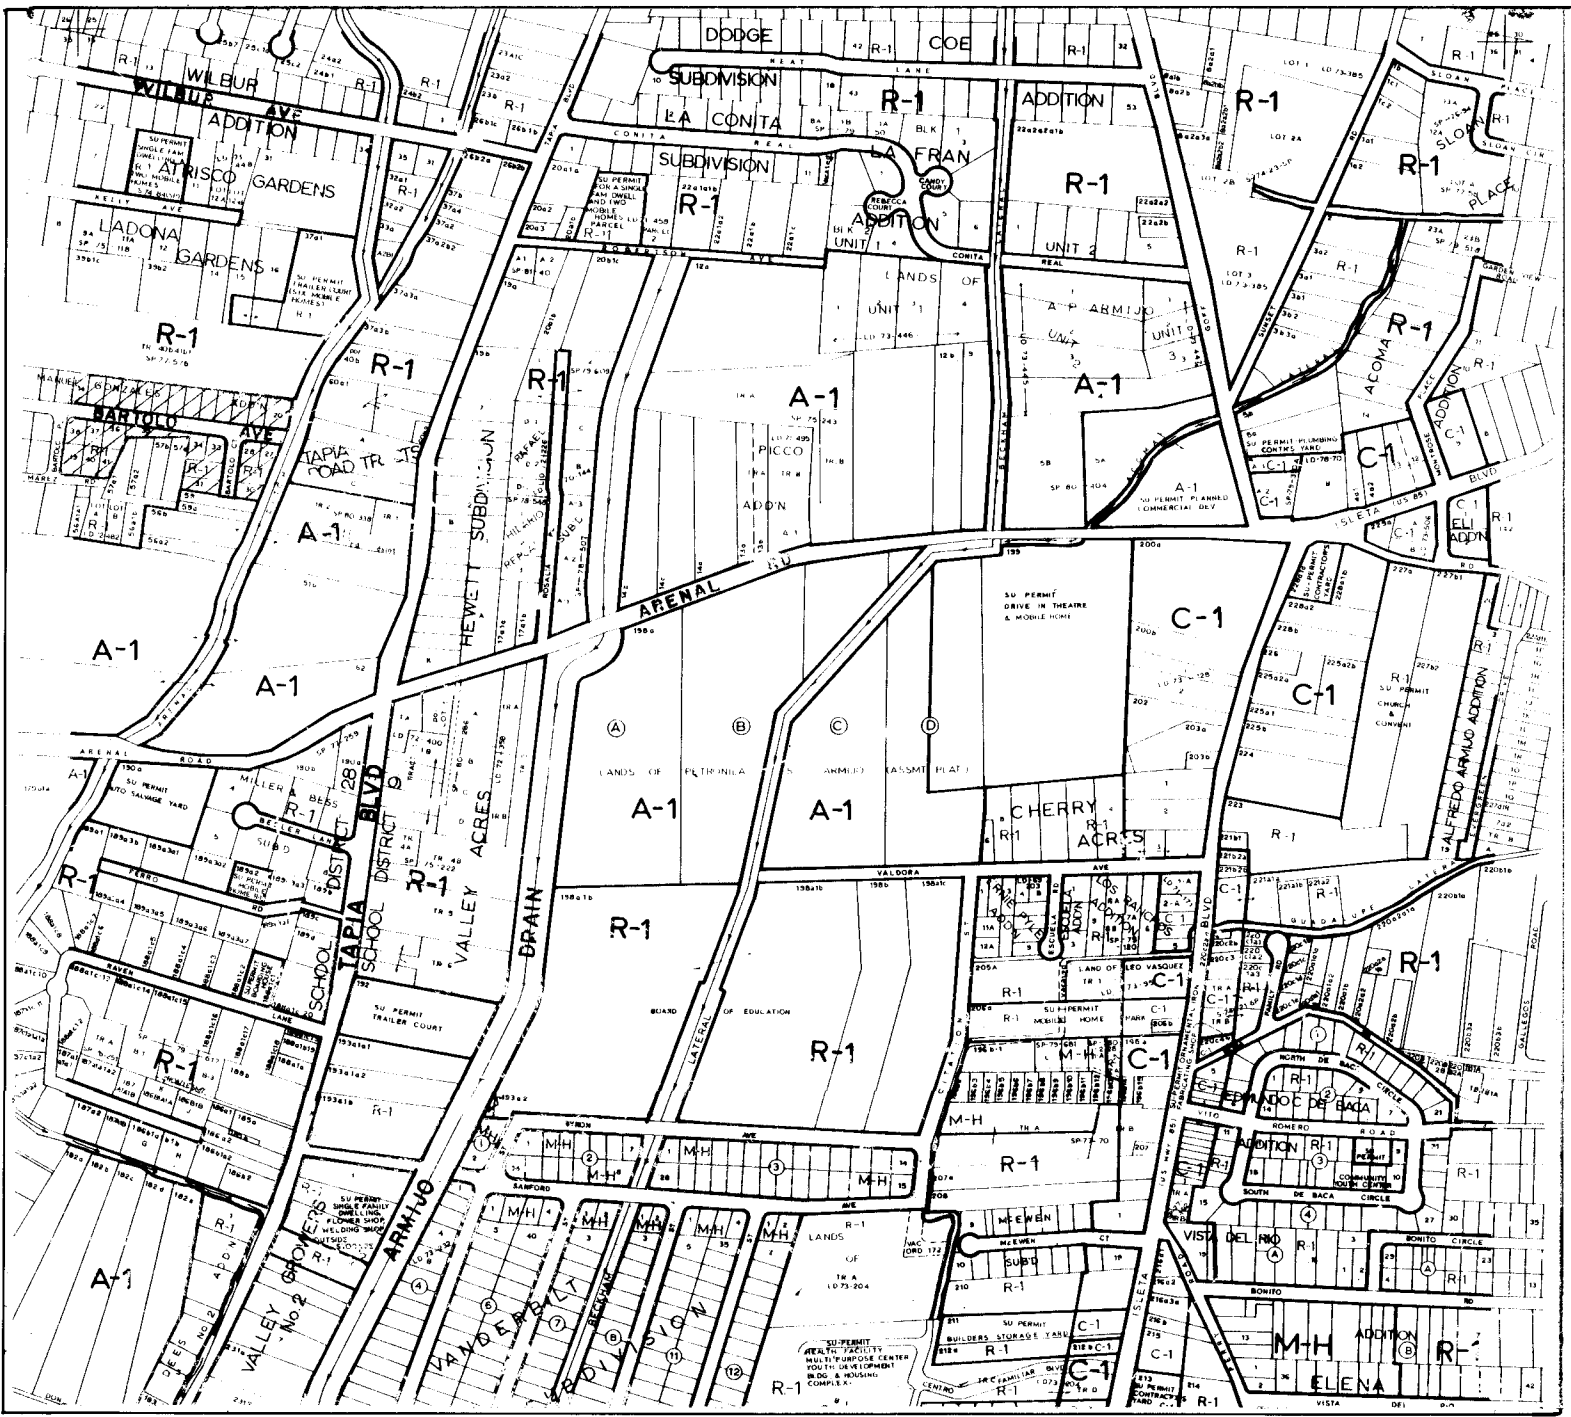

LOCATION MAP

M-12-Z

INDEX


SHEET NO.	DESCRIPTION
1.	TITLE
2.	PLAN & PROFILE

1 2 3 4 5 6 7 8 9 10 11 12 13 14 15
26-4055.190 01195


APPROVAL OF AS BUILT DRAWINGS
CHIEF CONSTRUCTION ENGINEER
Russell B. ...
DATE 12-7-95

CITY OF ALBUQUERQUE PUBLIC WORKS DEPARTMENT ENGINEERING GROUP Rev. 10/89					
TITLE: TITLE SHEET-WATER & SEWER BARTOLO AVE. S.W. & BARTOLO CT. S.W.					
APPROVALS	ENGINEER	DATE	APPROVALS	ENGINEER	DATE
D.R.C. Chairman	<i>Russell B. ...</i>	5/29/90	WATER	<i>R.W. Kane</i>	5-25-90
Transportation	<i>W.A. ...</i>	5/29/90	WASTE WATER	<i>R.W. Kane</i>	5-25-90
Hydrology	<i>W.A. ...</i>	5/29/90			
County Public Works Department	<i>Robert G. ...</i>	5/29/90			
DRAWING NO.	4055.90	MAP NO.	M-12	SHEET OF	2


Rogel Green 8-12-92

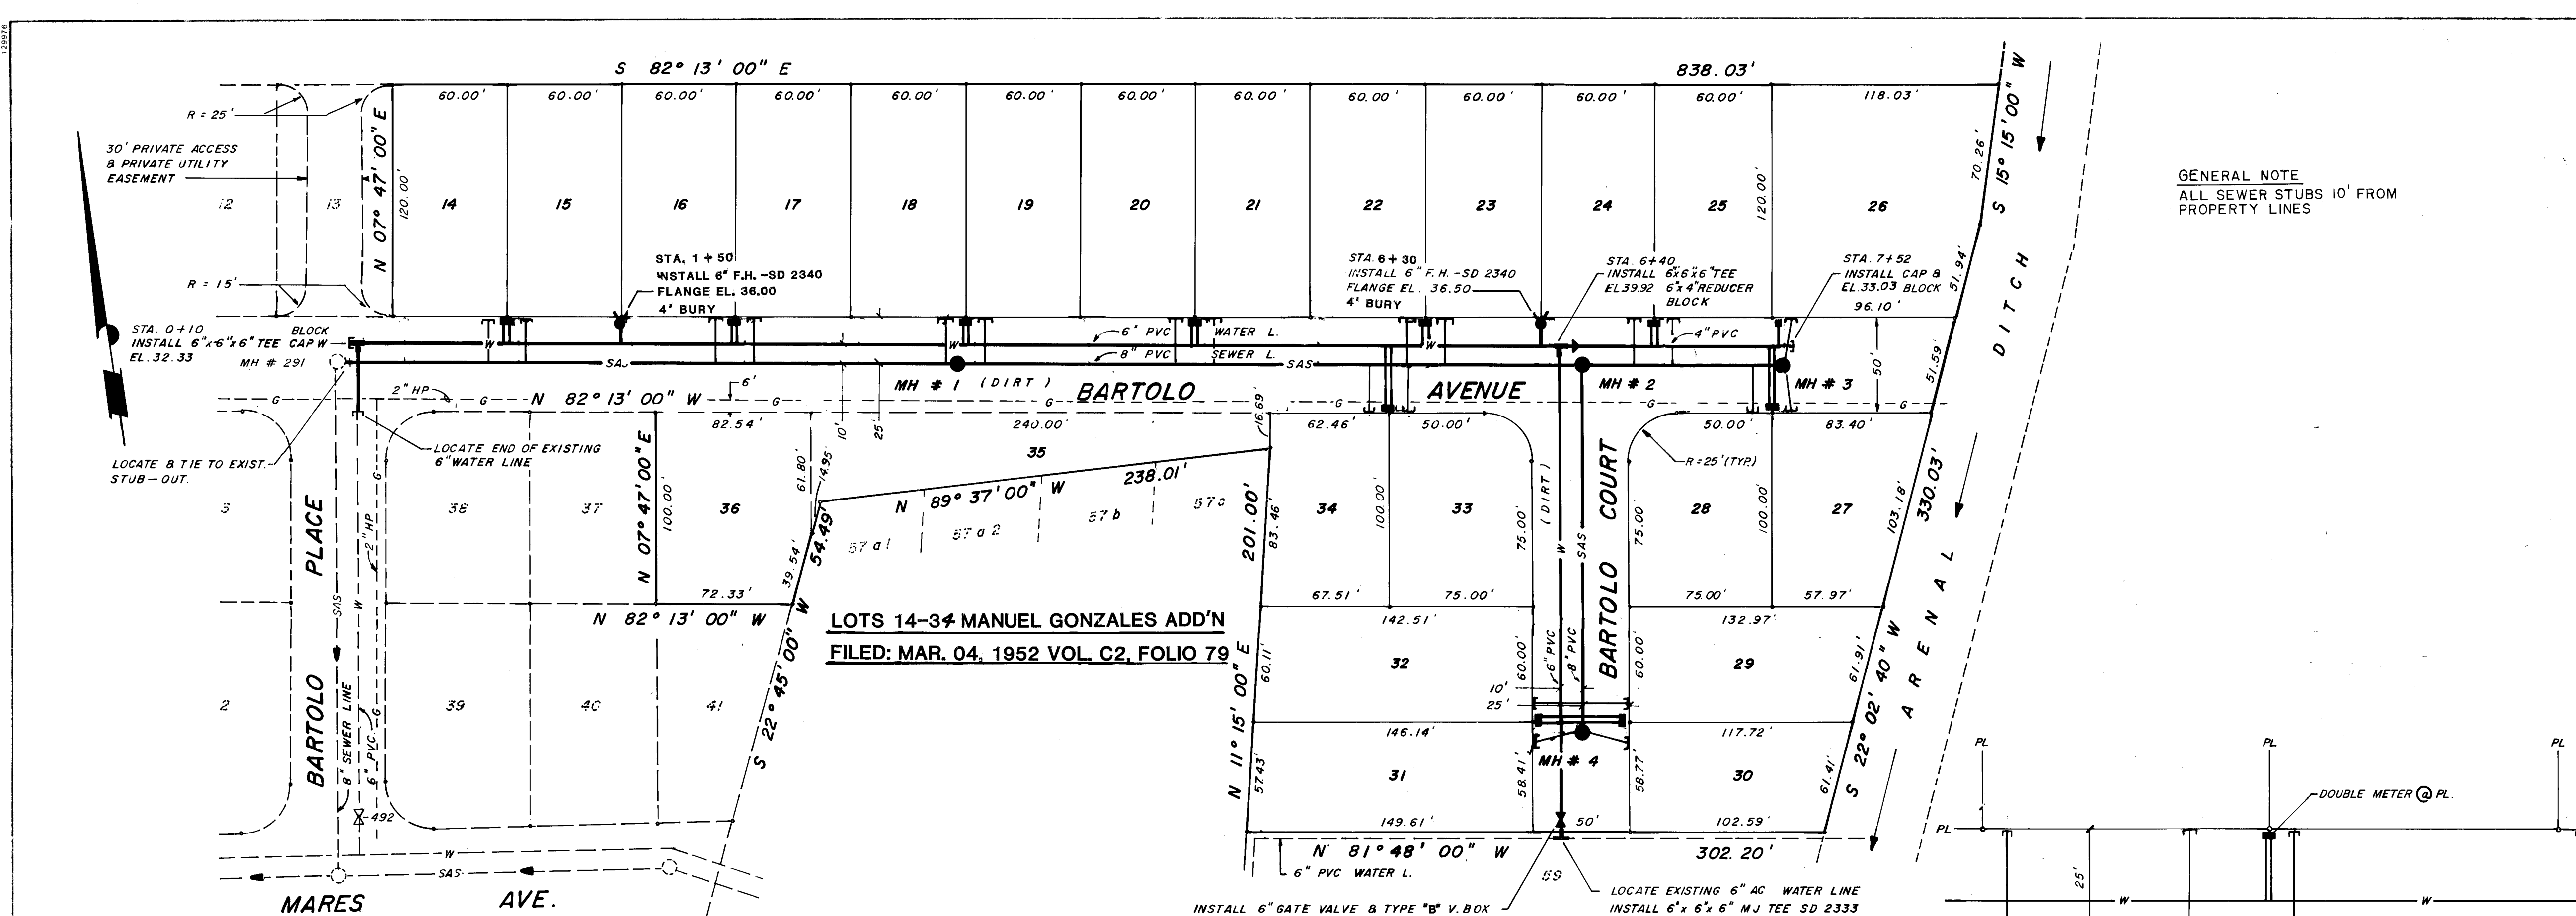

SCALE : 1" = 50' HOR.
1" = 5' VERT.

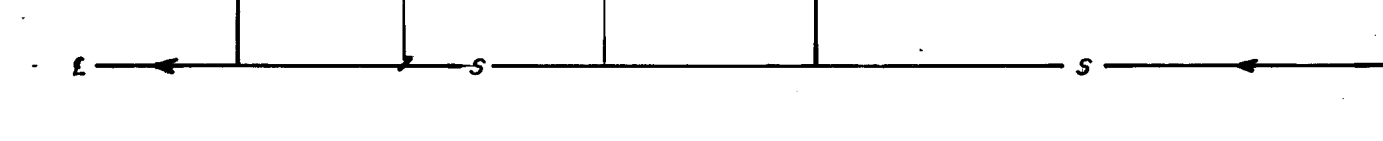

TYPICAL SERVICE LOCATIONS
SCALE : 1" = 20'

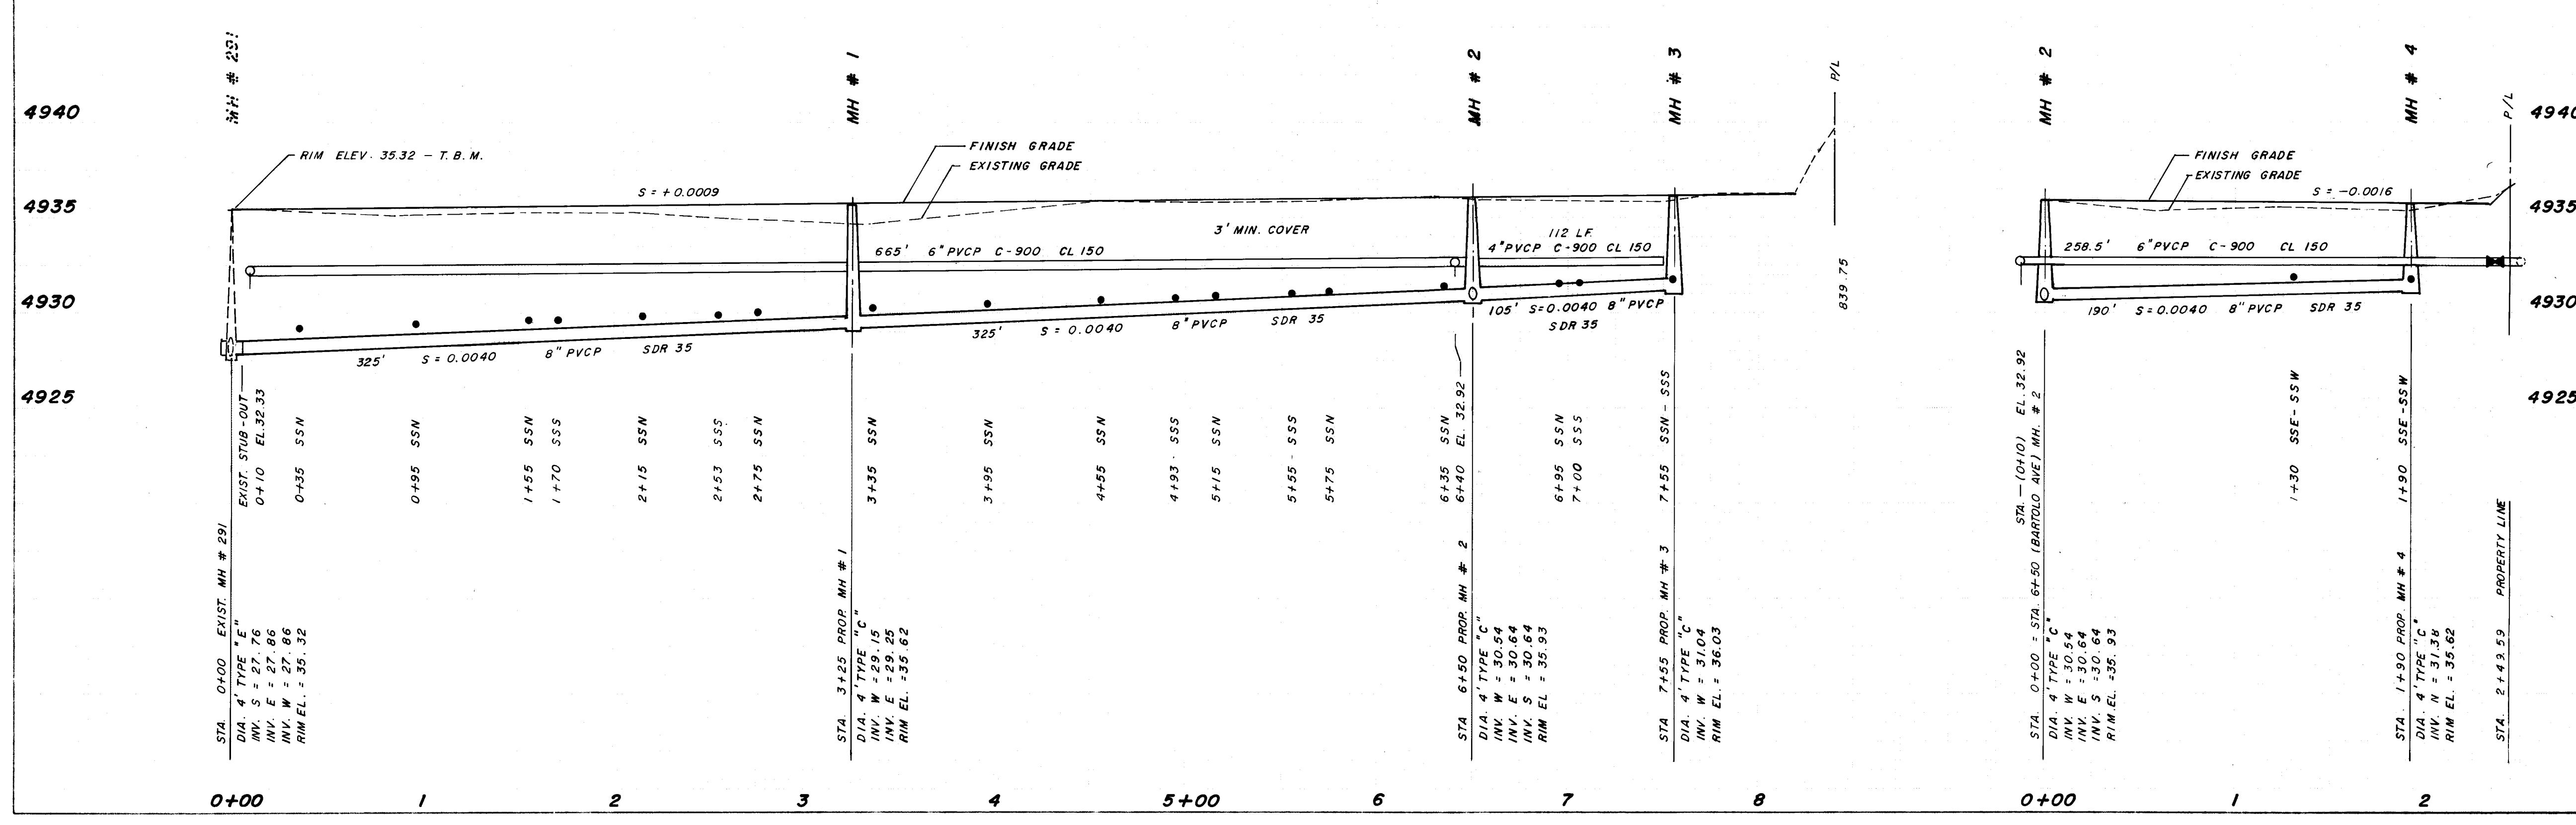

NOTES :

1. INSTALL 11 DOUBLE METER 3/4" SERVICE PER STD. DWG'S 2360, 2361, 2362, 2366.
2. INSTALL 1 SINGLE METER 3/4" SERVICE PER STD. DWG'S 2360, 2361, 2362, 2367.
3. INSTALL 23 SEWER SERVICE STUB-OUTS PER STD. DWG'S 2118, 2125
4. ALL SEWER STUB-OUTS TO BE LOCATED 5' FROM THE DOWNSTREAM PROPERTY LINE EXCEPT LOT 28 TO BE AT THE PC.
5. ALL TIES TO EXISTING WATER LINE TO BE NON-PRESSURE, SHUT-OFF VALVES 221 & 483 TO INSTALL TEE AND GATE VALVE N.O.P/L ON BARTOLO CT.
6. SHUT OFF VALVE 492 @ BARTOLO PL. & MARES ROAD TO TIE AT WEST END OF NEW WATER LINE INSTALLATION.
7. BLOCK ALL TEES, ELBOWS, CAPS PER STD. DWG. 2320
8. ELEVATIONS FOR FITTINGS ARE TOP OF PIPE
9. BACKFILL COMPACTION TO BE 95% MODIFIED PROCTOR DENSITY PER ASTM D1557.
10. ROADWAY TO BE EXCAVATED SERVES NO DEVELOPED LOTS AND IS DEAD-ENDED, ERECT BARRICADES & FLASHERS ALONG ALL UNATTENDED EXCAVATIONS.
11. OBTAIN EXCAVATION PERMIT FROM COUNTY PUBLIC WORKS.

LIST OF MATERIALS :

- 938.5 L.F. 6" C-900 CL150 PVCP
112 L.F. 4" C-900 CL150 PVCP
4 EA. 6"x6" TEE
1 EA. 6"x4" REDUCER
1 EA. 6" GATE VALVE
1 EA. "B" V.B.
2 EA. 6" FIRE HYDRANT
1 EA. 6" CAP
1 EA. 4" CAP
10 EA. D.M. SERV.
1 EA. S.M. SERV.

SEWER :

- 945 L.F. 8" SDR 35 PVCP
4 EA. TYPE "C" MANHOLE
21 EA. SERVICE STUB-OUTS

CITY OF ALBUQUERQUE PUBLIC WORKS DEPARTMENT ENGINEERING GROUP					
TITLE: PLAN & PROFILE-WATER & SEWER BARTOLO AVE. S. W. & BARTOLO CT. S.W.					
APPROVALS	ENGINEER	DATE	APPROVALS	ENGINEER	DATE
D.R.C. Chairman	Roger A. Shaw	5/24/90	WATER	R.W. Kane	5-25-90
Transportation	N.A. Duff	5/22/90	WASTE WATER	R.W. Kane	5-25-90
Hydrology	N.A. Duff	5/22/90			
County Public Works	L.A. Toranzo	5/21/90			
DRAWING NO.	4055.90	MAP NO.	M-12	SHEET	2

REVISIONS		REMARKS		BY	
1	2	3	4	5	6
26-90053.90	0295				
NO DATE		REVISIONS		BY	
		DESIGN			
		C.A.C.			
		V.M.			
		C.A.C.			
		DATE 3/1/90			
		DATE 3/5/90			
		DATE 3/1/90			