

AMOLE DEL NORTE
STORM DIVERSION FACILITIES
TIERRA BAYITA DRAINAGE FACILITIES

FOR
CITY OF ALBUQUERQUE - PUBLIC WORKS DEPARTMENT

PHASE IIIA



CITY OF ALBUQUERQUE, NEW MEXICO

OCTOBER 1991


INDEX TO DRAWINGS

NO.	DESCRIPTION	NO.	DESCRIPTION
1	TITLE SHEET	18	PIPE PENETRATION DETAILS
2	SHEET LAYOUT & LEGEND	19	JUNCTION BOX DETAILS ← DELETED FROM SET
3-5	BRIDGE BLVD. - STA. 9+00 TO STA. 41+06 CHANNEL & STORM DRAIN	20	WATER SHUT OFF PLANS
6-8	UNSER BLVD. - STA. 110+75 TO STA. 142+57 PAVING & STORM DRAIN	21	FRONTAGE ROAD CROSSING STRUCTURE
9	FRONTAGE RD. - PAVING	22	STINSON ROAD PLAN & PROFILE STA. 0+00 TO STA. 2+50
10	BRIDGE BLVD. - STA. 9+00 TO STA. 20+00 WATER & SANITARY SEWER	23	STINSON ROAD PLAN & PROFILE STA. 2+50 TO STA. 4+76
11	BRIDGE BLVD. - STA. 20+00 TO STA. 32+00 WATER & SANITARY SEWER	24	WESTERN CROSSING STRUCTURE PLAN & PROFILE
12	STORM DRAIN PROFILES	25	STRUCTURAL NOTES
13	MISCELLANEOUS PROFILES	26	TYPICAL BRIDGE SECTIONS
14	OUTFALL STRUCTURE PLAN	27	PRESTRESSED BEAM DETAILS
15	OUTFALL STRUCTURE DETAILS	28	ABUTMENT DETAILS
16	TYPICAL DRAINAGE DETAILS	29	TRAFFIC CONTROL PLAN
17	MISCELLANEOUS DETAILS	30-35	CHANNEL CROSS SECTIONS (6 SHEETS)

SCANNED BY
BY LASON

GENERAL NOTES

- ALL WORK DETAILED ON THIS PROJECT SHALL BE DONE IN ACCORDANCE WITH "CITY OF ALBUQUERQUE STANDARD SPECIFICATIONS FOR PUBLIC WORKS CONSTRUCTION", 1986 AND ANY REVISIONS AND ADDITIONS IN THE SUPPLEMENTAL SPECIFICATIONS IN THE CONTRACT DOCUMENTS.
- ALL BRIDGE WORK DETAILED ON THIS PROJECT SHALL BE DONE IN ACCORDANCE WITH "NEW MEXICO STATE HIGHWAY DEPARTMENT STANDARD SPECIFICATIONS FOR ROAD AND BRIDGE CONSTRUCTION" 1984 EDITION.
- ALL EXISTING UTILITIES SHOWN HERE WERE OBTAINED AS ACCURATELY AS POSSIBLE FROM RECORD DRAWINGS AND SPOT EXCAVATIONS. IT SHALL BE THE CONTRACTOR'S RESPONSIBILITY TO PROTECT/MAINTAIN IN SERVICE, AND VERIFY EXACT LOCATIONS OF ALL AFFECTED UTILITIES DURING CONSTRUCTION OF THIS PROJECT.
- THE CONTRACTOR SHALL NOTIFY ALL UTILITY COMPANIES WHEN WORKING NEAR THEIR SYSTEMS. TWO DAYS PRIOR TO ANY EXCAVATION, CONTRACTOR MUST CONTACT NEW MEXICO ONE-CALL SYSTEM (260-1990) FOR LOCATION OF EXISTING UTILITIES.
- PRIOR TO CONSTRUCTION, THE CONTRACTOR SHALL EXCAVATE AND VERIFY THE HORIZONTAL AND VERTICAL LOCATIONS OF ALL OBSTRUCTIONS. SHOULD A CONFLICT EXIST, THE CONTRACTOR SHALL NOTIFY THE PROJECT MANAGER SO THAT THE CONFLICT CAN BE RESOLVED WITH MINIMUM AMOUNT OF DELAY.
- CONTRACTOR SHALL NOTIFY THE ENGINEER NOT LESS THAN SEVEN (7) DAYS PRIOR TO STARTING WORK IN ORDER THAT THE ENGINEER MAY TAKE NECESSARY MEASURES TO INSURE THE PRESERVATION OF SURVEY MONUMENTS. CONTRACTOR SHALL NOT DISTURB PERMANENT SURVEY MONUMENTS WITHOUT THE CONSENT OF THE ENGINEER AND SHALL NOTIFY THE ENGINEER AND BEAR THE EXPENSE OF REPLACING ANY THAT MAY BE DISTURBED WITHOUT PERMISSION. REPLACEMENT SHALL BE DONE ONLY BY THE ENGINEER. WHEN A CHANGE IS MADE IN THE FINISHED ELEVATION OF THE PAVEMENT OF ANY ROADWAY IN WHICH A PERMANENT SURVEY MONUMENT IS LOCATED, CONTRACTOR SHALL, AT HIS OWN EXPENSE, ADJUST THE MONUMENT COVER TO THE NEW GRADE UNLESS OTHERWISE SPECIFIED. REFER TO SECTION 4.4.4.4 OF THE GENERAL CONDITIONS OF THE STANDARD SPECIFICATIONS.
- CURB RETURN RADI AND STREET WIDTHS ARE TO THE FACE OF CURB UNLESS OTHERWISE INDICATED ON THE PLANS.
- REMOVAL OF EXISTING CURB AND GUTTER OR SIDEWALK SHALL BE TO THE NEAREST JOINT OR SAW CUT.
- WHEN MATCHING NEW PAVING TO EXISTING PAVEMENT, THE CONTRACTOR SHALL SAW CUT THE EXISTING PAVING ON A RIGHT ANGLE OR AS DIRECTED BY THE PROJECT MANAGER TO REMOVE ANY BROKEN, RAVELED, OR CRACKED PAVING. THE COST OF THIS WORK SHALL BE CONSIDERED INCIDENTAL TO CONSTRUCTION.
- CURB AND GUTTER SHOWN AS EXISTING AND NOT TO BE REMOVED UNDER THIS CONTRACT, WHICH IS DAMAGED OR DISPLACED BY THE CONTRACTOR OR HIS SUBCONTRACTORS, SHALL BE REPLACED BY THE CONTRACTOR AT HIS EXPENSE.
- ALL UTILITIES AND UTILITY SERVICE LINES SHALL BE INSTALLED PRIOR TO PAVING.
- ACCESS TO LOCAL BUSINESS AND RESIDENCES SHALL BE KEPT OPEN AT ALL TIMES. TEMPORARY ACCESS CLOSURES, IF REQUIRED, SHALL BE SCHEDULED AT LEAST TWENTY-FOUR (24) HOURS IN ADVANCE WITH PROPERTY OWNER AND APPROVED BY THE PROJECT MANAGER.
- TACK COAT REQUIREMENTS SHALL BE DETERMINED BY THE CITY ENGINEER.
- REMOVALS SHALL BE DISPOSED OF OFF-SITE AND SHALL BE THE RESPONSIBILITY OF THE CONTRACTOR.
- THE CONTRACTOR SHALL DISPOSE OF ALL UNSUITABLE MATERIAL IN AN ENVIRONMENTALLY ACCEPTABLE MANNER AT A LOCATION ACCEPTABLE TO THE PROJECT MANAGER. THERE WILL BE NO DIRECT COMPENSATION FOR THIS WORK.
- CONTRACTOR SHALL PROVIDE A TEMPORARY STORM DRAINAGE SYSTEM (SUBJECT TO APPROVAL BY THE CITY HYDROLOGY DIVISION AND THE CITY CONSTRUCTION PROJECT MANAGER) FOR ALL WORK ON THIS PROJECT. THE TEMPORARY SYSTEM SHALL BE CAPABLE OF SAFELY CONVEYING EXISTING RUNOFF ACROSS THE PROJECT AND DISCHARGING INTO THE EXISTING DRAINAGE SYSTEM.
- THE AIR POLLUTION CONTROL REGULATIONS OF THE ALBUQUERQUE - BERNALILLO COUNTY AIR CONTROL BOARD, LIMIT EMISSION OF PARTICULATE MATTER AND THE USE OF CUT BACK ASPHALT. IT IS THE RESPONSIBILITY OF THE CONTRACTOR TO BECOME FULLY INFORMED OF THESE RESTRICTIONS PRIOR TO SUBMITTAL OF BIDS TO AVOID CONFLICT WITH THE REGULATIONS.
- CONTRACTOR SHALL BE RESPONSIBLE FOR ANY DAMAGE TO LANDSCAPING AND IRRIGATION SYSTEMS WITHIN WORK AREA NOT COVERED IN THE PLANS.
- ALL FLOWS INCLUDE A 10% SEDIMENT BULKING FACTOR.
- SEASIDE STREET OR 75TH STREET CAN BE CLOSED DURING CONSTRUCTION. ONE STREET MUST REMAIN OPEN AT ALL TIMES TO PROVIDE ACCESS.
- ALL STORM DRAIN PIPE SHALL BE REINFORCED CONCRETE PIPE UNLESS OTHERWISE NOTED.

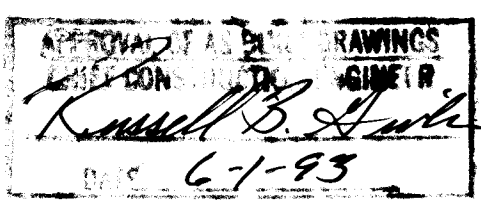

26 4076.90 0193

RECORD DRAWING

REV	SHEETS	CITY ENGR	DATE	USER DEPT.	DATE	USER DEPT.	DATE
APPROVAL OF REVISIONS							

	Greiner, Inc. 5971 JEFFERSON BLVD. NE SUITE 101 ALBUQUERQUE, NM 87109 (505) 345-3999	APPROVED FOR CONSTRUCTION <i>[Signature]</i> 10-28-91
	DRAWING NO. CITY PROJECT # 4076.90	SHEET 1 OF 35



NOTE:

THE CITY INTENDS TO INCLUDE THE CONSTRUCTION OF RETENTION PONDS ON THE WEST SIDE OF 102ND STREET ALONG WITH ASSOCIATED INFLOW WORKS. CONSTRUCTION PLANS ARE NOT AVAILABLE AT THIS TIME, BUT ARE ANTICIPATED TO BE AVAILABLE FOR CONSTRUCTION NO LATER THAN 12-15-91. ESTIMATED QUANTITIES ARE PROVIDED IN ADDITIVE ALTERNATE 1 OF THE BID SCHEDULE.

-PROJECT DRAINAGE BOUNDARY

FILL SITE FOR PORTION OF EXCESS CUT MATERIAL TO BE PLACED AND COMPACTED. GRADING PLAN TO BE PROVIDED NO LATER THAN DECEMBER 23, 1991. ESTIMATED QUANTITIES ARE PROVIDED IN THE BASE BID OF THE BID PROPOSAL.

PROJECT BENCH MARKS

ACS 10-L-9 ALUMINUM CAP SET IN CONCRETE CURB ON THE
NORTHEASTERLY TURN ISLAND IN THE INTERSECTION
OF 98th STREET AND CENTRAL AVENUE.
N = 1,482,085.203 E = 352,792.376
ELEV = 5204.425

ACS 9-L-9 ALUMINUM CAP SET IN 3" PIPE APPROXIMATELY 30'
EAST OF THE EDGE OF PAVEMENT ON 98th STREET AND
APPROXIMATELY 1/4 MILE SOUTH OF CENTRAL AVENUE.
N = 1,480,156.190 E = 353,052.987
ELEV = (HORIZ CONTROL ONLY)

TBM - AMOLE 13 BRASS CAP SET IN THE NORTH SIDE OF BRIDGE BOULEVARD APPROXIMATELY 30' NORTH OF THE EDGE OF PAVEMENT AND APPROXIMATELY 125' WEST OF SESAME STREET.



N = 1,481,394.909 E = 360,370.080

ELEV = 5072.064

TBM - AMOLE 14 BRASS CAP ON THE NORTH-WESTERLY TURN ISLAND IN
THE INTERSECTION OF NORTH/SOUTH COORS
CONNECTION AND BRIDGE BOULEVARD.
N = 1,481,037.480 E = 361,880.107
ELEV = 5035.731

SCANNED BY
BY LASON


PROJECT LEGEND

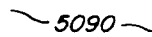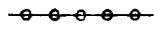DESCRIPTION	EXISTING	NEW
RIGHT-OF-WAY LINE	---	---
CONTOUR		---
SPOT ELEVATION	X 89.5	
CONTROL POINT		
GUARD RAIL		
BUILDING		
SIGN	• S	
POWER POLE		
LIGHT POLE		
TRAFFIC LIGHT	● TL	
FIRE HYDRANT		
TELEPHONE RISER	□	
FENCE	—X—X—	—O—
WALL	—W—W—	
WATER METER	□	
WATER VALVE		
SANITARY MANHOLE	∩	●
STORM DRAIN MANHOLE	⊙	⊙
TELEPHONE MANHOLE	⊕	
SANITARY SEWER LINE	—SAS—	—SAS—
WATER LINE	—W—	—W—
STORM DRAIN LINE	—SD—	—SD—
GAS LINE	—G—	
CABLE TV LINE	—CATV—	
OVERHEAD ELECTRIC LINE	—OE—	
UNDERGROUND TELEPHONE	—UGT—	
CONCRETE CHANNEL		

SURVEY INFORMATION	BENCH MARKS	AS BUILT INFORMATION
--------------------	-------------	----------------------

DATE		FIELD NOTES		DATE		FIELD NOTES		DATE		FIELD NOTES	
NO.	BY	NO.	BY	NO.	BY	NO.	BY	NO.	BY	NO.	BY
1880	GREINER	6-7/90		1881	GREINER	6-7/90		1882	GREINER	6-7/90	
1883	GREINER	7/6/90		1884	GREINER	7/6/90		1885	GREINER	7/6/90	
1886	GREINER	12/90		1887	GREINER	12/90		1888	GREINER	12/90	
1889	GREINER	12/90		1890	GREINER	12/90		1891	GREINER	12/90	
1892	GREINER	12/90		1893	GREINER	12/90		1894	GREINER	12/90	
1979	GREINER	12/90		1980	GREINER	12/90		1981	GREINER	12/90	
1982	GREINER	12/90		1983	GREINER	12/90		1984	GREINER	12/90	</

SECRET

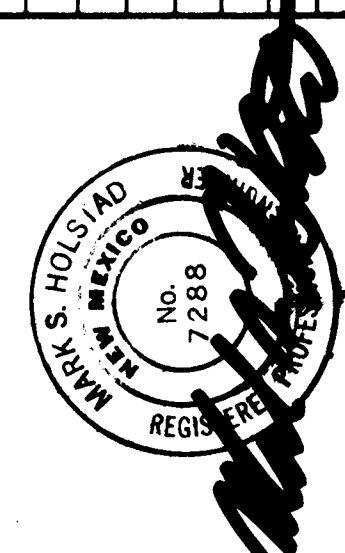

REVISIONS				DESIGN	
NO.	DATE	REMARKS	BY	DESIGNED BY	DATE
				WASH	10/91
				DRAWN BY	10/91

CITY OF ALBUQUERQUE
PUBLIC WORKS DEPARTMENT
ENGINEERING GROUP


TITLE: AMOLE DEL NORTE STORM DIVERSION FACILITIES - PHASE III
TIERRA BAYITA DRAINAGE FACILITIES

SHEET LAYOUT & LEGEND

APPROVALS	ENGINEER	DATE	APPROVALS	ENGINEER	DATE
DRG. CHAIRMAN	<i>Raymond</i>	10-23-91	WATER	<i>AKO</i>	10-1-91
TRANSPORTATION	<i>AKO</i>	10-21-91	WASTE WATER	<i>AKO</i>	"
HYDROLOGY	<i>AKO</i>	9-24-91			


DRAWING NO.	4076.90	MAP NO.	SHEET 2 OF 35
-------------	---------	---------	---------------

RECORD DRAWING

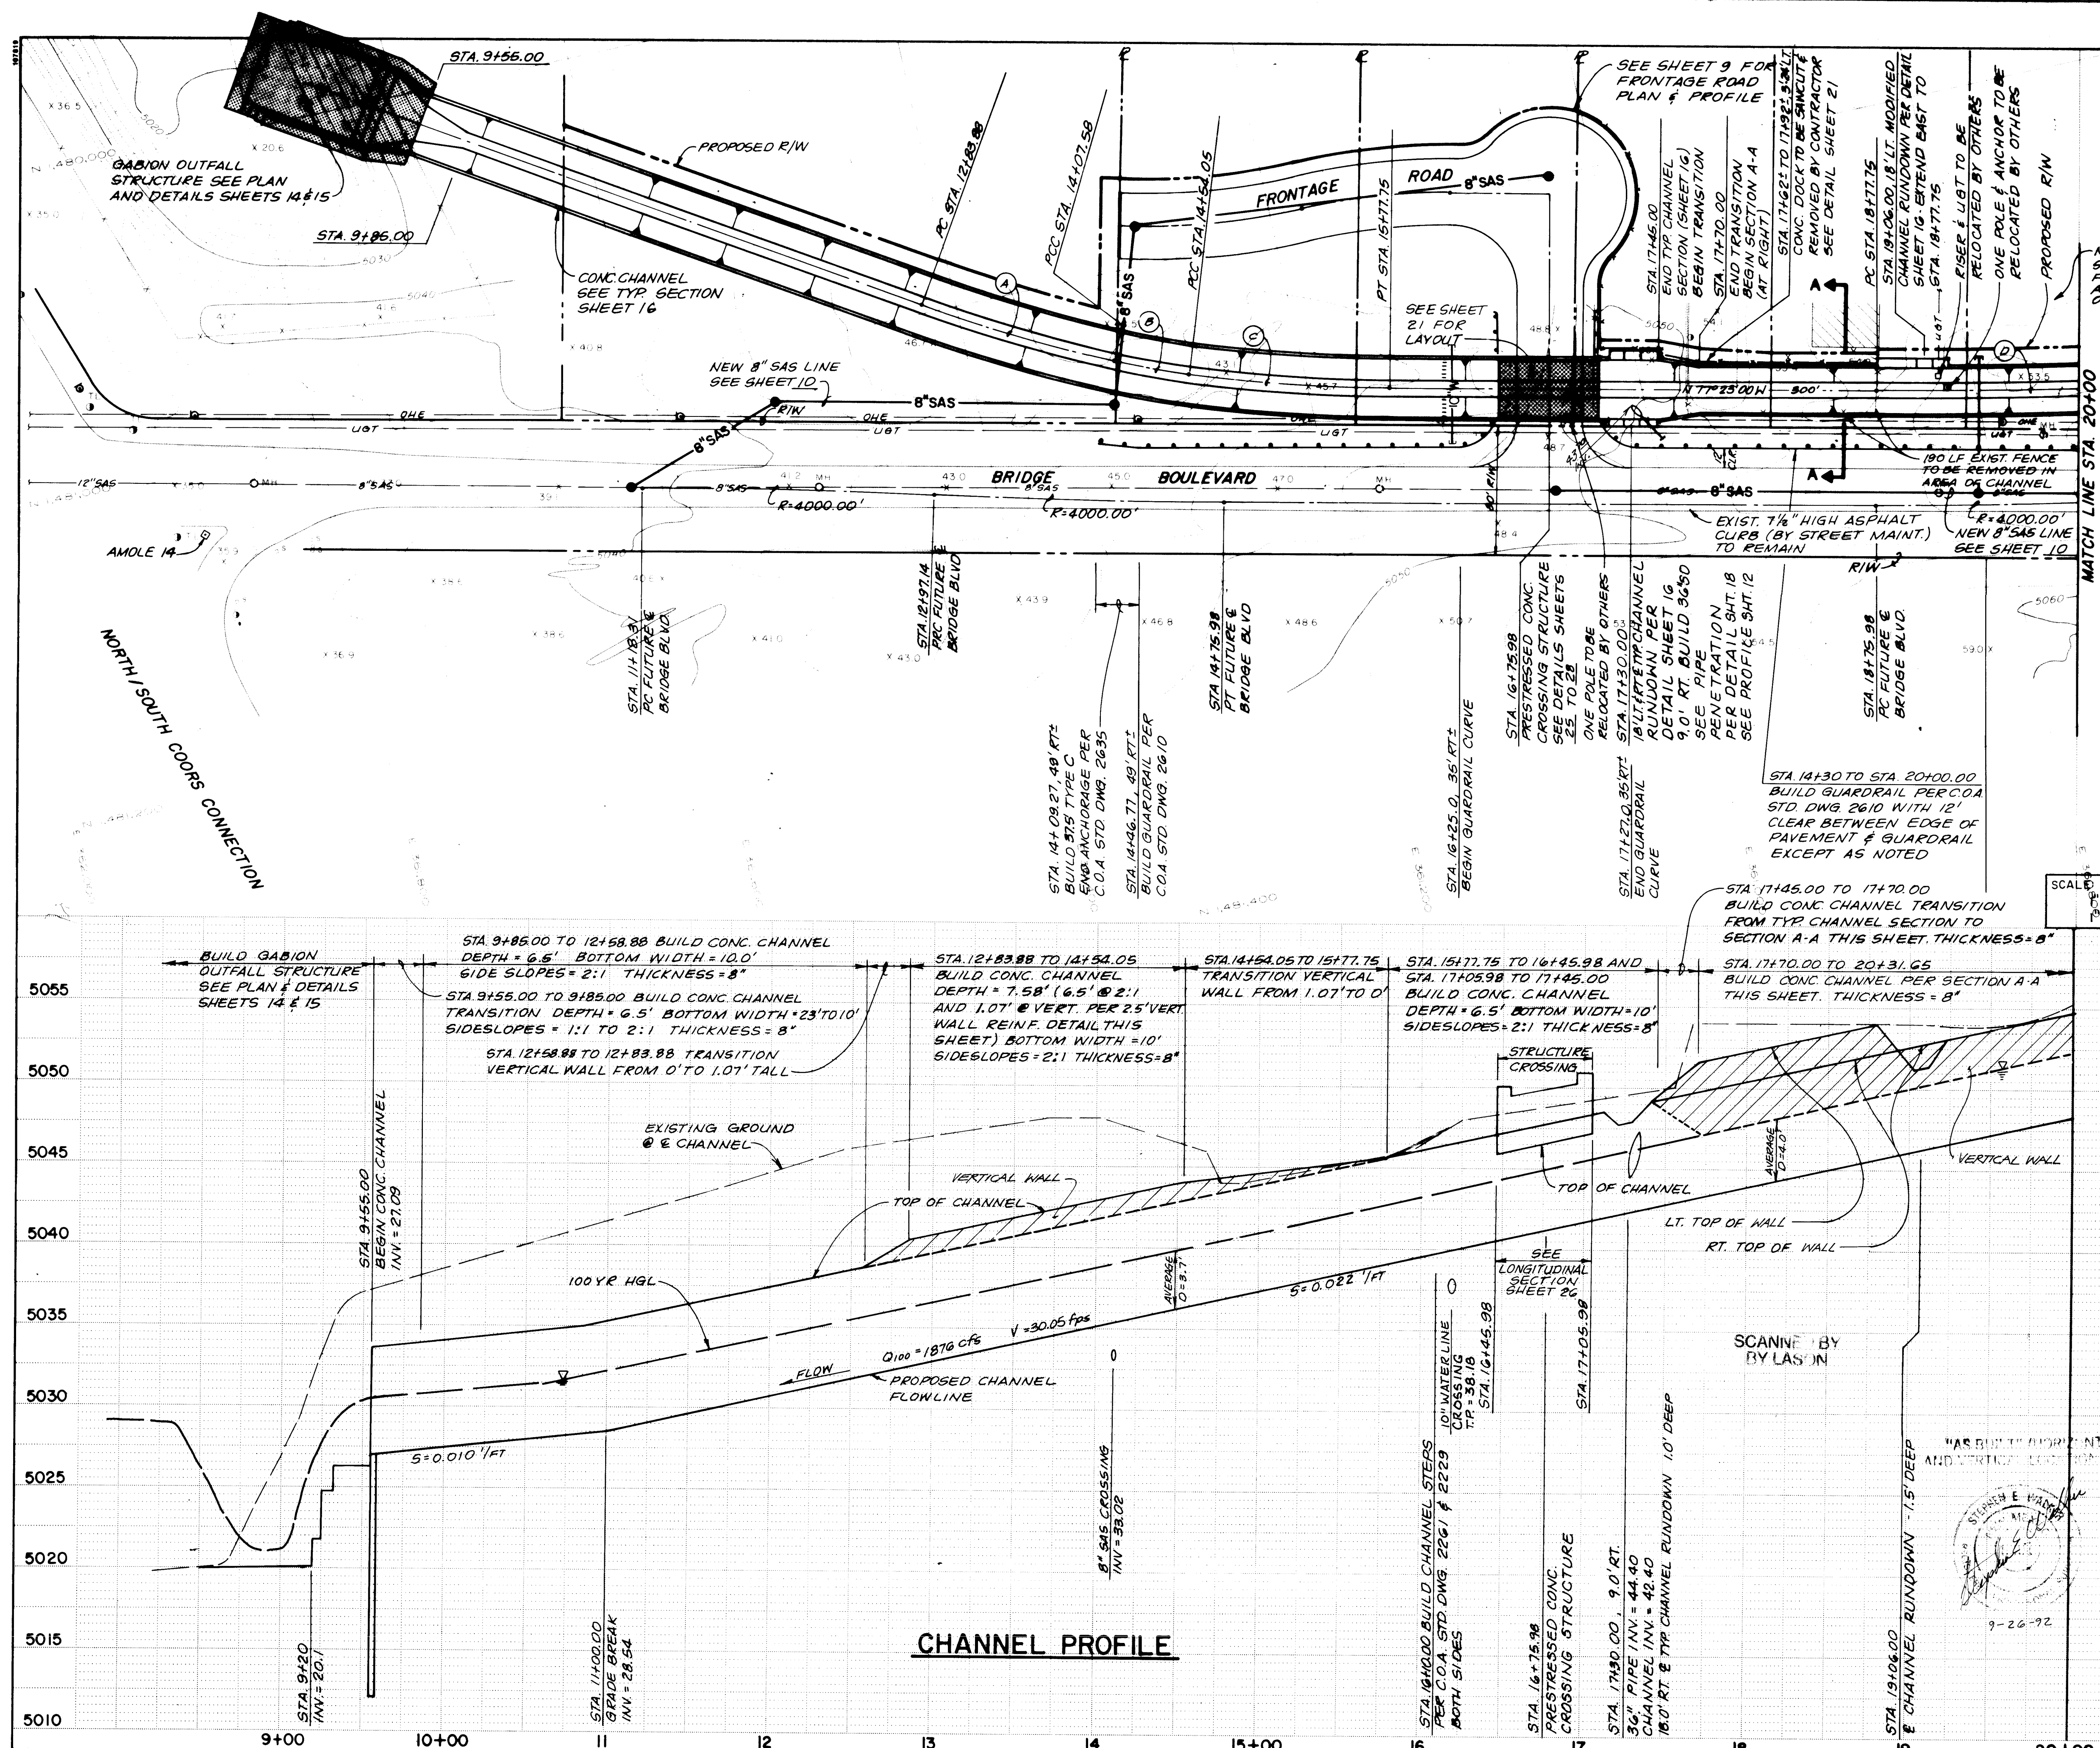

NOTE: SEE SHEET 21 FOR DETAIL OF AREA SOUTH OF CHANNEL



SECTION A-A

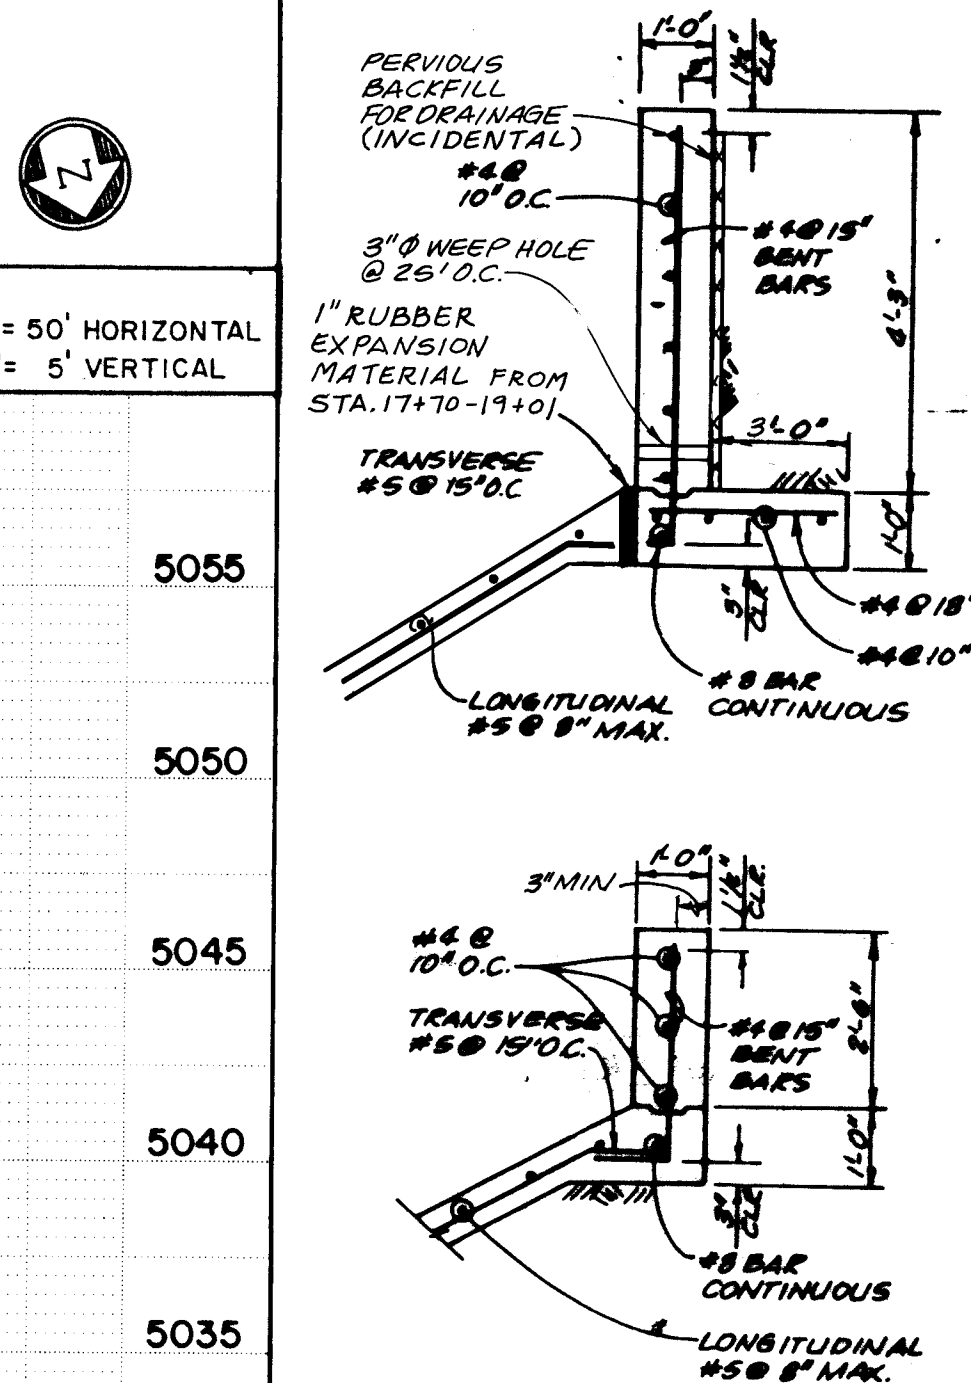

VERTICAL WALL REINFORCING

26 4076.900393

CITY OF ALBUQUERQUE PUBLIC WORKS DEPARTMENT ENGINEERING GROUP					
TITLE: AMOLE DEL NORTE STORM DIVERGENCE FACILITIES - PHASE III TIERRA BATTA DRAINAGE FACILITIES BRIDGE BOULEVARD - STA. 9+00 TO STA. 20+00 CHANNEL & STORM DRAIN					
APPROVALS	ENGINEER	DATE	APPROVALS	ENGINEER	DATE
D.R.C. Chair	10-23-91	Water			
Trans. Dev.	10-23-91	Wastewater			
Hydrology	9-24-91				
DRAWING NO.	4076.90	MAP NO.	L-10	SHEET	3 OF 35

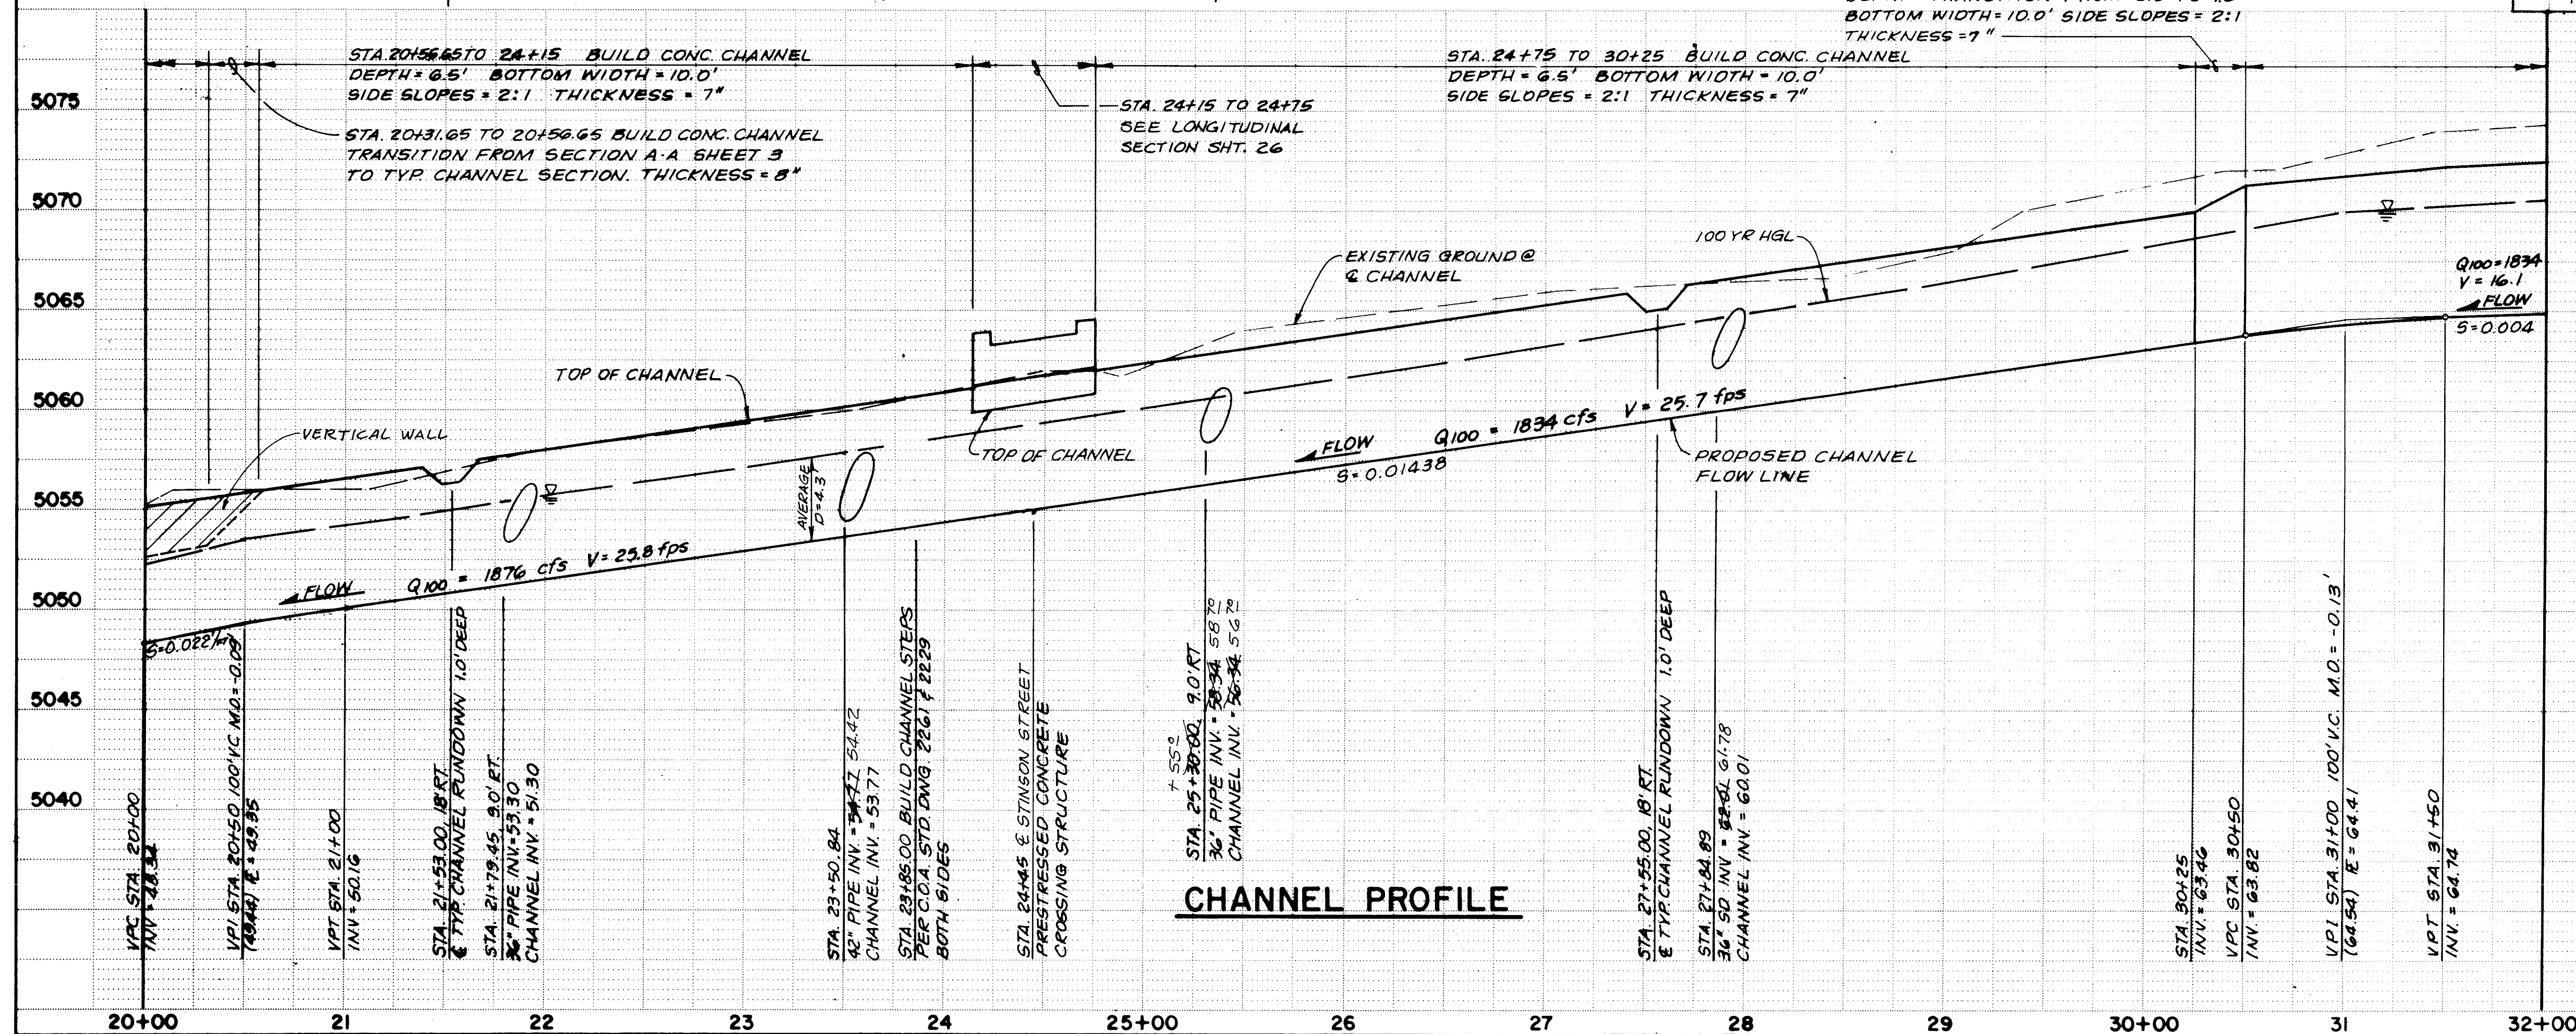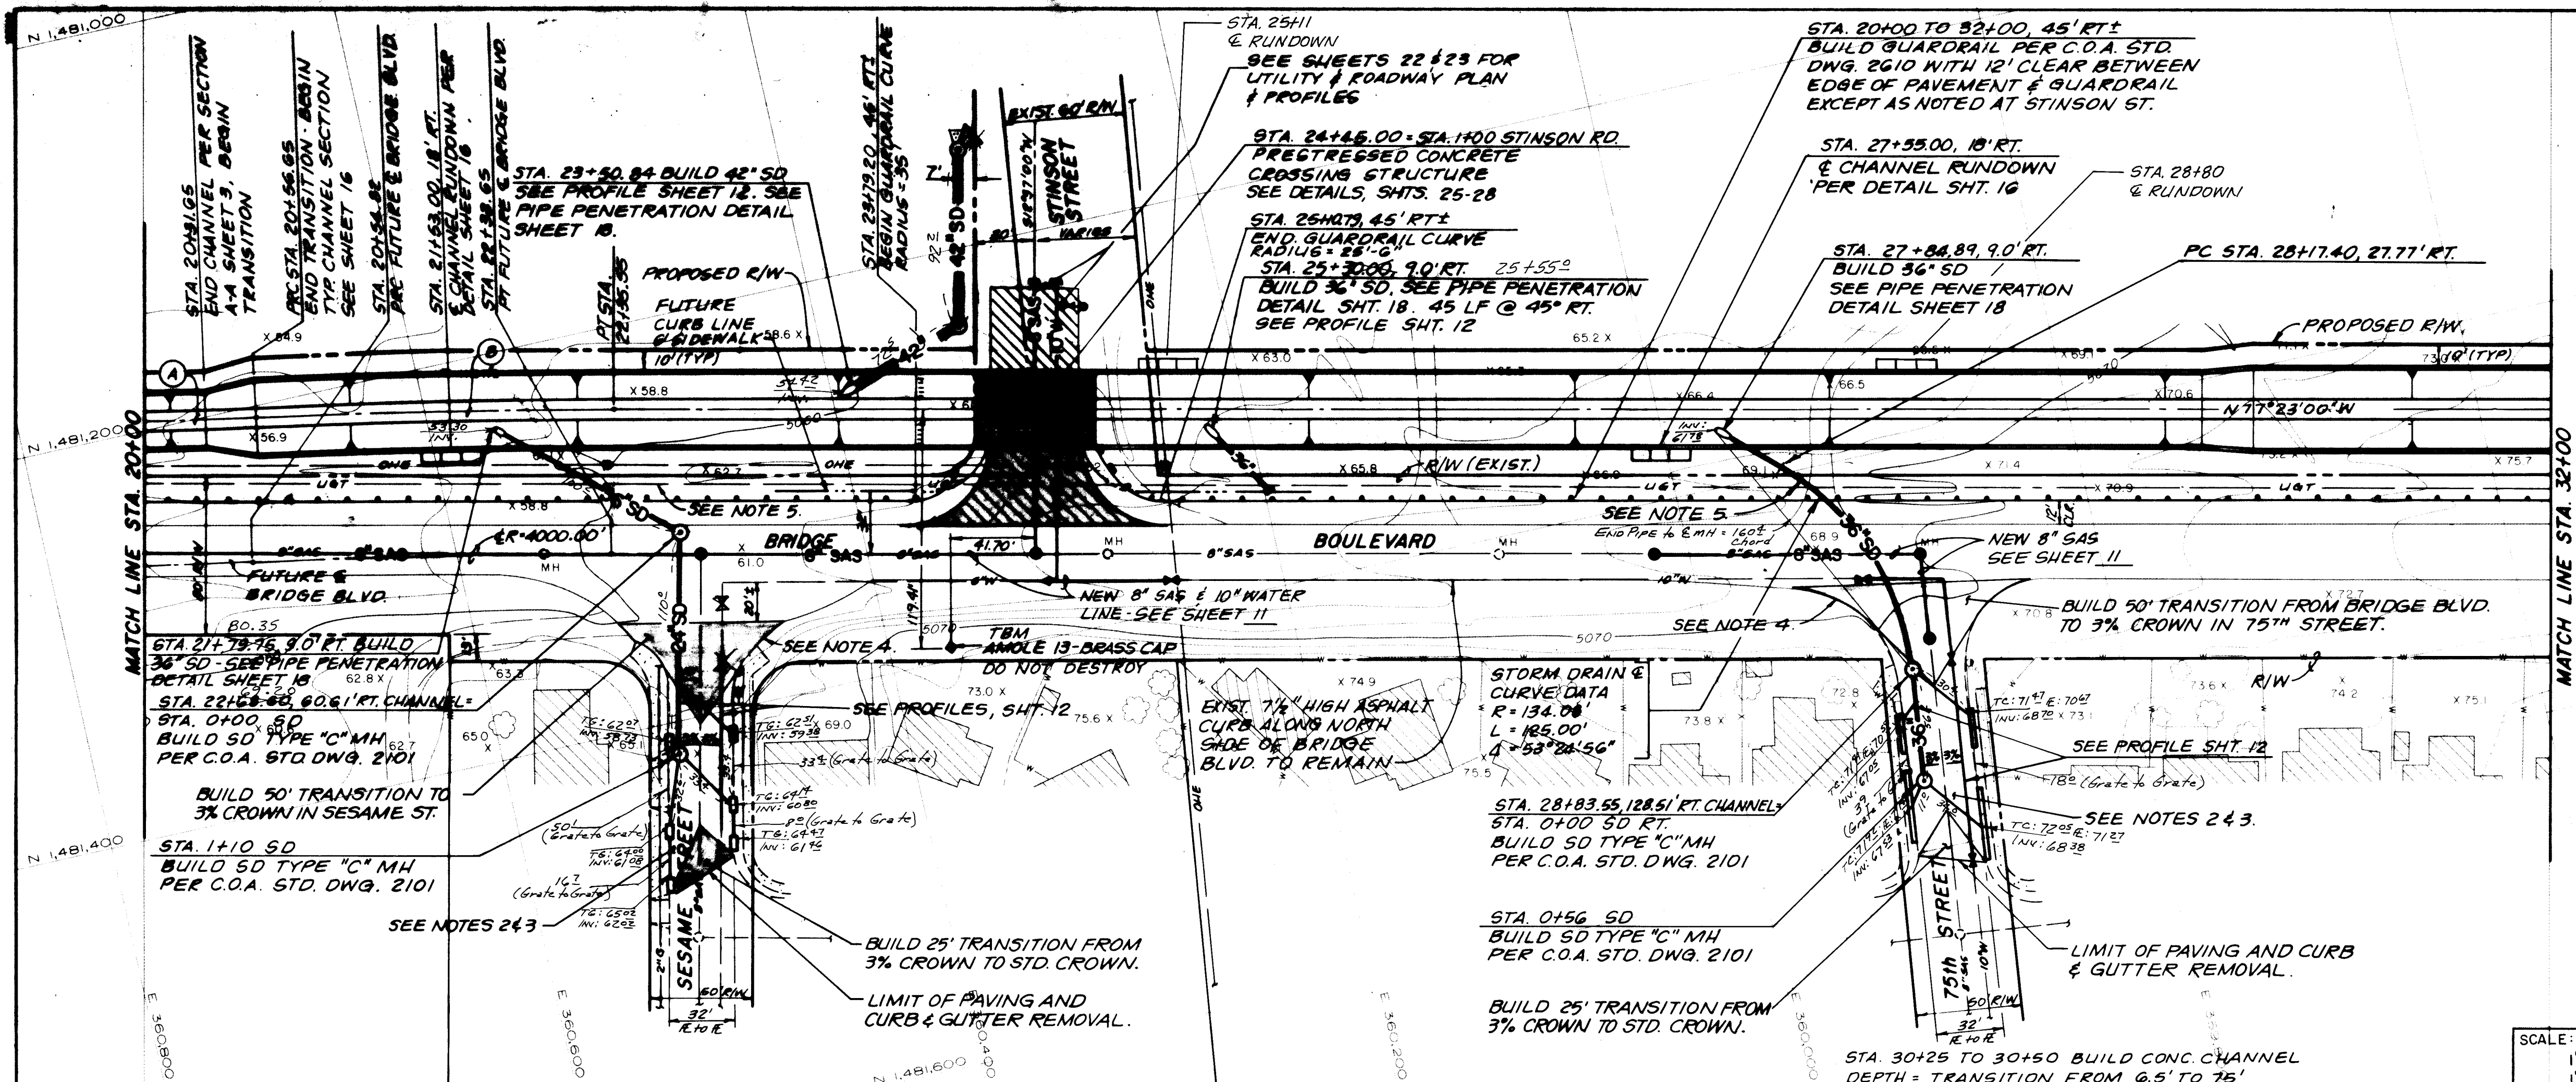

CHANNEL PROFILE

CENTER LINE CURVE DATA:
 A Δ = 02°33'45"
 R = 4000.00'
 L = 178.90'
 T = 83.47'
 B Δ = 02°33'45"
 R = 4000.00'
 L = 178.90'
 T = 83.47'

NOTES:

- CONTRACTOR TO CONTACT PHM AT LEAST THREE WORKING DAYS PRIOR TO EXCAVATING ADJACENT TO POWER POLES. CONTRACTOR SHALL COORDINATE WITH PHM IN SUPPORTING THESE POLES INCLUDING ANY PAYMENT REQUIRED BY PHM.
- SESAME STREET & 75th STREET SHALL BE PAVED AS SHOWN IN C.O.A. STD. DWG. 2406 FOR RESIDENTIAL STREETS, ASPHALT CONCRETE PAVEMENT SECTION - USING A 3% PAVEMENT SLOPE INSTEAD OF 2%.
- CURB & GUTTER SHALL BE REMOVED AS NECESSARY FOR CONSTRUCTION AND REPLACED WITH STANDARD CURB & GUTTER PER C.O.A. STD. DWG. 2415.
- ASPHALT CURB EXISTS ALONG THE NORTH SIDE OF BRIDGE BLVD. AND SHALL BE REMOVED ONLY AS NECESSARY FOR CONSTRUCTION AND REPLACED WITH ASPHALT CURB PER C.O.A. STD. DWG. 2415.
- THE AT&T FIBER OPTIC CABLE MUST BE COVERED AT NIGHT OR AT&T SHALL BE CONTACTED TO PROVIDE A GUARD.
- ALL STATIONING IS ALONG CENTERLINE OF CHANNEL EXCEPT AT SESAME ST. & 75th ST.

SCALE:
 1" = 50' HORIZONTAL
 1" = 5' VERTICAL

ENGINEER'S SEAL

NO. 1880
 DATE 6/7/90
 BY GREENER

NO. 1883
 DATE 7/2/90
 BY GREENER

NO. 1886
 DATE 7/2/90
 BY GREENER

NO. 1889
 DATE 7/2/90
 BY GREENER

NO. 1910
 DATE 9/1/91
 BY GREENER

REVISIONS


DESIGNED BY MSH/SKJ
 DRAWN BY A.H./PRW
 CHECKED BY L.S.J.

DATE 8-91
 DATE 8-91
 DATE 8-91

SCANNED BY BY LASON

26 4076.900493

CITY OF ALBUQUERQUE PUBLIC WORKS DEPARTMENT ENGINEERING GROUP					
TITLE: AMOLE DEL NORTE STORM DIVERSION FACILITIES - PHASE III BRIDGE BOULEVARD- STA. 20+00 TO STA. 32+00 CHANNEL & STORM DRAIN					
APPROVALS	ENGINEER	DATE	APPROVALS	ENGINEER	DATE
D.R.C. Chair	Regalado	10-23-91	Water	McDon	10-1-91
Trans. Dev.	Regalado	10-01-91	Wastewater	McDon	"
Hydrology	Regalado	7-2-91			
DRAWING NO.	4076.90	MAP NO.	L-10	SHEET	4 OF 35

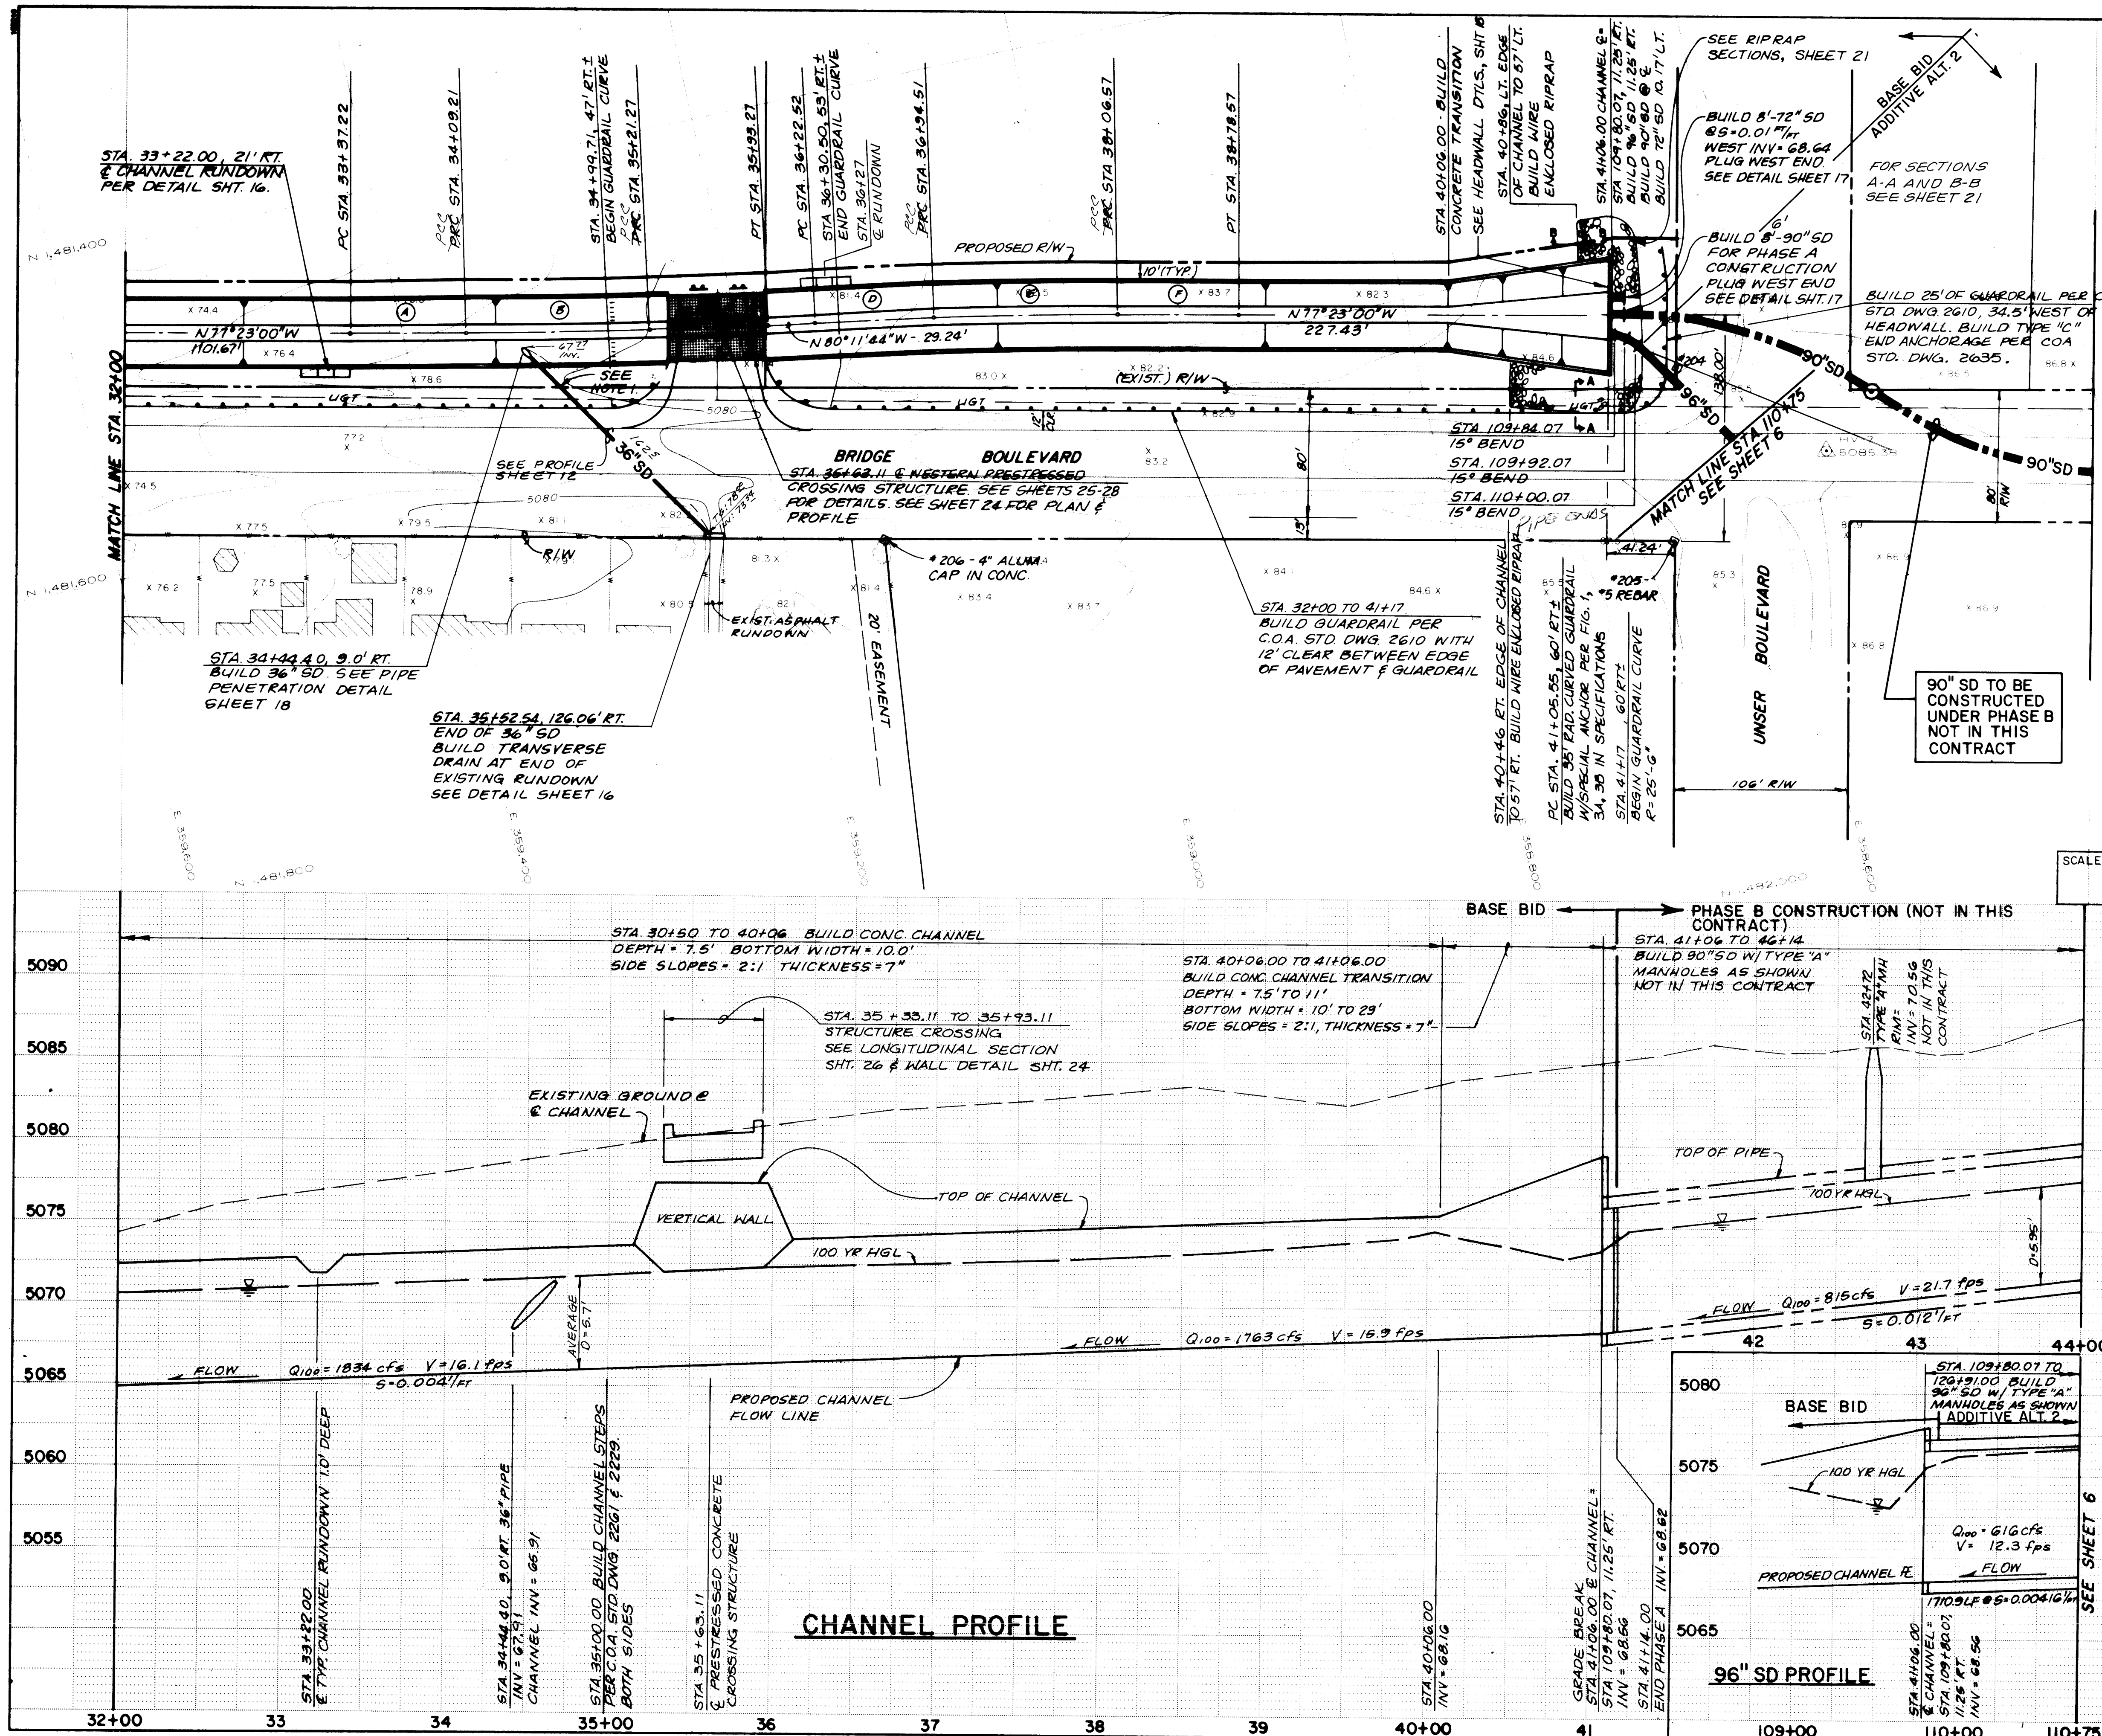

CENTERLINE CURVE DATA:

- A Δ = 0°33'00" R = 7500.00' L = 72.00' T = 38.00'
- B Δ = 01°42'44" R = 3749.83' L = 112.06' T = 56.03'
- C Δ = 00°33'00" R = 7500.00' L = 72.00' T = 38.00'
- D Δ = 00°33'00" R = 7500.00' L = 72.00' T = 38.00'
- E Δ = 01°42'44" R = 3749.83' L = 112.06' T = 56.03'
- F Δ = 00°33'00" R = 7500.00' L = 72.00' T = 38.00'

PHASE A

- NOTES:
- THE AT&T FIBER OPTIC CABLE MUST BE COVERED AT NIGHT OR AT&T SHALL BE CONTACTED TO PROVIDE A GUARD.
 - ALL STATIONING IS ALONG CENTERLINE OF CHANNEL.

SCALE:

1" = 50' HORIZONTAL
1" = 10' VERTICAL

SCANNED BY LASON

26 4076.90593

CITY OF ALBUQUERQUE PUBLIC WORKS DEPARTMENT ENGINEERING GROUP					
TITLE: AMOLE DEL NORTE STORM DIVERSION FACILITIES - PHASE III TIERRA BAYTA DRAINAGE FACILITIES BRIDGE BOULEVARD - STA 32+00 TO STA. 41+06 CHANNEL & STORM DRAIN					
APPROVALS	ENGINEER	DATE	APPROVALS	ENGINEER	DATE
D.R.C. Chair	<i>[Signature]</i>	10-1-91	Water	<i>[Signature]</i>	10-1-91
Trans. Dev.	<i>[Signature]</i>	10-1-91	Wastewater	<i>[Signature]</i>	"
Hydrology	<i>[Signature]</i>	9-24-91			
DRAWING NO.	4076.90	MAP NO.	L-10	SHEET	5 OF 35


RECORD DRAWING

AS BUILT INFORMATION		BENCH MARKS		SURVEY INFORMATION		ENGINEER'S SEAL	
CONTRACTOR	COOPER & COVART	1992		DATE	BY		
WORK	BRIDGE BOULEVARD	1992		NO.	NO.		
INSPECTED BY	WALKER DATE	1992		1880	GREINER		
COPIES	COPIES			1883	GREINER		
FIELD	FIELD			1886	GREINER		
DATE	DATE			1888	GREINER	DESIGNED BY SKJ DRAWN BY A/H CHECKED BY L/SJ	
DATE	DATE			1893	GREINER		
DATE	DATE			1910	GREINER		


MAPS

6, 7, 8.


missing

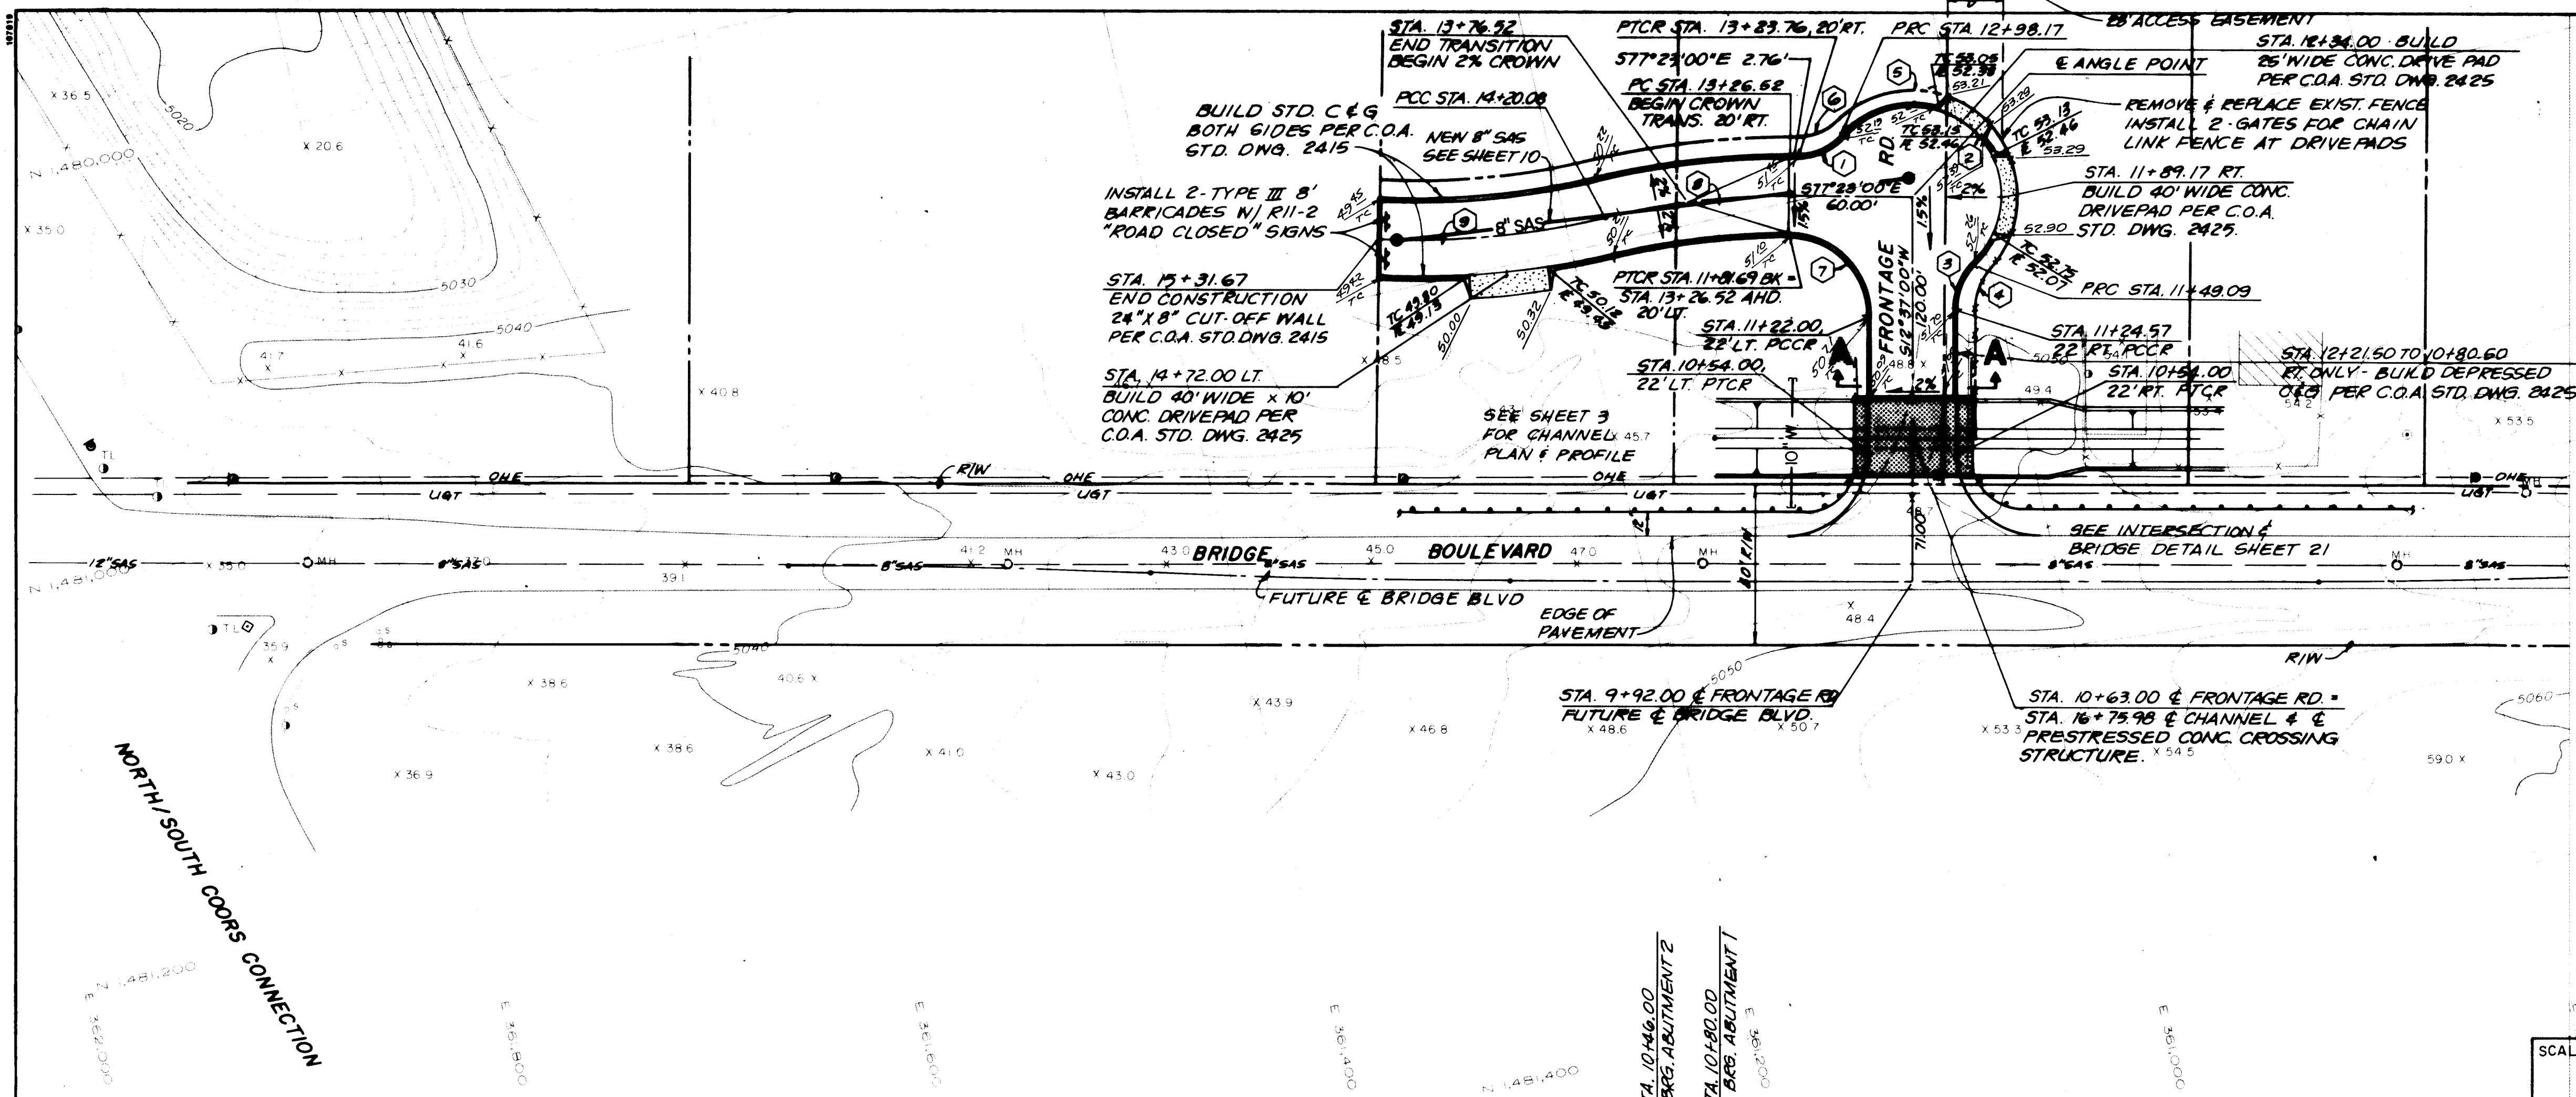

NORTH/SOUTH COORDS CONNECTION
 480,000
 481,200
 482,400
 483,600
 484,800
 486,000
 487,200
 488,400
 489,600
 490,800
 492,000
 493,200
 494,400
 495,600
 496,800
 498,000
 499,200
 500,400
 501,600
 502,800
 504,000
 505,200
 506,400
 507,600
 508,800
 510,000
 511,200
 512,400
 513,600
 514,800
 516,000
 517,200
 518,400
 519,600
 520,800
 522,000
 523,200
 524,400
 525,600
 526,800
 528,000
 529,200
 530,400
 531,600
 532,800
 534,000
 535,200
 536,400
 537,600
 538,800
 540,000
 541,200
 542,400
 543,600
 544,800
 546,000
 547,200
 548,400
 549,600
 550,800
 552,000
 553,200
 554,400
 555,600
 556,800
 558,000
 559,200
 560,400
 561,600
 562,800
 564,000
 565,200
 566,400
 567,600
 568,800
 570,000
 571,200
 572,400
 573,600
 574,800
 576,000
 577,200
 578,400
 579,600
 580,800
 582,000
 583,200
 584,400
 585,600
 586,800
 588,000
 589,200
 590,400
 591,600
 592,800
 594,000
 595,200
 596,400
 597,600
 598,800
 600,000
 601,200
 602,400
 603,600
 604,800
 606,000
 607,200
 608,400
 609,600
 610,800
 612,000
 613,200
 614,400
 615,600
 616,800
 618,000
 619,200
 620,400
 621,600
 622,800
 624,000
 625,200
 626,400
 627,600
 628,800
 630,000
 631,200
 632,400
 633,600
 634,800
 636,000
 637,200
 638,400
 639,600
 640,800
 642,000
 643,200
 644,400
 645,600
 646,800
 648,000
 649,200
 650,400
 651,600
 652,800
 654,000
 655,200
 656,400
 657,600
 658,800
 660,000
 661,200
 662,400
 663,600
 664,800
 666,000
 667,200
 668,400
 669,600
 670,800
 672,000
 673,200
 674,400
 675,600
 676,800
 678,000
 679,200
 680,400
 681,600
 682,800
 684,000
 685,200
 686,400
 687,600
 688,800
 690,000
 691,200
 692,400
 693,600
 694,800
 696,000
 697,200
 698,400
 699,600
 700,800
 702,000
 703,200
 704,400
 705,600
 706,800
 708,000
 709,200
 710,400
 711,600
 712,800
 714,000
 715,200
 716,400
 717,600
 718,800
 720,000
 721,200
 722,400
 723,600
 724,800
 726,000
 727,200
 728,400
 729,600
 730,800
 732,000
 733,200
 734,400
 735,600
 736,800
 738,000
 739,200
 740,400
 741,600
 742,800
 744,000
 745,200
 746,400
 747,600
 748,800
 750,000
 751,200
 752,400
 753,600
 754,800
 756,000
 757,200
 758,400
 759,600
 760,800
 762,000
 763,200
 764,400
 765,600
 766,800
 768,000
 769,200
 770,400
 771,600
 772,800
 774,000
 775,200
 776,400
 777,600
 778,800
 780,000
 781,200
 782,400
 783,600
 784,800
 786,000
 787,200
 788,400
 789,600
 790,800
 792,000
 793,200
 794,400
 795,600
 796,800
 798,000
 799,200
 800,400
 801,600
 802,800
 804,000
 805,200
 806,400
 807,600
 808,800
 810,000
 811,200
 812,400
 813,600
 814,800
 816,000
 817,200
 818,400
 819,600
 820,800
 822,000
 823,200
 824,400
 825,600
 826,800
 828,000
 829,200
 830,400
 831,600
 832,800
 834,000
 835,200
 836,400
 837,600
 838,800
 840,000
 841,200
 842,400
 843,600
 844,800
 846,000
 847,200
 848,400
 849,600
 850,800
 852,000
 853,200
 854,400
 855,600
 856,800
 858,000
 859,200
 860,400
 861,600
 862,800
 864,000
 865,200
 866,400
 867,600
 868,800
 870,000
 871,200
 872,400
 873,600
 874,800
 876,000
 877,200
 878,400
 879,600
 880,800
 882,000
 883,200
 884,400
 885,600
 886,800
 888,000
 889,200
 890,400
 891,600
 892,800
 894,000
 895,200
 896,400
 897,600
 898,800
 900,000
 901,200
 902,400
 903,600
 904,800
 906,000
 907,200
 908,400
 909,600
 910,800
 912,000
 913,200
 914,400
 915,600
 916,800
 918,000
 919,200
 920,400
 921,600
 922,800
 924,000
 925,200
 926,400
 927,600
 928,800
 930,000
 931,200
 932,400
 933,600
 934,800
 936,000
 937,200
 938,400
 939,600
 940,800
 942,000
 943,200
 944,400
 945,600
 946,800
 948,000
 949,200
 950,400
 951,600
 952,800
 954,000
 955,200
 956,400
 957,600
 958,800
 960,000
 961,200
 962,400
 963,600
 964,800
 966,000
 967,200
 968,400
 969,600
 970,800
 972,000
 973,200
 974,400
 975,600
 976,800
 978,000
 979,200
 980,400
 981,600
 982,800
 984,000
 985,200
 986,400
 987,600
 988,800
 990,000
 991,200
 992,400
 993,600
 994,800
 996,000
 997,200
 998,400
 1000,000

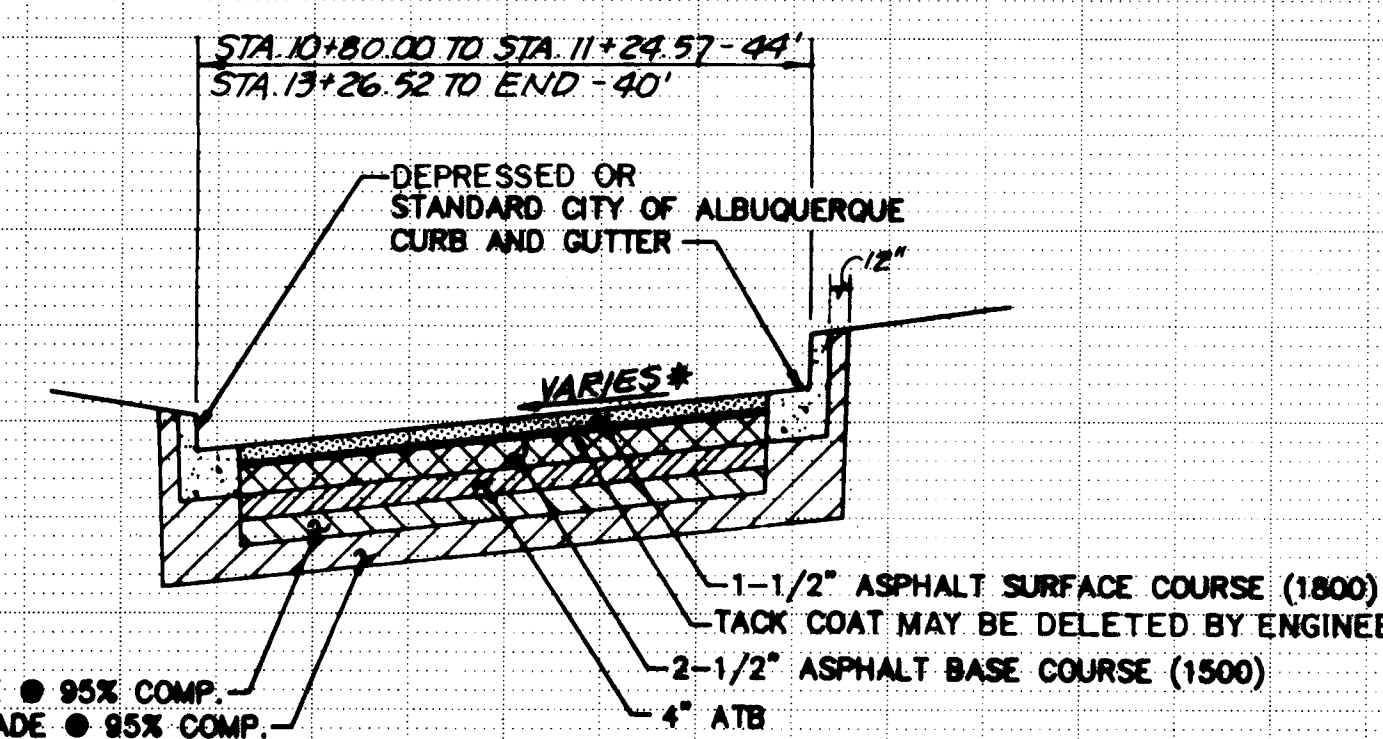

* 2% CROSS SLOPE - STA. 10+44.00 TO STA. 13+26.52
 30' CROWN TRANSITION - STA. 13+26.52 TO STA. 13+76.52
 2% STD. CROWN - STA. 13+76.52 TO END

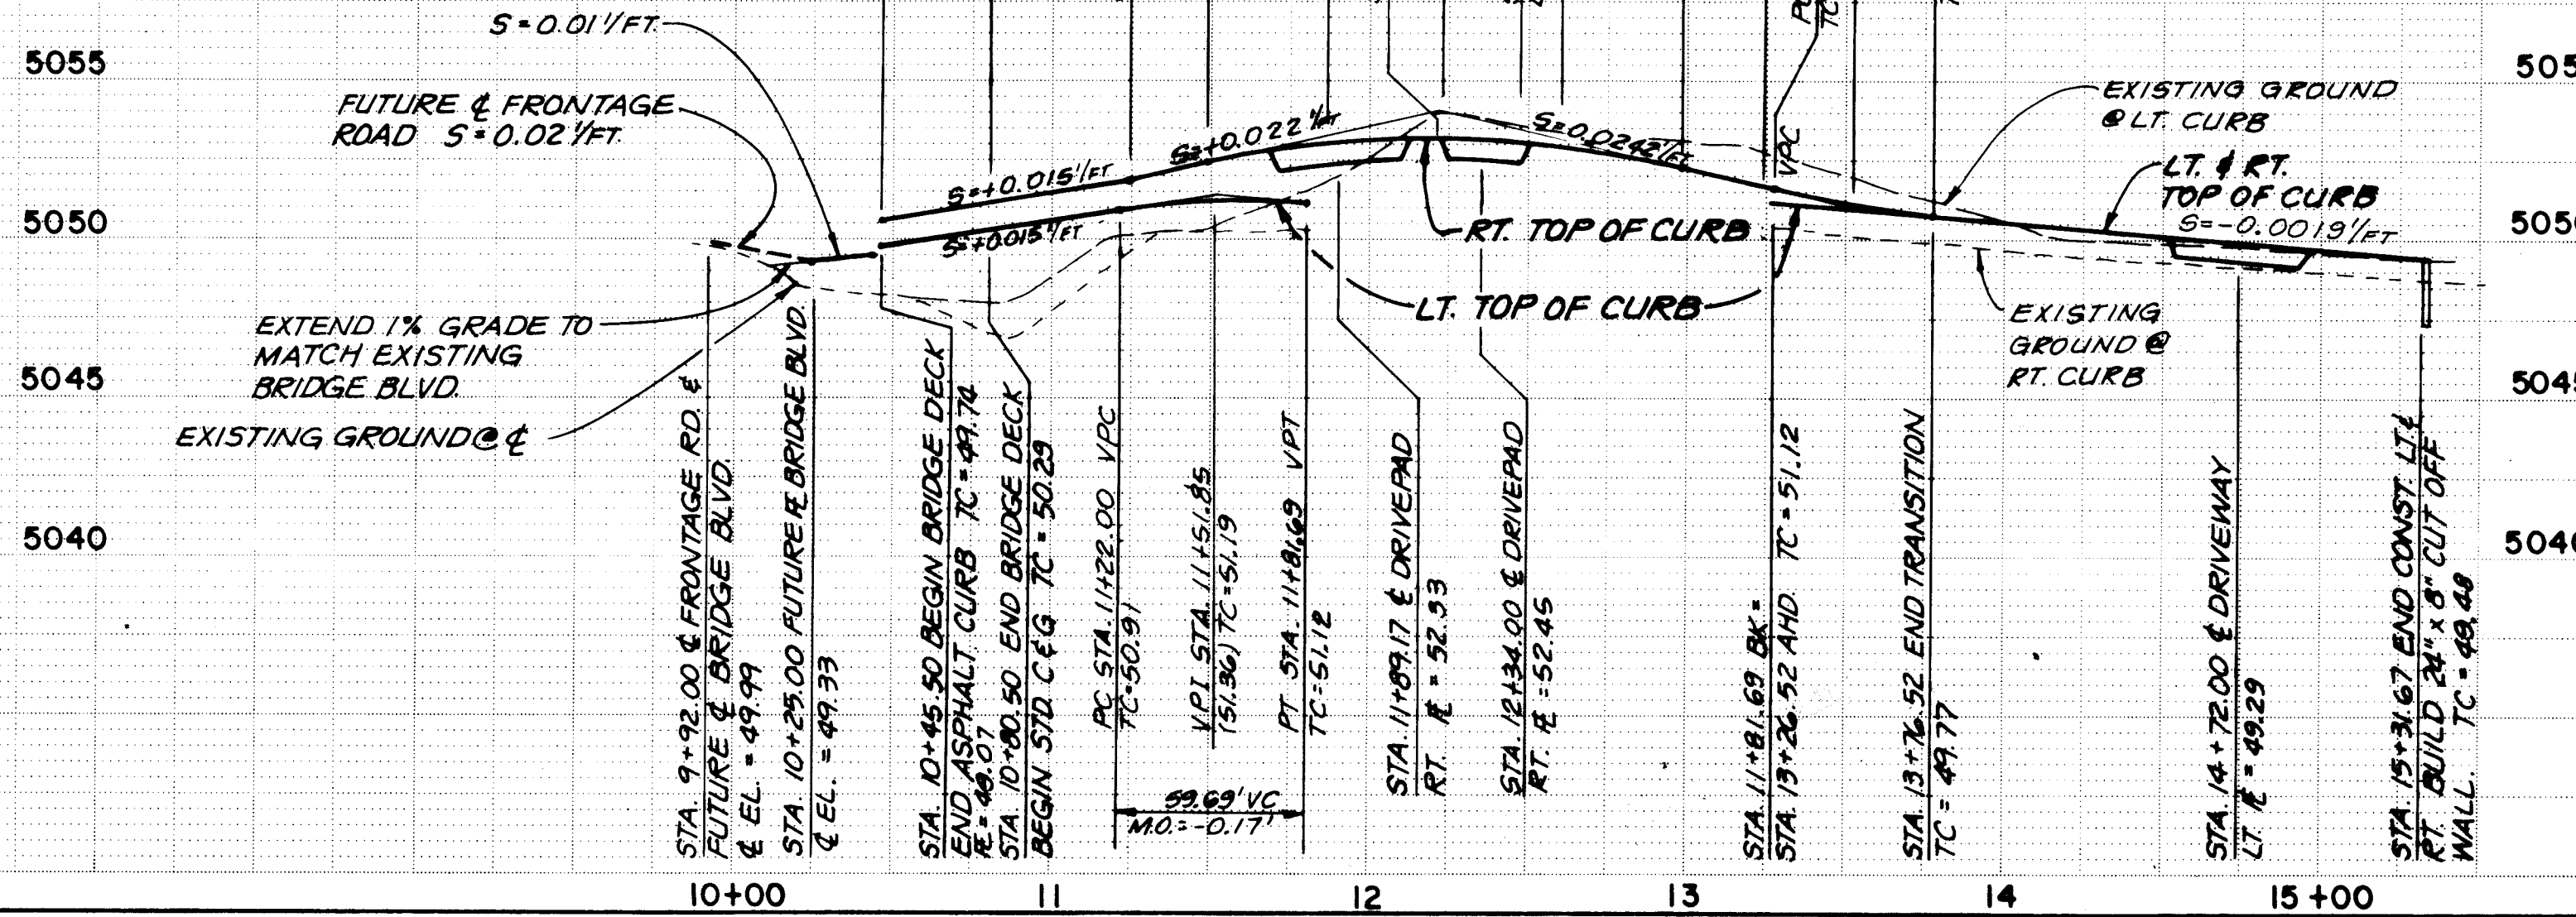

REMARKS ROAD CURVE DATA:

1	A = 40°12'30"	7	A = 80°00'00"
	R = 35.00'		R = 35.00'
	L = 25.00'		L = 35.00'
	T = 13.00'		T = 35.00'
2	A = 108°41'13"	8	A = 15°00'00"
	R = 40.00'		R = 40.00'
	L = 140.00'		L = 35.00'
	T = -		T = 45.00'
3	A = 40°40'30"	9	A = 15°00'00"
	R = 30.00'		R = 40.00'
	L = 24.52'		L = 111.00'
	T = 12.00'		T = 35.16'
4	A = 41°40'12"		
	R = 30.00'		
	L = 21.82'		
	T = 11.42'		
5	A = 175°23'01"		
	R = 53.00'		
	L = 102.28'		
	T = -		
6	A = 44°02'36"		
	R = 30.00'		
	L = 28.08'		
	T = 12.13'		

SCANNED BY LASON

26 4076.90 900993


CITY OF ALBUQUERQUE
 PUBLIC WORKS DEPARTMENT
 ENGINEERING GROUP

TITLE: AMOLE DEL NORTE STORM DRAINAGE FACILITIES - PHASE III
 FRONTAGE ROAD - PAVING


APPROVALS	ENGINEER	DATE	APPROVALS	ENGINEER	DATE
D.R.C. Chair	<i>[Signature]</i>	9-23-91	Water	<i>[Signature]</i>	10-1-91
Trans. Dev.	<i>[Signature]</i>	9-21-91	Wastewater	<i>[Signature]</i>	"
Hydrology	<i>[Signature]</i>	9/24/91			

DRAWING NO. 4076.90 MAP NO. L-10 SHEET 9 OF 35

AS BUILT INFORMATION			BENCH MARKS			SURVEY INFORMATION			ENGINEER'S SEAL		
CONTRACTOR	MOORE & COLEMAN	1988	TRIM-ANGLE 13 - BRASS CAP SET IN THE NORTH SIDE OF	DATE	BY	NO.	1980	GREENER	1980	GREENER	1980
DESIGNED BY	WALKER	1988	BRIDGE BOULEVARD APPROXIMATELY 90' NORTH OF THE EDGE	7/80	GREENER	1980	GREENER	1980	GREENER	1980	GREENER
CHECKED BY	WALKER	1988	OF PAVEMENT AND APPROXIMATELY 100' WEST OF SESAME	7/80	GREENER	1980	GREENER	1980	GREENER	1980	GREENER
RECORDED BY	WALKER	1988	STREET. N = 1,481,500.00 E = 300,570.00 ELEV = 5072.00	7/80	GREENER	1980	GREENER	1980	GREENER	1980	GREENER
DATE	WALKER	1988	TRIM-ANGLE 14 - BRASS CAP ON THE NORTHWESTERLY TURN	7/80	GREENER	1980	GREENER	1980	GREENER	1980	GREENER
	WALKER	1988	IN THE INTERSECTION OF NORTHWESTLY TURN	7/80	GREENER	1980	GREENER	1980	GREENER	1980	GREENER
	WALKER	1988	CONNECTION AND BRIDGE BOULEVARD. N = 1,481,500.00 E =	7/80	GREENER	1980	GREENER	1980	GREENER	1980	GREENER
	WALKER	1988	301,800.107 ELEV = 5008.731	7/80	GREENER	1980	GREENER	1980	GREENER	1980	GREENER

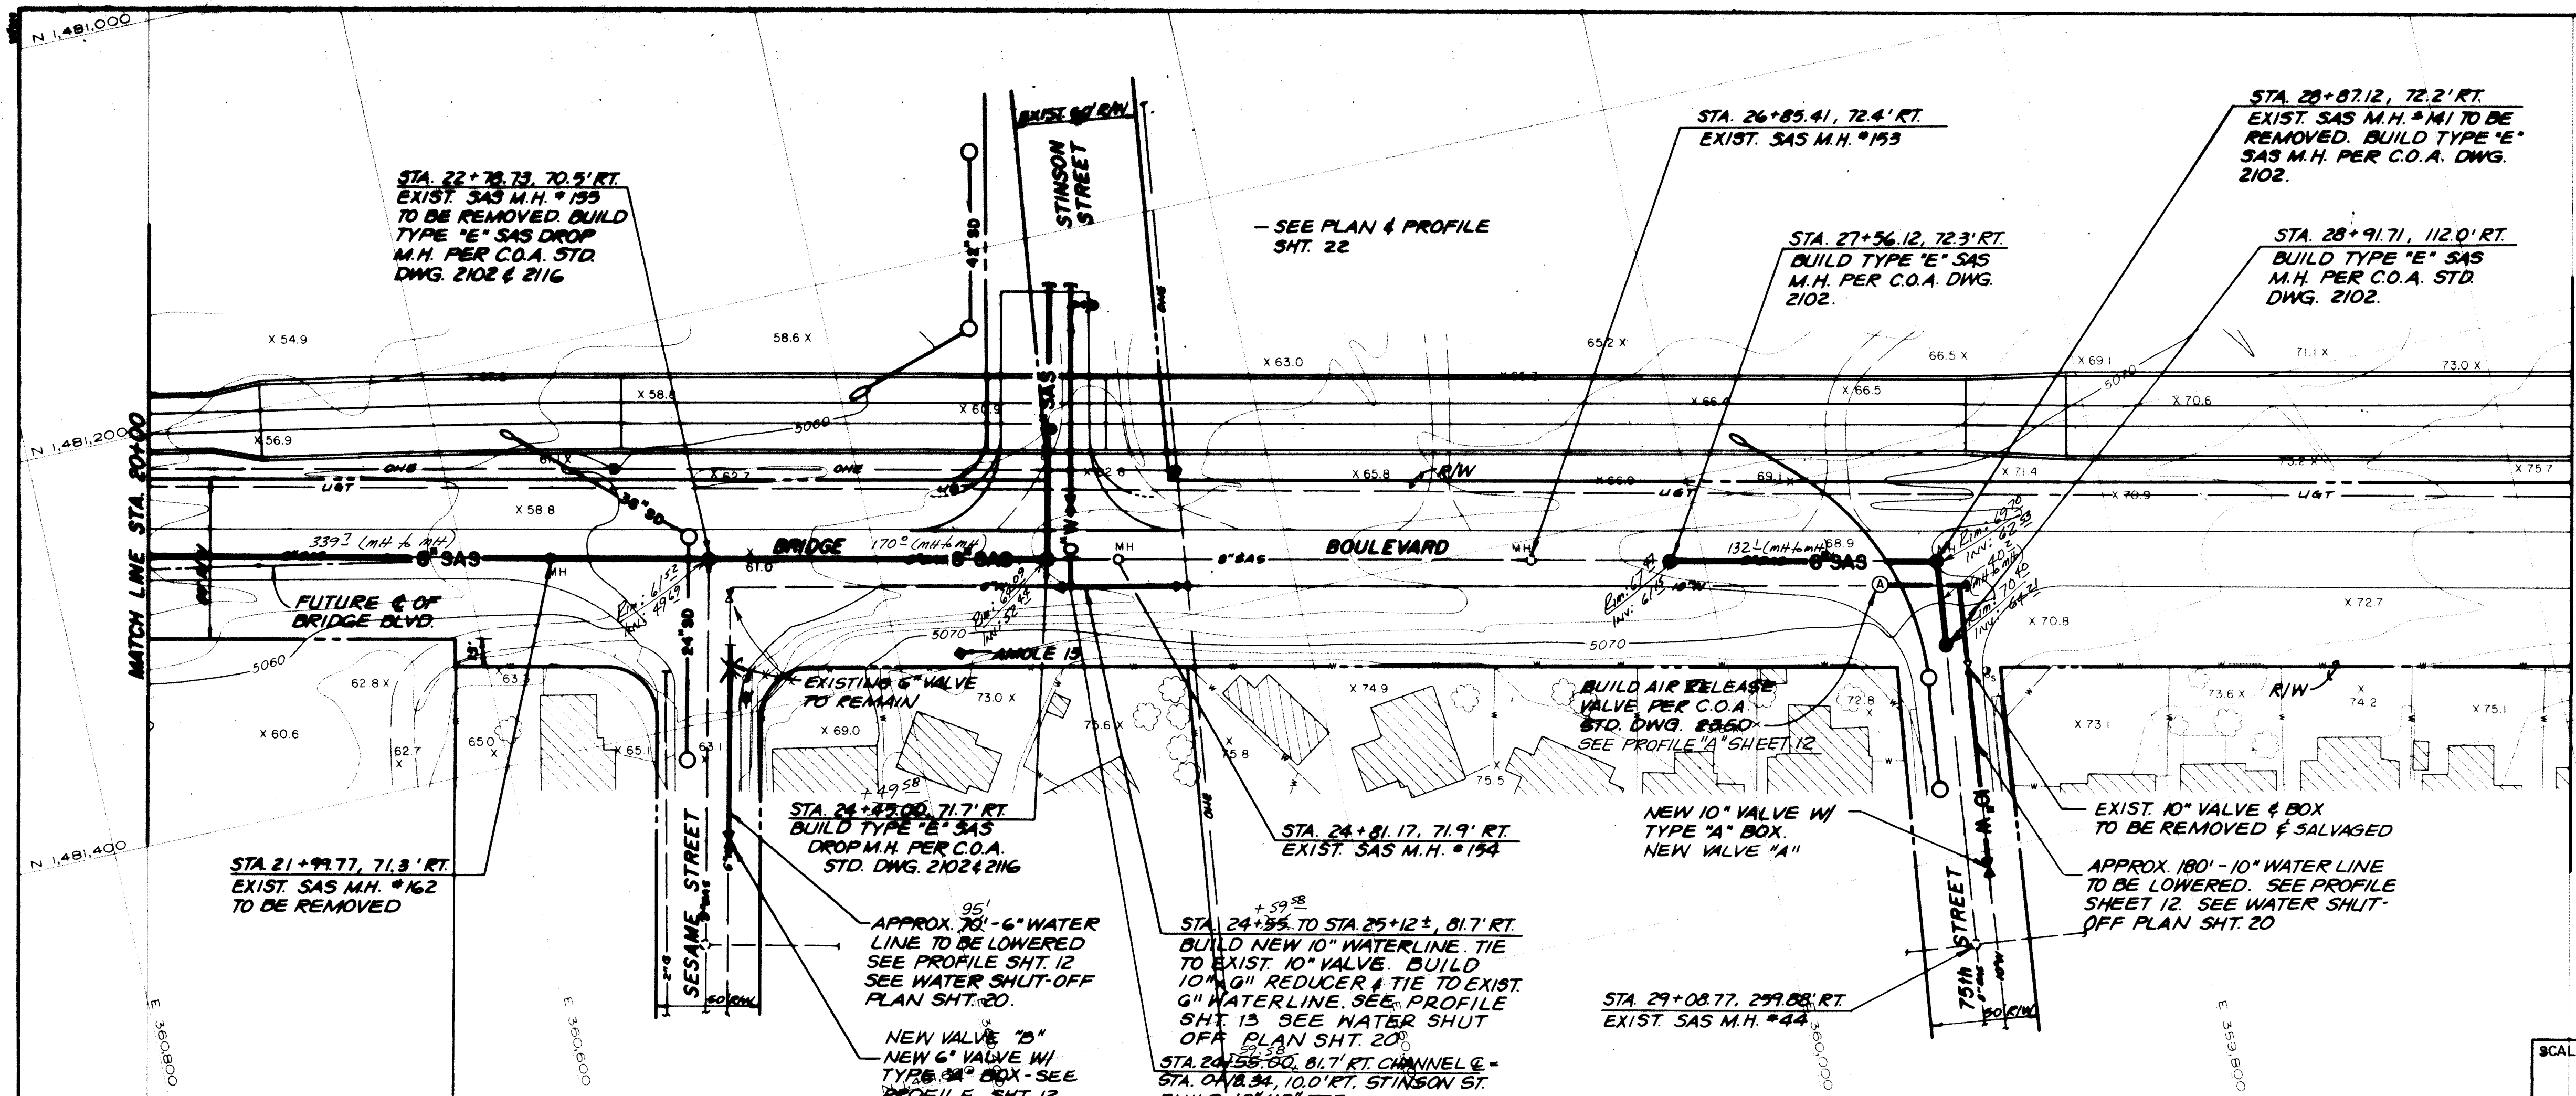


SCALE:
1" = 50' HORIZONTAL
1" = 5' VERTICAL

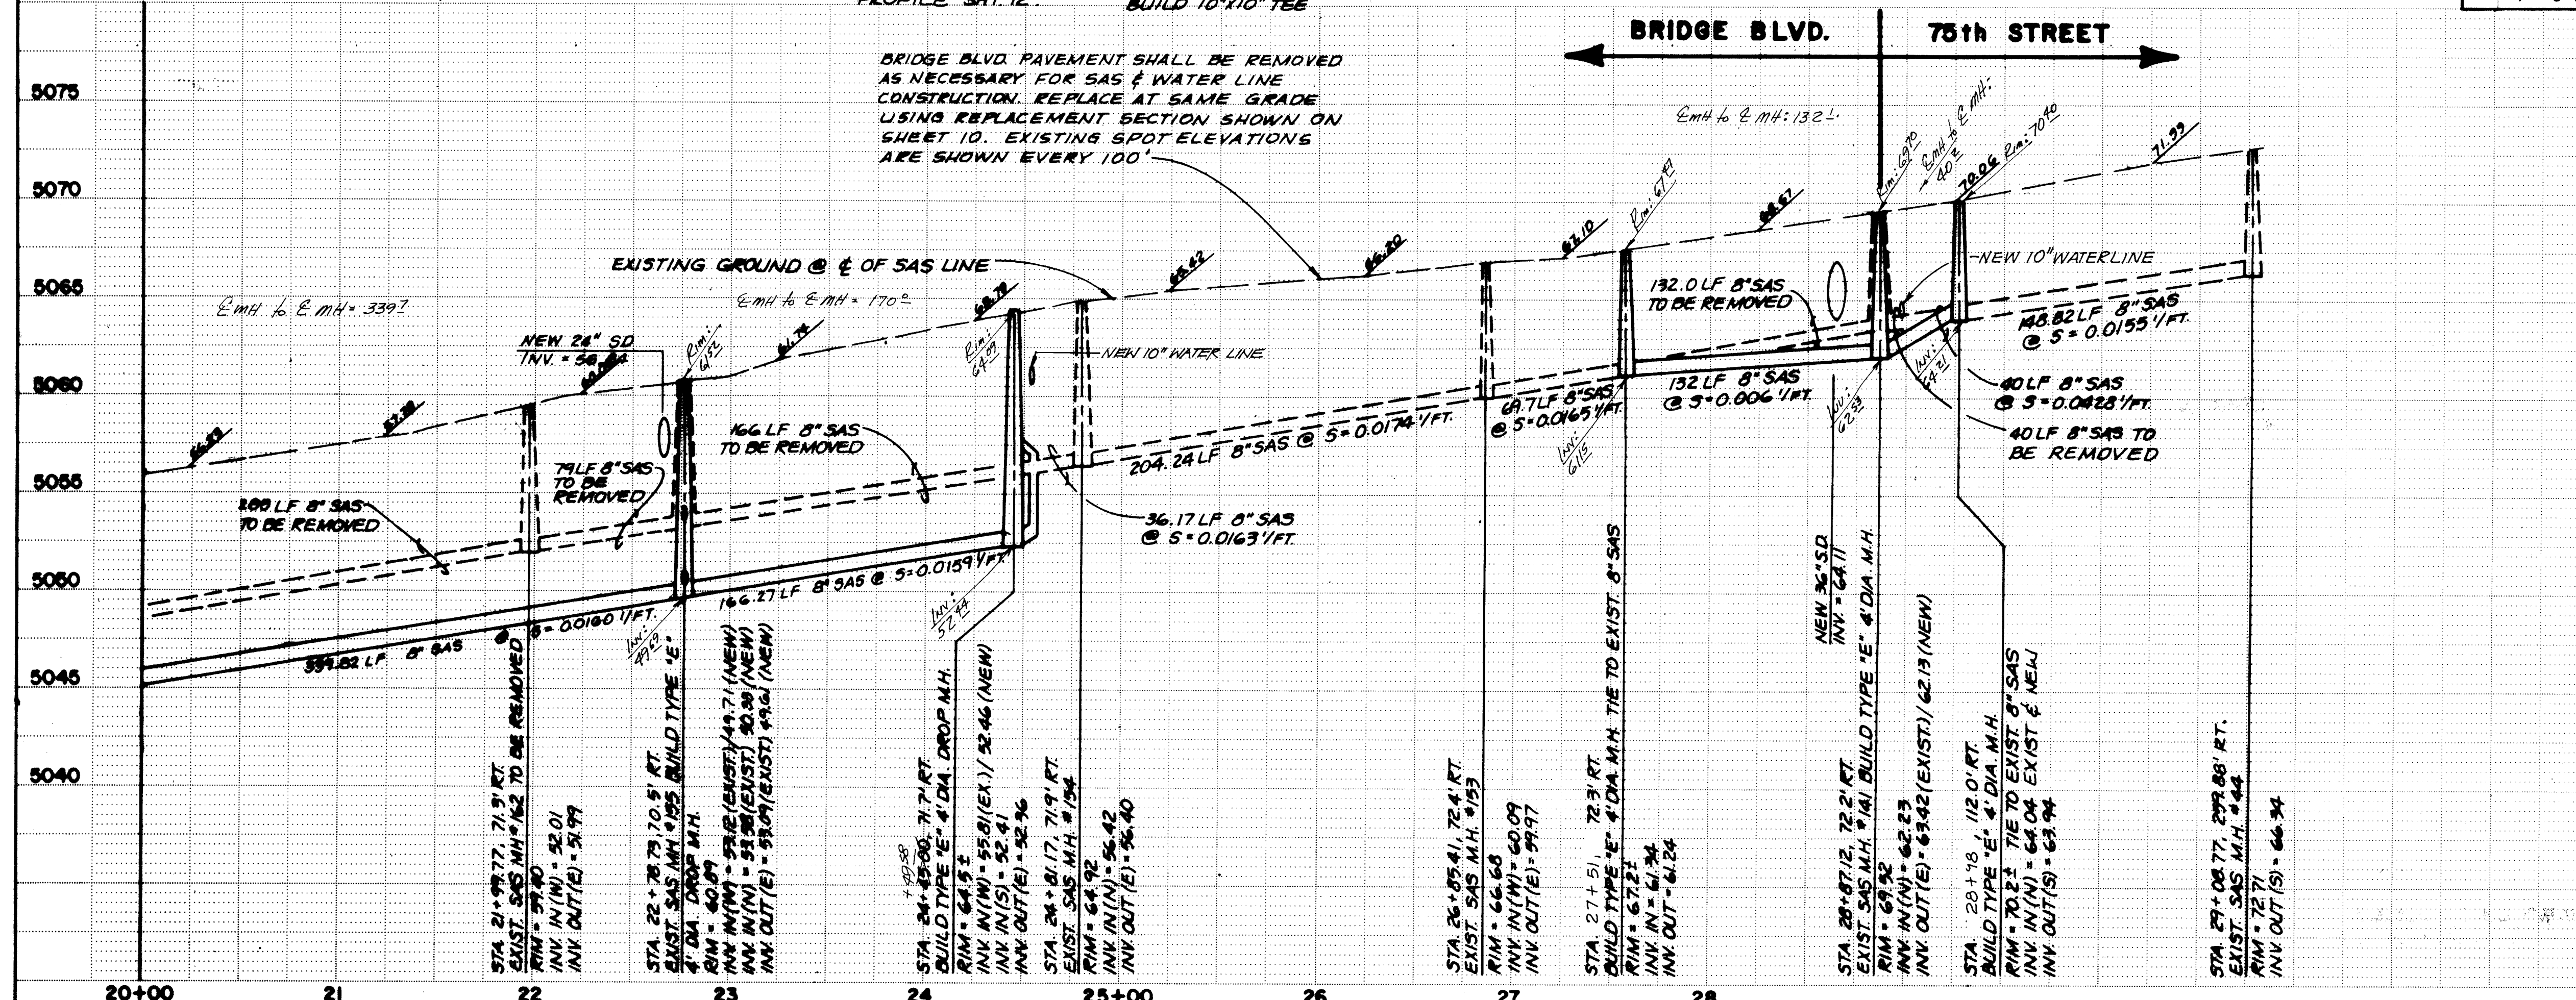

NOTE:
ALL STATIONING IS ALONG CENTERLINE OF CHANNEL.

SCANNED BY
BY LASON

"AS BUILT" HORIZONTAL
AND VERTICAL LOCATION ONLY

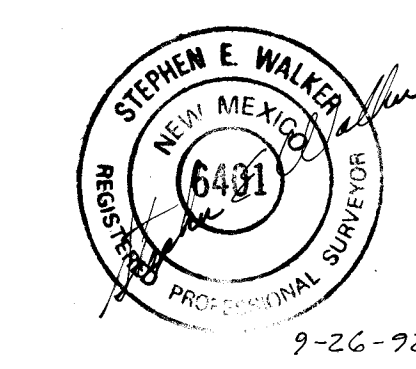



1 2 3 4 5 6 7 8 9 10 11 12 13 14 15
26 4076.90 901193

CITY OF ALBUQUERQUE PUBLIC WORKS DEPARTMENT ENGINEERING GROUP				
TITLE: AMOLE DEL NORTE STORM DRAINAGE FACILITIES - PHASE III BRIDGE BOULEVARD-STA. 20+00 TO STA. 32+00 WATER & SANITARY SEWER				
APPROVALS	ENGINEER	DATE	APPROVALS	ENGINEER
D.R.C. Chair	<i>[Signature]</i>	10-23-91	Water	<i>[Signature]</i>
Trans. Dev.	<i>[Signature]</i>	10-24-91	Wastewater	<i>[Signature]</i>
Hydrology	<i>[Signature]</i>	9/24/91		
DRAWING NO.	4076.90	MAP NO.	L-10	SHEET 11 OF 35

RECORD DRAWING

ORIGINAL			
SURVEY	SURVEYED	BY	DATE
	PLOTTED		
NOTE BOOK	TEMPLATE		
	AREAS		
NO	AREAS CHECKED		

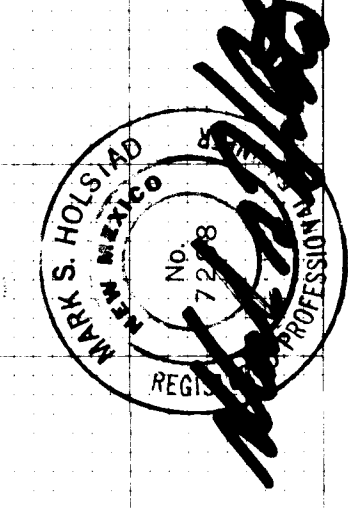

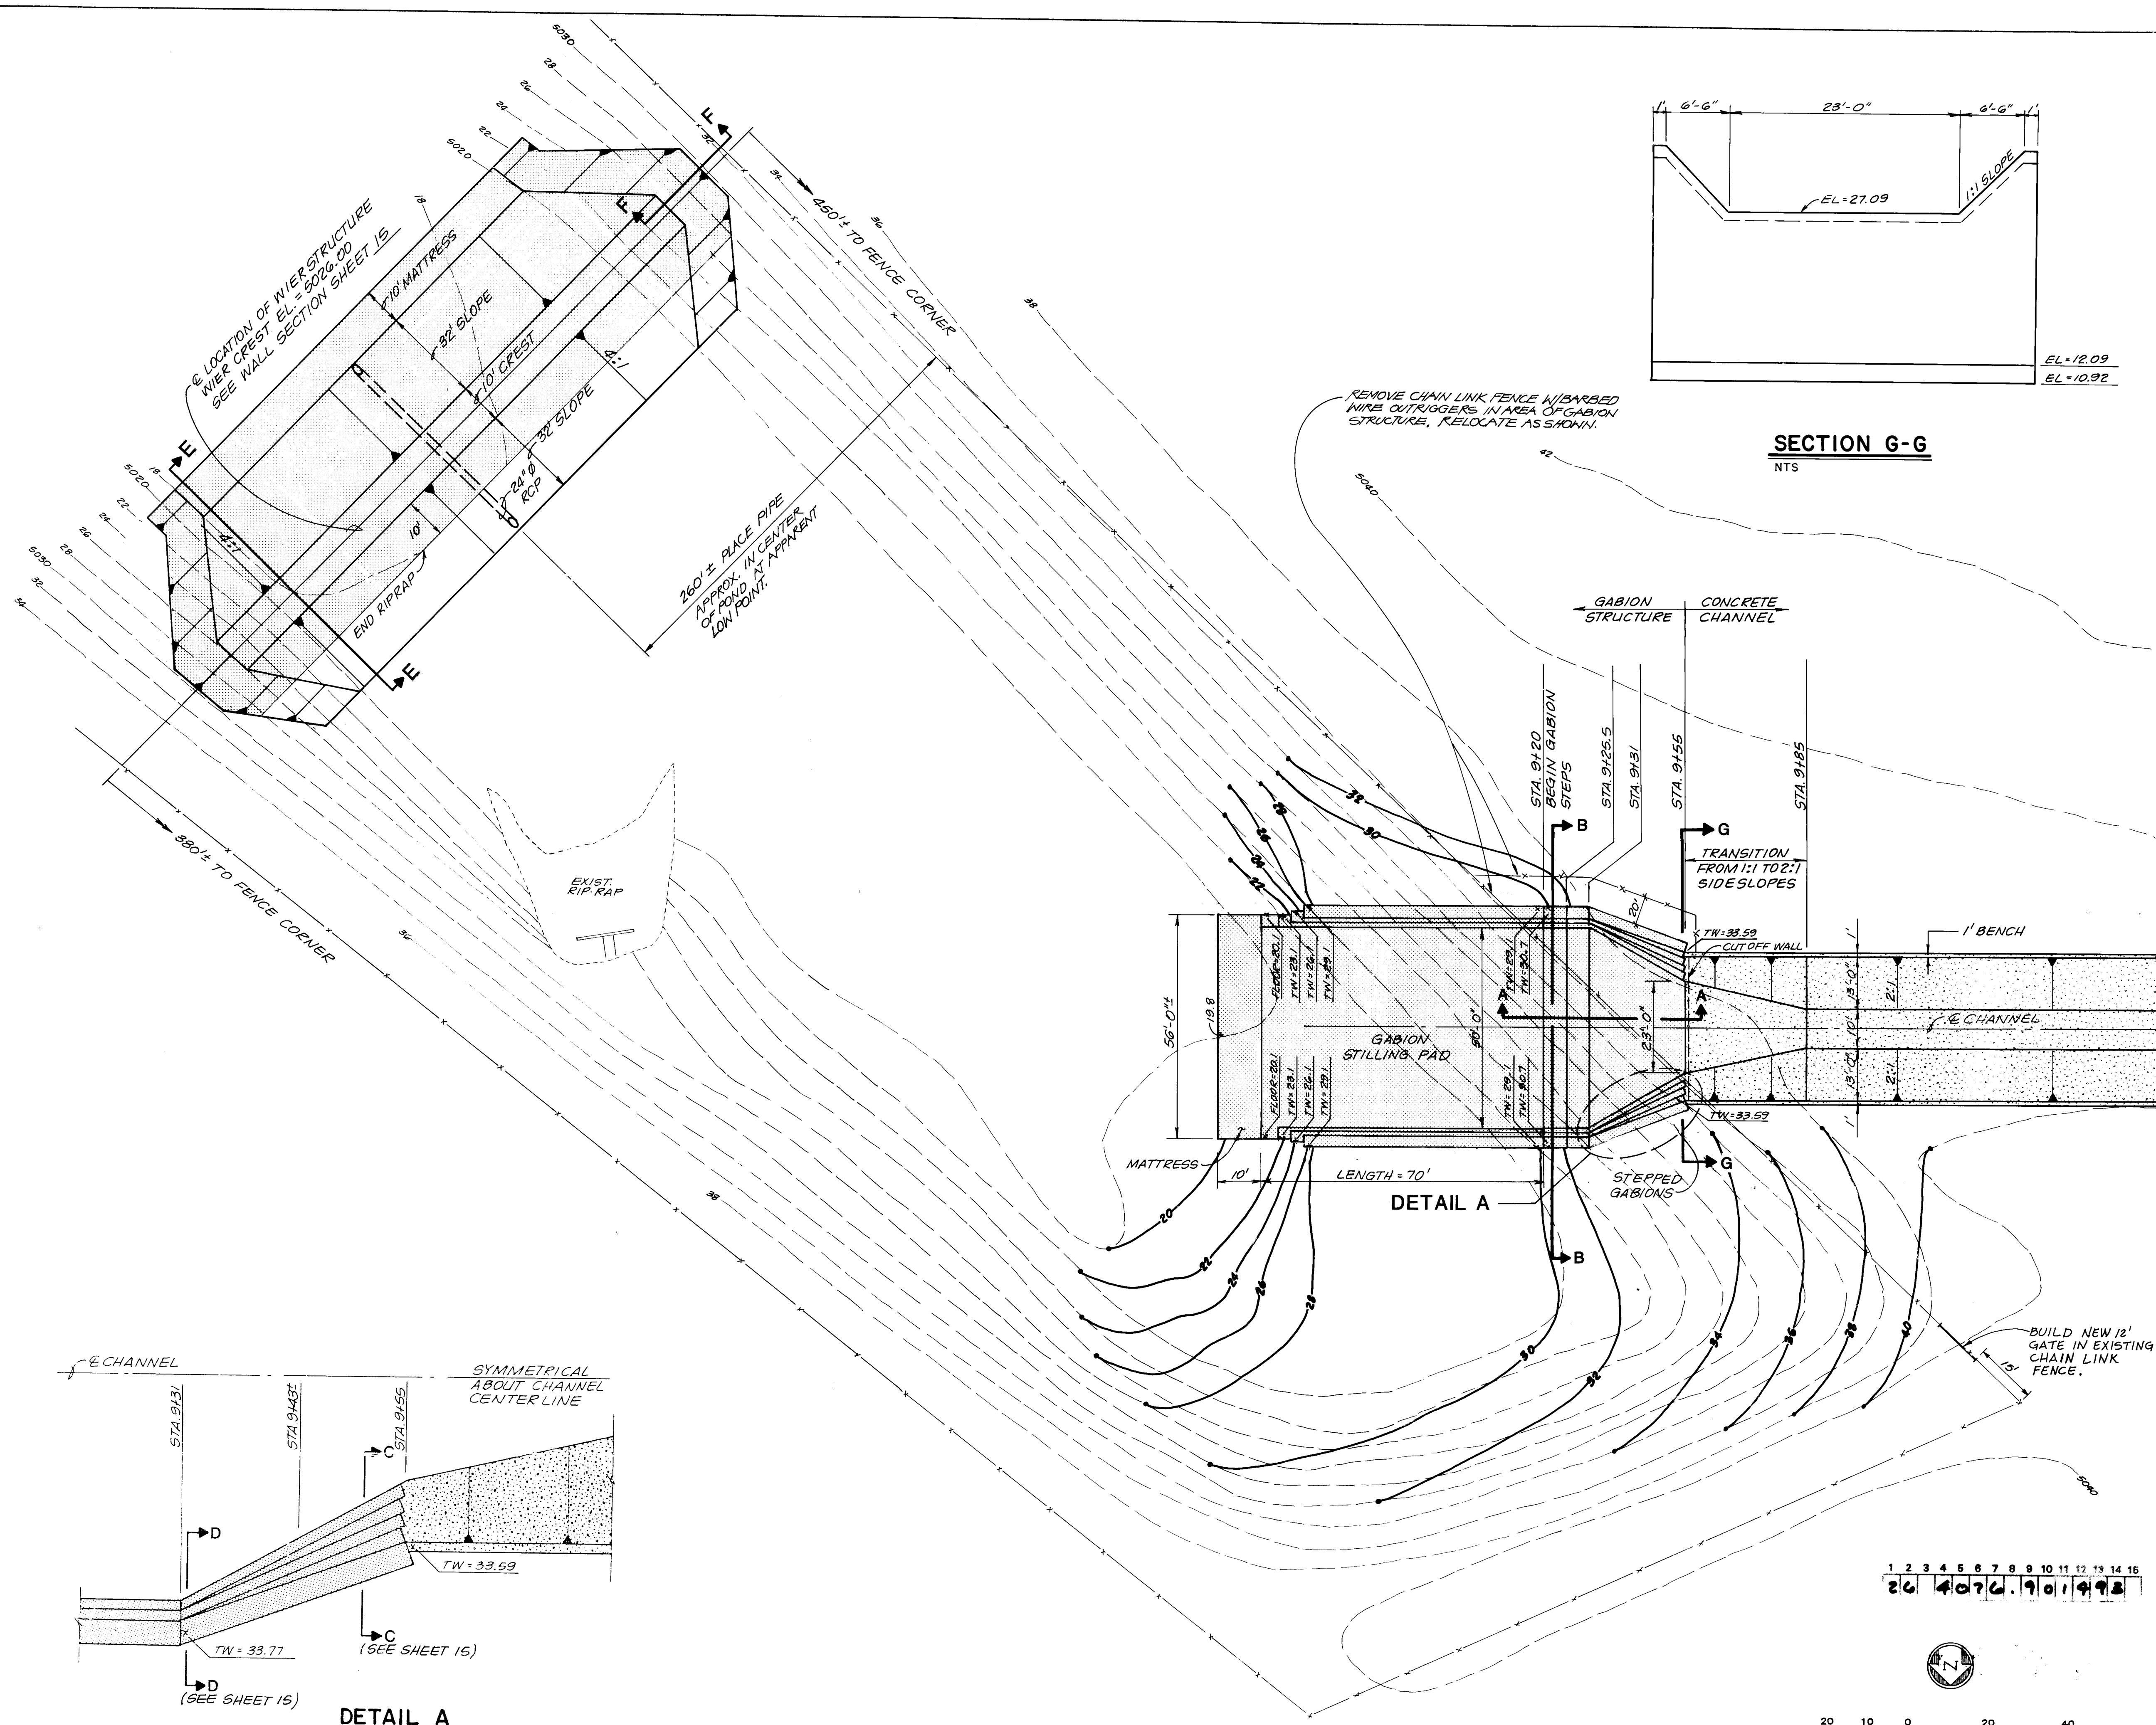

SECTION G-G
NTS

DETAIL A
NTS


DETAIL A
NTS

SCANNED BY
BY LASON

"AS BUILT" (HORIZONTAL
AND VERTICAL LOCATION ONLY)




1 2 3 4 5 6 7 8 9 10 11 12 13 14 15
26 40 76.90 149.8

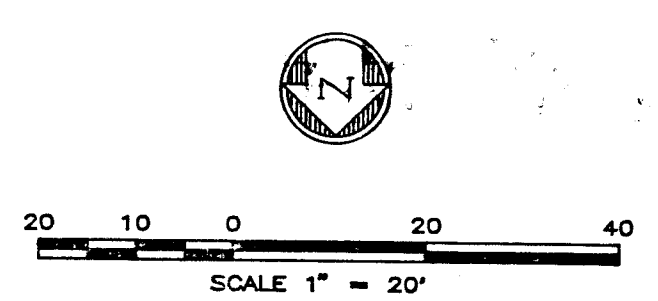


CITY OF ALBUQUERQUE PUBLIC WORKS DEPARTMENT ENGINEERING GROUP					
TITLE: AMOLE DEL NORTE STORM DIVERSION FACILITIES - PHASE III TIERRA BAYITA DRAINAGE FACILITIES OUTFALL STRUCTURE PLAN					
APPROVALS	ENGINEER	DATE	APPROVALS	ENGINEER	DATE
D.R.C. Chair	Ronald B...	10-23-91	Water	ADDISON	10-1-91
Trans. Dev.	K...	10-01-91	Wastewater	ADD	"
Hydrology	...	9/24/91			
DRAWING NO.	4076.90	MAP NO.	L-10	SHEET	14 OF 35

RECORD DRAWING


SURVEY INFORMATION		BENCH MARKS		AS BUILT INFORMATION	
NO.	DATE	BY	FIELD NOTES	CONTRACTOR	DATE
1880	6-7/90	GREINER		MOORE & COWART	1992
1883	7/6/90	GREINER		WALKER DATE	1992
1886	12/90	GREINER		SCALE BY	
1893	12/90	GREINER		FIELD	
1910	9-10/91	GREINER		ASSEMBLED BY	
DESIGNED BY		DATE 8/91		MICRO-FILM INFORMATION	
DRAWN BY		DATE 8/91		DATE	
CHECKED BY		DATE 8/91		NO	
				TBM AMOLE 13 - BRASS CAP SET IN THE NORTH SIDE OF	
				BRIDGE BOULEVARD APPROXIMATELY 30' NORTH OF THE EDGE	
				OF PAVEMENT AND APPROXIMATELY 125' WEST OF SESAME	
				STREET. N = 1,481,394.909 E = 960,370.080 ELEV = 5072.064	
				TBM AMOLE 14 - BRASS CAP ON THE NORTHWESTERLY TURN	
				ISLAND IN THE INTERSECTION OF NORTH/SOUTH COORS	
				CONNECTION AND BRIDGE BOULEVARD. N = 1,481,037.480 E =	
				361,880.107 ELEV = 5035.731	

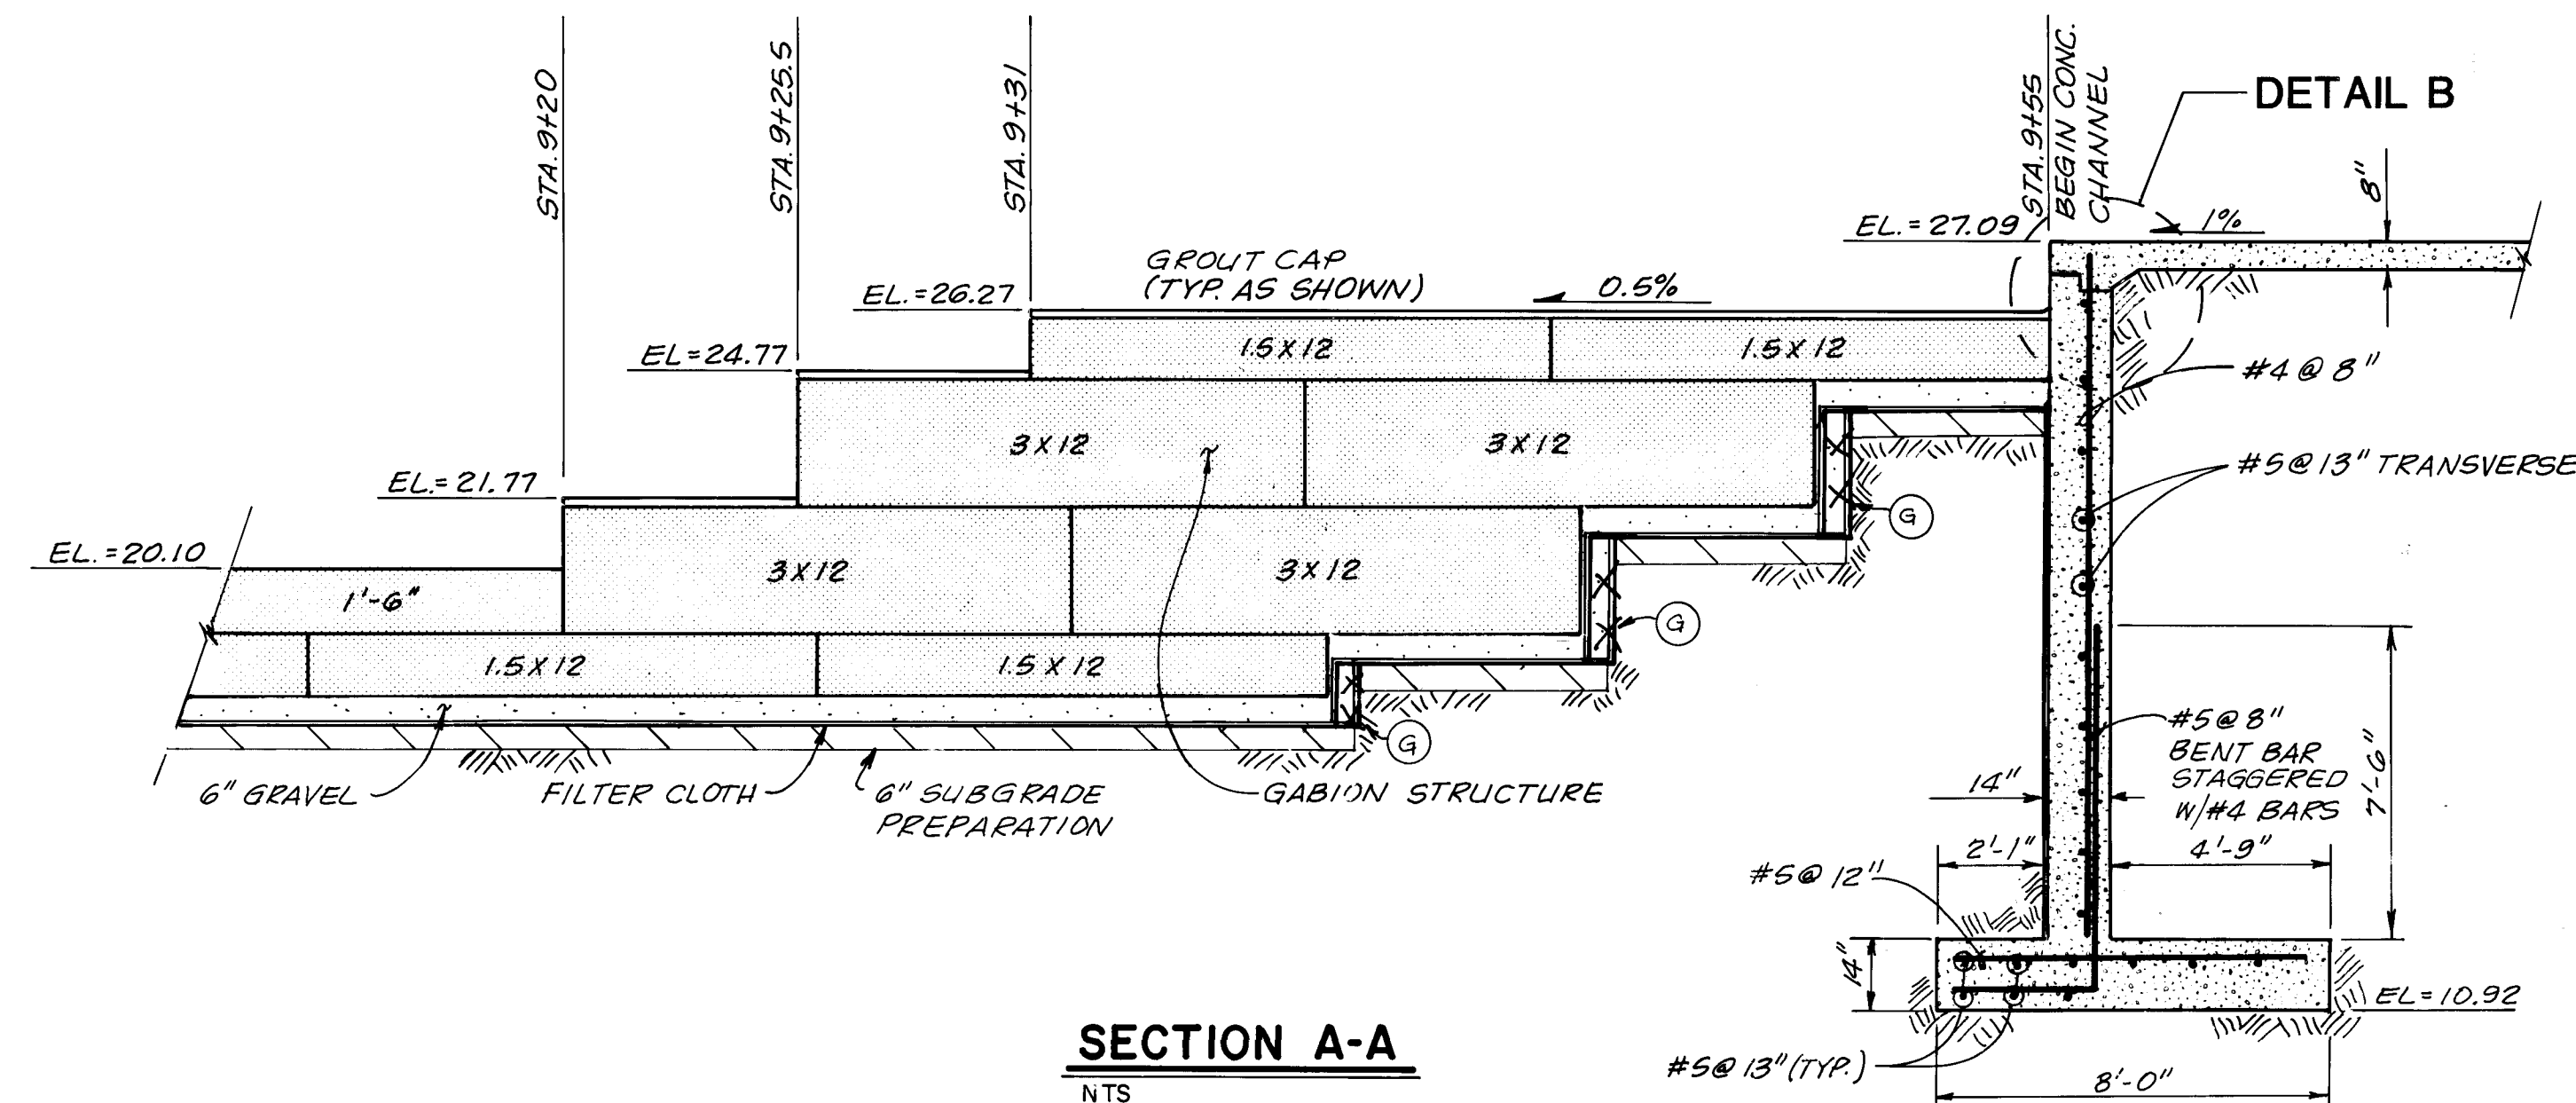


SECTION A-A
NTS

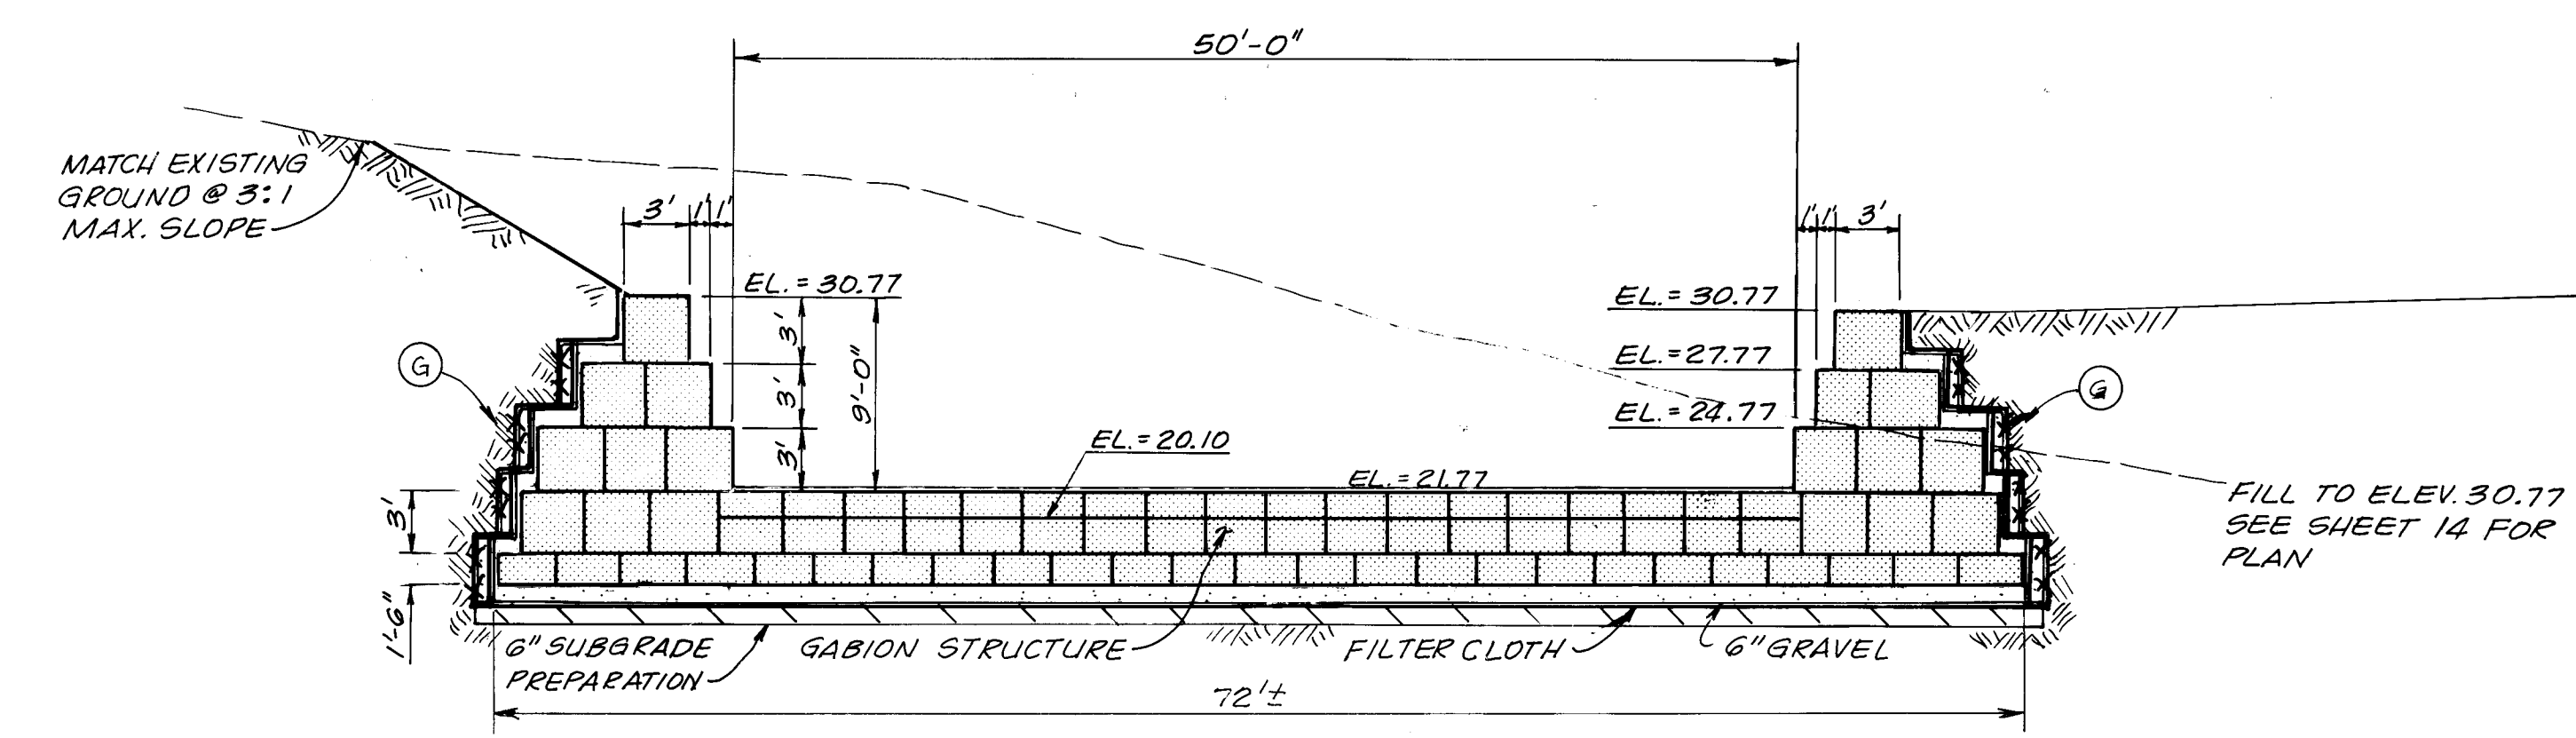


SECTION B-B
NTS

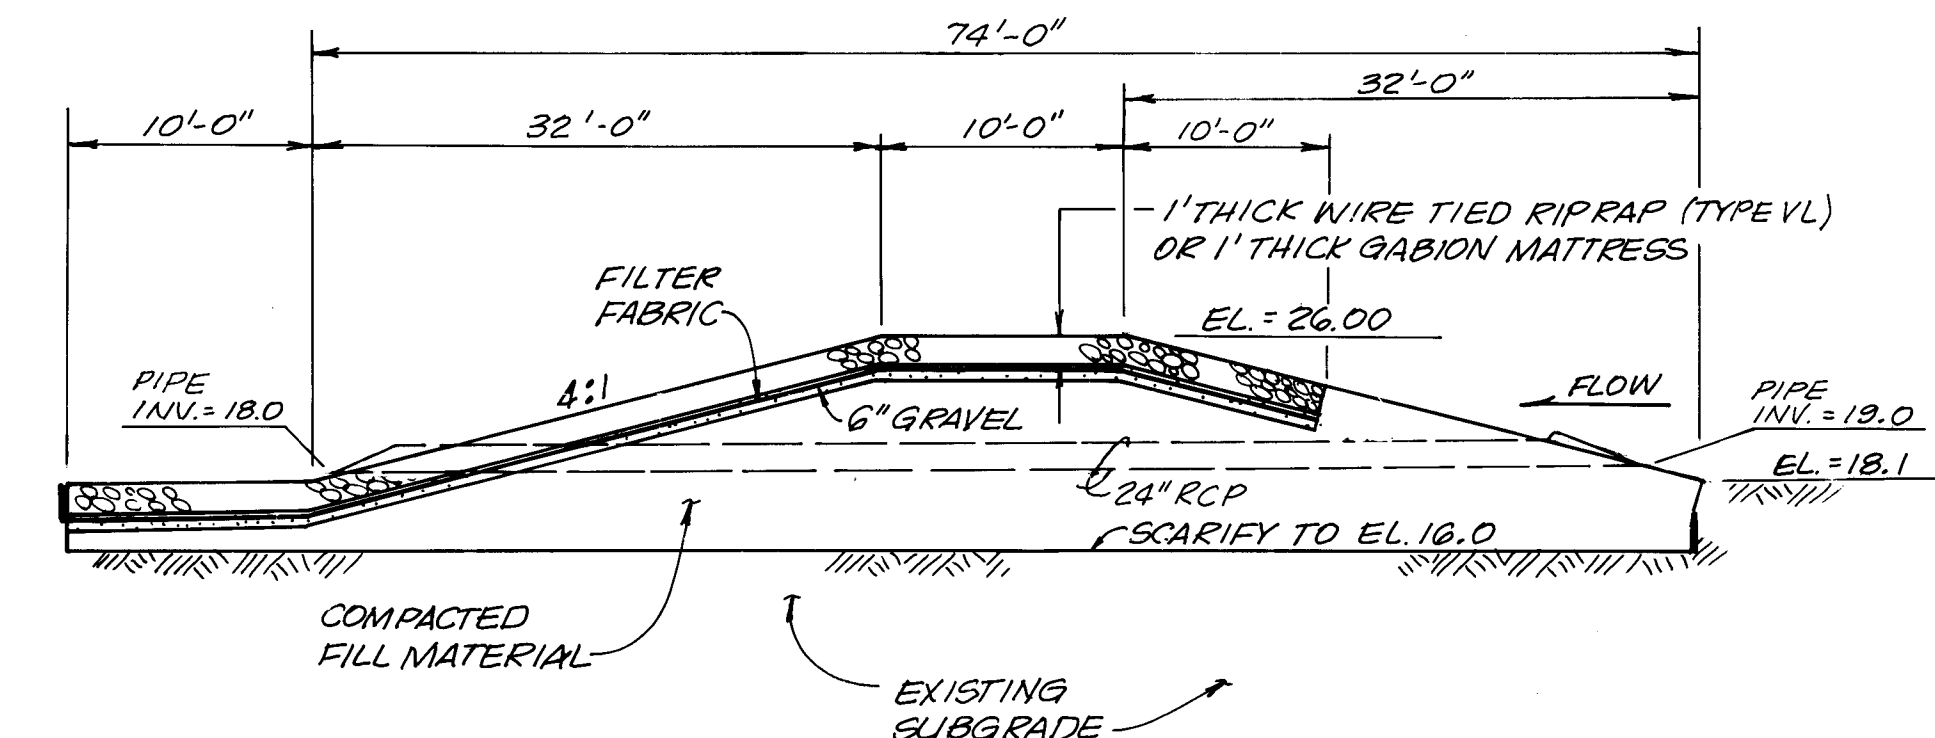


SECTION E-E
NTS

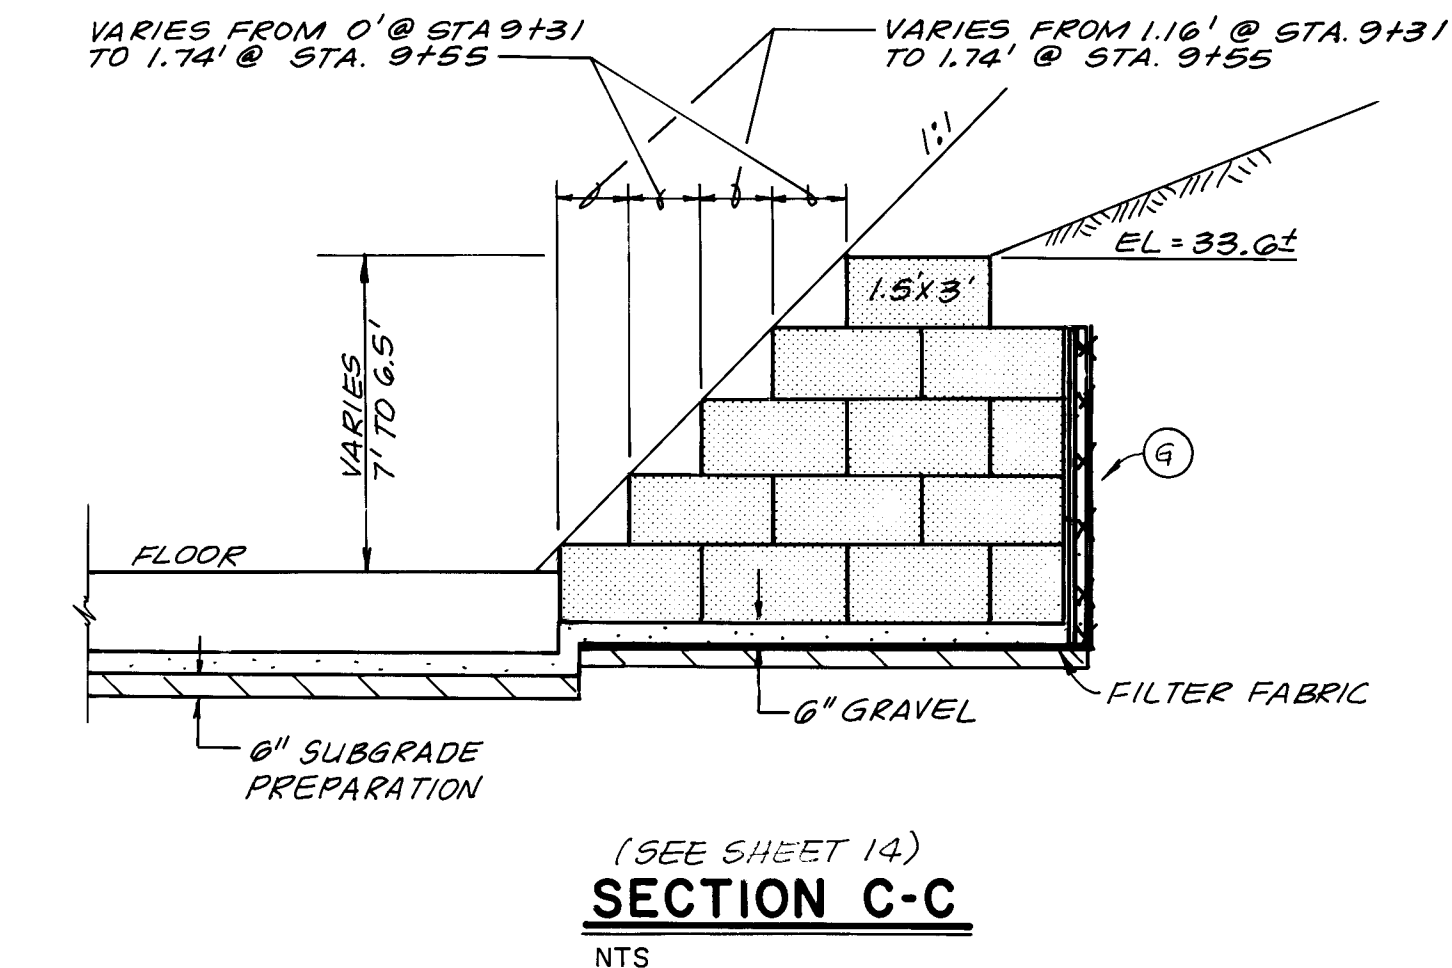


SECTION C-C
NTS

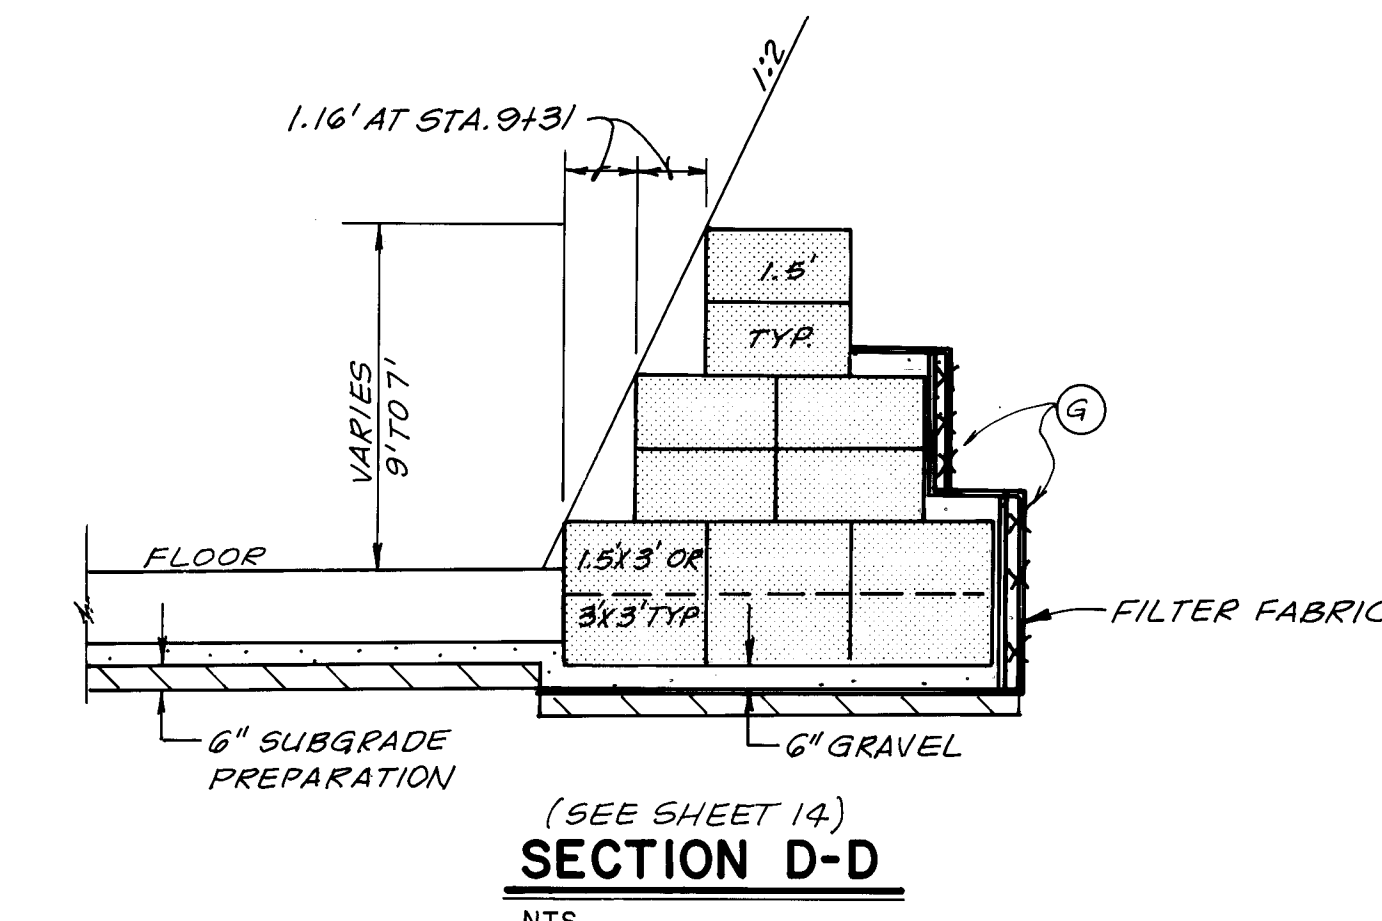

SECTION D-D
NTS

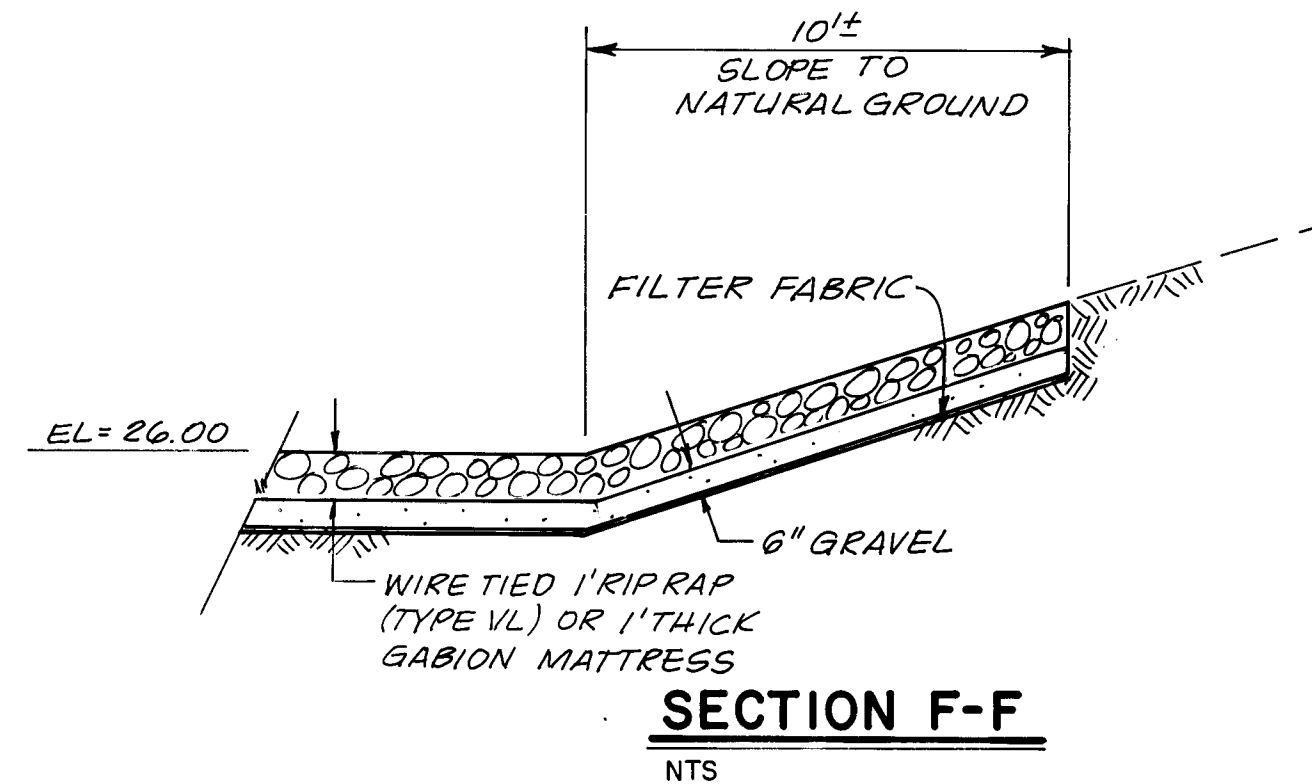

SECTION F-F
NTS

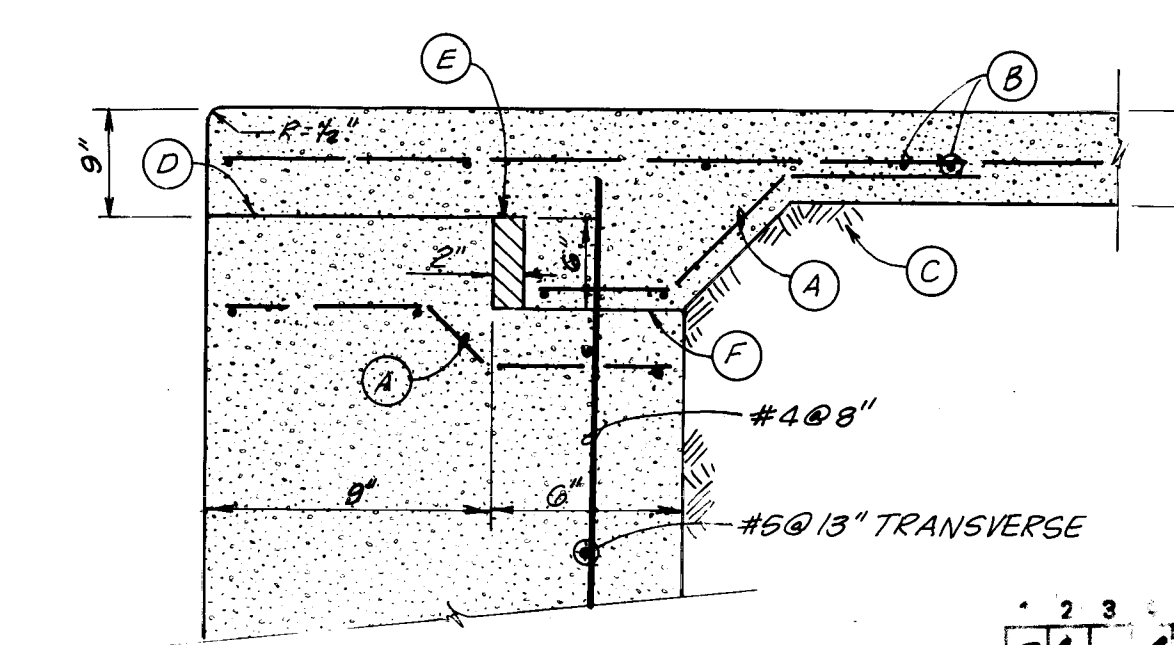

DETAIL B
NTS

KEYED NOTES


- ① Z-BAR LOCATIONS IN TWO POSITIONS SHOWN. SECURELY TIE ALL CONNECTIONS AND SUPPORT SLEEPER MAT WITH CHAIRS.
- ② TIE REINFORCEMENT MATS TOGETHER IN DOWNSTREAM SLAB WITH 6" STANDARD "Z-CHAIRS", NUMBER 4 BAR AT 15" CENTER-TO-CENTER, MIN. LAP LENGTH 12".
- ③ COMPACT SUBGRADE TO MINIMUM 95% PER ASTM D 1557.
- ④ PLACE 1/4" X 18" LOW DENSITY POLYETHYLENE BEARING PLATE AS SHOWN.
- ⑤ PLACE POLYETHYLENE FOAM FILLER AS SHOWN. PLASTAZONE OR APPROVED EQUAL. DO NOT ANCHOR WITH NAILS OR BONDING AGENT. KEEP IN PLACE WITH FRESH CONCRETE WHEN POURING UPSTREAM SECTION. DO NOT ALLOW FRESH CONCRETE BETWEEN FILLER AND PREVIOUSLY POURED CONCRETE.
- ⑥ LOW DENSITY POLYETHYLENE BEARING PLATE, 1/4" X 10" PLACED AS SHOWN.
- ⑦ GRAVEL NOT INSTALLED IN ALL VERTICAL SURFACES (TYP.)

GENERAL NOTES

1. FILTER CLOTH SHALL BE MIRAFI 14N OR APPROVED EQUAL.


SCANNED BY LASON

"AS BUILT" HORIZONTAL AND VERTICAL LOCATION ONLY

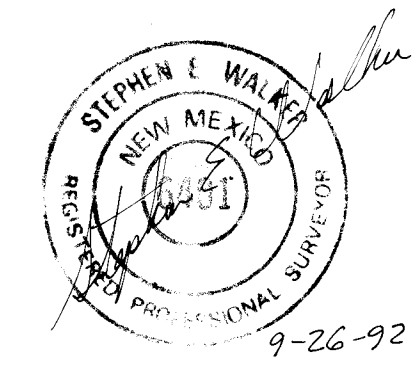


CITY OF ALBUQUERQUE PUBLIC WORKS DEPARTMENT ENGINEERING GROUP			
TITLE: AMOLE DEL NORTE STORM DIVERSION FACILITIES - PHASE III TIERRA BATITA DRAINAGE FACILITIES			
OUTFALL STRUCTURE DETAILS			
APPROVALS	ENGINEER	DATE	APPROVALS
DRG. CHAIRMAN	10-23-91	WATER	10-1-92
TRANSPORTATION	10-01-91	WASTE WATER	10-1-92
HYDROLOGY	9/24/91		
DESIGNED BY	DATE	DATE	DATE
DRAWN BY	DATE	DATE	DATE
CHECKED BY	DATE	DATE	DATE
PROJECT NO.	4076.90	MAP NO.	L-10
SHEET 15		OF 35	


RECORD DRAWING

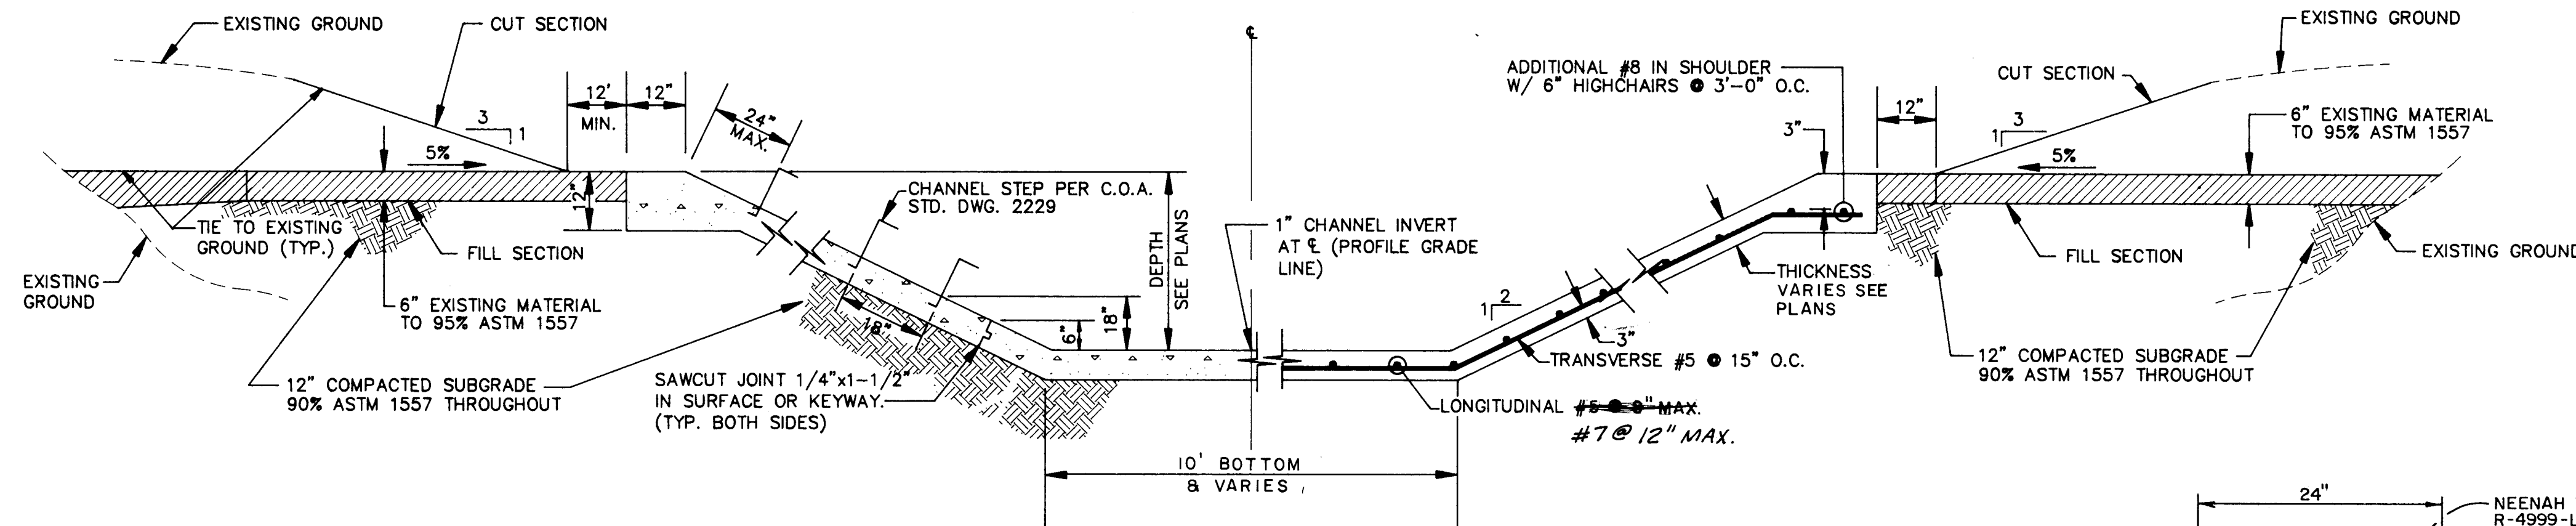


TYPICAL CHANNEL SECTION
NOT TO SCALE (SYMMETRICAL ABOUT ϵ UNLESS OTHERWISE SHOWN)

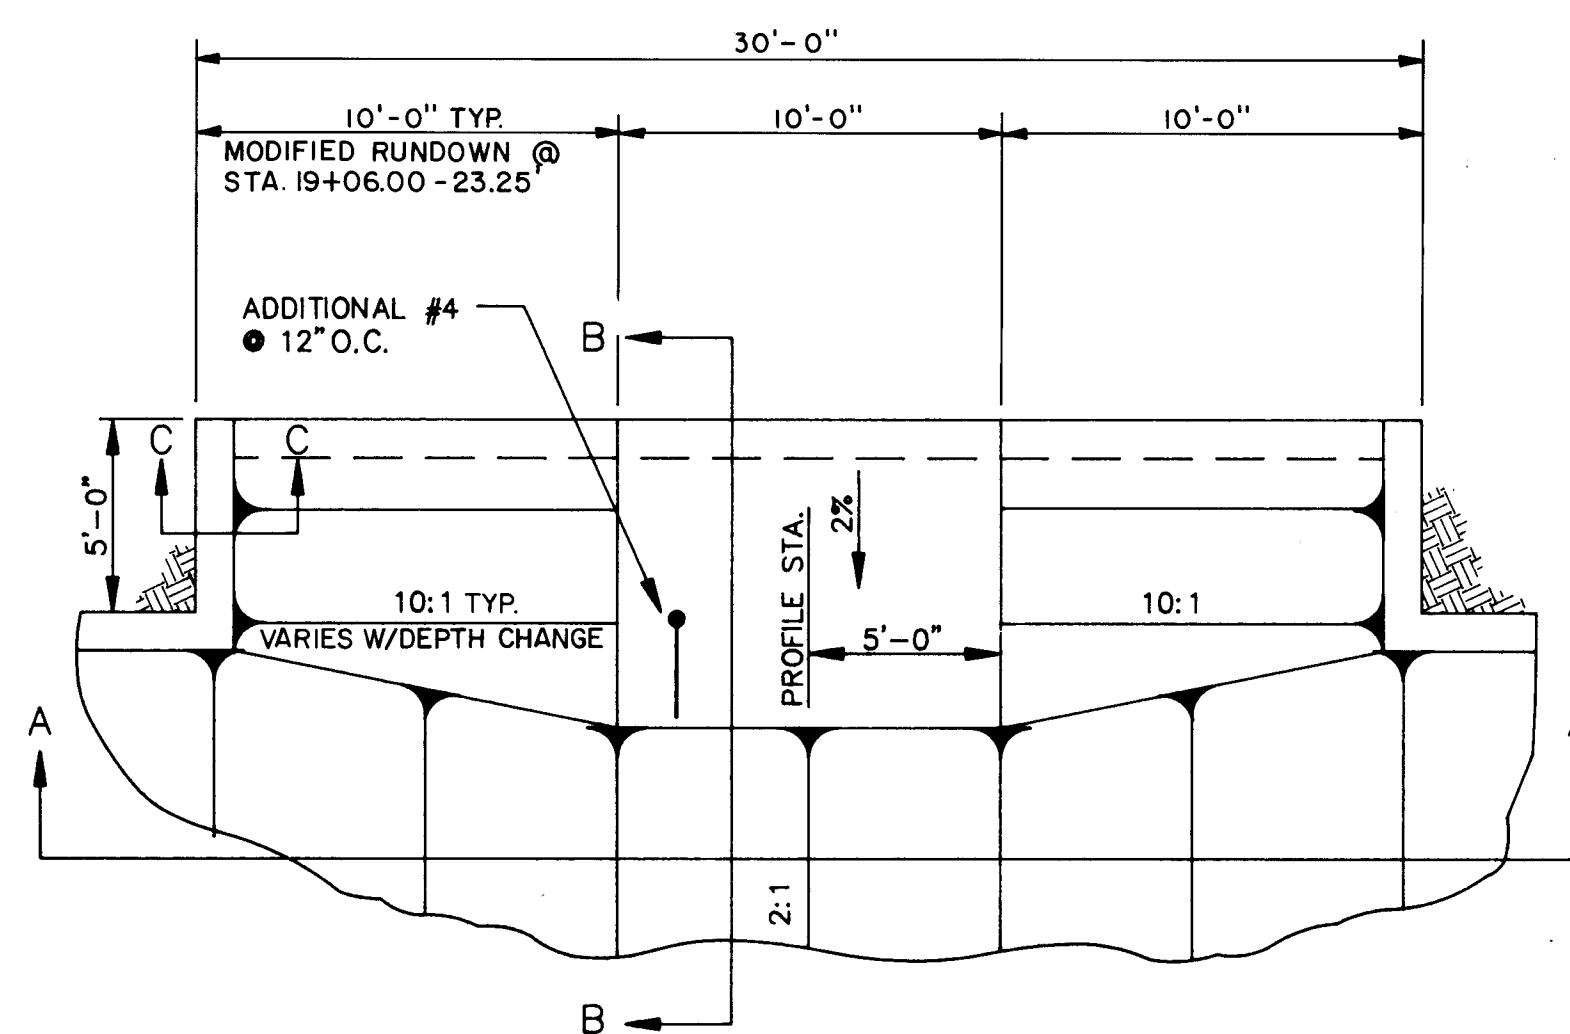


PLAN VIEW
TYPICAL CHANNEL RUNDOWN
NOT TO SCALE

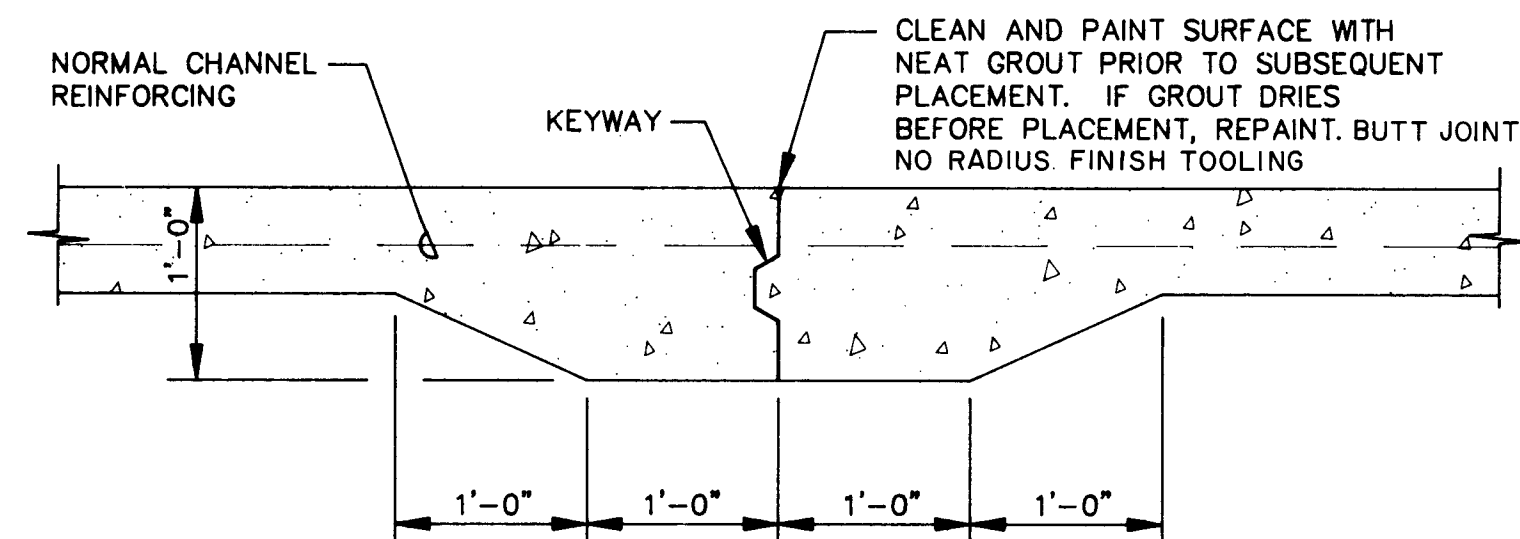


CONSTRUCTION JOINT
SCALE: 1"=1'-0"

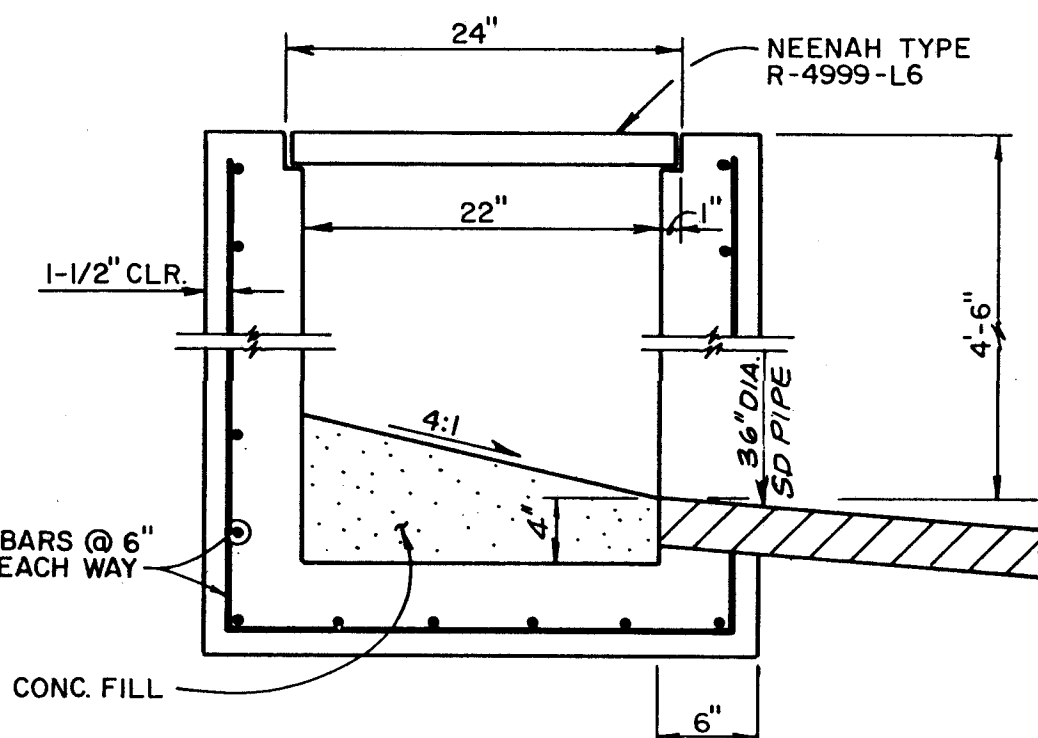


SECTION E-E
SCALE: 1"=1'-0"

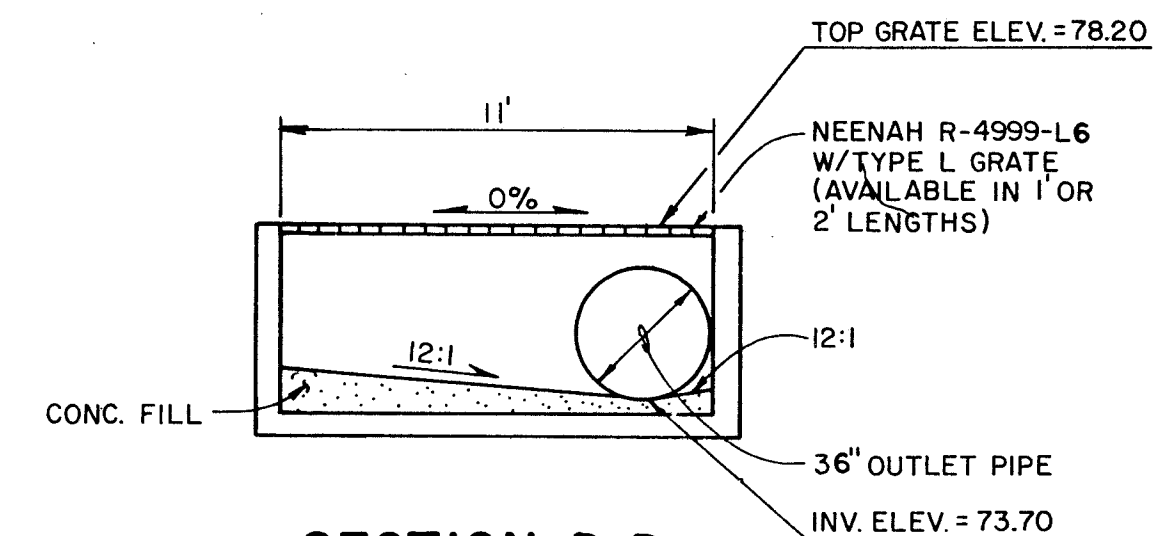


SECTION D-D
SCALE: 1"=5'

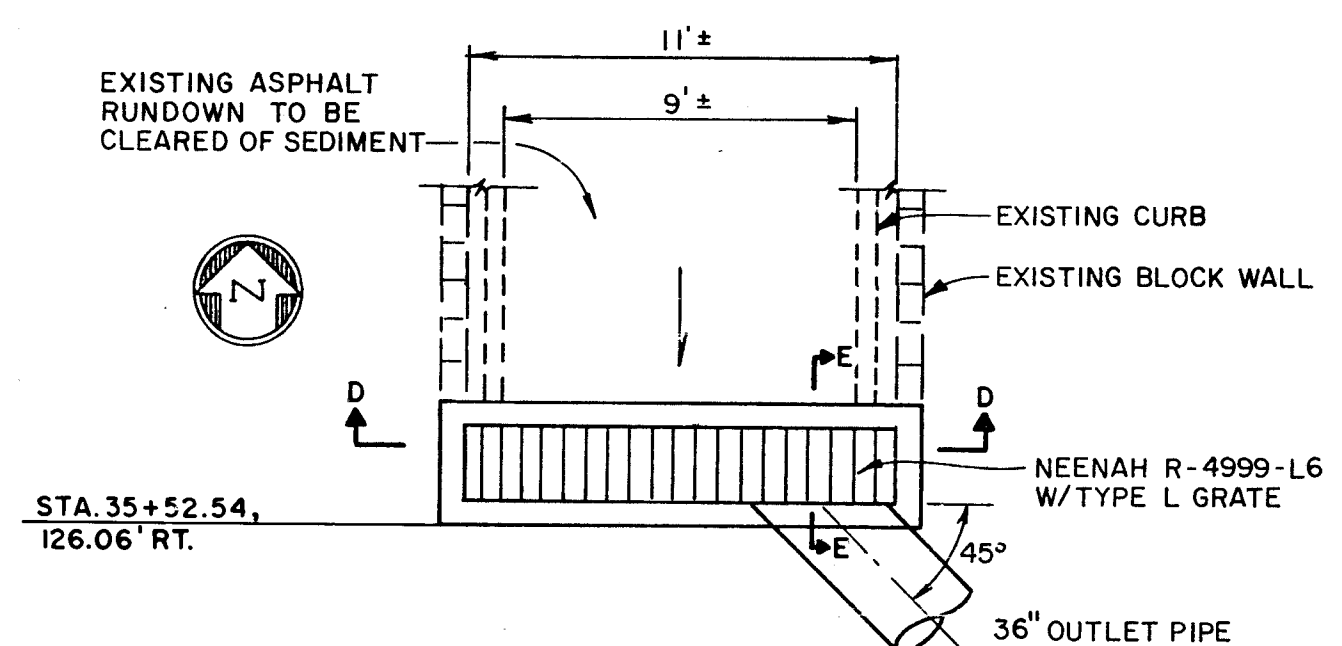


TRANSVERSE DRAIN PLAN
SCALE: 1"=5'

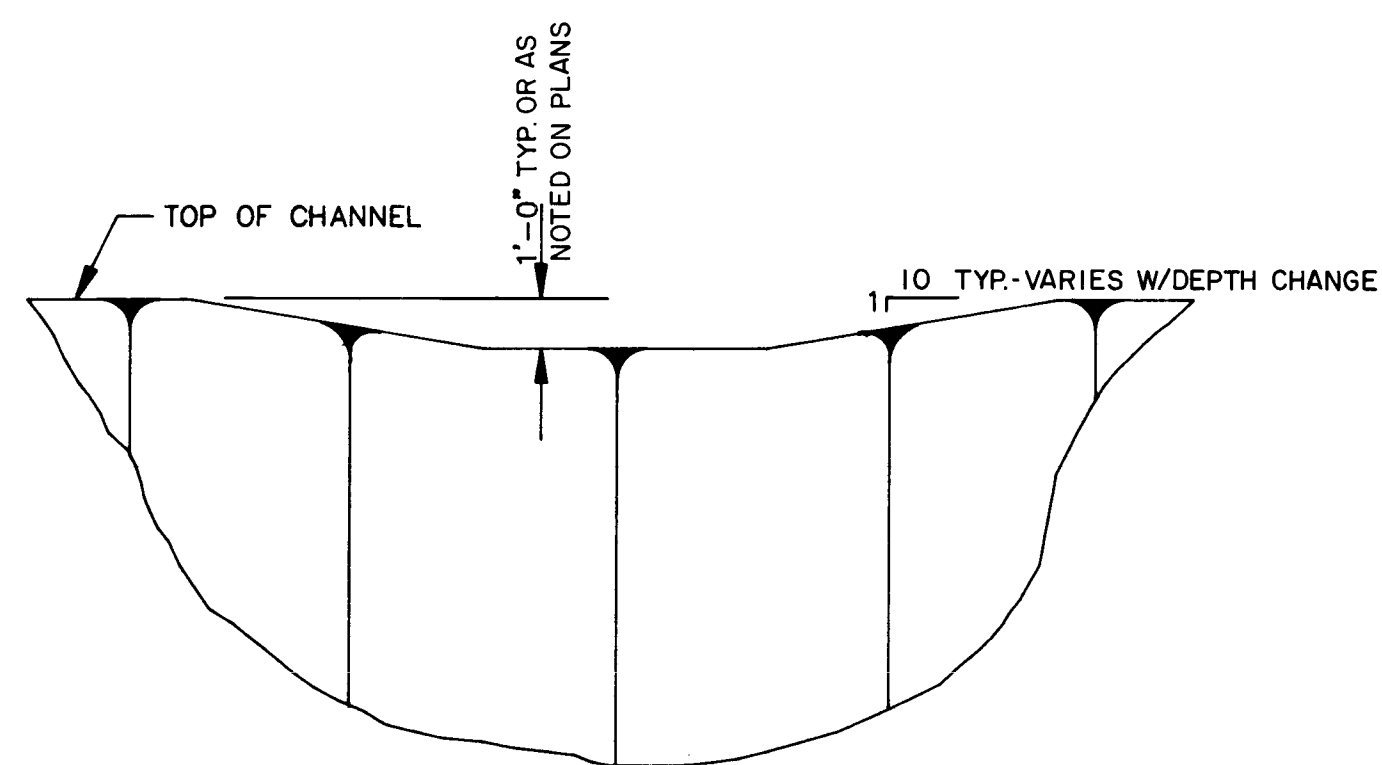

SECTION A-A
NOT TO SCALE

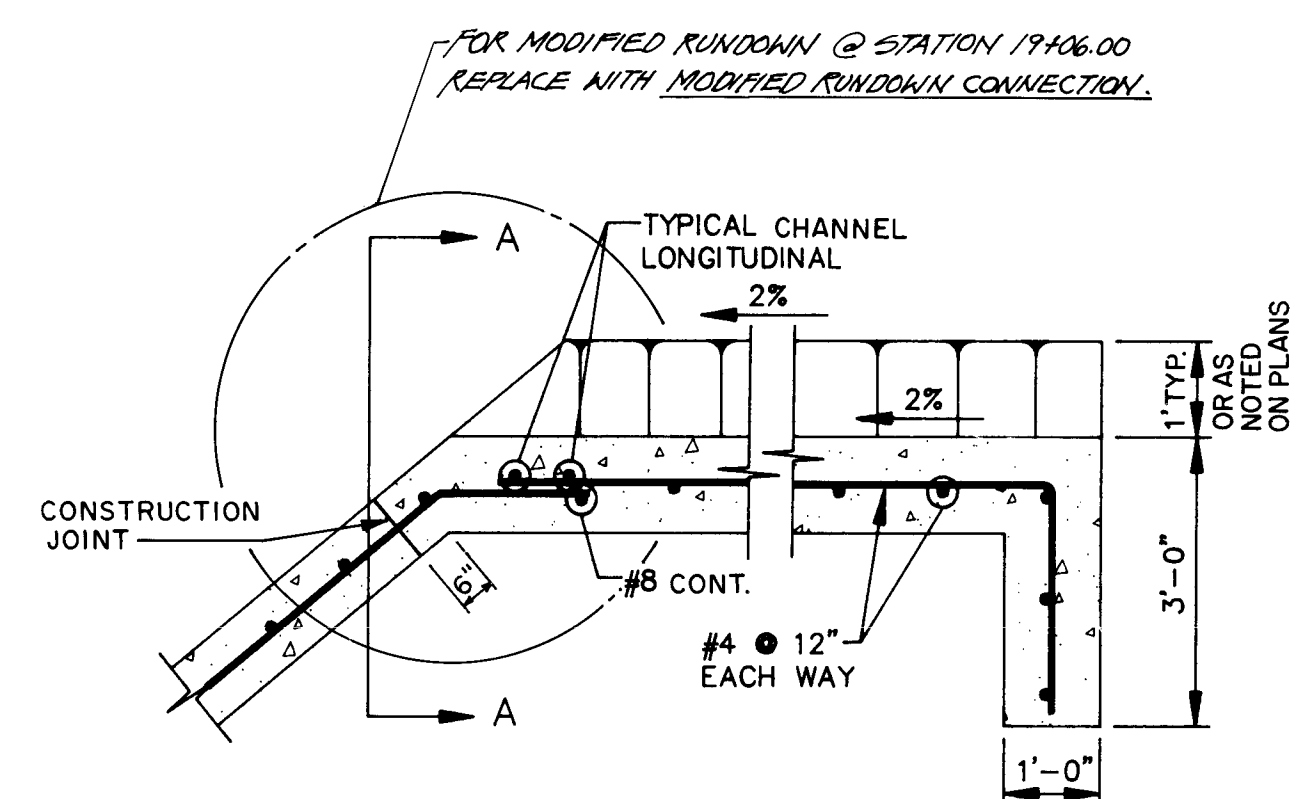


SECTION B-B
NOT TO SCALE

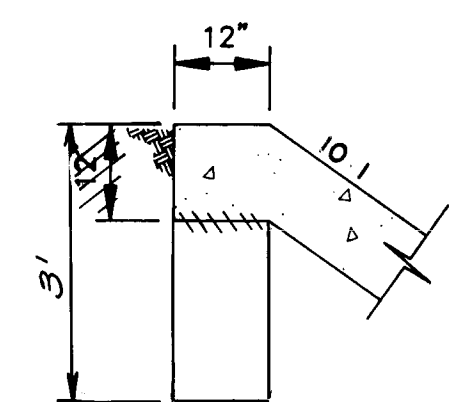


SECTION C-C
NOT TO SCALE

NOTES

- SEE PLAN AND PROFILE SHEETS FOR MODIFICATIONS TO TYPICAL CHANNEL GRADING.
- A TRANSVERSE CHANNEL CONSTRUCTION JOINT SHALL BE MADE AT THE END OF A WORK DAYS POUR. JOINT SHALL BE FORMED WITH KEYWAY. SEE CONSTRUCTION JOINT DETAIL THIS SHEET.

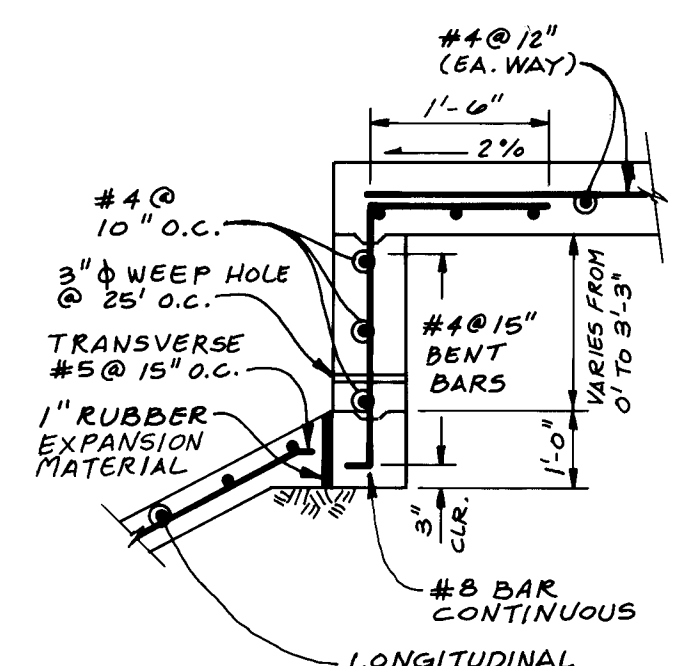

STA. 18+77.75 TO 19+01.00

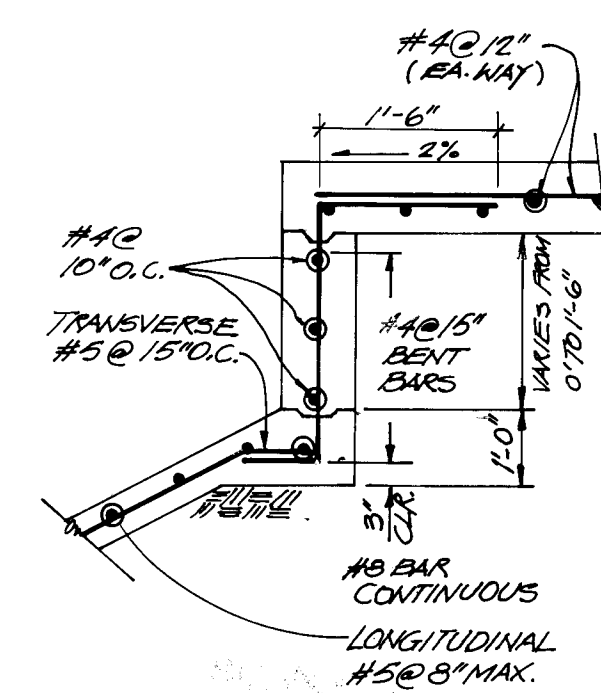

STA. 19+01.00 TO 19+21.00

MODIFIED RUNDOWN CONNECTION

Greiner, Inc.

CITY OF ALBUQUERQUE
PUBLIC WORKS DEPARTMENT
ENGINEERING GROUP


TITLE: AMOLE DEL NORTE STORM DIVERSION FACILITIES - PHASE III
TIERRA BATITA DRAINAGE FACILITIES

TYPICAL DRAINAGE DETAILS

APPROVALS	ENGINEER	DATE	APPROVALS	ENGINEER	DATE
D.R.C. Chair	Rogel Greiner	10-23-91	Water	MD	10-1-91
Trans. Dev	R. Greiner	10-21-91	Wastewater	MD	"
Hydrology	MD	9/24/91			
DRAWING NO.	4076.90	MAP NO.	L-10	SHEET	16 OF 35

RECORD DRAWING

BENCH MARKS		SURVEY INFORMATION		ENGINEER'S SEAL		REVISIONS		DESIGN		DATE		DATE		DATE	
TBM AMOLE 13	BRASS CAP SET IN THE NORTH SIDE OF BRIDGE BOULEVARD APPROXIMATELY 30' NORTH OF THE EDGE OF PAVEMENT AND APPROXIMATELY 125' WEST OF SESAME STREET. N = 1,481,394.909 E = 980,370.080 ELEV = 5072.064	NO.	DATE	BY	NO.	DATE	BY	NO.	DATE	BY	DATE	NO.	DATE	BY	DATE
		1880	6-7/90	GREINER	1883	7/8/90	GREINER	1886	12/90	GREINER	1889	1/91	GREINER	1910	9-10/91
TBM AMOLE 14 - BRASS CAP ON THE NORTH-WESTERLY TURN ISLAND IN THE INTERSECTION OF NORTH/SOUTH COORS CONNECTION AND BRIDGE BOULEVARD. N = 1,481,037.480 E = 381,880.107 ELEV = 5035.731															
AS BUILT INFORMATION															
CONTRACTOR	MOORE & COWART	DATE	1992	STAMPED BY	WALKER	DATE	1992	ACCEPTANCE BY	COA.T.W.	DATE	9-92	FIELD OBSERVATION BY	WALKER	DATE	9-92
MICRO-FILM INFORMATION															

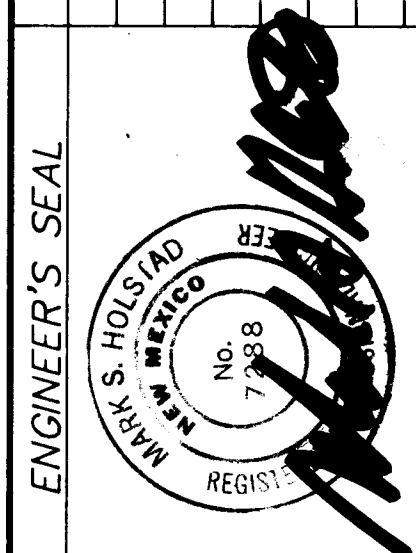

PROJECT NO. 0000101

CHECKED BY: LSJ

DATE: 10/1/91

DESIGNED BY: S.K.J.

DRAWN BY: J.L.R.

REMARKS

REVISIONS

DATE

DATE




DATE

DATE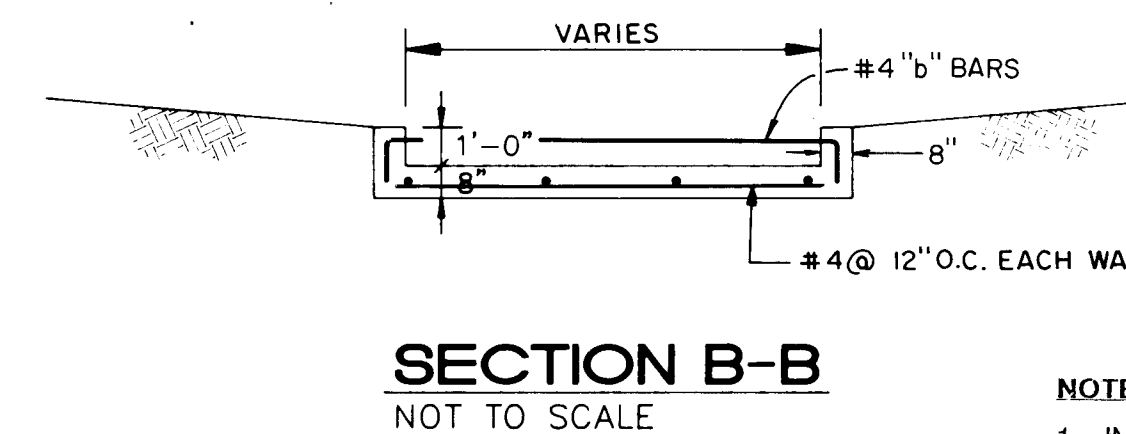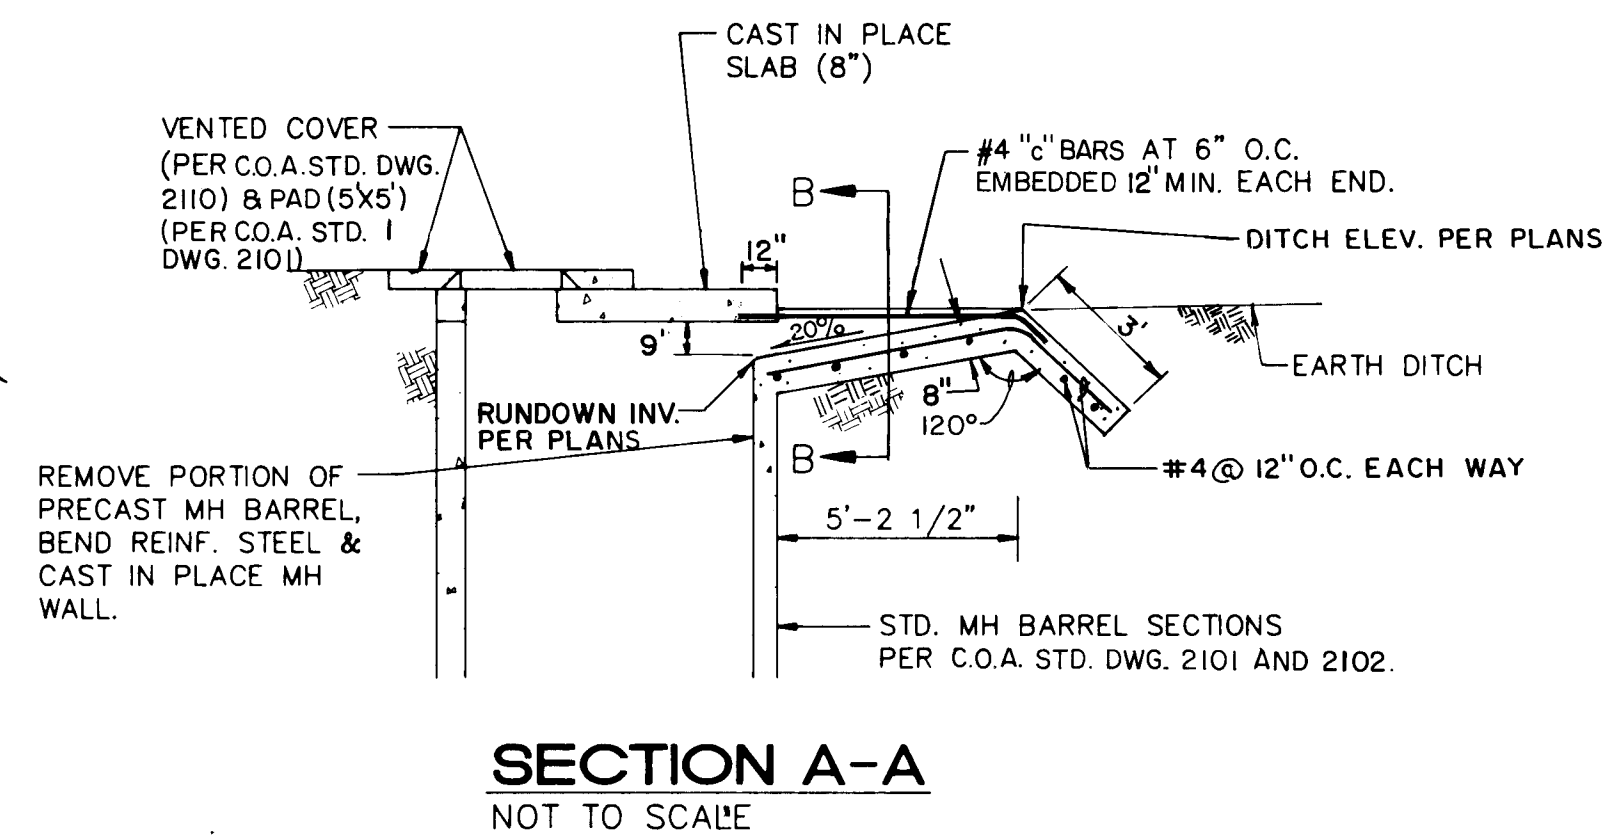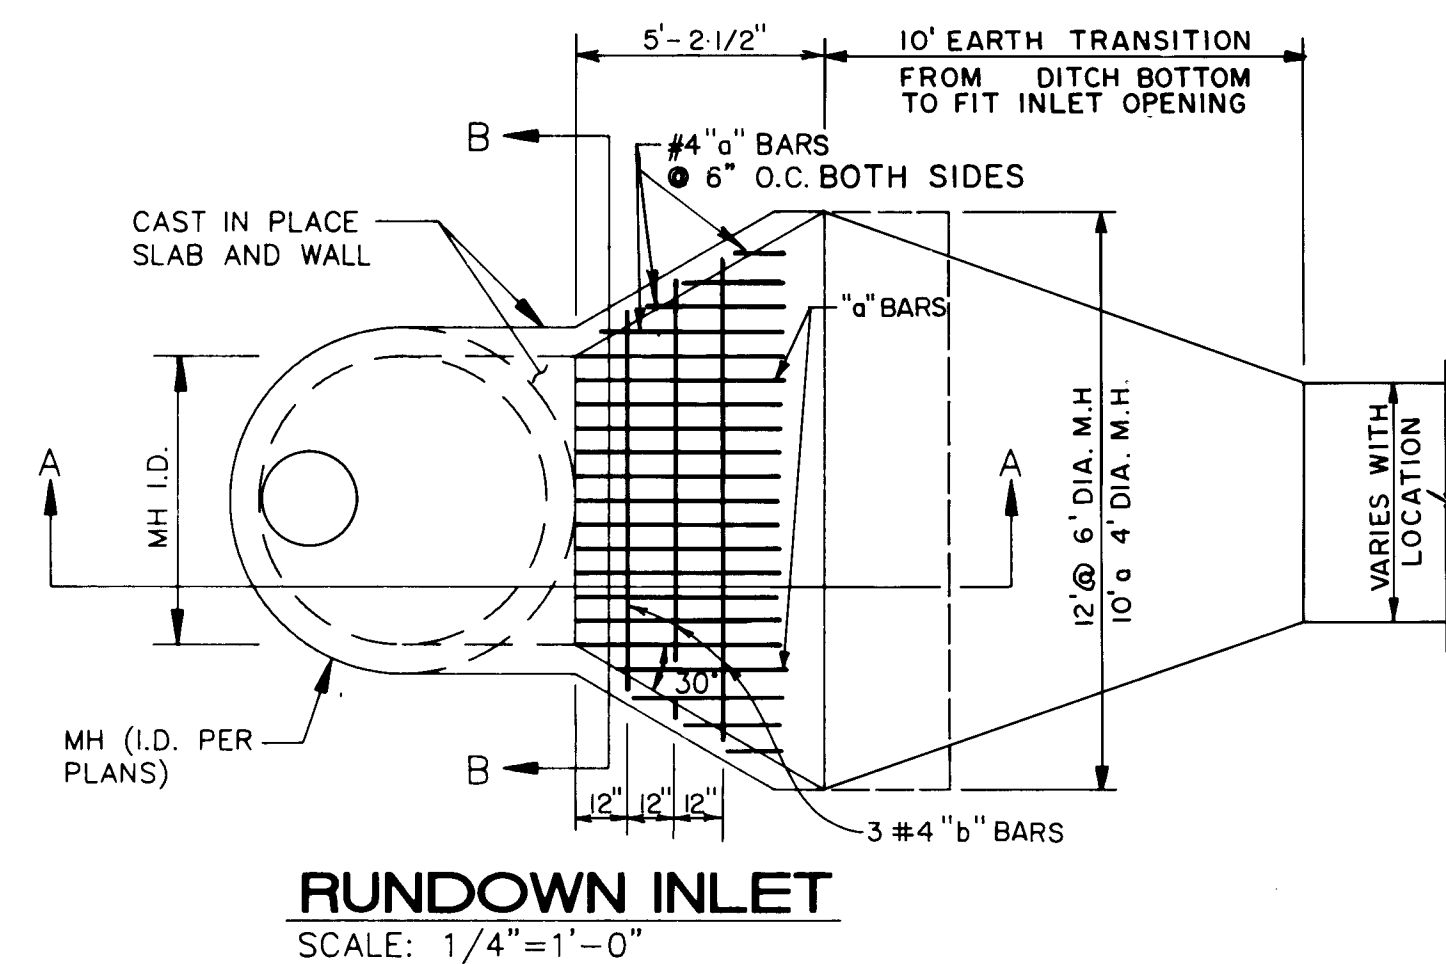

- ## NOTES

1. INSTALL 1"Ø STEEL PROTECTION BARS. THE PROTECTION BARS SHALL EXTEND THE FULL LENGTH OF THE CURB OPENINGS AND SHALL BE EMBEDDED 3" (MIN.) AT EACH END.
2. INSTALL ADDITIONAL BARS AT 3-1/2" CLEAR SPACING ABOVE FIRST BAR WHEN OPENING EXCEEDS 13".
3. WHEN CURB OPENING LENGTH EXCEEDS 6", INSTALL 1"Ø STEEL SUPPORT BOLTS, SPACED AT NO MORE THAN 5' O.C.
4. AFTER CLEANING SURFACE OF SCALE, RUST, ETC., ALL EXPOSED METAL HARDWARE SHALL BE PAINTED WITH ONE SHOP COAT OF PRIMER, TWO FINISH COATS ALUMINUM PAINT (ASHTO M 69).
5. CONNECTOR PIPE SHALL BE TRIMMED TO THE FINAL SHAPE AND LENGTH BEFORE CONCRETE IS POURED.

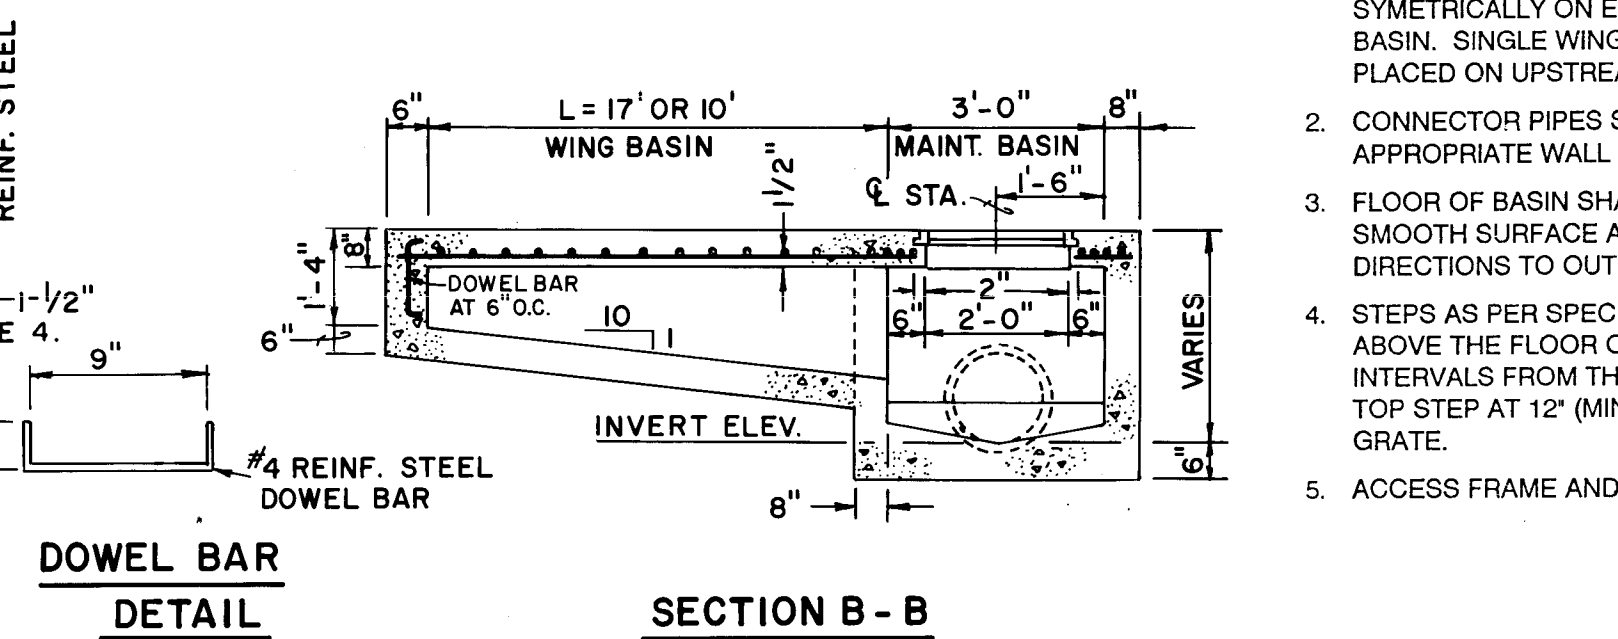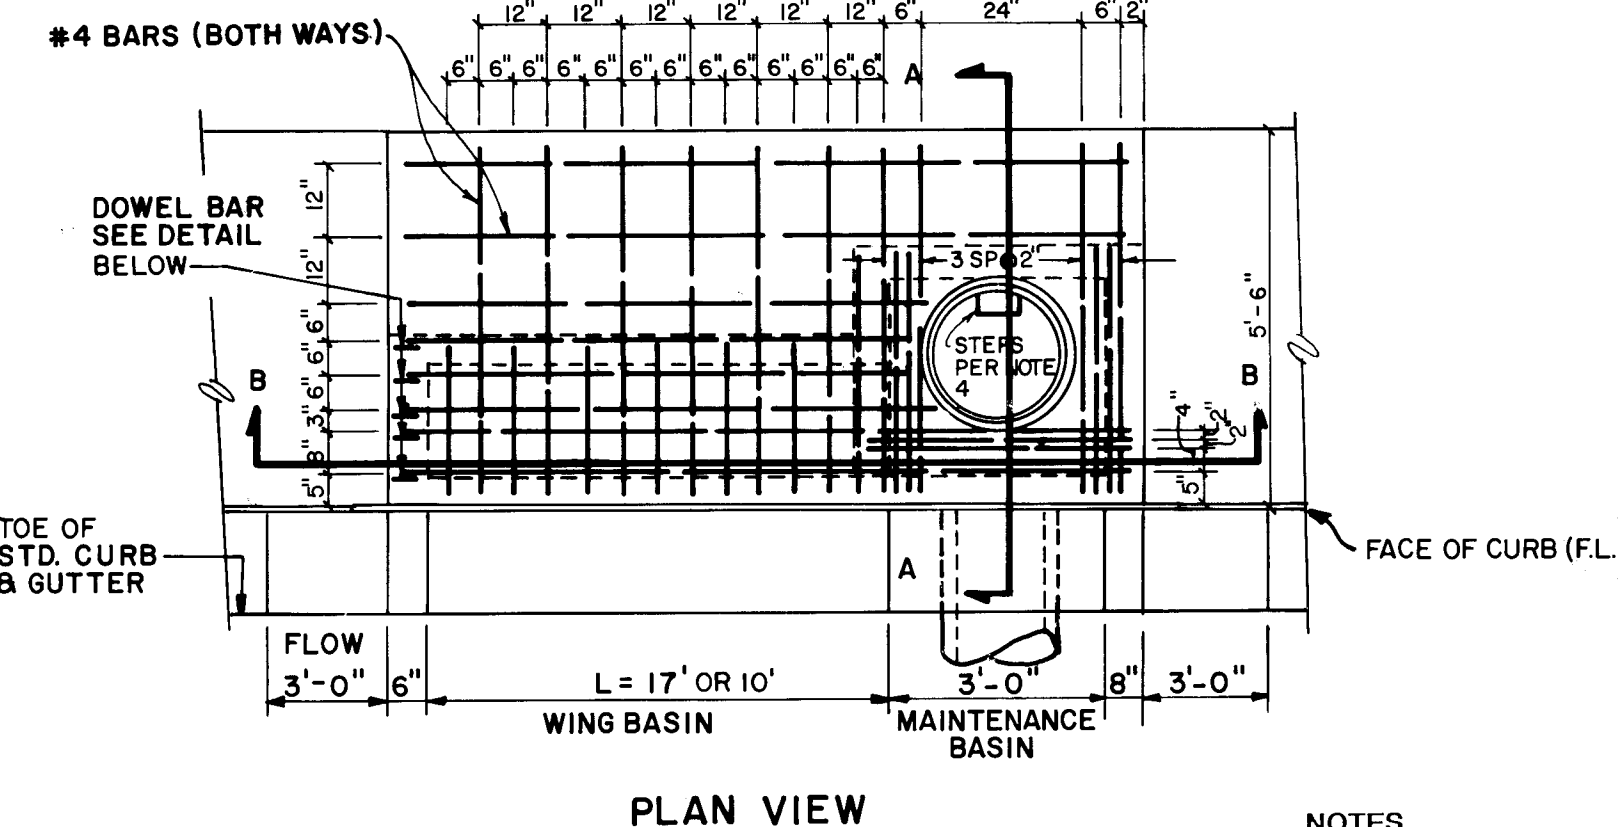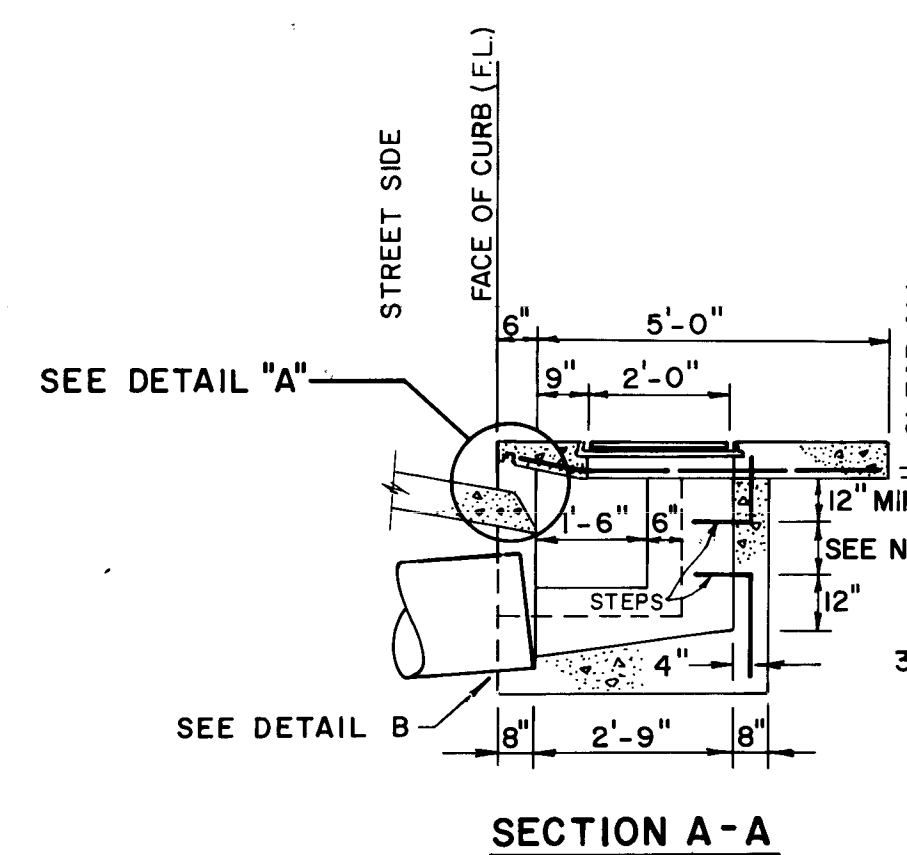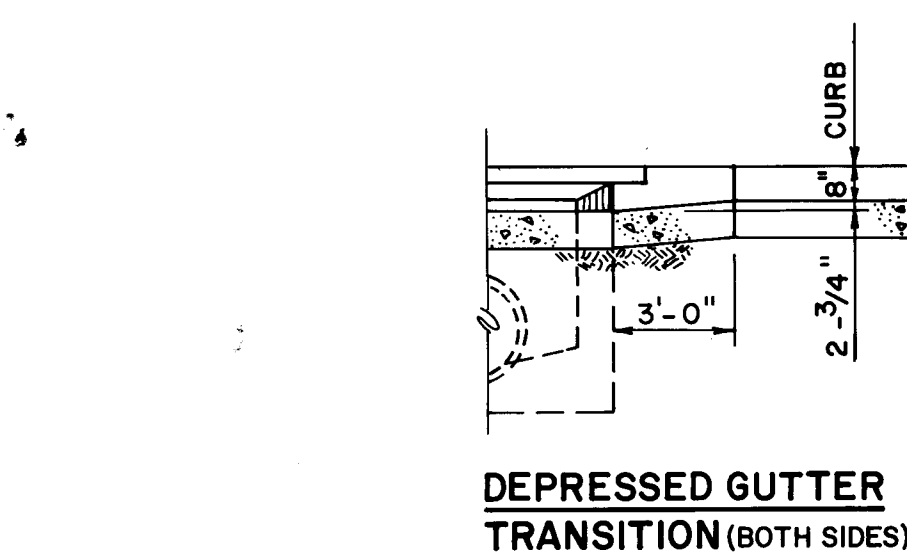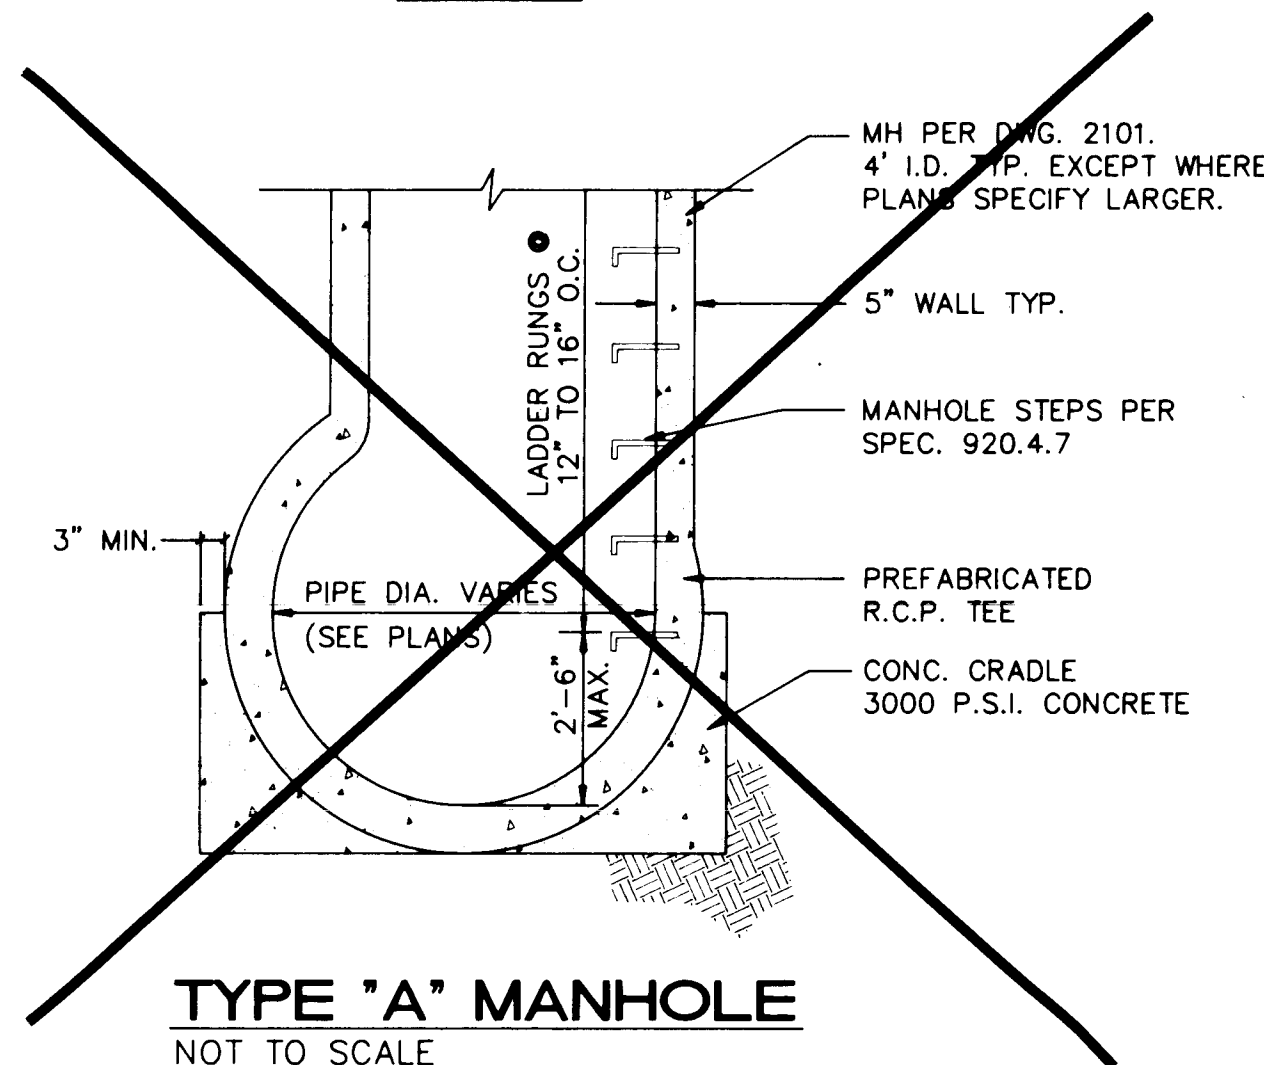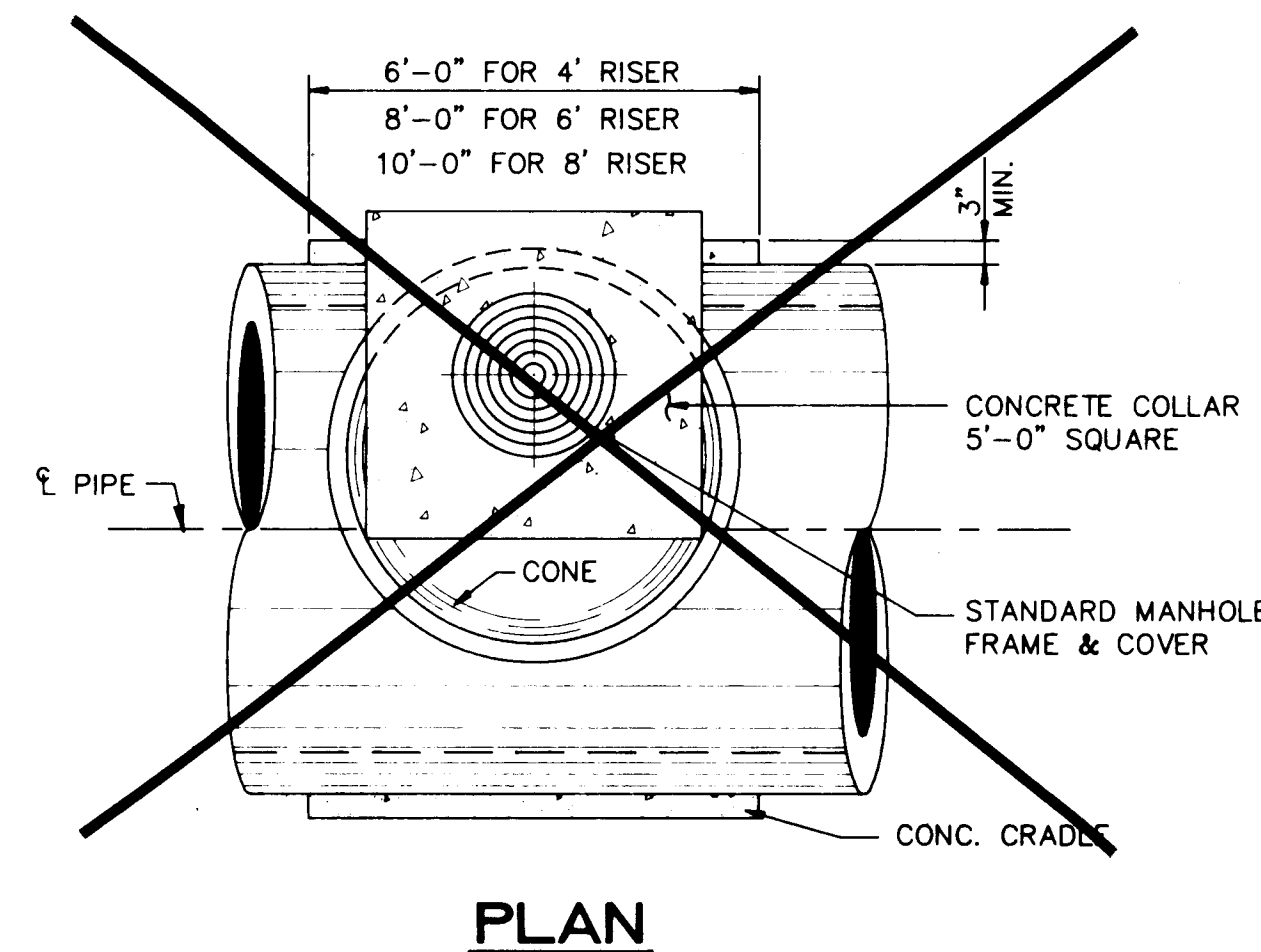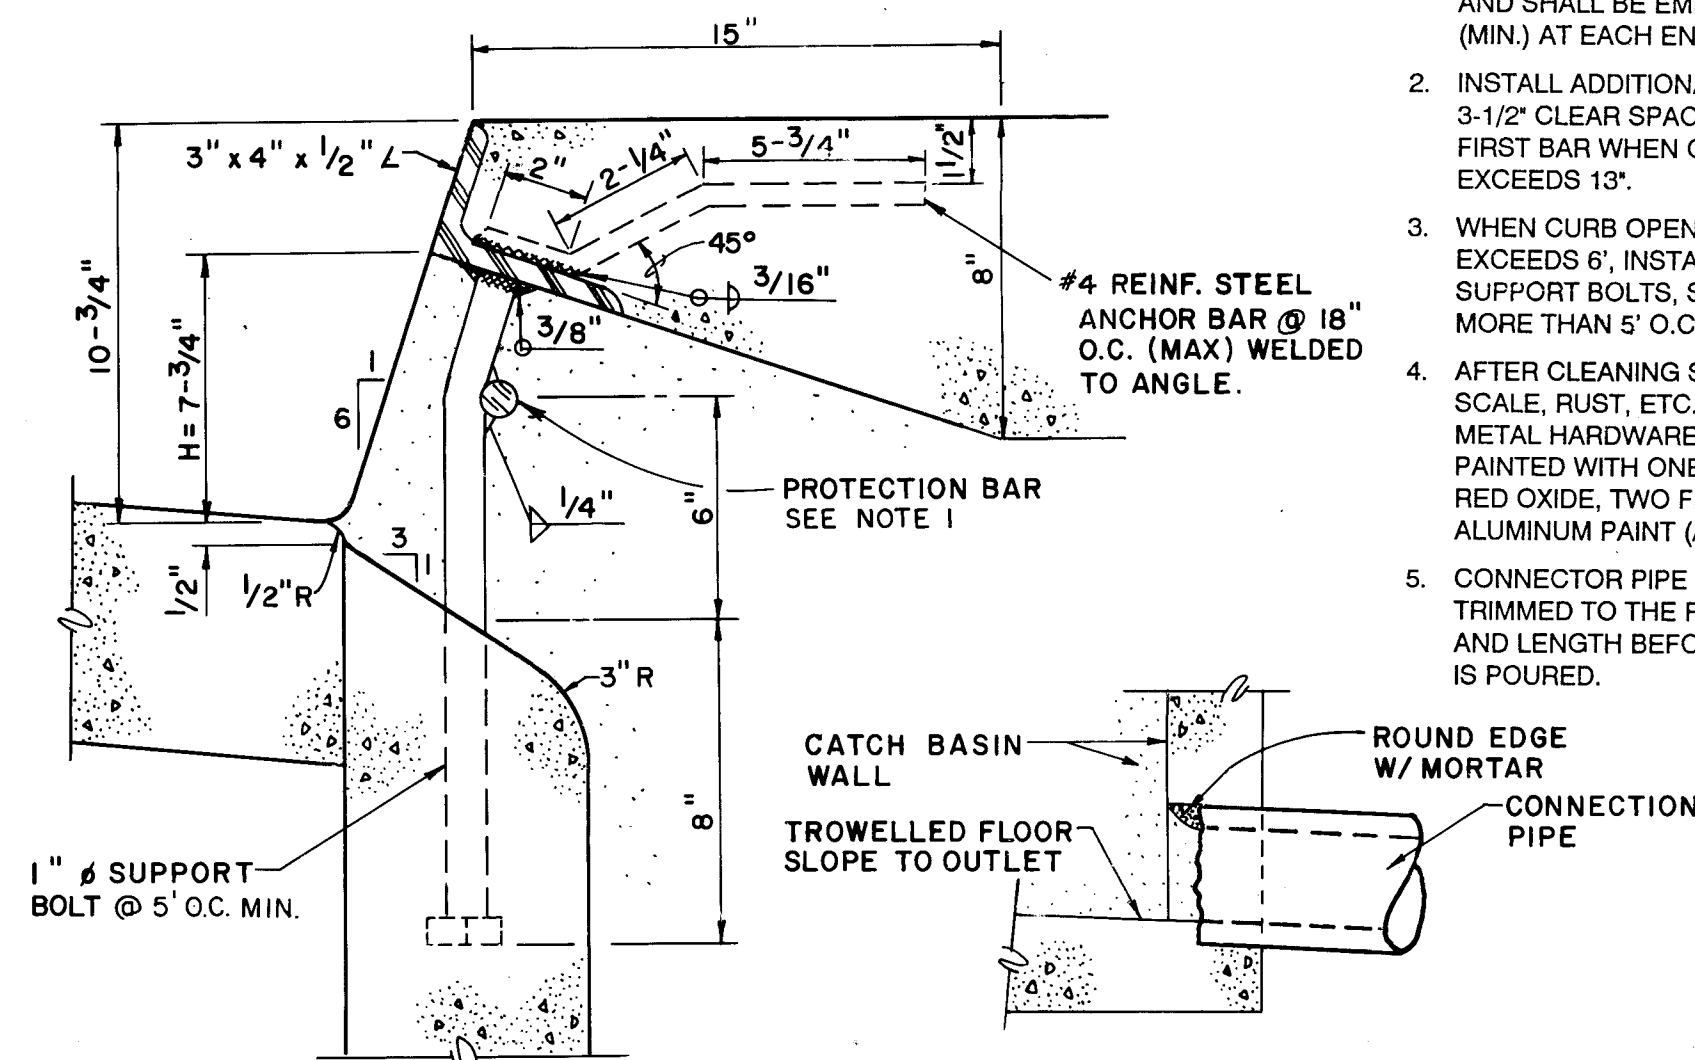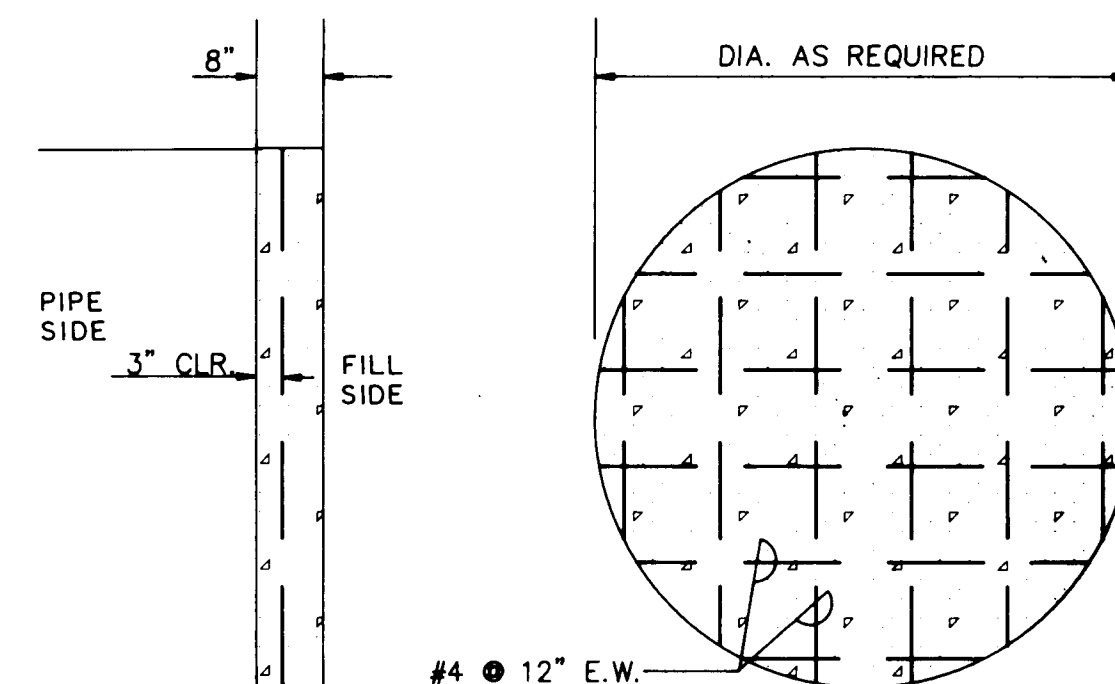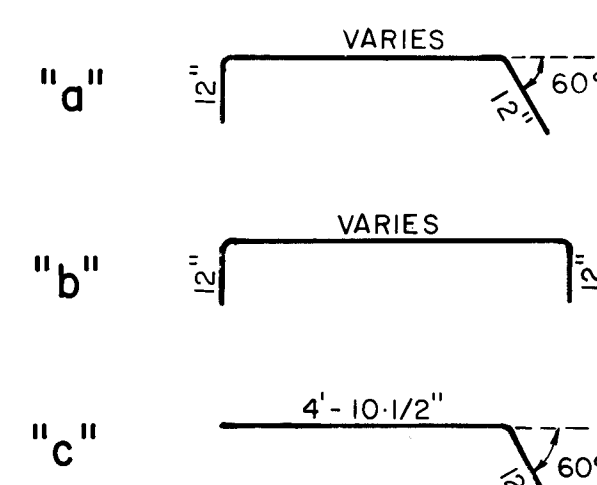

- ## NOTES

1. DOUBLE WING BASINS SHALL HAVE ONE WING PLACED SYMMETRICALLY ON EACH SIDE OF MAINTENANCE BASIN. SINGLE WING BASINS SHALL HAVE ONE WING PLACED ON UPSTREAM SIDE OF MAINTENANCE BASIN.
2. CONNECTOR PIPES SHALL BE PLACED IN THE APPROPRIATE WALL OF THE MAINTENANCE BASIN.
3. FLOOR OF BASIN SHALL BE TROWELLED TO A HARD, SMOOTH SURFACE AND SHALL SLOPE FROM ALL DIRECTIONS TO OUTLET.
4. STEPS AS PER SPEC. 920.4.7. PLACE ONE STEP 12" ABOVE THE FLOOR OF THE BASIN. PLACE STEPS AT 12' INTERVALS FROM THE FLOOR OF THE BASIN WITH THE TOP STEP AT 12" (MIN.) BELOW THE TOP OF THE GRATE.
5. ACCESS FRAME AND COVER NEENAH R1706-1S.

SCANNED BY
BY LASON

1	2	3	4	5	6	7	8	9	10	11	12	13	14	15
26			40	76				90	17	93				

Greiner, Inc.

CITY OF ALBUQUERQUE
PUBLIC WORKS DEPARTMENT
ENGINEERING DIVISION

TITLE	AMOLE DEL NORTE STORM DIVERSION FACILITIES-PHASE III TIERRA BAYITA DRAINAGE FACILITIES
-------	---

MISCELLANEOUS DETAILS

APPROVALS	ENGINEER	DATE	APPROVALS	ENGINEER	DATE
D.R.C Chairman	<i>[Signature]</i>	10-01-91	Water	<i>[Signature]</i>	10-01-91
Transportation	<i>[Signature]</i>	10-01-91	Wastewater	<i>[Signature]</i>	..
Hydrology	<i>[Signature]</i>	9/24/91			

DRAWING NO. 4076.90	MAP NO. L-10	SHEET 17 OF 35
-------------------------------	------------------------	------------------------------

RECORD DRAWING

DATE: 8/9/1	PROJECT NO: G0000101
DATE: 8/9/1	




PLAN VIEW

TYPICAL PIPE PENETRATION

NOT TO SCALE




NOT TO SCALE

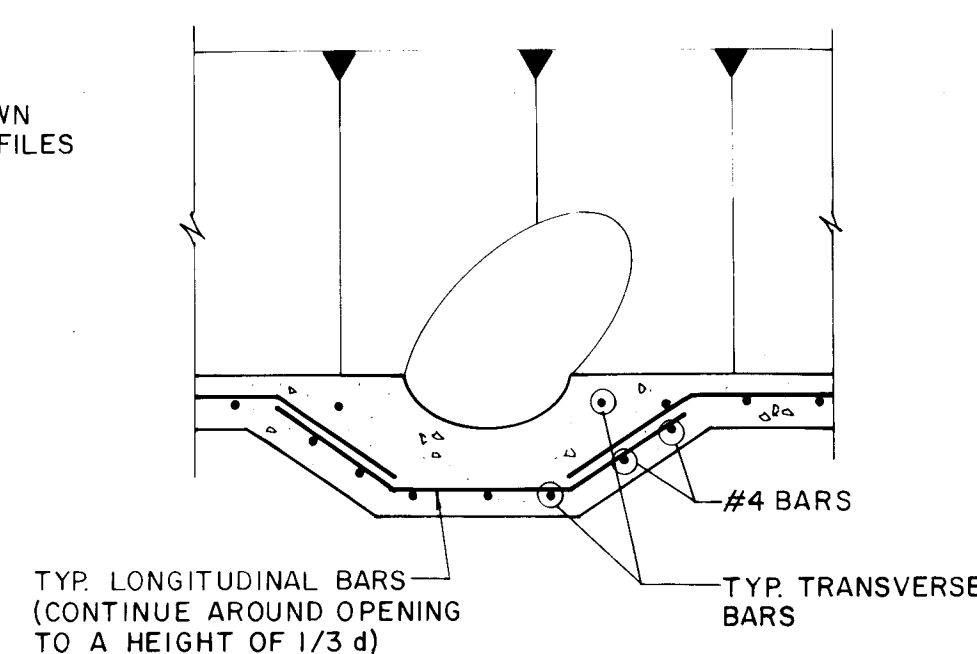


SECTION C-C

NOT TO SCALE

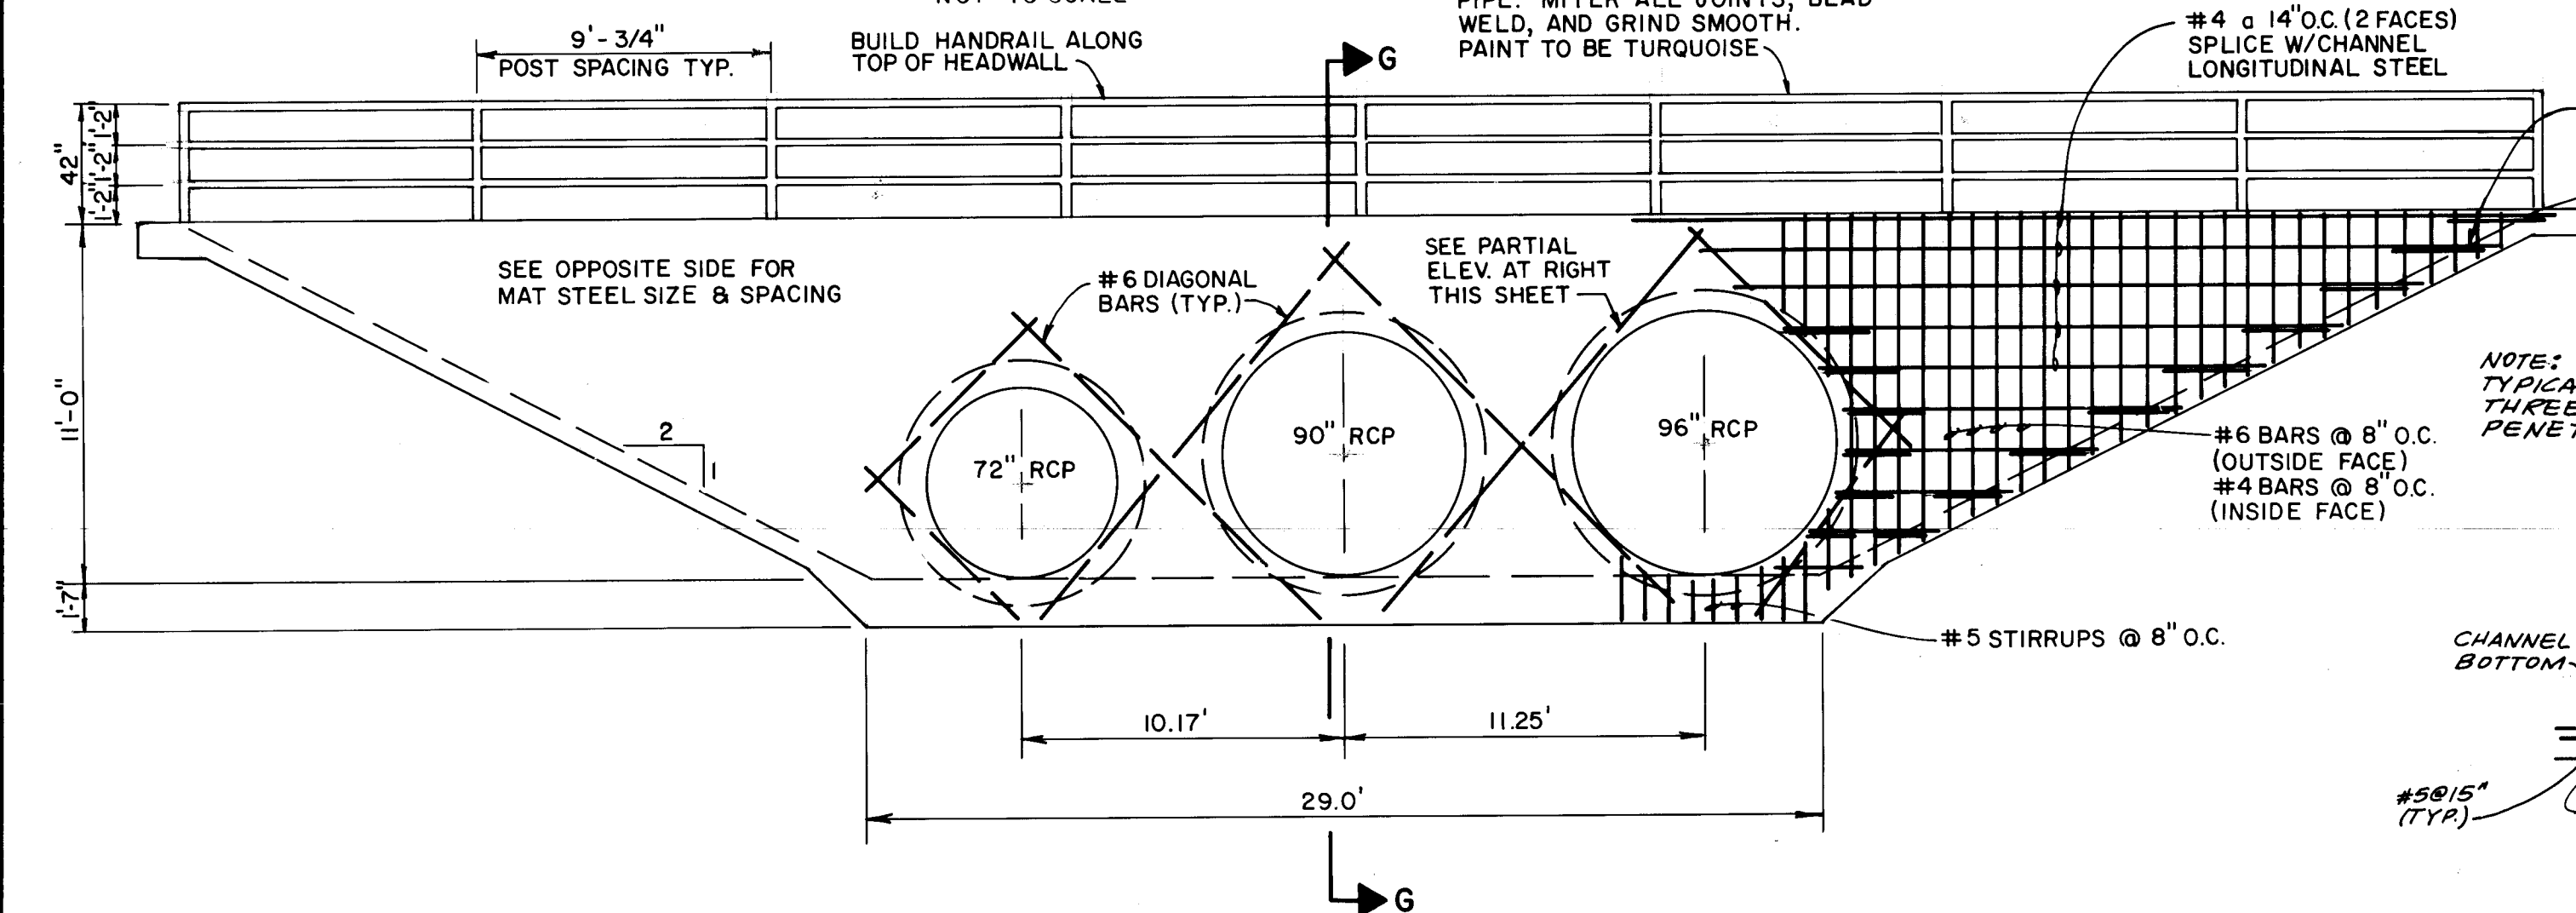


END WALL ELEVATION - STATION 41+06

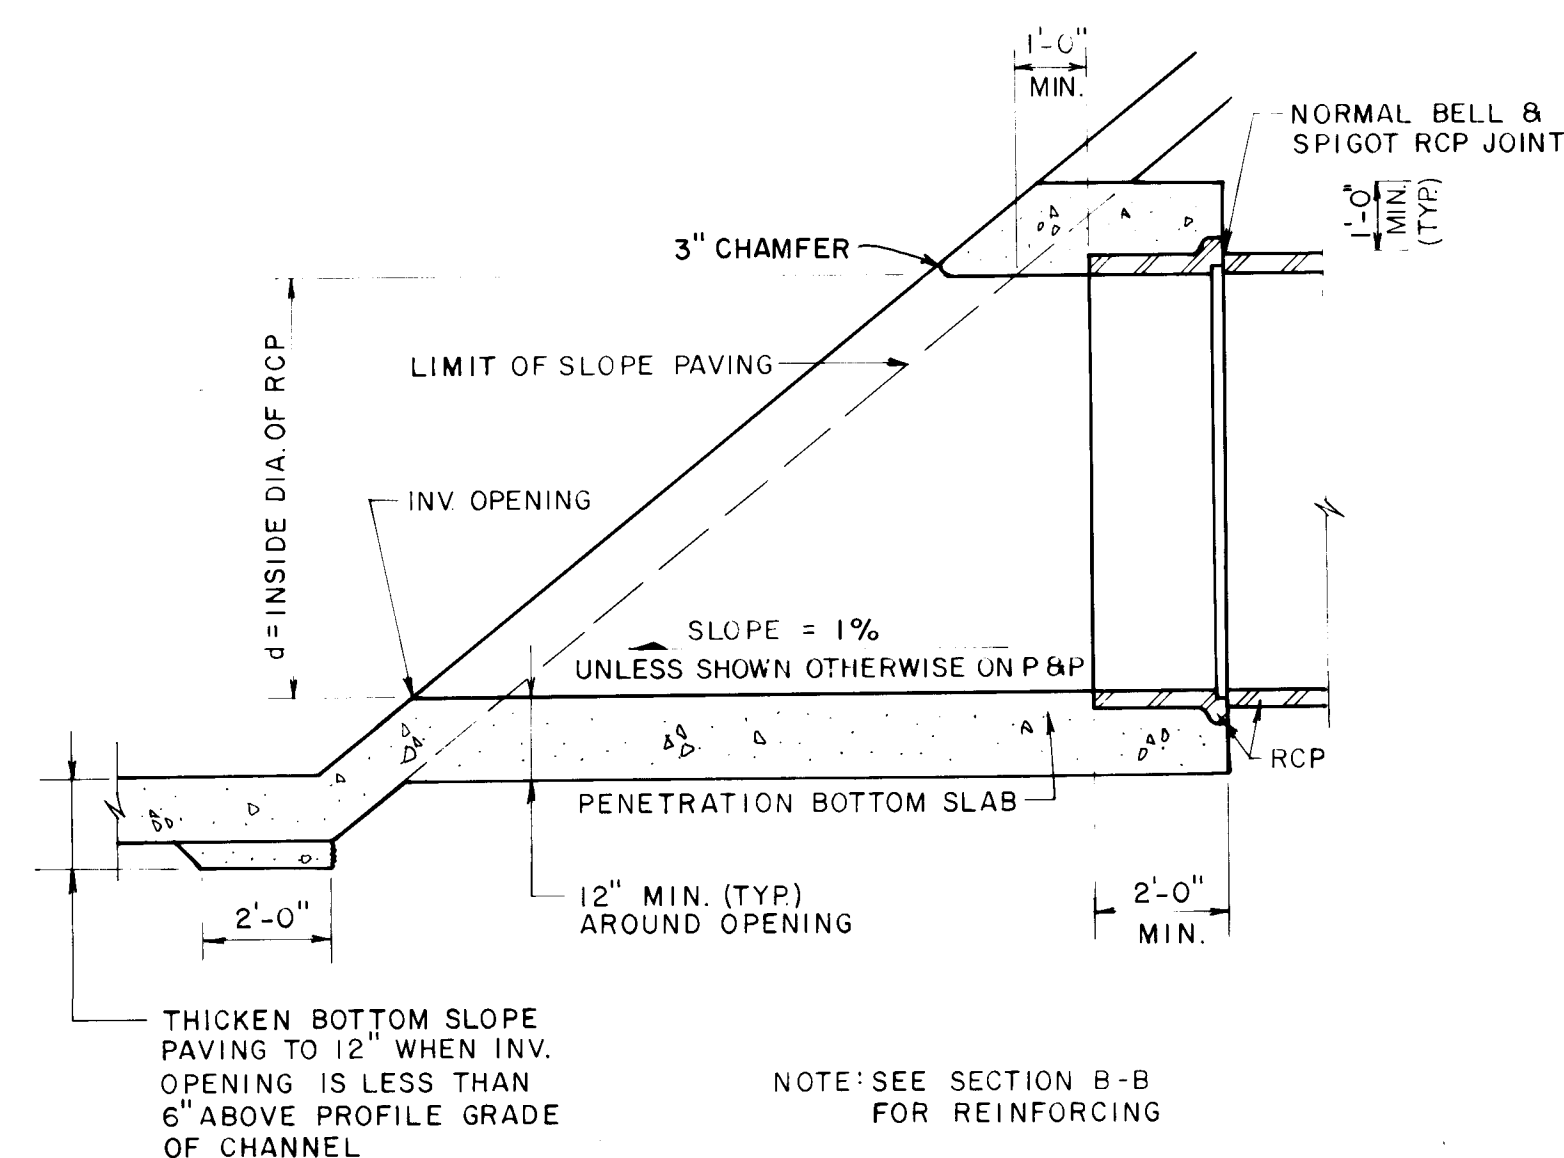


SECTION A-A

NOT TO SCALE

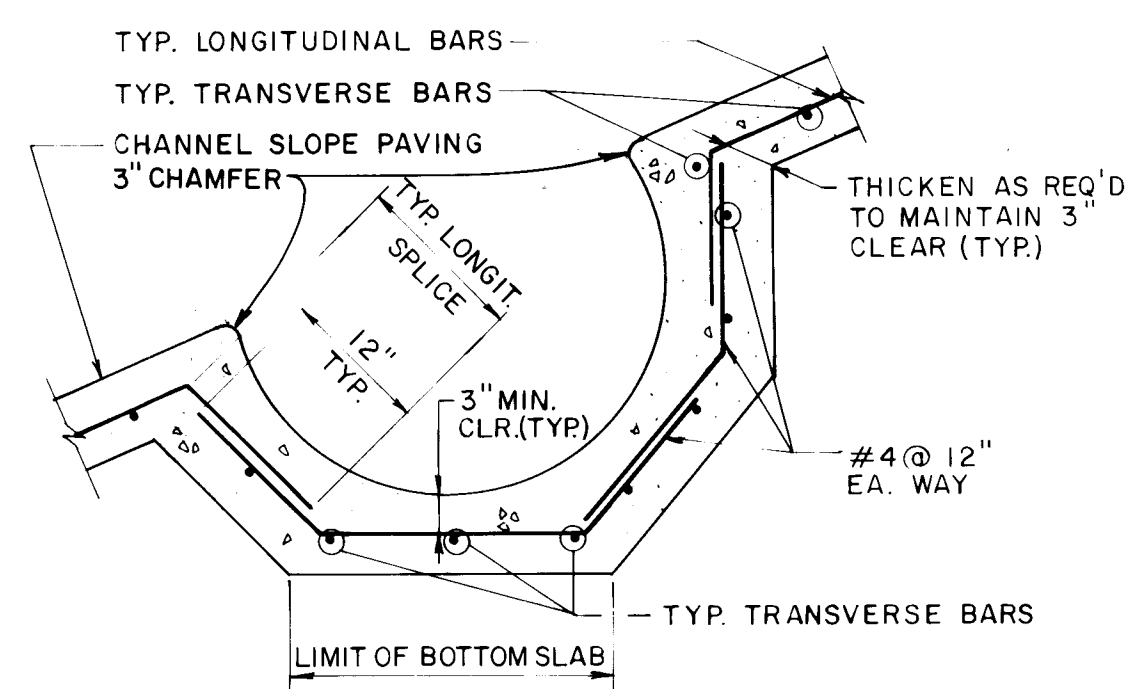


SECTION D-D

NOT TO SCALE

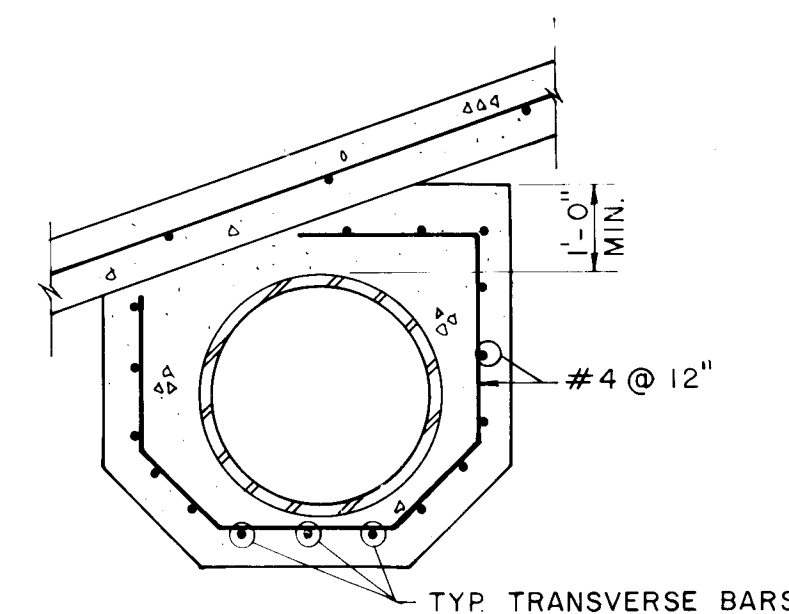


SECTION E-E

NOT TO SCALE

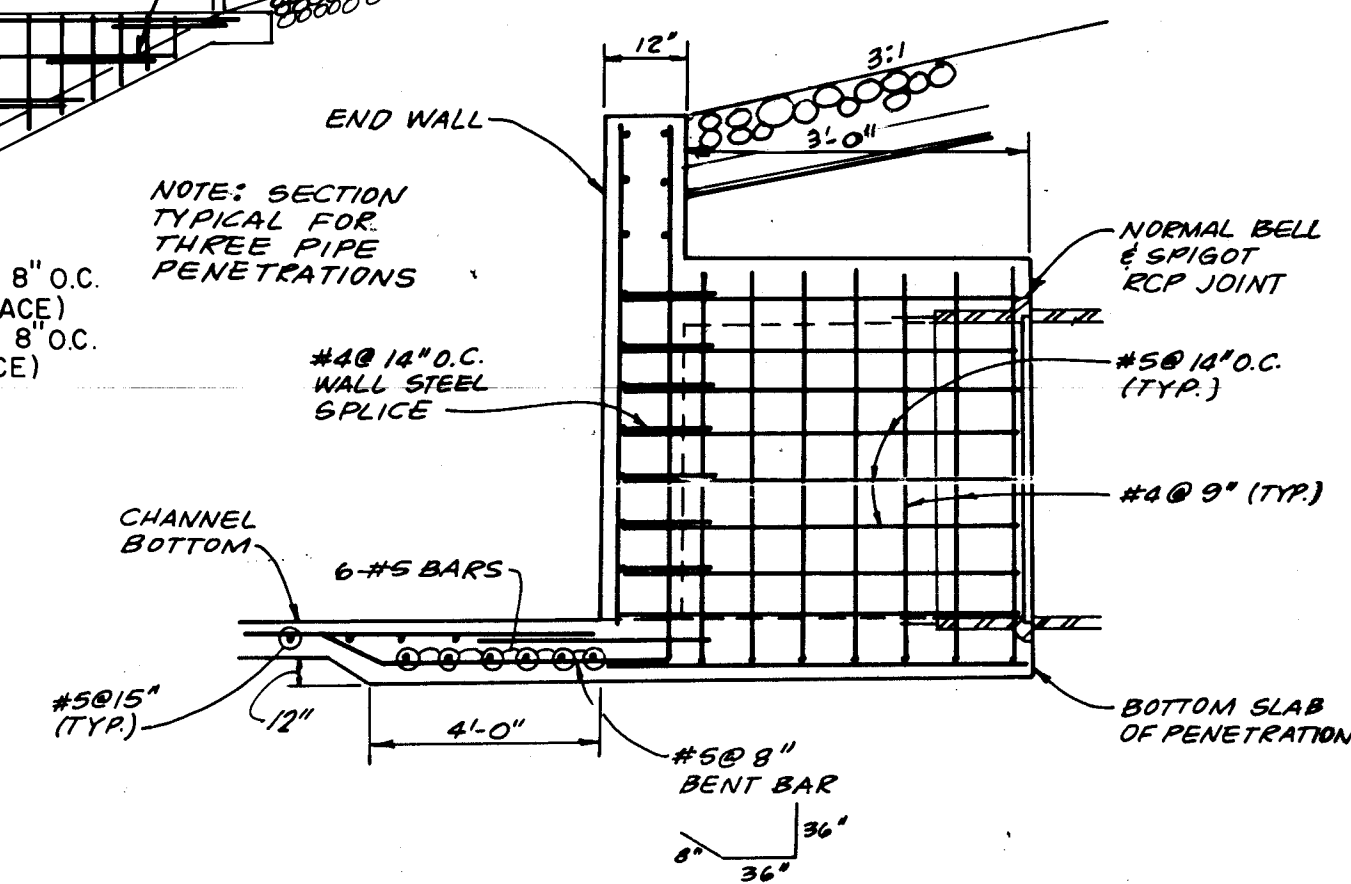


SECTION G-6

NOT TO SCALE

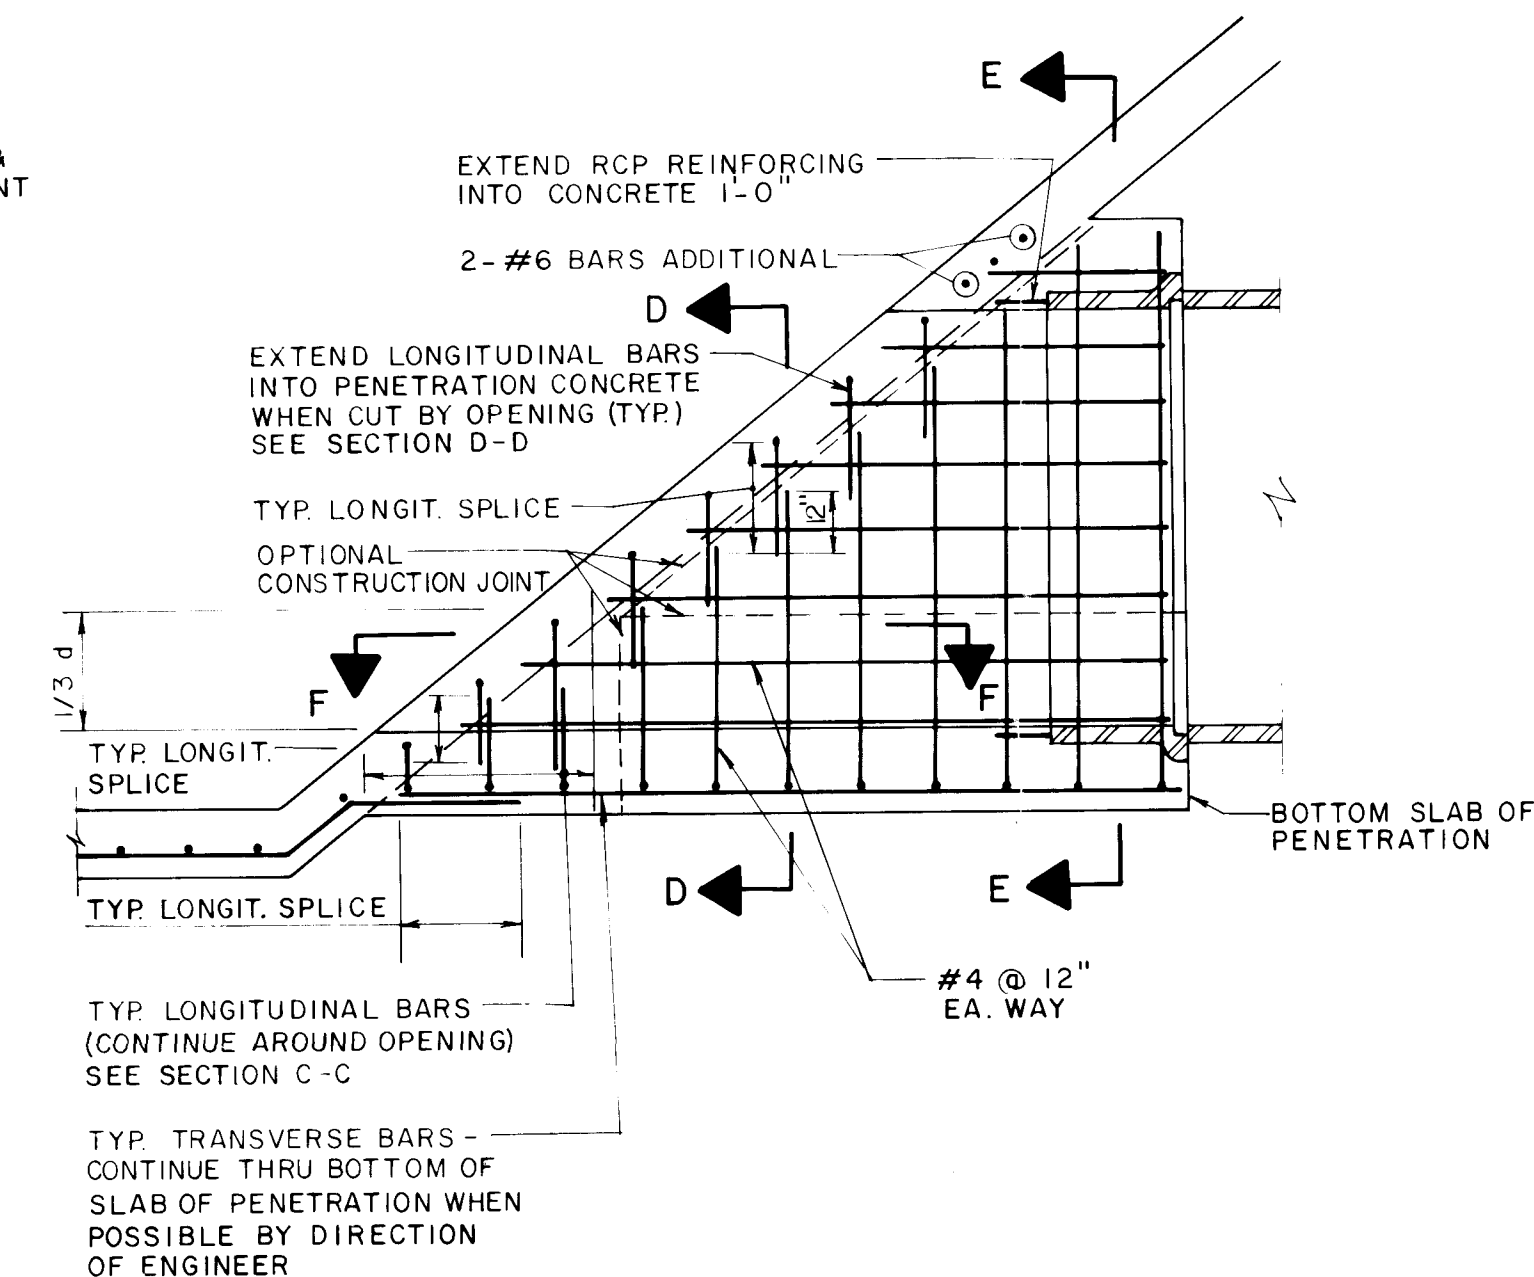


SECTION B-B

NOT TO SCALE

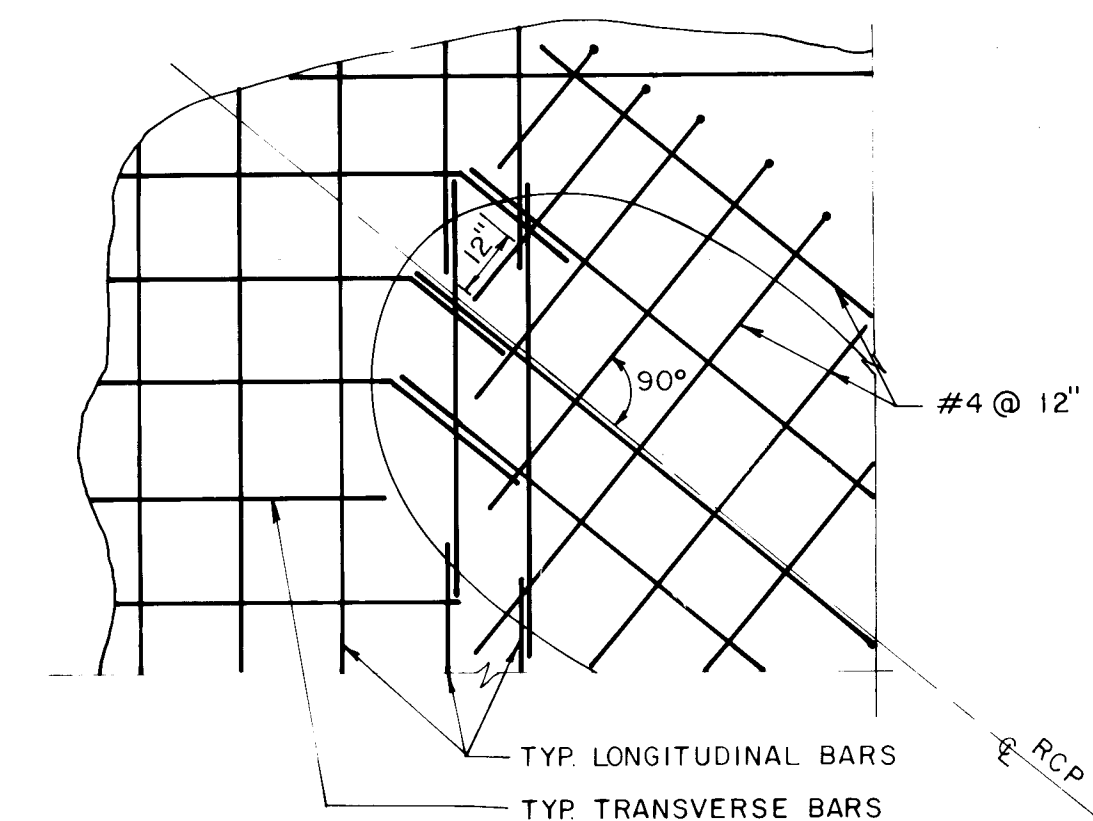


SECTION F-F

NOT TO SCALE

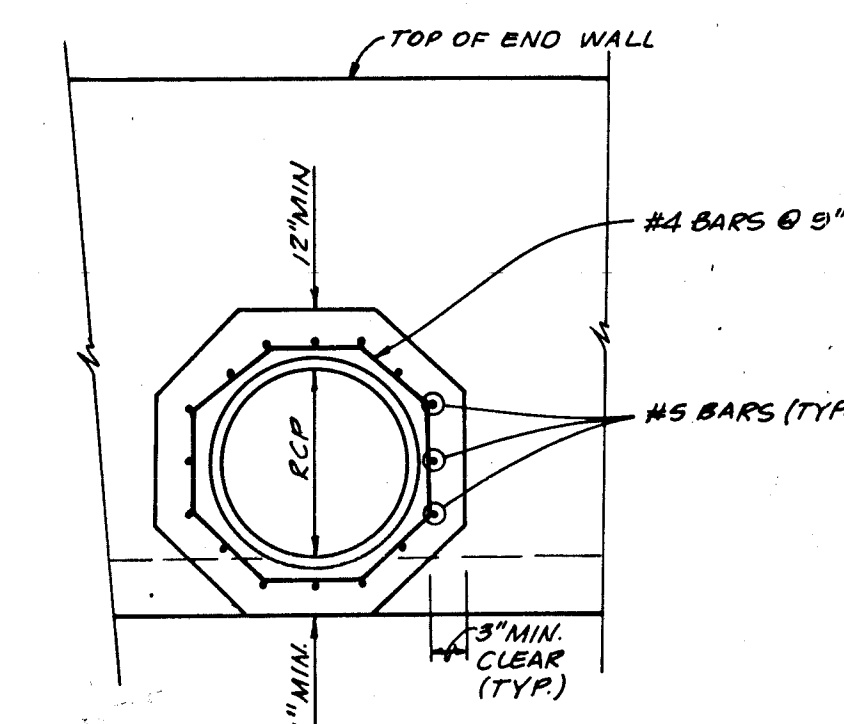

ELEVATION FOR TYPICAL RCP PENETRATION

NOT TO SCALE

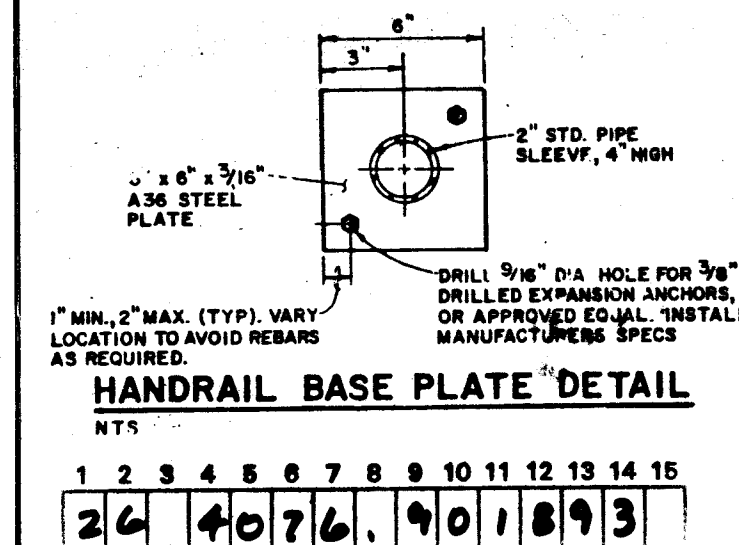

Greiner Engineering

CITY OF ALBUQUERQUE
PUBLIC WORKS DEPARTMENT
ENGINEERING GROUP

PIPE PENETRATION DETAILS

APPROVALS	ENGINEER	DATE	APPROVALS	ENGINEER	DATE
D.R.C. Chair	<i>Robert Shaw</i>	10-23-91	Water	<i>Robert Shaw</i>	10-21-91
Trans. Dev.	<i>W. J. Dams</i>	10-21-91	Wastewater	<i>WJD</i>	"
Hydrology	<i>Tommy</i>	9/24/91			
DRAWING NO.	4076 90	MAP NO.	SHEET 18 OF 35		

RECORD DRAWING

ENGINEER'S SEAL		SURVEY INFORMATION		BENCH MARKS		AS BUILT INFORMATION	
		FIELD NOTES					
NO	BY	DATE					
1880	GREINER	6-7/80			TBM-AMOLE 13 - BRASS CAP SET IN THE NORTH SIDE OF BRIDGE BOULEVARD APPROXIMATELY 30' NORTH OF THE EDGE	WALKER	1902
1883	GREINER	7/8/90			C-2 PAVEMENT AND APPROXIMATELY 125' WEST OF SESAME STREET. N = 1,481,384.909 E = 360,370.080 ELEV = 5072.064	C. PEDRONELLI	9-92
1886	GREINER	12/90			TBM-AMOLE 14 - BRASS CAP ON THE NORTHWESTERLY TURN ISLAND IN THE INTERSECTION OF NORTHSOUTH COORS CONNECTION AND BRIDGE BOULEVARD. N = 1,481,037.480 E = 361,880.107 ELEV = 5035.731	WALKER & COVART	9-92
1893	GREINER	1/91				WALKER & COVART	9-92
1910	GREINER	9-10/91				WALKER & COVART	9-92

DESIGNED BY T. L. H. DATE 8/91


DRAWN BY J.T.

CHECKED BY *WAK* DATE 9/91


BRUNING 44.232 71921

26 4076 90/993



MISSING

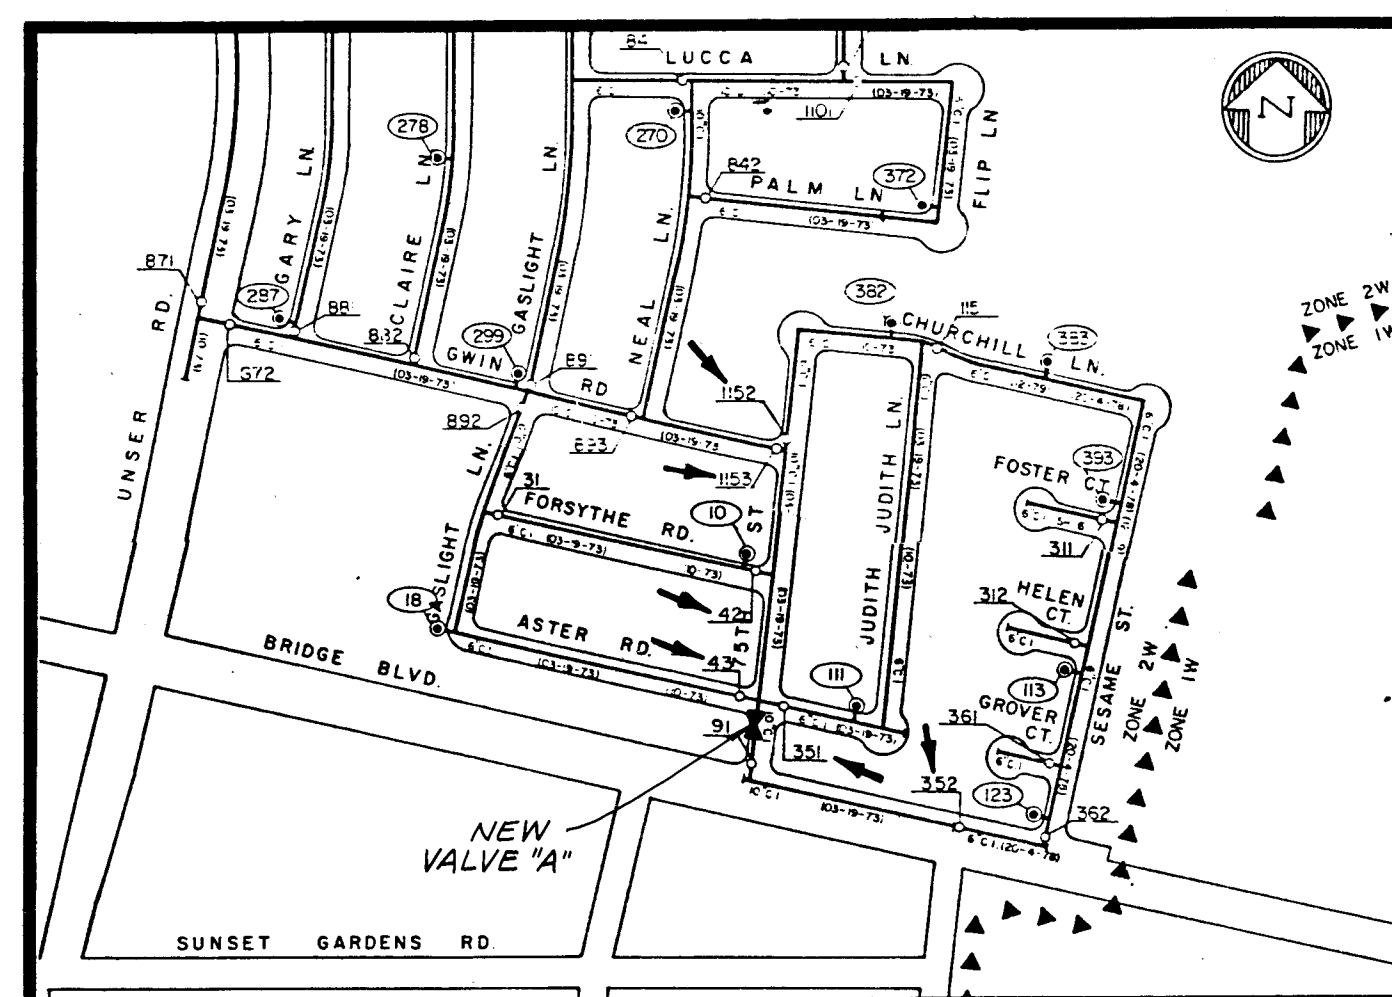

- SEQUENCE - 75th STREET**
1. SHUT OFF ALL VALVES SHOWN.
 2. INSTALL NEW 10" WATER VALVE "A" AT THE INTERSECTION OF ASTER ROAD & 75th STREET. CLOSE NEW VALVE.
 3. OPEN VALVES 1152, 1153, 42, 43, AND 351.
 4. PROCEED WITH NEW 10" WATER LINE CONSTRUCTION.
 5. REMOVE VALVE 91 & RETURN TO CITY YARDS.
 6. UPON COMPLETION OF NEW LINE AND ALL REQUIRED TESTING. OPEN ALL OTHER VALVES.


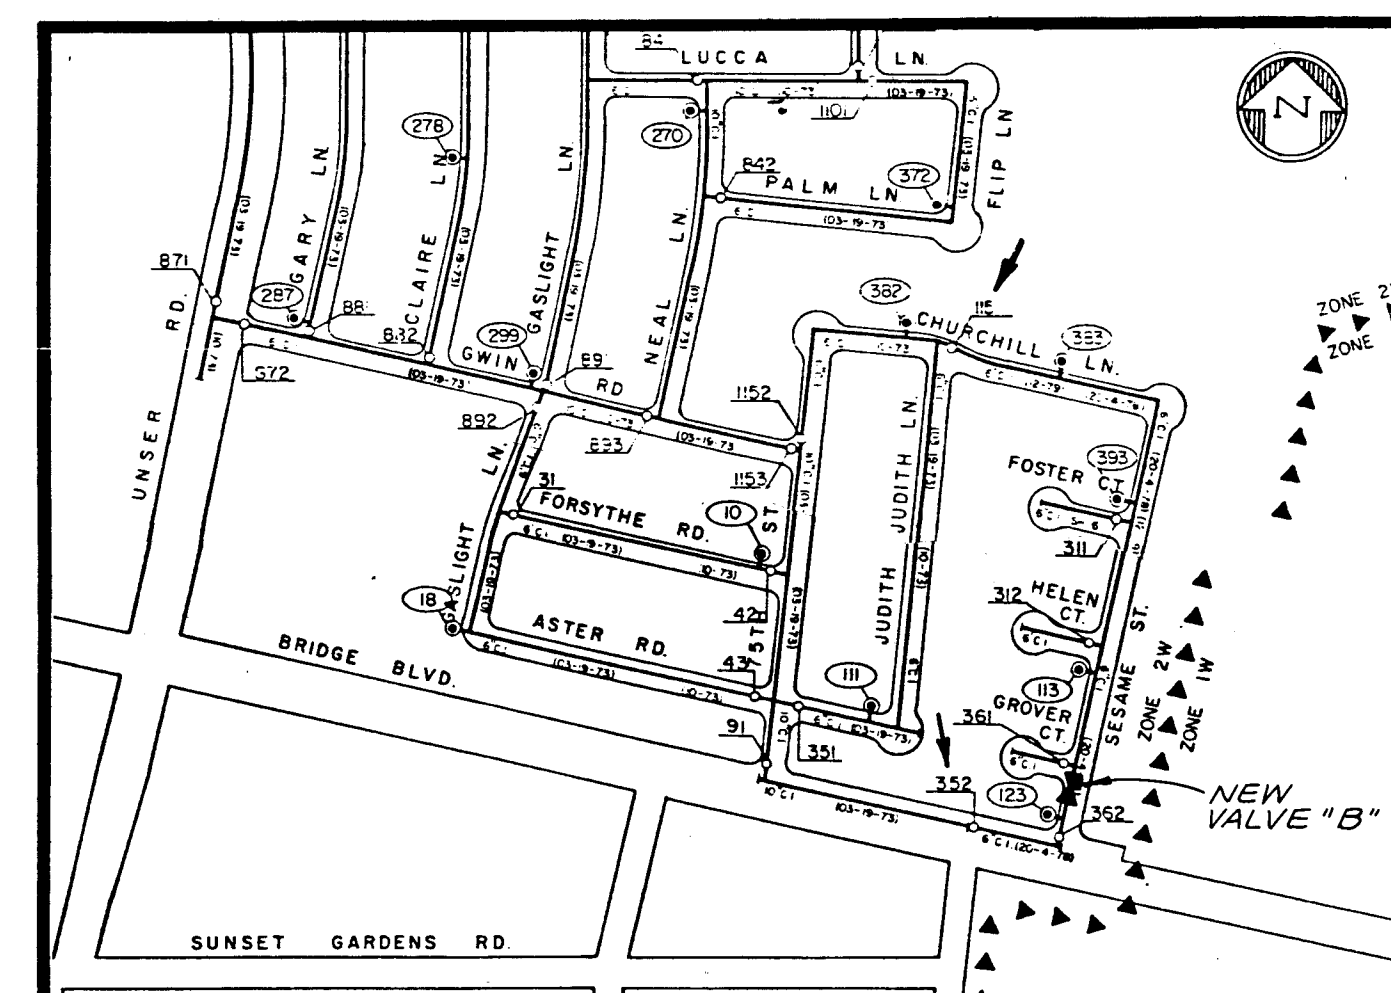


- SEQUENCE - SESAME STREET**
1. SHUT OFF ALL VALVES SHOWN.
 2. INSTALL NEW 6" WATER VALVE "B" AT THE INTERSECTION OF SESAME STREET & GROVER CT. CLOSE NEW VALVE.
 3. OPEN VALVE 115.
 4. PROCEED WITH NEW 6" WATER LINE CONSTRUCTION.
 5. UPON COMPLETION OF NEW LINE AND ALL REQUIRED TESTING. OPEN ALL OTHER VALVES.

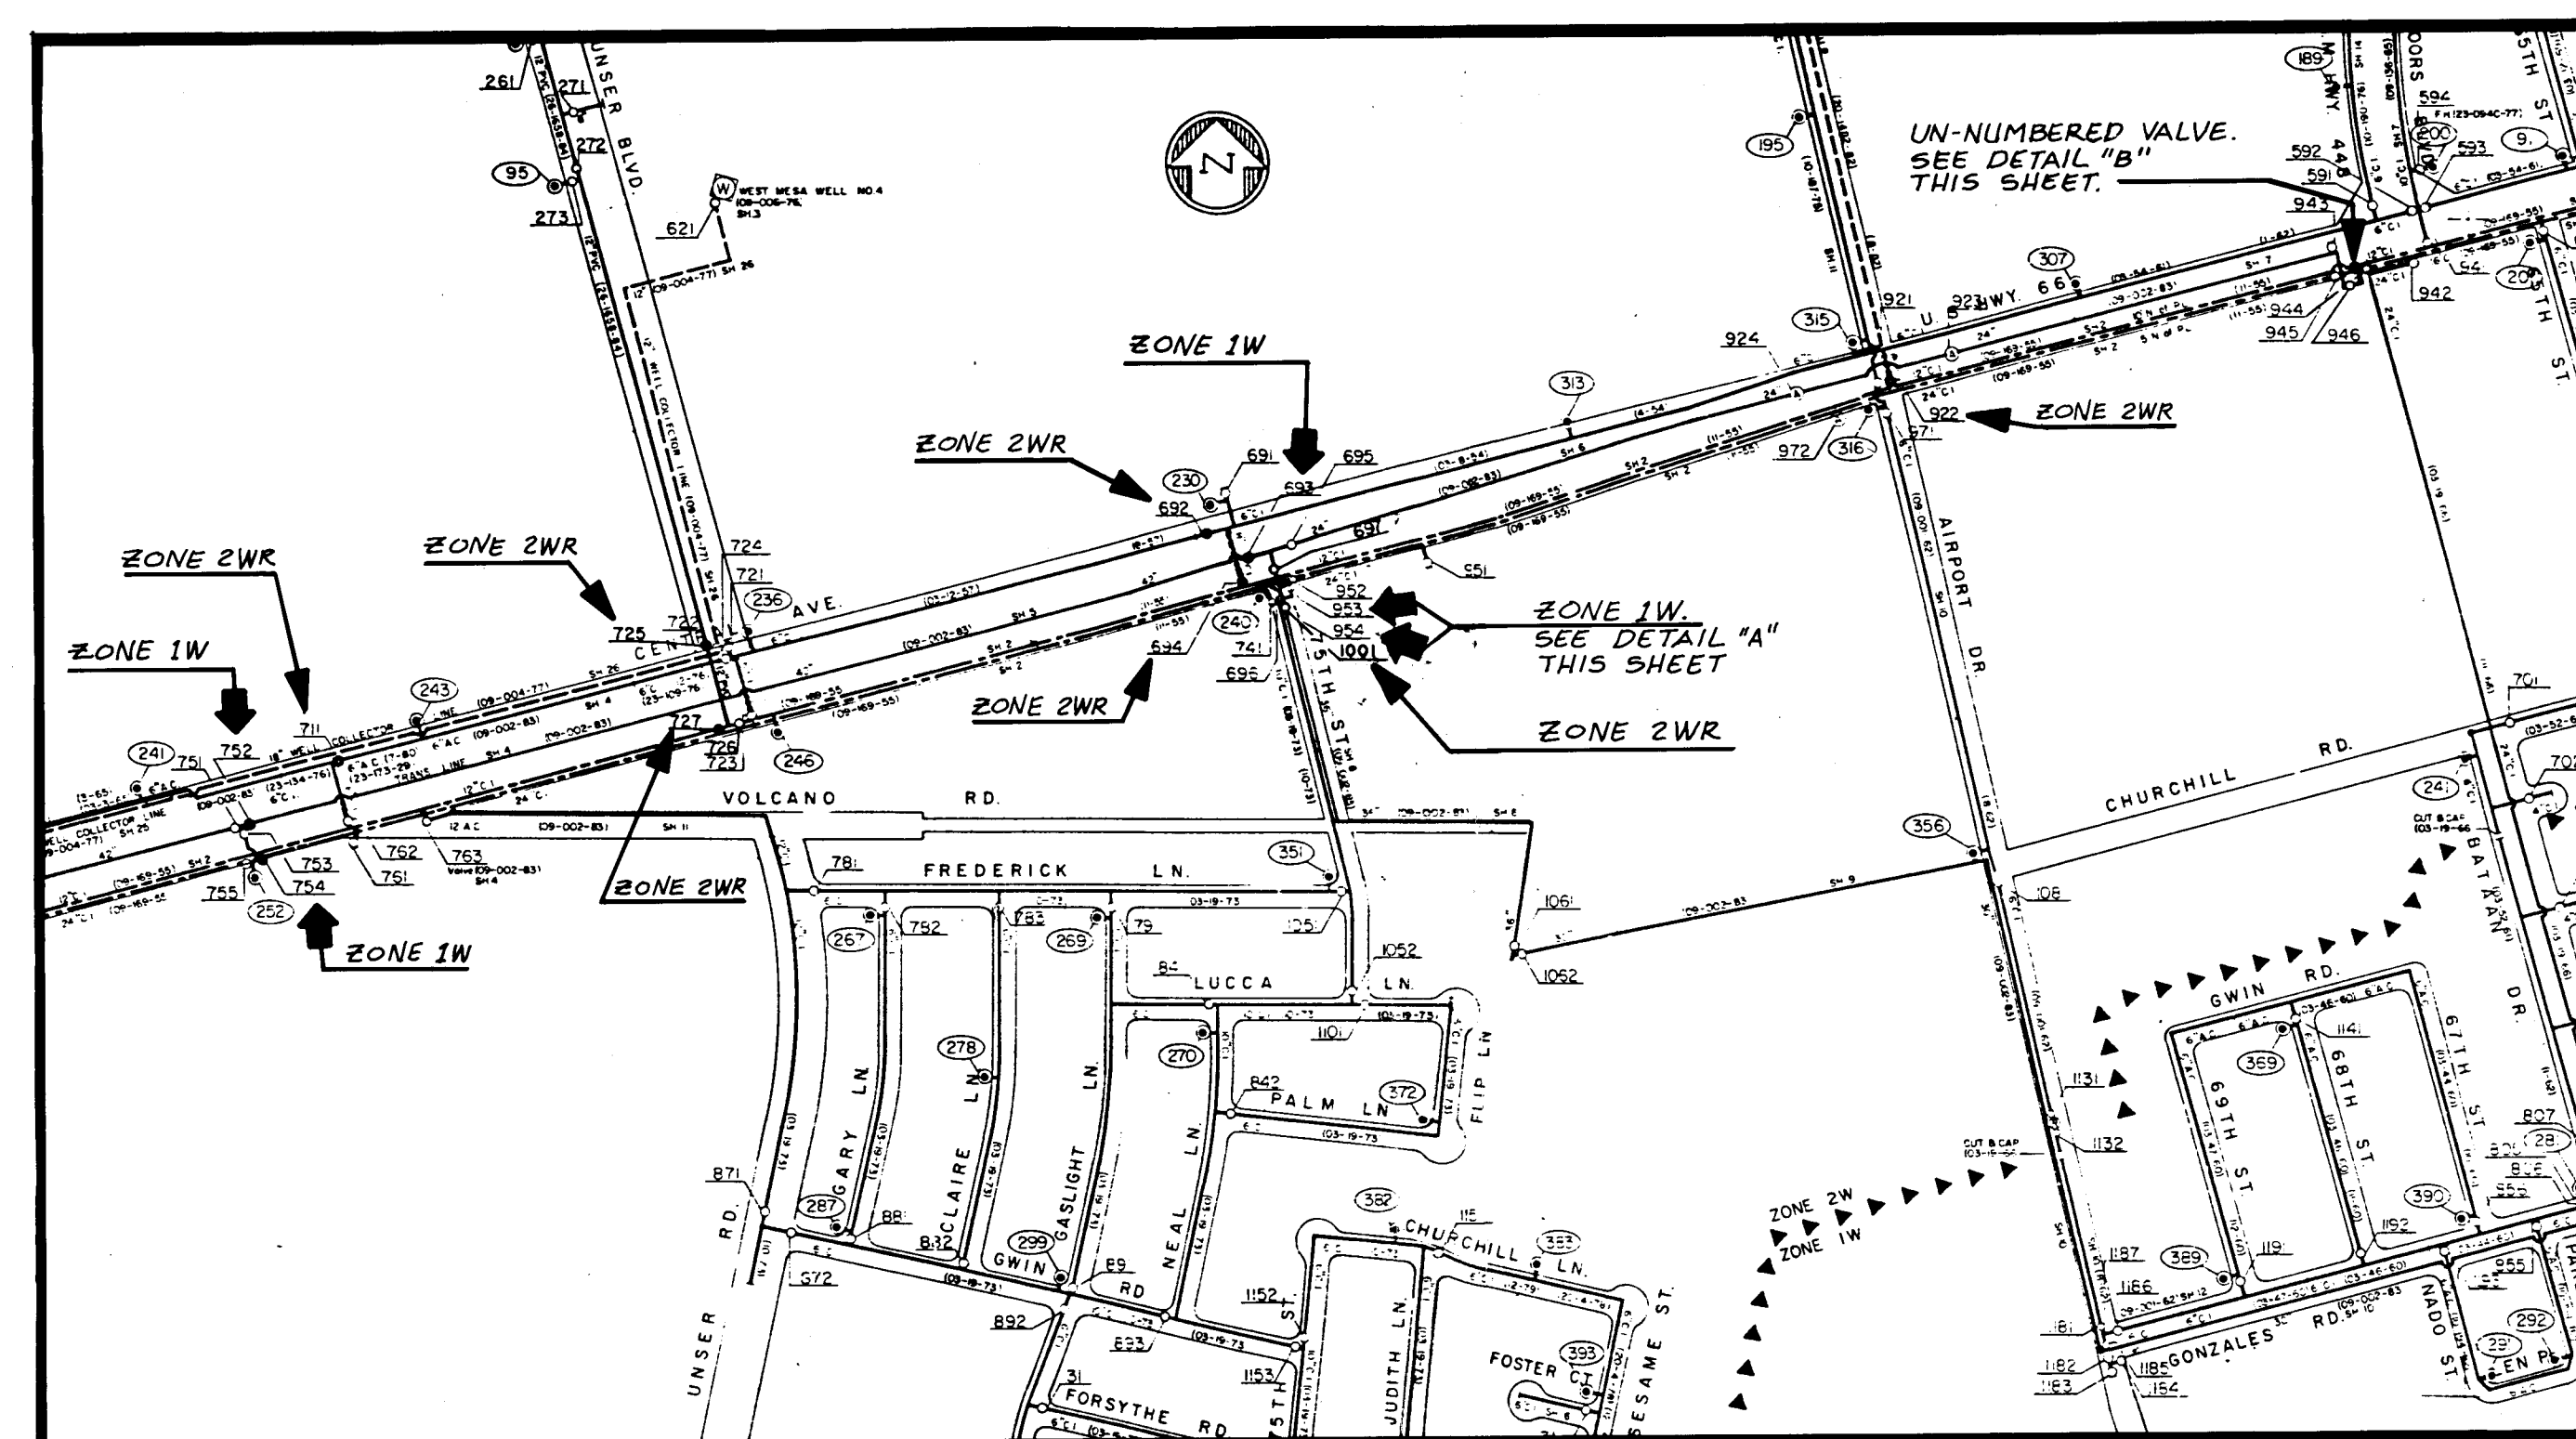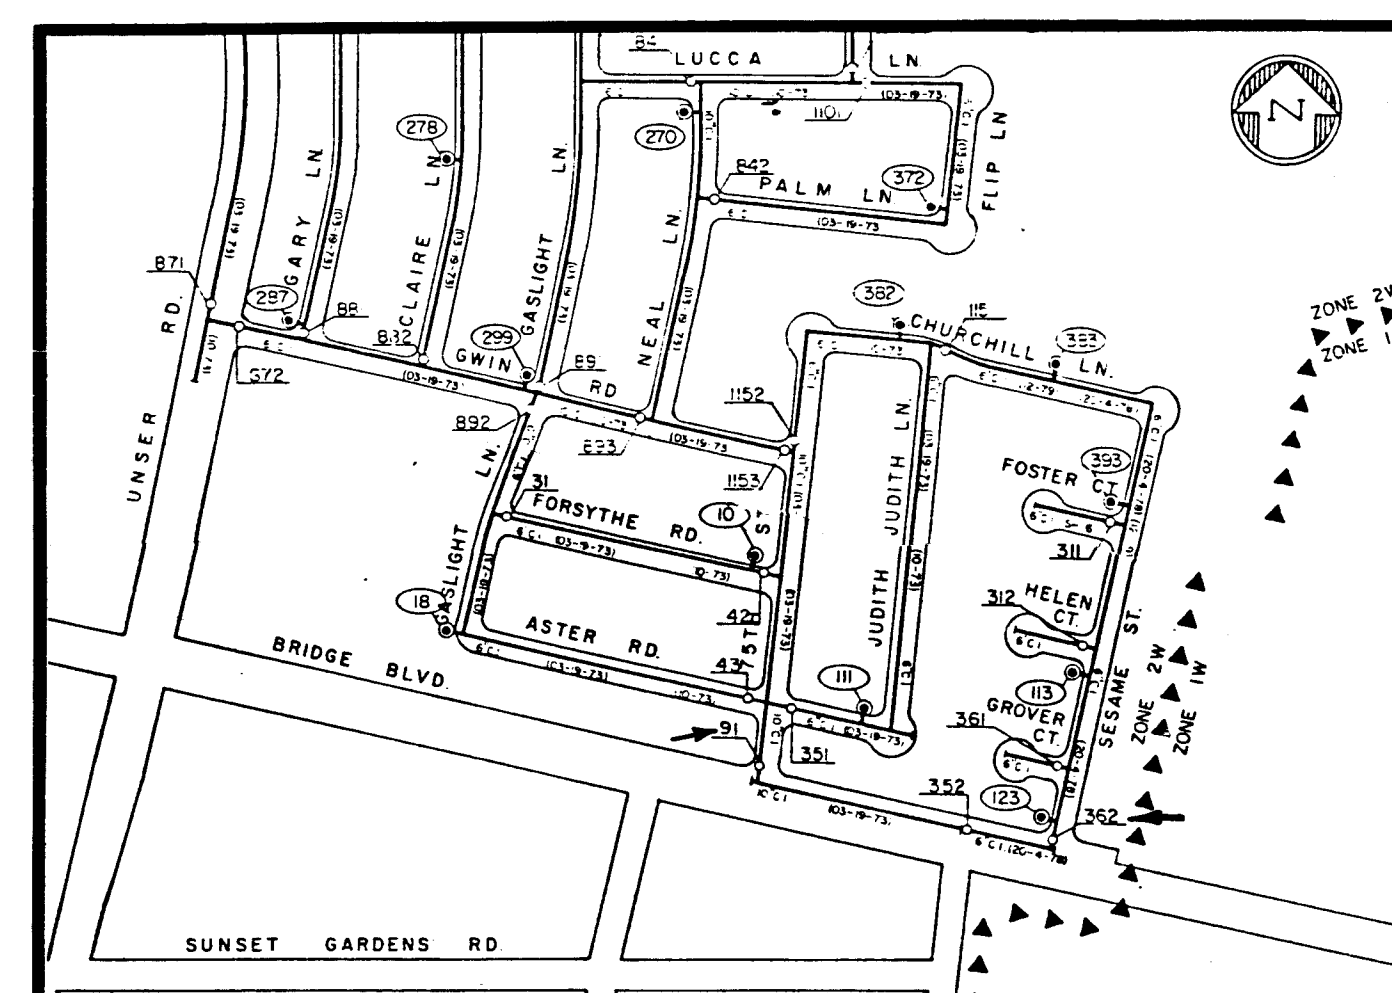


- SEQUENCE - WATER LINE SHUT DOWNS AT UNSER AND CENTRAL**

1. TEST SHUT DOWN OF THE FOLLOWING WATER LINES IN CENTRAL SHALL BE REQUIRED PRIOR TO CONSTRUCTION OF THE STORM DRAIN UNDER THE WATER LINES:
 - 12" (ZONE 2WR)
 - 24" AND 42" (ZONE 1W)
2. THE 24" (ZONE 1W) MAY BE SHUT DOWN INDEFINITELY. THE 12" (ZONE 2WR) LINE AND 42" (ZONE 1W) LINE MAY BE SHUT DOWN A MAXIMUM OF 8 HOURS EACH AND ONLY FROM SEPTEMBER 1 TO APRIL 30.
3. 24" AND 42" LINES (ZONE 1W) MUST BE SHUT DOWN DURING CONSTRUCTION OF STORM DRAIN UNDER THE WATER LINES.
4. 12" (ZONE 2WR) AND 24" (ZONE 1W) CAST IRON WATER LINES MUST BE REPRESSURIZED AFTER STORM DRAIN CONSTRUCTION AND BACKFILL;AND TOP HALF OF JOINTS WITHIN THE TRENCH PRISM SHALL BE EXPOSED AND CHECKED FOR LEAKS.
5. SHUT DOWN AND DEWATERING OF THE 12" (ZONE 2WR) LINE IS ONLY REQUIRED IF THE LINE IS DAMAGED AND LEAKS DURING INSTALLATION OF THE STORM DRAIN.
6. ALBUQUERQUE FIRE DEPARTMENT SHALL BE ALERTED OF LOW PRESSURE IN THE SKYVIEW WEST SUBDIVISION IF 12" (ZONE 2WR) LINE IS SHUT DOWN.

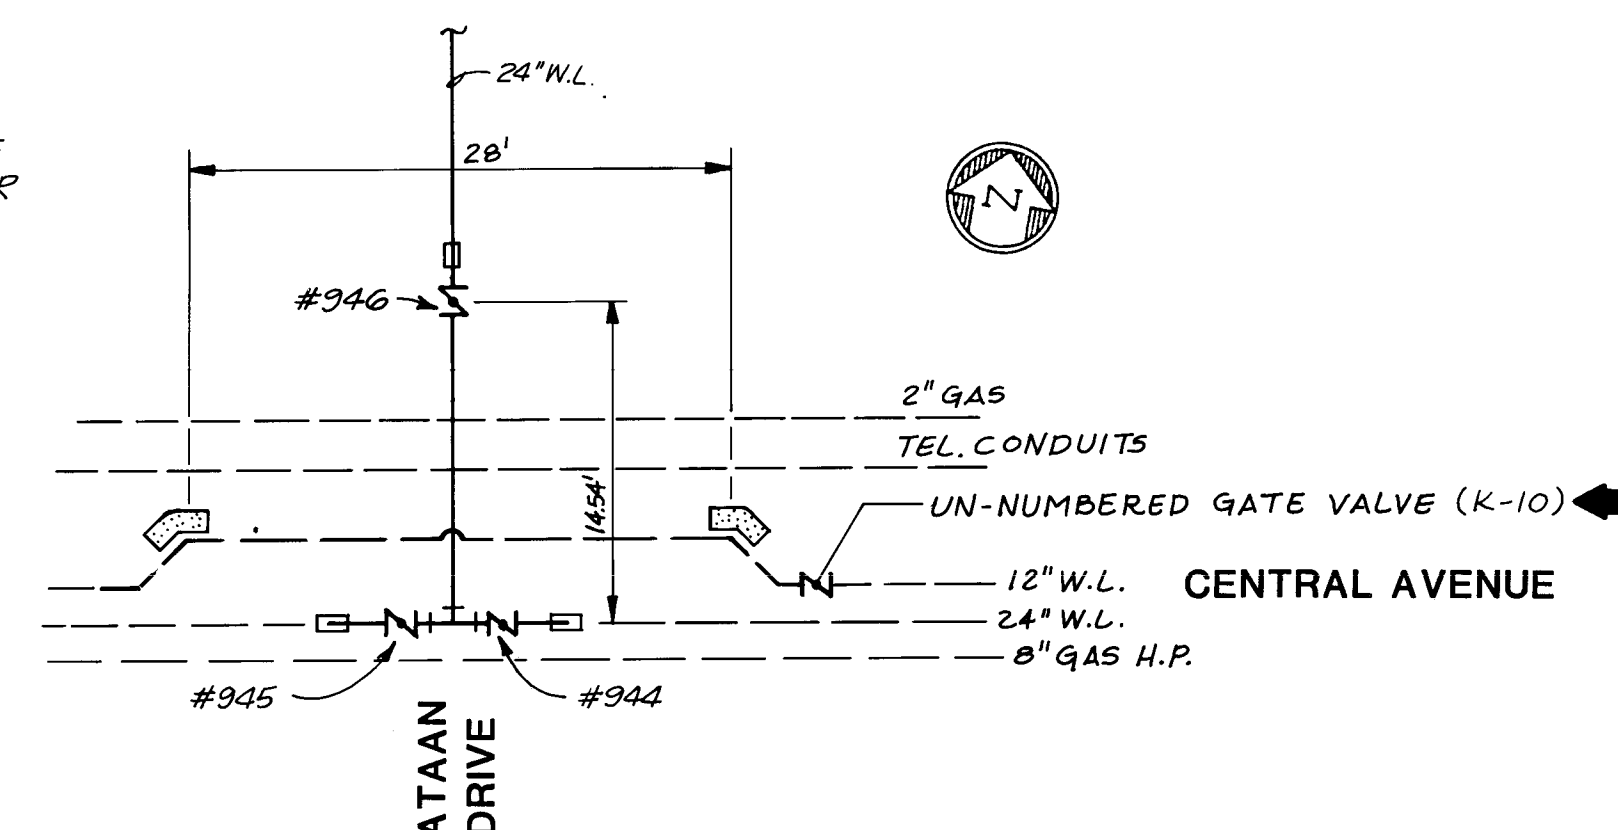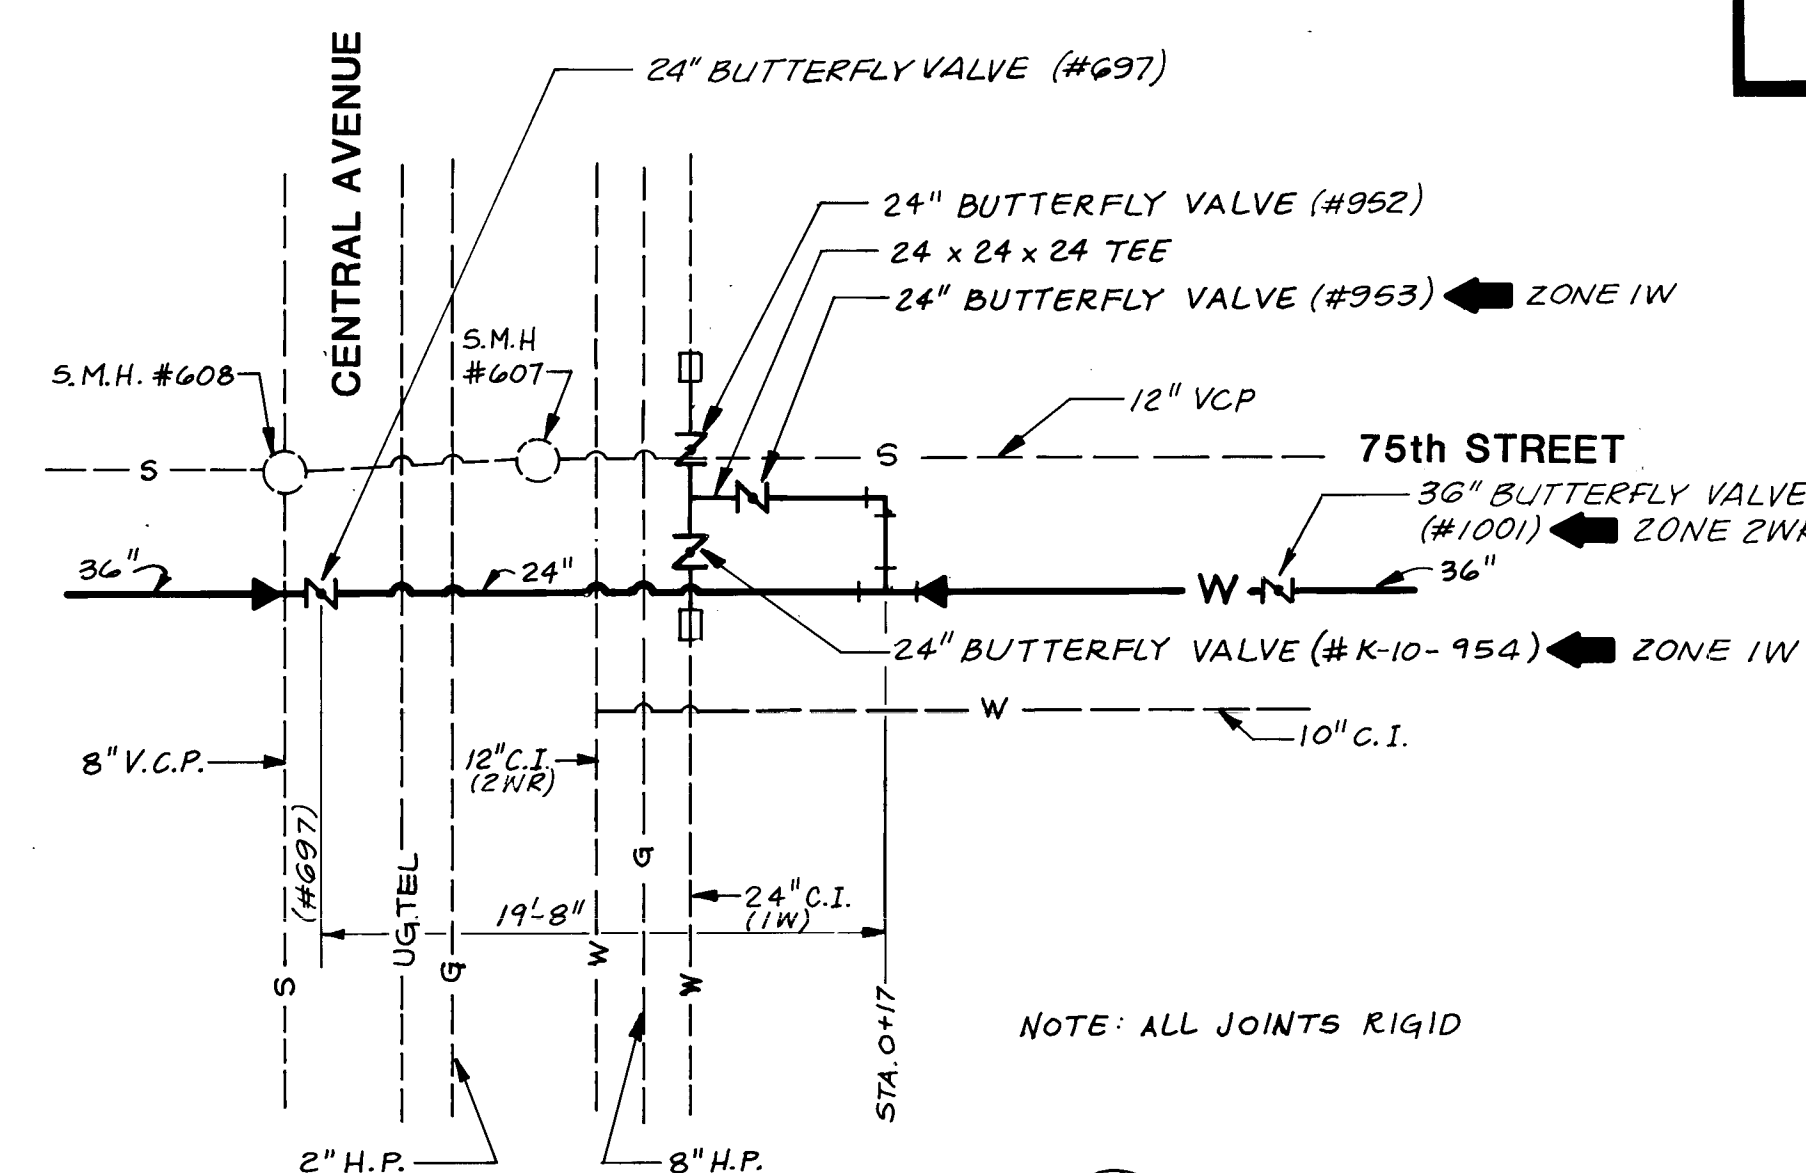


ENGINEER'S SEAL			SURVEY INFORMATION		BENCH MARKS		AS BUILT INFORMATION	
			FIELD NOTES					
			NO.	BY	DATE			
			1880	GREINER	6/7/90	TBM AMOLE 13 - BRASS CAP SET IN THE NORTH SIDE OF BRIDGE BOULEVARD APPROXIMATELY 30' NORTH OF THE EDGE OF PAVEMENT AND APPROXIMATELY 125' WEST OF SESAME STREET. N = 1,481,394.909 E = 360,370.080 ELEV = 5072.064		CONTRACTOR MOORE & COVART WORKED BY WALKER DATE 1992 INSPECTED BY C. PERGARELLI ACCEPTED BY C.O.A. PW DATE 9-92
		REMARKS	1883	GREINER	7/8/90			
			1886	GREINER	12/90	TBM AMOLE 14 - BRASS CAP ON THE NORTHWESTERLY TURN ISLAND IN THE INTERSECTION OF NORTH/SOUTH COORS CONNECTION AND BRIDGE BOULEVARD. N = 1,481,037.480 E = 361,880.107 ELEV = 5035.731		FIELD LATION BY WALKER DATE 9-92 DRAWINGS CORRECTED BY WALKER DATE 9-92
		DESIGN	1893	GREINER	12/90			MICRO-FILM INFORMATION
		DESIGNED BY	1893	GREINER	1/91			RECORDED BY DATE
		DRAWN BY	1910	GREINER	9-10/91			NO

CITY OF ALBUQUERQUE PUBLIC WORKS DEPARTMENT ENGINEERING GROUP					
TITLE: AMOLE DEL NORTE STORM DIVERSION FACILITIES - PHASE III A TIERRA BATITA DRAINAGE FACILITIES WATER SHUT - OFF PLAN					
APPROVALS	ENGINEER	DATE	APPROVALS	ENGINEER	DATE
DRC Chair	<i>[Signature]</i>	10/26/11	Water	<i>[Signature]</i>	10/26/11
Trans. Dev	<i>[Signature]</i>	10/26/11	Wastewater	<i>[Signature]</i>	10/26/11
Hydrology	<i>[Signature]</i>	9/26/11			
DRAWING NO.	4076.90	MAP NO.	K-L-10	SHEET	20 OF 35

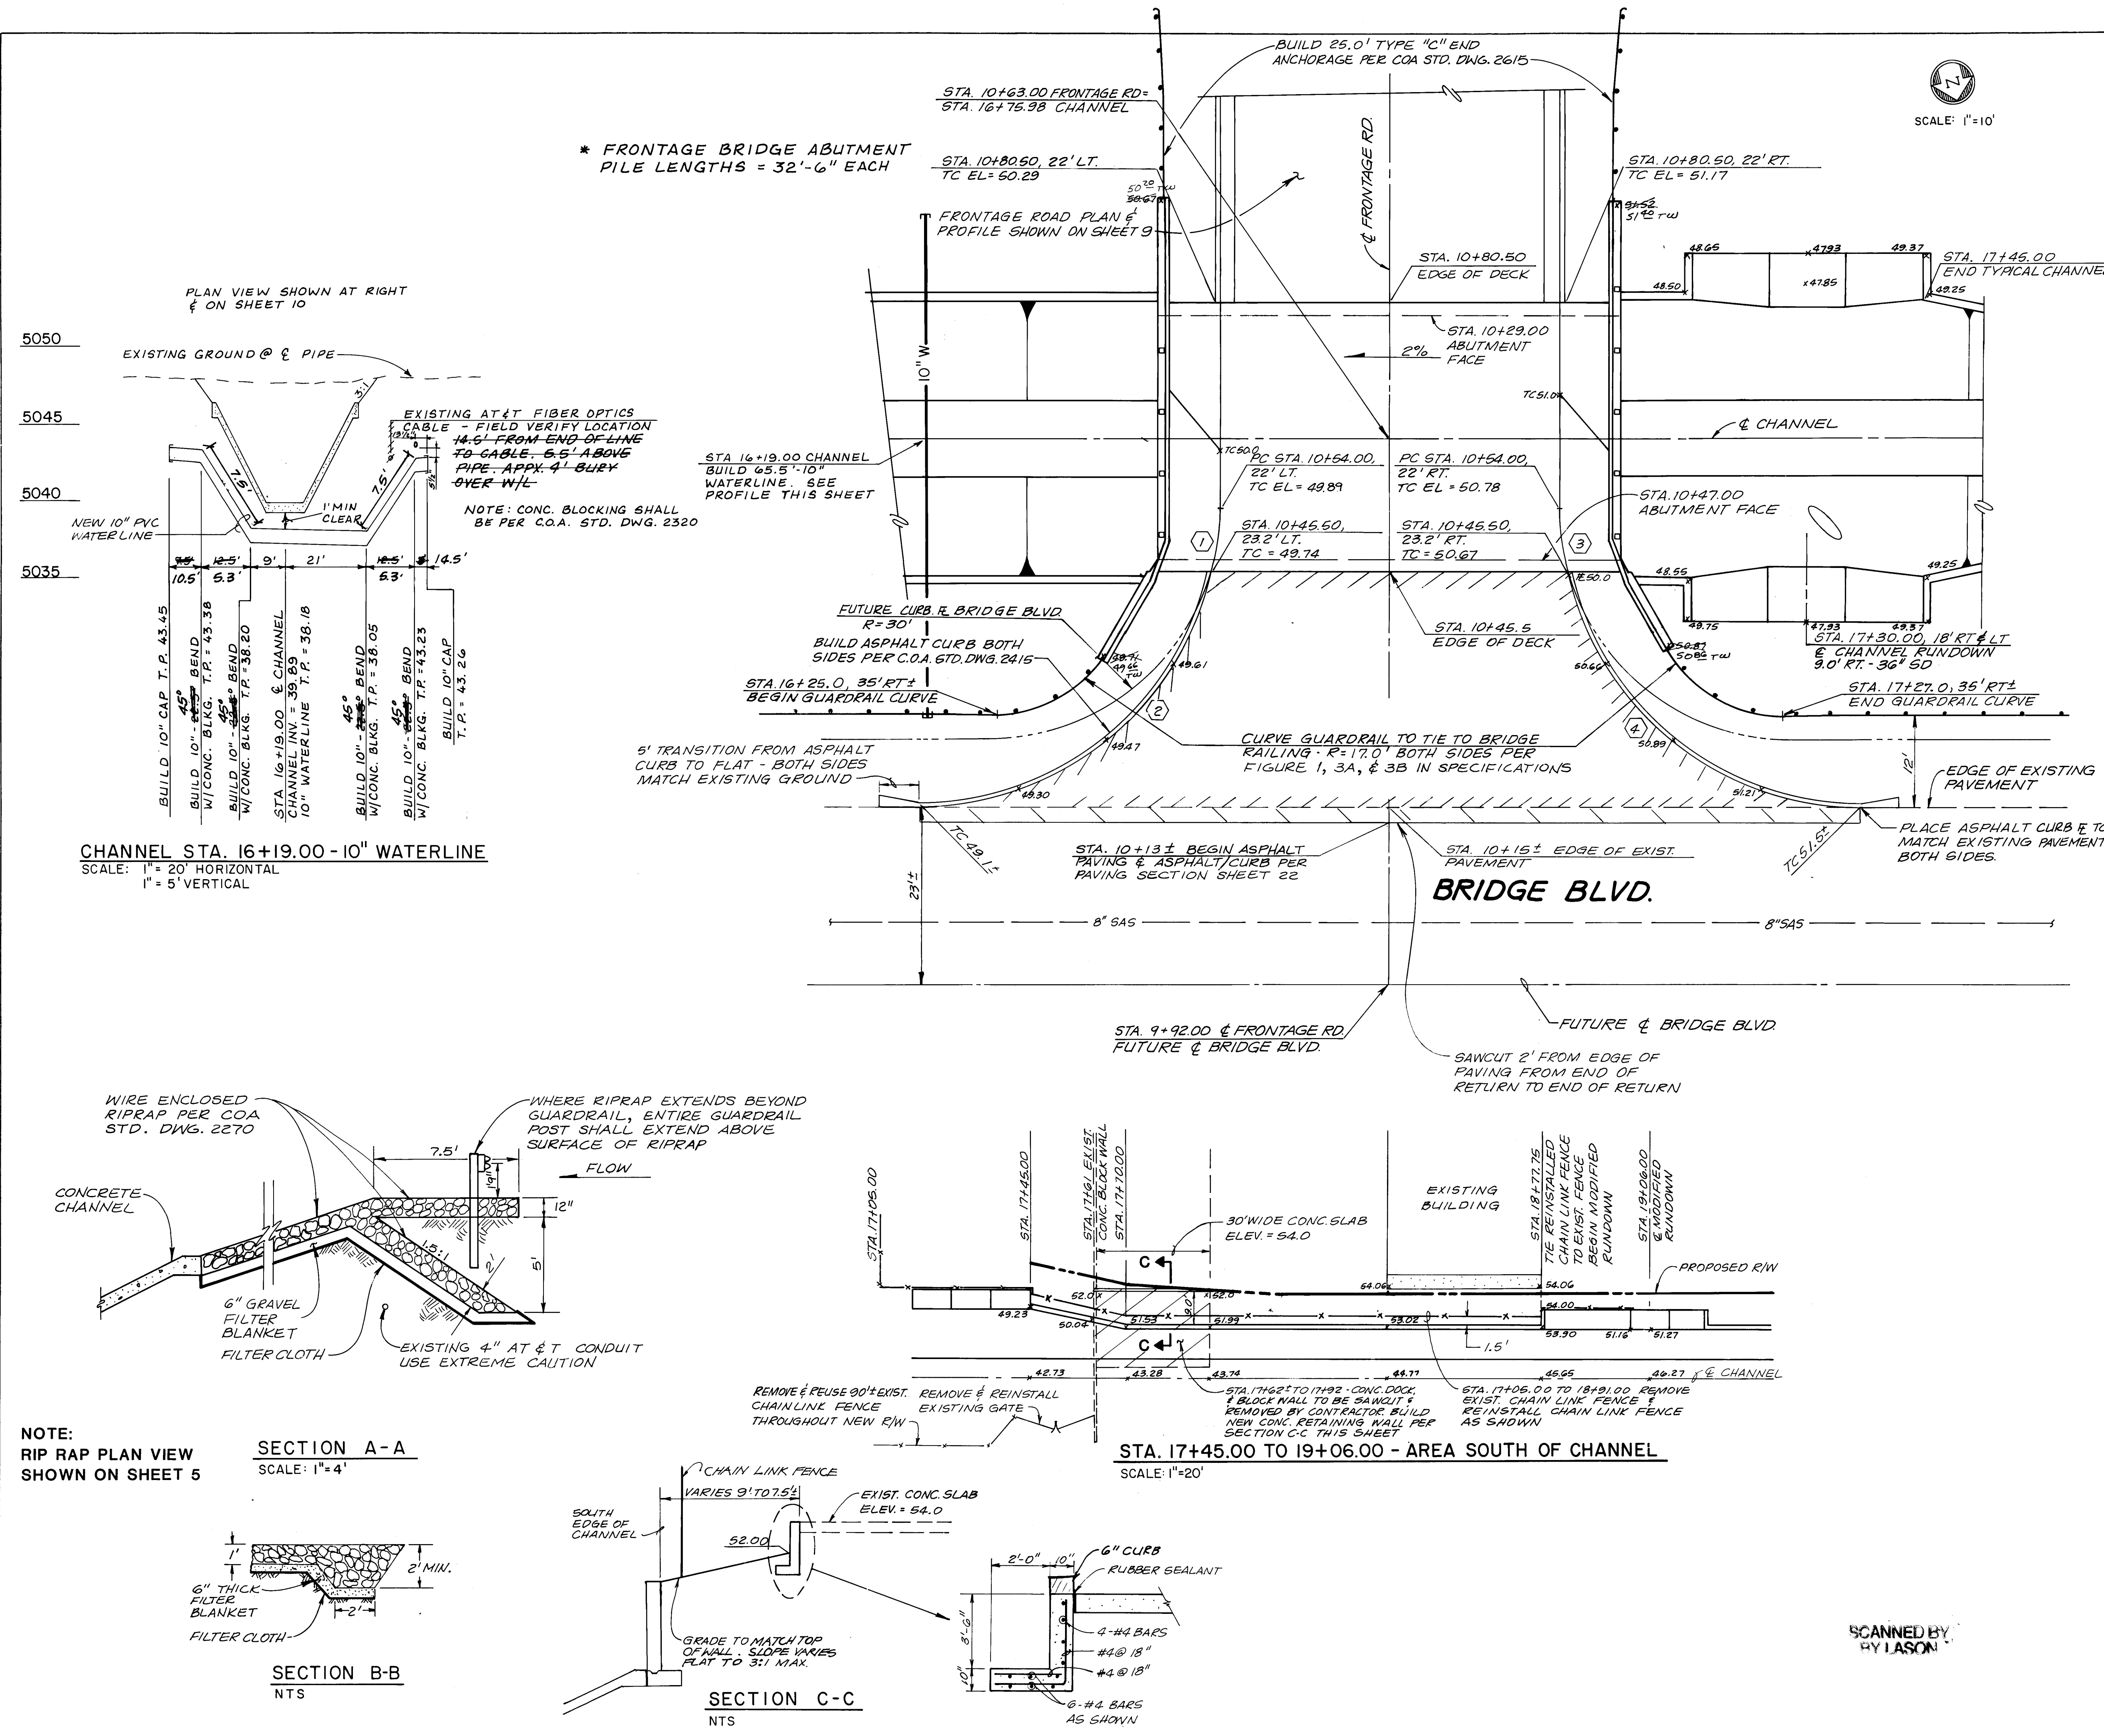

CURVE DATA:
1 Δ = 16°27'33"
R = 30.00'
L = 8.62'
T = 4.34'
2 Δ = 77°24'41"
R = 39.00'
L = 52.69'
T = 31.25'
3 Δ = 16°27'33"
R = 30.00'
L = 8.62'
T = 4.34'
4 Δ = 77°24'41"
R = 39.00'
L = 52.69'
T = 31.25'


"AS BUILT" HORIZONTAL
AND VERTICAL LOCATIONS ONLY

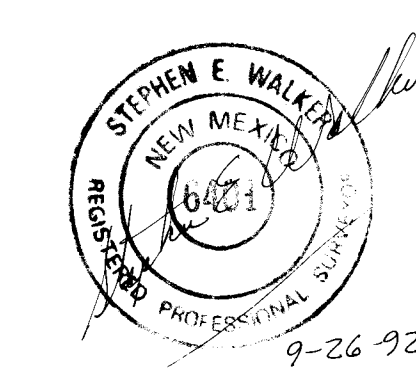


1 2 3 4 5 6 7 8 9 10 11 12 13 14 15
26 4076 91021193

CITY OF ALBUQUERQUE PUBLIC WORKS DEPARTMENT ENGINEERING GROUP									
TITLE: AMOLE DEL NORTE STORM DIVERSION FACILITIES - PHASE III FRONTAGE ROAD CROSSING STRUCTURE 8 MISCELLANEOUS DETAILS									
APPROVALS	ENGINEER	DATE	APPROVALS	ENGINEER	DATE				
D.R.C. Chair	Randy Rios	10-23-91	WATER	Stephen E. Walker	10-1-92				
Trans. Dev	Randy Rios	6-01-91	WASTE WATER	Stephen E. Walker	"				
Utility Dev	Randy Rios	9-24-91							
HYDROLOGY	Randy Rios	9-24-91							
DRAWING NO.	4076.90	MAP NO.	L-10	SHEET	21	OF 35			

RECORD DRAWING

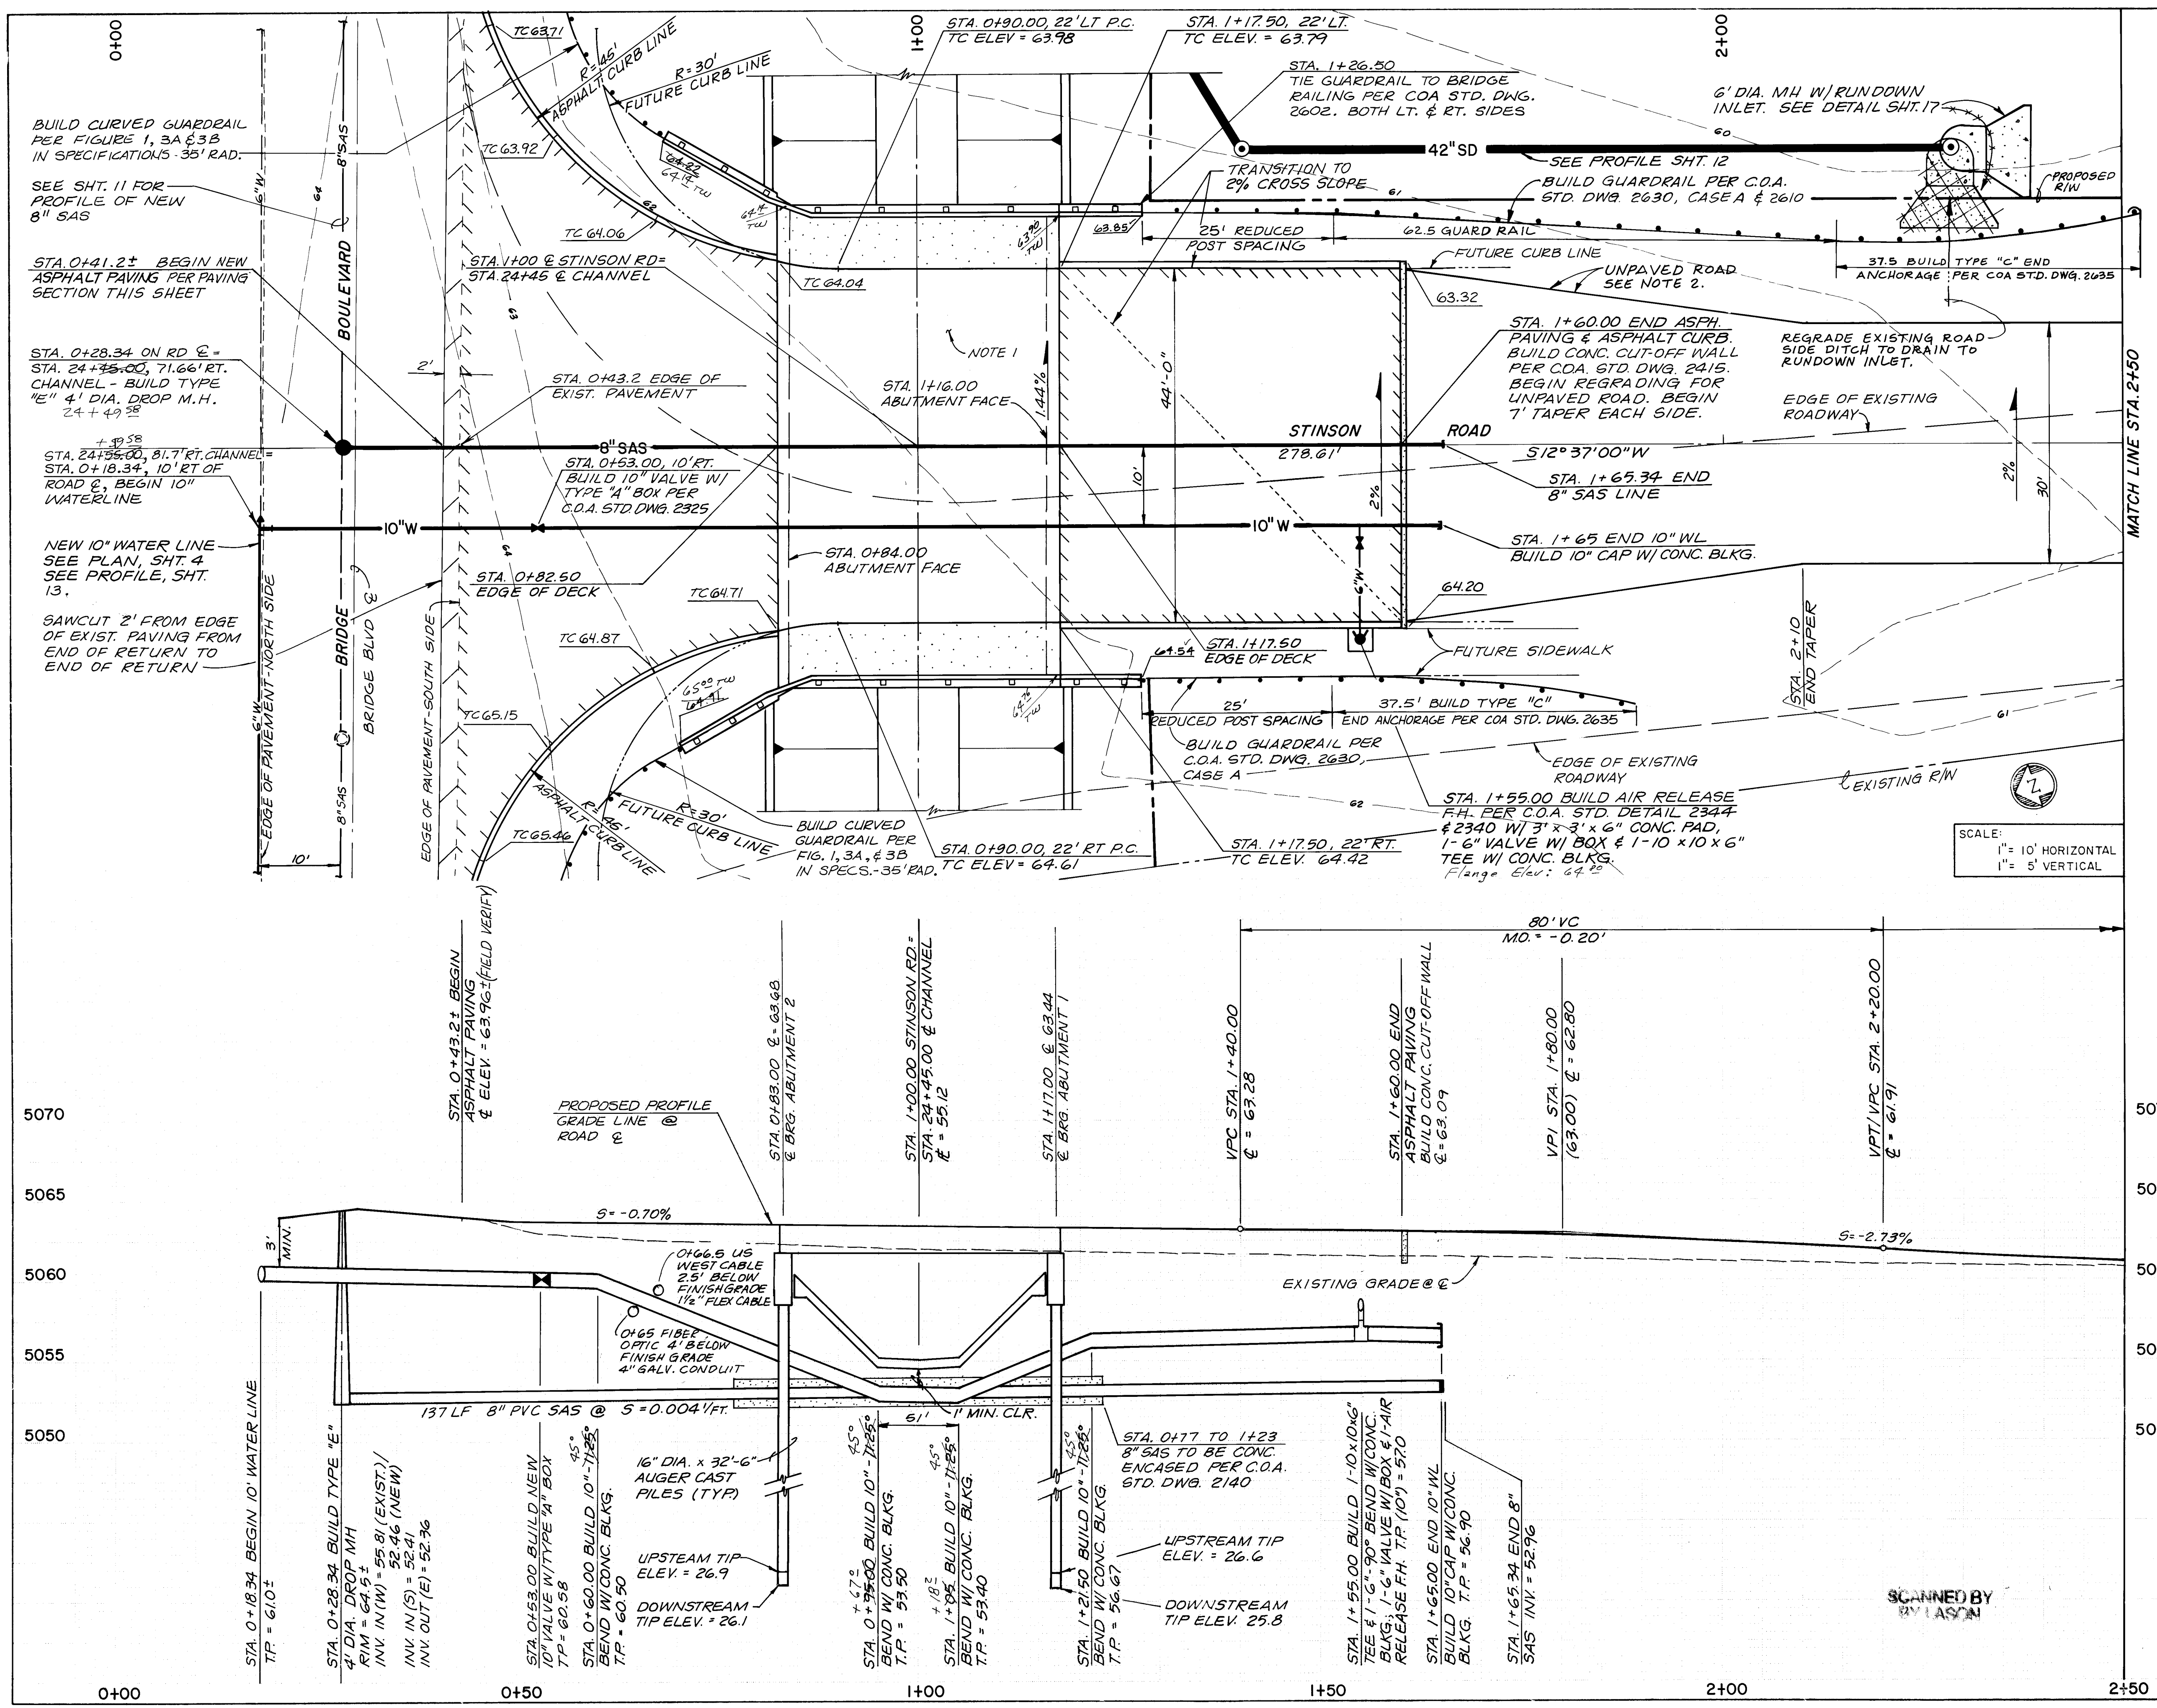

- NOTES:
1. ASPHALT ON BRIDGE SHALL BE 1800# STABILITY.
 2. UNPAVED ROAD SHALL CONSIST OF 12\"/>

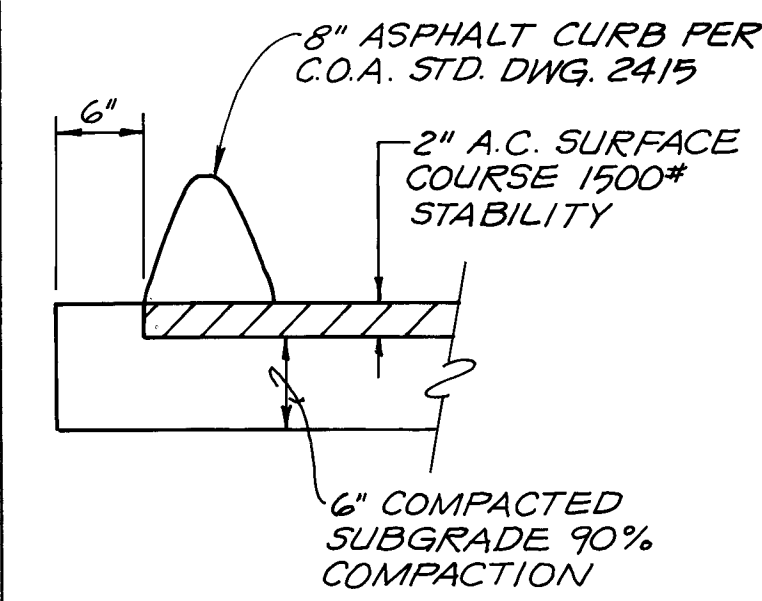


PAVING SECTION
NTS

26 4076 902 2193

SCANNED BY
BY LASAN

CITY OF ALBUQUERQUE PUBLIC WORKS DEPARTMENT ENGINEERING GROUP			
TITLE: AMOLE DEL NORTE STORM DIVERSION FACILITIES - PHASE III TIERRA BATITA DRAINAGE FACILITIES STINSON ROAD PLAN & PROFILE STA. 0+00 TO STA. 2+50			
APPROVALS	ENGINEER	DATE	APPROVALS
D.R.C. Chair	10-23-91	Water	10-23-91
Trans. Dev.	10-23-91	Wastewater	10-23-91
Hydrology	10-23-91		
DRAWING NO.	4076.90	MAP NO.	L-10
SHEET	22	OF	35

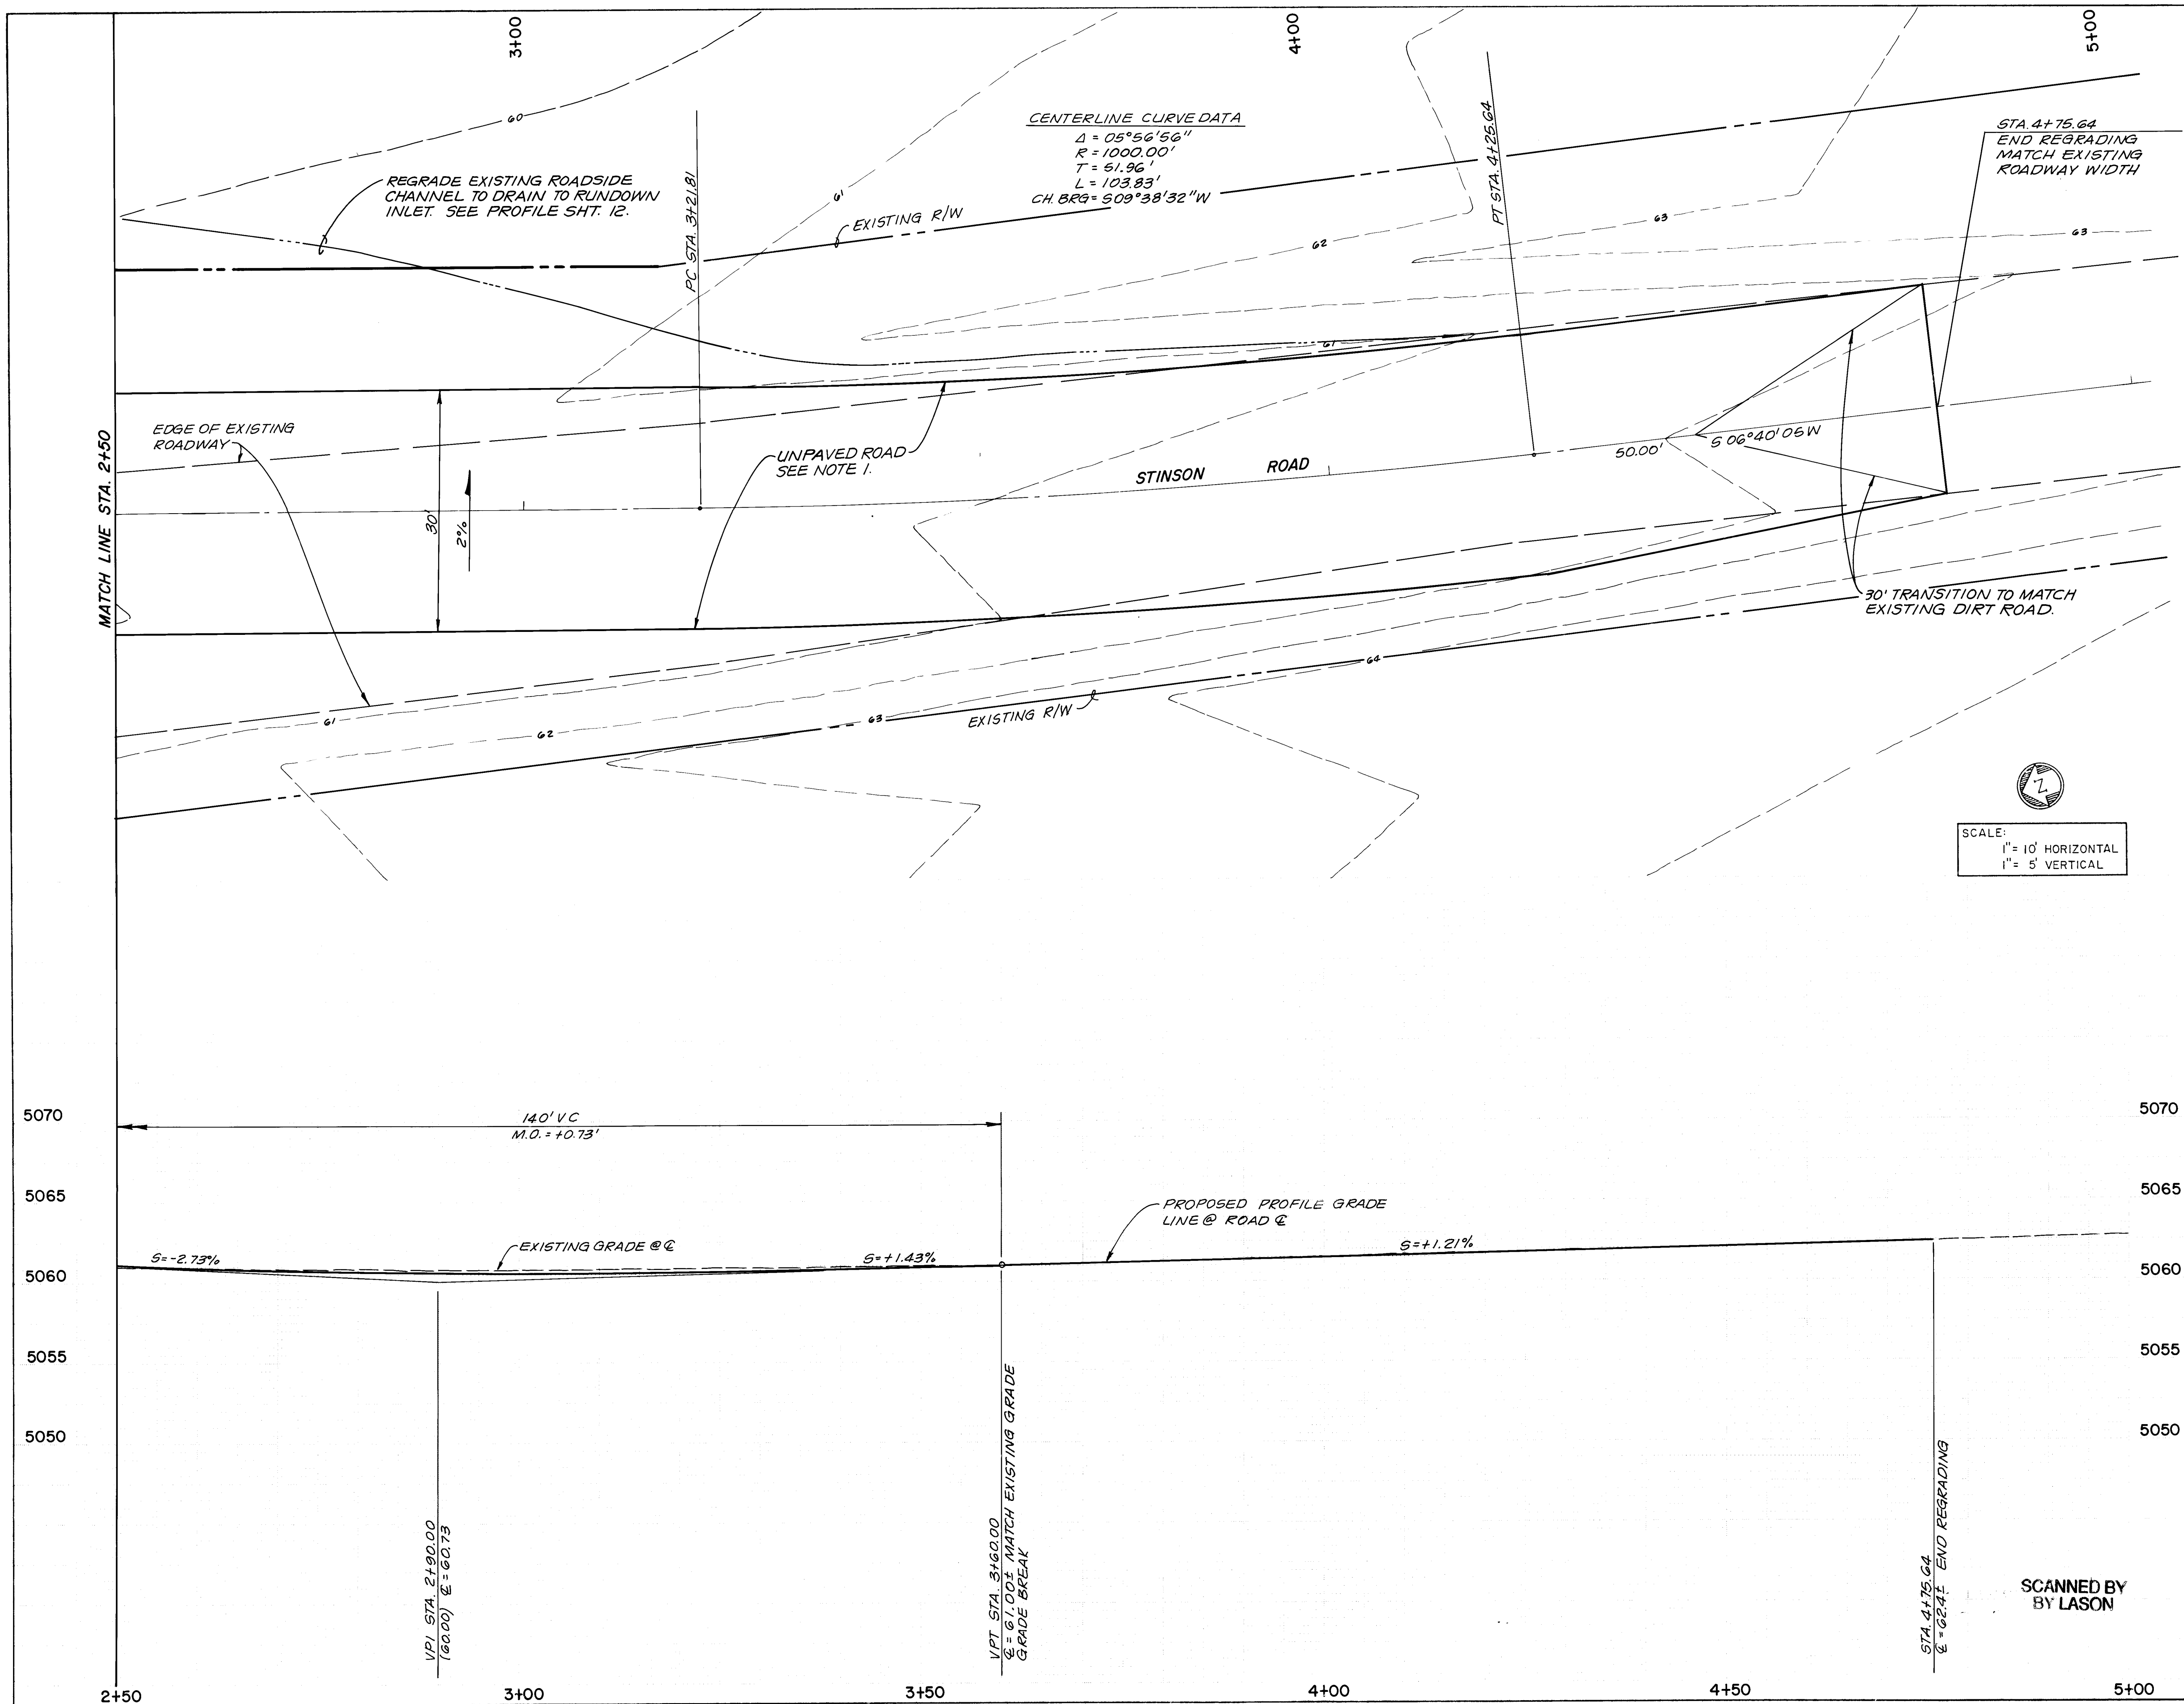


NOTES:

1. UNPAVED ROAD SHALL CONSIST OF 12" OF SUBGRADE PREP, COMPACTED TO 95% DENSITY

[illegible]

CITY OF ALBUQUERQUE PUBLIC WORKS DEPARTMENT ENGINEERING GROUP					
TITLE AMOLE DEL NORTE STORM DIVERSION FACILITIES - PHASE III TIERRA BATITA DRAINAGE FACILITIES STINSON ROAD PLAN & PROFILE STA. 2+50 TO STA. 4+75.64					
APPROVALS	ENGINEER	DATE	APPROVAL	ENGINEER	DATE
D.R.C. Chair	<i>Raymond</i>	10-25-91	Water	<i>Heller</i>	10-1-91
Trans. Dev.	<i>R. L. Smith</i>	10-25-91	Wastewater	<i>WLD</i>	"
Hydrology	<i>Calvin</i>	8/28/91			
DRAWING NO.	4076.90		MAP NO.	L-10	
			SHEET	23	OF 35

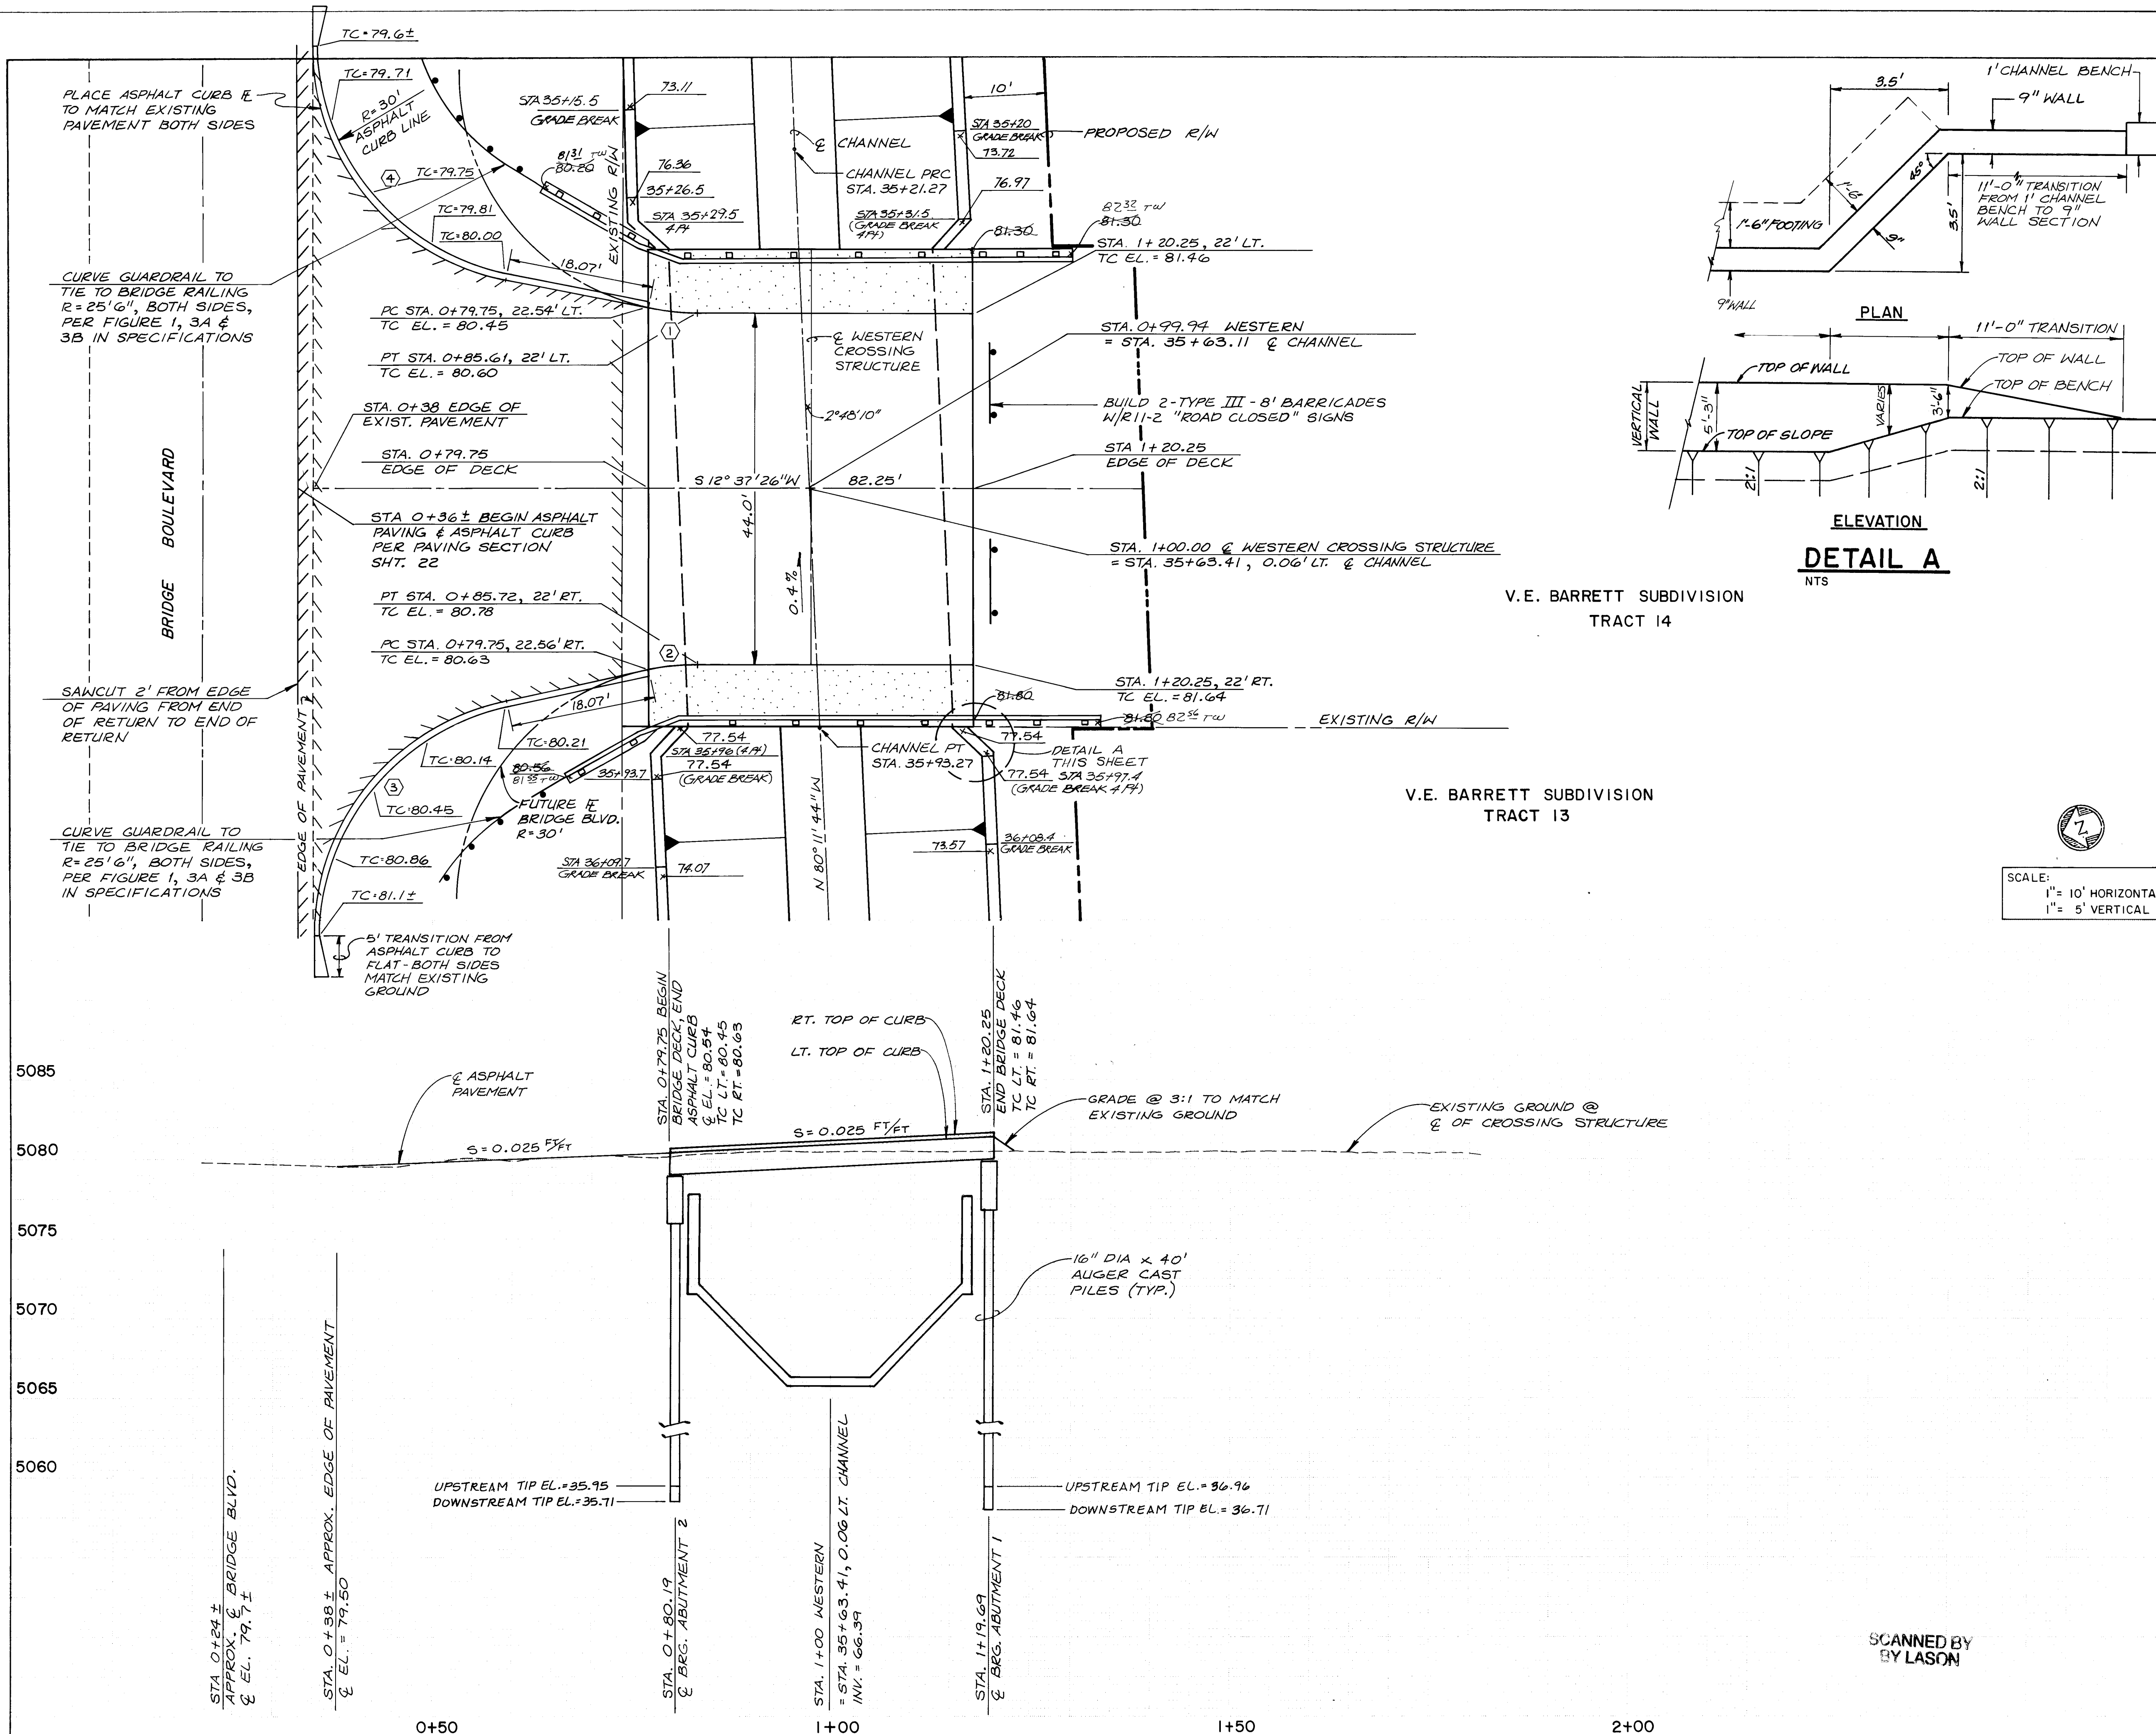


CURVE DATA

A	=	11°16'58"
R	=	30.00'
L	=	5.91'
T	=	2.96'

A	=	11°27'49"
R	=	30.00'
L	=	6.00'
T	=	3.01'

A	=	78°35'16"
R	=	30.00'
L	=	41.15'
T	=	24.55'

A	=	78°39'58"
R	=	30.00'
L	=	41.19'
T	=	24.58'

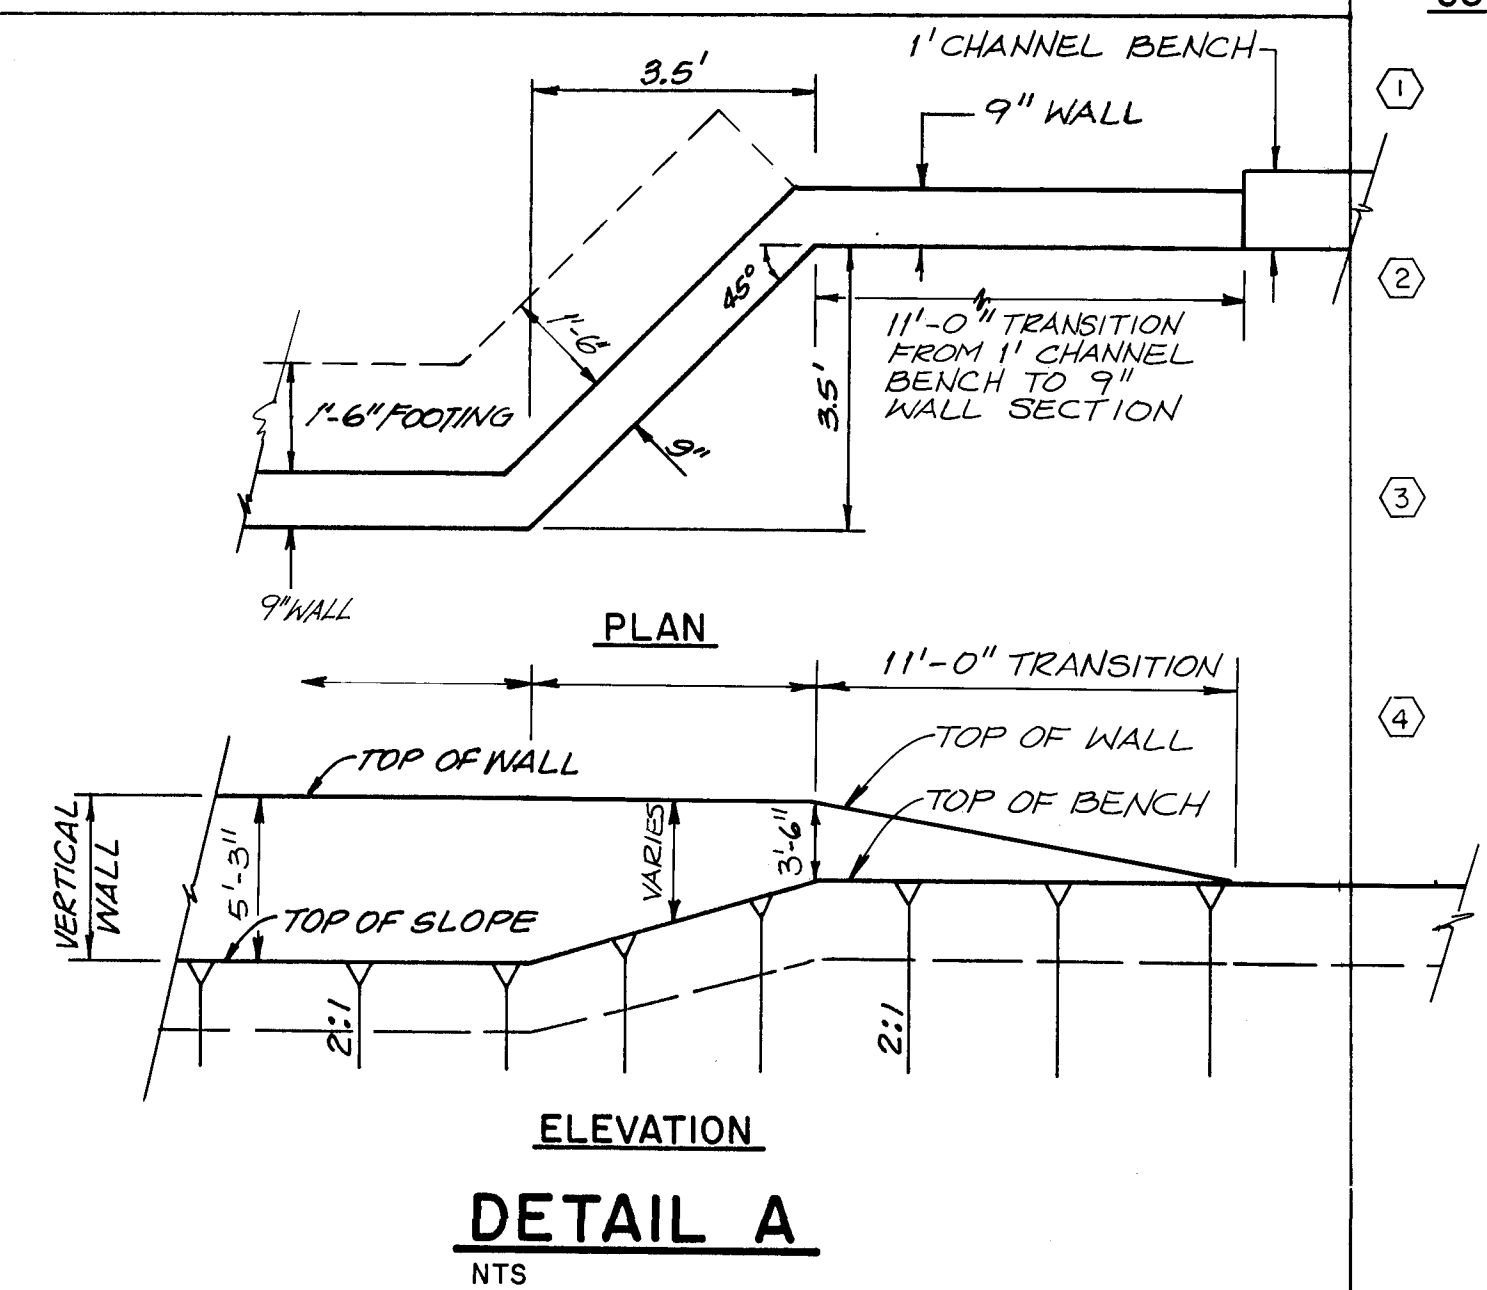

SCALE:
1" = 10' HORIZONTAL
1" = 5' VERTICAL

1' CHANNEL BENCH
9' WALL
1' TRANSITION FROM 1' CHANNEL BENCH TO 9' WALL SECTION

ELEVATION


DETAIL A

NTS

V.E. BARRETT SUBDIVISION
TRACT 14

V.E. BARRETT SUBDIVISION
TRACT 13

AND V. SECTION 100' (N. 1/4 S. 1/4)

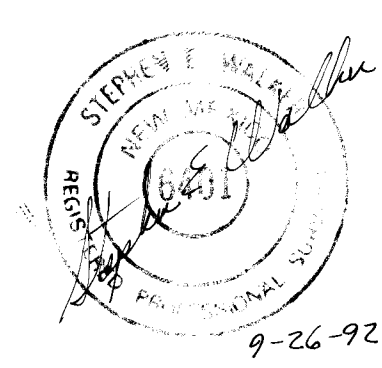

26 4076.9024.93

CITY OF ALBUQUERQUE PUBLIC WORKS DEPARTMENT ENGINEERING GROUP			
TITLE AMOLE DEL NORTE STORM DIVERSION FACILITIES - PHASE III TIERRA BATTA DRAINAGE FACILITIES WESTERN CROSSING STRUCTURE PLAN & PROFILE			
APPROVALS	ENGINEER	DATE	APPROVALS
D.R.C. Check	10-23-91	Water	10-23-91
Trans. Dev.	10-23-91	Wastewater	10-23-91
Hydrology	10-23-91		
DRAWING NO.	4076.90	MAP NO.	L-10
SHEET	24	OF	35

RECORD DRAWING

SCANNED BY
BY LASON

GENERAL NOTES

1. Workmanship and materials shall conform to New Mexico State Highway Department specification for Road and Bridge Construction, 1984 Edition.
2. Concrete for cast-in-place concrete shall conform to Albuquerque Standard Specifications Section 101, Portland Cement Concrete. Chamfer all exposed edges of concrete structures 3/4 inch unless otherwise noted.
3. Reinforcing bars shall conform to AASHTO M-31, Grade 60, unless otherwise noted. Dimensions are to centerline of bar unless otherwise noted.
4. Foundation data shown on plans are for designers only. The engineer is not responsible for any interpretation or assumptions made by the Contractor based on this information.
5. Structural steel shall be carbon steel conforming to AASHTO M270 unless otherwise noted.
6. Preformed bituminous joint filler shall conform to AASHTO M-213.
7. Waterproofing membrane shall consist of paving fabric ("Petro Mat", "AMOPAVE", or Approved equal) with approximately 0.25 gal/sq.yd. of hot applied asphalt cement (AC-10), and shall be installed in accordance with manufacturer's recommendations.
- * application is for Petro Mat, if alternate material is used fabric test section will be required.

SUPPLEMENTAL SPECIFICATION

Specification for Augered-Pressure Grouted Piling Installation.

DESIGN DATA

Design is in accordance with AASHTO Standard Specifications for Highway Bridges, 1989 Edition and 1990 interim.

Design Loading: Live Load = HS 20-44
Dead Load = 50 psf for future bituminous pavement
Horizontal Earth Pressure = 32 pcf equivalent fluid pressure and 2 feet surcharge

Design Stresses
Structural Steel = AASHTO M270
fs = 20,000 psi
Reinforced Concrete:
Superstructure: f'c = 4,000 psi @ 28 days, n=8
fc = 1,600 psi
fs = 24,000 psi, Grade 60
Substructure: f'c = 4,000 psi @ 28 days, n=8
fc = 1,600 psi
fs = 20,000 psi, Grade 40
fs = 24,000 psi, Grade 60

Prestressed
f'c = 5,000 psi @ 28 days, n=7
Minimum compressive strength of concrete at time of initial prestress f'ci = 4,000 psi
Fly Ash per Section 101
1/2" Dia High Strength seven wire steel strands
fs = 41,300 lbs/strand, fy = 35,100 lbs/strand

Precast Prestressed Beams: fse = 23100 lb/strand Prestress Loss = 5800 lb/strand

Conventional Reinforcing Steel: fs = 20,000 psi, Grade 40

Maximum Computed Pile Load = 80 kips per pile (all 16" Diameter Abutment piles only)

CROSSING STRUCTURE LOCATION TABLE

Bridge Blvd. Location (Station to Station)	Access to	Bridge Name	Span Center of Bearing
16+45.98 to 17+05.98	Frontage Road	Frontage	34'
24+15.00 to 24+75.00	Stinson Road	Stinson	34'
35+33.41 to 35+93.41	Tracts 13 & 14	Western	39'-6"

Note: Frontage and Stinson Bridges are identical in span length and dimensions. Western Bridge is longer in span. All three bridges are 60 ft. wide, from end to end of panels. All three bridges are incorporated in the details to follow.

INCIDENTAL ITEMS

1. Elastomeric Bearing Pad
2. Waterproofing Membrane
3. Preformed Bituminous Joint Filler
4. Urethane and Polyethylene Joint Filler.
5. Temporary Field Tensioning of Beams.

NOTE: Items listed above shall be incidental to the cost of other items for the completion of the work and no direct payment will be made therefore. This list does not include any incidental work or material required by Standard Drawings, Supplemental specifications, or the Standard Specifications.

MINIMUM SPLICE LENGTHS FOR REINFORCING

BAR SIZE:	#3	#4	#5	#6	#7	#8
SPLICE LENGTH:	1'-0"	1'-3"	1'-7"	1'-11"	2'-3"	2'-6"

SCANNED BY
BY LASON






26 4076.902593

Greiner, Inc.

CITY OF ALBUQUERQUE PUBLIC WORKS DEPARTMENT ENGINEERING DIVISION					
TITLE: AMOLE DEL NORTE STORM DIVERSION FACILITIES - PHASE III TIERRA BAYITA DRAINAGE FACILITIES					
STRUCTURAL NOTES					
APPROVALS	ENGINEER	DATE	APPROVALS	ENGINEER	DATE
DRC Chairman	<i>[Signature]</i>	10-23-91	Water	<i>[Signature]</i>	10-1-91
Transportation	<i>[Signature]</i>	10-01-91	Waste Water	<i>[Signature]</i>	"
Hydrology	<i>[Signature]</i>	9/24/91			
DRAWING NO. 4076.90		MAP NO. L-10		SHEET 25 OF 35	

RECORD DRAWING

SURVEY INFORMATION			ENGINEER'S SEAL			AS BUILT INFORMATION		
NO.	BY	DATE				CONTRACTOR	MOORE & COWART	DATE
						WORK STAKED BY	WALKER	1992
						ACCEPTANCE BY	G. REYNOLDS	1992
						FIELD ACCEPTANCE BY	WALKER	9-92
						FIELD ACCEPTANCE BY	WALKER	9-92
						DRAWINGS CORRECTED BY	GREINER & WALKER	9-92
						MICRO-FILM INFORMATION		
						RECORDED BY		
						DATE		
						PROJECT NO. G000101		
						DESIGNED BY: M.J.B.		
						DRAWN BY: P.J.R.		
						CHECKED BY: J.C./B.M.O.		

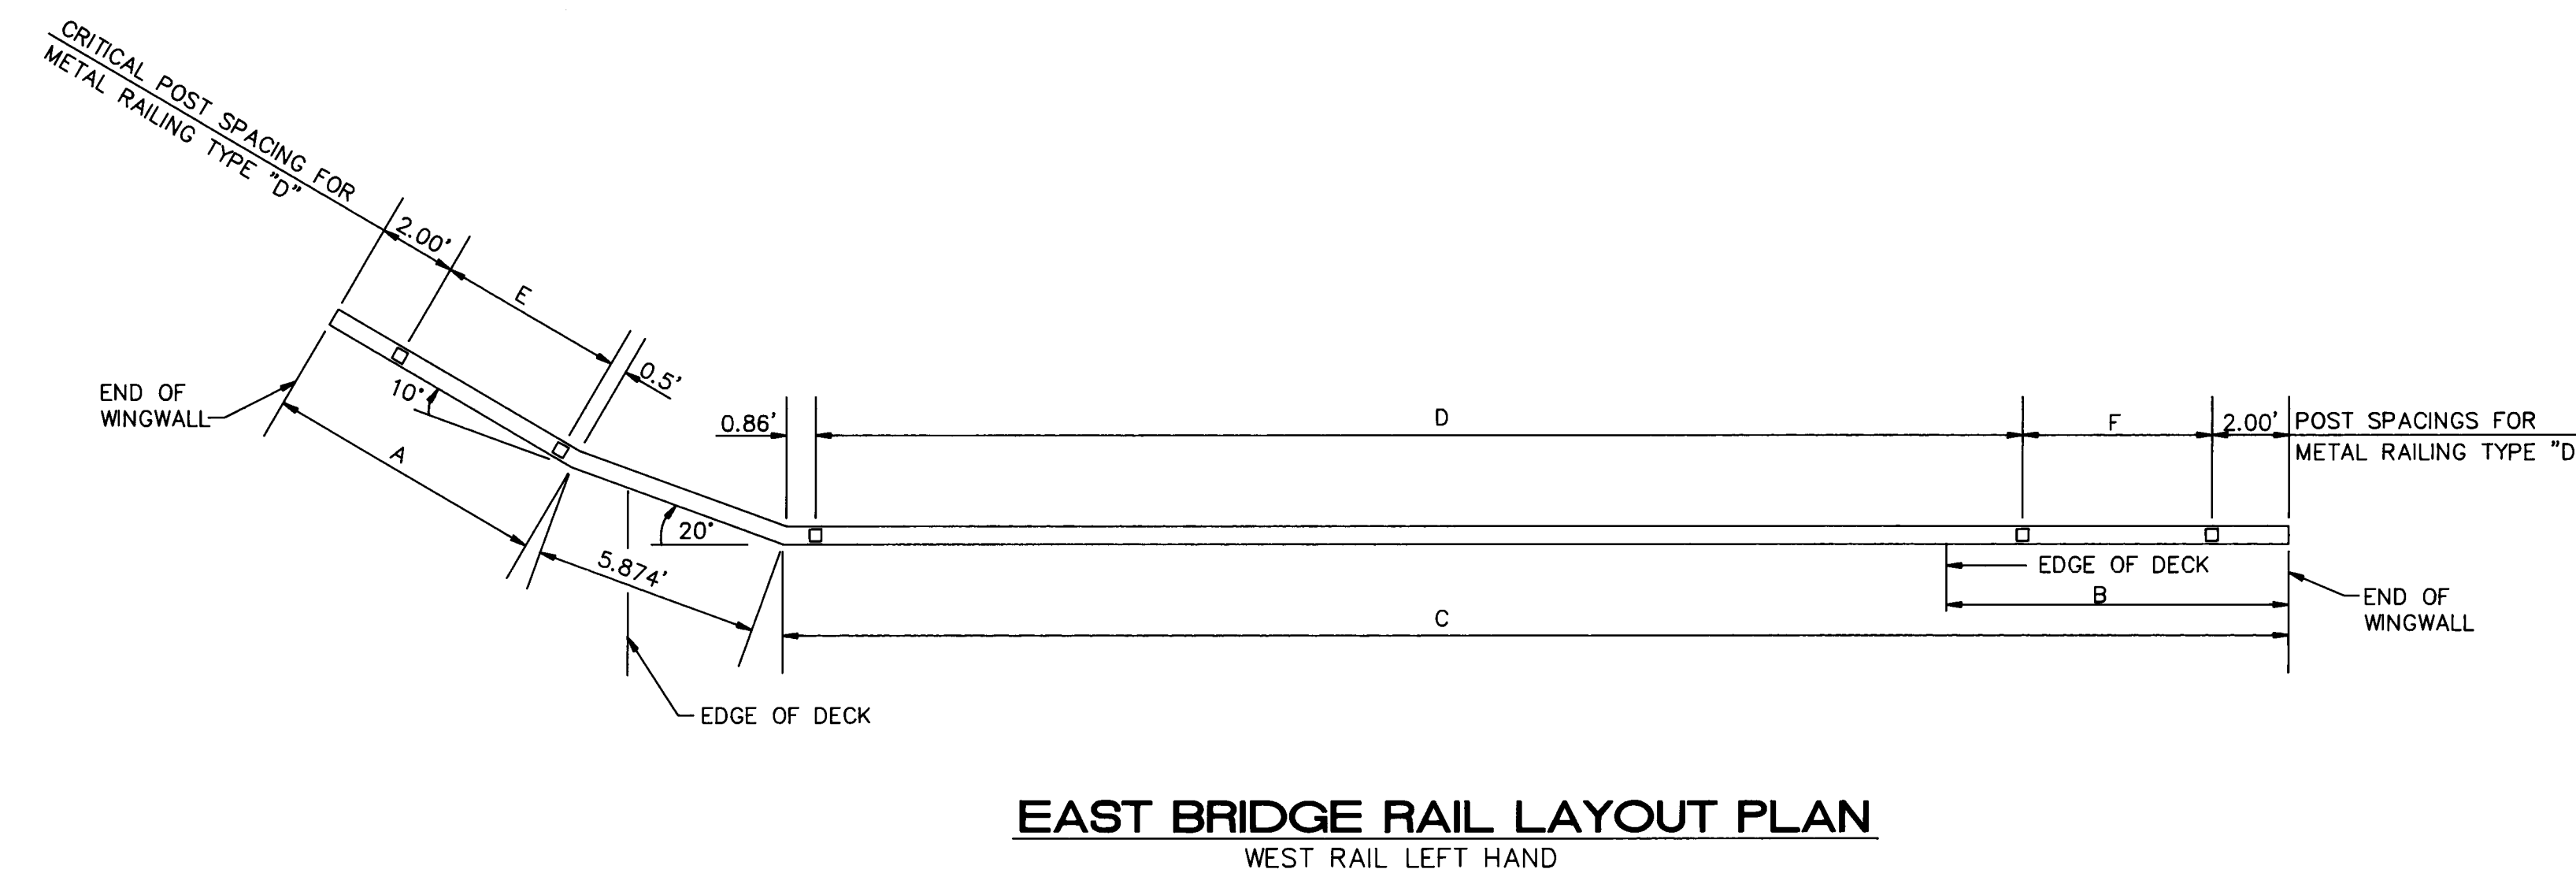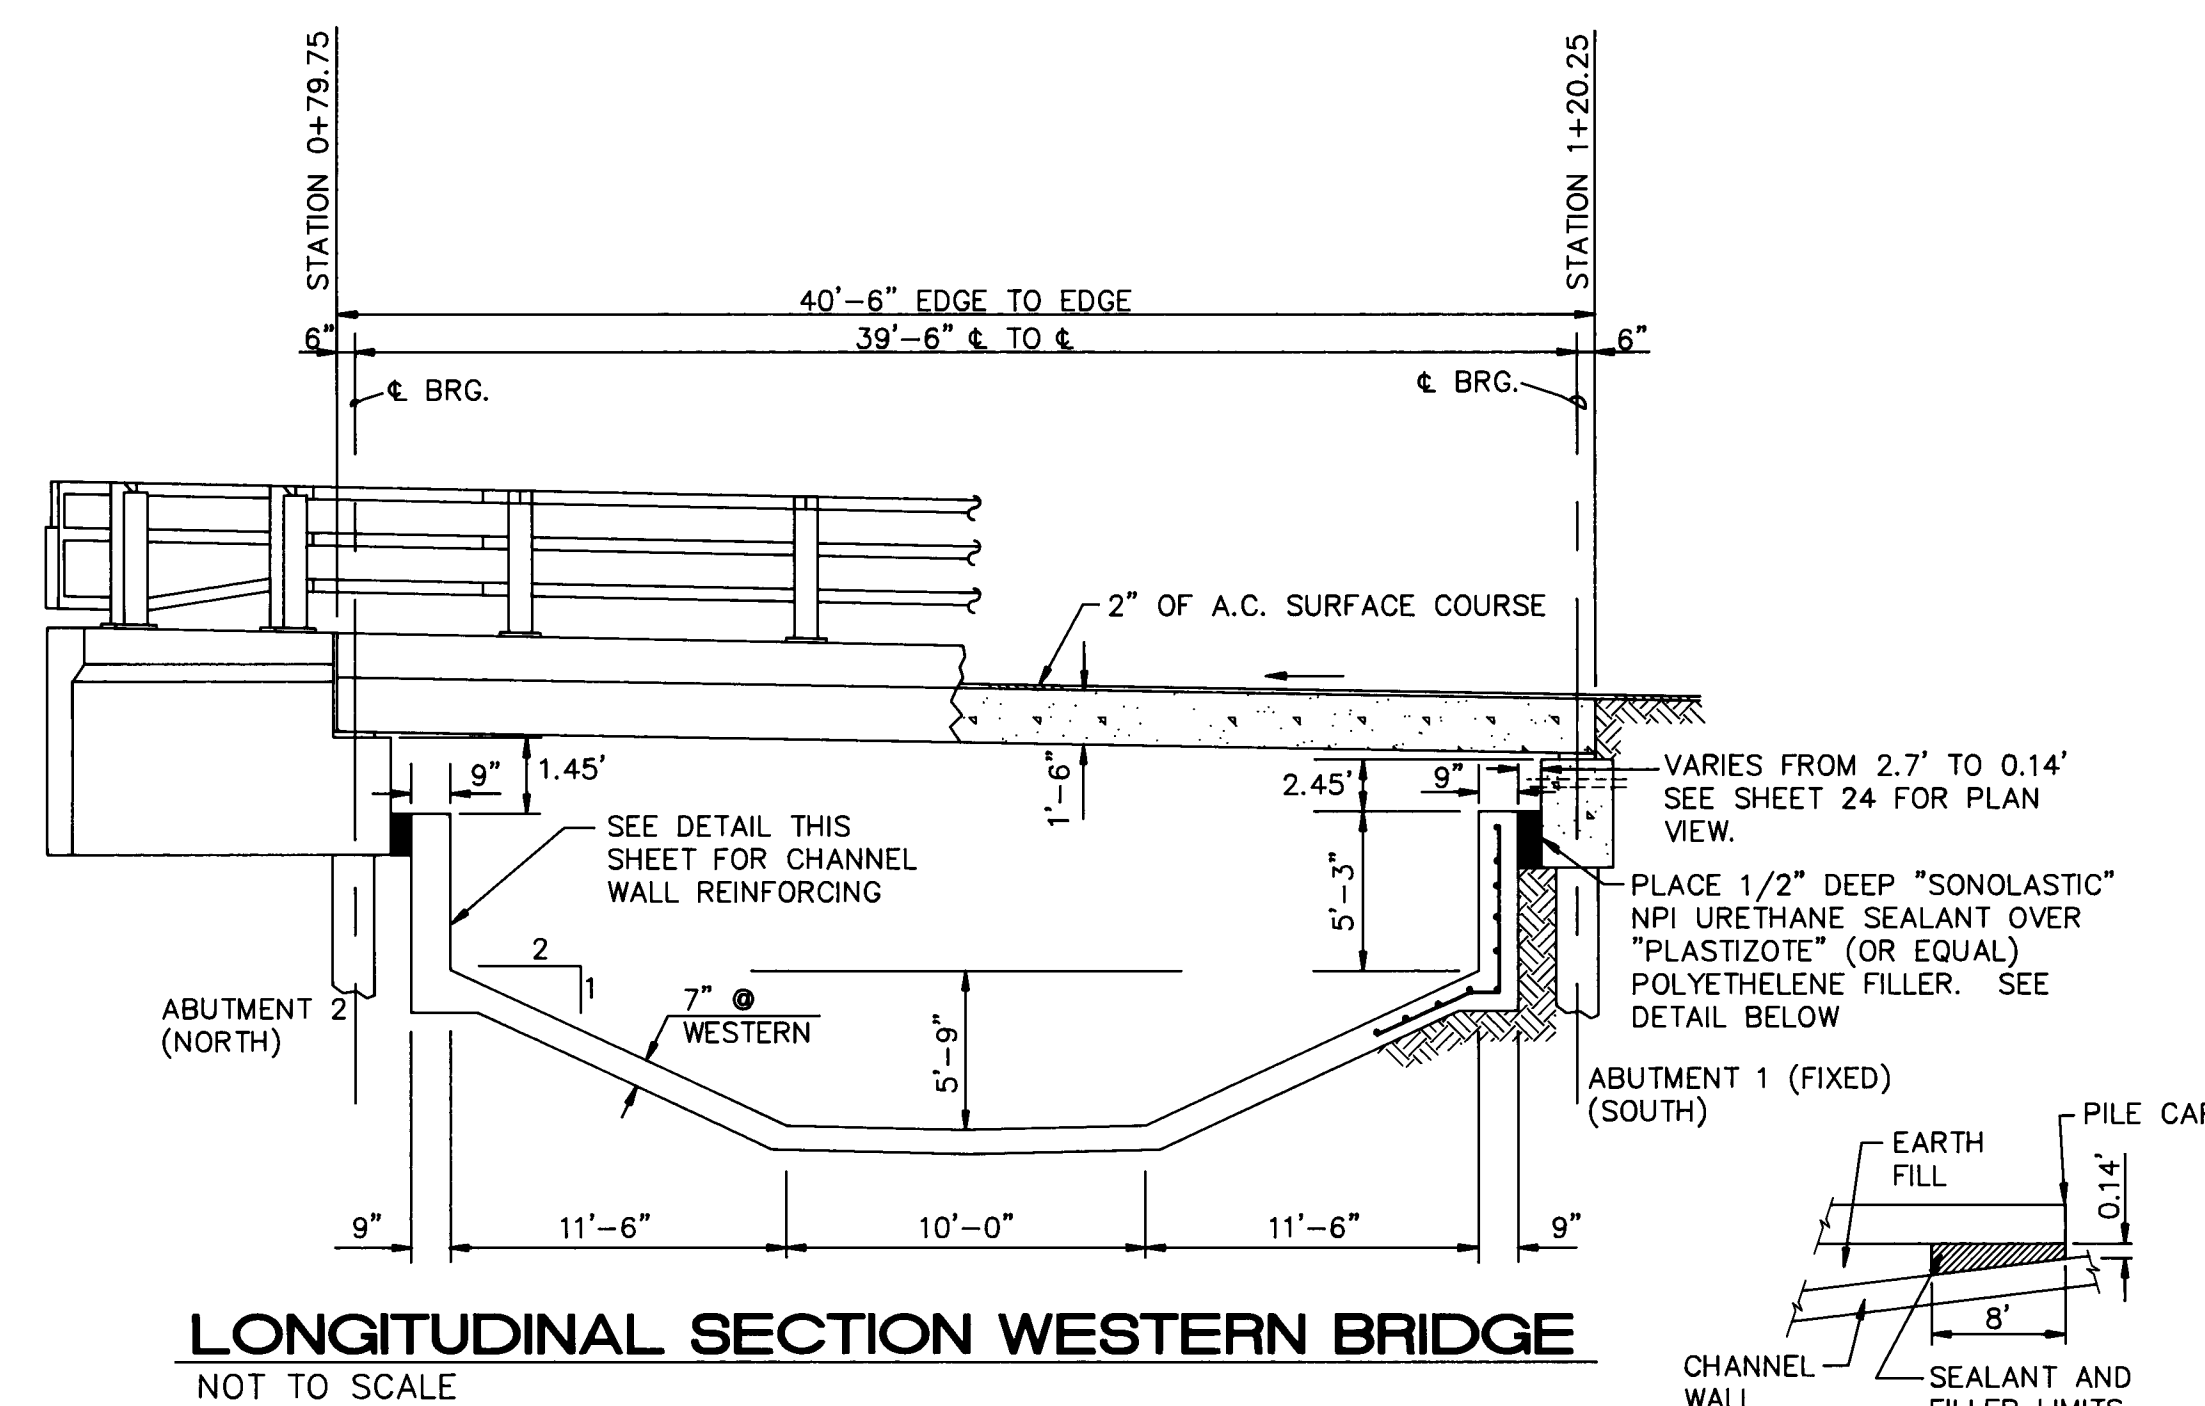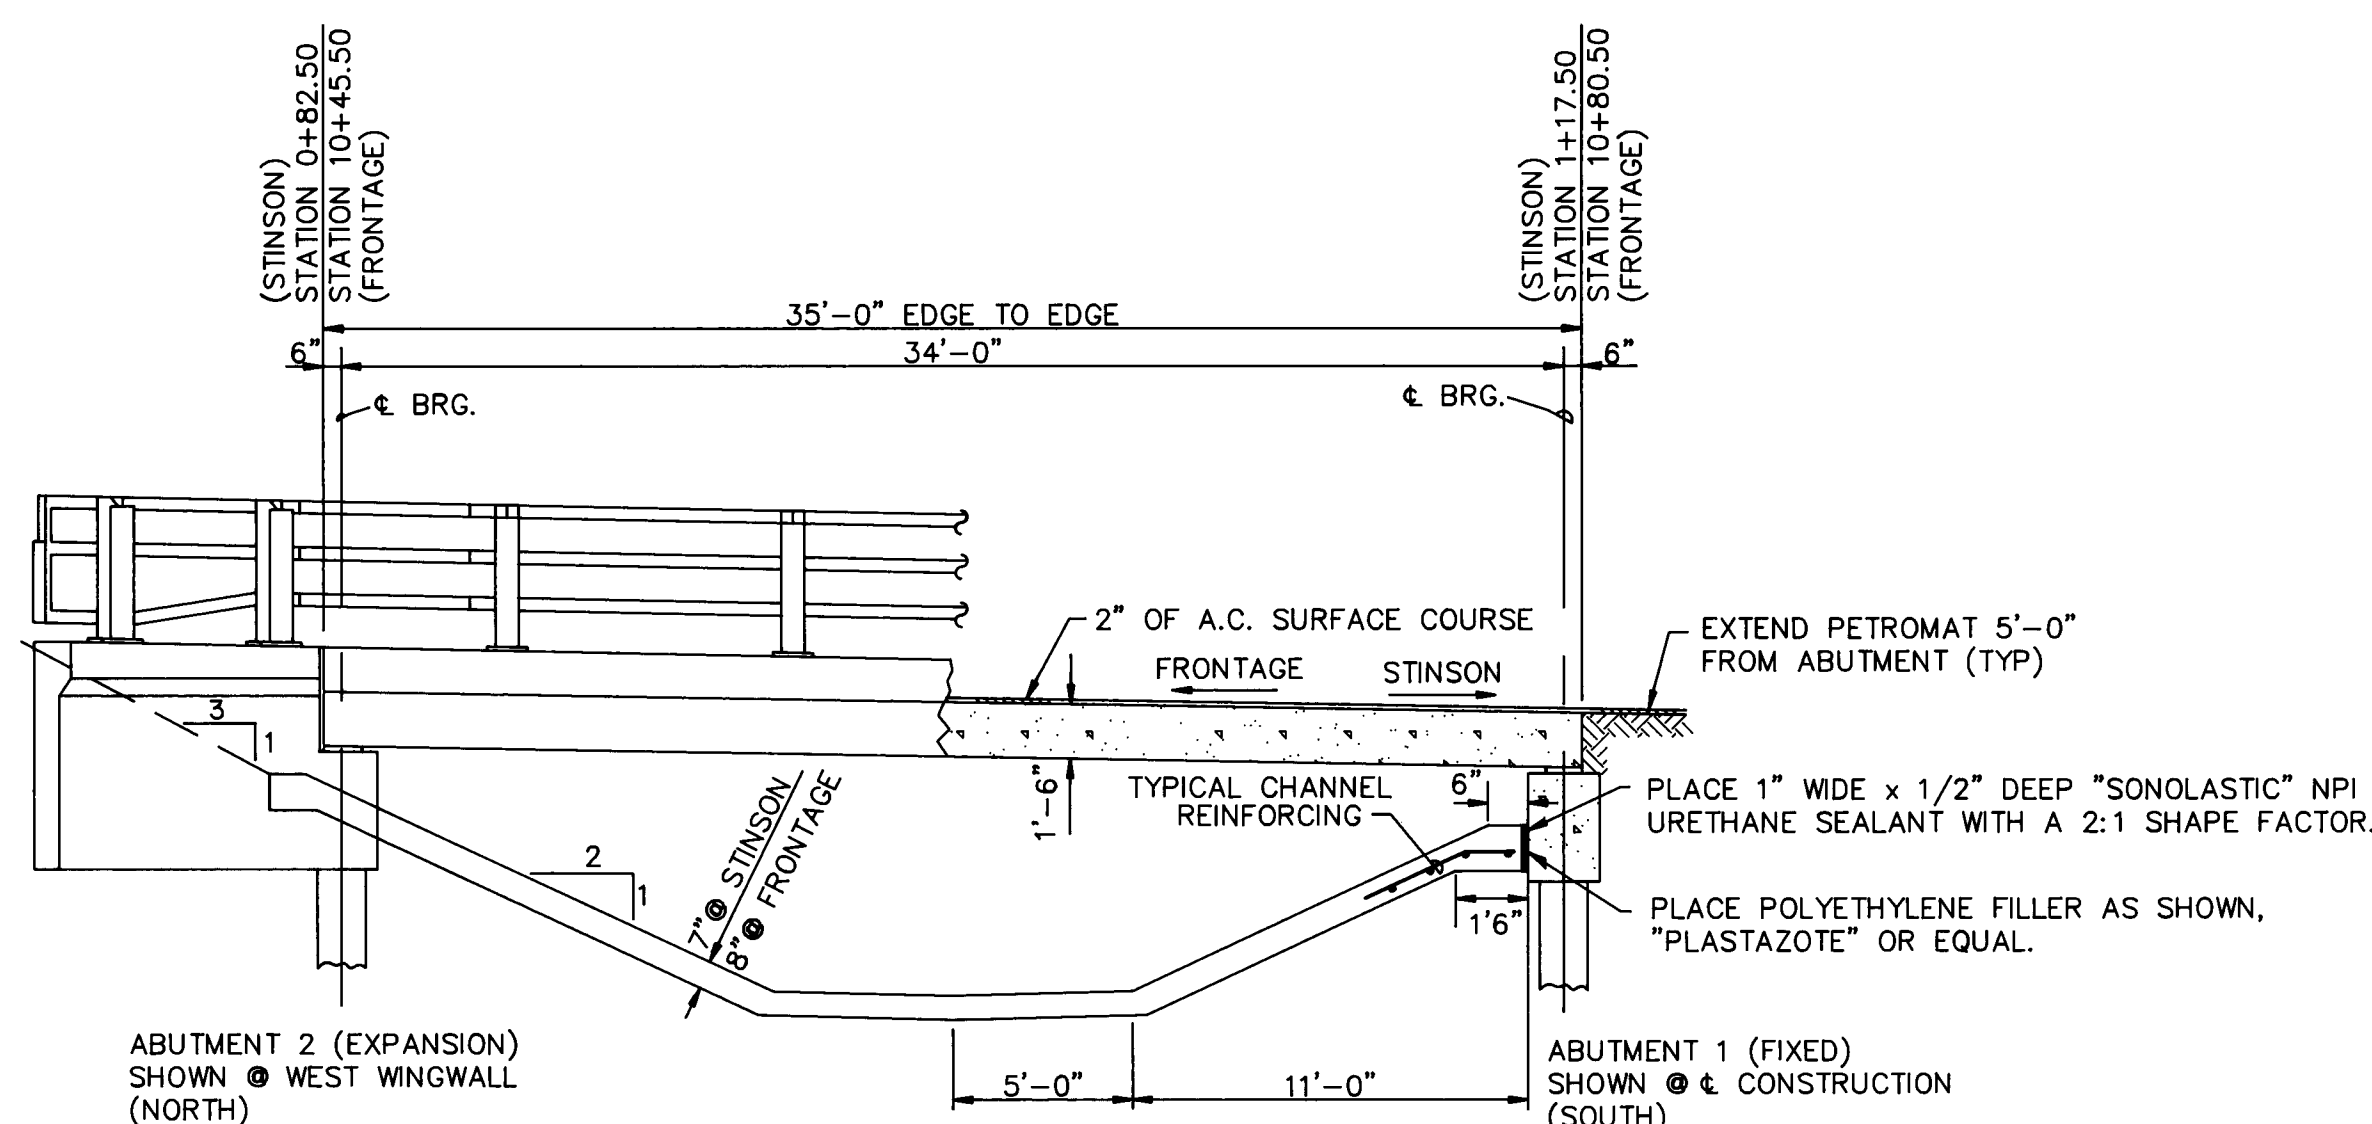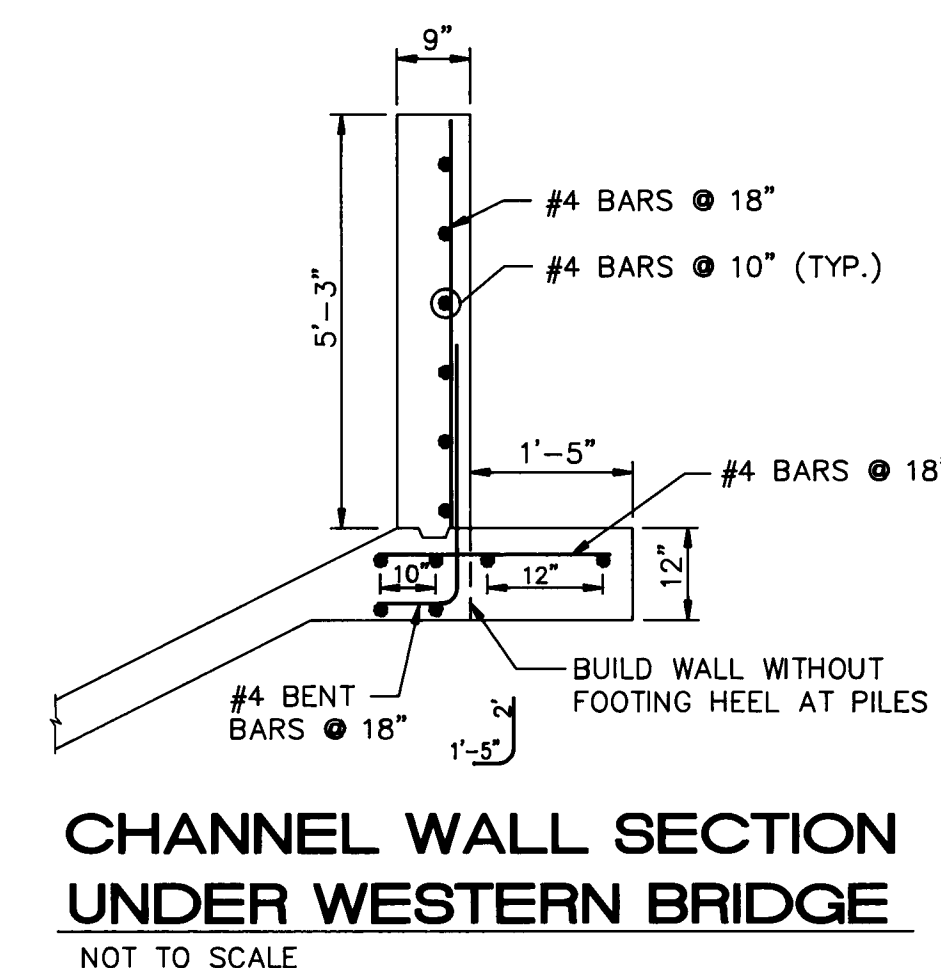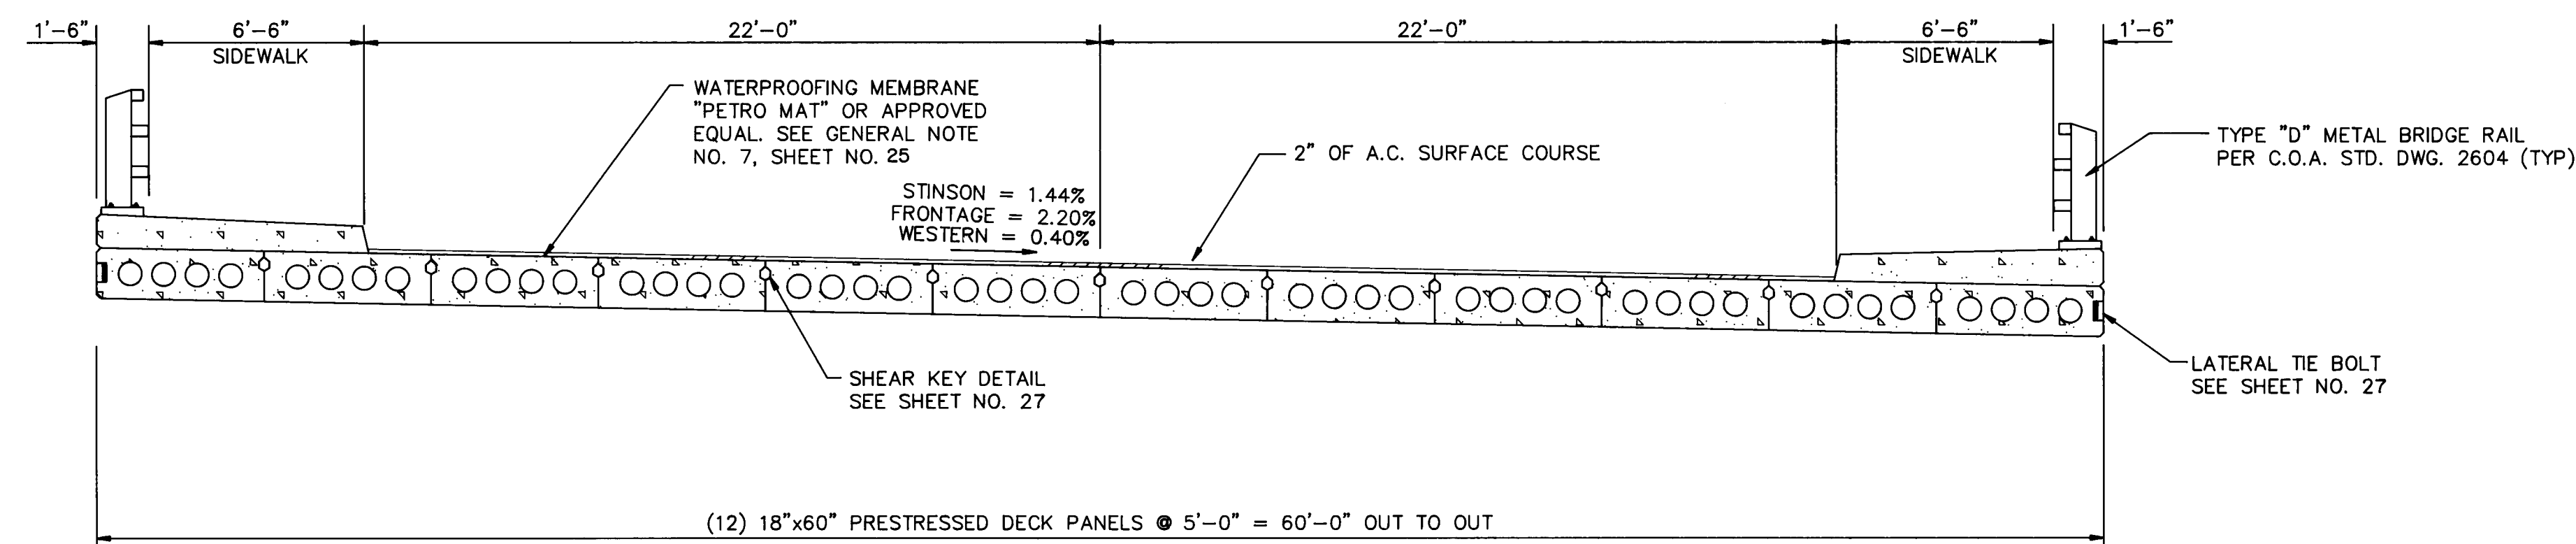

DIMENSION	STINSON		FRONTAGE		WESTERN	
	EAST	WEST	EAST	WEST	EAST	WEST
A	15.00'	12.50'	11.00'	11.00'	14.00'	11.00'
B	10.00'	10.00'	13.00'	13.00'	13.00'	16.00'
C	40.862'	40.862'	43.862'	43.862'	49.362'	52.362'
D	32.00'	32.00'	32.00'	32.00'	37.50'	37.50'
	4 SP 8.00' ⓐ	4 SP 8.00' ⓐ	4 SP 8.00' ⓐ	4 SP 8.00' ⓐ	5 SP 7.50' ⓐ	5 SP 7.50' ⓐ
E	11.75'	9.25'	7.75'	7.75'	10.75'	7.75'
	2 SP 5.875' ⓐ	2 SP 4.63' ⓐ			2 SP 4.5375' ⓐ	
F	6.00'	6.00'	9.00'	9.00'	9.00'	12.00'
			2 SP 4.50' ⓐ	2 SP 4.50' ⓐ	2 SP 4.50' ⓐ	2 SP 6.00' ⓐ

ABUTMENT PILE LENGTHS ARE AS FOLLOWS:

STINSON -	32'-6"	16" DIA.
FRONTAGE -	32'-6"	16" DIA.
WESTERN -	40'-0"	16" DIA.

ALL WINGWALL PILES ARE 12" DIA. X 10' LONG

[illegible]

SCANNED BY
BY LASON

26 4076.902693

Greiner, Inc.

CITY OF ALBUQUERQUE
PUBLIC WORKS DEPARTMENT
ENGINEERING DIVISION

TITLE	AMOLE DEL NORTE STORM DIVERSION FACILITIES - PHASE III TIERRA BAYITA DRAINAGE FACILITIES
-------	---

TYPICAL CROSSING STRUCTURE SECTIONS

APPROVALS	ENGINEER	DATE	APPROVALS	ENGINEER	DATE
D.R.C. Chairman	<i>[Signature]</i>	10-25-91	Water	<i>[Signature]</i>	10-25-91
Transportation	<i>[Signature]</i>	10-01-91	Waste Water	<i>[Signature]</i>	"
Hydrology	<i>[Signature]</i>	9/24/91			

DRAWING NO.	4076.90	MAP NO.	L-10	SHEET	26	OF	35
-------------	---------	---------	------	-------	----	----	----

RECORD DRAWING


1-9"x9"x1" MIN. THICKNESS
GROUT PAD (BURKE DAMP
PACK GROUT OR APPROVED
EQUAL)

FINISH TOP OF GROUT
PAD TO LEVEL SURFACE

ANCHOR BOLTS
SEE NOTE 1

(3) #4A8
AS SHOWN
(STINSON &
FRONTAGE)


#4A10
AS SHOWN
(WESTERN)

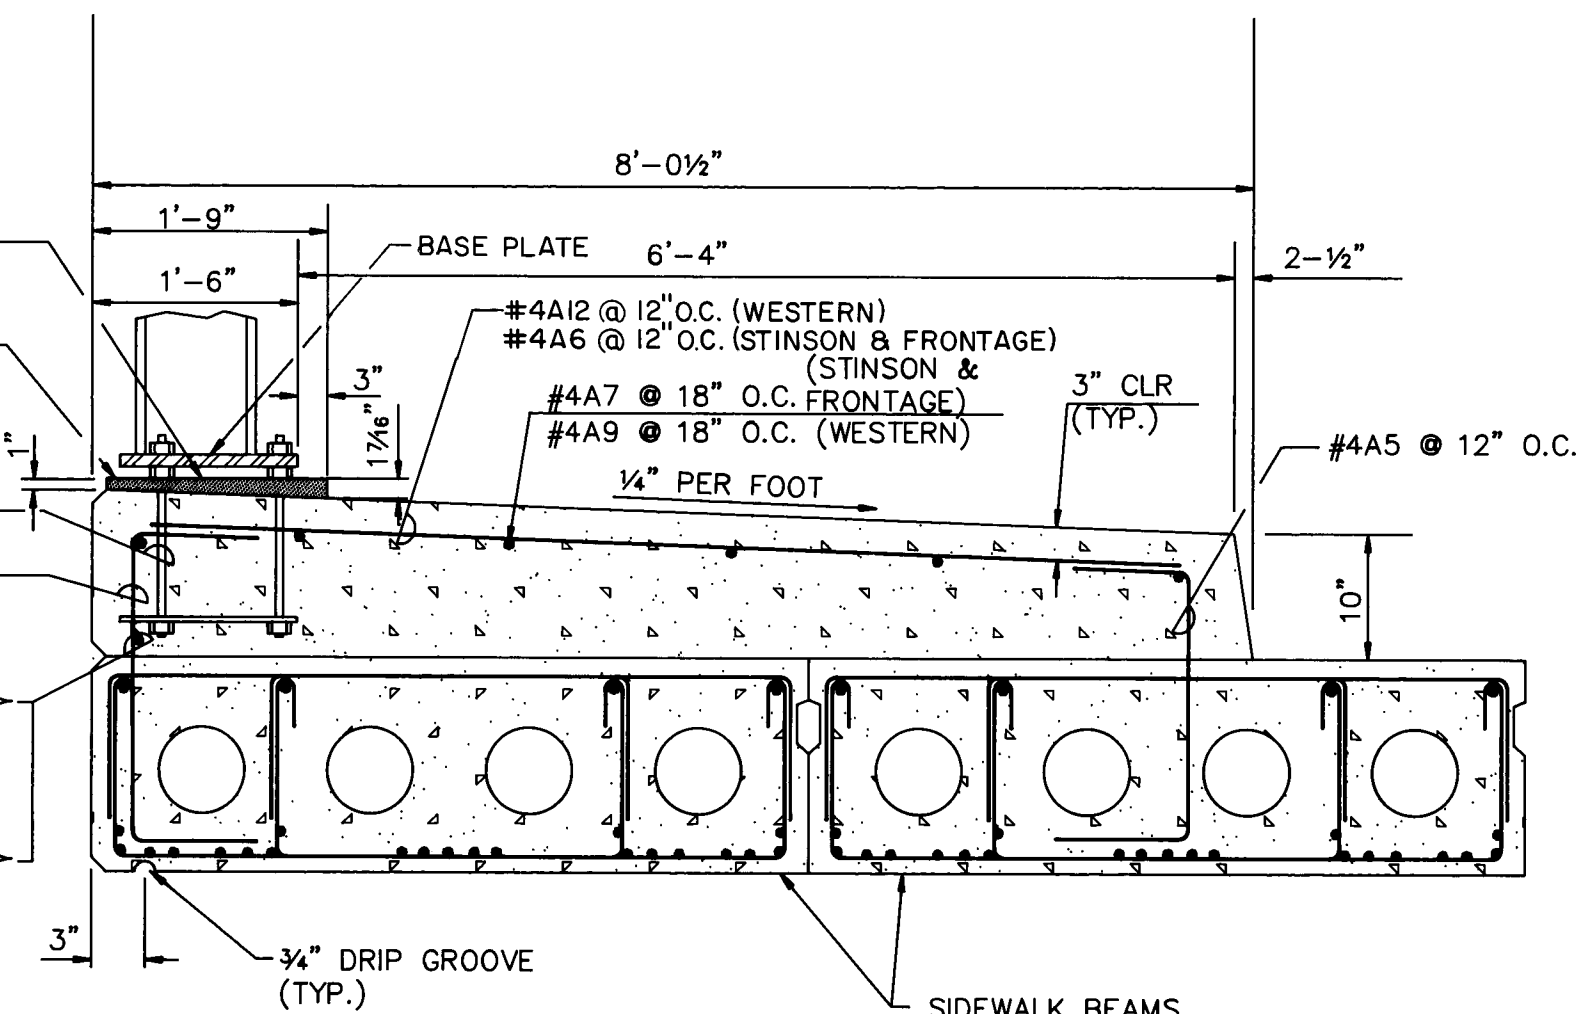

SIDEWALK DETAIL

**SIDEWALK
REINFORCING REQUIRED**

REGULAR GRADE 40 BARS (EACH BRIDGE)					
BAR	TYPE	SIZE	LENGTH	NO. REQ'D	REMARKS
#4A6	1	#4	7'-0"	80	FRONTAGE & STINSON
#4A7	1	#4	34'-8"	8	FRONTAGE & STINSON
#4A8	1	#4	34'-8"	6	FRONTAGE & STINSON
#4A9	1	#4	40'-2"	8	WESTERN
#4A10	1	#4	40'-2"	6	WESTERN
#4A12	1	#4	7'-0"	90	WESTERN

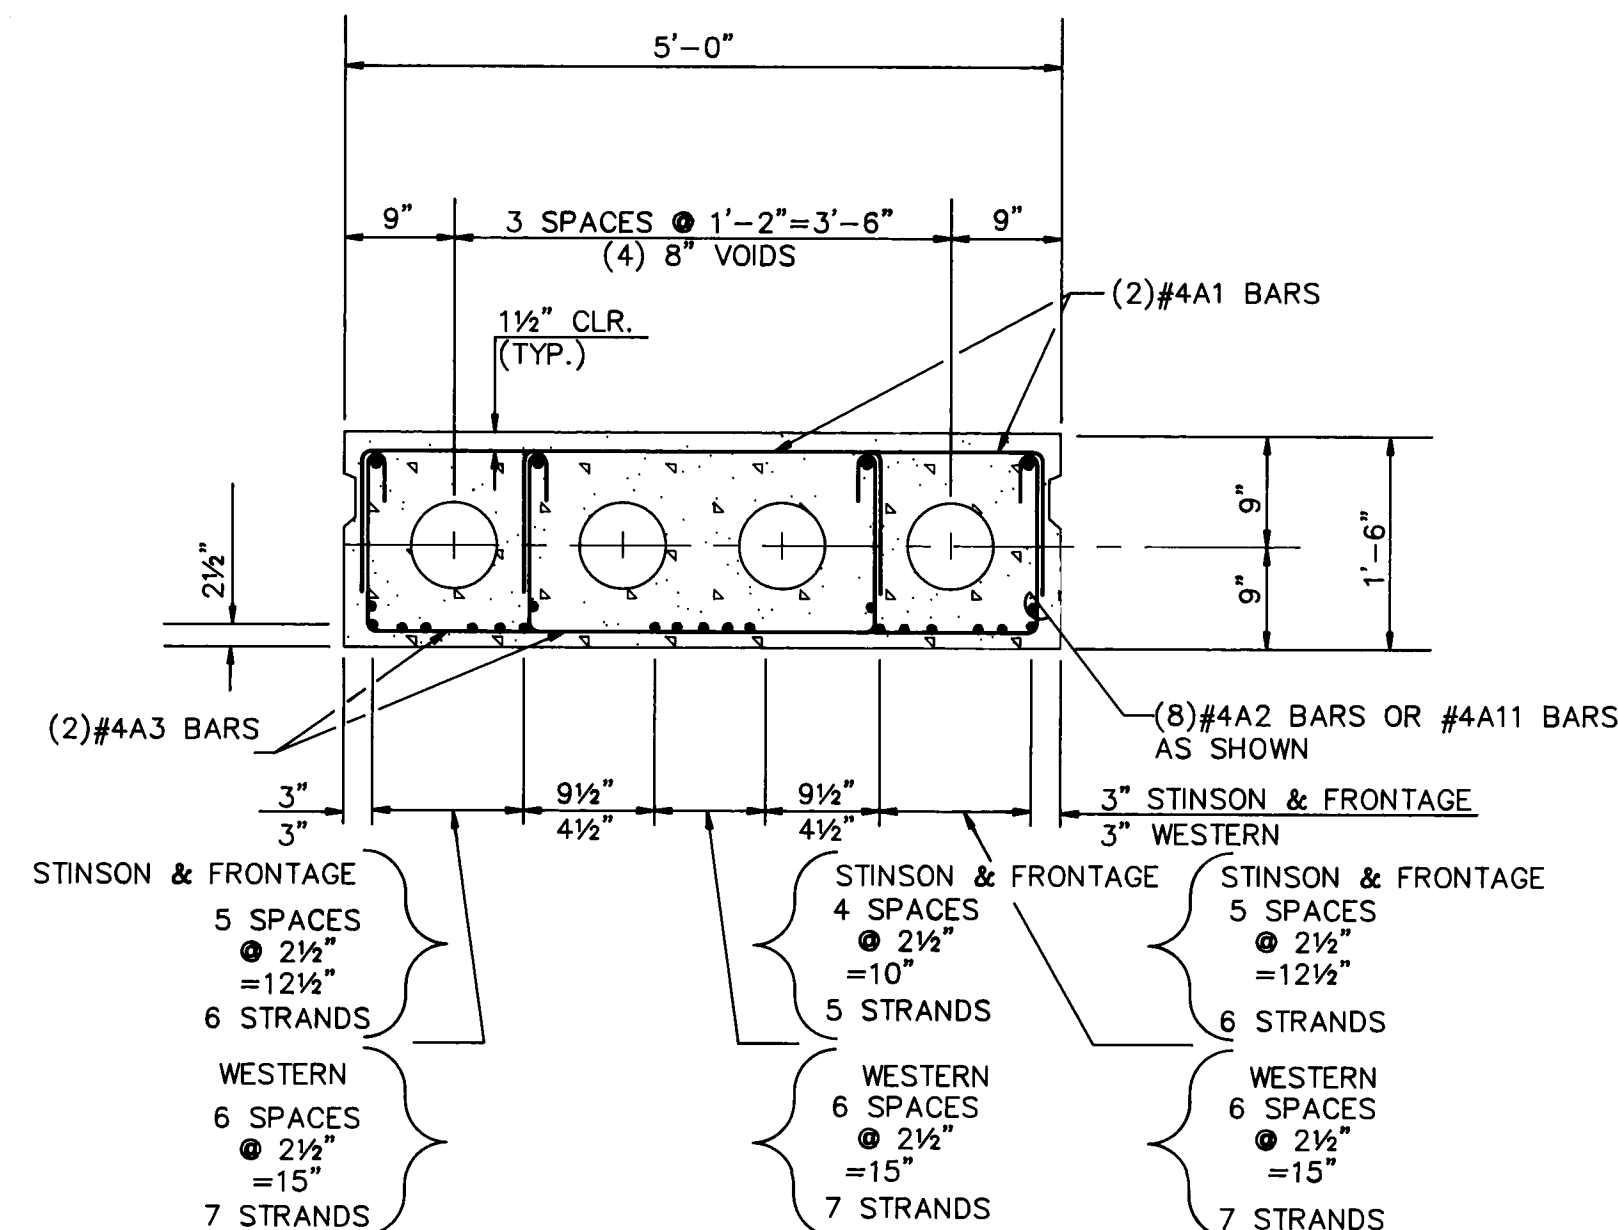

PRESTRESSED BEAM DETAIL


SEE NOTE 3

PRESTRESSED BEAM (12) REQUIRED


REGULAR GRADE 40 BARS (EACH BEAM)					
BAR	TYPE	SIZE	LENGTH	NO. REQ'D	REMARKS
#4A1	3	#4	5'-5 1/2"	80	FRONTAGE & STINSON
#4A2	1	#4	34'-8"	8	FRONTAGE & STINSON
#4A3	2	#4	6'-8"	80	FRONTAGE & STINSON
#4A4	4	#4	3'-5 3/4"	36	FRONTAGE & STINSON *
#4A5	4	#4	3'-2 3/4"	36	FRONTAGE & STINSON *
#4A1	3	#4	5'-5 1/2"	90	WESTERN
#4A11	1	#4	40'-2"	8	WESTERN
#4A3	2	#4	6'-8"	90	WESTERN
#4A4	4	#4	3'-5 3/4"	41	WESTERN *
#4A5	4	#4	3'-2 3/4"	41	WESTERN *

* SIDEWALK BEAMS ONLY

BAR BENDING DIAGRAMS

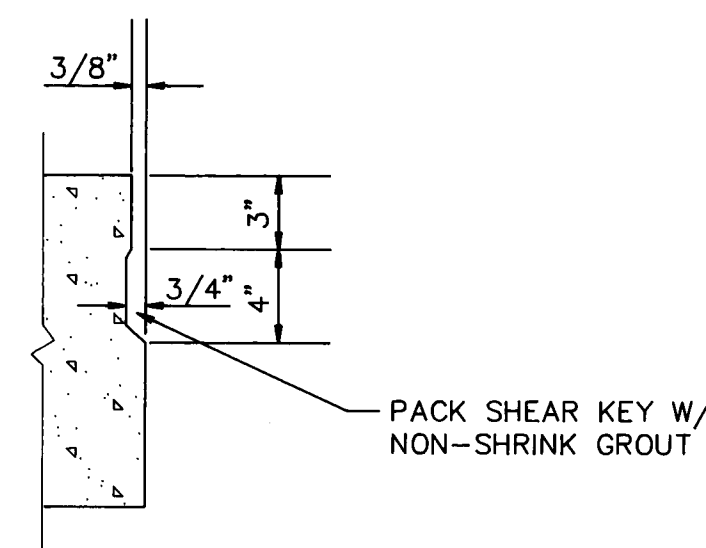


SHEAR KEY DETAIL

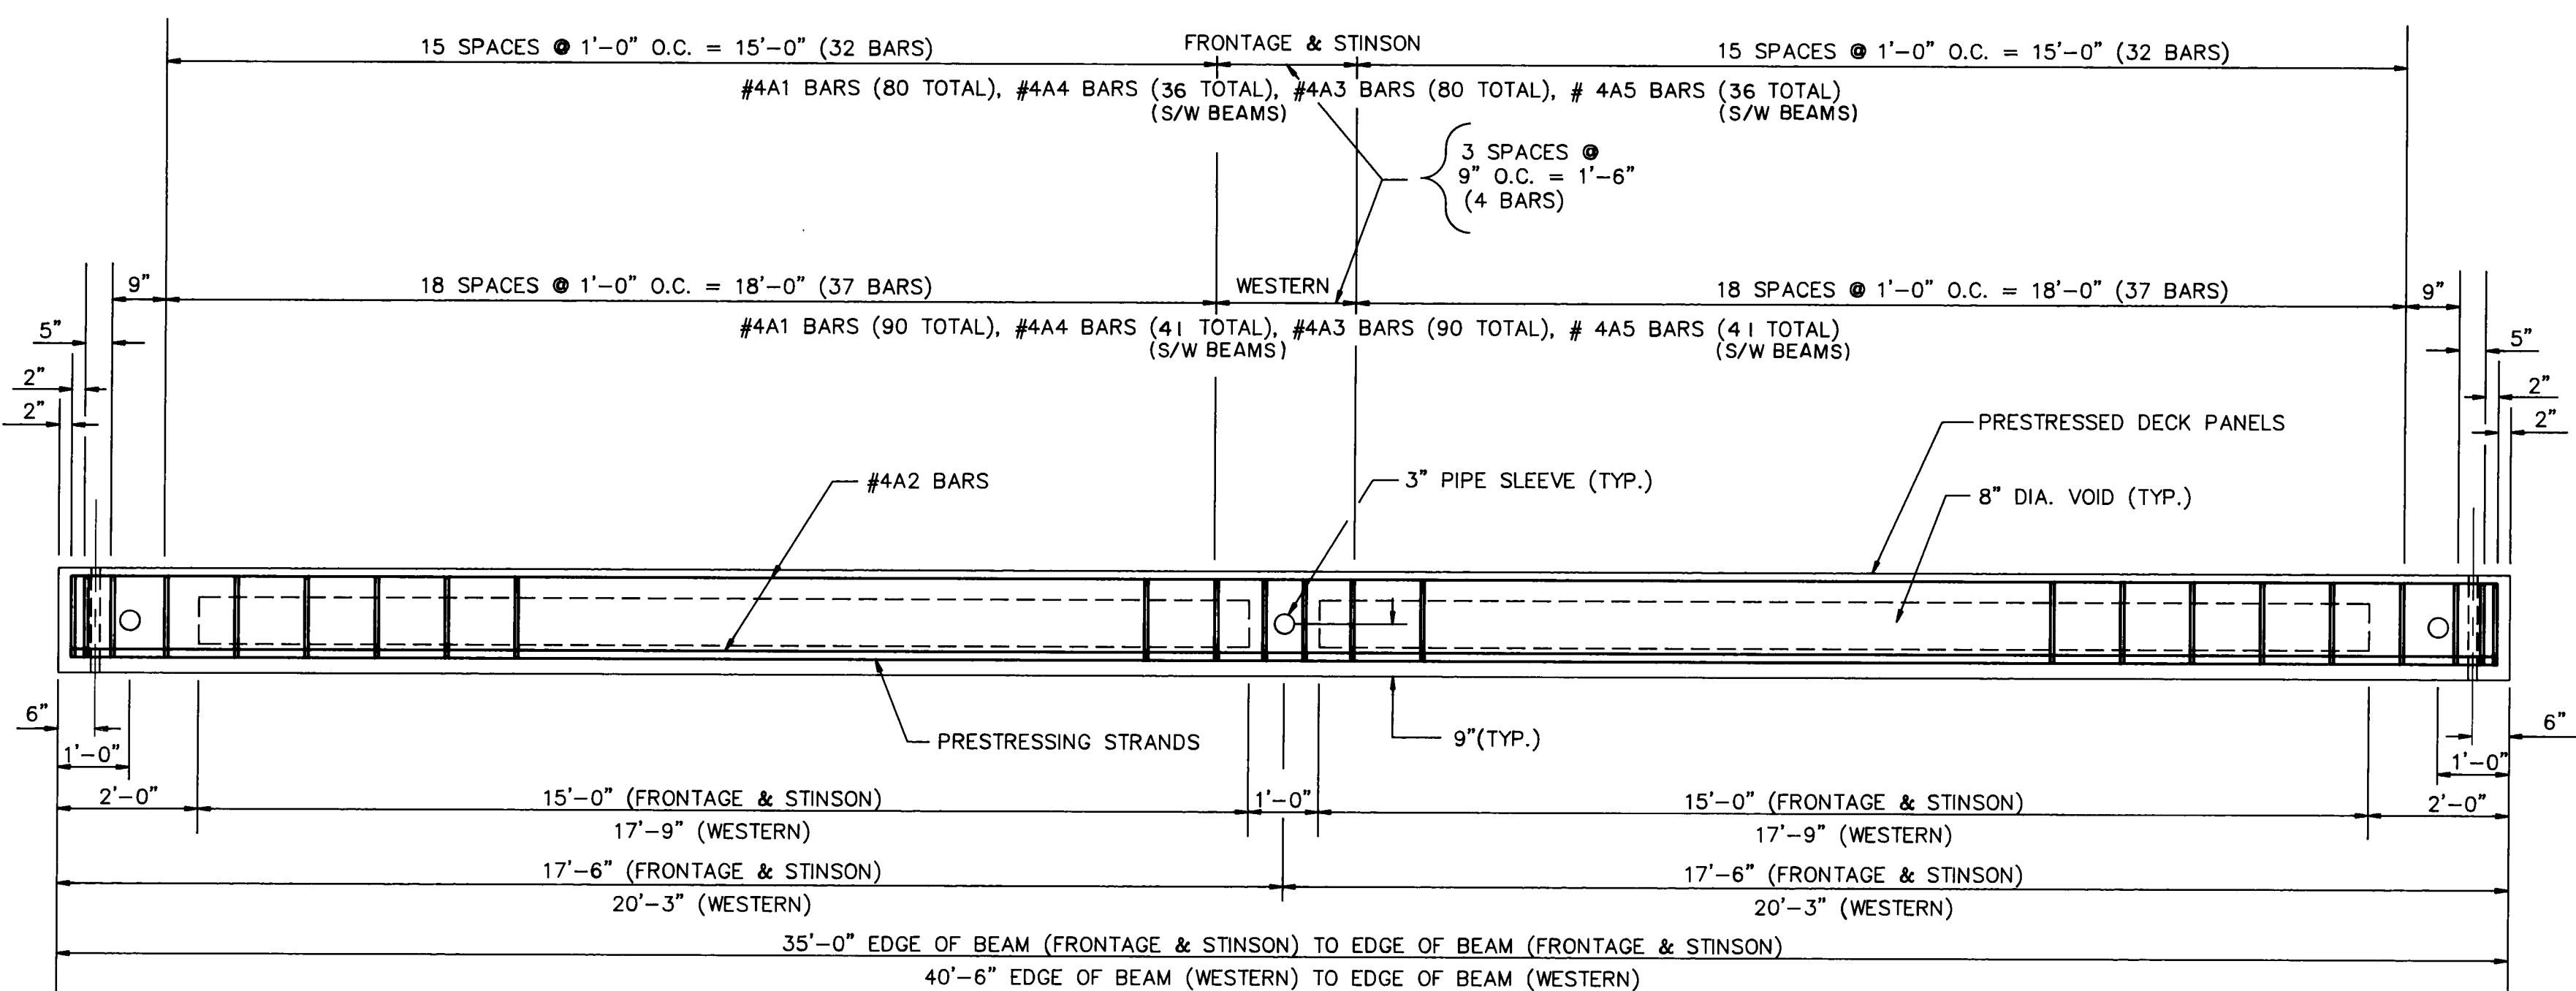

LONGITUDINAL BEAM SECTION

NOT TO SCALE

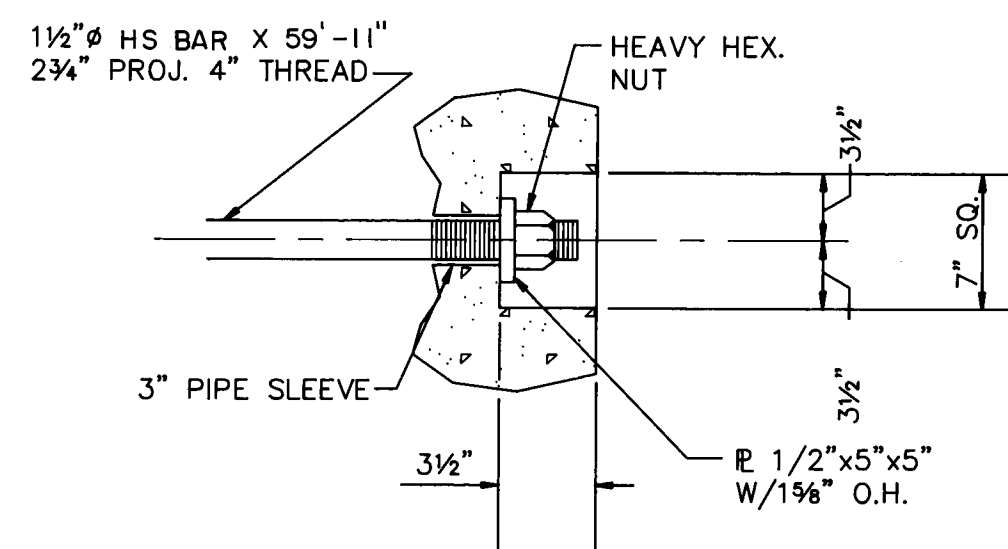


LATERAL TIE AND INSET

SEE NOTE 2

NOTES

- ANCHOR BOLTS SHALL BE EMBEDDED AS SHOWN IN DETAIL "ANCHOR FOR RAIL POST ON WINGWALL" PER C.O.A. STD DWG. 2604 MODIFIED TO SHOW AN ADDITIONAL PROTRUSION @ TOP OF SIDEWALK.
- EACH BEAM PANEL SHALL BE COMPRESSED AGAINST THE PREVIOUS PANEL BY MEANS OF TEMPORARY STRESSING BAR THROUGH EACH 3" PIPE SLEEVE. THIS ITEM IS CONSIDERED AS AN INCIDENTAL.
- DEBOND 4 STRANDS AT 24" EA. AT EACH BEAM END. (STINSON & FRONTAGE) DEBOND 7 STRANDS AT 40" EA. AT EACH BEAM END. (WESTERN)

AS BUILT INFORMATION				BENCH MARKS				SURVEY INFORMATION			
CONTRACTOR	MOORE & CONANT	DATE	1992	BRIDGE	BOULEVARD	APPROXIMATELY 30' NORTH OF THE EDGE OF PAVEMENT AND APPROXIMATELY 125' WEST OF SESAME STREET. N = 1,481,394.909 E = 980,370.080 ELEV = 5072.084	DATE	NO.	BY	DATE	DATE
WALKER				INSPECTION	BY	DATE		1880	GREINER	6-7/90	7/8/90
C. PEDROGUELLI				FIELD	DATE			1883	GREINER	7/8/90	12/90
WALKER				FIELD	DATE			1886	GREINER	12/90	12/90
WALKER				FIELD	DATE			1889	GREINER	12/90	12/90
WALKER				FIELD	DATE			1893	GREINER	1/91	9-10/91
WALKER				FIELD	DATE			1910	GREINER		
MICRO-FILM INFORMATION				RECORDED BY				PROJECT NO. G000101			

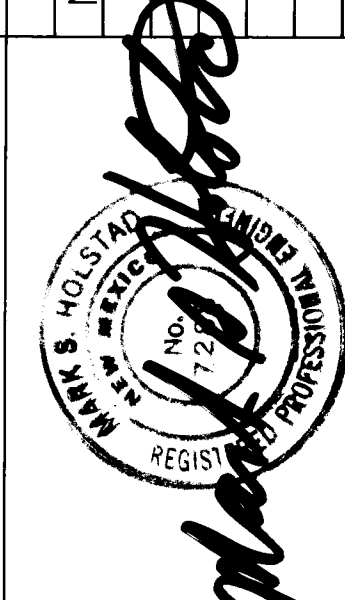

SCANNED BY
BY LASON

26 4076.902793

Greiner, Inc.

CITY OF ALBUQUERQUE
PUBLIC WORKS DEPARTMENT
ENGINEERING DIVISION













TITLE: AMOLE DEL NORTE STORM DIVERSION FACILITIES - PHASE III
TIERRA BAYITA DRAINAGE FACILITIES

PRESTRESSED BEAM DETAILS

APPROVALS	ENGINEER	DATE	APPROVALS	ENGINEER	DATE
DRC Chairman	Ray J. Greiner	10-23-91	Water	Ray J. Greiner	10-23-91
Transportation	R. J. Greiner	11-01-91	Waste Water	R. J. Greiner	11-01-91
Hydrology	R. J. Greiner	11-24-91			

DRAWING NO.	4076.90	MAP NO.	L-10	SHEET	27	OF	35
-------------	---------	---------	------	-------	----	----	----

RECORD DRAWING

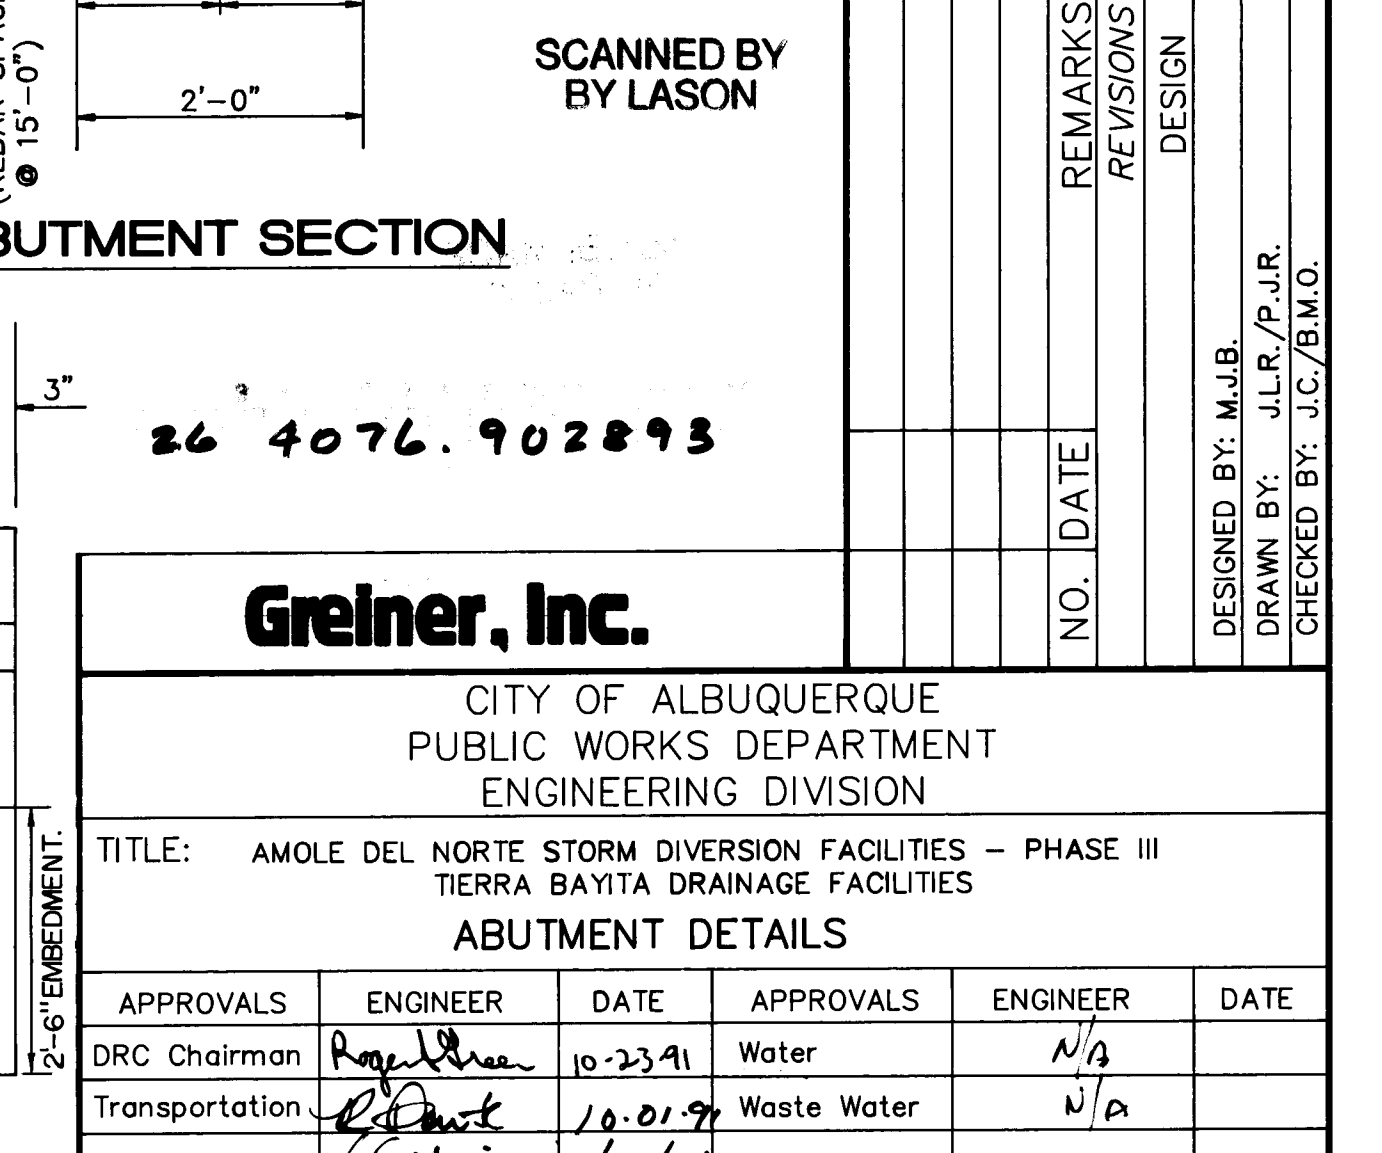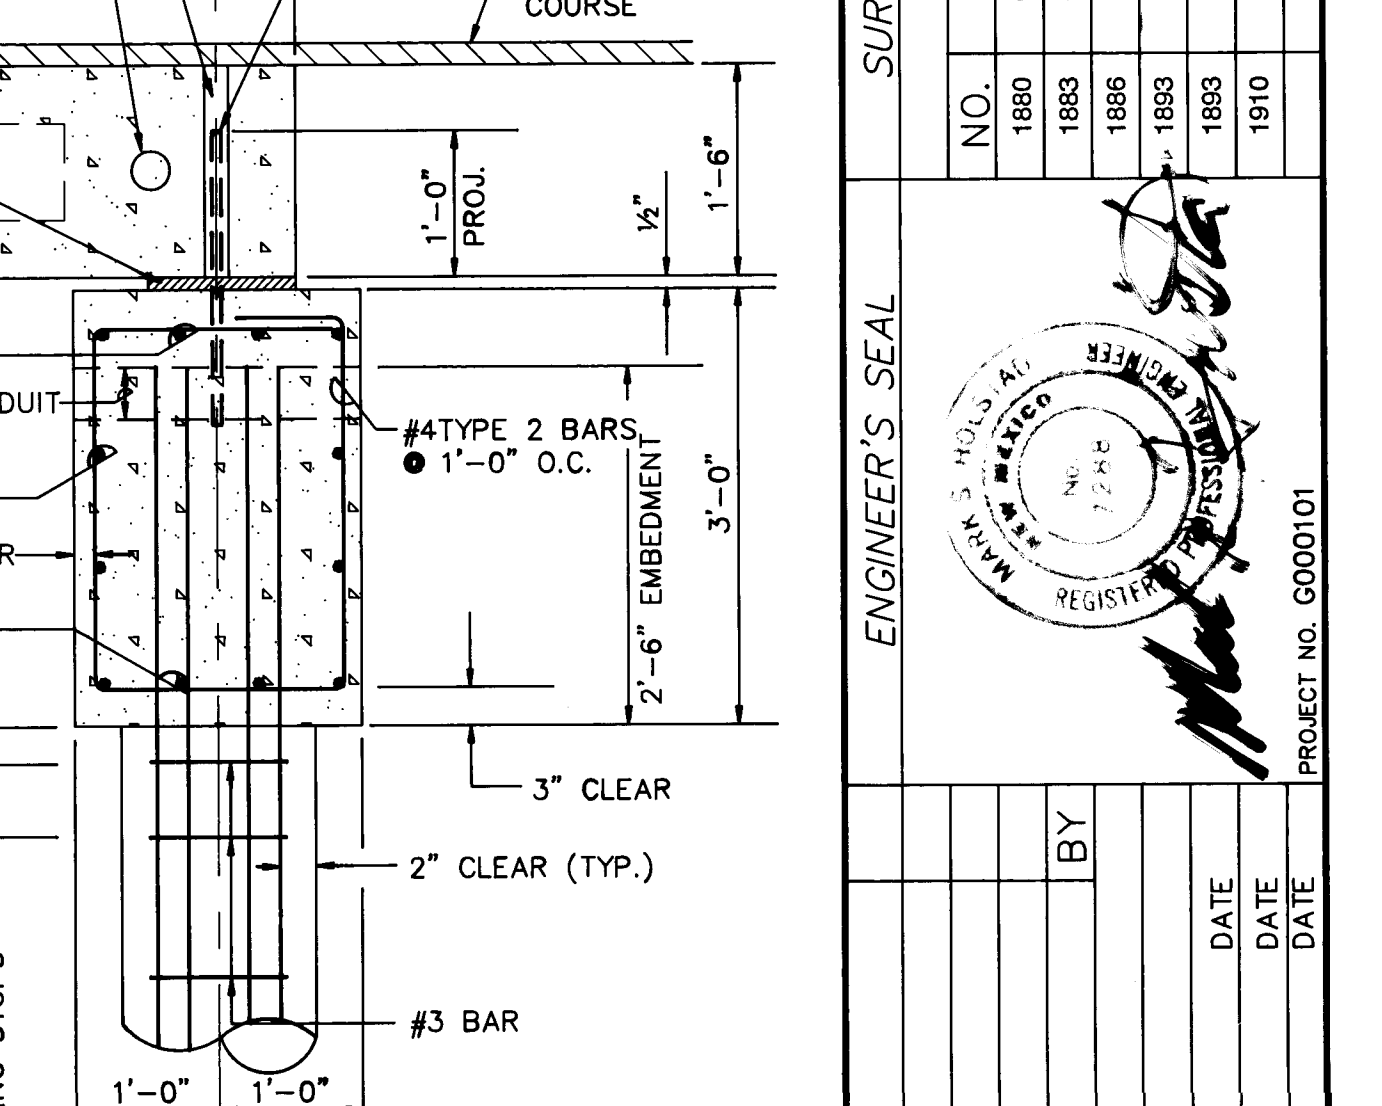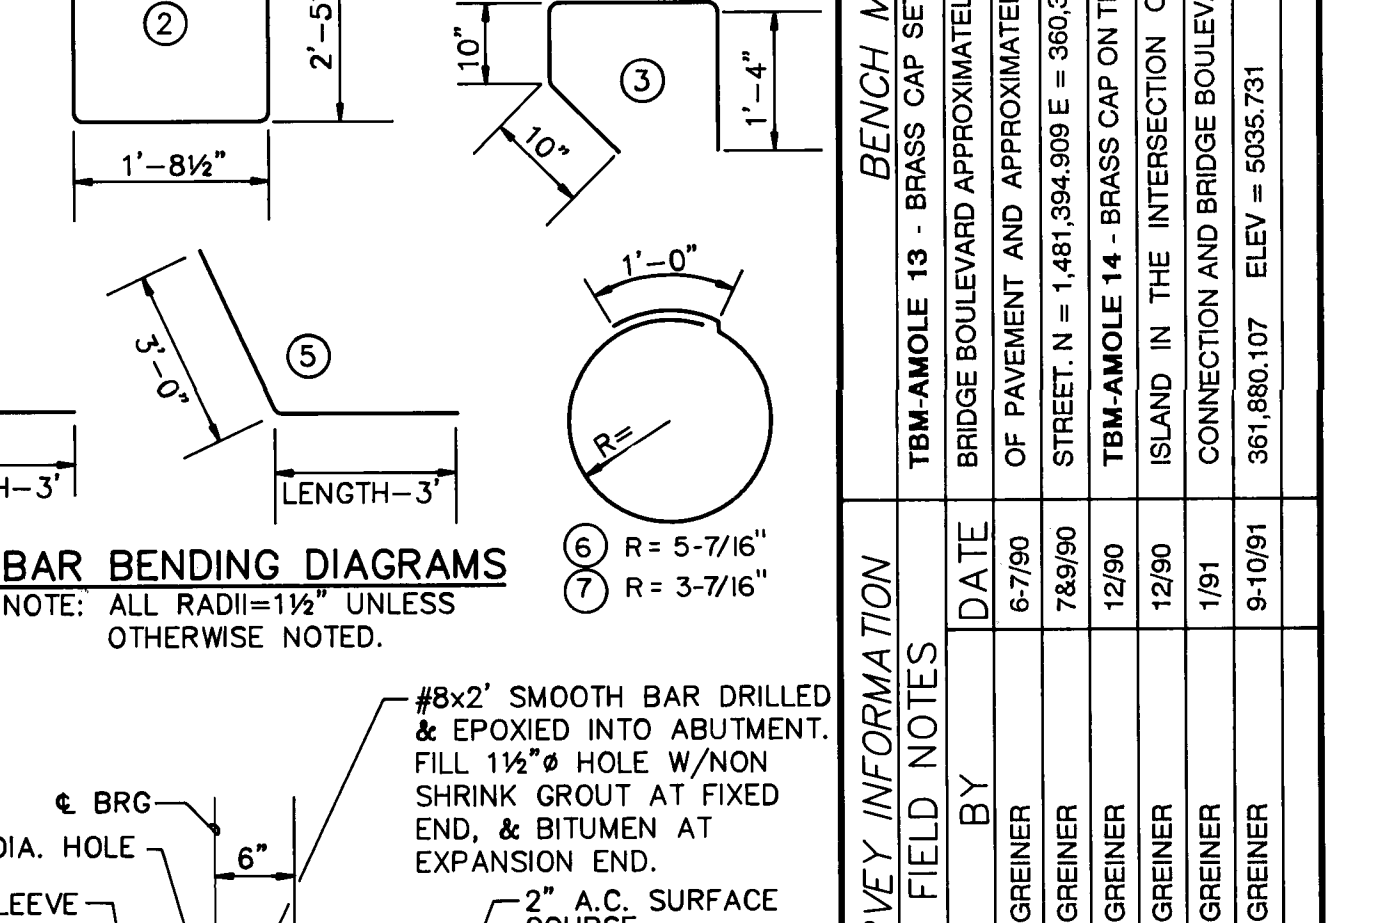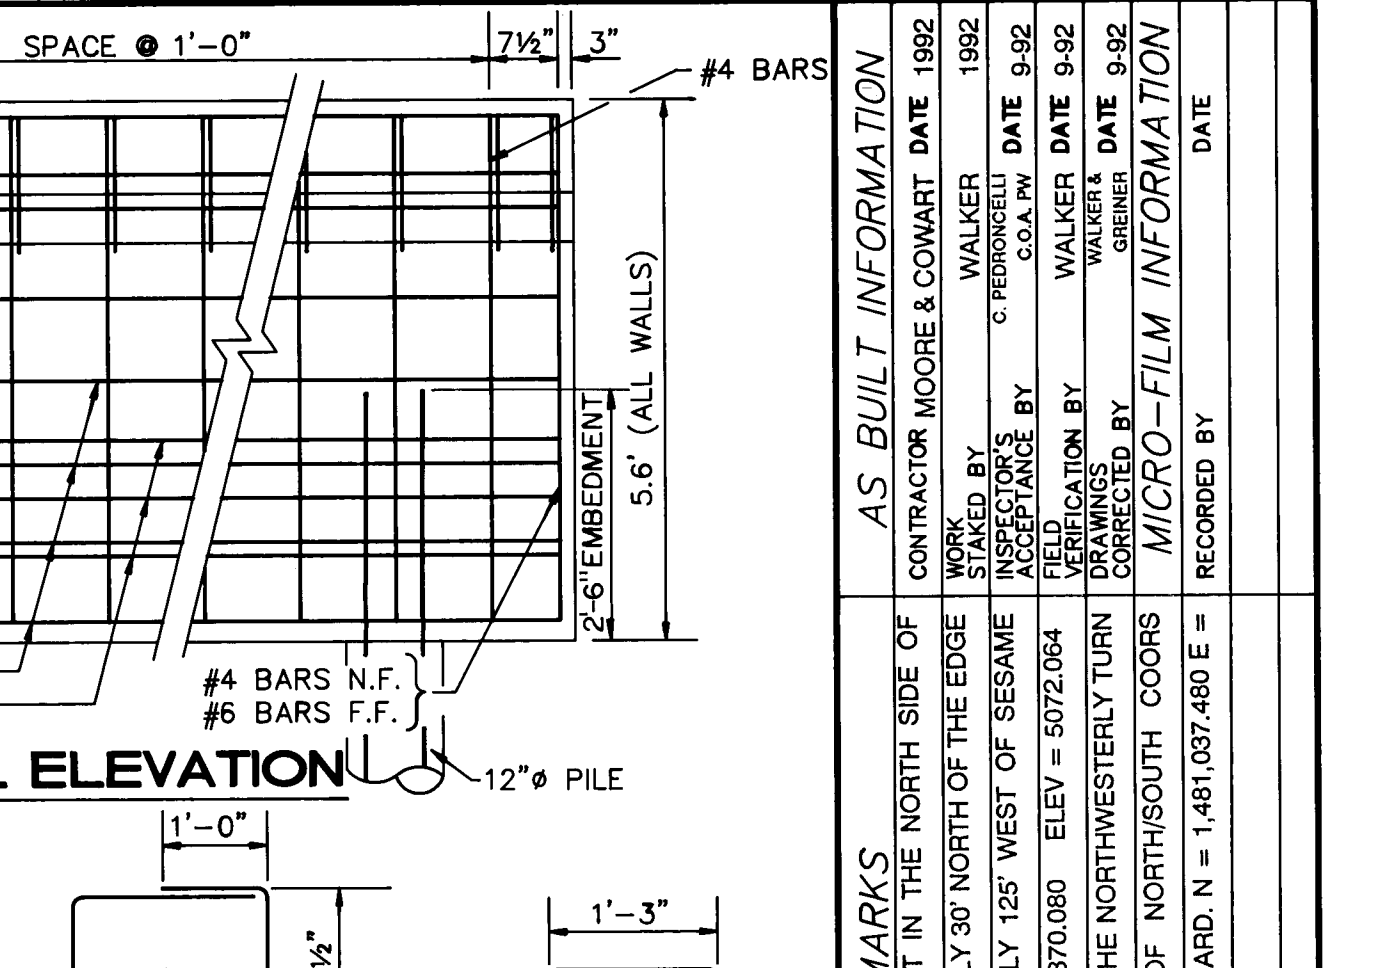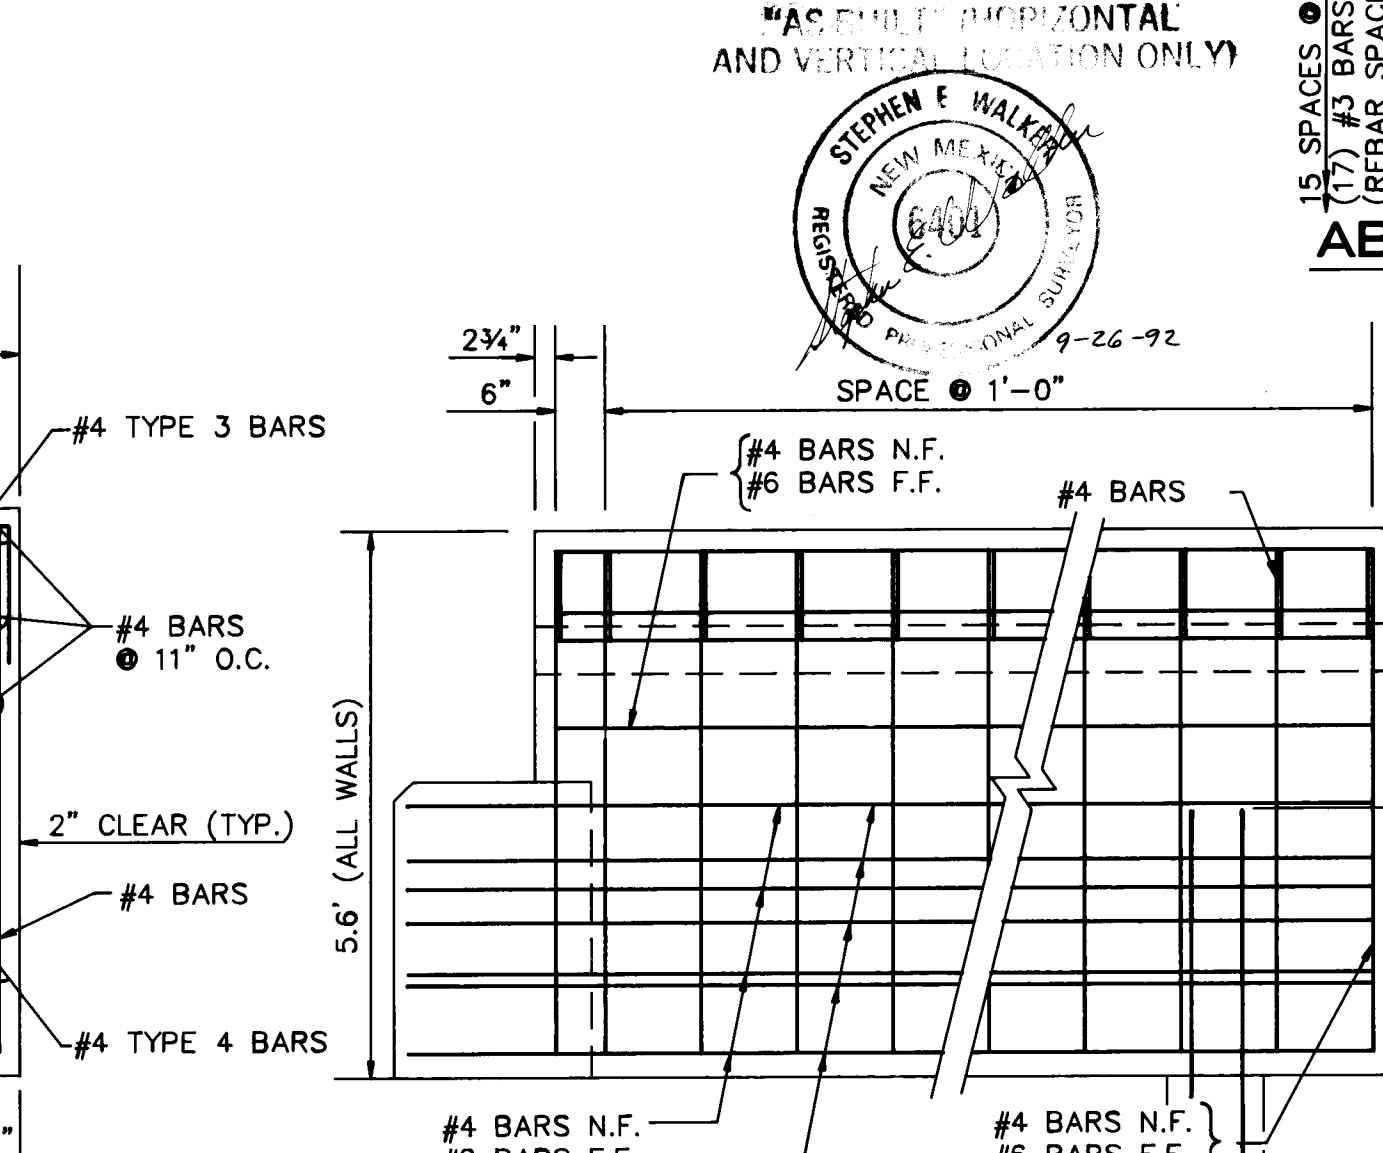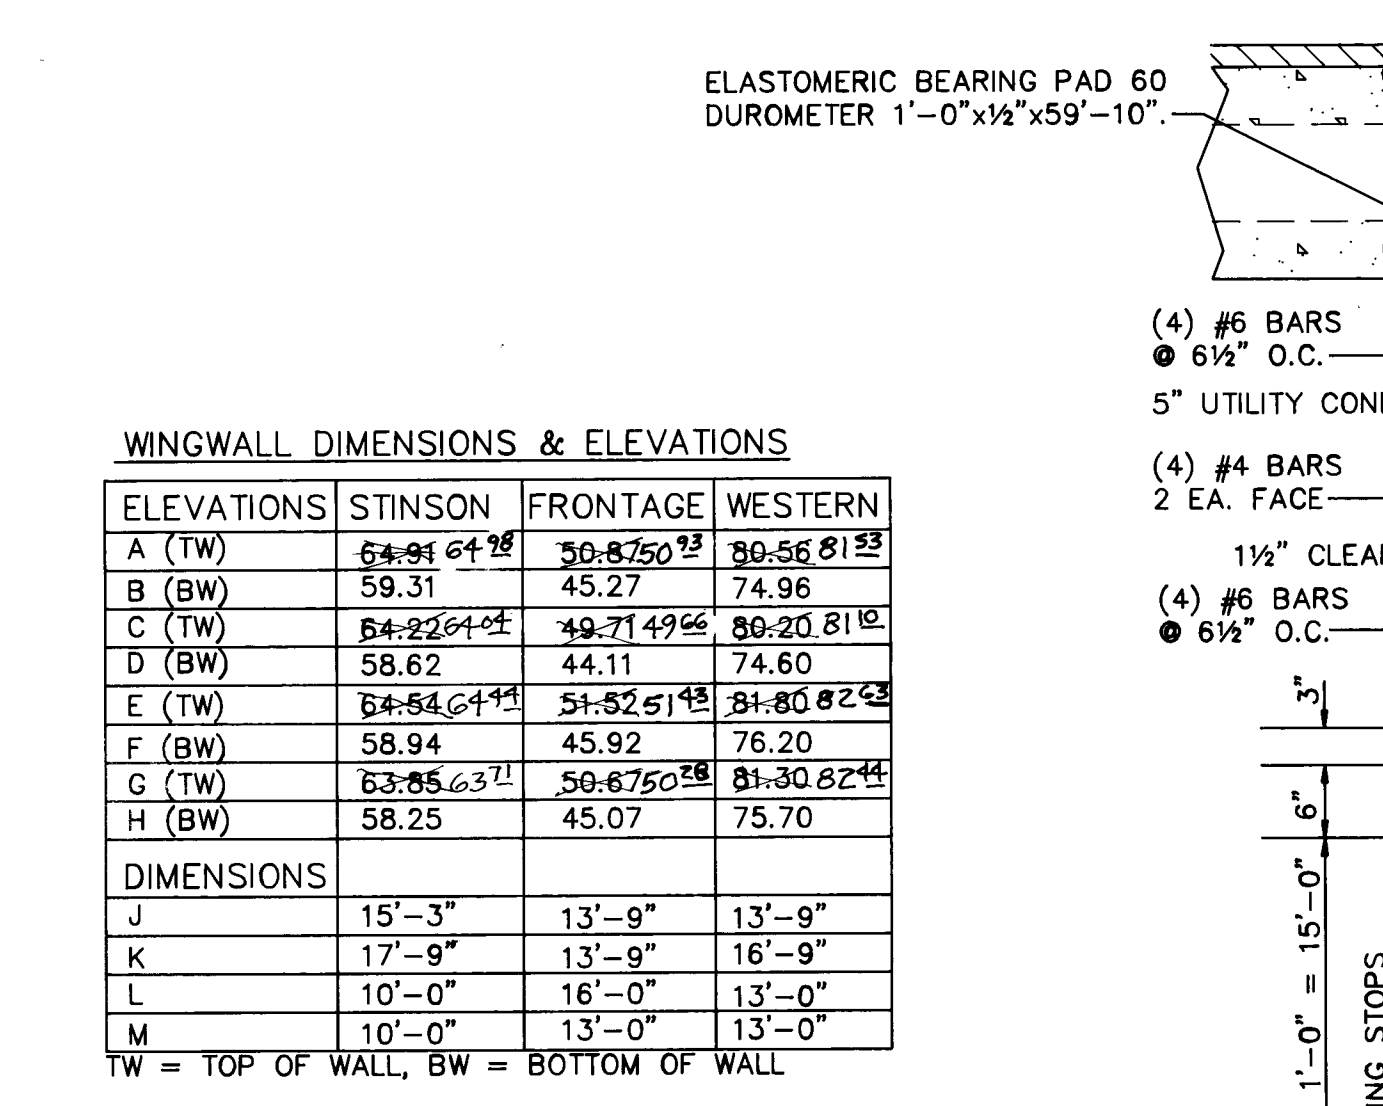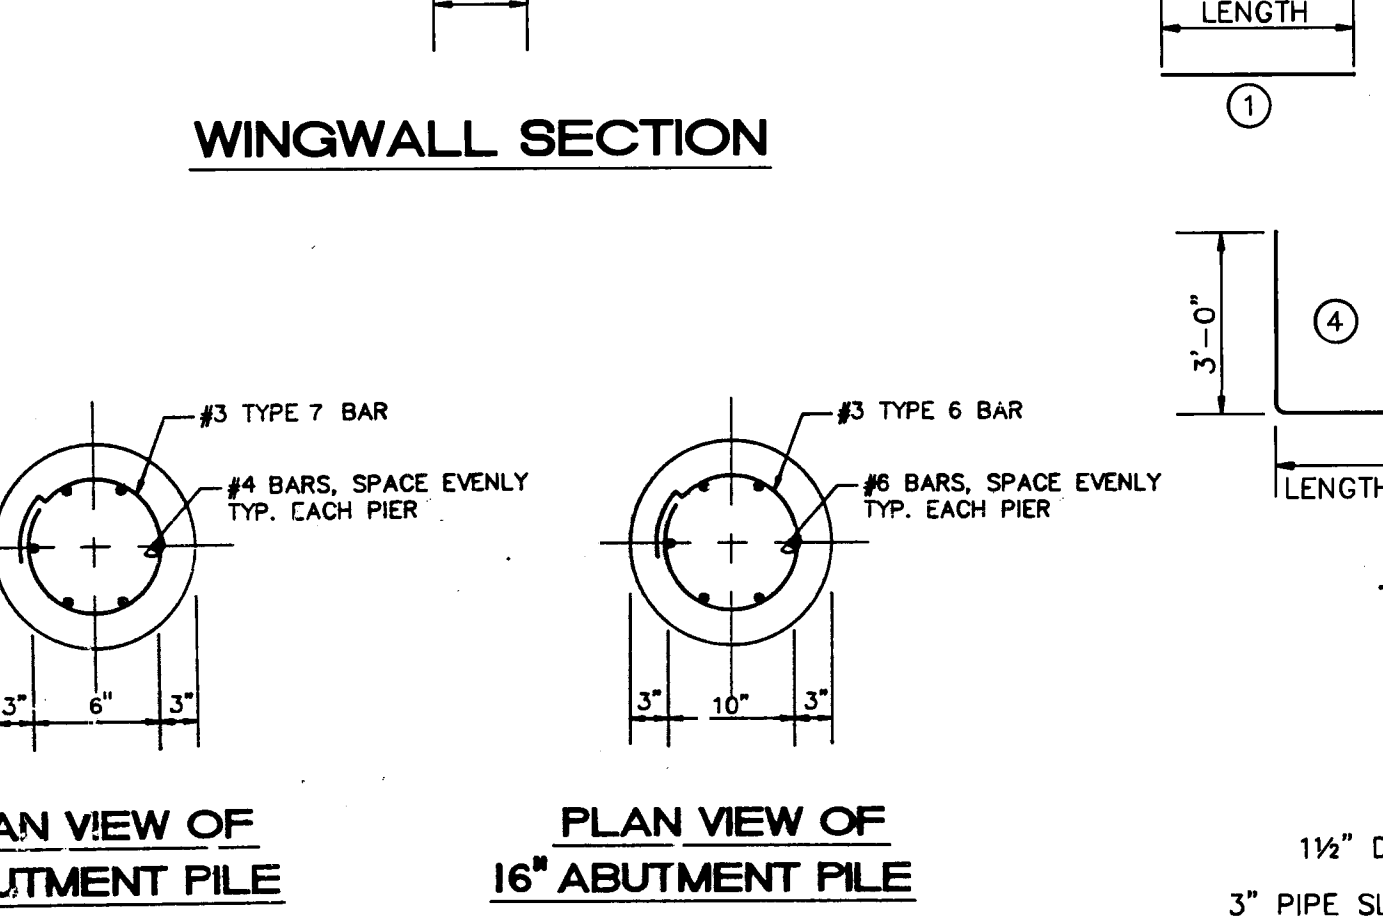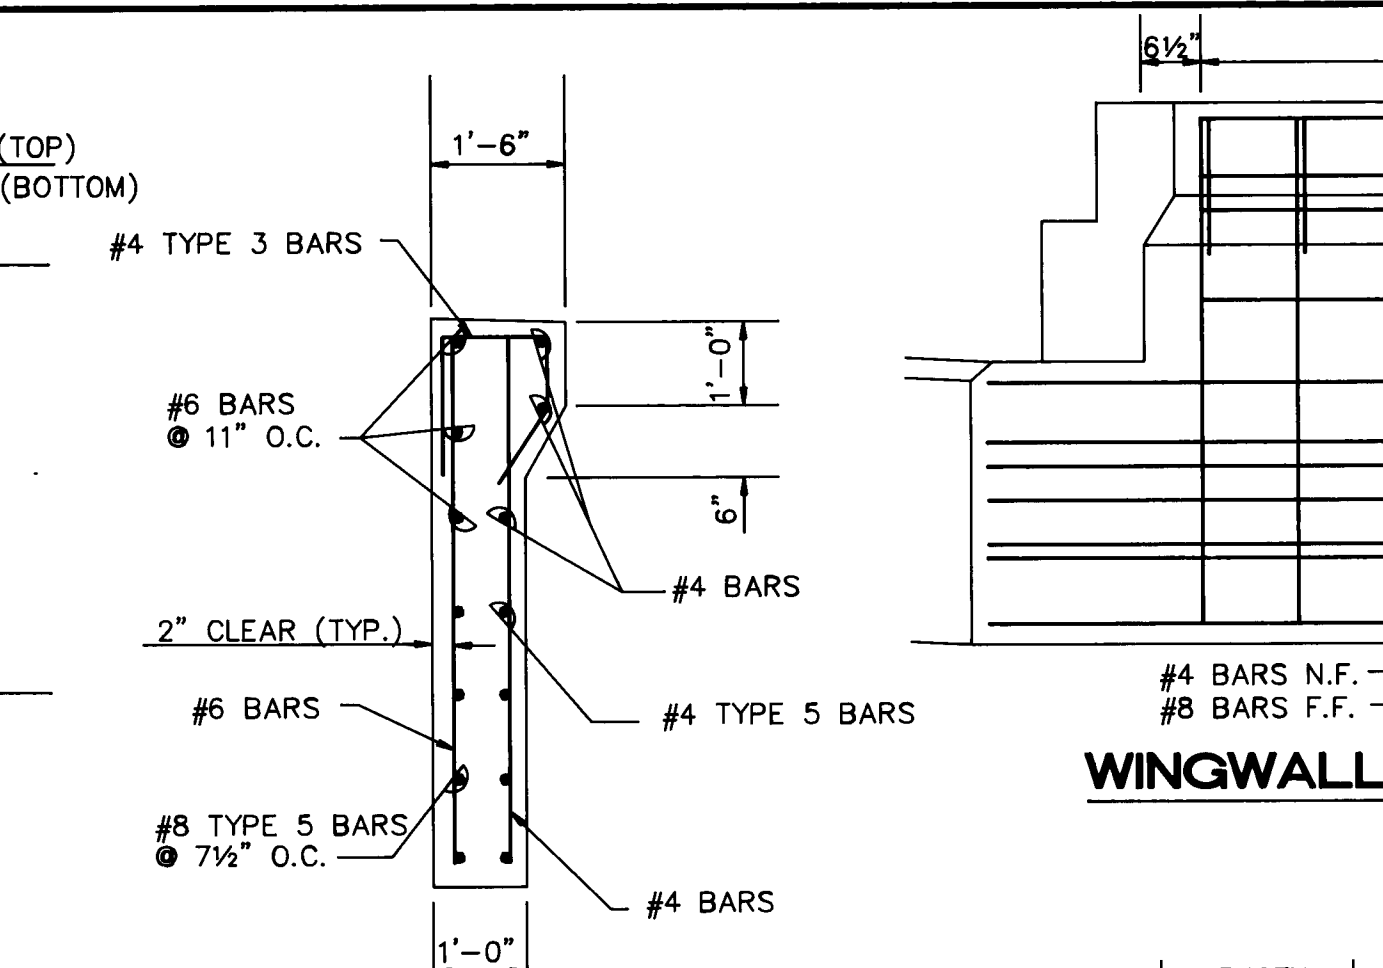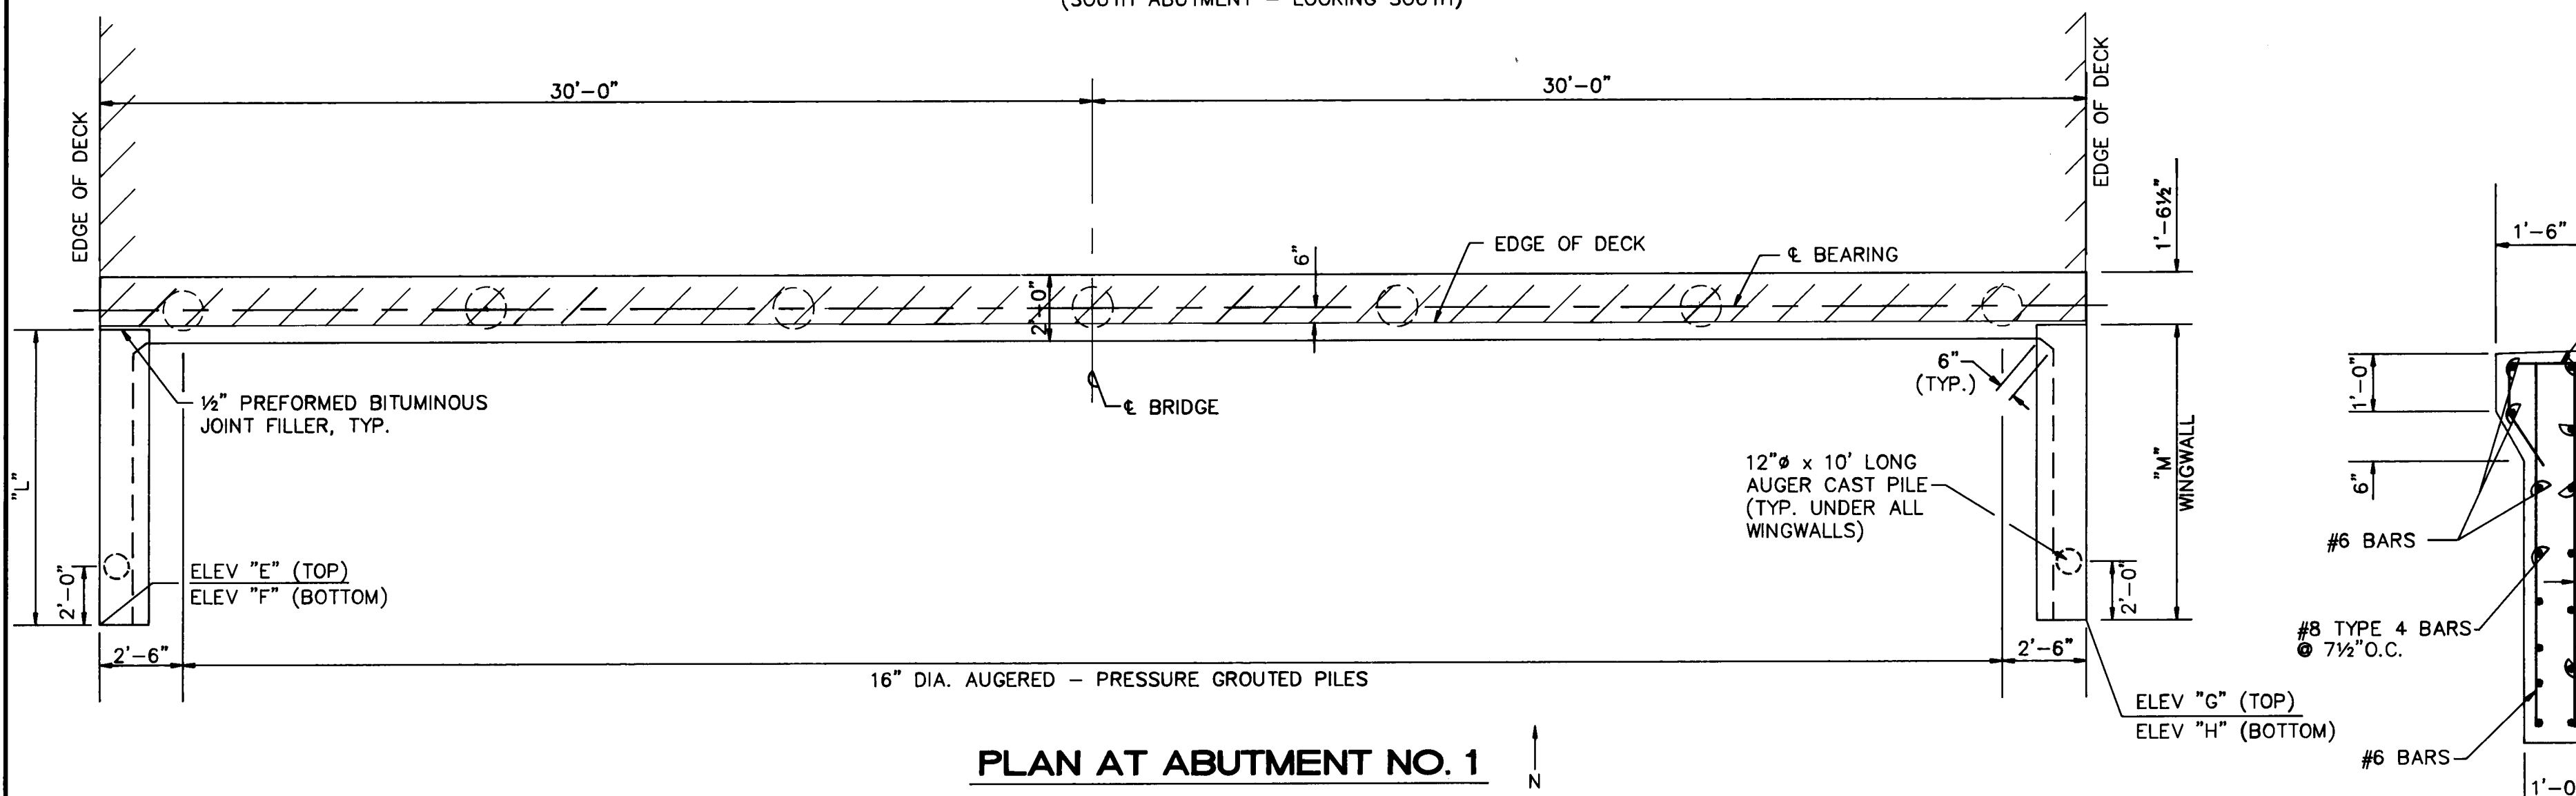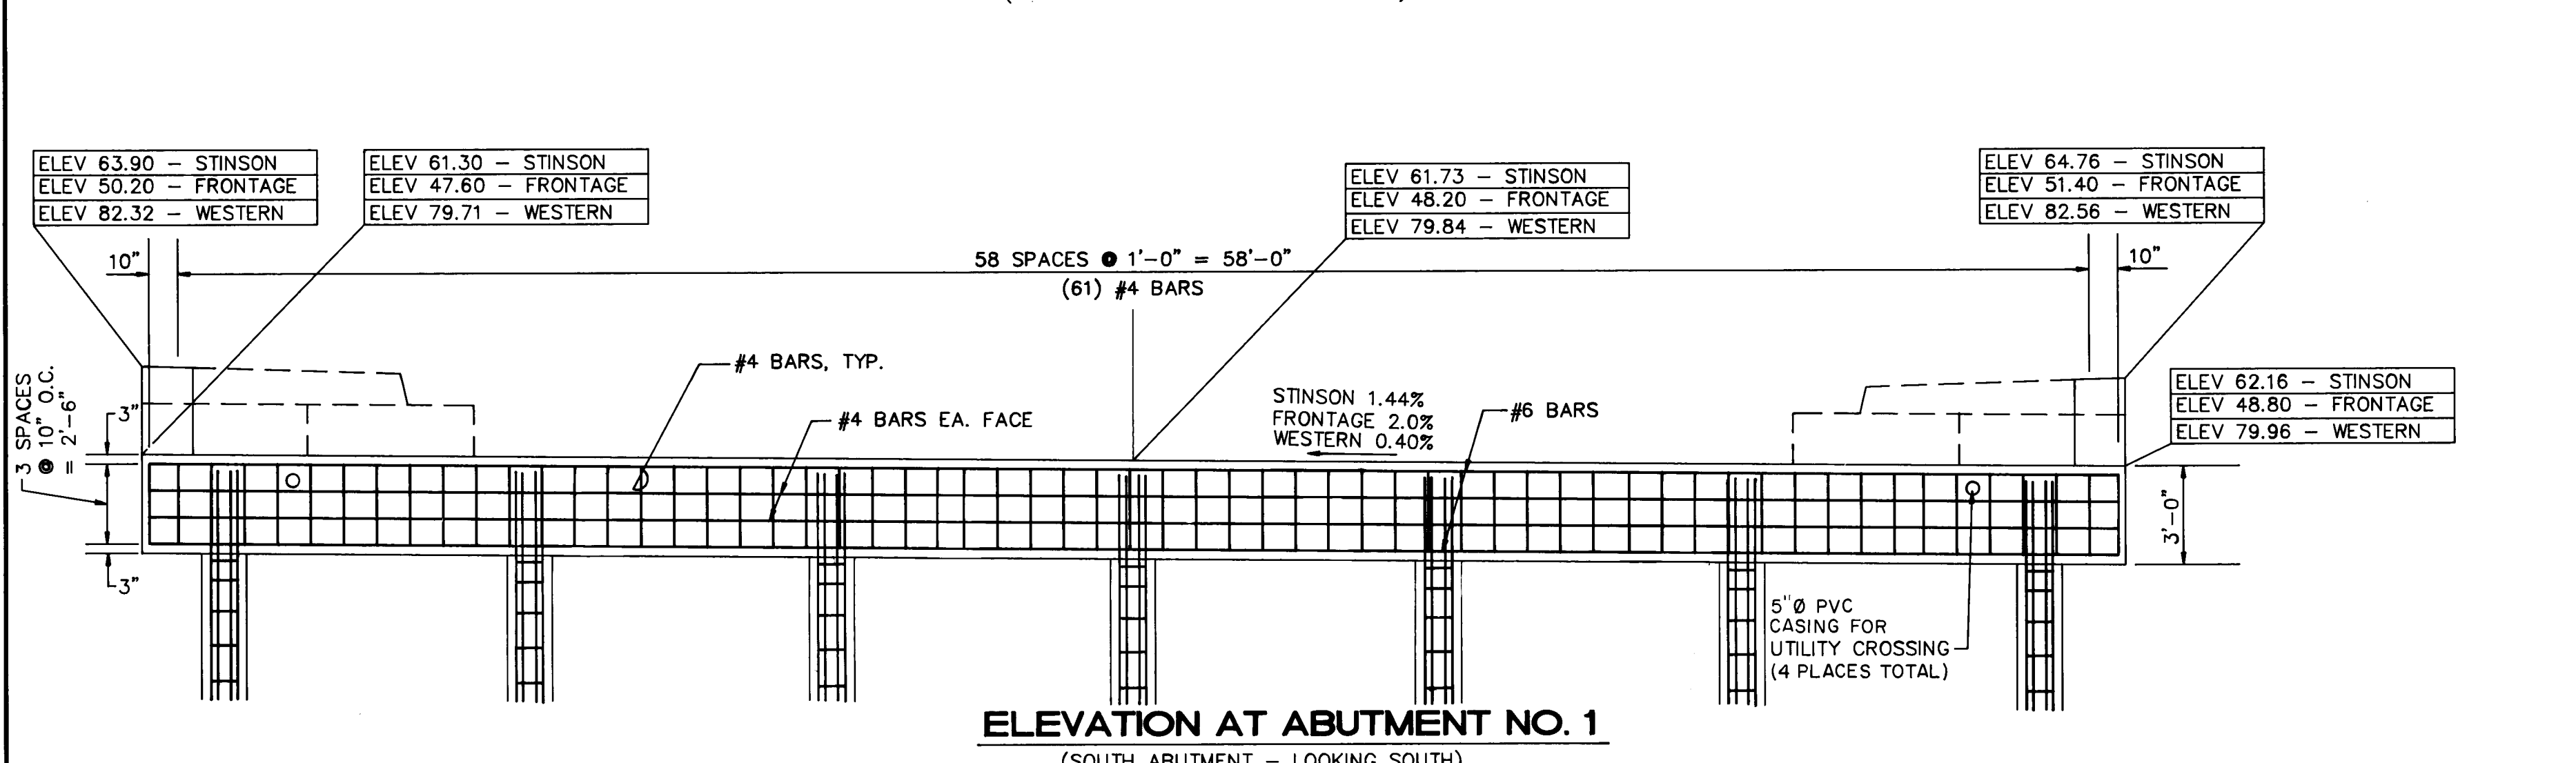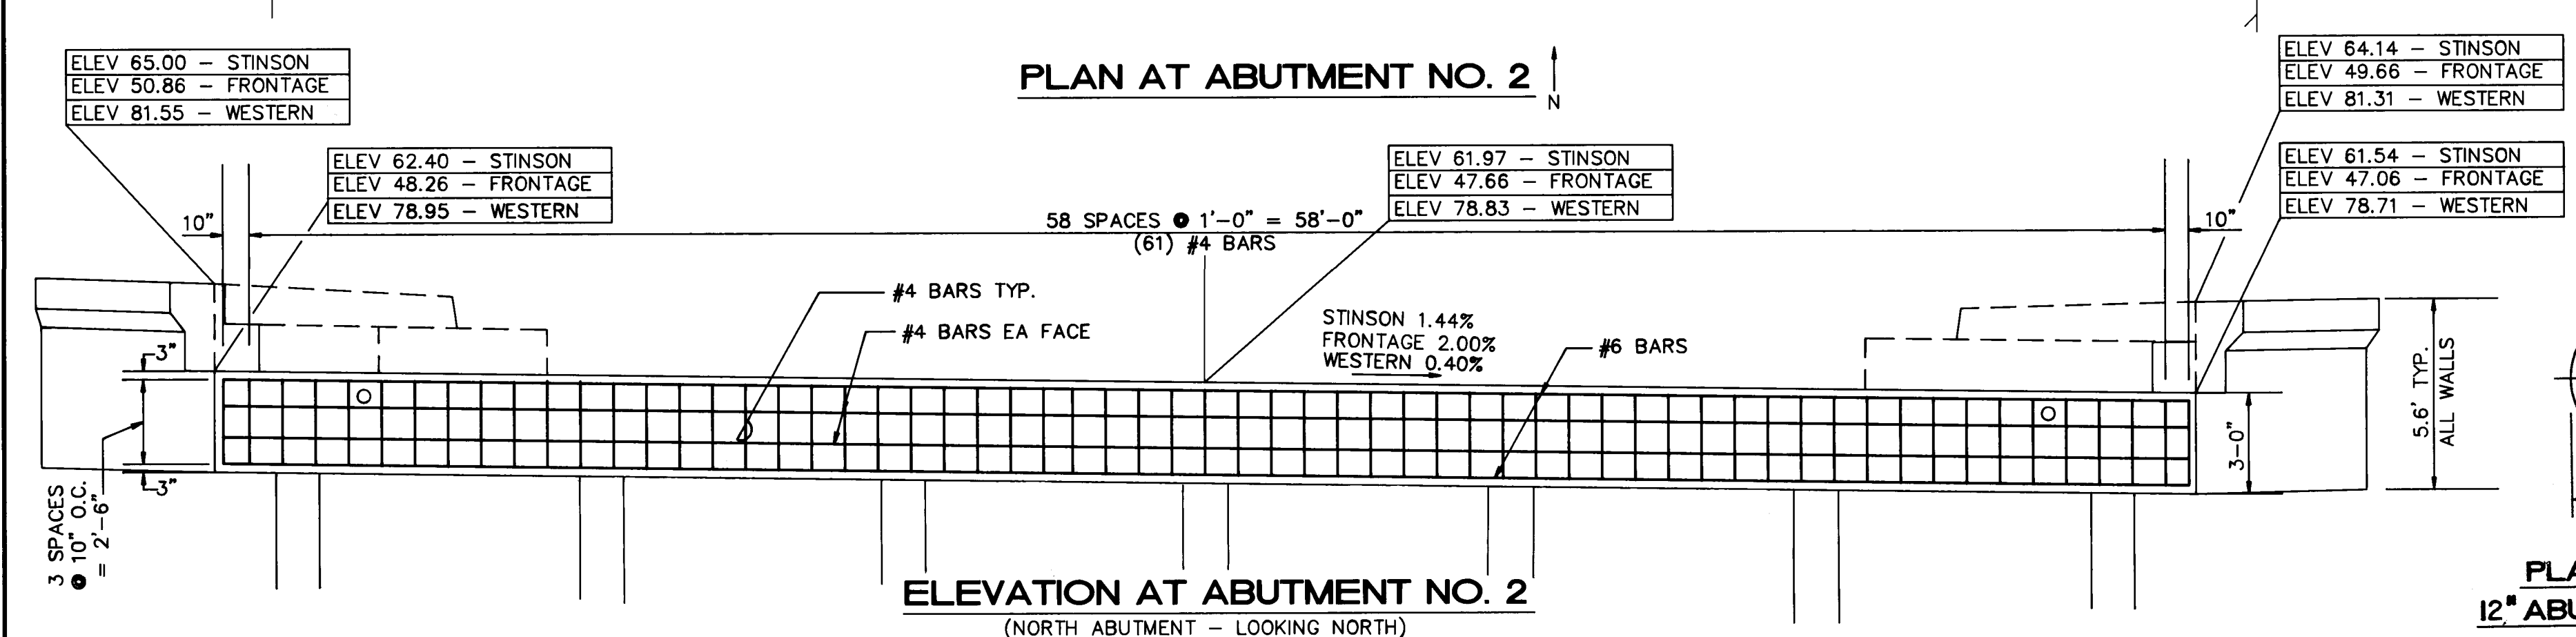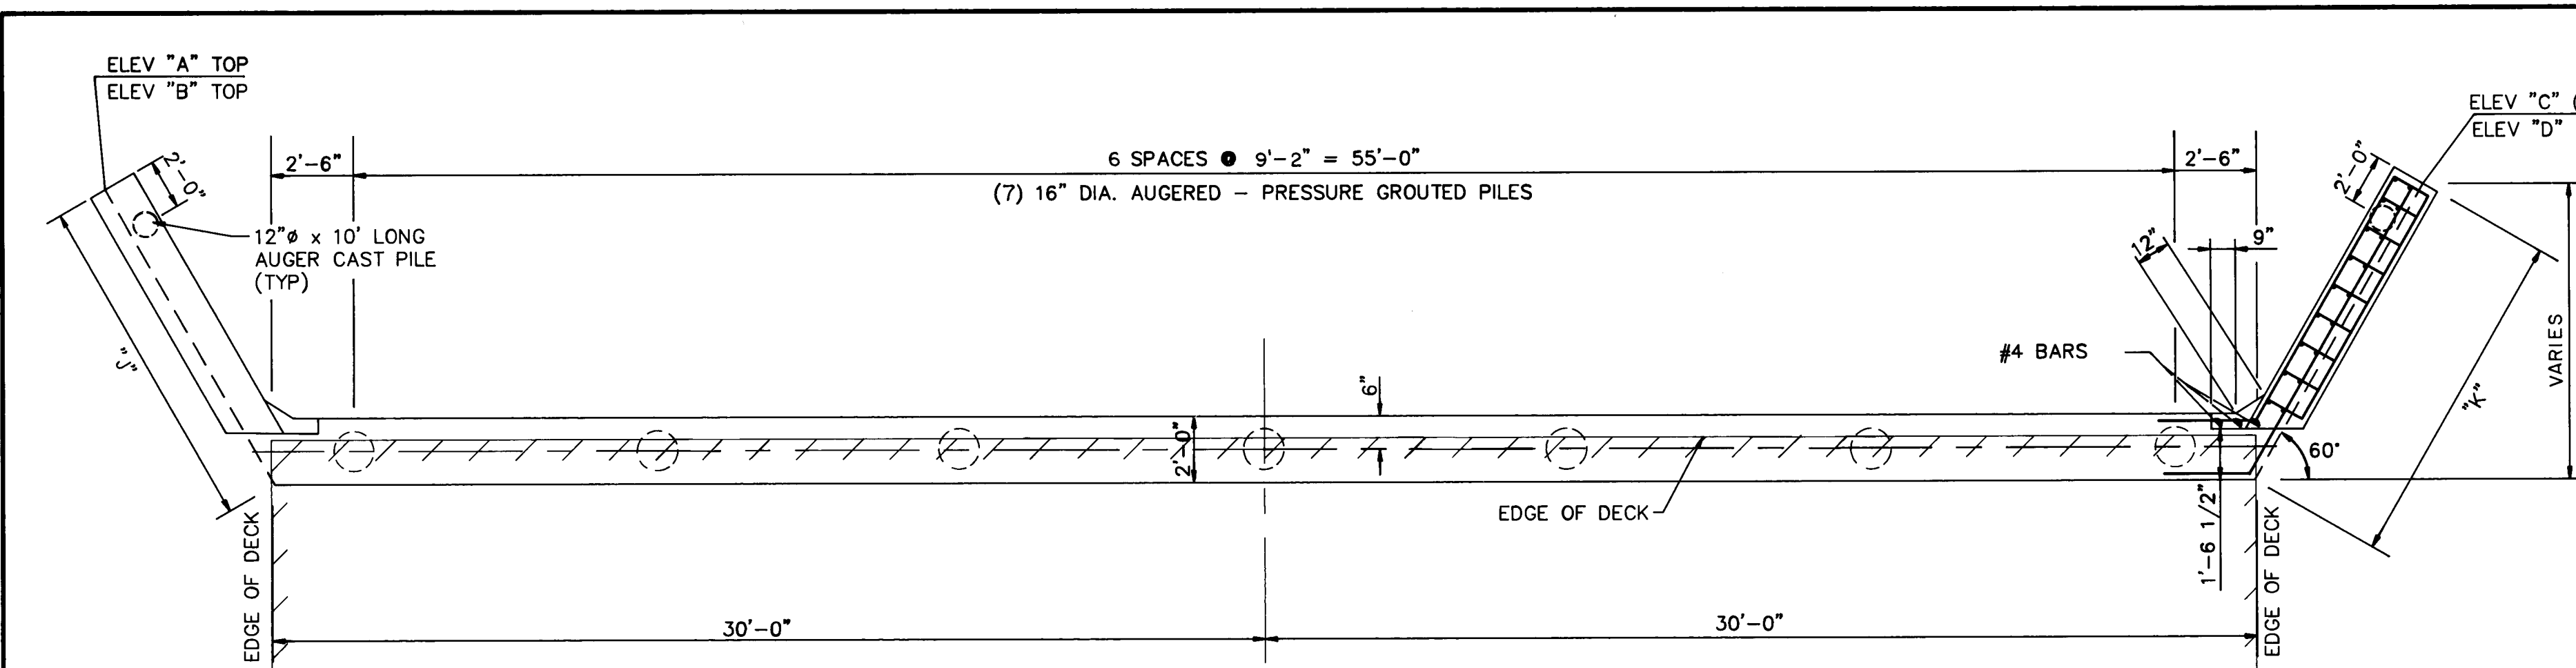

WINGWALL DIMENSIONS & ELEVATIONS

ELEVATIONS	STINSON	FRONTAGE	WESTERN
A (TW)	64.91	50.87	50.56
B (BW)	59.31	45.27	74.96
C (TW)	64.22	49.71	50.20
D (BW)	58.62	44.11	74.60
E (TW)	64.64	51.52	51.80
F (BW)	58.94	45.92	76.20
G (TW)	63.85	50.67	51.30
H (BW)	58.25	45.07	75.70


DIMENSIONS	J	K	L	M
J	15'-3"	13'-9"	13'-9"	
K	17'-9"	13'-9"	16'-9"	
L	10'-0"	16'-0"	13'-0"	
M	10'-0"	13'-0"	13'-0"	

TW = TOP OF WALL, BW = BOTTOM OF WALL

BAR BENDING DIAGRAMS

NOTE: ALL RADII=1/2" UNLESS OTHERWISE NOTED.

NO.	DATE	BY
1	6/7/90	GREINER
2	7/6/90	GREINER
3	12/90	GREINER
4	12/90	GREINER
5	1/91	GREINER
6	9/10/91	GREINER

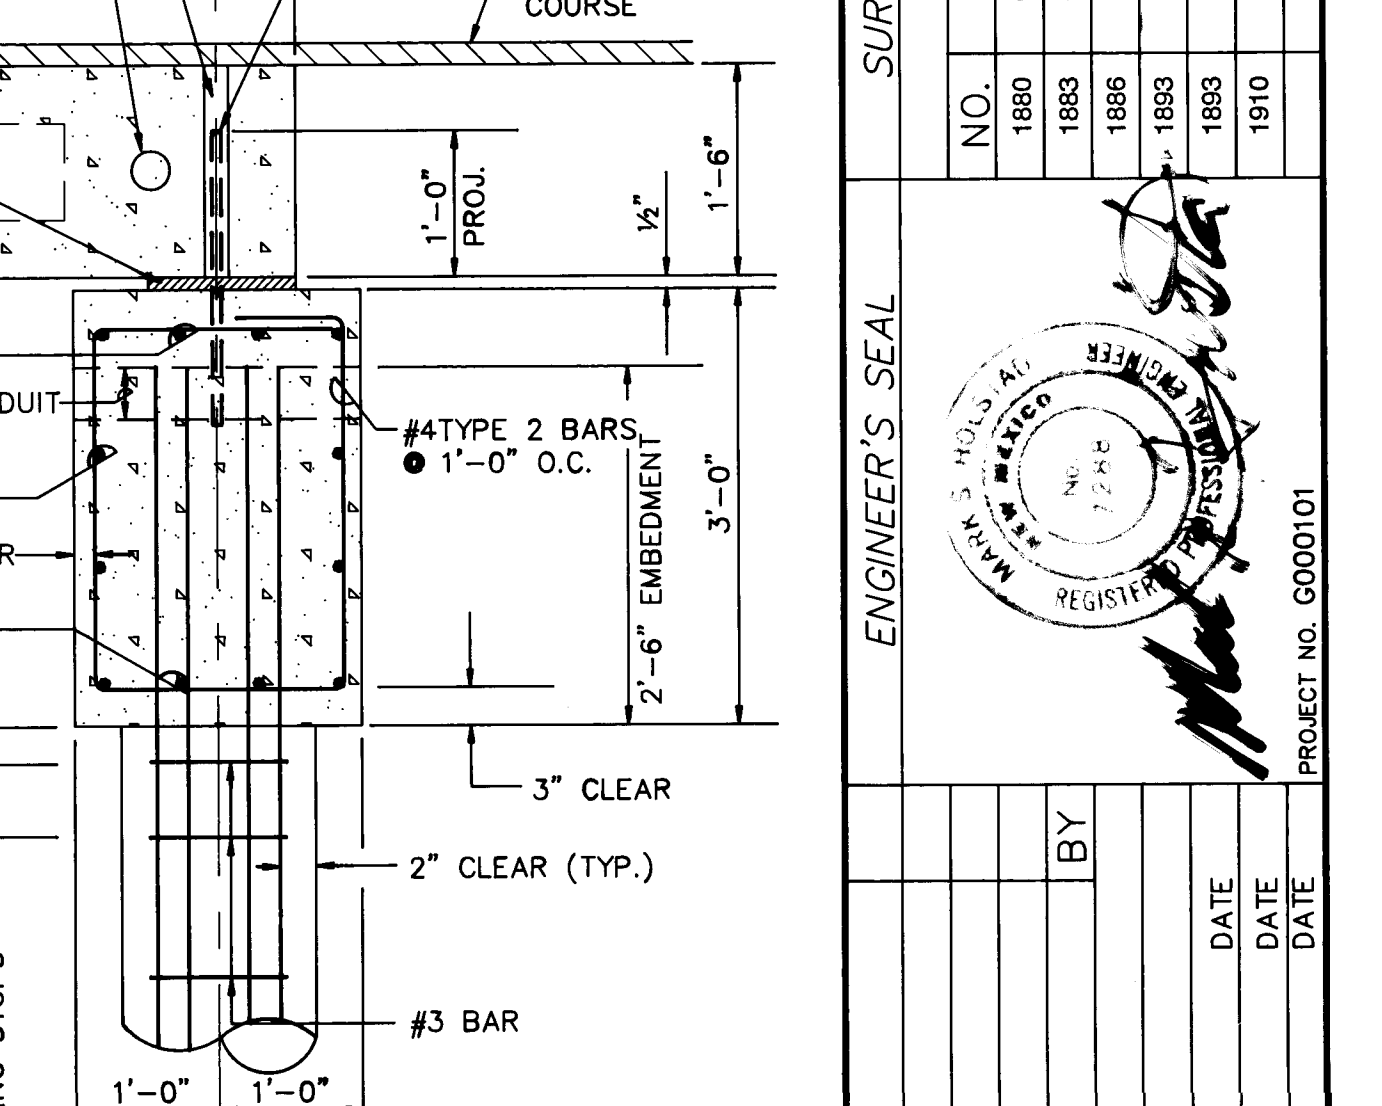

AS BUILT INFORMATION

CONTRACTOR: MOORE & CONWAT

DATE: 1992

WORKED BY: WALKER

DATE: 1992

INSPECTOR: C. FERGUSON

DATE: 1992

ACCEPTANCE BY: C.O.A. PW

DATE: 1992

VERIFICATION BY: WALKER

DATE: 1992

DRAWINGS BY: WALKER

DATE: 1992

COORDINATOR: WALKER

DATE: 1992

RECORDED BY: J.C.75/M.O.

DATE: 1992

APPROVALS

ENGINEER	DATE	APPROVALS	ENGINEER	DATE
DRC Chairman	10-23-91	Water	N/A	
Transportation	10-01-91	Waste Water	N/A	
Hydrology	9/24/91			

DRAWING NO. 4076.90

MAP NO. L-10

SHEET 28 OF 35

RECORD DRAWING



SPEED LIMIT (M.P.H.)	TAPER LENGTH (FEET)			MAXIMUM DISTANCE BETWEEN DEVICES (FEET)	MINIMUM NUMBER OF DEVICES REQUIRED
	10 FOOT LANE	11 FOOT LANE	12 FOOT LANE		
25	104	115	125	25	6
30	150	165	185	30	7
35	204	225	245	35	8
40	267	293	320	40	9
45	450	495	540	45	13
50	500	550	600	50	13
55	550	605	660	55	13

ENGINEER'S SEAL			SURVEY INFORMATION		BENCH MARKS		AS BUILT INFORMATION	
NO	DATE	REMARKS	BY	FIELD NOTES	DATE	BY	WALKER DATE	WALKER DATE
1880			GREINER	ACS 10-L-9 ALUMINUM CAP SET IN CONCRETE CURB ON THE NORTHEASTERLY TURN ISLAND IN THE INTERSECTION OF 98TH STREET AND CENTRAL AVENUE.	6-7/90	C. PEDERZELLI	1982	1982
1883			GREINER	N = 1,492,065.203 E = 952,792.376	7-8/90		9-92	9-92
1886			GREINER	ELEV = 5204.425	12/90		9-92	9-92
1883			GREINER		12/90		9-92	9-92
1910			GREINER		9-10/91		9-92	9-92

DESIGNED BY *MSH*
 DRAWN BY *AH*

SCANNED BY
BY LASON

26 4076.902993

CITY OF ALBUQUERQUE PUBLIC WORKS DEPARTMENT ENGINEERING GROUP	
TITLE:	AMOLE DEL NORTE STORM DIVERSION FACILITIES - PHASE IIIA TIERRA BAYITA DRAINAGE FACILITIES

TRAFFIC CONTROL PLAN

APPROVALS	ENGINEER	DATE	APPROVALS	ENGINEER	DATE
D.R.C. Chair			Water	<i>H. J. Lee</i>	10-1-91
Trans. Dev	<i>R. J. Davis</i>	10-9-91	Wastewater	<i>H. J. Lee</i>	"
Hydrology	<i>H. J. Lee</i>				


DRAWING NO.	4076.90	MAP NO.	L-10	SHEET	29	OF	35
-------------	---------	---------	------	-------	----	----	----

RECORD DRAWING

FINAL SURVEY	SURVEYED	BY	DATE
NOTE BOOK	PLOTTED		
NO.	DATE		
AREAS CHECKED			

ORIGINAL SURVEY	SURVEYED	BY	DATE
NOTE BOOK	PLOTTED		
NO.	DATE		
AREAS CHECKED			


F.H.W.A. REGION NO.	STATE	PROJ. NO.	SHEET NO.	TOTAL SHEETS
6	NEW MEXICO			

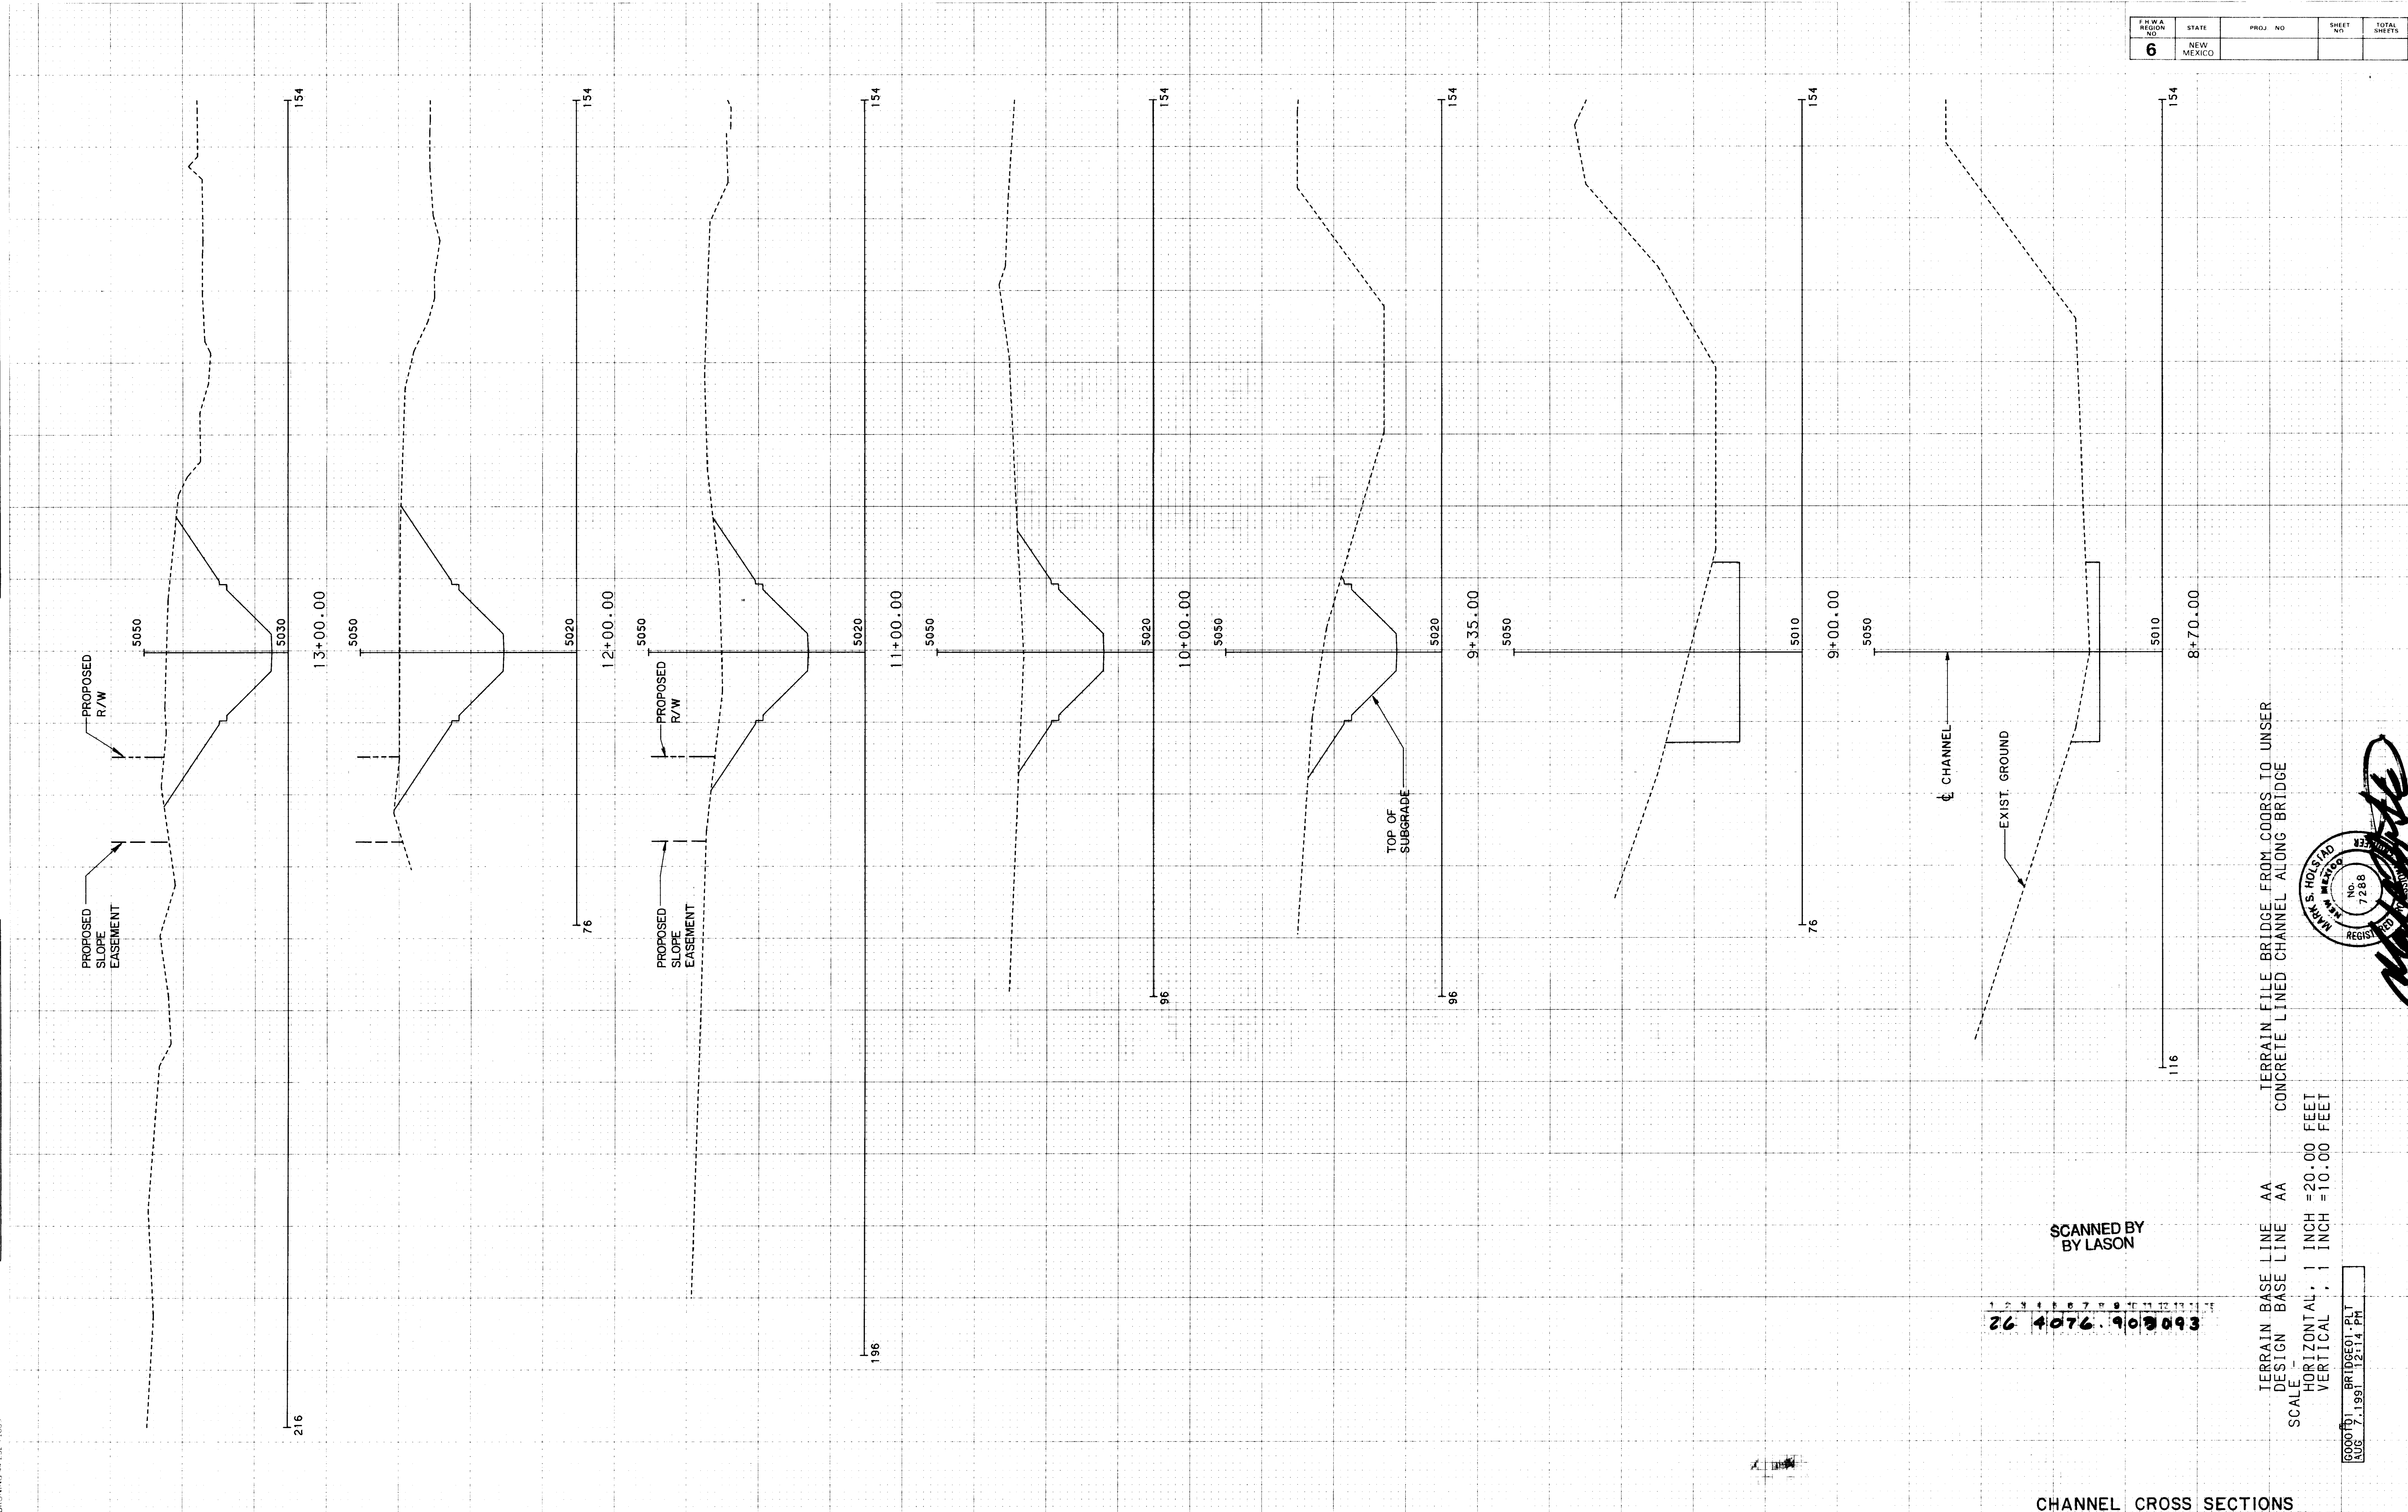

TERRAIN FILE BRIDGE FROM COORS TO UNSER
DESIGN BASE LINE AA
CONCRETE LINED CHANNEL ALONG BRIDGE

SCALE -
HORIZONTAL, 1 INCH = 20.00 FEET
VERTICAL, 1 INCH = 10.00 FEET

BRIDGE 01 PLT
008 7.1.1981 12.114 TH

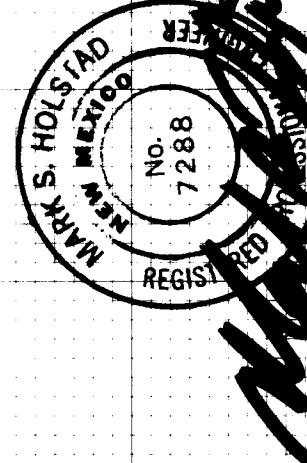


SCANNED BY LASON

26 4076.90 3093

CHANNEL CROSS SECTIONS
RECORD DRAWING

ORIGINAL SURVEY	SURVEYED _____	BY _____	DATE _____
	PLOTTED _____		
NOTE BOOK	TEMPLATE _____		
NO. _____	AREAS CHECKED _____		

BRUNING 44-232 71609

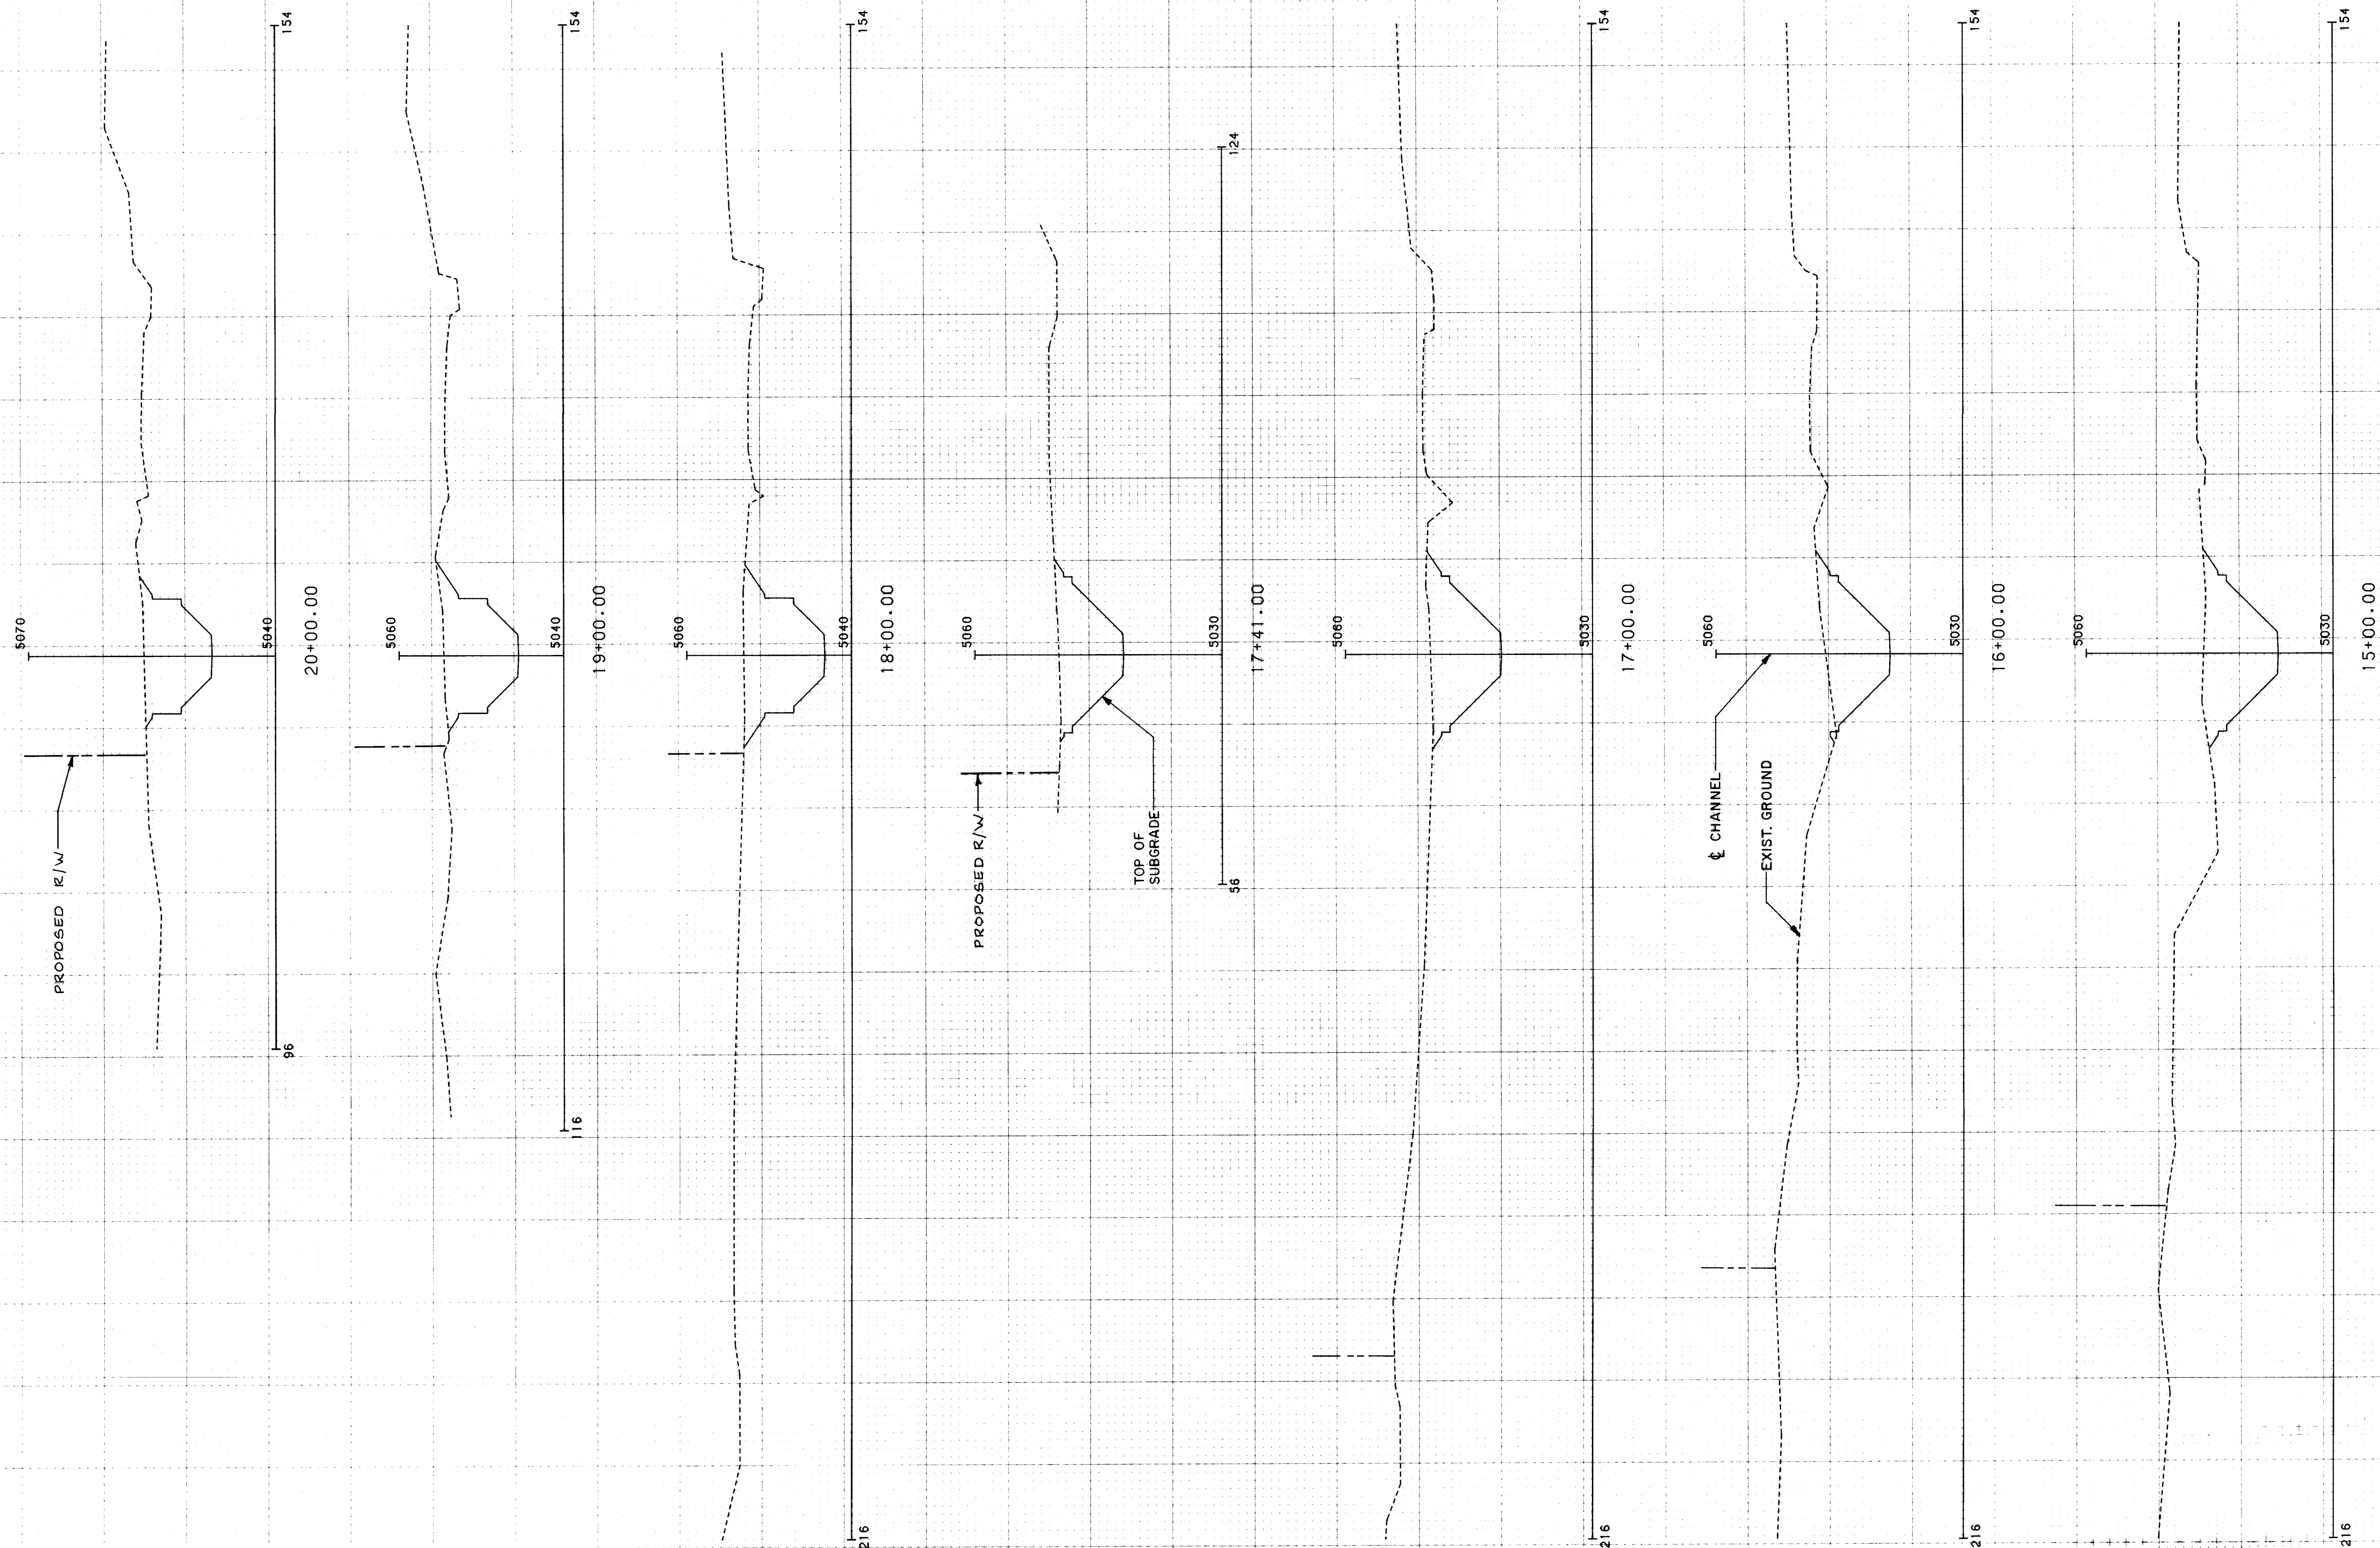

F.H.W.A REGION NO	STATE	PROJ. NO	SHEET NO	TOTAL SHEETS
6	NEW MEXICO			

SCANNED BY
BY LASON

26 4076.903193

CHANNEL CROSS SECTIONS RECORD DRAWING

PROJECT NO. **4076.90** SHEET NO. **31 of 35**

TERRAIN BASE LINE AA TERRAIN FILE BRIDGE FROM COORS TO UNSER
DESIGN BASE LINE AA CONCRETE LINED CHANNEL ALONG BRIDGE


SCALE -

HORIZONTAL 1 INCH = 20.00 FEET
VERTICAL 1 INCH = 10.00 FEET

45.400.0

LEVEL	DESCRIPTION	INCH	FEET
HORIZONTAL	1	INCH	=20.00 FEET
VERTICAL	1	INCH	=10.00 FEET

000001 BRIDGE02.PLT
AUG 5 1991 1:01 PM

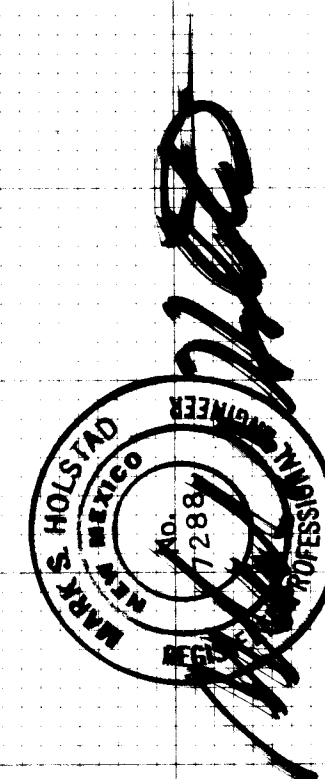

ORIGINAL SURVEY	BY _____	DATE _____
NOTED	SURVEYED _____	
	PLOTTED _____	
	TEMPLATE _____	
	AREAS _____	

TERRAIN BASE LINE	AA	TERRAIN FILE BRIDGE FROM COORS TO UNSER
DESIGN BASE LINE	AA	CONCRETE LINED CHANNEL ALONG BRIDGE

SCALE -
HORIZONTAL, 1 INCH = 20.00 FEET
VERTICAL, 1 INCH = 10.00 FEET

000001 BRIDGE03.PLT
AUG 5, 1991 2:40 PM

CHANNEL CROSS SECTIONS RECORD DRAWING


PROJECT NO. **4076.90** SHEET NO. **32 of 35**

SCANNED BY
BY LASON

26 4076.903293

ORIGINAL	SURVEYED	BY	DATE
NO.	NO.		
NO.	NO.		
NO.	NO.		
NO.	NO.		

FINAL	SURVEYED	BY	DATE
NO.	NO.		
NO.	NO.		
NO.	NO.		
NO.	NO.		

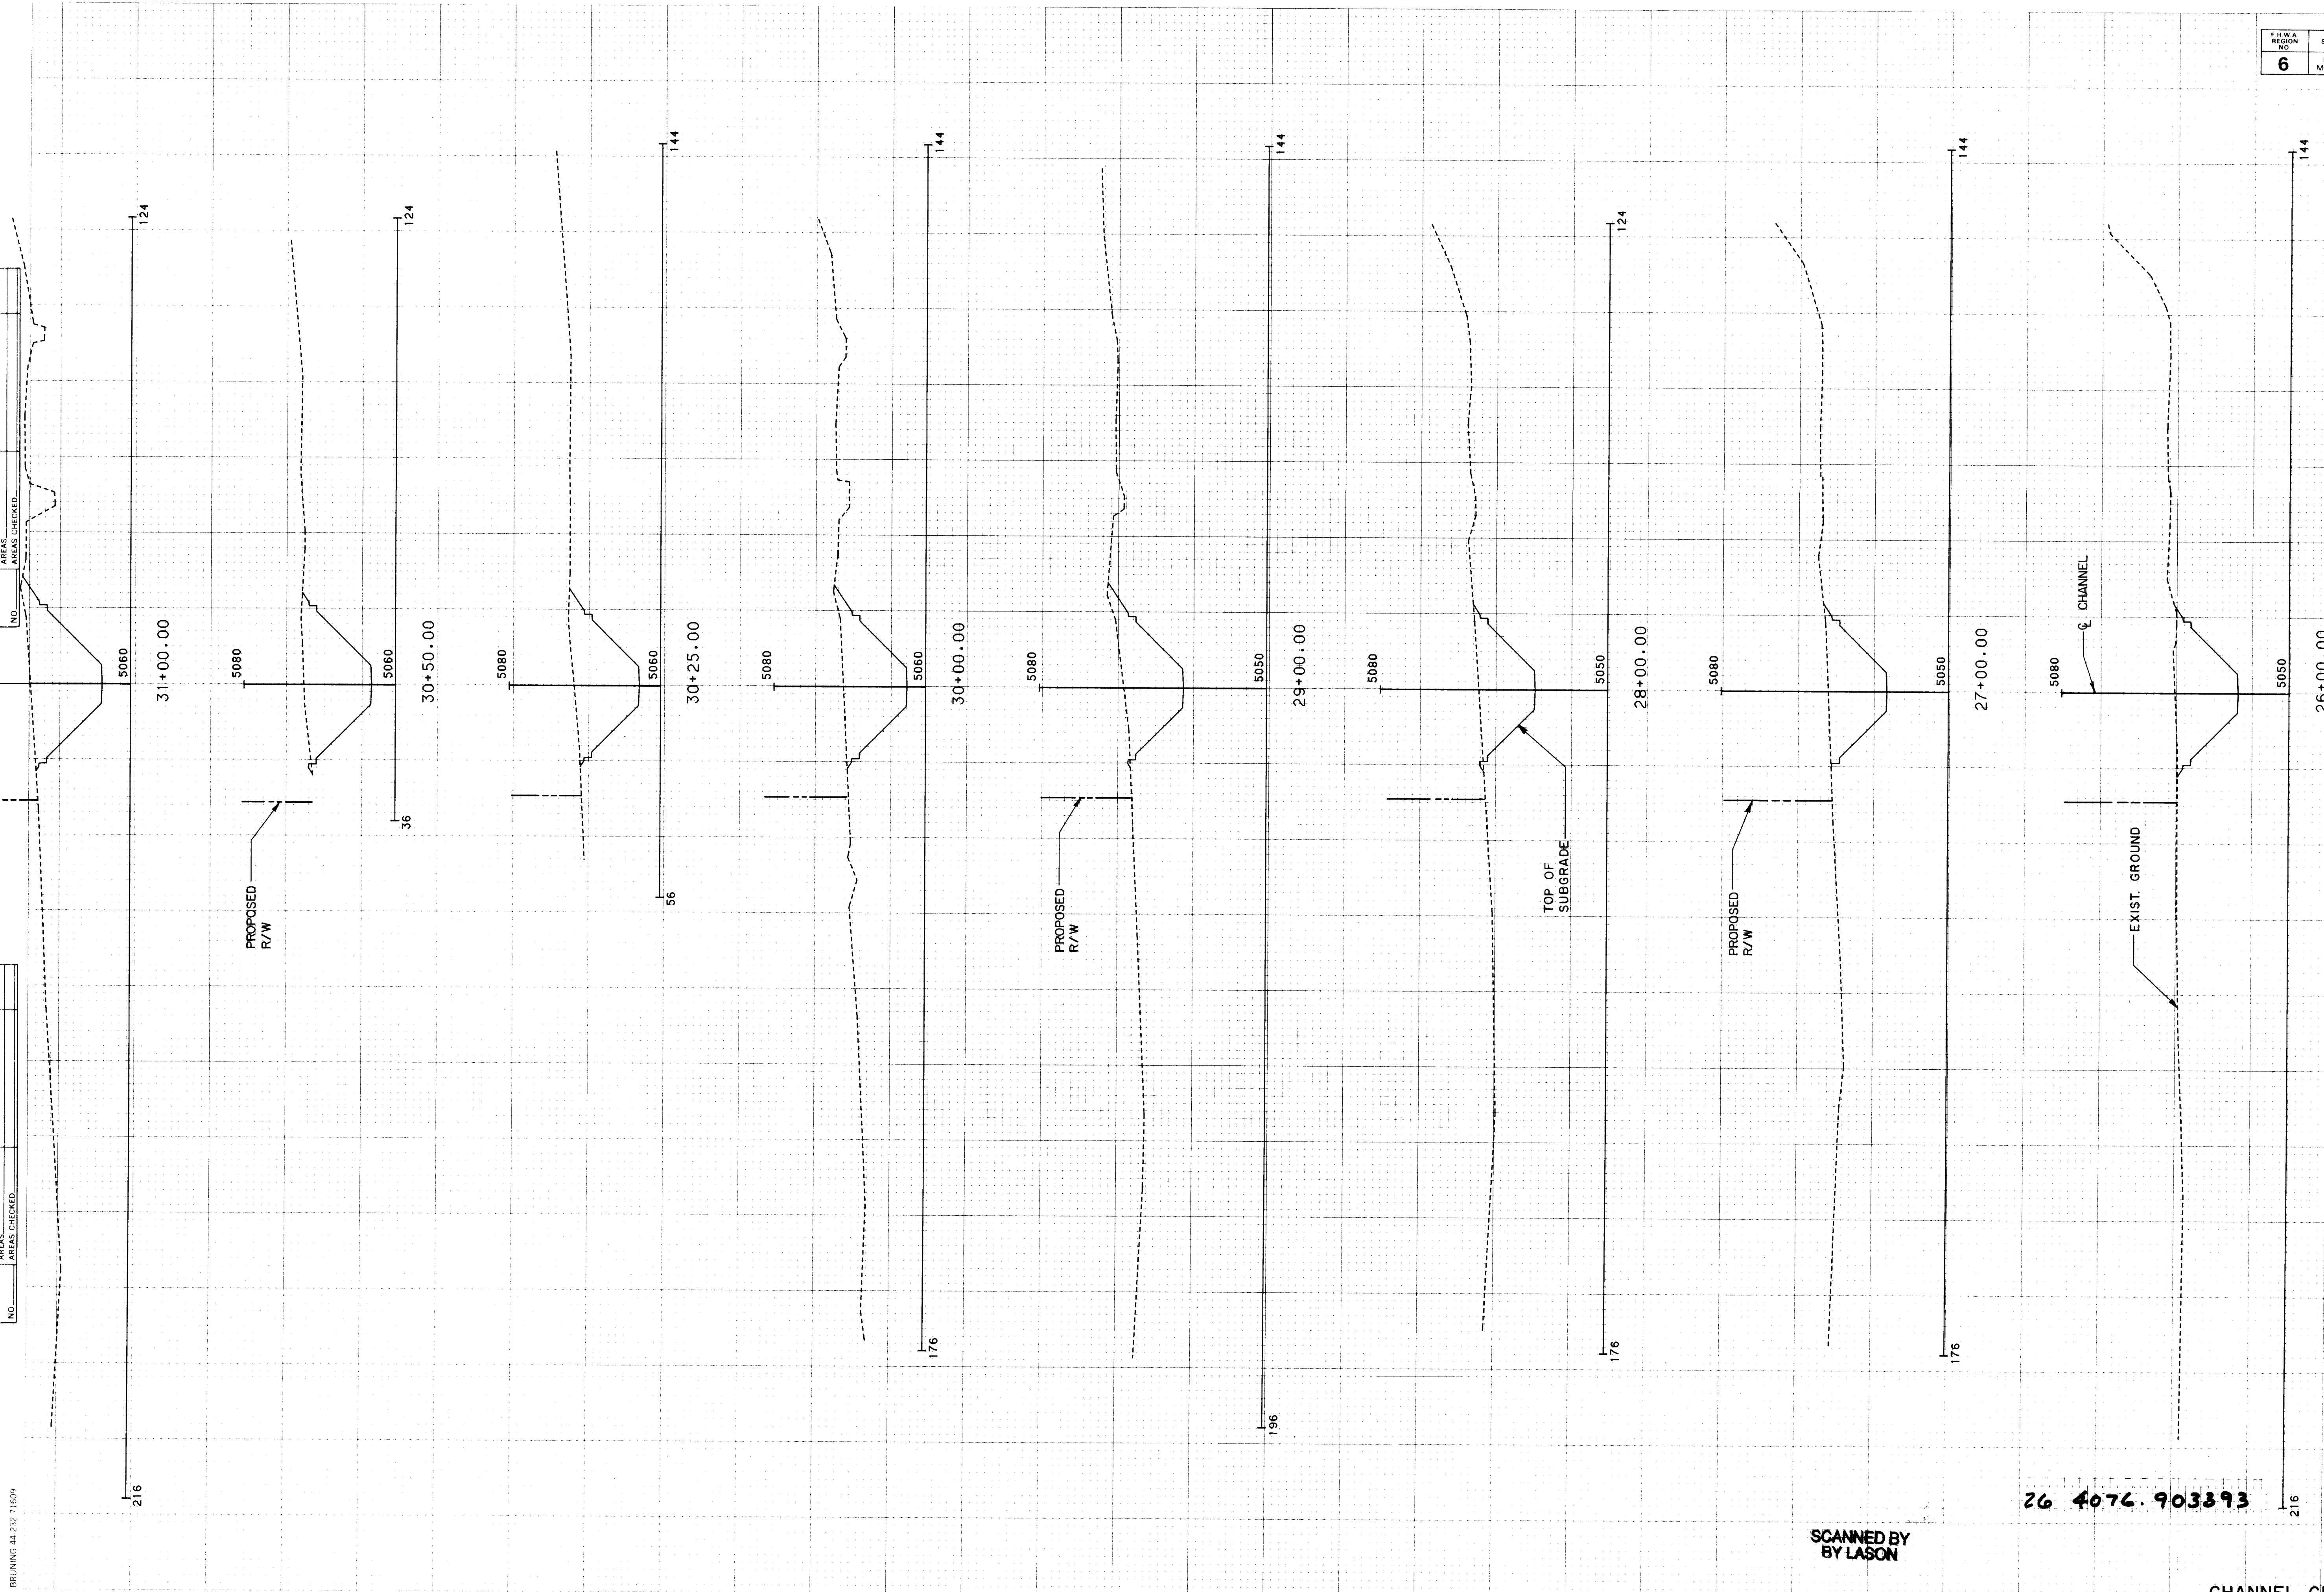

SCANNED BY
BY LASON

26 4076.903393


CHANNEL CROSS SECTIONS
RECORD DRAWING

PROJECT NO. 4076.90 SHEET NO. 33 of 35

TERRAIN BASE LINE AA TERRAIN FILE BRIDGE FROM COORS TO UNSER
DESIGN BASE LINE AA CONCRETE LINED CHANNEL ALONG BRIDGE

SCALE
HORIZONTAL, 1 INCH = 20.00 FEET
VERTICAL, 1 INCH = 10.00 FEET

6000 P11 BRIDGE04.PLT
AUG 5.1991 2:31 PM

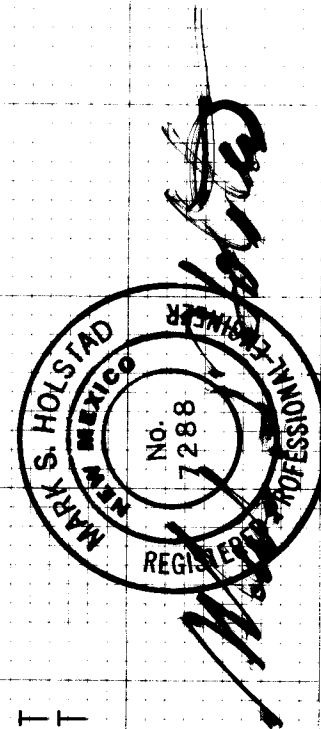


F.H.W.A. REGION NO.	STATE	PROJ. NO.	SHEET NO.	TOTAL SHEETS
6	NEW MEXICO			

FINAL	SURVEYED	BY	DATE
SURVEY	PLOTTED		
NOTE BOOK	AREAS		
NO.	AREAS CHECKED		

ORIGINAL	SURVEYED	BY	DATE
SURVEY	PLOTTED		
NOTE BOOK	AREAS		
NO.	AREAS CHECKED		


F.H.W.A. REGION NO.	STATE	PROJ. NO.	SHEET NO.	TOTAL SHEETS
6	NEW MEXICO			

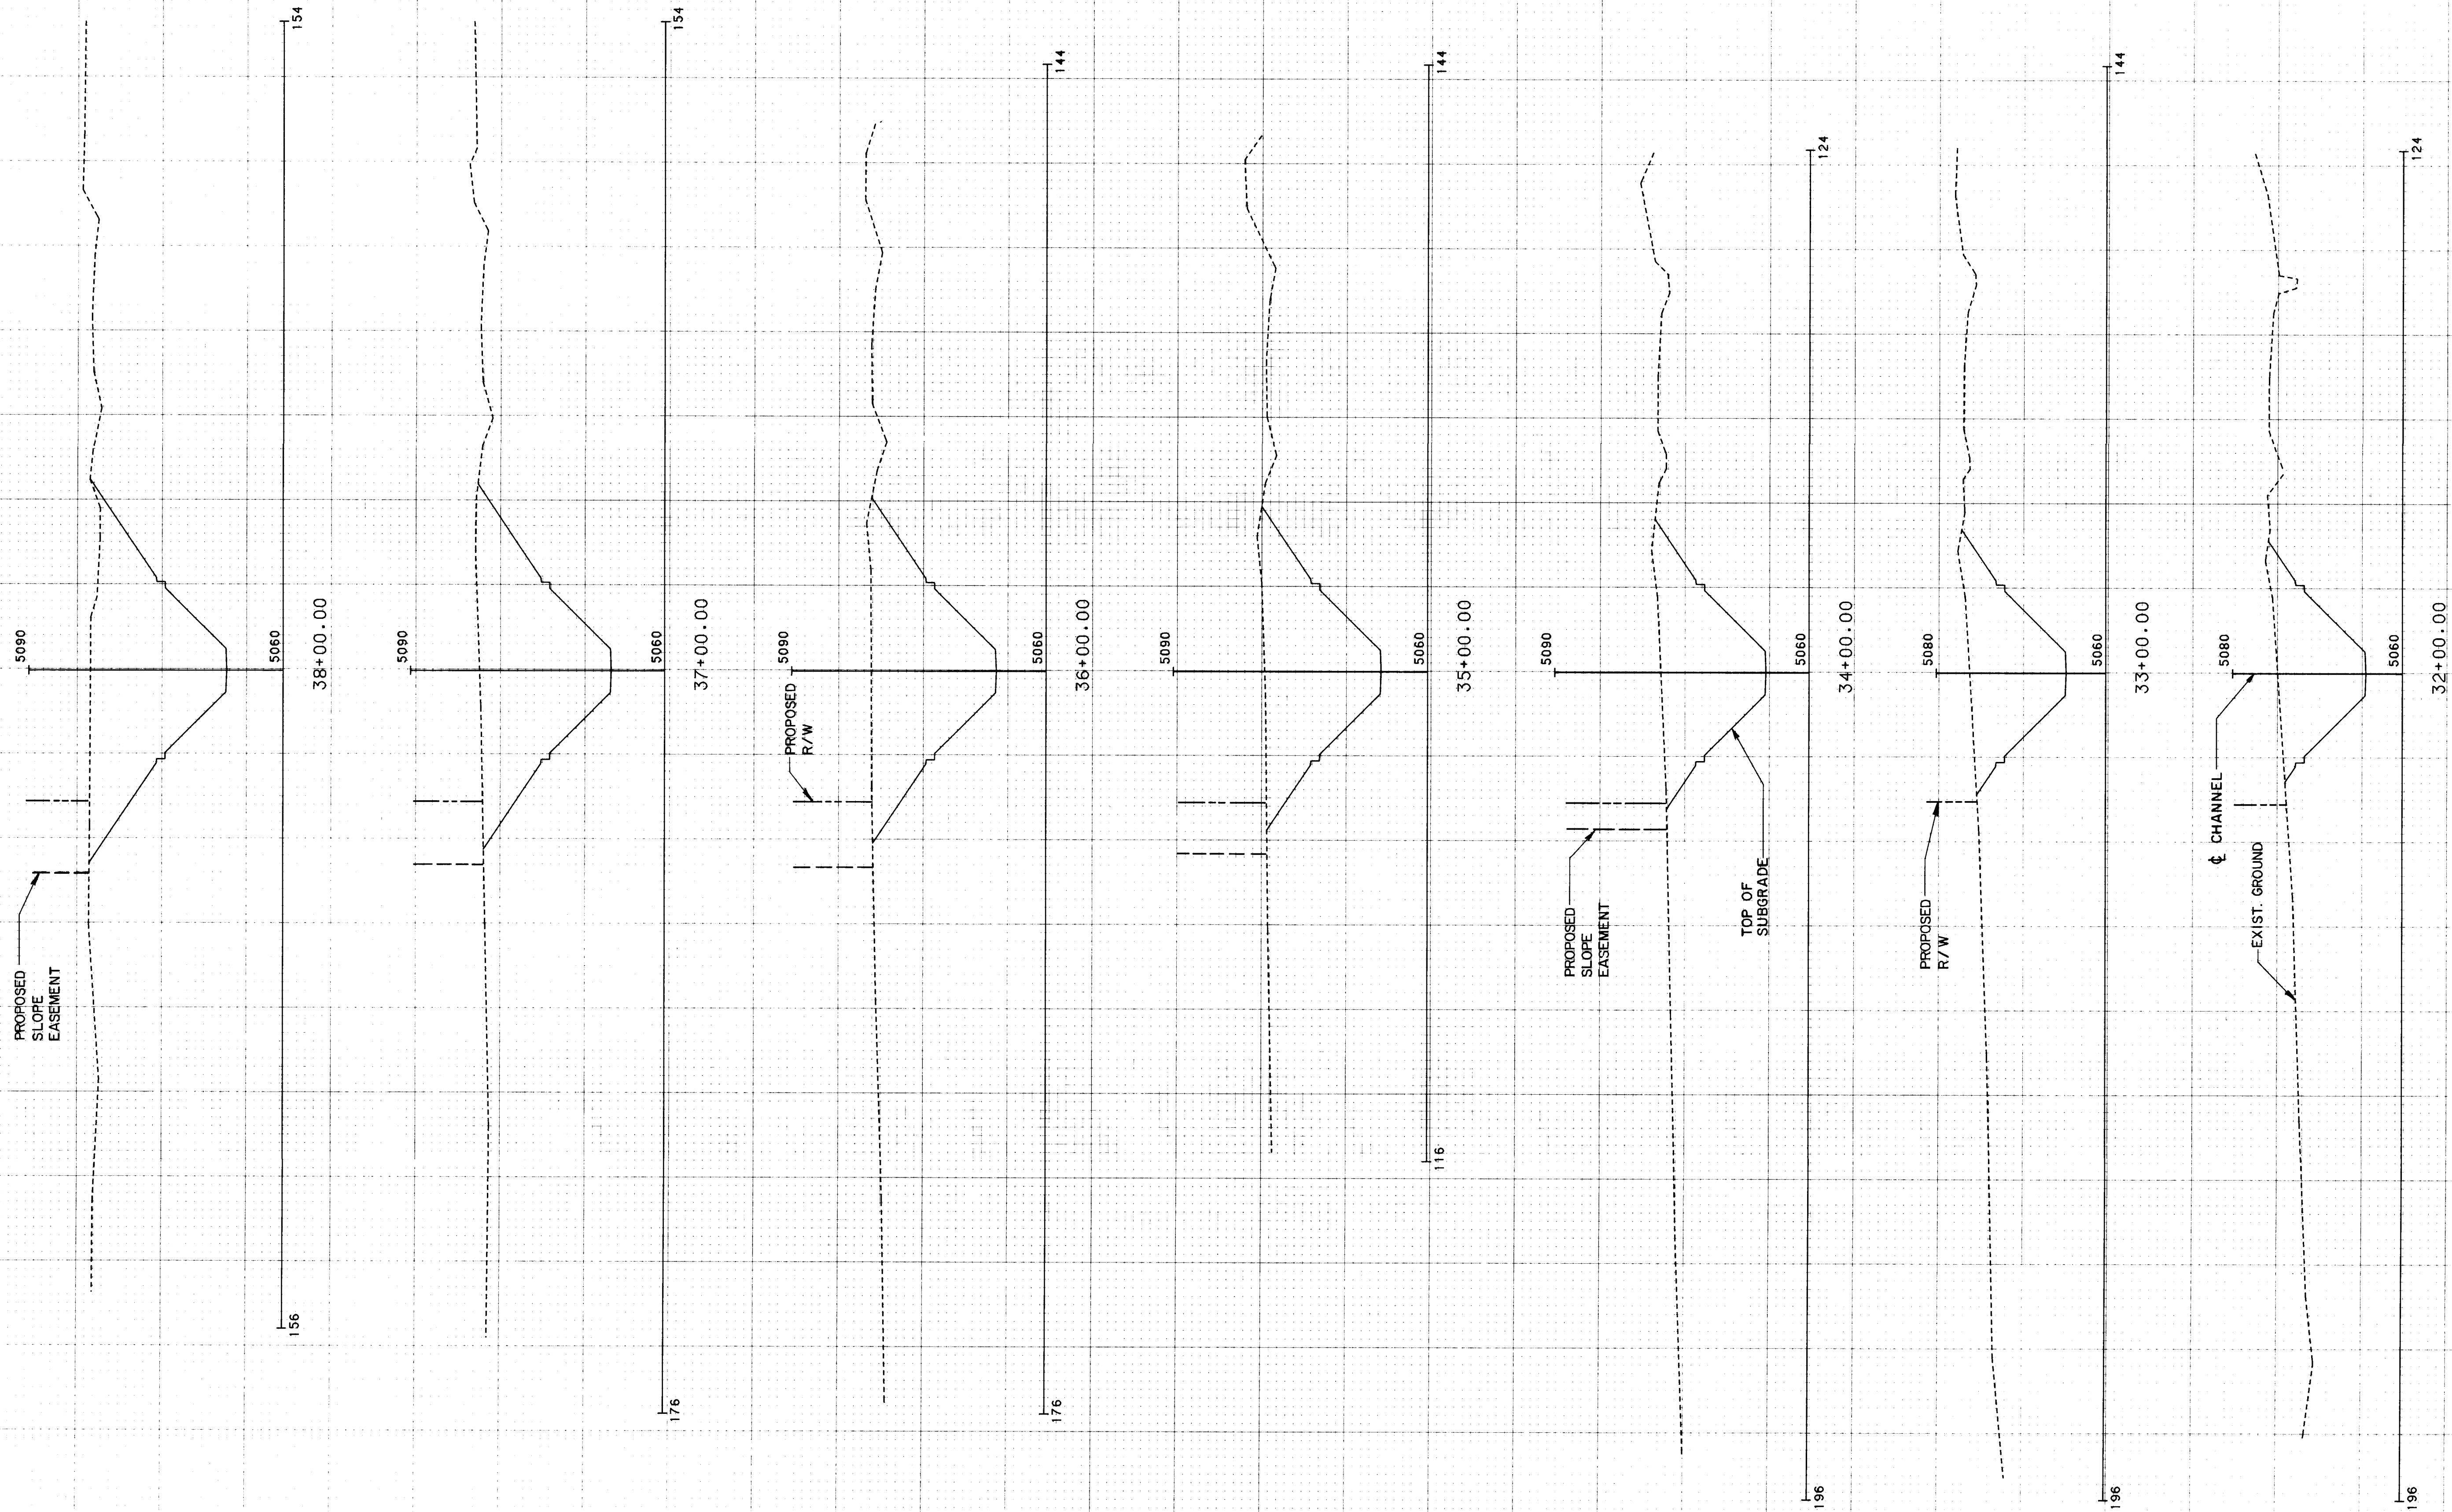

TERRAIN BASE LINE AA TERRAIN FILE BRIDGE FROM COORS TO UNSER
DESIGN BASE LINE AA CONCRETE LINED CHANNEL ALONG BRIDGE

SCALE
HORIZONTAL, 1 INCH = 20.00 FEET
VERTICAL, 1 INCH = 10.00 FEET

6010 P11 BRIDGE05 P11
AUG 5, 1991 2:22 PM

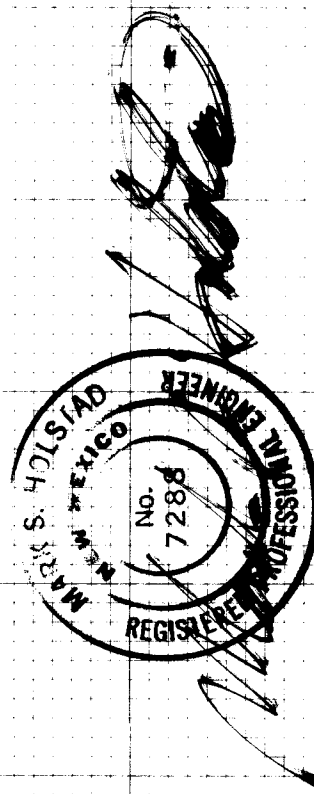

SCANNED BY
BY LASON

26 4076.903493


CHANNEL CROSS SECTIONS
RECORD DRAWING

PROJECT NO. 4076.90 SHEET NO. 34 of 35

ORIGINAL SURVEY	SURVEYED	BY	DATE
NOTE BOOK	PLOTTED		
NO.	AREA		
	AREAS CHECKED		

FINAL SURVEY	SURVEYED	BY	DATE
NOTE BOOK	PLOTTED		
NO.	AREA		
	AREAS CHECKED		

F.H.W.A. REGION NO.	STATE	PROJ. NO.	SHEET NO.	TOTAL SHEETS
6	NEW MEXICO			

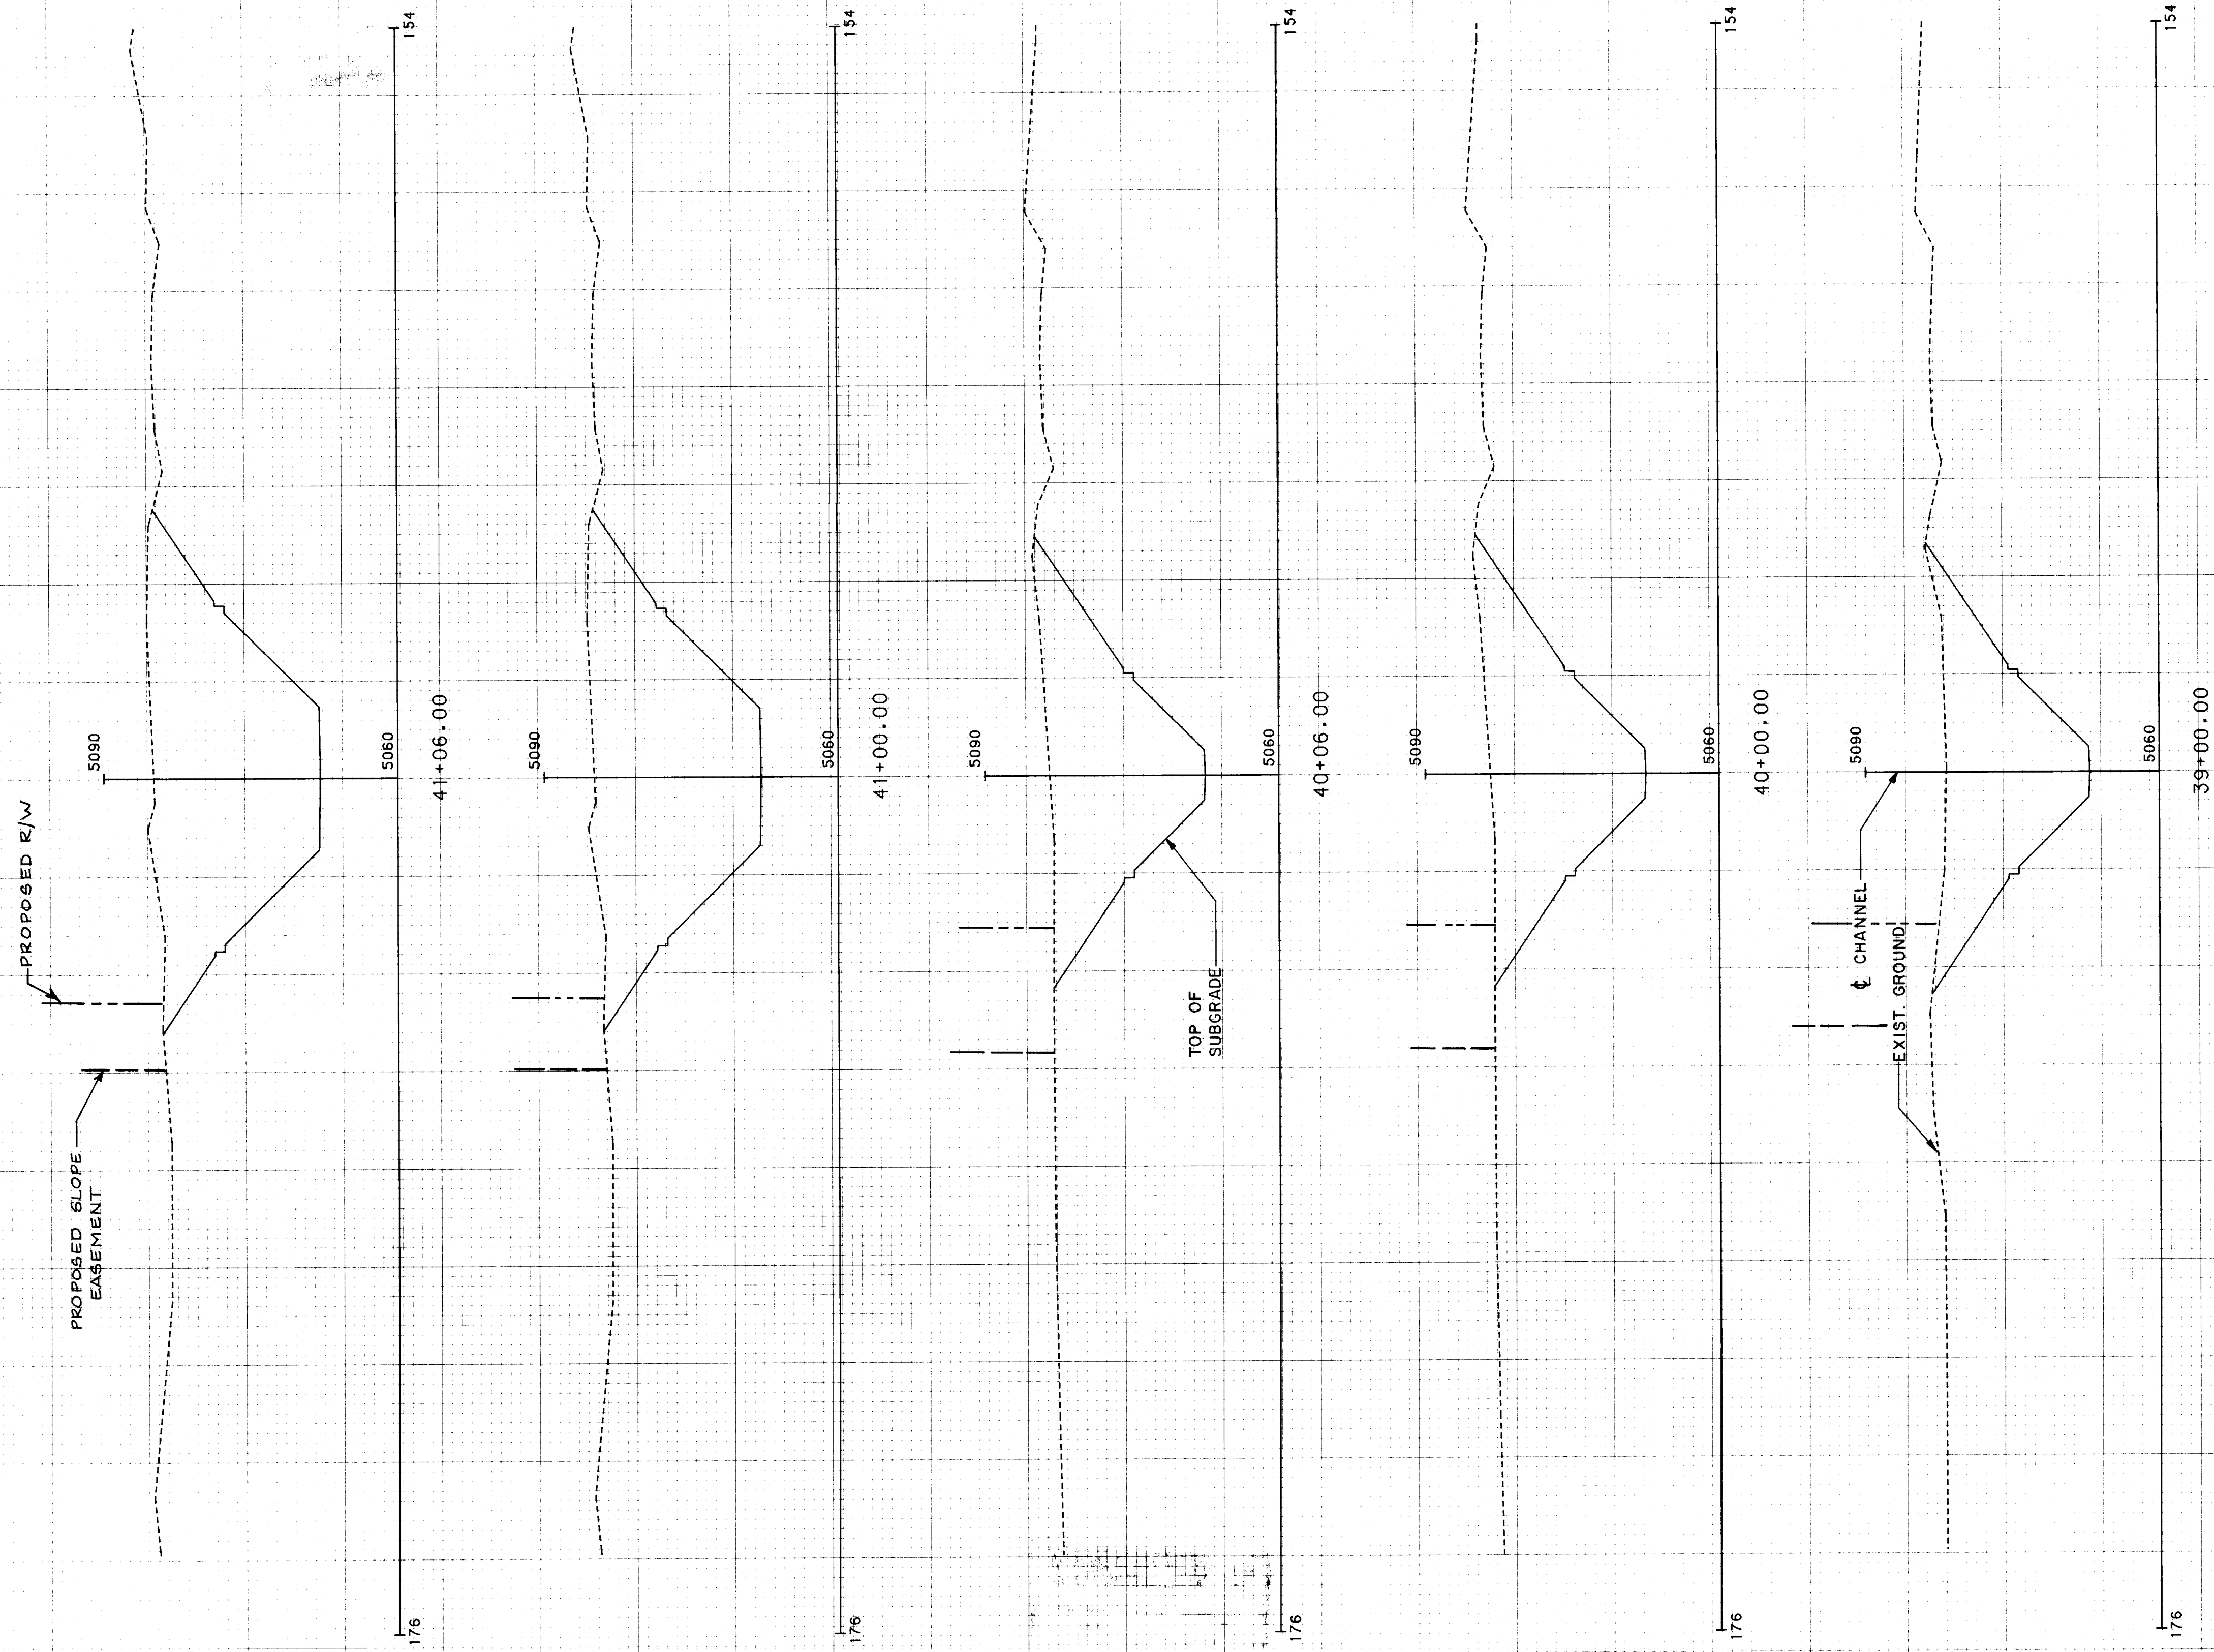

SCANNED BY
BY LASON

26 4076.903593

TERRAIN FILE BRIDGE FROM COORS TO UNSER
DESIGN BASE LINE AA
CONCRETE LINED CHANNEL ALONG BRIDGE

SCALE -
HORIZONTAL, 1 INCH = 20.00 FEET
VERTICAL, 1 INCH = 10.00 FEET



5000 P11 BRIDGE06-PLT
AUG 5, 1991 2:08 PM

CHANNEL CROSS SECTIONS
RECORD DRAWING