


CORONADO CENTER UTILITY RELOCATION FOR MAY D & F EXPANSION

INDEX

SHEET NO.	DESCRIPTION
1	TITLE SHEET
2	PLAT (TO BE SUBMITTED WITH FINALS)
3-4	WATER LINE PLANS & PROFILES
5	WATER DETAILS & VALVE SHUT-OFF PLAN

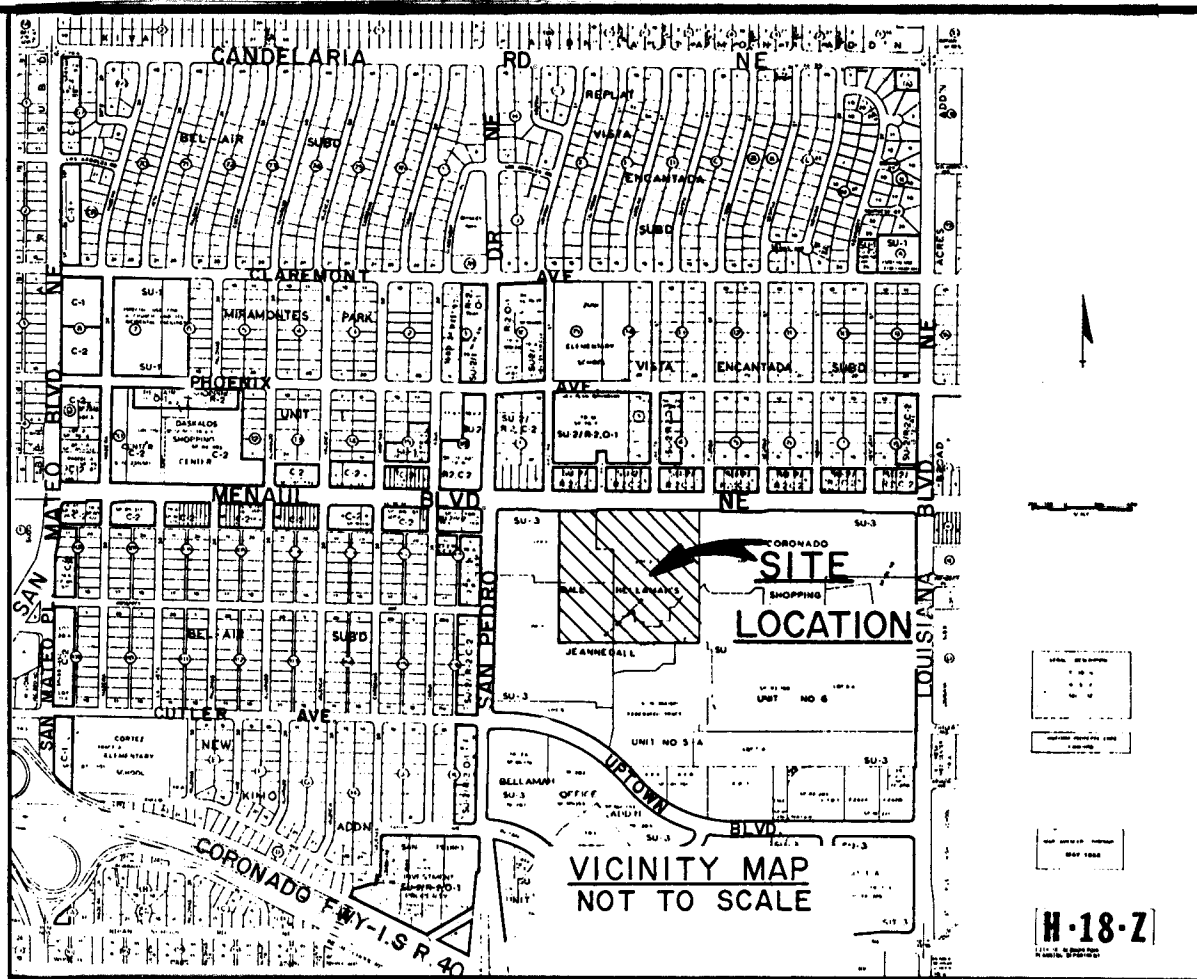

NOTICE TO CONTRACTORS

- ALL WORK DETAILED ON THESE PLANS TO BE PERFORMED UNDER CONTRACT SHALL, EXCEPT AS OTHERWISE STATED OR PROVIDED FOR HEREON, BE CONSTRUCTED IN ACCORDANCE WITH THE CITY OF ALBUQUERQUE STANDARD SPECIFICATIONS FOR PUBLIC WORKS CONSTRUCTION, LATEST EDITION.
- TWO WORKING DAYS PRIOR TO ANY EXCAVATION, THE CONTRACTOR MUST CONTACT NEW MEXICO ONE CALL SYSTEM (260-1990) FOR LOCATION OF EXISTING UTILITIES.
- PRIOR TO CONSTRUCTION, THE CONTRACTOR SHALL EXCAVATE AND VERIFY THE HORIZONTAL AND VERTICAL LOCATIONS OF ALL OBSTRUCTIONS. SHOULD A CONFLICT EXIST, THE CONTRACTOR SHALL NOTIFY THE ENGINEER OR SURVEYOR IMMEDIATELY SO THAT THE CONFLICT CAN BE RESOLVED WITH A MINIMUM AMOUNT OF DELAY.
- THREE (3) WORKING DAYS PRIOR TO BEGINNING CONSTRUCTION, THE CONTRACTOR SHALL SUBMIT TO CONSTRUCTION COORDINATION DIVISION A DETAILED CONSTRUCTION SCHEDULE. TWO (2) WORKING DAYS PRIOR TO CONSTRUCTION, THE CONTRACTOR SHALL OBTAIN A BARRICADING PERMIT FROM THE CONST. COORDINATION DIVISION. CONTRACTOR SHALL NOTIFY BARRICADE ENGINEER (768-2551) PRIOR TO OCCUPYING AN INTERSECTION.
- CONTRACTOR SHALL NOTIFY THE ENGINEER NOT LESS THAN SEVEN (7) DAYS PRIOR TO STARTING WORK IN ORDER THAT THE ENGINEER MAY TAKE NECESSARY MEASURES TO INSURE THE PRESERVATION OF SURVEY MONUMENTS. CONTRACTOR SHALL NOT DISTURB PERMANENT SURVEY MONUMENTS WITHOUT THE CONSENT OF THE ENGINEER AND SHALL NOTIFY THE ENGINEER AND BEAR THE EXPENSE OF REPLACING ANY THAT MAY BE DISTURBED WITHOUT PERMISSION. REPLACEMENT SHALL BE DONE ONLY BY THE ENGINEER. WHEN A CHANGE IS MADE IN THE FINISHED ELEVATIONS OF THE PAVEMENT OF ANY ROADWAY IN WHICH A PERMANENT SURVEY MONUMENT IS LOCATED, CONTRACTOR SHALL, AT HIS OWN EXPENSE, ADJUST THE MONUMENT COVER TO THE NEW GRADE UNLESS OTHERWISE SPECIFIED.

THE FOLLOWING NOTES ALSO APPLY WHEN CHECKED

- ☒ ALL UTILITIES AND UTILITY SERVICE LINES SHALL BE INSTALLED PRIOR TO PAVING.
- ☐ BACKFILL COMPACTION SHALL BE ACCORDING TO SPECIFIED STREET USE.
- ☐ JACK COAT REQUIREMENTS SHALL BE DETERMINED BY THE CITY ENGINEER.
- ☐ SIDEWALKS AND WHEELCHAIR RAMPS WITHIN THE CURB RETURNS SHALL BE CONSTRUCTED WHEREVER A NEW CURB RETURN IS CONSTRUCTED.
- ☐ IF CURB IS DEPRESSED FOR A DRIVEPAD, THE DRIVEPAD SHALL BE CONSTRUCTED PRIOR TO ACCEPTANCE OF CURB AND GUTTER.
- ☐ ALL STORM DRAINAGE FACILITIES SHALL BE COMPLETED PRIOR TO FINAL ACCEPTANCE.
- ☐ THE REQUESTOR OR DEVELOPER SHALL BE RESPONSIBLE FOR REPAIR OR REPLACEMENT OF ALL CURB AND GUTTER OR SIDEWALK DAMAGED AFTER APPROVAL BY THE CITY ENGINEER OF WORK COMPLETED BY THE CONTRACTOR.

1 2 3 4 5 6 7 8 9 10 11 12 13 14 15
20 4091.90 900192

APPROVAL OF AS BUILT DRAWINGS
CHIEF CONSTRUCTION ENGINEER
DATE 8/20/90



RECORD DRAWINGS
DATE 8/20/90

SCANNED BY
BY LASON

REV	SHEETS	CITY ENGINEER	DATE	USER	DEPT	DATE	USER	DEPT	DATE


APPROVAL OF REVISIONS

	 BOHANNAN - HUSTON INC. ALBUQUERQUE ENGINEERS PLANNERS PHOTOGRAMMETRISTS	APPROVED FOR CONSTRUCTION 7-25-90 C.E.
	PROJECT NUMBER 4091.90	SHEET 1 OF 5


PLAT OF
 LOT 2-A, UNIT 5-A
 DALE J. BELLAMAH'S JEANNEDALE
 CORONADO CENTER
 ALBUQUERQUE, BERNALILLO COUNTY, NEW MEXICO
 JUNE 1990

CITY OF ALBUQUERQUE
PUBLIC WORKS DEPT.
WATERLINE EASEMENTS

MENAU L BOULEVARD N.E.

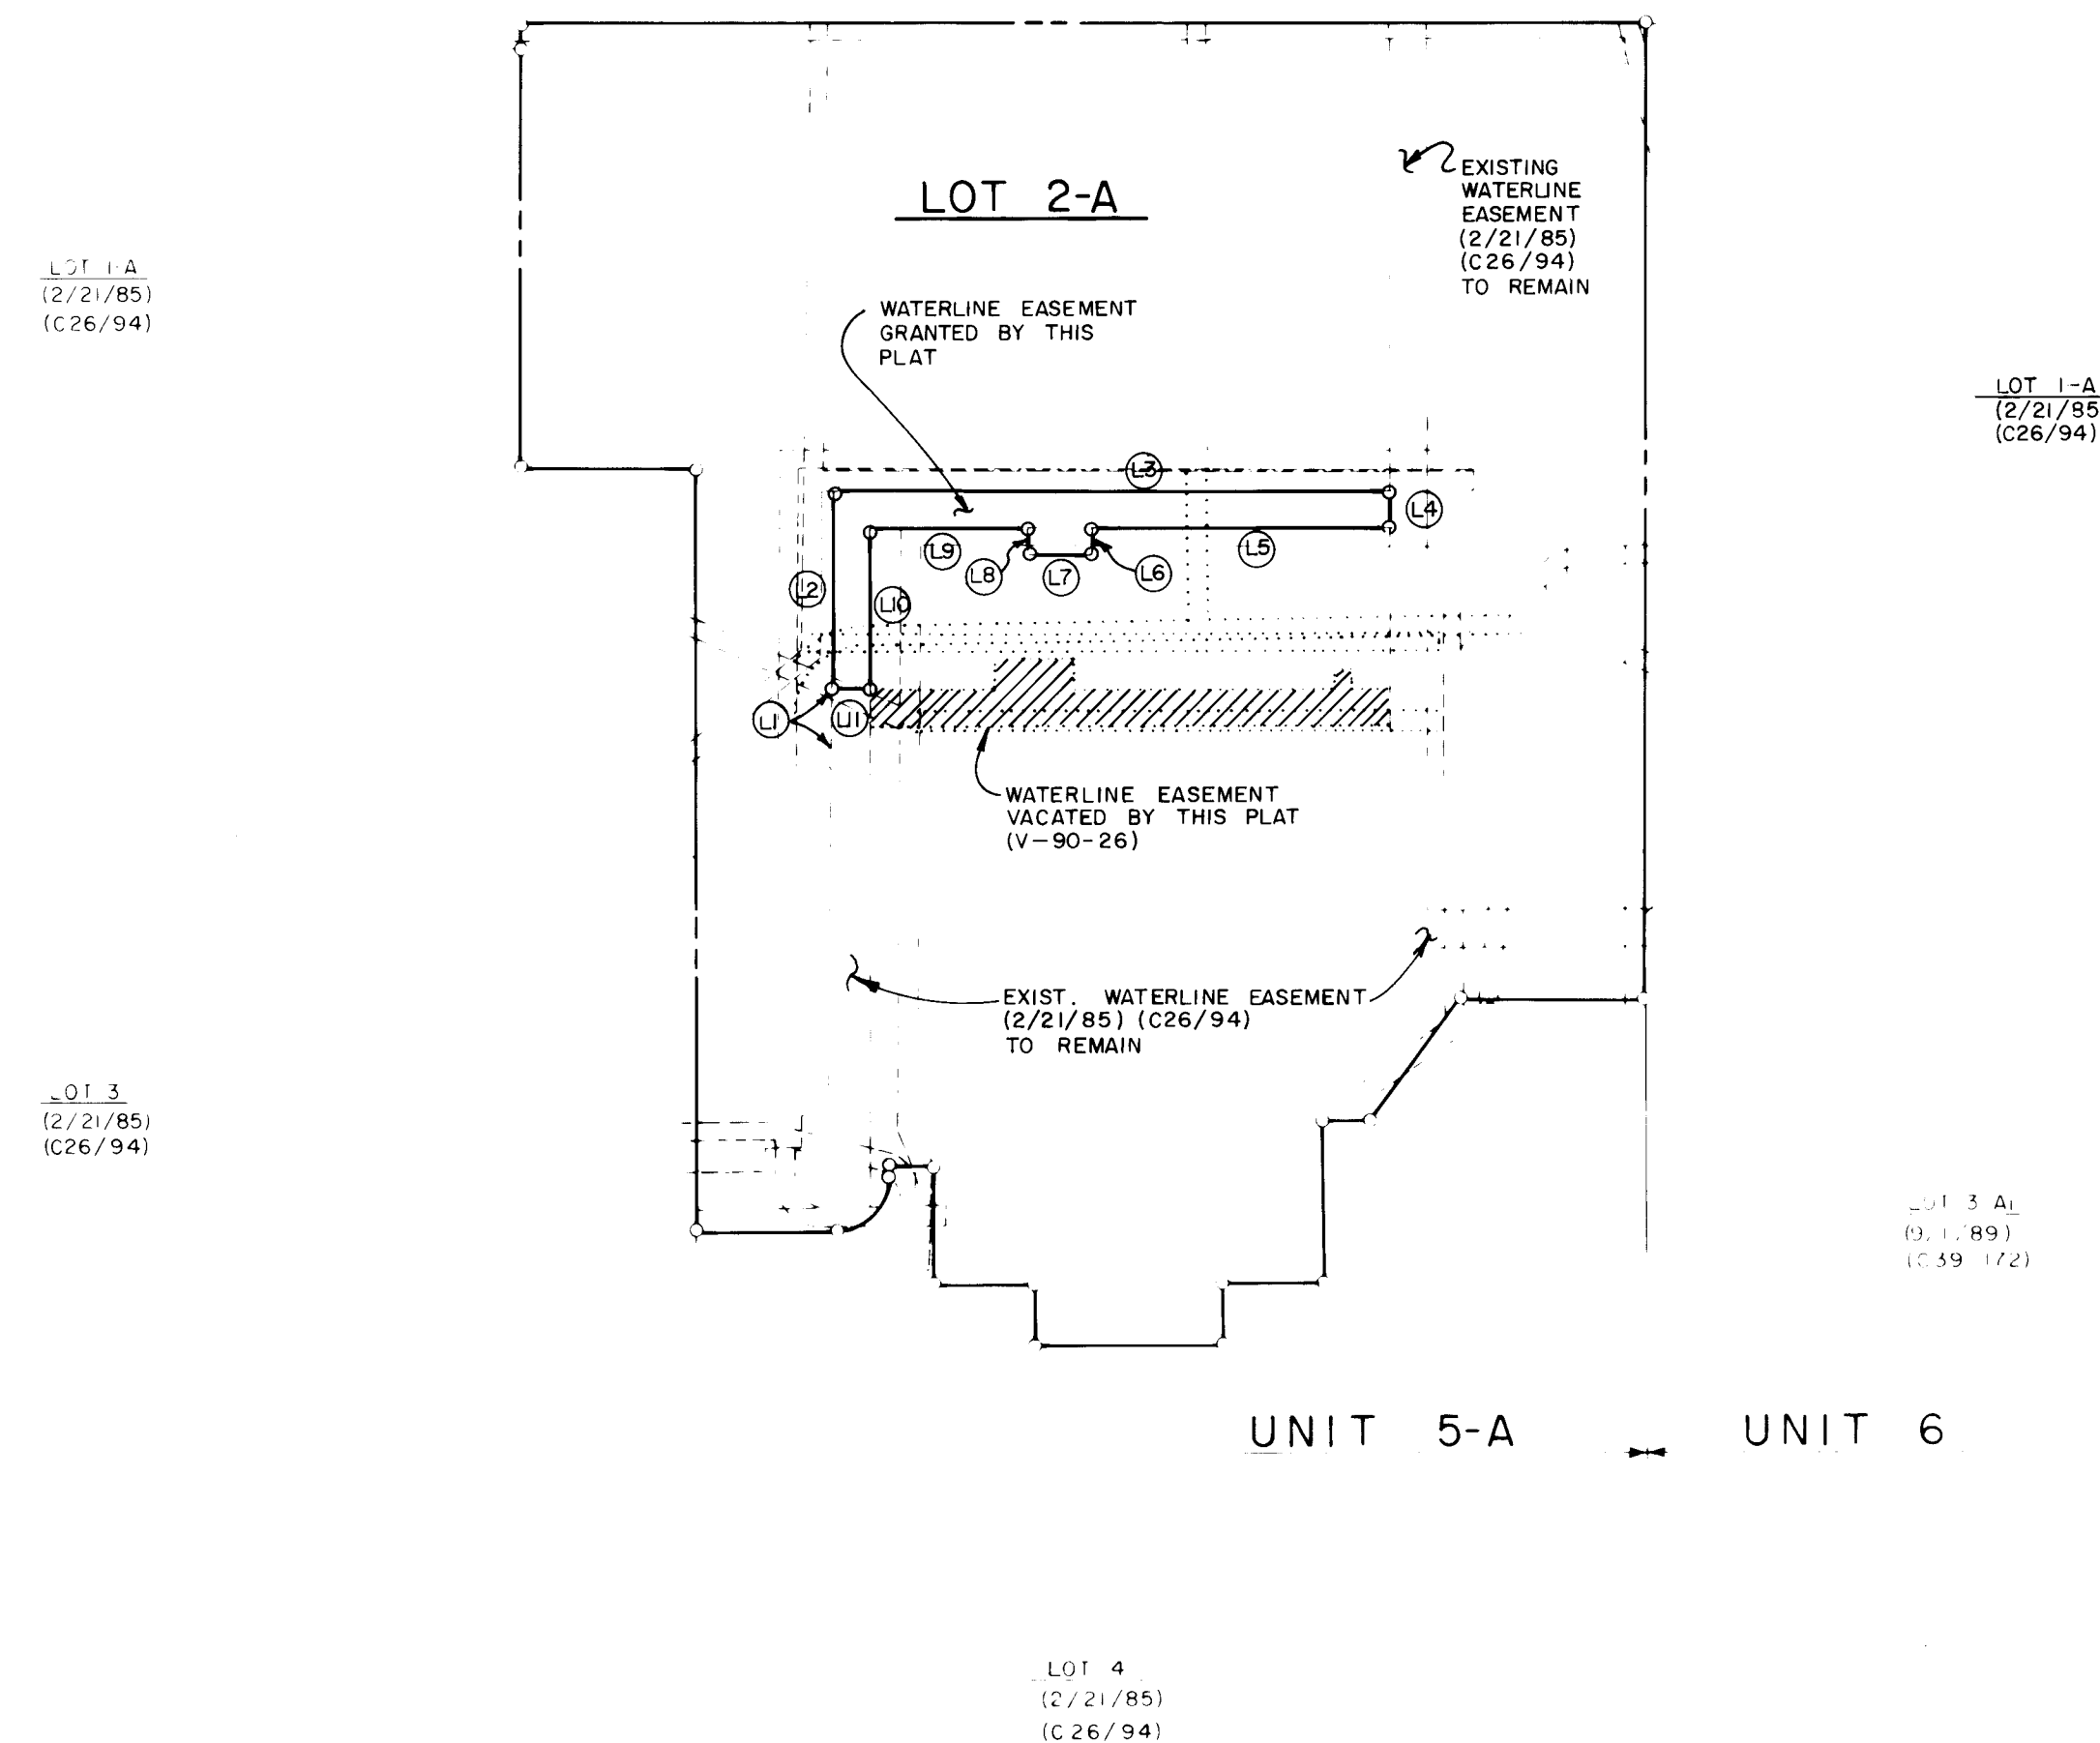


LINE TABLE			
L1	N. 00° 23' 00" W.,	31.80'	(TIE)
L2	N. 00° 23' 00" W.,	106.49'	
L3	N. 89° 37' 00" E.,	302.00'	
L4	S. 00° 23' 00" E.,	20.00'	
L5	S. 89° 37' 00" W.,	162.00'	
L6	S. 00° 23' 00" E.,	15.00'	
L7	S. 89° 37' 00" W.,	35.00'	
L8	N. 00° 23' 00" W.,	15.00'	
L9	S. 89° 37' 00" W.,	85.00'	
L10	S. 00° 23' 00" E.,	86.49'	
L11	S. 89° 37' 00" W.,	20.00'	

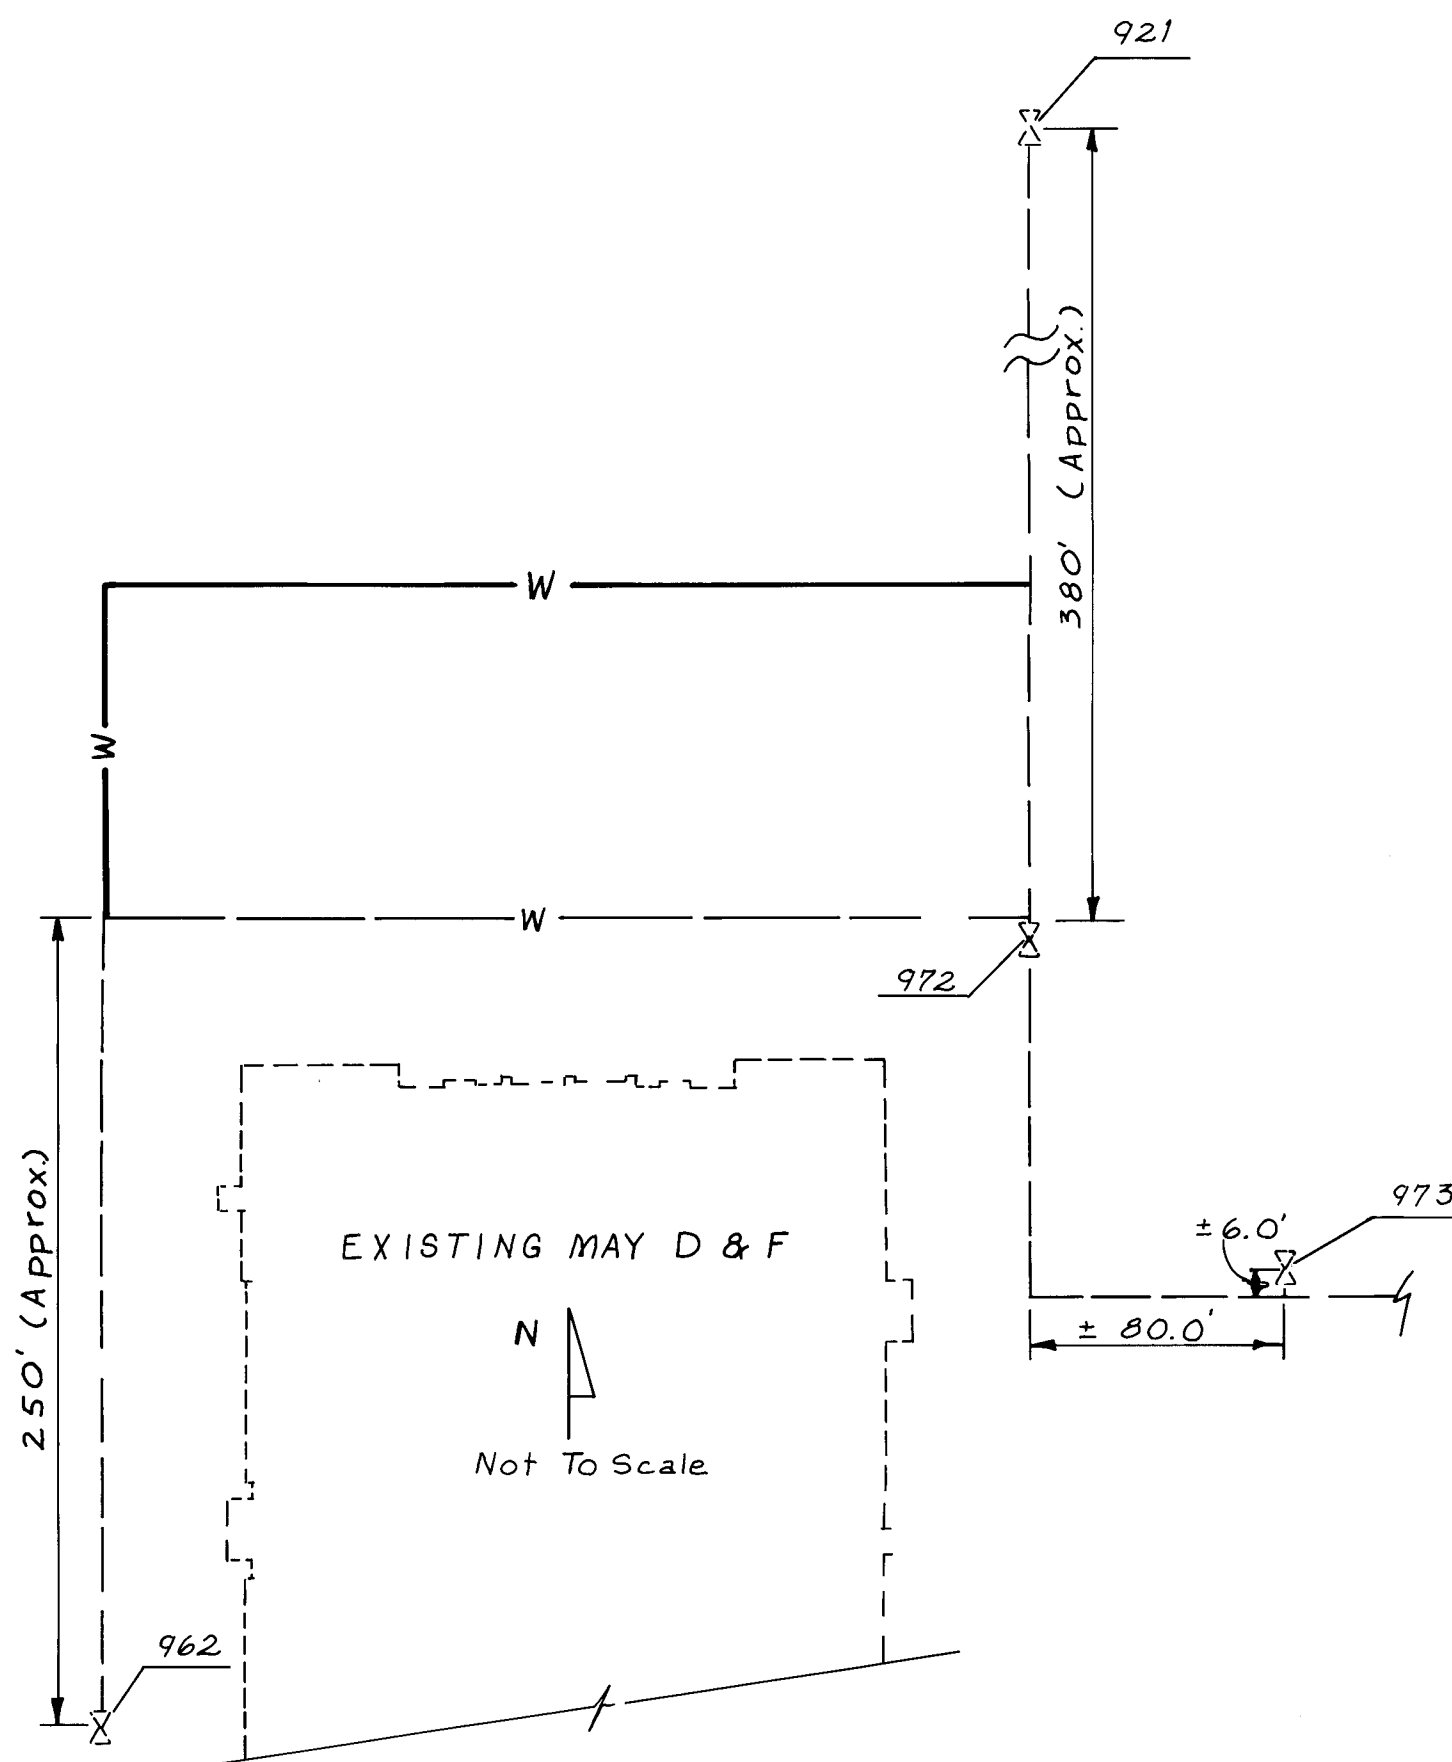

- Notes:
- The Numbers given to the valves are those of the "Water Distribution System Sectional Maps", City of Albuquerque Water Resources Department.
 - Valves 921, 962, and 972 are to be shutoff in order to connect new line to existing waterline. Valve 973 is to be permanently closed with a 6" cap.
 - Three day notice shall be given to the City of Albuquerque Water Systems Operations Group before required valve shut-off (823-4200).

VALVE SHUTOFF PLAN

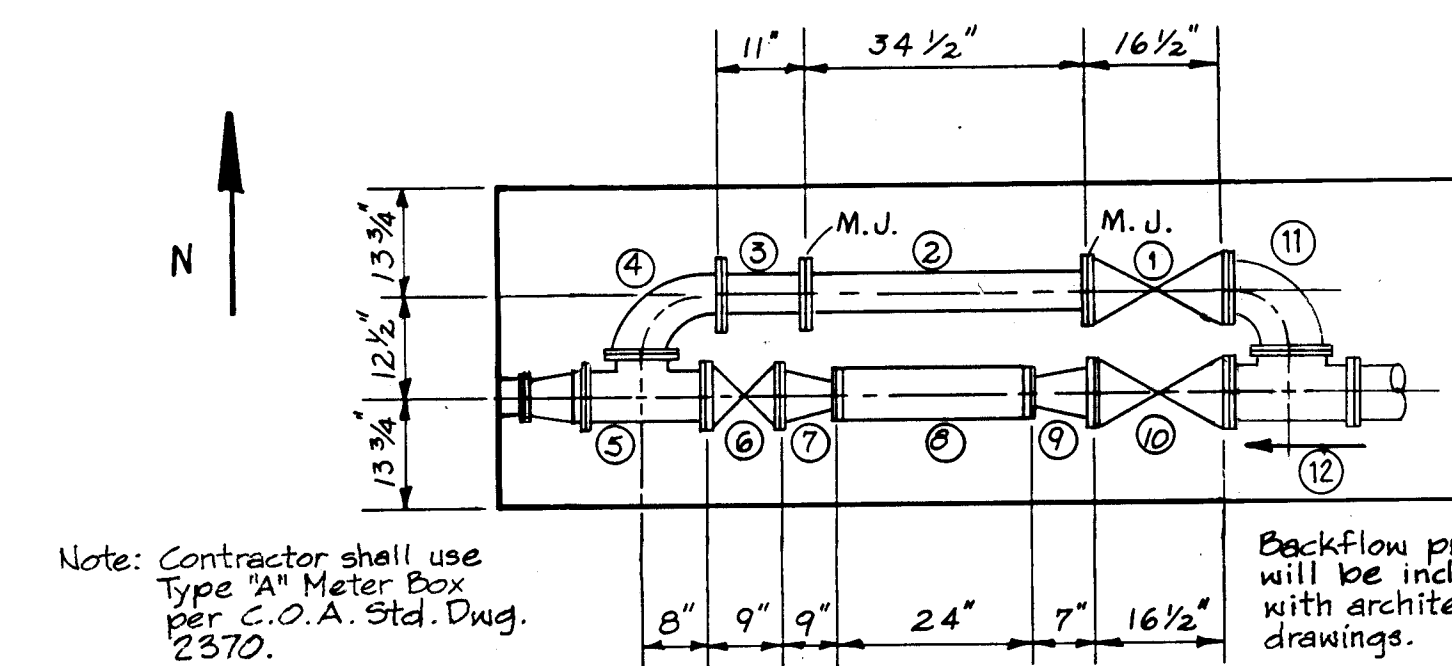


PLAN
PIPING DISTRIBUTION INSIDE
WATER METER BOX
@ STA. 3+27.00
N.T.S.

- Notes:
- Contractor shall coordinate with City of Albuquerque Water Systems Operations, 823-4200, for water meter relocation.
 - All joints are flanged except when specified as M.J. (Mechanical Joints).



- Gate Valve-4"
- 4" CIP or DIP
- 4" CIP or DIP
- 4"x4" 90° Bend
- 6"x4"x4" Tee
- Gate Valve-4"
- Reducer-4"x3"
- Water Meter-3"
- Reducer 3"x4"
- Gate Valve-4"
- 4"x4" 90° Bend
- 4"x4"x4" Tee



RECORD DRAWINGS
DATE 9/14/90

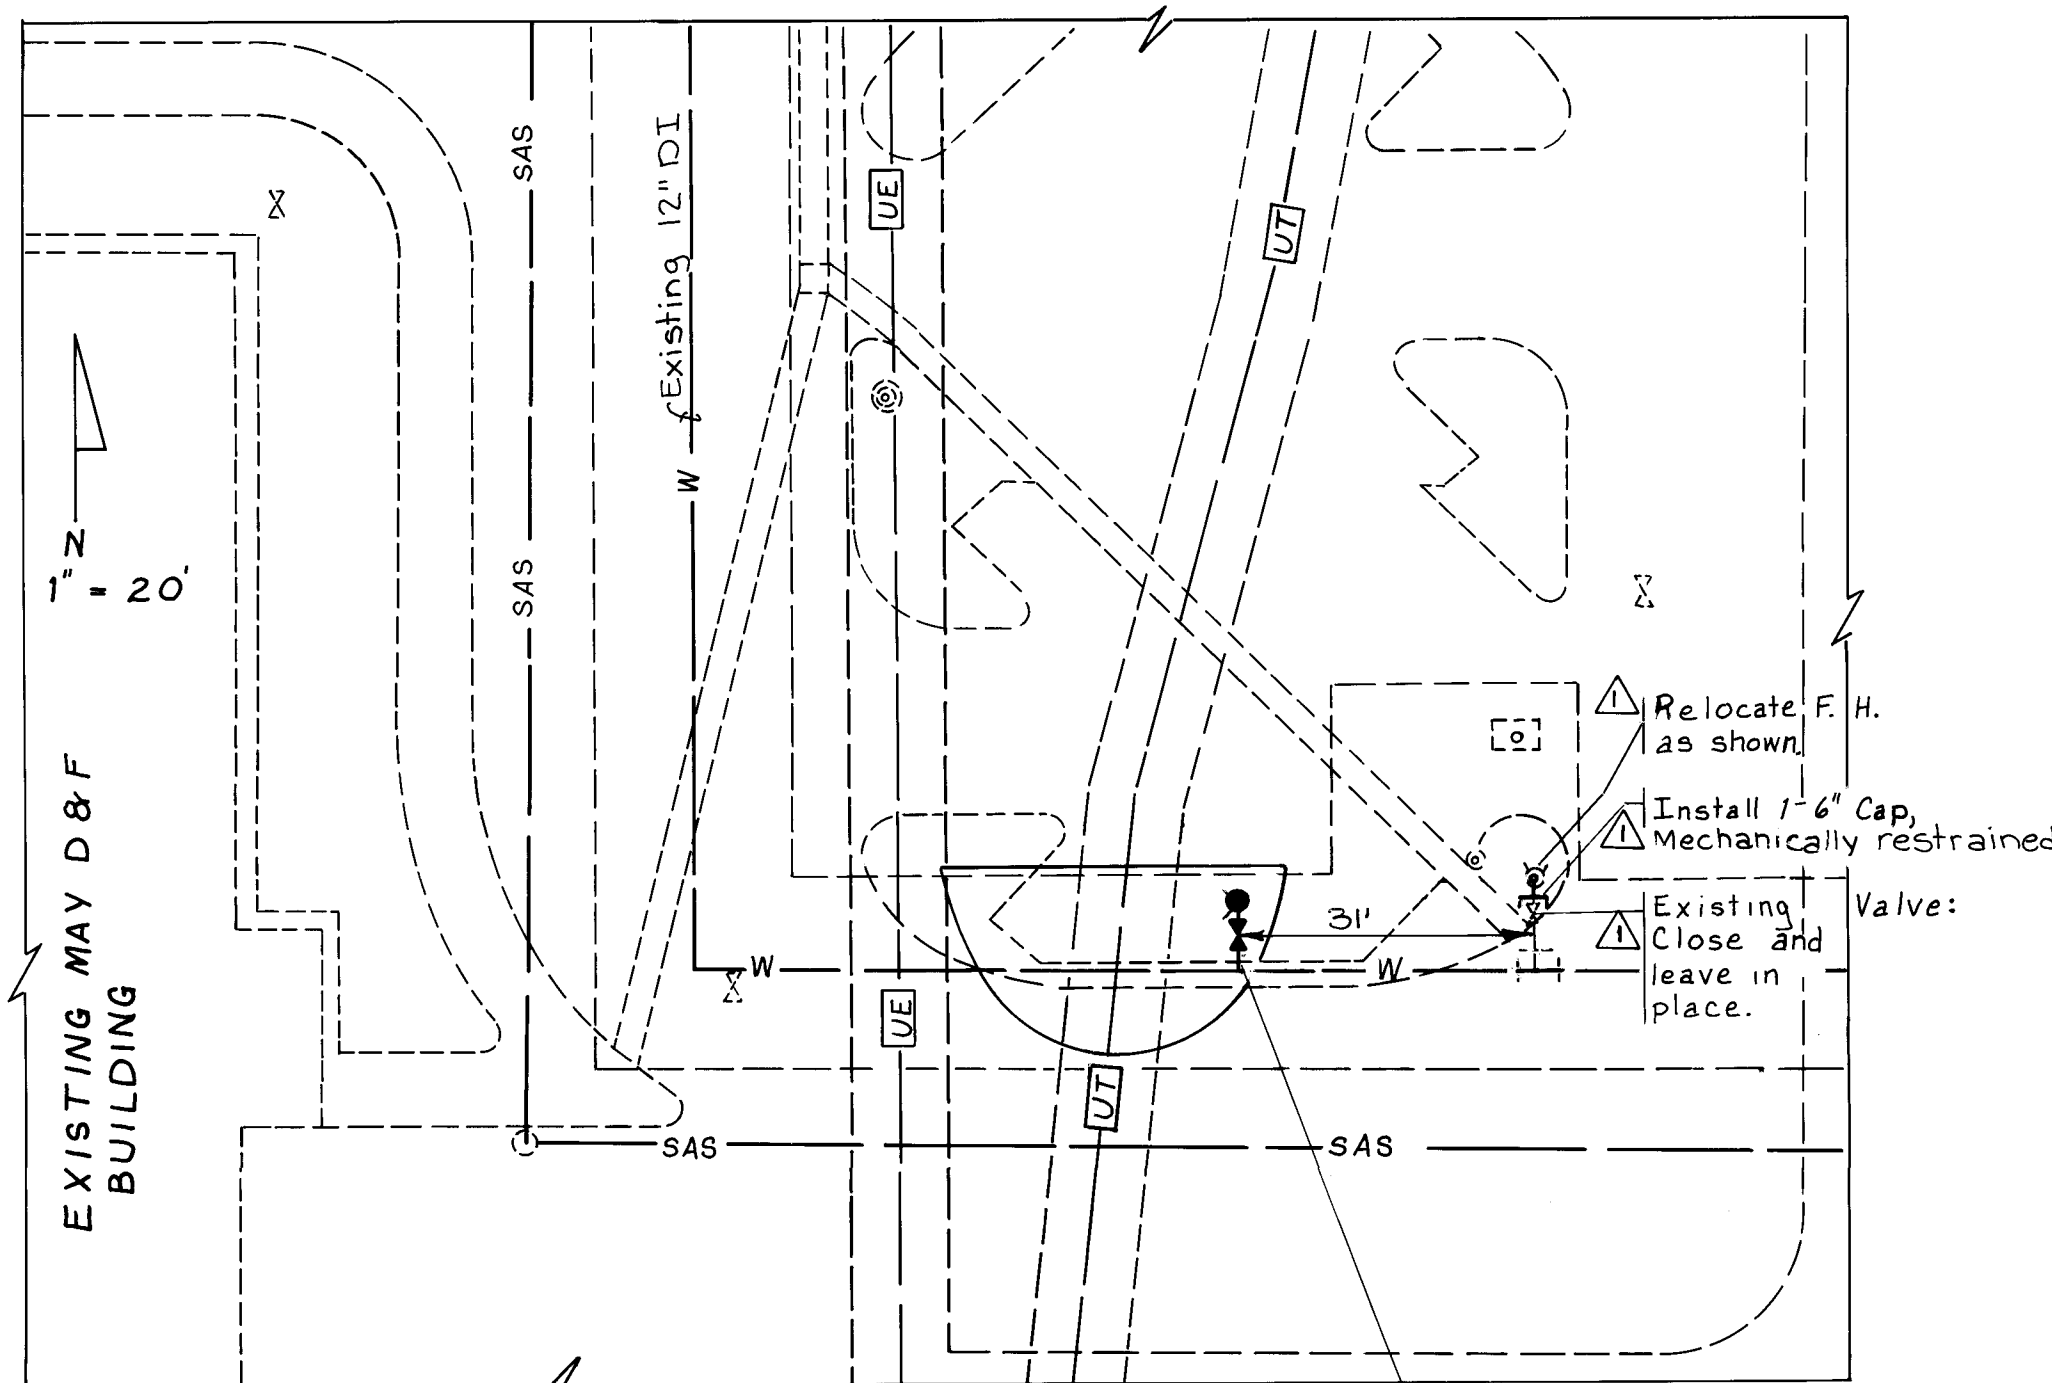

WATER LINE EAST SIDE
SCALE: 1" = 20'-0"

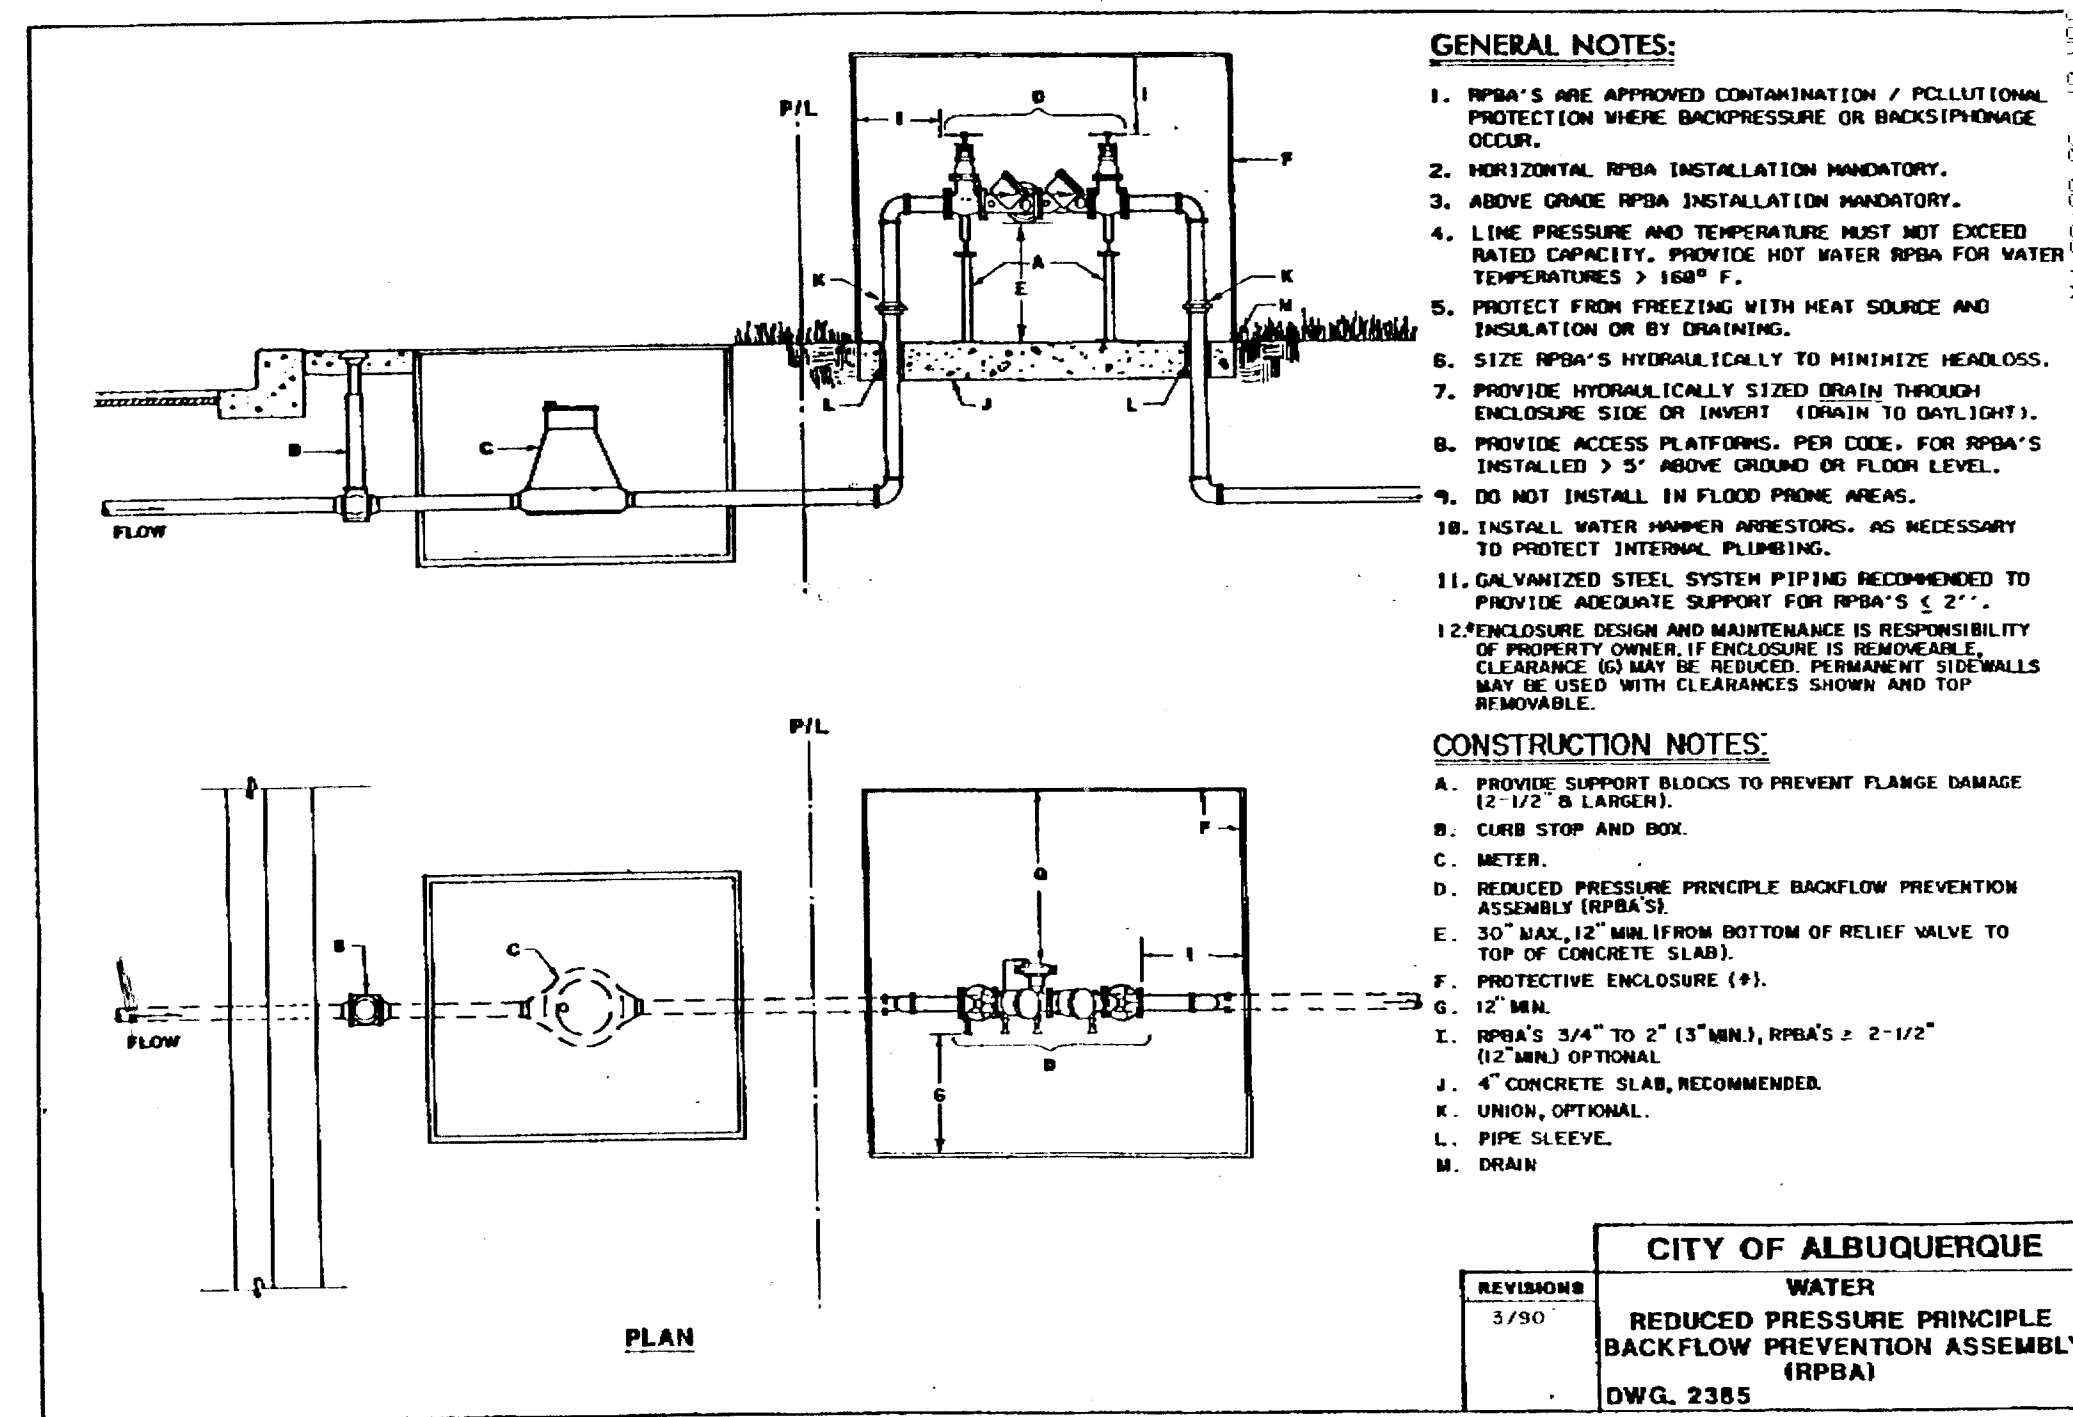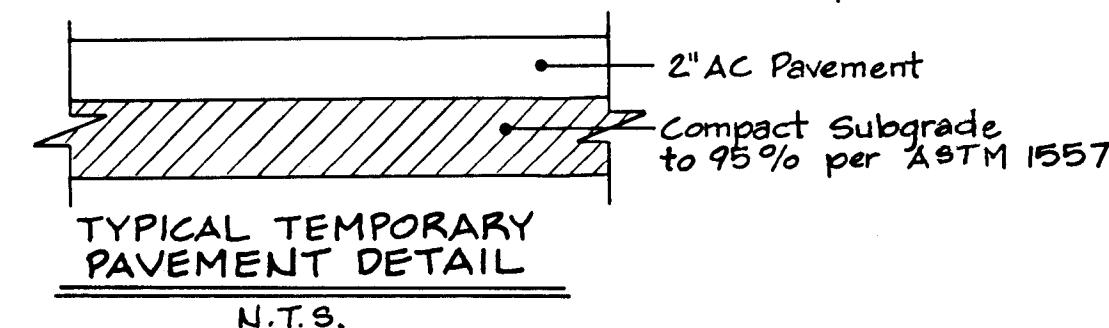

CITY OF ALBUQUERQUE		
WATER		
REVISIONS	DATE	DESCRIPTION
3/90		REDUCED PRESSURE PRINCIPLE BACKFLOW PREVENTION ASSEMBLY (RPBA) DWG. 2385

CITY OF ALBUQUERQUE PUBLIC WORKS DEPARTMENT ENGINEERING GROUP					
TITLE: MAY D & F EXPANSION WATERLINE DETAILS					
APPROVALS	ENGINEER	DATE	APPROVALS	ENGINEER	DATE
DRC CHAIRMAN	CAM	7-6-90	WATER	R.W. Kane	7-5-90
TRANSPORTATION	W/A RWD	7-5-90	WASTE WATER	R.W. Kane	7-5-90
HYDROLOGY	CAM	7-6-90			
DRAWING NO.	4091.90	MAP NO. H-18	SHEET 5	OF 5	