

CONSTRUCTION PLANS FOR

ALBUQUERQUE PUBLIC SCHOOLS WATERLINE EXTENSIONS

JOHN ADAMS, TRUMAN & VAN BUREN MIDDLE SCHOOLS
VALLEY & WEST MESA HIGH SCHOOLS

ALBUQUERQUE, NEW MEXICO

JUNE, 1990

INDEX OF DRAWINGS

- | | |
|--|--|
| 1. COVER SHEET, GENERAL NOTES, LEGEND & INDEX OF DRAWINGS | 18. SITE PLAN |
| 2. LOCATION MAPS | 19. EASEMENT SURVEY |
| 3. TRAFFIC CONTROL DETAILS | 20. WATERLINE EXTENSION PLAN & PROFILE LINE "M" AND LINE "N" |
| 4. SITE PLAN | 21. WATERLINE EXTENSION PLAN & PROFILE LINE "O" AND LINE "P" |
| 5. EASEMENT SURVEY | 22. WATER VALVE SHUTOFF PLAN, SECTIONS & DETAILS |
| 6. WATERLINE EXTENSION PLAN & PROFILE - LINE "A" | 23. SITE PLAN |
| 7. WATERLINE EXTENSION PLAN & PROFILE LINE "B", LINE "C", LINE "D", AND LINE "E" | 24. UNMETERED FIRE PROTECTION LINE MODIFICATIONS |
| 8. WATER VALVE SHUTOFF PLAN, SECTIONS & DETAILS | 25. WATER VALVE SHUTOFF PLAN, SECTIONS & DETAILS |
| | |
| 9. SITE PLAN | |
| 10. EASEMENT SURVEY | |
| 11. WATERLINE EXTENSION PLAN & PROFILE LINE "F" AND LINE "I" | |
| 12. WATERLINE EXTENSION PLAN & PROFILE LINE "G" AND LINE "H" | |
| 13. WATER VALVE SHUTOFF PLAN, SECTIONS & DETAILS | |
| | |
| 14. SITE PLAN | |
| 15. EASEMENT SURVEY | |
| 16. WATERLINE EXTENSION PLAN & PROFILE LINE "J", LINE "K", AND LINE "L" | |
| 17. WATER VALVE SHUTOFF PLAN, SECTIONS & DETAILS | |

RECORD DRAWING

I, Jeffrey G. Mortensen, Registered Professional Engineer in the State of New Mexico, do hereby certify that this "as-built" information was obtained by me or under my supervision and represents the "as-built" conditions of this project, and is true and correct to the best of my knowledge and belief. All vertical and horizontal dimensions should be field verified prior to use on future projects.

Jeffrey G. Mortensen
N.M.P.E. NO. 8547
DATE 6/14/90

GENERAL NOTES:

- ALL WORK DETAILED ON THESE PLANS TO BE PERFORMED UNDER CONTRACT SHALL, EXCEPT AS OTHERWISE STATED OR PROVIDED FOR HEREON, BE CONSTRUCTED IN ACCORDANCE WITH THE CITY OF ALBUQUERQUE STANDARD SPECIFICATIONS - PUBLIC WORKS CONSTRUCTION - 1986.
- TWO (2) WORKING DAYS PRIOR TO ANY EXCAVATION, CONTRACTOR MUST CONTACT NEW MEXICO ONE CALL SERVICE, 260-1990, FOR LOCATION OF EXISTING UTILITIES.
- IF ANY UTILITY LINES, PIPELINES, OR UNDERGROUND UTILITY LINES ARE SHOWN ON THESE DRAWINGS, THEY ARE SHOWN IN AN APPROXIMATE MANNER ONLY, AND SUCH LINES MAY EXIST WHERE NONE ARE SHOWN. IF ANY SUCH EXISTING LINES ARE SHOWN, THE LOCATION IS BASED UPON INFORMATION PROVIDED BY THE OWNER OF SAID UTILITY, AND THE INFORMATION MAY BE INCOMPLETE, OR MAY BE OBSOLETE BY THE TIME CONSTRUCTION COMMENCES. THE ENGINEER HAS CONDUCTED ONLY PRELIMINARY INVESTIGATION OF THE LOCATION, DEPTH, SIZE OR TYPE OF EXISTING UTILITY LINES, PIPELINES OR UNDERGROUND UTILITY LINES. THIS INVESTIGATION IS NOT CONCLUSIVE, AND MAY NOT BE COMPLETE, THEREFORE, MAKES NO REPRESENTATION PERTAINING THERETO, AND ASSUMES NO RESPONSIBILITY OR LIABILITY THEREFOR. THE CONTRACTOR SHALL INFORM ITSELF OF THE LOCATION OF ANY UTILITY LINE, PIPELINE, OR UNDERGROUND UTILITY LINE IN OR NEAR THE AREA OF THE WORK IN ADVANCE OF AND DURING EXCAVATION WORK. THE CONTRACTOR IS FULLY RESPONSIBLE FOR ANY AND ALL DAMAGE CAUSED BY ITS FAILURE TO LOCATE, IDENTIFY AND PRESERVE ANY AND ALL EXISTING UTILITIES, PIPELINES AND UNDERGROUND UTILITY LINES. IN PLANNING AND CONDUCTING EXCAVATION, THE CONTRACTOR SHALL COMPLY WITH STATE STATUTES, MUNICIPAL AND LOCAL ORDINANCES, RULES AND REGULATIONS, IF ANY, PERTAINING TO THE LOCATION OF THESE LINES AND FACILITIES.
- SHOULD A CONFLICT EXIST BETWEEN THESE PLANS AND ACTUAL FIELD CONDITIONS, THE CONTRACTOR SHALL PROMPTLY NOTIFY THE ENGINEER IN WRITING SO THAT THE CONFLICT CAN BE RESOLVED WITH A MINIMUM AMOUNT OF DELAY FOR ALL PARTIES.
- THE CONTRACTOR SHALL MAINTAIN ACCESS TO ADJACENT PROPERTIES DURING CONSTRUCTION.
- ALL WORK ON THIS PROJECT SHALL BE PERFORMED IN ACCORDANCE WITH APPLICABLE FEDERAL, STATE AND LOCAL LAWS, RULES AND REGULATIONS CONCERNING SAFETY AND HEALTH.
- CONTRACTOR SHALL COMPLY WITH SECTION 19 OF THE "STANDARD SPECIFICATIONS".
- ALL UTILITIES AND UTILITY SERVICE LINES SHALL BE INSTALLED PRIOR TO PAVING.
- BACKFILL COMPACTION SHALL BE ACCORDING TO SPECIFIED STREET USE.
- TACK COAT REQUIREMENTS SHALL BE DETERMINED DURING CONSTRUCTION BY THE PROJECT ENGINEER.
- SIDEWALKS AND WHEELCHAIR RAMPS WITHIN THE CURB RETURNS SHALL BE CONSTRUCTED WHEREVER A NEW CURB RETURN IS CONSTRUCTED.
- IF CURB IS DEEPENED FOR A DRIVEPAD OR A HANDICAP RAMP, THE DRIVEPAD OR RAMP SHALL BE CONSTRUCTED PRIOR TO ACCEPTANCE OF THE CURB AND GUTTER.
- ALL STORM DRAINAGE FACILITIES SHALL BE COMPLETED PRIOR TO FINAL ACCEPTANCE.
- CONTRACTOR SHALL COORDINATE WITH THE WATER SYSTEM DIVISION FOR THE EXECUTION OF THE VALVE SHUT OFF PLAN, NOT LESS THAN THREE (3) WORKING DAYS IN ADVANCE OF ANY WORK THAT MAY AFFECT THE EXISTING PUBLIC WATER UTILITIES.
- CONTRACTOR SHALL NOTIFY THE ENGINEER NOT LESS THAN SEVEN (7) DAYS PRIOR TO STARTING WORK IN ORDER THAT THE ENGINEER MAY TAKE NECESSARY MEASURES TO INSURE THE PRESERVATION OF SURVEY MONUMENTS. CONTRACTOR SHALL NOT DISTURB PERMANENT SURVEY MONUMENTS WITHOUT THE CONSENT OF THE ENGINEER AND SHALL NOTIFY THE ENGINEER AND BEAR THE EXPENSE OF REPLACING ANY THAT MAY BE DISTURBED WITHOUT PERMISSION. REPLACEMENT SHALL BE DONE ONLY BY THE ENGINEER. WHEN A CHANGE IS MADE IN THE FINISHED ELEVATION OF THE PAVEMENT OF ANY ROADWAY IN WHICH A PERMANENT SURVEY MONUMENT IS LOCATED, CONTRACTOR SHALL, AT HIS OWN EXPENSE, ADJUST THE MONUMENT COVER TO THE NEW GRADE UNLESS OTHERWISE SPECIFIED.
- THREE (3) WORKING DAYS PRIOR TO BEGINNING CONSTRUCTION THE CONTRACTOR SHALL SUBMIT TO THE CONSTRUCTION CO-ORDINATION DIVISION A DETAILED CONSTRUCTION SCHEDULE. TWO (2) WORKING DAYS PRIOR TO CONSTRUCTION THE CONTRACTOR SHALL OBTAIN A BARRICADING PERMIT FROM THE CONSTRUCTION CO-ORDINATION DIVISION. CONTRACTOR SHALL NOTIFY BARRICADE ENGINEER (768-2551) PRIOR TO OCCUPYING AN INTERSECTION.
- ALL STREET STRIPING ALTERED OR DESTROYED SHALL BE REPLACED IN KIND BY CONTRACTOR TO LOCATION AND IN KIND AS EXISTING OR AS INDICATED BY THIS PLAN SET.

APPROVAL OF AS-BUILT DRAWINGS
CHIEF CONSTRUCTION ENGINEER
DATE 6/14/90

REV.	SHEETS	CITY ENGINEER	DATE	USER DEPARTMENT	DATE	USER DEPARTMENT	DATE
1	25						

JEFF MORTENSEN & ASSOCIATES, INC.
6010-B MIDWAY PARK BLVD. N.E.
ALBUQUERQUE, N.M. 87109
ENGINEERS D (505) 345-4200

APPROVED FOR CONSTRUCTION

7/19/90 C.E.

PROJECT NO. 4111 90

SHEET 1 OF 25

CAUTION:

THESE DRAWINGS DO NOT INCLUDE NECESSARY COMPONENTS FOR CONSTRUCTION SAFETY WHICH SHALL REMAIN THE RESPONSIBILITY OF THE CONTRACTOR.

SCANNED BY
BY LASON

Jeffrey G. Mortensen
N.M.P.E. NO. 8547
DATE 6-26-90

LEGEND

MATERIALS

CONCRETE
RIP-RAP

LINES

SUBDIVISION BOUNDARY
PROPERTY LINE (PLAN)
PROPERTY LINE (SECTION)
CENTERLINE
EASEMENT LINE
MATCH LINE
SECTION CUT LINE

EARTHWORK

EXISTING NEW
CONTOUR LINE
SPOT ELEVATION
PROJECT / PHASE BOUNDARY
SWALE
DIRECTION OF FLOW

MISCELLANEOUS UTILITIES

GAS LINE
UNDERGROUND TELEPHONE
UNDERGROUND ELECTRICAL
STORM DRAIN
STORM DRAIN MANHOLE
STORM DRAIN INLET

SANITARY SEWER

SANITARY SEWER LINE
SANITARY SEWER MANHOLE
SAS SERVICE CONNECTIONS
SAS CAP OR PLUG
ENCASEMENT

WATER


WATER LINE
WATER SERVICE CONNECTIONS
GATE VALVE
FIRE HYDRANT
BUTTERFLY VALVE
REDUCER
WATER PRESSURE ZONE BOUNDARY

WATER FITTINGS


CAPS AND PLUGS
ELBOW
CROSS
TEE

MISCELLANEOUS


CHAINLINK FENCE
FIELD FENCE
COMMON YARD WALL
RETAINING WALL
POWER OR TELEPHONE POLE

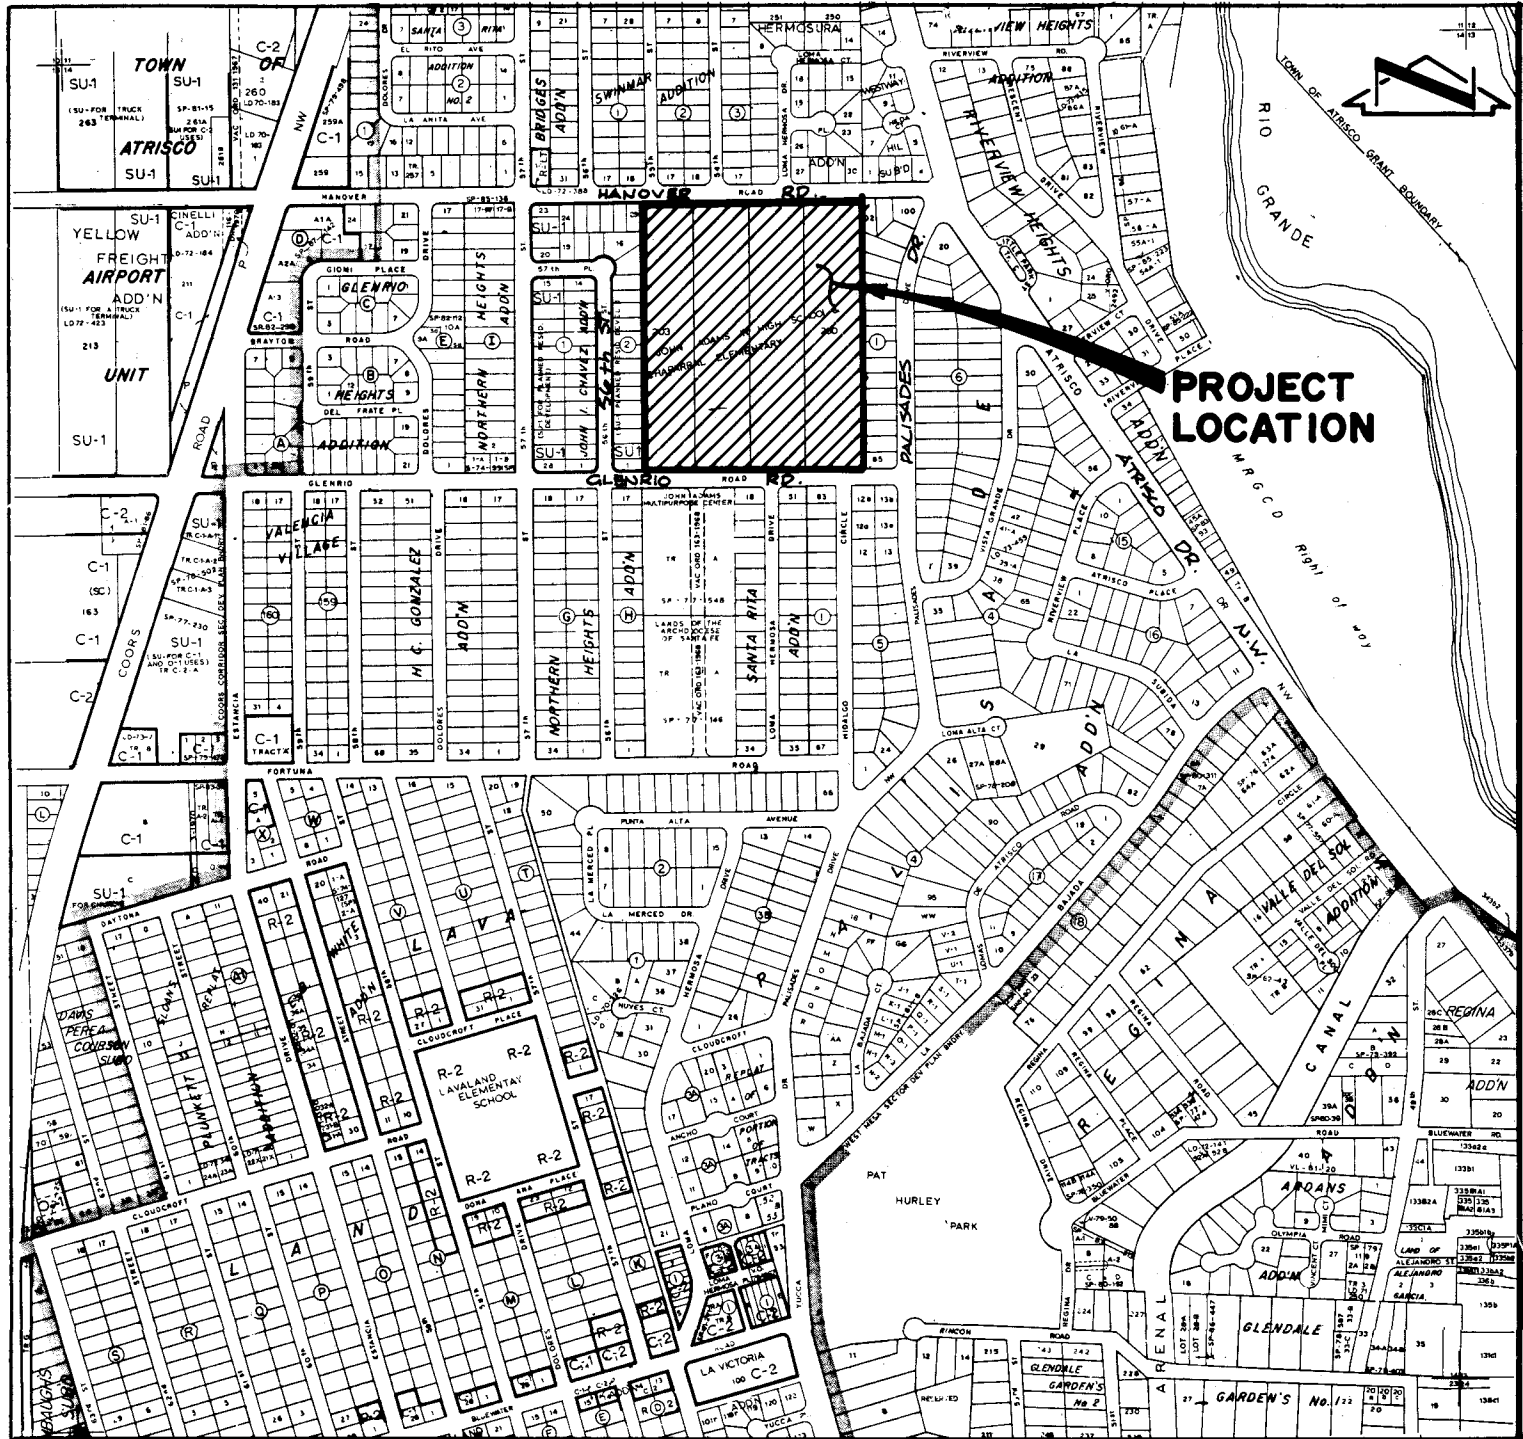


LOCATION MAP - JOHN ADAMS (J-11)
SCALE : 1" = 800' (APPROX.)

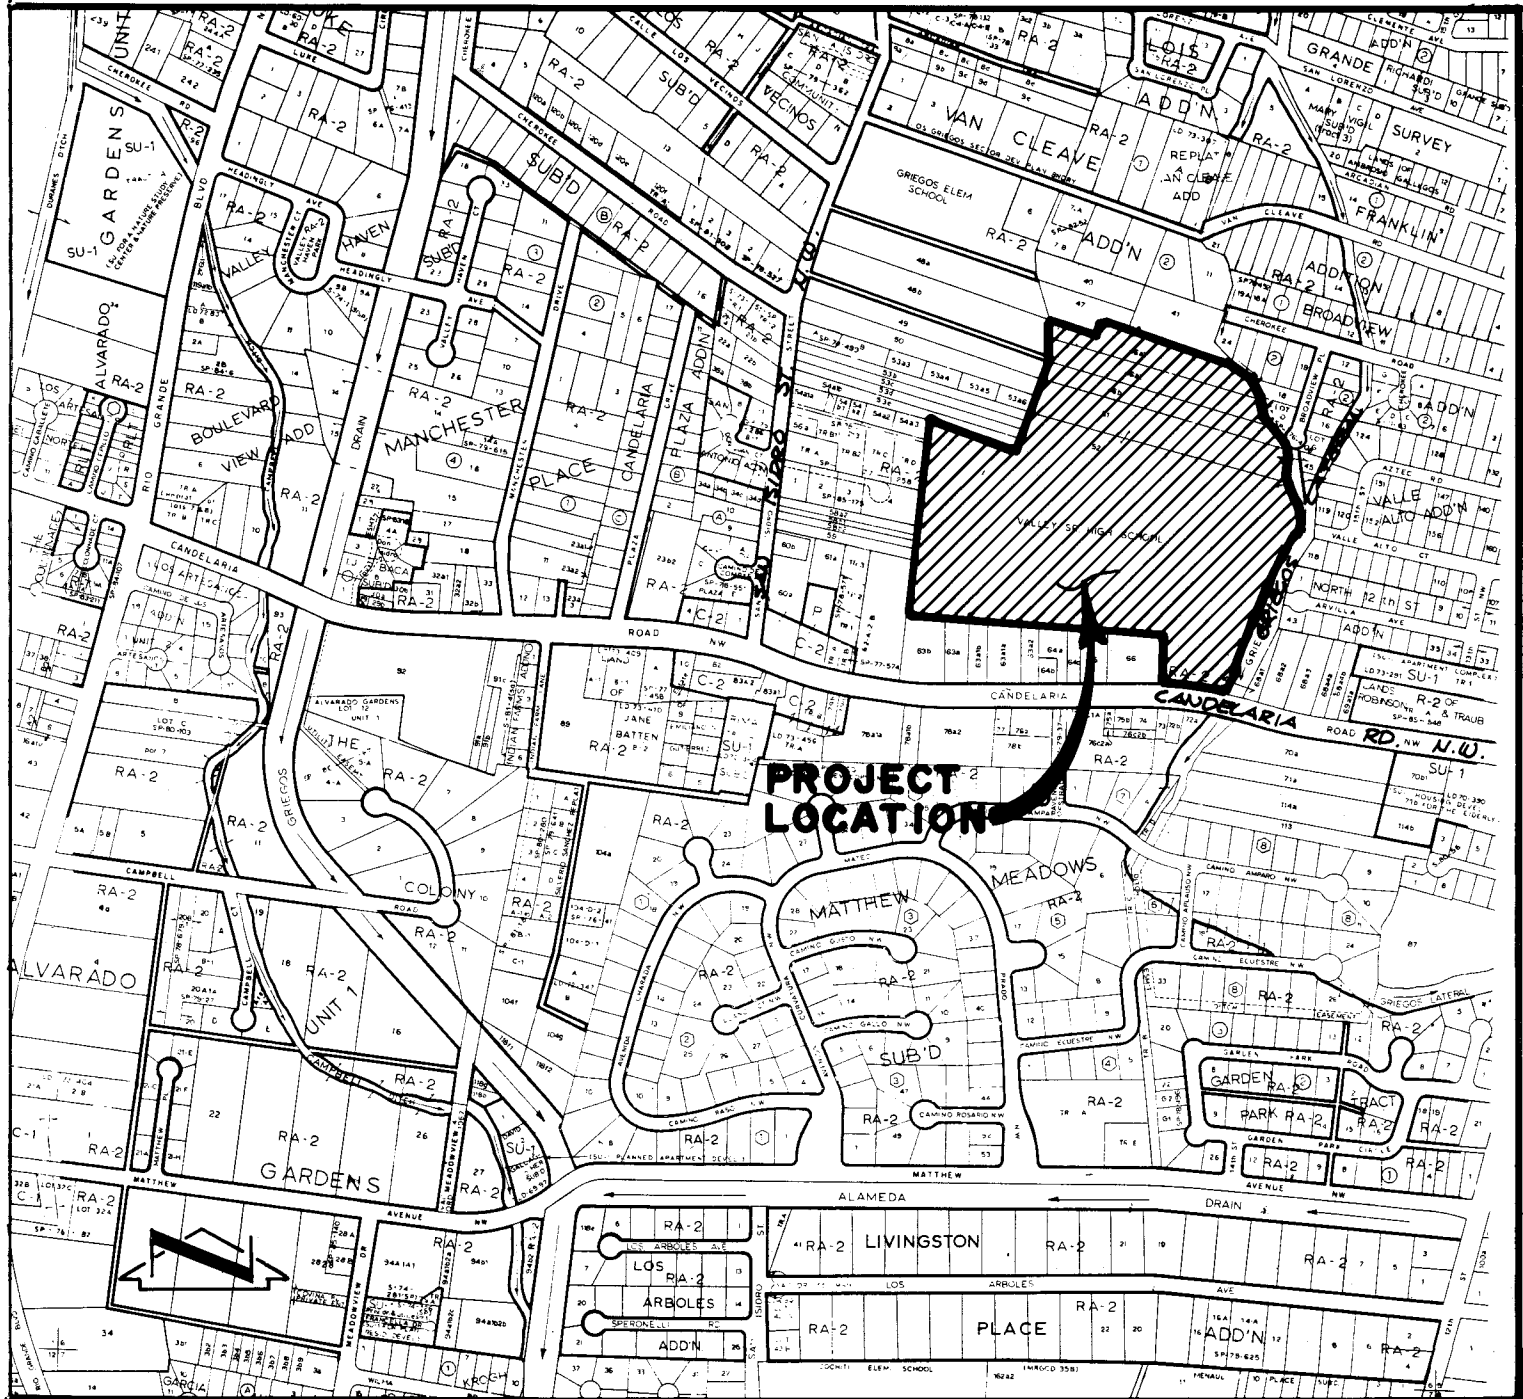


LOCATION MAP (G-13)
SCALE : 1" = 800' (APPROX.)

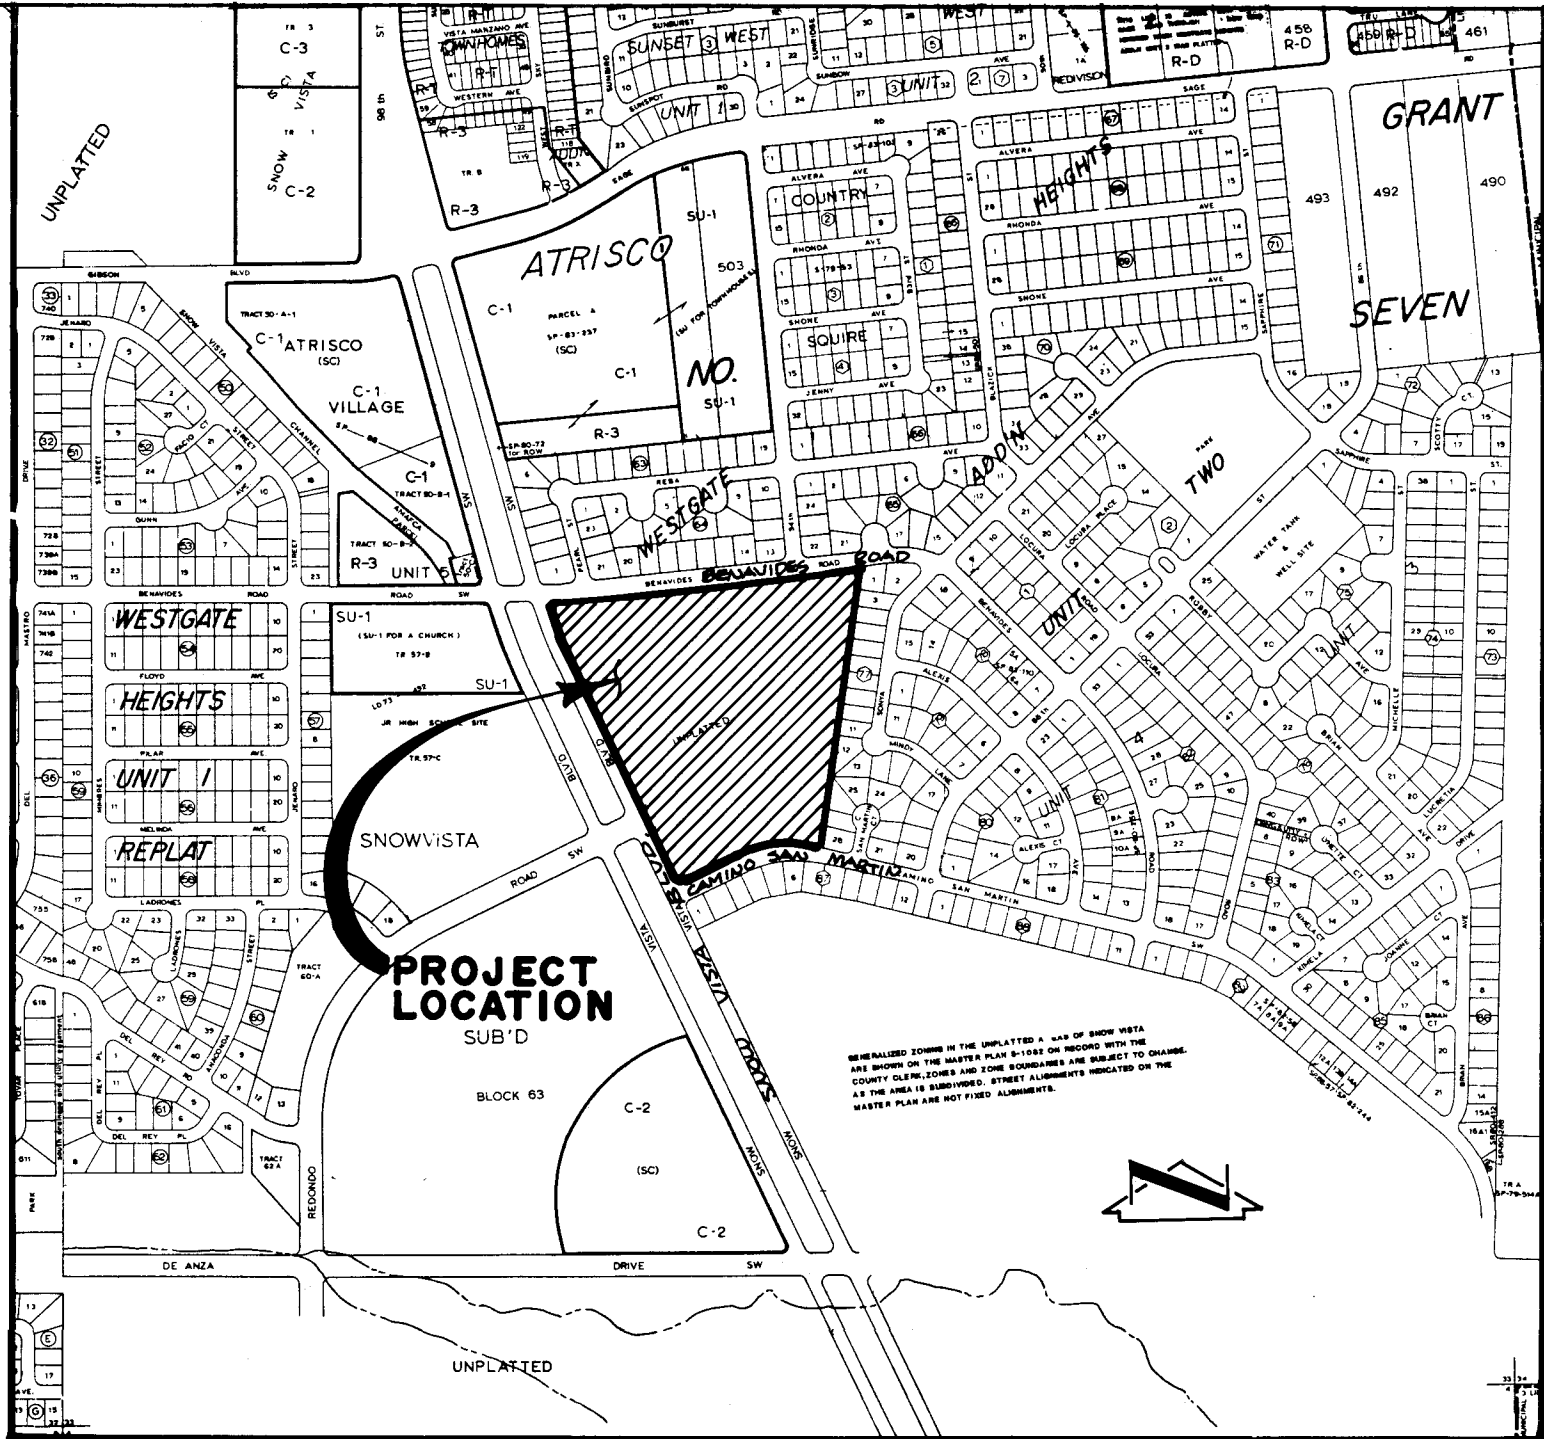

LOCATION MAP - TRUMAN (M-9)
SCALE : 1" = 800' (APPROX.)

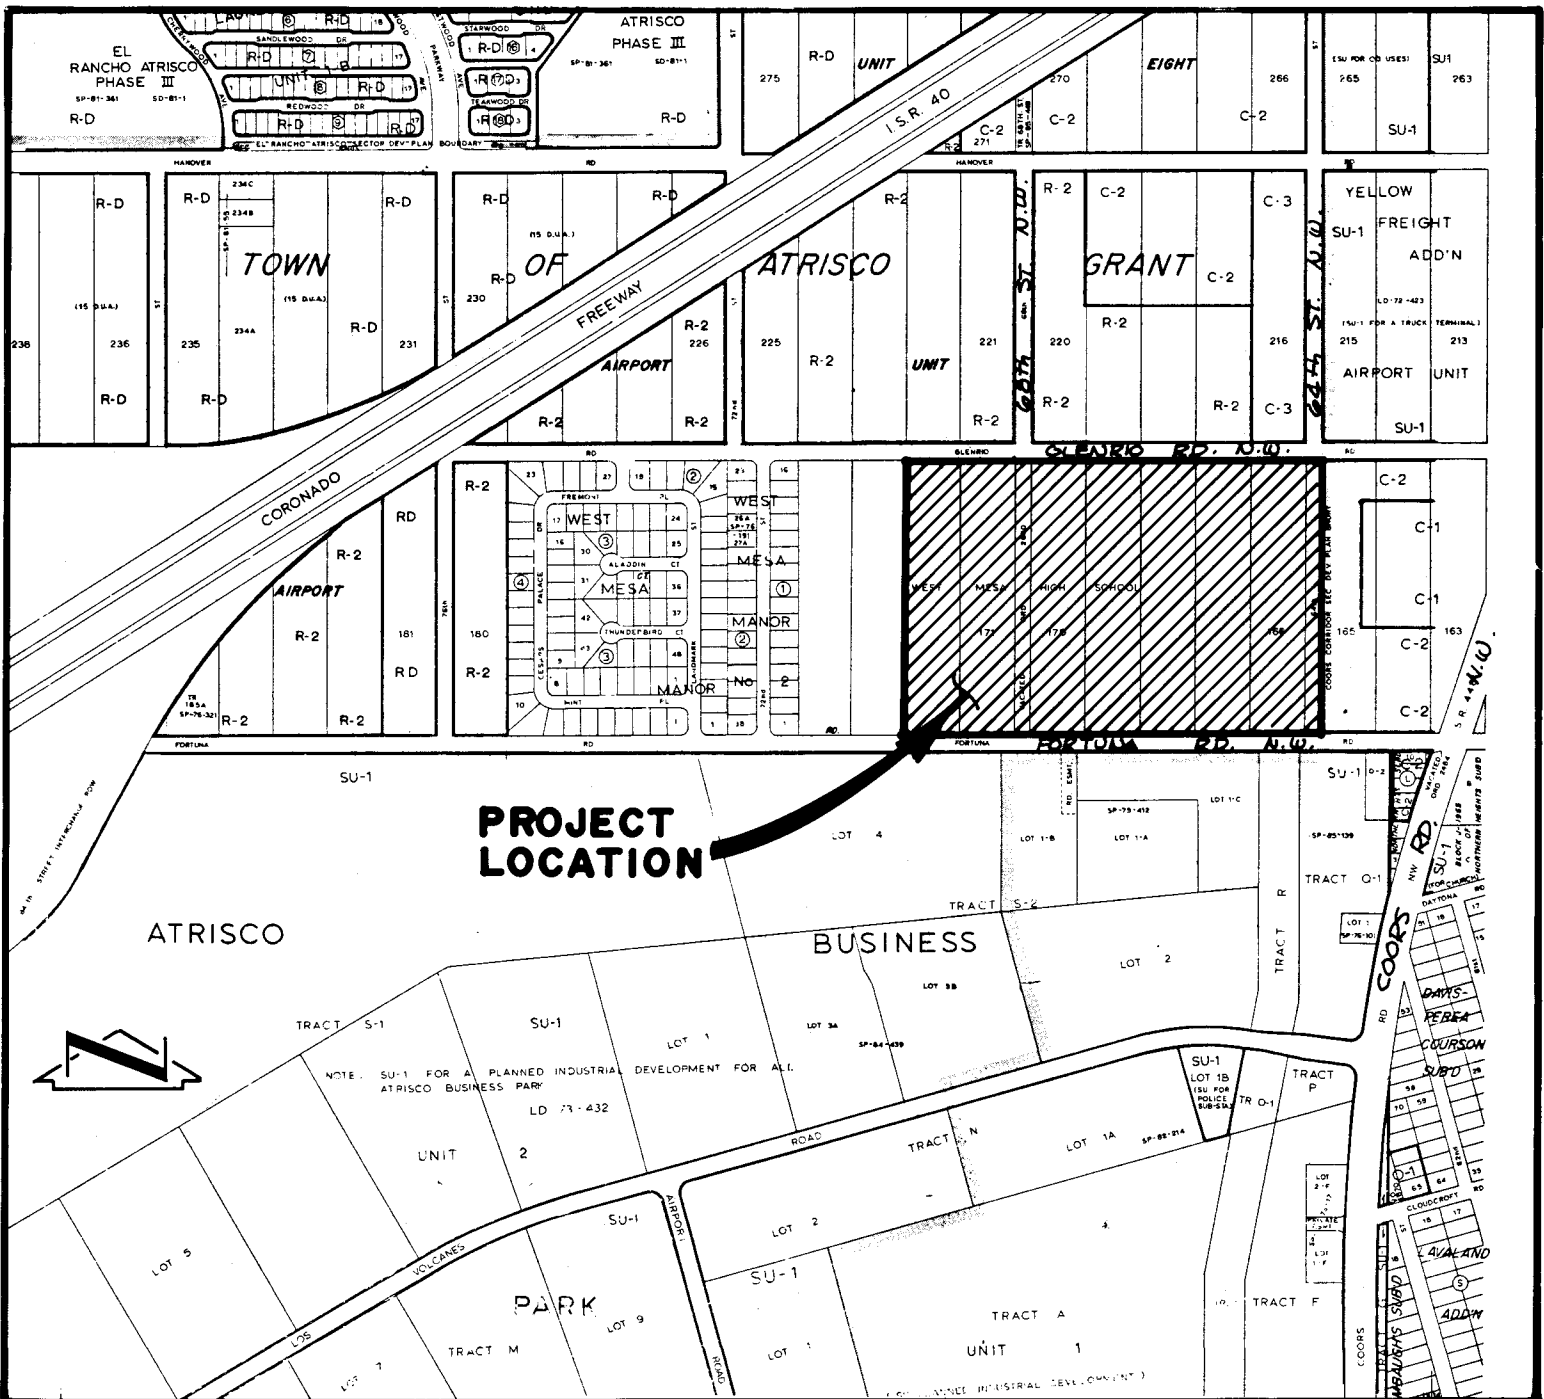

LOCATION MAP J-10)
SCALE : 1" = 800' (APPROX.)

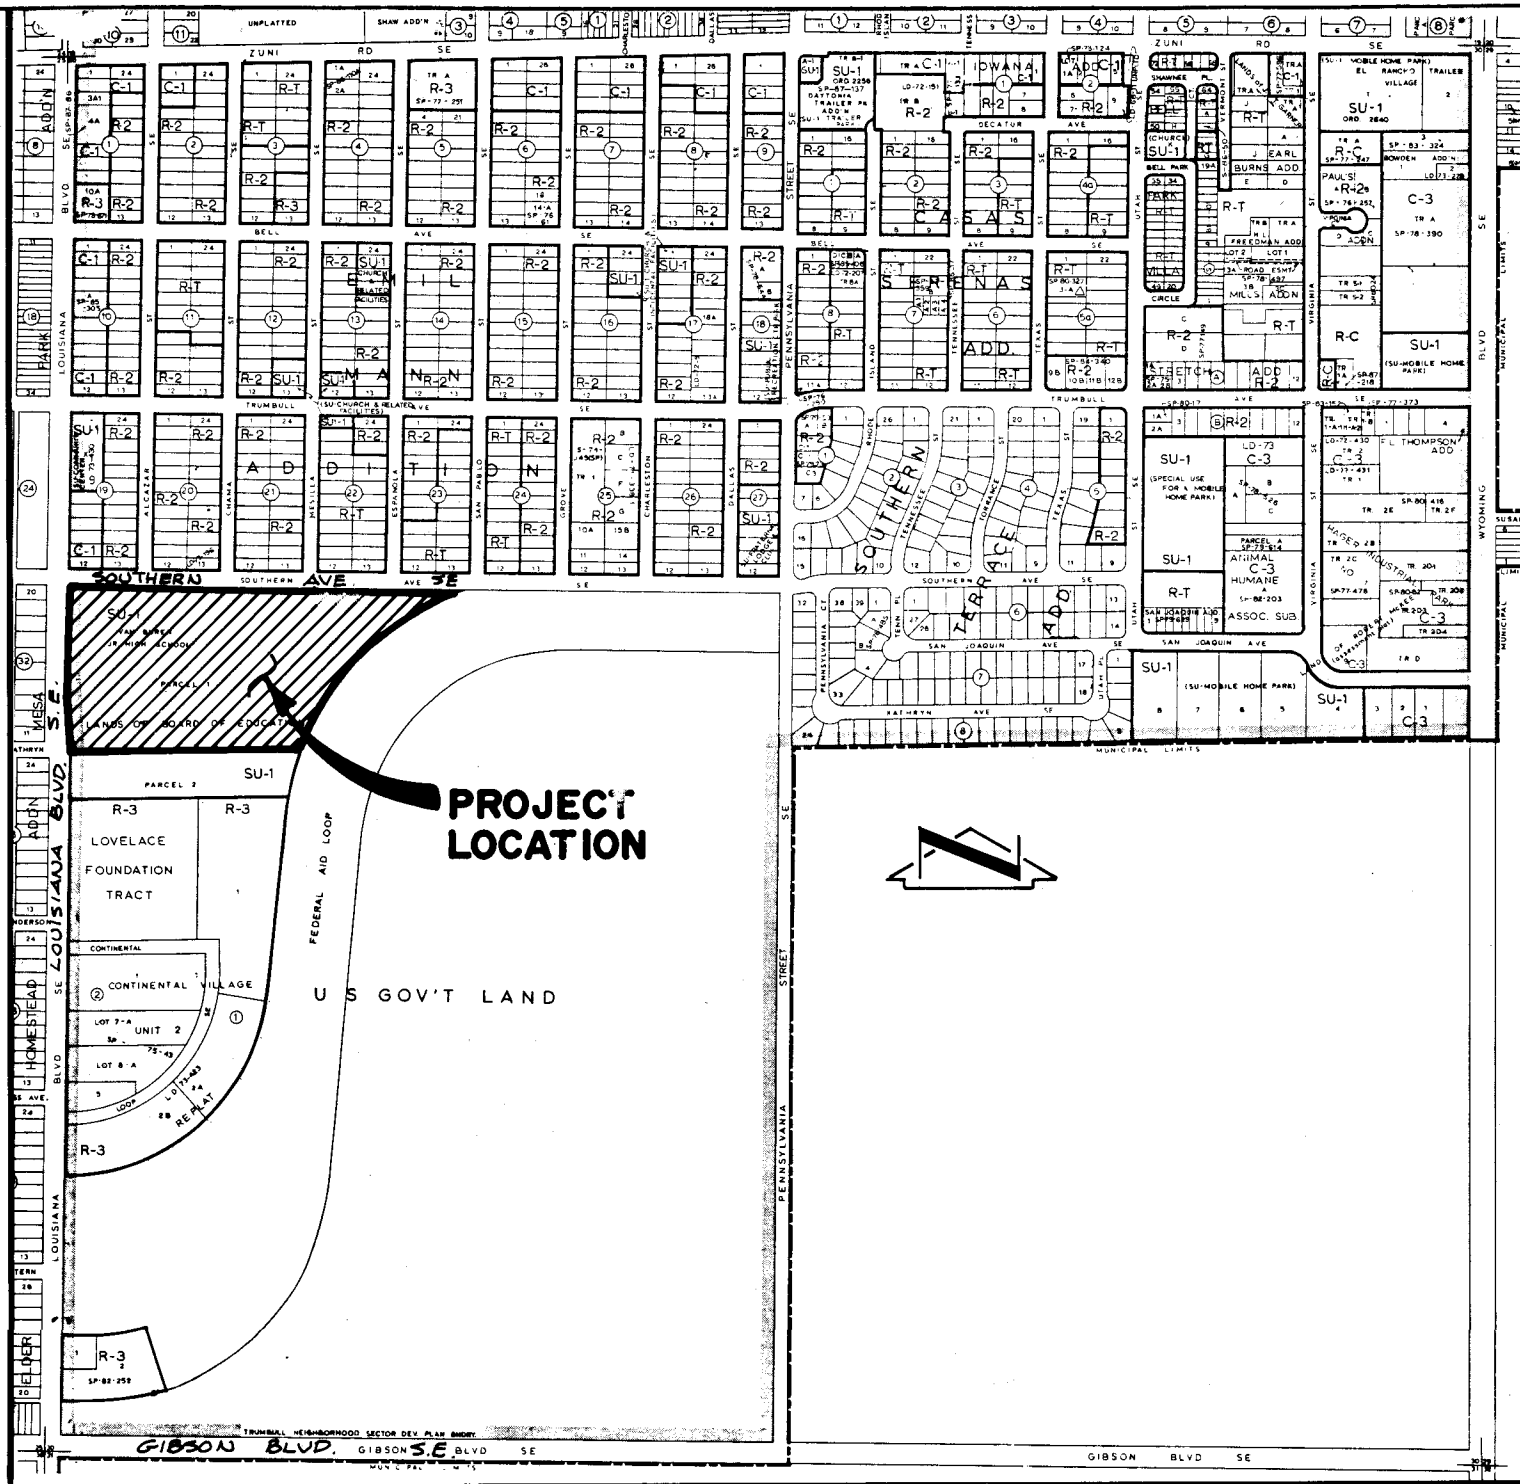

LOCATION MAP - VAN BUREN (L-19)
SCALE : 1" = 800' (APPROX.)

RECORD DRAWING

RECORD DRAWING

I, Jeffrey G. Mortensen, Registered Professional Engineer in the State of New Mexico, do hereby certify that this "as-built" information was obtained by me or under my supervision and represents the "as-built" conditions of this project, and is true and correct to the best of my knowledge and belief. All vertical and horizontal dimensions should be field verified prior to use on future projects.

Jeffrey G. Mortensen
Professional Engineer
New Mexico
8547
Date 7-16-90

CITY OF ALBUQUERQUE
PUBLIC WORKS DEPARTMENT
ENGINEERING GROUP
TITLE: JOHN ADAMS, TRUMAN & VAN BUREN MIDDLE SCHOOLS
VALLEY & WEST MESA HIGH SCHOOLS
LOCATION MAPS



APPROVALS	ENGINEER	DATE	APPROVALS	ENGINEER	DATE
D.R.C. CHAIRMAN	Rogers	7-18-90	WATER	R.W. Kane	7-16-90
TRANSPORTATION	Edmund	7-17-90	WASTE WATER	R.W. Kane	7-16-90
HYDROLOGY	N/A				

PROJECT NO. 4111.90
MAP NO. SEE ABOVE
SHEET 2 OF 25

ENGINEER'S SEAL		SURVEY INFORMATION		BENCH MARKS		AS BUILT INFORMATION	
		FIELD NOTES					
		NO.	BY	DATE			
						</	

1 2 3 4 5 6 7 8 9 10 11 12 13 14 15
26 47 11 900290

891816
871829
891812
31285
31415
SCANNED BY
BY LASON

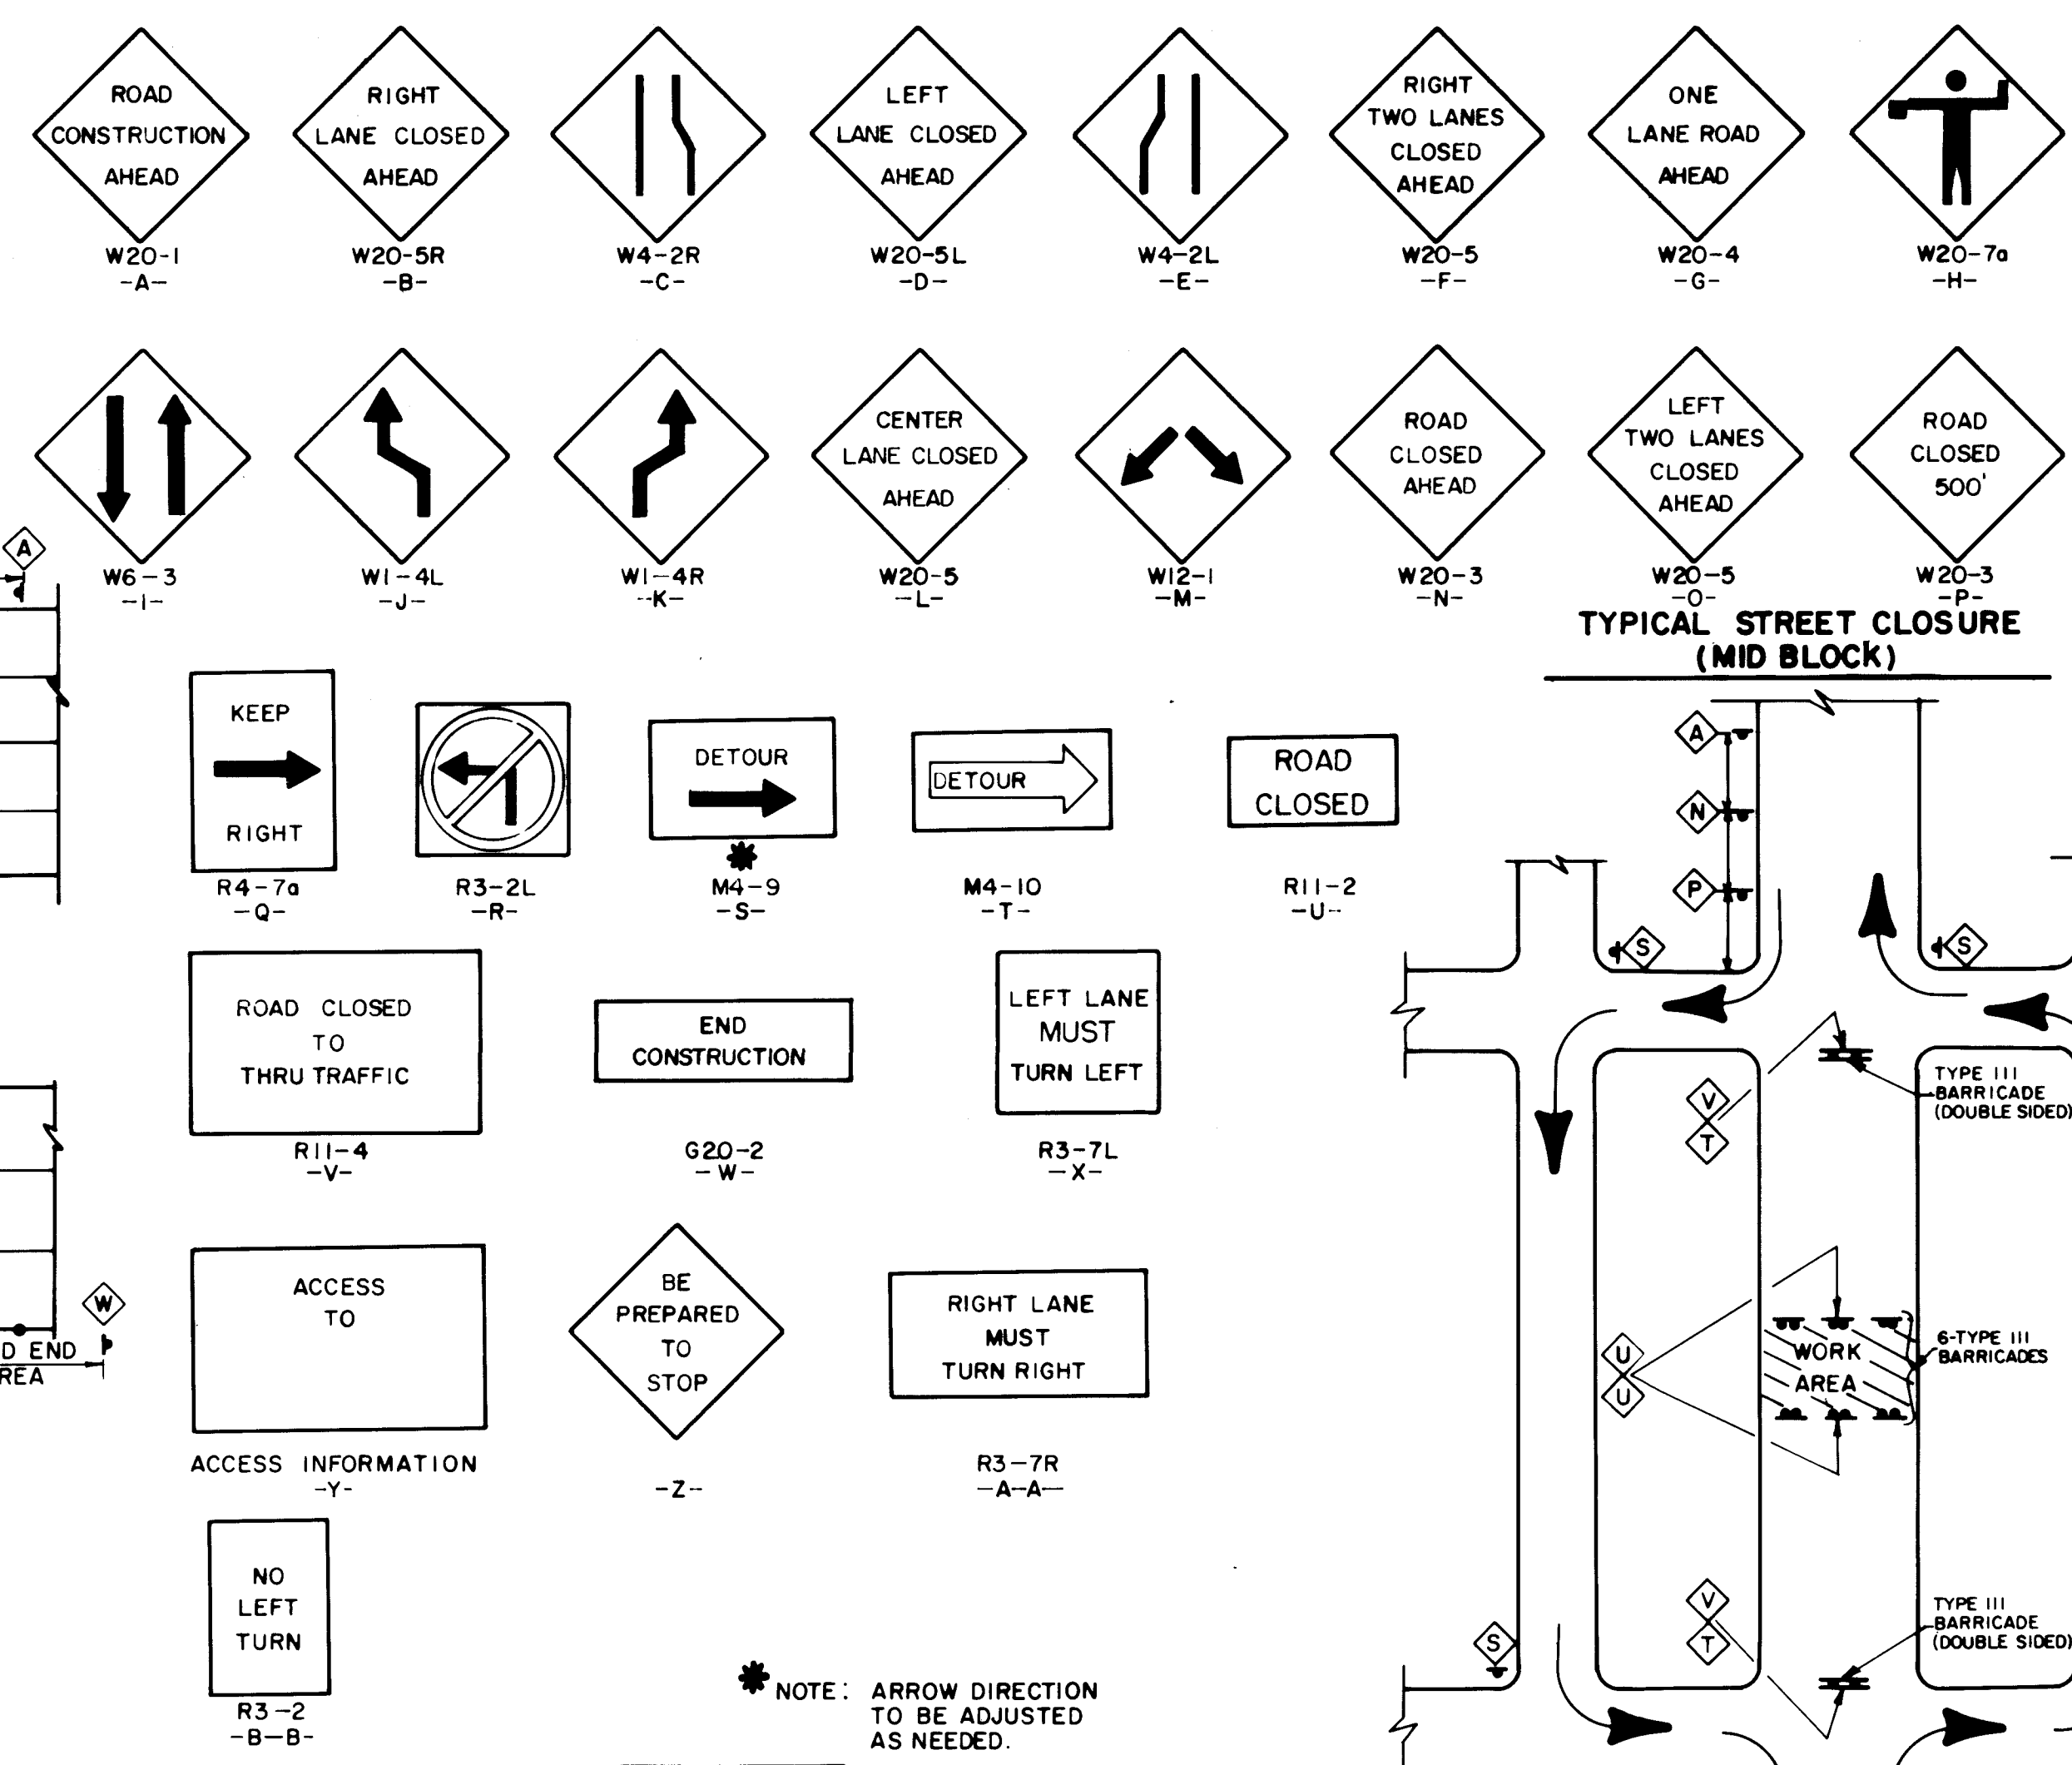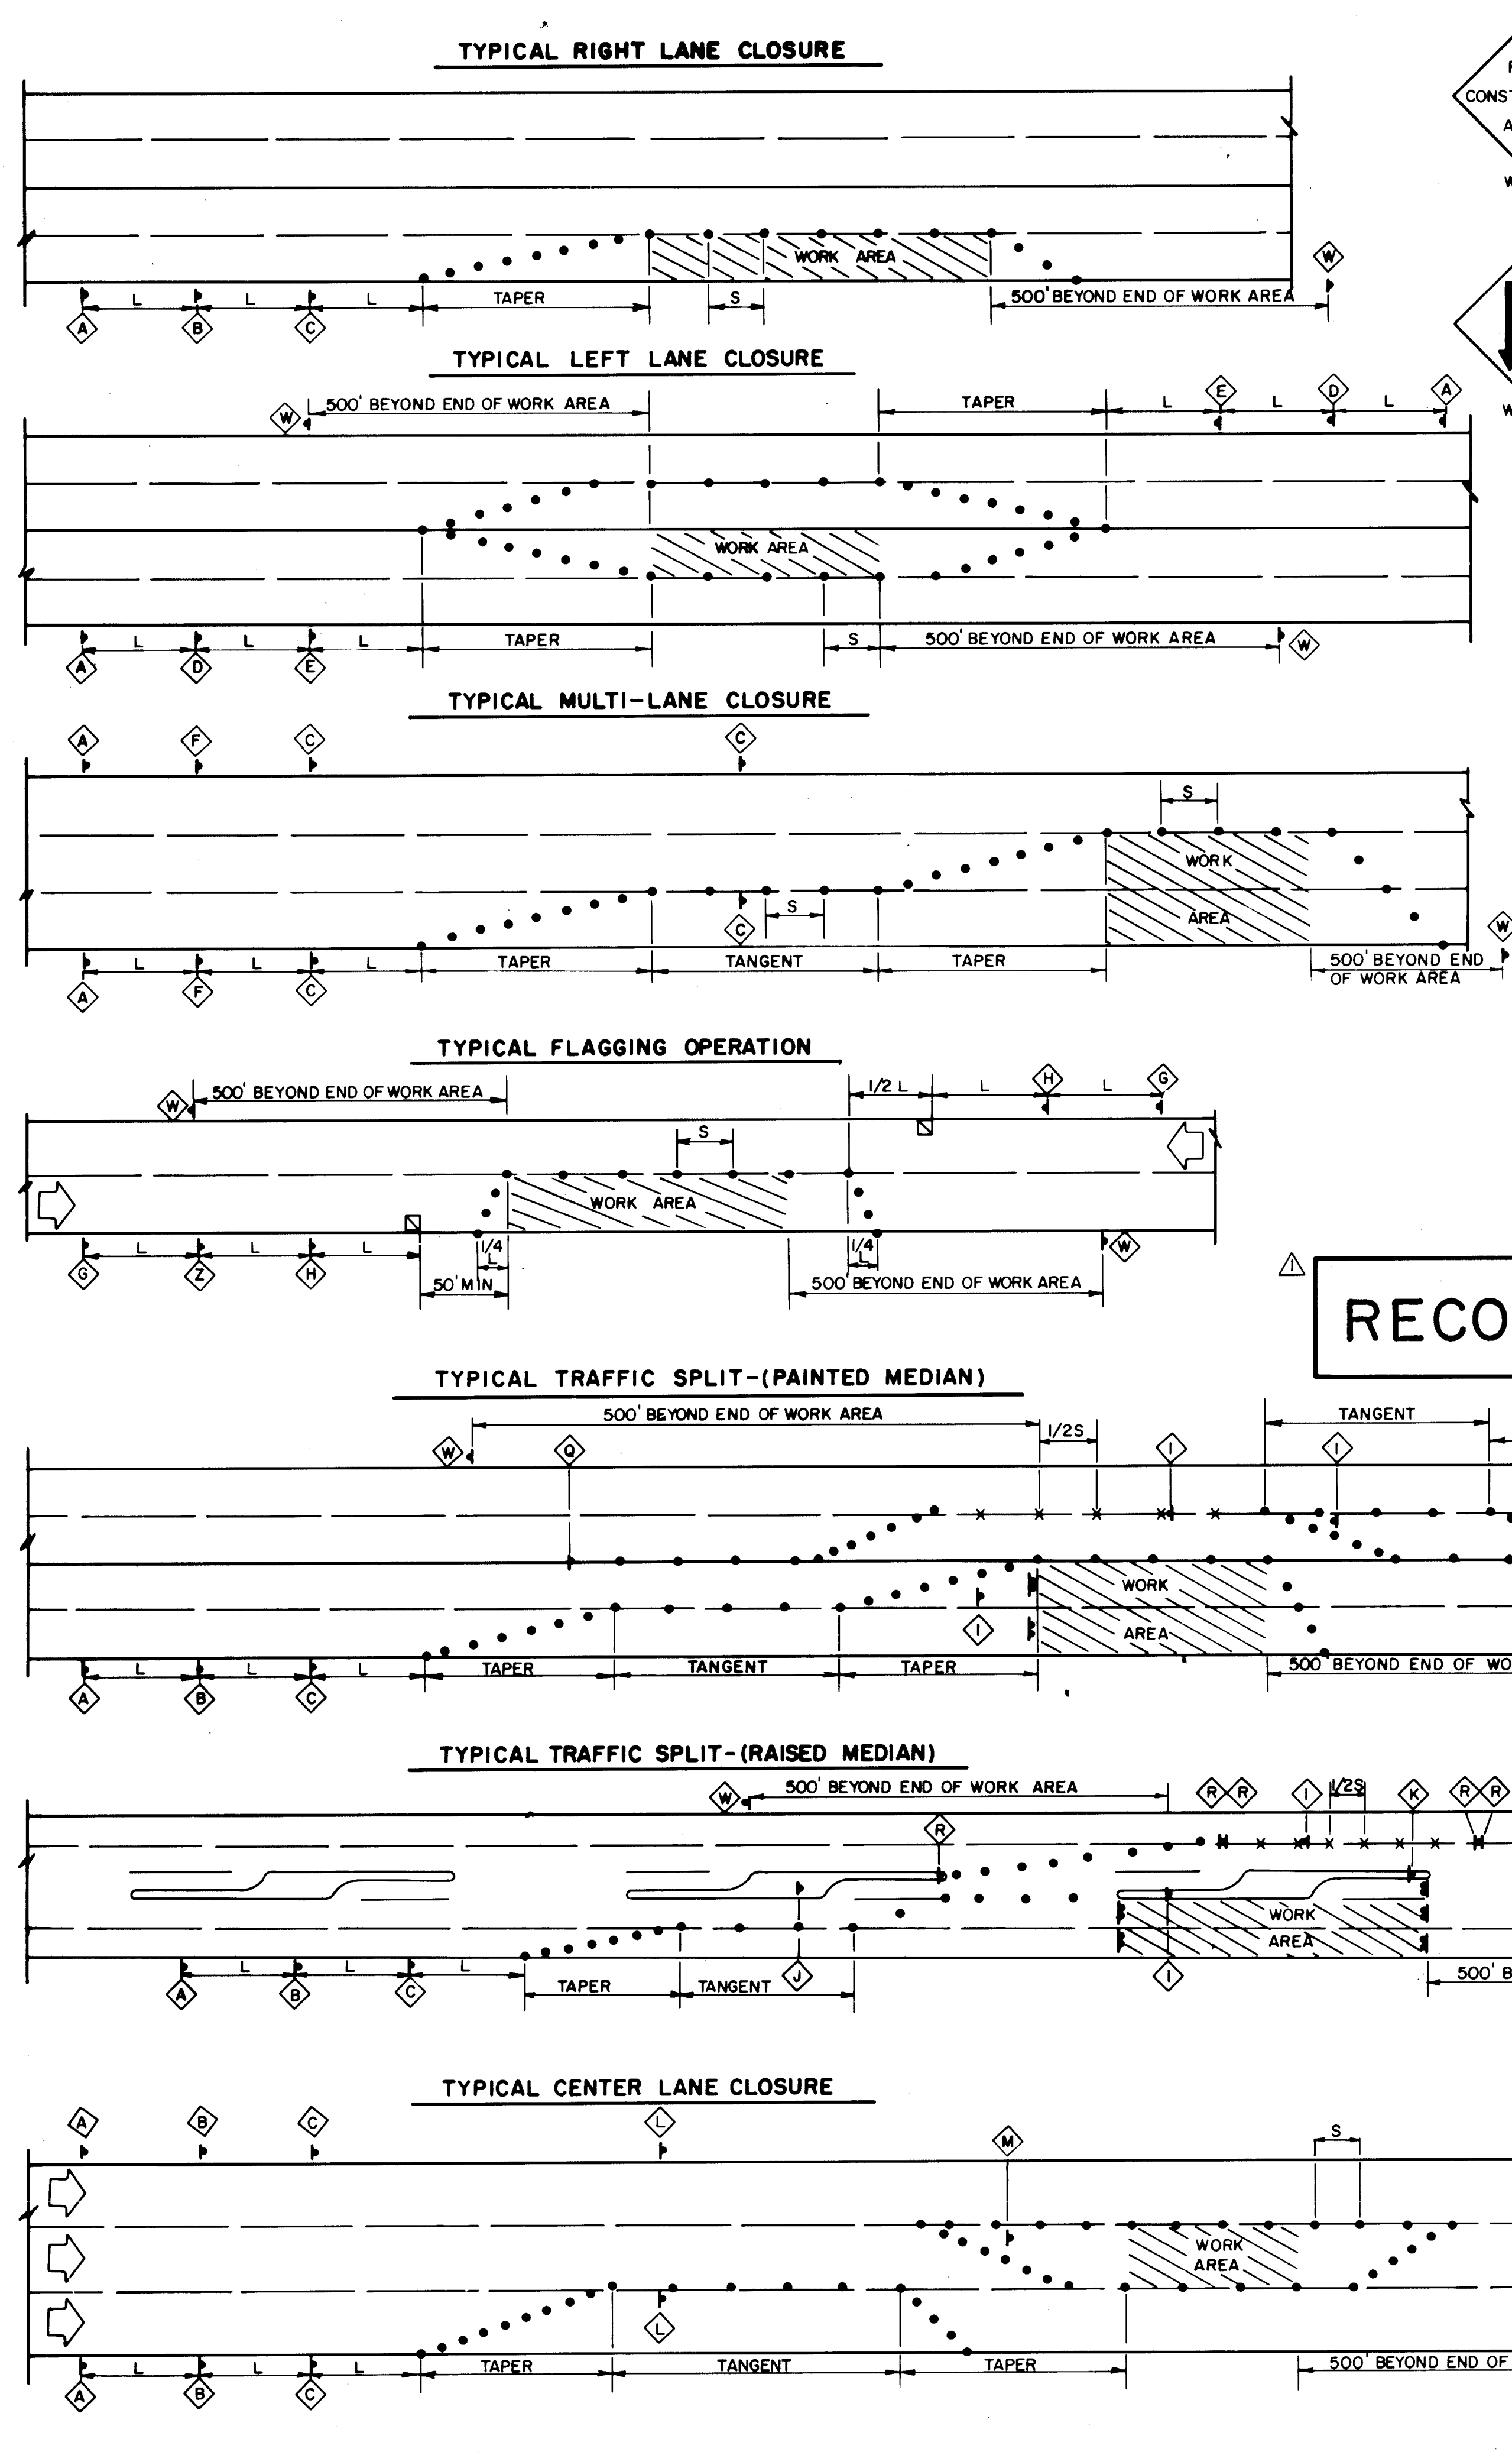

RECORD DRAWING

AS BUILT INFORMATION

CONTRACT NO. J.M.A. DATE N/A

STREET BY J.M.A. DATE 10/90

FIELD BY J.M.A. DATE 10/90

DESIGNED BY J.M.A. DATE 10/90

DRAWN BY J.M.A. DATE 10/90

CHECKED BY J.M.A. DATE 10/90

ENGINEER'S SEAL

Jeffrey G. Mortensen, Registered Professional Engineer in the State of New Mexico, do hereby certify that this "as-built" information was obtained by me or under my supervision and represents the "as-built" conditions of this project, and is true and correct to the best of my knowledge and belief. All vertical and horizontal dimensions should be field verified prior to use on future projects.

TAPER REQUIREMENTS

SPEED LIMIT (MPH)	TAPER LENGTH (FEET)			MAXIMUM DISTANCE BETWEEN DEVICES (FEET)	MINIMUM NUMBER OF DEVICES REQUIRED
	10' LANE	11' LANE	12' LANE		
25	104	115	125	25	6
30	150	165	185	30	7
35	204	225	245	35	8
40	267	293	320	40	9
45	450	495	540	45	13
50	500	550	600	50	13
55	550	605	660	55	13

CITY OF ALBUQUERQUE PUBLIC WORKS DEPARTMENT ENGINEERING GROUP

TITLE: ALBUQUERQUE PUBLIC SCHOOLS 1990 WATERLINE EXTENSIONS TRAFFIC CONTROL DETAILS


APPROVALS	ENGINEER	DATE	APPROVALS	ENGINEER	DATE
D.R.C. CHAIRMAN	Rogelio Jimenez	7-18-90	WATER	R.W. Kane	7-16-90
TRANSPORTATION	Alfonso	7-17-90	WASTE WATER	R.W. Kane	7-16-90
HYDROLOGY	N/A				

PROJECT NO. 4111.90

MAP NO. N/A

SHEET 3 OF 25

RECORD DRAWING

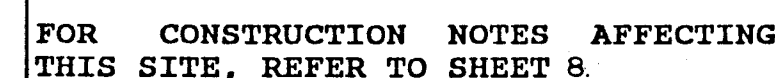

AS BUILT	INFORMATION
CONTRACTOR	JONES INDUSTRIES
DRAWN BY	J.M.A.
CHECKED BY	J.M.A.
DATE	DATE
APPROVED BY	M.A.S.
FIELD VERIFICATION BY	M.A.S.
DATE	DATE
REVIEWED BY	J.M.A.
DATE	DATE
CORRECTED BY	MICRO-FILM INFORMATION
DATE	DATE

BENCH MARKS
AN A.C.S. BENCHMARK, NO. 4-111; A
CHARGEABLE "X" ON THE N.W. BONNET BOLT
OF A FIRE HYDRANT @ THE INTERSEC-
TION OF GLENKIRK RD. N.W.; 6/94/1945
ELEVATION = 5092.98' / FEET (MSLB)
E.S. N.W.

SURVEY INFORMATION

ENGINEER'S SEAL

 **RECORD DRAWING**

I, Jeffrey G. Mortensen, Registered Professional Engineer in the State of New Mexico, do hereby certify that this "as-built" information was obtained by me under my supervision and represents the "as-built" conditions of this project, and is true and correct to the best of my knowledge and belief. All vertical and horizontal dimensions should be field verified prior to use on future projects.

use on future projects


Jeffrey G. Mortensen
NMEP No. 854



Date 4/4/90

CITY OF ALBUQUERQUE
PUBLIC WORKS DEPARTMENT
ENGINEERING GROUP

TITLE: JOHN ADAMS MIDDLE SCHOOL
SITE PLAN

APPROVALS	ENGINEER	DATE	APPROVALS	ENGINEER	DATE
D.R.C. Chairman	Roger A. Deane	7-18-90	Water	R.W. Kane	7-16-90
Transportation	R.D. Bunte	7-17-90	Waste Water	R.W. Kane	7-16-90
Hydrology	N/A				

PROJECT NO.	4111.90	MAP NO.	J-11	SHEET	4	OF	25
-------------	---------	---------	------	-------	---	----	----

RECORD DRAWING

JOHN I. CHAVEZ Abbitton

SCANNED BY
BY LASON

31415

PALISADES ABBITION
LOTS 85 - 102, FILED JUNE 18, 1949, D-063

HIDALGO CIRCLE

N.W.

LOMA HERMOSA

DR. N. W.

GLENN R I O

TRACTS 200, 201, 202 & 203
AIRPORT UNIT
TOWN OF ATRISCO GRANT
JULY 21, 1954, BOOK 6-285, PAGES 443-444

JOHN I. CHAVEZ ADDITION
LOT 1-29, FILED

RECORD DRAWING

NOTES:

1. BEARING BASE IS DEED FILED JULY 21, 1954, BOOK D-285, PAGES 443-444.
2. FIELD SURVEY PERFORMED ON DECEMBER 4, 1989.
3. EASEMENT FILED ON SEPTEMBER 21, 1990, BOOK 90-15, PAGES 7110 - 7113, DOC. # 9073812.

RECORD DRAWING

I, Jeffrey G. Mortensen, Registered Professional Engineer in the State of Mexico, do hereby certify that this "as-built" information was obtained by me or under my supervision and represents the "as-built" conditions of this project, and is true and correct to the best of my knowledge and belief. All vertical and horizontal dimensions should be field verified prior to use on future projects.

Jeffrey G. Mortensen
NMPE No. 854

JEFFREY & MORTENSEN
NEW MEXICO
REGISTERED PROFESSIONAL ENGINEERS
490
Date

CITY OF ALBUQUERQUE
PUBLIC WORKS DEPARTMENT
ENGINEERING GROUP

TITLE:	JOHN ADAMS MIDDLE SCHOOL
--------	--------------------------


EASEMENT SURVEY

APPROVALS	ENGINEER	DATE	APPROVALS	ENGINEER	DATE
D.R.C. Chairman	<i>Roger W. Kane</i>	7-18-90	Water	<i>R.W. Kane</i>	7-16-90
Transportation	<i>R. W. Kane</i>	7-17-90	Waste Water	<i>R.W. Kane</i>	7-16-90
Hydrology	<i>N/A</i>				

PROJECT NO.	4111.90	MAP NO.	J-11	SHEET	5	OF	25
-------------	---------	---------	------	-------	---	----	----

SURVEY INFORMATION		BENCH MARKS	AS BUILT INFORMATION	
FIELD NOTES			CONTRACTOR	JONIES INDUSTRIES
NO.	BY DATE	AN A.C.S. BENCH MARK, NO. 4111; A CHISELED "X" ON THE NW CORNER BOLT OF A FIRE HYDRANT @ THE INTERSECTION OF GLENVIEW RD. NW. 141.15 ACRES DR. NW. ELEVATION = 5092.981 FEET (M.S.L.D.)	WORK ORDER BY J.M.A. DATE 09/19/00	INSPECTED BY M.A.S. DATE 10/19/00
			ACCEPTED BY J.M.A. DATE 10/19/00	VERIFICATION BY M.A.S. DATE 10/19/00
			DRAWING BY J.M.A. DATE 10/19/00	
			MICRO-FILM INFORMATION	
			RECORDED BY	DATE
			NO	

SURVEYOR'S SEAL

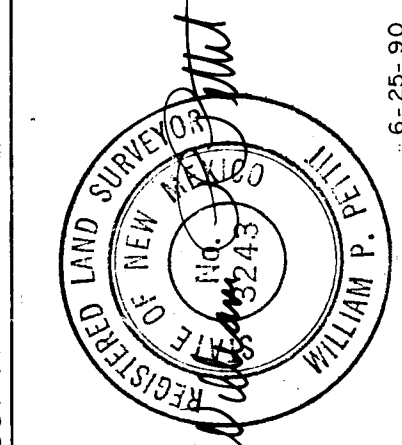

1


[illegible]

RECORD DRAWING

G: _____
ION & OTHER UNDERGROUND LINES
REPORTED TO CROSS THE NEW WATERLINE
MENT; ALL CONTRACTORS SHALL
SITE IN THIS AREA WITH CARE SO AS
DISRUPT EXISTING SERVICE.



I, Jeffrey G. Mortensen, Registered Professional Engineer in the State of New Mexico, do hereby certify that this "as-built" information was obtained by me or under my supervision and represents the "as-built" conditions of this project, and is true and correct to the best of my knowledge and belief. All vertical and horizontal dimensions should be field verified prior to use on future projects.

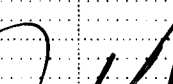
 Jeffrey G. Mortensen
 NMPE No. 8547
 Date 11-90

FOR CONSTRUCTION NOTES AFFECTING
THIS SHEET, REFER TO SHEET 8

HORIZONTAL SCALE: $1'' = 40'$
VERTICAL SCALE: $1'' = 10'$

CITY OF ALBUQUERQUE									
PUBLIC WORKS DEPARTMENT									
ENGINEERING DIVISION									
TITLE:		JOHN ADAMS MIDDLE SCHOOL WATERLINE EXTENSION, PLAN & PROFILE							


APPROVALS		ENGINEER	DATE	APPROVALS		ENGINEER	DATE
DRC Chairman		<i>Ronald Wilson</i>	7-18-90	Water		<i>R.W. Kane</i>	7-16-90
Transportation		<i>R. J. Smith</i>	7-17-90	Waste Water		<i>R.W. Kane</i>	7-16-90
Hydrology		<i>N/A</i>					

PROJECT NO.	4111.90	MAP NO.	J-11	SHEET	6	OF	25
-------------	---------	---------	------	-------	---	----	----

SURVEY INFORMATION		BENCH MARKS		AS BUILT INFORMATION	
NO.	FIELD NOTES	DATE	BY	CONTRACTOR	JONES INDUSTRIES
	AN A.C.S. BENCHMARK, NO. 4-III; A C-18B2-ED X1 ON THE NW CORNER BOLT OF A FIRE HYDRANT @ THE INTERSECTION OF CLEVELAND RD. NW. FALGOUTHS DR. N.W. ELEVATION = 5092.93' FEET (M.S.L.D.)			STARTED BY	J.M.A.
				INSPECTED BY	M.A.S.
				ACCEPTANCE BY	M.A.S.
				DATE	10/19/90
				VERIFICATION BY	M.A.S.
				DATE	10/19/90
				DRAWINGS BY	J.M.A.
				DATE	10/19/90
				MICRO-FILM INFORMATION	
				RECORDED BY	DATE
				NO	


[illegible]

RQUE ARTMENT ISION		
E SCHOOL AN & PROFILE		
OVALS	ENGINEER <i>R. W. Kane</i> <i>R. W. Kane</i>	DATE 7-16-9 7-16-9
Water		
SHEET 6 OF 25		

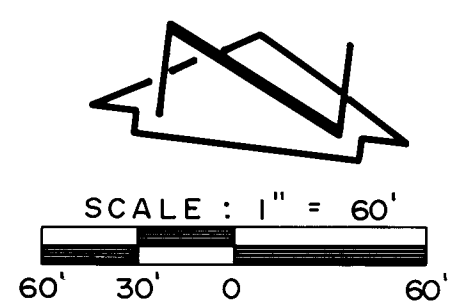

RECORD DRAWING

CURVE	ARC	DELTA	RADIUS	CHORD LENGTH	CHORD BEARING	TAN LENGTH
C1	39.25	89°57'55"	25.00	35.34	N 70°36'37" W	24.98
C2	46.90	107°28'52"	25.00	40.32	N 34°07'33" E	34.08

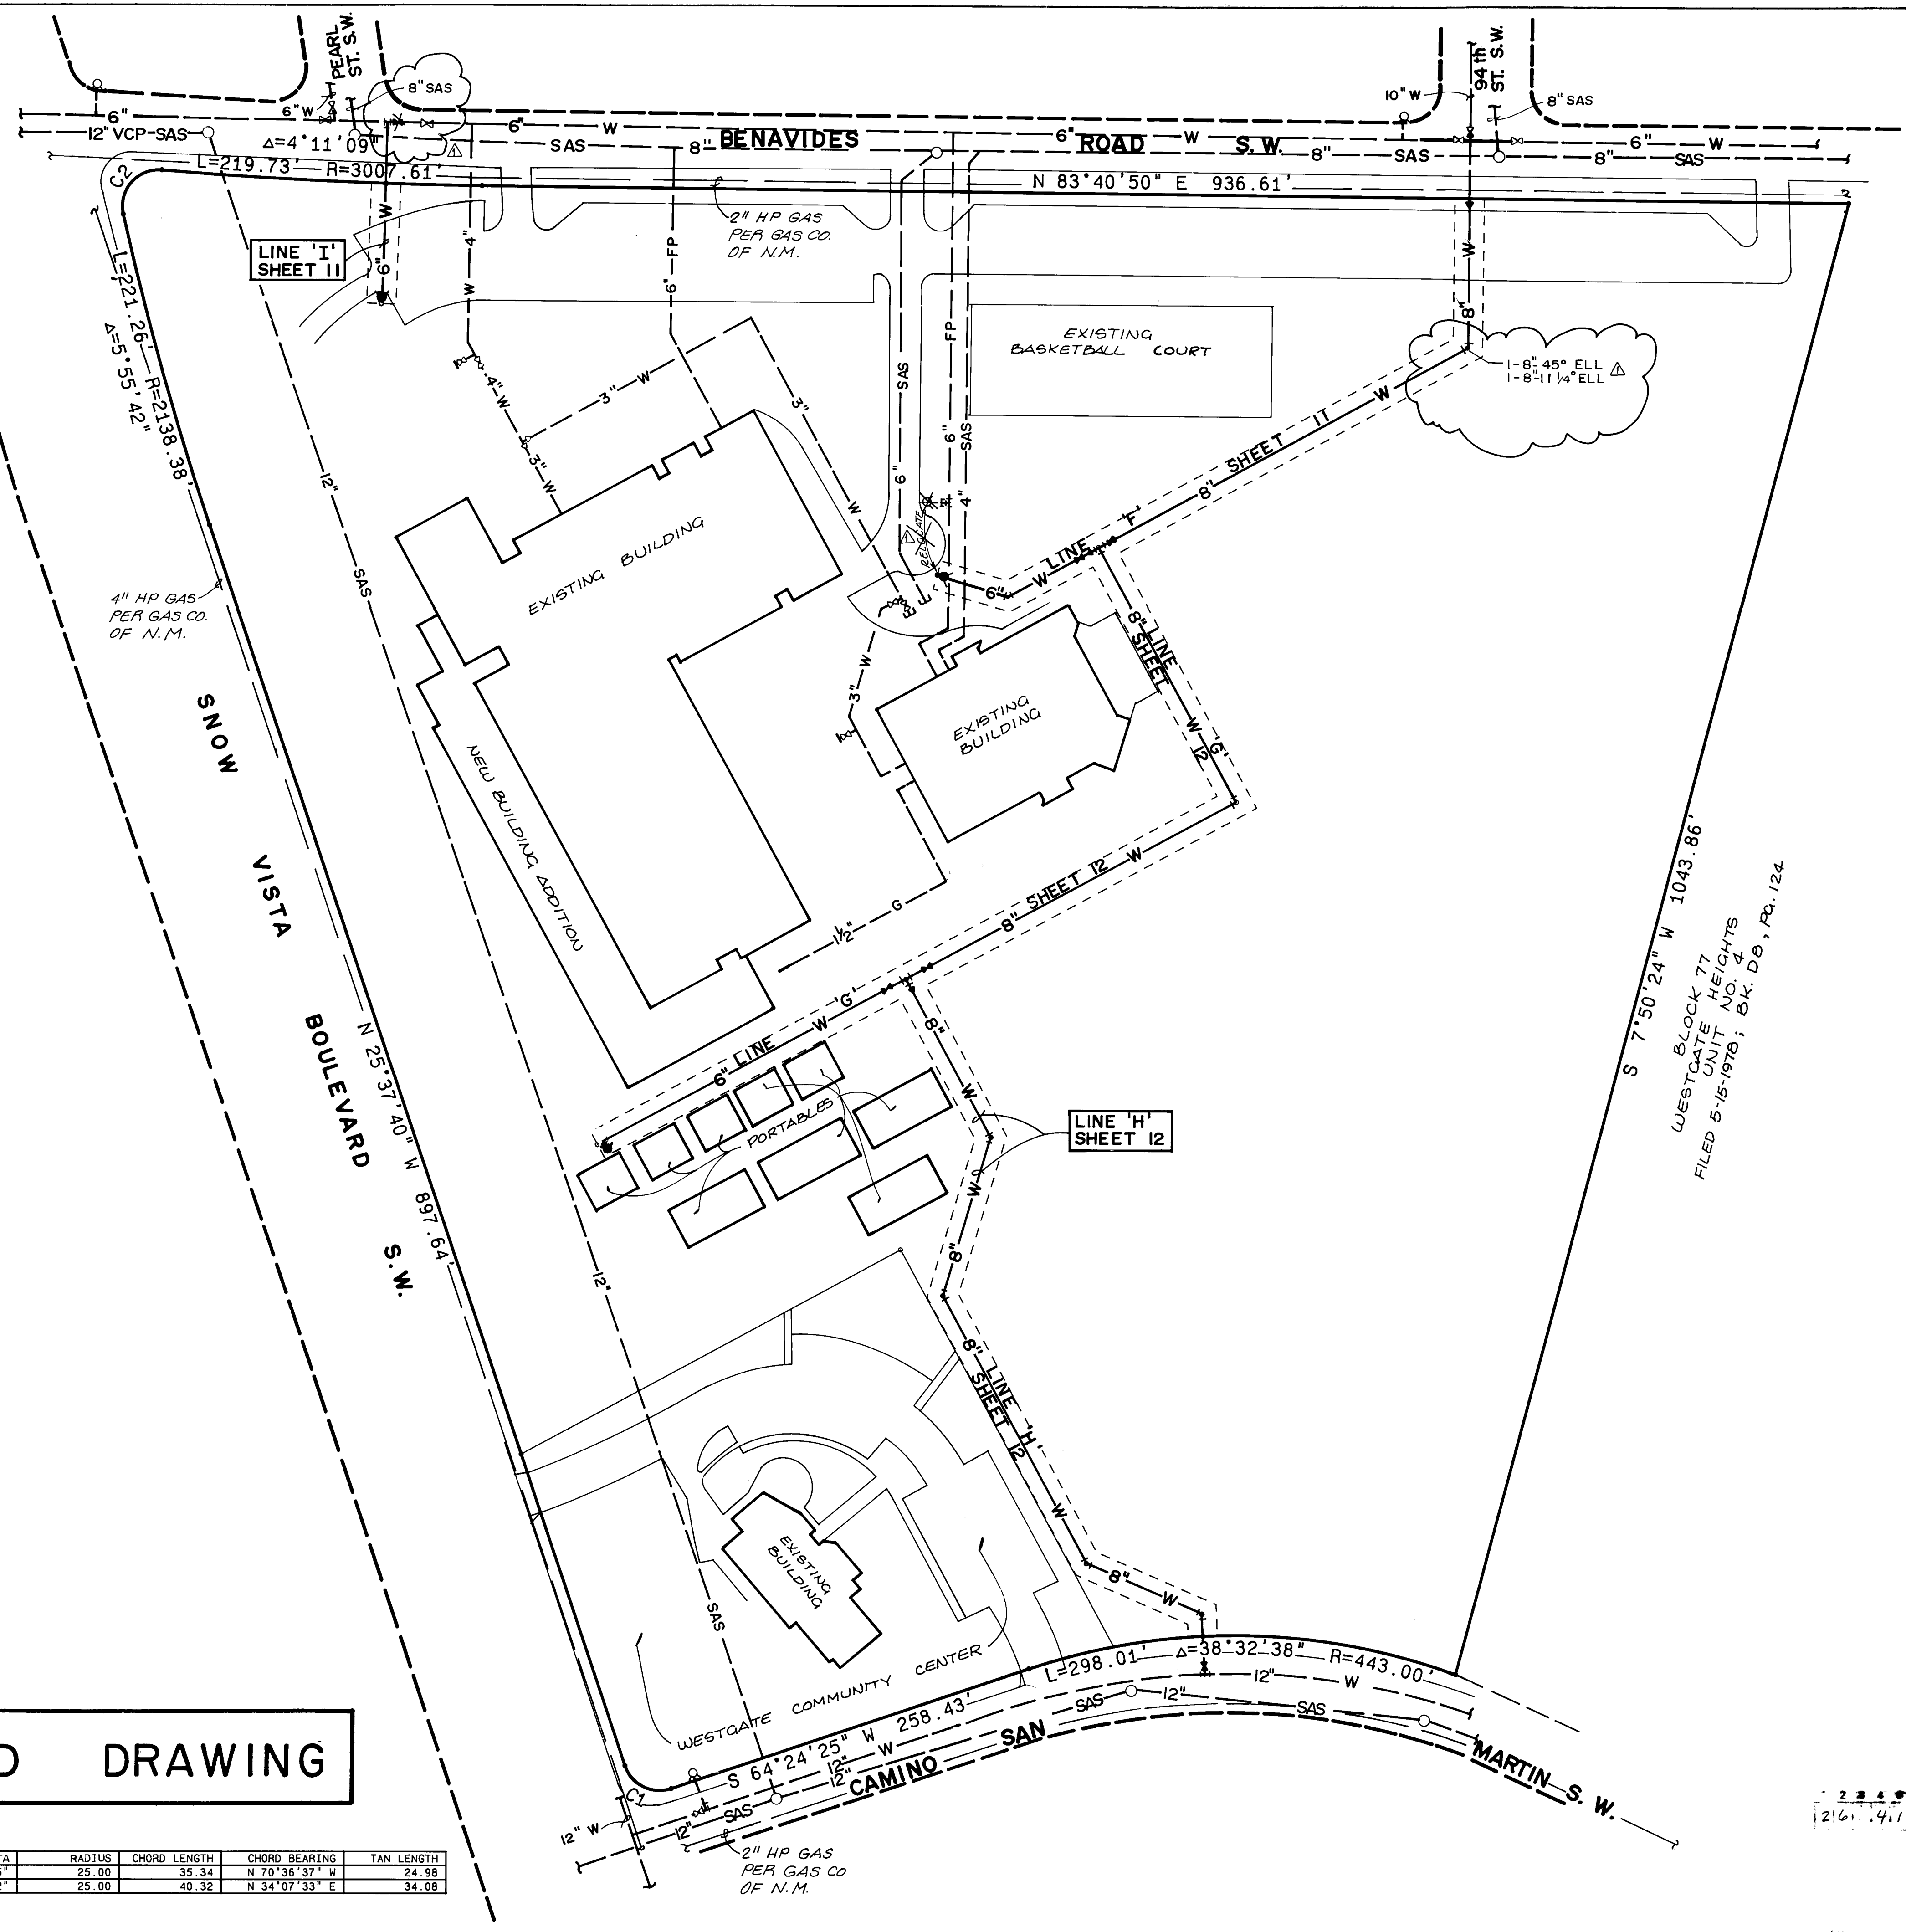

S 7°50'24" W 1043.86'
BLOCK 77
WESTGATE HEIGHTS
UNIT NO. 4
FILED 5-15-1978; BK. D8, Pg. 124

RECORD DRAWING


FOR CONSTRUCTION NOTES AFFECTING THIS SITE, REFER TO SHEET 13

RECORD DRAWING
I, Jeffrey G. Mortensen, Registered Professional Engineer in the State of New Mexico, do hereby certify that this "as-built" information was obtained by me or under my supervision and represents the "as-built" conditions of this project, and is true and correct to the best of my knowledge and belief. All vertical and horizontal dimensions should be field verified prior to use on future projects.

Jeffrey G. Mortensen
New Mexico Professional Engineer
No. 8547
Date 3/90

CITY OF ALBUQUERQUE PUBLIC WORKS DEPARTMENT ENGINEERING GROUP			
TITLE: TRUMAN MIDDLE SCHOOL SITE PLAN			
APPROVALS	ENGINEER	DATE	APPROVALS
D.R.C. CHAIRMAN	R. W. Kane	7-18-90	ENGINEER
TRANSPORTATION	R. W. Kane	7-17-90	DATE
HYDROLOGY	N/A		
DESIGNED BY	J.G.M.	DATE	3/90
DRAWN BY	S.G.H./U.M.C.	DATE	3/90
CHECKED BY	U.G.M.	DATE	6/90
PROJECT NO.	4111.90	MAP NO.	M-9
SHEET	9	OF	25


SURVEY INFORMATION		ENGINEER'S SEAL		AS BUILT INFORMATION	
NO.	BY	DATE	DATE	CONTRACTOR	JONES INDUSTRIES
				STATED BY	J.M.A.
				INSPECTOR'S	DATE 09/90
				FIELD	DATE 10/90
				VERIFICATION BY	M.A.S.
				CORRECTED BY	J.M.A.
				DATE 10/90	
				MICRO-FILM INFORMATION	
				RECORDED BY	NO
				DATE	

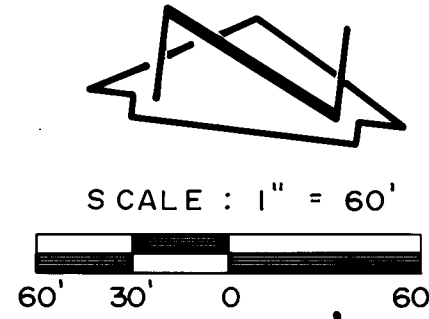

RECORD DRAWING

LINE	BEARING	DISTANCE
L1	N 80° 28' 25" W	45.75
L2	N 80° 28' 25" W	5.00
L3	S 54° 45' 15" W	5.00
L4	S 9° 53' 12" E	15.01
L5	S 4° 44' 02" E	5.00

CURVE	ARC	DELTA	RADIUS	CHORD LENGTH	CHORD BEARING	TAN LENGTH
C1	39.25	89° 57' 55"	25.00	35.34	N 70° 36' 37" W	24.98
C2	46.90	107° 28' 52"	25.00	40.32	N 34° 07' 33" E	34.06

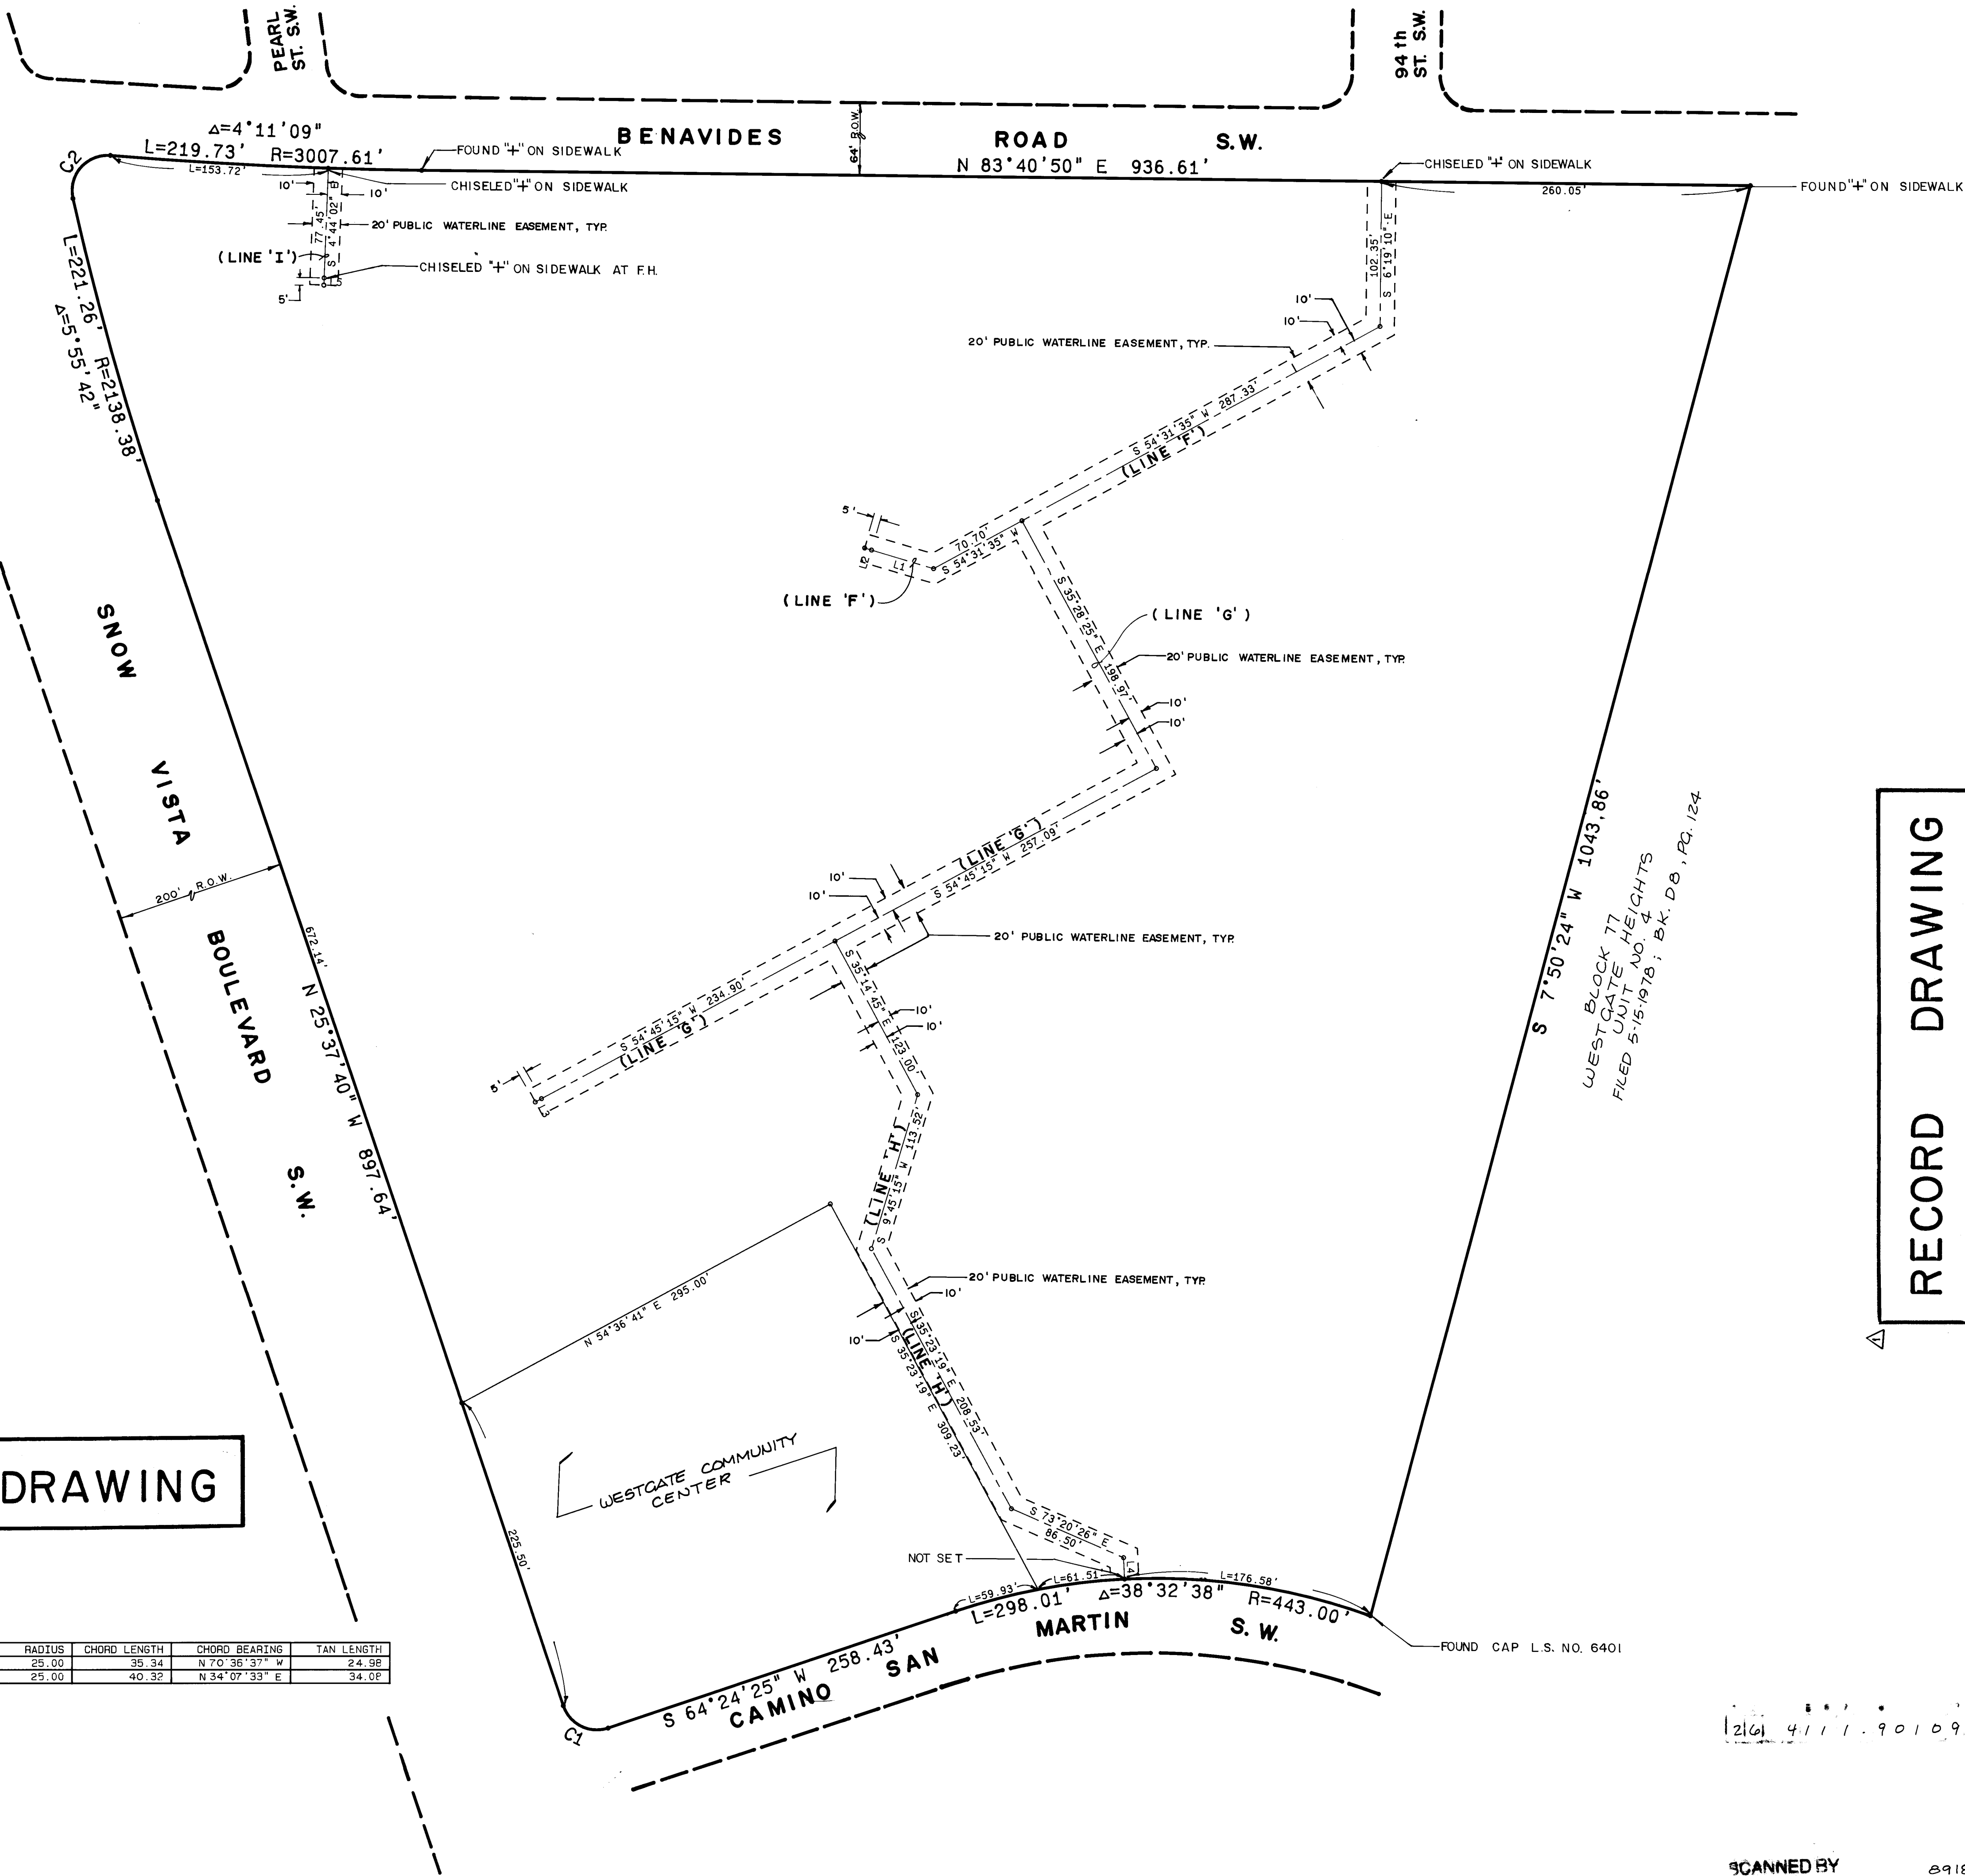

RECORD DRAWING





- NOTES:
- BEARING BASE IS PLAT OF WESTGATE HEIGHTS, UNIT NO. 4, FILED MAY 15, 1978; BOOK D8, PAGE 124.
 - FIELD SURVEY PERFORMED ON FEBRUARY 26, 1990.
 - UNLESS OTHERWISE NOTED, ALL CORNERS ARE 5/8" REBAR LS 3243.
 - EASEMENT FILED ON SEPTEMBER 21, 1990, BOOK 90-15, PAGES 7122 TO 7125, DOC. # 9073815.

RECORD DRAWING

I, Jeffrey G. Mortensen, Registered Professional Engineer in the State of New Mexico, do hereby certify that this "as-built" information was obtained by me or under my supervision and represents the "as-built" conditions of this project, and is true and correct to the best of my knowledge and belief. All vertical and horizontal dimensions should be field verified prior to use on future projects.

Jeffrey G. Mortensen
NEW MEXICO
REGISTERED PROFESSIONAL ENGINEER
No. 8547
Date 4-90

CITY OF ALBUQUERQUE PUBLIC WORKS DEPARTMENT ENGINEERING GROUP					
TITLE: TRUMAN MIDDLE SCHOOL EASEMENT SURVEY					
APPROVALS	ENGINEER	DATE	APPROVALS	ENGINEER	DATE
D.R.C. Chairman	R. W. Kane	7-18-90	Water	R. W. Kane	7-16-90
Transportation	R. W. Kane	7-17-90	Waste Water	R. W. Kane	7-16-90
Hydrology	N/A				
PROJECT NO.	4111.90	MAP NO.	M-9	SHEET	10 OF 25

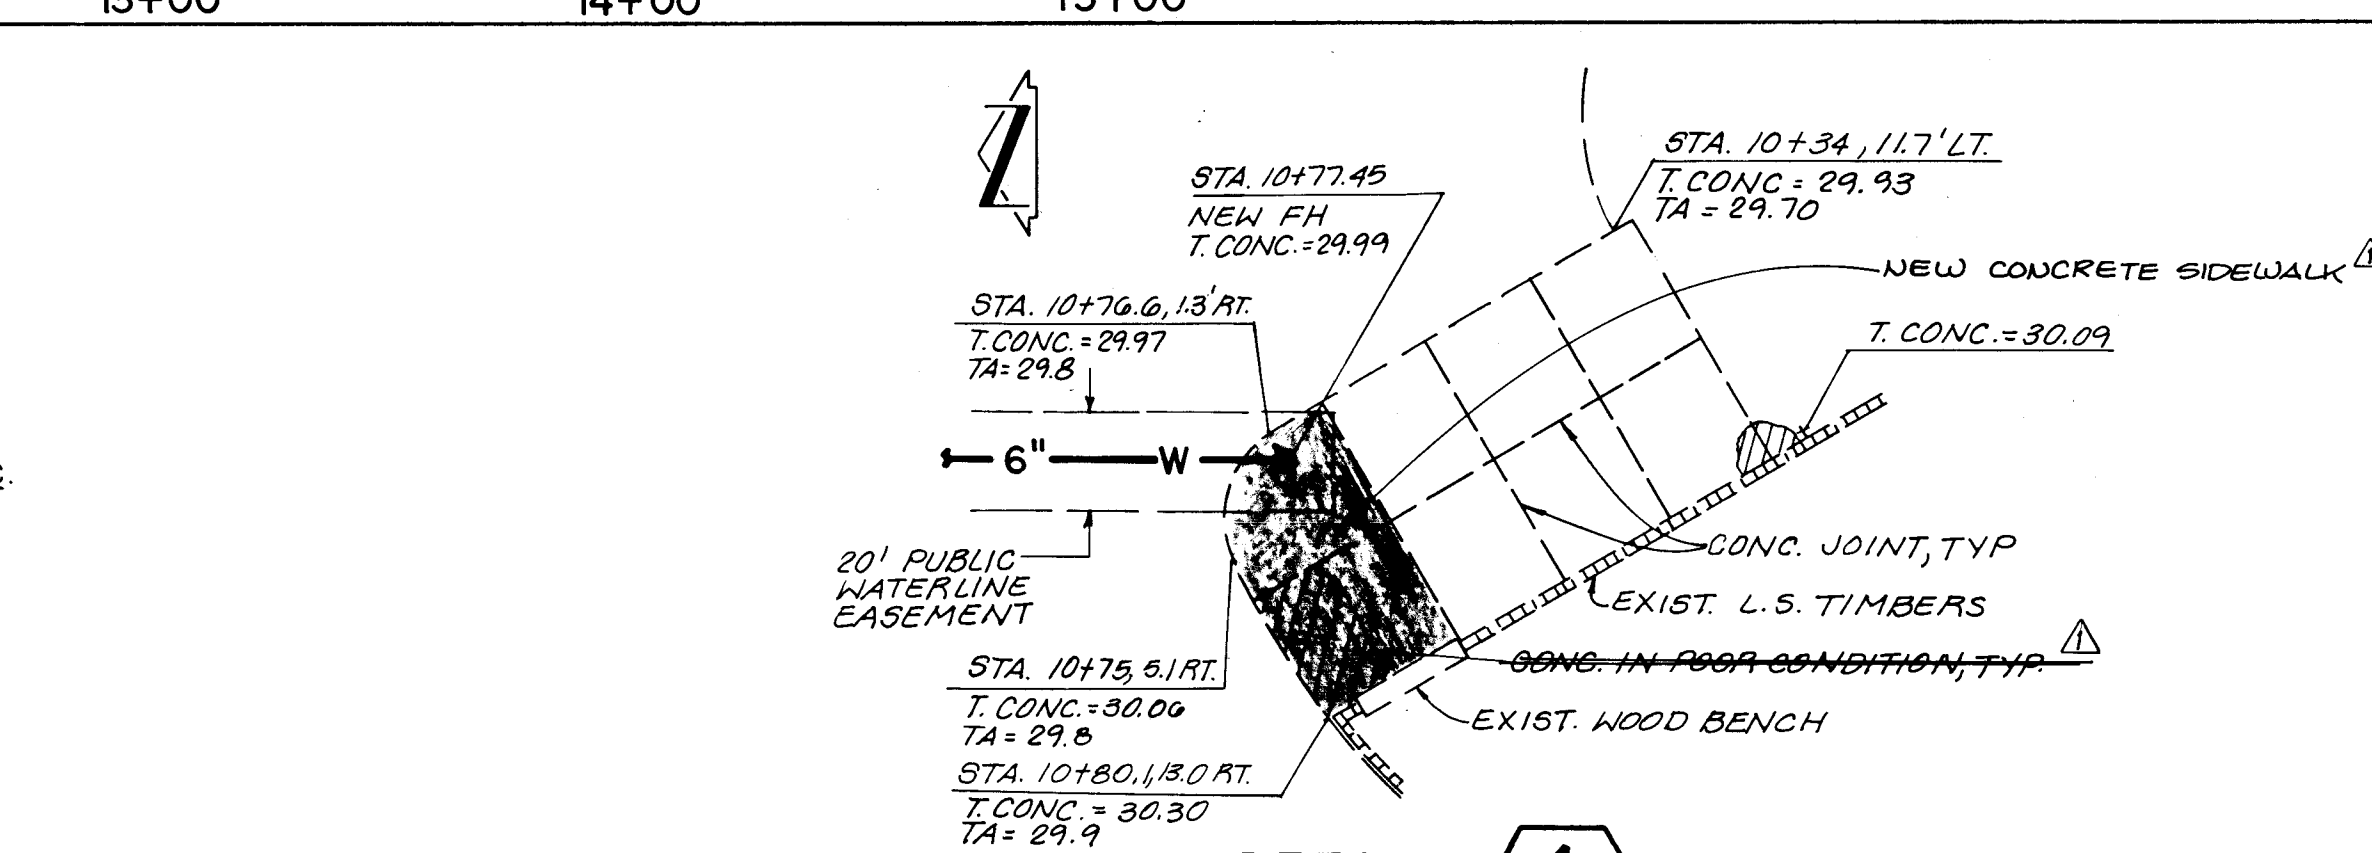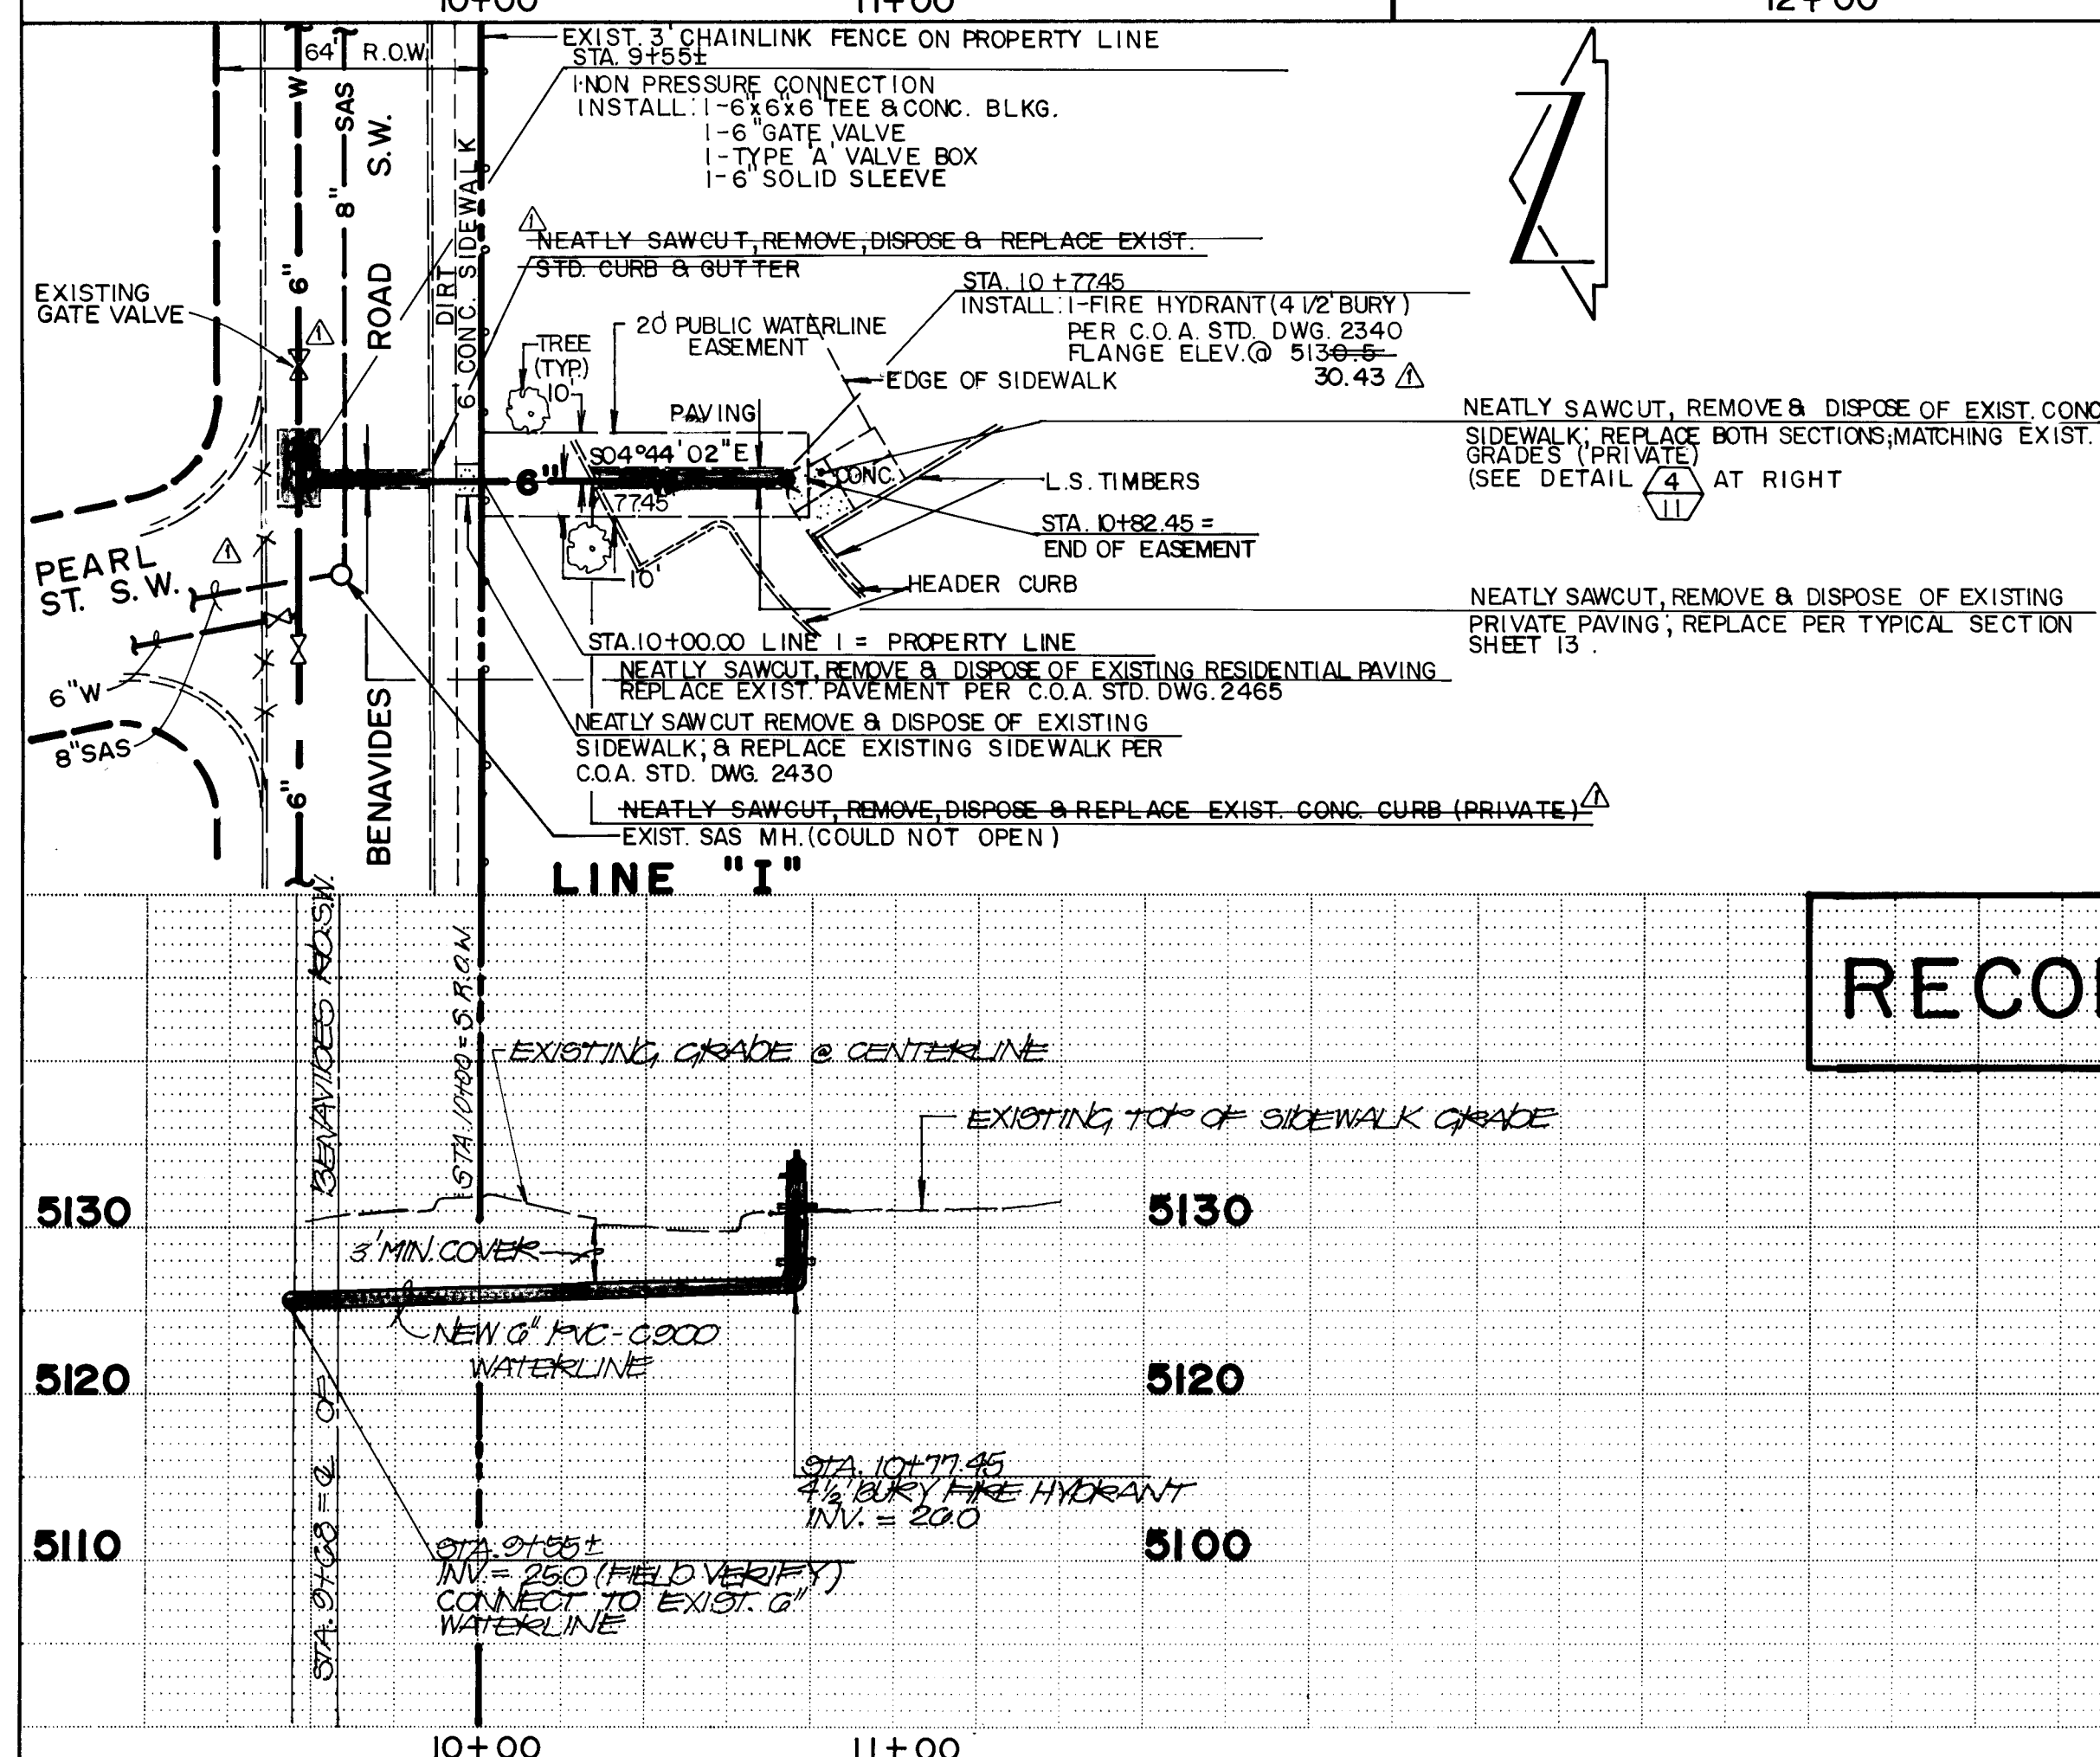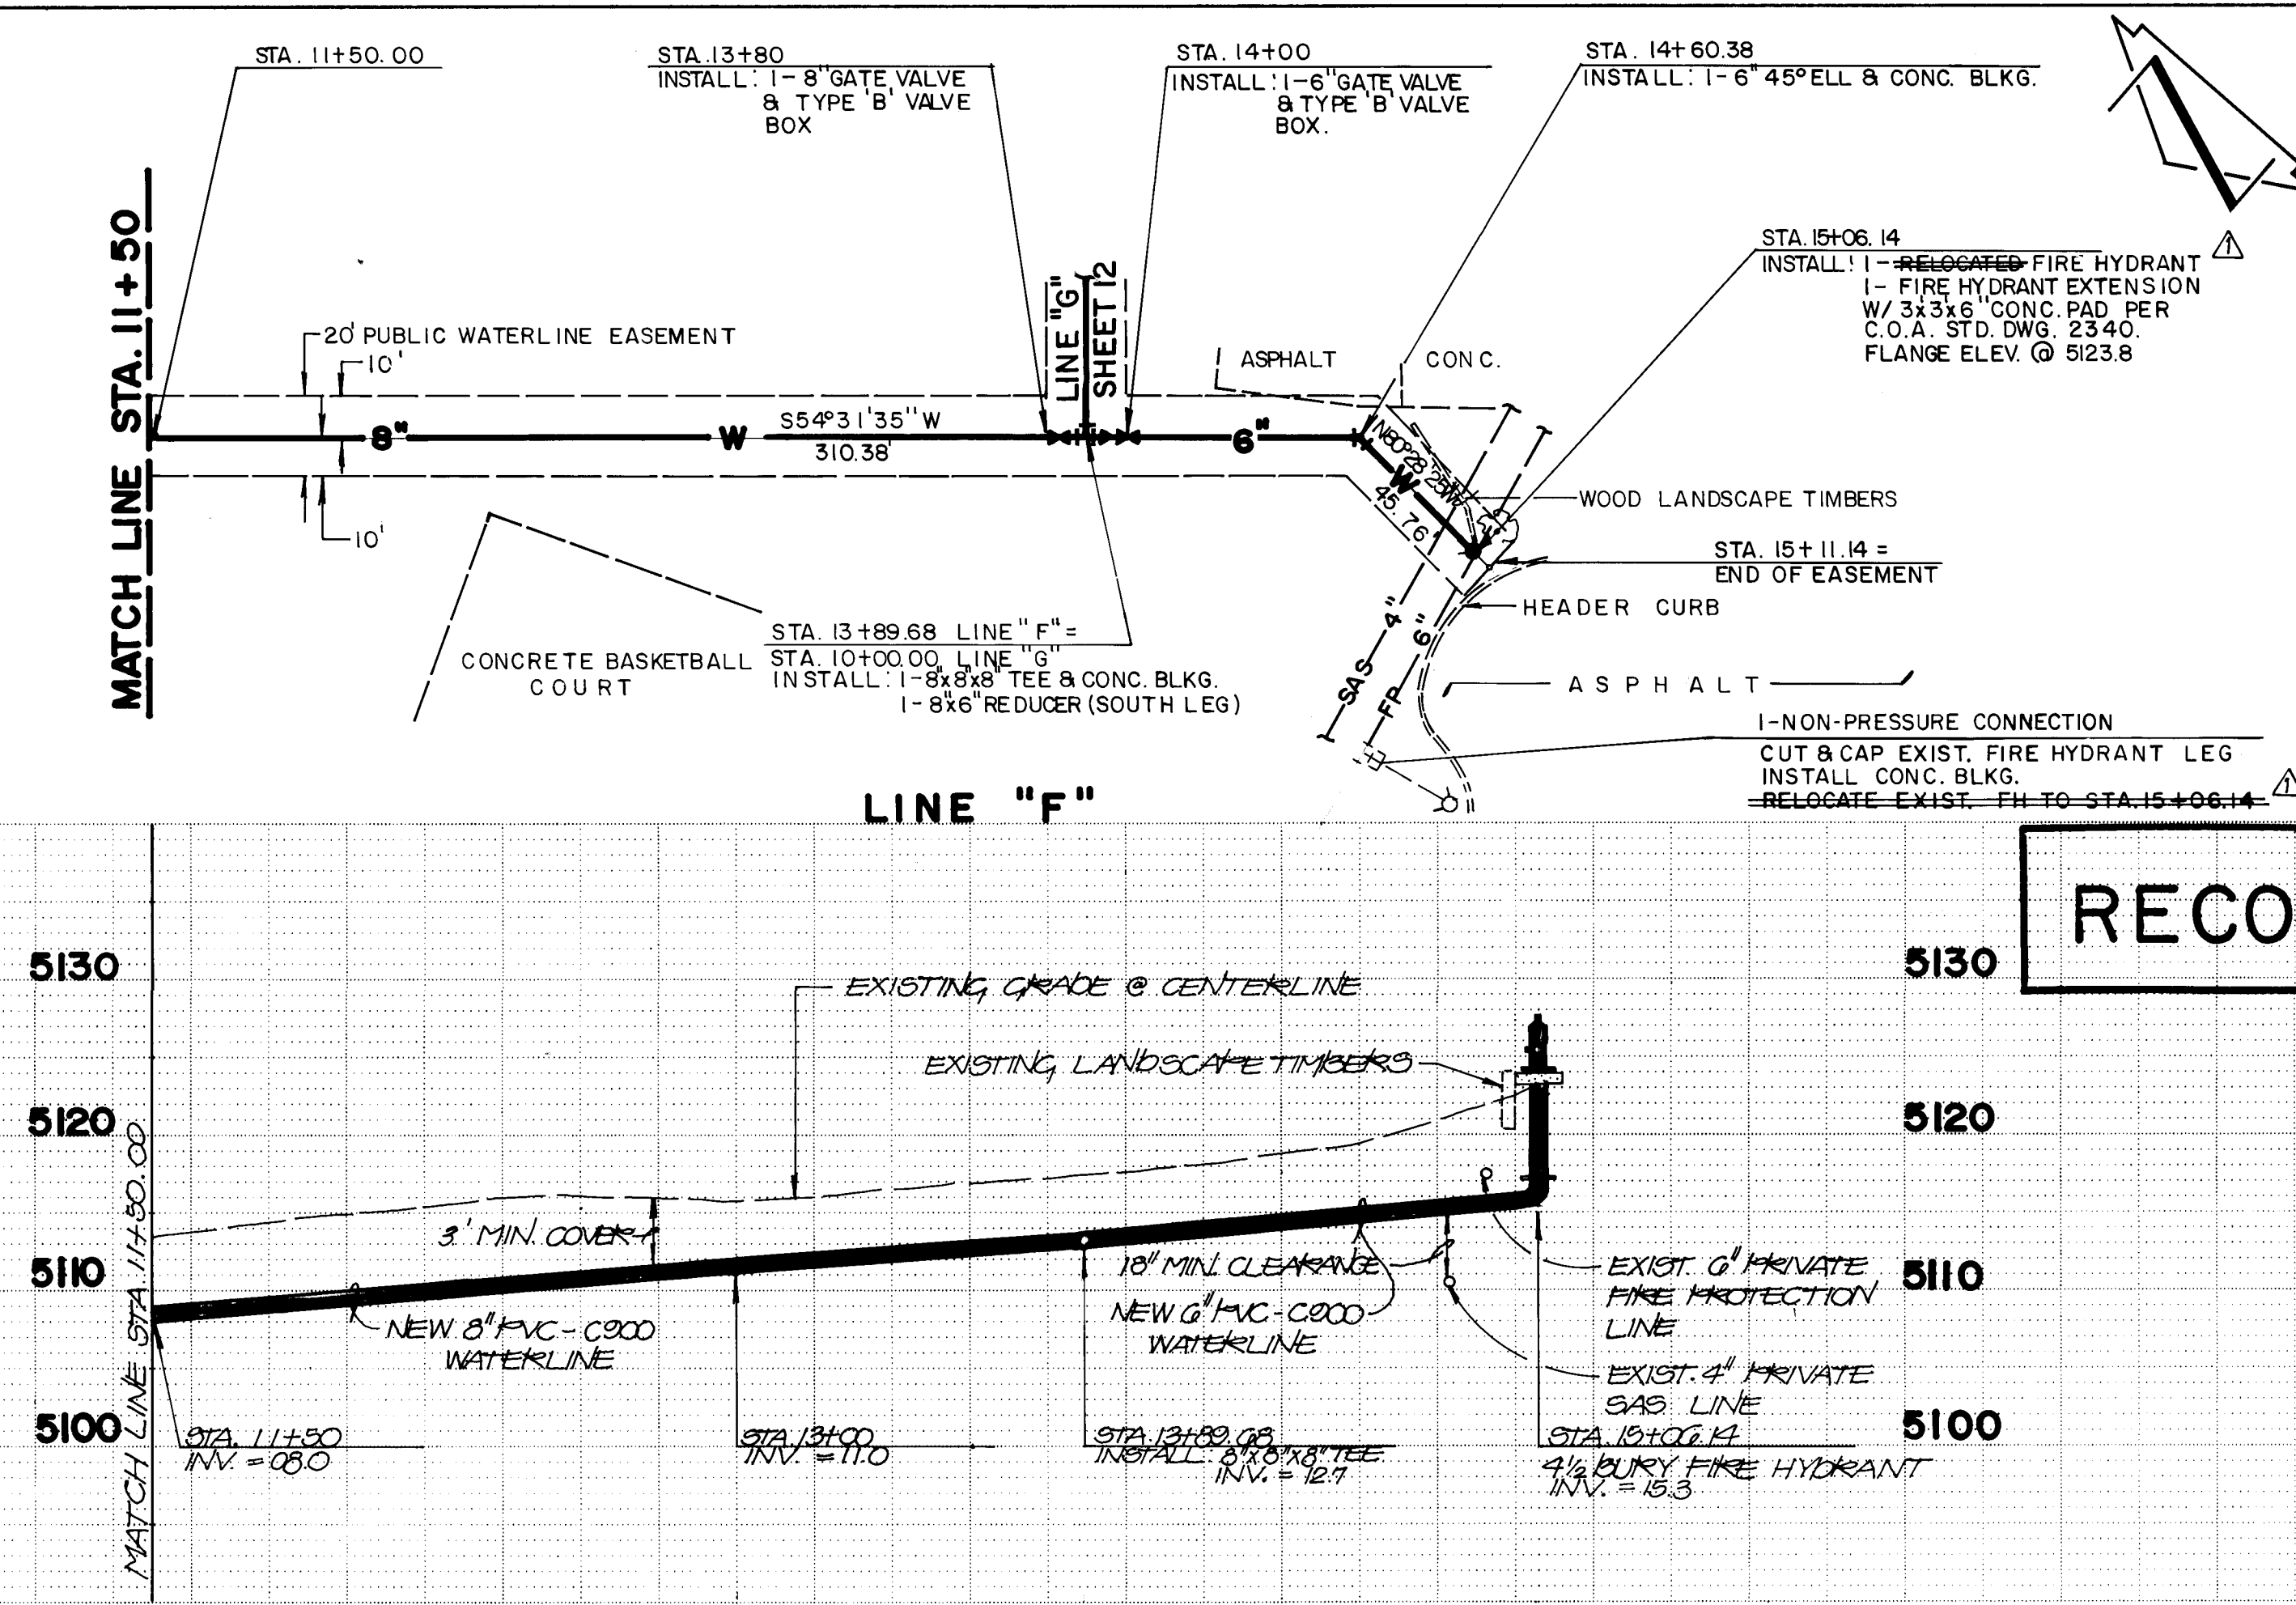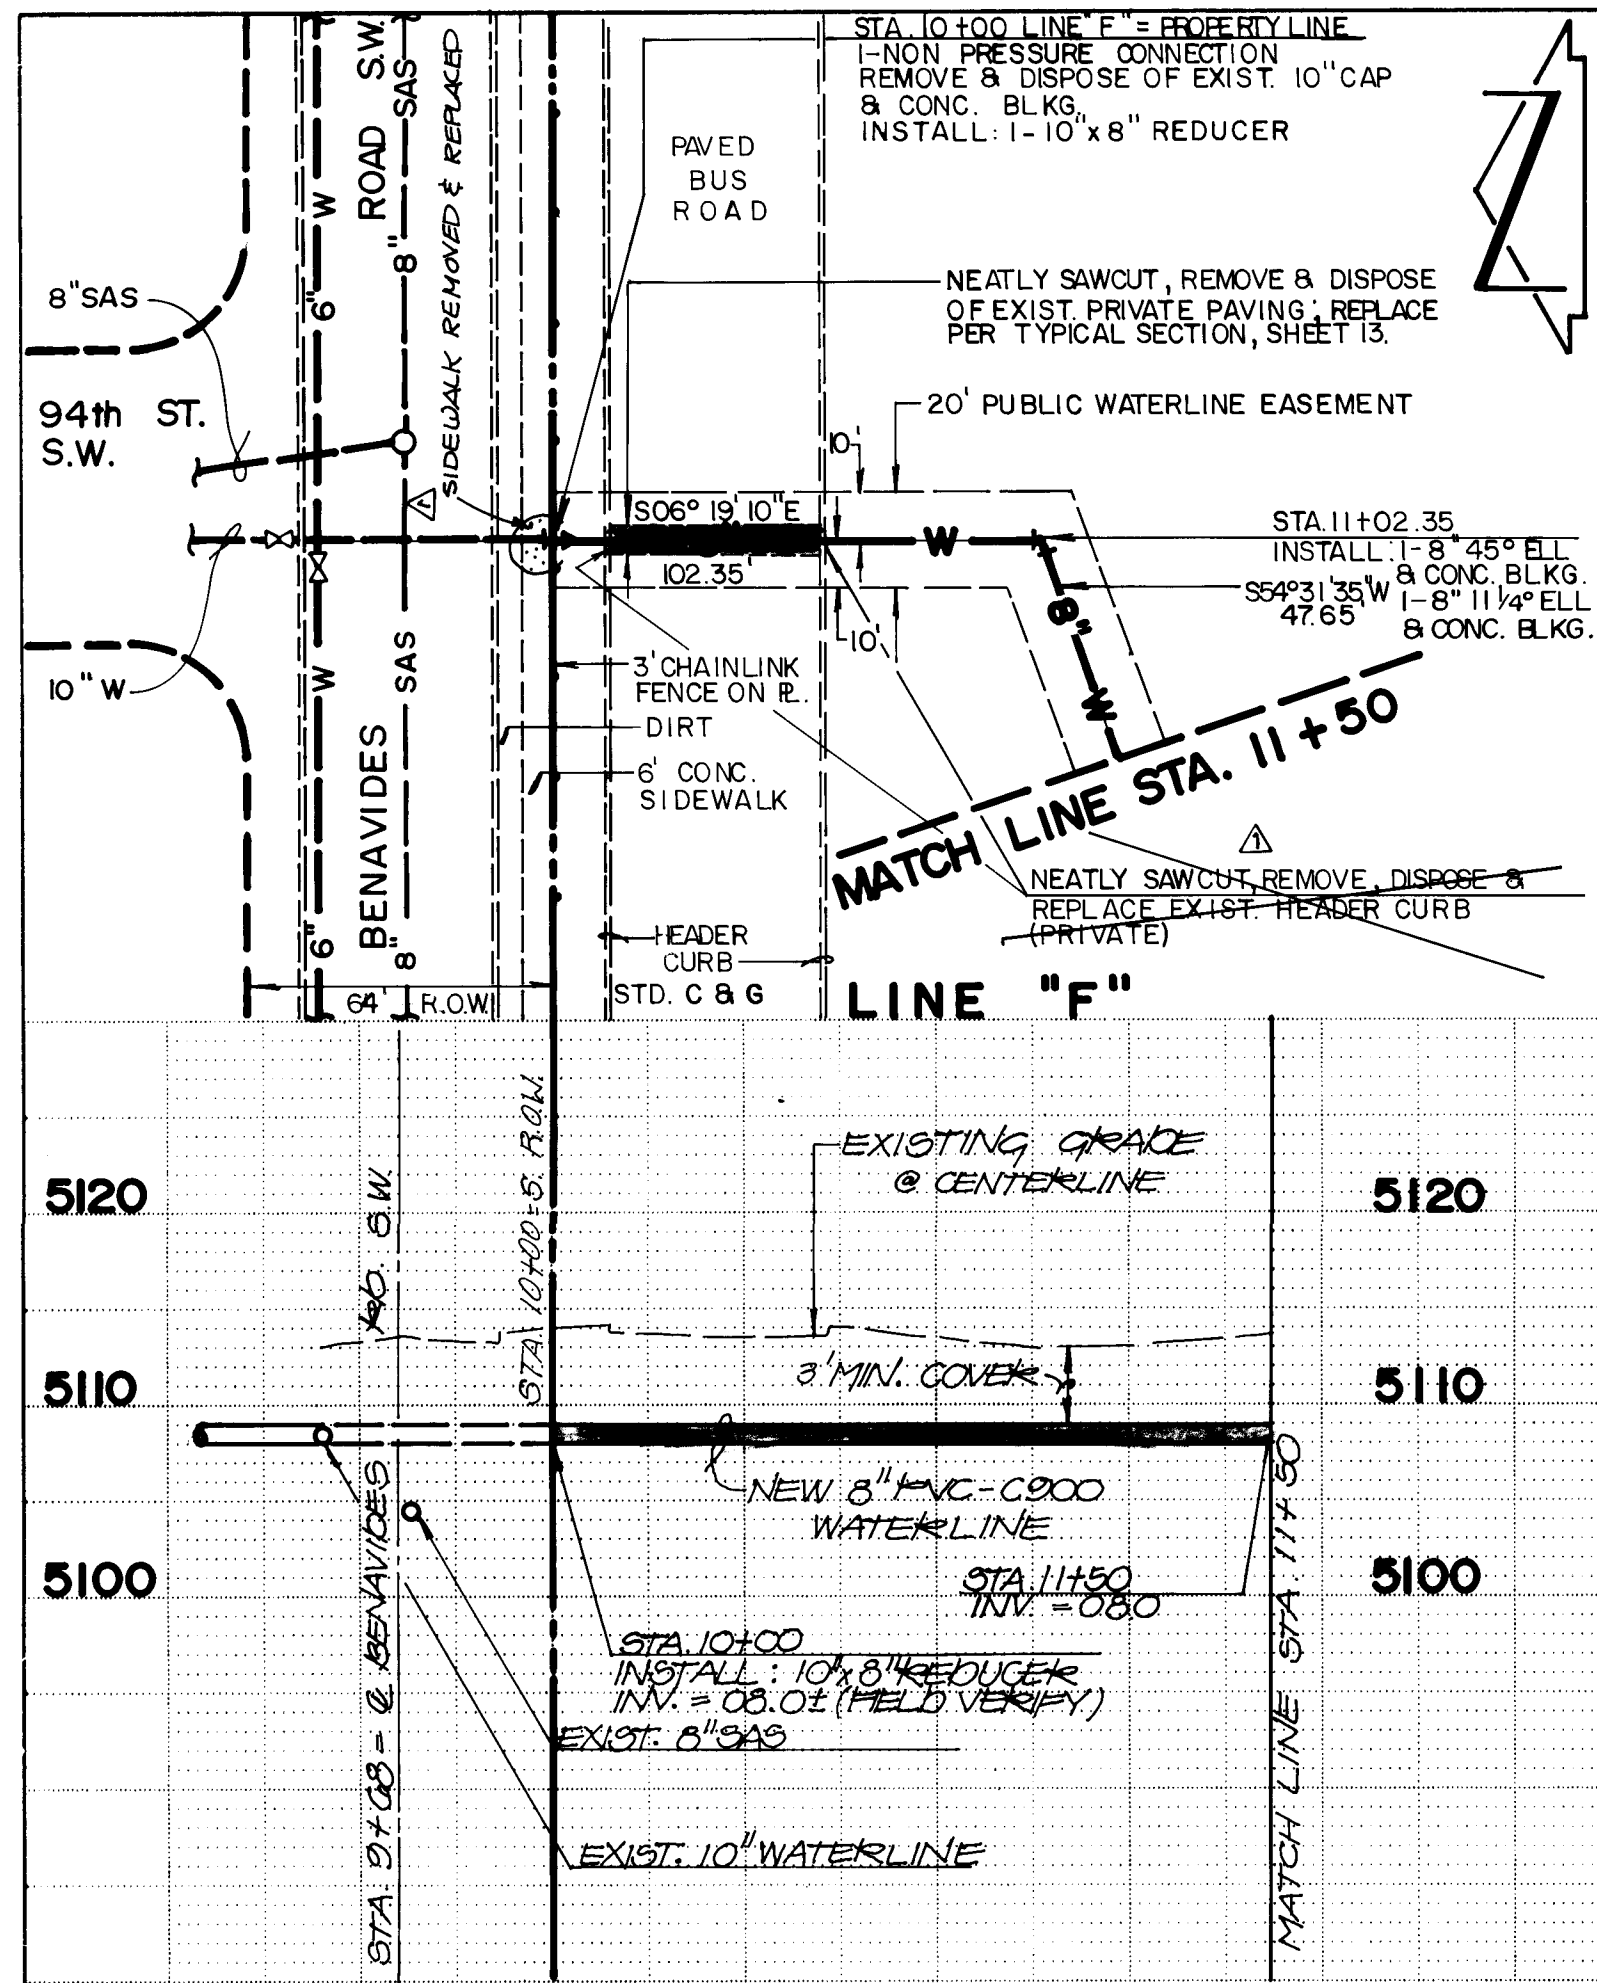

RECORD DRAWING

I, Jeffrey G. Mortensen, Registered Professional Engineer in the State of New Mexico, do hereby certify that this "as-built" information was obtained by me or under my supervision and represents the "as-built" conditions of this project, and is true and correct to the best of my knowledge and belief. All vertical and horizontal dimensions should be field verified prior to use on future projects.

Jeffrey G. Mortensen
NMP/No. 8547

DATE 7-16-90








RECORD DRAWING

FOR CONSTRUCTION NOTES AFFECTING THIS SHEET, REFER TO SHEET 13

HORIZONTAL SCALE: 1" = 40'
VERTICAL SCALE: 1" = 10'

CITY OF ALBUQUERQUE PUBLIC WORKS DEPARTMENT ENGINEERING DIVISION				
TITLE: TRUMAN MIDDLE SCHOOL WATERLINE EXTENSION PLAN & PROFILE LINE 'F', LINE 'I'				
APPROVALS	ENGINEER	DATE	APPROVALS	ENGINEER
D.R.C. CHAIRMAN	7-17-90	7-17-90	WATER	7-16-90
TRANSPORTATION	7-17-90	7-17-90	WASTE WATER	7-16-90
HYDROLOGY	N/A			
PROJECT NO.	4111.90		SHEET	11 OF 25

AS-BUILT INFORMATION		BENCH MARKS		SURVEY INFORMATION		ENGINEER'S SEAL	
CONTRACTOR	JONES INDUSTRIES	NO.	DATE	NO.	DATE	SEAL	DATE
STAKED BY	J.M.A.	DATE	09/90	BY	DATE		
INSPECTOR'S FIELD CHECK	DATE	DATE	10/90	REVISIONS	DATE		
FIELD CHECK BY	M.A.S.	DATE	10/90	DESIGN	DATE		
VERIFICATION BY	M.A.S.	DATE	10/90				
CORRECTED BY	J.M.A.	DATE	10/90				
MICRO-FILM INFORMATION							
RECORDED BY	NO						

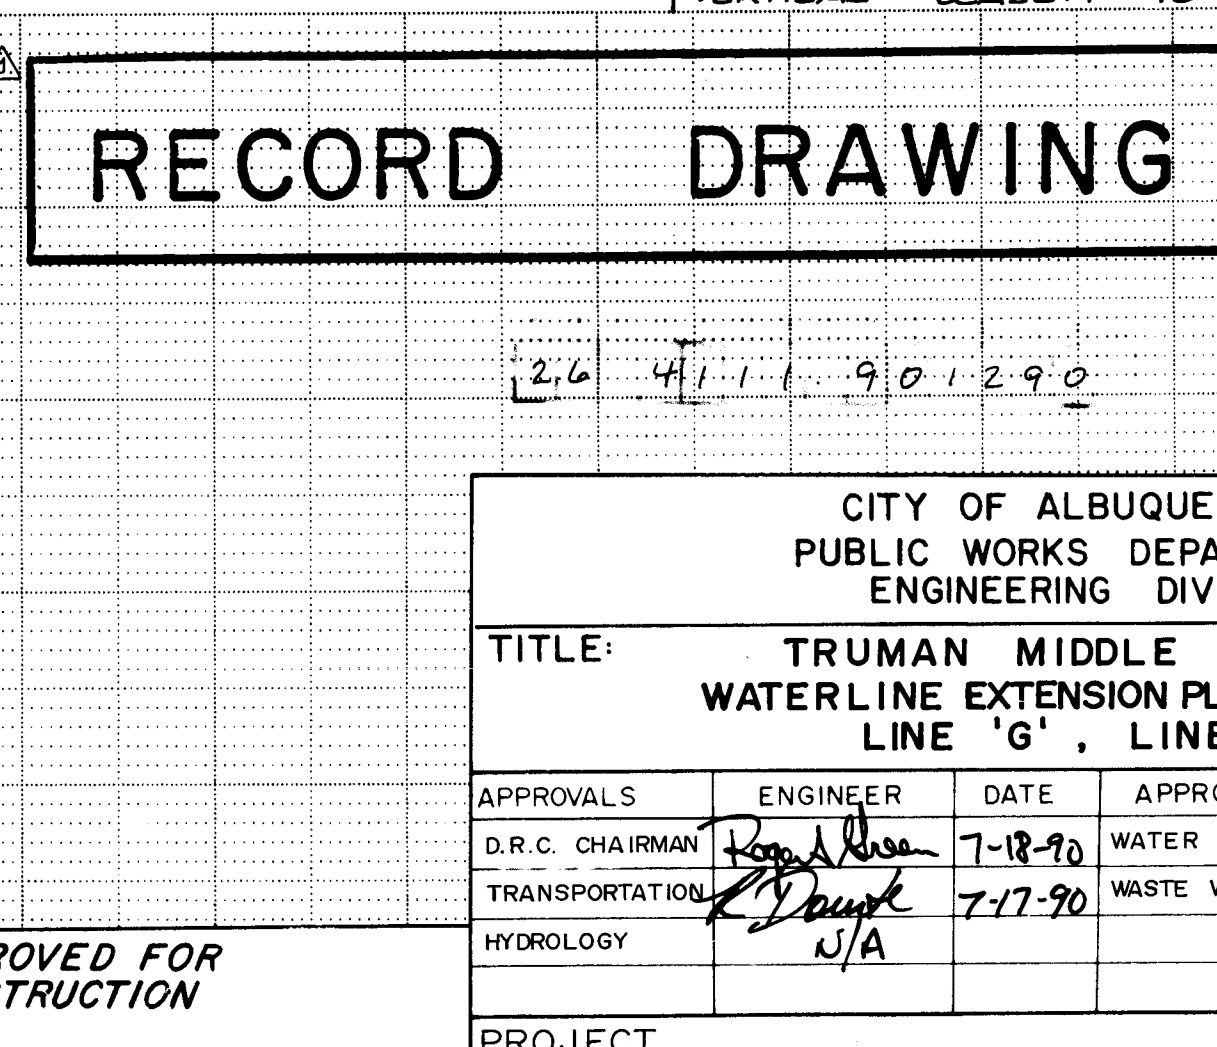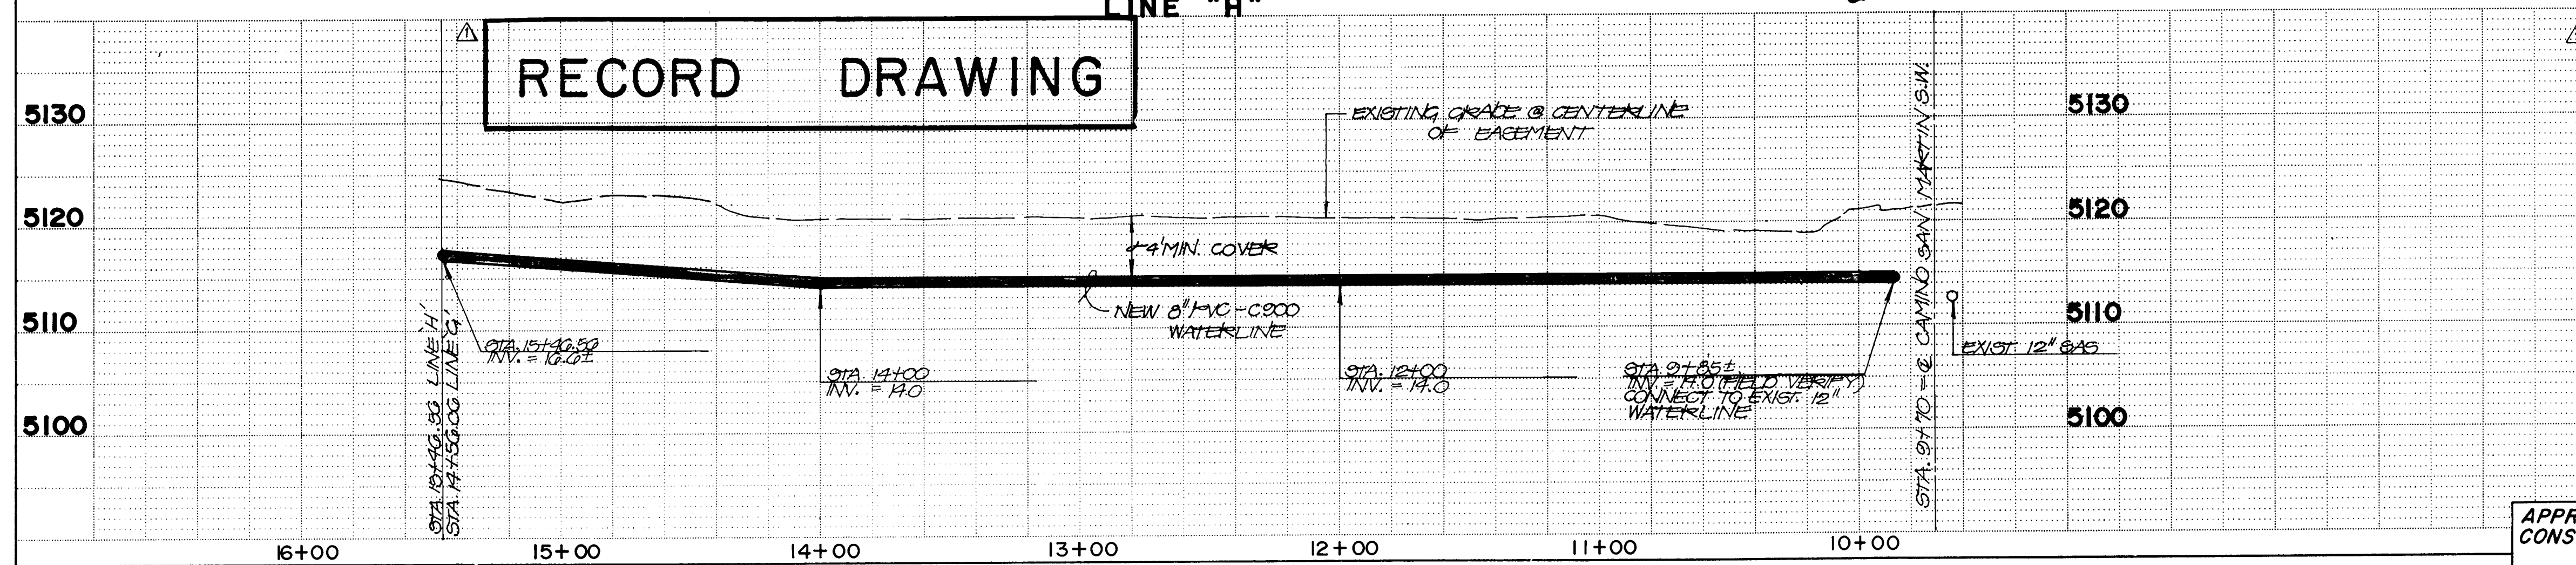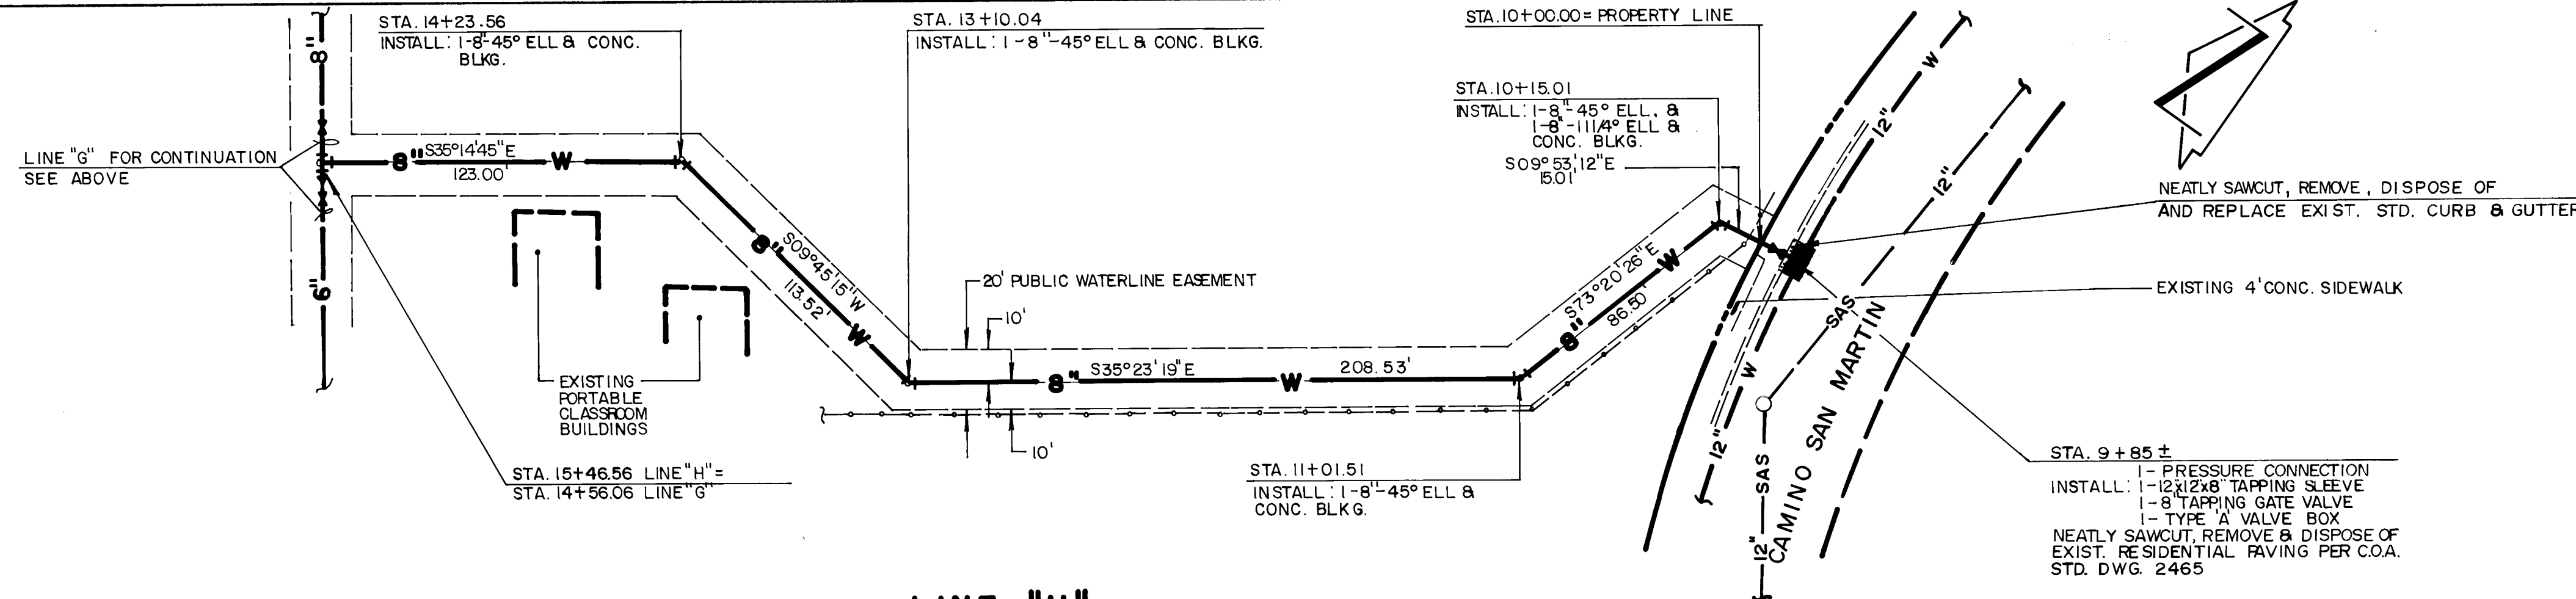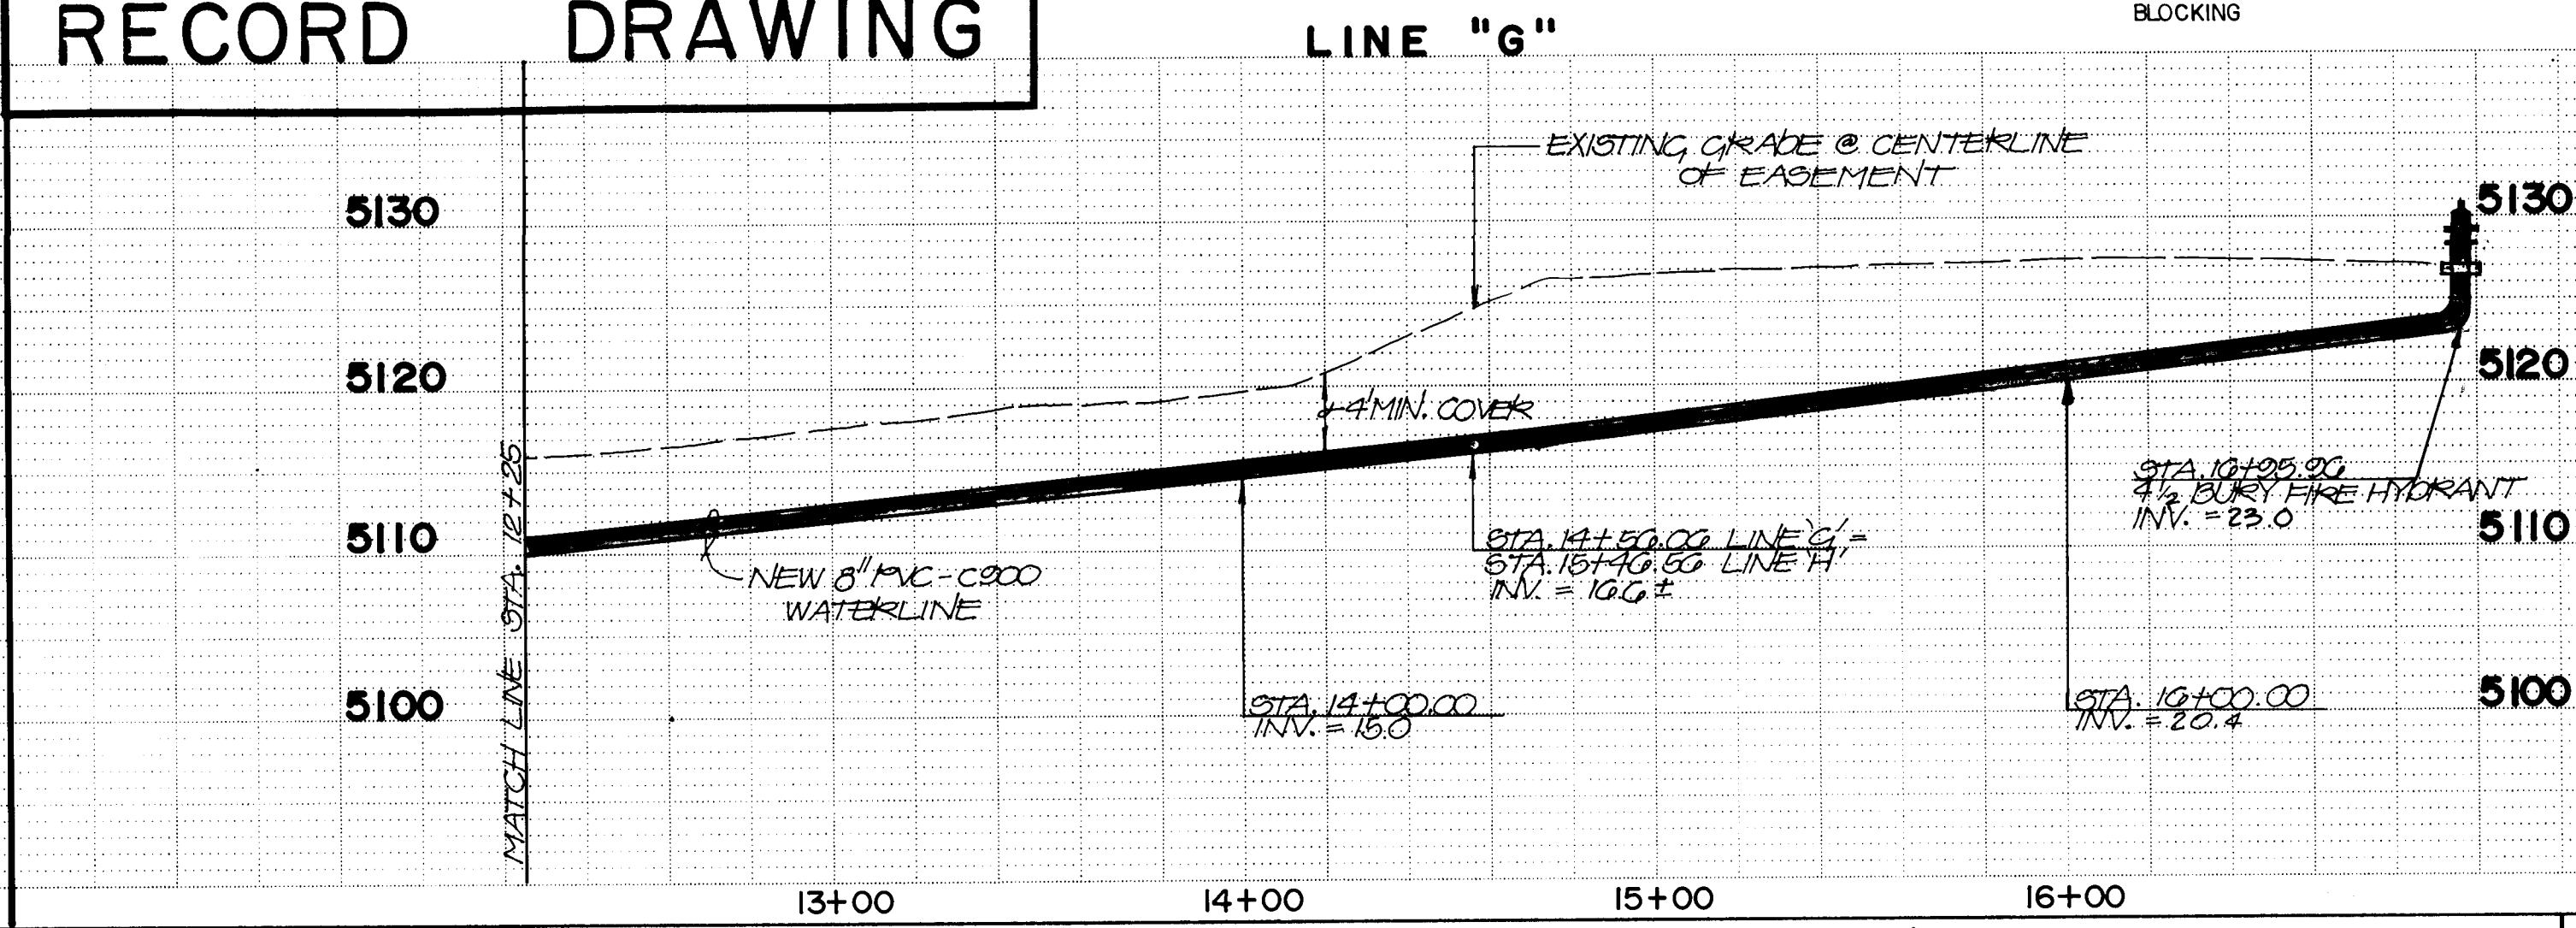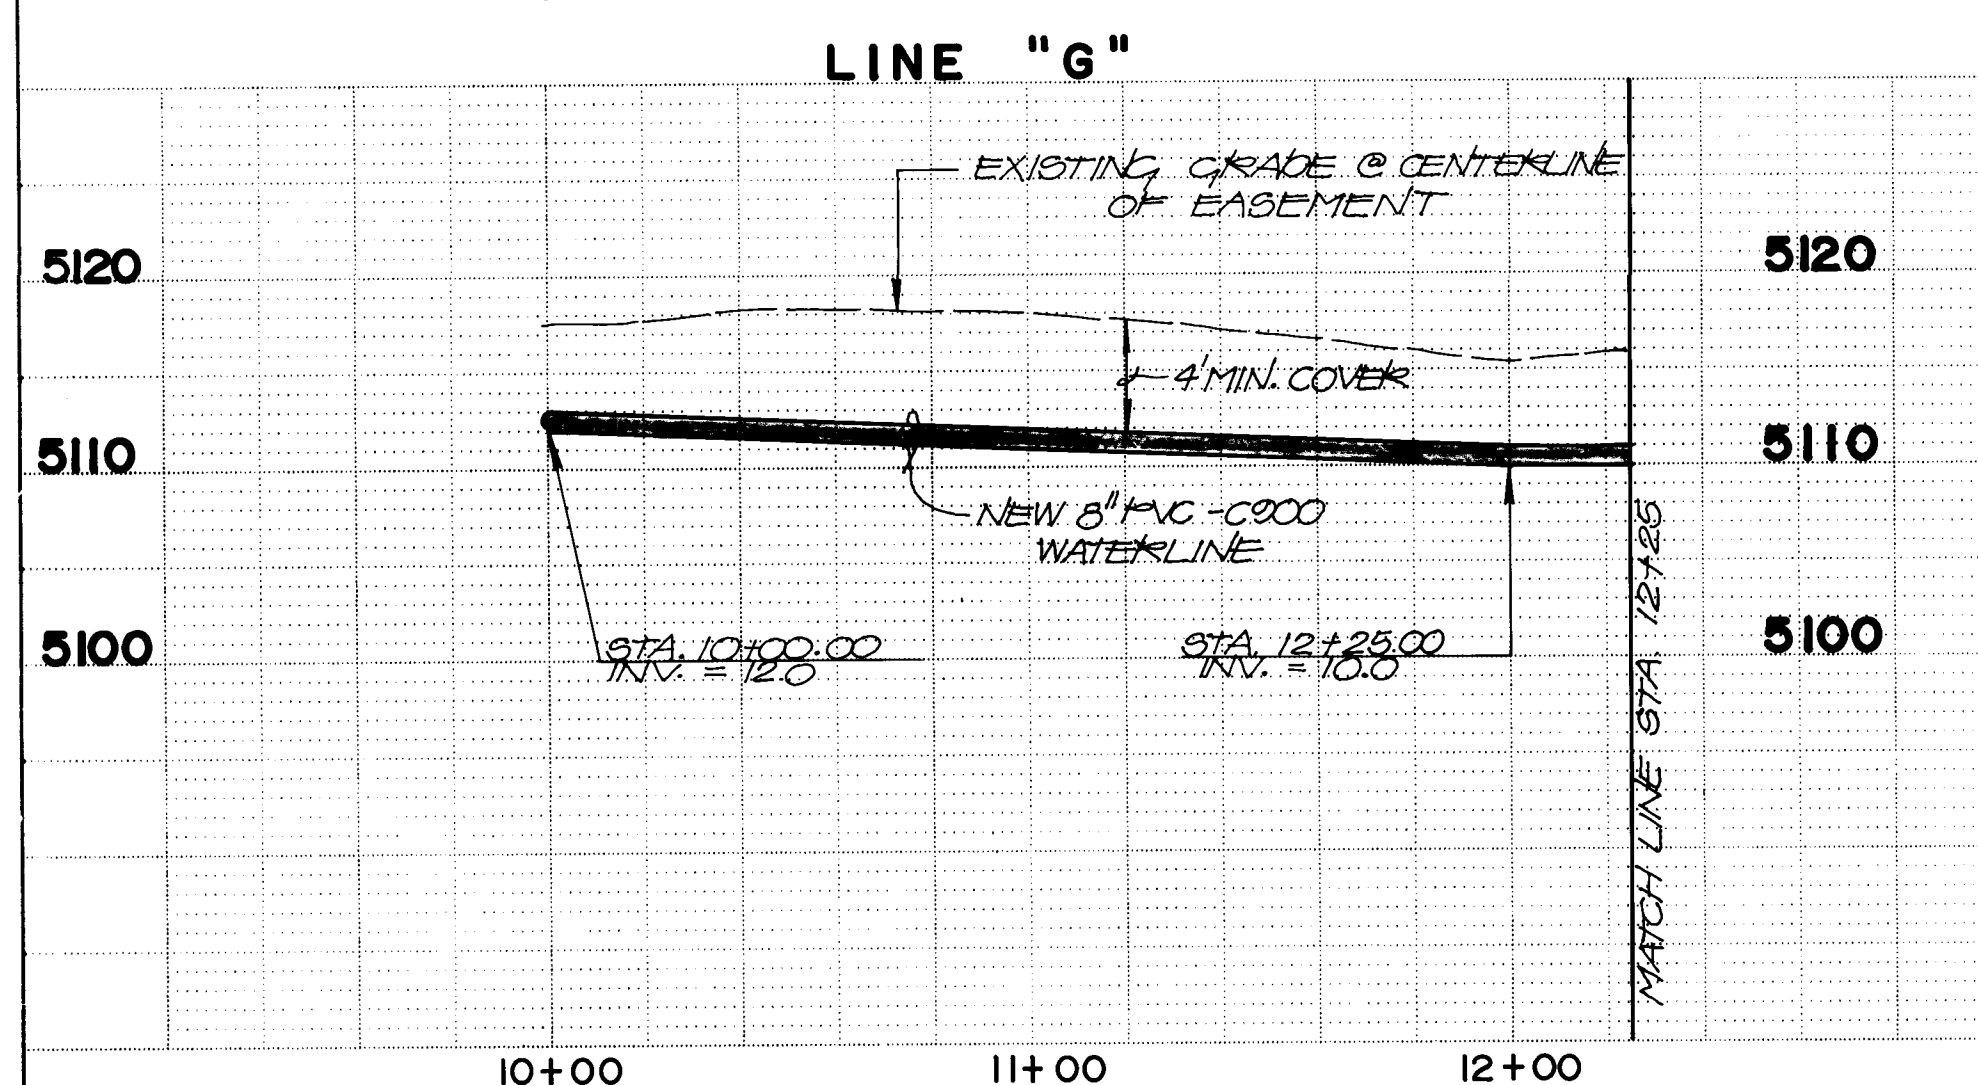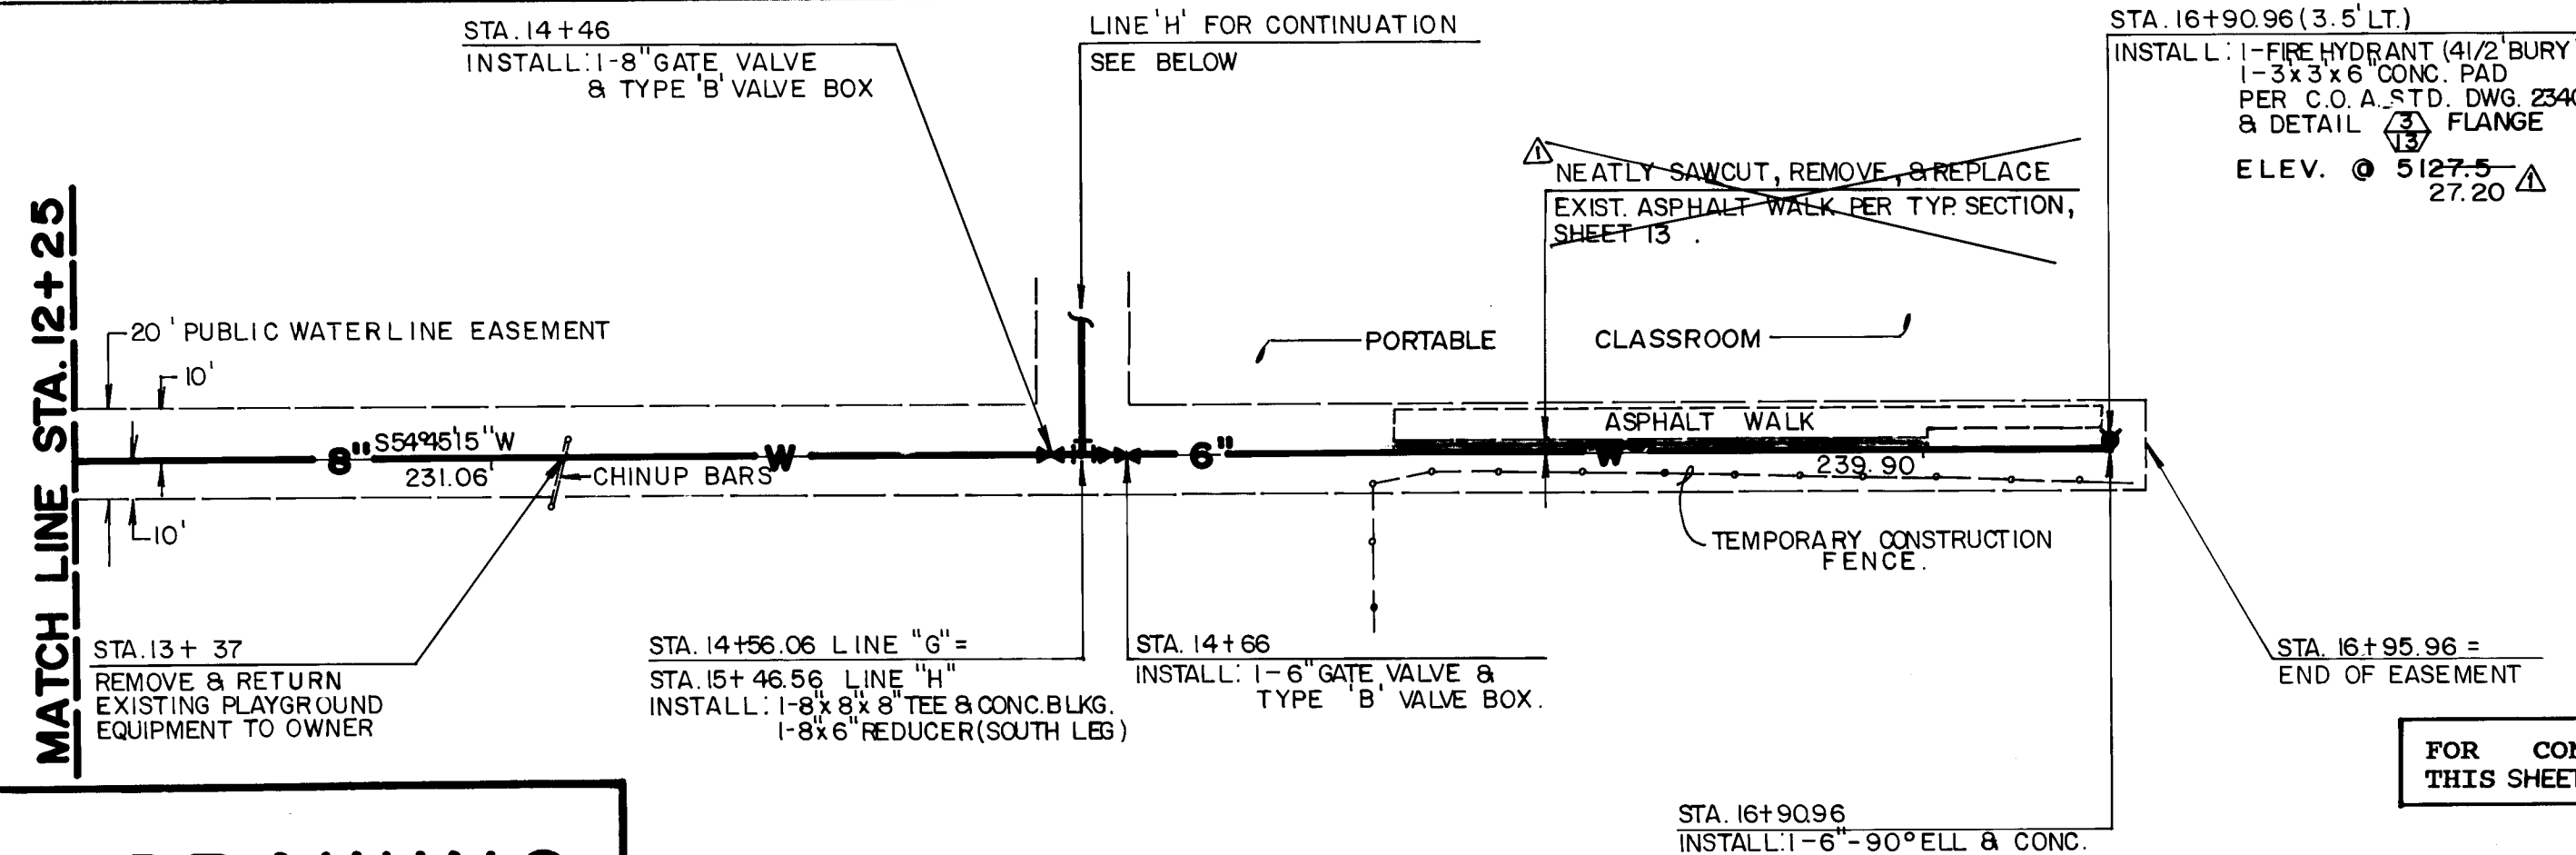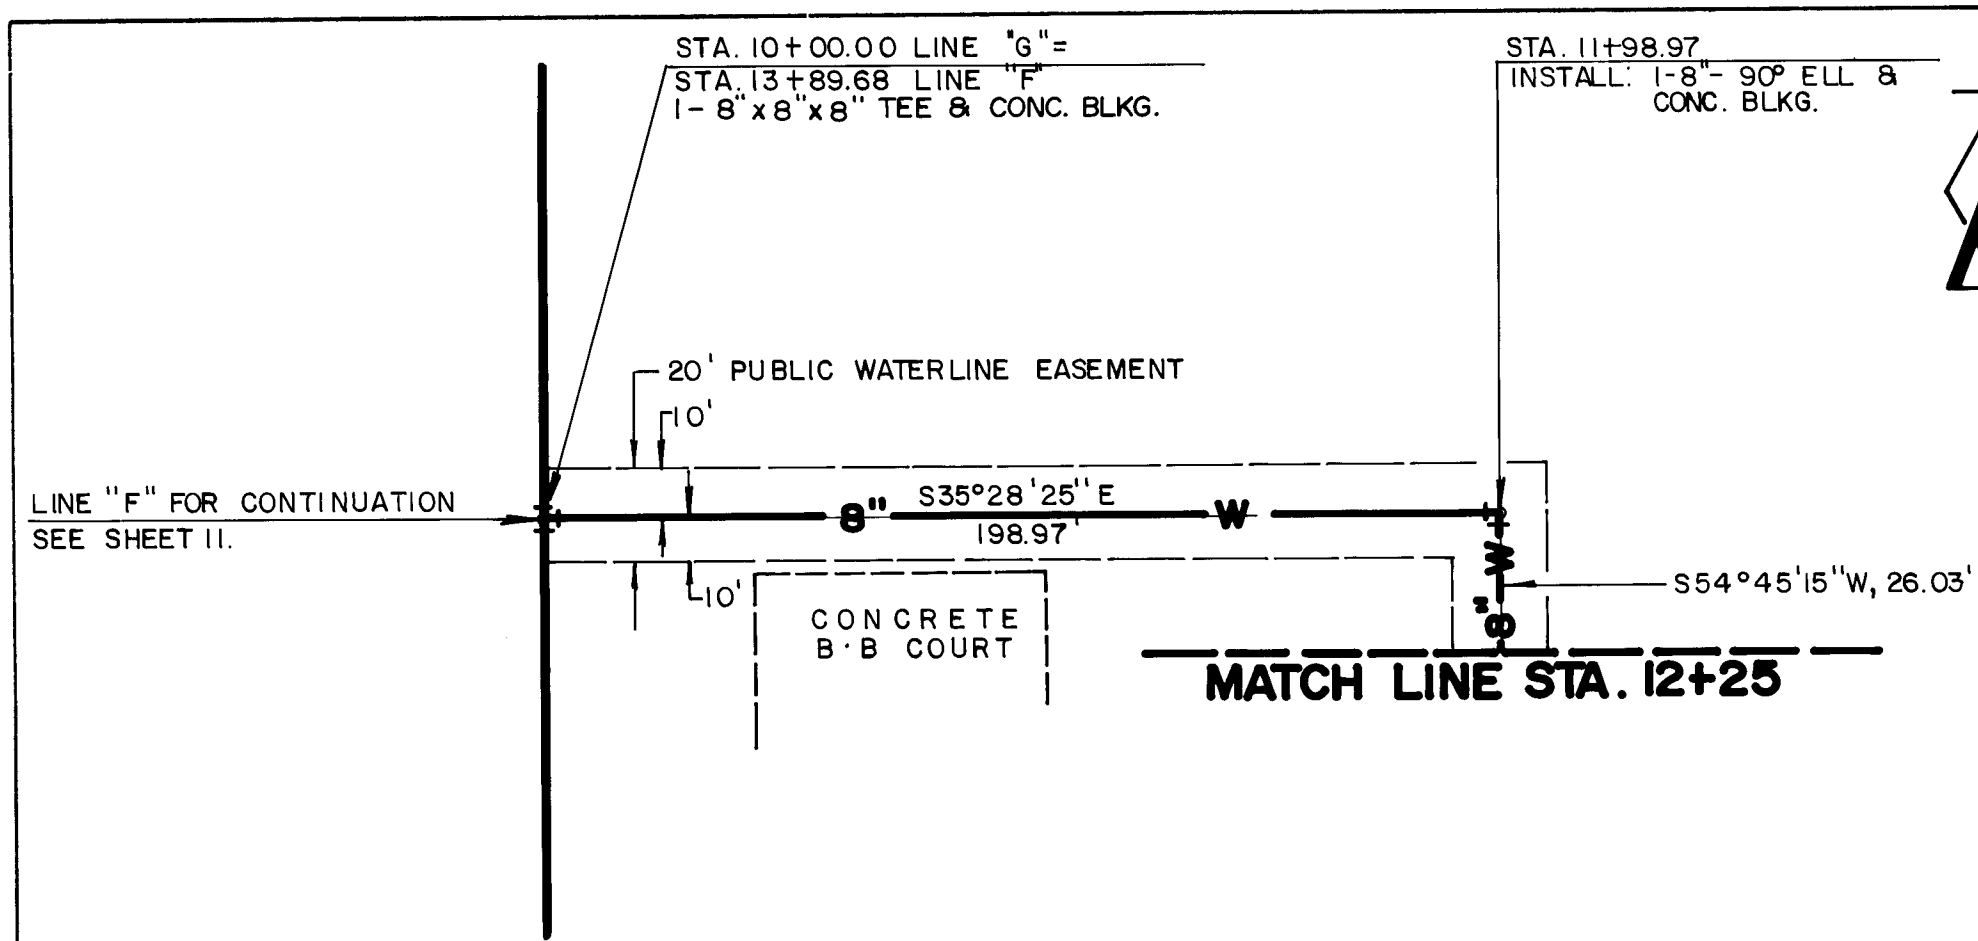

RECORD DRAWING

RECORD DRAWING

RECORD DRAWING

RECORD DRAWING

I, Jeffrey G. Mortensen, Registered Professional Engineer in the State of New Mexico, do hereby certify that this "as-built" information was obtained by me or under my supervision and represents the "as-built" conditions of this project, and is true and correct to the best of my knowledge and belief. All vertical and horizontal dimensions should be field verified prior to use on future projects.

Jeffrey G. Mortensen
New Mexico State Engineer
No. 8547
Date 7-16-90

FOR CONSTRUCTION NOTES AFFECTING THIS SHEET, REFER TO SHEET 13

HORIZONTAL SCALE: 1" = 40'
VERTICAL SCALE: 1" = 10'

CITY OF ALBUQUERQUE PUBLIC WORKS DEPARTMENT ENGINEERING DIVISION					
TITLE: TRUMAN MIDDLE SCHOOL WATERLINE EXTENSION PLAN & PROFILE LINE 'G', LINE 'H'					
APPROVALS	ENGINEER	DATE	APPROVALS	ENGINEER	DATE
D.R.C. CHAIRMAN	<i>[Signature]</i>	7-18-90	WATER	<i>[Signature]</i>	7-16-90
TRANSPORTATION	<i>[Signature]</i>	7-17-90	WASTE WATER	<i>[Signature]</i>	7-16-90
HYDROLOGY	J/A				
PROJECT NO.		4111.90		SHEET 12 OF 25	


APPROVED FOR CONSTRUCTION

CITY ENGINEER DATE

JMA. NO. 891812

SCANNED BY
BY LASOLASON

AS BUILT INFORMATION		BENCH MARKS		SURVEY INFORMATION		FIELD NOTES		ENGINEER'S SEAL	
CONTRACTOR	JONES INDUSTRIES	AN 'X' CUT ON THE N.E. BOUNKET BOLT	OF THE FIRE HYDRANT LOCATED ON THE WEST SIDE OF 96TH ST. S.W. 150' NORTH OF THE INTERSECTION OF CIBOLA BLVD. S.W. & 98TH ST. S.W. (CITY OF ALB. B.M. 5-M-9.) ELEVATION = 5160.92 (M.S.L.D.)	NO.	DATE	BY	DATE	NEW MEXICO 8547	26-26-90
STAKED BY	J.M.A.	DATE	09/90						
INSPECTED BY	M.A.S.	DATE	09/90						
FIELD VERIFICATION BY	M.A.S.	DATE	10/90						
CORRECTED BY	J.M.A.	DATE	10/90						
MICRO-FILM INFORMATION		RECORDED BY		DESIGNED BY		DRAWN BY		CHECKED BY	
				J.M.A.		S.G.H.		J.G.M.	
				DATE		DATE		DATE	
				3-90		3-90		6-90	

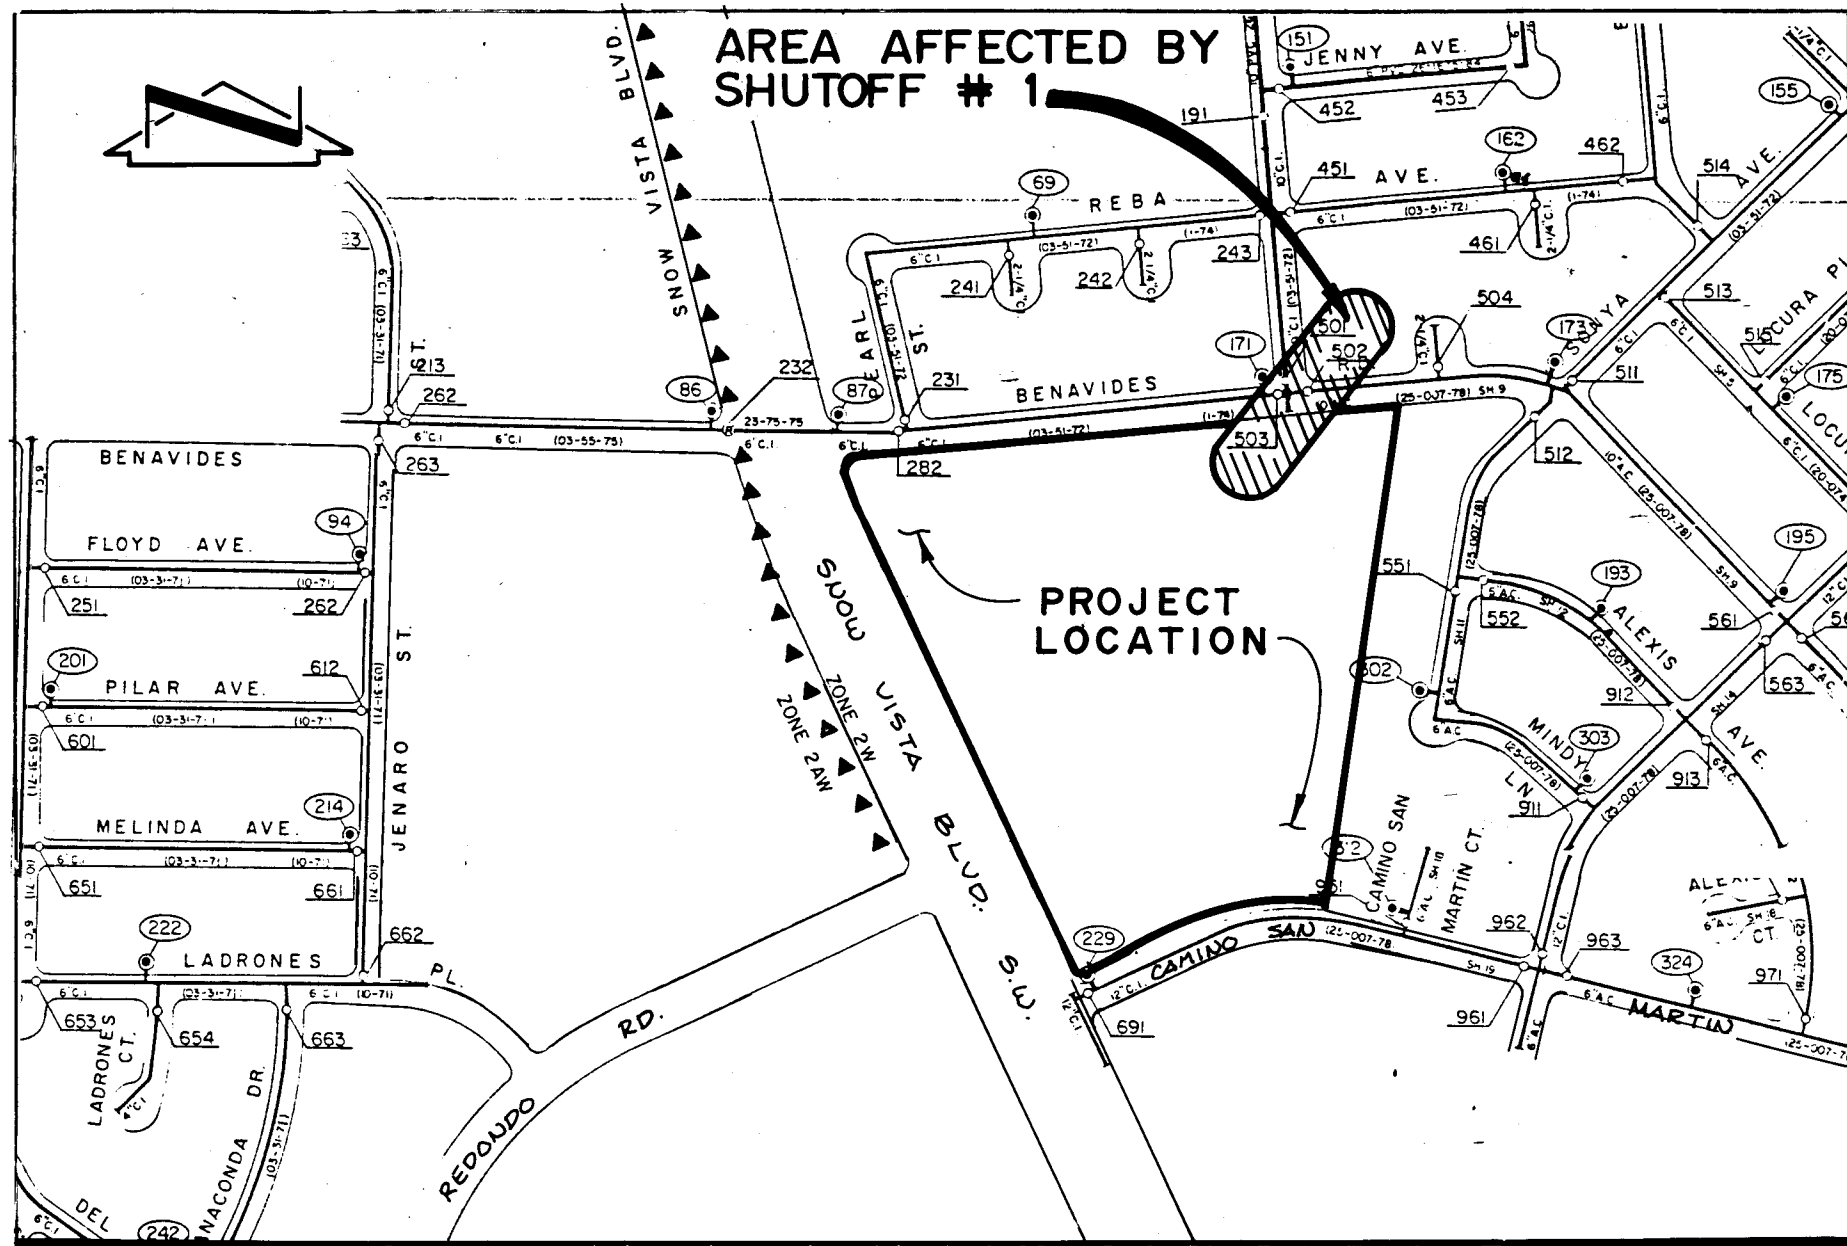


TRUMAN WATER VALVE SHUTOFF PLAN

SCALE : 1" = 400' (APPROX.)

TRUMAN WATER VALVE SHUTOFF PLAN NOTES:


- AS A MINIMUM, THE FOLLOWING VALVES SHALL BE CLOSED TO EFFECT THE RESPECTIVE SHUTOFFS SHALL BE CLOSED:
 - SHUTOFF #1 (CONNECTION IN BENAVIDES ROAD S.W.): VALVES 501, 502 & 503.
- THE CONTRACTOR SHALL NOTIFY WATER SYSTEMS, THREE (3) WORKING DAYS IN ADVANCE OF ANY WORK THAT MAY AFFECT EXISTING WATERLINE; ALL SHUTOFFS SHALL BE PERFORMED BY THE WATER SYSTEM DIVISION PERSONNEL.
- THE CONTRACTOR SHALL PROVIDE ALL RESTRAINTS AND THRUST BLOCKS NECESSARY TO EFFECT THE NECESSARY SHUTOFFS AND CONNECTIONS.
- EXISTING WATER VALVE AND WATERLINE INFORMATION OBTAINED FROM CITY OF ALBUQUERQUE WATER SECTIONAL MAPS M-9N AND M-9S.

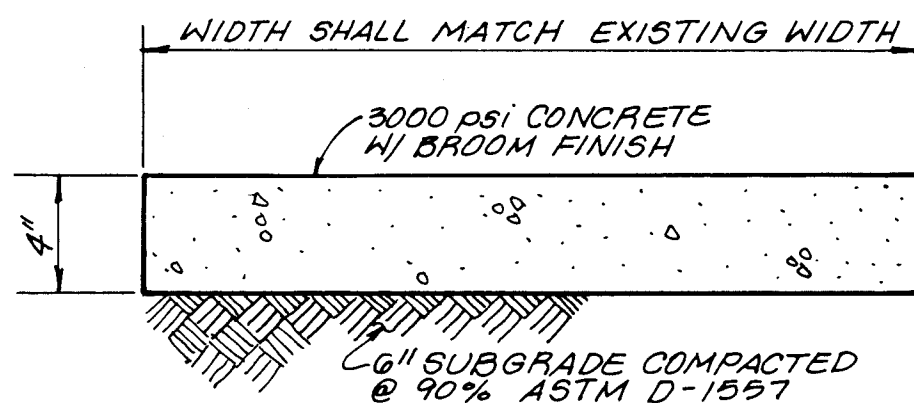

TYPICAL PRIVATE SIDEWALK REPLACEMENT

SECTION

N.T.S.

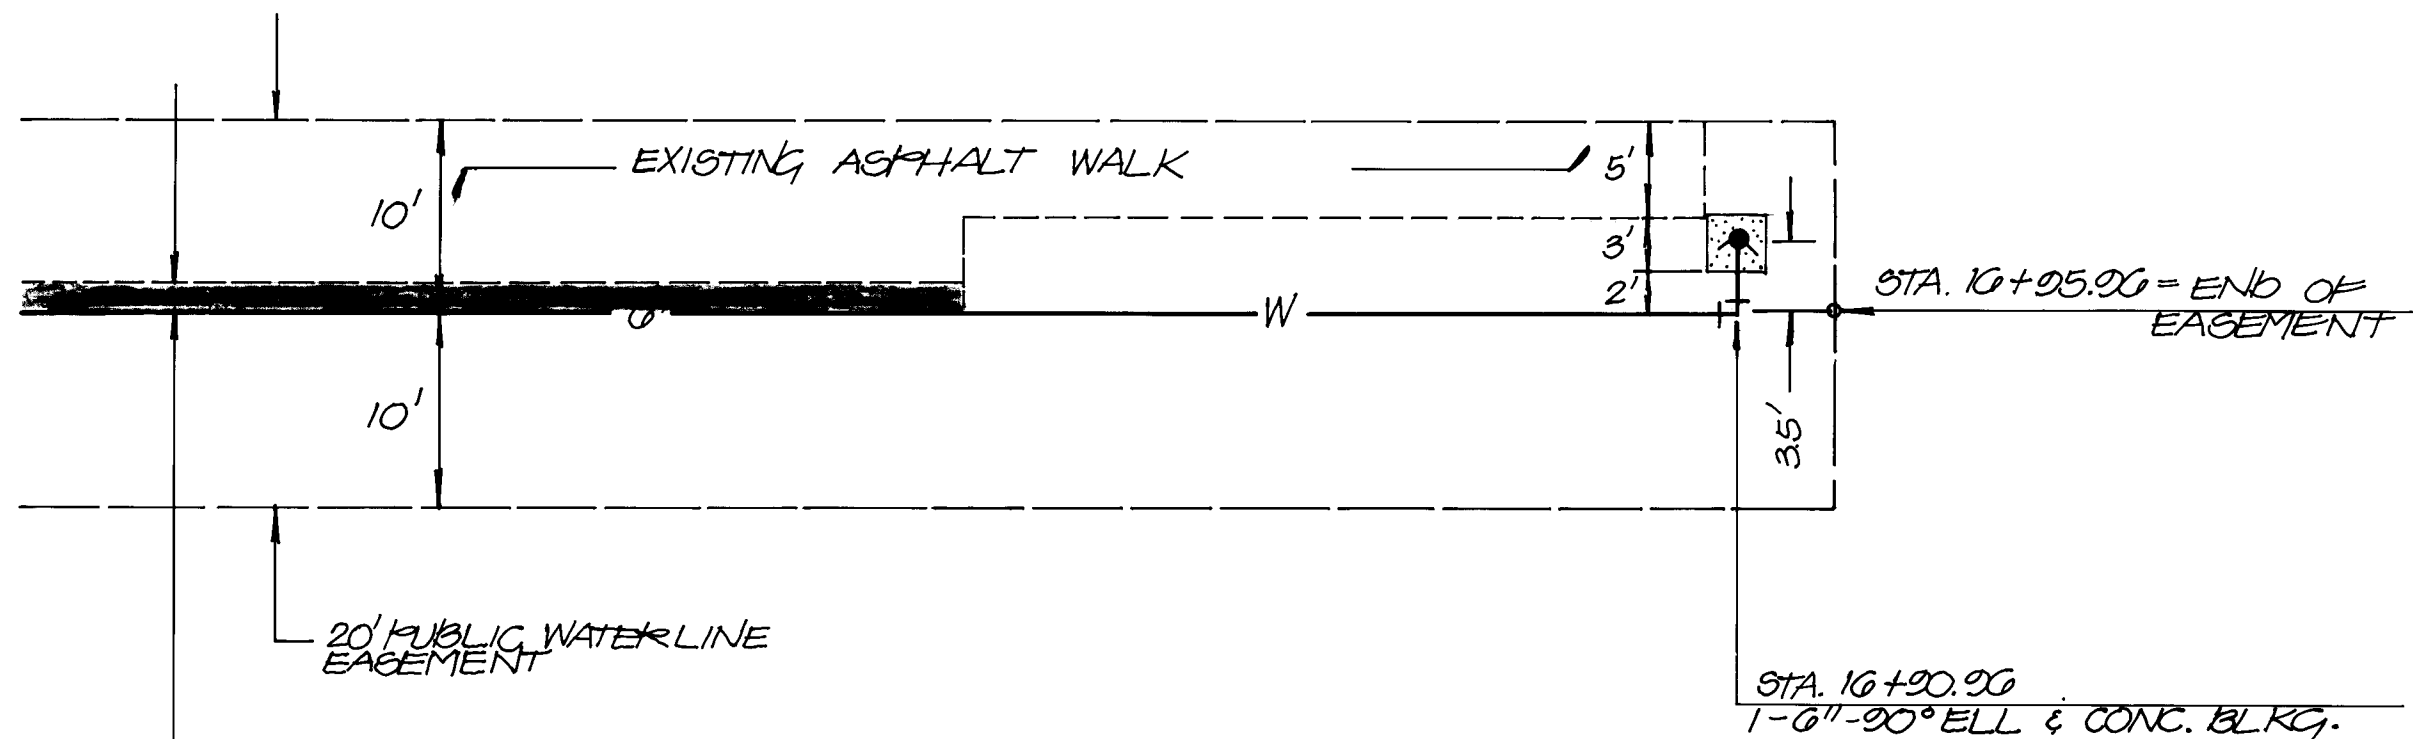


NEATLY SAWCUT, REMOVE DISK, & REPLACE EXIST. ASPHALT WALK, SEE TYP. SECTION, THIS SHEET.

DETAIL

SCALE: 1" = 10'

3/12

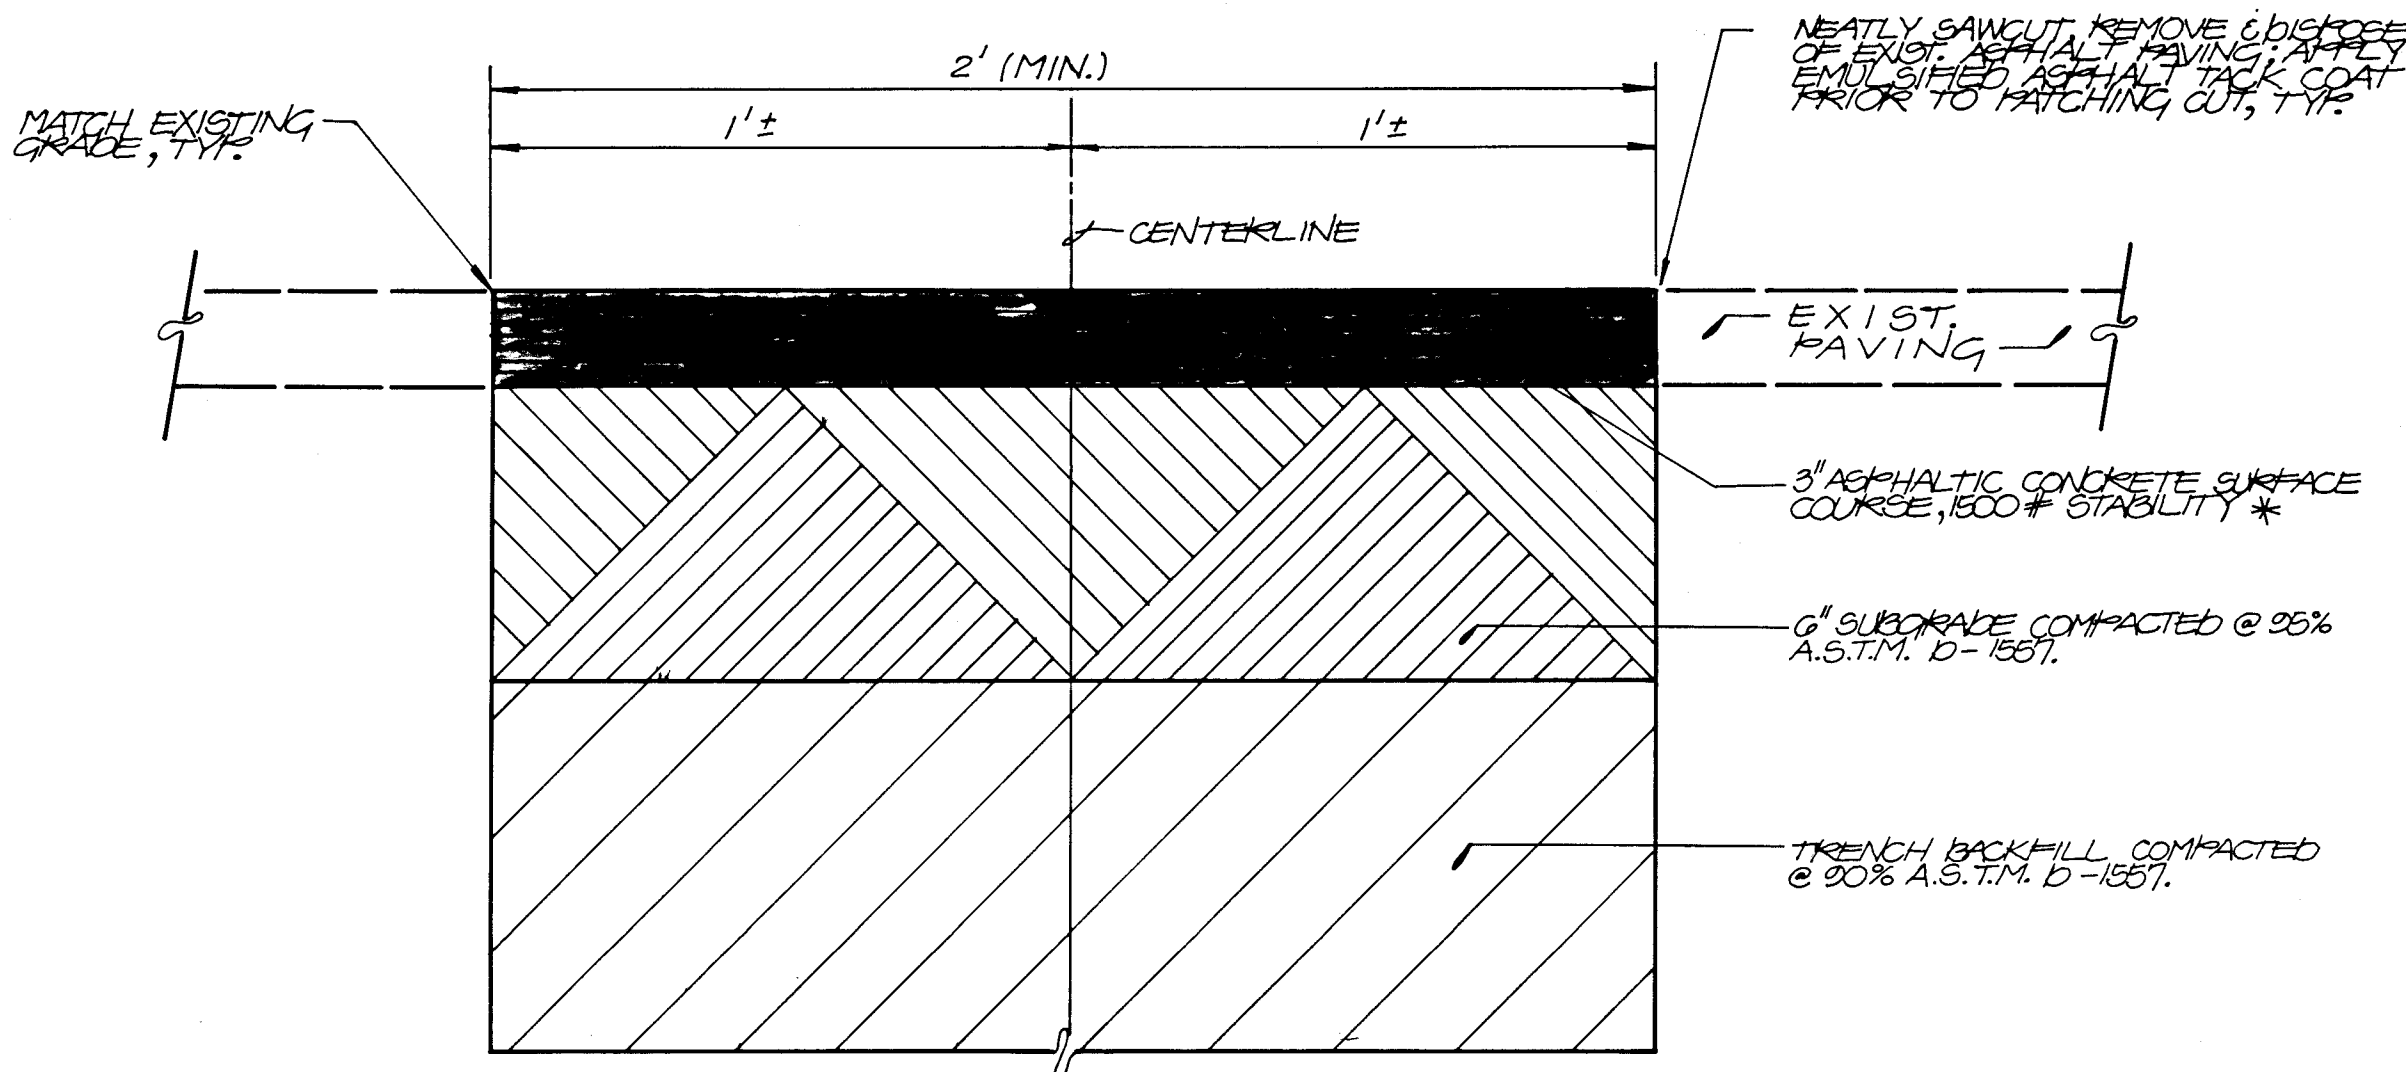

* SUBSTITUTE 2" THICKNESS IN NON-TRAFFIC AREAS.

TYPICAL PRIVATE PAVING UTILITY CUT & PAVEMENT REPLACEMENT SECTION


SCALE: 1" = 4"

RECORD DRAWING

NOTES:

- TWO (2) WORKING DAYS PRIOR TO ANY EXCAVATION, CONTRACTOR MUST CONTACT NEW MEXICO ONE CALL SYSTEM 260-1990, FOR LOCATION OF EXISTING UTILITIES.
- IF ANY UTILITY LINES, PIPELINES, OR UNDERGROUND UTILITY LINES ARE SHOWN ON THESE DRAWINGS, THEY ARE SHOWN IN AN APPROXIMATE MANNER ONLY, AND SUCH LINES MAY EXIST WHERE NONE ARE SHOWN. IF ANY SUCH EXISTING LINES ARE SHOWN, THE LOCATION IS BASED UPON INFORMATION PROVIDED BY THE OWNER OF SAID UTILITY, AND THE INFORMATION MAY BE INCOMPLETE, OR MAY BE OBSOLETE BY THE TIME CONSTRUCTION COMMENCES. THE ENGINEER HAS CONDUCTED ONLY PRELIMINARY INVESTIGATION OF THE LOCATION, DEPTH, SIZE, OR TYPE OF EXISTING UTILITY LINES, PIPELINES, OR UNDERGROUND UTILITY LINES. THIS INVESTIGATION IS NOT CONCLUSIVE, AND MAY NOT BE COMPLETE, THEREFORE, MAKES NO REPRESENTATION PERTAINING THERETO, AND ASSUMES NO RESPONSIBILITY OR LIABILITY THEREFOR. THE CONTRACTOR SHALL INFORM ITSELF OF THE LOCATION OF ANY UTILITY LINE, PIPELINE, OR UNDERGROUND UTILITY LINE IN OR NEAR THE AREA OF THE WORK IN ADVANCE OF AND DURING EXCAVATION WORK. THE CONTRACTOR IS FULLY RESPONSIBLE FOR ANY AND ALL DAMAGE CAUSED BY ITS FAILURE TO LOCATE, IDENTIFY AND PRESERVE ANY AND ALL EXISTING UTILITIES, PIPELINES, AND UNDERGROUND UTILITY LINES. IN PLANNING AND CONDUCTING EXCAVATION, THE CONTRACTOR SHALL COMPLY WITH STATE STATUTES, MUNICIPAL AND LOCAL ORDINANCES, RULES AND REGULATIONS, IF ANY, PERTAINING TO THE LOCATION OF THESE LINES AND FACILITIES.
- SHOULD A CONFLICT EXIST BETWEEN THESE PLANS AND ACTUAL FIELD CONDITIONS, THE CONTRACTOR SHALL PROMPTLY NOTIFY THE ENGINEER IN WRITING SO THAT THE CONFLICT CAN BE RESOLVED WITH A MINIMUM AMOUNT OF DELAY FOR ALL PARTIES.
- THE CONTRACTOR SHALL MAINTAIN ACCESS TO ALL BUILDINGS AND ADJACENT PROPERTIES DURING CONSTRUCTION.
- THE CONTRACTOR SHALL ENSURE THAT NO SOIL ERODES FROM THE SITE INTO PUBLIC RIGHT-OF-WAY OR ONTO PRIVATE PROPERTY. THIS CAN BE ACHIEVED BY CONSTRUCTING AND MAINTAINING TEMPORARY BERMS AT THE PROPERTY LINES AND WETTING THE SOIL TO KEEP IT FROM BLOWING.
- THE CONTRACTOR SHALL PROMPTLY CLEAN UP ANY MATERIAL EXCAVATED WITHIN THE PUBLIC RIGHT-OF-WAY SO THAT THE EXCAVATED MATERIAL IS NOT SUSCEPTIBLE TO BEING WASHED DOWN THE STREET.
- IF THE REMOVAL OF EXISTING CURB AND GUTTER, SIDEWALK, AND/OR PAVING IS REQUIRED, THE CONTRACTOR SHALL SAWCUT AND/OR REMOVE TO THE NEAREST JOINT. WHEN ABUTTING NEW PAVEMENT TO EXISTING, THE CONTRACTOR SHALL CUT BACK THE EXISTING PAVING TO A STRAIGHT LINE IN ORDER TO REMOVE ANY BROKEN OR CRACKED PAVEMENT. CURB AND GUTTER AND/OR PAVEMENT SHOWN AS EXISTING AND NOT TO BE REMOVED UNDER THIS CONTRACT AND WHICH IS DAMAGED OR DISPLACED BY THE CONTRACTOR SHALL BE REMOVED AND REPLACED BY THE CONTRACTOR AT THE CONTRACTOR'S EXPENSE.
- THE CONTRACTOR SHALL BE RESPONSIBLE FOR SAFELY OBTAINING THE REQUIRED COMPACTION. THE CONTRACTOR SHALL SELECT AND USE METHODS WHICH SHALL NOT BE INJURIOUS OR DAMAGING TO THE EXISTING FACILITIES AND STRUCTURES WHICH SURROUND THE WORK AREAS.
- THE CONTRACTOR SHALL CONFINE HIS WORK WITHIN THE CONSTRUCTION LIMITS IN ORDER TO PRESERVE THE EXISTING IMPROVEMENTS AND SO AS NOT TO INTERFERE WITH THE OPERATIONS OF THE EXISTING FACILITIES.
- WHERE THE NEW WATERLINE CROSSES UNDER EXISTING FENCES, THE CONTRACTOR SHALL TUNNEL UNDER THE FENCE IN ORDER TO TRENCH AND INSTALL THE NEW WATERLINE. THE CONTRACTOR SHALL BE SOLELY RESPONSIBLE FOR ANY DAMAGE TO THE FENCE DURING THE CONSTRUCTION PERIOD AND SHALL REPAIR AND/OR REPLACE THE FENCE, IF NECESSARY, AT HIS EXPENSE AND AT NO ADDITIONAL COST TO THE OWNER. ALL REPAIRS OR REPLACEMENT OF EXISTING FENCING SHALL BE EQUAL TO OR BETTER THAN THE EXISTING CONDITION OF THE FENCE.
- THE CONTRACTOR SHALL ENSURE ANY EXISTING TREES FOUND TO BE IN CONFLICT WITH THE PROPOSED CONSTRUCTION SHALL BE REMOVED AND DISPOSED OF BY THE CONTRACTOR. THIS SHALL BE CONSIDERED INCIDENTAL TO CONSTRUCTION, THEREFORE, NO SEPARATE PAYMENT WILL BE MADE.
- SEVENTY-TWO (72) HOURS PRIOR TO THE COMMENCEMENT OF CONSTRUCTION ON EACH OF THE SITES, THE CONTRACTOR SHALL NOTIFY THE OWNER OF HIS INTENT TO BEGIN CONSTRUCTION. CONTACT MR. BOB ROBIE, FACILITIES, PLANNING AND CONSTRUCTION, 242-5865.
- WHERE EXISTING FIRE HYDRANTS ARE TO BE REMOVED AND RELOCATED, THE CONTRACTOR SHALL COORDINATE THIS WORK WITH THE OWNER SO THAT SCHOOL OPERATIONS ARE NOT ADVERSELY IMPACTED AND THE NECESSARY PRIVATE WATERLINE SHUTOFFS CAN BE ACCOMPLISHED. CONTACT MR. KEITH RUTHERFORD, MAINTENANCE AND OPERATIONS, 765-5950.
- THE CONTRACTOR SHALL BE RESPONSIBLE FOR THE COMPLETE REPAIR OF ANY EXISTING FACILITIES, STRUCTURES, OR UTILITIES DAMAGED BY CONSTRUCTION. REPAIRS SHALL BE MADE AT THE SOLE EXPENSE OF THE CONTRACTOR AND AT NO ADDITIONAL COST TO THE OWNER.
- WHERE WATER AND SANITARY SEWER LINES CROSS THE SANITARY SEWER LINE SHALL BE CONCRETE ENCASED FOR A DISTANCE OF 10 FEET EACH SIDE OF THE CROSSING IF 18 INCHES OF VERTICAL SEPARATION DOES NOT EXIST.
- ELECTRONIC MARKER DISKS (EMD'S) SHALL BE PLACED ABOVE ALL FITTINGS IN ACCORDANCE WITH SECTION 170 OF THE "STANDARD SPECIFICATIONS".
- IN ACCORDANCE WITH SECTION 801 OF THE "STANDARD SPECIFICATIONS", DETECTABLE WARNING TAPE SHALL BE INSTALLED 18 INCHES ABOVE ALL PVC PIPE INSTALLED ON THIS PROJECT.
- VALVE STEM EXTENSIONS SHALL BE PROVIDED IN ACCORDANCE WITH THE STANDARD SPECIFICATIONS. THE COST OF THE VALVE STEM EXTENSIONS SHALL BE CONSIDERED INCIDENTAL TO CONSTRUCTION THEREFORE NO SEPARATE PAYMENT WILL BE MADE.

AS BUILT INFORMATION				BENCH MARKS				SURVEY INFORMATION				ENGINEER'S SEAL			
CONTRACTOR	JONES INDUSTRIES	WORK	DATE 09/00	A	1' CUT ON THE N.E. CORNER	BOULDER OF	DATE	NO.	BY	DATE	NO.	DATE	NO.	BY	DATE
INSPECTOR	J.M.A.	INSPECTOR'S	DATE 09/00	FIRE HYDRANT	LOCATED ON THE WEST SIDE	OF 98th STREET S.W., 150' NORTH OF THE	DATE								
FIELD	M.A.S.	FIELD	DATE 09/00	INTERSECTION	OF GIBSON BOULEVARD S.W.	AND 98th STREET S.W. (C.O.A. B.M. 5-M)	DATE								
VERIFICATION	J.M.A.	VERIFICATION	DATE 09/00	ELEVATION	= 8150.917 FEET (M.S.L.D.)		DATE								
CORRECTED BY		CORRECTED BY													
RECORDED BY		RECORDED BY													

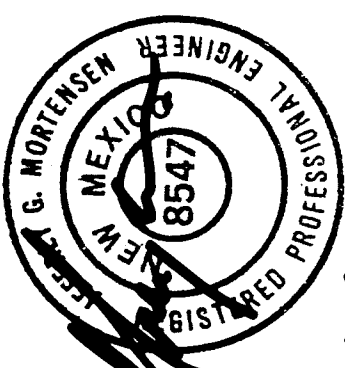

2 4 1 1 9 0 1 3 9 0

RECORD DRAWING

I, Jeffrey G. Mortensen, Registered Professional Engineer in the State of New Mexico, do hereby certify that this "as-built" information was obtained by me or under my supervision and represents the "as-built" conditions of this project, and is true and correct to the best of my knowledge and belief. All vertical and horizontal dimensions should be field verified prior to use on future projects.



CITY OF ALBUQUERQUE
PUBLIC WORKS DEPARTMENT
ENGINEERING GROUP

TITLE: TRUMAN MIDDLE SCHOOL
WATER VALVE SHUTOFF PLAN, SECTIONS & DETAILS



APPROVALS	ENGINEER	DATE	APPROVALS	ENGINEER	DATE
D.R.C. CHAIRMAN	Rogel Rios	7-18-90	WATER	R.W. Kame	7-16-90
TRANSPORTATION	R. J. Smith	7-17-90	WASTE WATER	R.W. Kame	7-16-90
HYDROLOGY	N/A				

PROJECT NO.	4111.90	MAP NO.	M-9	SHEET	13	OF	25
-------------	---------	---------	-----	-------	----	----	----

691812

STANDARD

RECORD DRAWING

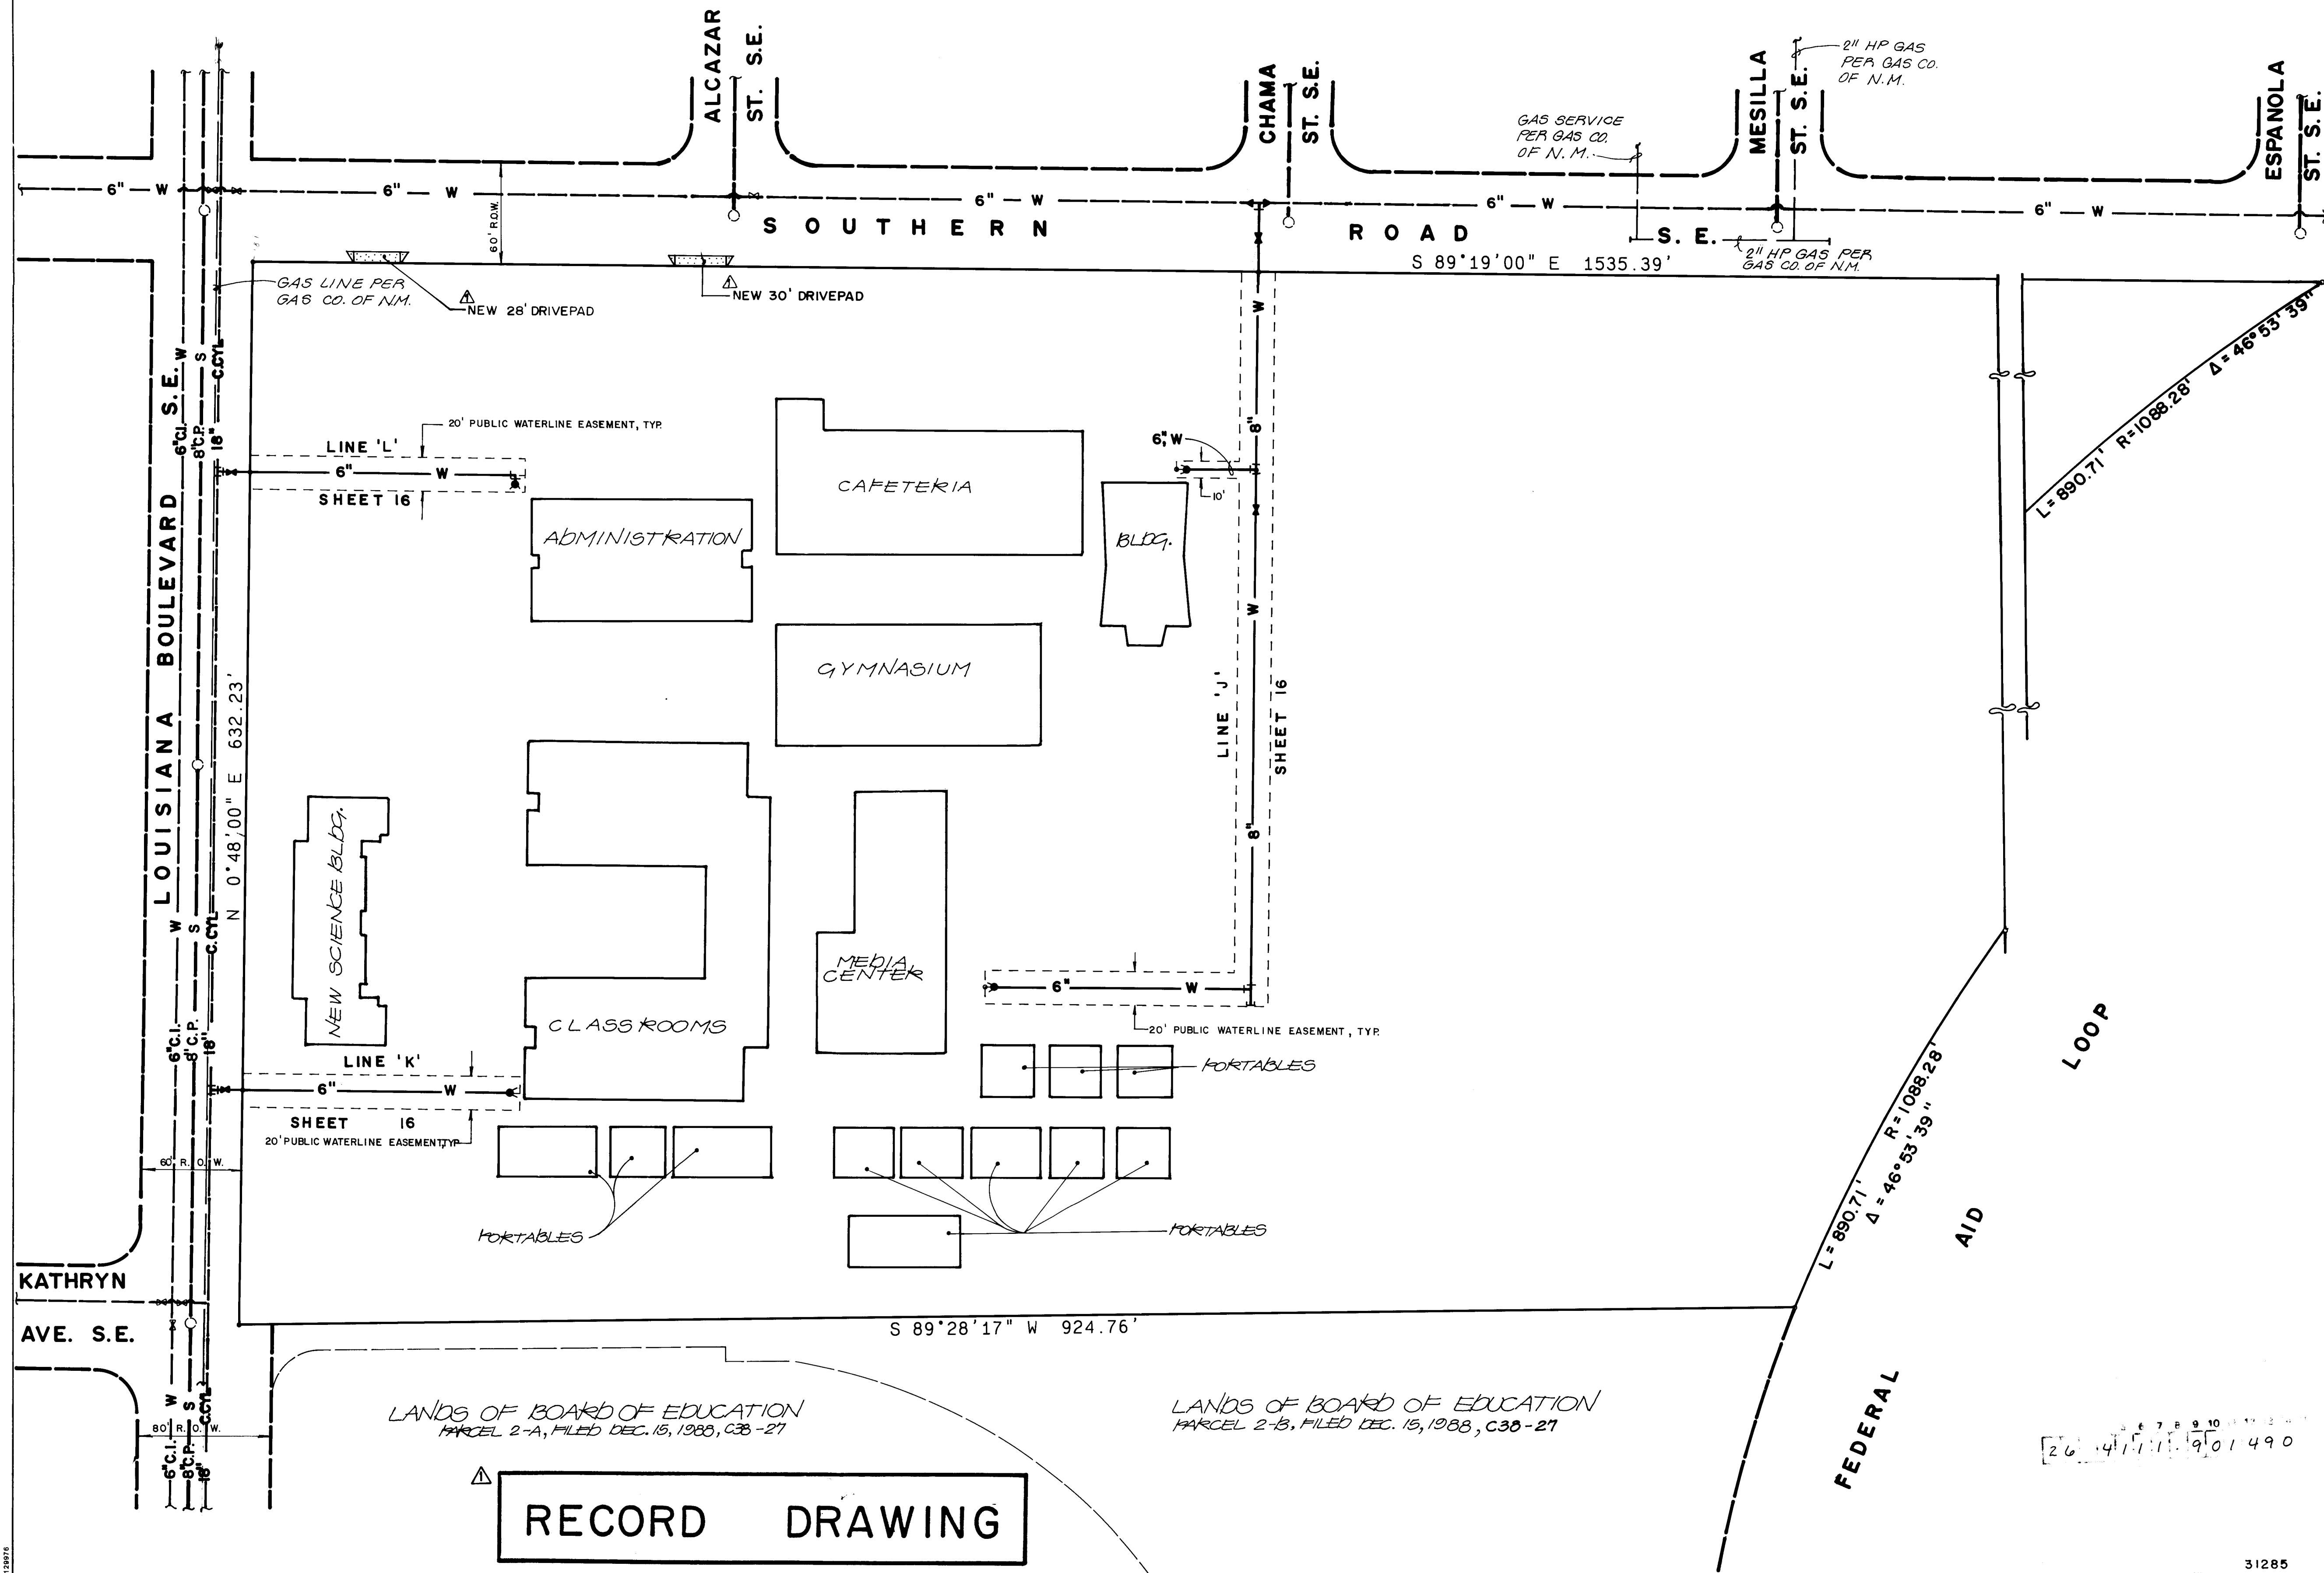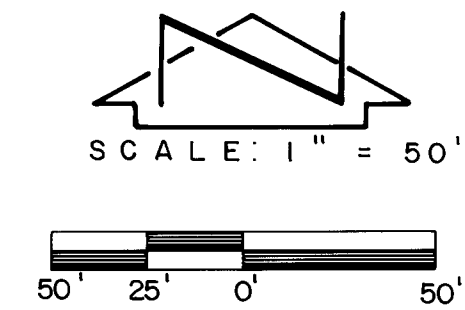

RECORD DRAWING

FOR CONSTRUCTION NOTES AFFECTING THIS SITE, REFER TO SHEET 17.

RECORD DRAWING


I, Jeffrey G. Mortensen, Registered Professional Engineer in the State of New Mexico, do hereby certify that this "as-built" information was obtained by me or under my supervision and represents the "as-built" conditions of this project, and is true and correct to the best of my knowledge and belief. All vertical and horizontal dimensions should be field verified prior to use on future projects.



Jeffrey G. Mortensen
Jeffrey G. Mortensen, P.E.
N.M.P.E. No. 8547
Date 06-26-90



JEFFREY G. MORTENSEN
NEW MEXICO
REGISTERED PROFESSIONAL ENGINEER
8547

CITY OF ALBUQUERQUE PUBLIC WORKS DEPARTMENT ENGINEERING GROUP			
TITLE: VAN BUREN MIDDLE SCHOOL SITE PLAN			
APPROVALS	ENGINEER	DATE	APPROVALS
D.R.C. Chairman	<i>Roger A. ...</i>	7-18-90	WATER
Transportation	<i>R. D. ...</i>	7-17-90	WASTE WATER
Hydrology	N/A		
PROJECT NO.		MAP NO.	SHEET OF
4111.90		L-19	14 25

ENGINEER'S SEAL		SURVEY INFORMATION		BENCH MARKS		AS BUILT INFORMATION	
		FIELD NOTES		A.C.S. BENCHMARK NO. G-L/B, A SQUARE, 12' CHISELED ON TOP OF CURB @ THE INTERSECTION OF LOUISIANA BLVD. S.E. & TRUMBULL ST. S.E. IN THE N.E. QUADRANT OF THE INTERSECTION. ELEVATION = 5327.68 FEET (M.S.L.D.)		CONTRACTOR: JONES INDUSTRIES WORK STAGED BY: J.M.A. DATE 08/90 INSPECTED BY: M.A.S. DATE 10/90 ACCEPTANCE BY: M.A.S. DATE 10/90 FIELD MEASUREMENT BY: M.A.S. DATE 10/90 DRAWINGS CORRECTED BY: J.M.A. DATE 10/90 MICRO-FILM INFORMATION RECORDED BY: NO DATE	
		NO.	BY				
NO.	DATE	REMARKS	BY	DATE			
DESIGN			DATE 12/80				
DRAWN BY J.M.C.			DATE 12/80				
CHECKED BY J.M.C.			DATE 08/90				

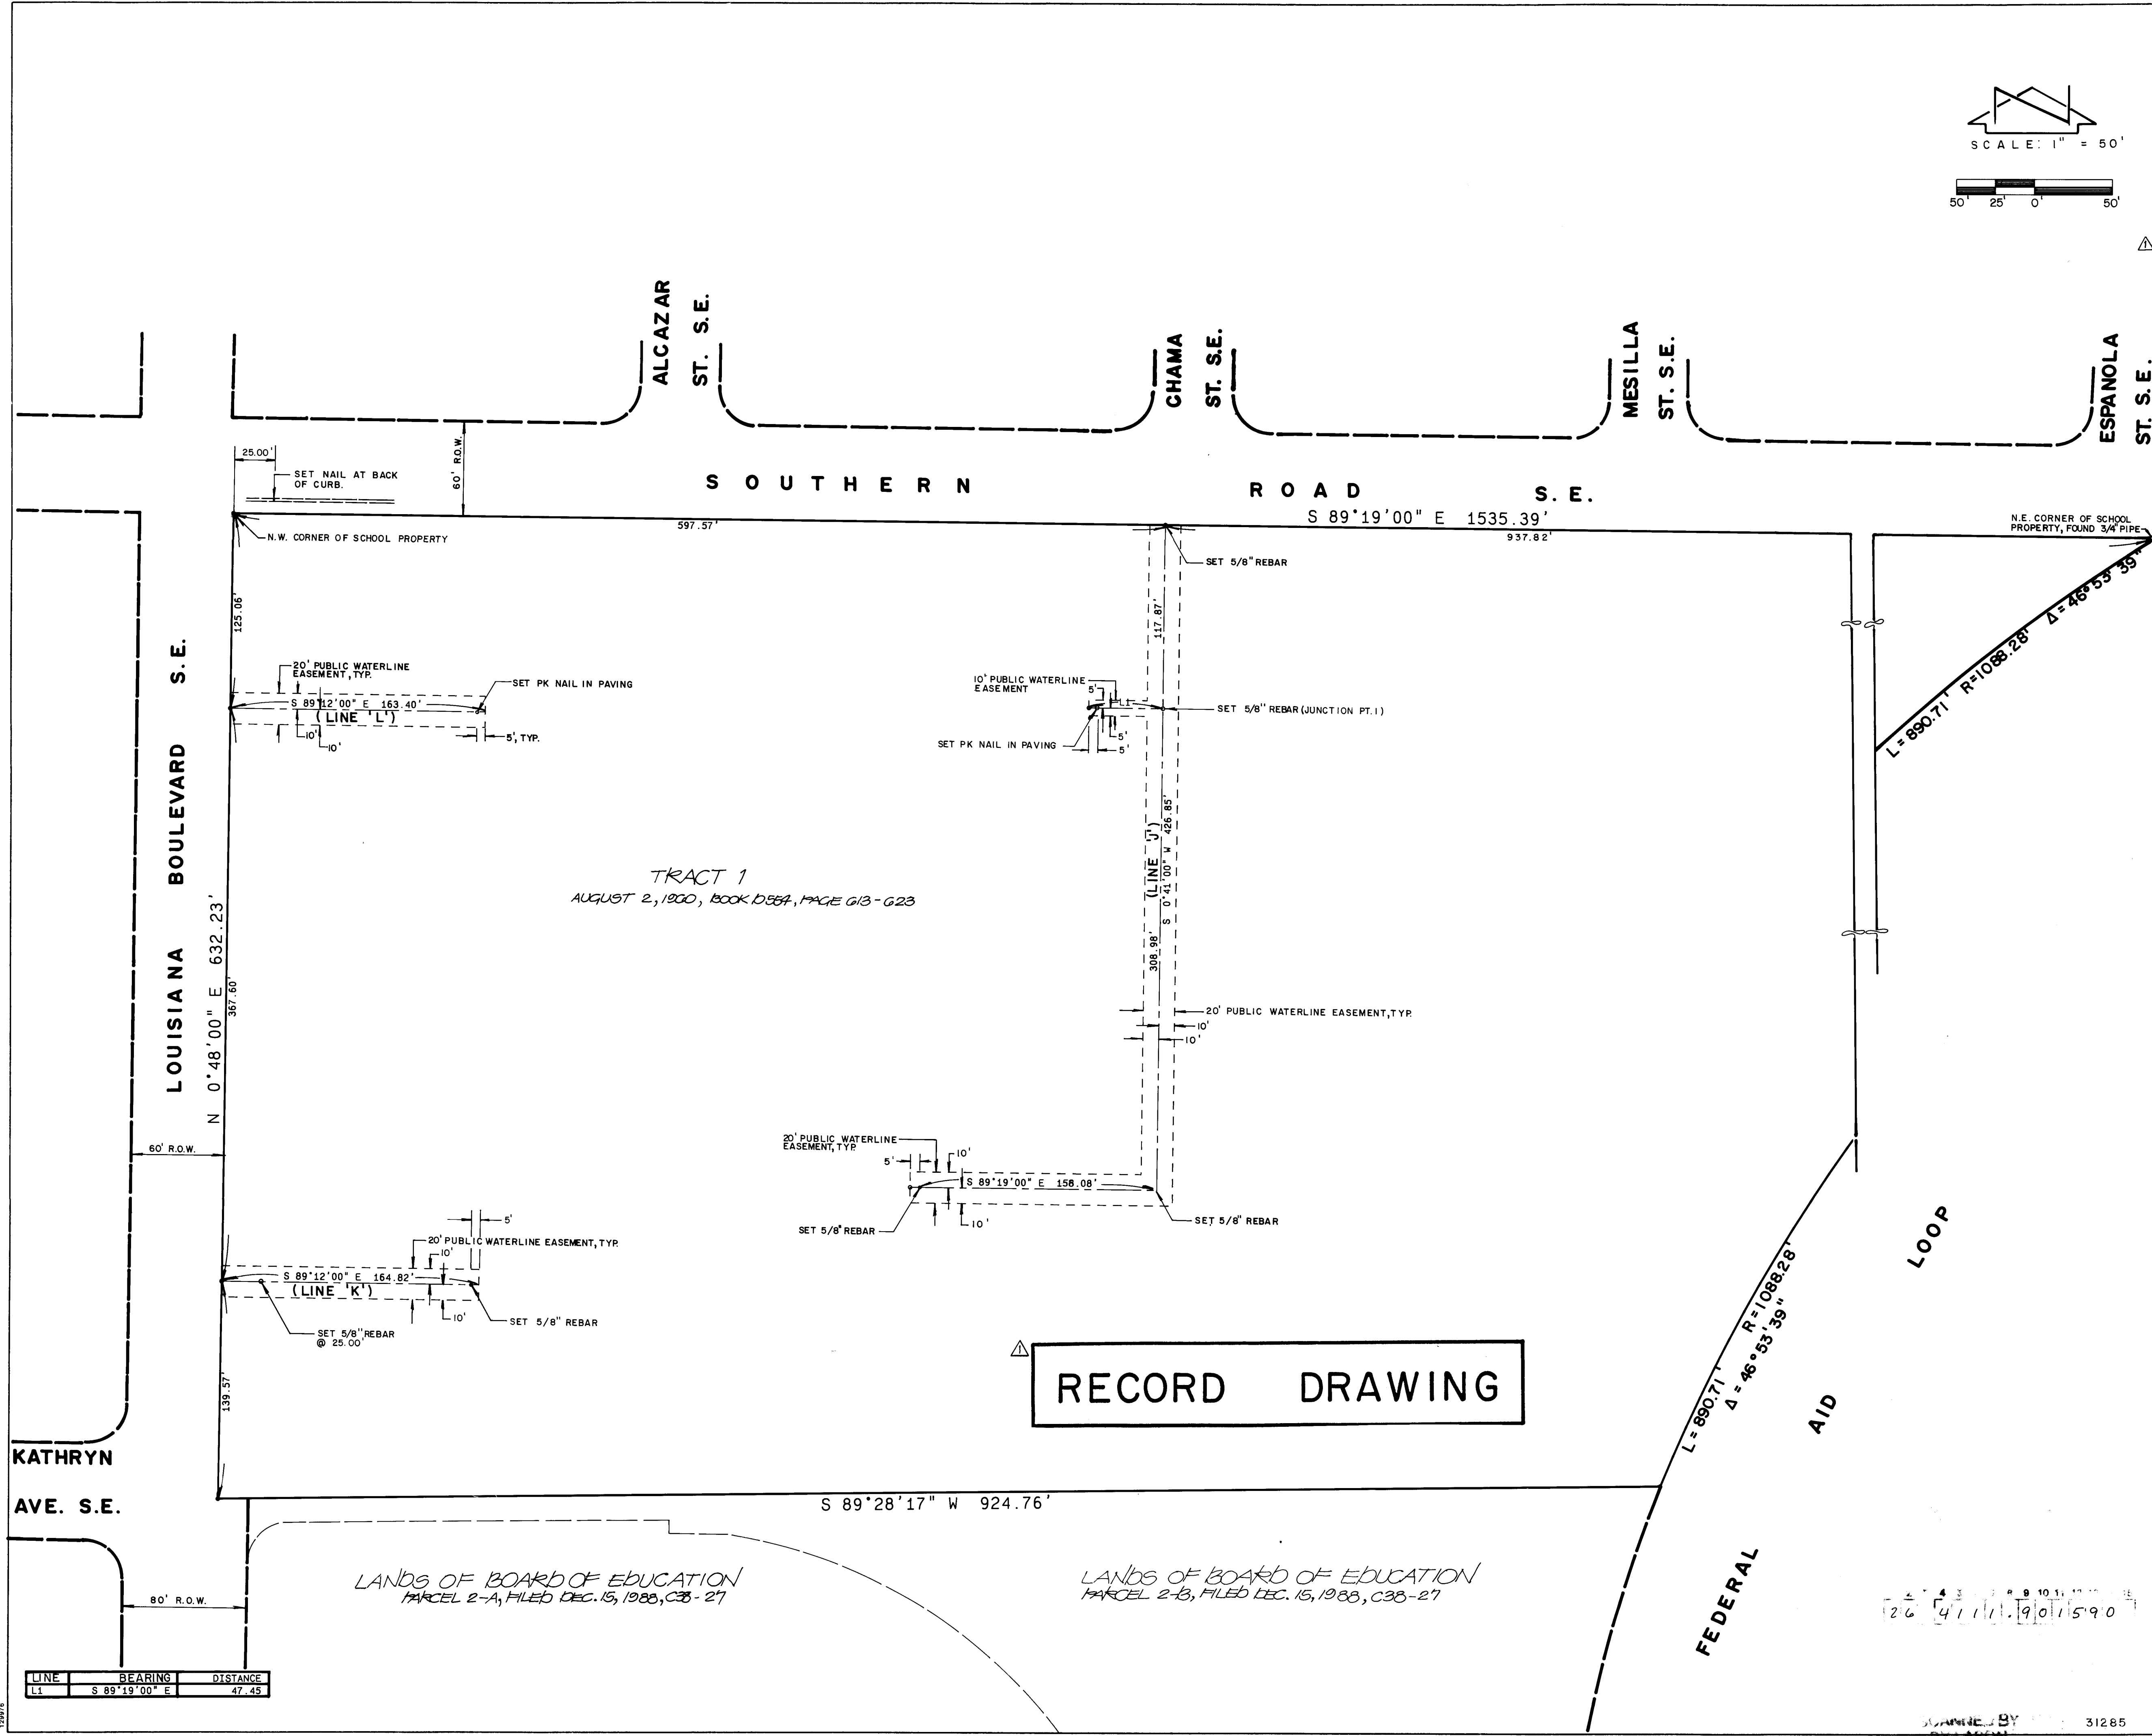


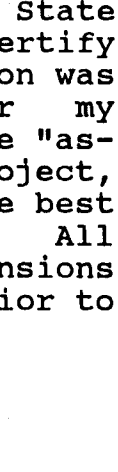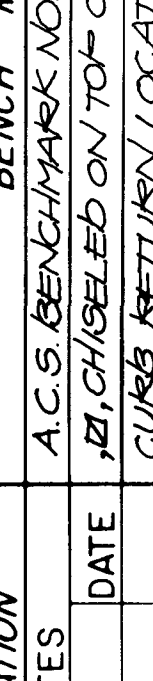NOTES:				BENCH MARKS		SURVEY INFORMATION		SURVEYOR'S SEAL		RECORD DRAWING		CITY OF ALBUQUERQUE PUBLIC WORKS DEPARTMENT ENGINEERING GROUP																																																									
1. THIS SITE COMPRISES BLOCKS 28-30, PORTIONS OF BLOCKS 31 & 32, FILED JUNE 15, 1944, BOOK D, PAGE 78. 2. TRACT 1 IS DEFINED BY DEED FILED AUGUST 2, 1960, BOOK D554, PAGES 613-623. 3. BEARING BASE IS DEED FILED AUGUST 2, 1960, BOOK D554, PAGES 613-623. 4. FIELD SURVEY PERFORMED ON DECEMBER 7 & 8, 1989. 5. EASEMENT FILED ON SEPTEMBER 21, 1990, BOOK 90-15, PAGES 7114-7117, DOC. # 9073813.	AS BUILT INFORMATION CONTRACTOR: JONES INDUSTRIES WORK STARTED BY: J.M.A. DATE 08/90 ACCEPTANCE BY: J.M.A. DATE 10/90 FIELD VERIFICATION BY: M.A.S. DATE 10/90 CORRECTED BY: J.M.A. DATE 10/90 MICRO-FILM INFORMATION RECORDED BY: DATE NO		BENCH MARKS A.C.S. BENCH MARK NO. G-1113. A SQUARE, PL. CHISELED ON TOP OF CURB @ THE N.W. CURB RETURN LOCATED AT THE INTER-SECTION OF LOUISIANA BLVD. (E. STRUT) BULL ST. 8 E. IN THE N.E. QUADRANT OF THE INTERSECTION. ELEVATION = 5327.68 FEET (MSL D.)		SURVEY INFORMATION FIELD NOTES <table border="1" style="width: 100%; border-collapse: collapse;"> <thead> <tr> <th style="width: 10%;">NO.</th> <th style="width: 10%;">BY</th> <th style="width: 10%;">DATE</th> </tr> </thead> <tbody> <tr><td> </td><td> </td><td> </td></tr> <tr><td> </td><td> </td><td> </td></tr> <tr><td> </td><td> </td><td> </td></tr> <tr><td> </td><td> </td><td> </td></tr> <tr><td> </td><td> </td><td> </td></tr> <tr><td> </td><td> </td><td> </td></tr> <tr><td> </td><td> </td><td> </td></tr> <tr><td> </td><td> </td><td> </td></tr> <tr><td> </td><td> </td><td> </td></tr> <tr><td> </td><td> </td><td> </td></tr> </tbody> </table>		NO.	BY	DATE																															SURVEYOR'S SEAL 		RECORD DRAWING I, Jeffrey G. Mortensen, Registered Professional Engineer in the State of New Mexico, do hereby certify that this "as-built" information was obtained by me or under my supervision and represents the "as-built" conditions of this project, and is true and correct to the best of my knowledge and belief. All vertical and horizontal dimensions should be field verified prior to use on future projects.  Jeffrey G. Mortensen, Registered Professional Engineer, No. 8547, Date 8-90		<table border="1" style="width: 100%; border-collapse: collapse;"> <thead> <tr> <th style="width: 10%;">J.G.M.</th> <th style="width: 10%;">BY</th> </tr> </thead> <tbody> <tr> <td> </td> <td> </td> </tr> </tbody> </table> <table border="1" style="width: 100%; border-collapse: collapse;"> <thead> <tr> <th style="width: 10%;">NO.</th> <th style="width: 10%;">DATE</th> <th style="width: 10%;">AS-BUILT</th> <th style="width: 10%;">REMARKS</th> </tr> </thead> <tbody> <tr> <td> </td> <td> </td> <td> </td> <td> </td> </tr> </tbody> </table> <table border="1" style="width: 100%; border-collapse: collapse;"> <thead> <tr> <th style="width: 10%;">DESIGNED BY</th> <th style="width: 10%;">DATE</th> <th style="width: 10%;">DRAWN BY</th> <th style="width: 10%;">DATE</th> <th style="width: 10%;">CHECKED BY</th> <th style="width: 10%;">DATE</th> </tr> </thead> <tbody> <tr> <td>J.G.M.</td> <td>12/89</td> <td>J.M.C.</td> <td>12/89</td> <td>J.G.M. / W.P.P.</td> <td>06/90</td> </tr> </tbody> </table>		J.G.M.	BY			NO.	DATE	AS-BUILT	REMARKS					DESIGNED BY	DATE	DRAWN BY	DATE	CHECKED BY	DATE	J.G.M.	12/89	J.M.C.	12/89	J.G.M. / W.P.P.	06/90
NO.	BY	DATE																																																																			
J.G.M.	BY																																																																				
NO.	DATE	AS-BUILT	REMARKS																																																																		
DESIGNED BY	DATE	DRAWN BY	DATE	CHECKED BY	DATE																																																																
J.G.M.	12/89	J.M.C.	12/89	J.G.M. / W.P.P.	06/90																																																																
TITLE: VAN BUREN MIDDLE SCHOOL EASEMENT SURVEY																																																																					
APPROVALS	ENGINEER	DATE	APPROVALS	ENGINEER	DATE																																																																
D.R.C. Chairman	<i>Robert Brown</i>	7-18-90	Water	<i>R.W. Kane</i>	7-16-90																																																																
Transportation	<i>R. D. Dwyer</i>	7-17-90	Waste Water	<i>R.W. Kane</i>	7-16-90																																																																
Hydrology	N/A																																																																				
PROJECT NO. 4111.90		MAP NO. L-19		SHEET 15 OF 25																																																																	

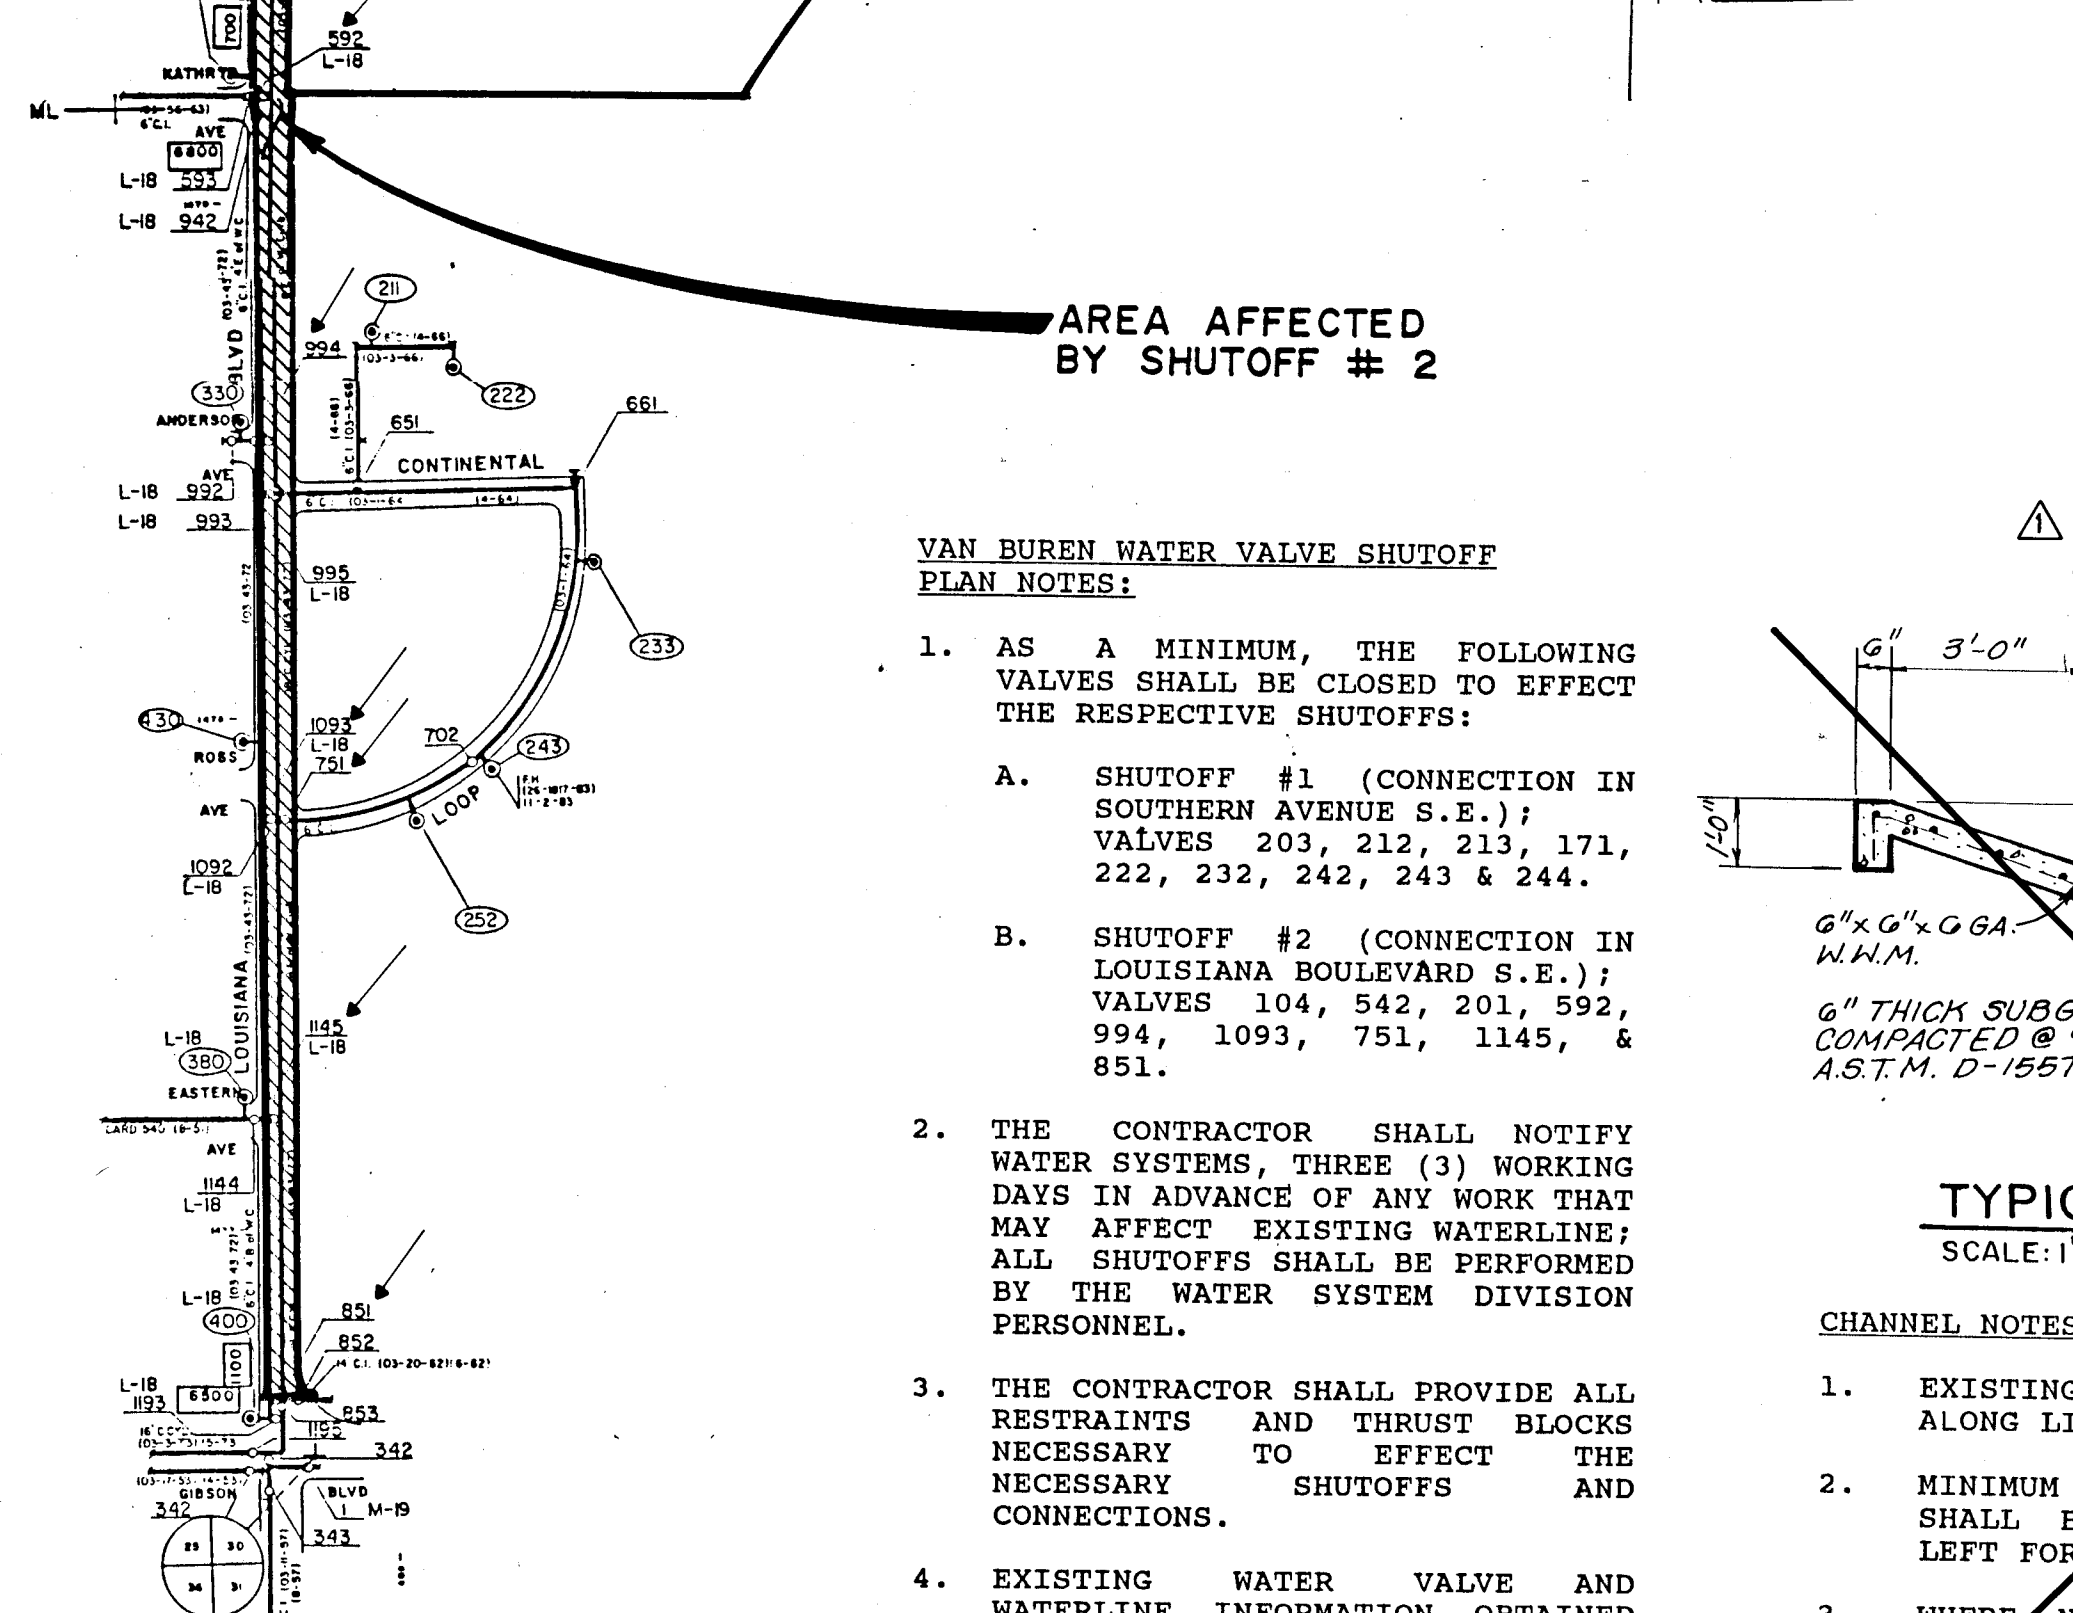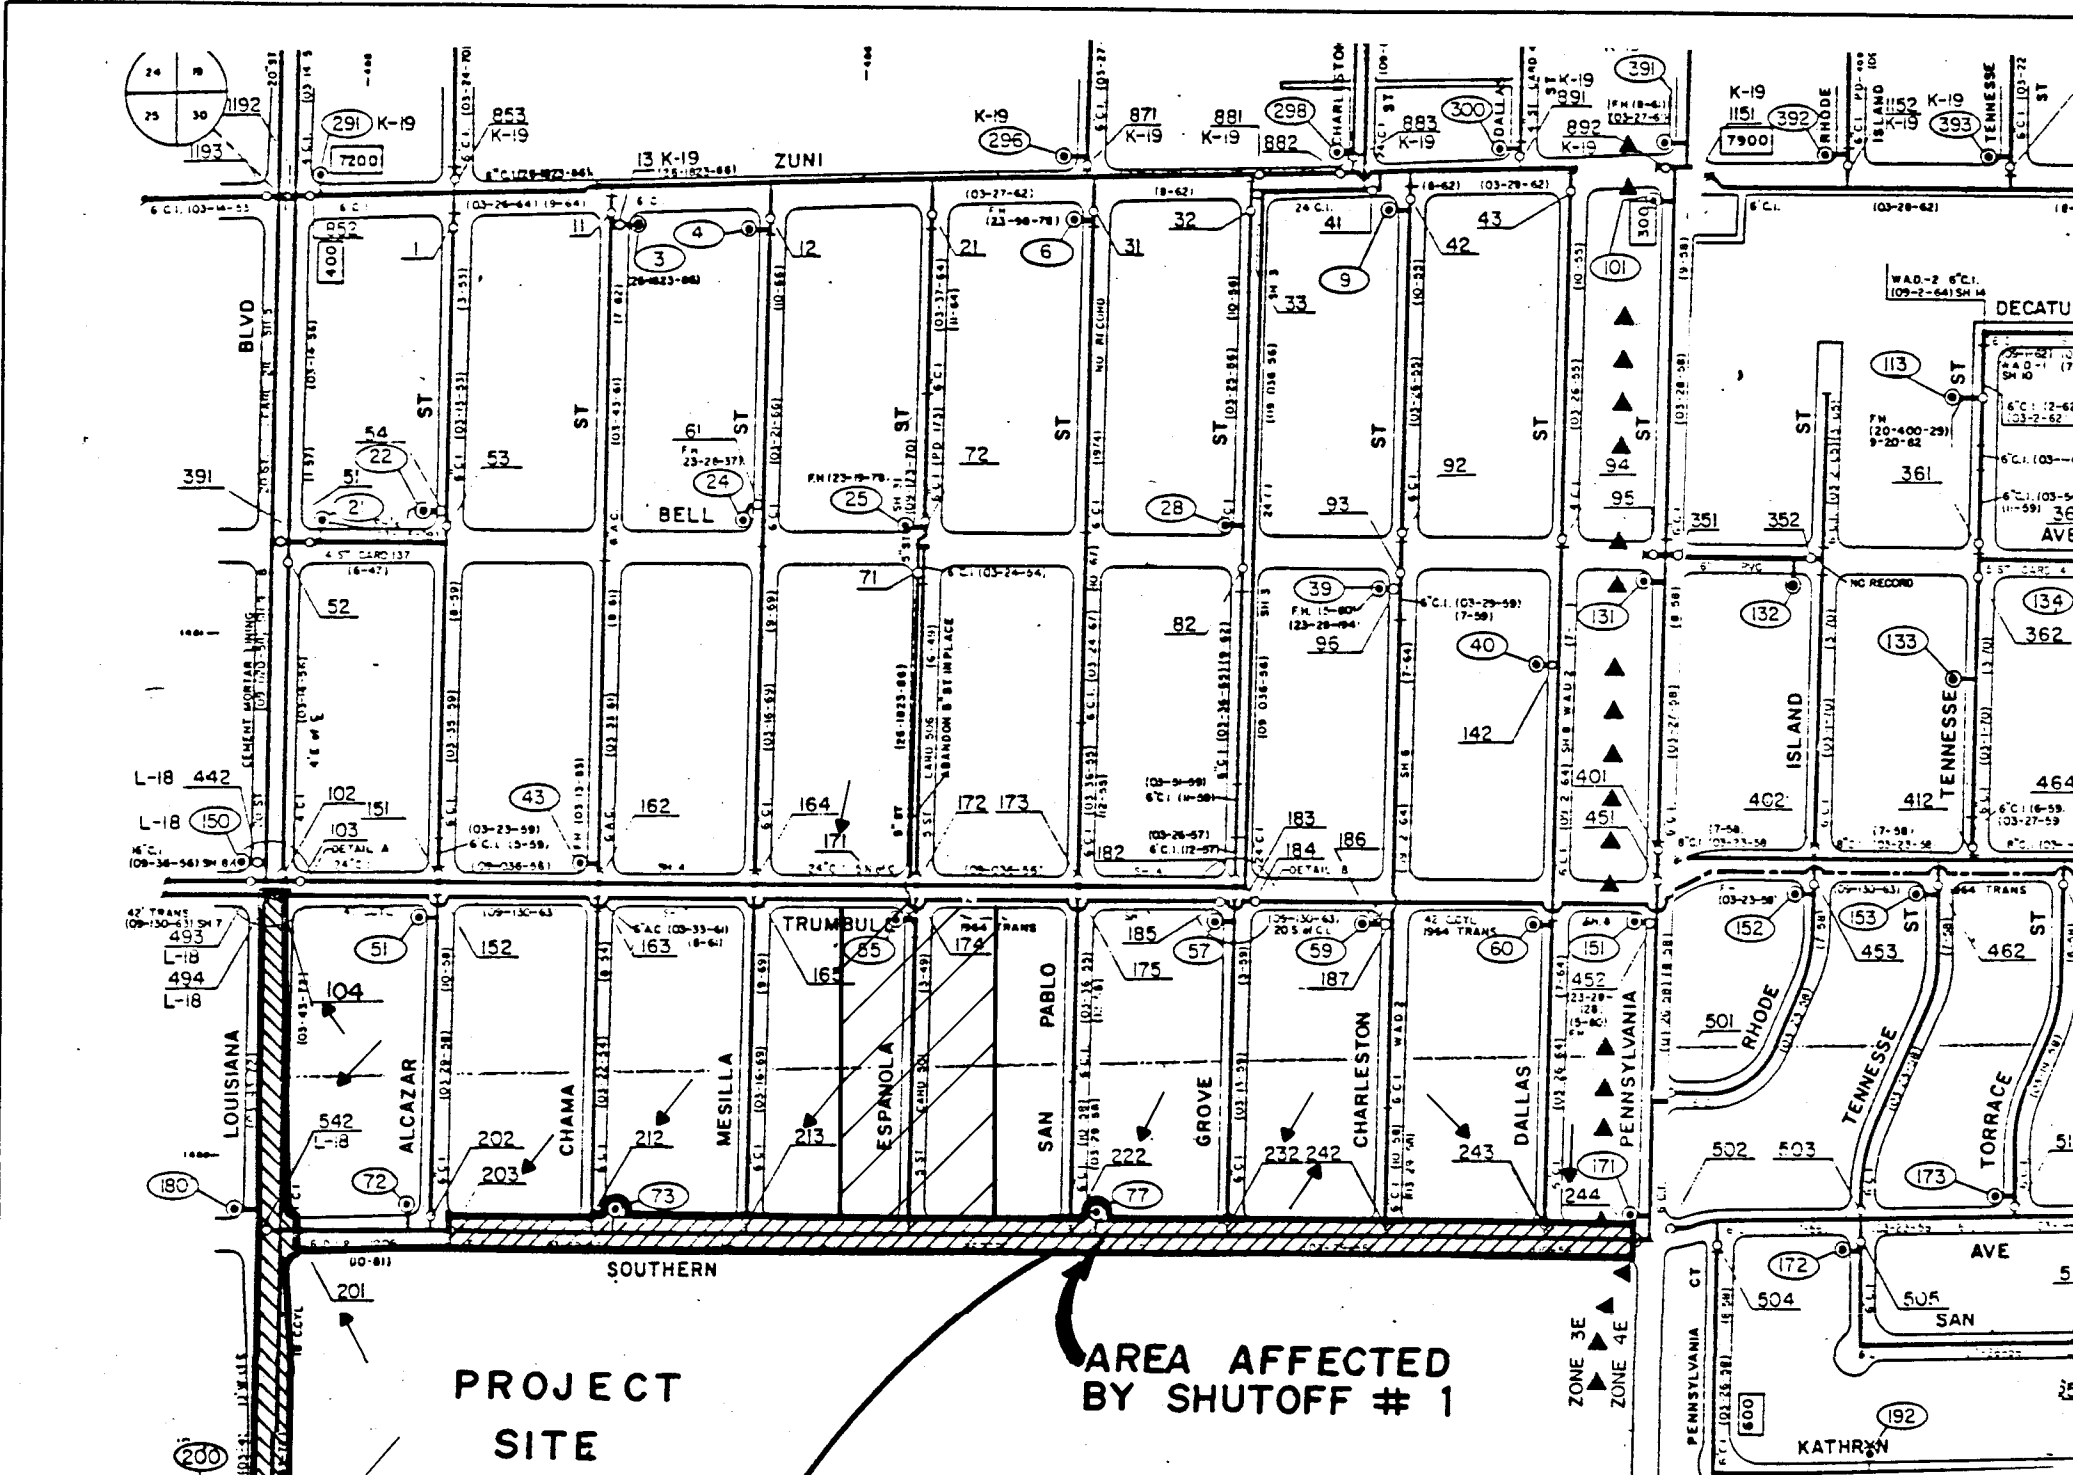


VAN BUREN WATER VALVE SHUTOFF PLAN NOTES:

1. AS A MINIMUM, THE FOLLOWING VALVES SHALL BE CLOSED TO EFFECT THE RESPECTIVE SHUTOFFS:
 - A. SHUTOFF #1 (CONNECTION IN SOUTHERN AVENUE S.E.); VALVES 203, 212, 213, 171, 222, 232, 242, 243 & 244.
 - B. SHUTOFF #2 (CONNECTION IN LOUISIANA BOULEVARD S.E.); VALVES 104, 542, 201, 592, 994, 1093, 751, 1145, & 851.
2. THE CONTRACTOR SHALL NOTIFY WATER SYSTEMS, THREE (3) WORKING DAYS IN ADVANCE OF ANY WORK THAT MAY AFFECT EXISTING WATERLINE; ALL SHUTOFFS SHALL BE PERFORMED BY THE WATER SYSTEM DIVISION PERSONNEL.
3. THE CONTRACTOR SHALL PROVIDE ALL RESTRAINTS AND THRUST BLOCKS NECESSARY TO EFFECT THE NECESSARY SHUTOFFS AND CONNECTIONS.
4. EXISTING WATER VALVE AND WATERLINE INFORMATION OBTAINED FROM CITY OF ALBUQUERQUE WATER SECTIONAL MAPS L-19N AND L-19S.

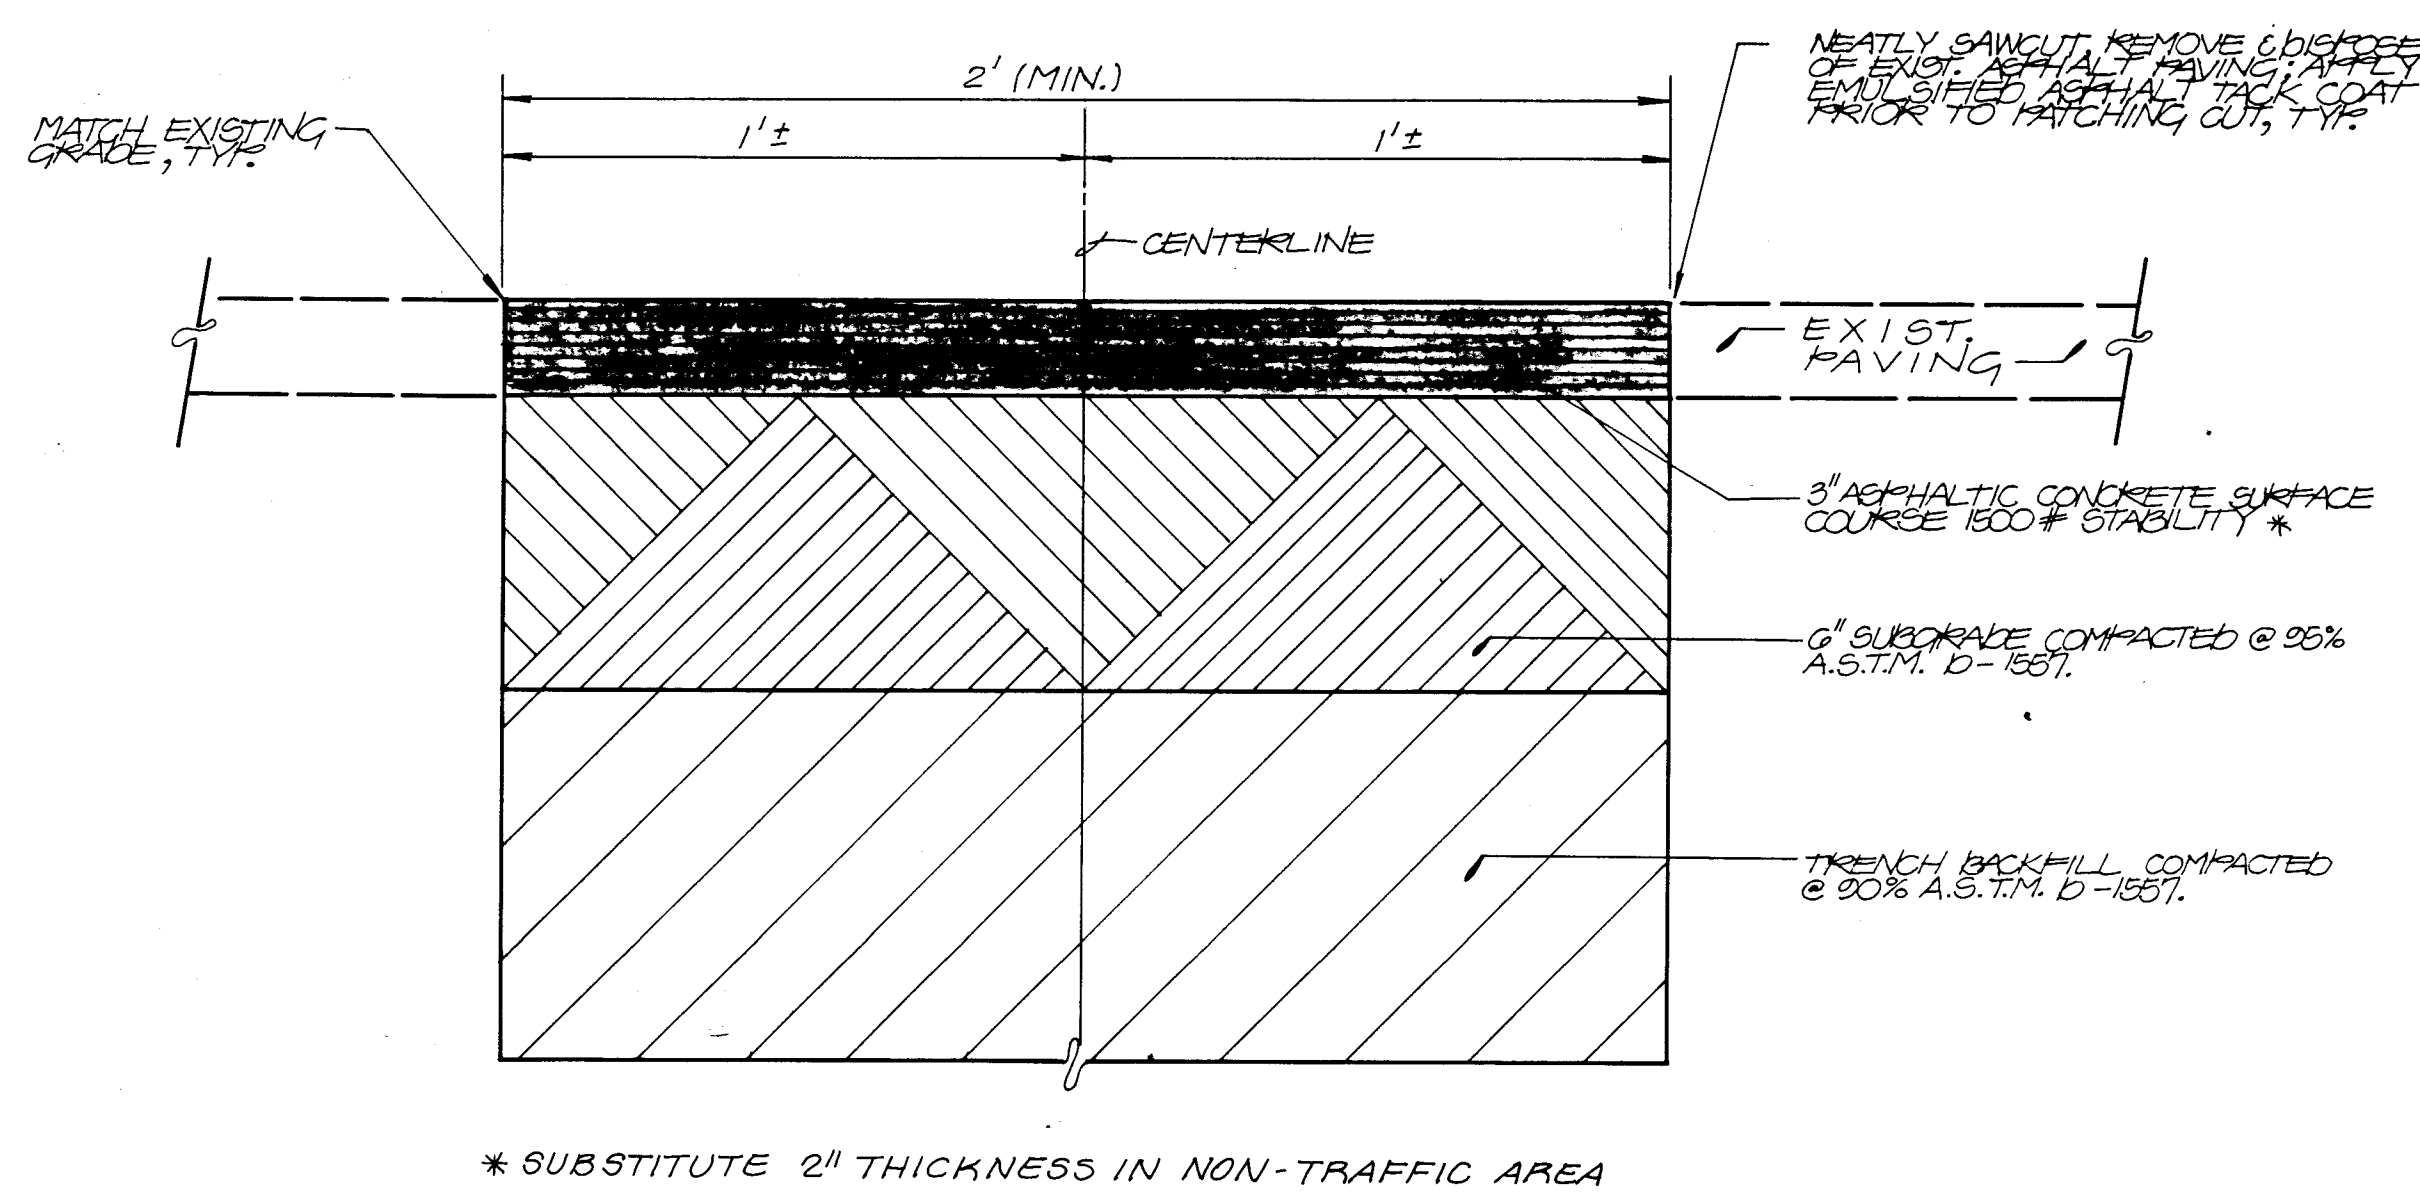

TYPICAL PRIVATE PAVING UTILITY CUT & PAVEMENT REPLACEMENT SECTION
SCALE: 1" = 4"

RECORD DRAWING

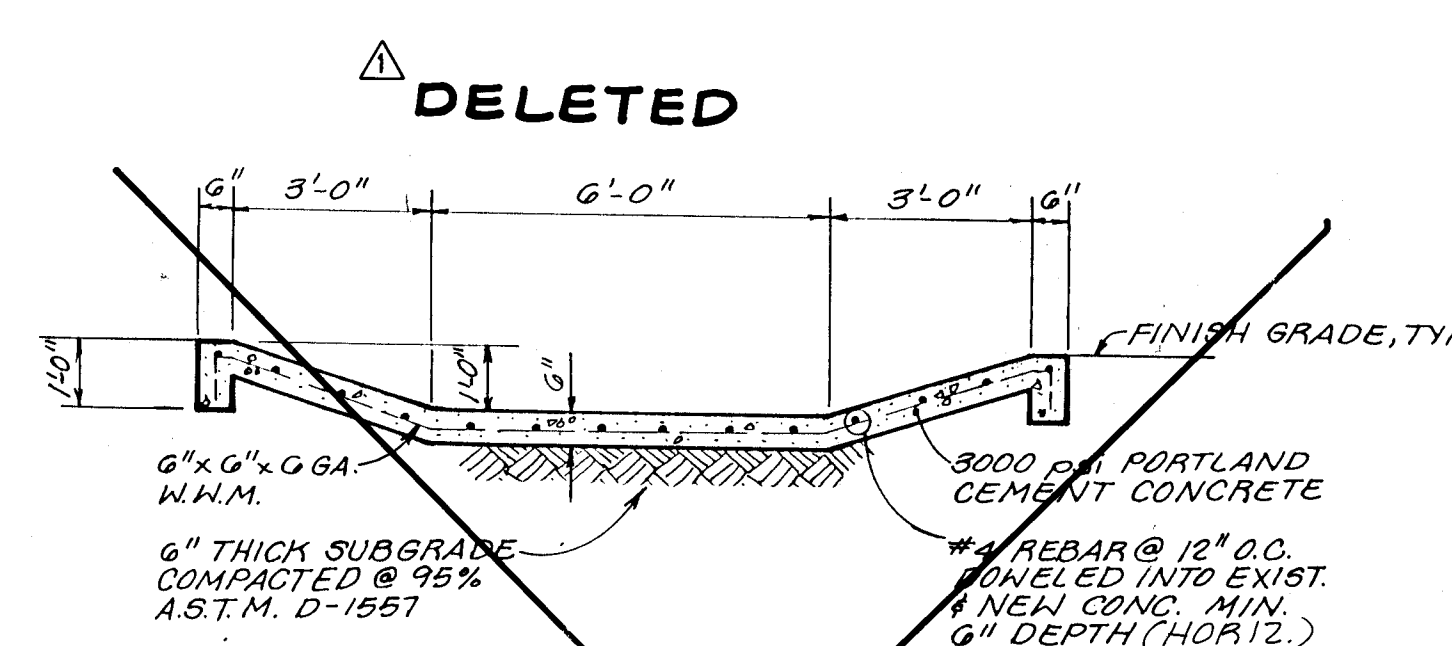

TYPICAL CHANNEL SECTION
SCALE: 1" = 3'-0"

CHANNEL NOTES:

1. EXISTING CHANNEL SHALL BE NEATLY SAWCUT ALONG LINES PERPENDICULAR TO THE FLOWING.
2. MINIMUM SECTION FOR REMOVAL AND REPLACEMENT SHALL BE 20' LONGITUDINALLY. (SEE NOTES AT LEFT FOR ADDITIONAL REQUIREMENTS).
3. WHERE NEW CONCRETE ABUTS EXISTING CONCRETE, JOINT SHALL BE THOROUGHLY SEALED WITH AN APPROVED URETHANE SEALANT TO PREVENT THE INFILTRATION OF SURFACE WATER.

NOTES:

1. TWO (2) WORKING DAYS PRIOR TO ANY EXCAVATION, CONTRACTOR MUST CONTACT NEW MEXICO ONE CALL SYSTEM 260-1990, FOR LOCATION OF EXISTING UTILITIES.
2. IF ANY UTILITY LINES, PIPELINES, OR UNDERGROUND UTILITY LINES ARE SHOWN ON THESE DRAWINGS, THEY ARE SHOWN IN AN APPROXIMATE MANNER ONLY, AND SUCH LINES MAY EXIST WHERE NONE ARE SHOWN. IF ANY SUCH EXISTING LINES ARE SHOWN, THE LOCATION IS BASED UPON INFORMATION PROVIDED BY THE OWNER OF SAID UTILITY, AND THE INFORMATION MAY BE INCOMPLETE, OR MAY BE OBSOLETE BY THE TIME CONSTRUCTION COMMENCES. THE ENGINEER HAS CONDUCTED ONLY PRELIMINARY INVESTIGATION OF THE LOCATION, DEPTH, SIZE, OR TYPE OF EXISTING UTILITY LINES, PIPELINES, OR UNDERGROUND UTILITY LINES. THIS INVESTIGATION IS NOT CONCLUSIVE, AND MAY NOT BE COMPLETE, THEREFORE, MAKES NO REPRESENTATION PERTAINING THERETO, AND ASSUMES NO RESPONSIBILITY OR LIABILITY THEREFOR. THE CONTRACTOR SHALL INFORM ITSELF OF THE LOCATION OF ANY UTILITY LINE, PIPELINE, OR UNDERGROUND UTILITY LINE IN OR NEAR THE AREA OF THE WORK IN ADVANCE OF AND DURING EXCAVATION WORK. THE CONTRACTOR IS FULLY RESPONSIBLE FOR ANY AND ALL DAMAGE CAUSED BY ITS FAILURE TO LOCATE, IDENTIFY AND PRESERVE ANY AND ALL EXISTING UTILITIES, PIPELINES, AND UNDERGROUND UTILITY LINES. IN PLANNING AND CONDUCTING EXCAVATION, THE CONTRACTOR SHALL COMPLY WITH STATE STATUTES, MUNICIPAL AND LOCAL ORDINANCES, RULES AND REGULATIONS, IF ANY, PERTAINING TO THE LOCATION OF THESE LINES AND FACILITIES.
3. SHOULD A CONFLICT EXIST BETWEEN THESE PLANS AND ACTUAL FIELD CONDITIONS, THE CONTRACTOR SHALL PROMPTLY NOTIFY THE ENGINEER IN WRITING SO THAT THE CONFLICT CAN BE RESOLVED WITH A MINIMUM AMOUNT OF DELAY FOR ALL PARTIES.
4. THE CONTRACTOR SHALL MAINTAIN ACCESS TO ALL BUILDINGS AND ADJACENT PROPERTIES DURING CONSTRUCTION.
5. THE CONTRACTOR SHALL ENSURE THAT NO SOIL ERODES FROM THE SITE INTO PUBLIC RIGHT-OF-WAY OR ONTO PRIVATE PROPERTY. THIS CAN BE ACHIEVED BY CONSTRUCTING AND MAINTAINING TEMPORARY BERMS AT THE PROPERTY LINES AND WETTING THE SOIL TO KEEP IT FROM BLOWING.
6. THE CONTRACTOR SHALL PROMPTLY CLEAN UP ANY MATERIAL EXCAVATED WITHIN THE PUBLIC RIGHT-OF-WAY SO THAT THE EXCAVATED MATERIAL IS NOT SUSCEPTIBLE TO BEING WASHED DOWN THE STREET.
7. IF THE REMOVAL OF EXISTING CURB AND GUTTER, SIDEWALK, AND/OR PAVING IS REQUIRED, THE CONTRACTOR SHALL SAWCUT AND/OR REMOVE TO THE NEAREST JOINT. WHEN ABUTTING NEW PAVEMENT TO EXISTING, THE CONTRACTOR SHALL CUT BACK THE EXISTING PAVING TO A STRAIGHT LINE IN ORDER TO REMOVE ANY BROKEN OR CRACKED PAVEMENT. CURB AND GUTTER AND/OR PAVEMENT SHOWN AS EXISTING AND NOT TO BE REMOVED UNDER THIS CONTRACT AND WHICH IS DAMAGED OR DISPLACED BY THE CONTRACTOR SHALL BE REMOVED AND REPLACED BY THE CONTRACTOR AT THE CONTRACTOR'S EXPENSE.
8. THE CONTRACTOR SHALL BE RESPONSIBLE FOR SAFELY OBTAINING THE REQUIRED COMPACTION. THE CONTRACTOR SHALL SELECT AND USE METHODS WHICH SHALL NOT BE INJURIOUS OR DAMAGING TO THE EXISTING FACILITIES AND STRUCTURES WHICH SURROUND THE WORK AREAS.
9. THE CONTRACTOR SHALL CONFINE HIS WORK WITHIN THE CONSTRUCTION LIMITS IN ORDER TO PRESERVE THE EXISTING IMPROVEMENTS AND SO AS NOT TO INTERFERE WITH THE OPERATIONS OF THE EXISTING FACILITIES.
10. WHERE THE NEW WATERLINE CROSSES UNDER EXISTING FENCES, THE CONTRACTOR SHALL TUNNEL UNDER THE FENCE IN ORDER TO TRENCH AND INSTALL THE NEW WATERLINE. THE CONTRACTOR SHALL BE SOLELY RESPONSIBLE FOR ANY DAMAGE TO THE FENCE DURING THE CONSTRUCTION PERIOD AND SHALL REPAIR AND/OR REPLACE THE FENCE, IF NECESSARY, AT HIS EXPENSE AND AT NO ADDITIONAL COST TO THE OWNER. ALL REPAIRS OR REPLACEMENT OF EXISTING FENCING SHALL BE EQUAL TO OR BETTER THAN THE EXISTING CONDITION OF THE FENCE.
11. ANY EXISTING TREES FOUND TO BE IN CONFLICT WITH THE PROPOSED CONSTRUCTION SHALL BE REMOVED AND DISPOSED OF BY THE CONTRACTOR. THIS SHALL BE CONSIDERED INCIDENTAL TO CONSTRUCTION, THEREFORE, NO SEPARATE PAYMENT WILL BE MADE.
12. SEVENTY-TWO (72) HOURS PRIOR TO THE COMMENCEMENT OF CONSTRUCTION ON EACH OF THE SITES, THE CONTRACTOR SHALL NOTIFY THE OWNER OF HIS INTENT TO BEGIN CONSTRUCTION. CONTACT MR. BOB ROBBIE, FACILITIES, PLANNING AND CONSTRUCTION, 242-5865.
13. WHERE EXISTING FIRE HYDRANTS ARE TO BE REMOVED AND RELOCATED, THE CONTRACTOR SHALL COORDINATE THIS WORK WITH THE OWNER SO THAT SCHOOL OPERATIONS ARE NOT ADVERSELY IMPACTED AND THE NECESSARY PRIVATE WATERLINE SHUTOFFS CAN BE ACCOMPLISHED. CONTACT MR. KEITH RUTHERFORD, MAINTENANCE AND OPERATIONS, 765-5950.
14. THE CONTRACTOR SHALL BE RESPONSIBLE FOR THE COMPLETE REPAIR OF ANY EXISTING FACILITIES, STRUCTURES, OR UTILITIES DAMAGED BY CONSTRUCTION. REPAIRS SHALL BE MADE AT THE SOLE EXPENSE OF THE CONTRACTOR AND AT NO ADDITIONAL COST TO THE OWNER.
15. WHERE WATER AND SANITARY SEWER LINES CROSS THE SANITARY SEWER LINE SHALL BE CONCRETE ENCASED FOR A DISTANCE OF 10 FEET EACH SIDE OF THE CROSSING IF 18 INCHES OF VERTICAL SEPARATION DOES NOT EXIST.
16. ELECTRONIC MARKER DISKS (EMD'S) SHALL BE PLACED ABOVE ALL FITTINGS IN ACCORDANCE WITH SECTION 170 OF THE "STANDARD SPECIFICATIONS".
17. IN ACCORDANCE WITH SECTION 801 OF THE "STANDARD SPECIFICATIONS", METALLIZED DETECTABLE WARNING TAPE SHALL BE INSTALLED 18 INCHES ABOVE ALL PVC PIPE INSTALLED ON THIS PROJECT.
18. VALVE STEM EXTENSIONS SHALL BE PROVIDED IN ACCORDANCE WITH THE STANDARD SPECIFICATIONS. THE COST OF THE VALVE STEM EXTENSIONS SHALL BE CONSIDERED INCIDENTAL TO CONSTRUCTION THEREFORE NO SEPARATE PAYMENT WILL BE MADE.

VAN BUREN WATER VALVE SHUTOFF PLAN
SCALE: 1" = 400' (APPROX.)

26 26 90

RECORD DRAWING

I, Jeffrey G. Mortensen, Registered Professional Engineer in the State of New Mexico, do hereby certify that this "as-built" information was obtained by me or under my supervision and represents the "as-built" conditions of this project, and is true and correct to the best of my knowledge and belief. All vertical and horizontal dimensions should be field verified prior to use on future projects.

Jeffrey G. Mortensen
NEW MEXICO
REGISTERED PROFESSIONAL ENGINEER
No. 1547

CITY OF ALBUQUERQUE PUBLIC WORKS DEPARTMENT ENGINEERING GROUP					
TITLE: VAN BUREN MIDDLE SCHOOL WATER VALVE SHUTOFF PLAN, SECTIONS & DETAILS					
APPROVALS	ENGINEER	DATE	APPROVALS	ENGINEER	DATE
D.R.C. Chairman	Roger A. Dura	7-18-90	WATER	R.W. Kane	7-16-90
Transportation	R. Dura	7-17-90	WASTE WATER	R.W. Kane	7-16-90
Hydrology	N/A				
PROJECT NO.	4111.90	MAP NO.	L-19	SHEET	17 OF 25



FOR CONSTRUCTION NOTES AFFECTING THIS SITE, REFER TO SHEETS 20 & 21.

NOTE:

LINE "P" IS "PRIVATE" AND NOT PART OF THE CITY WORK ORDER. HOWEVER, IS INCLUDED IN THIS CONTRACT

RECORD DRAWING

1 2 3 4 5 6 7 8 9 10 11 12 13 14 15
26 4 1 1 1 . 9 0 1 8 9 0

RECORD DRAWING

I, Jeffrey G. Mortensen, Registered Professional Engineer in the State of New Mexico, do hereby certify that this "as-built" information was obtained by me or under my supervision and represents the "as-built" conditions of this project and is true and correct to the best of my knowledge and belief. All vertical and horizontal dimensions should be field verified prior to use on future projects.

Jeffrey G. Mortensen
N.M.P.E. No. 8547
NEW MEXICO
REGISTERED PROFESSIONAL ENGINEER

CITY OF ALBUQUERQUE
PUBLIC WORKS DEPARTMENT
ENGINEERING GROUP

TITLE: VALLEY HIGH SCHOOL SITE PLAN			
APPROVALS	ENGINEER	DATE	APPROVALS
D.R.C. Chairman	<i>R.W. Kane</i>	7-18-90	Water
Transportation	<i>R.W. Kane</i>	7-17-90	Waste Water
Hydrology	<i>N/A</i>		
PROJECT NO.	4111.90	MAP NO.	G-13
		SHEET	18
		OF	25

SURVEY INFORMATION		AS BUILT INFORMATION	
FIELD NOTES	NO.	AC.S. STATION 5-G13A, A STANDARD BOXES TABLE SET FLOSH WITH THE GROUND. STATION IS LOCATED WITHIN THE NORTHERN R.O.W. OF CANDELARIA RD. U.W. APPROX. 6.4' EAST OF THE ENTRANCE LANE TO VALLEY HIGH SCHOOL, ON THE NORTH SIDE OF THE SIDEWALK.	CONTRACTOR JONES INDUSTRIES
DATE			STATIONED BY J.M.A.
BY			INSPECTOR'S FIELD PLANCE BY H.A.G.
			DATE 07/90
			VERIFICATION BY J.M.A.
			DATE 10/90
			CORRECTED BY J.M.A.
			DATE 10/90
			MICRO-FILM INFORMATION
			RECORDED BY
			NO.
			DATE

LINE	BEARING	DISTANCE
L1	N 06°55'00" E	142.56
L2	N 86°19'00" W	160.88
L3	N 06°55'00" E	13.29
L4	N 05°18'00" E	95.58
L5	N 33°57'00" E	120.30
L6	N 26°17'00" E	67.24
L7	N 16°59'00" E	126.33
L8	N 14°03'30" E	35.34
L9	S 71°22'30" E	189.50
L10	N 72°07'00" W	189.36
L11	S 71°53'00" E	128.97
L12	S 70°16'00" E	25.00
L13	S 18°10'00" W	33.05
L14	S 16°53'00" W	131.00
L15	S 23°31'00" E	42.00
L16	S 50°01'00" E	144.65
L17	S 36°12'00" E	85.46
L18	S 21°33'00" E	104.52
L19	S 45°16'40" E	139.35
L20	S 75°18'00" E	103.85
L21	S 17°02'00" W	198.90
L22	S 01°18'00" W	131.37
L23	S 34°29'00" W	107.50
L24	S 12°44'00" W	197.22
L25	S 30°05'00" W	149.78
L26	S 25°57'00" W	201.54
L27	N 18°17'35" E	156.71
L28	N 28°20'33" E	65.45
L29	N 10°17'35" E	6.38
L30	S 05°41'28" W	192.90
L31	N 84°13'29" E	11.00
L32	N 15°03'13" E	110.54
L33	S 84°32'52" E	60.81
L34	S 84°13'29" E	77.24
L35	S 84°13'48" E	30.59
L36	S 84°13'48" E	32.48
L37	S 65°15'53" E	41.23
L38	S 05°46'12" W	81.39
L39	S 05°46'12" W	115.94
L40	S 84°13'48" E	22.82
L41	S 05°46'12" W	34.55
L42	S 84°30'36" E	16.50

CURVE	ARC	DELTA	RADIUS	CHORD LENGTH	CHORD BEARING	TAN LENGTH
C1	286.97	11°10'00"	1472.40	286.51	N 78°50'16" W	143.94

CHEROKEE ROAD N.W.

CAMINO DE COMPANIA

DON JUAN CT. N.W.

SAN ISIDRO ROAD

CHEROKEE ROAD N.W.

SCHOOL ROADWAY

N 71°22'30" W 963.58'

N 75°01'00" E 543.43'

N 75°22'00" W 543.25'

S 75°18'00" E 326.30'

N 5°18'00" E 667.64'

N 85°37'00" W 503.48'

N 84°20'00" W 332.26'

N 19°18'00" E 356.56'

S 19°44'00" W 216.60'

N 21°28'30" E 212.29'

S 70°16'00" E 631.70'

N 15°00'30" E 271.93'

S 75°01'00" E 543.43'

N 75°22'00" W 543.25'

S 75°18'00" E 326.30'

N 5°18'00" E 667.64'

N 85°37'00" W 503.48'

N 84°20'00" W 332.26'

N 19°18'00" E 356.56'

S 19°44'00" W 216.60'

N 21°28'30" E 212.29'

S 70°16'00" E 631.70'

N 15°00'30" E 271.93'



S 75°01'00" E 543.43'

N 75°22'00" W 543.25'

S 75°18'00" E 326.30'

N 5°18'00" E 667.64'

N


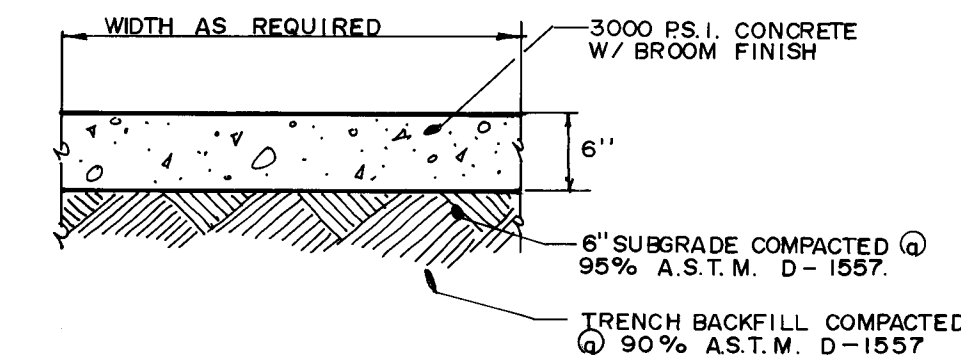
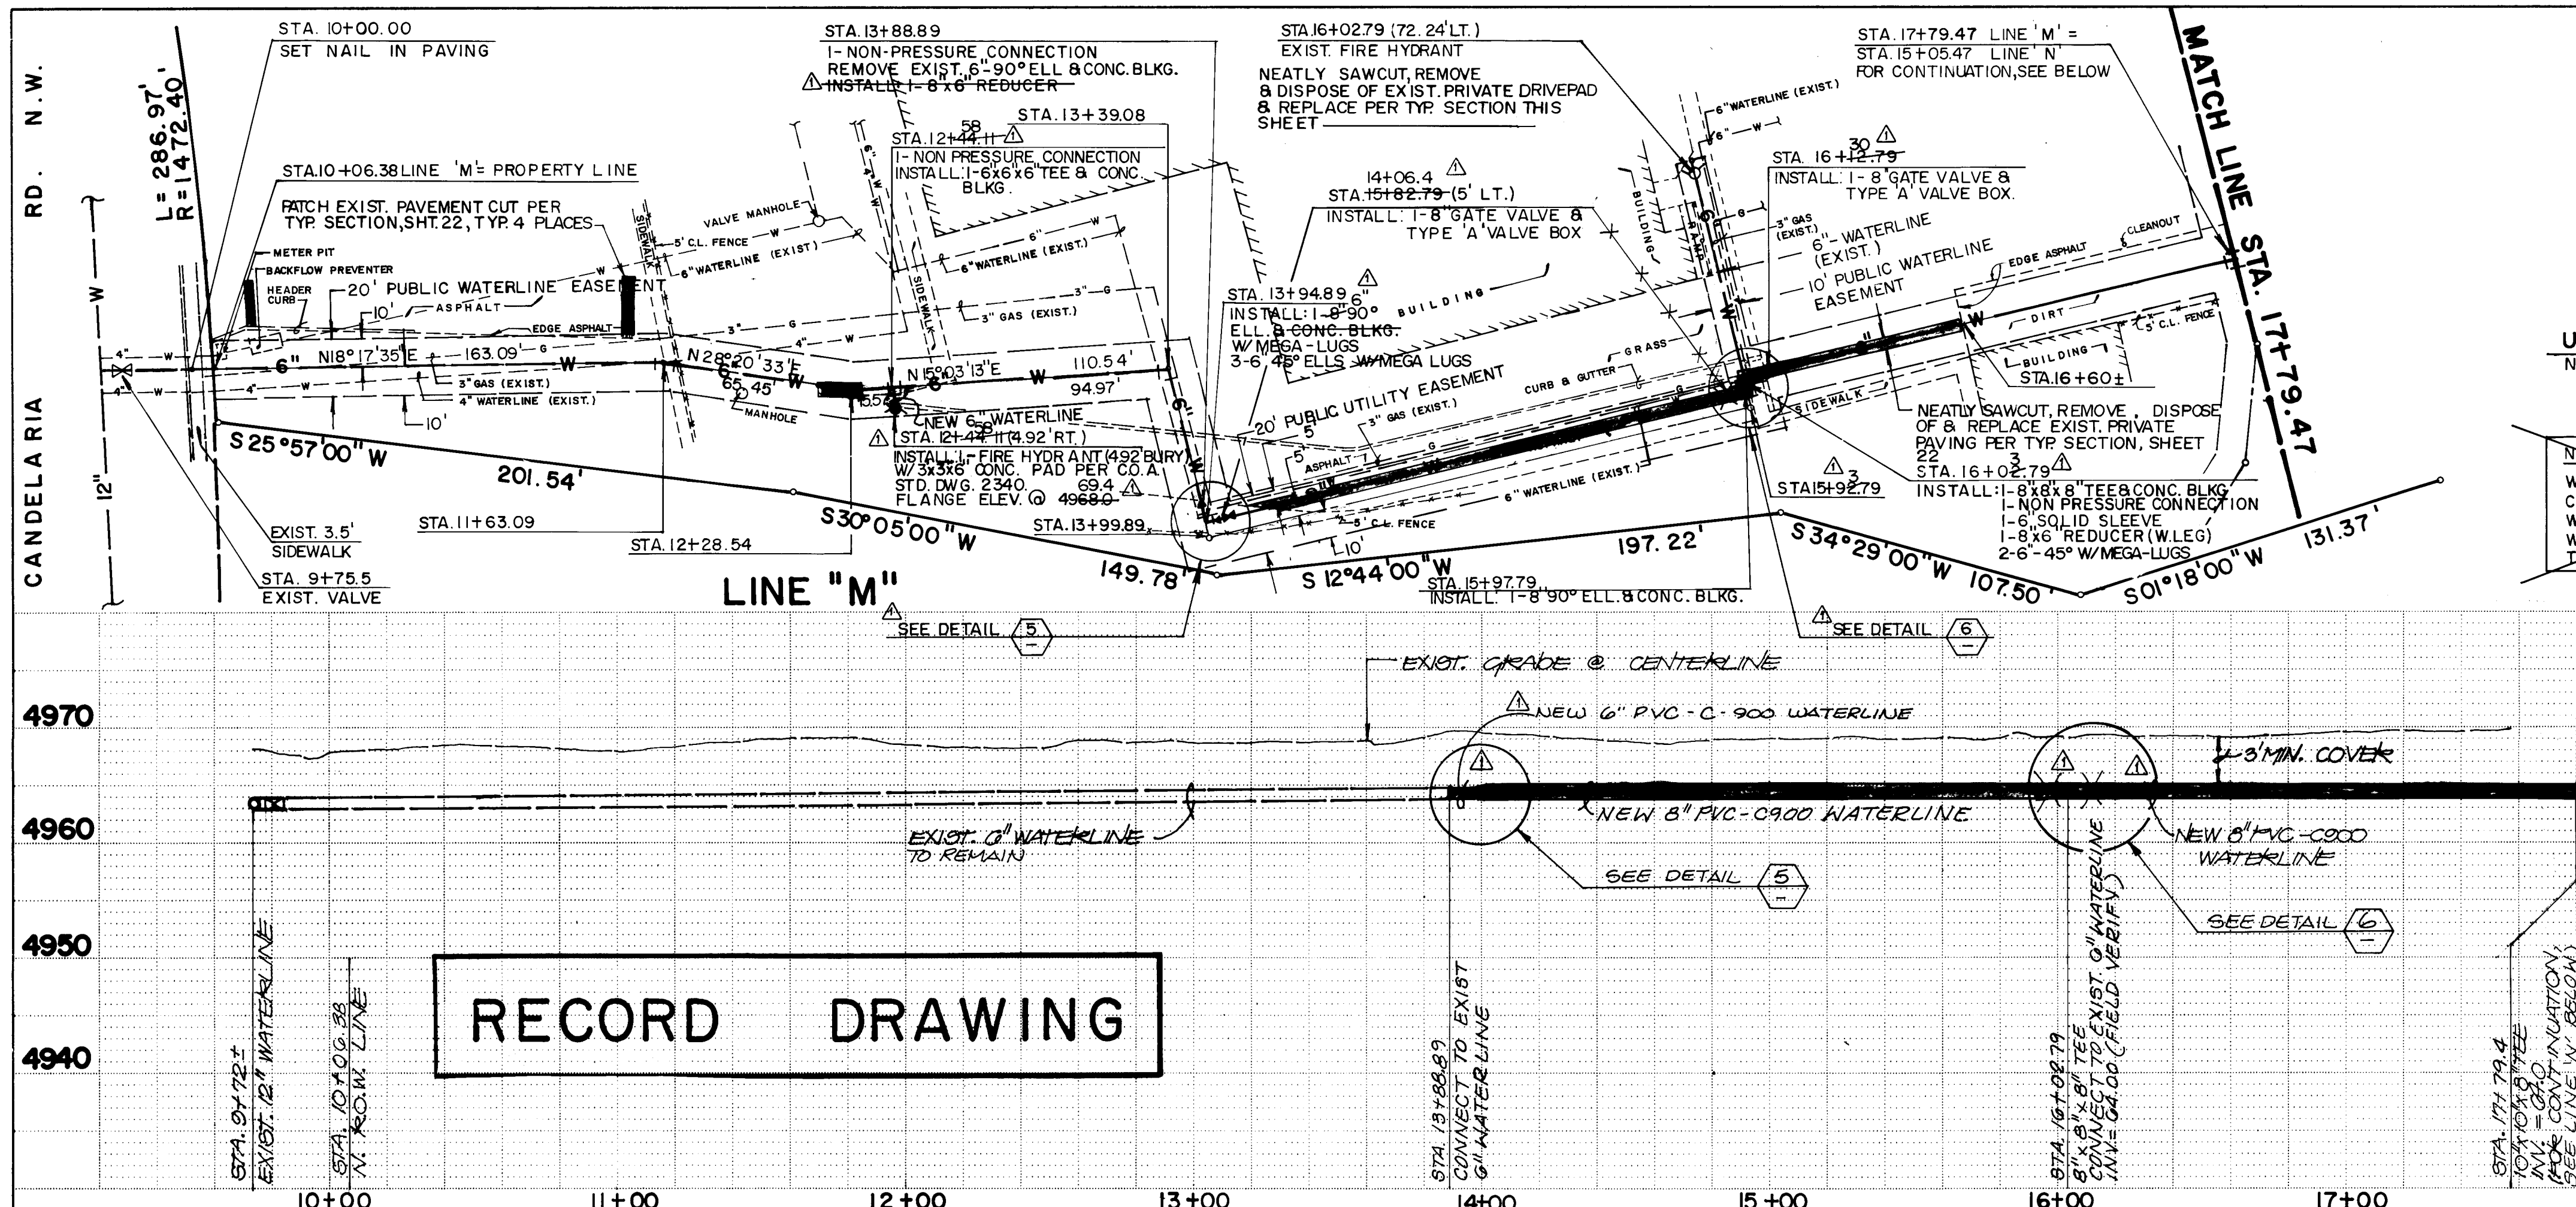


NOTE: WHERE THE NEW 8" WATERLINE CROSSES THE EXIST. 6" PRIVATE WATERLINE, THE EXISTING 6" WATERLINE SHALL BE LOWERED TO AVOID CONFLICT.

FOR CONSTRUCTION NOTES AFFECTING THIS SITE, REFER TO SHEET 22.

HORIZONTAL SCALE: 1"=40'
VERTICAL SCALE: 1"=10'

RECORD DRAWING

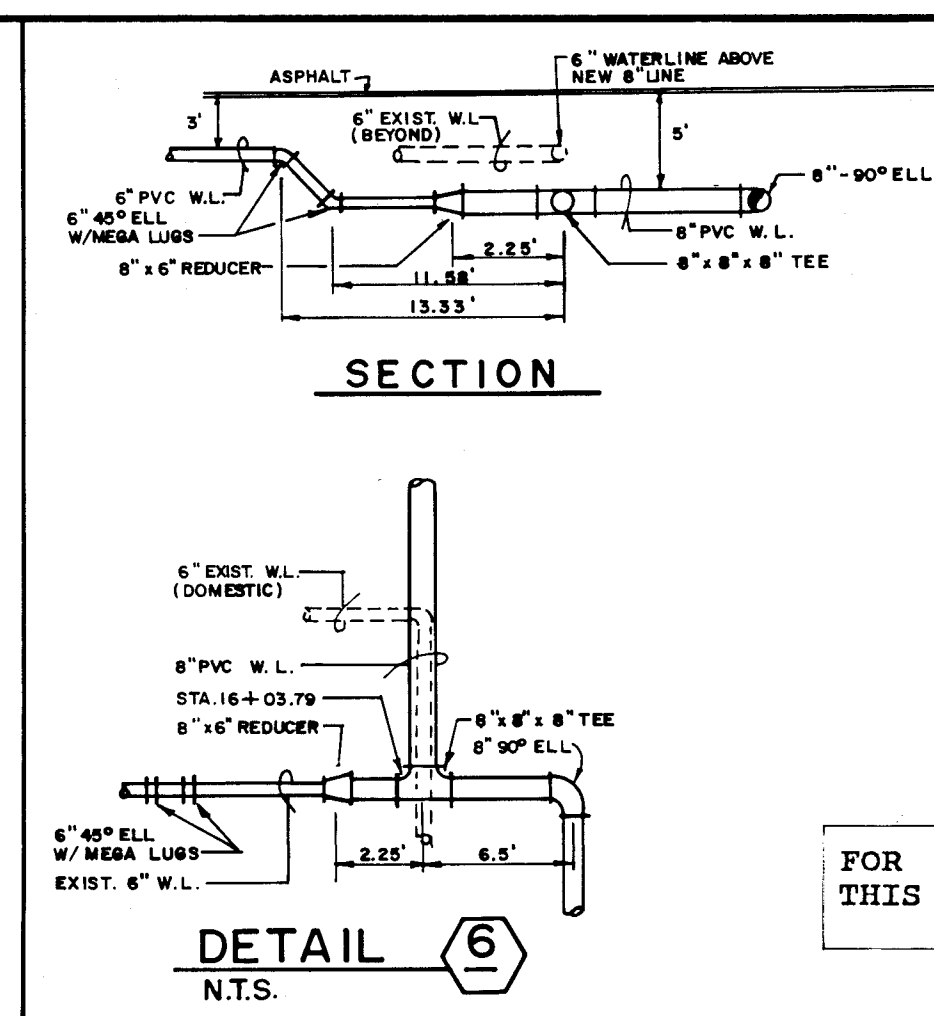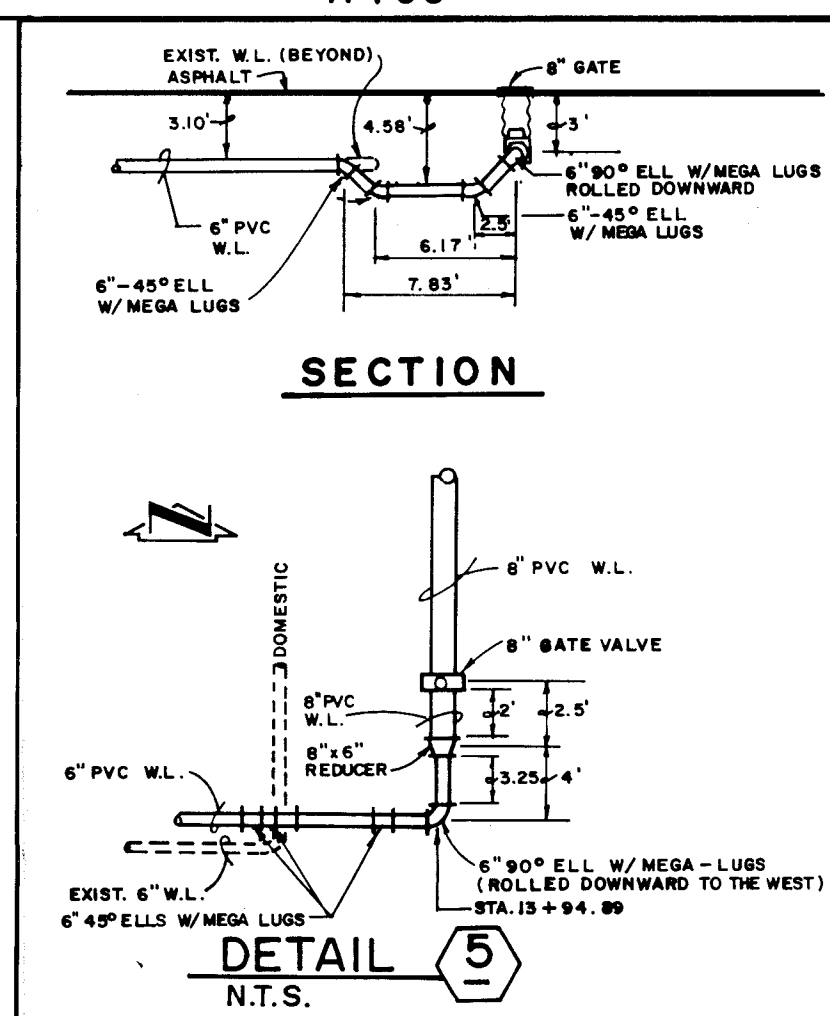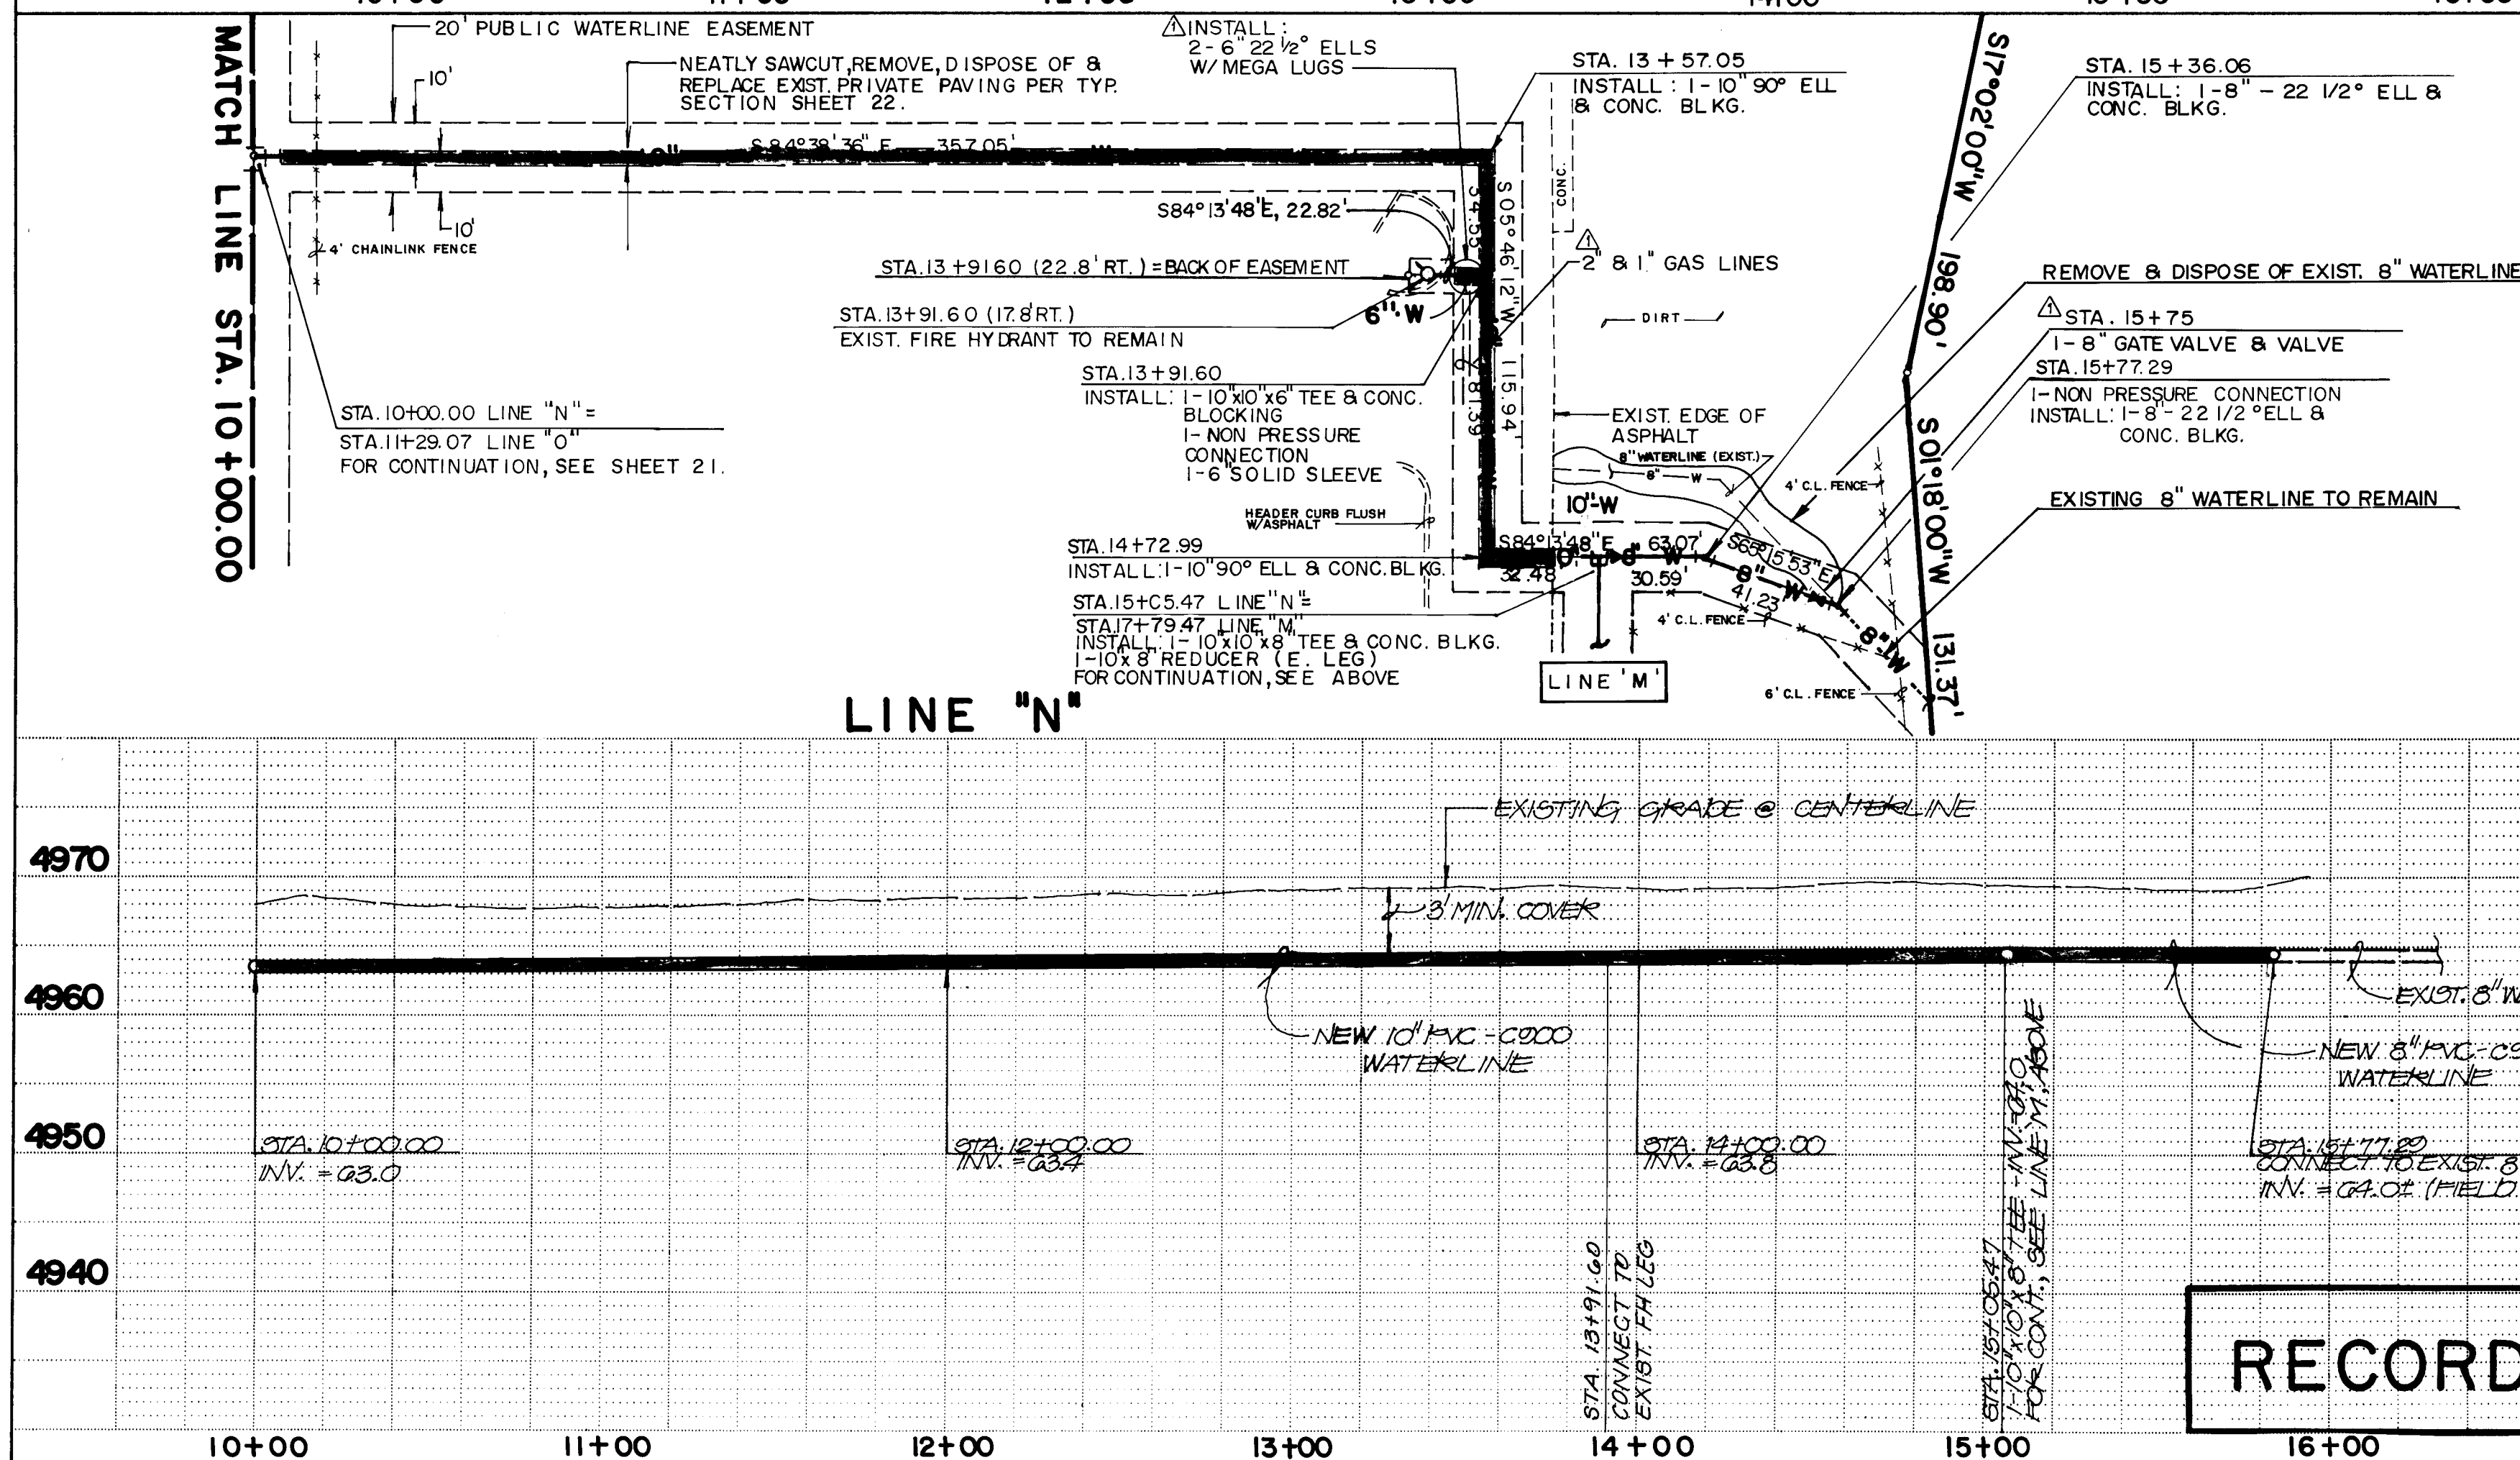

FOR CONSTRUCTION NOTES AFFECTING THIS SITE, REFER TO SHEET 22.

HORIZONTAL SCALE: 1"=40'
VERTICAL SCALE: 1"=10'

RECORD DRAWING

RECORD DRAWING
I, Jeffrey G. Mortensen, Registered Professional Engineer in the State of New Mexico, do hereby certify that this "as-built" information was obtained by me or under my supervision and represents the "as-built" conditions of this project, and is true and correct to the best of my knowledge and belief. All vertical and horizontal dimensions should be field verified prior to use on future projects.
Jeffrey G. Mortensen
N.M.E. No. 8547
Date: 7-16-90



APPROVED FOR CONSTRUCTION
CITY ENGINEER DATE

CITY OF ALBUQUERQUE PUBLIC WORKS DEPARTMENT ENGINEERING DIVISION				
TITLE: VALLEY HIGH SCHOOL WATERLINE EXTENSION PLAN & PROFILE LINE "M" & LINE "N"				
APPROVALS	ENGINEER	DATE	APPROVALS	ENGINEER
DRG Chairman	7-8-90	Water	R.W. Kane	7-16-90
Transportation	7-17-90	Waste Water	R.W. Kane	7-16-90
Hydrology	U/A			
PROJECT NO.	4111.90	MAP NO.	6.13	SHEET 20 OF 25


ENGINEER'S SEAL		SURVEY INFORMATION		BENCH MARKS		AS BUILT INFORMATION	
		FIELD NOTES		A.C.S. STATION 5+03.84, A STANDARD BRASS TABLET SET FLUSH WITH THE GROUND. STATION IS LOCATED WITHIN THE NORTHERN ROOM OF CANGELANGA #2 N.W., APPROX. 64' EAST OF THE ENTRANCE LANE TO VALLEY HIGH SCHOOL, ON THE NORTH SIDE OF THE SIDEWALK. ELEVATION = 4937.94 FEET (M.S.L.D.)		CONTRACTOR JOHNS INDUSTRIES	
		NO.	BY	DATE	WORK STARTED BY: J.M.A.	DATE 08/90	
					ACCEPTED BY: J.M.A.	DATE 10/90	
					VERIFICATION BY: J.M.A.	DATE 10/90	
DESIGNED BY J.G.M. 5/1/90						MICRO-FILM INFORMATION	
DRAWN BY J.M.C.						RECORDED BY	
DATE 6-90						DATE	
CHECKED BY J.G.M.						NO	
DATE 6-90							




RECORD DRAWING

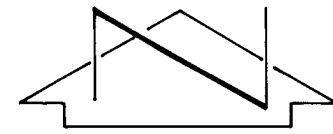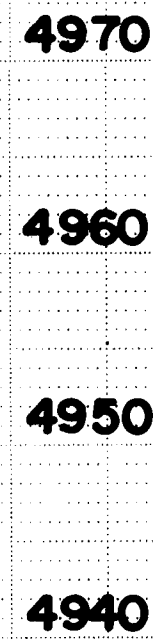

RECORD DRAWING

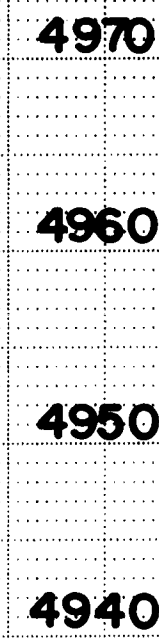

HORIZONTAL SCALE: 1" = 40'
VERTICAL SCALE: 1" = 10'

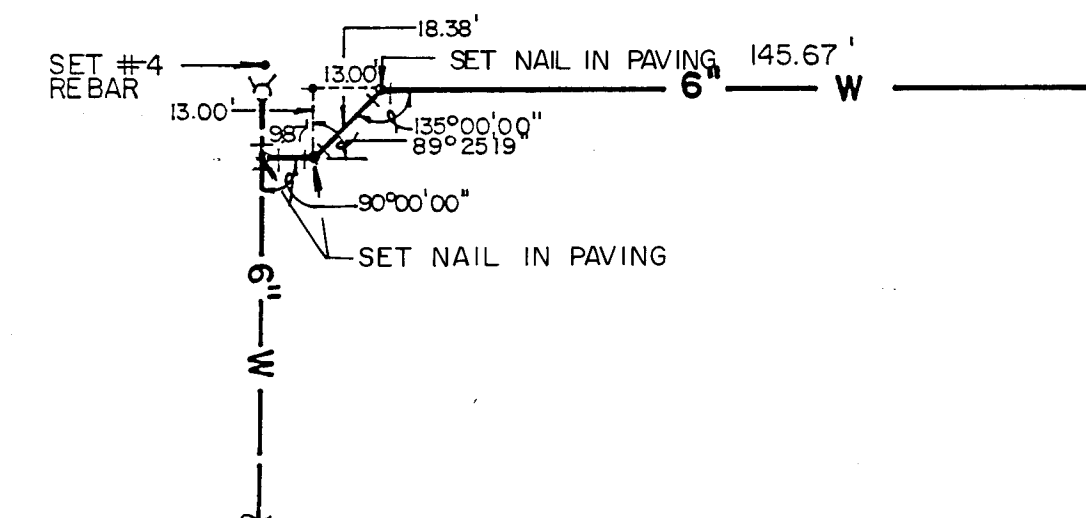

FOR CONSTRUCTION NOTES AFFECTING
THIS SITE, REFER TO SHEET 22.

HORIZONTAL SCALE: 1" = 40'
VERTICAL SCALE: 1" = 10'

PRIVATE CONSTRUCTION - NOT PART OF CITY WORK ORDER


**APPROVED FOR
CONSTRUCTION**

871829

CITY ENGINEER

DATE _____
 NED BY _____
 AS ON _____

CITY OF ALBUQUERQUE PUBLIC WORKS DEPARTMENT ENGINEERING DIVISION					
TITLE: VALLEY HIGH SCHOOL WATERLINE EXTENSION PLAN & PROFILE LINE "O" & LINE "P"					
APPROVALS	ENGINEER	DATE	APPROVALS	ENGINEER	DATE
DRC Chairman	<i>[Signature]</i>	7-18-20	Water	<i>R.W. Kane</i>	7-16-20
Transportation	<i>[Signature]</i>	7-17-20	Waste Water	<i>R.W. Kane</i>	7-16-20
Hydrology	<i>N/A</i>				
PROJECT NO. 4 111.90		MAP NO. G. 13		SHEET OF 21 25	

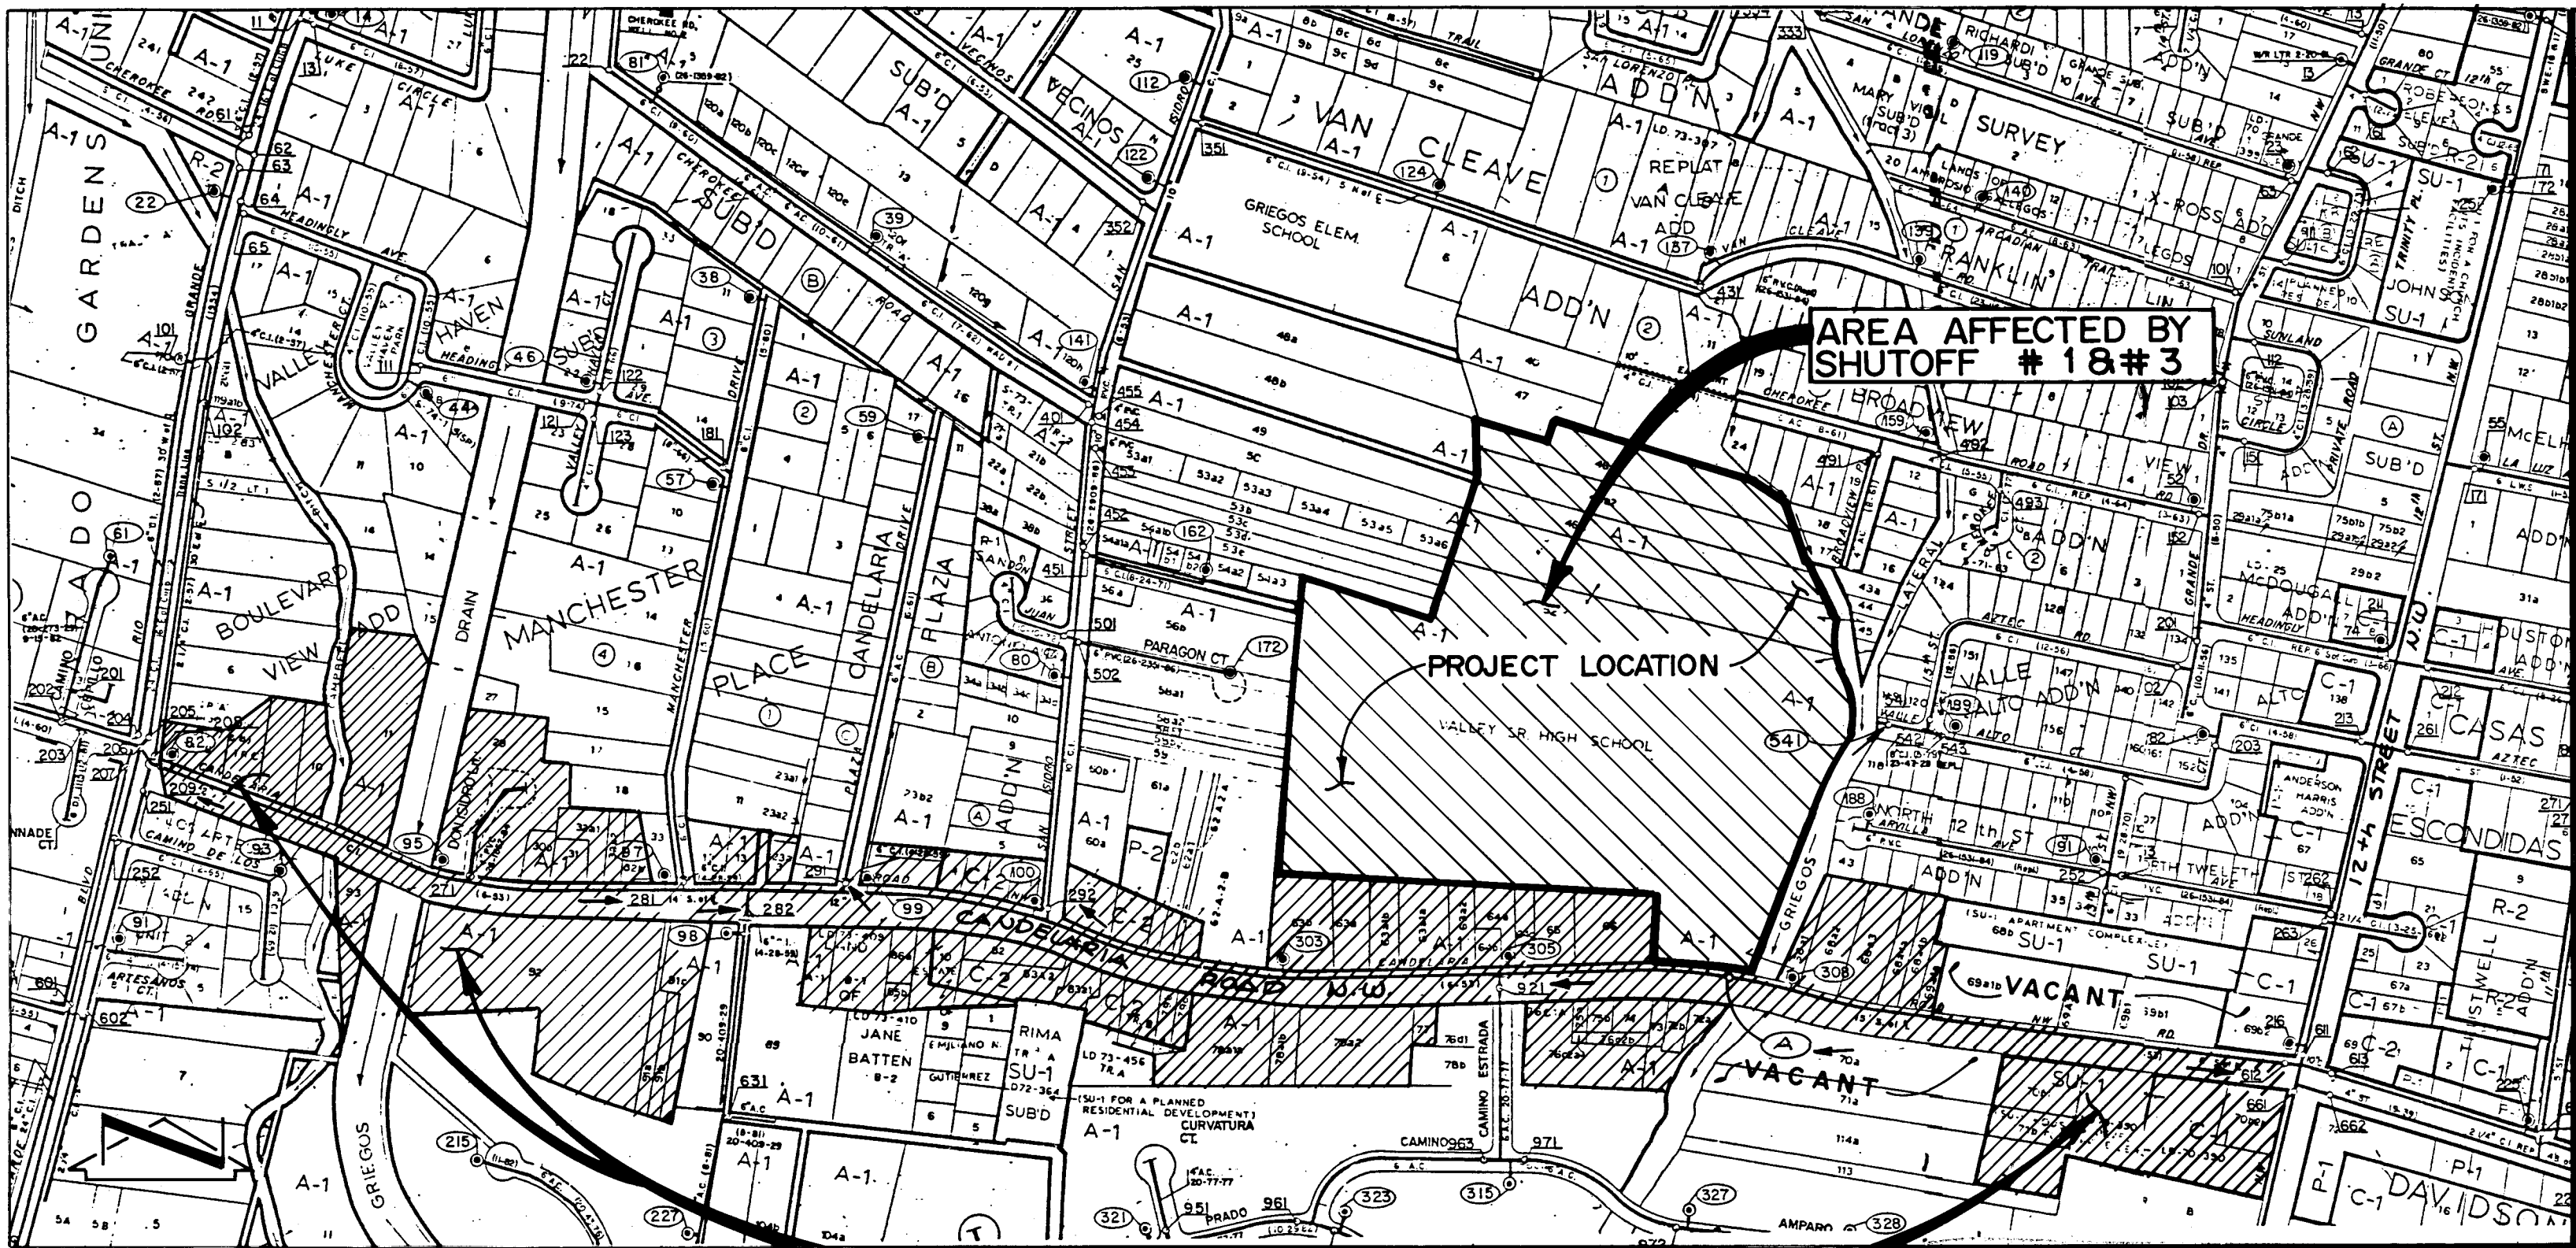


VALLEY HIGH SCHOOL WATER VALVE SHUTOFF PLAN

SCALE : 1" = 400' (APPROX.)

VALLEY HIGH SCHOOL WATER VALVE SHUTOFF PLAN NOTES:

- AS A MINIMUM, THE FOLLOWING VALVES SHALL BE CLOSED TO EFFECT THE RESPECTIVE SHUTOFFS:
 - SHUTOFF #1 (CONNECTION IN VALLE ALTO N.W.); VALVE 541.
 - SHUTOFF #2 (CONNECTION IN CANDELARIA ROAD N.W.); VALVES 209, 281, 282, 291, 292, 921, AND 612.
 - SHUTOFF #3 (CONNECTION ONSITE TO LINE "M"); VALVE "A" WHICH IS LOCATED ON EXISTING 6" WATERLINE PRESENTLY SERVING THE SITE AS A PRIVATE UNMETERED FIRE PROTECTION LINE.
- THE CONTRACTOR SHALL NOTIFY WATER SYSTEMS, THREE (3) WORKING DAYS IN ADVANCE OF ANY WORK THAT MAY AFFECT EXISTING WATERLINE; ALL SHUTOFFS SHALL BE PERFORMED BY THE WATER SYSTEM DIVISION PERSONNEL.
- THE CONTRACTOR SHALL PROVIDE ALL RESTRAINTS AND THRUST BLOCKS NECESSARY TO EFFECT THE NECESSARY SHUTOFFS AND CONNECTIONS.
- EXISTING WATER VALVE AND WATERLINE INFORMATION OBTAINED FROM CITY OF ALBUQUERQUE WATER SECTIONAL MAPS G-13N AND G-14N.
- SHUTOFF #2 WILL ONLY BE REQUIRED IF THE EXISTING 6" GATE VALVE IN CANDELARIA ON LINE "M" DOES NOT PERFORM UNDER HYDROSTATIC TEST AND THEREFORE MUST BE REPLACED.

RECORD DRAWING

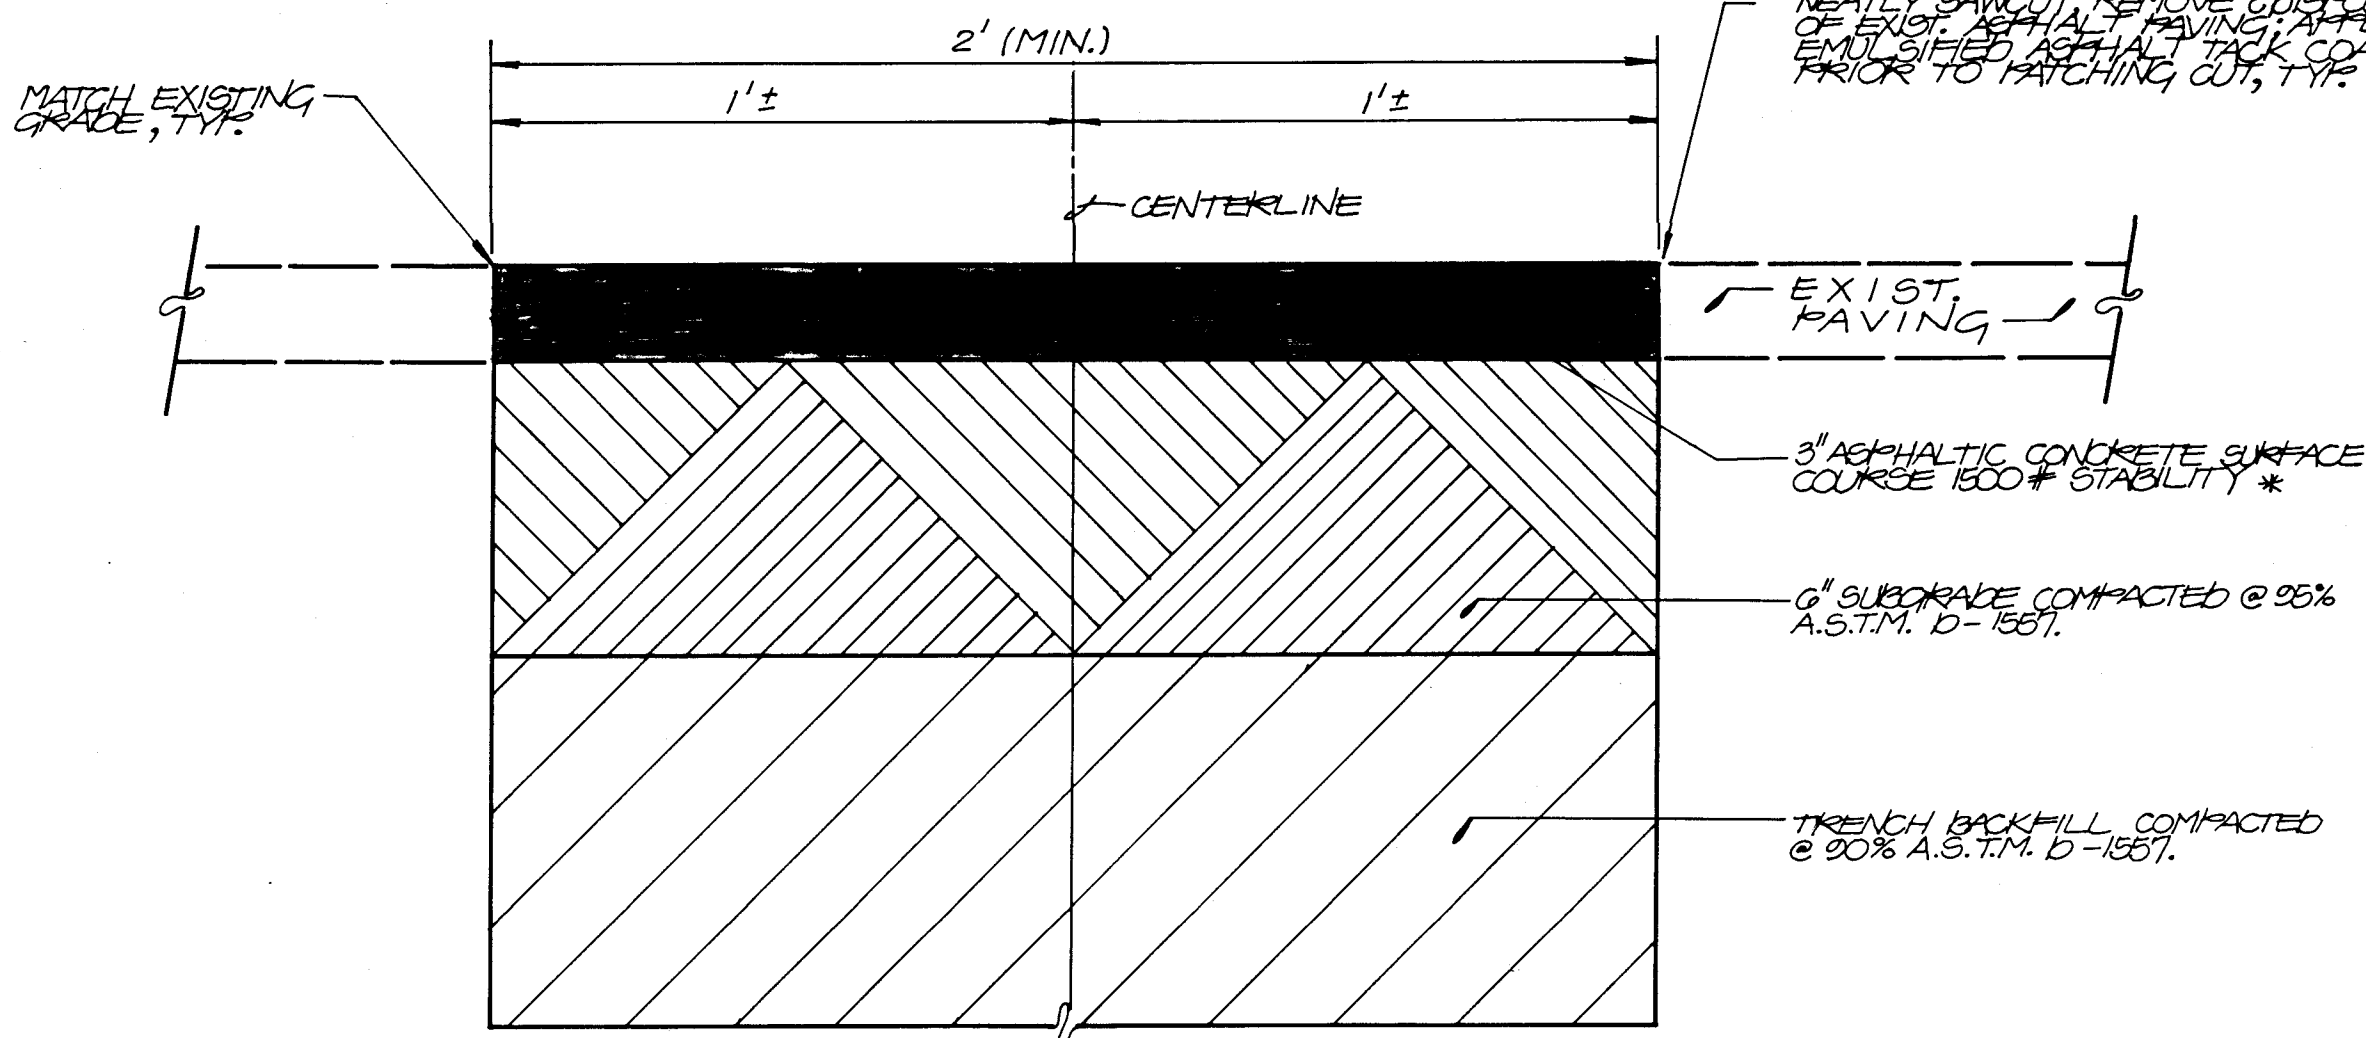

* SUBSTITUTE 2" THICKNESS IN NON-TRAFFIC AREAS.

TYPICAL PRIVATE PAVING UTILITY CUT & PAVEMENT REPLACEMENT SECTION

SCALE: 1" = 4"

NOTES:

- TWO (2) WORKING DAYS PRIOR TO ANY EXCAVATION, CONTRACTOR MUST CONTACT NEW MEXICO ONE CALL SYSTEM 248-1990, FOR LOCATION OF EXISTING UTILITIES.
- IF ANY UTILITY LINES, PIPELINES, OR UNDERGROUND UTILITY LINES ARE SHOWN IN THESE DRAWINGS, THEY ARE SHOWN IN AN APPROXIMATE MANNER ONLY, AND SUCH LINES MAY EXIST WHERE NONE ARE SHOWN. IF ANY SUCH EXISTING LINES ARE SHOWN, THE LOCATION IS BASED UPON INFORMATION PROVIDED BY THE OWNER OF SAID UTILITY, AND THE INFORMATION MAY BE INCOMPLETE, OR MAY BE OBSOLETE BY THE TIME CONSTRUCTION COMMENCES. THE ENGINEER HAS CONDUCTED ONLY PRELIMINARY INVESTIGATION OF THE LOCATION, DEPTH, SIZE, OR TYPE OF EXISTING UTILITY LINES, PIPELINES, OR UNDERGROUND UTILITY LINES. THIS INVESTIGATION IS NOT CONCLUSIVE, AND MAY NOT BE COMPLETE, THEREFORE, MAKES NO REPRESENTATION PERTAINING THERETO, AND ASSUMES NO RESPONSIBILITY OR LIABILITY THEREFOR. THE CONTRACTOR SHALL INFORM ITSELF OF THE LOCATION OF ANY UTILITY LINE, PIPELINE, OR UNDERGROUND UTILITY LINE IN OR NEAR THE AREA OF THE WORK IN ADVANCE OF AND DURING EXCAVATION WORK. THE CONTRACTOR IS FULLY RESPONSIBLE FOR ANY AND ALL DAMAGE CAUSED BY ITS FAILURE TO LOCATE, IDENTIFY AND PRESERVE ANY AND ALL EXISTING UTILITIES, PIPELINES, AND UNDERGROUND UTILITY LINES. IN PLANNING AND CONDUCTING EXCAVATION, THE CONTRACTOR SHALL COMPLY WITH STATE STATUTES, MUNICIPAL AND LOCAL ORDINANCES, RULES AND REGULATIONS, IF ANY, PERTAINING TO THE LOCATION OF THESE LINES AND FACILITIES.
- SHOULD A CONFLICT EXIST BETWEEN THESE PLANS AND ACTUAL FIELD CONDITIONS, THE CONTRACTOR SHALL PROMPTLY NOTIFY THE ENGINEER IN WRITING SO THAT THE CONFLICT CAN BE RESOLVED WITH A MINIMUM AMOUNT OF DELAY FOR ALL PARTIES.
- THE CONTRACTOR SHALL MAINTAIN ACCESS TO ALL BUILDINGS AND ADJACENT PROPERTIES DURING CONSTRUCTION.
- THE CONTRACTOR SHALL ENSURE THAT NO SOIL ERODES FROM THE SITE INTO PUBLIC RIGHT-OF-WAY OR ONTO PRIVATE PROPERTY. THIS CAN BE ACHIEVED BY CONSTRUCTING AND MAINTAINING TEMPORARY BERMS AT THE PROPERTY LINES AND WEETING THE SOIL TO KEEP IT FROM BLOWING.
- THE CONTRACTOR SHALL PROMPTLY CLEAN UP ANY MATERIAL EXCAVATED WITHIN THE PUBLIC RIGHT-OF-WAY SO THAT THE EXCAVATED MATERIAL IS NOT SUSCEPTIBLE TO BEING WASHED DOWN THE STREET.
- IF THE REMOVAL OF EXISTING CURB AND GUTTER, SIDEWALK, AND/OR PAVING IS REQUIRED, THE CONTRACTOR SHALL SAWCUT AND/OR REMOVE TO THE NEAREST JOINT. WHEN ABUTTING NEW PAVEMENT TO EXISTING, THE CONTRACTOR SHALL CUT EACH THE EXISTING PAVING TO A STRAIGHT LINE IN ORDER TO REMOVE ANY BROKEN OR CRACKED PAVEMENT. CURB AND GUTTER AND/OR PAVEMENT SHALL BE AS EXISTING AND NOT TO BE REMOVED UNDER THIS CONTRACT AND WHICH IS DAMAGED OR DISPLACED BY THE CONTRACTOR SHALL BE REMOVED AND REPLACED BY THE CONTRACTOR AT THE CONTRACTOR'S EXPENSE.
- THE CONTRACTOR SHALL BE RESPONSIBLE FOR SAFELY OBTAINING THE REQUIRED COMPACTION. THE CONTRACTOR SHALL SELECT AND USE METHODS WHICH SHALL NOT BE INJURIOUS OR DAMAGING TO THE EXISTING FACILITIES AND STRUCTURES WHICH SURROUND THE WORK AREAS.
- THE CONTRACTOR SHALL CONFINE HIS WORK WITHIN THE CONSTRUCTION LIMITS IN ORDER TO PRESERVE THE EXISTING IMPROVEMENTS AND SO AS NOT TO INTERFERE WITH THE OPERATIONS OF THE EXISTING FACILITIES.
- WHERE THE NEW WATERLINE CROSSES UNDER EXISTING FENCES THE CONTRACTOR SHALL TUNNEL UNDER THE FENCE IN ORDER TO TRENCH AND INSTALL THE NEW WATERLINE. THE CONTRACTOR SHALL BE SOLELY RESPONSIBLE FOR ANY DAMAGE TO THE FENCE DURING THE CONSTRUCTION PERIOD AND SHALL REPAIR AND/OR REPLACE THE FENCE, IF NECESSARY, AT HIS EXPENSE AND AT NO ADDITIONAL COST TO THE OWNER. ALL REPAIRS OR REPLACEMENT OF EXISTING FENCING SHALL BE EQUAL TO OR BETTER THAN THE EXISTING CONDITION OF THE FENCE.
- ANY EXISTING TREES FOUND TO BE IN CONFLICT WITH THE PROPOSED CONSTRUCTION SHALL BE REMOVED AND DISPOSED OF BY THE CONTRACTOR. THIS SHALL BE CONSIDERED INCIDENTAL TO CONSTRUCTION, THEREFORE, NO SEPARATE PAYMENT WILL BE MADE.
- SEVENTY-TWO (72) HOURS PRIOR TO THE COMMENCEMENT OF CONSTRUCTION ON EACH OF THE SITES, THE CONTRACTOR SHALL NOTIFY THE OWNER OF HIS INTENT TO BEGIN CONSTRUCTION. CONTACT MR. BOB ROBIE, FACILITIES, PLANNING AND CONSTRUCTION, 242-5865.
- WHERE EXISTING FIRE HYDRANTS ARE TO BE REMOVED AND RELOCATED, THE CONTRACTOR SHALL COORDINATE THIS WORK WITH THE OWNER SO THAT SCHOOL OPERATIONS ARE NOT ADVERSELY IMPACTED AND THE NECESSARY PRIVATE WATERLINE SHUTOFFS CAN BE ACCOMPLISHED. CONTACT MR. KEITH RUTHERFORD, MAINTENANCE AND OPERATIONS, 765-5950.
- THE CONTRACTOR SHALL BE RESPONSIBLE FOR THE COMPLETE REPAIR OF ANY EXISTING FACILITIES, STRUCTURES, OR UTILITIES DAMAGED BY CONSTRUCTION. REPAIRS SHALL BE MADE AT THE SOLE EXPENSE OF THE CONTRACTOR AND AT NO ADDITIONAL COST TO THE OWNER.
- WHERE WATER AND SANITARY SEWER LINES CROSS THE SANITARY SEWER LINE SHALL BE CONCRETE ENCASED FOR A DISTANCE OF 10 FEET EACH SIDE OF THE CROSSING IF 18 INCHES OF VERTICAL SEPARATION DOES NOT EXIST.
- ELECTRONIC MARKER DISKS (EMD'S) SHALL BE PLACED ABOVE ALL FITTINGS IN ACCORDANCE WITH SECTION 170 OF THE "STANDARD SPECIFICATIONS".
- IN ACCORDANCE WITH SECTION 801 OF THE "STANDARD SPECIFICATIONS", METALLIZED DETECTABLE WARNING TAPE SHALL BE INSTALLED 18 INCHES ABOVE ALL PVC PIPE INSTALLED ON THIS PROJECT.
- VALVE STEM EXTENSIONS SHALL BE PROVIDED IN ACCORDANCE WITH THE STANDARD SPECIFICATIONS. THE COST OF THE VALVE STEM EXTENSIONS SHALL BE CONSIDERED INCIDENTAL TO CONSTRUCTION THEREFORE NO SEPARATE PAYMENT WILL BE MADE.

RECORD DRAWING

I, Jeffrey G. Mortensen, Registered Professional Engineer in the State of New Mexico, do hereby certify that this "as-built" information was obtained by me or under my supervision and represents the "as-built" conditions of this project, and is true and correct to the best of my knowledge and belief. All vertical and horizontal dimensions should be field verified prior to use on future projects.

Jeffrey G. Mortensen
N.M.P.E. No. 8547
Date 7-16-90

CITY OF ALBUQUERQUE
PUBLIC WORKS DEPARTMENT
ENGINEERING GROUP


TITLE: VALLEY HIGH SCHOOL
WATER VALVE SHUTOFF PLAN, SECTIONS & DETAILS

APPROVALS	ENGINEER	DATE	APPROVALS	ENGINEER	DATE
D.R.C. CHAIRMAN	Rogers	7-18-90	WATER	R.W. Kame	7-16-90
TRANSPORTATION	Boyd	7-17-90	WASTE WATER	R.W. Kame	7-16-90
HYDROLOGY	H/A				


PROJECT NO.	4111.90	MAP NO.	G-13	SHEET	22	OF	25
-------------	---------	---------	------	-------	----	----	----

SURVEY INFORMATION		FIELD NOTES		ENGINEER'S SEAL		BENCH MARKS		AS BUILT INFORMATION	
NO.	BY	DATE				AC.S. STATION 5-G13A - A STANDARD BENCH TABLE	CONTRACTOR JONES INDUSTRIES	STANDARD BY J.G.M.	DATE 08/90
						SET FLUSH WITH THE GROUND. STATION IS LOCATED WITHIN THE NORTHERN R.O.W. OF CANDELARIA RD. APPROX. 6.4' EAST OF THE ENTRANCE LANE TO VALLEY HIGH SCHOOL, ON THE NORTH SIDE OF THE SIDEWALK.		FIELD ACCEPTANCE BY M.A.S.	DATE 10/90
						ELEVATION = 4967.94 FEET (M.S.L.D.)		VERIFICATION BY M.A.S.	DATE 10/90
								CORRECTED BY J.G.M.	DATE 10/90
								RECORDED BY	DATE
								NO	



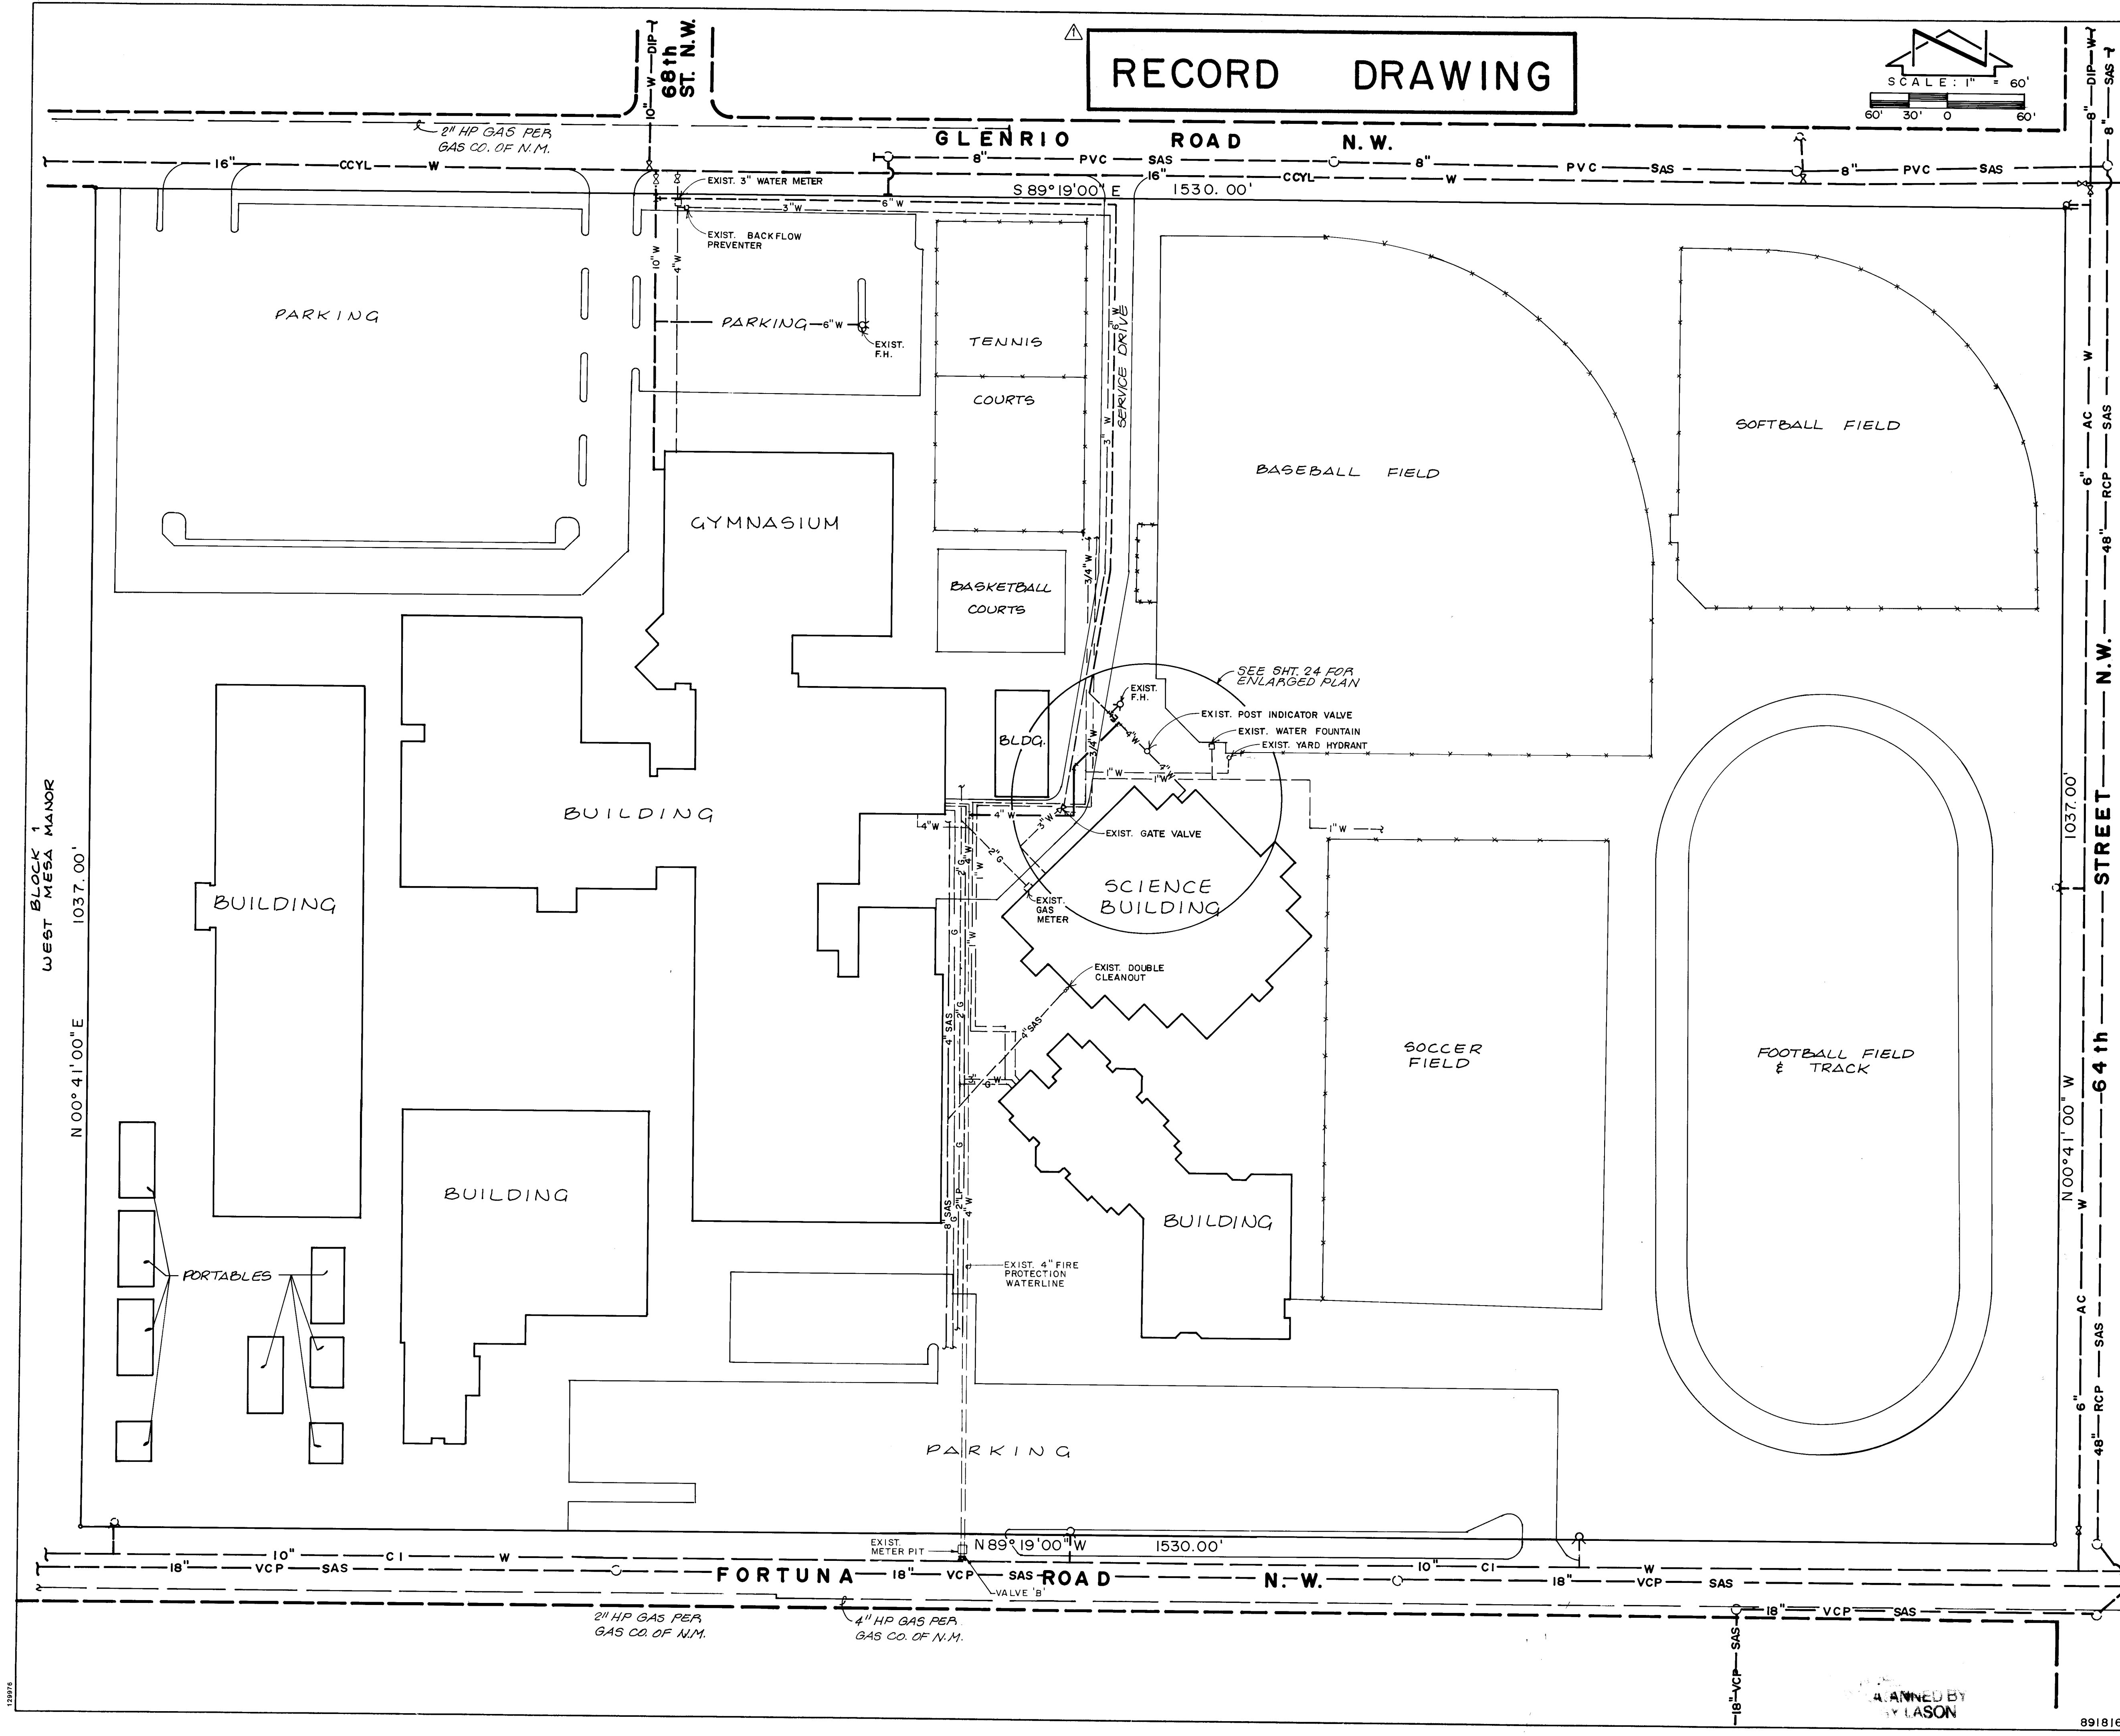

RECORD DRAWING

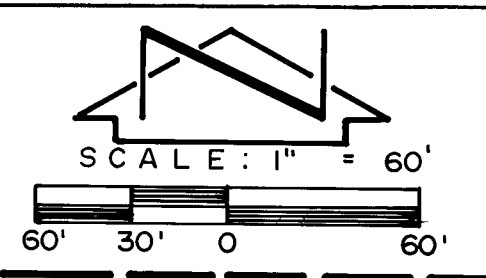

FOR CONSTRUCTION NOTES AFFECTING THIS SITE, REFER TO SHEET 25.

AS BUILT INFORMATION	
CONTRACTOR	JONES INDUSTRIES
WORKED BY	M.A.S.
INSPECTED BY	DATE 07/90
ACCEPTANCE BY	DATE 10/90
VERIFICATION BY	DATE 10/90
DRAWINGS BY	DATE 10/90
REVISIONS	DATE 10/90
MICRO-FILM INFORMATION	
RECORDED BY	DATE
NO	

BENCH MARKS	
A STANDARD ACS BRASS CAP SET PLUSH W/ SIDEWALK & STAMPED "18-JIT". STATION IS LOCATED IN THE NORTHEAST QUADRANT OF THE INTERSECTION OF COORS RD. N.W. & GLENRIO RD. N.W. STATION IS 490' EAST OF THE CENTERLINE OF COORS RD. N.W. & 54.0' NORTH OF THE CENTERLINE OF GLENRIO RD. N.W.	
ELEVATION: 5096.14 FEET (M.S.L.D.)	

SURVEY INFORMATION	
FIELD NOTES	
NO.	DATE
BY	

ENGINEER'S SEAL

1 2 3 4 5 6 7 8 9 10 11 12 13 14 15 16
26 14 17 1.902390

RECORD DRAWING

I, Jeffrey G. Mortensen, Registered Professional Engineer in the State of New Mexico, do hereby certify that this "as-built" information was obtained by me or under my supervision and represents the "as-built" conditions of this project, and is true and correct to the best of my knowledge and belief. All vertical and horizontal dimensions should be field verified prior to use on future projects.

JEFFREY G. MORTENSEN
NEW MEXICO
REGISTERED PROFESSIONAL ENGINEER
8547
DATE 1-14-90

26.26.90

REVISIONS	
NO.	DATE
DESIGNED BY	J.G.M.
DRAWN BY	S.G.H.
CHECKED BY	J.G.M.
DATE	3-90
DATE	3-90
DATE	3-90


PRIVATE CONSTRUCTION NOT PART OF WORK ORDER

CITY OF ALBUQUERQUE
PUBLIC WORKS DEPARTMENT
ENGINEERING GROUP

TITLE: WEST MESA HIGH SCHOOL SITE PLAN

APPROVALS	ENGINEER	DATE	APPROVALS	ENGINEER	DATE
D.R.C. CHAIRMAN	R. Kane	7-18-90	WATER	R. Kane	7-16-90
TRANSPORTATION	D.A.	7-17-90	WASTE WATER	R. Kane	7-16-90
HYDROLOGY					

PROJECT NO. 4111.90 MAP NO. J-10 SHEET 23 OF 25

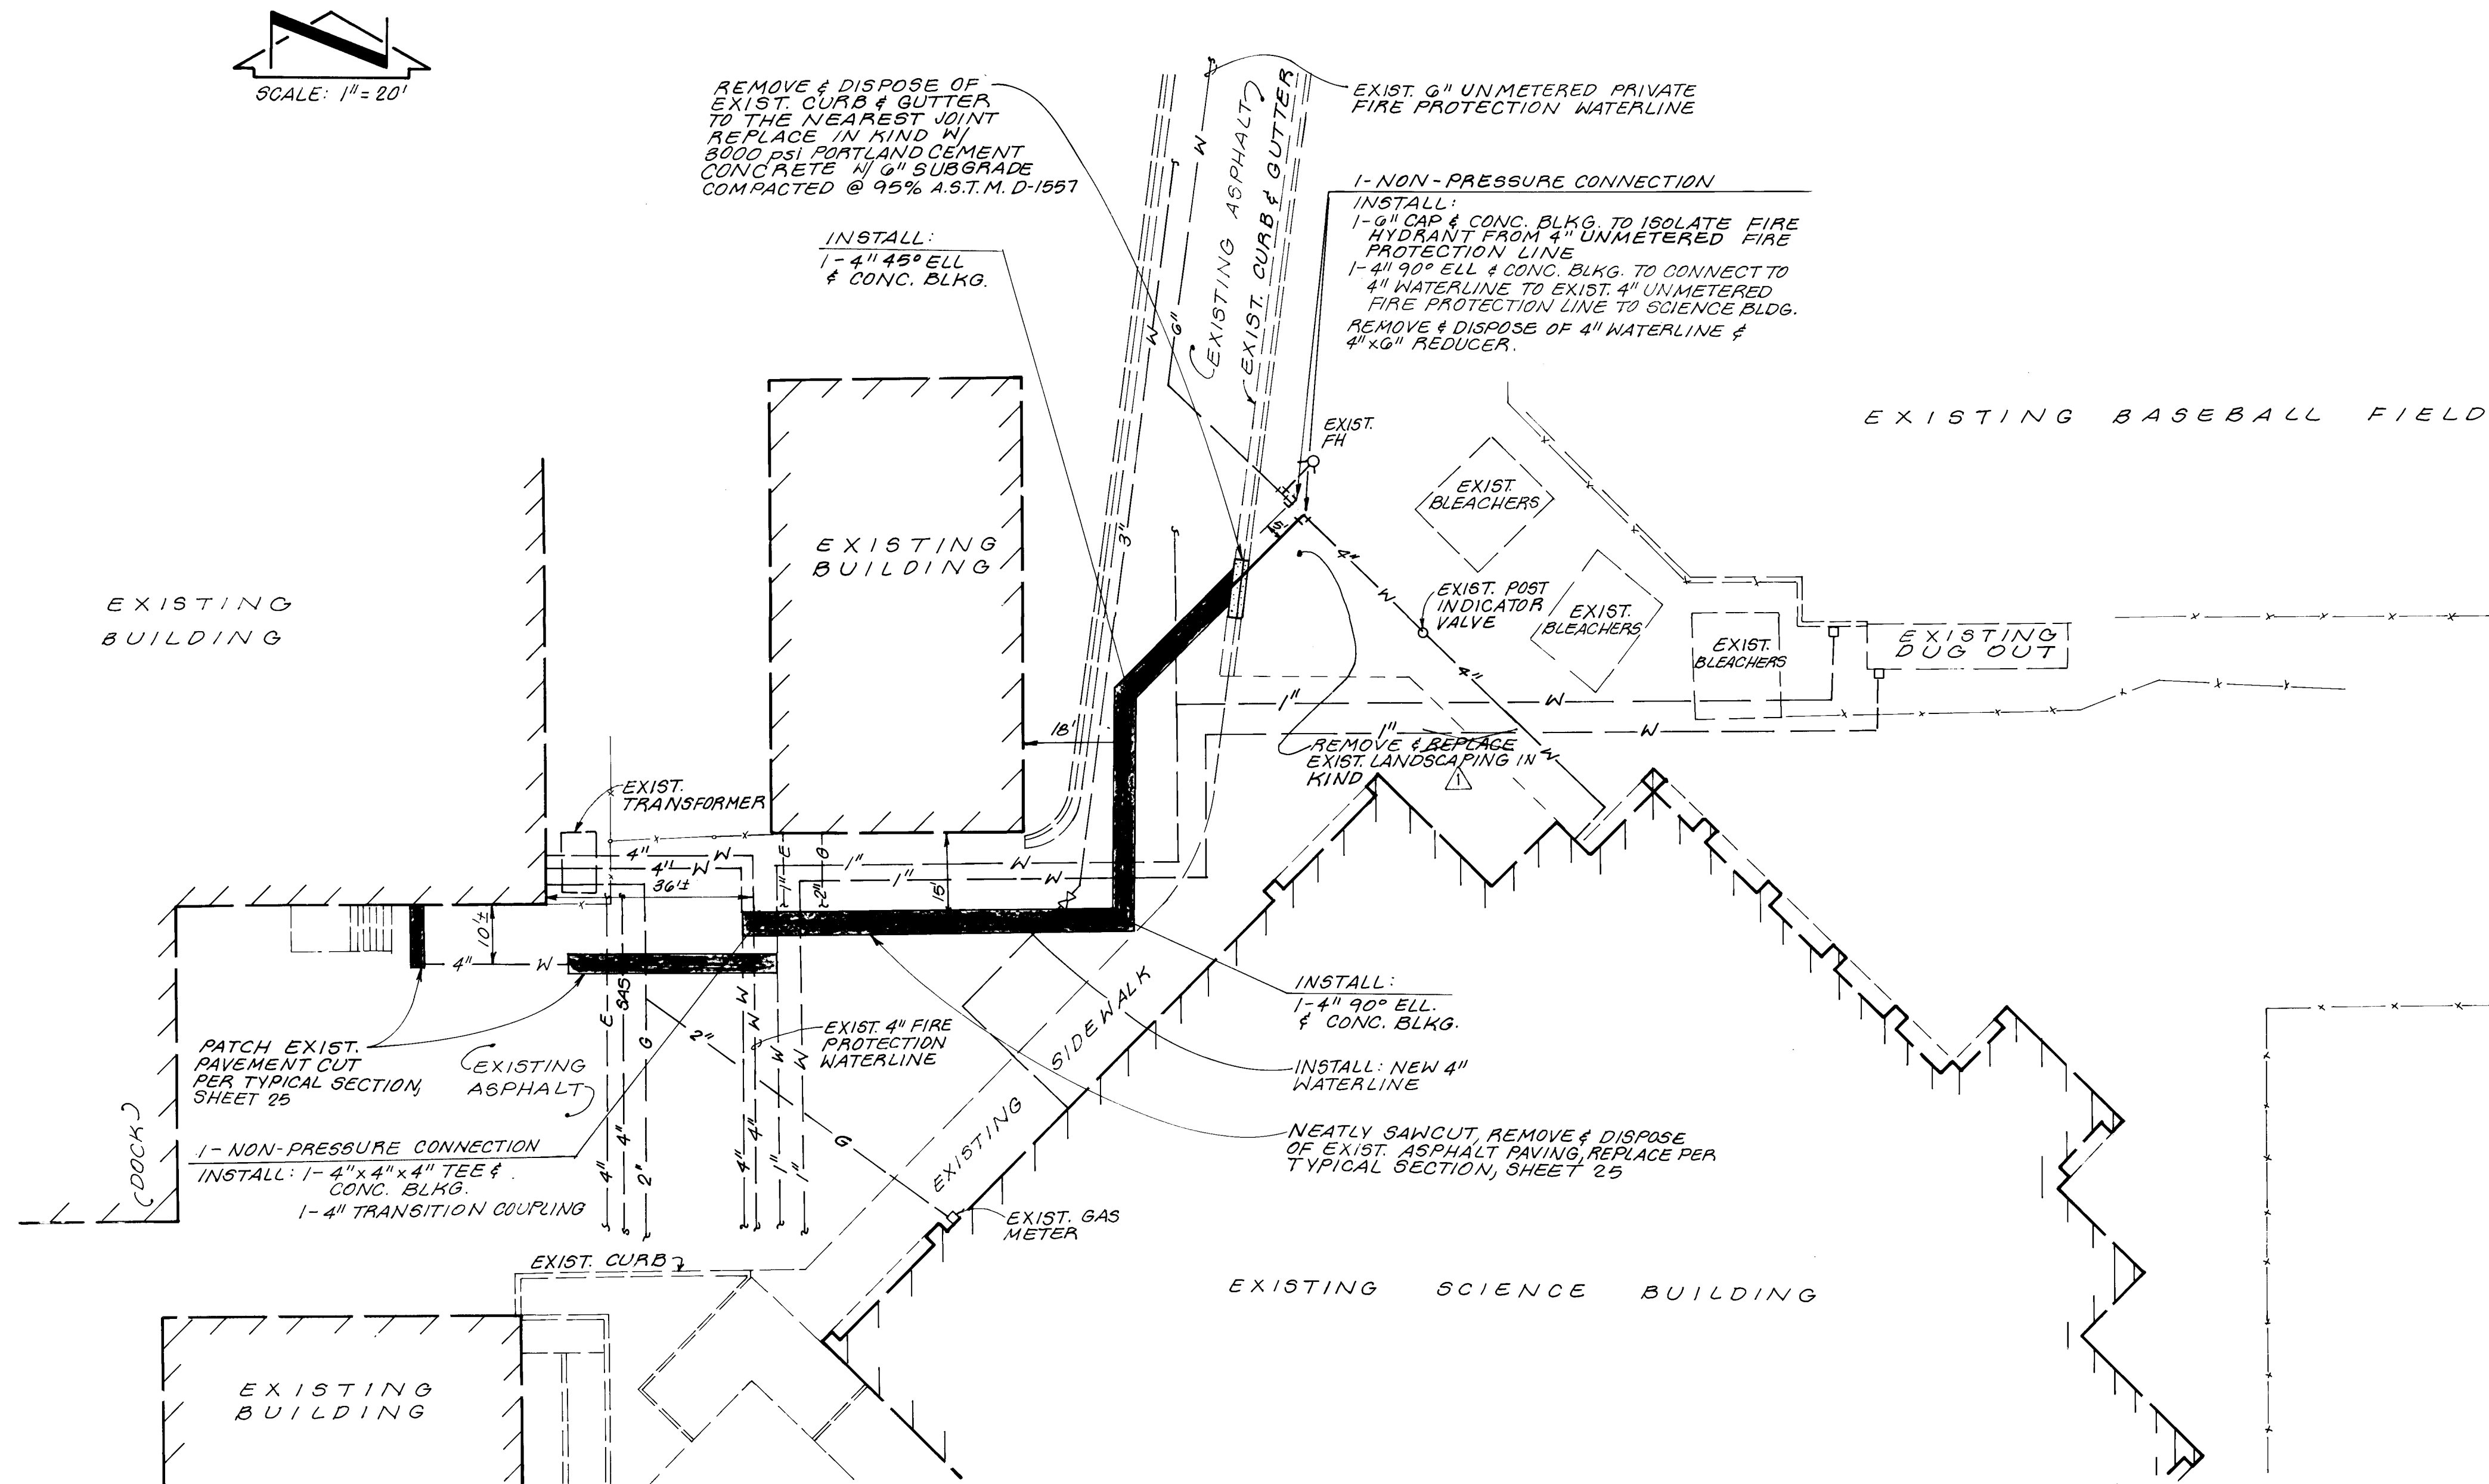

NOTES:

1. WATERLINES SHALL BE PVC C-900 PIPE OR AS APPROVED BY THE ALBUQUERQUE PUBLIC SCHOOLS.
2. WATERLINE SHALL HAVE A MINIMUM COVER OF 3'-0" (TOP OF ASPHALT PAVEMENT TO TOP OF PIPE).
3. ALL PIPE SHALL BE FURNISHED WITH CLASS "C" BEDDING UNLESS OTHERWISE NOTED. ALL TRENCH BACKFILL SHALL BE COMPACTED TO A MINIMUM OF 90% OF OPTIMUM, AS PER A.S.T.M. D-1557.

ENGINEER'S SEAL		SURVEY INFORMATION		BENCH MARKS		AS BUILT INFORMATION	
		FIELD NOTES					
		NO.	BY	DATE			
Δ	10/90		JMA		A STANDARD A.C.S. BRASS CAP SET FLUSH WITH SIDEWALK & DAMPTOWN ALBUQUERQUE AT THE INTER. SECTION OF CORRS RD NW & GLENVIEW RD. NW, LOCATED IN THE NE QUADRANT OF THE INTERSECTION, 490' EAST FROM CENTERLINE OF GLENVIEW ROAD. ELEVATION = 5099.74 FEET (M.S.L.D.)		
REVISIONS							
NO.	DATE	REMARKS					
DESIGNED BY LPU		DATE 6-90					
DRAWN BY MJT		DATE 6-90					
CHECKED BY JGM		DATE 6-90					

I, Jeffrey G. Mortensen, Registered Professional Engineer in the State of New Mexico, do hereby certify that this "as-built" information was obtained by me or under my supervision and represents the "as built" conditions of this project and is true and correct to the best of my knowledge and belief. All vertical and horizontal dimension should be field verified prior to use on future projects.

Jeffrey G. Mortensen
 NMPE No. 9547


Date _____

NEW MEXICO
 REGISTERED PROFESSIONAL ENGINEER
 9547

RECORD DRAWING

PRIVATE CONSTRUCTION-NOT PART OF CITY WORK ORDER

CITY OF ALBUQUERQUE PUBLIC WORKS DEPARTMENT ENGINEERING GROUP					
TITLE:		WEST MESA HIGH SCHOOL UNMETERED FIRE PROTECTION LINE MODIFICATIONS			
APPROVALS	ENGINEER	DATE	APPROVALS	ENGINEER	DATE
D.R.C. Chairman	<i>Roger A. Shaw</i>	7-18-90	Water	<i>R.W. Kame</i>	7-16-90
Transportation	<i>R. Kame</i>	7-17-90	Waste Water	<i>R.W. Kame</i>	7-16-90
Hydrology	<i>W. A.</i>				
PROJECT NO.		MAP NO.		SHEET OF	
4111.90		J-10		24 25	

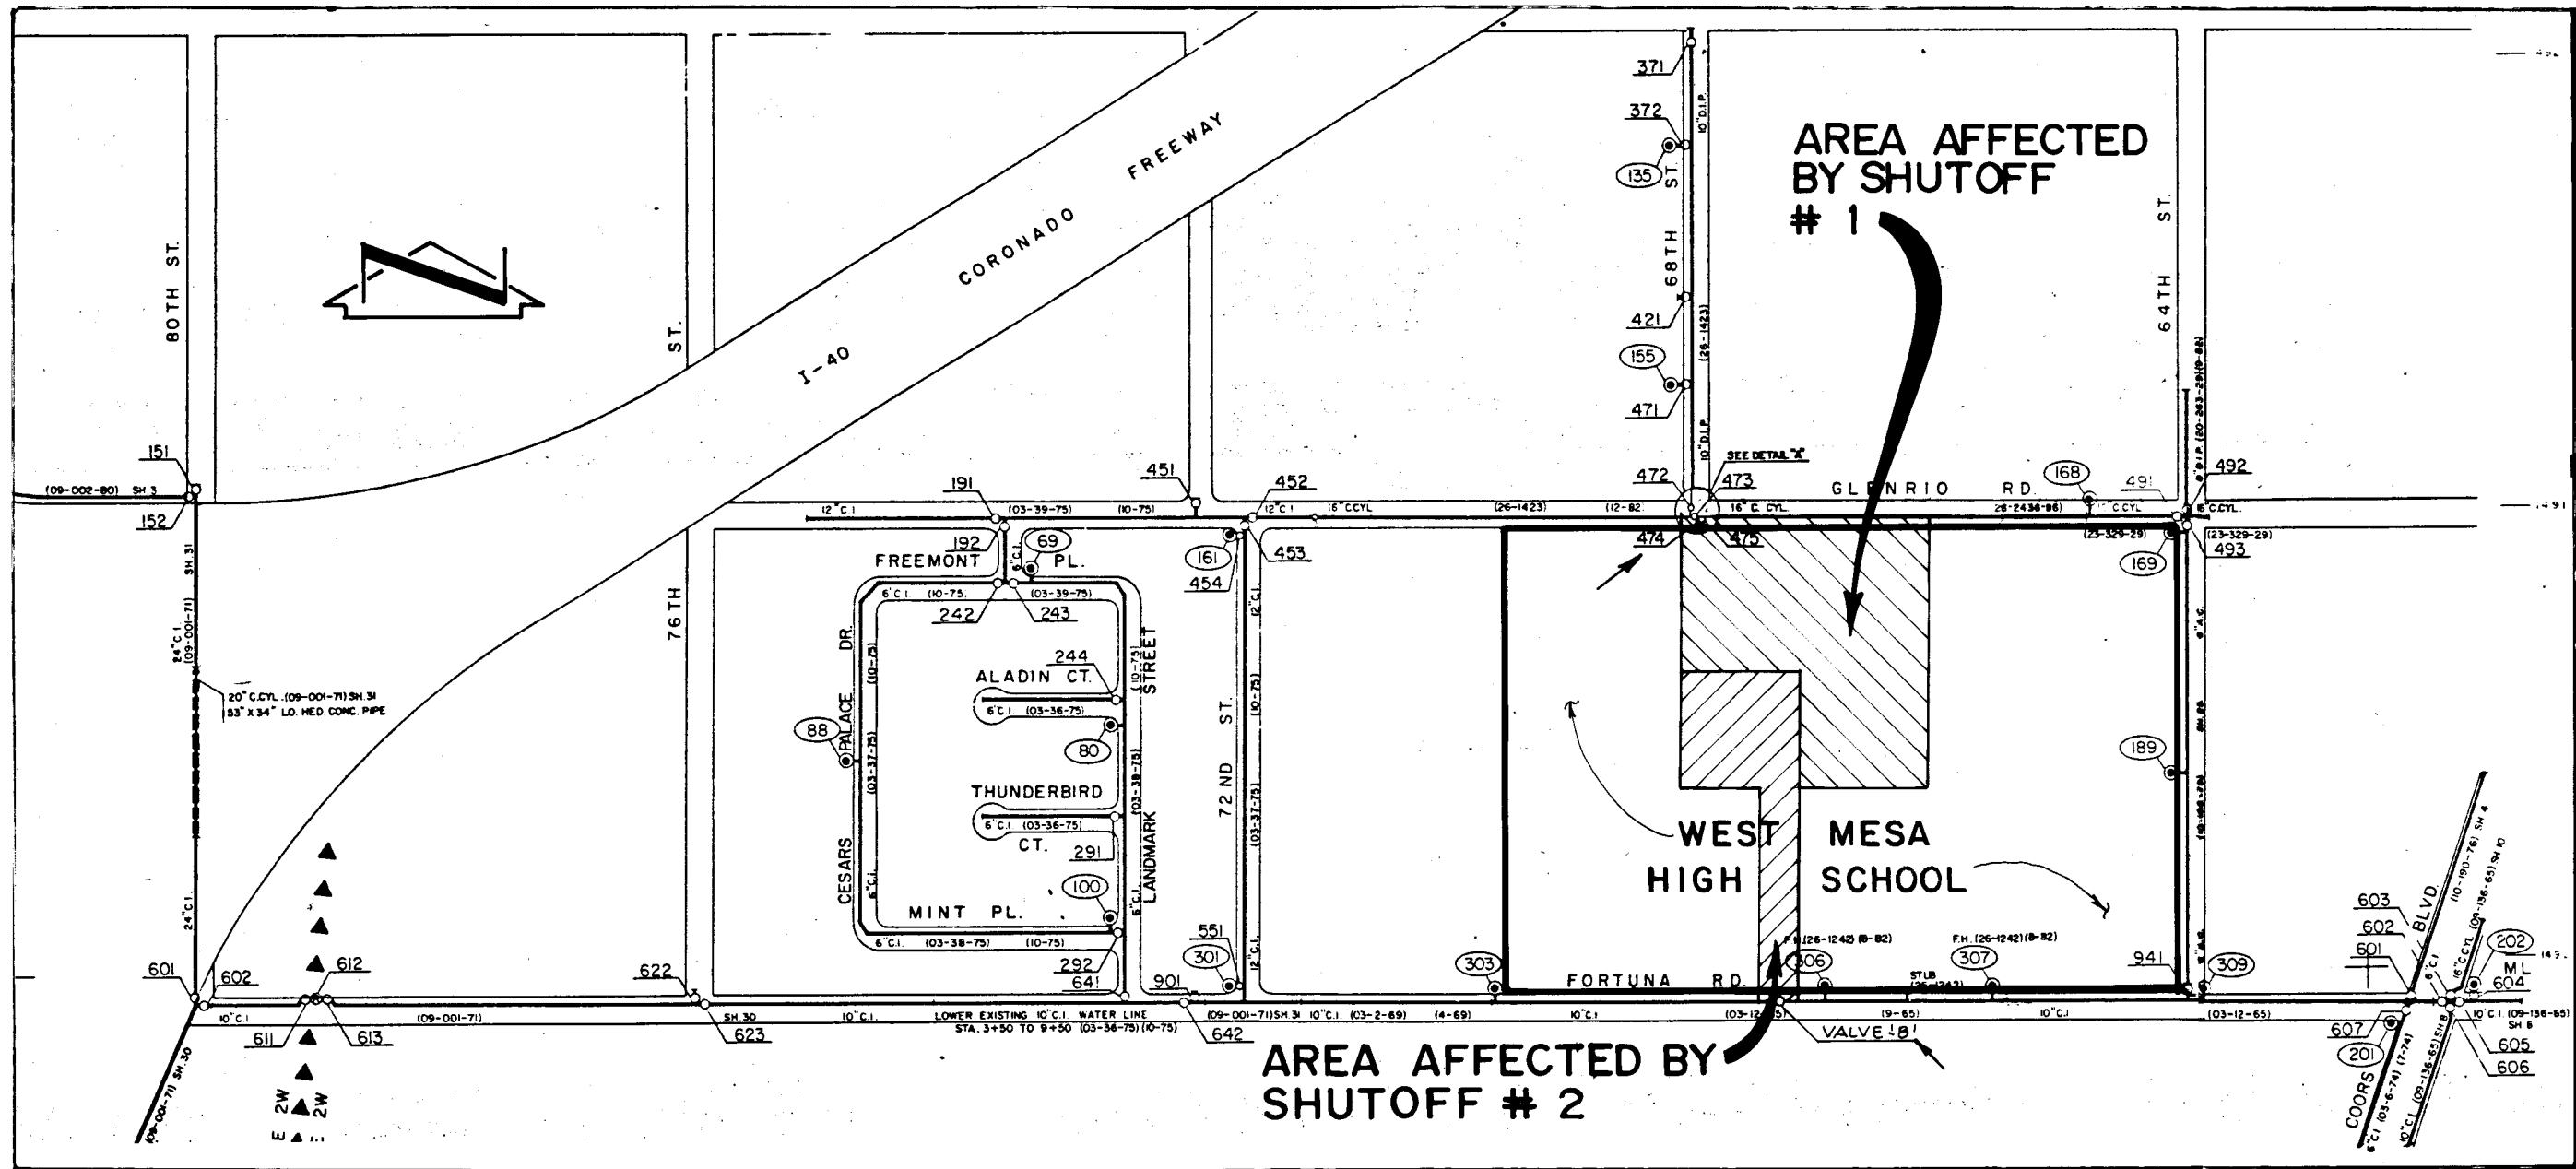

WEST MESA HIGH SCHOOL WATER VALVE SHUTOFF PLAN

SCALE: 1"=400' (APPROX.)


WEST MESA WATER VALVE SHUTOFF PLAN NOTES:

- IN THE EVENT OF A NON-PRESSURE CONNECTION, THE FOLLOWING VALVES AS A MINIMUM, SHALL BE CLOSED TO EFFECT THE RESPECTIVE SHUTOFFS:
 - SHUTOFF #1 (CONNECTION TO 6" WATERLINE); 474, (FIELD VERIFY).
 - SHUTOFF #2 (CONNECTION TO 4" WATERLINE); CLOSE VALVE "B" (FIELD VERIFY).
- THE CONTRACTOR SHALL NOTIFY WATER SYSTEM, THREE (3) WORKING DAYS IN ADVANCE OF ANY WORK THAT MAY AFFECT EXISTING WATERLINE; ALL SHUTOFFS SHALL BE PERFORMED BY THE WATER SYSTEM DIVISION PERSONNEL.
- THE CONTRACTOR SHALL NOTIFY ALBUQUERQUE PUBLIC SCHOOLS MAINTENANCE AND OPERATIONS (765-5950, EXT. 221), THREE (3) WORKING DAYS IN ADVANCE OF ANY WORK THAT MAY AFFECT THE EXISTING WATERLINES AND BUILDINGS.
- THE CONTRACTOR SHALL PROVIDE ALL RESTRAINTS AND THRUST BLOCKS NECESSARY TO EFFECT THE NECESSARY SHUTOFFS AND CONNECTIONS.
- EXISTING WATER VALVE AND WATERLINE INFORMATION OBTAINED FROM CITY OF ALBUQUERQUE WATER SECTIONAL MAPS AND ALBUQUERQUE PUBLIC SCHOOLS AS-BUILTS.

NOTES:

- TWO (2) WORKING DAYS PRIOR TO ANY EXCAVATION, CONTRACTOR MUST CONTACT NEW MEXICO ONE CALL SYSTEM 260-1990, FOR LOCATION OF EXISTING UTILITIES.
- IF ANY UTILITY LINES, PIPELINES, OR UNDERGROUND UTILITY LINES ARE SHOWN ON THESE DRAWINGS, THEY ARE SHOWN IN AN APPROXIMATE MANNER ONLY, AND SUCH LINES MAY EXIST WHERE NONE ARE SHOWN. IF ANY SUCH EXISTING LINES ARE SHOWN, THE LOCATION IS BASED UPON INFORMATION PROVIDED BY THE OWNER OF SAID UTILITY, AND THE INFORMATION MAY BE INCOMPLETE, OR MAY BE OBSOLETE BY THE TIME CONSTRUCTION COMMENCES. THE ENGINEER HAS CONDUCTED ONLY PRELIMINARY INVESTIGATION OF THE LOCATION, DEPTH, SIZE, OR TYPE OF EXISTING UTILITY LINES, PIPELINES, OR UNDERGROUND UTILITY LINES. THIS INVESTIGATION IS NOT CONCLUSIVE, AND MAY NOT BE COMPLETE, THEREFORE, MAKES NO REPRESENTATION PERTAINING THERETO, AND ASSUMES NO RESPONSIBILITY OR LIABILITY THEREFOR. THE CONTRACTOR SHALL INFORM ITSELF OF THE LOCATION OF ANY UTILITY LINE, PIPELINE, OR UNDERGROUND UTILITY LINE IN OR NEAR THE AREA OF THE WORK IN ADVANCE OF AND DURING EXCAVATION WORK. THE CONTRACTOR IS FULLY RESPONSIBLE FOR ANY AND ALL DAMAGE CAUSED BY ITS FAILURE TO LOCATE, IDENTIFY AND PRESERVE ANY AND ALL EXISTING UTILITIES, PIPELINES, AND UNDERGROUND UTILITY LINES. IN PLANNING AND CONDUCTING EXCAVATION, THE CONTRACTOR SHALL COMPLY WITH STATE STATUTES, MUNICIPAL AND LOCAL ORDINANCES, RULES AND REGULATIONS, IF ANY, PERTAINING TO THE LOCATION OF THESE LINES AND FACILITIES.
- SHOULD A CONFLICT EXIST BETWEEN THESE PLANS AND ACTUAL FIELD CONDITIONS, THE CONTRACTOR SHALL PROMPTLY NOTIFY THE ENGINEER IN WRITING SO THAT THE CONFLICT CAN BE RESOLVED WITH A MINIMUM AMOUNT OF DELAY FOR ALL PARTIES.
- THE CONTRACTOR SHALL MAINTAIN ACCESS TO ALL BUILDINGS AND ADJACENT PROPERTIES DURING CONSTRUCTION.
- THE CONTRACTOR SHALL ENSURE THAT NO SOIL ERODES FROM THE SITE INTO PUBLIC RIGHT-OF-WAY OR ONTO PRIVATE PROPERTY. THIS CAN BE ACHIEVED BY CONSTRUCTING AND MAINTAINING TEMPORARY BEHMS AT THE PROPERTY LINES AND WETTING THE SOIL TO KEEP IT FROM BLOWING.
- THE CONTRACTOR SHALL PROMPTLY CLEAN UP ANY MATERIAL EXCAVATED WITHIN THE PUBLIC RIGHT-OF-WAY SO THAT THE EXCAVATED MATERIAL IS NOT SUSCEPTIBLE TO BEING WASHED DOWN THE STREET.
- IF THE REMOVAL OF EXISTING CURB AND GUTTER, SIDEWALK, AND/OR PAVING IS REQUIRED, THE CONTRACTOR SHALL SAWCUT AND/OR REMOVE TO THE NEAREST JOINT. WHEN ABUTTING NEW PAVEMENT TO EXISTING, THE CONTRACTOR SHALL CUT BACK THE EXISTING PAVING TO A STRAIGHT LINE IN ORDER TO REMOVE ANY BROKEN OR CRACKED PAVEMENT. CURB AND GUTTER AND/OR PAVEMENT SHOWN AS EXISTING AND NOT TO BE REMOVED UNDER THIS CONTRACT AND WHICH IS DAMAGED OR DISPLACED BY THE CONTRACTOR SHALL BE REMOVED AND REPLACED BY THE CONTRACTOR AT THE CONTRACTOR'S EXPENSE.
- THE CONTRACTOR SHALL BE RESPONSIBLE FOR SAFELY OBTAINING THE REQUIRED COMPACTION. THE CONTRACTOR SHALL SELECT AND USE METHODS WHICH SHALL NOT BE INJURIOUS OR DAMAGING TO THE EXISTING FACILITIES AND STRUCTURES WHICH SURROUND THE WORK AREAS.
- THE CONTRACTOR SHALL CONFINED HIS WORK WITHIN THE CONSTRUCTION LIMITS IN ORDER TO PRESERVE THE EXISTING IMPROVEMENTS AND SO AS NOT TO INTERFERE WITH THE OPERATIONS OF THE EXISTING FACILITIES.
- WHERE THE NEW WATERLINE CROSSES EXISTING FENCES, THE CONTRACTOR SHALL TUNNEL UNDER THE FENCE IN ORDER TO TRENCH AND INSTALL THE NEW WATERLINE. THE CONTRACTOR SHALL BE SOLELY RESPONSIBLE FOR ANY DAMAGE TO THE FENCE DURING THE CONSTRUCTION PERIOD AND SHALL REPAIR AND/OR REPLACE THE FENCE, IF NECESSARY, AT HIS EXPENSE AND AT NO ADDITIONAL COST TO THE OWNER. ALL REPAIRS OR REPLACEMENT OF EXISTING FENCING SHALL BE EQUAL TO OR BETTER THAN THE EXISTING CONDITION OF THE FENCE.
- IF THE REMOVAL OF EXISTING CURB AND GUTTER, SIDEWALK, AND/OR PAVING IS REQUIRED, THE CONTRACTOR SHALL SAWCUT AND/OR REMOVE TO THE NEAREST JOINT. WHEN ABUTTING NEW PAVEMENT TO EXISTING, THE CONTRACTOR SHALL CUT BACK THE EXISTING PAVING TO A STRAIGHT LINE IN ORDER TO REMOVE ANY BROKEN OR CRACKED PAVEMENT. CURB AND GUTTER AND/OR PAVEMENT SHOWN AS EXISTING AND NOT TO BE REMOVED UNDER THIS CONTRACT AND WHICH IS DAMAGED OR DISPLACED BY THE CONTRACTOR SHALL BE REMOVED AND REPLACED BY THE CONTRACTOR AT THE CONTRACTOR'S EXPENSE.
- ANY EXISTING TREES FOUND TO BE IN CONFLICT WITH THE PROPOSED CONSTRUCTION SHALL BE REMOVED AND DISPOSED OF BY THE CONTRACTOR. THIS SHALL BE CONSIDERED INCIDENTAL TO CONSTRUCTION, THEREFORE, NO SEPARATE PAYMENT WILL BE MADE.
- SEVENTY-TWO (72) HOURS PRIOR TO THE COMMENCEMENT OF CONSTRUCTION ON EACH OF THE SITES, THE CONTRACTOR SHALL NOTIFY THE OWNER OF HIS INTENT TO BEGIN CONSTRUCTION. CONTACT MR. BOB ROBBIE, FACILITIES, PLANNING AND CONSTRUCTION, 242-5865.
- WHERE EXISTING FIRE HYDRANTS ARE TO BE REMOVED AND RELOCATED, THE CONTRACTOR SHALL COORDINATE THIS WORK WITH THE OWNER SO THAT SCHOOL OPERATIONS ARE NOT ADVERSELY IMPACTED AND THE NECESSARY PRIVATE WATERLINE SHUTOFFS CAN BE ACCOMPLISHED. CONTACT MR. KEITH RUTHERFORD, MAINTENANCE AND OPERATIONS, 765-5950.
- THE CONTRACTOR SHALL BE RESPONSIBLE FOR THE COMPLETE REPAIR OF ANY EXISTING FACILITIES, STRUCTURES, OR UTILITIES DAMAGED BY CONSTRUCTION. REPAIRS SHALL BE MADE AT THE SOLE EXPENSE OF THE CONTRACTOR AND AT NO ADDITIONAL COST TO THE OWNER.
- WHERE WATER AND SANITARY SEWER LINES CROSS THE SANITARY SEWER LINE SHALL BE CONCRETE ENCASED FOR A DISTANCE OF 10 FEET EACH SIDE OF THE CROSSING IF 18 INCHES OF VERTICAL SEPARATION DOES NOT EXIST.
- ELECTRONIC MARKER DISKS (EMD'S) SHALL BE PLACED ABOVE ALL FITTINGS IN ACCORDANCE WITH SECTION 170 OF THE "STANDARD SPECIFICATIONS".
- IN ACCORDANCE WITH SECTION 801 OF THE "STANDARD SPECIFICATIONS", METALIZED DETECTABLE WARNING TAPE SHALL BE INSTALLED 18 INCHES ABOVE ALL PVC PIPE INSTALLED ON THIS PROJECT.
- VALVE STEM EXTENSIONS SHALL BE PROVIDED IN ACCORDANCE WITH THE STANDARD SPECIFICATIONS. THE COST OF THE VALVE STEM EXTENSIONS SHALL BE CONSIDERED INCIDENTAL TO CONSTRUCTION THEREFORE NO SEPARATE PAYMENT WILL BE MADE.

RECORD DRAWING

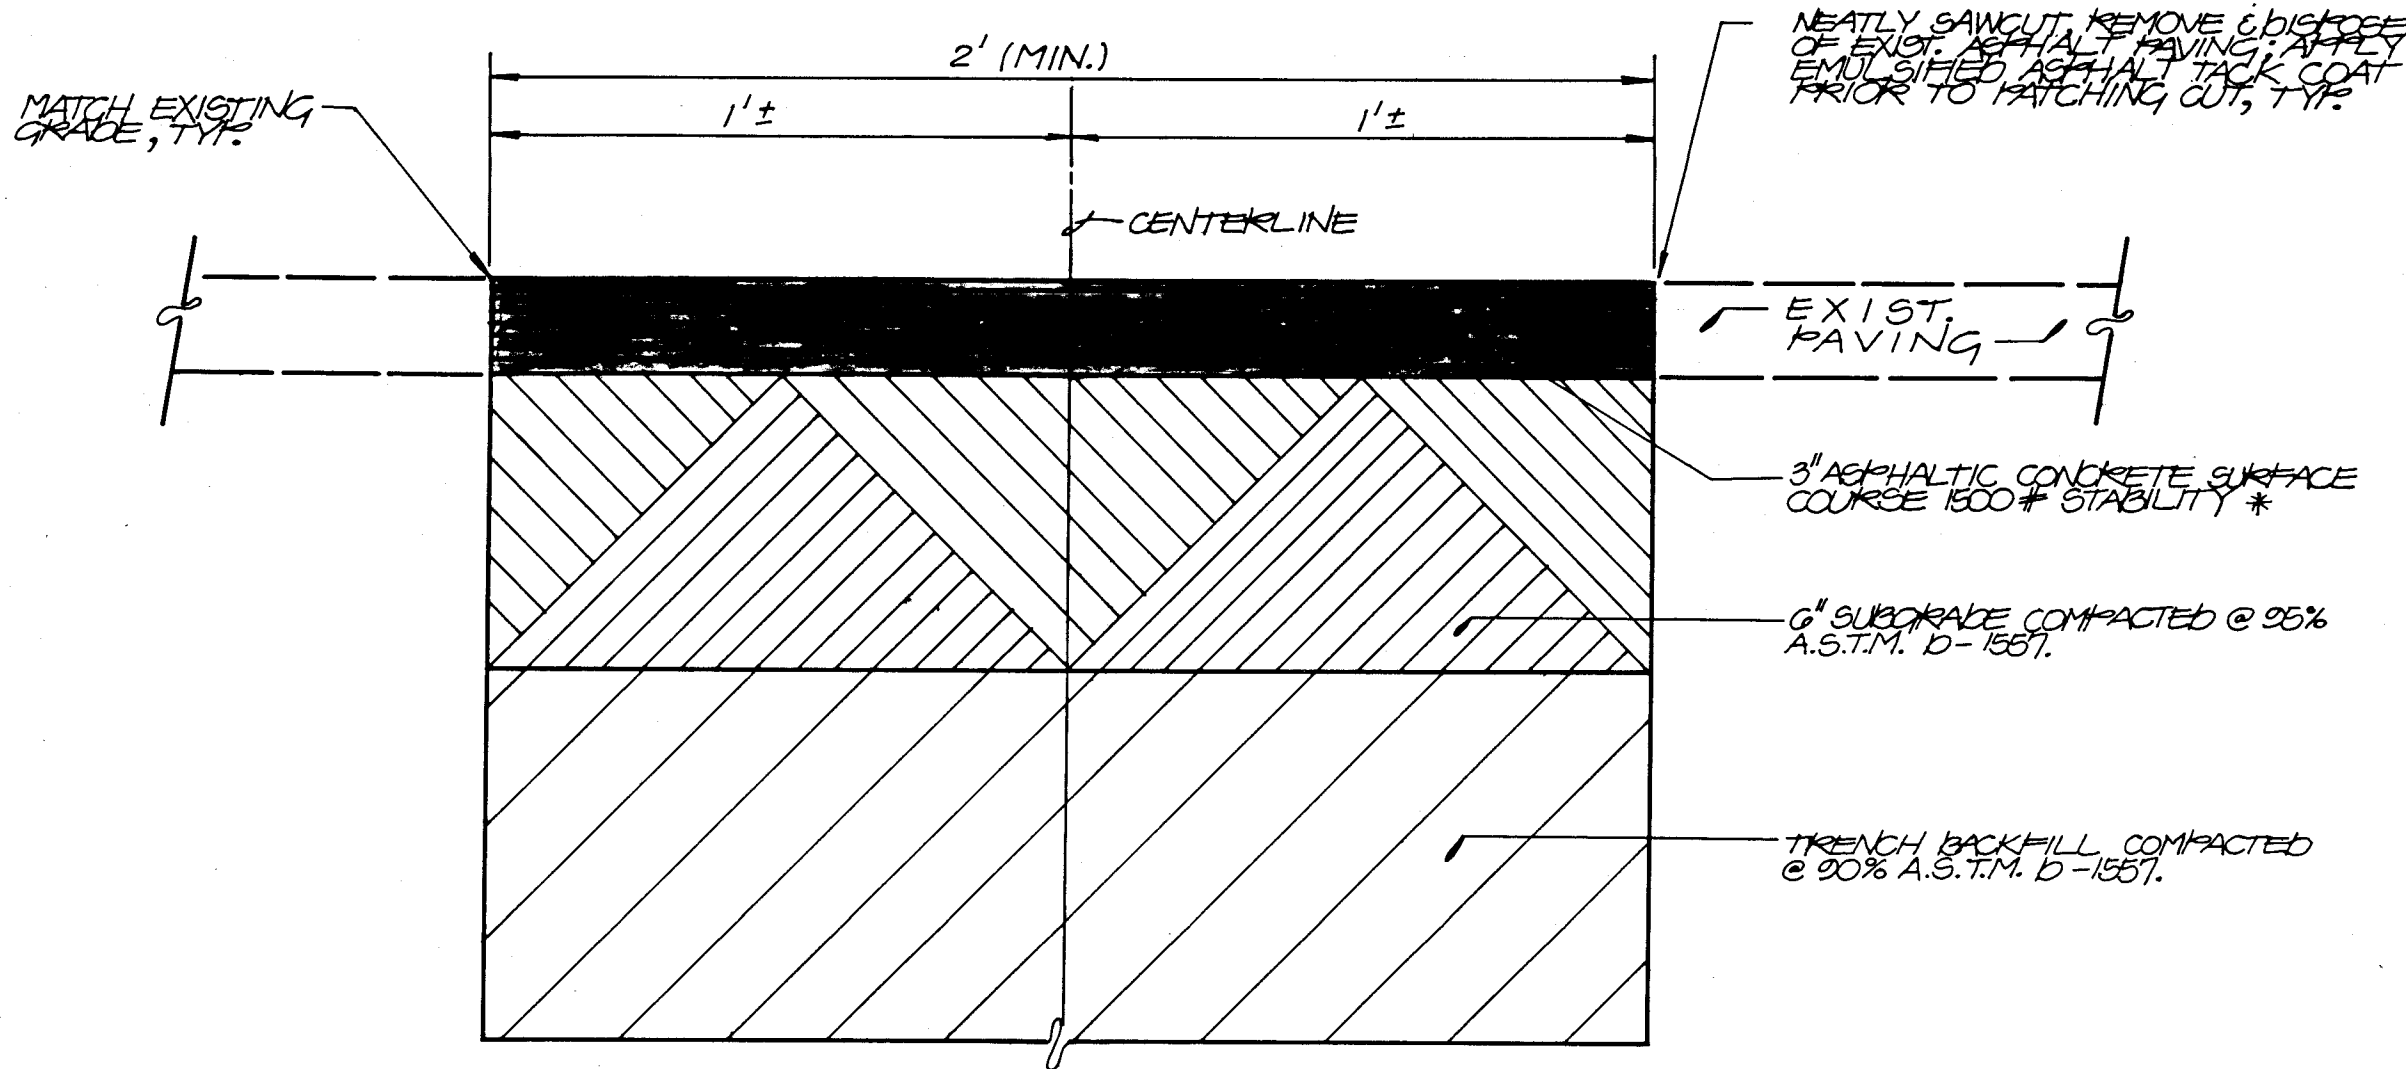

* SUBSTITUTE 2" THICKNESS IN NON-TRAFFIC AREAS

TYPICAL PRIVATE PAVING UTILITY CUT & PAVEMENT REPLACEMENT SECTION

SCALE: 1"=4'

1 2 3 4 5 6 7 8 9 10 11 12 13 14 15
2 4 4 1 1 1 1 9 0 2 5 9 0

SCANNED BY
BYLASON
891816

RECORD DRAWING

I, Jeffrey G. Mortensen, Registered Professional Engineer in the State of New Mexico, do hereby certify that this "as-built" information was obtained by me or under my supervision and represents the "as-built" conditions of this project, and is true and correct to the best of my knowledge and belief. All vertical and horizontal dimensions should be field verified prior to use on future projects.

Jeffrey G. Mortensen
NEW MEXICO
8947
REGISTERED PROFESSIONAL ENGINEER
DATE 4-90
NMP# No. 854

CITY OF ALBUQUERQUE
PUBLIC WORKS DEPARTMENT
ENGINEERING GROUP

TITLE: WEST MESA HIGH SCHOOL
WATER VALVE SHUTOFF PLAN, SECTIONS & DETAILS

APPROVALS	ENGINEER	DATE	APPROVALS	ENGINEER	DATE
D.R.C. CHAIRMAN	Rog. A. R...	7-18-90	WATER	R.W. Kane	7-16-90
TRANSPORTATION	R. Kane	7-17-90	WASTE WATER	R.W. Kane	7-16-90
HYDROLOGY	N/A				

PROJECT NO.	MAP NO.	SHEET	OF
4111.90	J-10	25	25