

RECORD DRAWING AS BUILT
PROJECT TITLE
NEW MEXICO UTILITIES, INC
WATERLINE EXTENSIONS

WITHIN
PASEO DEL NORTE, GOLF COURSE ROAD, EAGLE RANCH ROAD
AND BLOCK F, ALBUQUERQUE WEST SUBDIVISION

PREPARED FOR
NEW MEXICO UTILITIES, INC.
4700 IRVING N.W. - SUITE 201
ALBUQUERQUE, NEW MEXICO

INDEX TO SHEETS

1	COVER SHEET AND INDEX TO DRAWINGS
2	COMPOSITE PLAN
3-8	PASEO DEL NORTE, N.W. PLAN AND PROFILES (S (SHEET 3 NOT INCLUDED WITH THIS CONTRACT))
9	EAGLE RANCH ROAD, N.W. PLAN AND PROFILES
10-11	BLOCK F, ALBUQUERQUE WEST SUBDIVISION PLAN AND PROFILES
12-15	GOLF COURSE ROAD, N.W. PLAN AND PROFILES (NOT INCLUDED WITH THIS CONTRACT)

RECORD DRAWING AS BUILT
NOTE: AS BUILT CERTIFICATION IS BASED
UPON PERIODIC CONSTRUCTION MONITORING,
NOT FULL-TIME PROFESSIONAL CONSTRUCTION
INSPECTION. AS SUCH, THIS CERTIFICATION
REFERS TO READILY AVAILABLE LOCATION AND
ELEVATION DATA, AND MATERIAL CHARACTERIS-
TIC ASPECTS OF THE WORK AND IS NOT
INTENDED TO VERIFY EITHER SPECIFIC DE-
TAILS OR QUALITY OF CONSTRUCTION. IN
ADDITION, THE DRAWING MAY CONTAIN INFOR-
MATION GATHERED BY NEW MEXICO UTILITIES,
INC., INSPECTORS WHICH I CANNOT VERIFY.
Michael A. Hunt 9/1/90
CERTIFIED BY DATE

GENERAL NOTES:

1. ALL WORK DETAILED ON THESE PLANS TO BE PERFORMED UNDER CONTRACT SHALL, EXCEPT AS OTHERWISE STATED OR PROVIDED FROM HEREON, BE CONSTRUCTED IN ACCORDANCE WITH THE CITY OF ALBUQUERQUE STANDARD SPECIFICATIONS PUBLIC WORKS CONSTRUCTION, 1986.
2. ALL WORK DETAILED ON THESE PLANS TO BE PERFORMED UNDER CONTRACT SHALL, EXCEPT AS OTHERWISE STATED OR PROVIDED FROM HEREON, BE CONSTRUCTED IN ACCORDANCE WITH NEW MEXICO UTILITIES, INC. (NMU) STANDARD SPECIFICATIONS. IF NMU SPECIFICATIONS ARE IN CONFLICT WITH THE CITY SPECIFICATIONS, NMU SPECIFICATIONS SHALL TAKE PRIORITY.
3. TWO (2) WORKING DAYS PRIOR TO ANY EXCAVATION, CONTRACTOR MUST CONTACT LINE LOCATING SERVICE, 260-1990, FOR LOCATION OF EXISTING UTILITIES.
4. PRIOR TO CONSTRUCTION, THE CONTRACTOR SHALL EXCAVATE AND VERIFY THE HORIZONTAL AND VERTICAL LOCATIONS OF ALL OBSTRUCTIONS AND EXISTING PAVEMENT. SHOULD A CONFLICT EXIST, THE CONTRACTOR SHALL NOTIFY THE ENGINEER OR SURVEYOR SO THAT THE CONFLICT CAN BE RESOLVED WITH MINIMUM AMOUNT OF DELAY.
5. THE CONTRACTOR SHALL FURNISH EMOs ON ALL WATER AND SEWER SERVICE STUBS, CAPS AND PLUGS.
6. CONTRACTOR SHALL NOTIFY THE ENGINEER NOT LESS THAN SEVEN (7) DAYS PRIOR TO STARTING WORK IN ORDER THAT THE ENGINEER MAY TAKE NECESSARY MEASURES TO INSURE THE PRESERVATION OF SURVEY MONUMENTS. CONTRACTOR SHALL NOT DISTURB PERMANENT SURVEY MONUMENTS WITHOUT THE CONSENT OF THE ENGINEER AND SHALL NOTIFY THE ENGINEER AND BEAR THE EXPENSE OF REPLACING ANY THAT MAY BE DISTURBED WITHOUT PERMISSION. REPLACEMENT SHALL BE DONE ONLY BY THE ENGINEER. WHEN A CHANGE IS MADE IN THE FINISHED ELEVATION OF THE PAVEMENT OF ANY ROADWAY IN WHICH A PERMANENT SURVEY MONUMENT IS LOCATED, CONTRACTOR SHALL, AT HIS OWN EXPENSE, ADJUST THE MONUMENT COVER TO THE NEW GRADE UNLESS OTHERWISE SPECIFIED.
7. CONTRACTOR SHALL BEGIN PROJECT CONSTRUCTION AT STA. 26 + 93.97, 62' L.T., PASEO DEL NORTE, UNLESS OTHERWISE NOTIFIED BY NEW MEXICO UTILITIES, INC.



C.O.A. PROJECT NO. 4113.90

SCANNED BY
BY LASON

1 2 3 4 5 6 7 8 9 10 11 12 13 14 15
26 14/1/3. 19 10 1/17

ENGINEER'S SEAL	APRIL, 1990	community sciences corporation	APPROVED FOR CONSTRUCTION
DATE	N/A		
DESIGNED	MKS		
DRAWN	R.Q.		
CHECKED	210-02-055		
PLANNING			
ENGINEERING			
SURVEYING			
CONSULTING			
CRAWFORD DEVELOPMENT SERVICES			
P.O. Drawer M. Corrales, N.M. 87048 (505) 897-0167			

NEW MEXICO UTILITIES, INC.
DATE 8/26/90
SHEET 1 OF 15

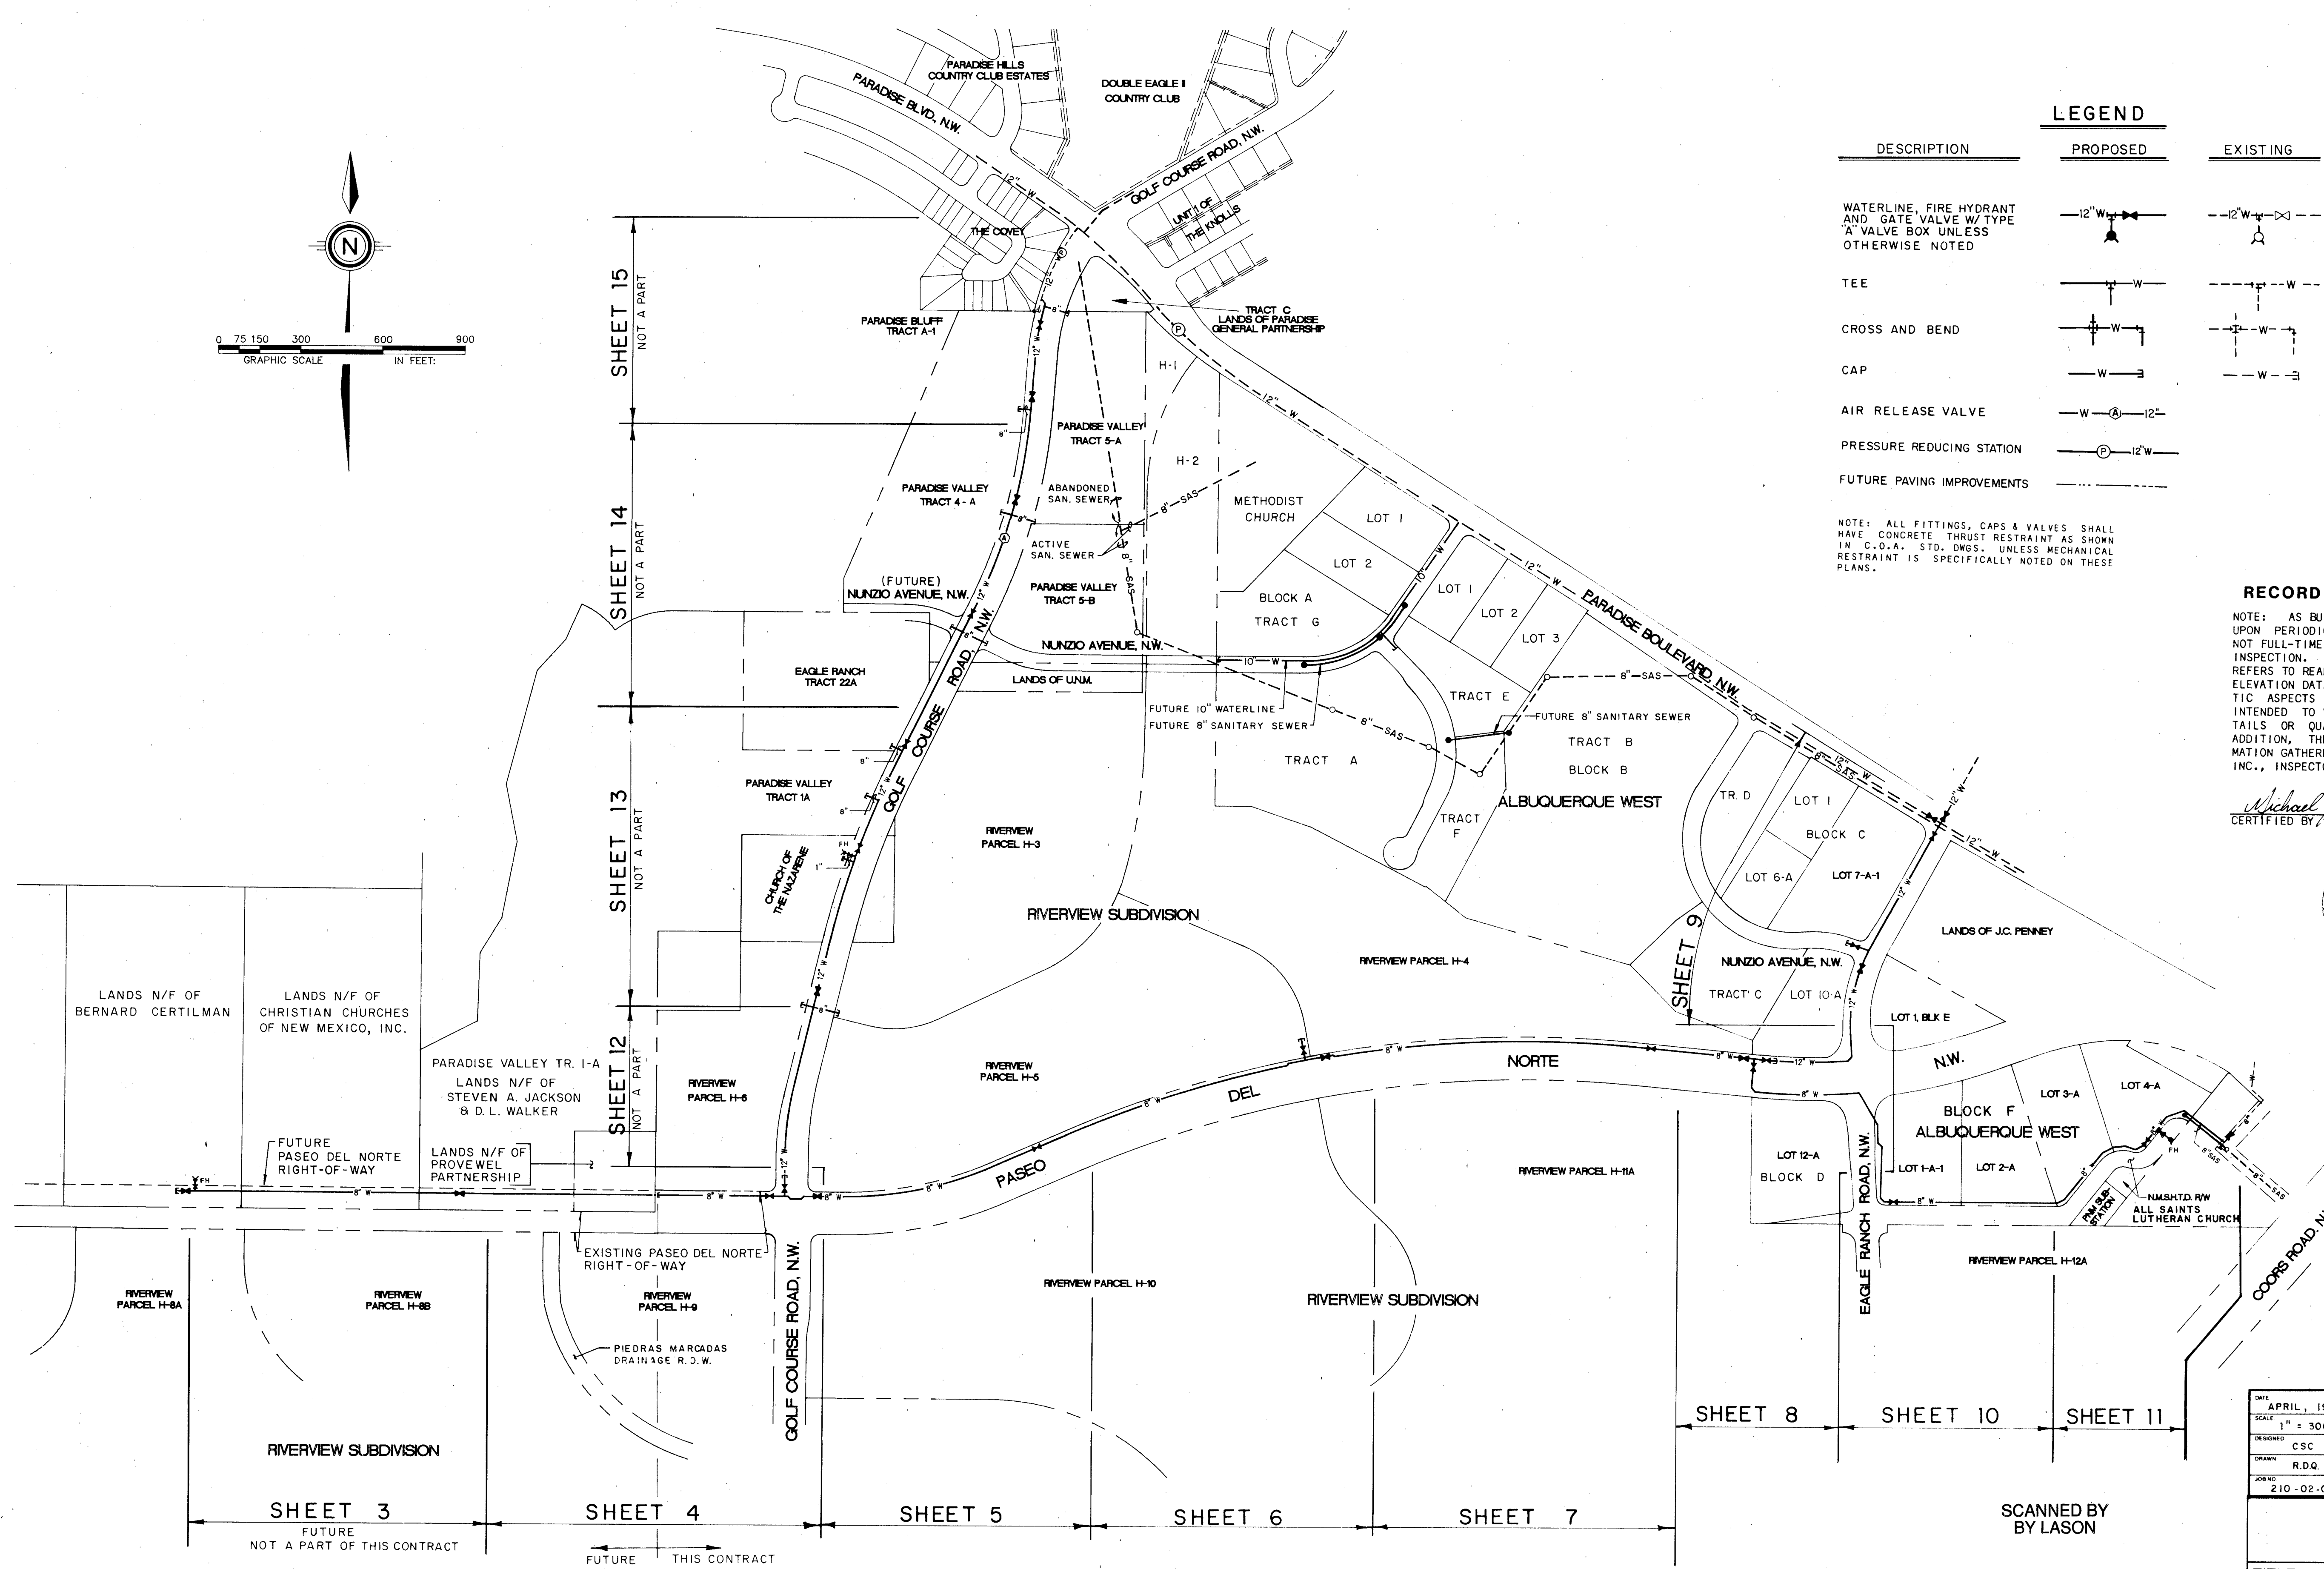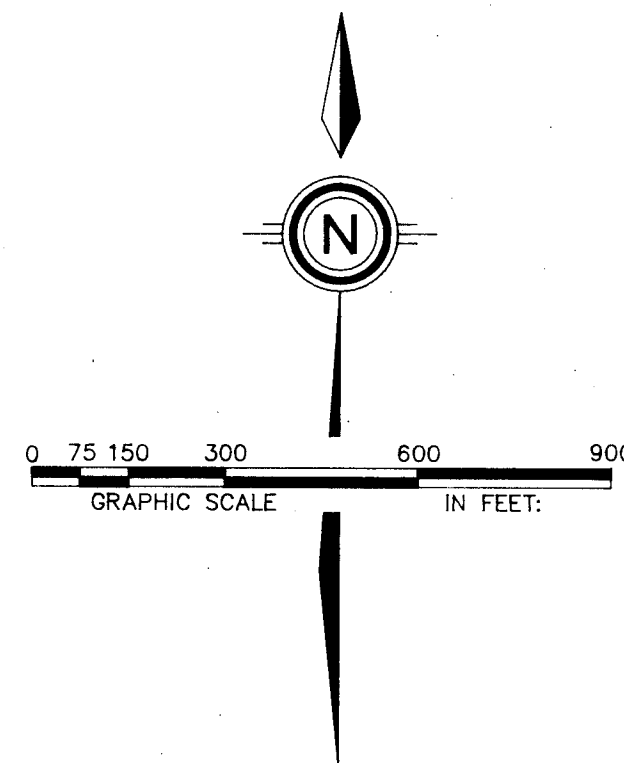


LEGEND		
DESCRIPTION	PROPOSED	EXISTING
WATERLINE, FIRE HYDRANT AND GATE VALVE W/ TYPE 'A' VALVE BOX UNLESS OTHERWISE NOTED		
TEE		
CROSS AND BEND		
CAP		
AIR RELEASE VALVE		
PRESSURE REDUCING STATION		
FUTURE PAVING IMPROVEMENTS		

NOTE: ALL FITTINGS, CAPS & VALVES SHALL HAVE CONCRETE THRUST RESTRAINT AS SHOWN IN C.O.A. STD. DWGS. UNLESS MECHANICAL RESTRAINT IS SPECIFICALLY NOTED ON THESE PLANS.

RECORD DRAWING AS BUILT
NOTE: AS BUILT CERTIFICATION IS BASED UPON PERIODIC CONSTRUCTION MONITORING, NOT FULL-TIME, PROFESSIONAL, CONSTRUCTION INSPECTION. AS SUCH, THIS CERTIFICATION REFERS TO READILY AVAILABLE LOCATION AND ELEVATION DATA, AND MATERIAL CHARACTERISTIC ASPECTS OF THE WORK AND IS NOT INTENDED TO VERIFY EITHER SPECIFIC DETAILS OR QUALITY OF CONSTRUCTION. IN ADDITION, THE DRAWING MAY CONTAIN INFORMATION GATHERED BY NEW MEXICO UTILITIES, INC., INSPECTORS WHICH I CANNOT VERIFY.

Michael J. Yost 9/11/90
CERTIFIED BY DATE

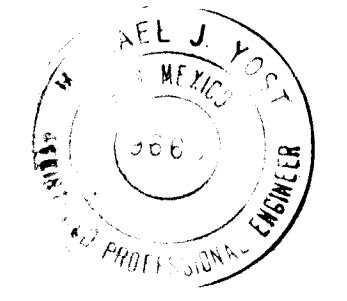


DATE	APRIL, 1990
SCALE	1" = 300'
DESIGNED	CSC
DRAWN	R.D.Q.
JOB NO.	210-02-055

NEW MEXICO UTILITIES, INC.					
TITLE: COMPOSITE PLAN					
APPROVALS	ENGINEER	DATE	APPROVALS	ENGINEER	DATE
	<i>[Signature]</i>	8-8-90		<i>[Signature]</i>	8-8-90
DRAWING NO. 4113.90		MAP NO. C-12, C-13		SHEET 2 OF 15	

1 2 3 4 5 6 7 8 9 10 11 12 13 14 15
26 4113.900291

CRAWFORD DEVELOPMENT SERVICES
P.O. Drawer M, Corrales, N.M. 87048 (505) 897-0167

SHEET 3
NOT INCLUDED
WITH THIS
CONTRACT.

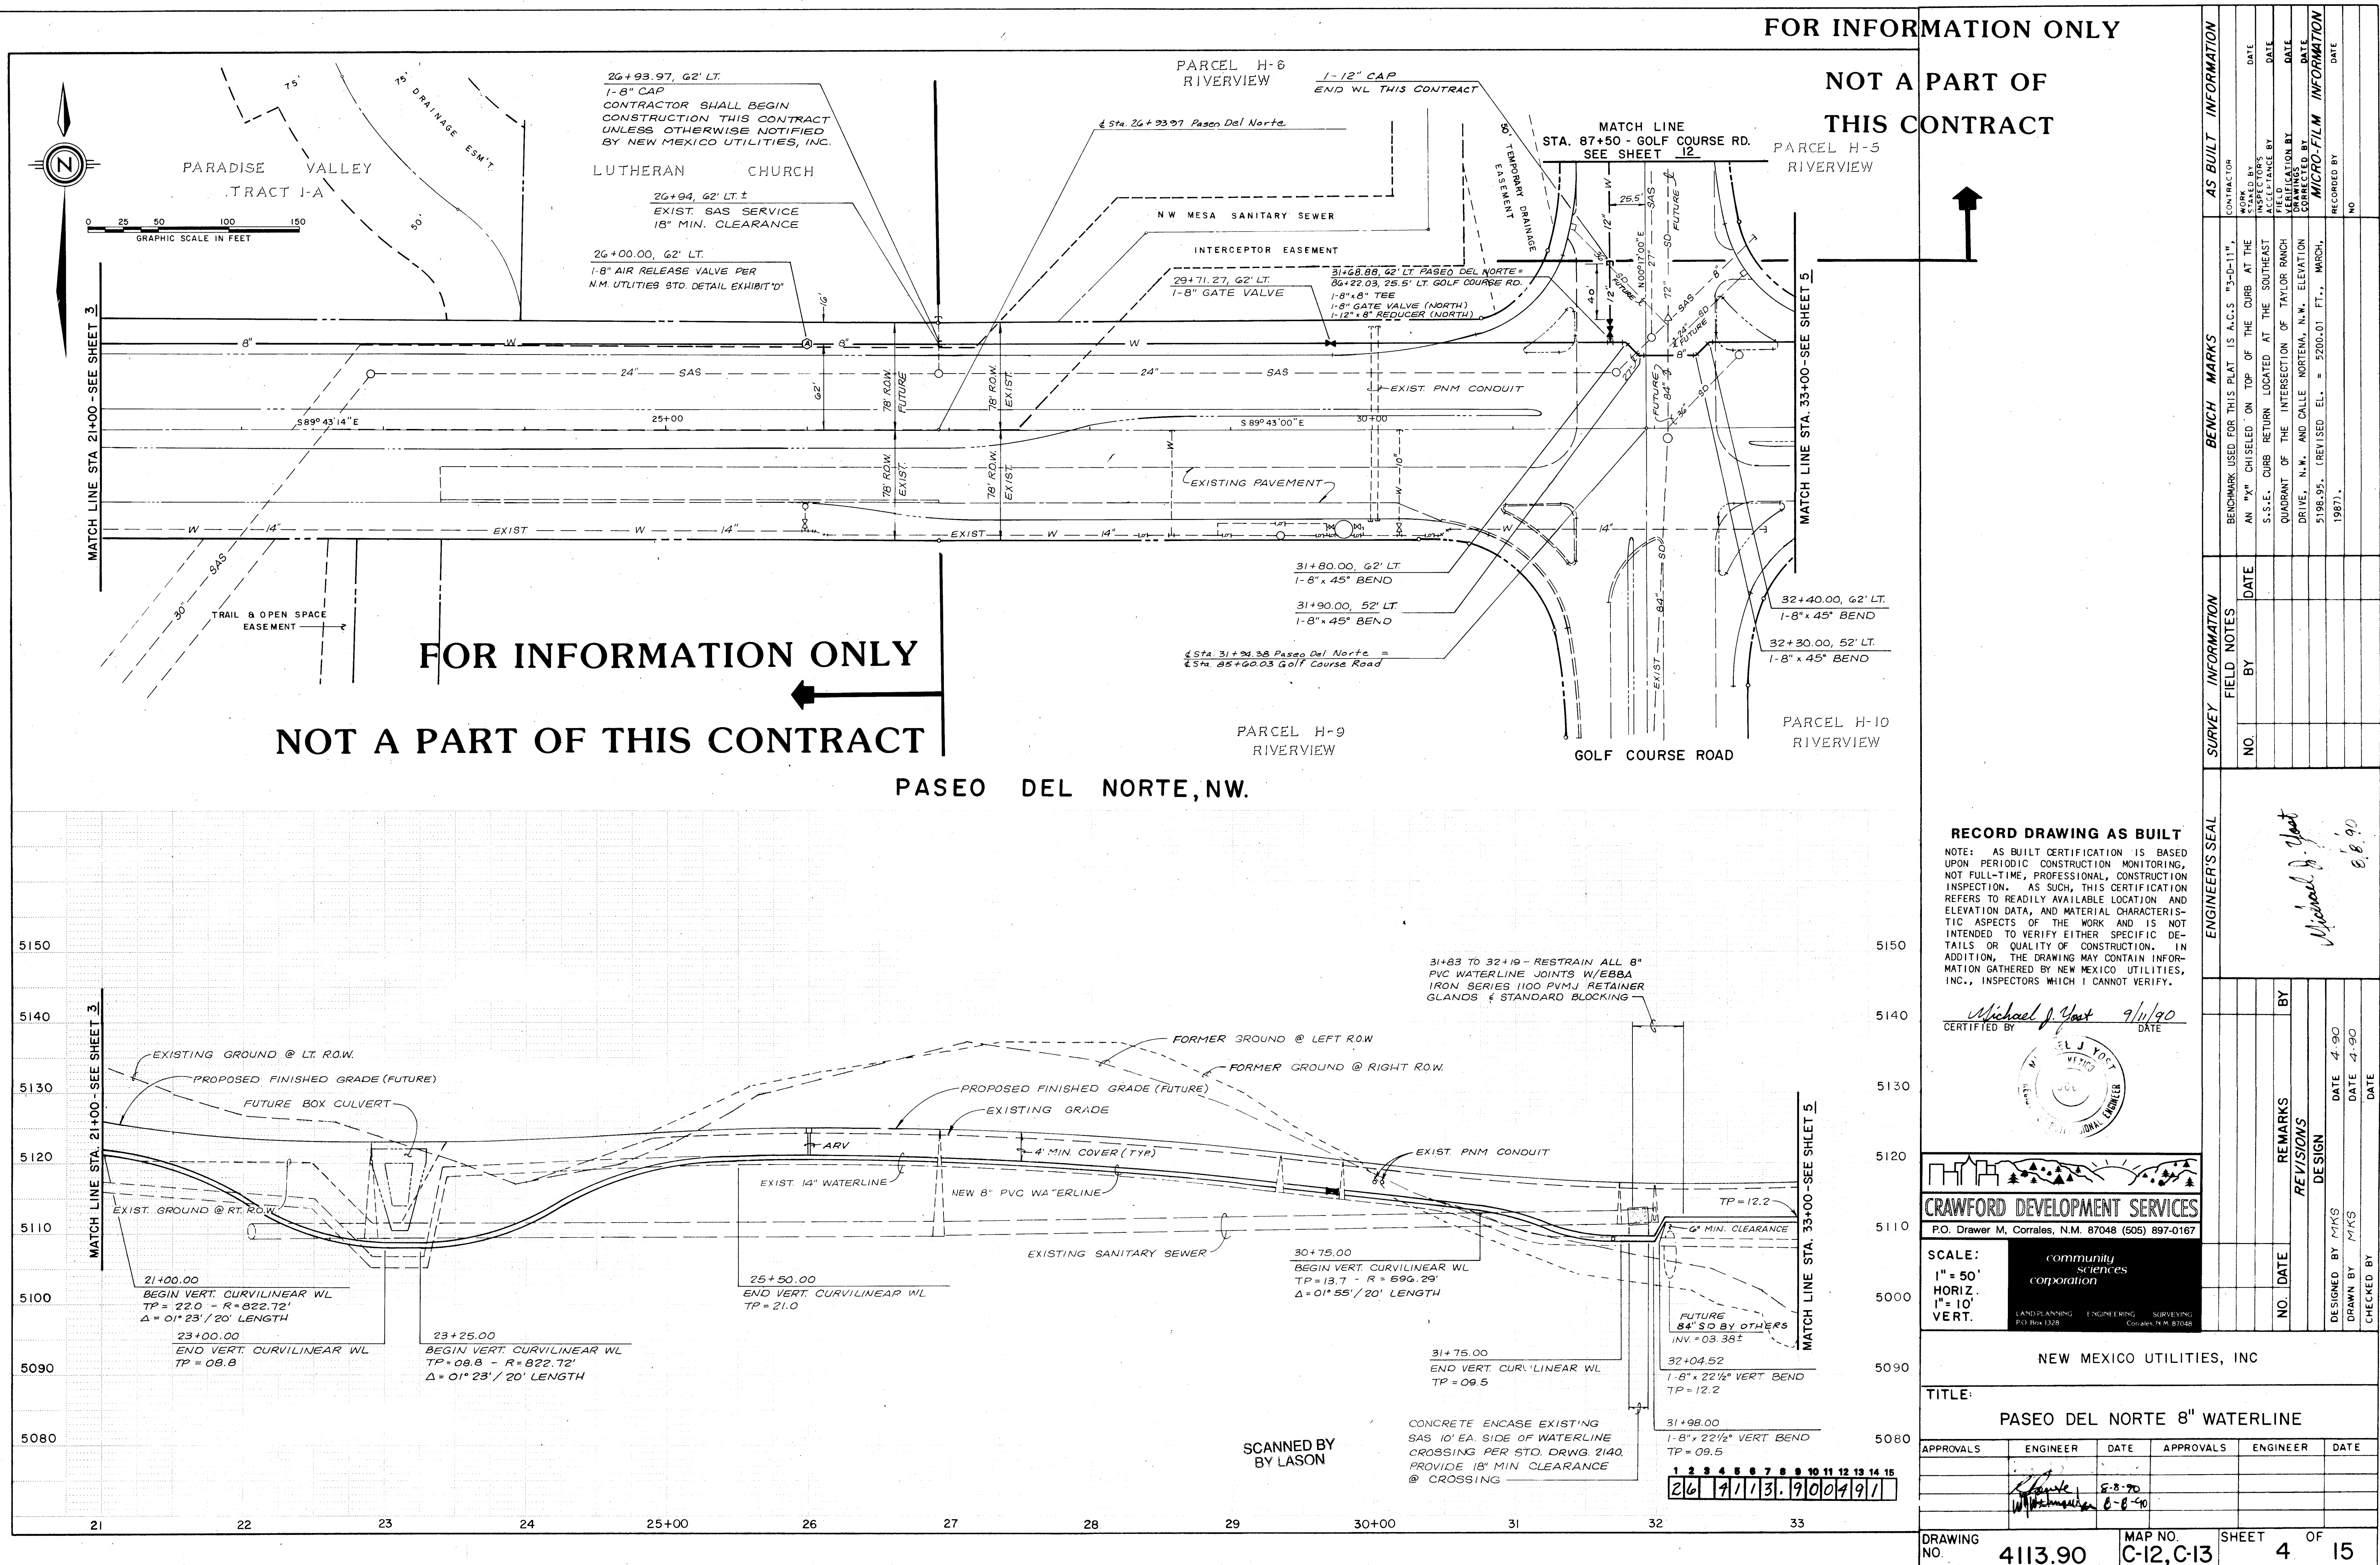


FOR INFORMATION ONLY
NOT A PART OF
THIS CONTRACT

FOR INFORMATION ONLY
NOT A PART OF THIS CONTRACT

PASEO DEL NORTE, NW.

RECORD DRAWING AS BUILT
NOTE: AS BUILT CERTIFICATION IS BASED UPON PERIODIC CONSTRUCTION MONITORING, NOT FULL-TIME, PROFESSIONAL, CONSTRUCTION INSPECTION. AS SUCH, THIS CERTIFICATION REFERS TO READILY AVAILABLE LOCATION AND ELEVATION DATA, AND MATERIAL CHARACTERISTIC ASPECTS OF THE WORK AND IS NOT INTENDED TO VERIFY EITHER SPECIFIC DETAILS OR QUALITY OF CONSTRUCTION. IN ADDITION, THE DRAWING MAY CONTAIN INFORMATION GATHERED BY NEW MEXICO UTILITIES, INC., INSPECTORS WHICH I CANNOT VERIFY.

CERTIFIED BY *Michael J. Yost* 9/11/90
DATE

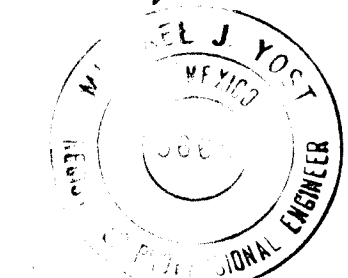


CRAWFORD DEVELOPMENT SERVICES
P.O. Drawer M, Corrales, N.M. 87048 (505) 897-0167

SCALE:
1" = 50'
HORIZ.
1" = 10'
VERT.

NEW MEXICO UTILITIES, INC

TITLE: PASEO DEL NORTE 8" WATERLINE					
APPROVALS	ENGINEER	DATE	APPROVALS	ENGINEER	DATE
	<i>[Signature]</i>	8-8-90			
	<i>[Signature]</i>	8-8-90			
DRAWING NO.	4113.90	MAP NO.	C-12, C-13	SHEET	4 OF 15

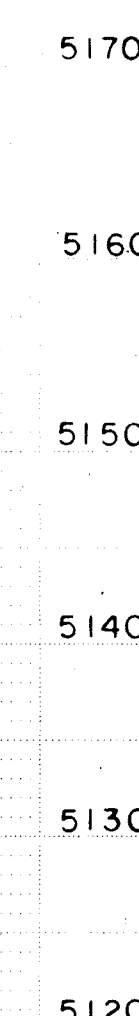

NOTE: AS BUILT CERTIFICATION IS BASED UPON PERIODIC CONSTRUCTION MONITORING, NOT FULL-TIME, PROFESSIONAL, CONSTRUCTION INSPECTION. THE SURVEY OF CERTIFICATION REFERS TO READILY AVAILABLE LOCATION AND ELEVATION DATA, AND MATERIAL CHARACTERISTIC ASPECTS OF THE WORK AND IS NOT INTENDED TO VERIFY EITHER SPECIFIC DETAILS OR QUALITY OF CONSTRUCTION. IN ADDITION, THE DRAWING MAY CONTAIN INFORMATION GATHERED BY NEW MEXICO UTILITIES, INC., INSPECTORS WHICH I CANNOT VERIFY.

RECEIVED
MICHAEL J. YOST
MAY 10 1994
872494





community
science
corporation

TITLE: PASEO DEL NORTE 8" WATERLINE

APPROVALS	ENGINEER	DATE	APPROVALS	ENGINEER	DATE
	<i>[Signature]</i>	8-9-90			
	<i>[Signature]</i>	8-8-90			
	<i>[Signature]</i>	8-8-90			


DRAWING NO.	4113.90	MAP NO.	C-12, C-13	SHEET	5	OF	15
-------------	---------	---------	------------	-------	---	----	----

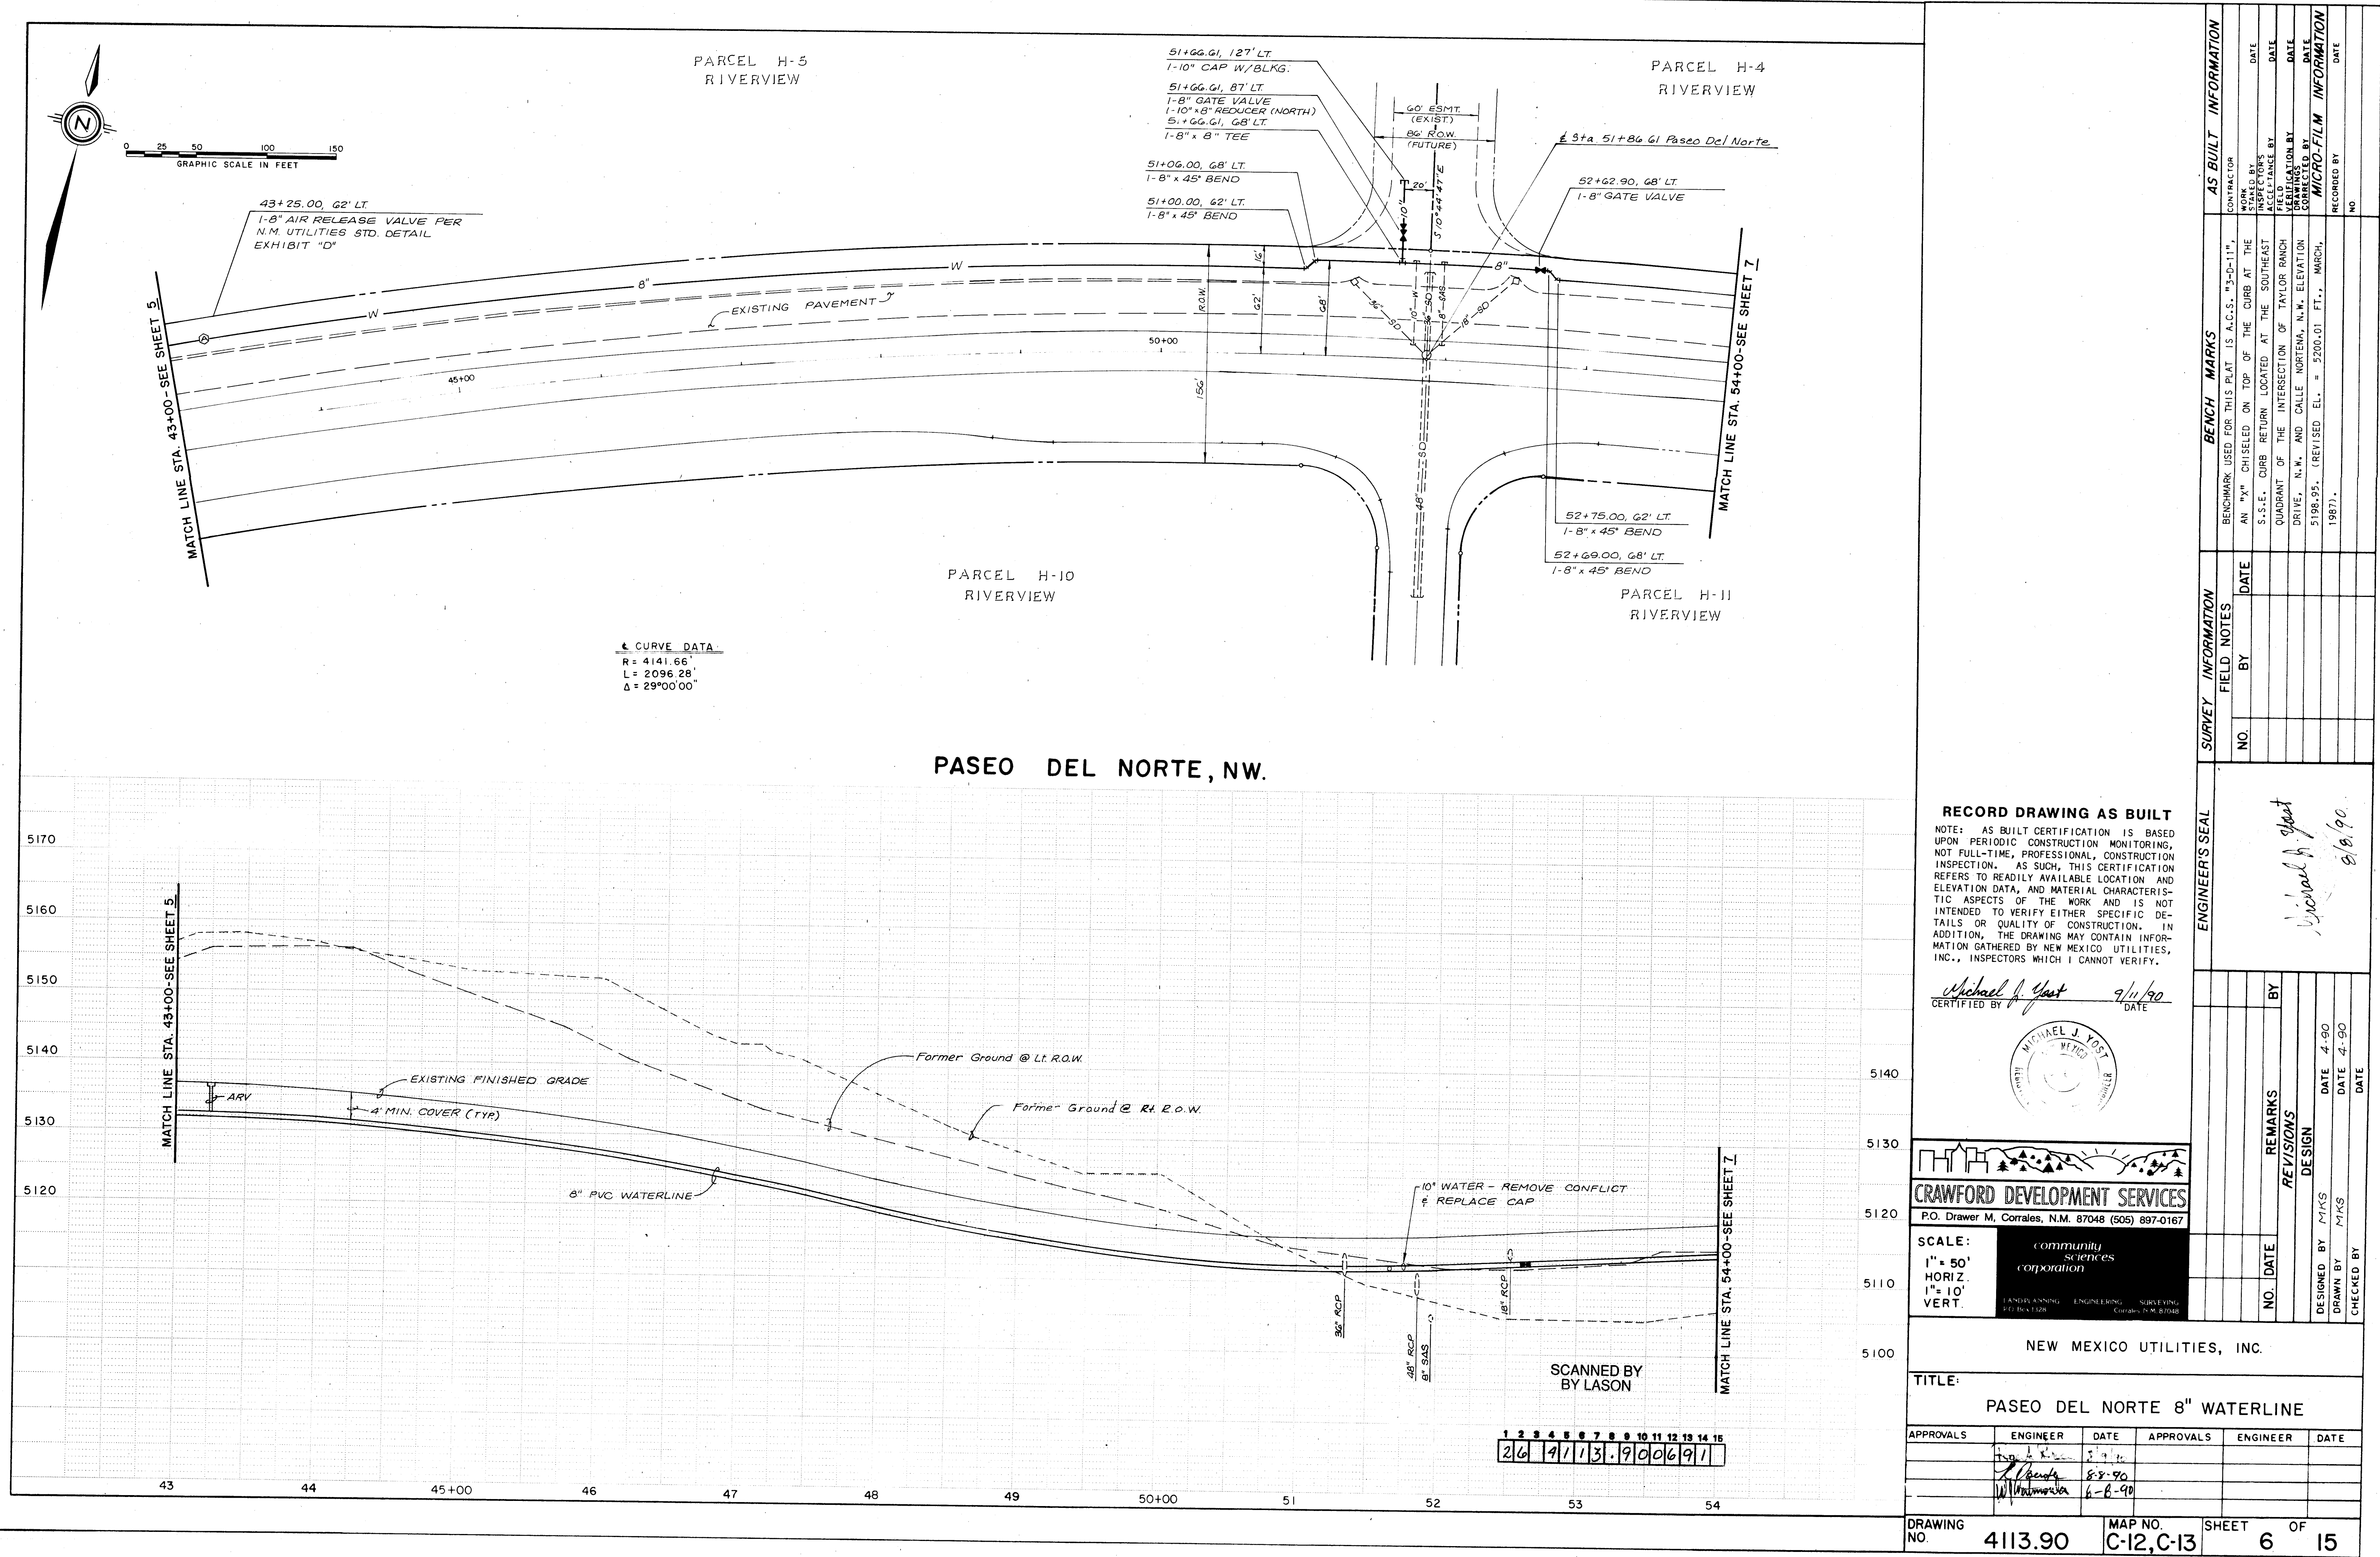

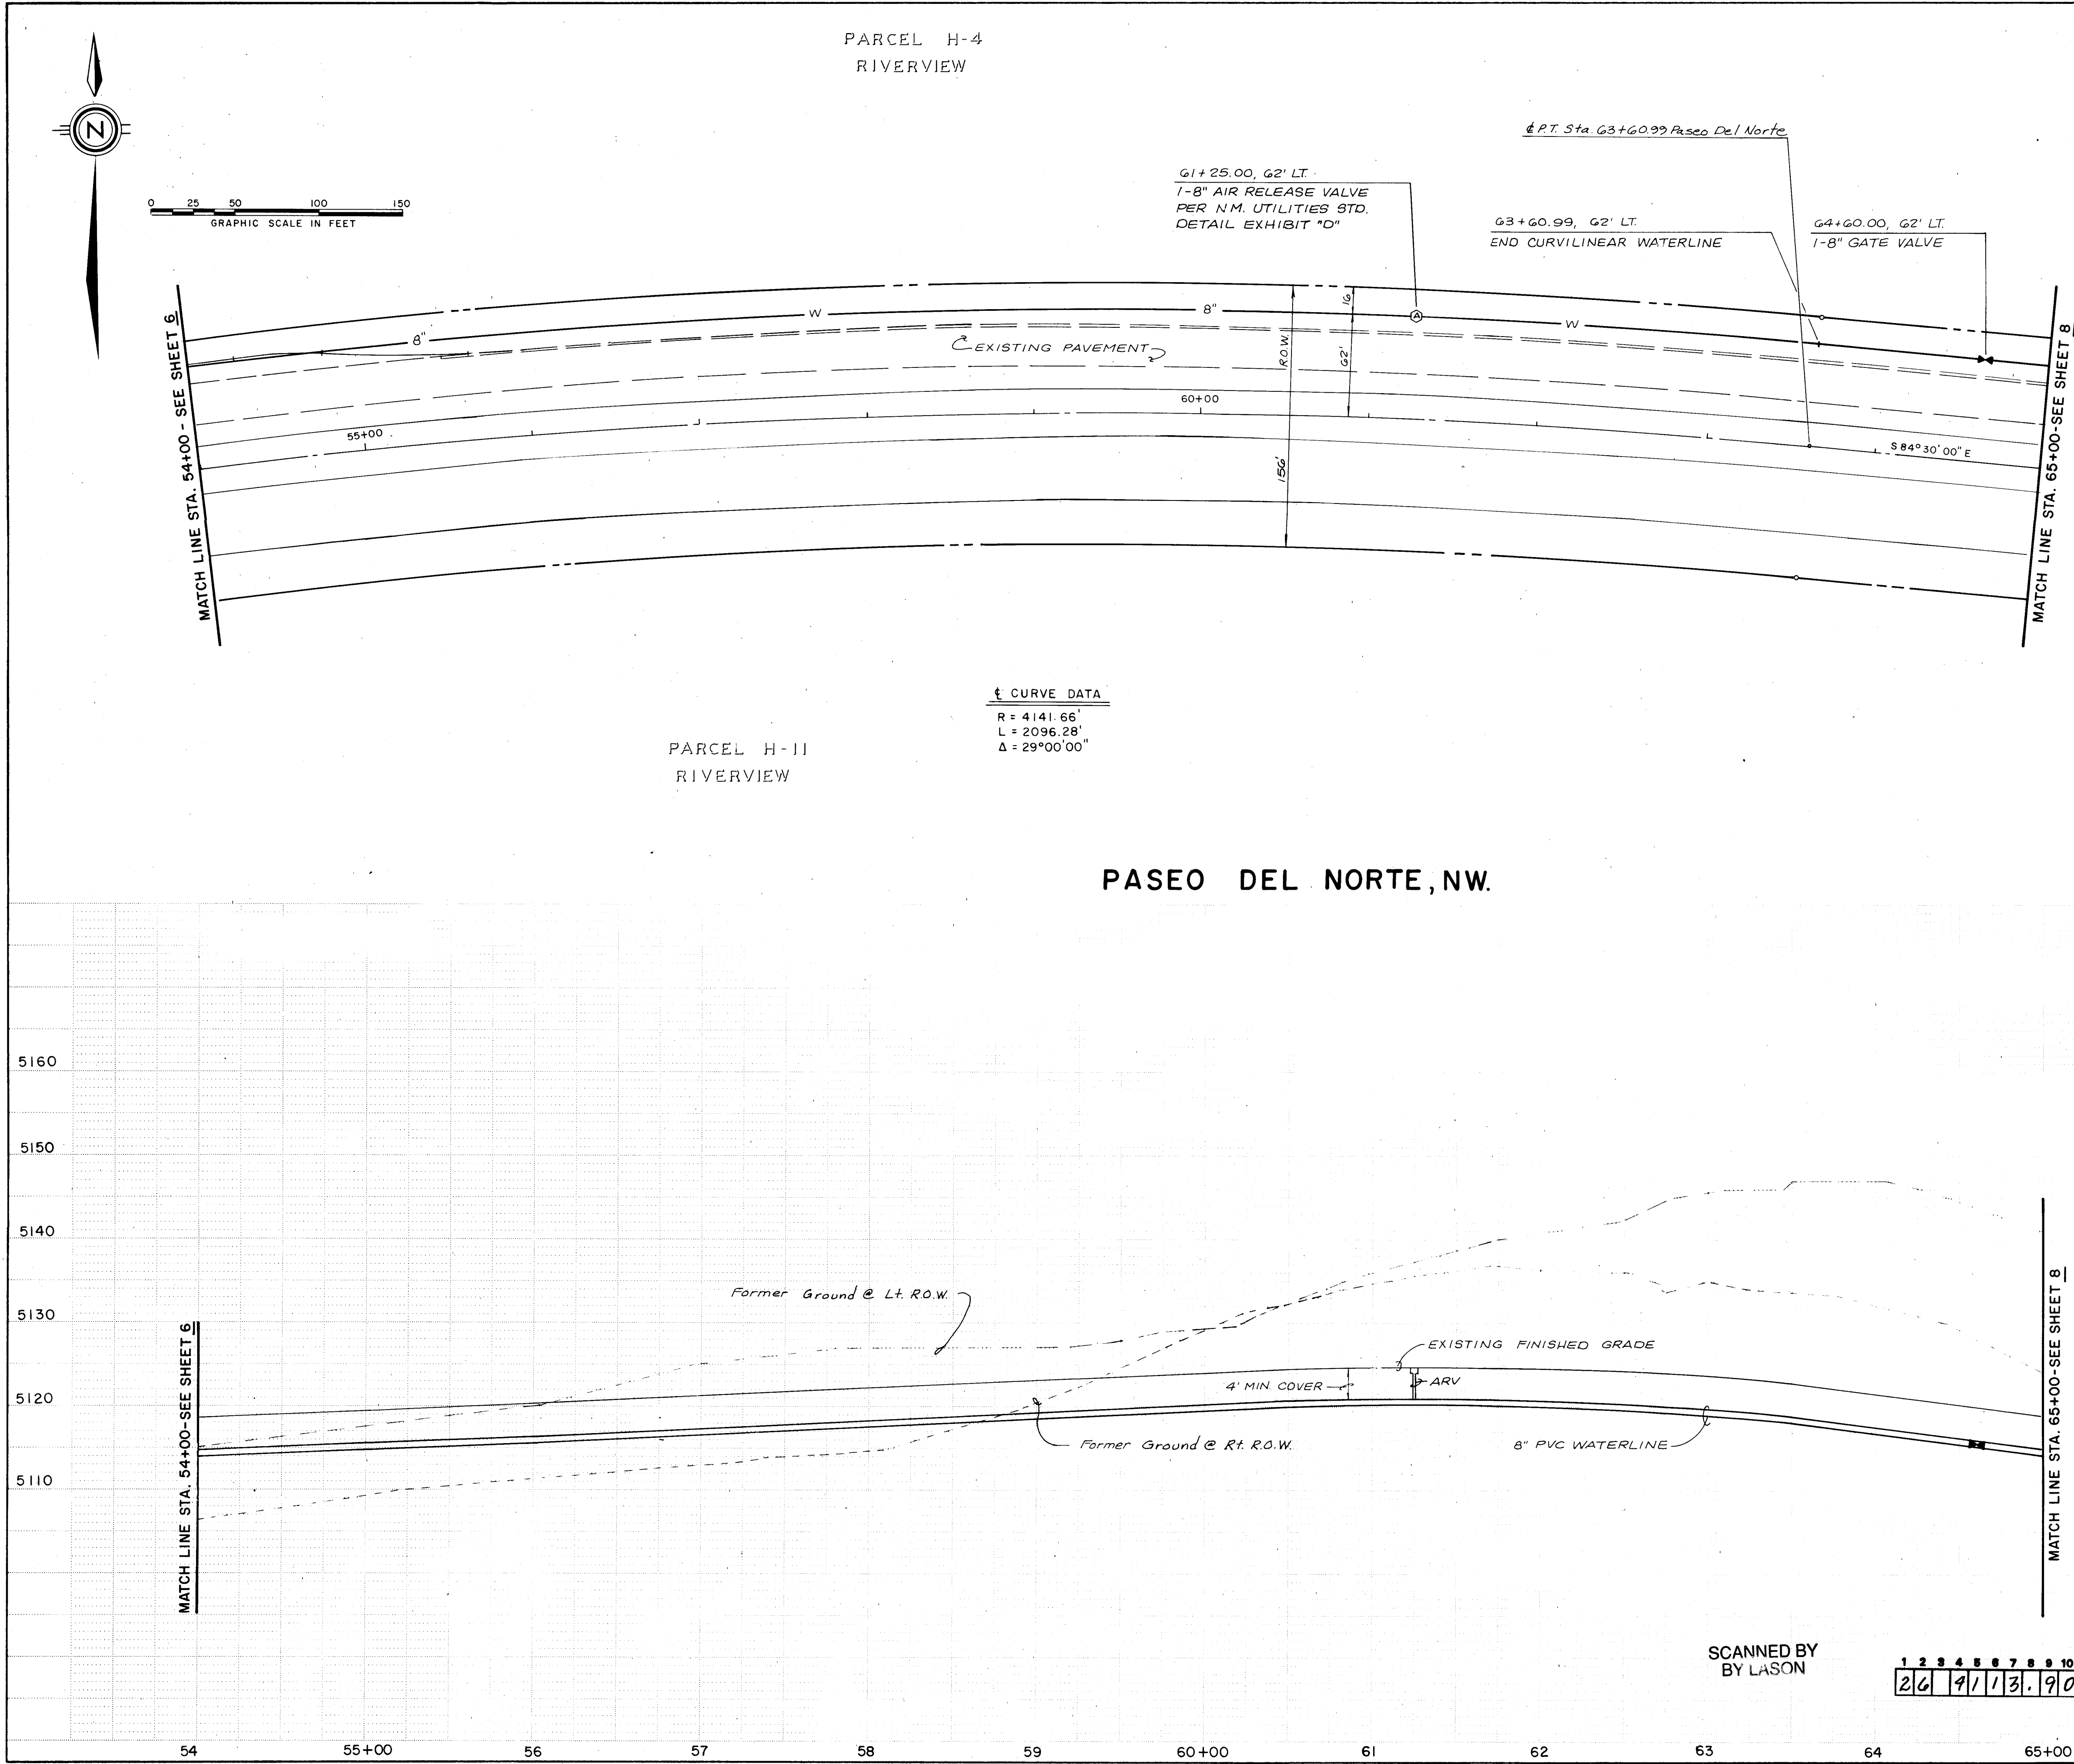

RECORD DRAWING AS BUILT
NOTE: AS BUILT CERTIFICATION IS BASED UPON PERIODIC CONSTRUCTION MONITORING, NOT FULL-TIME, PROFESSIONAL, CONSTRUCTION INSPECTION. AS SUCH, THIS CERTIFICATION REFERS TO READILY AVAILABLE LOCATION AND ELEVATION DATA, AND MATERIAL CHARACTERISTIC ASPECTS OF THE WORK AND IS NOT INTENDED TO VERIFY EITHER SPECIFIC DETAILS OR QUALITY OF CONSTRUCTION. IN ADDITION, THE DRAWING MAY CONTAIN INFORMATION GATHERED BY NEW MEXICO UTILITIES, INC., INSPECTORS WHICH I CANNOT VERIFY.

CERTIFIED BY Michael J. Post DATE 9/11/90

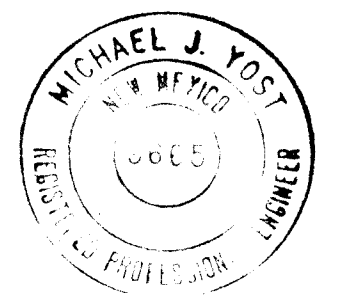

CRAWFORD DEVELOPMENT SERVICES
P.O. Drawer M, Corrales, N.M. 87048 (505) 897-0167

SCALE: 1" = 50' HORIZ. 1" = 10' VERT.

community sciences corporation
LAND PLANNING ENGINEERING SURVEYING
P.O. Box 1128 Corrales, N.M. 87048

NEW MEXICO UTILITIES, INC.



TITLE: **PASEO DEL NORTE 8" WATERLINE**

APPROVALS	ENGINEER	DATE	APPROVALS	ENGINEER	DATE
	<u>[Signature]</u>	<u>8-8-78</u>			
	<u>[Signature]</u>	<u>6-6-90</u>			

DESIGNED BY	MKS	DATE	4-90
DRAWN BY	MKS	DATE	4-90
CHECKED BY		DATE	

DRAWING NO. **4113.90** MAP NO. **C-12, C-13** SHEET **7** OF **15**


SURVEY INFORMATION		BENCH MARKS		AS BUILT INFORMATION	
NO.	BY	DATE	BENCHMARK USED FOR THIS PLAT IS A.C.S. "3-D-11", AN "X" CHISELED ON TOP OF THE CURB AT THE S.S.E. CURB RETURN LOCATED AT THE SOUTHEAST QUADRANT OF THE INTERSECTION OF TAYLOR RANCH DRIVE, N.W. AND CALLE NORTENA, N.W. ELEVATION 5198.95. (RE/USED EL. = 5200.01 FT., MARCH, 1987).	CONTRACTOR	NO.
				WORKED BY	
				INSPECTORS	
				ACCEPTANCE BY	
				VERIFICATION BY	
				DRAWINGS	
				REVISIONS	
				DATE	
				RECORDED BY	
				DATE	

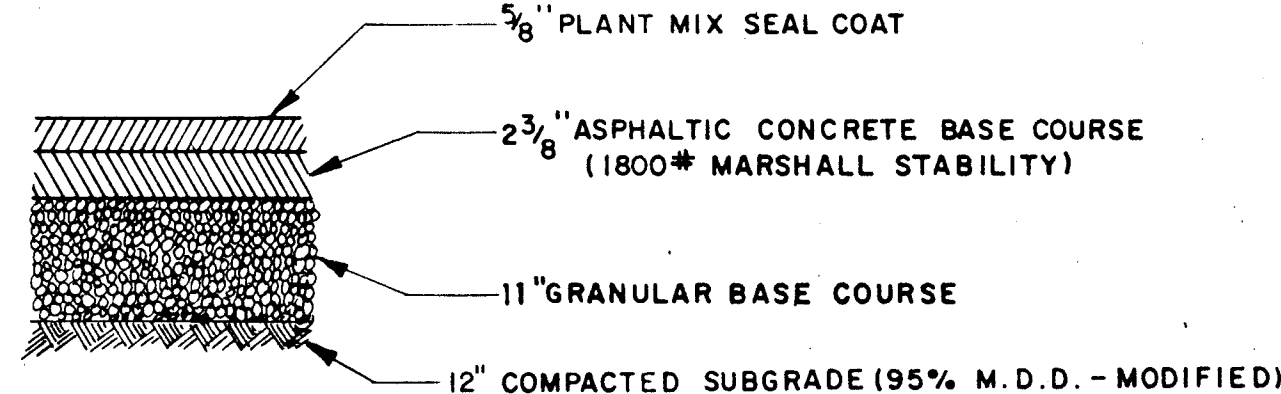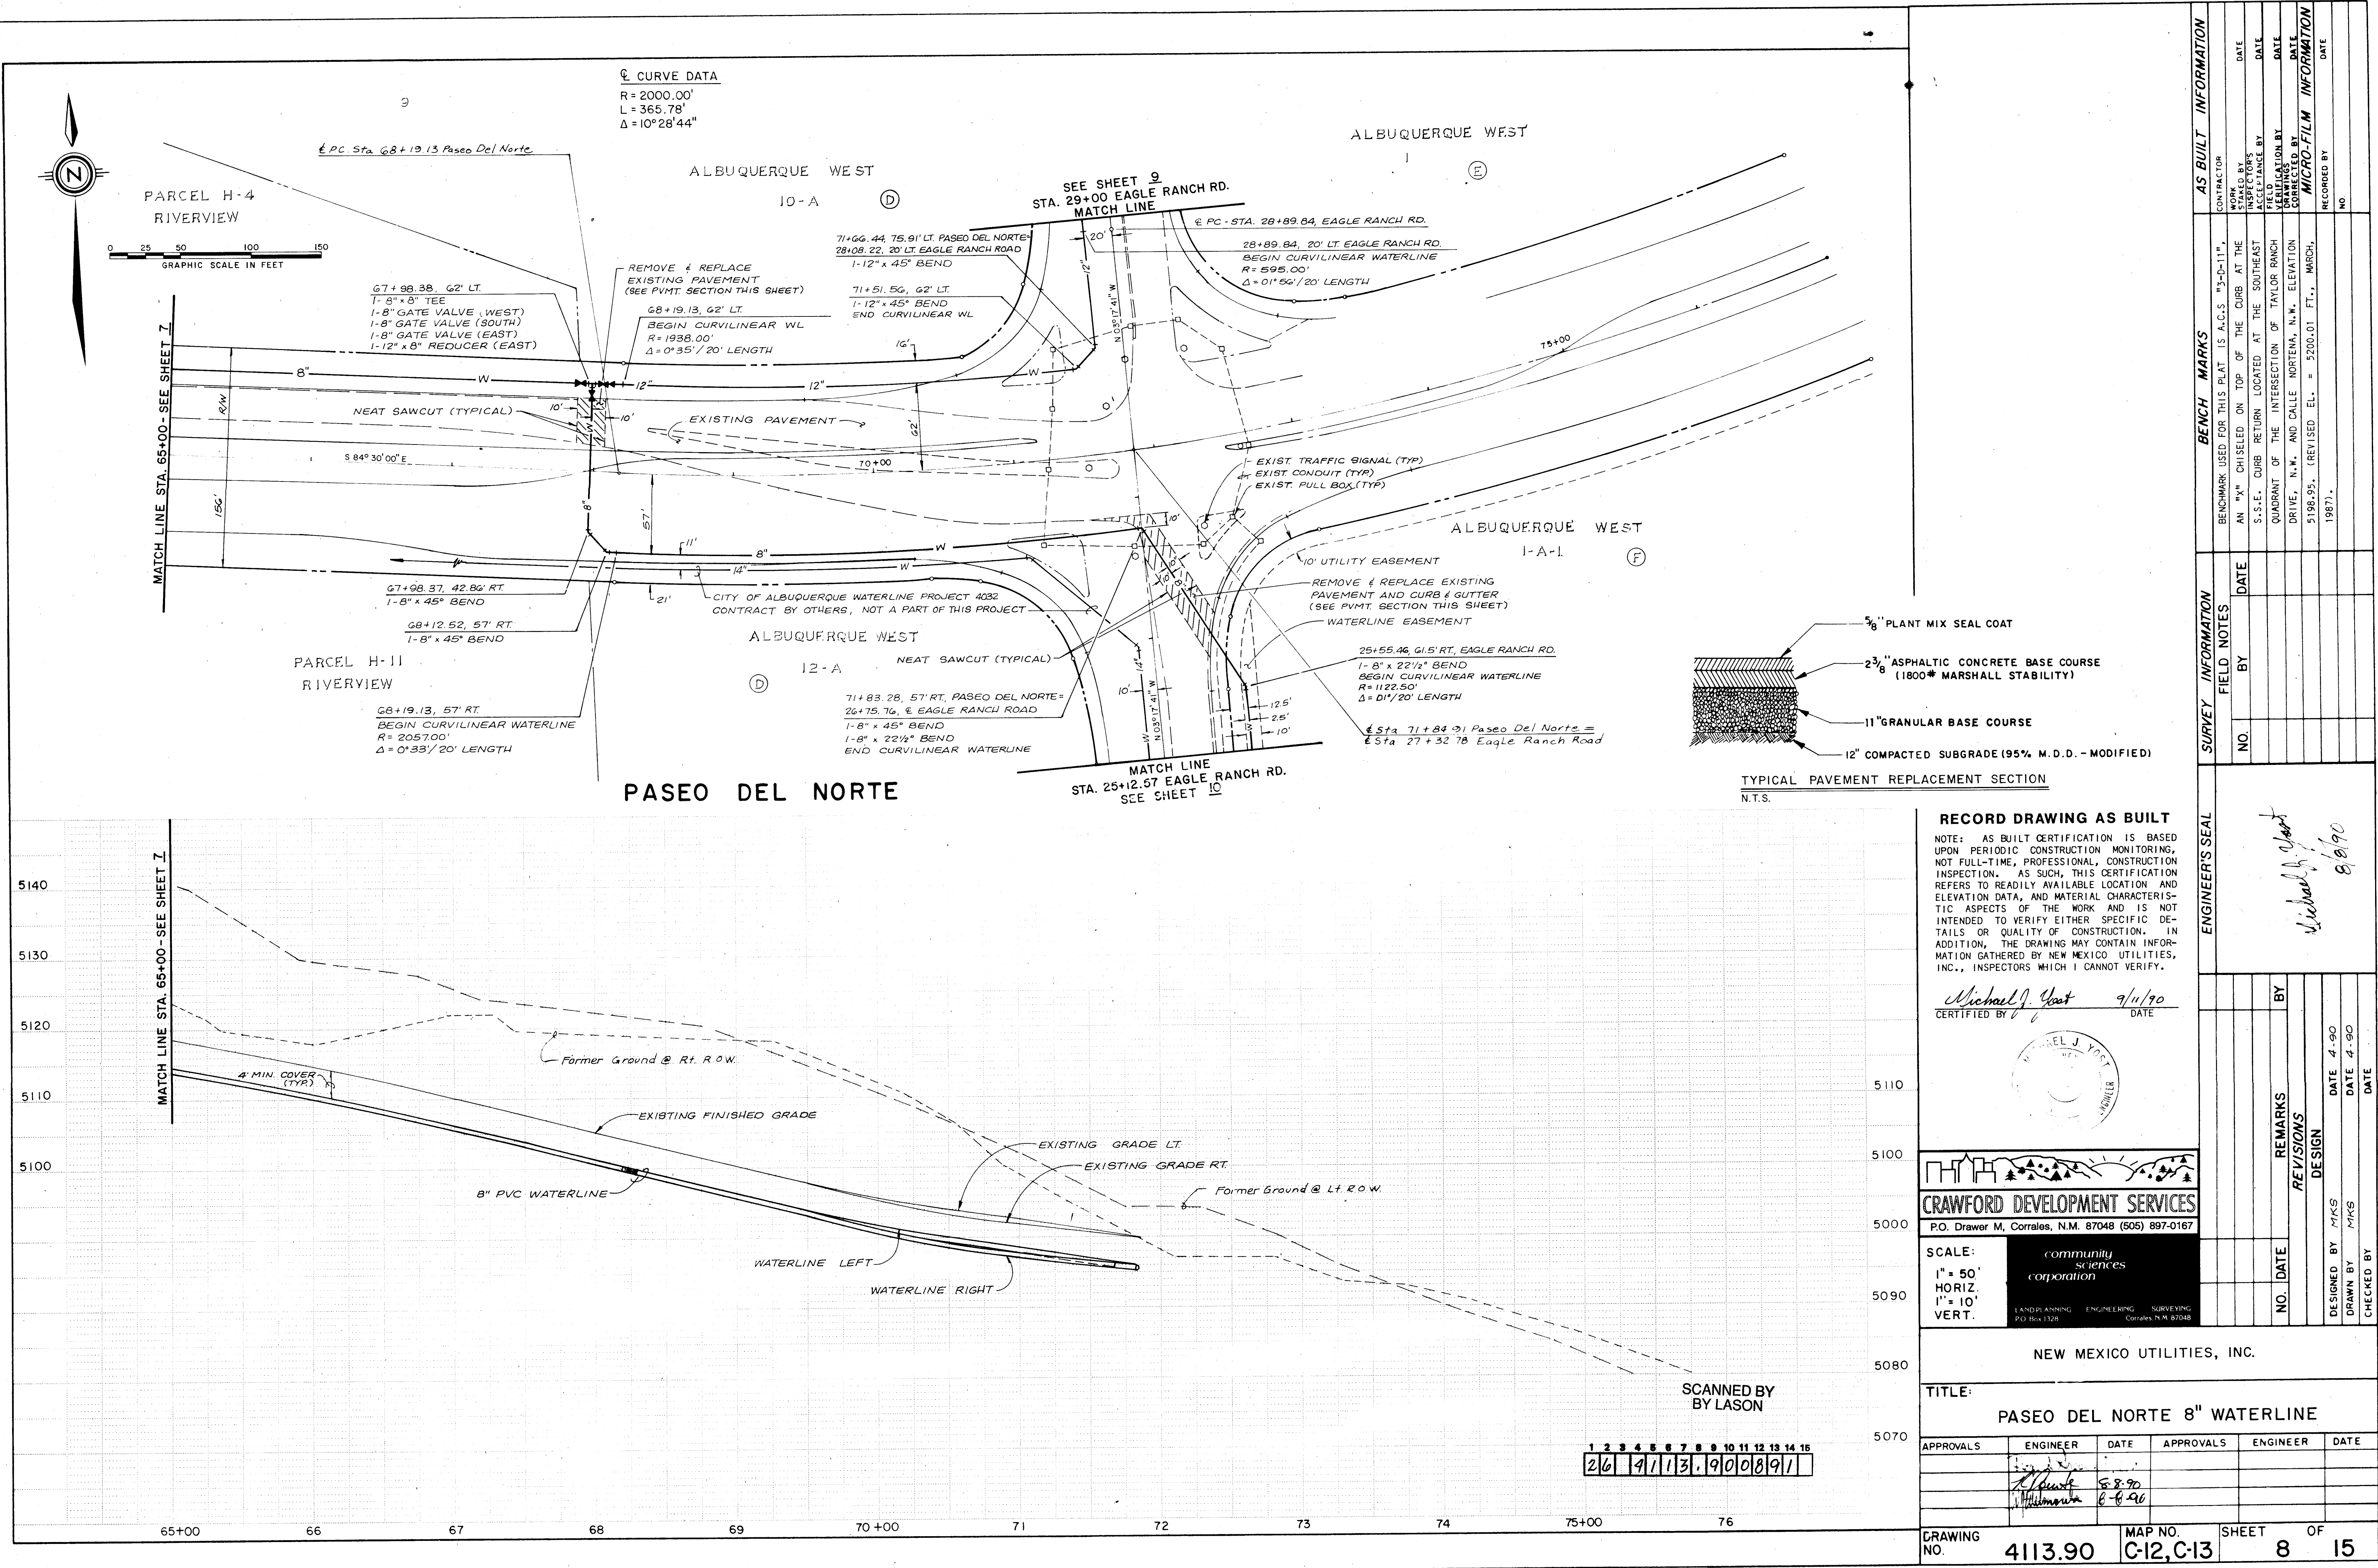

RECORD DRAWING AS BUILT

NOTE: AS BUILT CERTIFICATION IS BASED UPON PERIODIC CONSTRUCTION MONITORING, NOT FULL-TIME, PROFESSIONAL, CONSTRUCTION INSPECTION. AS SUCH, THIS CERTIFICATION REFERS TO READILY AVAILABLE LOCATION AND ELEVATION DATA, AND MATERIAL CHARACTERISTIC ASPECTS OF THE WORK AND IS NOT INTENDED TO VERIFY EITHER SPECIFIC DETAILS OR QUALITY OF CONSTRUCTION. IN ADDITION, THE DRAWING MAY CONTAIN INFORMATION GATHERED BY NEW MEXICO UTILITIES, INC., INSPECTORS WHICH I CANNOT VERIFY.

CERTIFIED BY *Michael J. Yost* 9/11/90 DATE

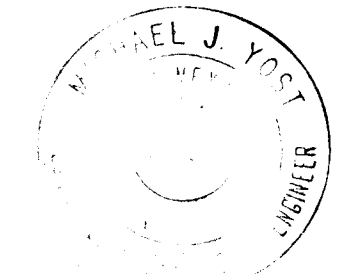

P.O. Drawer M, Corrales, N.M. 87048 (505) 897-0167


SCALE:
1" = 50'
HORIZ.
1" = 10'
VERT.

community sciences corporation
LAND PLANNING ENGINEERING SURVEYING
P.O. Box 1328 Corrales, N.M. 87048

NEW MEXICO UTILITIES, INC.

TITLE: PASEO DEL NORTE 8" WATERLINE

APPROVALS	ENGINEER	DATE	APPROVALS	ENGINEER	DATE
	<i>Michael J. Yost</i>	8-8-90			
	<i>Michael J. Yost</i>	8-6-90			

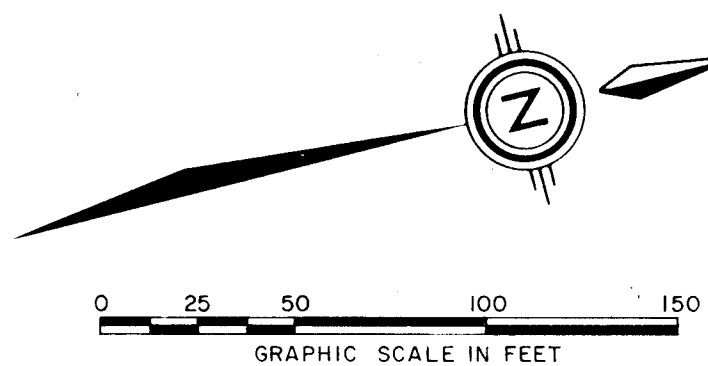

1	2	3	4	5	6	7	8	9	10	11	12	13	14	1
2	6		9	1	1	3	.	9	0	0	9	9	1	

NOTE: AS BUILT CERTIFICATION IS BASED UPON PERIODIC CONSTRUCTION MONITORING, NOT FULL-TIME, PROFESSIONAL, CONSTRUCTION INSPECTION. AS SUCH, CERTIFICATION REFERS TO READILY AVAILABLE LOCATION AND ELEVATION DATA, AND MATERIAL CHARACTERISTIC ASPECTS OF THE WORK AND IS NOT INTENDED TO VERIFY EITHER SPECIFIC DETAILS OR QUALITY OF CONSTRUCTION. IN ADDITION, THE DRAWING MAY CONTAIN INFORMATION GATHERED BY NEW MEXICO UTILITIES, INC., INSPECTORS WHICH I CANNOT VERIFY.

CRAWFORD DEVELOPMENT SERVICES
P.O. Drawer M, Corrales, N.M. 87048 (505) 897-0166



SCALE:
1" = 50'
HORIZ.
1" = 10'
VERT.

NEW MEXICO UTILITIES, INC.


TITLE: EAGLE RANCH ROAD 12" WATERLINE

APPROVALS	ENGINEER	DATE	APPROVALS	ENGINEER	DATE
	<i>[Signature]</i>	8-8-90			
	<i>[Signature]</i>	8-8-90			

DRAWING NO.	4113.90	MAP NO.	C-12.C-13	SHEET	9	OF	15
----------------	---------	---------	-----------	-------	---	----	----

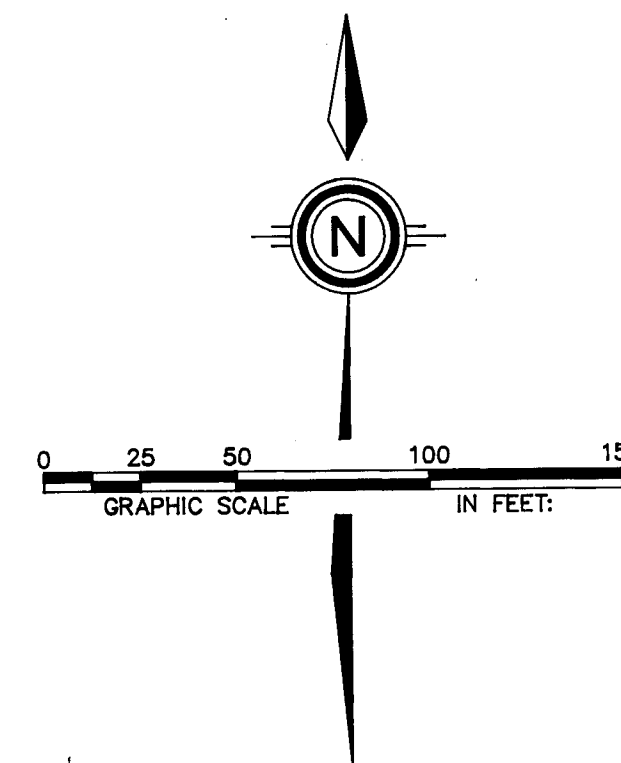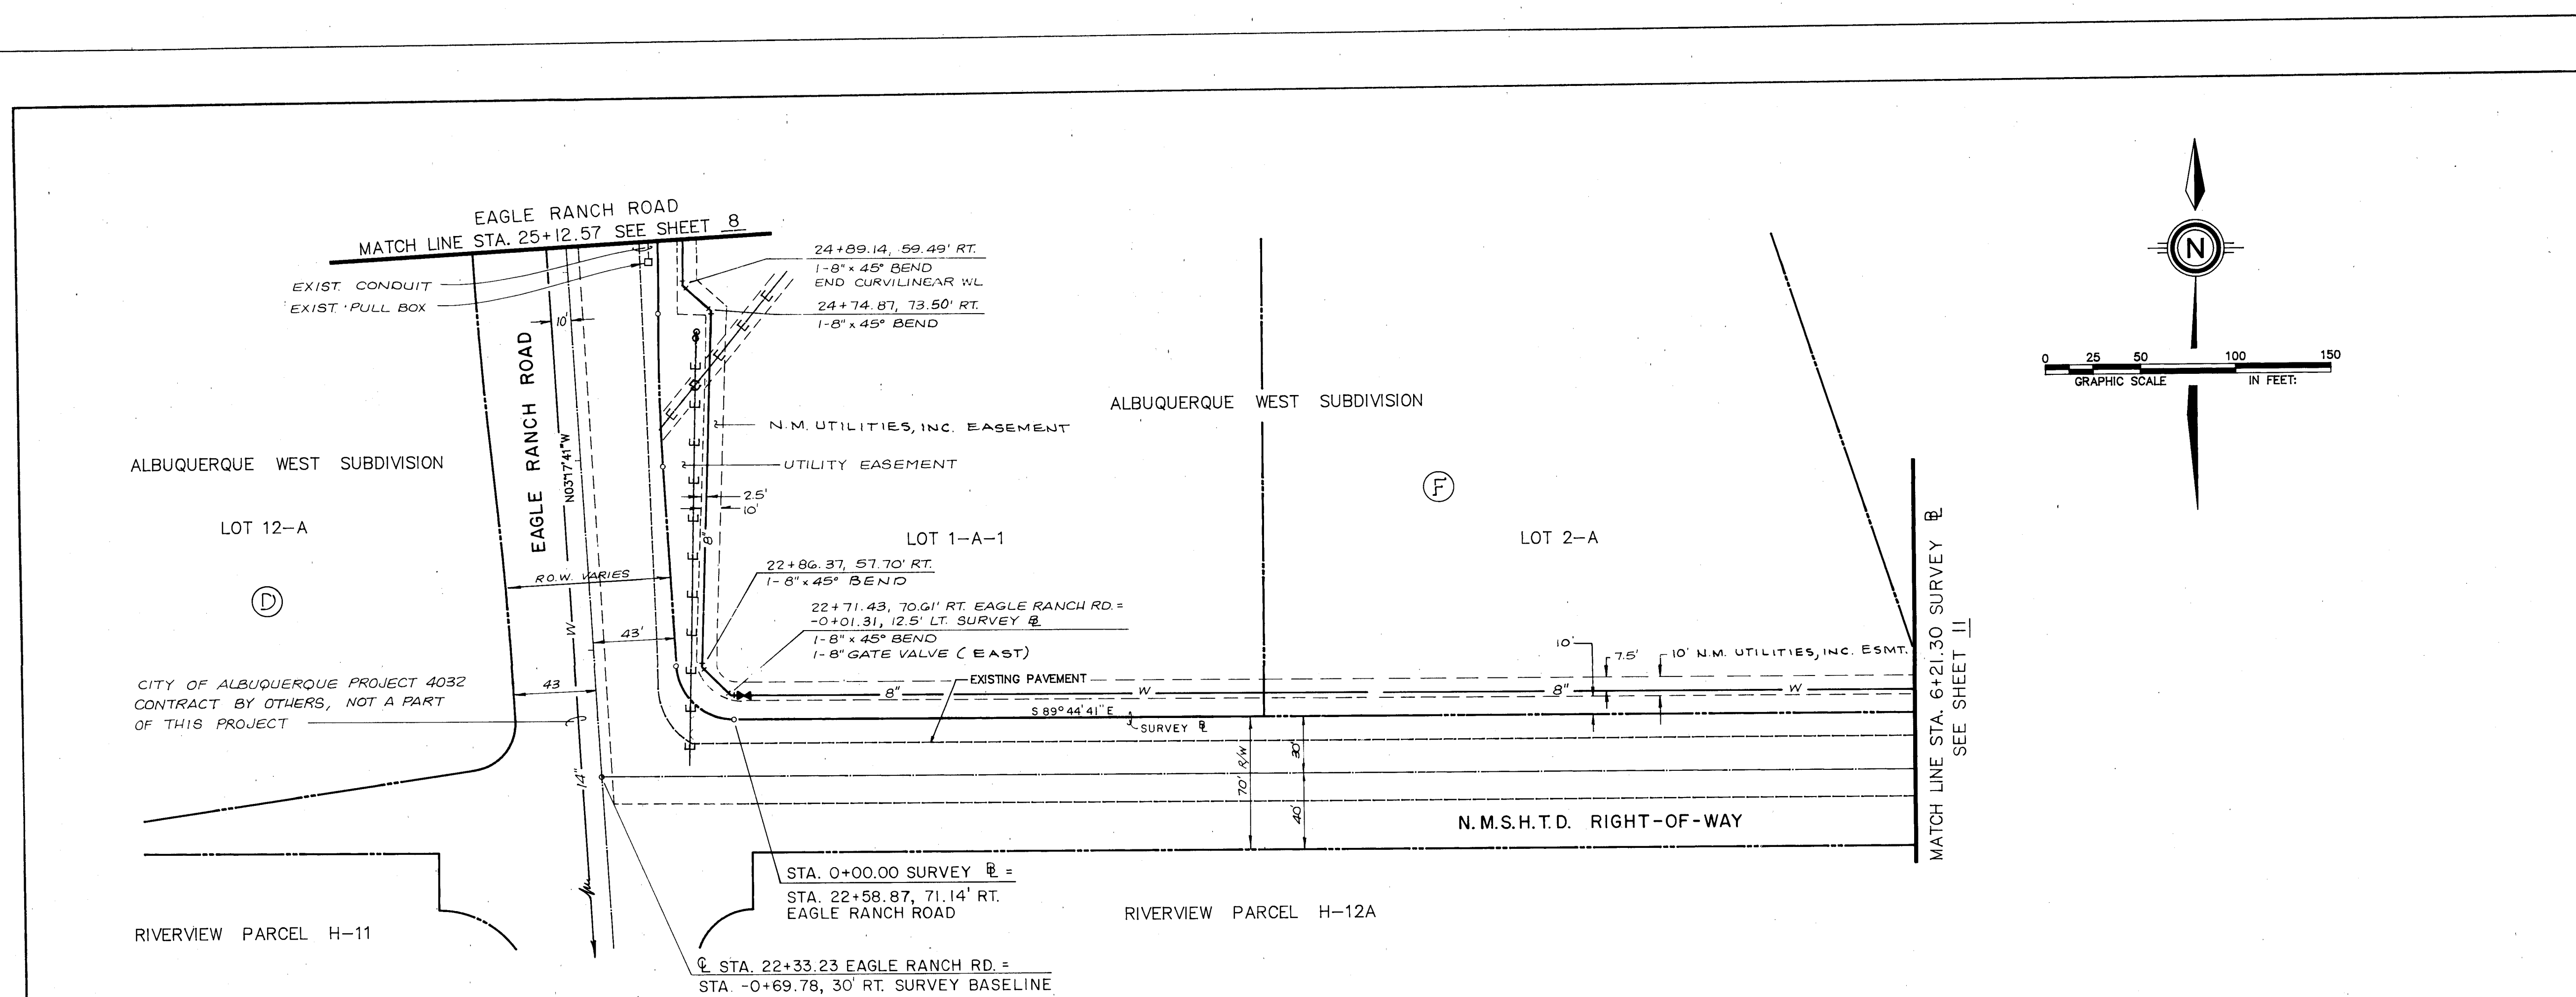

EAGLE RANCH ROAD / BLOCK F, ALBUQUERQUE WEST

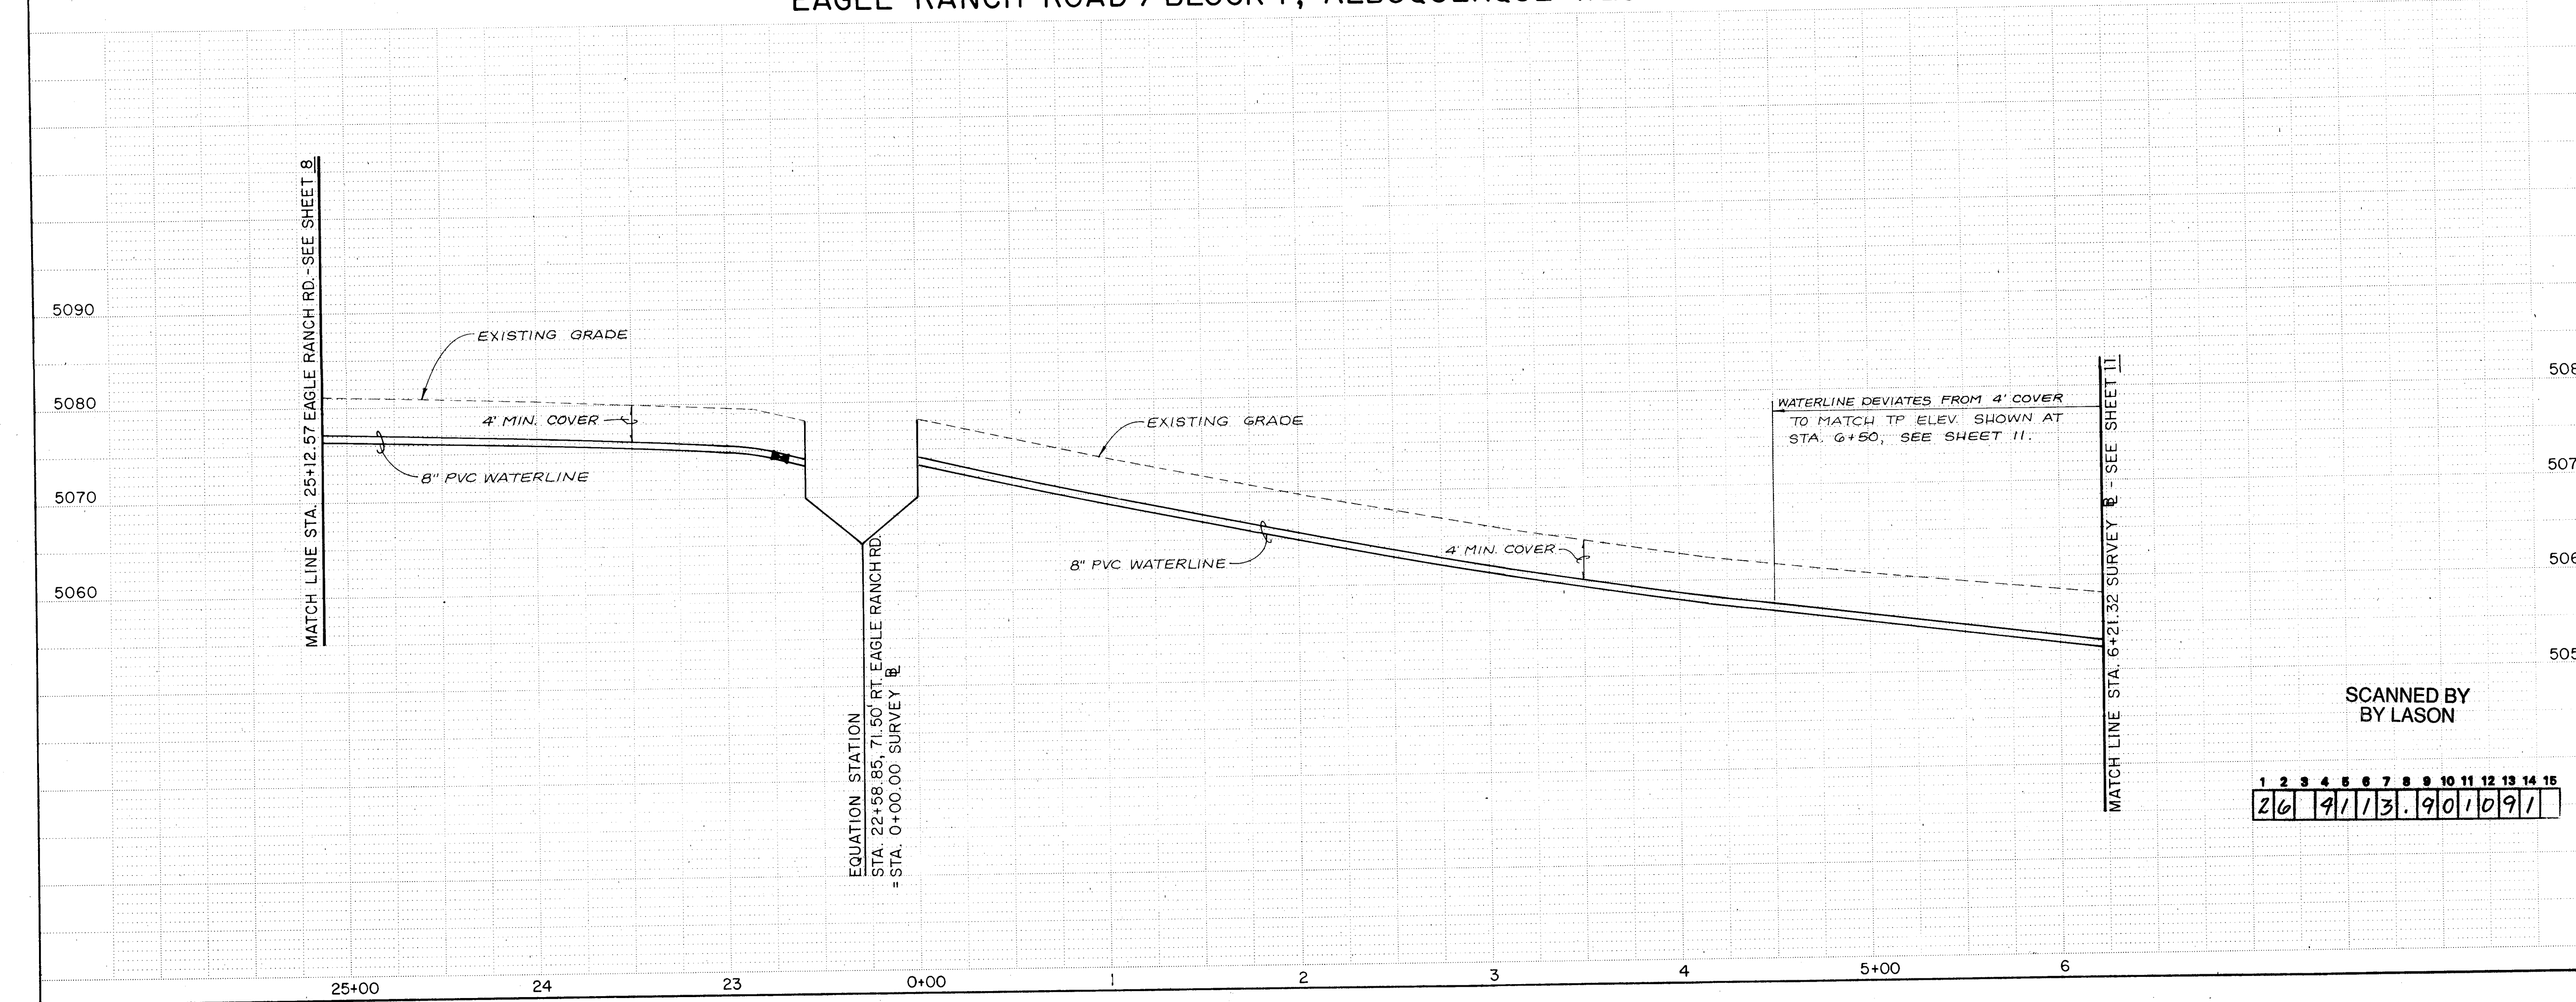


SCANNED BY
BY LASON

1 2 3 4 5 6 7 8 9 10 11 12 13 14 15
26 9113.901091

RECORD DRAWING AS BUILT
NOTE: AS BUILT CERTIFICATION IS BASED UPON PERIODIC CONSTRUCTION MONITORING, NOT FULL-TIME, PROFESSIONAL, CONSTRUCTION INSPECTION. AS SUCH, THIS CERTIFICATION REFERS TO READILY AVAILABLE LOCATION AND ELEVATION DATA, AND MATERIAL CHARACTERISTICS ASPECTS OF THE WORK AND IS NOT INTENDED TO VERIFY EITHER SPECIFIC DETAILS OR QUALITY OF CONSTRUCTION. IN ADDITION, THE DRAWING MAY CONTAIN INFORMATION GATHERED BY NEW MEXICO UTILITIES, INC., INSPECTORS WHICH I CANNOT VERIFY.

Michael J. York 9/11/90
CERTIFIED BY DATE

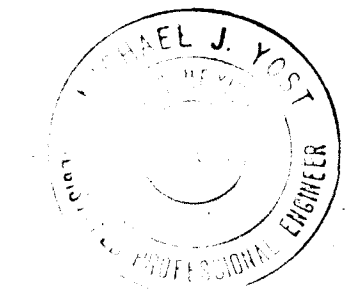



CRAWFORD DEVELOPMENT SERVICES
P.O. Drawer M, Corrales, N.M. 87048 (505) 897-0167

SCALE:
1" = 50'
HORIZ.
1" = 10'
VERT.

NEW MEXICO UTILITIES, INC.

TITLE: BLOCK F, ALBUQUERQUE WEST					
APPROVALS	ENGINEER	DATE	APPROVALS	ENGINEER	DATE
	<i>[Signature]</i>	8-8-90			
	<i>[Signature]</i>	8-8-90			
DRAWING NO.	4113.90	MAP NO.	C-12, C-13	SHEET OF	10 15

SURVEY INFORMATION		BENCH MARKS		AS BUILT INFORMATION	
NO.	BY	DATE	CONTRACTOR	CONTRACTOR	NO.
			BENCHMARK USED FOR THIS PLAT IS A.C.S. "13-11", AN "X" CHISEL ON TOP OF THE CURB AT THE S.S.E. CURB RETURN LOCATED AT THE SOUTHEAST QUADRANT OF THE INTERSECTION OF TAYLOR RANCH DRIVE, N.W. AND CALLE NORTENA, N.W. ELEVATION 5198.95. (REVISED EL. = 5200.01 FT., MARCH, 1987).		

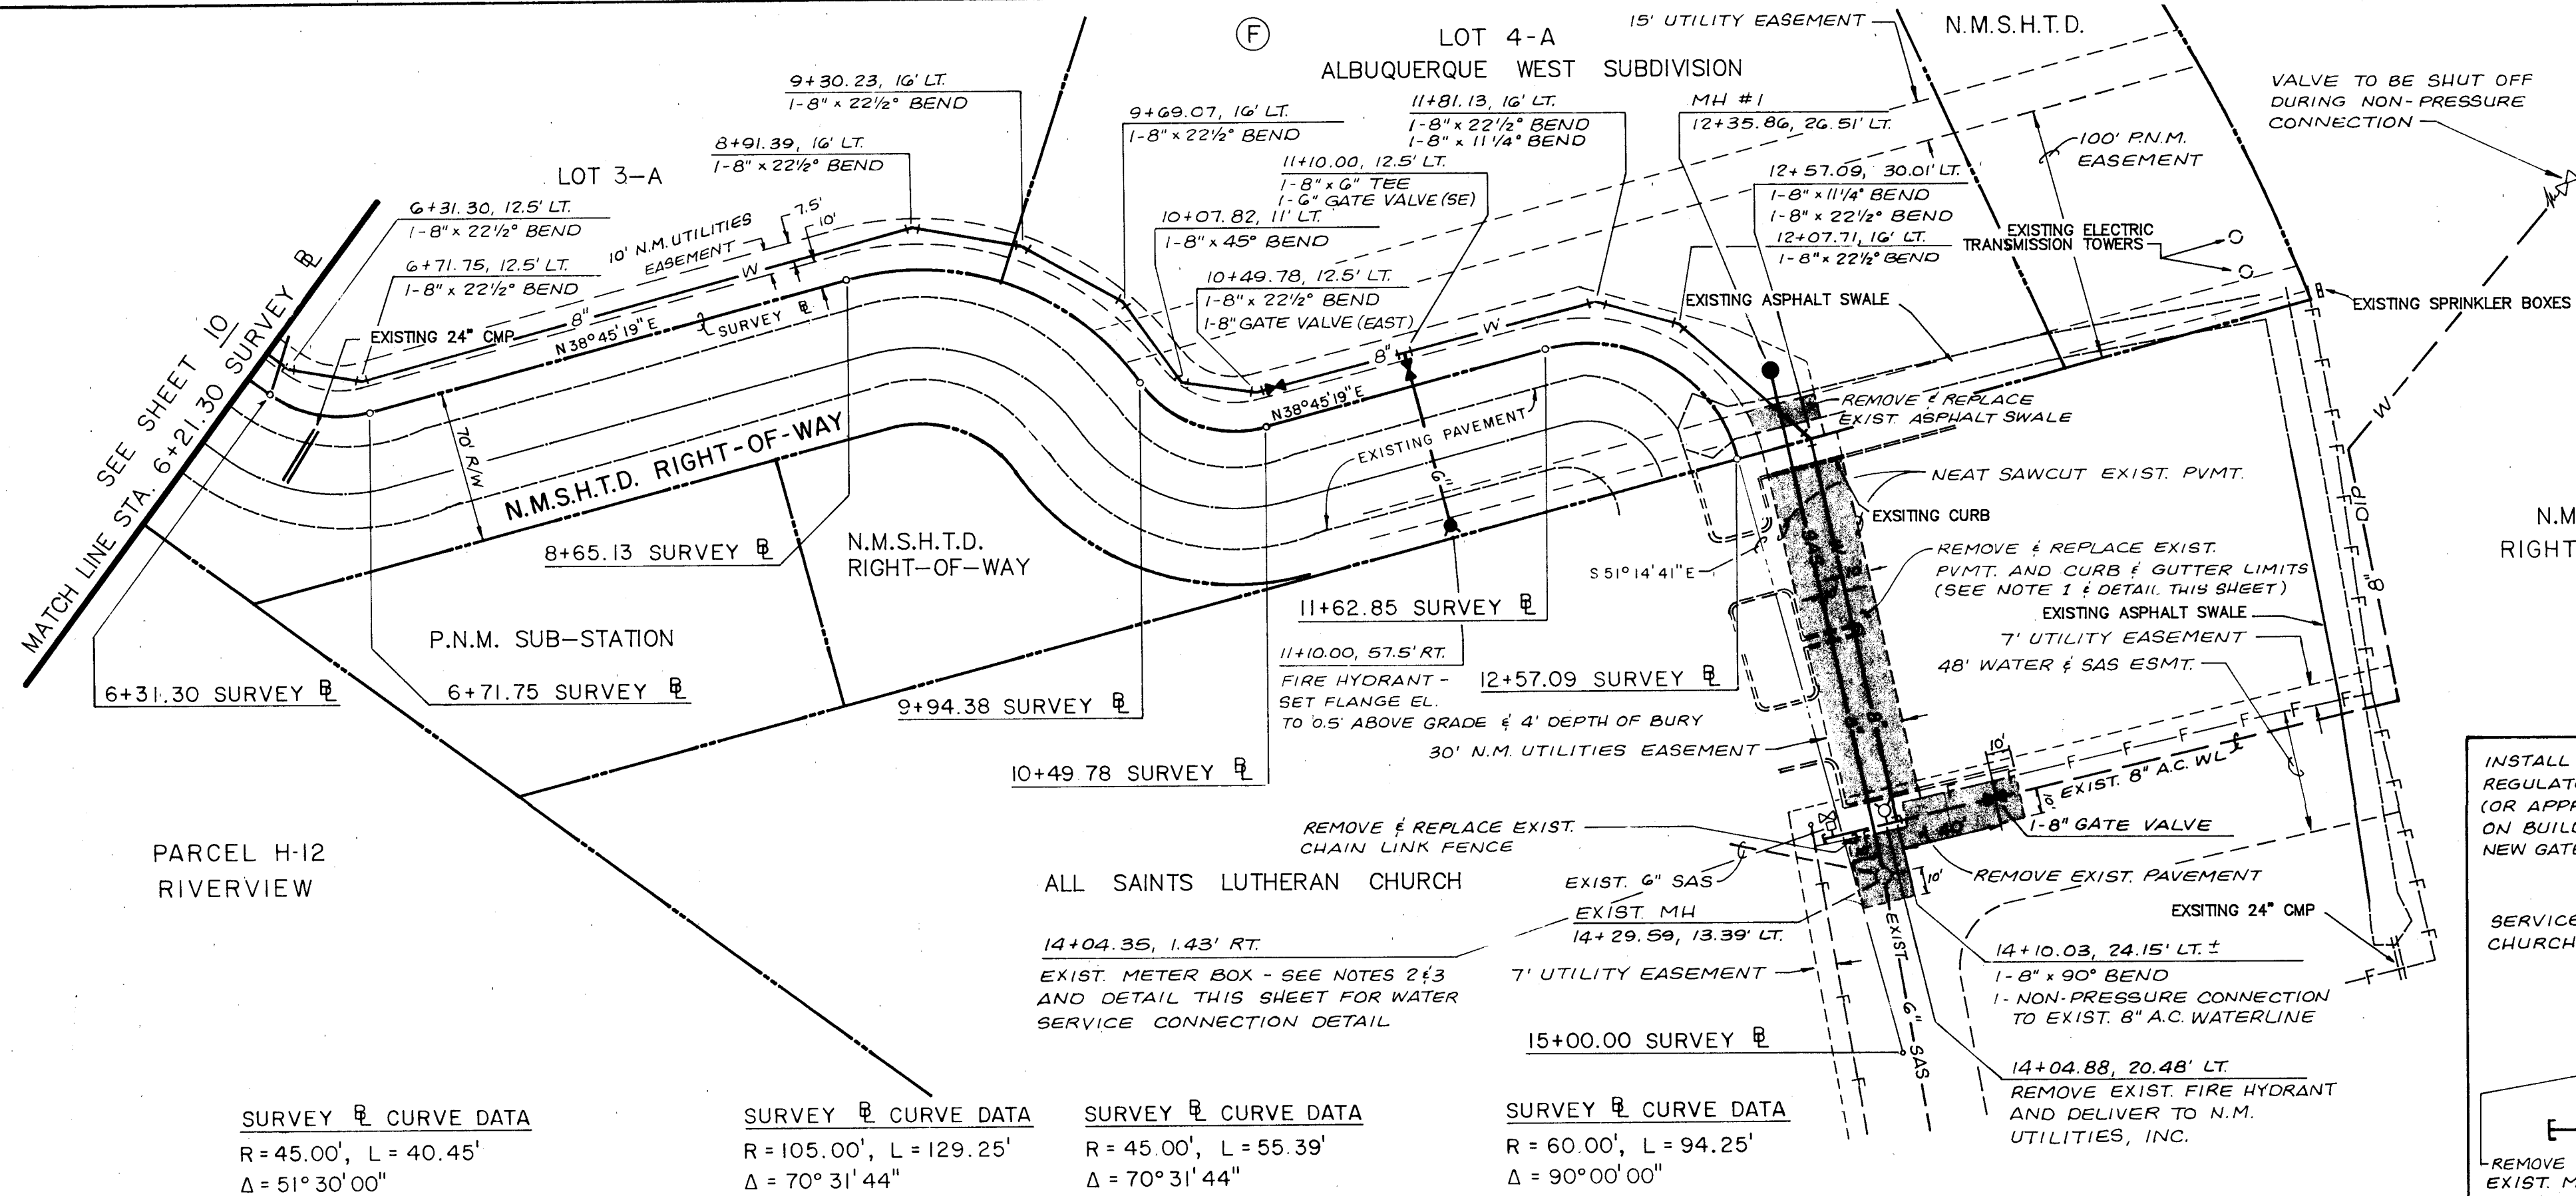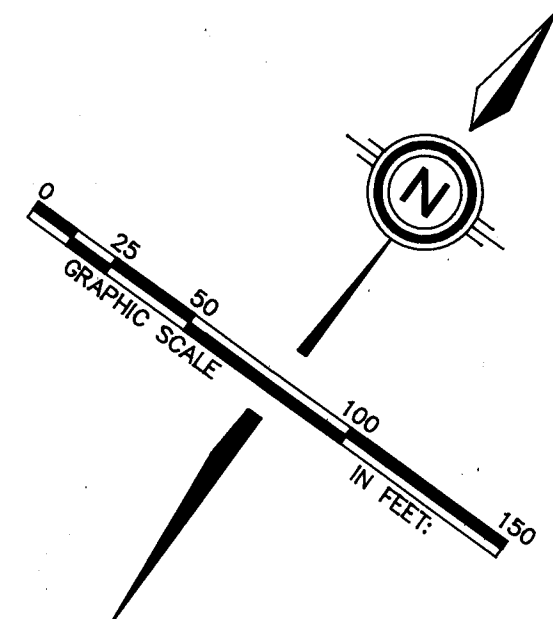

SURVEY CURVE DATA
R = 45.00', L = 40.45'
Δ = 51° 30' 00"

SURVEY CURVE DATA
R = 105.00', L = 129.25'
Δ = 70° 31' 44"

SURVEY CURVE DATA
R = 45.00', L = 55.39'
Δ = 70° 31' 44"



SURVEY CURVE DATA
R = 60.00', L = 94.25'
Δ = 90° 00' 00"

BLOCK F, ALBUQUERQUE WEST

RECORD DRAWING AS BUILT

NOTE: AS BUILT CERTIFICATION IS BASED UPON PERIODIC CONSTRUCTION MONITORING, NOT FULL-TIME, PROFESSIONAL, CONSTRUCTION INSPECTION. AS SUCH, THIS CERTIFICATION REFERS TO READILY AVAILABLE LOCATION AND ELEVATION DATA, AND MATERIAL CHARACTERISTIC ASPECTS OF THE WORK AND IS NOT INTENDED TO VERIFY EITHER SPECIFIC DETAILS OR QUALITY OF CONSTRUCTION. IN ADDITION, THE DRAWING MAY CONTAIN INFORMATION GATHERED BY NEW MEXICO UTILITIES, INC., INSPECTORS WHICH I CANNOT VERIFY.

Michael J. Yost 9/11/90
CERTIFIED BY DATE

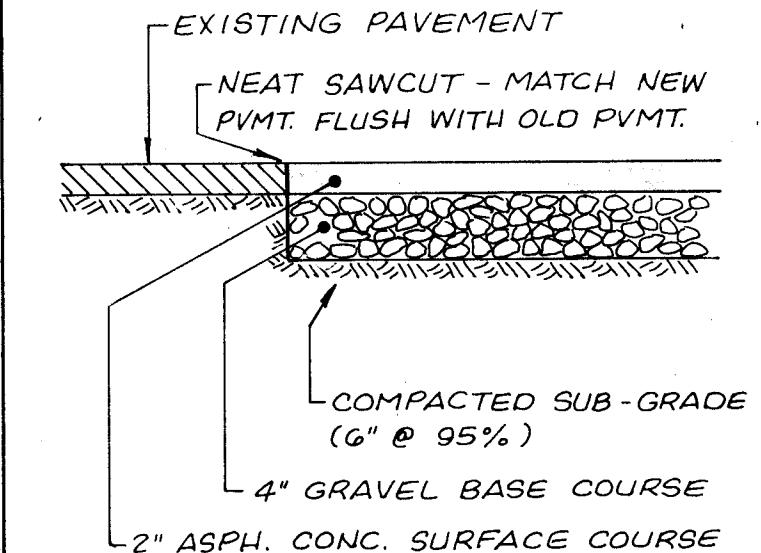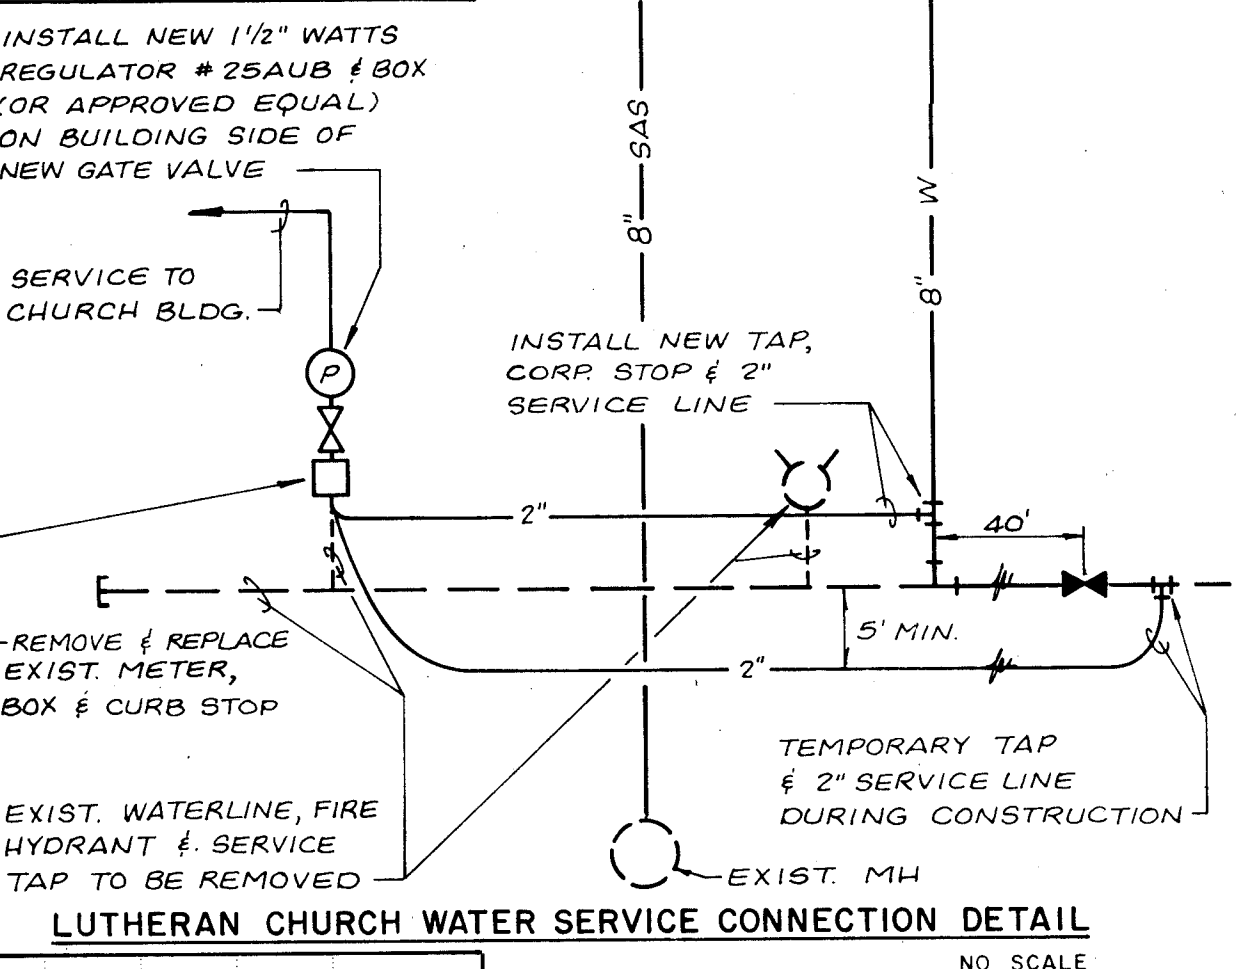

CRAWFORD DEVELOPMENT SERVICES
P.O. Drawer M, Corrales, N.M. 87048 (505) 897-0167

SCALE:
1" = 50' HORIZ.
1" = 10' VERT.

community sciences corporation

DESIGNED BY MKS
DRAWN BY MKS
CHECKED BY

NEW MEXICO UTILITIES, INC.



TITLE:
BLOCK F, ALBUQUERQUE WEST

APPROVALS	ENGINEER	DATE	APPROVALS	ENGINEER	DATE
	<i>[Signature]</i>	8-8-90			
	<i>[Signature]</i>	8-8-90			

DRAWING NO. **4113.90** MAP NO. **C-12, C-13** SHEET **11** OF **15**


AS BUILT INFORMATION			BENCH MARKS			SURVEY INFORMATION			ENGINEER'S SEAL		
CONTRACTOR	DATE	DATE	BENCHMARK USED FOR THIS PLAN IS A.C.S. "3-D-11"	DATE	DATE	NO.	BY	DATE			
INSPECTOR	DATE	DATE	AN "X" CHISELED ON TOP OF THE CURB AT THE S.S.-E. CURB RETURN LOCATED AT THE SOUTHEAST QUADRANT OF THE INTERSECTION OF TAYLOR RANCH DRIVE, N.W. AND CALLE NORTENA, N.W. ELEVATION 5198.95'. (REVISED EL. = 5200.01 FT., MARCH, 1987).	DATE	DATE	NO.	BY	DATE			
FIELD	DATE	DATE							<i>Michael J. Yost</i> 9/11/90		
REVISIONS	DATE	DATE									
DESIGN	DATE	DATE							REMARKS		
DATE	DATE	DATE									
NO.	DATE	DATE							DESIGNED BY MKS DRAWN BY MKS CHECKED BY		

107819

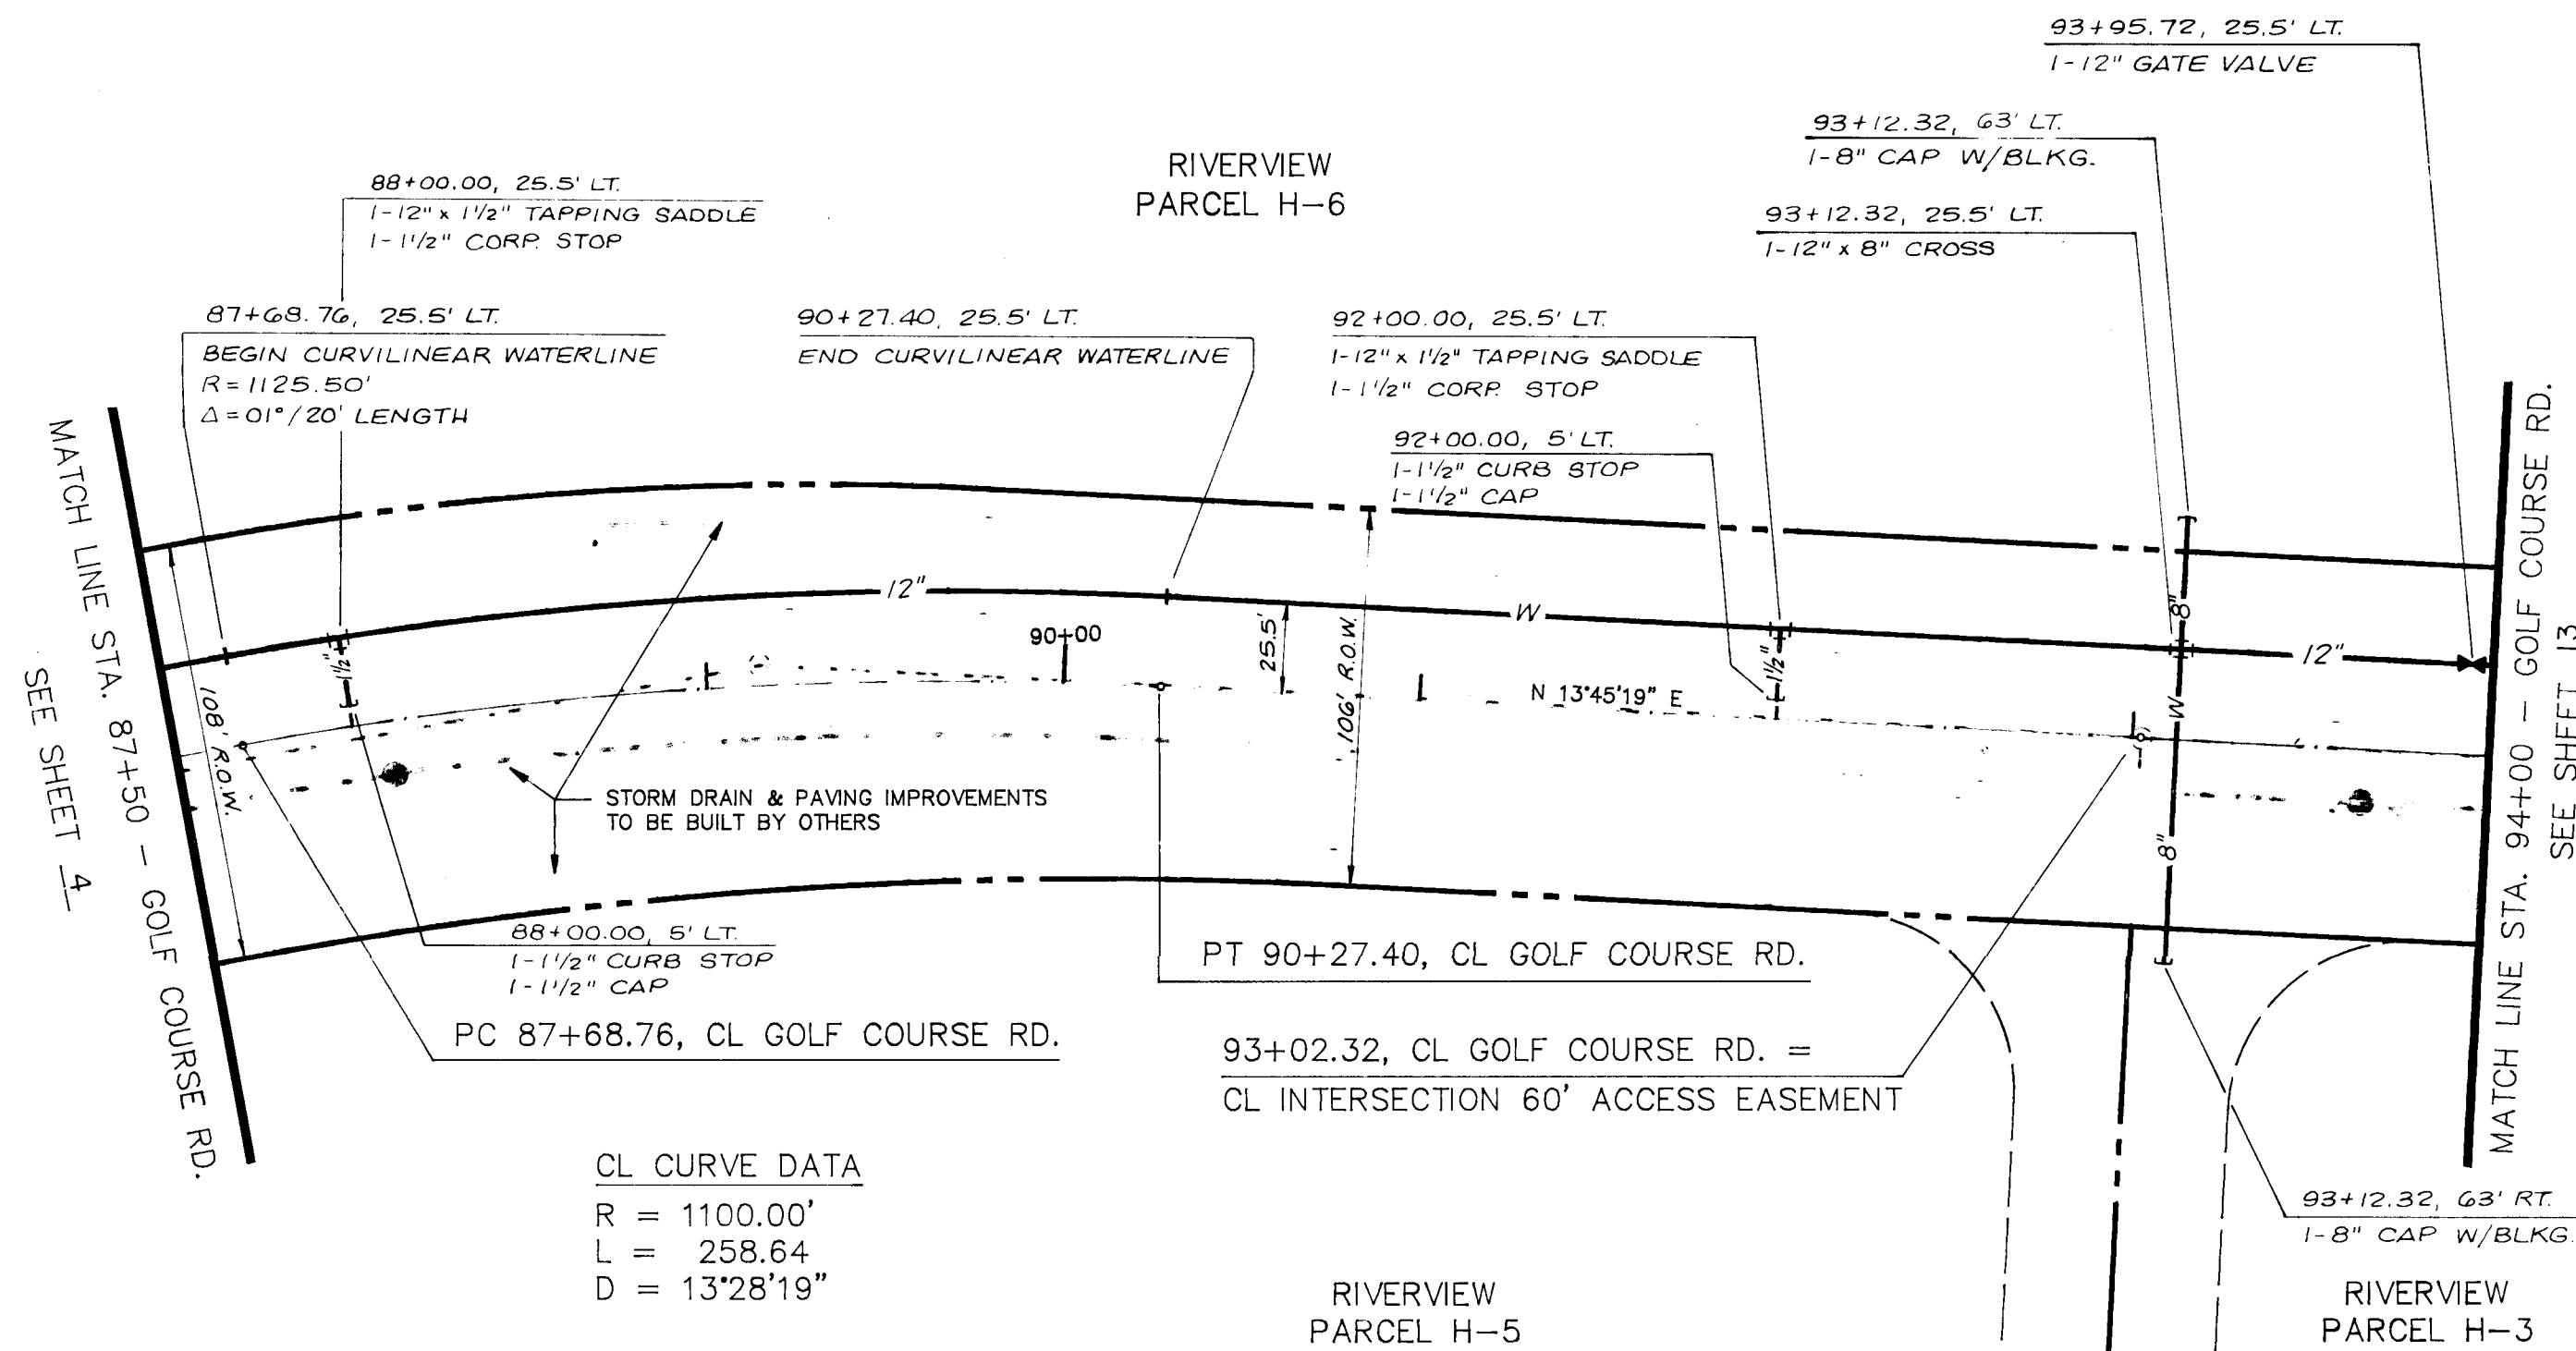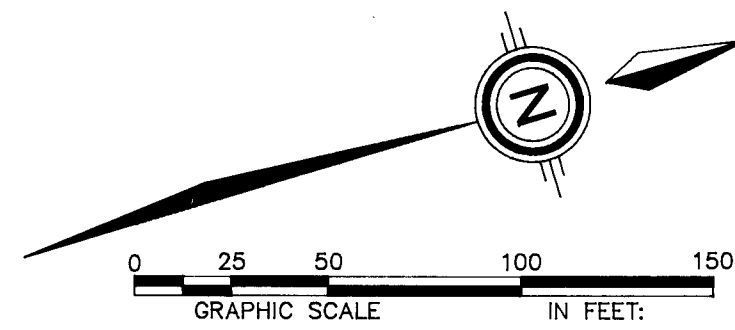

CL CURVE DATA
R = 1100.00'
L = 258.64
D = 13°28'19"

GOLF COURSE ROAD

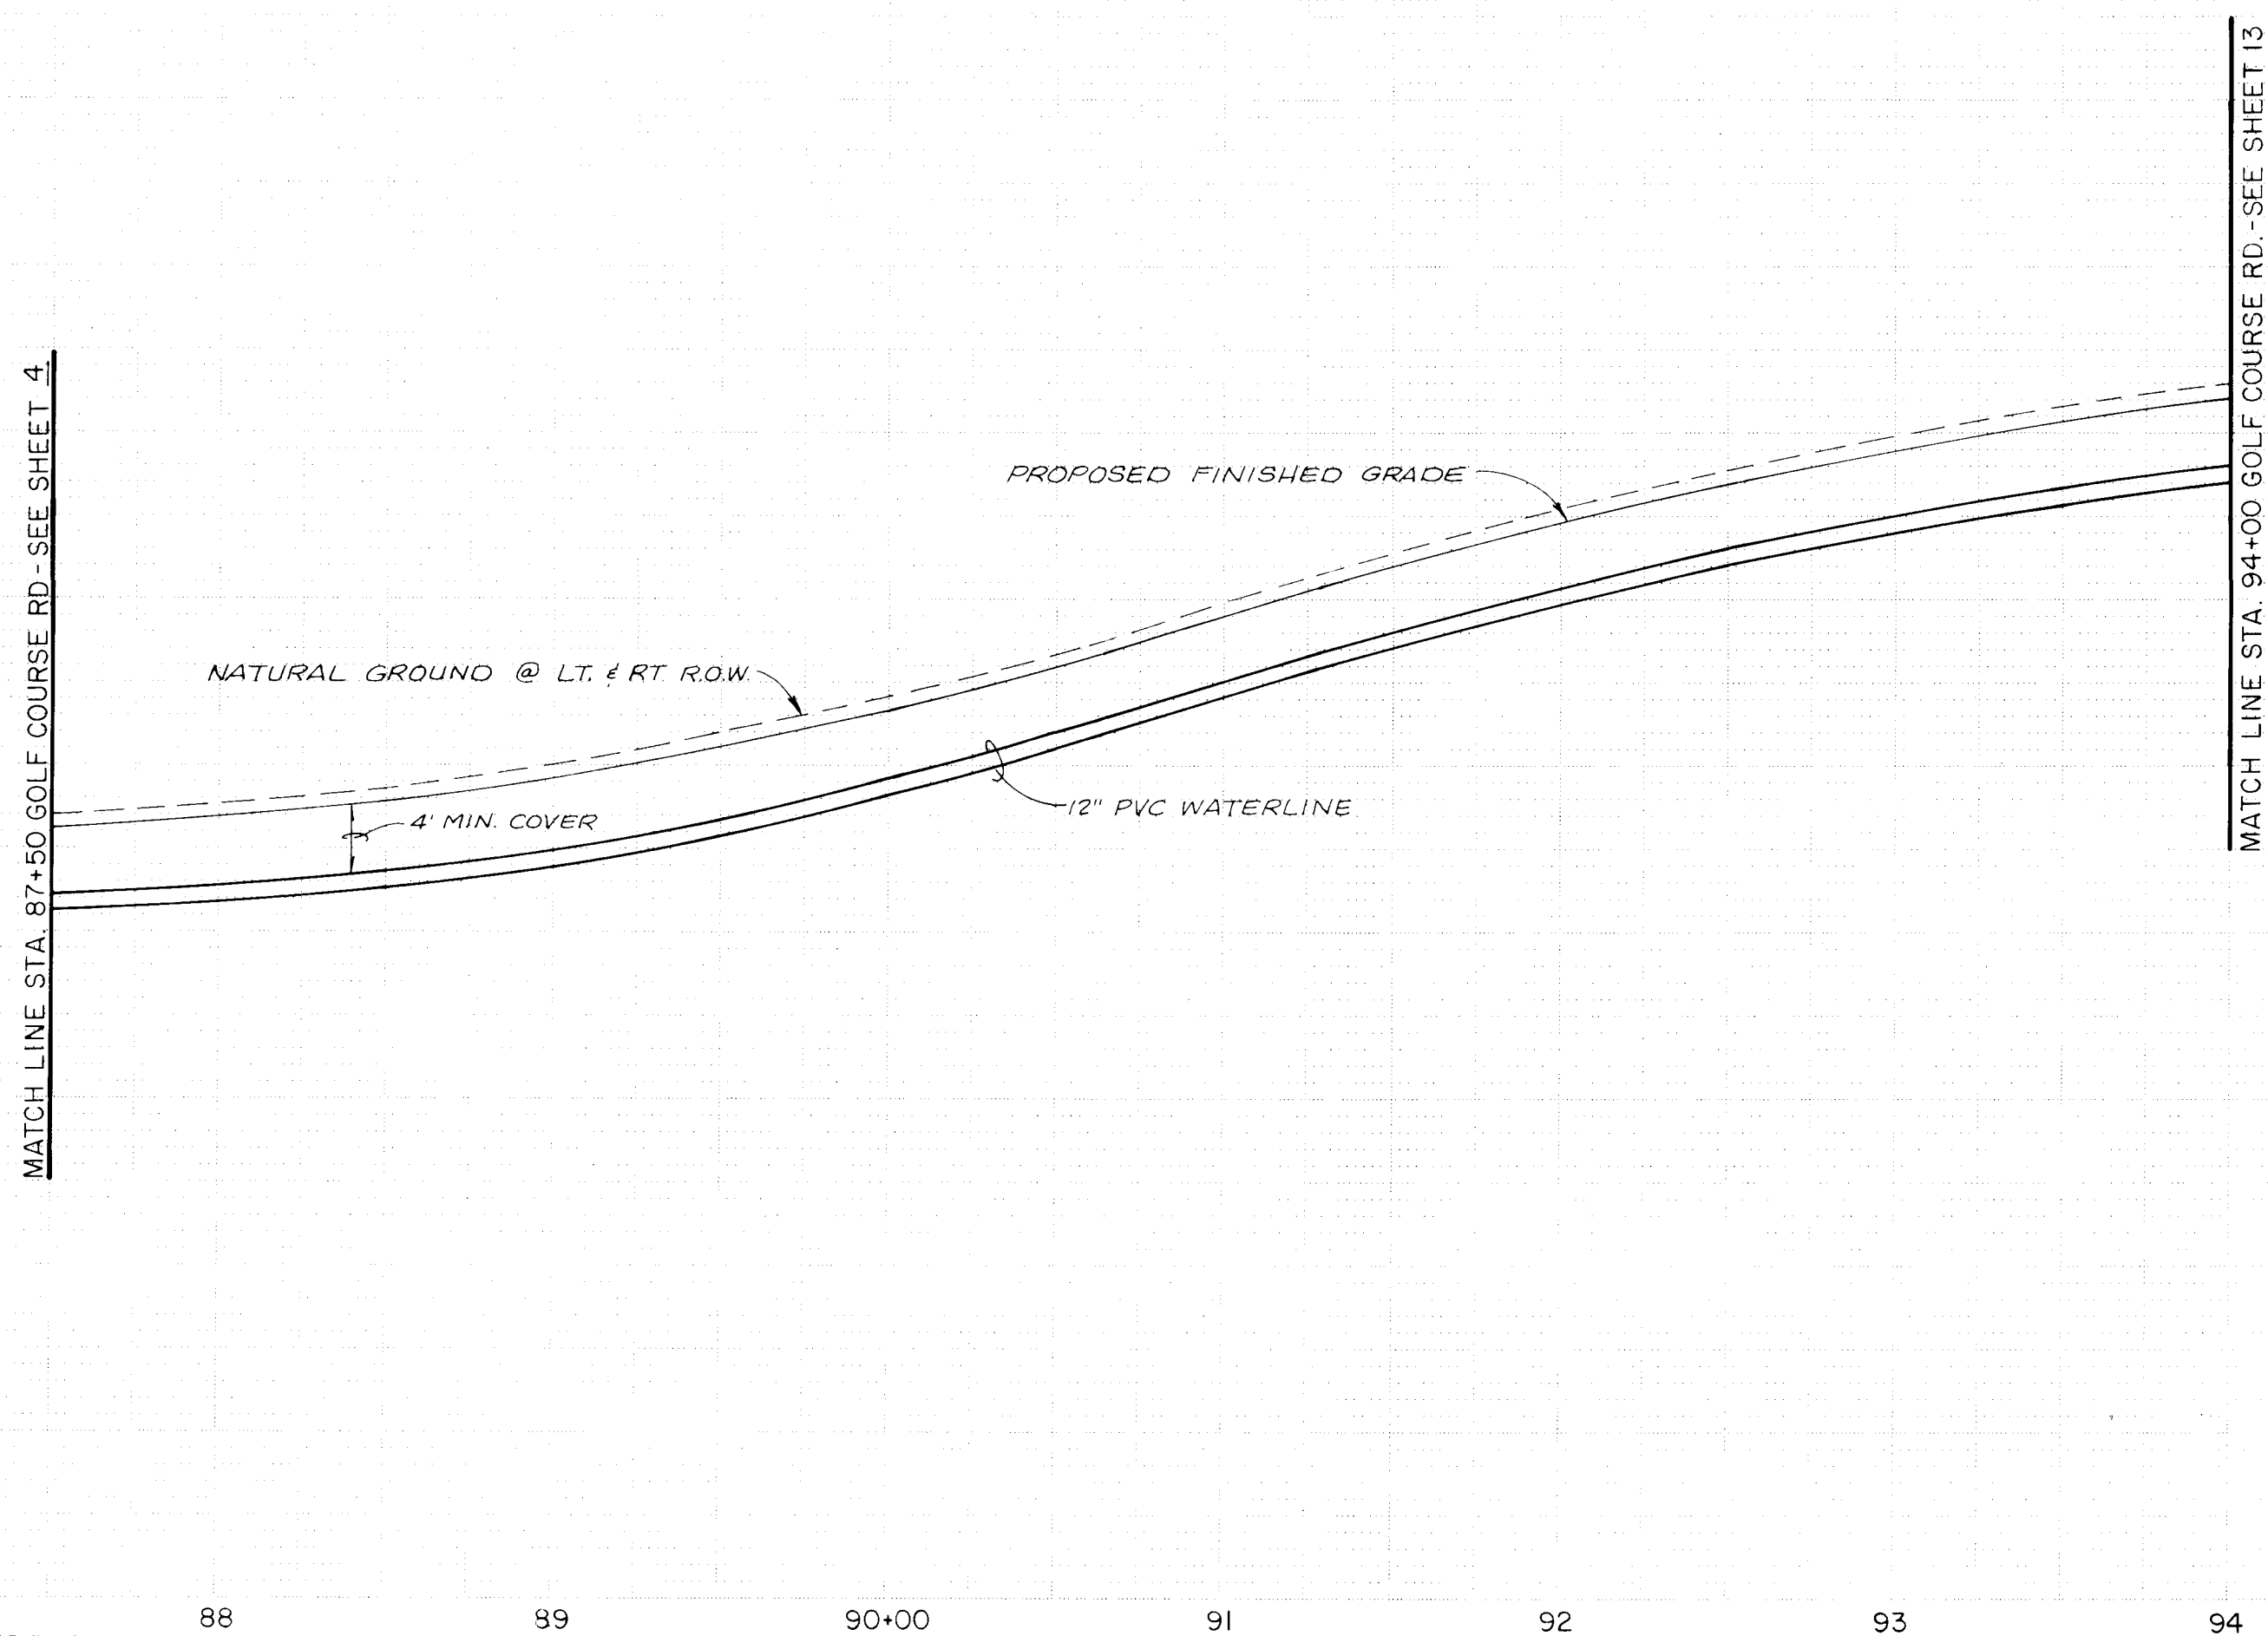

SCANNED BY
BY LASON

1 2 3 4 5 6 7 8 9 10 11 12
12/13/2013

FOR INFORMATION ONLY



CRAWFORD DEVELOPMENT SERVICES
P.O. Drawer M, Corrales, N.M. 87048 (505) 897-0167

SCALE:
1" = 50'
HORIZ.
1" = 10'
VERT.

community sciences corporation
LAND PLANNING ENGINEERING SURVEYING
P.O. Box 1328 Corrales, N.M. 87048

NEW MEXICO UTILITIES, INC.

TITLE:
GOLF COURSE ROAD 12" WATERLINE

APPROVALS	ENGINEER	DATE	APPROVALS	ENGINEER	DATE

DRAWING NO. MAP NO. SHEET 12 OF 15

ENGINEER'S SEAL			SURVEY INFORMATION		BENCH MARKS		AS BUILT INFORMATION	
			FIELD NOTES					
			NO.	BY				
							CONTRACTOR	
							WORK & BY	
							INSPECTOR'S	
							DATE	
							ACCEPTANCE BY	
							DATE	
							FIELD	
							DRAWING	
							BY	
							DATE	
							DRAWINGS	
							DATE	
							CORRECTED BY	
							DATE	
							MICRO-FILM INFORMATION	
							DATE	
							RECORDED BY	
							DATE	
							NO	
							DATE	

DESIGNED BY		CSC	DATE	4-90
DRAWN BY		MKS	DATE	4-90
CHECKED BY			DATE	

SHEET		12	OF	15
-------	--	----	----	----



BY LASON

1	2	3	4	5	6	7	8	9	10	11	12
26	4	1	3					90	3	9	1

[illegible]

FOR INFORMATION ONLY



CRAWFORD DEVELOPMENT SERVICES
P.O. Drawer M, Corrales, N.M. 87048 (505) 897-0167

SCALE:
1" = 50'
HORIZ.
1" = 10'
VERT.

community
sciences
corporation

LAND PLANNING ENGINEERING SURVEYING
P.O. Box 1328 Corrales, N.M. 87048

NEW MEXICO UTILITIES, INC.

TITLE: GOLF COURSE ROAD 12" WATERLINE

APPROVALS	ENGINEER	DATE	APPROVALS	ENGINEER	DATE

DRAWING NO.	MAP NO.	SHEET 13 OF 15
----------------	---------	------------------------------

