

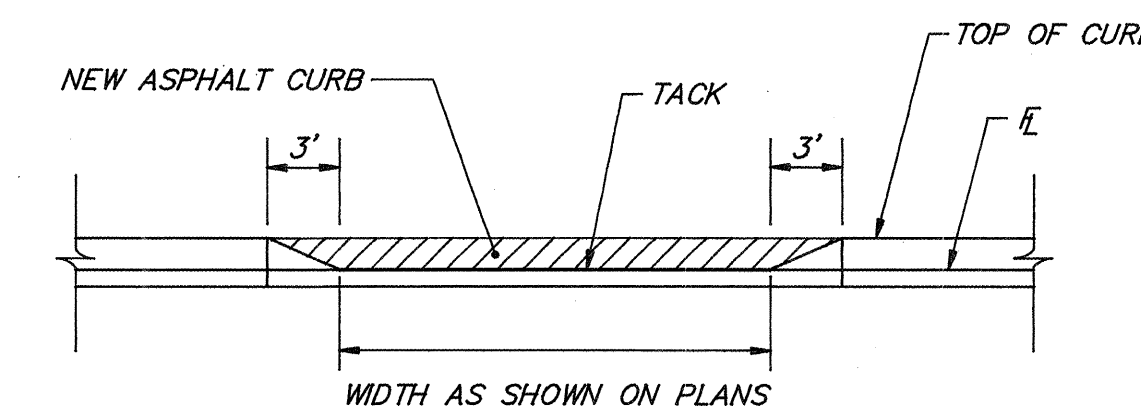
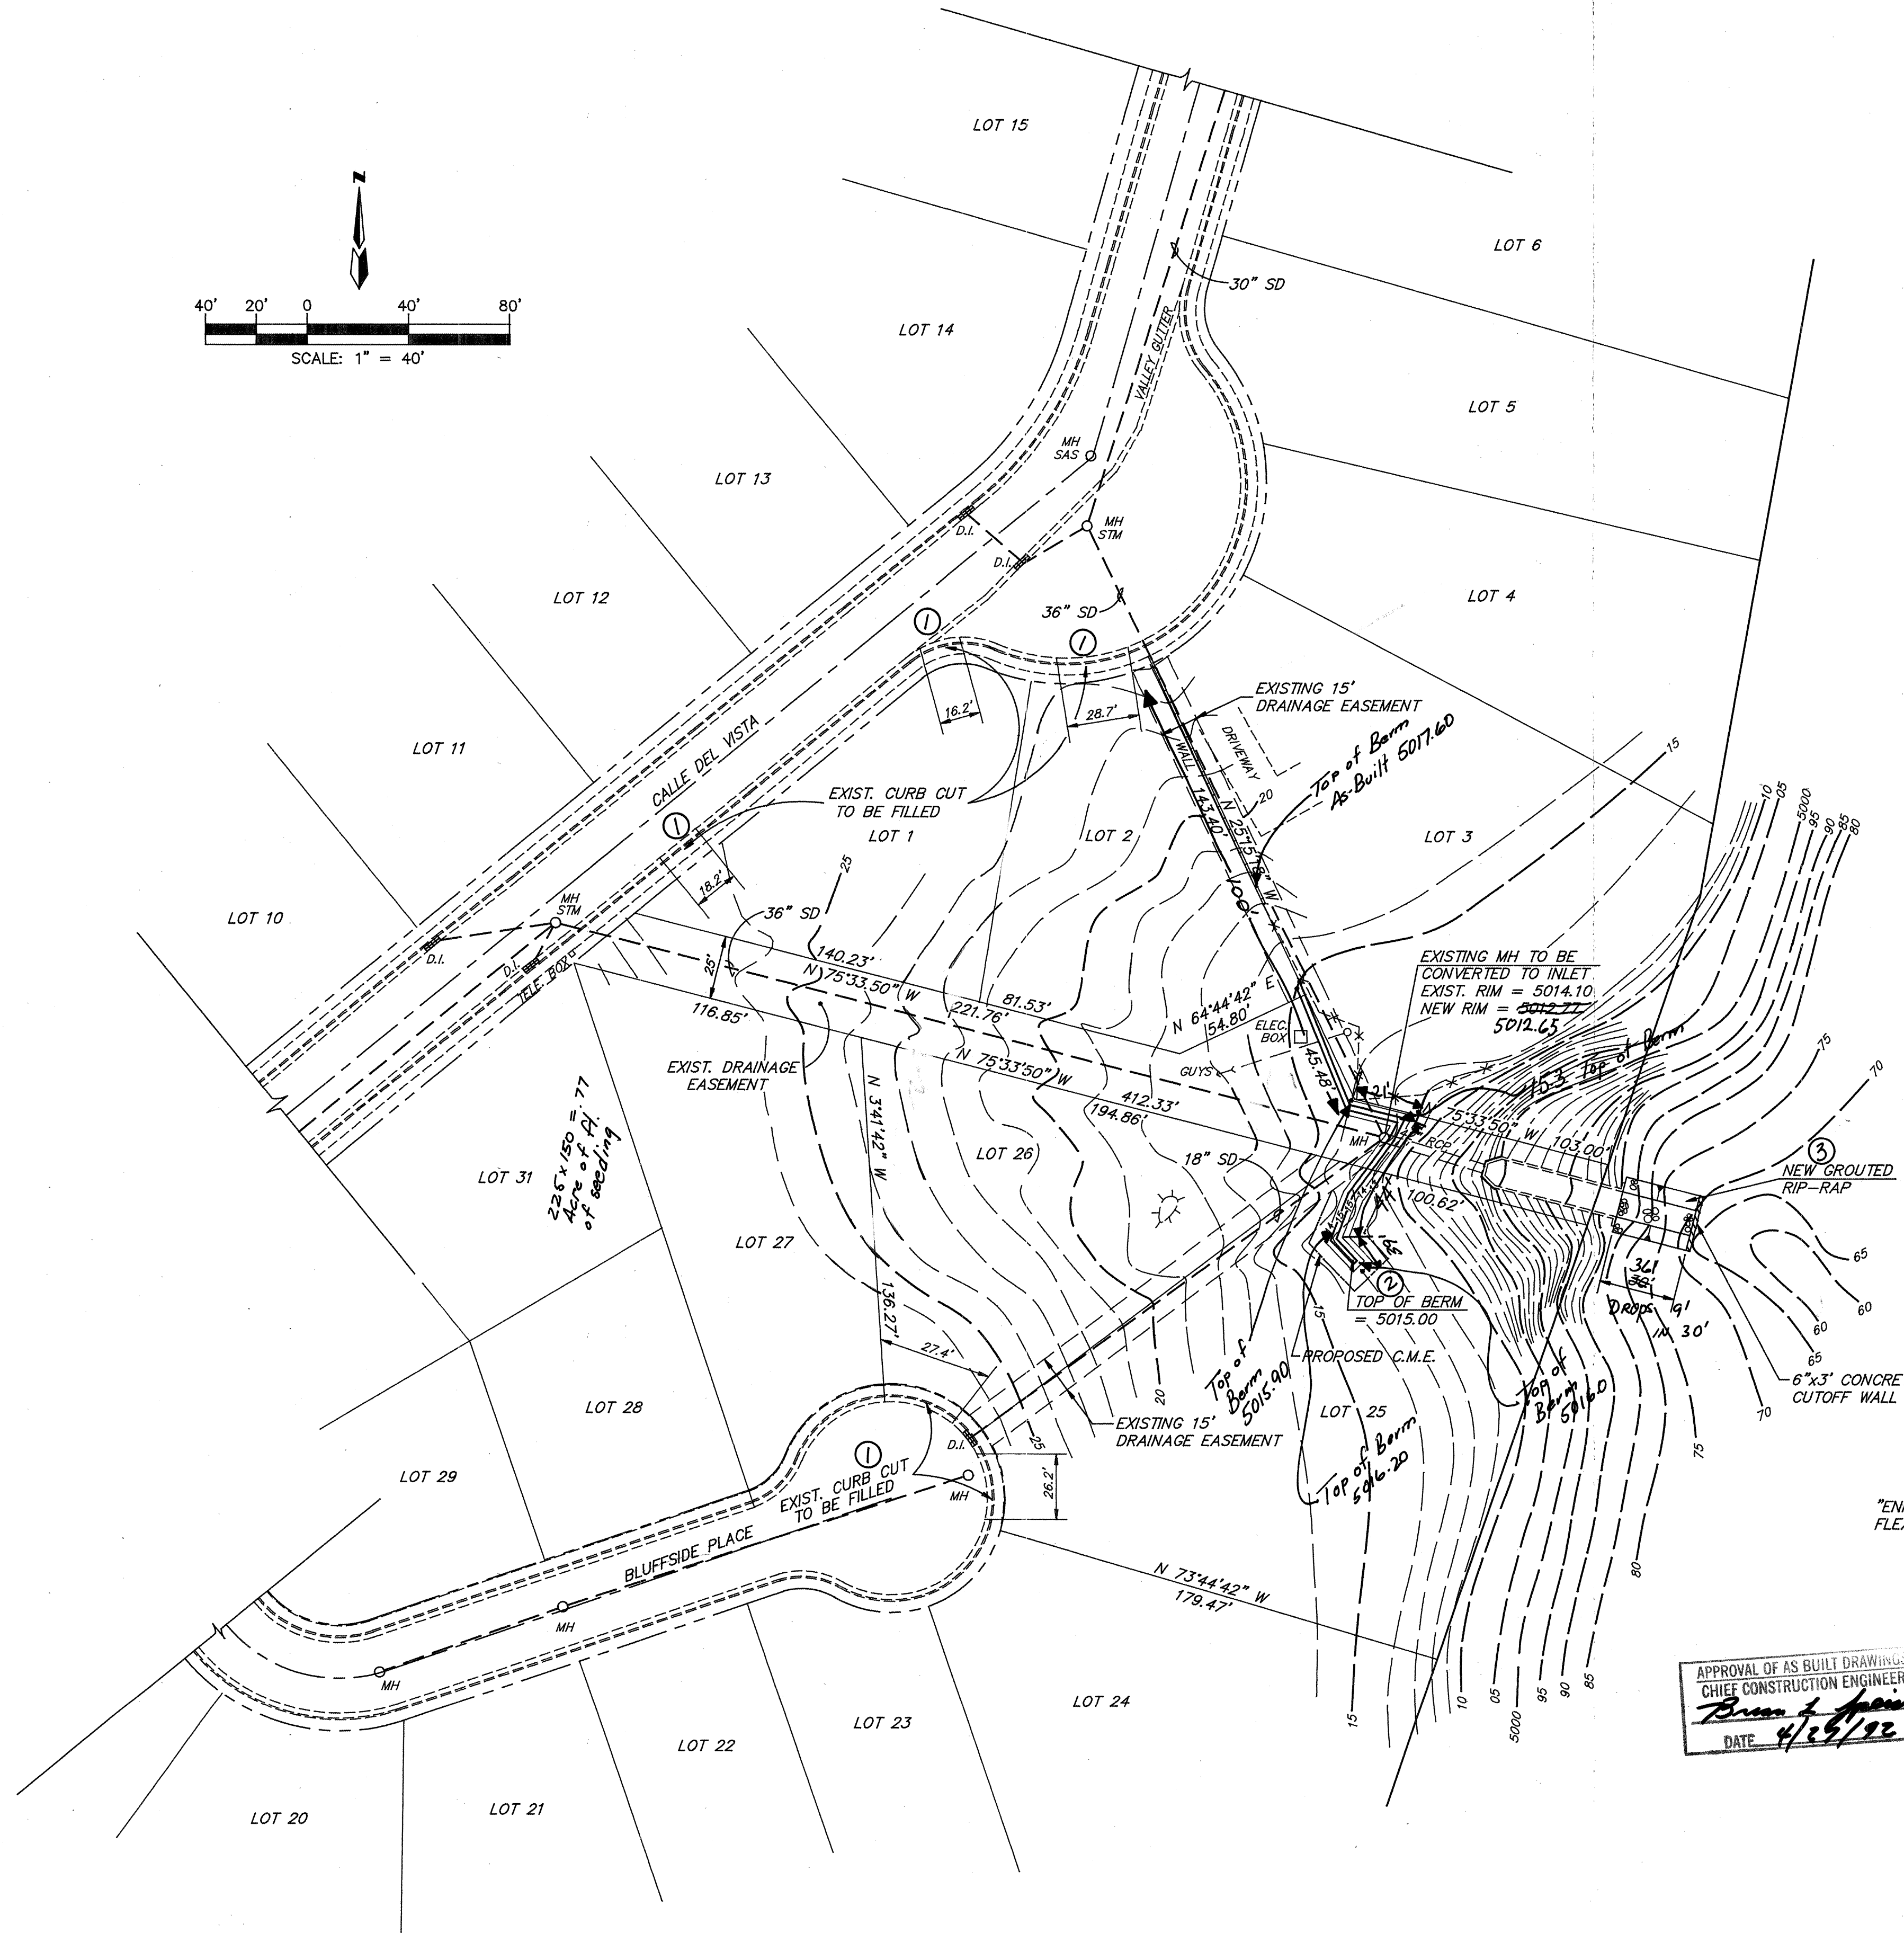


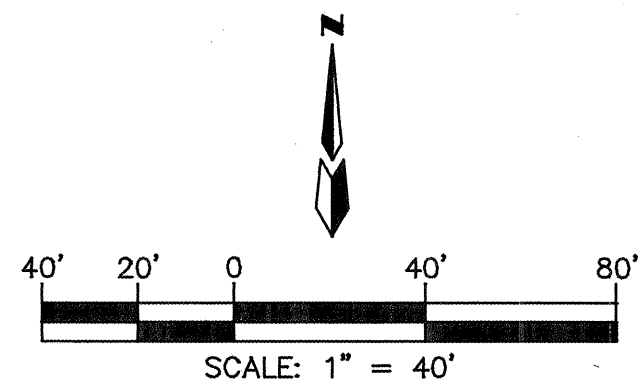


① CURB CUT FILLER DETAIL

N.T.S.

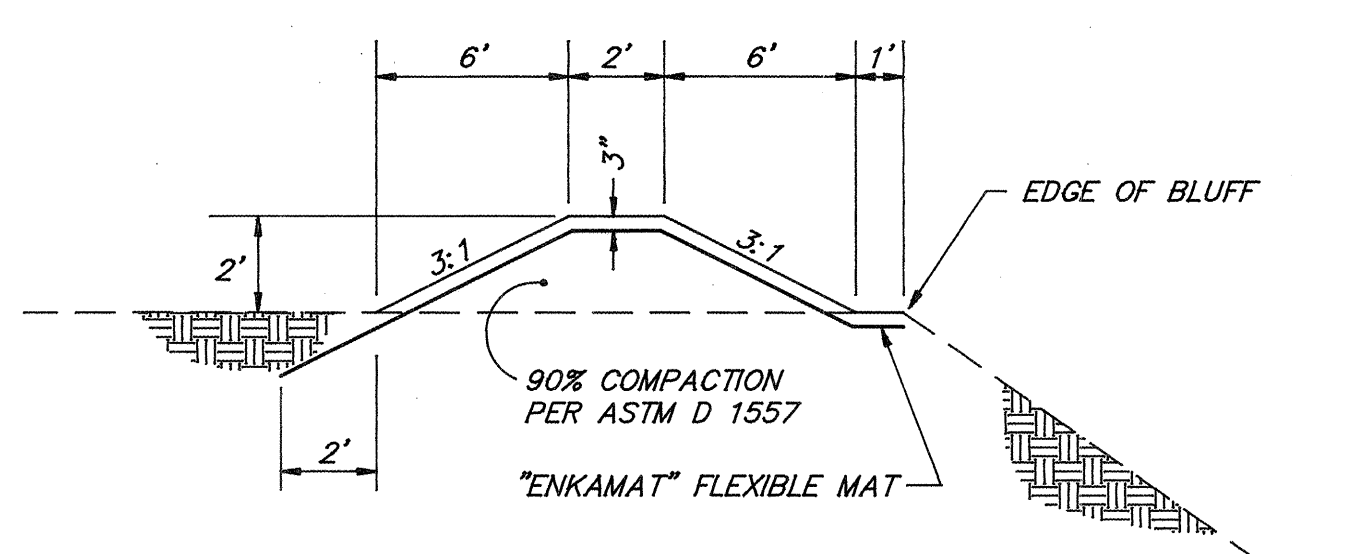


② TYPICAL EARTHEN BERM DETAIL

N.T.S.

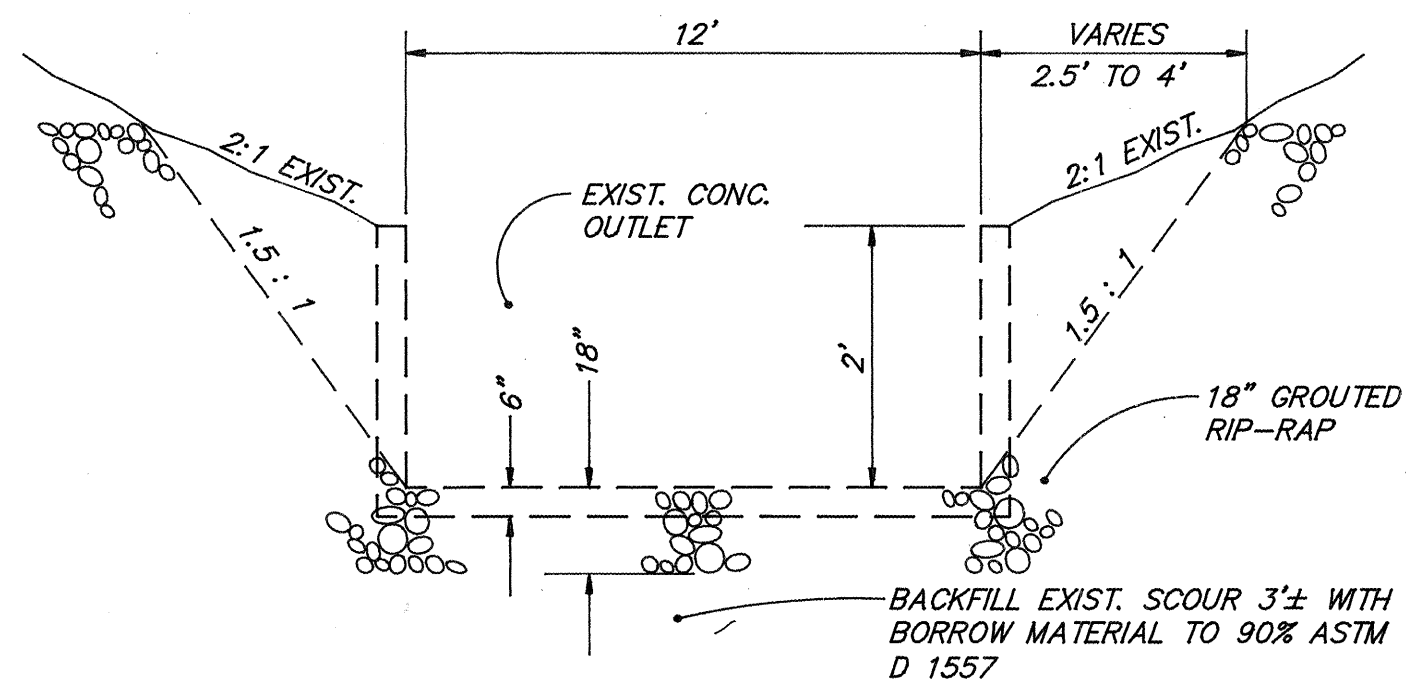

③ TYPICAL GROUTED RIP-RAP OUTLET DETAIL

N.T.S.

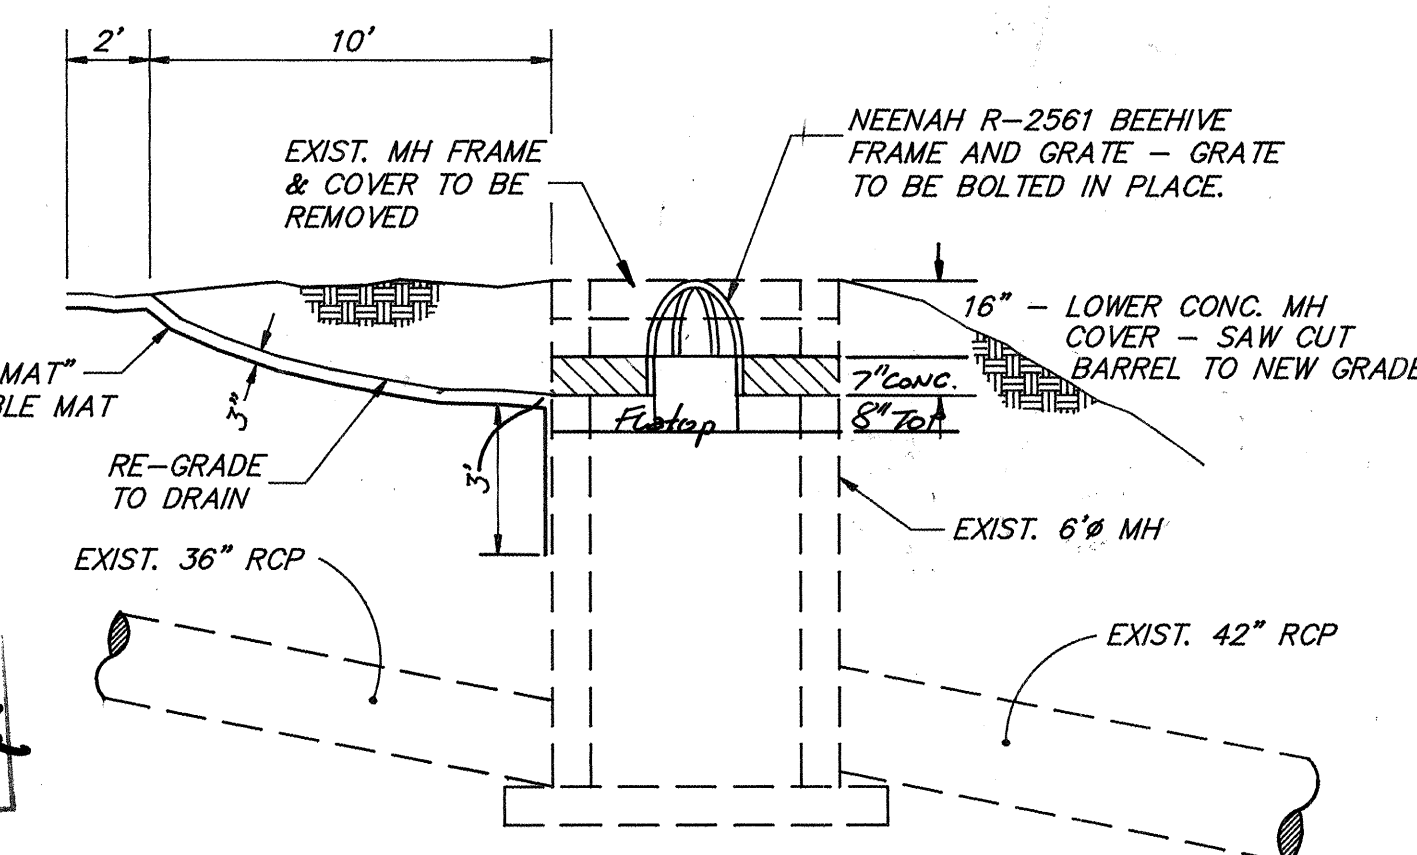


④ MANHOLE TO INLET CONVERSION DETAIL

N.T.S.

APPROVAL OF AS BUILT DRAWINGS
CHIEF CONSTRUCTION ENGINEER
David J. Smith
DATE 4/25/92

- NOTES:
- ALL BORROW SHALL CONFORM TO SECTION 205, BORROW MATERIAL, CITY OF ALBUQUERQUE STANDARD SPECIFICATIONS FOR PUBLIC WORKS CONSTRUCTION, 1986 EDITION.
 - THE BLUFF IS TO BE MAINTAINED AS MUCH AS POSSIBLE DURING CONSTRUCTION.

1	2	3	4	5	6	7	8	9	10	11	12	13	14	15
2	6	4	1	2	3	9	0	0	1	9	2			

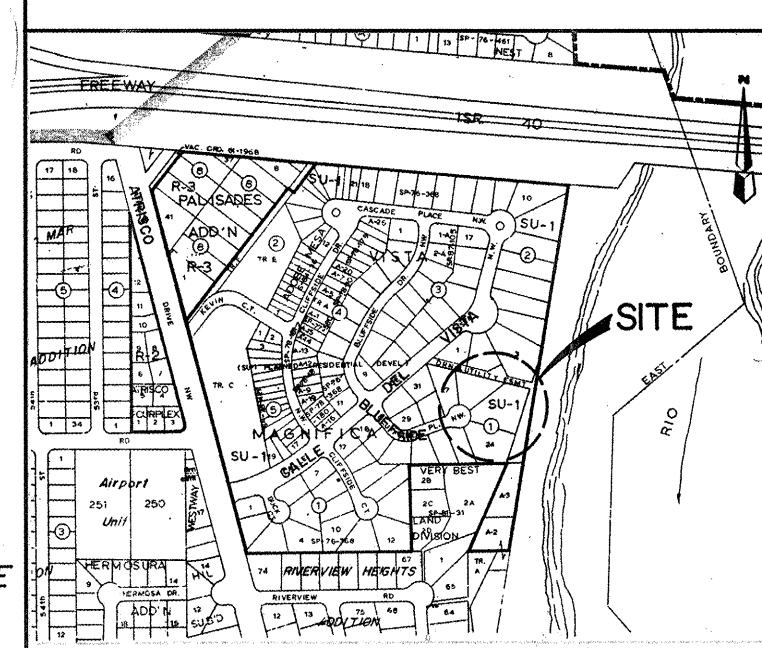

VICINITY MAP
SCALE: NONE ZONE ATLAS NO. H-11
dmg D. MARK GOODWIN & ASSOCIATES, P.A.
CONSULTING ENGINEERS & SURVEYORS
P.O. BOX 21307
ALBUQUERQUE, NEW MEXICO 87154
(505) 265-0905

CITY OF ALBUQUERQUE PUBLIC WORKS DEPARTMENT ENGINEERING GROUP					
TITLE: VISTA MAGNIFICA SUBDIVISION MISCELLANEOUS DRAINAGE IMPROVEMENTS					
APPROVALS	ENGINEER	DATE	APPROVALS	ENGINEER	DATE
DRC CHAIRMAN	<i>David J. Smith</i>	8-21-90	WATER	<i>N/A</i>	8-16-90
TRANSPORTATION	<i>David J. Smith</i>	8-11-90	WASTE WATER	<i>N/A</i>	8-16-90
HYDROLOGY	<i>David J. Smith</i>	8-21-90			
PROJECT NO.	4123.90	MAP NO.	H11	SHEET	1 OF 1

APPROVED FOR
CONSTRUCTION
Kenneth B. Smith
CITY ENGINEER 8-21-90