



CITY OF ALBUQUERQUE, NEW MEXICO

CONSTRUCTION PLANS FOR

STORM DRAINAGE CHANNEL REHABILITATION  
PHASE I


CITY OF ALBUQUERQUE - PUBLIC WORKS DEPARTMENT

SEPTEMBER, 1992

FINAL DESIGN

INDEX TO DRAWINGS

| NO. | DESCRIPTION                                             |
|-----|---------------------------------------------------------|
| 1   | TITLE SHEET                                             |
| 2   | LOCATION MAP                                            |
| 3   | SIFCON LINING - HAHN ARROYO - PENNSYLVANIA TO LOUISIANA |
| 4   | DETAIL SHEET - SIFCON LINING                            |
| 5   | DETAIL SHEET - CHANNEL REPAIR                           |
| 6   | DETAIL SHEET - CHANNEL REPAIR                           |

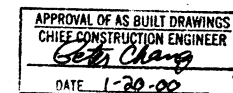

GENERAL NOTES

- ALL WORK DETAILED ON THIS PROJECT SHALL BE DONE IN ACCORDANCE WITH "CITY OF ALBUQUERQUE STANDARD SPECIFICATIONS FOR PUBLIC WORKS CONSTRUCTION", 1988 AND ANY REVISIONS AND ADDITIONS IN THE SUPPLEMENTAL SPECIFICATIONS IN THE CONTRACT DOCUMENTS.
- THE CONTRACTOR SHALL NOTIFY ALL UTILITY COMPANIES WHEN WORKING NEAR THEIR SYSTEMS. TWO DAYS PRIOR TO ANY EXCAVATION, CONTRACTOR MUST CONTACT NEW MEXICO ONE-CALL SYSTEM (280-1990) FOR LOCATION OF EXISTING UTILITIES.
- PRIOR TO CONSTRUCTION, THE CONTRACTOR SHALL EXCAVATE AND VERIFY THE HORIZONTAL AND VERTICAL LOCATIONS OF ALL OBSTRUCTIONS. SHOULD A CONFLICT EXIST, THE CONTRACTOR SHALL NOTIFY THE PROJECT MANAGER SO THAT THE CONFLICT CAN BE RESOLVED WITH MINIMUM AMOUNT OF DELAY.
- CONTRACTOR SHALL NOTIFY THE ENGINEER NOT LESS THAN SEVEN (7) DAYS PRIOR TO STARTING WORK IN ORDER THAT THE ENGINEER MAY TAKE NECESSARY MEASURES TO INSURE THE PRESERVATION OF SURVEY MONUMENTS. CONTRACTOR SHALL NOT DISTURB PERMANENT SURVEY MONUMENTS WITHOUT THE CONSENT OF THE ENGINEER AND SHALL NOTIFY THE ENGINEER AND BEAR THE EXPENSE OF REPLACING ANY THAT MAY BE DISTURBED WITHOUT PERMISSION. REPLACEMENT SHALL BE DONE ONLY BY THE ENGINEER. WHEN A CHANGE IS MADE IN THE FINISHED ELEVATION OF THE PAVEMENT OF ANY ROADWAY IN WHICH A PERMANENT SURVEY MONUMENT IS LOCATED, CONTRACTOR SHALL, AT HIS OWN EXPENSE, ADJUST THE MONUMENT COVER TO THE NEW GRADE UNLESS OTHERWISE SPECIFIED. REFER TO SECTION 4.4 OF THE GENERAL CONDITIONS OF THE STANDARD SPECIFICATIONS.
- REMOVALS SHALL BE DISPOSED OF OFF-SITE AND SHALL BE THE RESPONSIBILITY OF THE CONTRACTOR.
- THE CONTRACTOR SHALL DISPOSE OF ALL UNSUITABLE MATERIAL IN AN ENVIRONMENTALLY ACCEPTABLE MANNER AT A LOCATION ACCEPTABLE TO THE PROJECT MANAGER. THERE WILL BE NO DIRECT COMPENSATION FOR THIS WORK.
- CONTRACTOR SHALL PROVIDE A TEMPORARY STORM DRAINAGE SYSTEM (SUBJECT TO APPROVAL BY THE CITY HYDROLOGY DIVISION AND THE CITY CONSTRUCTION PROJECT MANAGER) FOR ALL WORK ON THIS PROJECT. THE TEMPORARY SYSTEM SHALL BE CAPABLE OF SAFELY CONVEYING EXISTING RUNOFF ACROSS THE PROJECT AND DISCHARGING INTO THE EXISTING DRAINAGE SYSTEM.

RECORD DRAWING

| REV                   | SHEETS | CITY ENGR | DATE | USER DEPT. | DATE | USER DEPT. | DATE |
|-----------------------|--------|-----------|------|------------|------|------------|------|
| APPROVAL OF REVISIONS |        |           |      |            |      |            |      |

|                                            |                                                                                                         |                                                                    |
|--------------------------------------------|---------------------------------------------------------------------------------------------------------|--------------------------------------------------------------------|
|                                            | <b>Grainer, Inc.</b><br>5971 JEFFERSON BLVD. NE<br>SUITE 101<br>ALBUQUERQUE, NM 87109<br>(505) 345-3999 | APPROVED FOR<br>CONSTRUCTION<br><i>Russell E. Smith</i><br>12-5-92 |
| DRAWING NO.<br><b>CITY PROJECT 4171-90</b> |                                                                                                         | SHEET 1 OF 6                                                       |



CONSTRUCTION EQUIPMENT ACCESS  
TO THE HAHN ARROYO WILL BE  
TYPICALLY FROM THE NORTH  
SIDE OR 1500' ± UPSTREAM  
WHERE THE HAHN ARROYO  
INTERSECTS DELLWOOD ROAD.  
UNDER NO CIRCUMSTANCES WILL  
CONSTRUCTION ACTIVITIES  
INTERFERE WITH USE OF THE  
BIKE TRAIL ON THE SOUTH  
SIDE OF THE HAHN ARROYO.

THESE DRAWINGS HAVE BEEN REVISED TO REFLECT AS-CONSTRUCTED CONDITIONS IN ACCORDANCE WITH INFORMATION FURNISHED BY THE CONTRACTOR (TRIAD BUILDERS OF NM) AND THE CITY OF ALBUQUERQUE, WHICH PERFORMED ON-SITE INSPECTION DURING CONSTRUCTION. THERE WERE NO CONSTRUCTION SURVEYS.

CITY OF ALBUQUERQUE  
PUBLIC WORKS DEPARTMENT  
ENGINEERING GROUP


TITLE: STORM DRAINAGE CHANNEL REHABILITATION- PHASE I  
SIFCON LINING-HAHN ARROYO-  
PENNSYLVANIA TO LOUISIANA

| APPROVALS      | ENGINEER             | DATE    | APPROVALS   | ENGINEER   | DATE   |
|----------------|----------------------|---------|-------------|------------|--------|
| DRC CHAIRMAN   | R. C. A. [Signature] | 10-5-92 | WATER       | R. W. Kane | 9-28-9 |
| TRANSPORTATION | N. H. RHO            | 9-25-92 | WASTE WATER | R. W. Kane | 9-28-9 |
| HYDROLOGY      | [Signature]          | 9-25-92 |             |            |        |


|                        |                 |              |
|------------------------|-----------------|--------------|
| PROJECT<br>NO. 4171.90 | MAP<br>NO. G-19 | SHEET 3 OF 6 |
|------------------------|-----------------|--------------|



## SLURRY INFILTRATED FIBER CONCRETE (SIFCON) LINING

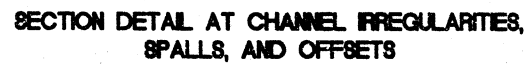


1. FIBER MATS MUST BE STAGGERED SUCH THAT EDGES AND ENDS OF TOP LAYERED MATS DO NOT COINCIDE WITH EDGES AND ENDS OF UNDERLYING MATS.
2. INSTALL VANDAL PLATES OVER EVA FOAM JOINTS AT BOTH UPSTREAM AND DOWNSTREAM LOCATIONS.

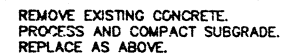[illegible]

SECTION

SIFCON OVERLAY  
SECTION AT DOWNSTREAM TIE TO EXISTING CHANNEL

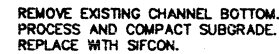

SECTION

SIFCON OVERLAY  
SECTION AT UPSTREAM TIE TO EXISTING CHANNEL

# RECORD DRAWING

**Greiner, Inc.**

CITY OF ALBUQUERQUE  
PUBLIC WORKS DEPARTMENT  
ENGINEERING DIVISION

TITLE: STORM DRAINAGE CHANNEL REHABILITATION PHASE I


DETAIL SHEET - SIFCON LINING

| APPROVALS      | ENGINEER           | DATE    | APPROVALS   | ENGINEER         | DATE    |
|----------------|--------------------|---------|-------------|------------------|---------|
| DRC Chairman   | <i>Rogers</i>      | 10-5-92 | Water       | <i>R.W. Kane</i> | 9-28-92 |
| Transportation | <i>N/A (LHO)</i>   | 9-28-92 | Waste Water | <i>R.W. Kane</i> | 9-28-92 |
| Hydrology      | <i>[Signature]</i> | 9/24/92 |             |                  |         |


|         |         |       |    |
|---------|---------|-------|----|
| PROJECT | MAP NO. | SHEET | OF |
|---------|---------|-------|----|



SECTION B-B

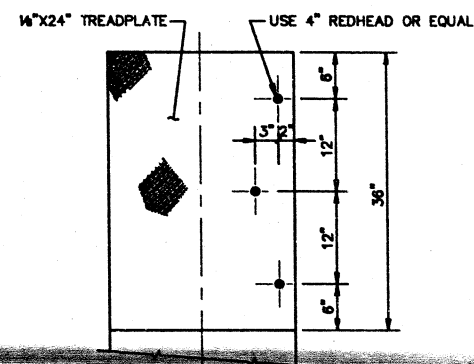


### JOINT VANDAL PLATE DETAILS

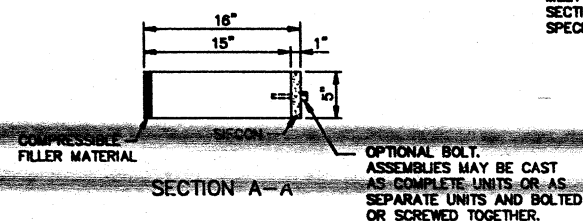

- JOINT SEALANT SHALL FOLLOW THE REQUIREMENTS AS DETAILED IN REPAIR TYPE II-A.
- PRE-MOLDED JOINT FILLER SHALL MEET THE REQUIREMENTS OF SECTION 107.3.1 OF THE SPECIFICATIONS.

REPAIR TYPE I-A  
SLURRY INFILTRATED FIBER  
CONCRETE (SIFCON) JOINT REPAIR

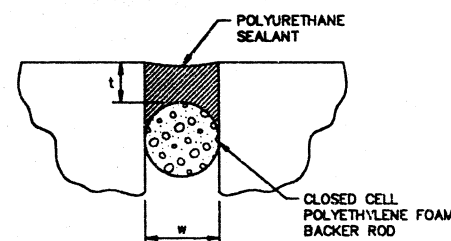REPAIR TYPE I-B  
CONVENTIONAL CONCRETE  
JOINT REPAIR

- REMOVE ALL DEBRIS IN JOINT TO DEPTH OF WATERSTOP OR AS DEEP AS PRACTICAL IF THERE IS NO WATERSTOP.
- CLEAN AND SEAL JOINT IN ACCORDANCE WITH SECTIONS 107.4.1.2 OF THE SPECIFICATIONS.
- CONTINUE SEALANT 1' UP SIDE WALL JOINTS.
- CRACKS OF LESS THAN 1/4" WIDTH THAT ARE REQUIRED TO BE SEALED SHALL BE ROUTED TO A MINIMUM WIDTH OF 3/8" AND A DEPTH OF 3/8". BACKER TAPE MEETING REQUIREMENTS OF SECTION 107 OF THE SPECIFICATIONS SHALL BE USED IN PLACE OF THE BACK ROD.

| $\frac{W}{4}$<br>JOINT<br>WIDTH,<br>INCHES | $\frac{T}{4}$<br>NOMINAL<br>SEALANT DEPTH,<br>INCHES | BACKER ROD<br>DIAMETER,<br>INCHES |
|--------------------------------------------|------------------------------------------------------|-----------------------------------|
| $\frac{1}{4}$                              | $\frac{1}{4}$                                        | $\frac{3}{8}$                     |
| $\frac{1}{2}$                              | $\frac{1}{4}$                                        | $\frac{3}{8}$                     |
| $\frac{3}{4}$                              | $\frac{3}{8}$                                        | 1                                 |
| 1                                          | $\frac{1}{2}$                                        | $1\frac{1}{4}$                    |
| $1\frac{1}{4}$                             | $\frac{1}{2}$                                        | $1\frac{1}{2}$                    |
| $1\frac{1}{2}$                             | $\frac{1}{2}$                                        | 2                                 |

REPAIR TYPE II-A  
POLYURETHANE SEALANT FOR EXPANSION  
AND CONTRACTION JOINTS AND CRACKS

# RECORD DRAWING

**Greiner, Inc.**

CITY OF ALBUQUERQUE  
PUBLIC WORKS DEPARTMENT  
ENGINEERING DIVISION

TITLE: STORM DRAINAGE CHANNEL REHABILITATION PHASE I



## DETAIL SHEET - CHANNEL REPAIR

| APPROVALS      | ENGINEER             | DATE    | APPROVALS   | ENGINEER   | DATE    |
|----------------|----------------------|---------|-------------|------------|---------|
| DRC Chairman   | R. W. Kane           | 10-5-92 | Water       | R. W. Kane | 9-28-92 |
| Transportation | NIA RHO              | 9-28-92 | Waste Water | R. W. Kane | 9-28-92 |
| Hydrology      | <del>Signature</del> | 9-28-92 |             |            |         |


|         |         |       |    |
|---------|---------|-------|----|
| PROJECT | MAP NO. | SHEET | OF |
|---------|---------|-------|----|



| FILLER SIZE (W) |       | SEALANT BLOCK-OUT<br>(SW) (SD) |       | SEALANT ORDER SIZE |       |
|-----------------|-------|--------------------------------|-------|--------------------|-------|
| WIDTH           | DEPTH | WIDTH                          | DEPTH | WIDTH              | DEPTH |
| 2"              | 4"    | 2"                             | 2"    | 2½"                | 2"    |
| 3"              | 3½"   | 3"                             | 2½"   | 3½"                | 2½"   |

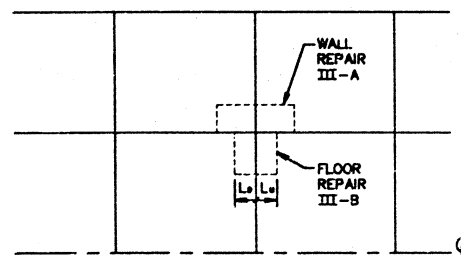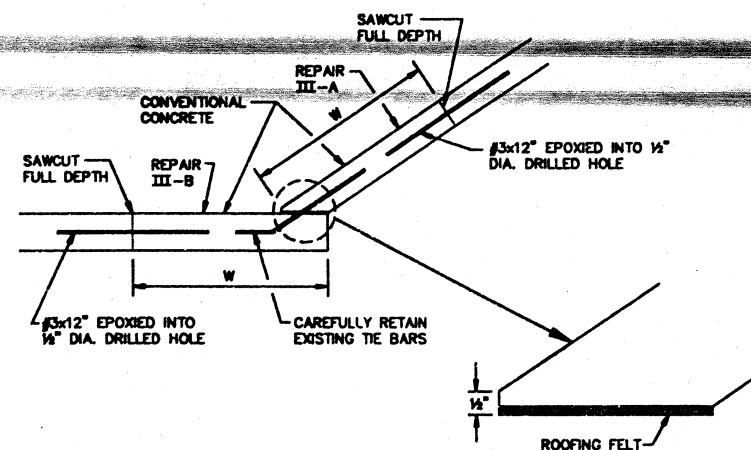

CHANNEL PLAN VIEW

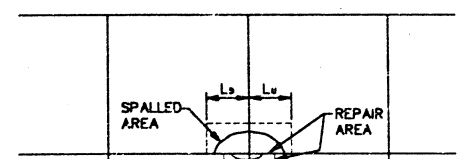

CHANNEL LONGITUDINAL SECTION


- BRING SUBGRADE UNDER PATCH AREA TO PROPER GRADE AND COMPACTION BEFORE PLACING CONCRETE. (INCIDENTAL)
- #3 TIE BARS ARE TO BE PLACED AT 24" O.C. ALONG ALL EDGES EXCEPT JOINTS (INCIDENTAL)

REPAIR TYPE III-A AND B  
SPALL REPAIR


| SECTION | CROSS STREET             | STATION | REPAIR                        | L <sub>p</sub> | L <sub>u</sub> | COMMENTS                            |
|---------|--------------------------|---------|-------------------------------|----------------|----------------|-------------------------------------|
| EAGJM1  | I-40                     |         |                               |                |                |                                     |
|         | INFLOW FROM I-40 RUNDOWN | 5+00    | I-A                           | 3'             | 2'             | 1 & 2 upstream side only            |
|         | GROUND WATER WEEPHOLES   | 6+00    | I-A, II-A, Spall repair(sp.r) | 5'             | 2'             | 162 & 7                             |
|         |                          | 7+00    | I-B, II-A, Sp.r               |                |                | 162                                 |
|         |                          | 8+00    | I-B, II-A, Sp.r               | 3'             | 3'             | 162 & 6                             |
|         |                          | 8+60    | I-B, II-A, Sp.r               |                |                | 162                                 |
|         |                          | 9+00    | I-A, II-A, Sp.r               |                |                | 162                                 |
|         |                          | 10+00   | II-A, Sp.r                    |                |                |                                     |
|         |                          | 10+30   | I-A                           |                |                | 162                                 |
|         |                          | 11+10   | I-A                           |                |                | 1 UPSTREAM, 3 DOWNSTREAM            |
|         |                          | 12+10   | I-A, II-A, sp.r               |                |                | 263                                 |
|         |                          | 13+20   | II-A                          |                |                |                                     |
|         |                          | 14+20   | I-B                           |                |                | 264                                 |
|         |                          | 15+40   | II-A, III-A, Sp.r             |                |                | 8                                   |
|         |                          | 16+20   | I-B, IIIA, sp.r               | 2'             | 3'             | 264 & 9                             |
|         |                          |         |                               |                |                |                                     |
|         |                          | 17+10   | IIA, sp.r                     |                |                |                                     |
|         |                          | 18+40   | IIA, IIB, sp.r                |                |                |                                     |
|         |                          | 18+60   | IIA                           |                |                |                                     |
|         |                          | 19+00   | IB                            | 2.5'           | 2.5'           | Between existing transverse sawcuts |
|         |                          | 19+50   | IIB                           |                |                | 10                                  |
|         |                          | 20+00   | IA                            |                |                |                                     |
|         |                          | 20+60   | IIA, sp.r                     |                |                |                                     |
|         |                          | 21+00   | IIA                           |                |                |                                     |
|         |                          | 22+00   | IA                            | 5'             | 5'             |                                     |
|         |                          | 23+00   | IIB                           |                |                | 11                                  |
|         |                          | 24+00   | IIC                           |                |                | 6 & 12                              |
|         |                          | 25+00   | IA                            |                |                |                                     |
|         |                          | 26+00   | IB                            |                |                |                                     |
|         |                          | 27+00   | IIA                           |                |                |                                     |
|         |                          | 28+00   | IB                            | 3'             | 2.5'           |                                     |
|         |                          |         |                               |                |                |                                     |
|         |                          | 29+70   | IIA                           |                |                |                                     |
|         |                          | 30+20   | IIB, IIIB, IIA                | 1'             | 1'             | 2 s. side, w=1'                     |
|         |                          | 31+20   | IB                            |                |                |                                     |
|         |                          | 32+20   | IIB, sp.r                     |                |                | 14                                  |
|         |                          | 33+20   | IIA, sp.r                     |                |                |                                     |
|         |                          | 34+20   | IA                            | 3'             | 2.5'           |                                     |
|         |                          | 35+20   | IIIB, IIA, sp.r               |                |                | 2 s. side; w=1'                     |
|         |                          | 36+20   | IA                            | 10'            | 4.5'           | 6                                   |
| EAGJM2  | PENNSYLVANIA             |         |                               |                |                |                                     |
| EAGJM3  | HENDOLA                  |         |                               |                |                |                                     |

RECORD DRAWINGS


THESE DRAWINGS HAVE BEEN REVISED TO REFLECT AS-CONSTRUCTED CONDITIONS IN ACCORDANCE WITH INFORMATION FURNISHED BY THE CONTRACTOR (TRIAD BUILDERS OF NM) AND THE CITY OF ALBUQUERQUE, WHICH PERFORMED ON-SITE INSPECTION DURING CONSTRUCTION. THERE WERE NO CONSTRUCTION SURVEYS.

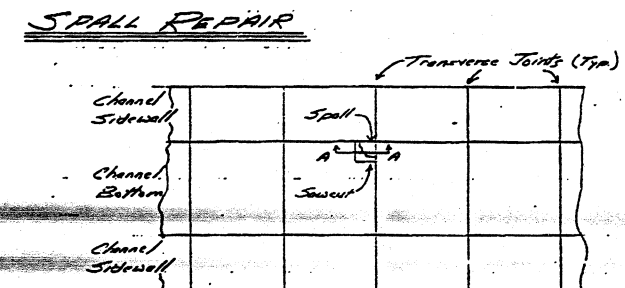

PLAN OF CHANNEL  
SHOWING SPALL

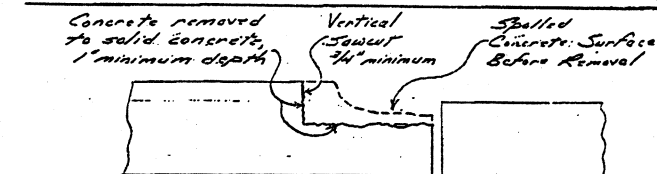

SECTION A-A AFTER RENOVATION

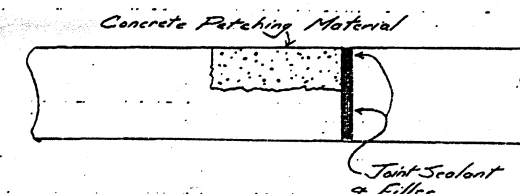

SECTION A-A AFTER PATCHING

**NOTES:**

- ① REPAIR CENTER 27'( $\pm$ ) BETWEEN OUTSIDE LONGITUDINAL JOINTS AND RESEAL OUTER 2'( $\pm$ ) OF TRANSVERSE JOINT BETWEEN WALL AND LONGITUDINAL JOINT (PERTINENT TO STATIONS 5+00 THROUGH 11+10.)
- ② CAREFULLY REMOVE CONCRETE ALONG LONGITUDINAL JOINTS TO MAINTAIN TRANSVERSE REBAR. CLEAN THIS REBAR AND PLACE REHABILITATION CONCRETE AROUND IT.
- ③ REPAIR CENTER 30'( $\pm$ ) BETWEEN OUTSIDE LONGITUDINAL JOINTS AND RESEAL OUTER 5'( $\pm$ ) OF TRANSVERSE JOINT BETWEEN WALL AND OUTSIDE LONGITUDINAL JOINT (PERTINENT TO STATIONS 11+10 THROUGH 13+70.)
- ④ REPAIR CENTER 38.5'( $\pm$ ) BETWEEN OUTSIDE LONGITUDINAL JOINTS AND RESEAL 2'( $\pm$ ) OF TRANSVERSE JOINT BETWEEN WALL AND OUTSIDE LONGITUDINAL JOINT (PERTINENT TO STATIONS 14+20 THROUGH 19+00)
- ⑤ PLACE VANDAL PLATES AT THESE JOINTS. SEGMENT PLATE LENGTHS TO 1/3 CHANNEL WIDTH.
- ⑥ II-A IS FROM LONGIT. JT. TO WALL.
- ⑦ III-A IN VERTICAL WALL S. SIDE.
- ⑧ II-A OUTSIDE LONGT. JTS. BOTH SIDES.
- ⑨ 33' VANDAL PLATES
- ⑩ 18' VANDAL PLATES
- ⑪ 18' VANDAL PLATES
- ⑫ 19' VANDAL PLATES
- ⑬ 18' VANDAL PLATES

**Greiner, Inc.**

CITY OF ALBUQUERQUE  
PUBLIC WORKS DEPARTMENT  
ENGINEERING DIVISION

TITLE: STORM DRAINAGE CHANNEL REHABILITATION PHASE I

## DETAIL SHEET - CHANNEL REPAIR

| APPROVALS      | ENGINEER           | DATE    | APPROVALS   | ENGINEER         | DATE    |
|----------------|--------------------|---------|-------------|------------------|---------|
| DRC Chairman   | <i>[Signature]</i> | 7-25-92 | Water       | <i>R.W. Kane</i> | 7-28-92 |
| Transportation | <i>N.A. Lind</i>   | 7-25-92 | Waste Water | <i>R.W. Kane</i> | 7-28-92 |
| Hydrology      | <i>[Signature]</i> | 7/25/92 |             |                  |         |

|         |        |         |        |       |   |    |   |
|---------|--------|---------|--------|-------|---|----|---|
| PROJECT | 147100 | MAP NO. | 147100 | SHEET | 6 | OF | 6 |
|---------|--------|---------|--------|-------|---|----|---|

[illegible]