


NORTH DOMINGO BACA DAM

DAM REVISIONS

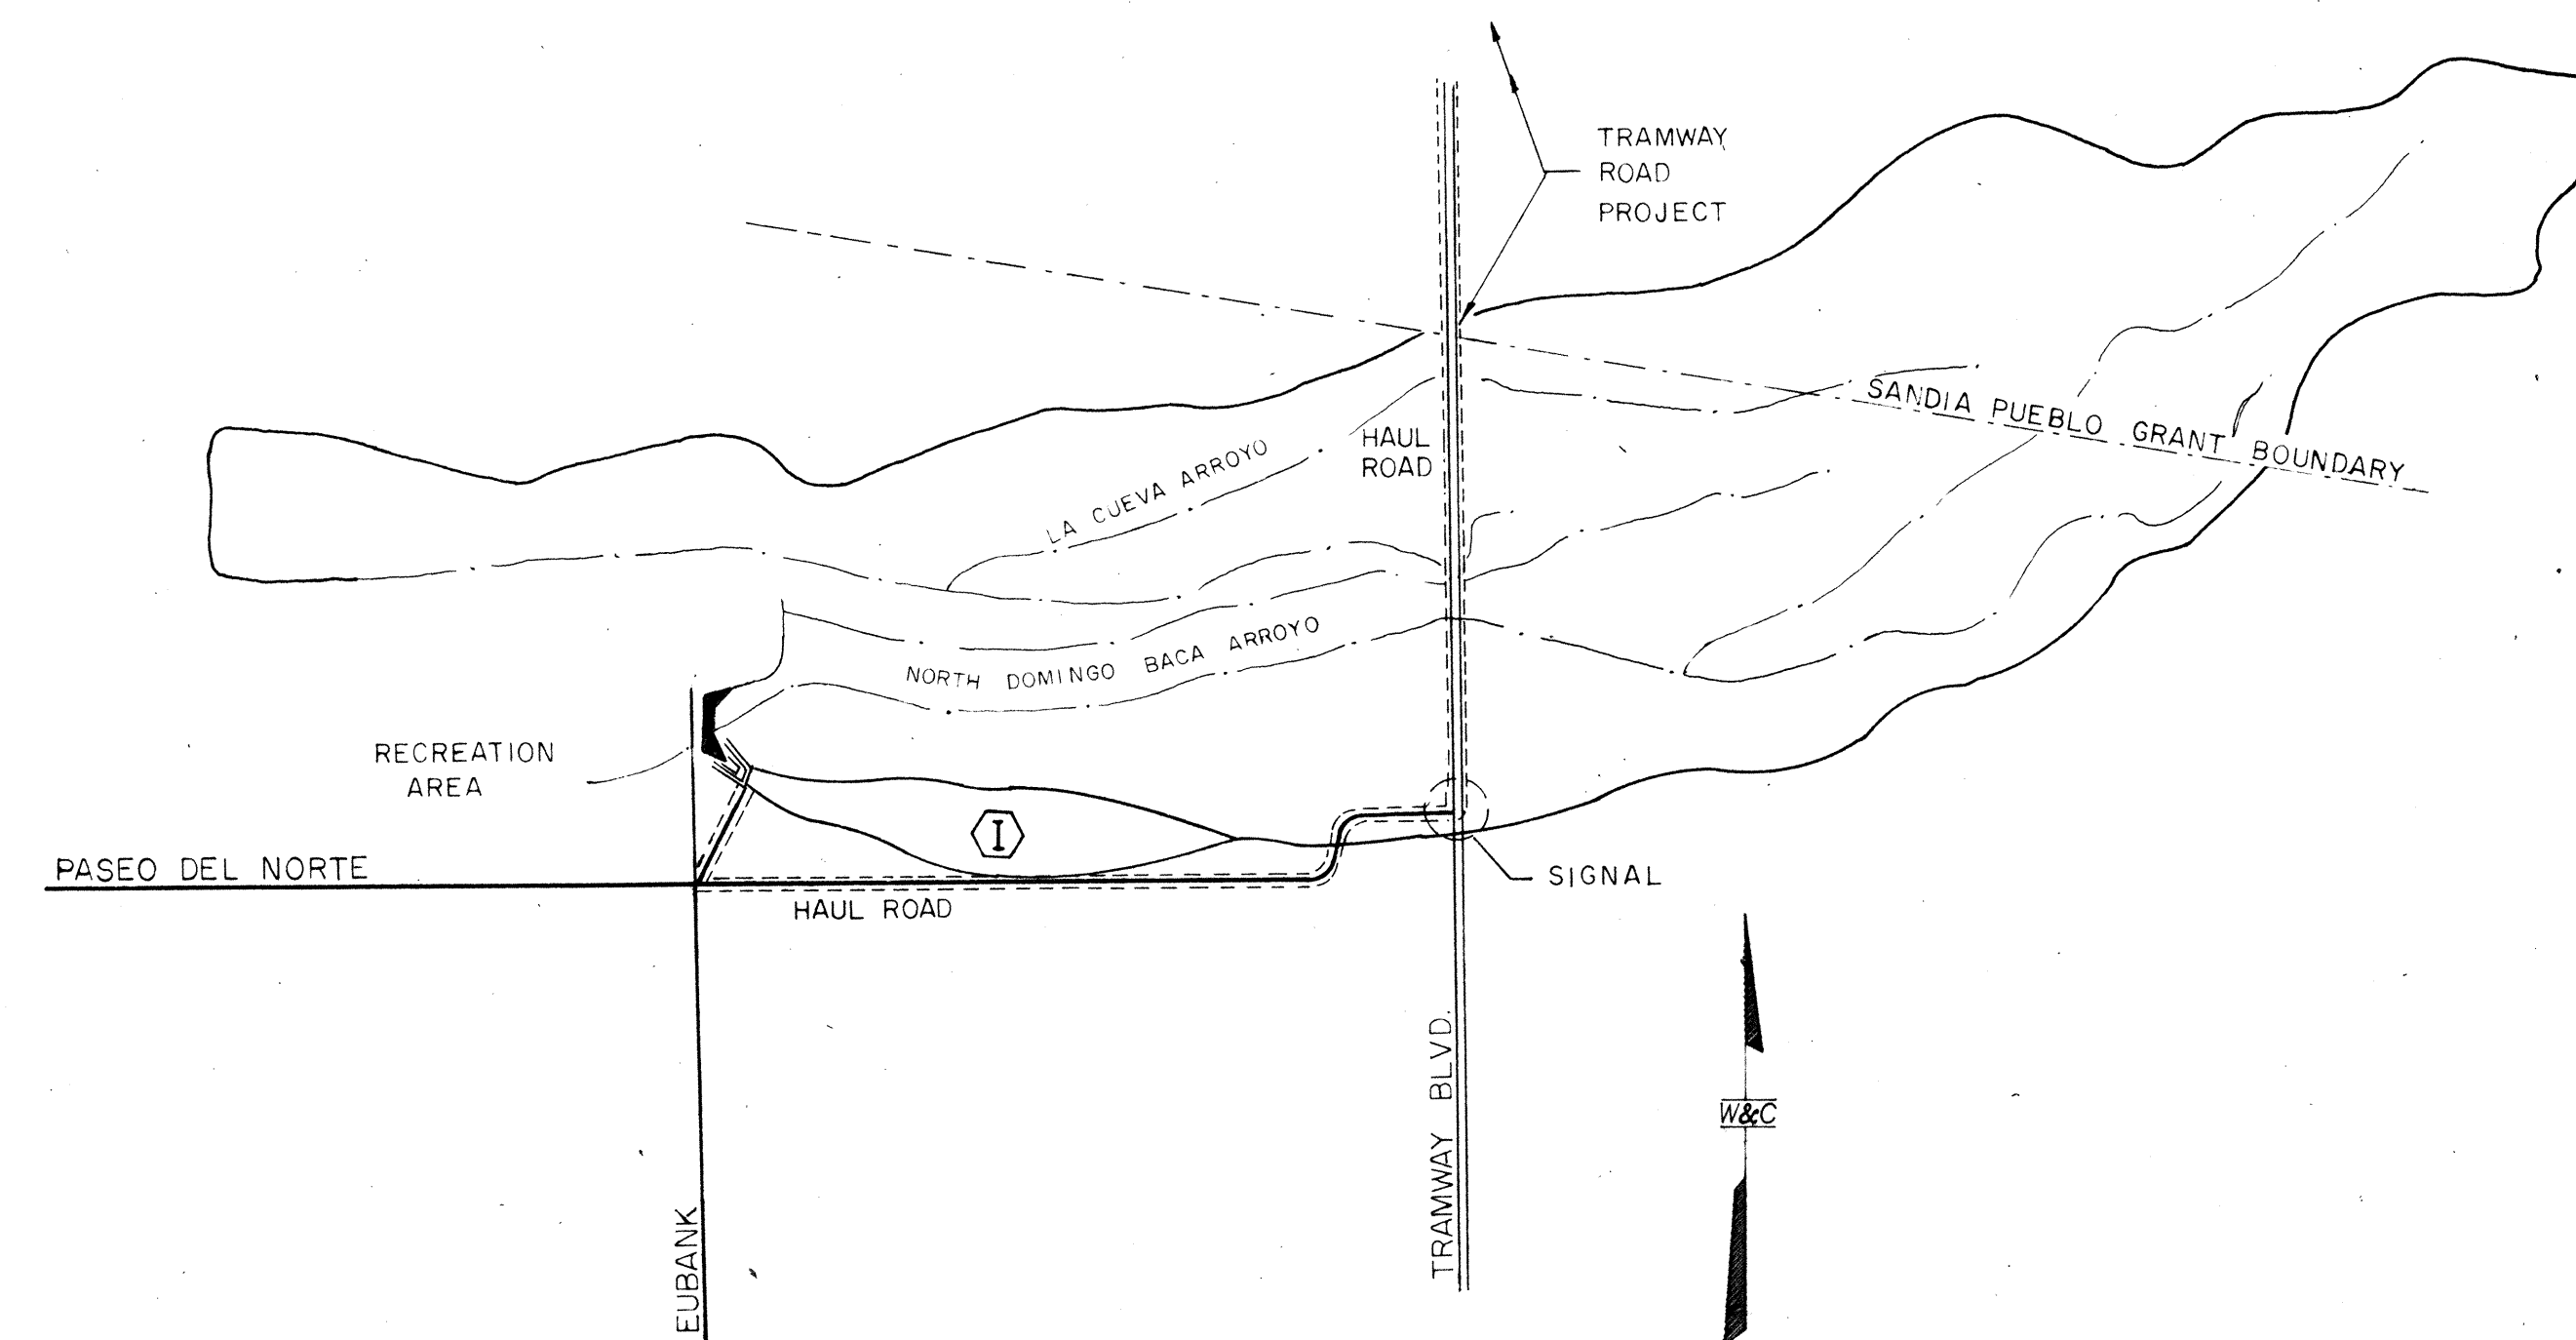

LOCATION MAP

NOTE:

1. All work shown is to be completed as part of this project. This includes the ditch diverting flows from the east and south of the emergency spillway along with the concrete rundowns and seeding.
2. All embankment will be compacted to 95% of the Standard Proctor per the NMSH&TD Specifications.
3. Clearing & Grubbing of the embankment areas will be done prior to the placing of embankment per the NMSH&TD Specifications.
4. The NMSH&TD will test the embankment for compaction and send copies of the test results to the City.
5. Boulders must be clean of excess material. The boulder stockpile locations shown on the plans are approximate and the locations may be adjusted as directed by the Project Manager.
6. Concrete shall contain fly ash as per City of Albuquerque standard specifications.


AMAFCA PROJECT

C of A PWD Maps & Records											
1	2	3	4	5	6	7	8	9	10	11	12
26	42	44	47	49	50	51	52	53	54	55	56




RECORD DRAWING
DATE 1 Feb 1990


Revised 9-11-89 to add Notes by SUM

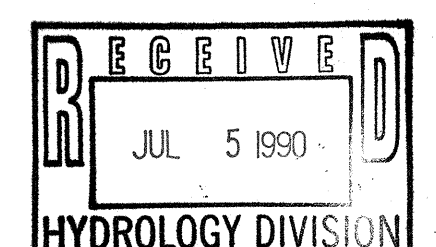

WILSON & COMPANY ENGINEERS & ARCHITECTS
ALBUQUERQUE, NEW MEXICO

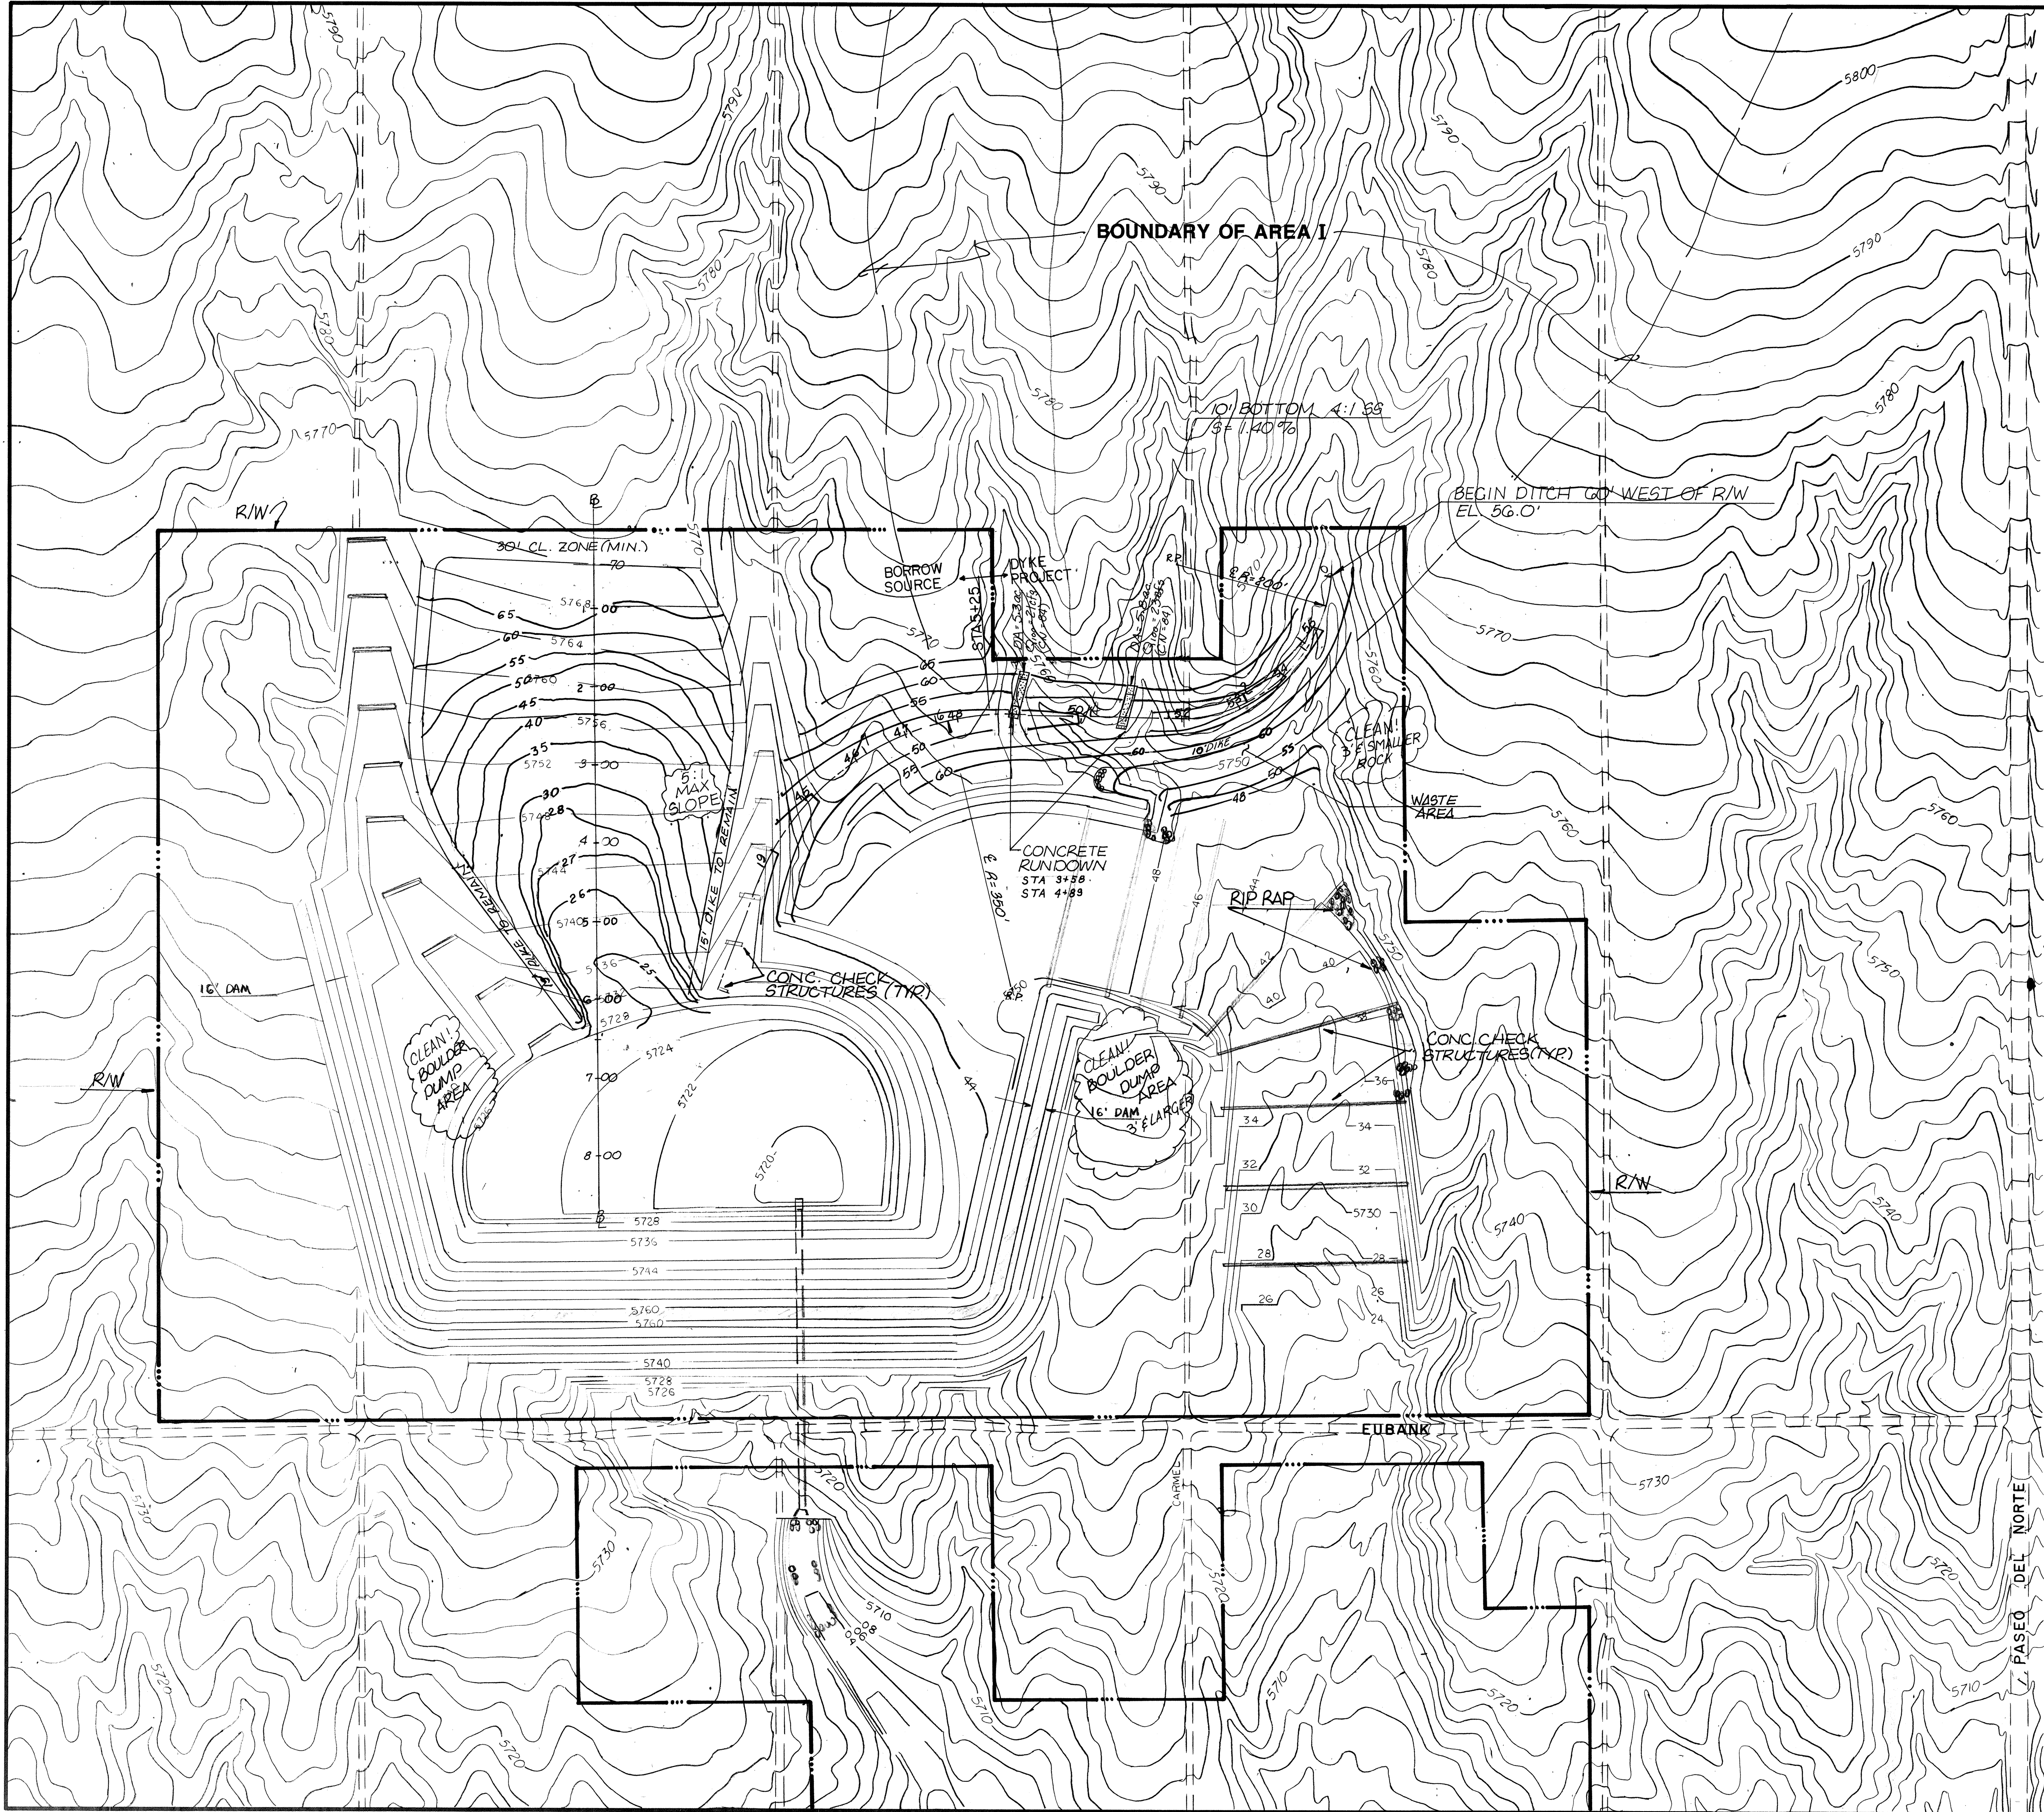

PROJECT LOCATION

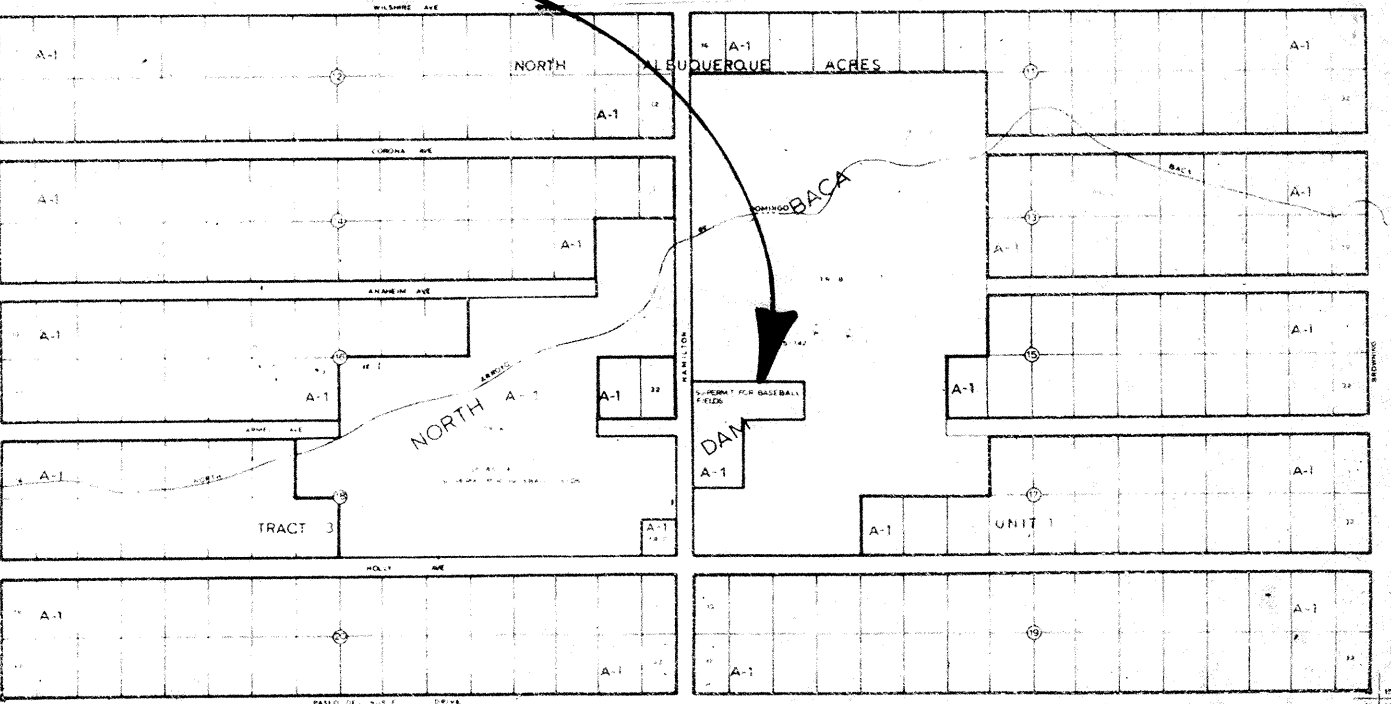

NORTH DOMINGO BACA DAM PROPERTIES

MAXIMUM HEIGHT ABOVE FOUNDATION CENTERLINE	34 FEET
LENGTH	1,700 FEET
MAXIMUM WIDTH AT BASE	230 FEET
CREST WIDTH	16 FEET
SLOPE UPSTREAM FACE	2.5:1
SLOPE DOWNSTREAM FACE	2.5:1
ELEVATION AT CREST OF DAM	5,760.0
FLOWLINE ELEVATION OF PRINCIPAL OUTLET AT INLET	5,720.0
ELEVATION AT EMERGENCY SPILLWAY CREST	5,749.0
WIDTH OF EMERGENCY SPILLWAY:	
EXISTING	200 FEET
WITH DA "I" & EXCAVATION	200 FEET
ULTIMATE	250 FEET
DISCHARGE CAPACITY OF EMERGENCY SPILLWAY	
AT ELEVATION 5758.2	15,300 CFS
(5858.7, ULTIMATE)	20,800 CFS
OUTLET CONDUIT SIZE AND TYPE	36" RCP
OUTLET CONDUIT CAPACITY AT ELEVATION 5749.0	160 CFS
EVACUATION TIME - EXISTING	18 HRS
ULTIMATE	28 HRS
STORAGE CAPACITY AT ELEVATION 5749.0 - EXISTING	124 AC-FT
WITH DA "I" & EXC	130 AC-FT
ULTIMATE	194 AC-FT
DRAINAGE AREA - EXISTING	1,221 AC
WITH DA "I" & EXCAVATION	1,287 AC
ULTIMATE	1,918 AC
PMP DESIGN RAINFALL	12.5" IN 1 HR
PMP PEAK INFLOW TO DAM - EXISTING	15,400 CFS
WITH DA "I" & EXC	15,470 CFS
WITH ULTIMATE	21,000 CFS
100-YEAR DESIGN RAINFALL	2.7" IN 1 HR
100-YEAR PEAK INFLOW TO DAM - EXISTING	1,960 CFS
WITH DA "I" & EXC	1,980 CFS
ULTIMATE	2,900 CFS
HAZARD CLASSIFICATION (AS'S DEFINITION)	C
DISCHARGE CAPACITY OF EMERGENCY SPILLWAY AT ELEVATION 5760 - EXISTING	22,000 CFS
WITH DA "I" & EXC	22,000 CFS
ULTIMATE	26,000 CFS
ULTIMATE DESIGN INCLUDES THE DIVERSION OF APPROXIMATELY 610 ACRES OF THE LA CUEVA ARROYO TO THE NORTH DOMINGO BACA DAM.	

C of A PWD Maps & Records
26 12 0 0 2 9 0

RECORD DRAWING
DATE 1 Feb. 1990

SCALE IN FEET
0 100 200 300 400

GRADING PLAN

NORTH DOMINGO BACA DAM

DESIGN SJM DRAWN JRT
STEVEN J. METO
8220
PROFESSIONAL ENGINEER


WILSON
& COMPANY
ENGINEERS
& ARCHITECTS
ALBUQUERQUE, NEW MEXICO

DATE: 8/89
FILE NO. 89-522
SHEET NO. 2
OF 8

F H W A REGION NO.	STATE	PROJECT NO.	FISCAL YEAR	SHEET NO.	TOTAL SHEETS
6	NEW MEXICO	89-522	19	3	8

FINAL SURVEY NOTE BOOK NO.	SURVEYED PLOTTED AREAS AREAS CHECKED	BY	DATE

ORIGINAL SURVEY NOTE BOOK NO.	SURVEYED PLOTTED AREAS AREAS CHECKED	BY	DATE

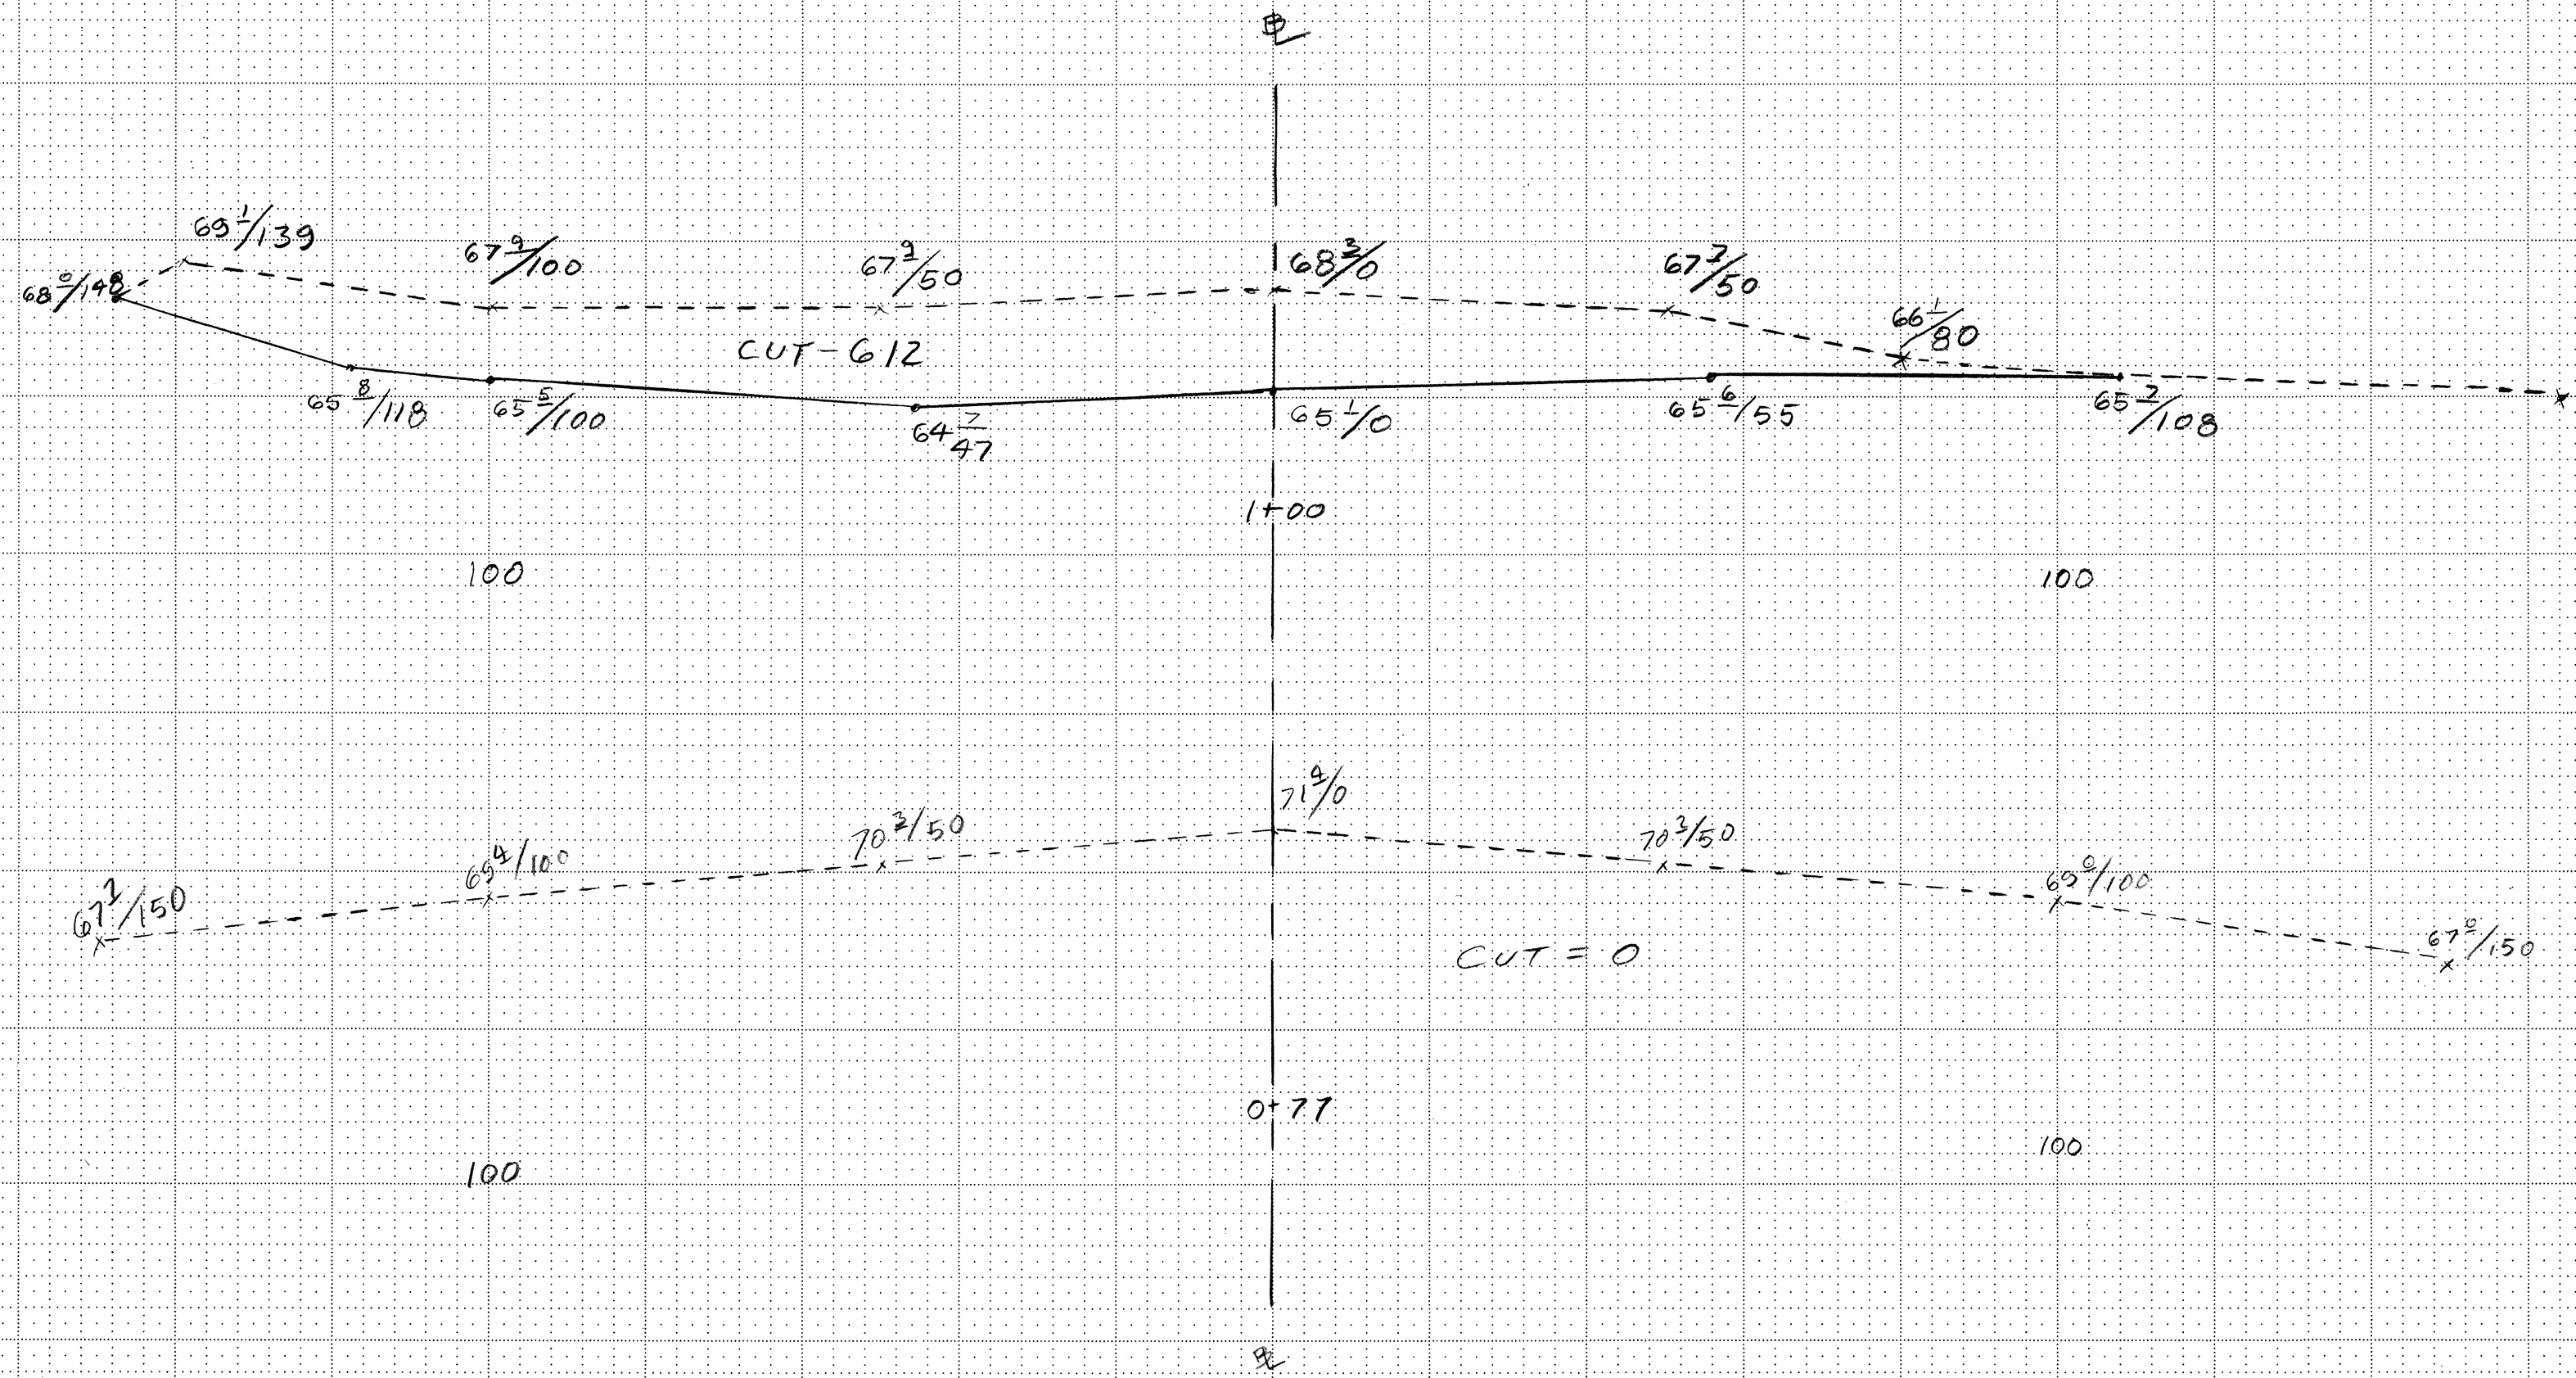

C of A PWD Maps & Records
1 2 3 4 5 6 7 8 9 10 11 12
26 7 20 6 3 7 0


RECORD DRAWING
DATE 1 FEB 1990

RECEIVED
JUL 5 1990
HYDROLOGY DIVISION

F H W A REGION NO.	STATE	PROJECT NO.	FISCAL YEAR	SHEET NO.	TOTAL SHEETS
6	NEW MEXICO	89-522	19	5	8

FINAL SURVEY NO.	SURVEYED PLOTTED NOTE BOOK AREAS CHECKED	BY	DATE

ORIGINAL SURVEY NO.	SURVEYED PLOTTED NOTE BOOK AREAS CHECKED	BY	DATE

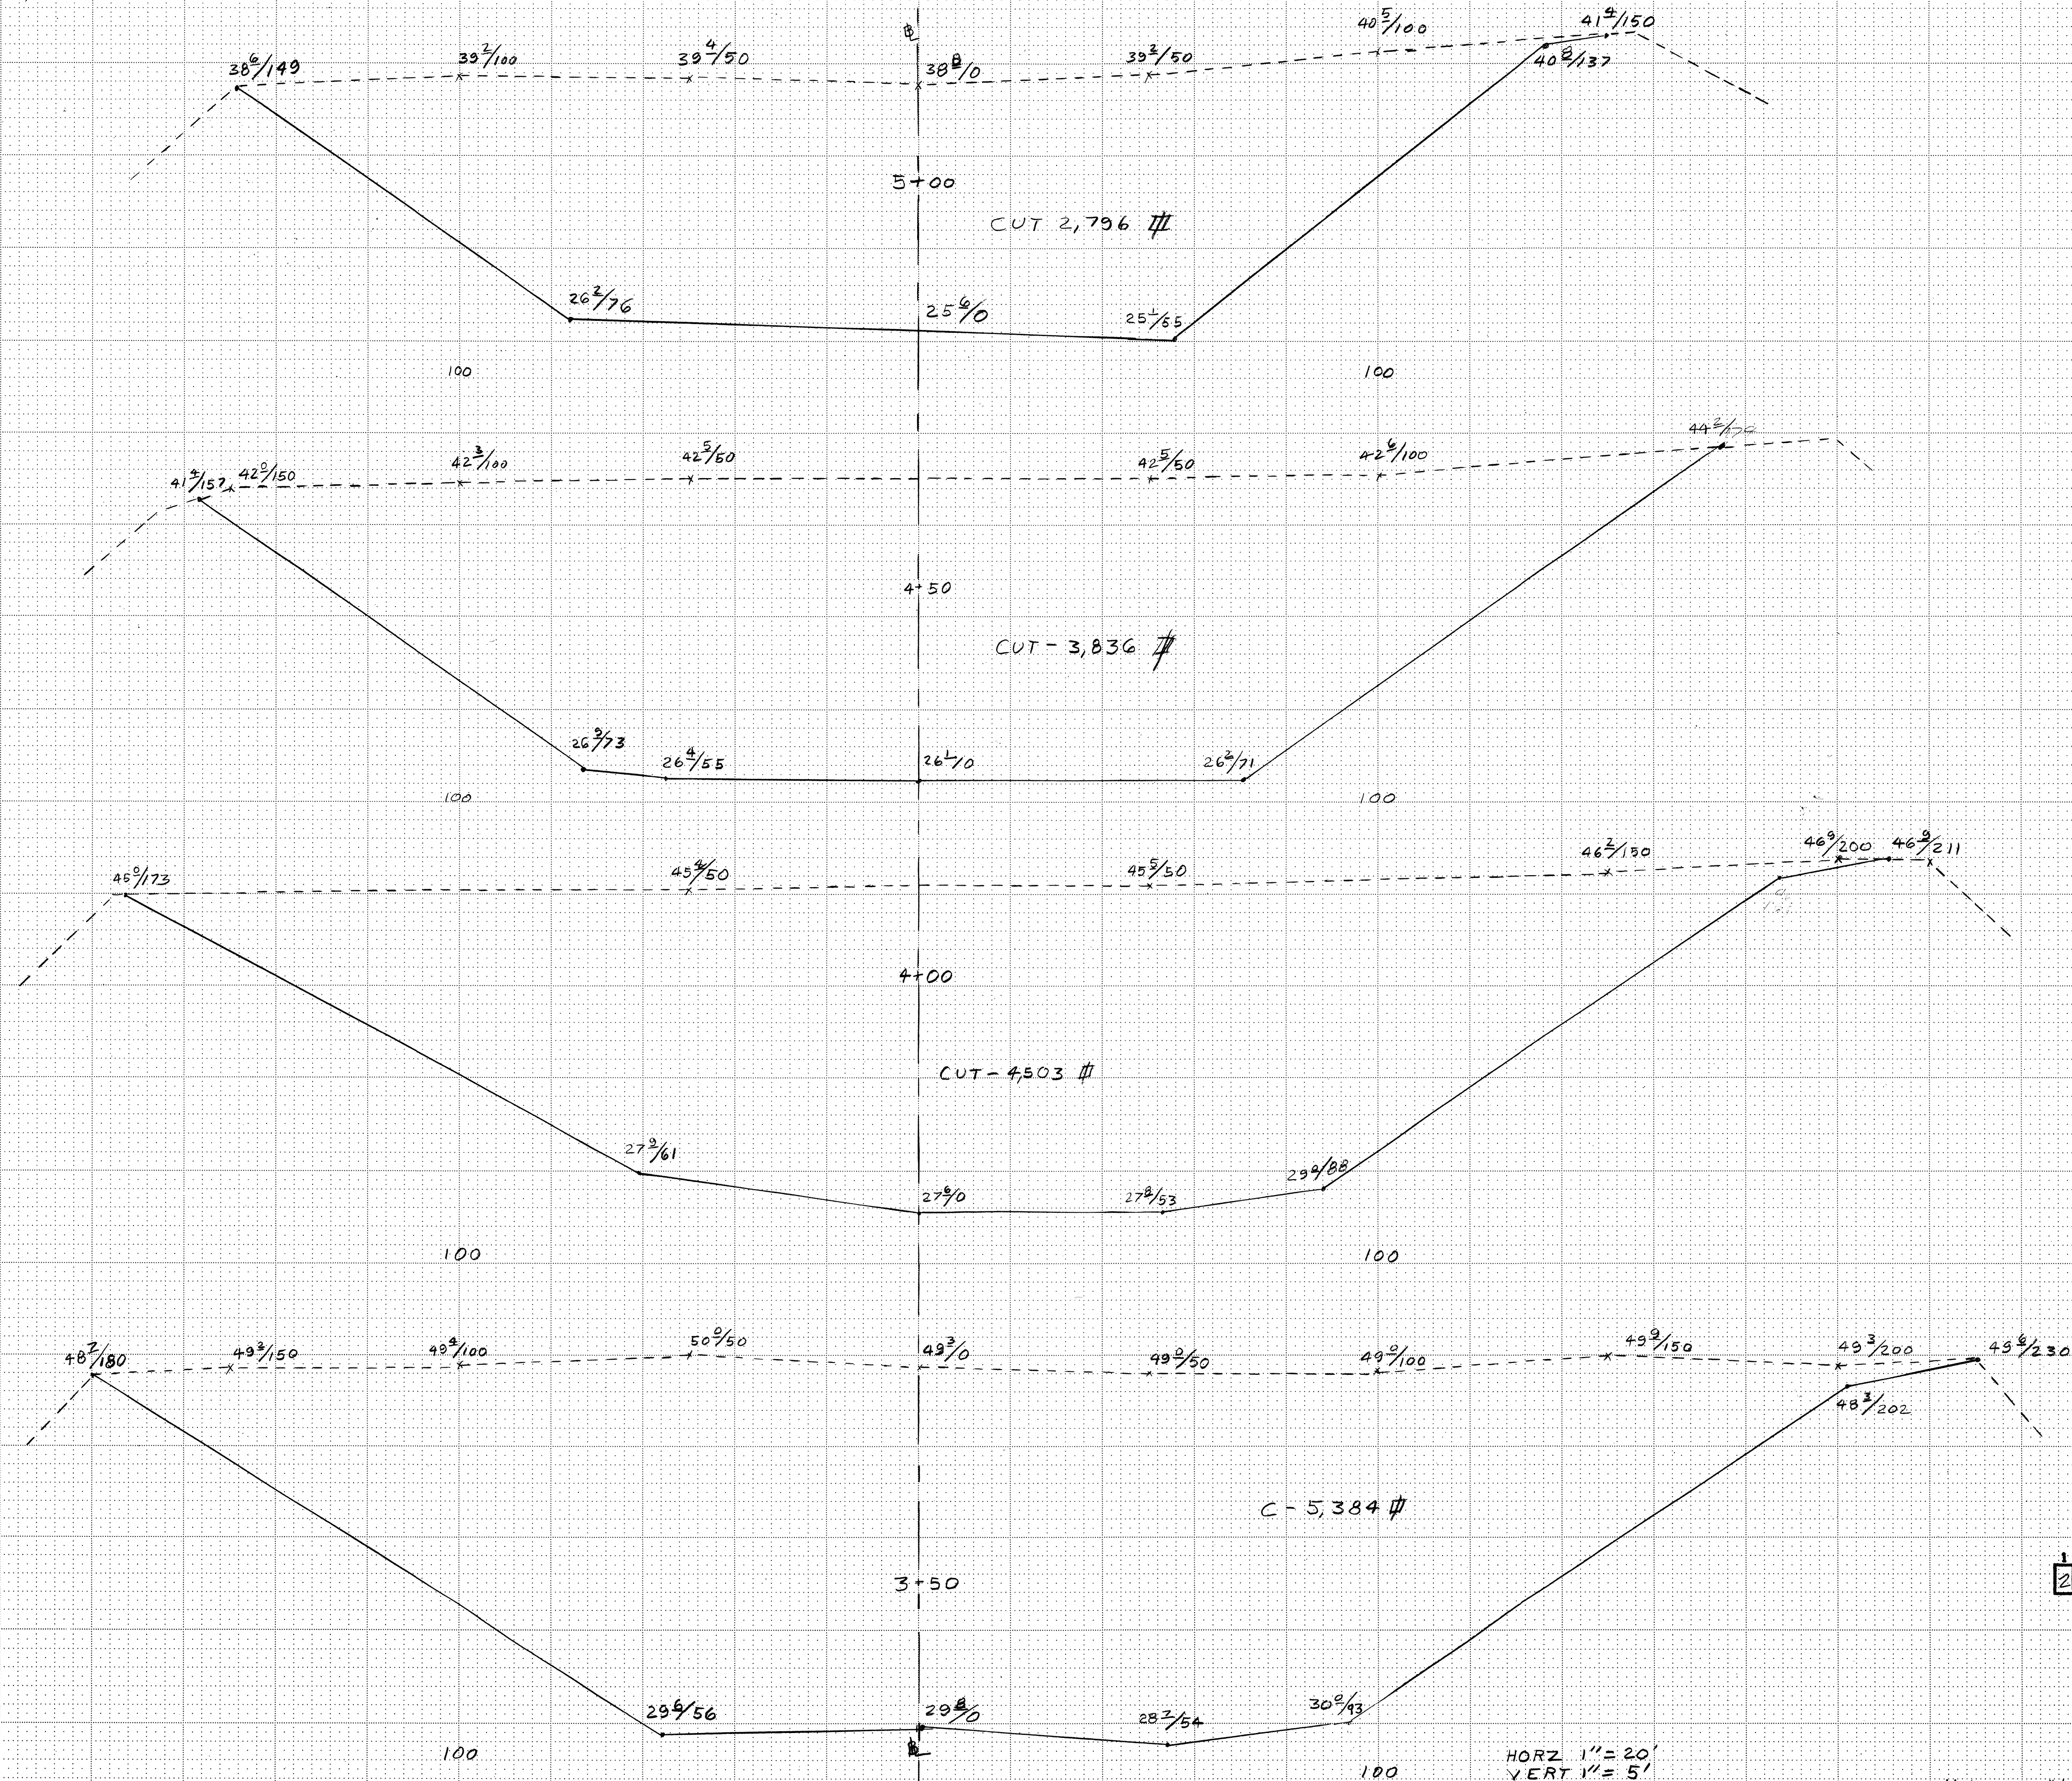


C of A PWD Maps & Records
1 2 3 4 5 6 7 8 9 10 11 12
22 4 20 6 0 5 9 0


RECORD DRAWING
DATE 1 FEB 1990

HORZ 1" = 20'
VERT 1" = 5'

N DOMINGO BACA

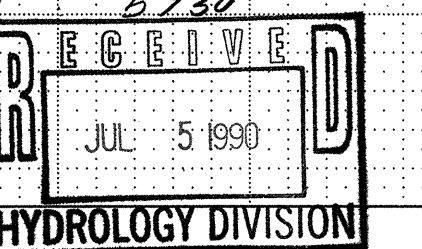


FINAL SURVEY		BY _____		DATE _____	
NOTE BOOK		SURVEYED _____		_____	
NO. _____		PLOTTED _____		_____	
		TEMPLATE _____		_____	
		AREAS _____		_____	
		AREAS CHECKED _____		_____	

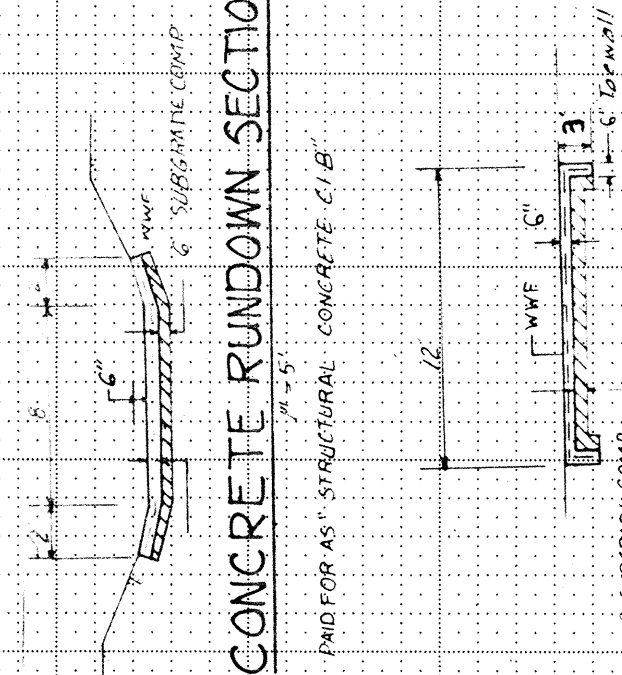


CONCRETE CHECK STRUCTURE SECTION

PLAN CONCRETE RUNDOWN & CHECK STRUCTURE

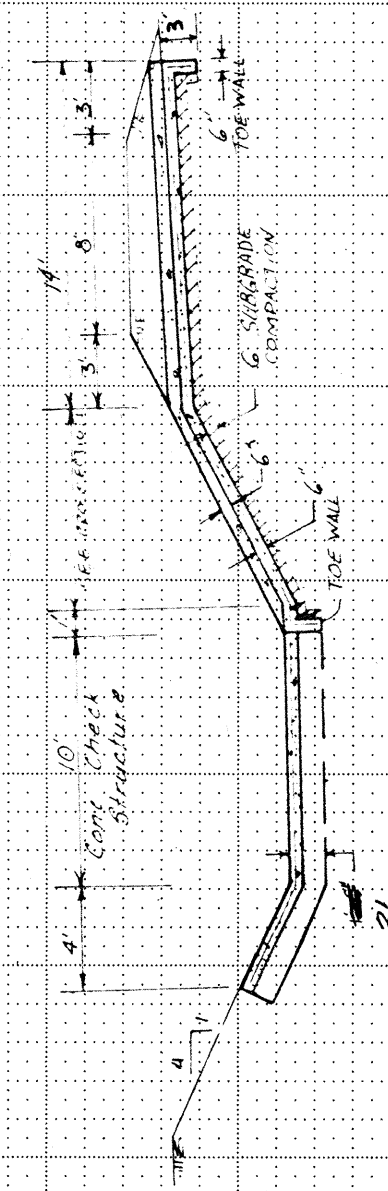

NOTE: All Concrete shall be "Structural Concrete (C18)" with Welded Wire Fabric W14 x W18 (6" x 6" Mesh).
C62 #1000 SF

CONCRETE RUNDOWN &
CHECK STRUCTURE ELEVATION

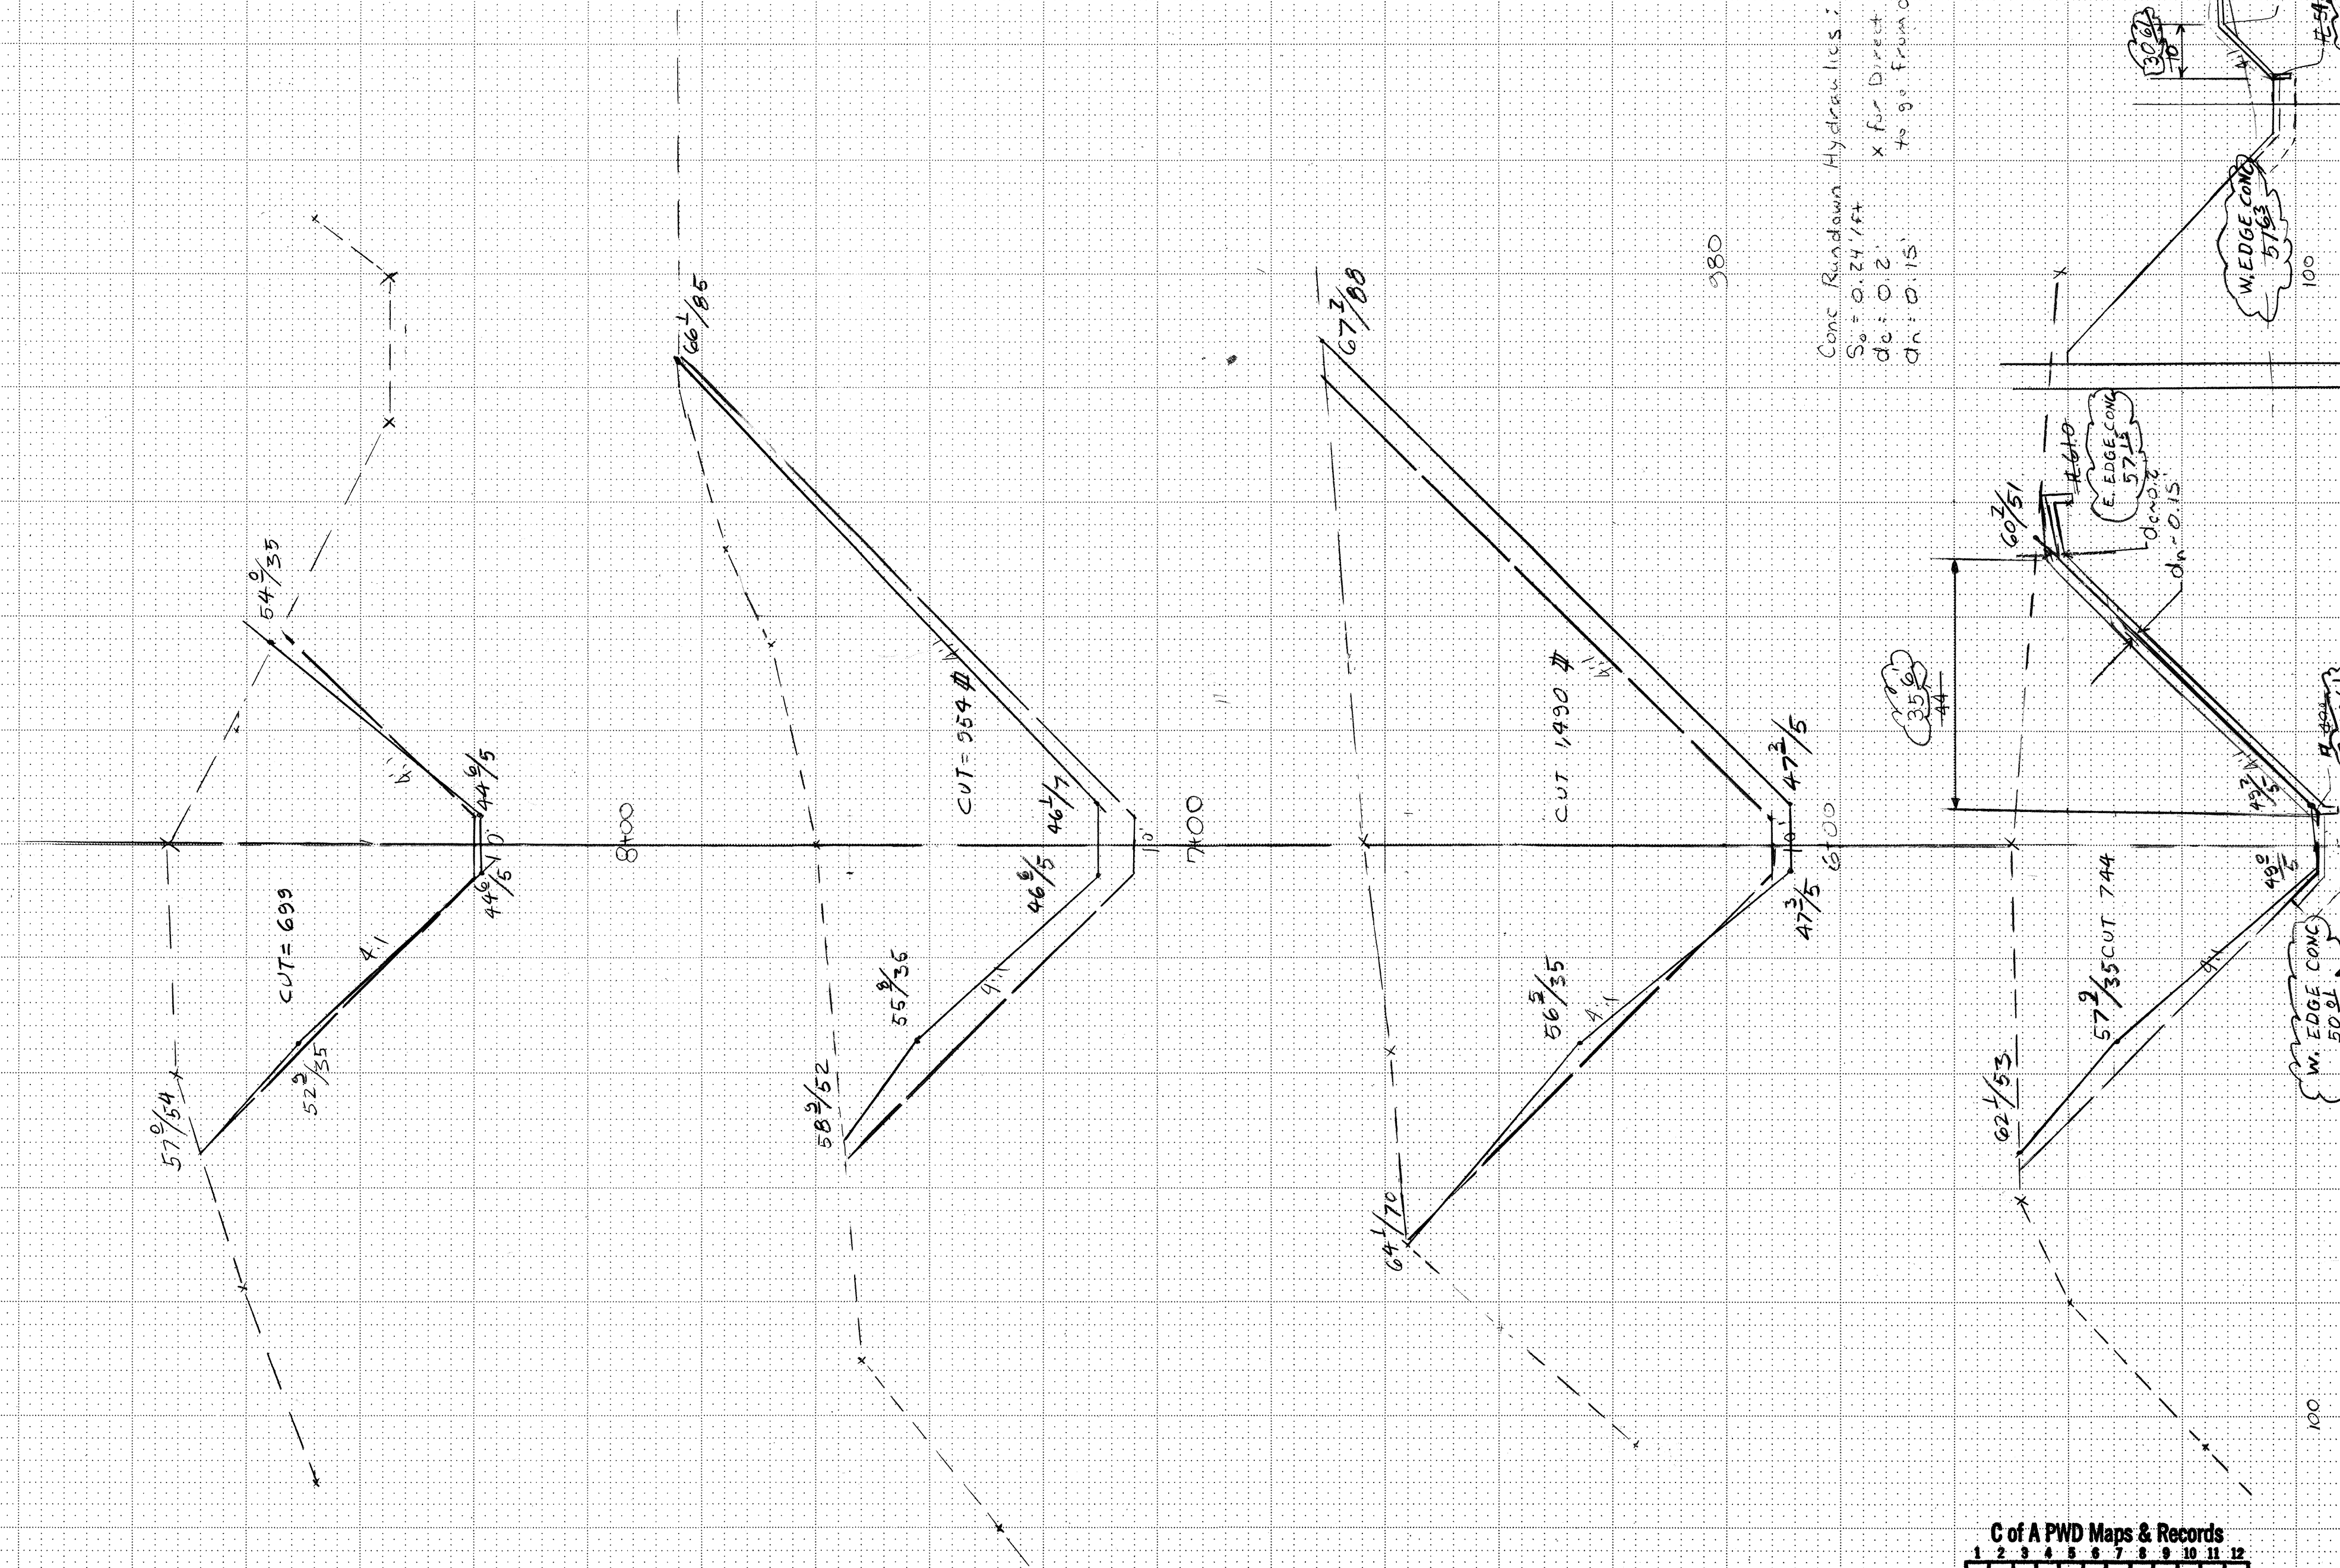

Conc. Run-down Hydraulics:
 $S_o = 0.24/ft$
 de: 0.2'
 dc: 0.15'
 x for Direct Step Method
 to go from dc to dn = 18.5'

C of A PWD Maps & Records											
1	2	3	4	5	6	7	8	9	10	11	12
26		4	2	0	6	0	8	9	0		

FRED:
Project CANCELLED.
SUCCEEDED BY NEWLY
SUBMITTED PROJECT ~~CLIFFORD PARK~~
INCLUDING THIS PROJ. +
PROPERTY TO NORTH. (CLIFFORD
INDUSTRIAL PARK.)
WAS 3628

Terri M

RECEIVED
JUL 5 1990
HYDROLOGY DIVISION

RECORD DRAWING
DATE 1 FEB 1990

9