
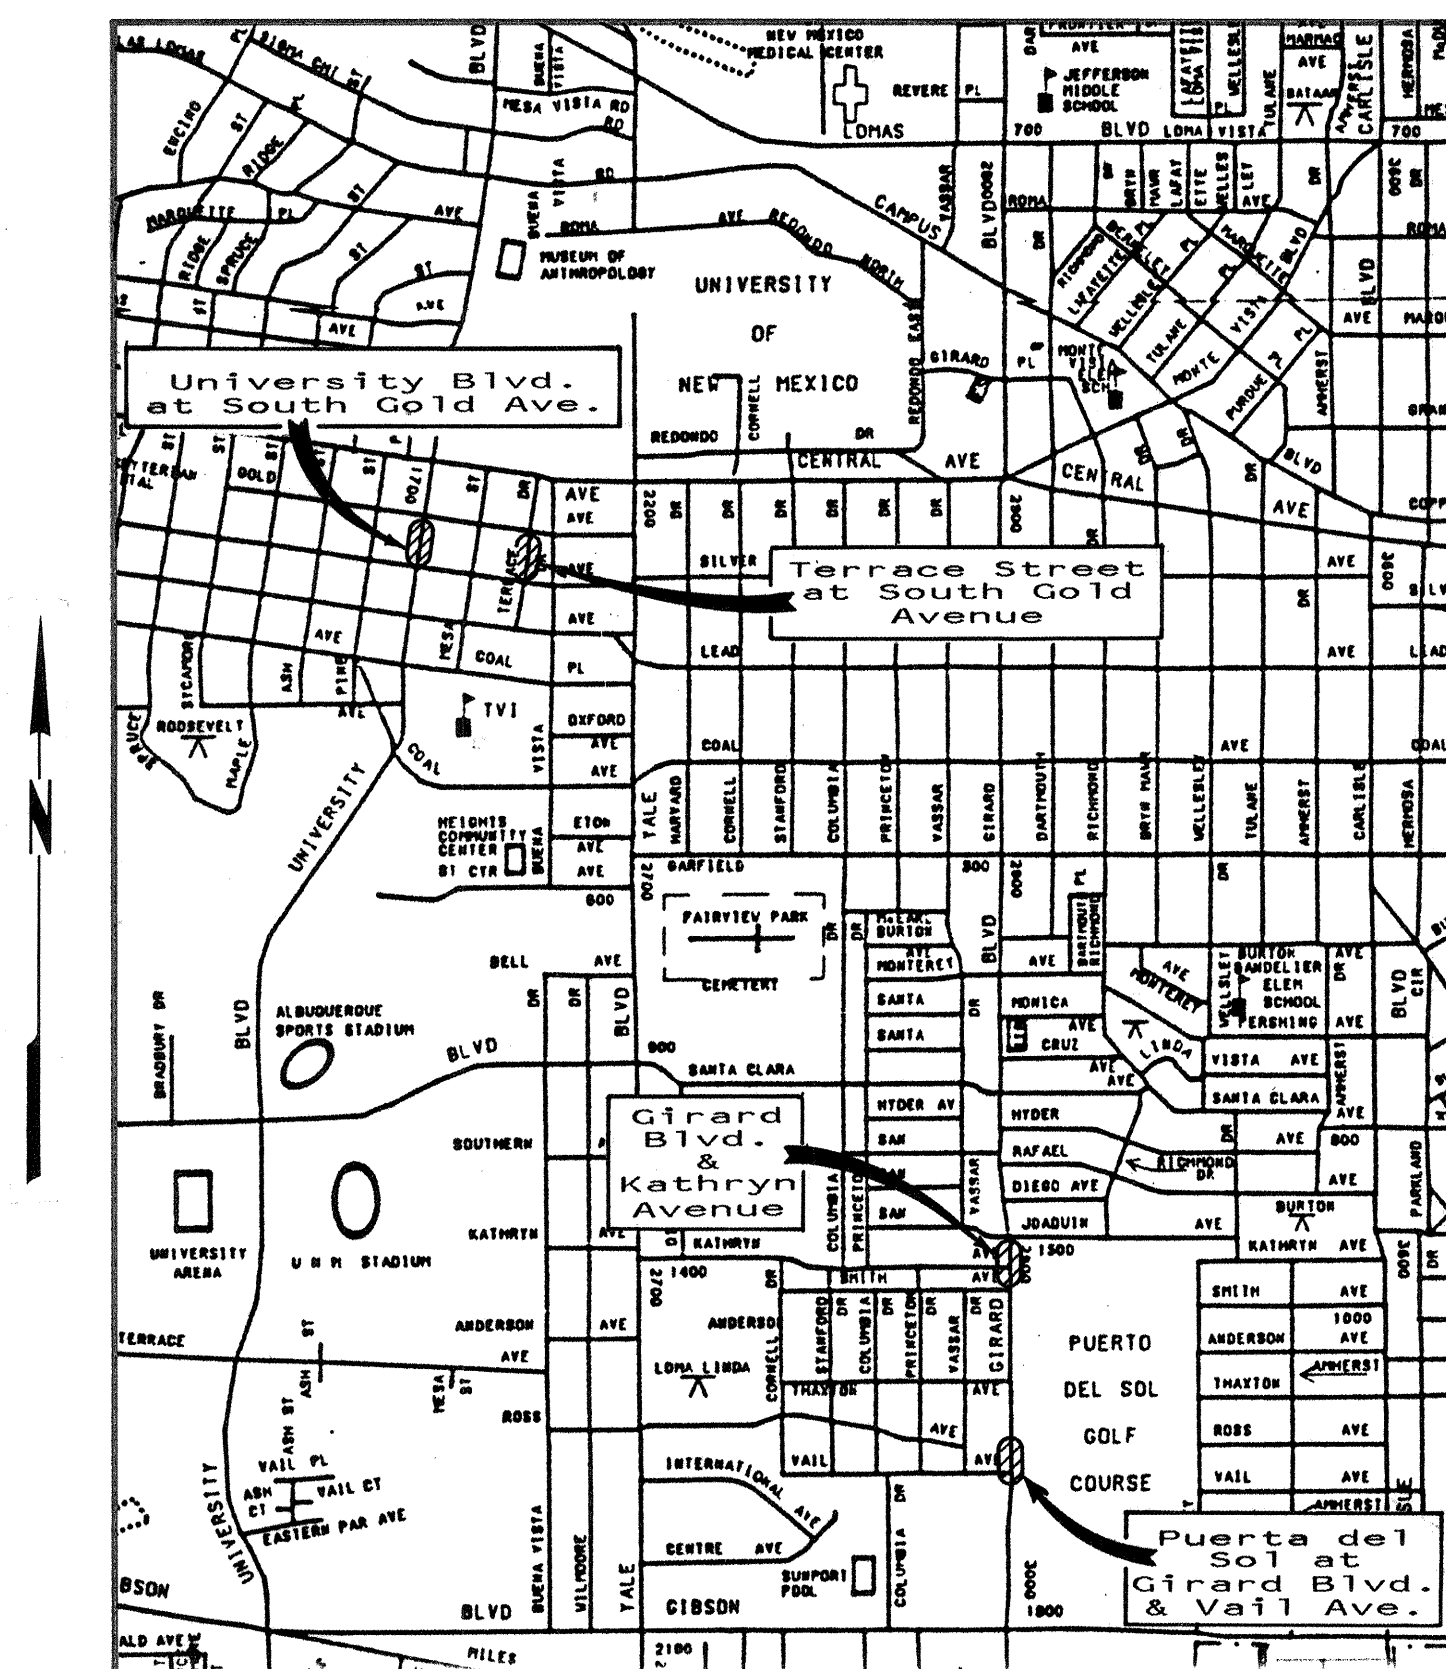


CONSTRUCTION PLANS FOR STORM DRAIN MODIFICATIONS

HYDROLOGY DIVISION
PUBLIC WORKS DEPARTMENT
CITY OF ALBUQUERQUE

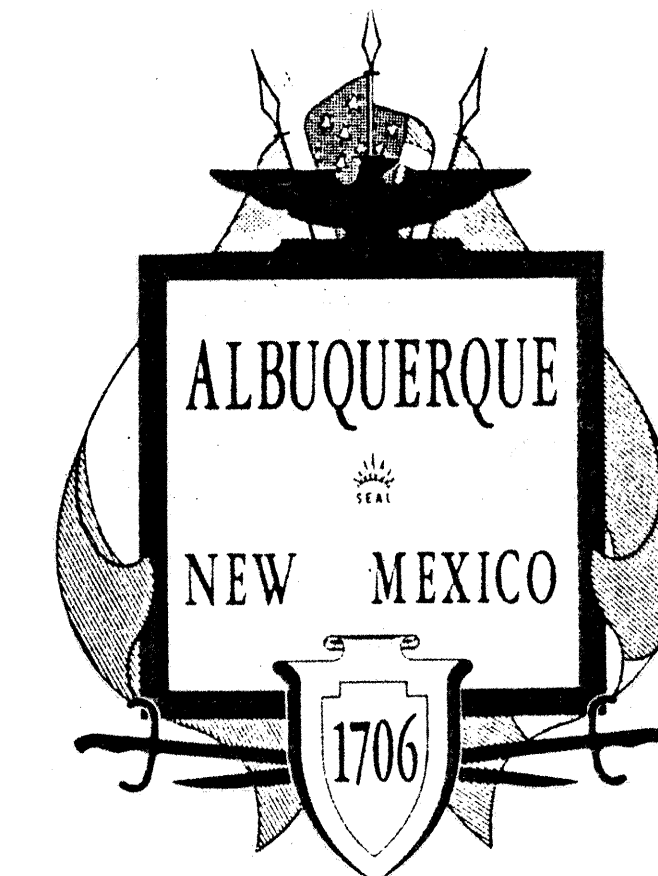

VICINITY MAP


NO SCALE

INDEX TO DRAWINGS

1. TITLE SHEET
2. UNIVERSITY BLVD. AT SOUTH GOLD AVE.
3. TERRACE STREET AT SOUTH GOLD AVE.
4. GIRARD BLVD. AND KATHRYN AVE.
5. PUERTA DEL SOL AT GIRARD & VAIL AVE.
6. DETAILS FOR PUERTA DEL SOL IMPROVEMENTS
7. TRAFFIC CONTROL PLAN

GENERAL NOTES


1. ALL WORK DETAILED ON THESE PLANS TO BE PERFORMED UNDER CONTRACT SHALL, EXCEPT AS OTHERWISE STATED OR PROVIDED FOR HEREON, BE CONSTRUCTED IN ACCORDANCE WITH THE CITY OF ALBUQUERQUE STANDARD SPECIFICATIONS FOR PUBLIC WORKS CONSTRUCTION 1986.
2. TWO (2) WORKING DAYS PRIOR TO ANY EXCAVATION, CONTRACTOR MUST CONTACT LINE LOCATING SERVICE @ 260-1990 FOR LOCATION OF EXISTING UTILITIES.
3. CONTRACTOR SHALL COMPLY WITH ALL REQUIREMENTS IN SECTION 19 OF THE SPECIFICATIONS, CONSTRUCTION TRAFFIC CONTROL.

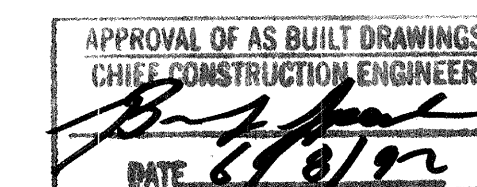

1 2 3 4 5 6 7 8 9 10 11 12 13 14 15
26 4230.900192


REV	SHEETS	CITY ENGR.	DATE	USER DEPT.	DATE	USER DEPT.	DATE

APPROVAL OF REVISIONS

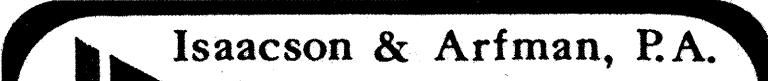 <i>3-13-91</i>		APPROVED FOR CONSTRUCTION <i>Russell B. Arfman</i> <i>3-27-91</i>
PROJECT NO. 4230.90		SHEET 1 OF 7



REMOVAL/REPLACEMENT NOTES

1. REMOVE, DISPOSE & REPLACE 12 LF CURB & GUTTER.
2. REMOVE, DISPOSE & REPLACE 8 SY PCC DRIVEPAD.
3. REMOVE & DISPOSE 116 SY RESIDENTIAL PAVING.
4. REPLACE 95 SY RESIDENTIAL PAVING.
5. REMOVE & DISPOSE 60 LF 18" RCP

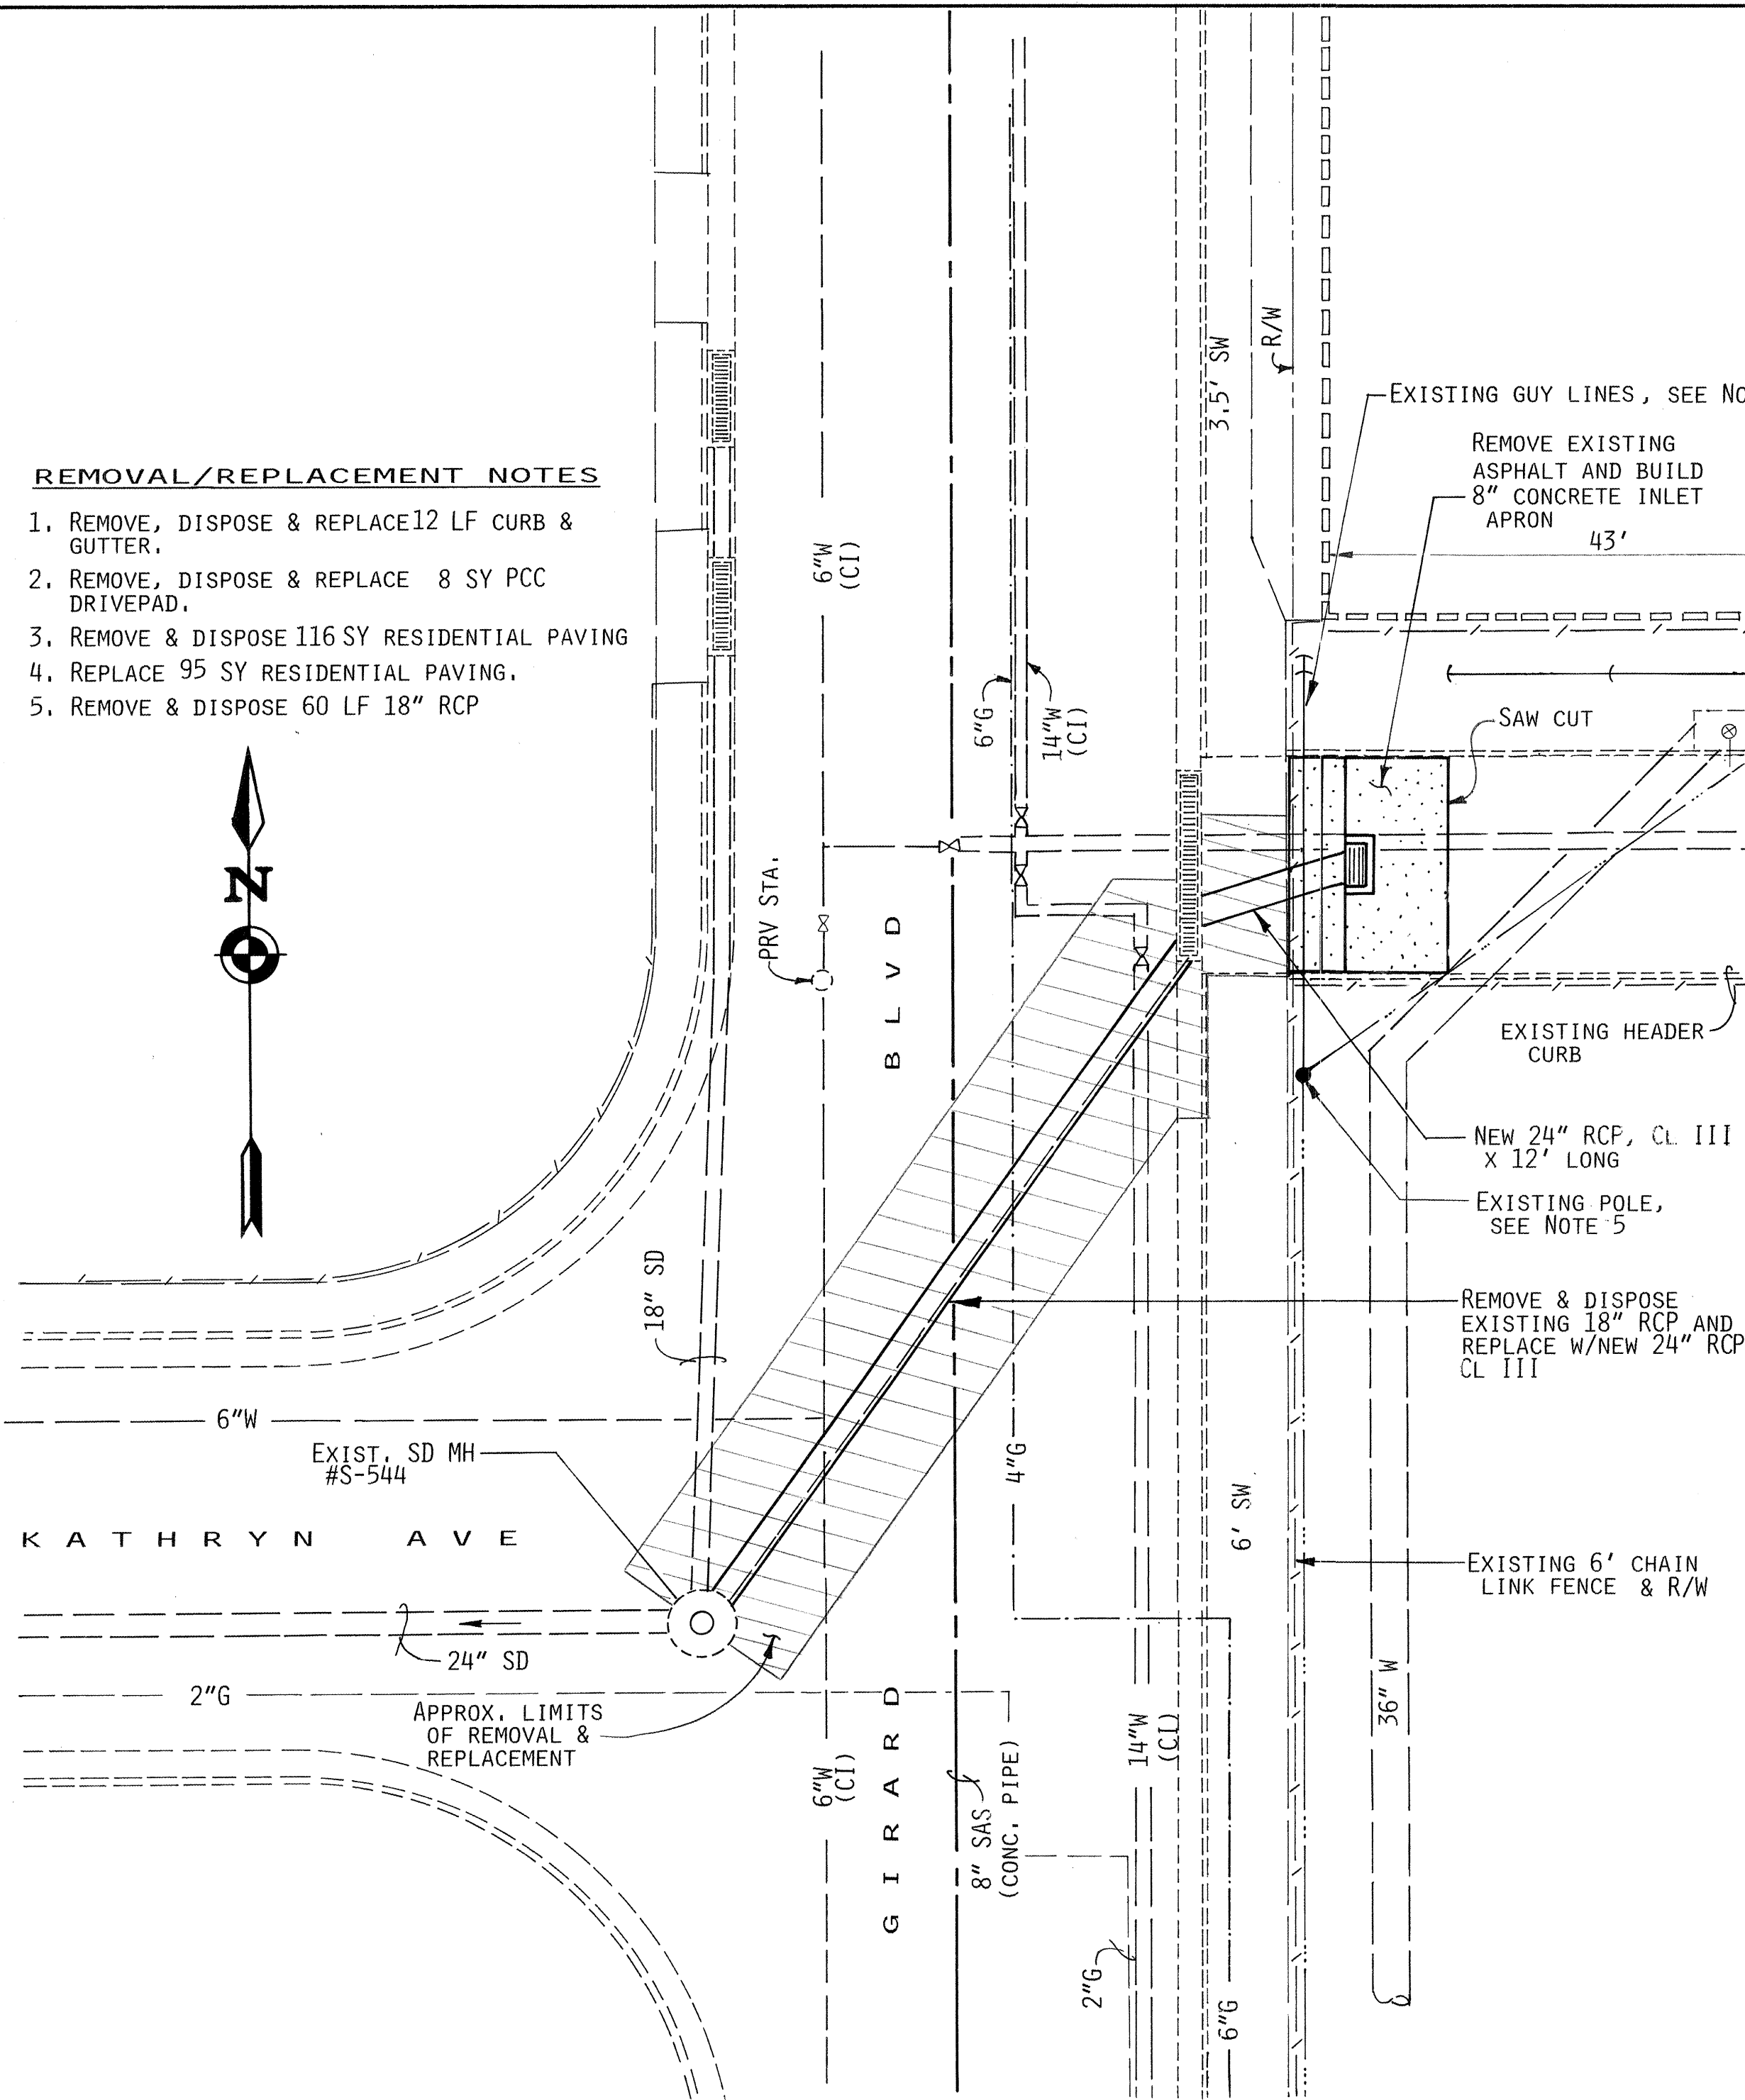


NEW INLET & CONNECTOR PIPE - GIRARD & KATHRYN

SCALE: 1"=10' HOR., 1"=5' VERT.

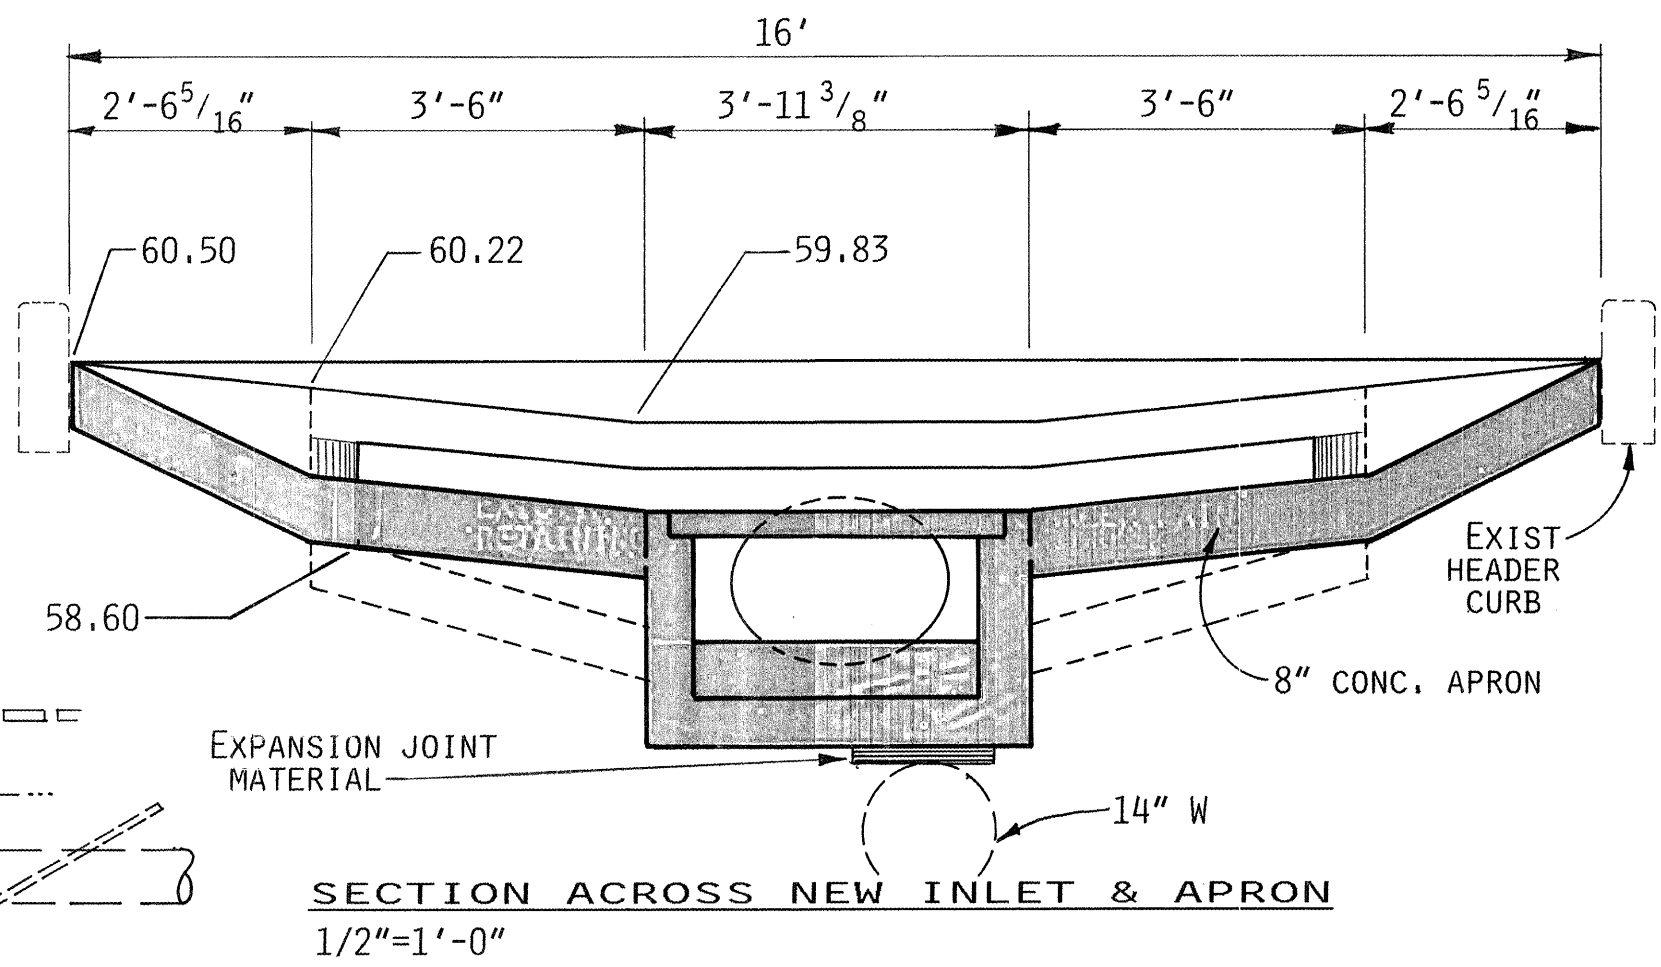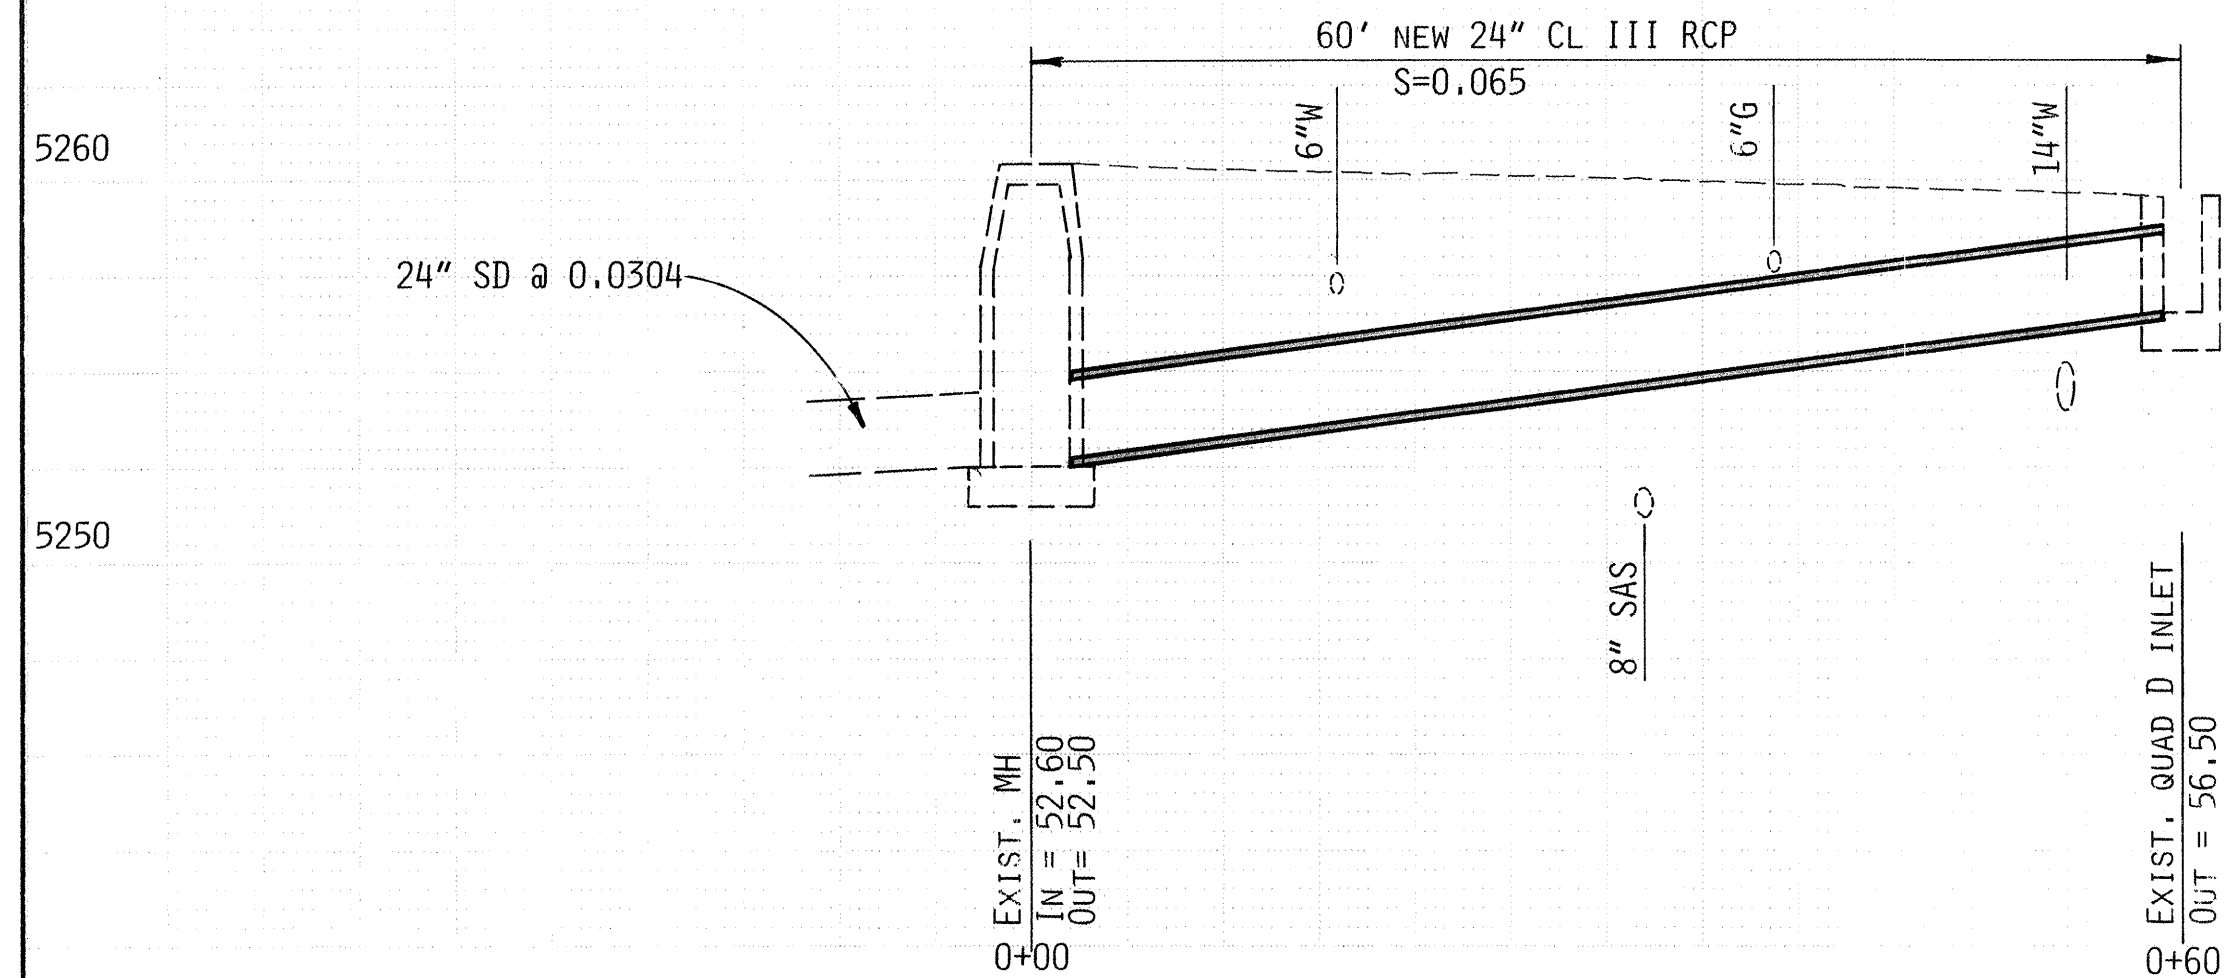


SECTION ACROSS NEW INLET & APRON
1/2"=1'-0"

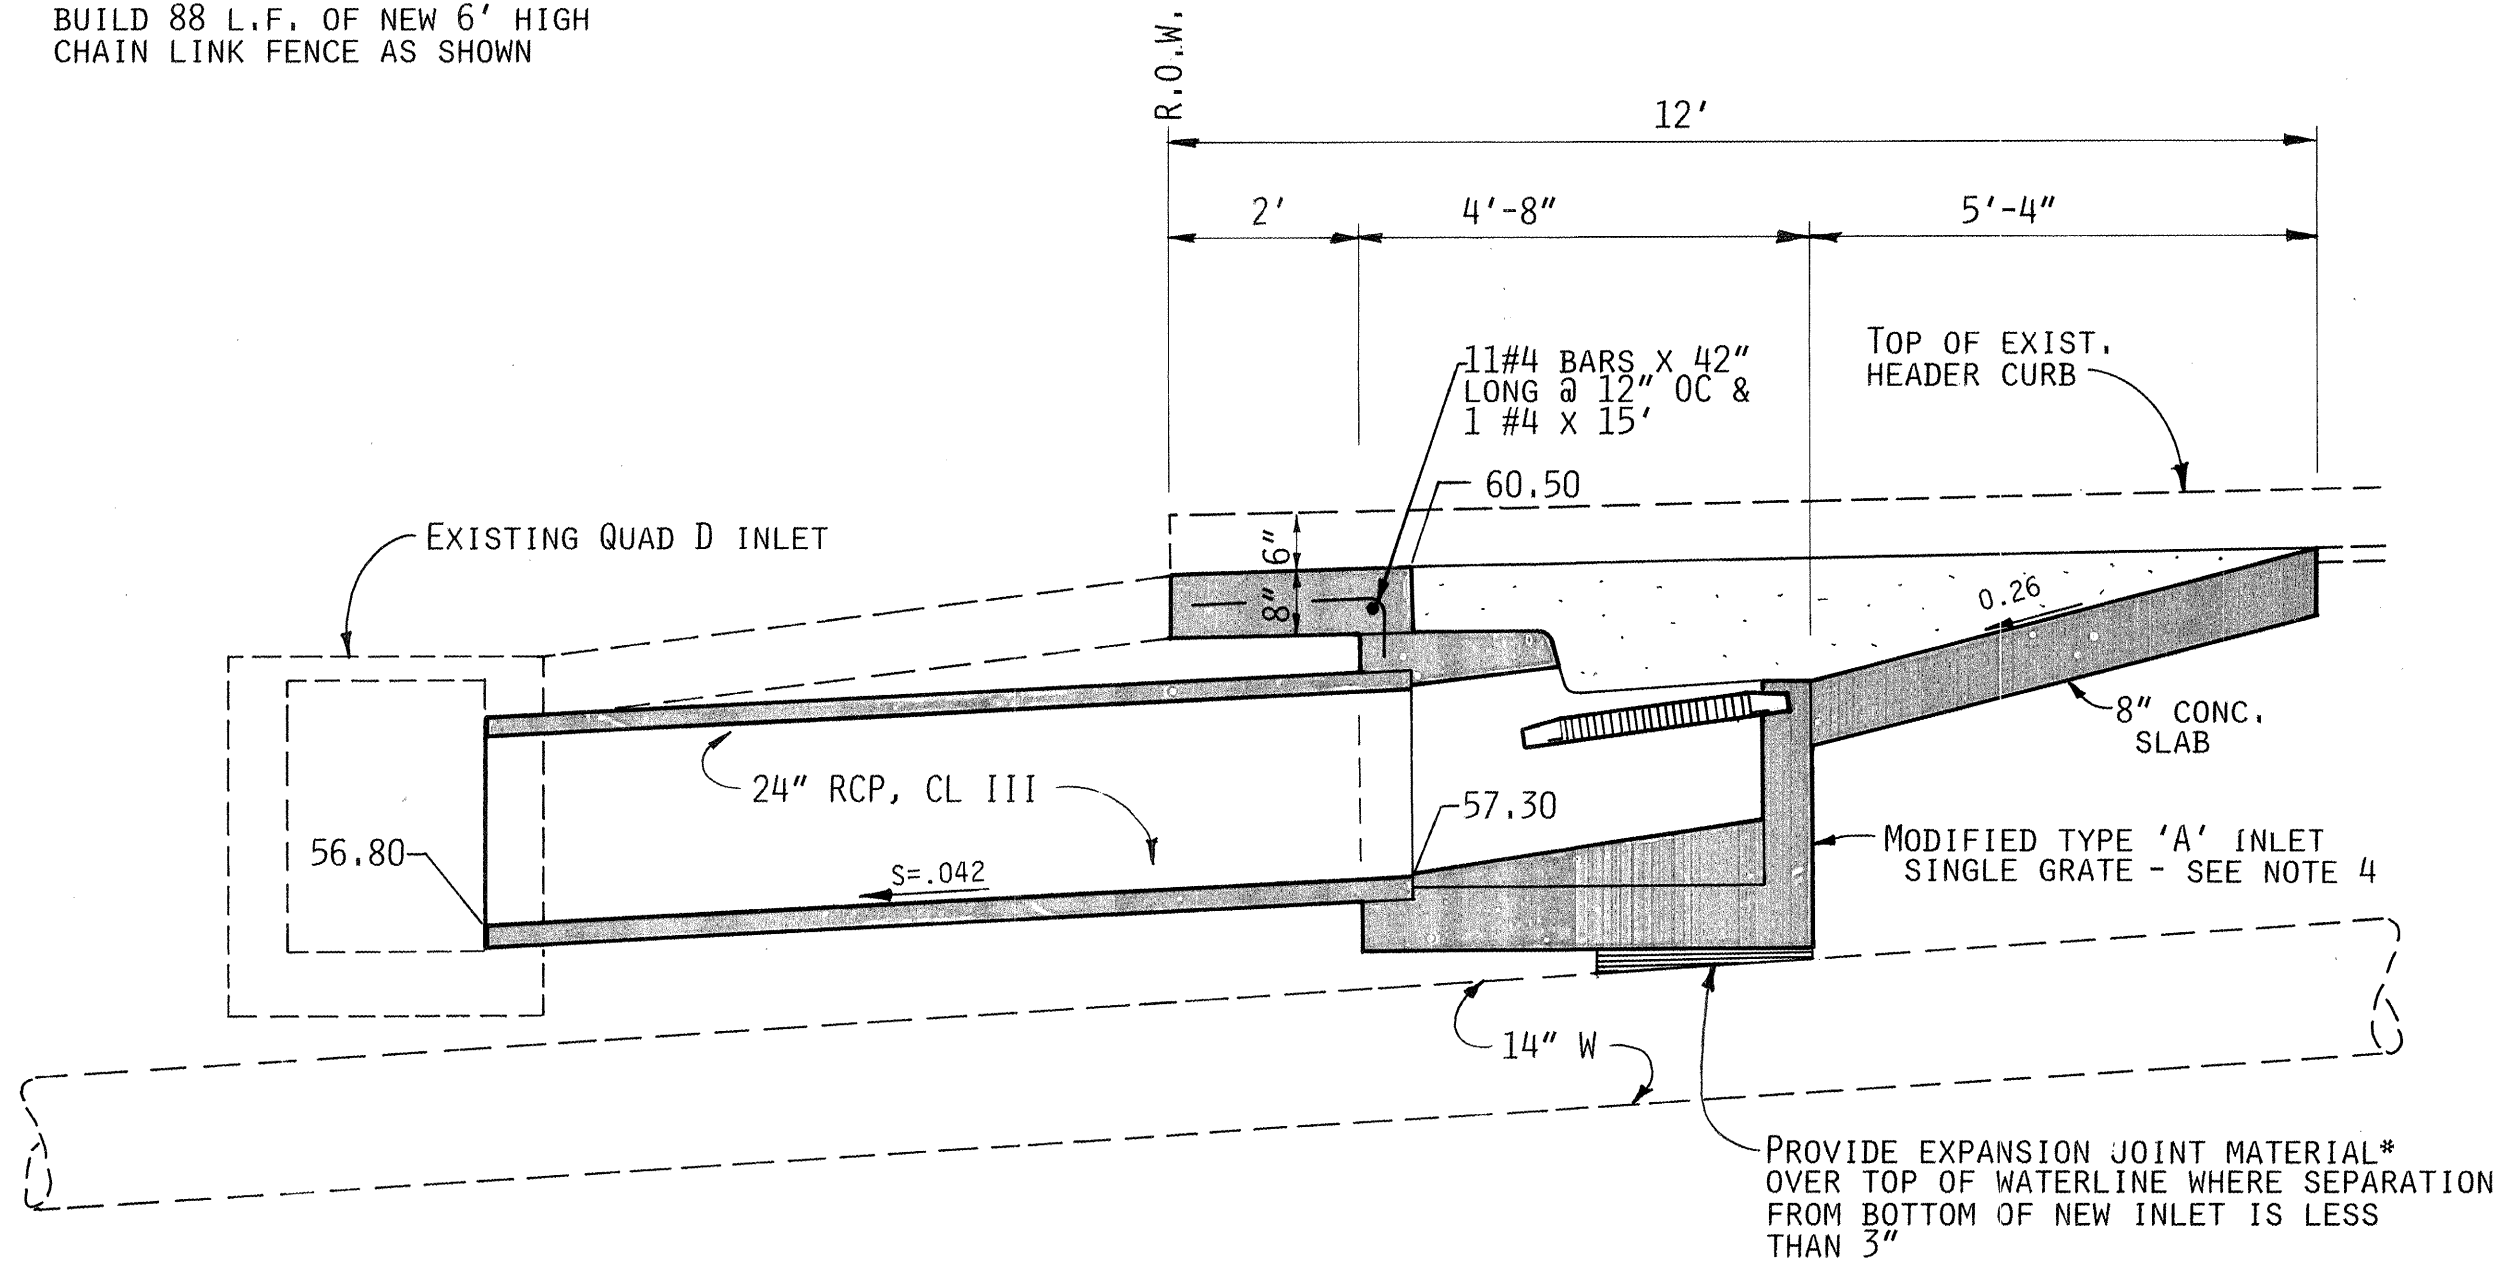

SECTION ALONG NEW INLET & CONNECTOR LINE
1/2"=1'-0"

*BURKE FIBER EXPANSION JOINT, GROUP ORDER NO. 236, OR APPROVED EQUAL. INCIDENTAL COST TO STORM INLET.

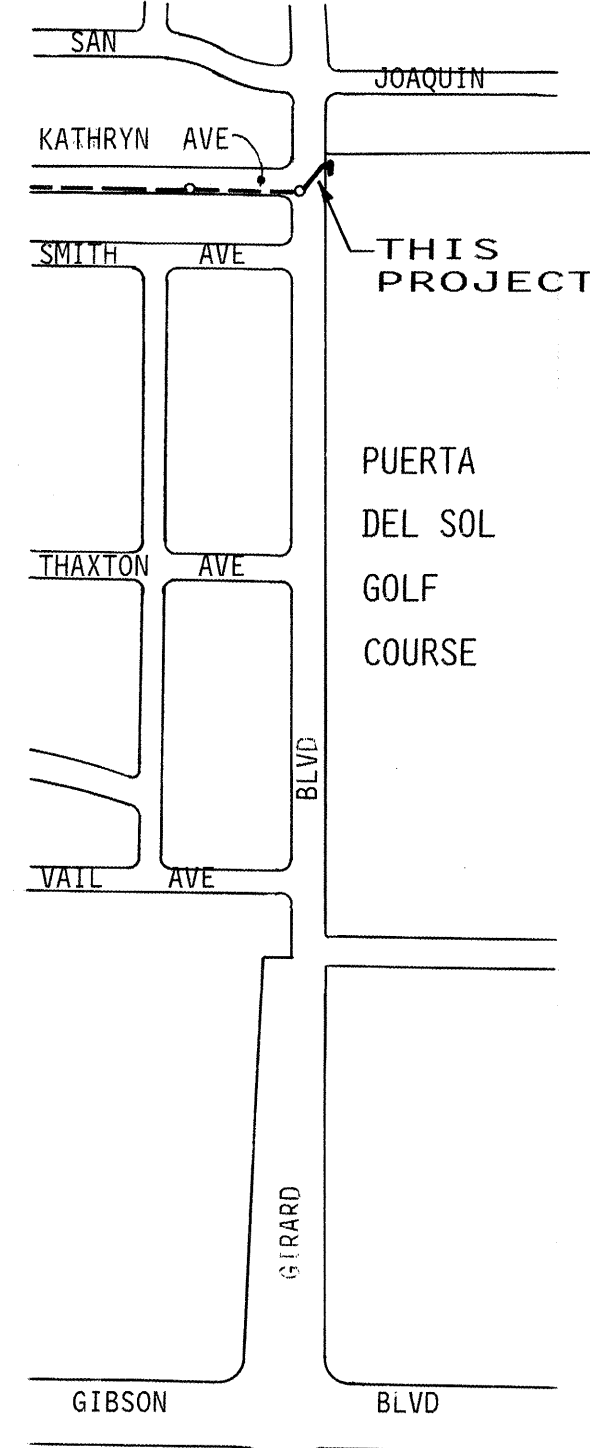

LOCATION MAP
1"=400'


NOTES

1. REPLACE PAVEMENT CUT IN ACCORDANCE WITH CITY STANDARD DETAIL NO. 2465 FOR RESIDENTIAL STREETS.
2. CONTRACTOR TO COORDINATE ALL CONSTRUCTION WORK ON THE PUERTA DEL SOL GOLF COURSE WITH THE GOLF COURSE SUPERINTENDENT, BILL SKINNER 256-2090.
3. CONTRACTOR SHALL BE FULLY RESPONSIBLE FOR SECURING THE GOLF COURSE SECURITY FENCE AT THE COMPLETION OF EACH WORK DAY.
4. INLET IS SIMILAR TO STD. DWG. 2201 MODIFIED FOR TWO CURB OPENINGS CONFIGURED AS SHOWN. ALL OTHER FEATURES ARE IDENTICAL.
5. PNM TO REMOVE GUY WIRE AND SUPPORT POLE TO ACCOMMODATE CONSTRUCTION. CONTRACTOR TO CALL JIM VANN (PNM) @ 848-3426 AND BARBARA MCCRAY (US WEST) @ 245-6023, FIVE DAYS PRIOR TO CONSTRUCTION FOR CO-ORDINATION.

AS BUILT INFORMATION		BENCH MARKS		SURVEY INFORMATION		ENGINEER'S SEAL		REVISIONS		DESIGN		DATE	
CONTRACTOR	J.R. HALE	DATE	3/20/92	NO.	10/90	BY	W. PETTIT	NO.	1	DATE	3/91	DATE	3/91
INSPECTOR'S	C.O.A.	DATE	3/20/92	BY				REMARKS		DESIGN		DATE	3/91
FIELD	7/7/92	DATE	3/20/92									DATE	3/91
VERIFICATION	7/7/92	DATE	3/20/92									DATE	3/91
CONSTRUCTION	7/7/92	DATE	3/20/92									DATE	3/91
NO.													



26 4230.900492

CITY OF ALBUQUERQUE PUBLIC WORKS DEPARTMENT ENGINEERING GROUP			
TITLE: STORM DRAIN MODIFICATIONS GIRARD & KATHRYN			
APPROVALS	ENGINEER	DATE	DATE
D.R.C. Chair	3-26-91	Water	3-20-91
Trans. Dev.	3-20-91	Waste Water	3-20-91
Hydrology	3-25-91		
PROJECT NO.	4230.90	MAP NO.	L-16
SHEET	4	OF	7

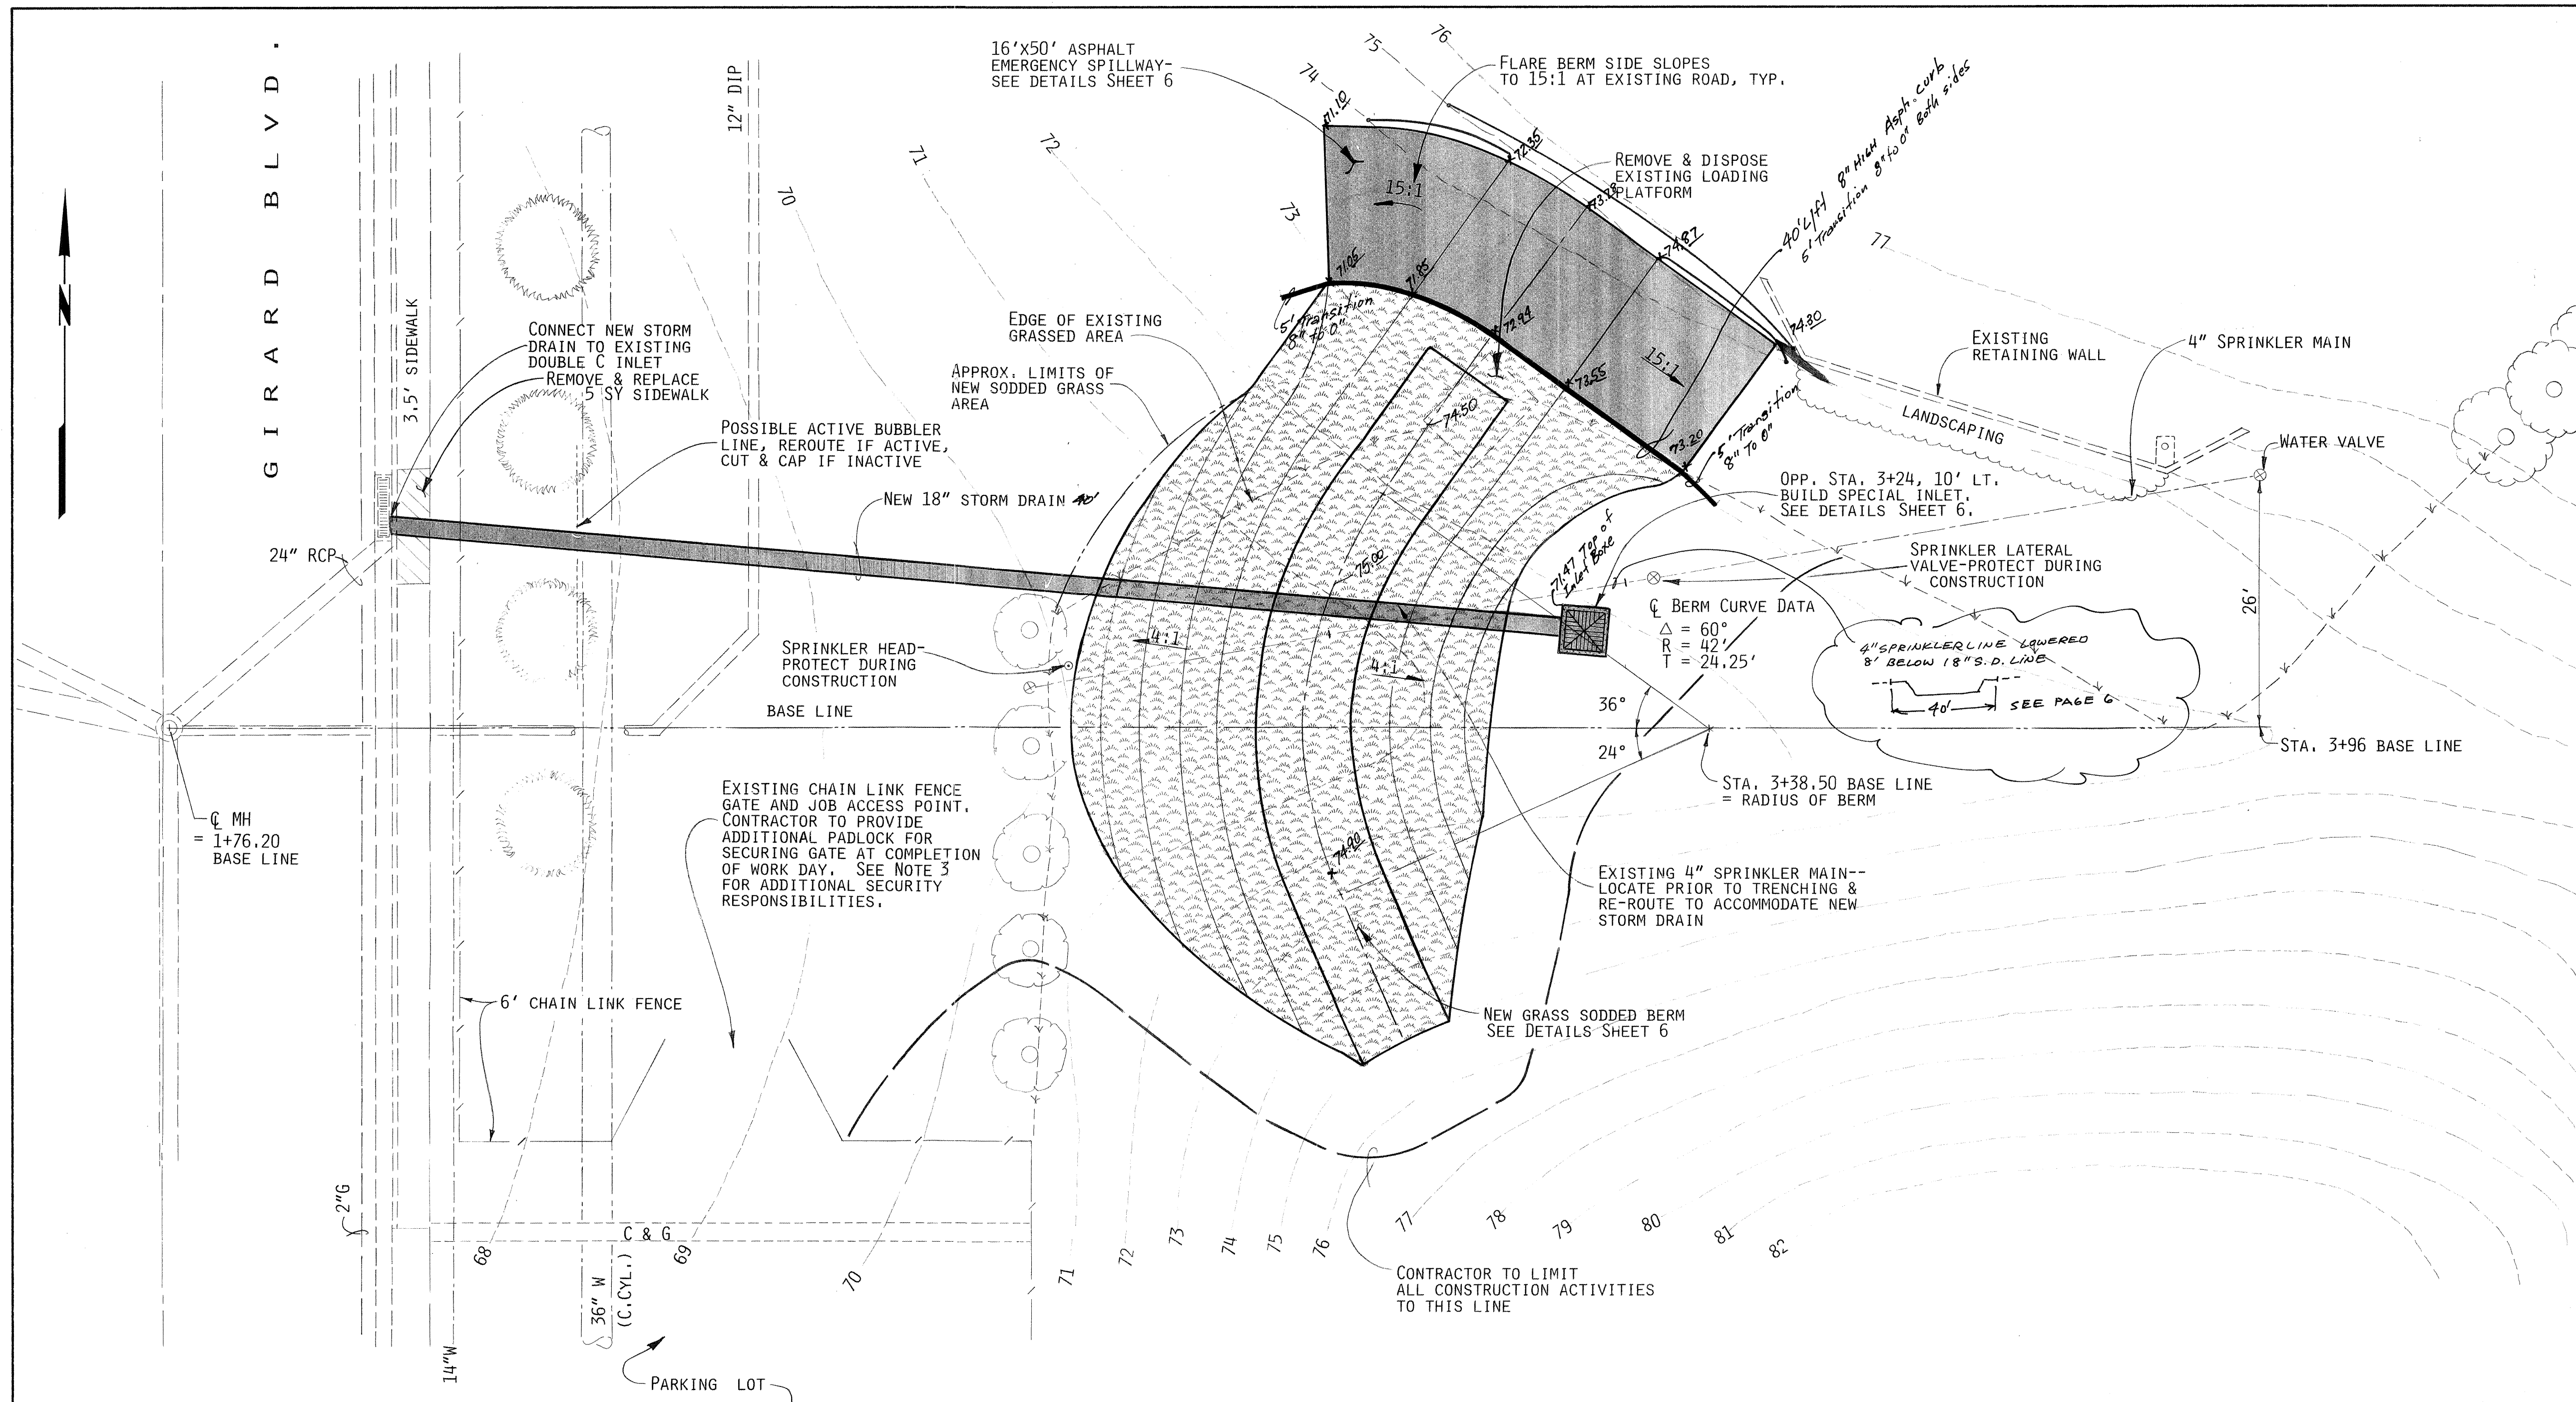


INTERCEPTING & DETENTION FACILITIES - PUERTA DEL SOL at GIRARD & VAIL

SCALES:
1"=10' HOR.
1"=5' VER.

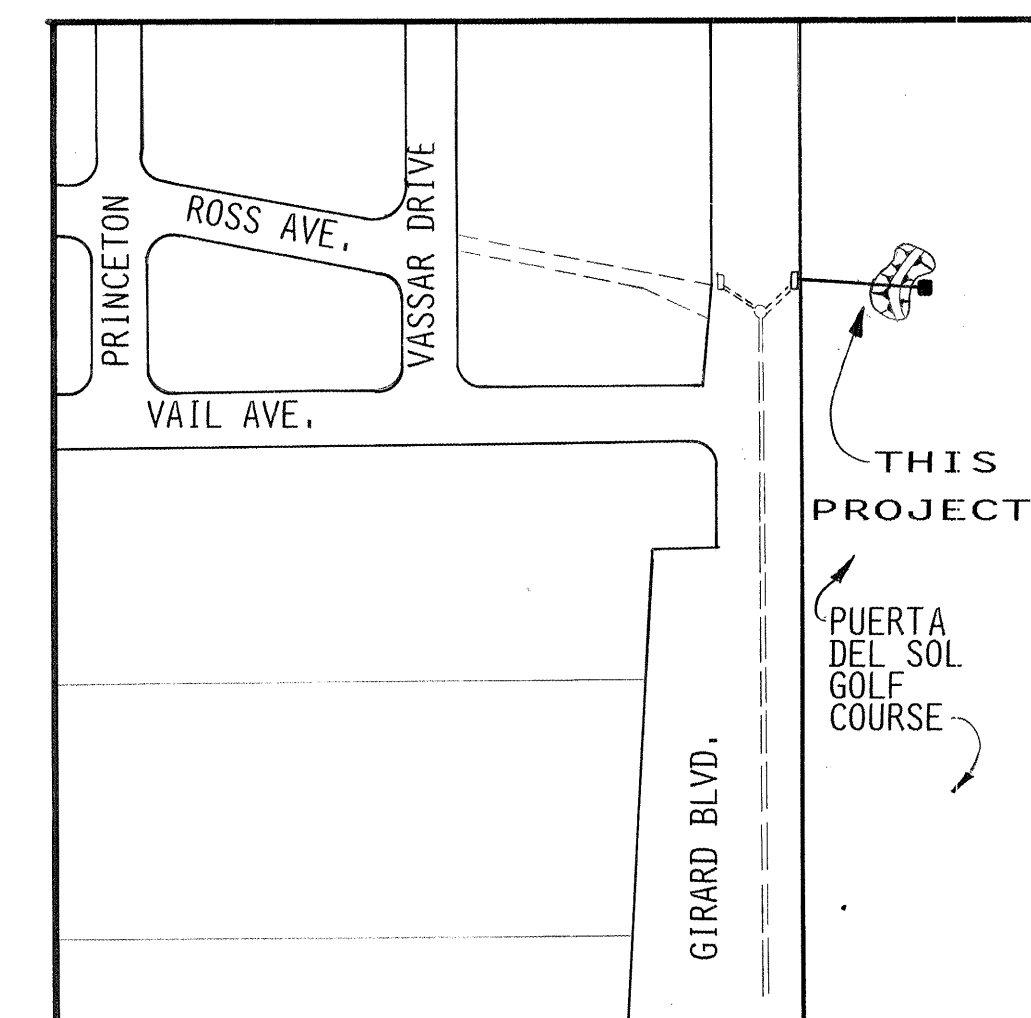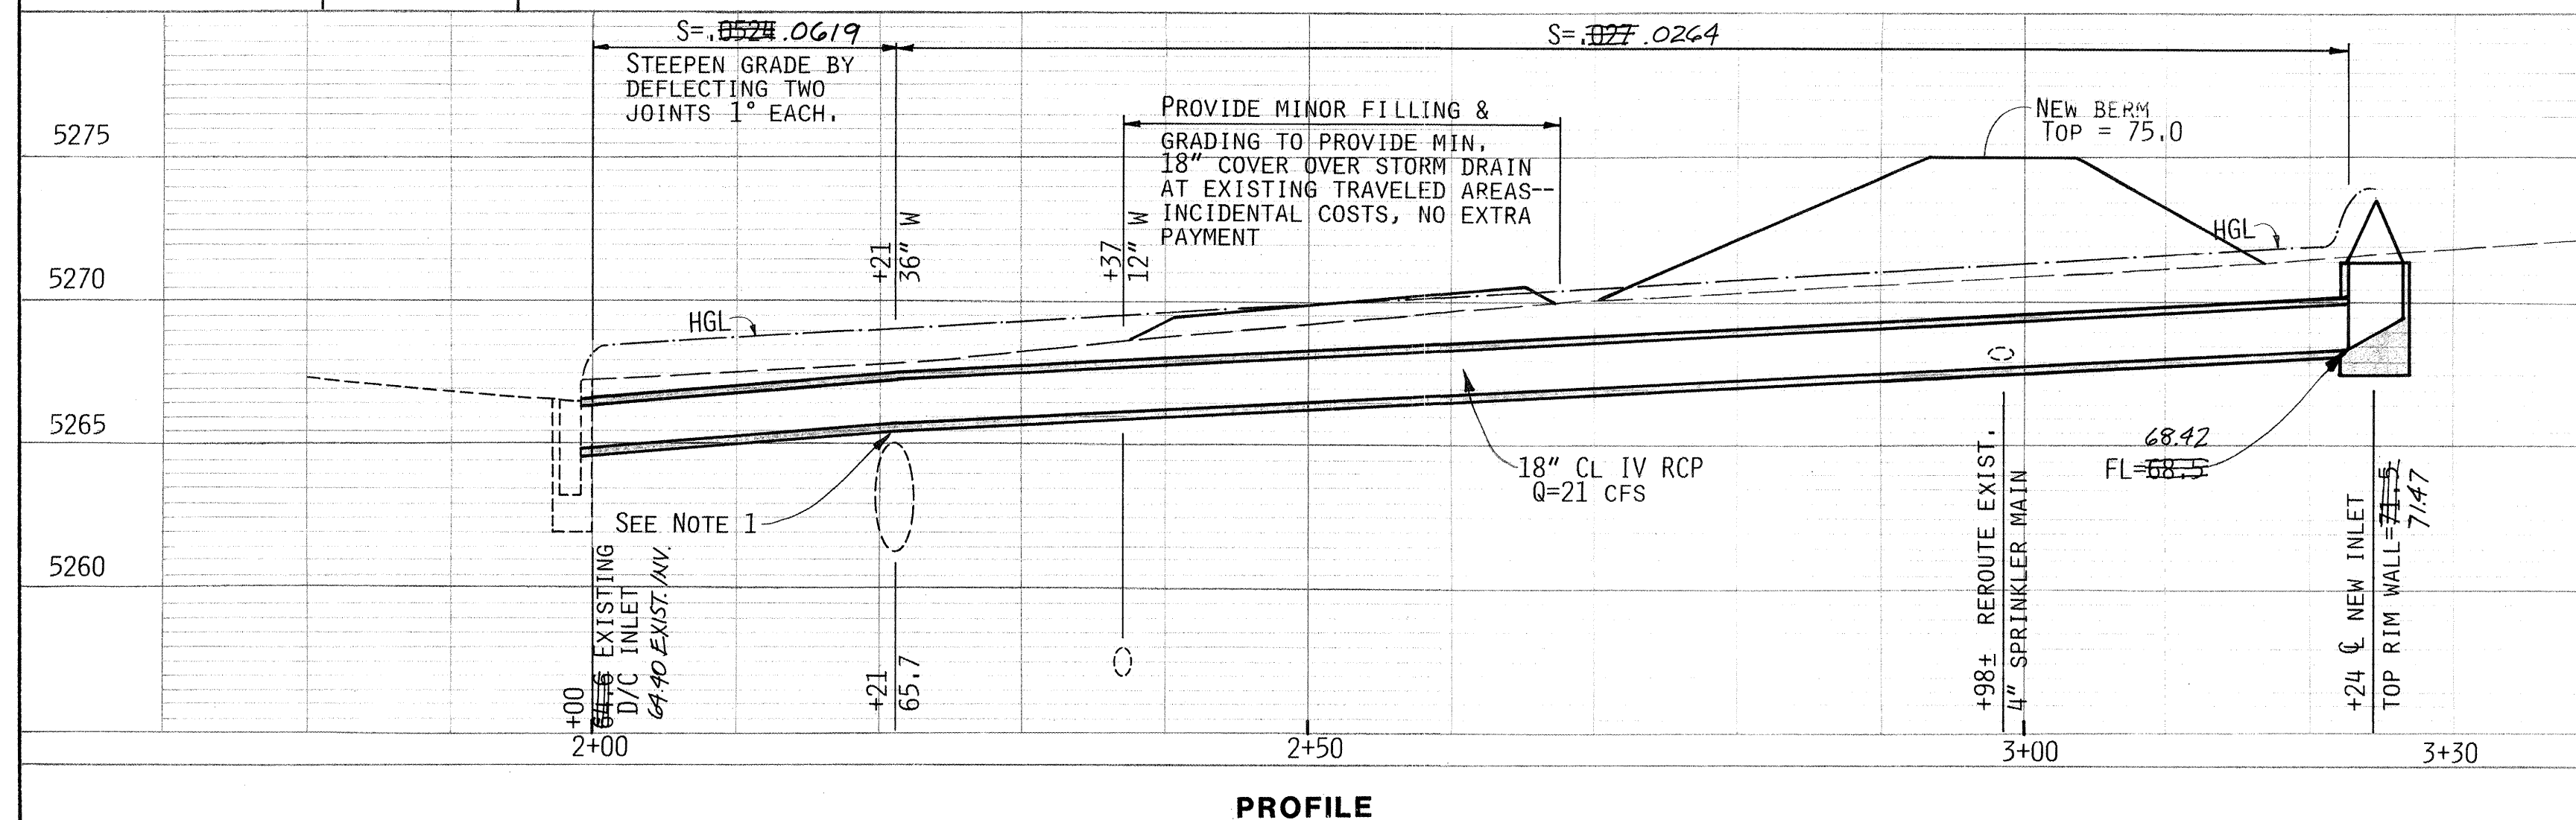


CONSTRUCTION NOTES

1. LOCATE AND UNCOVER EXISTING 36" WATERLINE PRIOR TO INSTALLING NEW STORM DRAIN. DETERMINE STATION AND ELEVATION OF TOP OF PIPE AND ADVISE ENGINEER AND INSPECTOR. ENGINEER OR INSPECTOR MAY REVISE GRADES TO LOWER NEW STORM DRAIN IF ELEVATIONS PERMIT OR MAY ORDER PREFABRICATED STORM DRAIN ELBOW IF WATERLINE IS HIGHER THAN SHOWN. PROVIDE MINIMUM 6" CLEARANCE BETWEEN LINES AND INSTALL 3'X3'X6" EXPANSION JOINT MATERIAL CUSHION BETWEEN LINES--INCIDENTAL ITEM, NO EXTRA PAYMENT.
2. CONTRACTOR TO COORDINATE ALL CONSTRUCTION WORK WITH THE GOLF COURSE SUPERINTENDENT, BILL SKINNER, 256-2090.
3. CONTRACTOR WILL BE FULLY RESPONSIBLE FOR SECURING THE SITE AT COMPLETION OF WORK EACH DAY-- COURSE MAINTENANCE STAFF IS ANTICIPATED TO LEAVE COURSE BEFORE CONTRACTOR DURING SPRING AND SUMMER SEASON.

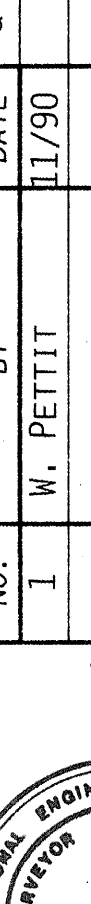ENGINEER'S SEAL				SURVEY INFORMATION				BENCH MARKS				AS BUILT INFORMATION			
 <i>W. Pettit</i> 3/13/91				FIELD NOTES				CHISELED ON CURB @ SSW RETURN OF GIRARD & VAIL, COA NO. 11-116, ELEV = 5270.72				CONTRACTOR <i>J.R. HALE</i>			
				NO. BY DATE								DATE			
				1 W. PETTIT 11/90								DATE 6/91			
												INSPECTOR'S <i>C.O.A.</i>			
												DATE 3/20/92			
												PLACED MADE BY <i>J. Hale</i>			
												DATE 3/20/92			
												VERIFICATION BY <i>J. Hale</i>			
												DATE 3/20/92			
												CONFIRMED BY <i>J. Hale</i>			
												DATE 3/20/92			
												MICRO-FILM INFORMATION			
												RECORDED BY			
												DATE			
												NO.			

CITY OF ALBUQUERQUE PUBLIC WORKS DEPARTMENT ENGINEERING GROUP					
TITLE: INTERCEPTING & DETENTION FACILITIES PUERTA DEL SOL at GIRARD & VAIL					
APPROVALS	ENGINEER	DATE	APPROVALS	ENGINEER	DATE
D.R.C. Chair	3-26-91	Water		3-20-91	
Trans. Dev.	3-20-91	Waste Water		3-20-91	
Hydrology	3-25-91				
PROJECT NO.	4230.90	MAP NO.	L-16	SHEET	5 OF 7

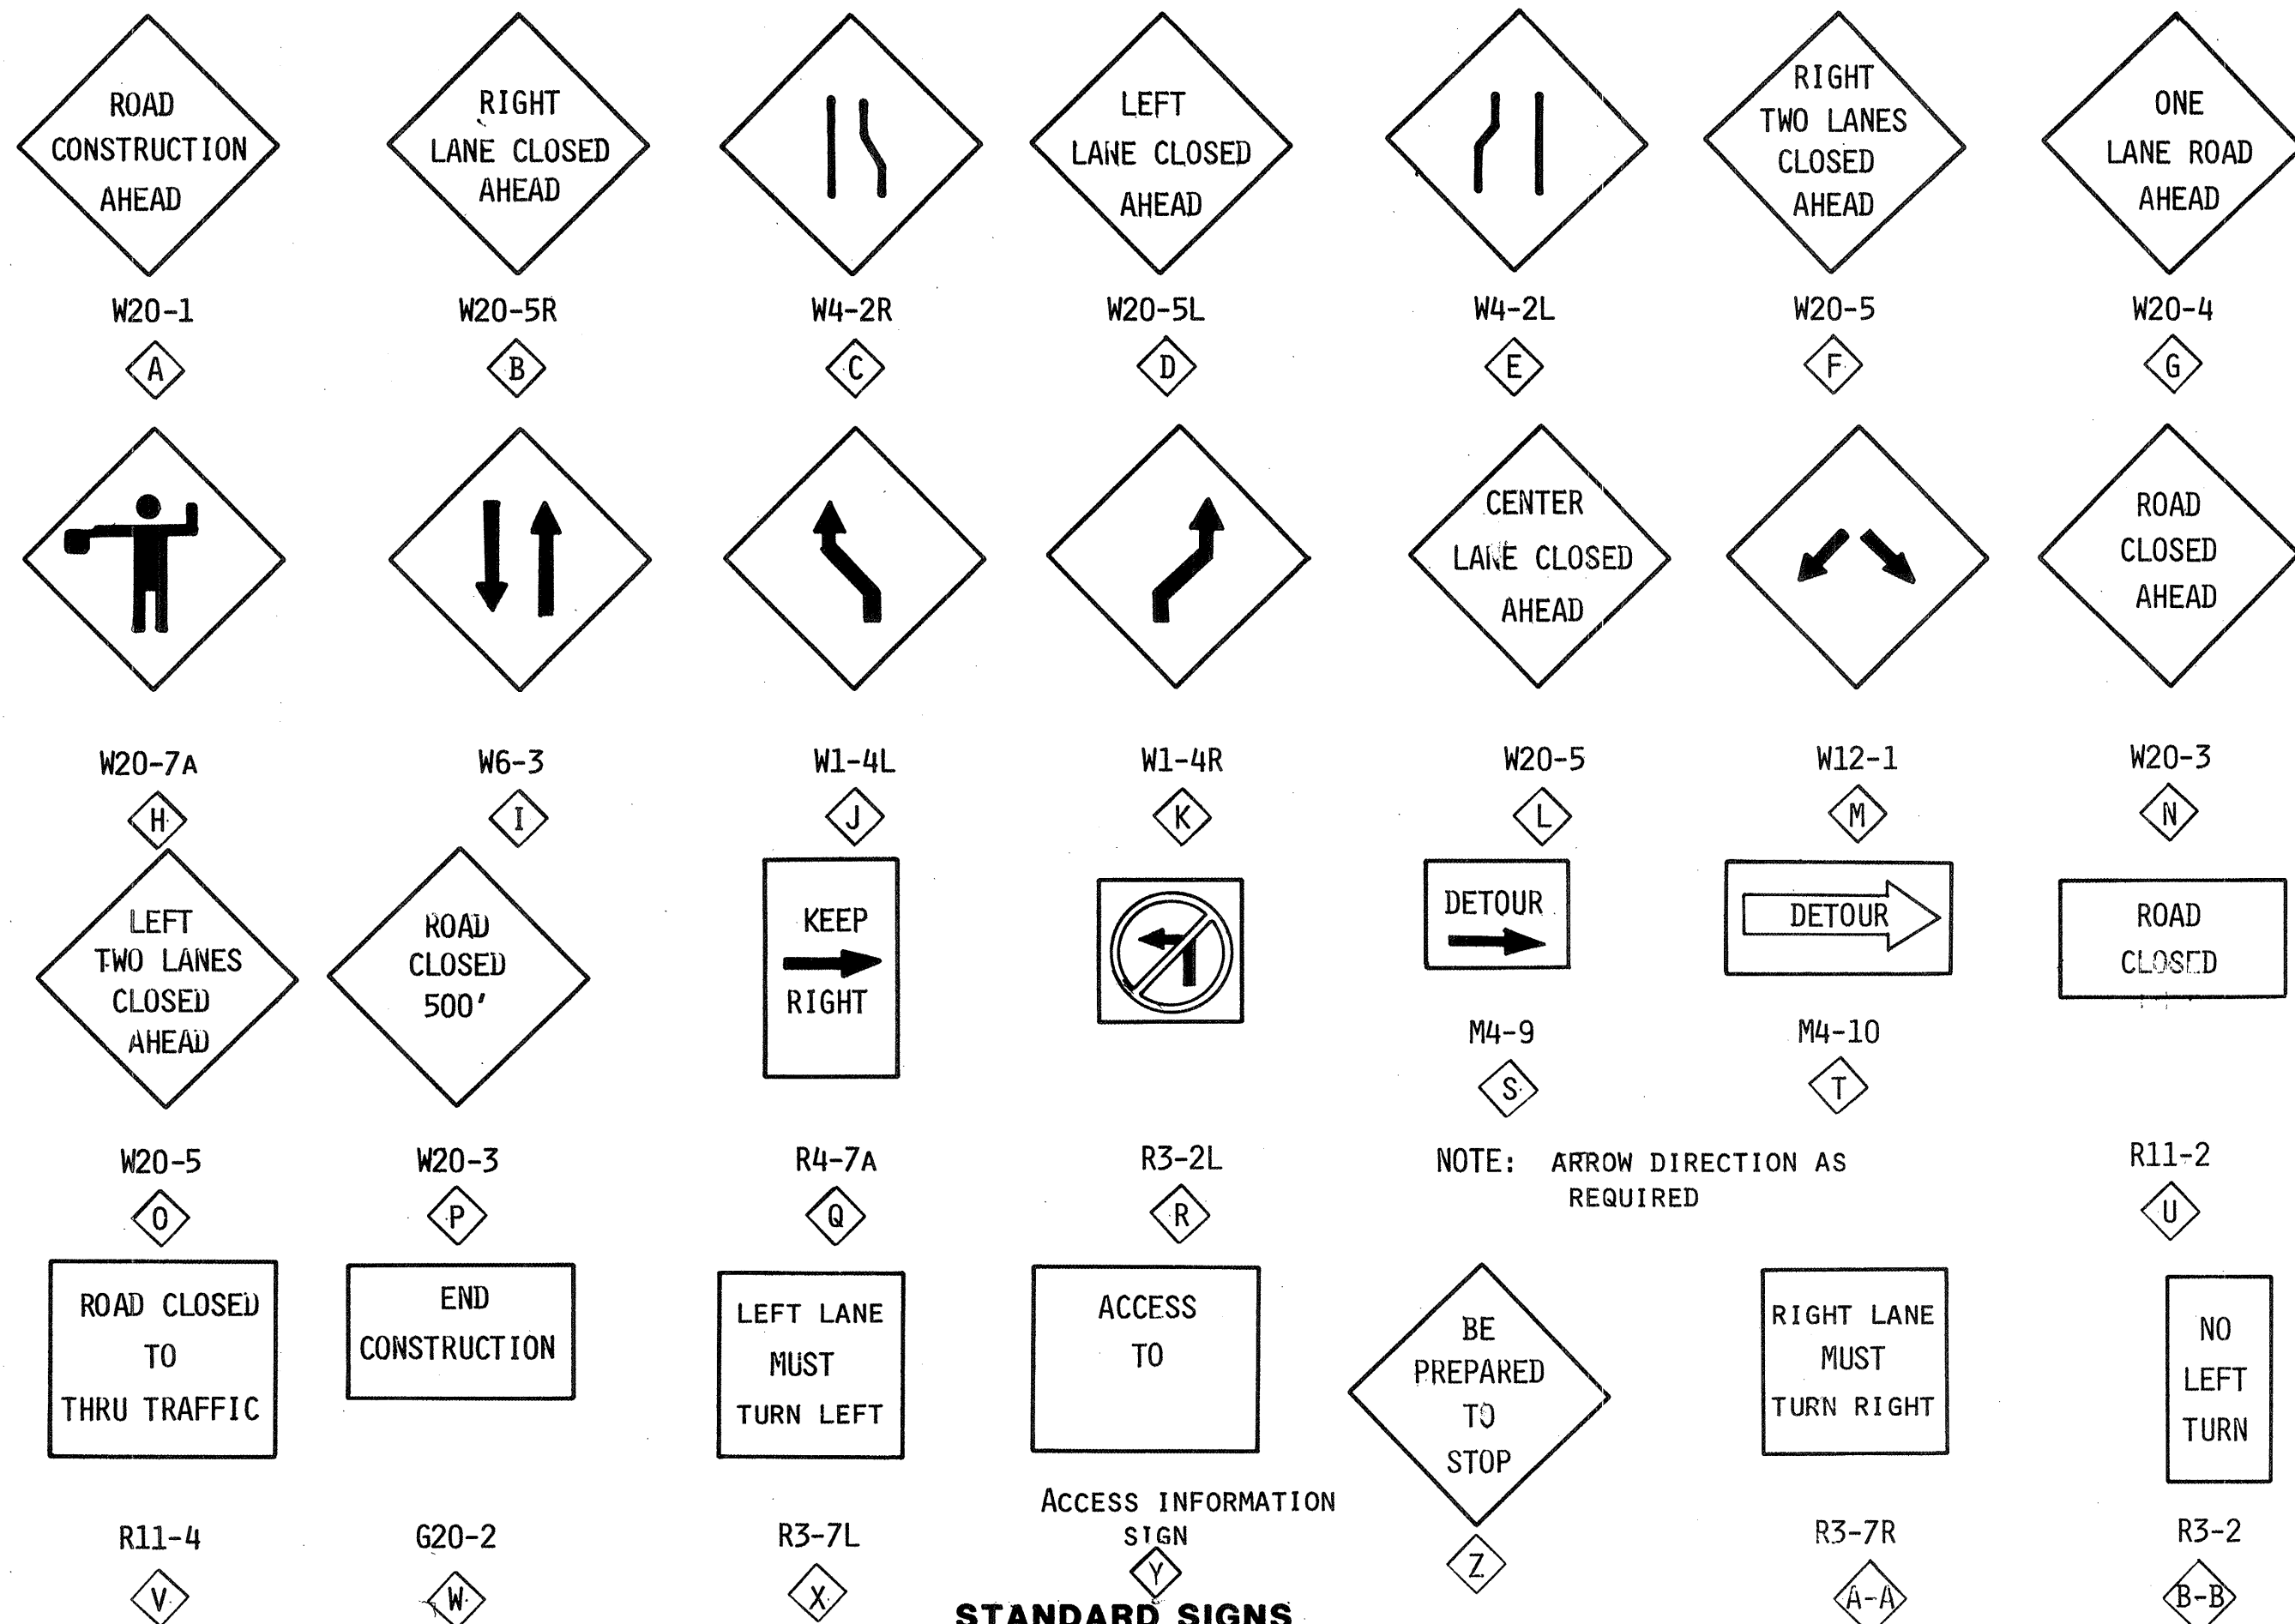

STANDARD SIGNS

NO SCALE


SPEED LIMIT (MPH)	TAPER LENGTH (FEET)			MAXIMUM DISTANCE BETWEEN DEVICES (FEET)	MINIMUM NUMBER OF DEVICES REQUIRED
	10' LANE	11' LANE	12' LANE		
25	104	115	125	25	6
30	150	165	185	30	7
35	204	225	245	35	8
40	267	293	320	40	9
45	450	495	540	45	13
50	500	550	600	50	13
55	550	605	660	55	13

LEGEND

- WORK AREA
- TRAFFIC SIGN & QUANTITY (SEE THIS SHEET FOR DESIGNATION)
- BARRICADE-TYPE I, TYPE II, OR BARREL
- BARRICADE-TYPE III
- VERTICAL PANEL
- WARNING SIGN
- DISTANCE BETWEEN SIGNS-A DISTANCE MEASURED IN FEET EQUAL TO A VALUE OF TEN TIMES THE SPEED LIMIT OF THE STREET
- SPACING BETWEEN BARRICADES-A DISTANCE MEASURED IN FEET EQUAL TO THE SPEED LIMIT OF THE STREET


TAPER LENGTH-SEE CHART ABOVE

TANGENT LENGTH-IS EQUAL TO THE TAPER LENGTH FOR A GIVEN STREET

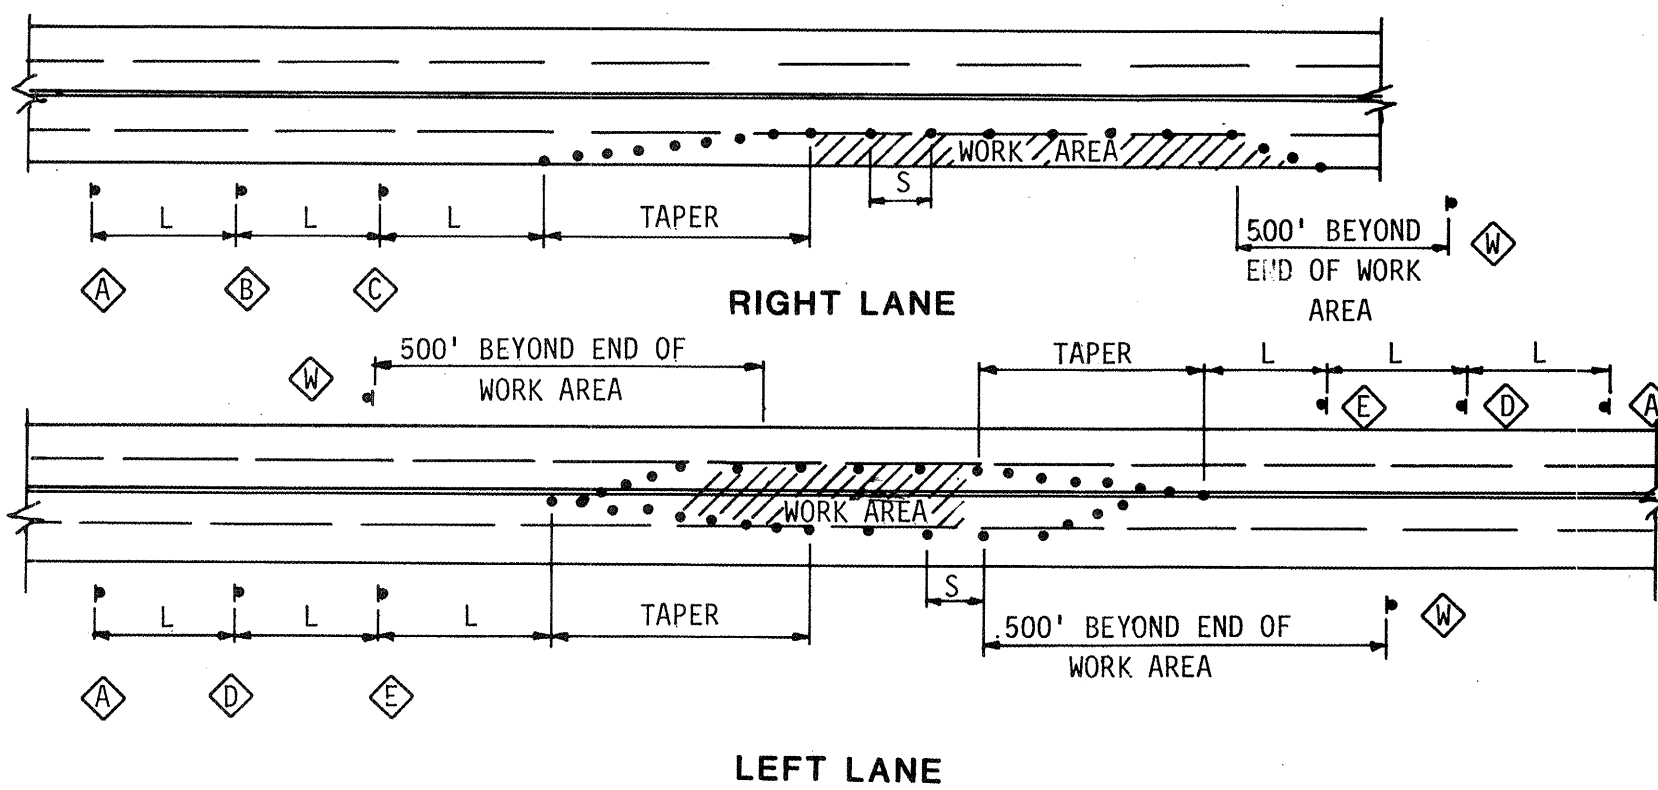

TYPICAL LANE CLOSURE

NO SCALE

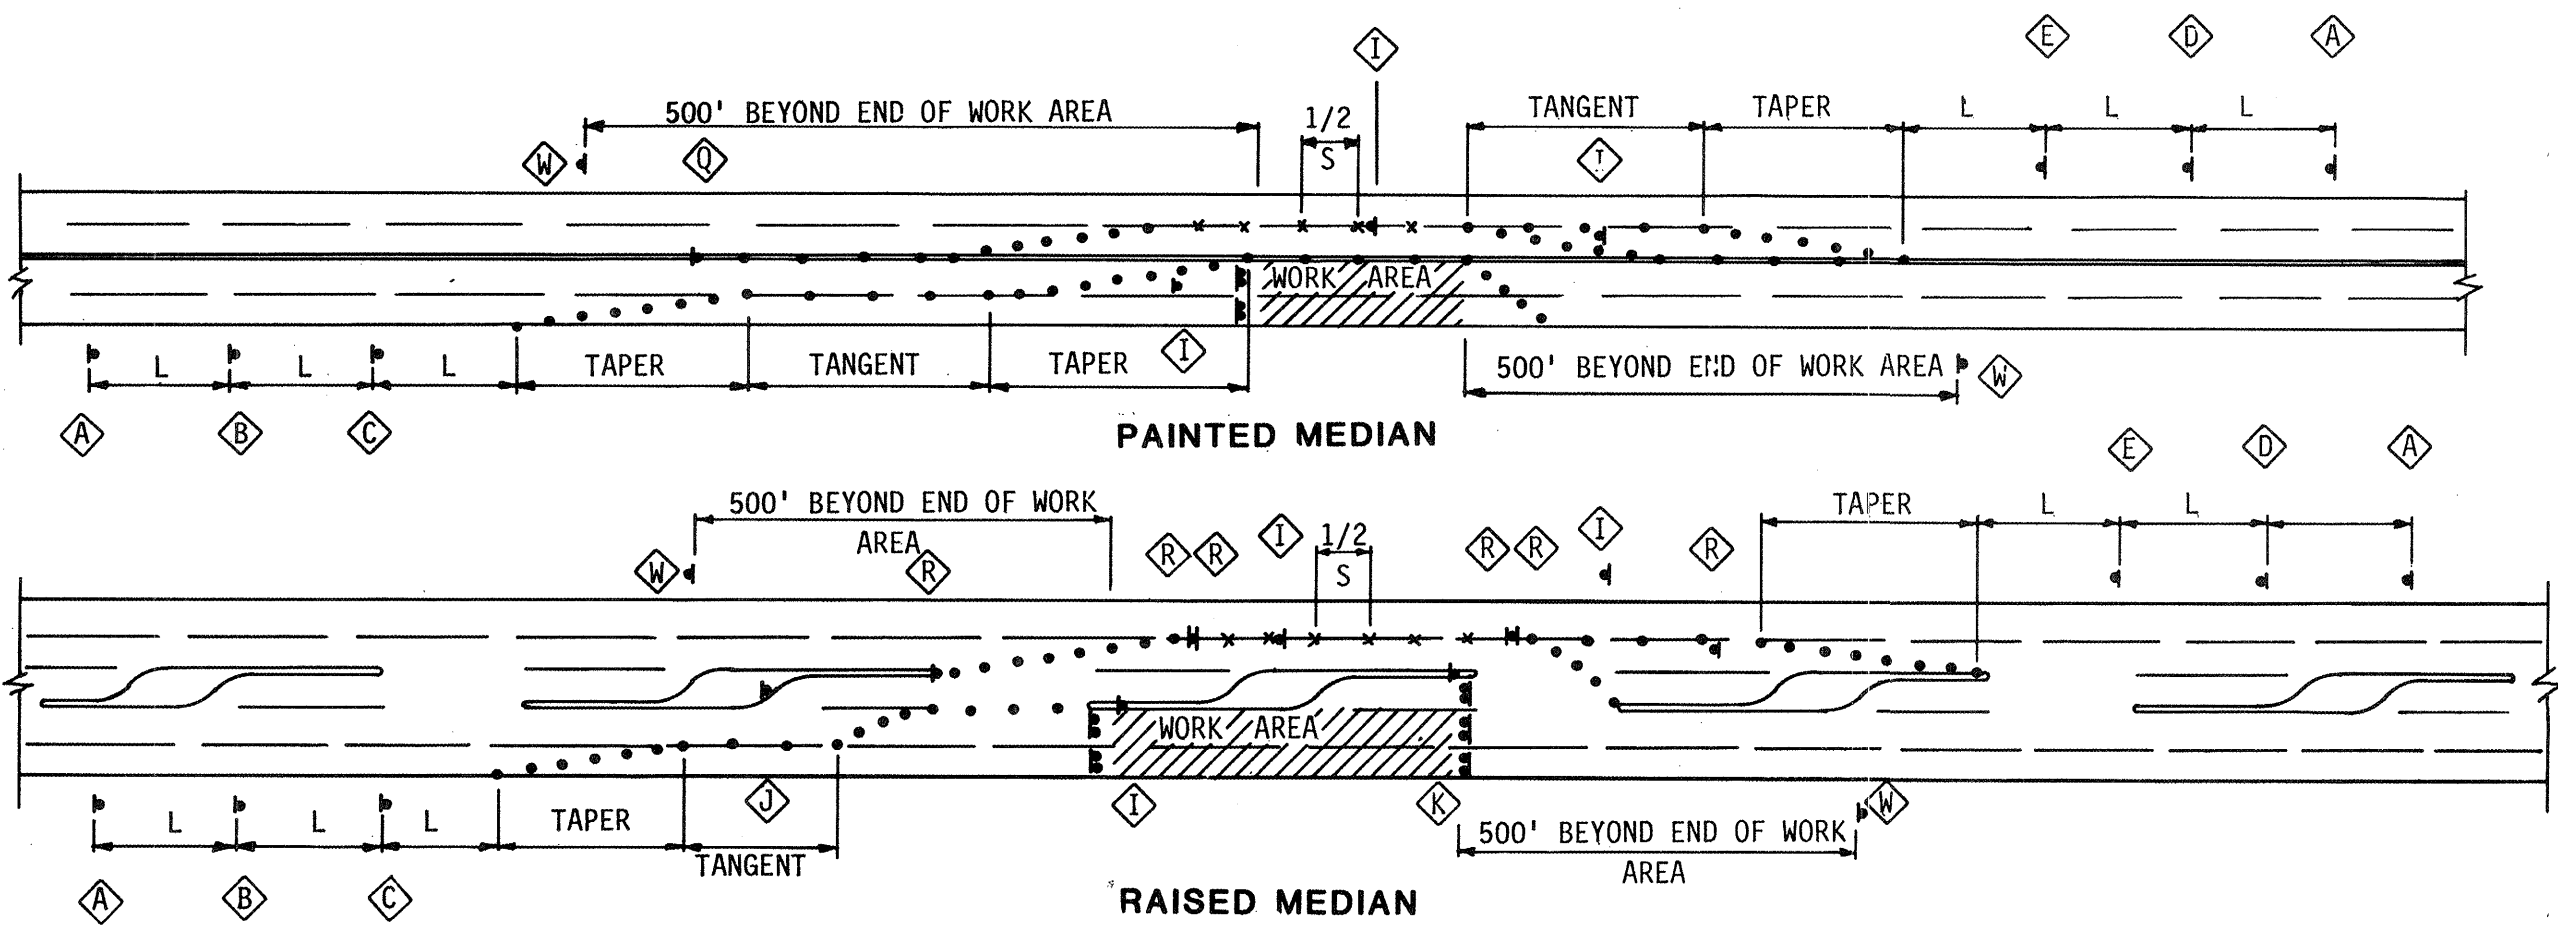

TYPICAL TRAFFIC SPLIT

NO SCALE

TRAFFIC CONTROL NOTES

- CONTRACTOR SHALL COMPLY WITH ALL REQUIREMENTS IN SECTION 19 OF THE CONSTRUCTION SPECIFICATIONS, CONSTRUCTION TRAFFIC CONTROL.

AS BUILT INFORMATION			BENCH MARKS			SURVEY INFORMATION			ENGINEER'S SEAL		
CONTRACTOR	DATE	NO.	BY	DATE	NO.	BY	DATE	NO.	BY	DATE	NO.
INSPECTOR	DATE	NO.	BY	DATE	NO.	BY	DATE	NO.	BY	DATE	NO.
VERIFICATION BY	DATE	NO.	BY	DATE	NO.	BY	DATE	NO.	BY	DATE	NO.
CORRECTION BY	DATE	NO.	BY	DATE	NO.	BY	DATE	NO.	BY	DATE	NO.
MICRO-FILM INFORMATION			REVISIONS			DESIGN			REVISIONS		
RECORDED BY			NO.			NO.			NO.		

CITY OF ALBUQUERQUE
PUBLIC WORKS DEPARTMENT
ENGINEERING GROUP

TRAFFIC CONTROL PLAN					
APPROVALS	ENGINEER	DATE	APPROVALS	ENGINEER	DATE
D.R.C. Chair	Roger Green	3-26-91	Water	W. Green	3-20-91
Trans. Dev.	R. Green	3-20-91	Wastewater	W. Green	3-20-91
Hydrology	R. Green	3-20-91			
PROJECT NO.	4230.90	MAP NO.		SHEET	7 OF 7