
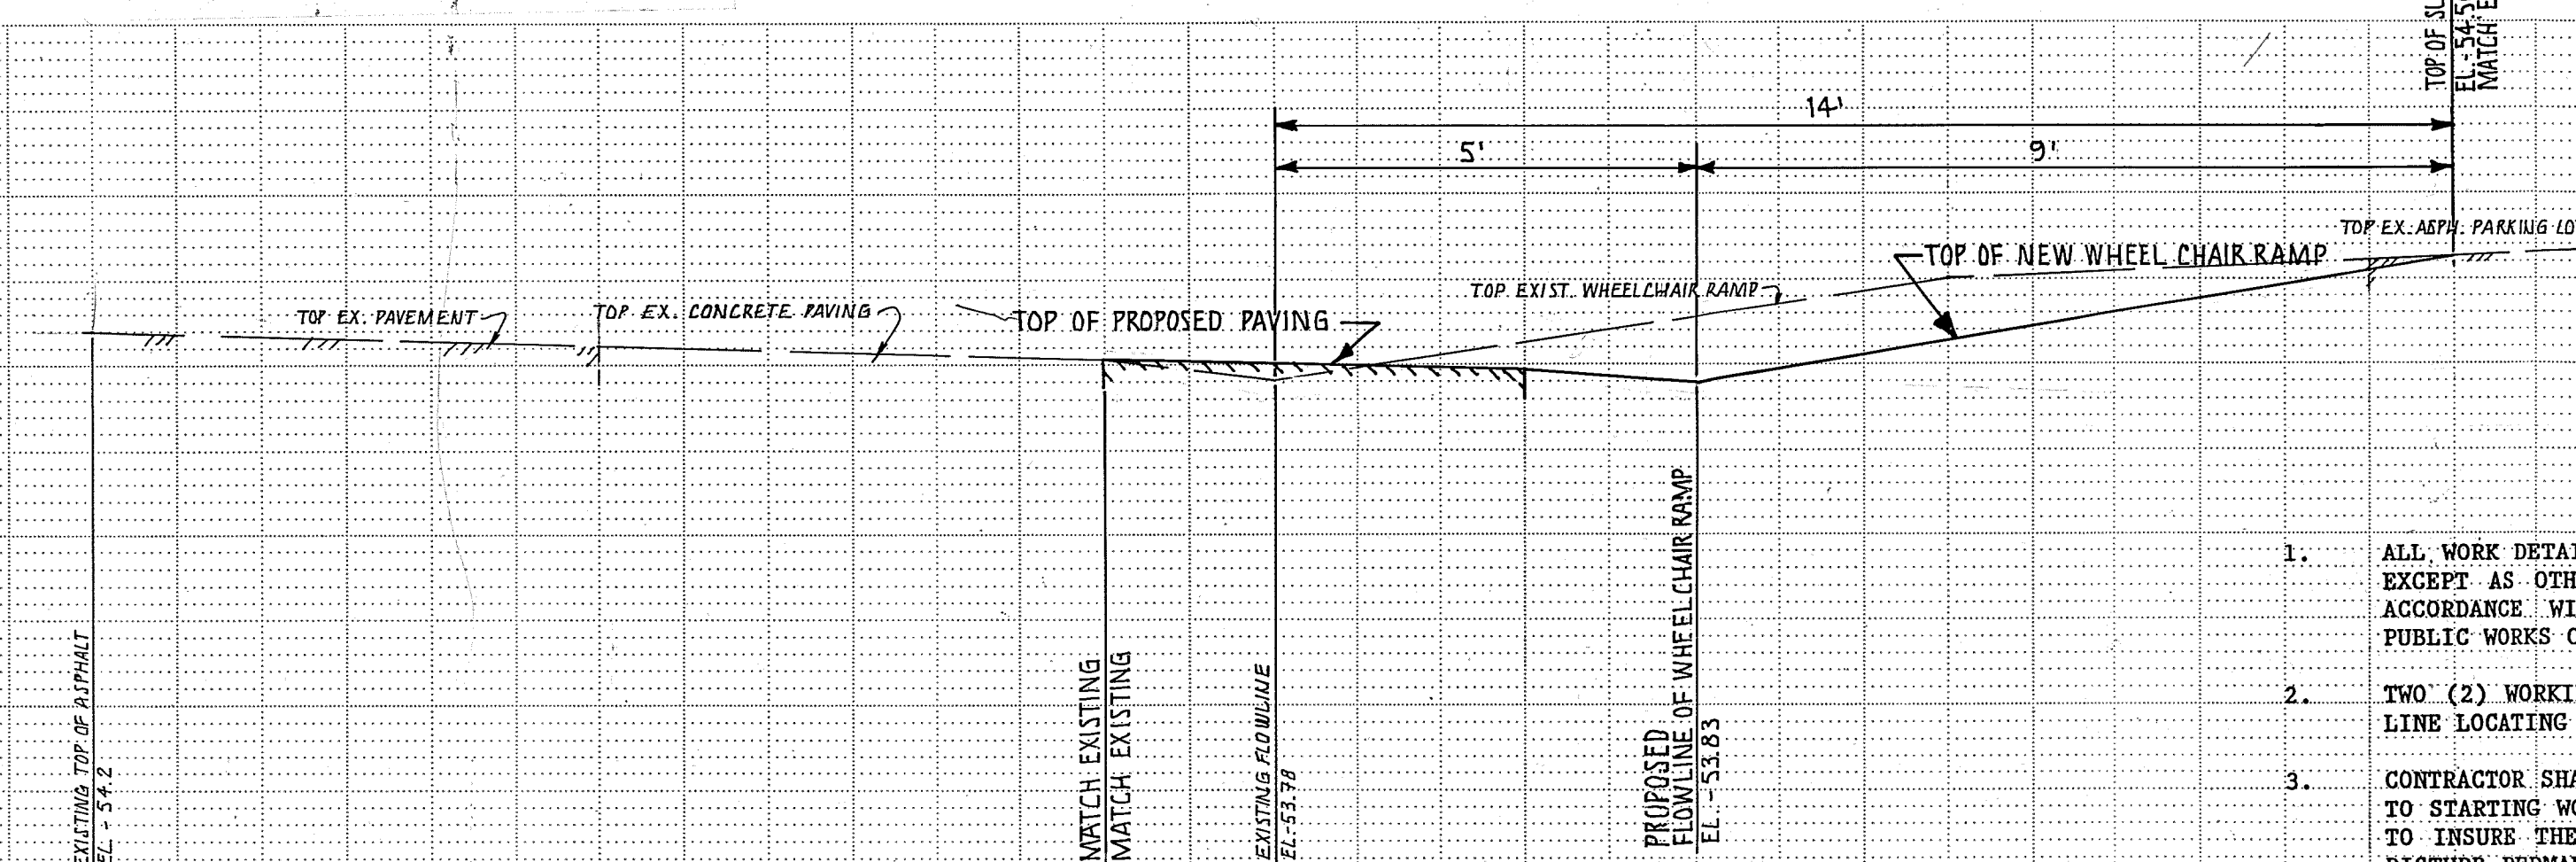
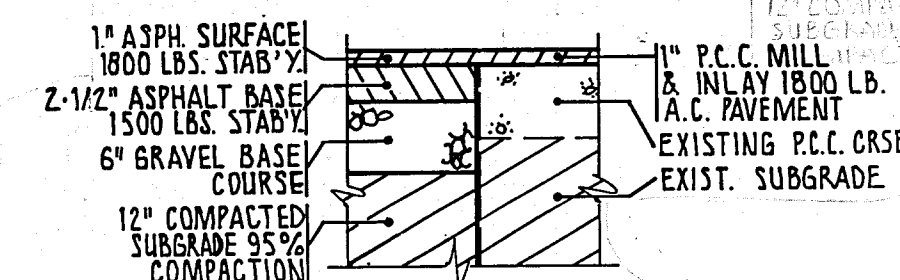


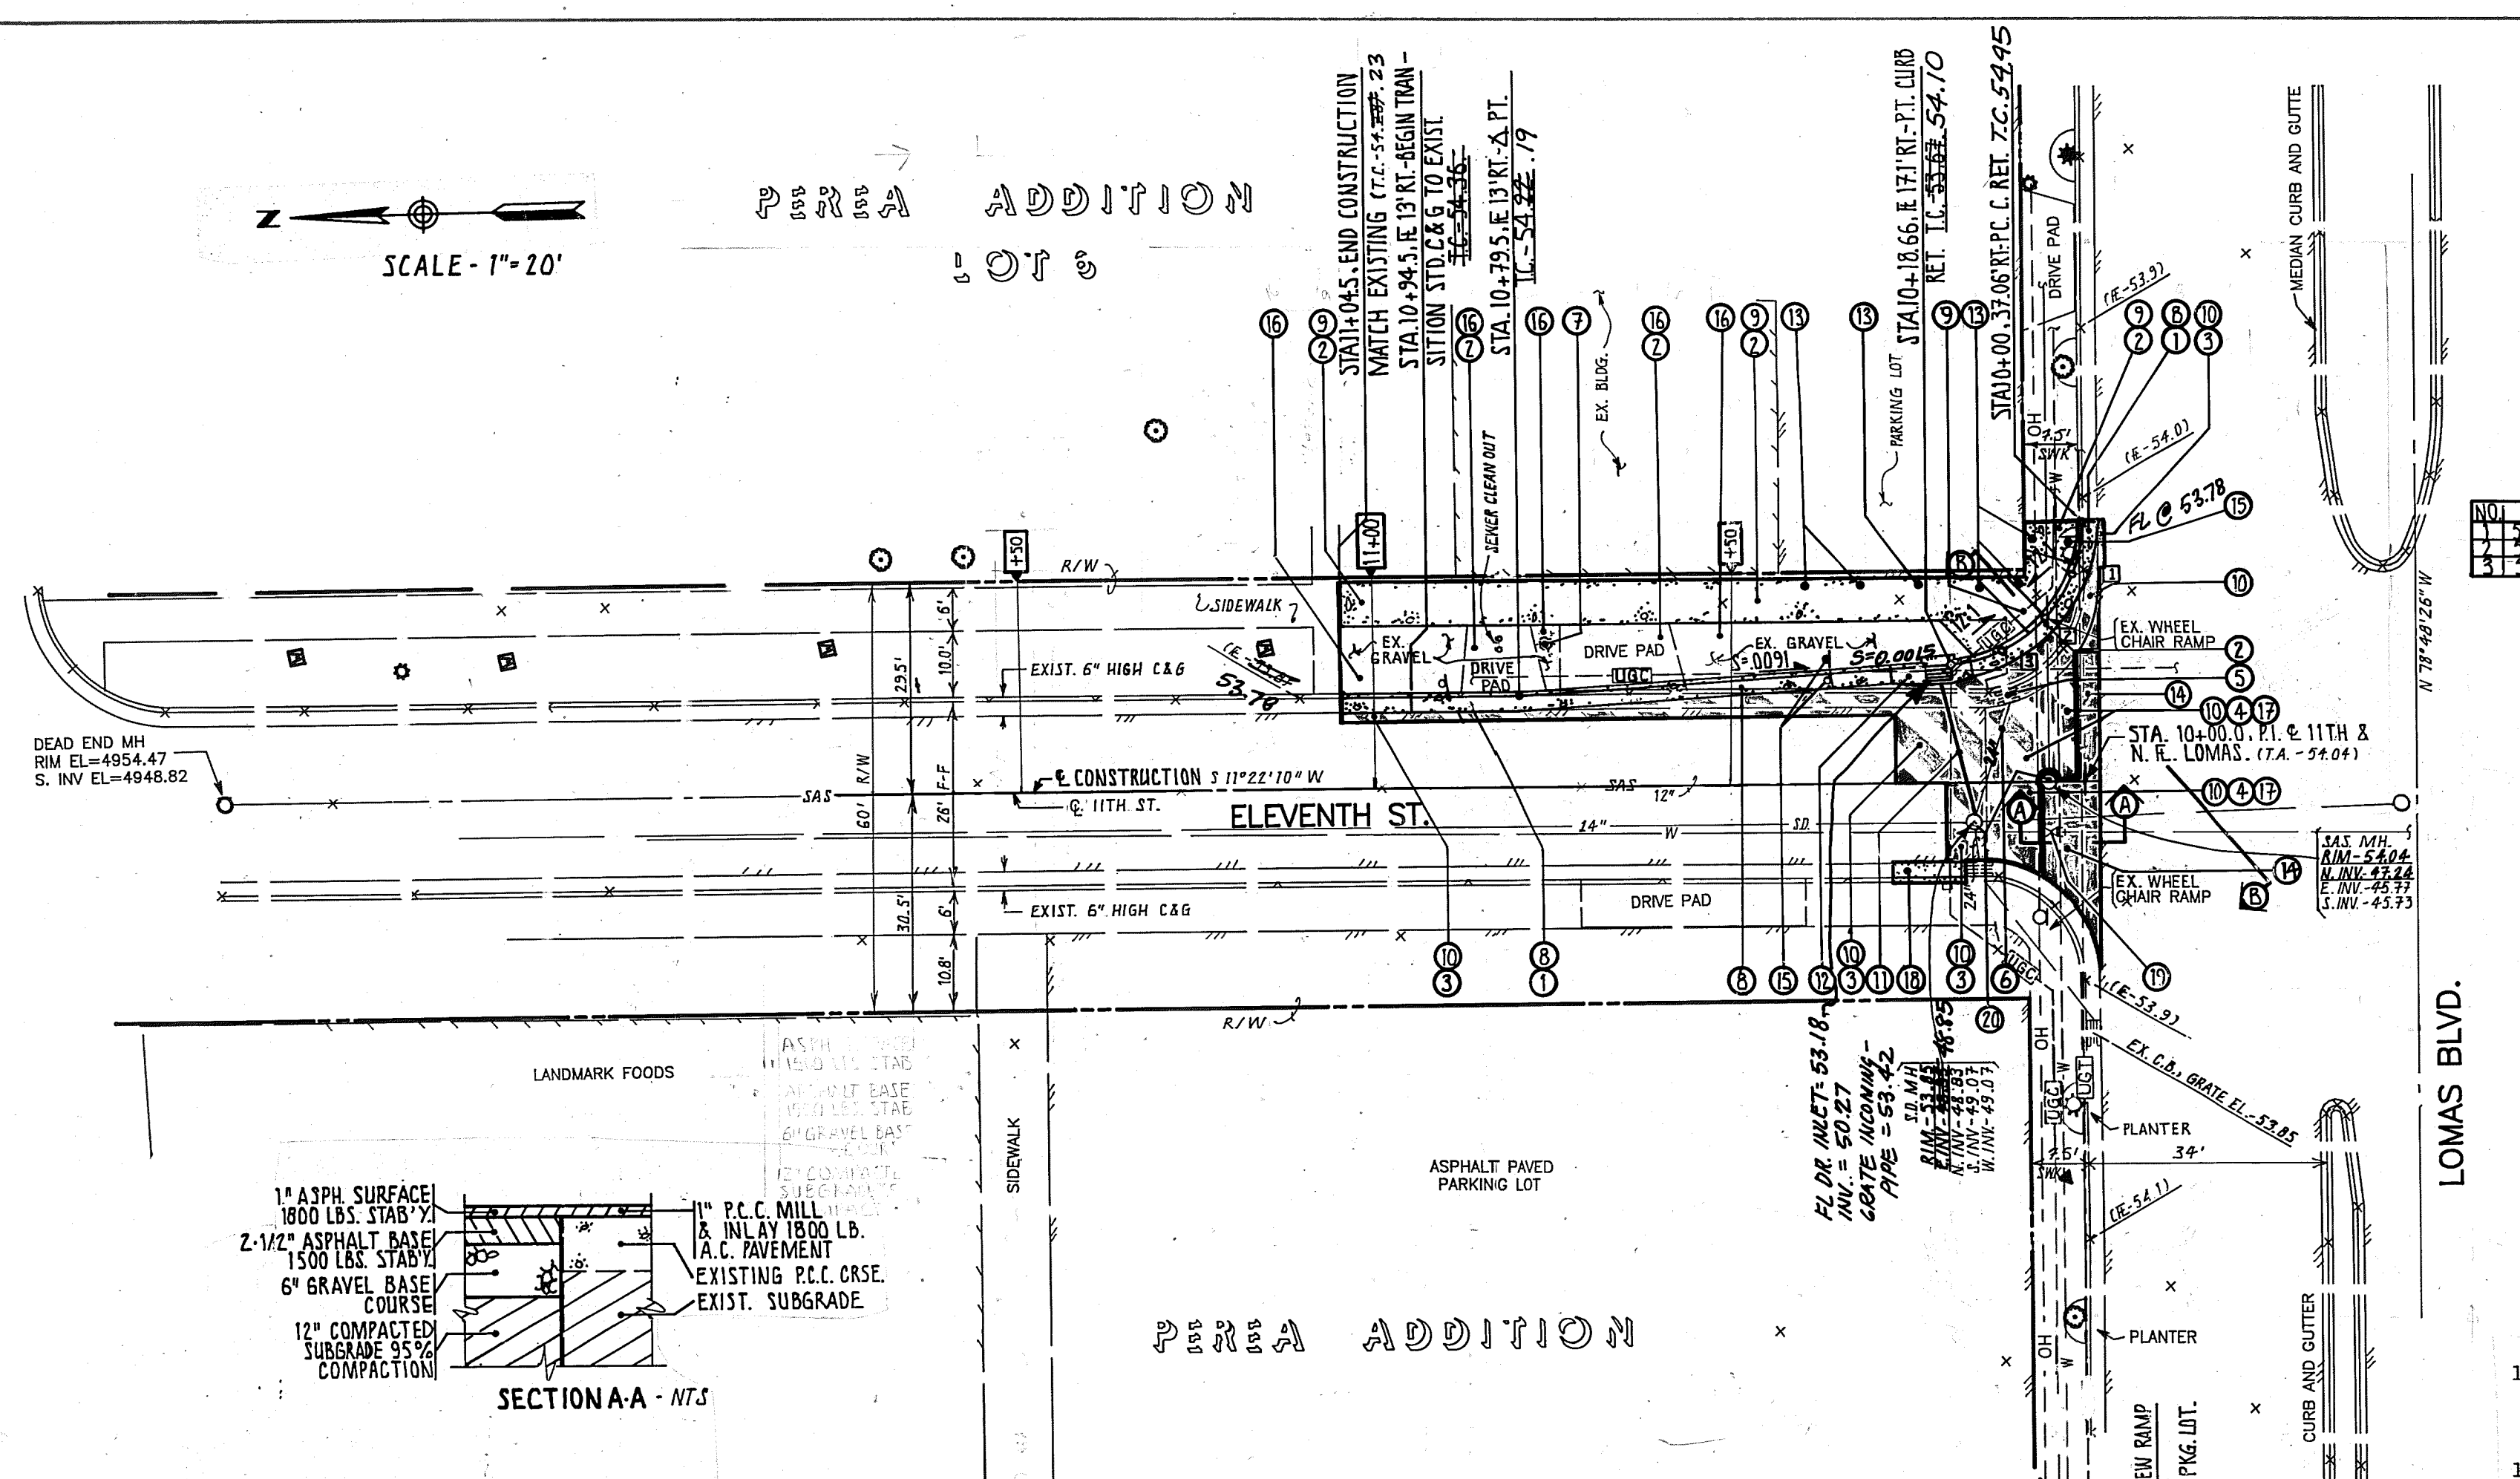


SECTION B-B

APPROVAL OF AS BUILT DRAWINGS
CHIEF CONSTRUCTION ENGINEER
DATE 10/1/01

- 18) Remove, dispose & replace complete one stone of standard C & G on north side of C.B. per std dtl DWG 2415.
- 19) Adjust water valve box to grade.
- 20) Adjust M.H. rim & cover to grade.

GENERAL NOTES

- ALL WORK DETAILED ON THESE PLANS TO BE PERFORMED UNDER CONTRACT SHALL, EXCEPT AS OTHERWISE STATED OR PROVIDED FOR HEREON, BE CONSTRUCTED IN ACCORDANCE WITH THE CITY OF ALBUQUERQUE STANDARD SPECIFICATIONS - PUBLIC WORKS CONSTRUCTION - 1986.
- TWO (2) WORKING DAYS PRIOR TO ANY EXCAVATION, CONTRACTOR MUST CONTACT LINE LOCATING SERVICE, 260-1990, FOR LOCATION OF EXISTING UTILITIES.
- CONTRACTOR SHALL NOTIFY THE ENGINEER NOT LESS THAN SEVEN (7) DAYS PRIOR TO STARTING WORK IN ORDER THAT THE ENGINEER MAY TAKE NECESSARY MEASURES TO INSURE THE PRESERVATION OF SURVEY MONUMENTS. CONTRACTOR SHALL NOT DISTURB PERMANENT SURVEY MONUMENTS WITHOUT THE CONSENT OF THE ENGINEER AND SHALL NOTIFY THE ENGINEER AND BEAR THE EXPENSE OF REPLACING ANY THAT MAY BE DISTURBED WITHOUT PERMISSION. REPLACEMENT SHALL BE DONE ONLY BY THE ENGINEER. WHEN A CHANGE IS MADE IN THE FINISHED ELEVATION OF THE PAVEMENT OF ANY ROADWAY IN WHICH A PERMANENT SURVEY MONUMENT IS LOCATED, CONTRACTOR SHALL, AT HIS OWN EXPENSE, ADJUST THE MONUMENT COVER TO THE NEW GRADE UNLESS OTHERWISE SPECIFIED.
- SHOULD A CONFLICT EXIST BETWEEN THESE PLANS AND ACTUAL FIELD CONDITIONS, THE CONTRACTOR SHALL PROMPTLY NOTIFY THE ENGINEER IN WRITING SO THAT THE CONFLICT CAN BE RESOLVED WITH A MINIMUM AMOUNT OF DELAY FOR ALL PARTIES.
- THE CONTRACTOR SHALL MAINTAIN ACCESS TO ADJACENT PROPERTIES DURING CONSTRUCTION.
- ALL WORK ON THIS PROJECT SHALL BE PERFORMED IN ACCORDANCE WITH APPLICABLE FEDERAL, STATE AND LOCAL LAWS, RULES AND REGULATIONS CONCERNING CONSTRUCTION SAFETY AND HEALTH.
- THE CONTRACTOR MUST OBTAIN A BARRICADE PERMIT FROM THE CONSTRUCTION CO-ORDINATION DIVISION 48 HOURS PRIOR TO CONSTRUCTION. CONTRACTOR SHALL NOTIFY BARRICADE ENGINEER (768-2551) PRIOR TO OCCUPYING AN INTERSECTION. CONTRACTOR MUST REFER TO SECTION 19 OF THE STANDARD SPECIFICATIONS FOR TRAFFIC CONTROL.
- ALL STATIONING SHALL BE BASED ON CONSTRUCTION CENTERLINE.
- ALL STREET STRIPING ALTERED OR DESTROYED SHALL BE REPLACED IN KIND BY CONTRACTOR TO LOCATION AND IN KIND AS EXISTING OR AS INDICATED BY THIS PLAN SET.

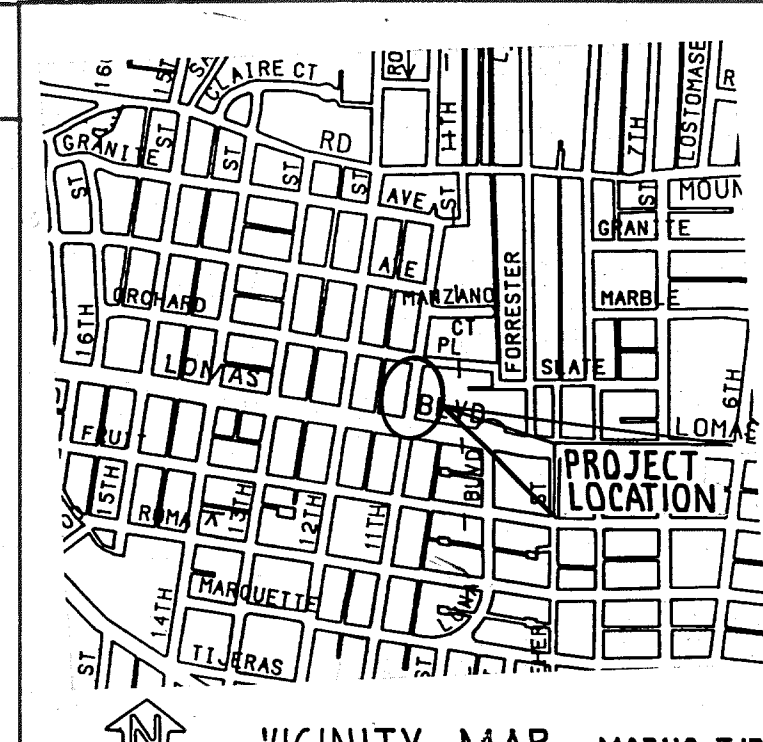

CONSTRUCTION NOTES:

- Sawcut, remove and dispose of 115LF standard C & G.
- Sawcut, remove and dispose of 110 SY existing concrete D/W, S/W and W.C.R. complete.
- Sawcut, remove and dispose 448Y arterial A.C. pavement complete.
- Sawcut, remove and dispose 305Y arterial PCC pavement complete.
- Remove and dispose of existing storm inlet complete. Inv. 50.29. & Grate 53.27.
- Remove and dispose of 16LF of 24" stormdrain pipe complete. EX.M.H. 48.95.
- Remove and dispose existing stump complete.
- Install 105LF of standard C & G per std. dtl. DWG 2415.
- Install 770 SF of sidewalk (including W.C.R.) per std. dtl. DWG 2430 & 2441 case II.
- Install 80 SY of A.C. pavement complete with base & subgrade per section A-A) per C.O.A. DWG 2405.
- Install 20 LF of 24" RCP III from existing manhole (E. Inv. 48.95) to new inlet per C.O.A. Std. Spec's. Sect. 701.
- Install storm inlet type "A" per std dtl DWG 2201. Inv. 50.29. Grate 52.77.
- Install stationary 4" steel posts, 6 ea. per C.O.A. DWG 2250. Appx. location as shown.
- Mill P.C.C. pavement to 1" and inlay 34 SY of 1" A.C. pavement surface course per typ sec A.
- Relocate existing signs as shown.
- Install 3/4" river run Gravel to a depth of 2", complete in place w/inner.
- Import and compact 5 C.Y. of suitable subgrade fill material.

STATION EQUATION-10+00 =
B.M. 12-J13 578°51'58"E, 1063.73'
X=374766.65, Y=1489006.93

LEGEND:

- EDGE OF EXISTING PAVEMENT
- EXISTING BLDG.
- STREET SIGN
- EXISTING MANHOLE
- EXISTING POWER POLE
- EXISTING STD. CURB & GUTTER
- EXIST. UNDERGROUND TELEPH. CABLE
- EXIST. UNDERGROUND TV. CABLE
- AREA OF RESIDENTIAL PAVEMENT
- AREA OF MILLING & INLAY
- AREA OF NEW PAV.

1 2 3 4 5 6 7 8 9 10 11 12 13 14 15
26 4247.90 01 19 1

CITY OF ALBUQUERQUE
PUBLIC WORKS DEPARTMENT
ENGINEERING GROUP

TITLE: INTERSECTION IMPROVEMENTS-
11TH STREET NORTH OF LOMAS

APPROVALS	ENGINEER	DATE	APPROVALS	ENGINEER	DATE
D.R.C. Chair	Roger Wilson	4-5-91	Water	Wilson	4-1-91
Trans. Dev.	Wilson	4-03-91	Wastewater	Wilson	4-1-91
Hydrology	Wilson	4-03-91	Parks & Recreation	N/A	-

DRAWING NO. 4247.90 MAP NO. J-13 SHEET 1 OF 1

APPR. WCD FOR
CONSTRUCTION
Randy B. Smith
CITY ENGINEER 4-5-91