


CONSTRUCTION PLANS
FOR
VENTURA STREET
STORM DRAINAGE IMPROVEMENTS

HYDROLOGY DIVISION
PUBLIC WORKS DEPARTMENT
CITY OF ALBUQUERQUE

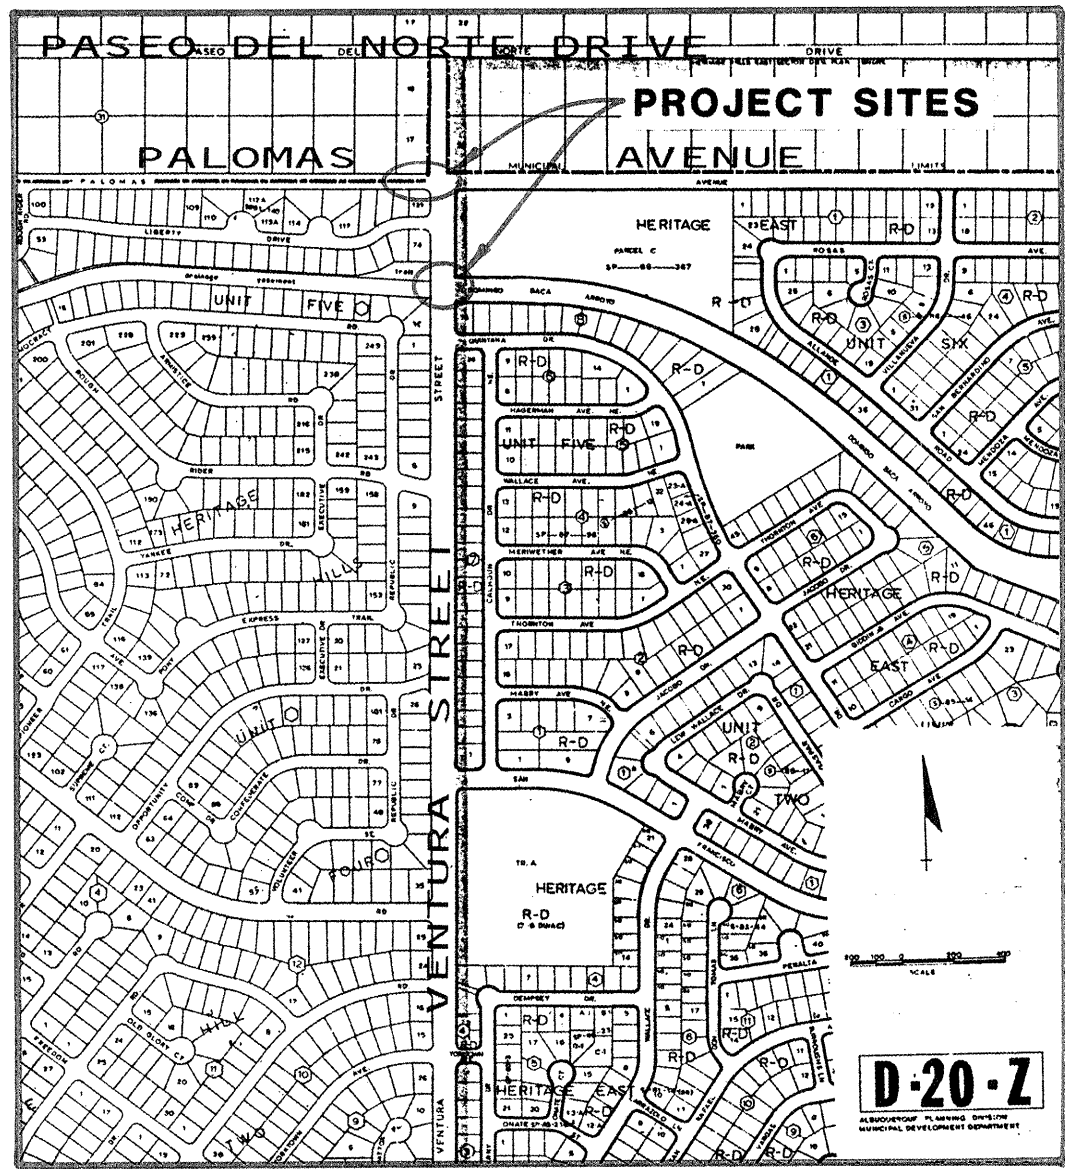

LOCATION MAP


INDEX TO DRAWINGS

- 1. TITLE SHEET
- 2. PALOMAS-VENTURA STORM DRAIN LATERAL
- 3. DRAINAGE RUNDOWN & MISCELLANEOUS REPAIRS--VENTURA BRIDGE

GENERAL NOTES

- 1. ALL WORK DETAILED ON THESE PLANS TO BE PERFORMED UNDER CONTRACT SHALL, EXCEPT AS OTHERWISE STATED OR PROVIDED FOR HEREON, BE CONSTRUCTED IN ACCORDANCE WITH THE CITY OF ALBUQUERQUE STANDARD SPECIFICATIONS FOR PUBLIC WORKS CONSTRUCTION 1986.
- 2. TWO (2) WORKING DAYS PRIOR TO ANY EXCAVATION, CONTRACTOR MUST CONTACT LINE LOCATING SERVICE @ 260-1990 FOR LOCATION OF EXISTING UTILITIES.
- 3. TRAFFIC CONTROL: THREE (3) WORKING DAYS PRIOR TO BEGINNING CONSTRUCTION, THE CONTRACTOR SHALL SUBMIT TO THE CONSTRUCTION CO-ORDINATION DIVISION A DETAILED CONSTRUCTION SCHEDULE. TWO (2) WORKING DAYS PRIOR TO CONSTRUCTION, THE CONTRACTOR SHALL OBTAIN A BARRICADING PERMIT FROM THE CONSTRUCTION CO-ORDINATION DIVISION. CONTRACTOR SHALL NOTIFY BARRICADE ENGINEER (768-2551) PRIOR TO OCCUPYING AN INTERSECTION. SEE SECTION 19 OF THE SPECIFICATIONS.

- ALL STREET STRIPING ALTERED OR DESTROYED SHALL BE REPLACED IN KIND BY CONTRACTOR TO LOCATION AND IN KIND AS EXISTING OR AS INDICATED BY THIS PLAN SET.
- 4. ALL WORK NOTED ON THESE PLANS FOR WHICH THERE IS NO RELATED PAY ITEM SHALL BE INCIDENTAL TO CONSTRUCTION AND NO SEPARATE PAYMENT SHALL BE MADE THEREFORE.

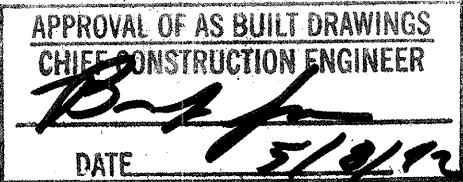

2	3	4	5	6	7	8	9	10	11	12	13	14	15
26	42	3	9	0	0	1	9	2					

REV	SHEETS	CITY ENGR.	DATE	USER DEPT.	DATE	USER DEPT.	DATE
APPROVAL OF REVISIONS							

6/13/91

PROJECT NO. 4283.90

APPROVED FOR CONSTRUCTION

James H. Hilkey


7-15-91

SHEET 1 OF 3


SCALE: 1"=10'

NOTES:

1. PREPARE EXISTING TOP OF WALL SURFACE AND LAY 3 COURSES OF NEW CMU WALL.
 2. PREPARE EXISTING TOP OF WALL SURFACE AND LAY 6 COURSES OF NEW CMU WALL WITH PILASTER AT CENTER.
 3. REBUILD PILASTER USING EXISTING REBAR DOWELS, FILL PILASTER BLOCK CELLS WITH CONCRETE.
 4. REMOVE & DISPOSE ALL EXISTING CMU BLOCK DEBRIS AT SITE.
- NOTE: BLOCK WALL REPAIRED BY OTHERS.

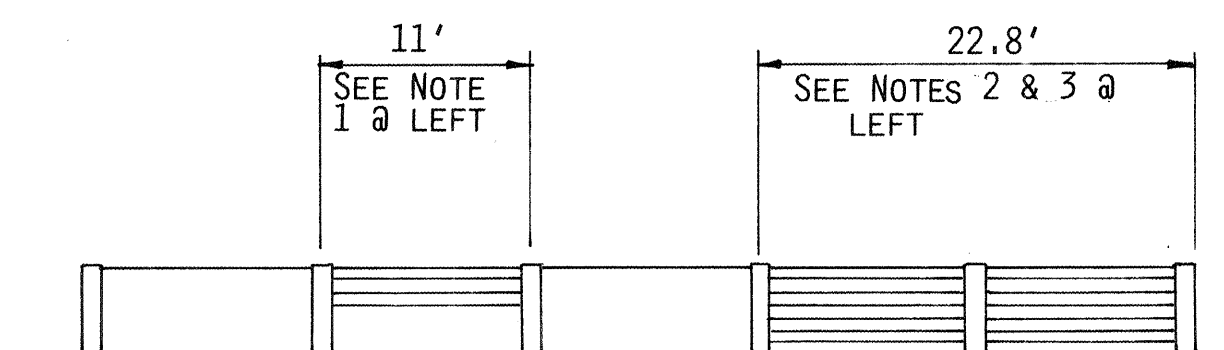


BLOCK WALL REPAIR
SCALE: 1"=10' LOOKING WEST

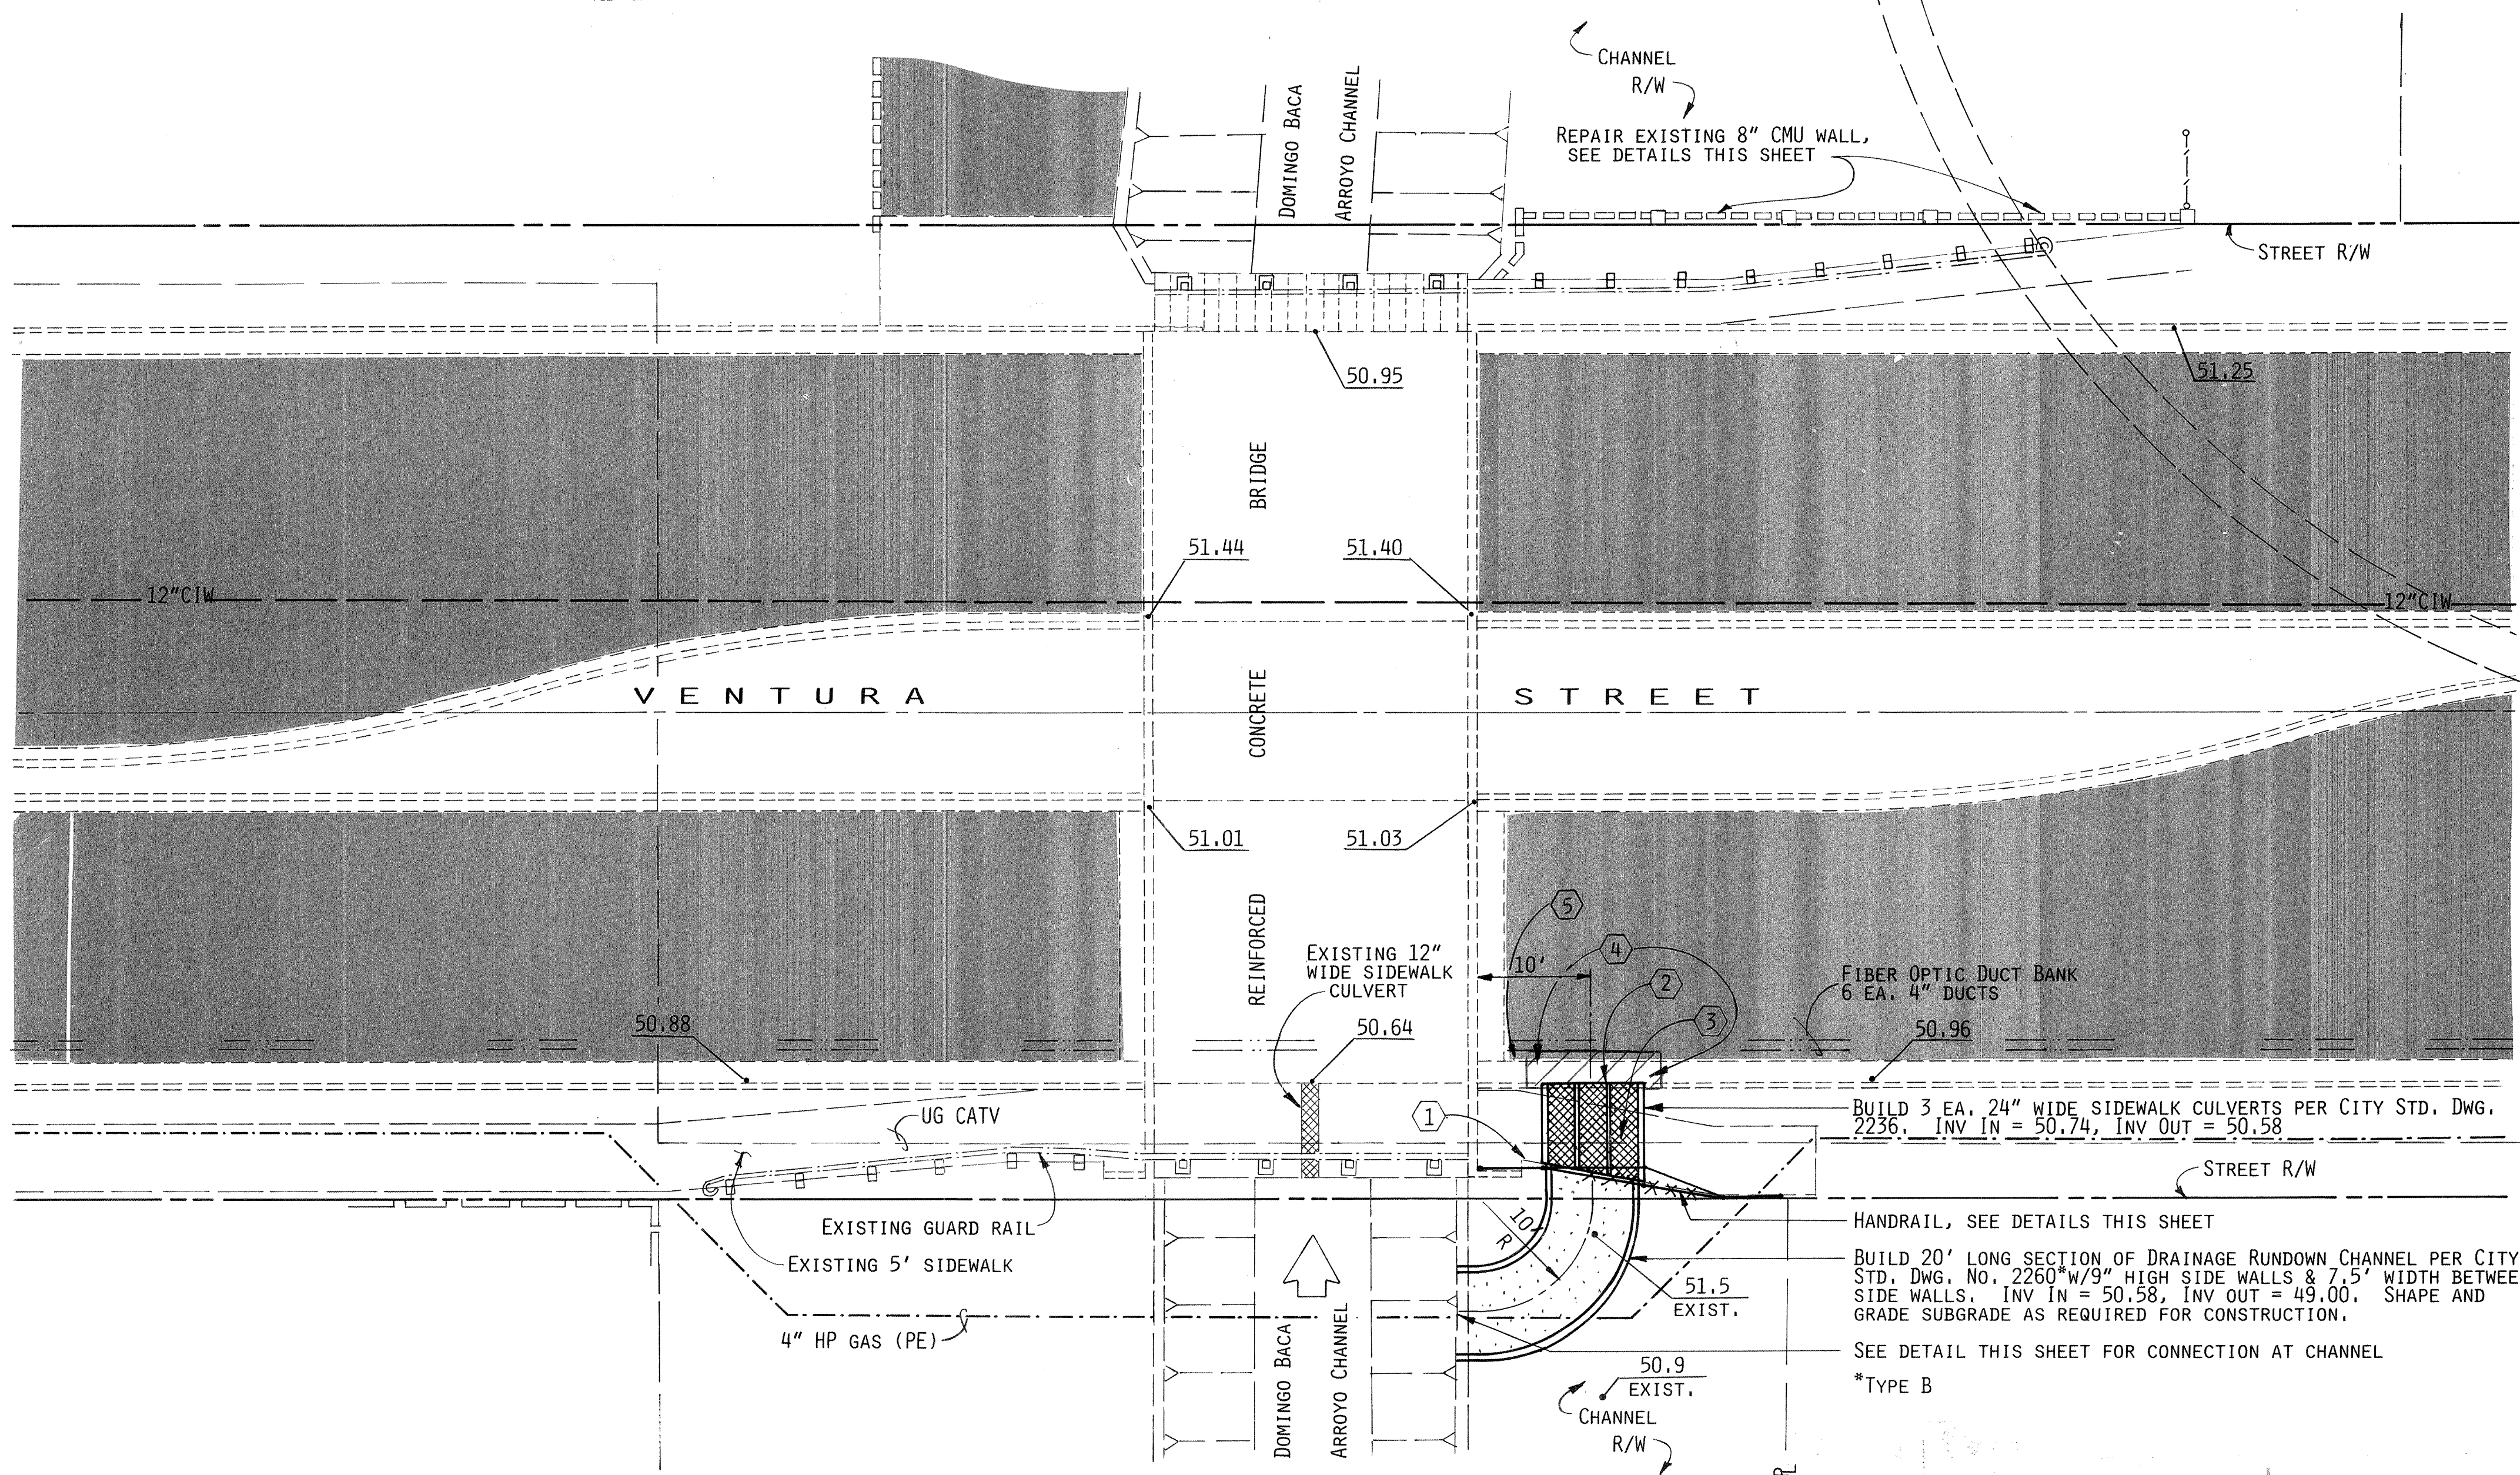


VENTURA BRIDGE DRAINAGE
RUNDOWN & WALL REPAIRS

SCALE: 1"=10'

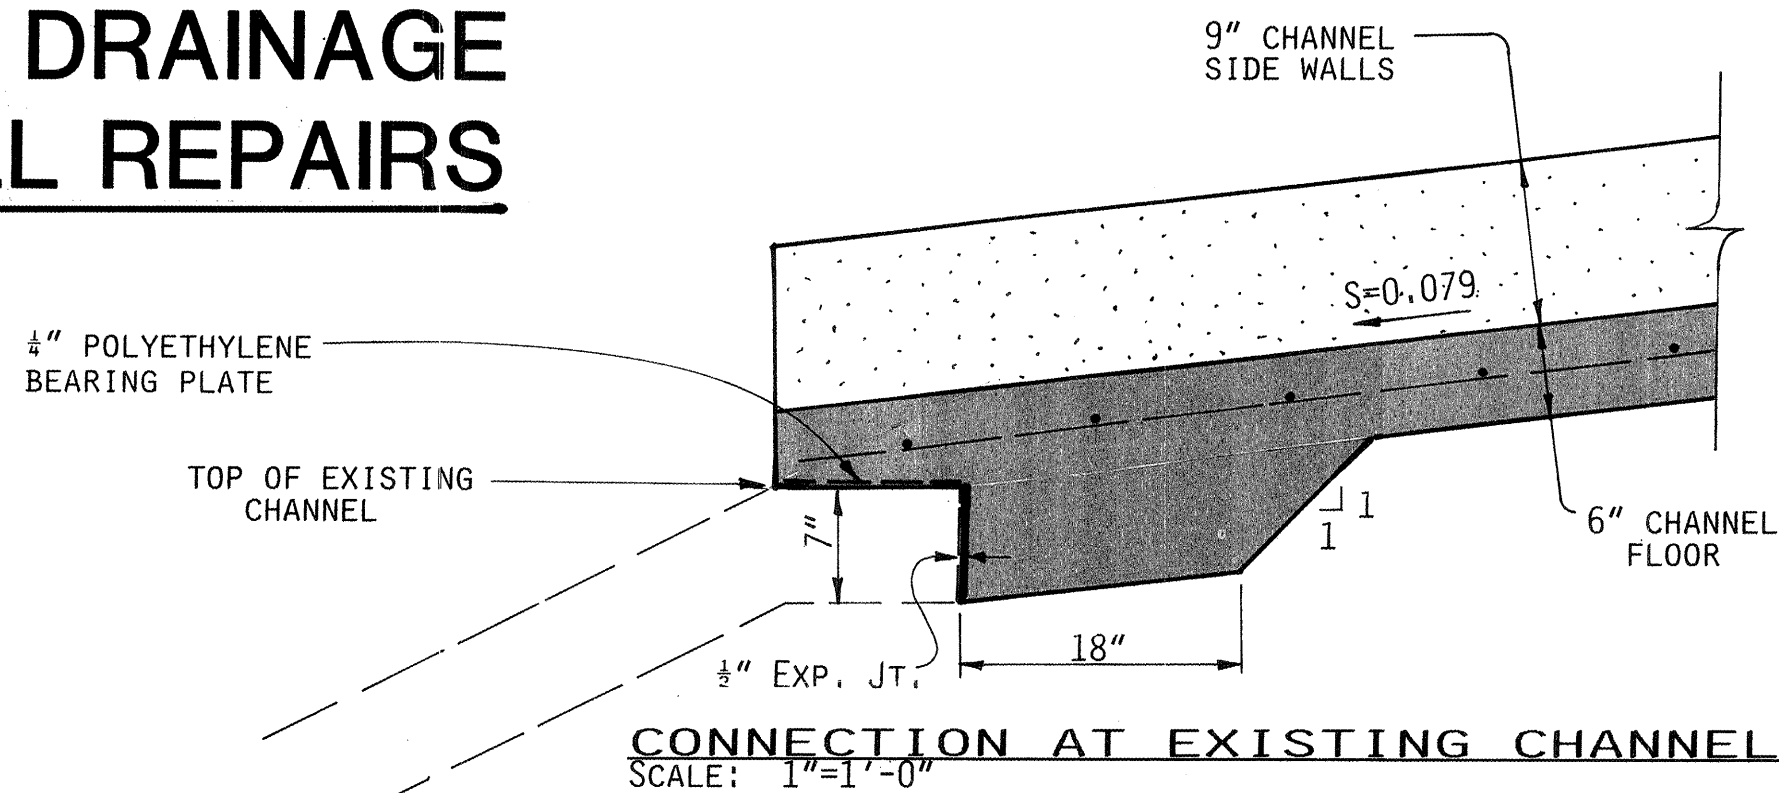

CONNECTION AT EXISTING CHANNEL
SCALE: 1"=1'-0"

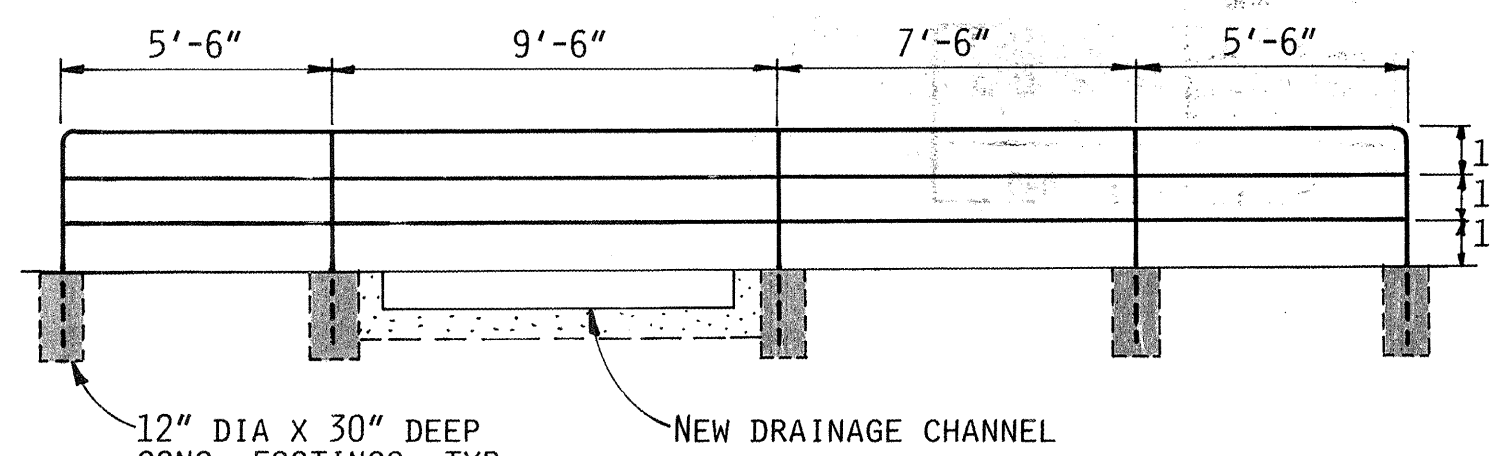

HANDRAIL ELEVATION & DETAILS
SCALE: 1/4"=1'-0"

KEYED NOTES

1. SIDEWALK UNDERMINED APPROXIMATELY 6" BEHIND EDGE OF CONCRETE, FILL WITH COMPACTED EARTH AND SHAPE TO FIT NEW CONSTRUCTION.
2. REMOVE 12' CURB & GUTTER & 1'X12' SECTION OF PAVEMENT.
3. REMOVE 54 SF OF SIDEWALK.
4. REPLACE 4 LF STD. CURB & GUTTER (8' GUTTER SECTION OPPOSITE NEW SIDEWALK CULVERT IS CONSTRUCTED PER DRWG 2236 AND PAID UNDER SIDEWALK CULVERT).
5. REPLACE 1'X8' SECTION OF PAVEMENT PER DETAIL ON SHEET 2.

ENGINEER'S SEAL			SURVEY INFORMATION		BENCH MARKS		AS BUILT INFORMATION	
			FIELD NOTES		"□" MARKED ON THE NE CORNER OF VENTURA BRIDGE		CONTRACTOR <i>MCC. INC.</i>	
			BY		DATE		WORK ORDERED BY <i>C.O.A.</i>	
			1 S. GUTIERREZ		2/91		INSPECTOR'S FIELD ACCEPTANCE BY <i>L. ROJAS-ERCO</i>	
							DATE	
							DATE	
NO. DATE					DRAWINGS CORRECTED BY		MICRO-FILM INFORMATION	
DESIGNED BY			TO1		RECORDED BY		DATE	
DRAWN BY			NW					
CHECKED BY			TO1					
			5/91				4/13/91	