




4. EXISTING WATER VALVE AND WATERLINE INFORMATION
OBTAINED FROM CITY OF ALBUQUERQUE WATER
SECTIONAL MAP G-14S.

Jeffrey G. Mortensen
 Jeffrey G. Mortensen
 NAME NO. 86457
 10-15-91
 Date



17. ALL STREET STRIPING ALTERED OR DESTROYED SHALL BE REPLACED IN KIND BY CONTRACTOR TO LOCATION AND IN KIND AS EXISTING OR AS INDICATED BY THIS PLAN SET.

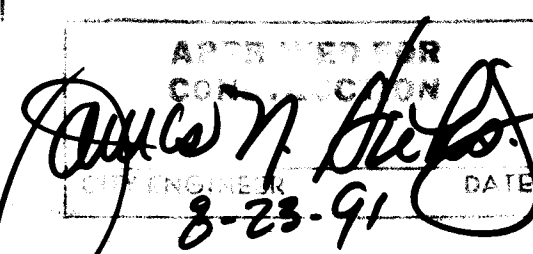

G - 14

AS BUILT INFORMATION		BENCH MARKS		SURVEY INFORMATION		ENGINEER'S SEAL		AS - BUILT		REVISIONS		DESIGN	
CONTRACTOR: SUNDAVE MECHANICAL		PROJECT: BENCH MARK		FIELD NOTES				MAS		BY		DATE	
NO.	DATE	NO.	DATE	NO.	DATE			NO.	DATE	NO.	DATE	NO.	DATE
1	9/1/91	1	9/1/91	1	9/1/91	06-06-91							
2	9/1/91	2	9/1/91	2	9/1/91								
3	9/1/91	3	9/1/91	3	9/1/91								
4	9/1/91	4	9/1/91	4	9/1/91								

TITLE: FIRE HYDRANT INSTALLATION
JOHN BROOKS FOOD TOWN

APPROVALS	ENGINEER	DATE	APPROVALS	ENGINEER	DATE
DRC CHAIRMAN	<i>Robert Green</i>	7/3/91	WATER	<i>John Brooks</i>	7-3-91
TRANSPORTATION	<i>David L. Hume</i>	7/3/91	WASTE WATER	<i>ALC</i>	7-3-91
HYDROLOGY	<i>N/A RRS</i>	7/3/91			

PROJECT NO. **4289.90**

MAP NO. **G-14**

SHEET **1** OF **1**