
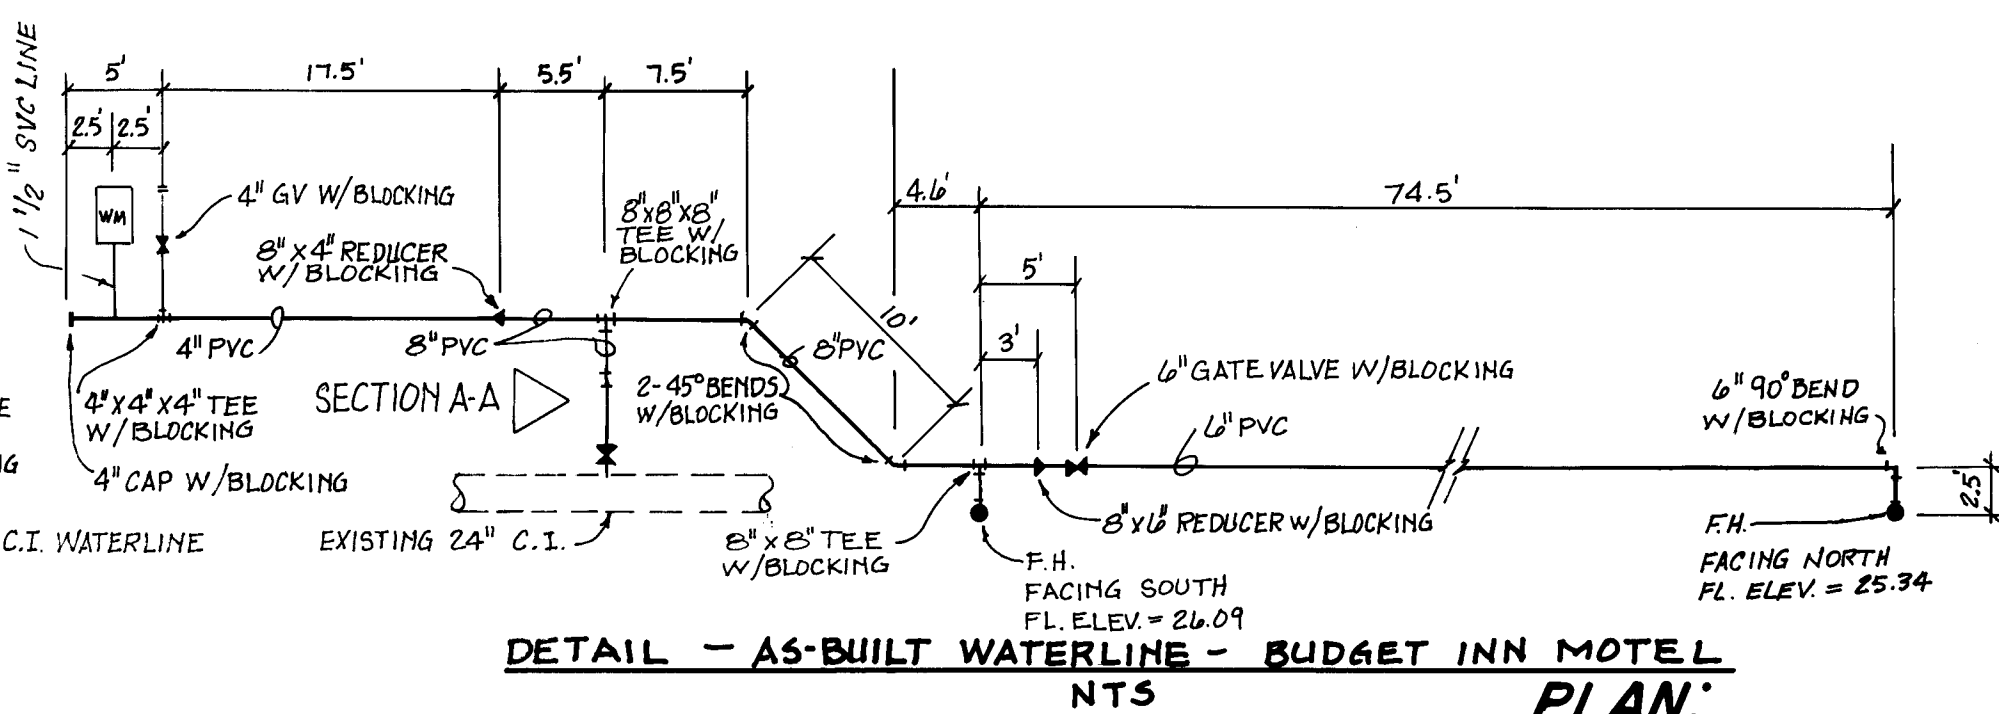


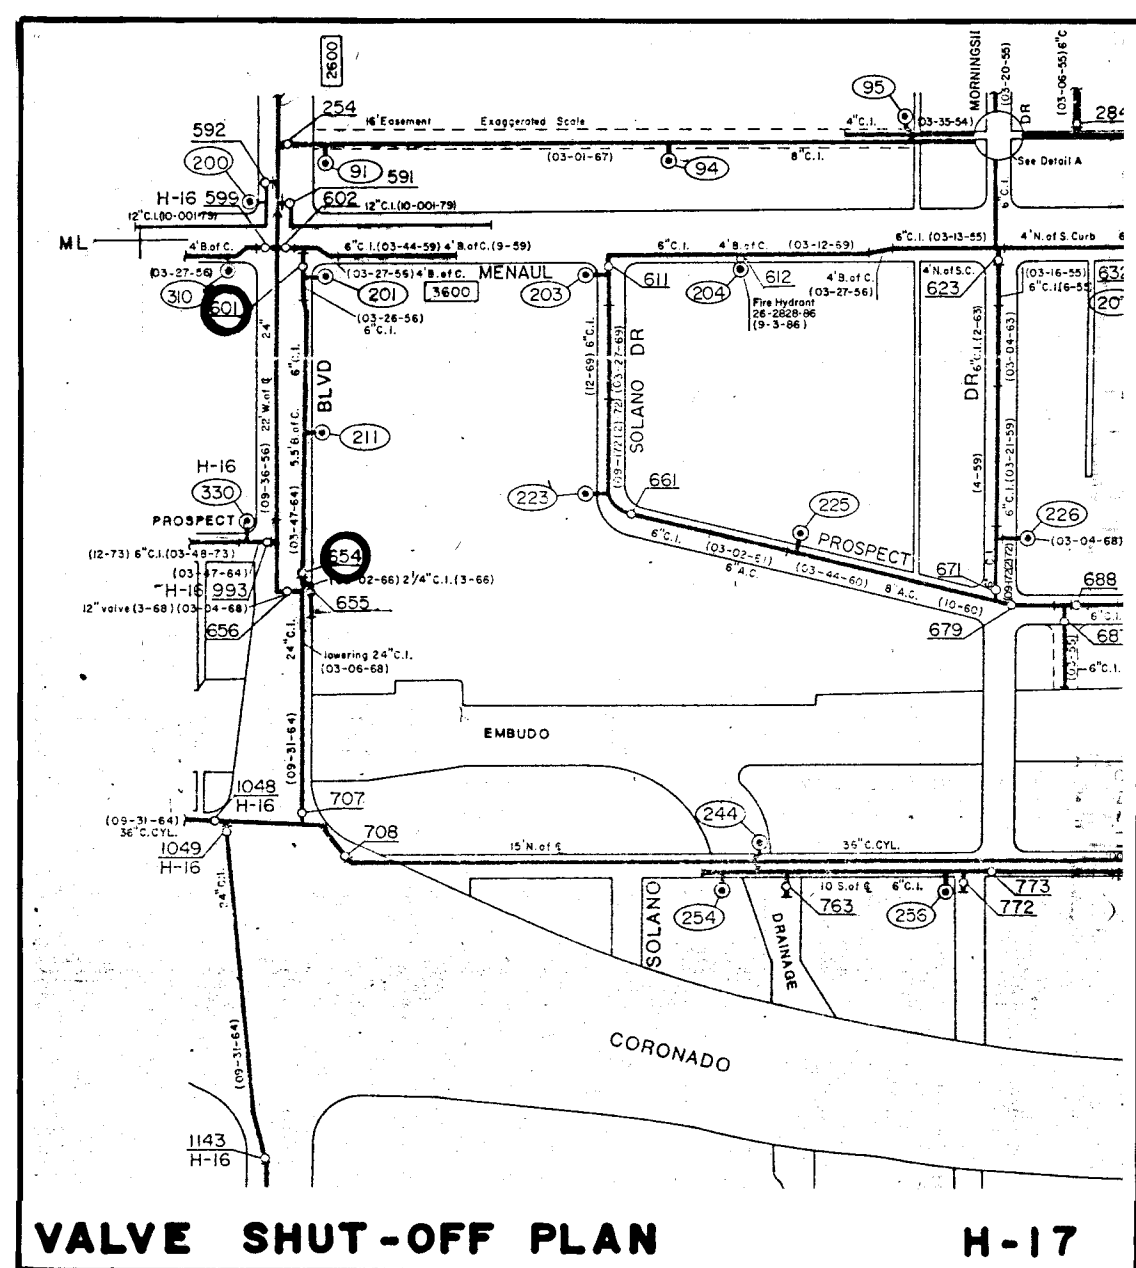


PLAN:
SCALE: 1" = 20'

PROFILE:
SCALE: HORIZ. 1" = 20'
VERT. 1" = 5'

APPROVAL OF AS BUILT DRAWINGS
CHIEF CONSTRUCTION ENGINEER
[Signature]
 DATE 6/5/84

1	2	3	4	5	6	7	8	9	10	11	12	13	14	15
2	6		4	3	3	0	.	9	0	0	1	9	1	

APPROVED FOR
CONSTRUCTION
Sahib W. Sahib 11/4/21
CITY ENGINEER DATE

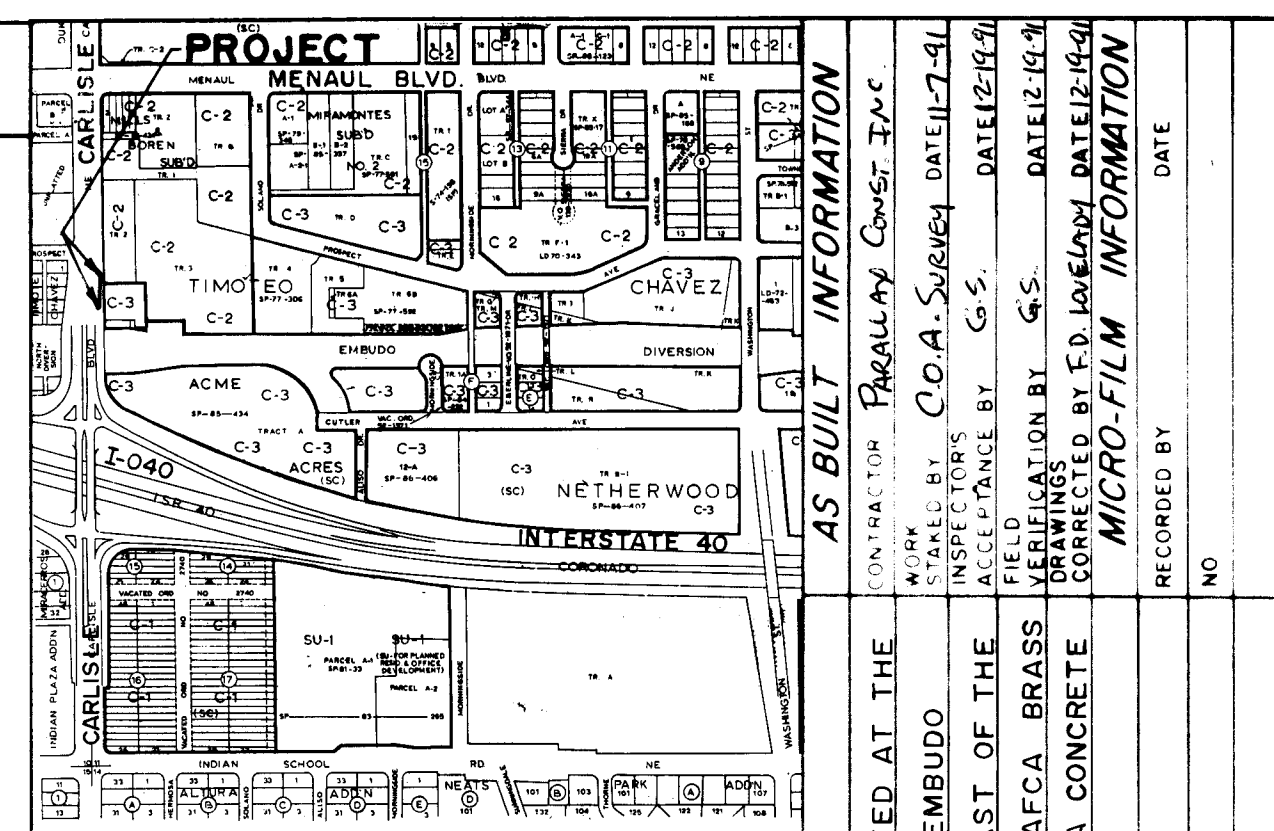

LOCATION MAP	H-17
--------------	------

NOTICE TO CONTRACTOR

1. All work detailed on these plans to be performed under contract shall, except as otherwise stated or provided for hereon, be constructed in accordance with the City of Albuquerque Standard Specifications for Public Works Construction, 1986.
2. Two (2) working days prior to any excavation, the contractor must contact New Mexico One Call System, Inc. (260-1990), for location of existing Utilities.
3. Prior to construction, the contractor shall excavate and verify the horizontal and vertical locations of all obstructions. Should a conflict exist, the contractor shall notify the engineer or surveyor so that the conflict can be resolved with a minimum amount of delay.

TRAFFIC CONTROL NOTES

1. Three (3) working days prior to beginning construction the Contractor shall submit to the Construction Coordination Division a detailed construction schedule. Two (2) working days prior to construction the Contractor shall obtain a barricading permit from the Construction Coordination Division. Contractors shall notify Barricading Engineer (768-2551) prior to occupying an intersection. See section 19 of the Specifications.
2. All street striping altered or destroyed shall be replaced in kind by Contractor to location and in kind as existing or as indicated by this plan set.

THE FOLLOWING NOTES
ALSO APPLY WHEN CHECKED

- ☐ All utilities and utility service lines shall be installed prior to paving.
- ☐ Backfill compaction shall be according to arterial street use.
- ☐ Tack coat requirements shall be determined by the City Engineer.
- ☐ Sidewalks and wheelchair ramps within the curb returns shall be constructed whenever a new curb return is constructed.
- ☐ If curb is depressed for a driveway or a handicap ramp, the driveway or ramp shall be constructed prior to acceptance of the curb and gutter.
- ☐ All storm drainage facilities shall be completed prior to final acceptance.

WATER VALVE SHUT-OFF NOTE

Three (3) working days prior to construction, Contractor shall contact Water Systems (857-8200) for implementation of the Valve Shut-off Plan.

CITY OF ALBUQUERQUE
PUBLIC WORKS DEPARTMENT
ENGINEERING GROUP

TITLE: INFRASTRUCTURE IMPROVEMENTS FOR
BUDGET INN MOTEL
LOT 22A, BLOCK 22, TIMOTEO CHAVEZ ADDITION

APPROVALS	ENGINEER	DATE	APPROVALS	ENGINEER	DATE
DRC CHAIRMAN	<i>Roger A. Lee</i>	10-7-91	WATER	<i>HL</i>	10-1-91
TRANSPORTATION	<i>R. Davis</i>	10-02-91	WASTE WATER	<i>HL</i>	"
HYDROLOGY	<i>Frank O. Davis</i>	10-4-91			

PROJECT NO.	4330.90	MAP NO.	H-17	SHEET	1	OF	1
-------------	----------------	---------	-------------	-------	----------	----	----------