

RINCONADA POINT - UNIT 1

CITY OF ALBUQUERQUE, BERNALILLO COUNTY, NEW MEXICO

IMPROVEMENTS FOR GRADING, PAVING AND UTILITIES

INDEX TO DRAWINGS


ABBREVIATIONS

RL	CURB RETURN LEFT
RR	CURB RETURN RIGHT
R	RADIUS
PC	POINT OF COMPOUND CURVE
PR	POINT OF REVERSE CURVE
PT	POINT OF TANGENCY
CL	CENTER LINE
PVI	POINT OF VERTICAL INTERSECTION
BVC	BEGIN VERTICAL CURVE
END	END VERTICAL CURVE
PTC	POINT OF TANGENCY
PRV	POINT OF REVERSE VERTICAL CURVE
EASE	EASEMENT
EX	EXISTING
FACE	FACE TO FACE
R/W	RIGHT OF WAY
FL	FLOWLINE
EL	ELEVATION
SD	STORM DRAIN
SA	SANITARY SEWER
WL	WATERLINE
MH	MANHOLE
NTS	NOT TO SCALE
HP	POWER POLE
VERT	VERTICAL
HORIZ	HORIZONTAL
TO	TOP OF CURB
STD	STANDARD
INV	INVERT
TP	TOP OF PIPE
TW	TOP OF WALL
EP	EDGE OF PAVEMENT
STA	STATION
TOP	TOP OF PAVEMENT

WARNING - EXISTING UTILITY LINE LOCATIONS ARE SHOWN IN AN APPROXIMATE MANNER ONLY, AND SUCH LINES MAY EXIST WHERE NONE ARE SHOWN. THE LOCATION OF ANY SUCH EXISTING LINES IS BASED UPON INFORMATION PROVIDED BY THE UTILITY COMPANY, THE OWNER, OR BY OTHERS, AND THE INFORMATION MAY BE INCOMPLETE OR MAY BE OBSOLETE BY THE TIME CONSTRUCTION COMMENCES.

THE ENGINEER HAS UNDERTAKEN LIMITED FIELD VERIFICATION OF THE LOCATION, DEPTH, SIZE, OR TYPE OF EXISTING UNDERGROUND UTILITY LINES, MAKES NO REPRESENTATION PERTAINING THERETO AND ASSUMES NO RESPONSIBILITY OR LIABILITY THEREFORE. THE CONTRACTOR SHALL INFORM ITSELF OF THE LOCATION OF ANY UTILITY LINE IN OR NEAR THE AREA OF THE WORK IN ADVANCE OF AND DURING EXCAVATION WORK. THE CONTRACTOR IS FULLY RESPONSIBLE FOR ANY AND ALL DAMAGE CAUSED BY ITS FAILURE TO LOCATE, IDENTIFY, AND PRESERVE ANY AND ALL EXISTING UTILITIES. THE CONTRACTOR SHALL COMPLY WITH STATE STATUTES, MUNICIPAL AND LOCAL ORDINANCES, RULES AND REGULATIONS PERTAINING TO THE LOCATION OF THESE LINES AND FACILITIES IN PLANNING AND CONDUCTING EXCAVATION, WHETHER BY CALLING OR NOTIFYING THE UTILITIES, COMPLYING WITH "BLUE STAKES" PROCEDURES, OR OTHERWISE.

SHEET NO	DESCRIPTION
1	COVER SHEET AND INDEX TO DRAWINGS
2 3	PLAT OF GEOMETRY
4 5	GRADING AND EROSION CONTROL PLANS
6	GRADING AND EROSION CONTROL DETAILS
PAVING PLAN AND PROFILES	
7	COMPOSITE PAVING PLAN
8 9	PAINTED ROCK DRIVE N W
10	RUNNING BIRD PLACE N W & BLACK ROCK ROAD N W
11	OURAY ROAD N W
12	VISTA ALEGRE STREET N W (NOT A PART OF THIS PROJECT)
UTILITY PLAN AND PROFILES	
13	COMPOSITE UTILITY PLAN
14 15	PAINTED ROCK DRIVE N W
16	RUNNING BIRD PLACE N W & BLACK ROCK ROAD N W
17	VISTA ALEGRE STREET N W (NOT A PART OF THIS PROJECT)
18	OFFSITE STORM DRAIN (BASELINE "B")
19	OFFSITE STORM DRAIN (BASELINES "A" AND "C")

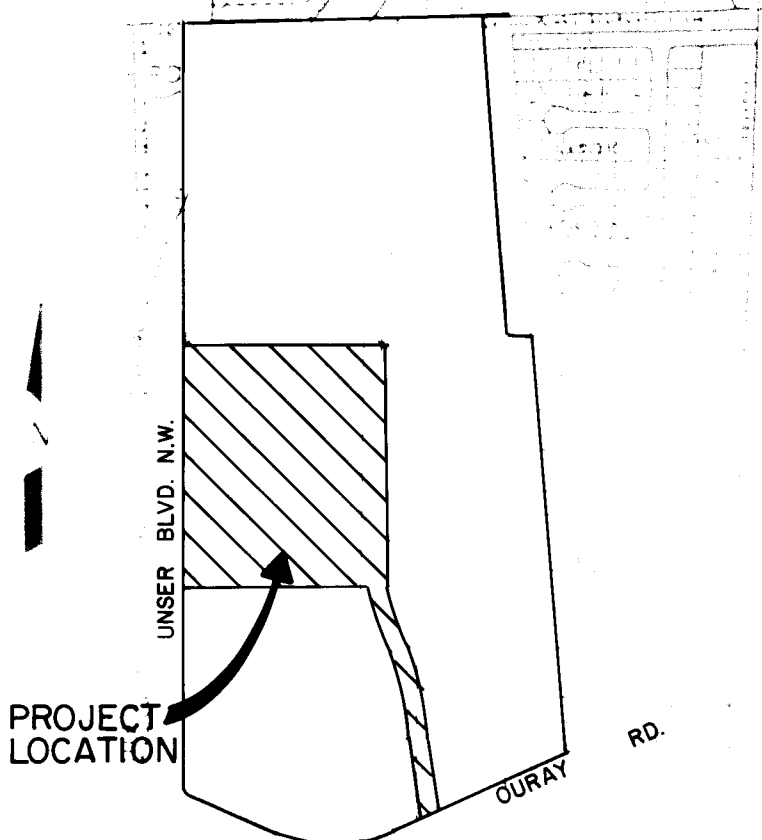


SCALE = 750' VICINITY MAP

- GENERAL NOTES
- ALL WORK DETAILED ON THESE PLANS TO BE PERFORMED UNDER CONTRACT SHALL, EXCEPT AS OTHERWISE STATED, OR PROVIDED FROM HEREON, BE CONSTRUCTED IN ACCORDANCE WITH THE CITY OF ALBUQUERQUE STANDARD SPECIFICATIONS FOR PUBLIC WORKS CONSTRUCTION, 1986 EDITION AS AMENDED WITH UPDATE NO. 4.
 - TWO (2) WORKING DAYS PRIOR TO ANY EXCAVATION, CONTRACTOR MUST CONTACT LINE LOCATING SERVICE, (260-1990) FOR LOCATION OF EXISTING UTILITIES.
 - PRIOR TO CONSTRUCTION, THE CONTRACTOR SHALL EXCAVATE AND VERIFY THE HORIZONTAL AND VERTICAL LOCATIONS OF ALL OBSTRUCTIONS AND EXISTING PAVEMENT. SHOULD A CONFLICT EXIST, THE CONTRACTOR SHALL NOTIFY THE ENGINEER OR SURVEYOR SO THAT THE CONFLICT CAN BE RESOLVED WITH MINIMUM AMOUNT OF DELAY.
 - THE CONTRACTOR SHALL FURNISH EMD'S ON ALL WATER AND SEWER SERVICE STUBS, CAPS AND PLUGS.
 - CONTRACTOR SHALL NOTIFY THE PROJECT ENGINEER NOT LESS THAN SEVEN (7) DAYS PRIOR TO STARTING WORK IN ORDER THAT THE ENGINEER MAY TAKE NECESSARY MEASURES TO INSURE THE PRESERVATION OF SURVEY MONUMENTS. CONTRACTOR SHALL NOT DISTURB PERMANENT SURVEY MONUMENTS WITHOUT THE CONSENT OF THE ENGINEER AND BEAR THE EXPENSE OF REPLACING ANY THAT MAY BE DISTURBED WITHOUT PERMISSION. REPLACEMENT SHALL BE DONE ONLY BY THE CITY SURVEY SECTION. WHEN A CHANGE IS MADE IN ANY ROADWAY IN WHICH A PERMANENT SURVEY MONUMENT IS LOCATED, CONTRACTOR SHALL, AT HIS OWN EXPENSE, ADJUST THE MONUMENT COVER TO THE NEW GRADE UNLESS OTHERWISE SPECIFIED. REFER TO SECTION 4.4 OF GENERAL CONDITIONS OF THE CITY OF ALBUQUERQUE STANDARD SPECIFICATIONS FOR PUBLIC WORKS CONSTRUCTION.
 - RESTRAINED JOINTS ARE REQUIRED AT ALL WATER LINE BENDS, TEES, CAPS AND GATE VALVES.
 - THE PUBLIC WATER LINE MUST BE A MINIMUM OF 18" ABOVE THE SEWER LINE AT ALL CROSSINGS.
 - THE CONTRACTOR SHALL CONTACT WATER SYSTEMS DIVISION (857-8200) THREE (3) WORKING DAYS PRIOR TO NEEDING SHUT-OFF OR TURN-ON OF VALVES. ONLY CITY WATER SYSTEMS PERSONNEL ARE AUTHORIZED TO OPERATE VALVE.
 - THREE (3) WORKING DAYS PRIOR TO BEGINNING CONSTRUCTION, THE CONTRACTOR SHALL SUBMIT TO THE CONSTRUCTION COORDINATION DIVISION A DETAILED CONSTRUCTION SCHEDULE. TWO (2) WORKING DAYS PRIOR TO CONSTRUCTION, THE CONTRACTOR SHALL OBTAIN A BARRICADING PERMIT FROM THE CONSTRUCTION COORDINATION DIVISION. CONTRACTOR SHALL NOTIFY BARRICADE ENGINEER (768-2551) PRIOR TO OCCUPYING AN INTERSECTION. SEE SECTION 19 OF THE SPECIFICATIONS.
 - ALL STREET STRIPING ALTERED OR DESTROYED SHALL BE REPLACED IN KIND BY CONTRACTOR TO LOCATION AND IN KIND AS EXISTING OR AS INDICATED BY THIS PLAN SET. ALL NEW STRIPING SHALL BE PLASTIC AS PER CITY STANDARDS.


SCANNED BY
BY LASON

REV	DATE	BY	DATE	USER	DATE	DATE	DATE
1	8-2-94	B.P. Lopez	11-16-94	John Curtin	10-26-94	R.W. Kane	7-29-94
2	8-2-94	B.P. Lopez	8-2-94	Black	7-29-94		

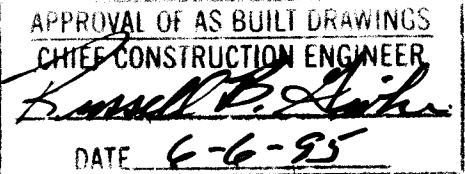

ENGINEER'S SEAL	DATE: MARCH 1994	community sciences corporation	APPROVED FOR CONSTRUCTION
DESIGNED: B.P. Lopez	SCALE: AS SHOWN		
DRAWN: M	INCHES: 1" = 40'		
TEXT: M	AND PLANNING: P.O. Box 1328		
NUMBER: 4933.90	NUMBER: Corrales N.M. 87048		
DATE: 7/18/94			

1 2 3 4 5 6 7 8 9 10 11 12 13 14 15
26 4933.90 1900/1951

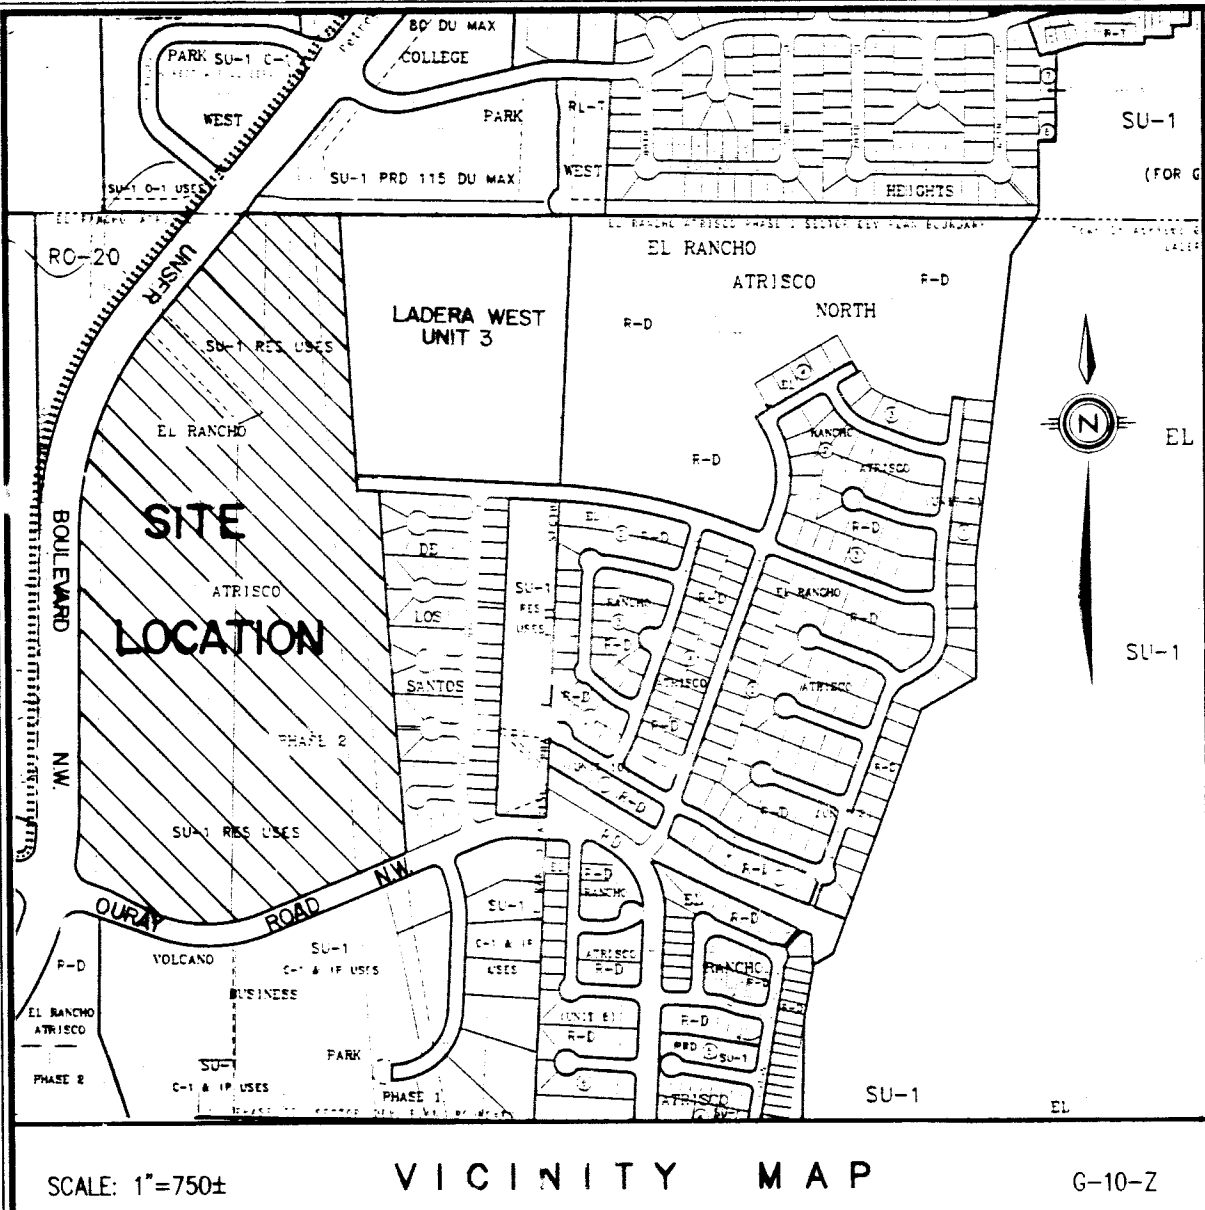

LEGAL DESCRIPTION

THAT CERTAIN PARCEL OF LAND SITUATE WITHIN THE TOWN OF ATRISCO GRANT ("PROJECTED" SECTION 3, TOWNSHIP 10 NORTH, RANGE 3 EAST, NEW MEXICO PRINCIPAL MERIDIAN), CITY OF ALBUQUERQUE, BERNALILLO COUNTY, NEW MEXICO AND BEING COMPRISED OF A PORTION OF TRACT 6-A, EL RANCHO ATRISCO PHASE II AS THE SAME IS SHOWN AND DESIGNATED ON THE PLAT OF RECORD FILED IN THE OFFICE OF THE COUNTY CLERK OF BERNALILLO COUNTY, NEW MEXICO ON FEBRUARY 27, 1987 IN VOLUME C33, FOLIO 11; TOGETHER WITH "TRACT 7-A-1, EL RANCHO ATRISCO PHASE II AS THE SAME IS SHOWN AND DESIGNATED ON THE PLAT OF RECORD FILED IN THE OFFICE OF THE COUNTY CLERK OF BERNALILLO COUNTY, NEW MEXICO ON NOVEMBER 24, 1993 IN VOLUME 93C, FOLIO 327 AND BEING MORE PARTICULARLY DESCRIBED AS FOLLOWS:

BEGINNING FROM AT THE CITY OF ALBUQUERQUE CONTROL STATION (ACS) BRASS CAP "2-08" HAVING NEW MEXICO STATE PLANE COORDINATES OF X = 356,080.72 AND Y = 4,490,064.48; THENCE S82°15'47"E, 865.84 FEET TO A POINT BEING THE SOUTHWEST CORNER OF SAID TRACT 6-A, A POINT ON THE EASTERLY RIGHT-OF-WAY LINE OF UNSER BOULEVARD (156' RW) AND THE TRUE PLACE OF BEGINNING OF THE PARCEL HEREIN DESCRIBED; THENCE ALONG SAID EASTERLY RIGHT-OF-WAY LINE OF UNSER BOULEVARD N00°14'19"E, 93.71 FEET TO A POINT ON CURVE (POC); THENCE 172.13 FEET ALONG THE ARC OF A CURVE BEARING TO THE LEFT (SAID ARC HAVING A RADIUS OF 1475.70 FEET, A CENTRAL ANGLE OF 08°39'45" AND A CHORD THAT BEARS S03°34'16"W, 172.03 FEET) TO A POINT OF TANGENCY (PT); THENCE N00°14'19"E, 774.62 FEET TO AN ANGLE POINT; THENCE N01°47'09"W, 283.08 FEET TO A POINT OF CURVATURE (PC); THENCE CONTINUING ALONG SAID UNSER BOULEVARD RIGHT-OF-WAY 899.33 FEET ALONG THE ARC OF A CURVE BEARING TO THE RIGHT (SAID ARC HAVING A RADIUS OF 1122.00 FEET, A CENTRAL ANGLE OF 38°58'38" AND A CHORD THAT BEARS N18°43'38"E, 882.09 FEET) TO A POINT OF TANGENCY (PT); THENCE N39°12'57"E, 560.96 FEET TO A POINT ON THE NORTH BOUNDARY LINE OF TOWN OF ATRISCO GRANT AND THE NORTHWEST CORNER OF THE PARCEL HEREIN DESCRIBED; THENCE DEPARTING UNSER BOULEVARD RIGHT-OF-WAY 1147.94 FEET ALONG THE WESTERLY BOUNDARY OF SAID EL RANCHO ATRISCO DE LOS SANTOS (FILED 2-8-94, VOL. 94C, FOL. 63) AND THE NORTHEAST CORNER OF THE PARCEL HEREIN DESCRIBED; THENCE DEPARTING SAID GRANT LINE S04°17'07"E, 1077.81 FEET ALONG THE WESTERLY BOUNDARY OF SAID LADERA WEST UNIT 3 TO AN ANGLE POINT ON THE SOUTH RIGHT-OF-WAY LINE OF VISTA ALEGRE STREET (50' RW); THENCE ALONG SAID RIGHT-OF-WAY LINE S87°16'08"E, 100.75 FEET TO AN ANGLE POINT, SAID POINT BEING THE NORTHWEST CORNER OF EL RANCHO ATRISCO DE LOS SANTOS (FILE 2-25-82, VOL. C19, FOL. 181); THENCE DEPARTING VISTA ALEGRE RIGHT-OF-WAY S04°17'07"E, 1407.94 FEET ALONG THE WESTERLY BOUNDARY OF SAID EL RANCHO ATRISCO DE LOS SANTOS TO A POINT ON THE NORTHERLY RIGHT-OF-WAY LINE OF OURAY ROAD N.W. (86' RW); THE SOUTHWEST CORNER OF EL RANCHO ATRISCO DE LOS SANTOS, AND THE SOUTHEAST CORNER OF THE PARCEL HEREIN DESCRIBED; THENCE S67°11'00"W, 620.58 FEET ALONG SAID OURAY ROAD RIGHT-OF-WAY TO A POINT OF CURVATURE (PC); THENCE 38.54 FEET ALONG THE ARC OF A CURVE BEARING TO THE RIGHT (SAID ARC HAVING A RADIUS OF 519.54 FEET, A CENTRAL ANGLE OF 42°04'36" AND A CHORD THAT BEARS S88°13'18"W, 373.02 FEET) TO A POINT OF TANGENCY (PT); THENCE S62°22'12"W, 150.18 FEET TO AN ANGLE POINT; THENCE N70°44'24"W, 166.24 FEET TO A POINT OF CURVATURE (PC); THENCE CONTINUING ALONG OURAY RIGHT-OF-WAY 42.77 FEET ALONG THE ARC OF A CURVE BEARING TO THE LEFT (SAID ARC HAVING A RADIUS OF 75.00 FEET, A CENTRAL ANGLE OF 32°40'33" AND A CHORD THAT BEARS N54°13'43"W, 42.20 FEET) TO A POINT ON THE WESTERLY RIGHT-OF-WAY LINE OF UNSER BOULEVARD AND THE TRUE PLACE OF BEGINNING OF THE PARCEL HEREIN DESCRIBED.

THE ABOVE DESCRIBED ENCLOSURE CONTAINS 62.7703 ACRES, MORE OR LESS.

TREASURER'S CERTIFICATION

THIS IS TO CERTIFY THAT TAXES ARE CURRENT AND PAID ON UPC #'S:

TRACT 6-A, UPC #10100600341913010
TRACT 7-A-1, UPC#101006009018530102

PROPERTY OWNER OF RECORD: CURB INC., CHARLES A. HAEGELIN, PRESIDENT

BERNALILLO COUNTY TREASURER'S OFFICE:

BY: _____ DATE: _____

CITY INFRASTRUCTURE AND DRAINAGE REQUIREMENT NOTICE: SEE SHEET 3 OF THIS PLAT FOR REQUIREMENT NOTICE. (PERTAINS TO TRACTS A, B, C AND E SUBDIVIDED HEREIN.)

In approving this plat, PNM did not conduct a Title Search of the properties shown hereon. Consequently, PNM does not waive or release any easement or easement rights which may have been granted by prior plat, replat, or other document and which are not shown on this plat.

VACATION AND REPLAT COMPRISED OF A PORTION OF TRACT 6-A AND ALL OF TRACT 7-A-1, EL RANCHO ATRISCO PHASE II TO **RINCONADA POINT UNIT 1** SITUATE WITHIN TOWN OF ATRISCO GRANT PROJECTED SECTION 3, T10N, R3E, N.M.P.M. CITY OF ALBUQUERQUE, BERNALILLO COUNTY, NEW MEXICO MAY, 1994

SUBDIVISION DATA:

CASE NO. _____ DFE# 94-125, V-94-29, SV-94-11
GROSS SUBDIVISION ACREAGE 62.7703 AC
ZONE ATLAS INDEX NO. G-10-Z
NO. OF EXISTING TRACTS 2
NO. OF TRACTS CREATED 5
NO. OF LOTS CREATED 50
MILES OF FULL-WIDTH STREETS CREATED 0.4641
DATE OF SURVEY MARCH 1994
P.L.O.G. NO. 94-05-06-1450-0329

APPROVALS:

*SUBDIVISION PLAT CONDITIONS: FILED _____ DOC. NO. _____
FOLIO _____ VOLUME _____

SUBDIVISION CASE NUMBER: _____

CITY PLANNER/ALBUQUERQUE, BERNALILLO CO. PLANNING DIVISION _____ DATE _____

PARKS AND RECREATION DEPARTMENT _____ DATE _____

TRAFFIC ENGINEER, TRANSPORTATION DEPARTMENT _____ DATE _____

CITY ENGINEER, ENGINEERING DIVISION _____ DATE _____

ALBUQUERQUE METROPOLITAN ARROYO FLOOD CONTROL AUTHORITY _____ DATE _____

UTILITY DEVELOPMENT _____ DATE _____

CITY SURVEYOR, ENGINEERING DIVISION _____ DATE _____

PROPERTY MANAGEMENT _____ DATE _____

THE COMPANY OF NEW MEXICO _____ DATE _____


JOHN E. MARTINEZ _____ DATE _____

PUBLIC SERVICE COMPANY OF NEW MEXICO _____ DATE _____

SURVEYOR'S CERTIFICATION:

I, C. A. SPIROCK, HEREBY AFFIRM THAT I AM A DULY QUALIFIED REGISTERED PROFESSIONAL SURVEYOR UNDER THE LAWS OF THE STATE OF NEW MEXICO AND DO CERTIFY THAT THIS PLAT WAS PREPARED BY ME OR UNDER MY DIRECT SUPERVISION; SHOWS ACCURATE DIMENSIONS, AND LAND AREAS; SHOWS ALL EASEMENTS AND RESTRICTIONS AS SHOWN ON THE PLAT OF RECORD OR MADE KNOWN TO ME BY THE OWNERS AND/OR PROPRIETORS OF THE SUBDIVISION SHOWN HEREON. TITLE COMPANIES, UTILITY COMPANIES OR OTHER PARTIES EXPRESSING AN INTEREST. I FURTHER CERTIFY THAT THIS PLAT MEETS THE MINIMUM REQUIREMENTS FOR MONUMENTATION AND SURVEYS OF THE ALBUQUERQUE SUBDIVISION ORDINANCE, MEETS THE MINIMUM STANDARDS FOR LAND SURVEYS SET FORTH BY THE STATE OF NEW MEXICO AND IS TRUE AND CORRECT TO THE BEST OF MY KNOWLEDGE AND BELIEF.


C. A. SPIROCK, N.M.P.S. #4972 _____ DATE 5/23/94

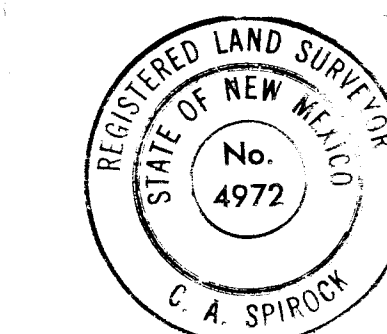

SHEET 1 OF 4

DATE: APRIL 1994
SCALE: AS SHOWN
DESIGNED: KD
DRAWN: DER
JOB NO.: 291-05-025
LAND PLANNING: P.O. Box 1328
ENGINEERING: Corrales, N.M. 87046
SURVEYING: Corrales, N.M. 87046

community sciences corporation

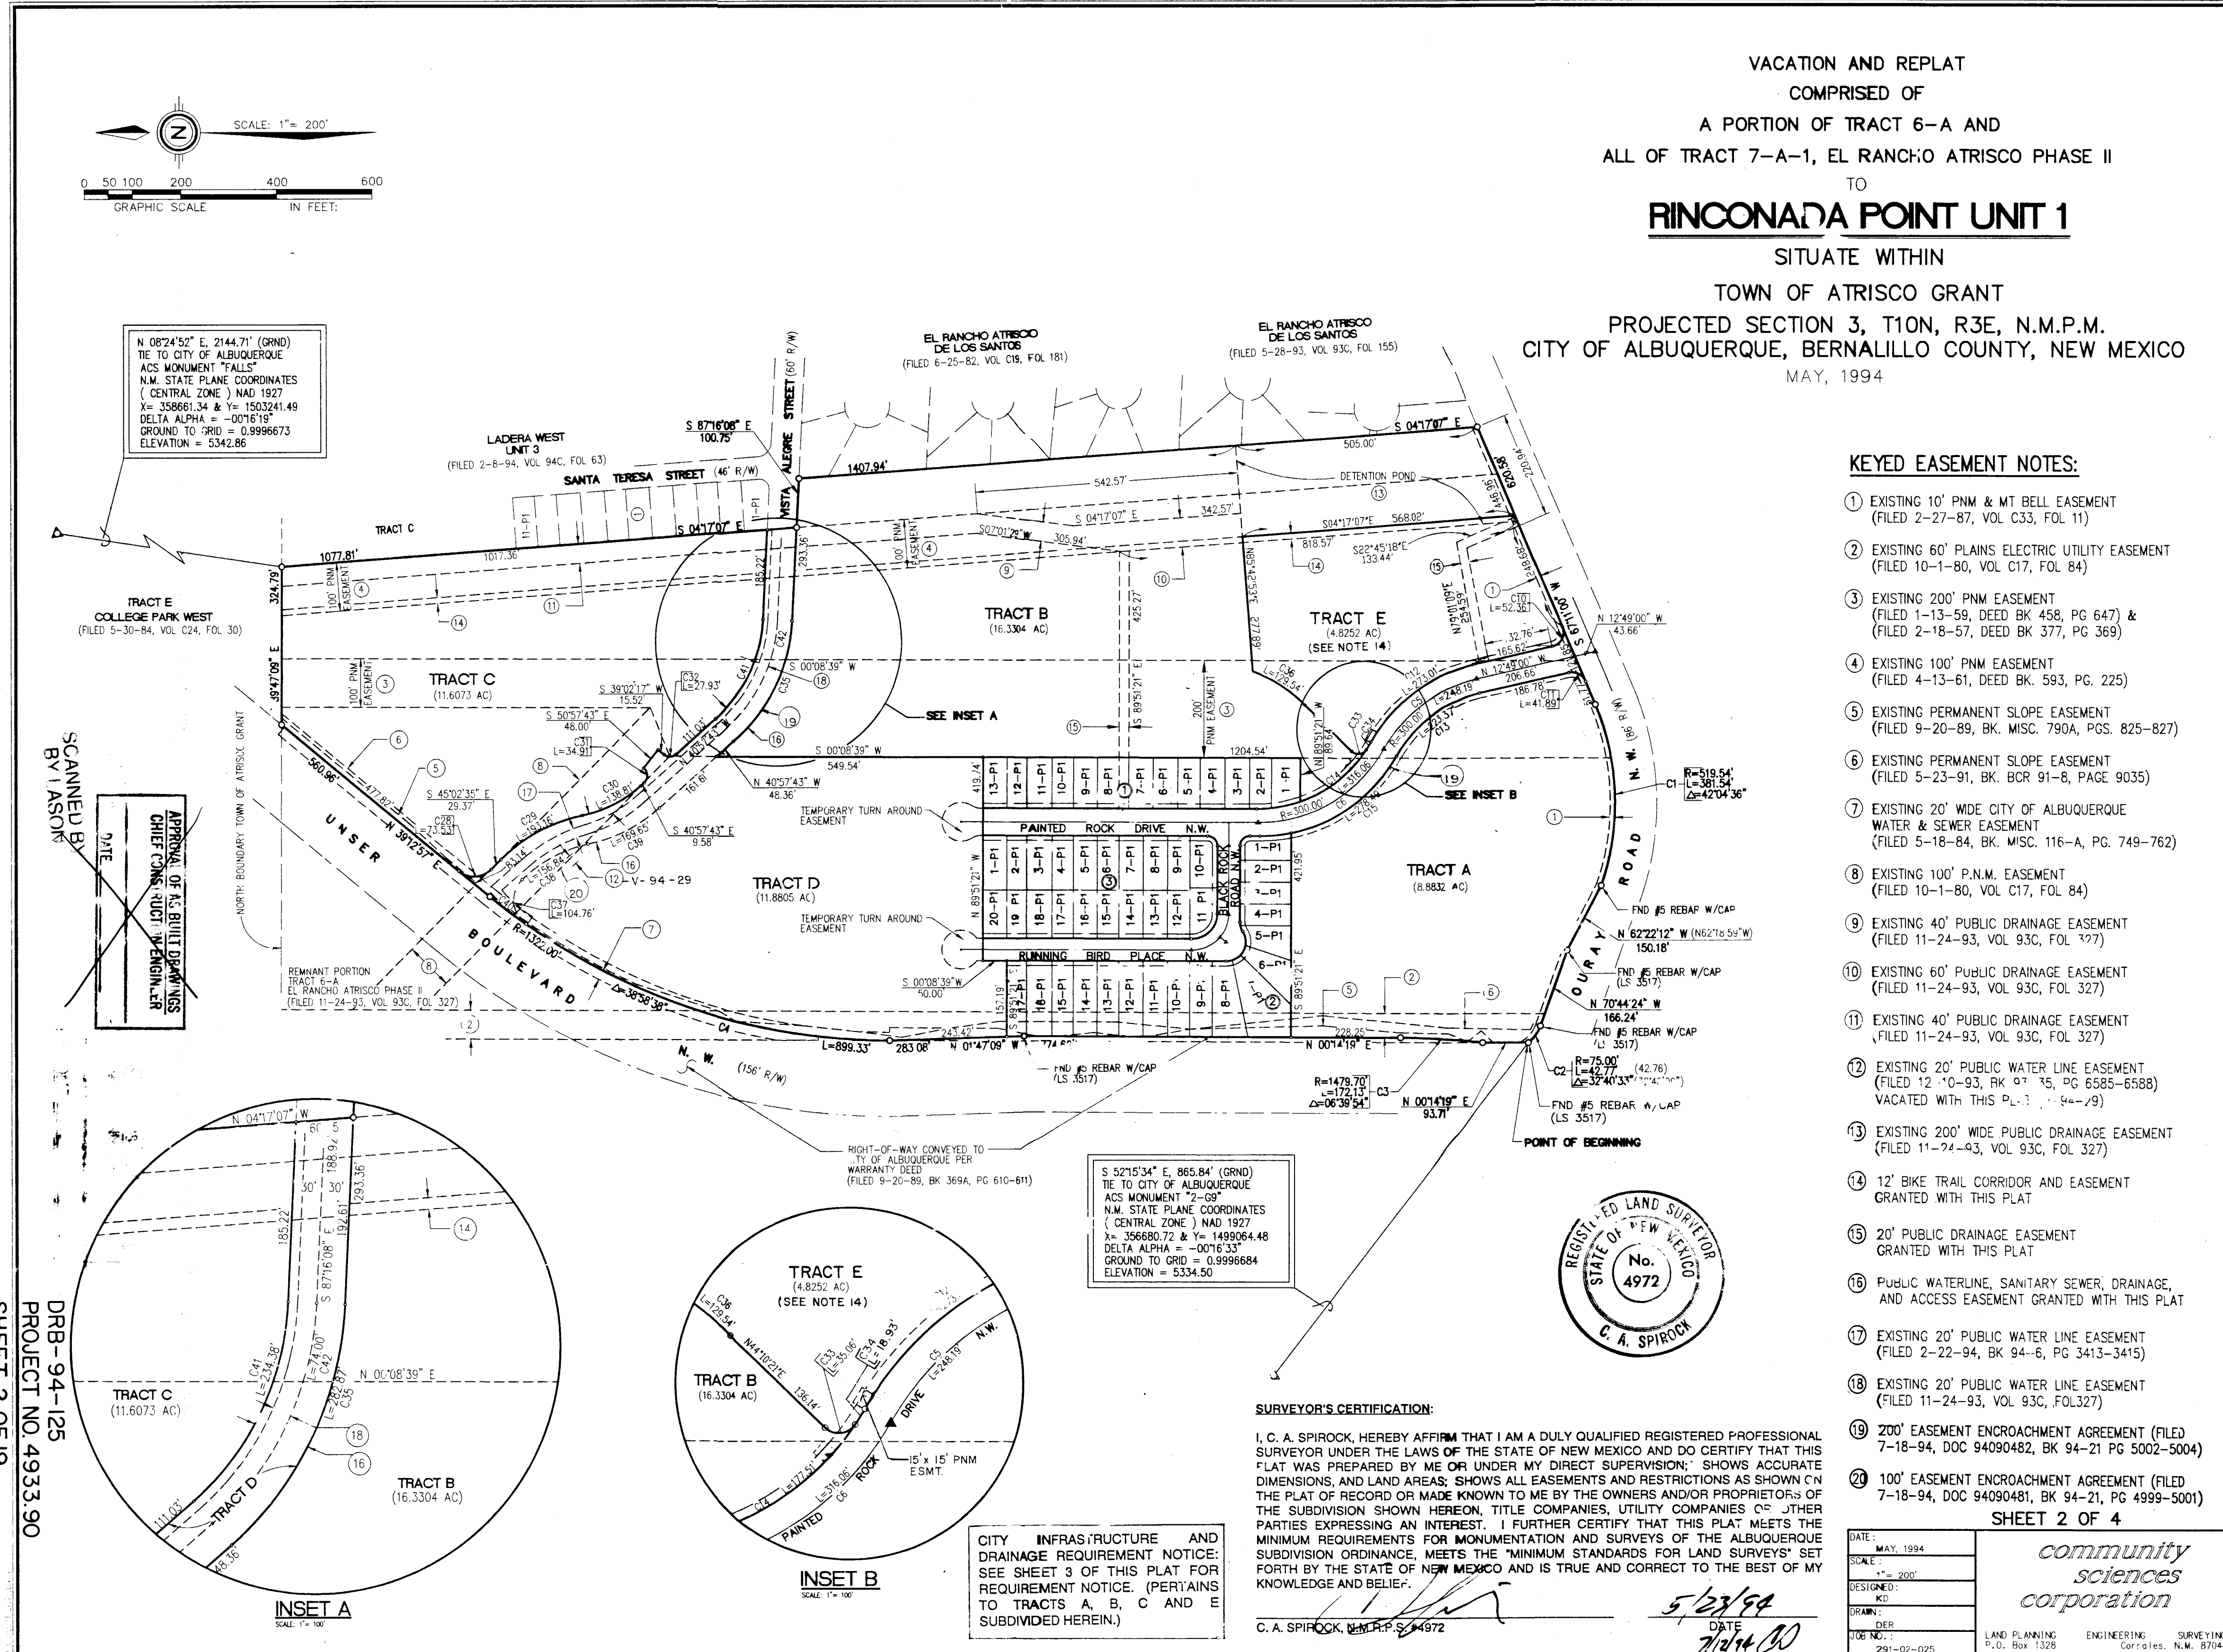

KEYED EASEMENT NOTES:

- EXISTING 10' PNM & MT BELL EASEMENT (FILED 2-27-87, VOL. C33, FOL. 11)
- EXISTING 60' PLAINS ELECTRIC UTILITY EASEMENT (FILED 10-1-80, VOL. C17, FOL. 84)
- EXISTING 200' PNM EASEMENT (FILED 1-13-59, DEED BK 458, PG. 647) & (FILED 2-18-57, DEED BK 377, PG. 369)
- EXISTING 100' PNM EASEMENT (FILED 4-13-61, DEED BK. 593, PG. 225)
- EXISTING PERMANENT SLOPE EASEMENT (FILED 9-20-89, BK. MISC. 790A, PGS. 825-827)
- EXISTING PERMANENT SLOPE EASEMENT (FILED 5-23-91, BK. BCR 91-8, PAGE 9035)
- EXISTING 20' WIDE CITY OF ALBUQUERQUE WATER & SEWER EASEMENT (FILED 5-18-84, BK. MISC. 116-A, PG. 749-762)
- EXISTING 100' P.N.M. EASEMENT (FILED 10-1-80, VOL. C17, FOL. 84)
- EXISTING 40' PUBLIC DRAINAGE EASEMENT (FILED 11-24-93, VOL. 93C, FOL. 327)
- EXISTING 60' PUBLIC DRAINAGE EASEMENT (FILED 11-24-93, VOL. 93C, FOL. 327)
- EXISTING 40' PUBLIC DRAINAGE EASEMENT (FILED 11-24-93, VOL. 93C, FOL. 327)
- EXISTING 20' PUBLIC WATER LINE EASEMENT (FILED 12-10-93, RK 07 35, PG. 6585-6588) VACATED WITH THIS PLAT (94-09)
- EXISTING 200' WIDE PUBLIC DRAINAGE EASEMENT (FILED 11-24-93, VOL. 93C, FOL. 327)
- 12' BIKE TRAIL CORRIDOR AND EASEMENT GRANTED WITH THIS PLAT
- 20' PUBLIC DRAINAGE EASEMENT GRANTED WITH THIS PLAT
- PUBLIC WATERLINE, SANITARY SEWER, DRAINAGE, AND ACCESS EASEMENT GRANTED WITH THIS PLAT
- EXISTING 20' PUBLIC WATER LINE EASEMENT (FILED 2-22-94, BK. 94-6, PG. 3413-3415)
- EXISTING 20' PUBLIC WATER LINE EASEMENT (FILED 11-24-93, VOL. 93C, FOL. 327)
- 200' EASEMENT ENCROACHMENT AGREEMENT (FILED 7-18-94, DOC. 94090482, BK. 94-21 PG. 5002-5004)
- 100' EASEMENT ENCROACHMENT AGREEMENT (FILED 7-18-94, DOC. 94090481, BK. 94-21, PG. 4999-5001)

SURVEYOR'S CERTIFICATION:

I, C. A. SPIROCK, HEREBY AFFIRM THAT I AM A DULY QUALIFIED REGISTERED PROFESSIONAL SURVEYOR UNDER THE LAWS OF THE STATE OF NEW MEXICO AND DO CERTIFY THAT THIS PLAT WAS PREPARED BY ME OR UNDER MY DIRECT SUPERVISION; SHOWS ACCURATE DIMENSIONS, AND LAND AREAS; SHOWS ALL EASEMENTS AND RESTRICTIONS AS SHOWN ON THE PLAT OF RECORD OR MADE KNOWN TO ME BY THE OWNERS AND/OR PROPRIETORS OF THE SUBDIVISION SHOWN HEREON. TITLE COMPANIES, UTILITY COMPANIES OR OTHER PARTIES EXPRESSING AN INTEREST. I FURTHER CERTIFY THAT THIS PLAT MEETS THE MINIMUM REQUIREMENTS FOR MONUMENTATION AND SURVEYS OF THE ALBUQUERQUE SUBDIVISION ORDINANCE, MEETS THE MINIMUM STANDARDS FOR LAND SURVEYS SET FORTH BY THE STATE OF NEW MEXICO AND IS TRUE AND CORRECT TO THE BEST OF MY KNOWLEDGE AND BELIEF.

C. A. SPIROCK, N.M.P.S. #4972 _____ DATE 5/23/94

CITY INFRASTRUCTURE AND DRAINAGE REQUIREMENT NOTICE: SEE SHEET 3 OF THIS PLAT FOR REQUIREMENT NOTICE. (PERTAINS TO TRACTS A, B, C AND E SUBDIVIDED HEREIN.)


SHEET 2 OF 4

DATE: MAY 1994
SCALE: 1"=200'
DESIGNED: KD
DRAWN: DER
JOB NO.: 291-05-025
LAND PLANNING: P.O. Box 1328
ENGINEERING: Corrales, N.M. 87046
SURVEYING: Corrales, N.M. 87046

community sciences corporation

COMMUNITY SCIENCES CORPORATION - CORRALLES, NEW MEXICO 87505 - (505) 878-0000

DRB-94-125
PROJECT NO. 4933.90
SHEET 3 OF 19

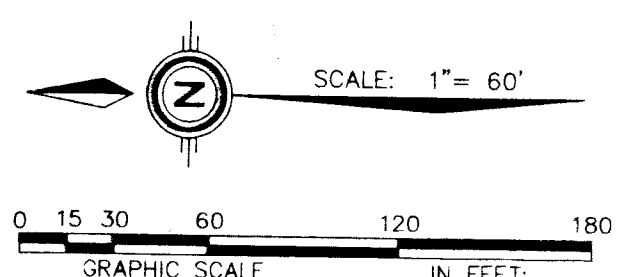

TANGENT TABLE		
T-1	S 39°47'18" W	15.91'
T-2	S 00°08'39" W	20.43'
T-4	N 00°14'19" E	5.37'
T-5	S 00°08'39" W	3.00'
T-6	S 00°08'39" W	14.55'

ABBREVIATIONS:
P.U.E. PUBLIC UTILITY EASEMENT
P.D.E. PRIVATE DRAINAGE EASEMENT
ESMT. EASEMENT
R/W RIGHT-OF-WAY

VACATION AND REPLAT
COMPRISED OF
A PORTION OF TRACT 6-A AND
ALL OF TRACT 7-A-1, EL RANCHO ATRISCO PHASE II
TO
RINCONADA POINT UNIT 1
SITUATE WITHIN
TOWN OF ATRISCO GRANT
PROJECTED SECTION 3, T10N, R3E, N.M.P.M.
CITY OF ALBUQUERQUE, BERNALILLO COUNTY, NEW MEXICO
MAY, 1994

SEE SHEET 2 OF 4
TRACT B
(16.3304 AC)

TRACT E
(FUTURE PARK)
(SEE NOTE 14)

SEE SHEET 2 OF 4
TRACT A
(8.8832 AC)

NOTICE OF SUBDIVISION PLAT CONDITIONS

PURSUANT TO SECTION 7 OF THE CITY OF ALBUQUERQUE, NEW MEXICO SUBDIVISION ORDINANCE, A VARIANCE OR WAIVER FROM CERTAIN SUBDIVISION REQUIREMENTS HAS BEEN GRANTED BY THE CITY AND THE ALBUQUERQUE METROPOLITAN APPROVED FLOOD CONTROL AUTHORITY IN CONNECTION WITH THIS PLAT.

FUTURE SUBDIVISION OF TRACTS A, B, C AND E WITHIN THIS PLAT, ZONING SITE DEVELOPMENT PLAN APPROVALS, AND DEVELOPMENT PERMITS MAY BE CONDITIONED UPON DEDICATION OF RIGHTS-OF-WAY AND EASEMENTS, AND/OR UPON INFRASTRUCTURE IMPROVEMENTS BY THE OWNER FOR WATER, SANITARY SEWER, STREETS, DRAINAGE, GRADING, AND PARKS, IN ACCORDANCE WITH CURRENT RESOLUTIONS, ORDINANCES, AND POLICIES IN EFFECT AT THE TIME FOR ANY SPECIFIC PROPOSAL.

THE CITY (AND AMAPCA WITH REFERENCE TO DRAINAGE) MAY REQUIRE AND/OR PERMIT EASEMENTS TO BE ADDED, MODIFIED, OR REMOVED WHEN FUTURE PLATS AND/OR SITE DEVELOPMENT PLANS ARE APPROVED.

BY ITS APPROVAL, THE CITY MAKES NO REPRESENTATION OR WARRANTIES AS TO AVAILABILITY OF UTILITIES, OR FINAL APPROVAL OF ALL REQUIREMENTS REMAINING (BUT NOT LIMITED TO) THE FOLLOWING ITEMS:

WATER AND SANITARY SEWER AVAILABILITY,
FUTURE STREET DEDICATIONS AND/OR IMPROVEMENTS,
PARK AND OPEN SPACE REQUIREMENTS,
DRAINAGE REQUIREMENTS AND/OR IMPROVEMENTS,
EXCAVATION, FILLING, OR GRADING REQUIREMENTS.

ANY PERSON INTENDING DEVELOPMENT OF LANDS WITHIN THIS SUBDIVISION IS CAUTIONED TO INVESTIGATE THE STATUS OF THESE ITEMS.

A SEPARATE NOTICE OF THESE CONDITIONS IS TO BE RECORDED WITH THE COUNTY CLERK AT THE TIME OF FINAL PLAT RECORDING.

SURVEYOR'S CERTIFICATION:

I, C. A. SPIROCK, HEREBY AFFIRM THAT I AM A DULY QUALIFIED REGISTERED PROFESSIONAL SURVEYOR UNDER THE LAWS OF THE STATE OF NEW MEXICO AND DO CERTIFY THAT THIS PLAT WAS PREPARED BY ME OR UNDER MY DIRECT SUPERVISION; SHOWS ACCURATE DIMENSIONS, AND LAND AREAS; SHOWS ALL EASEMENTS AND RESTRICTIONS AS SHOWN ON THE PLAT OF RECORD OR MADE KNOWN TO ME BY THE OWNERS AND/OR PROPRIETORS OF THE SUBDIVISION SHOWN HEREON, TITLE COMPANIES, UTILITY COMPANIES OR OTHER PARTIES EXPRESSING AN INTEREST. I FURTHER CERTIFY THAT THIS PLAT MEETS THE MINIMUM REQUIREMENTS FOR MONUMENTATION AND SURVEYS OF THE ALBUQUERQUE SUBDIVISION ORDINANCE, MEETS THE "MINIMUM STANDARDS FOR LAND SURVEYS" SET FORTH BY THE STATE OF NEW MEXICO AND IS TRUE AND CORRECT TO THE BEST OF MY KNOWLEDGE AND BELIEF.

C. A. SPIROCK, N.M.P.S. #4972

DATE: 5/23/94
C.A.S. 7/12/94



SHEET 3 OF 4

community sciences corporation

DATE: MAY 1994
SCALE: 1" = 60'
DESIGNED: KD
DRAWN: DER
JOB NO.: 291-05-025

LAND PLANNING: P.O. Box 1328
ENGINEERING: Corrales, N.M. 87048
SURVEYING: Corrales, N.M. 87048

NOTES:

- THE PURPOSE OF THIS PLAT IS TO COMBINE A PORTION OF TRACT 6-A AND ALL OF TRACT 7-A-1, EL RANCHO ATRISCO PHASE II, TO CREATE 80 RESIDENTIAL LOTS, 5 RESIDUAL TRACTS, AND TO VACATE A WATER LINE EASEMENT ALONG VISTA ALEGRE.
- ALL BEARINGS SHOWN HEREON ARE GRID BEARINGS BASED ON THE NEW MEXICO, STATE PLANE COORDINATE SYSTEM CENTRAL ZONE, MEAN DELTA ALPHA -00°16'24". ALL DISTANCES ARE GROUND.
- BEARINGS AND DISTANCES SHOWN IN PARENTHESES ARE FROM RECORD PLATS.
- ALL DIMENSIONS PUBLISHED ALONG CURVED LINES ARE ARC DISTANCES. LOT LINES MARKED N/R ARE NON-RADIAL.
- BENCHMARK FOR THIS PLAT IS A STANDARD A.C.S. BRASS TABLET STAMPED "2-39" SET IN A 2" IRON PIPE 1" ABOVE GROUND. STA. IS LOCATED ON TOP OF VOLCANO OUTCROP. TO REACH THIS STA. BEGIN AT 1400 COORS RD. PROCEED NORTH ON COORS 0.4 MI. TO OURAY RD. WEST ON OURAY RD. 0.7 MI. TO END OF PAVEMENT CONTINUE WEST ON DIRT RD. TO TOP OF DAM, ALONG NORTH BANK 0.6 MI. TO DIRT CROSS ROAD. NORTH ON DIRT ROAD 0.5 MI. THE STA. IS ABOUT 600' WEST OF THIS POINT. ELEVATION = 5334.50 FEET.
- UNLESS OTHERWISE NOTED, ALL CORNERS ARE EVIDENCED BY A #5 REBAR WITH ALUMINUM CAP STAMPED "P.S. #4972".
- CENTERLINE (IN LIEU OF R/W) MONUMENTATION TO BE INSTALLED AT ALL CENTERLINE PCS, PTS, ANGLE POINTS AND STREET INTERSECTIONS PRIOR TO ACCEPTANCE OF SUBDIVISION STREET IMPROVEMENTS AND WILL CONSIST OF A FOUR INCH (ALUMINUM ALLOY CAP STAMPED "CITY OF ALBUQUERQUE CENTERLINE MONUMENTATION SURVEY MARKER DO NOT DISTURB P.L.S. 4972". ▲ DENOTES CENTERLINE MONUMENT.
- PUBLIC UTILITY EASEMENTS (P.U.E.) SHOWN ON THIS PLAT ARE TEN (10) FEET WIDE AND ARE GRANTED FOR THE COMMON AND JOINT USE OF:
 - A. THE PUBLIC SERVICE COMPANY OF NEW MEXICO FOR THE INSTALLATION, MAINTENANCE, AND SERVICE OF UNDERGROUND ELECTRICAL LINES, TRANSFORMERS, POLES AND ANY OTHER EQUIPMENT, FIXTURES, STRUCTURES AND RELATED FACILITIES REASONABLY NECESSARY TO PROVIDE ELECTRICAL SERVICE.
 - B. THE GAS COMPANY OF NEW MEXICO FOR INSTALLATION, MAINTENANCE, AND SERVICE OF NATURAL GAS LINES, VALVES AND OTHER EQUIPMENT AND FACILITIES REASONABLY NECESSARY TO PROVIDE NATURAL GAS.
 - C. U.S. WEST FOR THE INSTALLATION, MAINTENANCE AND SERVICE OF ALL BURIED COMMUNICATION LINES AND OTHER RELATED EQUIPMENT AND FACILITIES REASONABLY NECESSARY TO PROVIDE COMMUNICATION SERVICES, INCLUDING BUT NOT LIMITED TO ABOVE GROUND PEDESTALS AND CLOSURES.
 - D. JONES INTERCABLE FOR THE INSTALLATION, MAINTENANCE, AND SERVICE OF SUCH UNDERGROUND LINES, CABLE, AND OTHER RELATED EQUIPMENT AND FACILITIES REASONABLY NECESSARY TO PROVIDE CABLE TV SERVICE.

INCLUDED IS THE RIGHT TO BUILD, REBUILD, CONSTRUCT, RECONSTRUCT, LOCATE, RELOCATE, CHANGE, REMOVE, MODIFY, RENEW, OPERATE, AND MAINTAIN FACILITIES FOR THE PURPOSES DESCRIBED ABOVE, TOGETHER WITH FREE ACCESS TO, FROM, AND OVER SAID EASEMENTS, INCLUDING SUFFICIENT WORKING AREA SPACE FOR ELECTRIC TRANSFORMERS, WITH THE RIGHT AND PRIVILEGE TO TRIM AND REMOVE TREES, SHRUBS OR BUSHES WHICH INTERFERE WITH THE PURPOSES SET FORTH HEREIN. NO BUILDING, SIGN, POOL (ABOVE GROUND OR SUBSURFACE), HOT TUB, CONCRETE OR WOOD POOL DECKING, OR OTHER STRUCTURE SHALL BE ERRECTED OR CONSTRUCTED ON SAID EASEMENTS, NOR SHALL ANY WELL BE DRILLED OR OPERATED THEREON. PROPERTY OWNERS SHALL BE SOLELY RESPONSIBLE FOR CORRECTING ANY VIOLATIONS OF NATIONAL ELECTRIC SAFETY CODE CAUSED BY CONSTRUCTION OR POOLS, DECKING, OR ANY STRUCTURES ADJACENT TO OR NEAR EASEMENTS SHOWN ON THIS PLAT.

- CITY OF ALBUQUERQUE WATER AND SEWER SERVICE TO THESE LOTS MUST BE VERIFIED AND COORDINATED WITH THE PUBLIC WORKS DEPARTMENT, CITY OF ALBUQUERQUE.
- DRIVEWAY ACCESS WILL BE ALLOWED FROM ANY LOT TO UNSER BOULEVARD.
- MINIMUM DWELLING SETBACKS SHALL BE:
SIDE YARD 5'
FRONT YARD 20'
REAR YARD 15'
SIDE ADJACENT TO STREET 10'
SPECIAL SETBACKS ADJACENT TO PNM EASEMENTS ON NORTH, EAST AND WEST SIDES OF SUBDIVISION:
SIDE YARD & REAR YARD 25'
- THERE IS A TEN (10) FOOT WIDE PRIVATE DRAINAGE EASEMENT CENTERED ON ALL COMMON SIDE LOT LINES FOR ALL LOTS IN THIS SUBDIVISION (5' ON EACH SIDE). DOES NOT APPLY AT STREET RIGHT-OF-WAY.
- THE P1 SUFFIX TO LOT NUMBERS DESIGNATES SPECIAL ON-SITE PARKING CRITERIA WHICH JUSTIFIED THE CITY ALLOWING REDUCED STREET WIDTHS IN THIS SUBDIVISION.
- TRACT E IS TO BE RESERVED FOR FUTURE PARK DEDICATION WHEN LOCATION AND SIZE IS DETERMINED BY THE CITY OF ALBUQUERQUE, PARKS GENERAL SERVICES AND OWNER. NOT TO BE DEDICATED BY THIS PLAT.

CURVE DATA - UNIT 1											
CURVE IDEN	RADIUS	ARC	DELTA	TANGENT	CHORD	CHORD BRG	CURVE IDEN	RADIUS	ARC	DELTA	TANGENT
1	519.54	381.54	042-04-36	199.83	373.02	S88-13-18W	23	40.00	22.19	031-47-24	11.39
2	75.00	42.77	032-40-33	21.99	42.20	N54-13-43W	24	40.00	20.15	028-52-07	10.30
3	1479.70	172.13	006-39-54	86.16	172.03	S02-34-15W	25	40.00	12.85	018-74-44	6.48
4	1322.00	899.33	038-58-58	467.85	882.09	N19-43-38E	26	52.00	81.68	090-41-00	52.00
5	300.00	248.19	047-24-06	131.70	241.18	S36-31-03E	27	50.00	73.53	084-15-32	45.23
6	300.00	316.06	060-21-45	174.47	301.64	N30-02-13W	28	330.00	193.16	033-32-18	99.43
7	75.00	117.81	090-00-00	75.00	106.07	N44-51-21W	29	330.00	138.81	029-27-21	70.97
8	75.00	65.92	050-21-21	35.26	63.81	N25-02-01W	30	270.00	100-00-00	23.84	30.64
9	75.00	51.89	039-38-39	27.03	50.87	N70-02-01W	31	20.00	27.93	080-00-00	16.78
10	30.00	52.36	100-00-00	35.75	45.96	N62-49-00W	32	20.00	35.16	100-25-55	24.02
11	30.00	41.89	080-00-00	25.17	38.57	S27-11-00W	33	270.00	156.84	033-16-53	80.70
12	330.00	273.01	047-24-06	144.87	265.29	S36-31-03E	34	273.96	18.93	013-14-59	40.65
13	270.00	223.37	047-24-06	118.53	217.06	S36-31-03E	35	350.00	80.94	100-02-33	71.56
14	273.96	177.51	037-07-29	92.00	174.42	N37-41-50W	36	325.00	129.54	004-02-45	64.70
15	325.04	278.49	045-56-22	145.38	270.10	N35-44-55W	37	330.00	169.65	029-27-21	86.75
16	273.96	61.67	012-53-49	30.96	61.54	N12-41-10W	38	1322.00	93.35	046-18-25	124.02
17	273.96	30.51	006-22-55	15.27	30.50	N03-02-48W	39	41.00	74.00	013-14-59	37.17
18	326.04	65.00	011-25-23	32.61	64.90	N05-34-03W	40				
19	29.00	31.42	090-00-00	20.00	28.28	S44-51-21E	41				
20	35.00	7.00	011-27-36	3.51	6.59	N64-24-51E	42				
21	35.00	13.07	021-23-59	6.61	13.00	N67-59-03E					
22	40.00	30.57	043-47-20	16.08	29.83	S79-10-44W					

SURVEYOR'S CERTIFICATION:

I, C. A. SPIROCK, HEREBY AFFIRM THAT I AM A DULY QUALIFIED REGISTERED PROFESSIONAL SURVEYOR UNDER THE LAWS OF THE STATE OF NEW MEXICO AND DO CERTIFY THAT THIS PLAT WAS PREPARED BY ME OR UNDER MY DIRECT SUPERVISION; SHOWS ACCURATE DIMENSIONS, AND LAND AREAS; SHOWS ALL EASEMENTS AND RESTRICTIONS AS SHOWN ON THE PLAT OF RECORD OR MADE KNOWN TO ME BY THE OWNERS AND/OR PROPRIETORS OF THE SUBDIVISION SHOWN HEREON, TITLE COMPANIES, UTILITY COMPANIES OR OTHER PARTIES EXPRESSING AN INTEREST. I FURTHER CERTIFY THAT THIS PLAT MEETS THE MINIMUM REQUIREMENTS FOR MONUMENTATION AND SURVEYS OF THE ALBUQUERQUE SUBDIVISION ORDINANCE, MEETS THE "MINIMUM STANDARDS FOR LAND SURVEYS" SET FORTH BY THE STATE OF NEW MEXICO AND IS TRUE AND CORRECT TO THE BEST OF MY KNOWLEDGE AND BELIEF.

C. A. SPIROCK, N.M.P.S. #4972

DATE: 5/23/94
C.A.S. 7/12/94



CITY INFRASTRUCTURE AND DRAINAGE REQUIREMENT NOTICE:
SEE SHEET 3 OF THIS PLAT FOR REQUIREMENT NOTICE. (PERTAINS TO TRACTS A, B, C AND E SUBDIVIDED HEREIN.)

SHEET 4 OF 4



community sciences corporation

DATE: APRIL 1994
SCALE: 1" = 300'
DESIGNED: KD
DRAWN: DER
JOB NO.: 291-05-025

LAND PLANNING: P.O. Box 1328
ENGINEERING: Corrales, N.M. 87048
SURVEYING: Corrales, N.M. 87048




COMPRISED OF
A PORTION OF TRACTS 6-A AND 7-A-1
EL RANCHO ATRISCO PHASE II
SITUATE WITHIN
TOWN OF ATRISCO GRANT
PROJECTED SECTION 3, T.10N., R.3E., N.M.P.M.
CITY OF ALBUQUERQUE, BERNALILLO COUNTY, NEW MEXICO
DRB-94-125

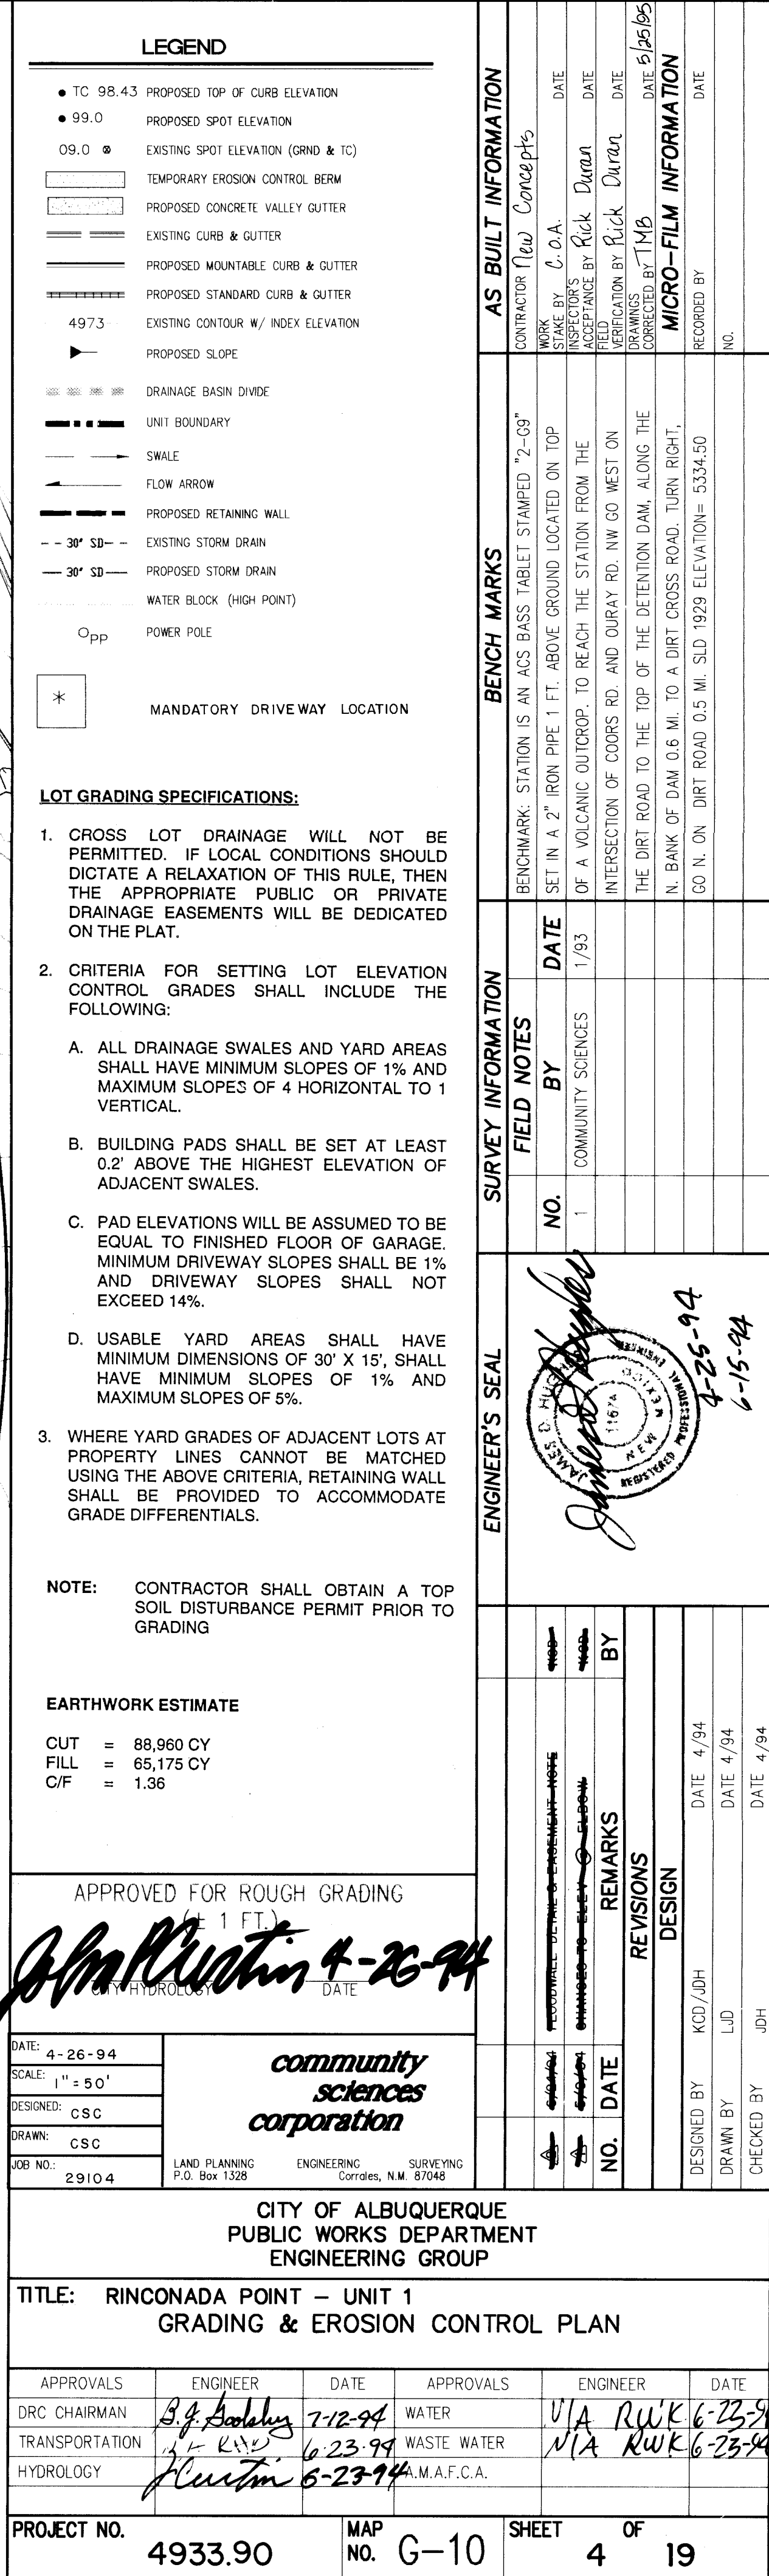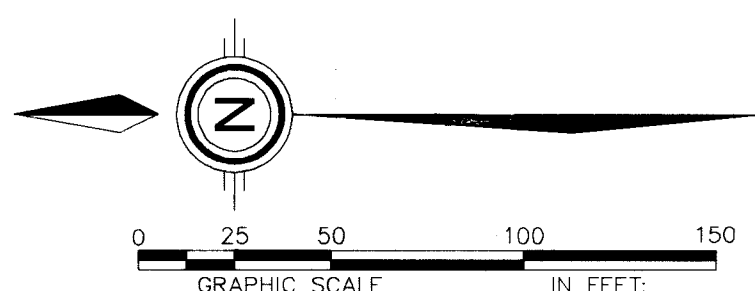

SCANNED BY
BY LASON

26 4933.900495

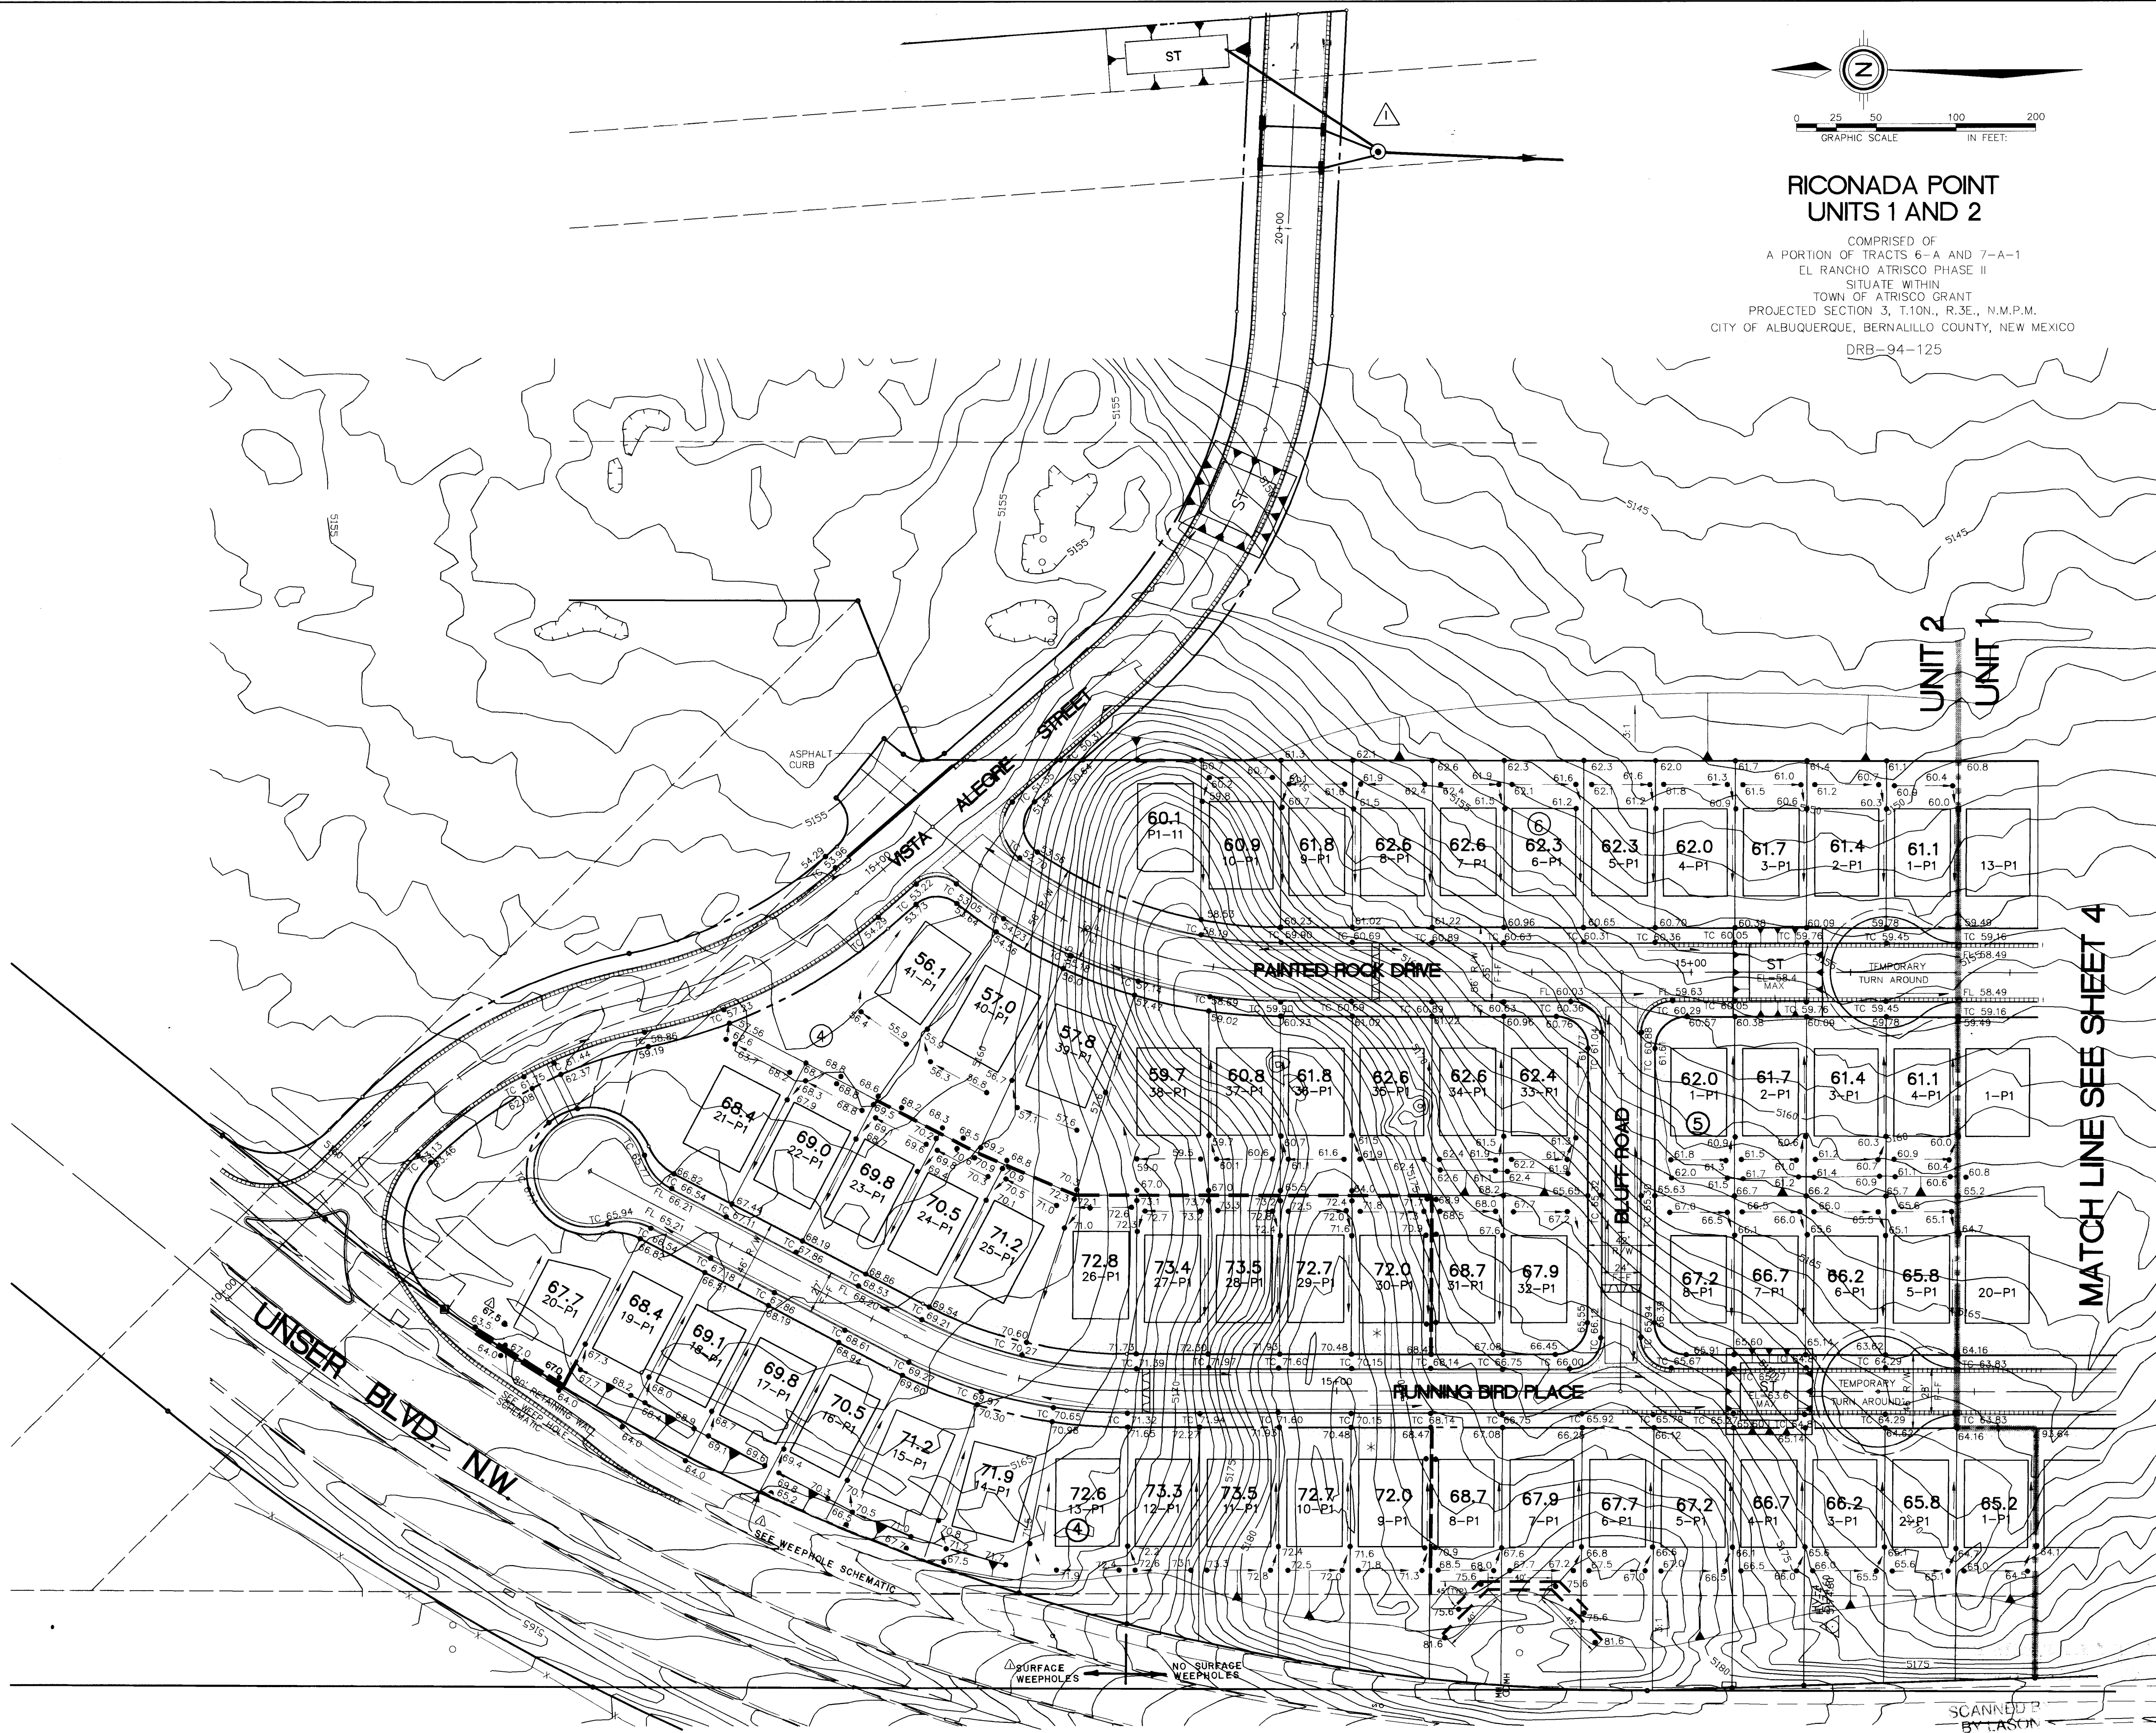

RICONADA POINT
UNITS 1 AND 2
COMPRISED OF
A PORTION OF TRACTS 6-A AND 7-A-1
EL RANCHO ATRISCO PHASE II
SITUATE WITHIN
TOWN OF ATRISCO GRANT
PROJECTED SECTION 3, T.10N., R.3E., N.M.P.M.
CITY OF ALBUQUERQUE, BERNALILLO COUNTY, NEW MEXICO
DRB-94-125

- LEGEND**
- TC 98.43 PROPOSED TOP OF CURB ELEVATION
 - 99.0 PROPOSED SPOT ELEVATION
 - 09.0 EXISTING SPOT ELEVATION (GRID & TC)
 - ▬ TEMPORARY EROSION CONTROL BERM
 - ▬ PROPOSED CONCRETE VALLEY GUTTER
 - ▬ EXISTING CURB & GUTTER
 - ▬ PROPOSED MOUNTABLE CURB & GUTTER
 - ▬ PROPOSED STANDARD CURB & GUTTER
 - ▬ 497.3 EXISTING CONTOUR W/ INDEX ELEVATION
 - ▬ PROPOSED SLOPE
 - ▬ UNIT BOUNDARY
 - ▬ SWALE
 - ▬ FLOW ARROW
 - ▬ PROPOSED RETAINING WALL
 - ▬ 30" SD EXISTING STORM DRAIN
 - ▬ 30" SD PROPOSED STORM DRAIN
 - ▬ WATER BLOCK (HIGH POINT)
 - PP POWER POLE
 - ▬ MANDATORY DRIVEWAY LOCATION
 - ▬ SEDIMENT TRAP 36"x36" BOTTOM (2' DEEP)

- LOT GRADING SPECIFICATIONS:**
- CROSS LOT DRAINAGE WILL NOT BE PERMITTED. IF LOCAL CONDITIONS SHOULD DICTATE A RELAXATION OF THIS RULE, THEN THE APPROPRIATE PUBLIC OR PRIVATE DRAINAGE EASEMENTS WILL BE DEDICATED ON THE PLAT.
 - CRITERIA FOR SETTING LOT ELEVATION CONTROL GRADES SHALL INCLUDE THE FOLLOWING:
 - ALL DRAINAGE SWALES AND YARD AREAS SHALL HAVE MINIMUM SLOPES OF 1% AND MAXIMUM SLOPES OF 4 HORIZONTAL TO 1 VERTICAL.
 - BUILDING PADS SHALL BE SET AT LEAST 0.2' ABOVE THE HIGHEST ELEVATION OF ADJACENT SWALES.
 - PAD ELEVATIONS WILL BE ASSUMED TO BE EQUAL TO FINISHED FLOOR OF GARAGE. MINIMUM DRIVEWAY SLOPES SHALL BE 1% AND DRIVEWAY SLOPES SHALL NOT EXCEED 14%.
 - USABLE YARD AREAS SHALL HAVE MINIMUM DIMENSIONS OF 30' X 15'. SHALL HAVE MINIMUM SLOPES OF 1% AND MAXIMUM SLOPES OF 5%.
 - WHERE YARD GRADES OF ADJACENT LOTS AT PROPERTY LINES CANNOT BE MATCHED USING THE ABOVE CRITERIA, RETAINING WALL SHALL BE PROVIDED TO ACCOMMODATE GRADE DIFFERENTIALS.

NOTE: CONTRACTOR SHALL OBTAIN A TOP SOIL DISTURBANCE PERMIT PRIOR TO GRADING

EARTHWORK ESTIMATE

CUT = 88,960 CY
FILL = 65,175 CY
C/F = 1.36

APPROVED FOR ROUGH GRADING
(+ 1 FT.)
John Pludin 4-26-94
DATE

DATE: 4-26-94
SCALE: 1"=50'
DESIGNED: CSC
DRAWN: CSC
JOB NO.: 29104

community sciences corporation

CITY OF ALBUQUERQUE
PUBLIC WORKS DEPARTMENT
ENGINEERING GROUP

TITLE: RINCONADA POINT - UNIT 1
GRADING & EROSION CONTROL PLAN

APPROVALS	ENGINEER	DATE	APPROVALS	ENGINEER	DATE
DRG CHAIRMAN	89.8 Soohy	7-12-94	WATER	N/A RWK	6-23-94
TRANSPORTATION	Y. E. W.	6-23-94	WASTE WATER	N/A RWK	6-23-94
HYDROLOGY	Pludin	6-23-94	A.M.A.F.C.A.		


PROJECT NO. 4933.90 MAP NO. G-10 SHEET 5 OF 19

1 2 3 4 5 6 7 8 9 10 11 12 13 14 15
26 49 33 90 05 95

AS BUILT INFORMATION				BENCH MARKS				SURVEY INFORMATION				ENGINEER'S SEAL			
CONTRACTOR	NEW CONCEPTS	DATE	DATE	BENCHMARK	STATION IS AN ACS BASS TABLE STAMPED "2-C9"	DATE	BY	NO.	FIELD NOTES	NO.	BY	DATE	DATE	DATE	DATE
STATE BY	DATE	DATE	DATE	SET IN A 2" IRON PIPE 1 FT. ABOVE GROUND LOCATED ON TOP	DATE	DATE	DATE	1	COMMUNITY SCIENCES	1	DATE	DATE	DATE	DATE	DATE
APPROVED BY	DATE	DATE	DATE	OF A VOLCANIC OUTCROP. TO REACH THE STATION FROM THE	DATE	DATE	DATE								
REVISIONS	DATE	DATE	DATE	INTERSECTION OF COORS RD. AND OURAY RD. NW CO WEST ON	DATE	DATE	DATE								
NO.	DATE	DATE	DATE	THE DIRT ROAD TO THE TOP OF THE DETENTION DAM, ALONG THE	DATE	DATE	DATE								
DATE	DATE	DATE	DATE	N. BANK OF DAM 0.6 MI. TO A DIRT CROSS ROAD. TURN RIGHT,	DATE	DATE	DATE								
DATE	DATE	DATE	DATE	GO N. ON DIRT ROAD 0.5 MI. SLD 1929 ELEVATION= 5334.50	DATE	DATE	DATE								
DATE	DATE	DATE	DATE		DATE	DATE	DATE								



PROJECT NO.	MAP NO.	SHEET OF
4933.90	G-10	6 19

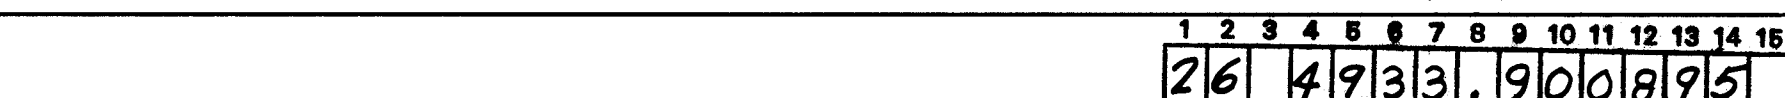

CURVE IDEN	RADIUS	ARC	DELTA
F	20.00	31.42	090-00-00
F1	35.00	39.95	065-23-57
F2	35.00	24.92	040-47-41


CITY OF ALBUQUERQUE PUBLIC WORKS DEPARTMENT ENGINEERING GROUP					
TITLE: RINCONADA POINT - UNIT 1 PAVING PLAN & PROFILE PAINTED ROCK DRIVE N.W.					
APPROVALS	ENGINEER	DATE	APPROVALS	ENGINEER	DATE
DRC CHAIRMAN	<i>B. G. Smith</i>	7-2-94	WATER	<i>N/A RWK</i>	6-23-94
TRANSPORTATION	<i>Chavez</i>	6-23-94	WASTE WATER	<i>N/A RWK</i>	6-23-94
HYDROLOGY	<i>N/A DPC</i>	6-23-94			

PROJECT NO.	MAP NO.	SHEET OF
4933.90	G-10	8 19

[illegible]

E. LEFT
WHEN RT ≠ LT

E. RT & LT
WHEN RT = LT

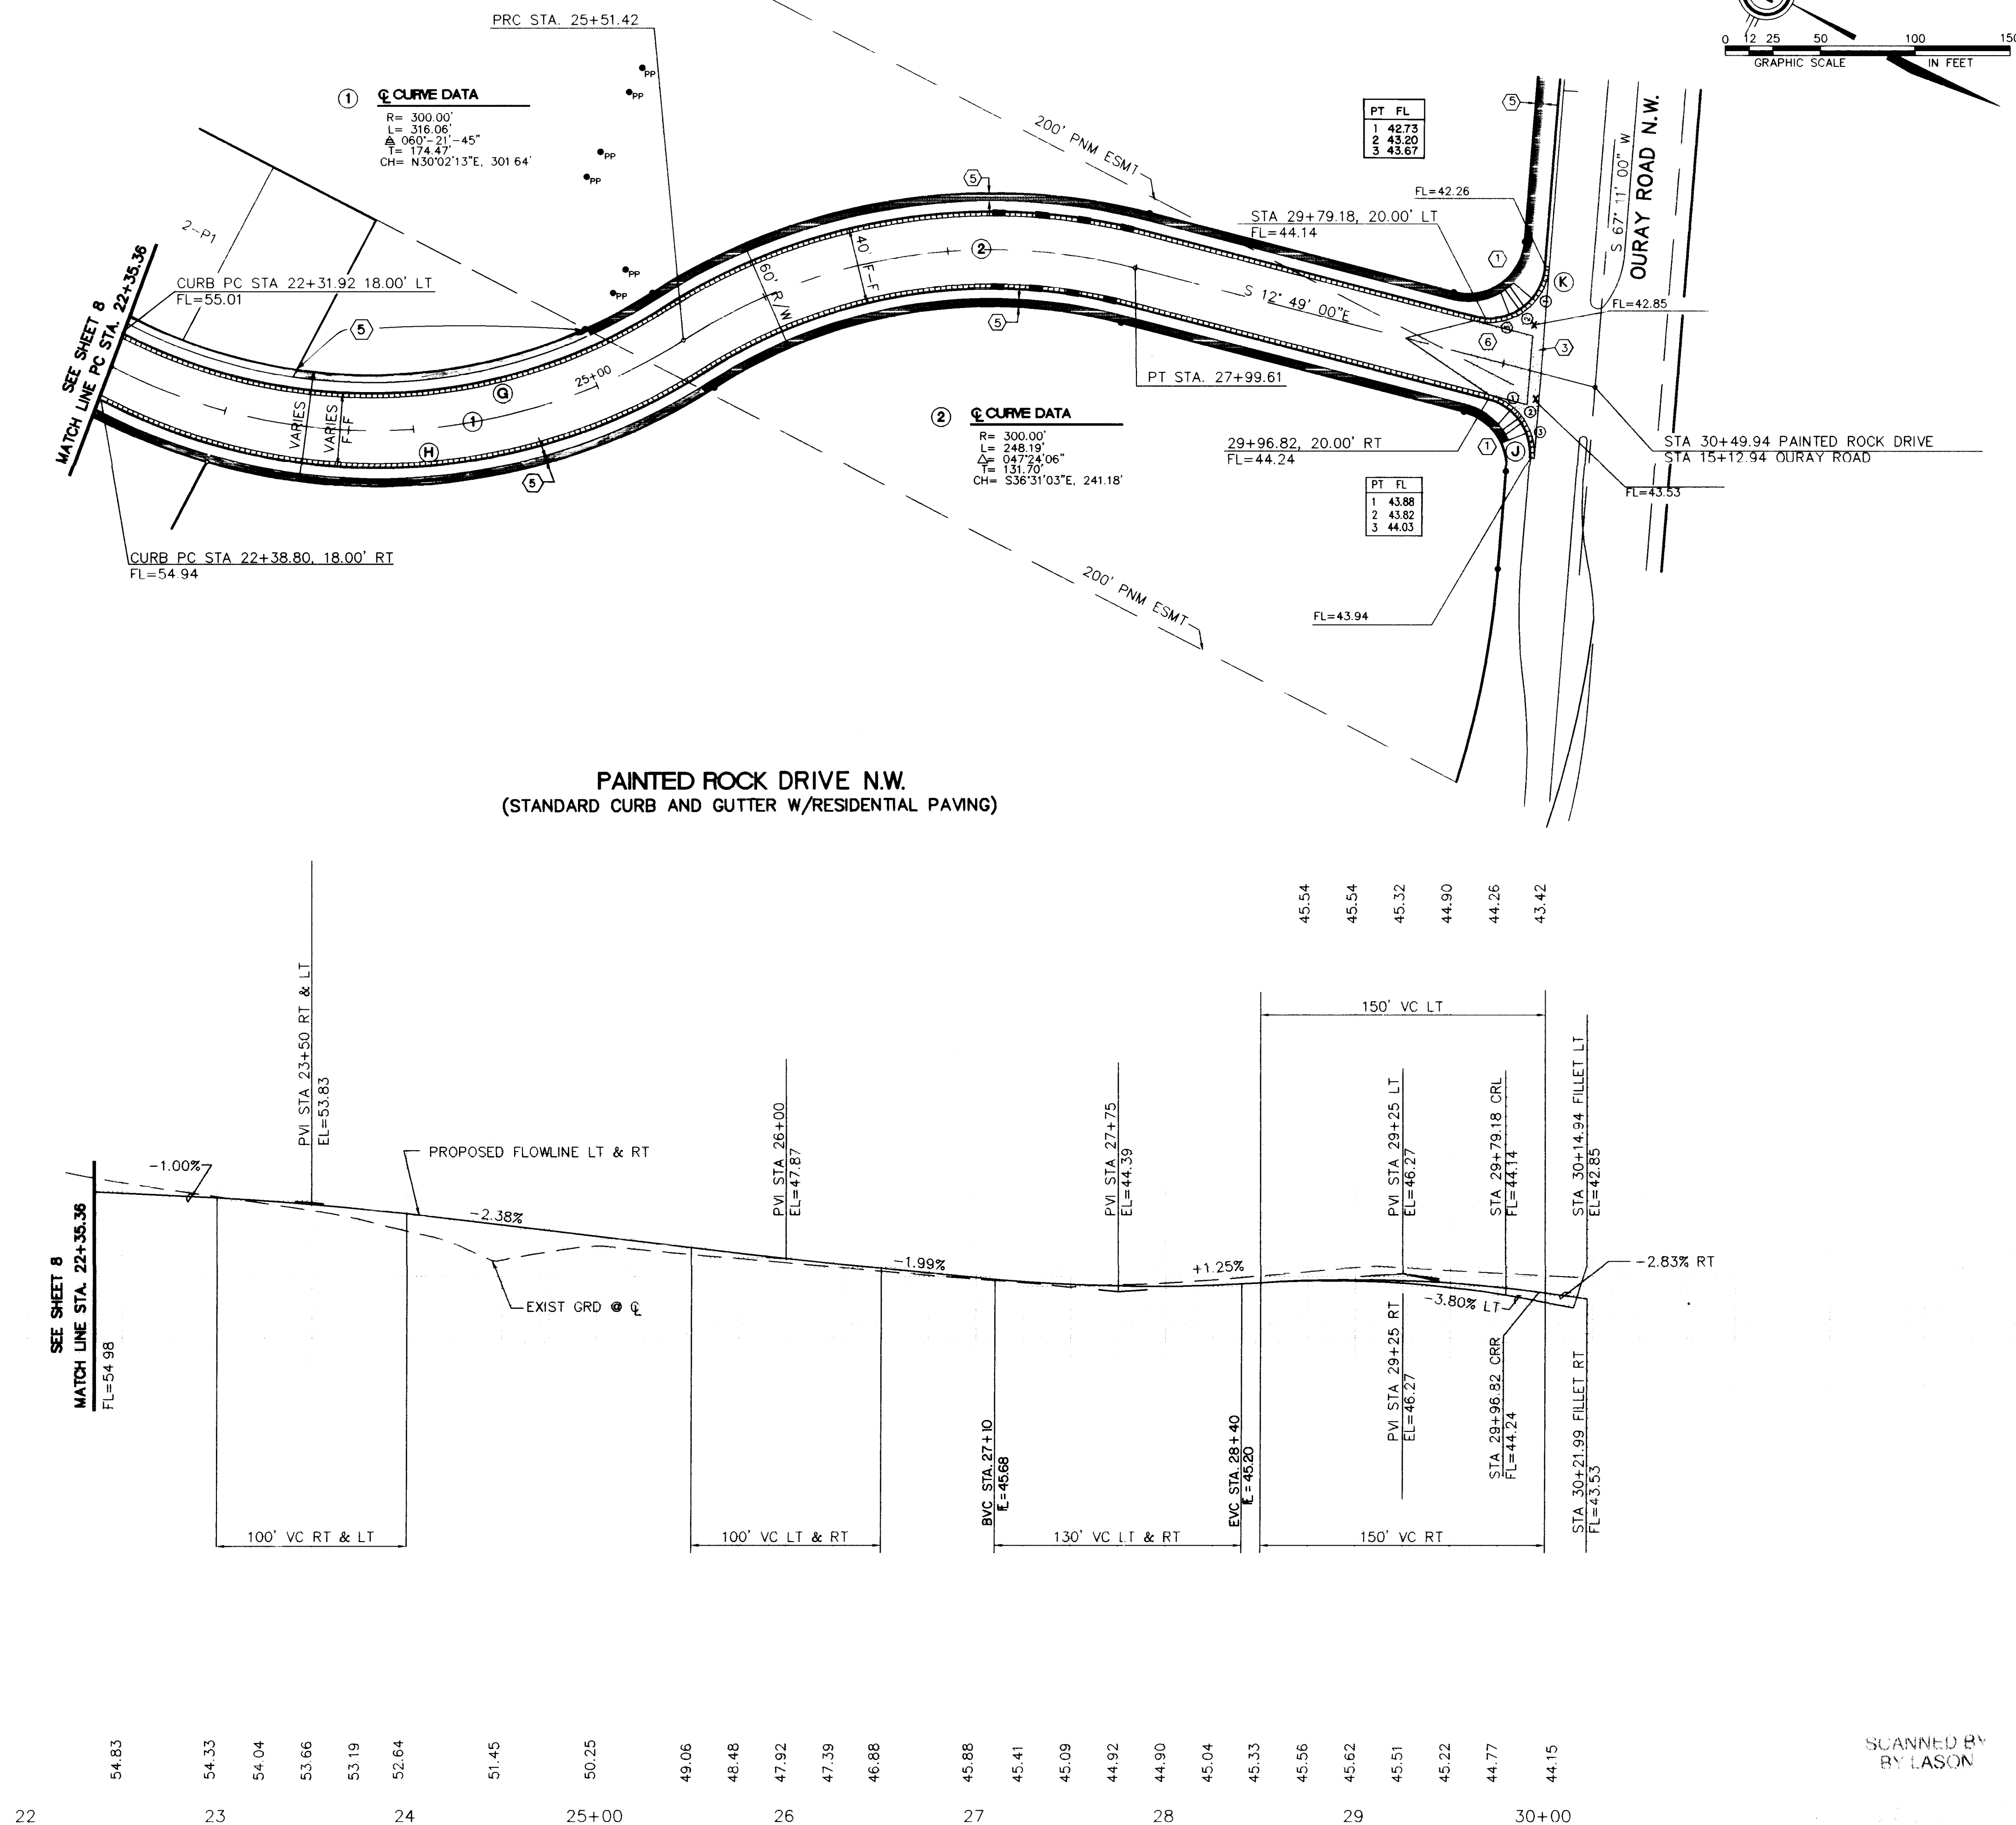

- LEGEND**
- X FL=74.11 PROPOSED CURB FLOWLINE ELEVATION
 - 73.6 ● EXISTING SPOT ELEVATION (GRND & TC)
 - PROPOSED VALLEY GUTTER
 - EXISTING CURB & GUTTER
 - PROPOSED MOUNTABLE CURB & GUTTER
 - PROPOSED STANDARD CURB & GUTTER
 - CROWN TRANSITION
 - 4' SIDEWALK THIS CONTRACT
 - POWER POLE

- KEYNOTES:**
- ① WHEELCHAIR RAMP PER COA STD. DWG. 2441 CASE II, UNLESS OTHERWISE NOTED
 - ② MOUNTABLE TO STANDARD CURB TRANSITION PER COA STD. DWG. 2418
 - ③ CONC. VALLEY GUTTER PER COA STD. DWG. 2420
 - ④ FUTURE 4' SIDEWALK, BY OTHERS
 - ⑤ 4' SIDEWALK, THIS CONTRACT
 - ⑥ 50' CROWN TRANSITION PER C.O.A. STD. DWG. 2401
 - ⑦ ASPHALT CURB AS PER COA STD DWG 2415
 - ⑧ SPECIAL CONC. VALLEY GUTTER PER COA STD. DWG. 2421

CURB CURVE DATA
(FACE OF CURB)

CURVE IDEN	RADIUS	ARC	DELTA
A	89.00	25.76	016-34-53
B	35.00	28.23	046-12-59
C	35.00	24.43	039-59-44
D	35.00	28.23	046-12-59
E	89.00	9.12	005-52-11
F	20.00	31.42	090-00-00
G	283.98	299.15	060-21-45
H	316.04	332.96	060-21-45
I	30.00	52.36	100-00-00
J	30.00	41.89	080-00-00
K	300.00	60.10	011-28-42
L	300.00	202.47	038-40-07
M	150.00	42.57	016-15-37
N	150.00	30.06	011-28-57
O	2.00	6.28	90-00-00
P	4.00	10.17	145-41-56
Q	50.00	29.93	34-18-04

DATE: 5-2-94
SCALE: HORIZ. 1"=50'
VERT. 1"=10'
DESIGNED: CSC
DRAWN: CSC
JOB NO.: 29105

community sciences corporation

LAND PLANNING P.O. Box 1328
ENGINEERING CORRALES, N.M. 87046
SURVEYING

CITY OF ALBUQUERQUE
PUBLIC WORKS DEPARTMENT
ENGINEERING GROUP

TITLE: RINCONADA POINT - UNIT 1
PAVING PLAN & PROFILE
PAINTED ROCK DRIVE N.W.

APPROVALS	ENGINEER	DATE	APPROVALS	ENGINEER	DATE
DRG. CHAIRMAN	B.G. Bookley	7-12-94	WATER	N/A RWE	6-23-94
TRANSPORTATION	6-23-94	6-23-94	WASTE WATER	N/A RWE	6-23-94
HYDROLOGY	6-23-94	6-23-94			

PROJECT NO. 4933.90 MAP NO. G-10 SHEET 9 OF 19

SURVEY INFORMATION			BENCH MARKS			AS BUILT INFORMATION		
FIELD NOTES			BENCHMARK			CONTRACTOR New Corrales		
NO.	BY	DATE	STATION	DESCRIPTION	ELEVATION	DATE	DATE	DATE
1	COMMUNITY SCIENCES	1/93	SET IN A 2" IRON PIPE 1 FT. ABOVE GROUND LOCATED ON TOP OF A VOLCANIC OUTCROP. TO REACH THE STATION FROM THE INTERSECTION OF COORS RD. AND OURAY RD. NW GO WEST ON THE DIRT ROAD TO THE TOP OF THE DETENTION DAM. ALONG THE N. BANK OF DAM 0.6 MI. TO A DIRT CROSS ROAD. TURN RIGHT. GO N. ON DIRT ROAD 0.5 MI. SLD 1929 ELEVATION= 5334.50			DATE	DATE	DATE


ENGINEER'S SEAL

DESIGNED BY: CSC
DRAWN BY: CSC
CHECKED BY:

REVISIONS

NO.	DATE	REMARKS
1	5-2-94	DESIGN

SCANNED BY
BY LASON

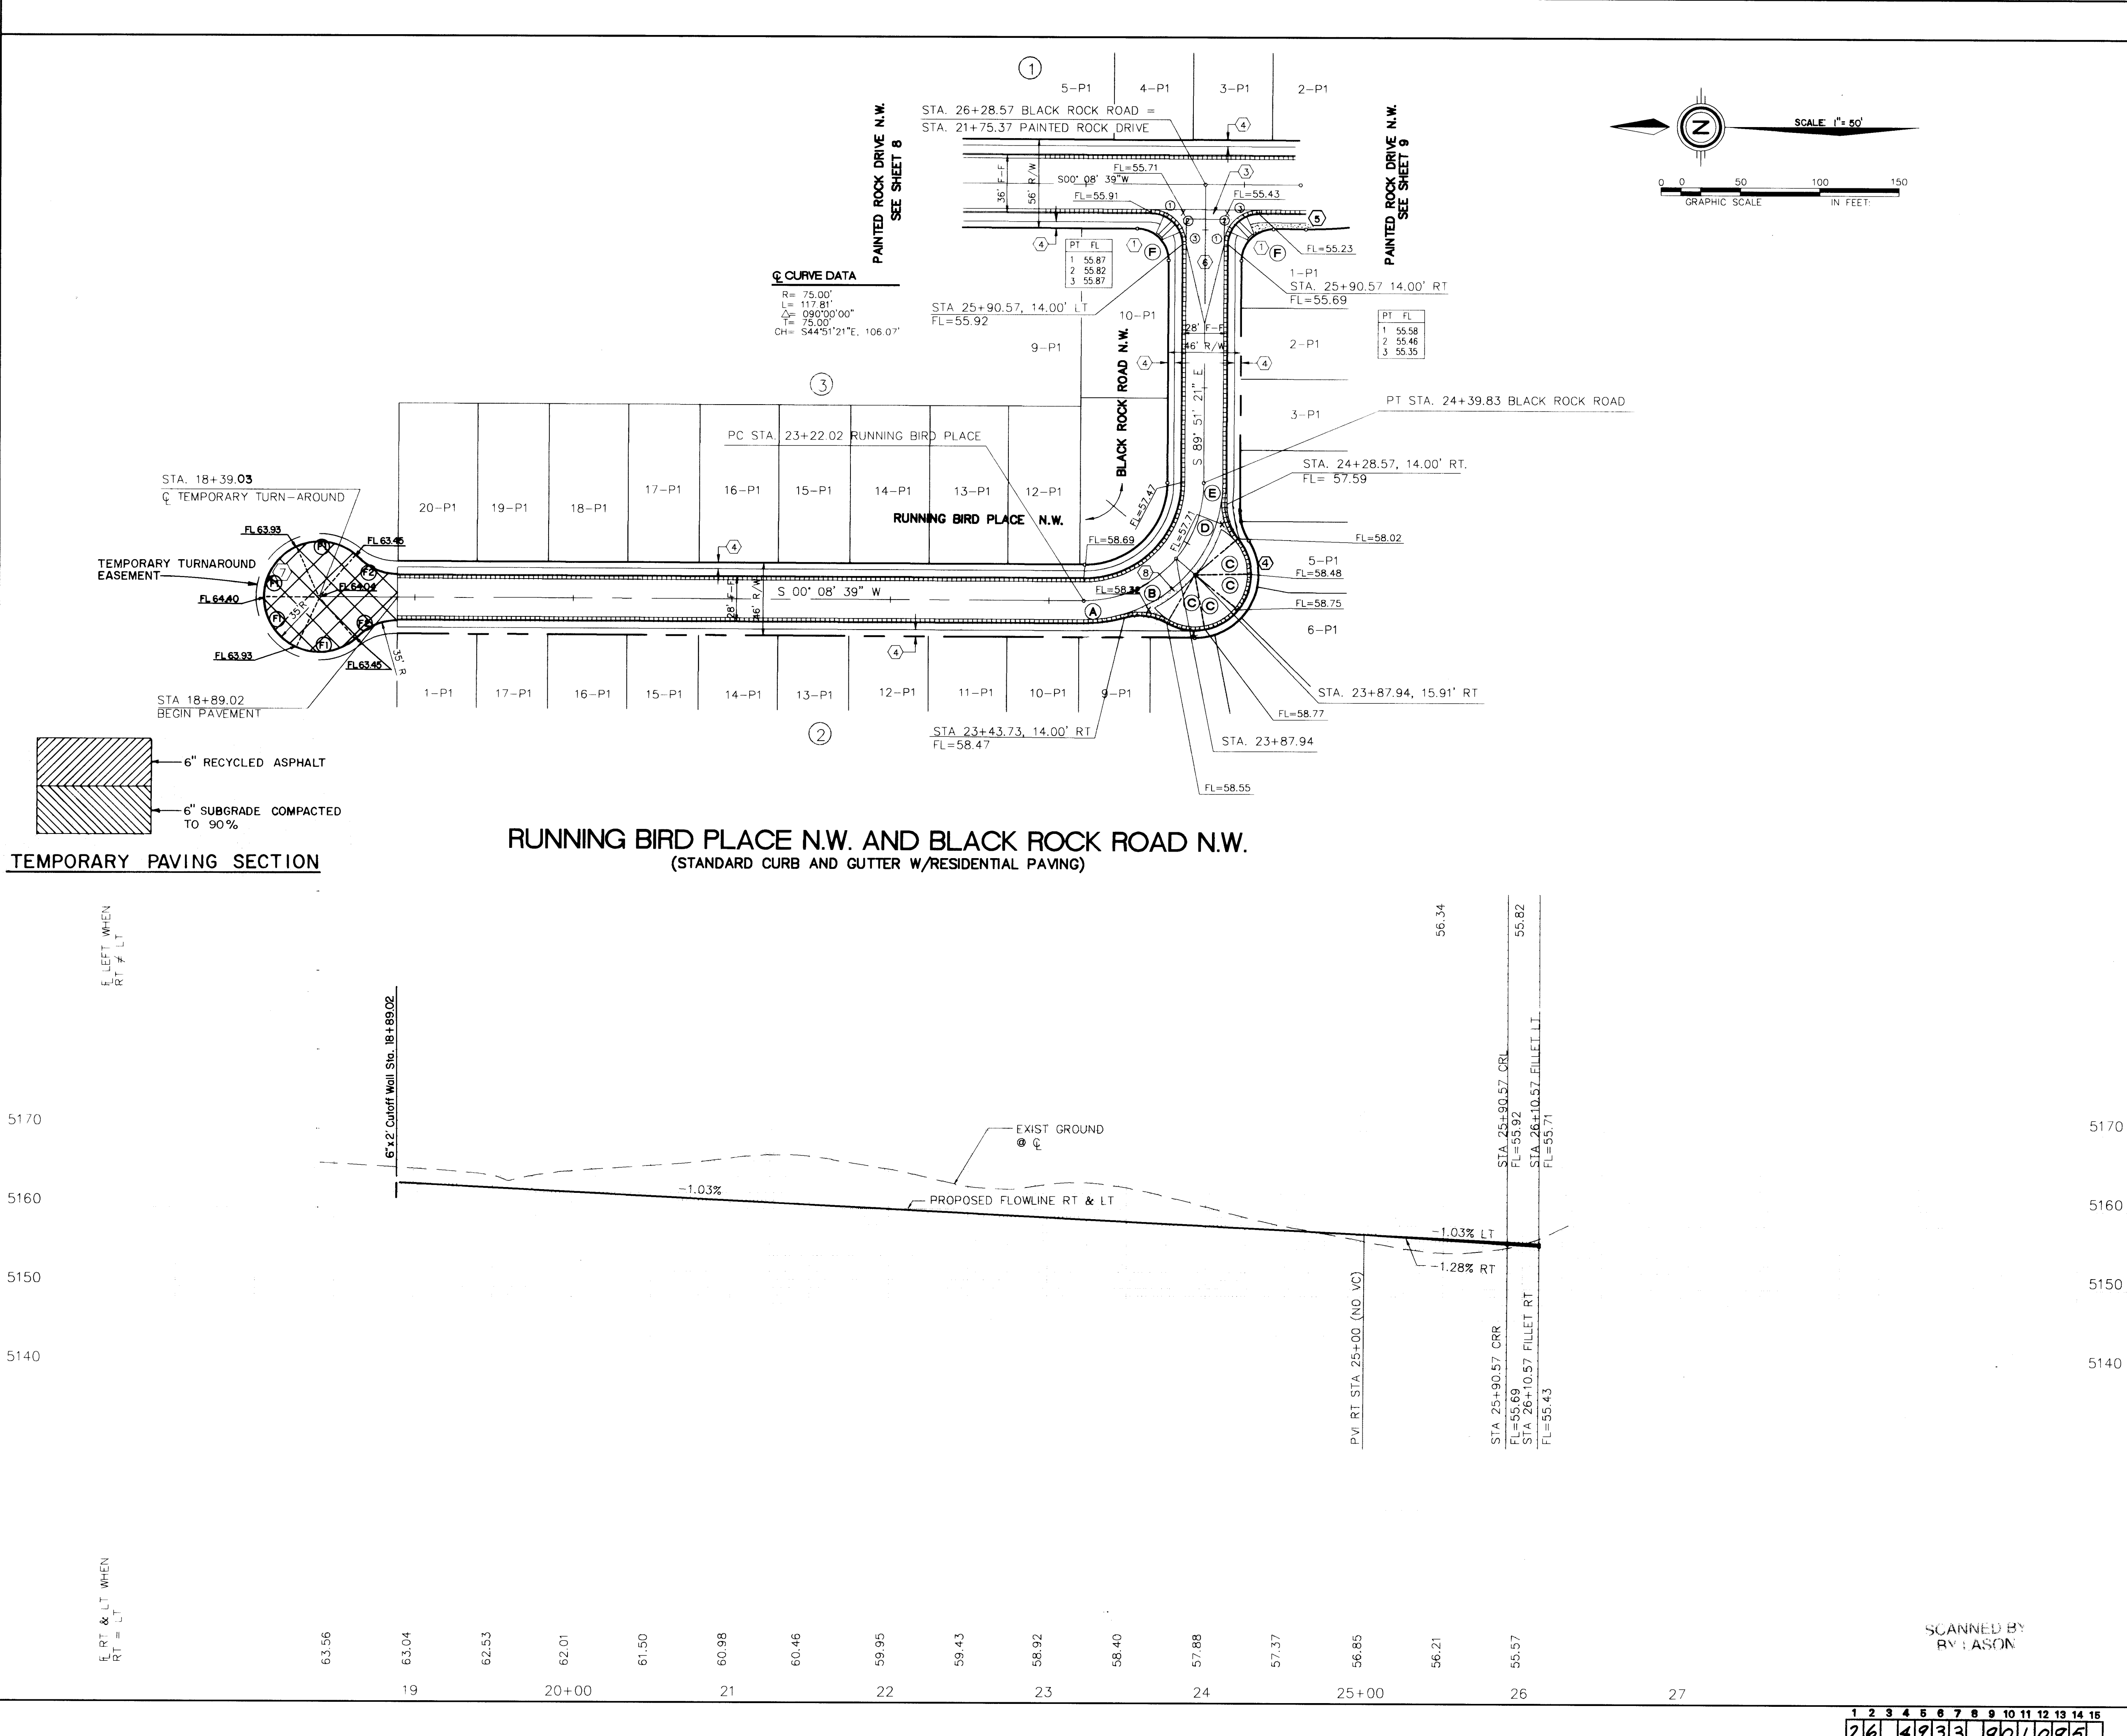

LEGEND

- FL=74.11 PROPOSED CURB FLOWLINE ELEVATION
- 73.6 EXISTING SPOT ELEVATION (GRND & TC)
- PROPOSED VALLEY GUTTER
- EXISTING CURB & GUTTER
- PROPOSED MOUNTABLE CURB & GUTTER
- PROPOSED STANDARD CURB & GUTTER
- CROWN TRANSITION
- TEMPORARY PAVEMENT
- 4' SIDEWALK THIS CONTRACT

KEYNOTES:

- WHEELCHAIR RAMP PER COA STD. DWG. 2441. CASE II, UNLESS OTHERWISE NOTED.
- MOUNTABLE TO STANDARD CURB TRANSITION PER COA STD. DWG. 2418
- CONC. VALLEY GUTTER PER COA STD. DWG. 2420
- FUTURE 4' SIDEWALK, BY OTHERS
- 4' SIDEWALK, THIS CONTRACT
- 50' CROWN TRANSITION PER C.O.A. STD. DWG. 2401
- ASPHALT CURB PER COA STD DWG 2415
- SPECIAL CONC. VALLEY GUTTER PER COA STD. DWG. 2421

CURB CURVE DATA

CURVE	RADIUS	ARC	DELTA
A	89.00	25.76	016-34-53
B	35.00	28.23	046-12-59
C	35.00	24.43	039-59-44
D	35.00	28.23	046-12-59
E	89.00	9.12	005-52-11
F	20.00	31.42	090-00-00
F1	35.00	39.95	065-23-57
F2	35.00	24.92	040-47-41

AS BUILT INFORMATION

CONTRACTOR: *New Concepts*
DATE: *6-23-94*
BY: *C.O.A.*
CHECKED BY: *Rich Duran*
DATE: *6-23-94*
RECORDED BY: *Rich Duran*
DATE: *6-23-94*

BENCH MARKS

BENCHMARK: STATION IS AN AIS BASS TABLE STAMPED "2-03" SET IN A 2" IRON PIPE 1 FT. ABOVE GROUND LOCATED ON TOP OF A VOLCANIC OUTCROP TO REACH THE STATION FROM THE INTERSECTION OF COORS RD. AND DURAY RD. NW CO WEST ON THE DIRT ROAD TO THE TOP OF THE DETENTION DAM, ALONG THE N. BANK OF DAM 0.6 MI. TO A DIRT CROSS ROAD, TURN RIGHT. CO N. ON DIRT ROAD 0.5 MI. SLD 1929 ELEVATION= 5334.50

SURVEY INFORMATION

FIELD NOTES
NO. 1
DATE 1/93
BY COMMUNITY SCIENCES

ENGINEER'S SEAL

Professional Engineer Seal

REVISIONS

NO.	DATE	REMARKS	BY
1	6-23-94	DESIGN	KCD
2	6-23-94	DESIGN	LJD

community sciences corporation

**CITY OF ALBUQUERQUE
PUBLIC WORKS DEPARTMENT
ENGINEERING GROUP**

**TITLE: RINCONADA POINT - UNIT 1
PAVING PLAN & PROFILE
RUNNING BIRD PLACE N.W. & BLACK ROCK ROAD N.W.**



APPROVALS

ENGINEER	DATE	APPROVALS	ENGINEER	DATE
<i>Rich Duran</i>	7-12-94	WATER	<i>Rich Duran</i>	6-23-94
<i>Rich Duran</i>	6-23-94	WASTE WATER	<i>Rich Duran</i>	6-23-94
<i>Rich Duran</i>	6-23-94			

PROJECT NO. 4933.90

MAP NO. G-10

SHEET 10 OF 19

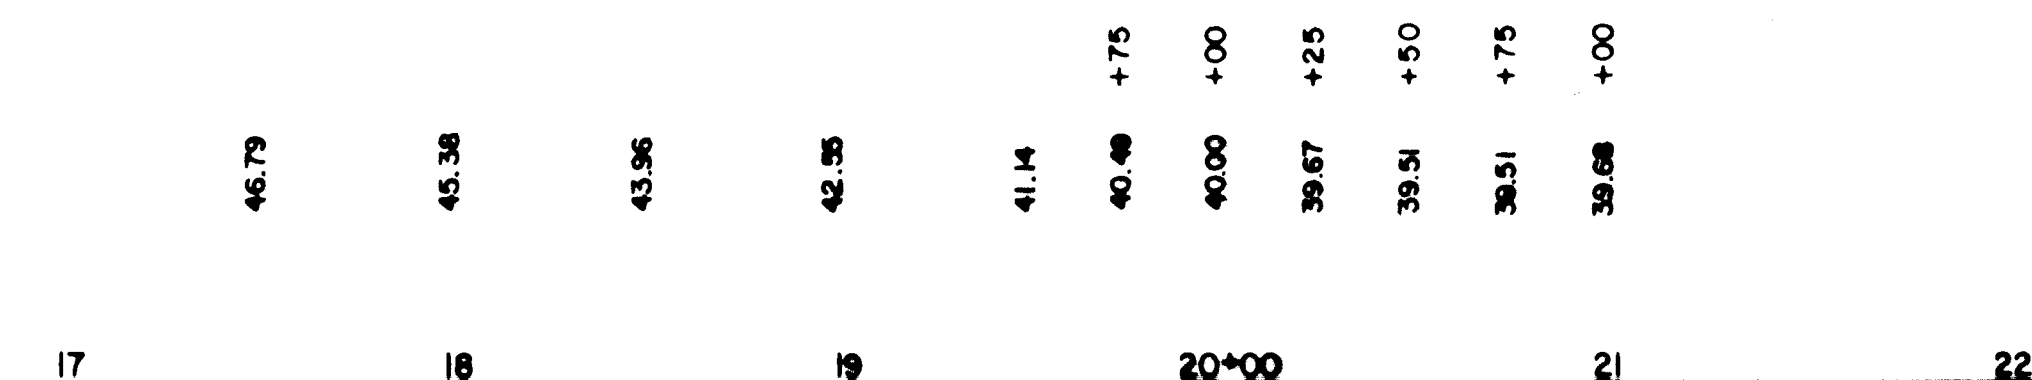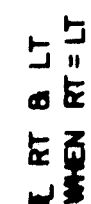


2 NOT ACCURATELY SHOWN HERE
SEE PROJECT NO. 4933.91

SCANNED BY
BY LASON

[illegible]


[illegible]

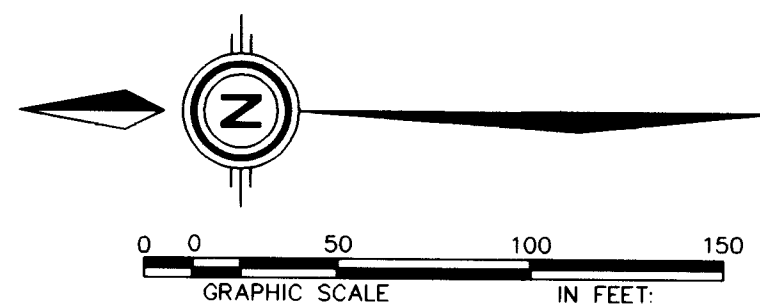

INLET PAIR	Ho (ft.)	AREA (sq. ft.)	Lw (ft.)	Qo (cfs)	Qw (cfs)
7 & 8	0.67 (O) 0.54 (W)	16.4	21.67	70.02	30.37
CAPACITY				70.02	30.37
CAPACITY (CLOGGING FACTOR APPLIED)				42.01	27.33





LR = Length to be restrained each side of the fitting. For Tees, all three legs shall be restrained for a distance of "LR". For Reducers, "LR" is given for the larger diameter pipe. Gate valves shall be mechanically restrained and installed with concrete blocking per COA STD DWG 2333. All caps shall be installed with concrete blocking per COA STD DWG 2320. Fire hydrants to be restrained from the tee to the fire hydrant flange.

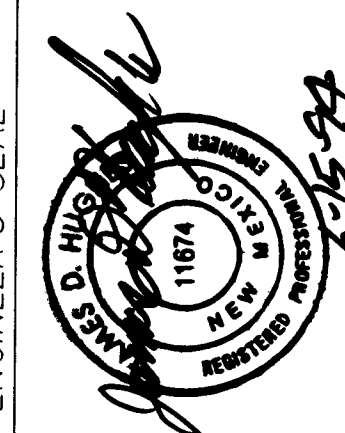ENGINEER'S SEAL

PROJECT NO.	4933.90	MAP NO.	G-10	SHEET	14 ^{OF}	19
-------------	---------	---------	------	-------	------------------	----

INLET CAPACITY CALCULATIONS TABLE 3					
$Q_{\infty} = 41.96 \text{ CFS}$					
ORIFICE EQ. $Q_o = CA (2gh)^{1/2}$ $C = 0.65$ CLOGGING FACTOR = 0.60					
WEIR EQ. $Q_w = C_d L_w h^{3/2}$ $C = 2.65$ CLOGGING FACTOR = 0.90					
INLET PAIR	H _o (ft.)	AREA (sq. ft.)	L _w (ft.)	Q _o (cfs)	Q _w (cfs)
1 & 4	0.67 (o) 0.55 (w)	8.2	15.00	35.01	16.21
2 & 5	0.63 (o) 0.55 (w)	8.2	15.00	33.95	16.21
3 & 6	0.52 (o) 0.52 (w)	8.2	15.00	29.63	14.91
CAPACITY				98.60	47.34
CAPACITY (CLOGGING FACTOR APPLIED)				59.16	42.61

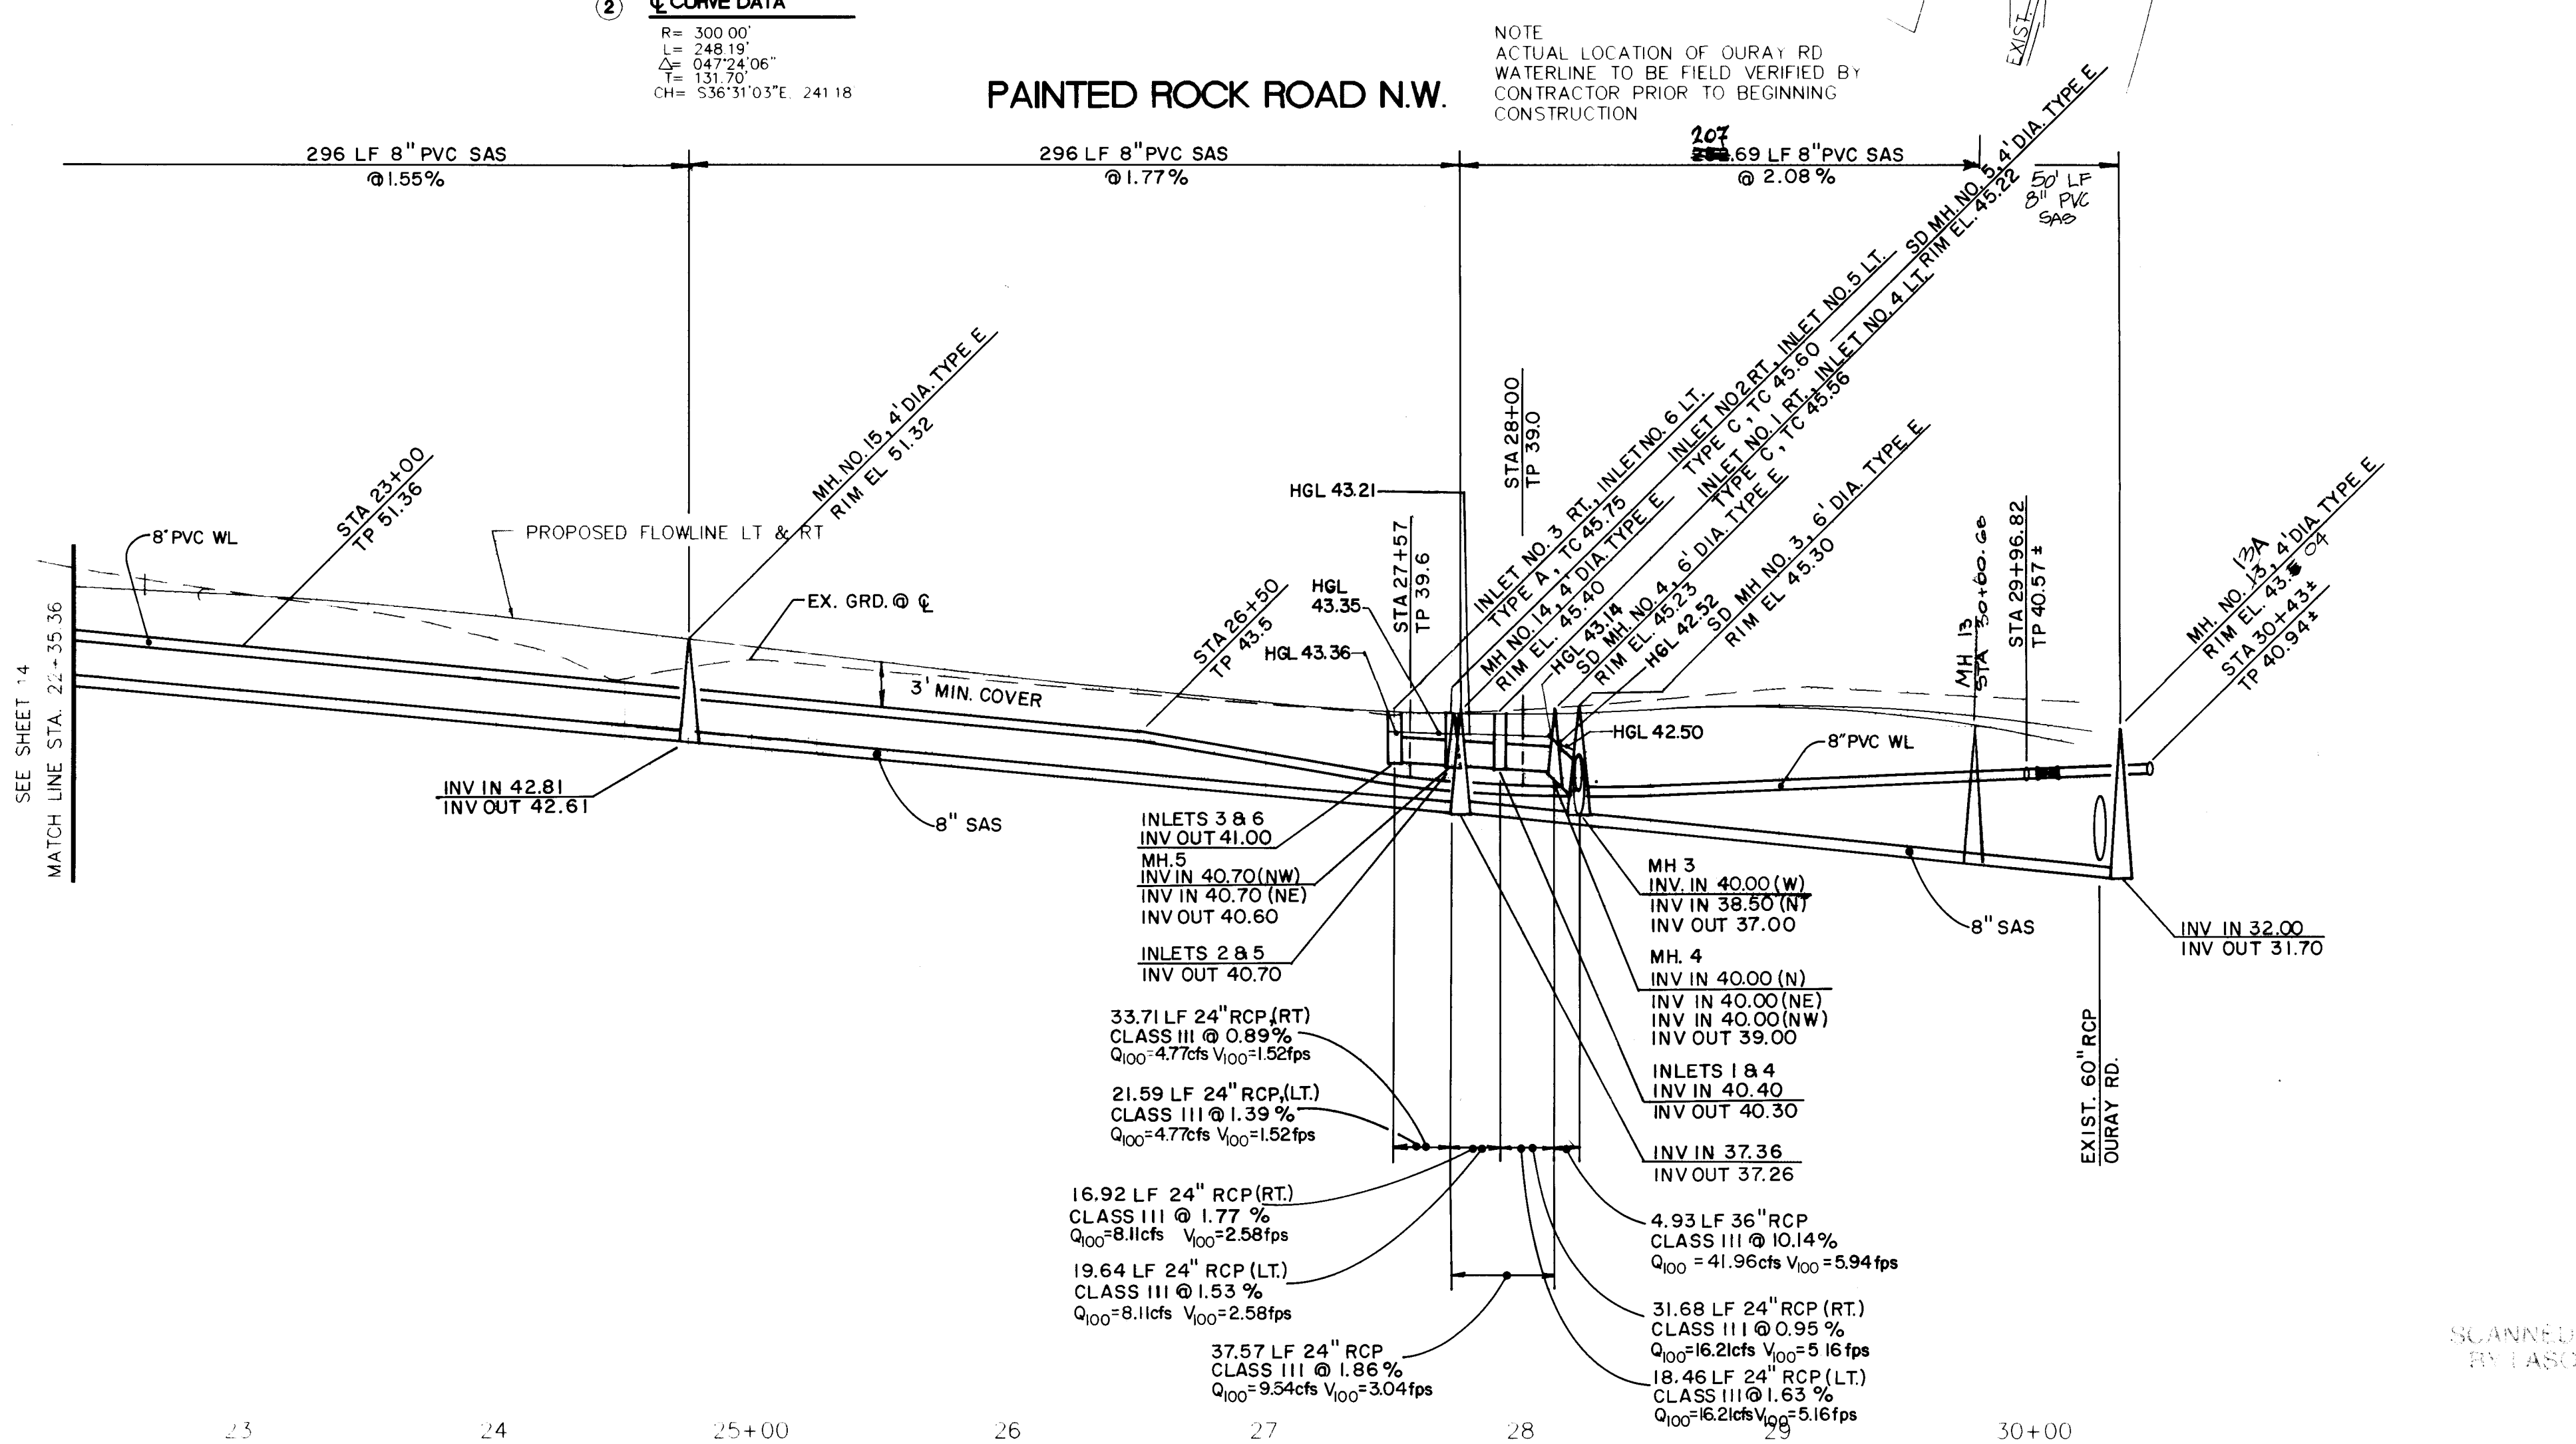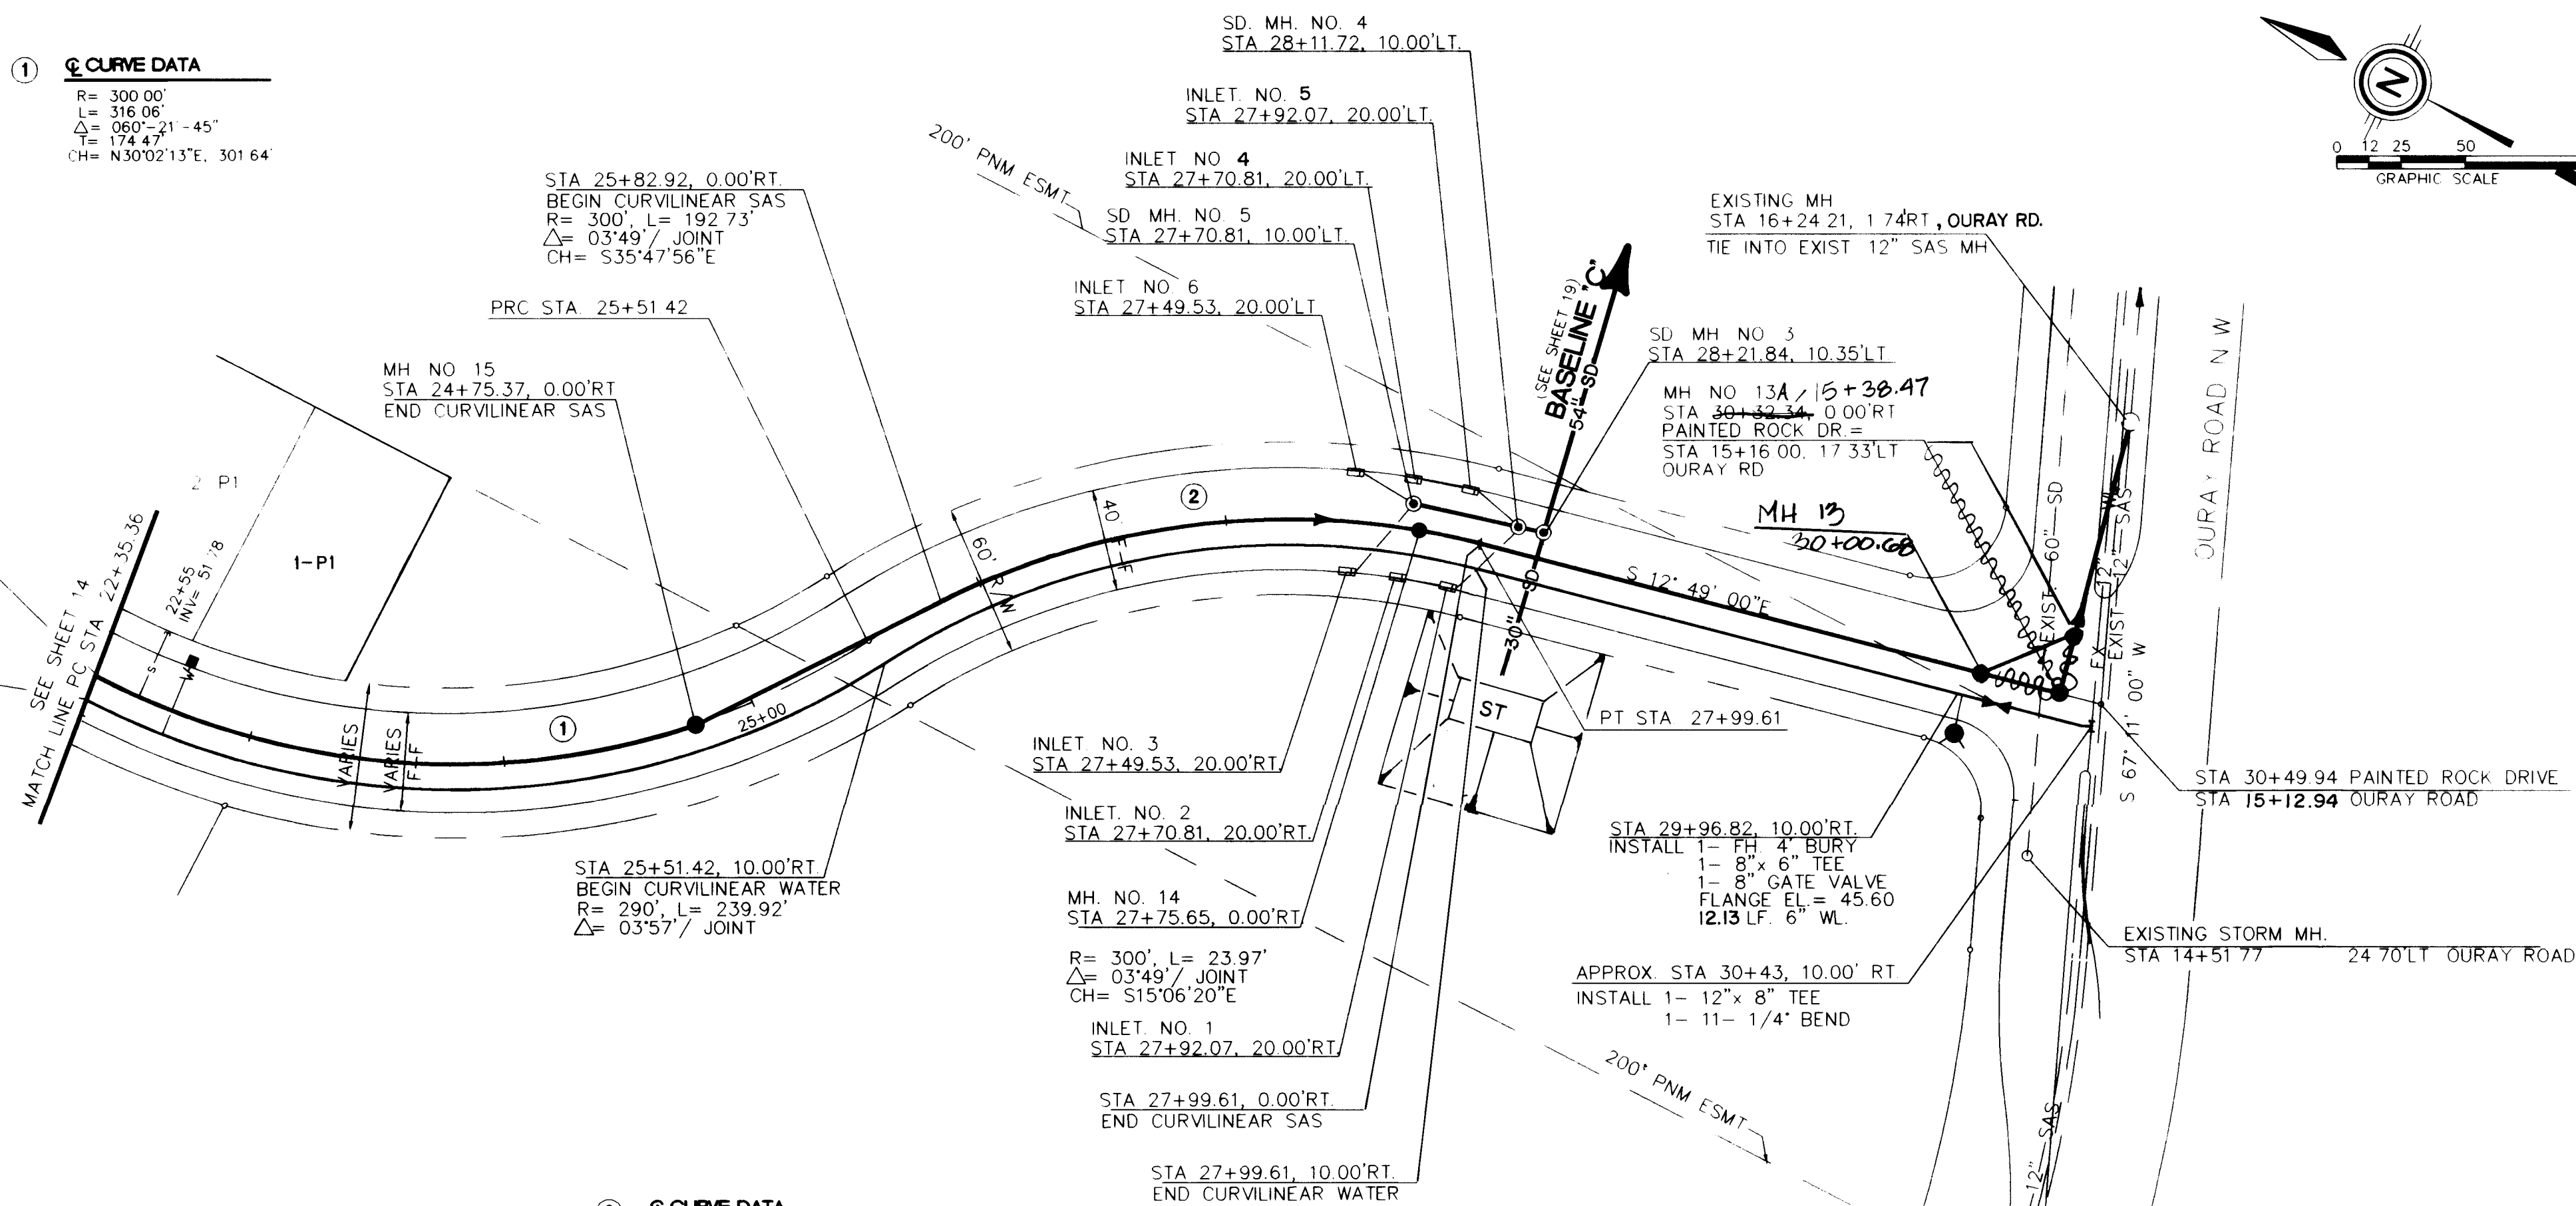

UTILITY LEGEND		
DESCRIPTION	PROPOSED	EXISTING
SANITARY SEWER LINE	S-8"	S-8"
ENCASEMENT	S-8"	S-8"
SANITARY SEWER MANHOLE	S-8"	S-8"
SAS SERVICE CONNECTION	S-8"	S-8"
STORM DRAIN LINE	SD-12"	SD-12"
STORM DRAIN MANHOLE	SD-12"	SD-12"
STORM DRAIN INLETS	SD-12"	SD-12"
WATER LINE	W-6"	W-6"
GATE VALVE	G-6"	G-6"
BUTTERFLY VALVE	B-6"	B-6"
FIRE HYDRANTS	F-6"	F-6"
REDUCERS	R-6"	R-6"
WATER SERVICE METER	W-6"	W-6"
TEES	T-6"	T-6"
ROUSES	R-6"	R-6"
BENDS	B-6"	B-6"
APPS & PLUGS	P-6"	P-6"

RESTRAINING LENGTHS	
FITTING	LR
6" Tee	Run 10' Branch 2'
8" x 6" Tee	Run 7' Branch 5'
10" x 8" Tee	Run 10' Branch 4'
12" x 8" Tee	Run 8' Branch 5'
6" x 4" Reducer	24'
6" Gate Valve	46'
8" Gate Valve	60'
10" Gate Valve	72'

LR = Length to be restrained each side of the fitting. For Tees, all three legs shall be restrained for a distance of "LR". For Reducers, "LR" is given for the larger diameter pipe. Gate valves shall be mechanically restrained and installed with concrete blocking per COA STD DWG 2333. All caps shall be installed with concrete blocking per COA STD DWG 2320. Fire hydrants to be restrained from the tee to the fire hydrant flange.

SURVEY INFORMATION	
DATE	7/93
COMMUNITY SCIENCES	
NO	

ENGINEER'S SEAL	
DATE	6-15-94
NO	

REVISIONS	
NO	DATE
1	7-12-94
2	6-23-94
3	6-23-94



SCALE	1" = 50' HORIZ 1" = 10' VERT
JOB NO	29105
LAND PLANNING	P.O. Box 1328
ENGINEERING	Corrales, N.M. 87048
SURVEYING	

CITY OF ALBUQUERQUE
PUBLIC WORKS DEPARTMENT
ENGINEERING GROUP

TITLE: RINCONADA POINT UNIT 1
UTILITY PLAN & PROFILE
PAINTED ROCK DRIVE N.W.

APPROVALS	ENGINEER	DATE	APPROVALS	ENGINEER	DATE
DR. CHAIRMAN	B.G. Goodley	7-12-94	WATER	R.W. Kane	6-23-94
TRANSPORTATION	R.W. Kane	6-23-94	WASTE WATER	R.W. Kane	6-23-94
HYDROLOGY	R.W. Kane	6-23-94			


PROJECT NO	4933.90	MAP NO	010	SHEET	15 OF 19
------------	---------	--------	-----	-------	----------

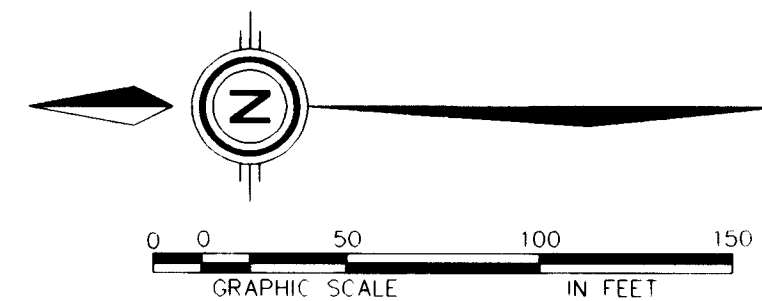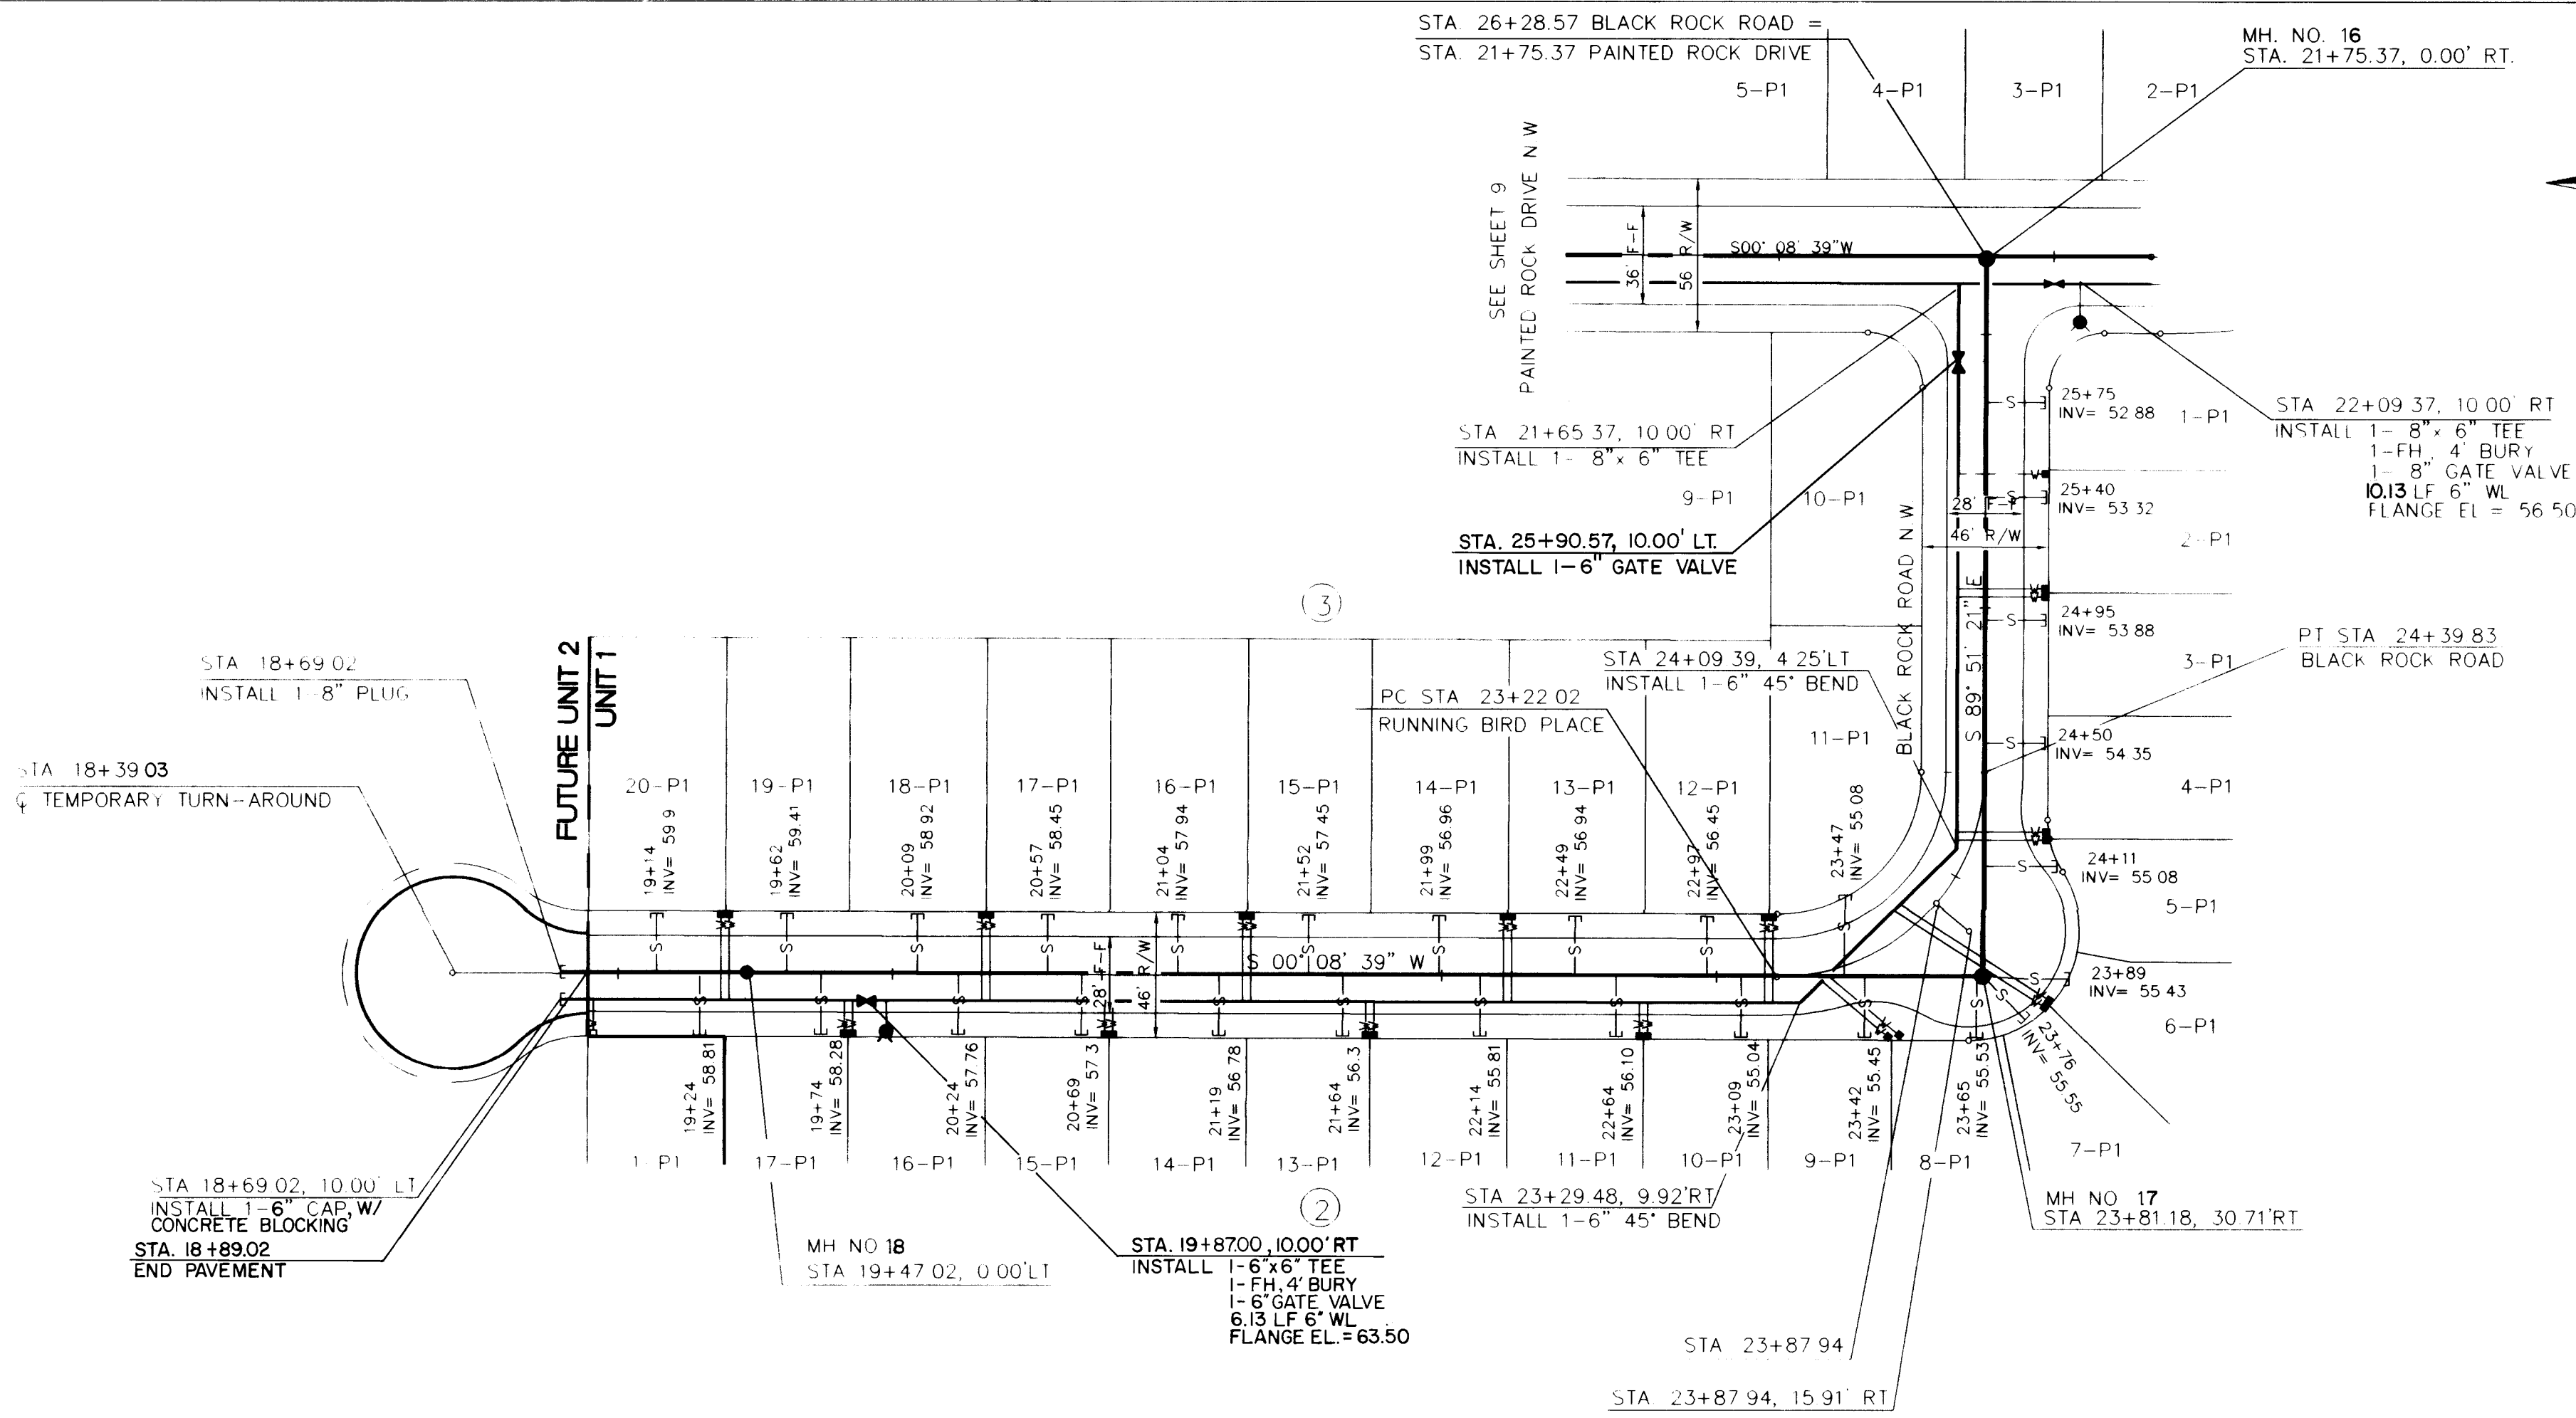

UTILITY LEGEND		
DESCRIPTION	PROPOSED	EXISTING
SANITARY SEWER LINE		
ENCASEMENT		
SANITARY SEWER MANHOLE		
SAS SERVICE CONNECTION		
STORM DRAIN LINE		
STORM DRAIN MANHOLE		
STORM DRAIN INLETS		
WATER LINE		
GATE VALVE		
BITTER/VALVE		
FIRE HYDRANTS		
REDUCERS		
WATER SERVICE/ METER		
TEES		
BROSSES		
BENDS		
AD. & PLUGS		

RESTRAINING LENGTHS	
FITTING	LR
6" Tee	Run 10' Branch 2'
8" x 6" Tee	Run 7' Branch 5'
10" x 8" Tee	Run 10' Branch 4'
12" x 8" Tee	Run 8' Branch 5'
6" x 4" Reducer	24'
6" Gate Valve	46'
8" Gate Valve	60'
10" Gate Valve	72'


LR = Length to be restrained each side of the fitting. For Tees, all three legs shall be restrained for a distance of "LR". For Reducers, "LR" is given for the larger diameter pipe. Gate valves shall be mechanically restrained and installed with concrete blocking per COA STD DWG 2333. All caps shall be installed with concrete blocking per COA STD DWG 2320. Fire hydrants to be restrained from the tee to the fire hydrant flange.

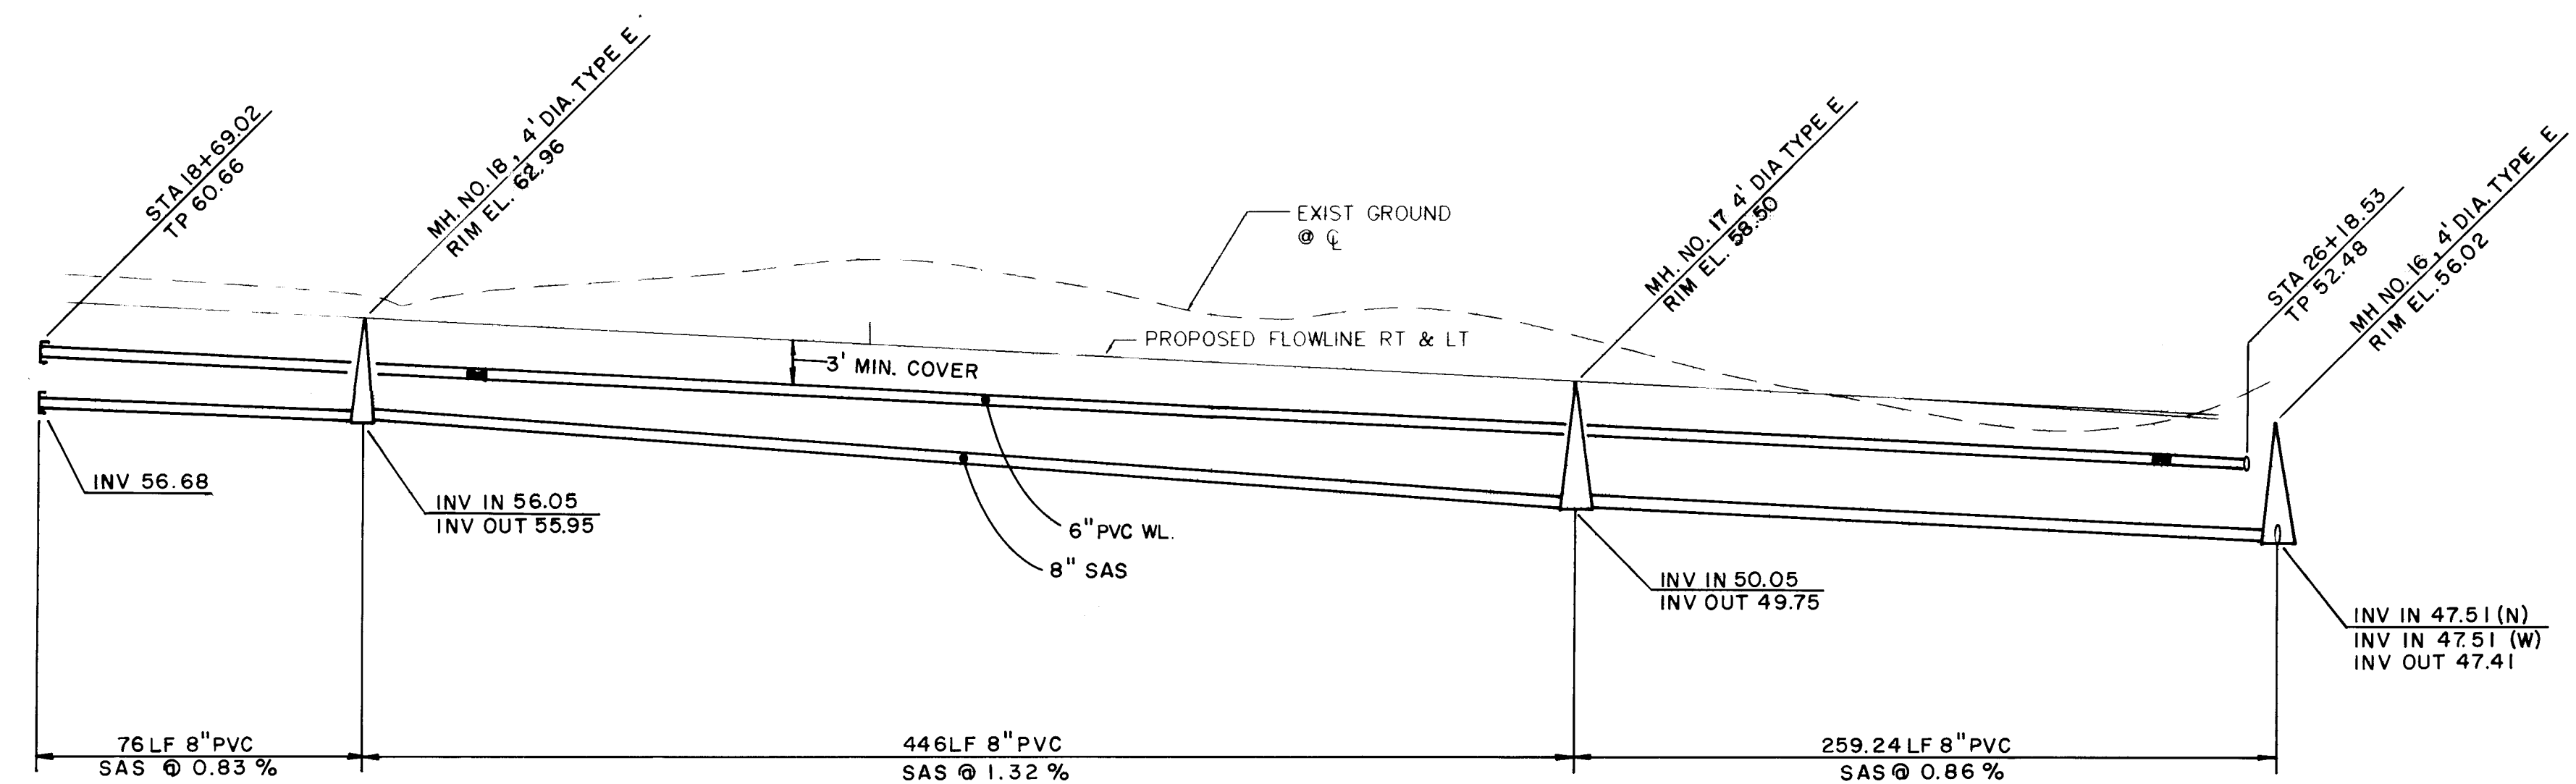

SCALE 1" = 50' HORIZ 1" = 10' VERT		community sciences corporation	
JOB NO. 29105	LAND PLANNING P.O. Box 1328	ENGINEERING Corrales, N.M. 87048	SURVEYING
CITY OF ALBUQUERQUE PUBLIC WORKS DEPARTMENT ENGINEERING GROUP			
TITLE RINCONADA POINT UNIT 1 UTILITY PLAN & PROFILE RUNNING BIRD PLACE N.W. & BLACK ROCK ROAD N.W.			
APPROVALS	ENGINEER	DATE	APPROVALS
DIR. CHAIRMAN	<i>R.A. Goolsby</i>	7-12-94	ENGINEER
TRANSPORTATION	<i>W.A. Rupp</i>	6-23-94	WATER
HYDROLOGY	<i>W.A. Rupp</i>	6-23-94	WASTE WATER
DESIGNED BY	CSC	DATE	MAY 1993
DRAWN BY	CSC	DATE	MAY 1993
CHECKED BY		DATE	

PROJECT NO. 4933.90
MAP NO. G-10
SHEET 16 OF 19

1 2 3 4 5 6 7 8 9 10 11 12 13 14 15
26 7933.90 1695

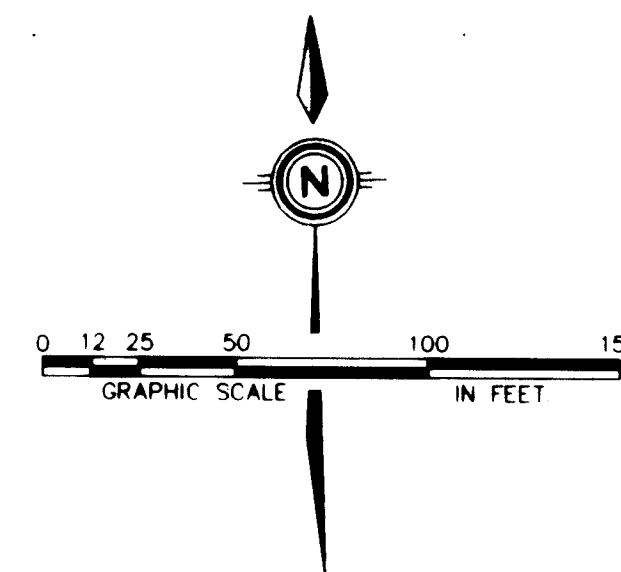


UTILITY LEGEND		
DESCRIPTION	PROPOSED	EXISTING
SANITARY SEWER LINE		
ENCASUREMENT		
SANITARY SEWER MANHOLE		
SAS SERVICE CONNECTION		
STORM DRAIN LINE		
STORM DRAIN MANHOLE		
STORM DRAIN INLETS		
WATER LINE		
GATE VALVE		
BUTTERFLY VALVE		
FIRE HYDRANTS		
REDUCERS		
WATER SERVICE/ METER		
TEES		
CROSSES		
BENDS		
CAPS & PLUGS		

FITTING	LR
6" Tee	Run 10' Branch 2'
8" x 6" Tee	Run 7' Branch 5'
10" x 8" Tee	Run 10' Branch 4'
12" x 8" Tee	Run 8' Branch 5'
6" x 4" Reducer	24'
6" Gate Valve	46'
8" Gate Valve	60'
10" Gate Valve	72'

LR = Length to be restrained each side of the fitting. For Tees, all three legs shall be restrained for a distance of "LR". For Reducers, "LR" is given for the larger diameter pipe. Gate valves shall be mechanically restrained and installed with concrete blocking per COA STD DWG 2333. All caps shall be installed with concrete blocking per COA STD DWG 2320. Fire hydrants to be restrained from the tee to the fire hydrant flange.

INLET CAPACITY CALCULATIONS
TABLE 1

Q _∞ = 23.25						
ORIFICE EQ.						
Q _c = CA (2gh) ^{-1/2}						
C = 0.65						
CLOGGING FACTOR = 0.60						
WEIR EQ.						
Q _c = C _w L _w h ^{3/2}						
C = 2.65						
CLOGGING FACTOR = 0.90						
INLET PAIR	Ho (ft.)	AREA (sq. ft.)	Lw (ft.)	Qo (cfs)	Qwc (cfs)	
9 & 11	0.67 (o)	16.4	21.67	70.02	22.79	
	0.54 (w)					
10 & 12	0.62 (o)	8.2	15.00	33.68	14.05	
	0.50 (w)					
CAPACITY				103.70	36.84	
CAPACITY (CLOGGING FACTOR APPLIED)				62.22	33.16	

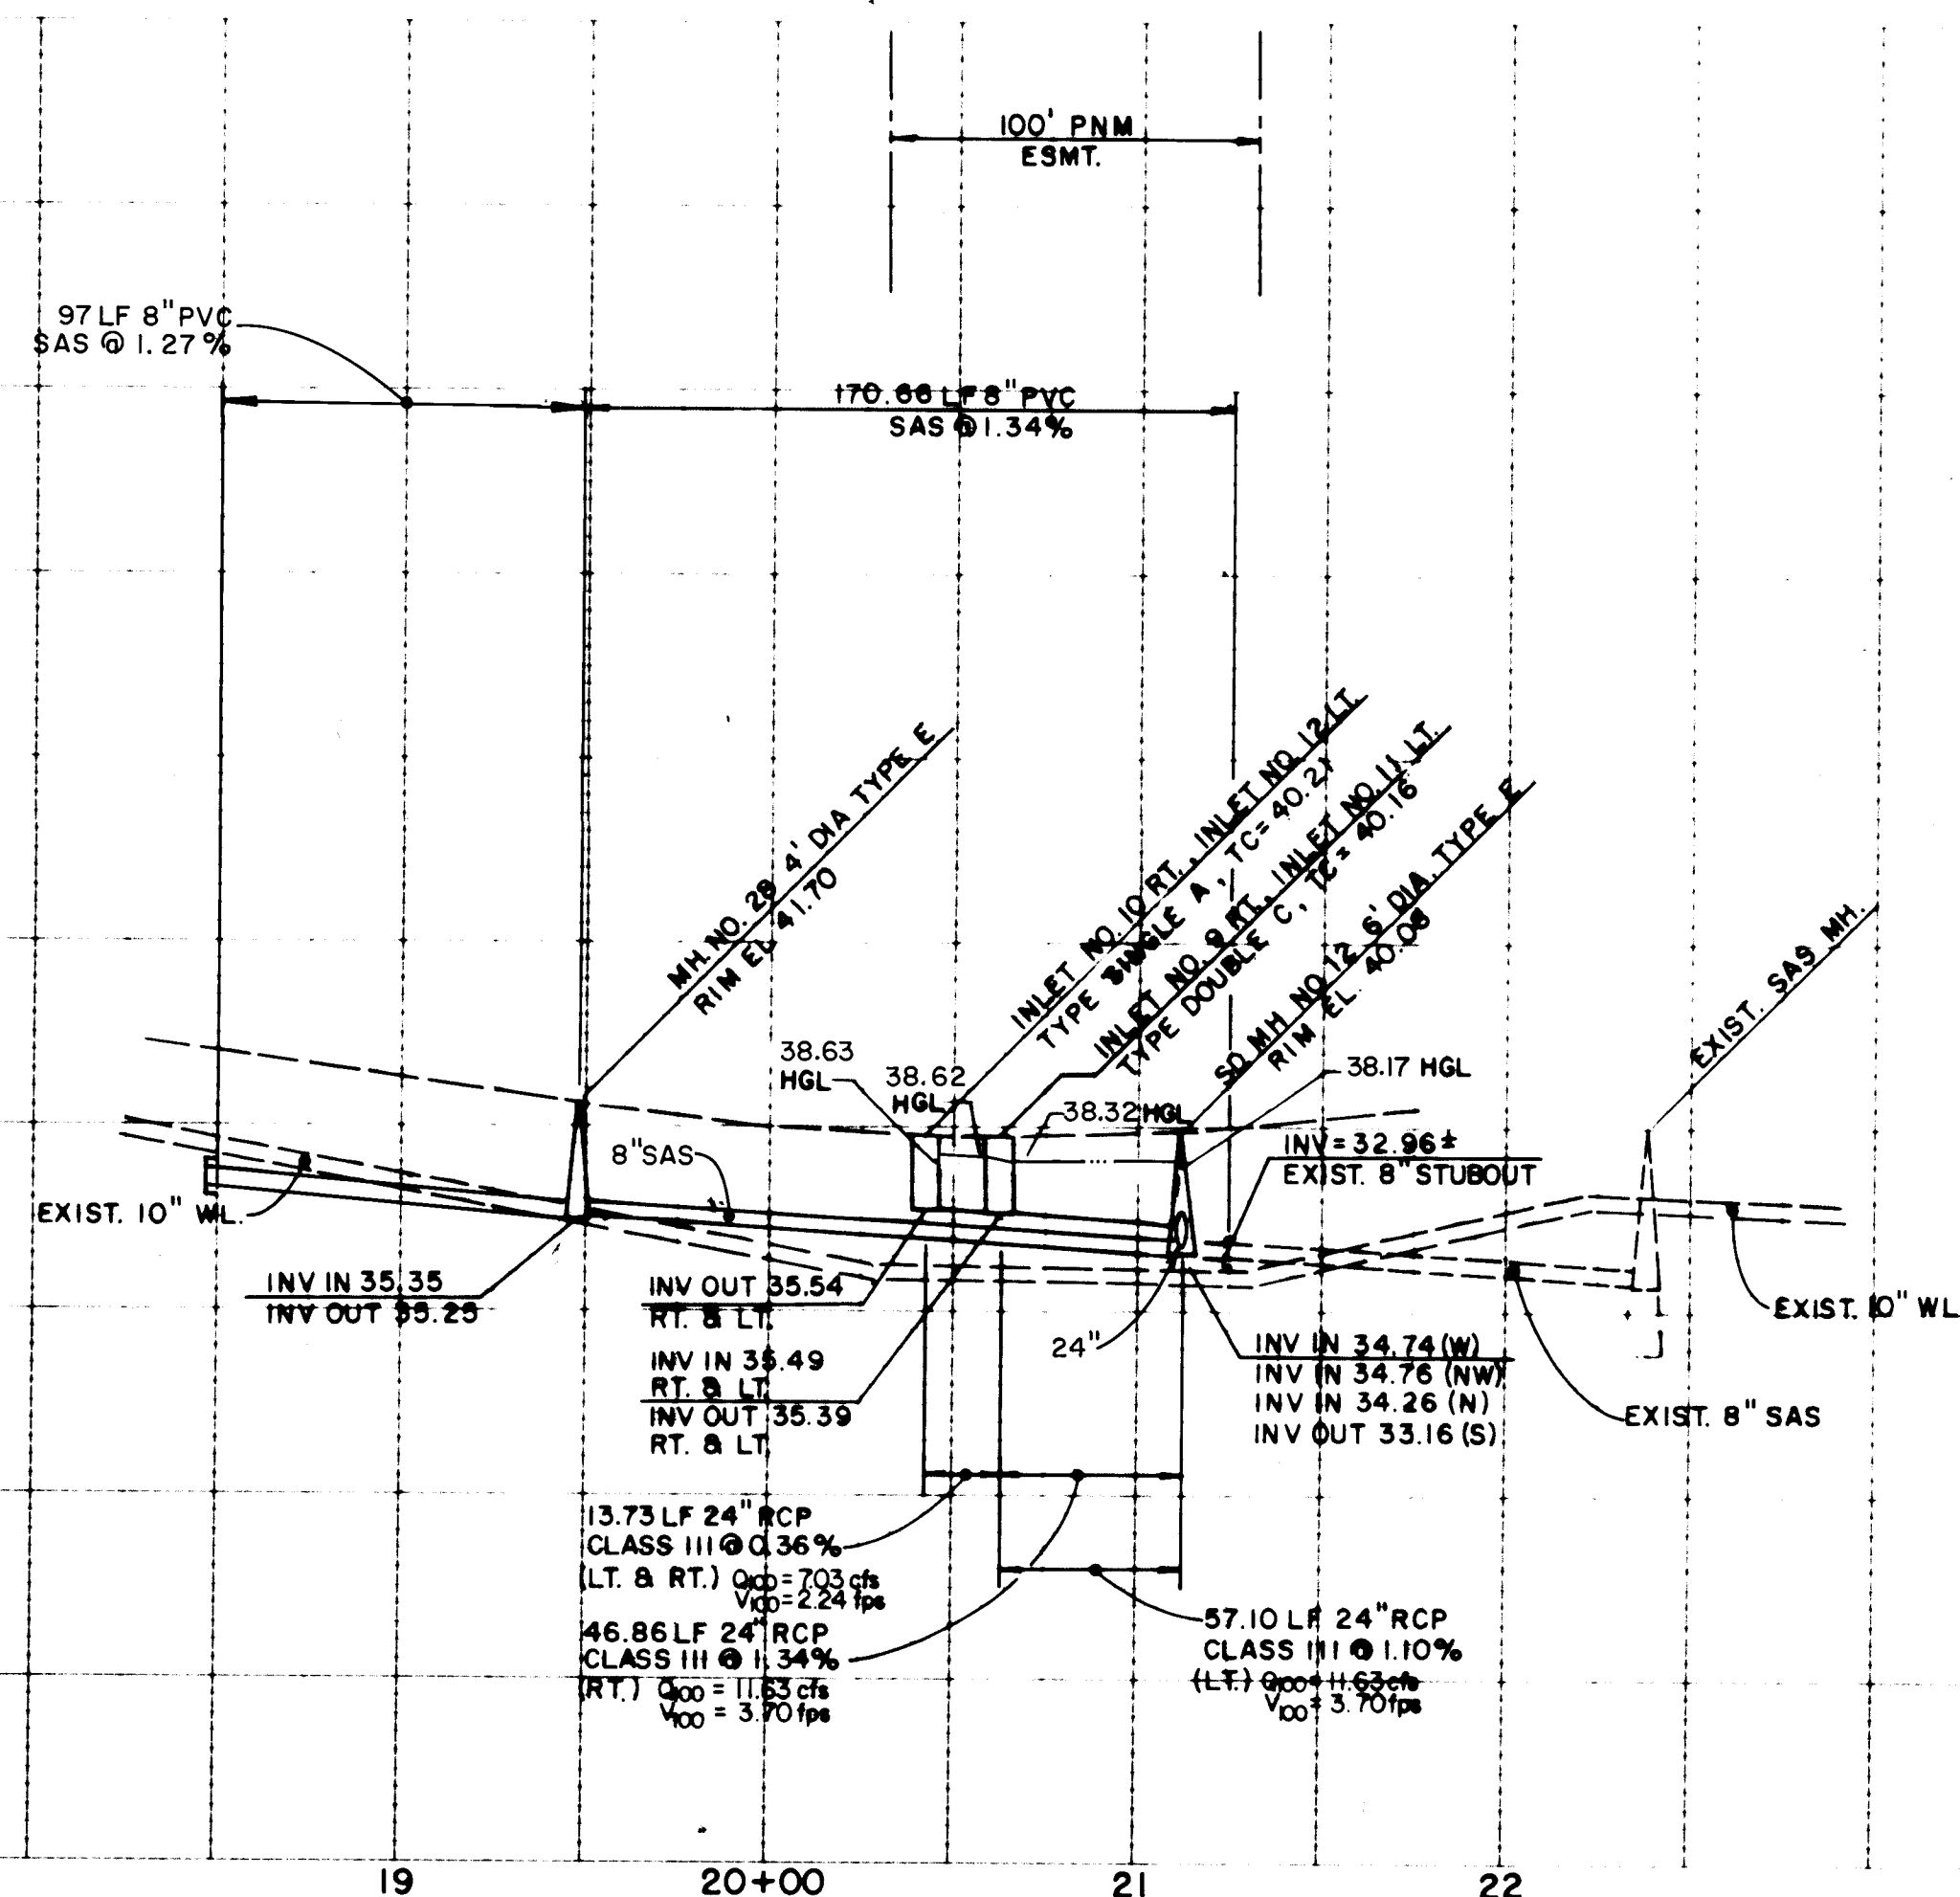

NOT A PART
OF THIS PROJECT

2 NOT ACCURATELY SHOWN HERE
SEE PROJECT NO. 4933.91

SCANNED BY LASON

1	2	3	4	5	6	7	8	9	10	11	12	13	14	15
26			49	33				90	17	95				

SCALE
1" = 50' HORI.
1" = 10' VERT

community
sciences
corporation



CITY OF ALBUQUERQUE
PUBLIC WORKS DEPARTMENT
ENGINEERING GROUP

TITLE: RINCONADA POINT - UNIT 1
OFFSITE WATER & SANITARY SEWER
VISTA ALEGRE STREET, N.W.

APPROVALS	ENGINEER	DATE	APPROVALS	ENGINEER	DATE
DRC CHAIRMAN	<i>R. D. Kase</i>	7-12-94	WATER	<i>R. D. Kase</i>	6-23-94
TRANSPORTATION	<i>N. L. Rupp</i>	6-23-94	WASTE WATER	<i>R. W. Kase</i>	6-23-94
HYDROLOGY	<i>W. L. Rupp</i>	6-23-94	M.A.F.C.A.		

PROJECT NO.	4933.90
-------------	---------

MAP NO. G-10	SHEET 17 OF 19
--------------	----------------

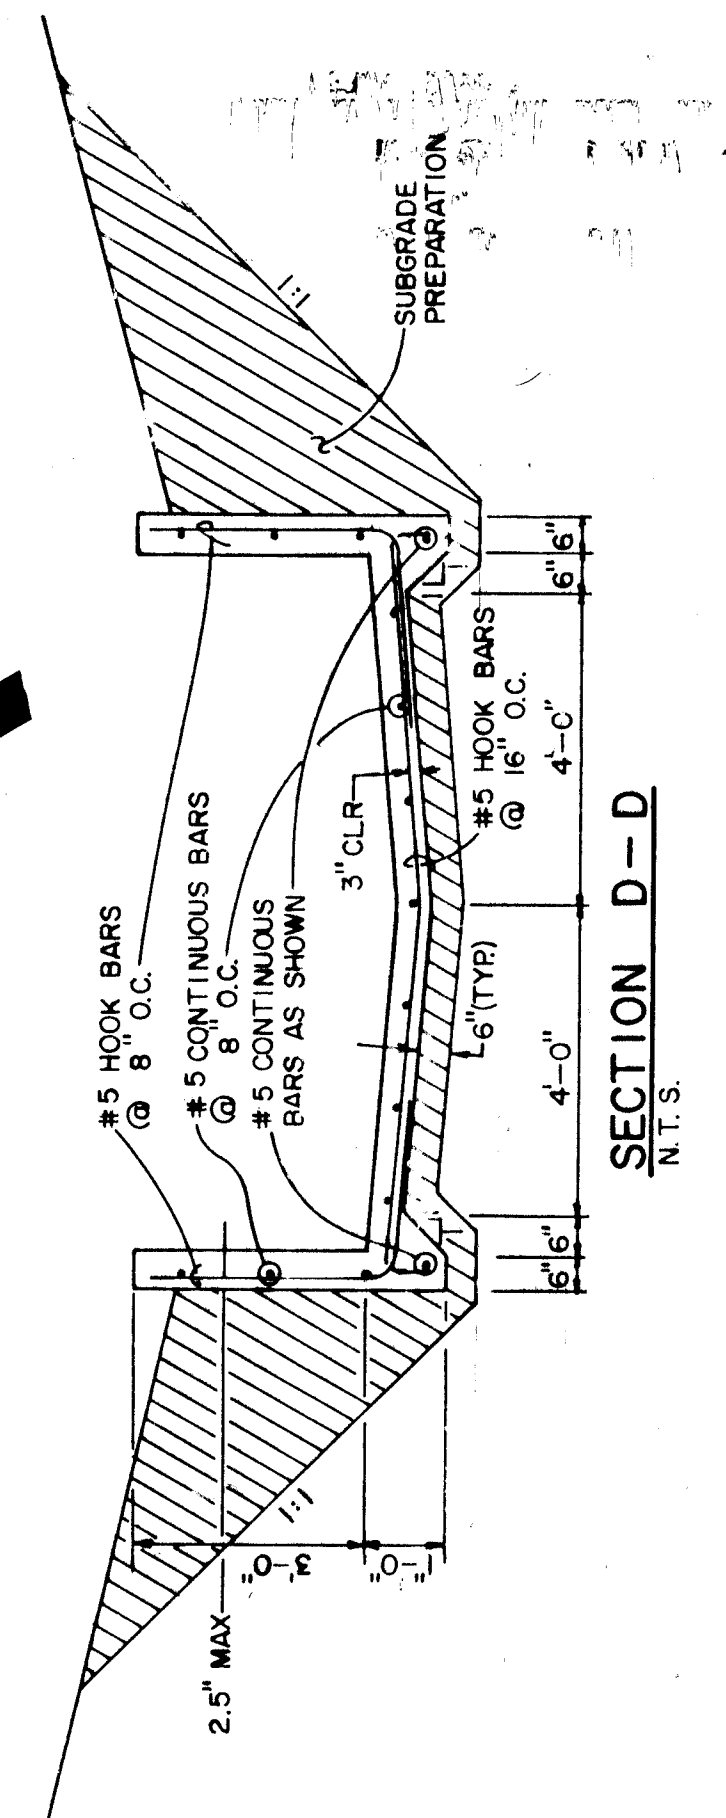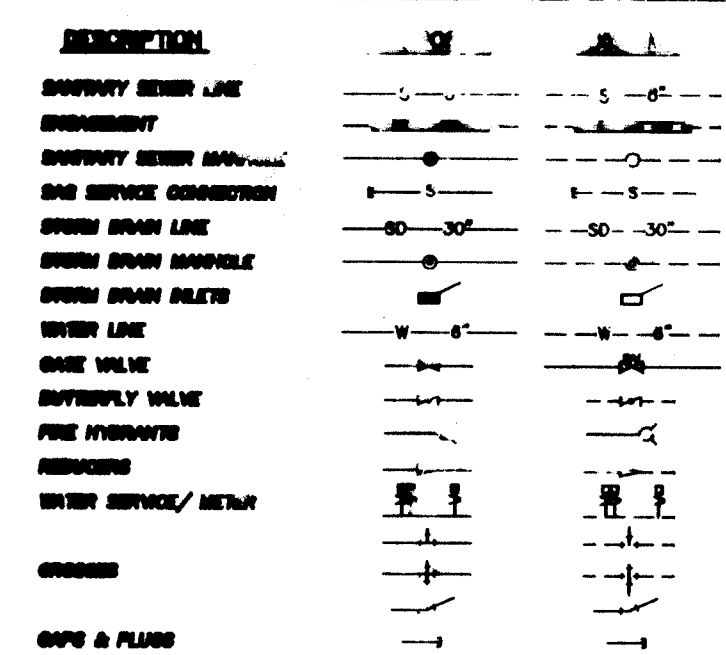

NOT ACCURATELY SHOWN HERE
SEE PROJECT NO. 4933.91

[illegible]

INLET CAPACITY CALCULATIONS
TABLE 2

$Q_{100} = 19.49$ CFS

ORIFICE EQ.

$Q_o = CA (2gh)^{1/2}$
 $C = 0.65$
CLOGGING FACTOR = 0.60





WEIR EQ.

$Q_o = C_w L_w h^{3/2}$
 $C = 2.65$
CLOGGING FACTOR = 0.90

INLET PAIR	H _o (ft.)	AREA (sq. ft.)	L _w (ft.)	Q _o (cfs)	Q _w (cfs)
7 & 8	0.67 (O) 0.54 (W)	16.4	21.67	70.02	30.37


CAPACITY CAPACITY (CLOGGING FACTOR APPLIED)

70.02 30.37
42.01 27.33

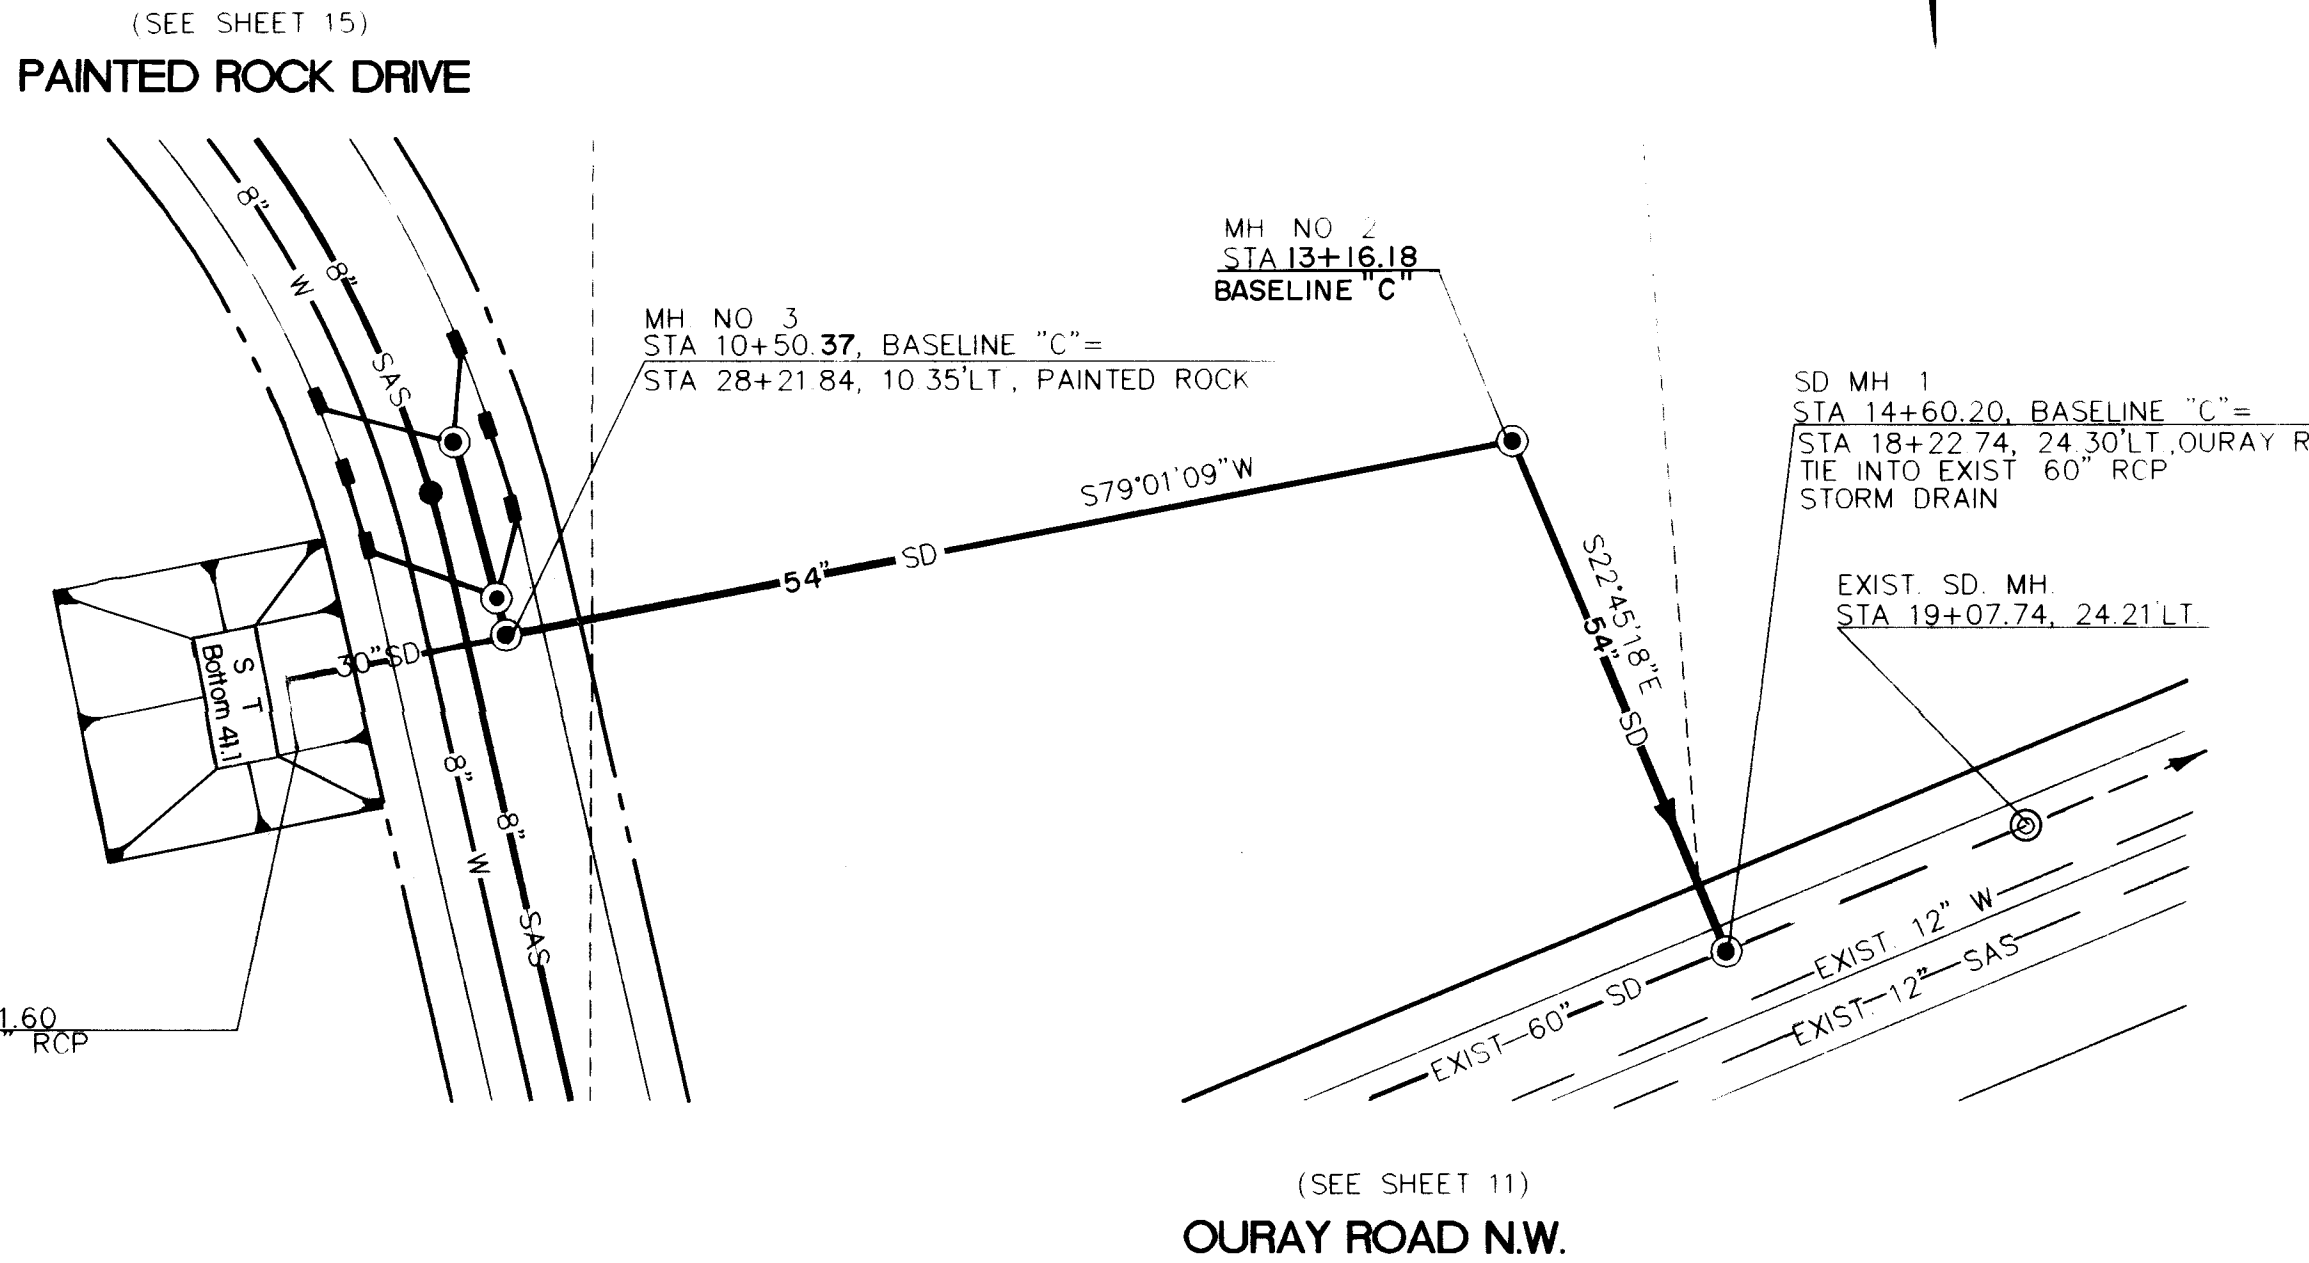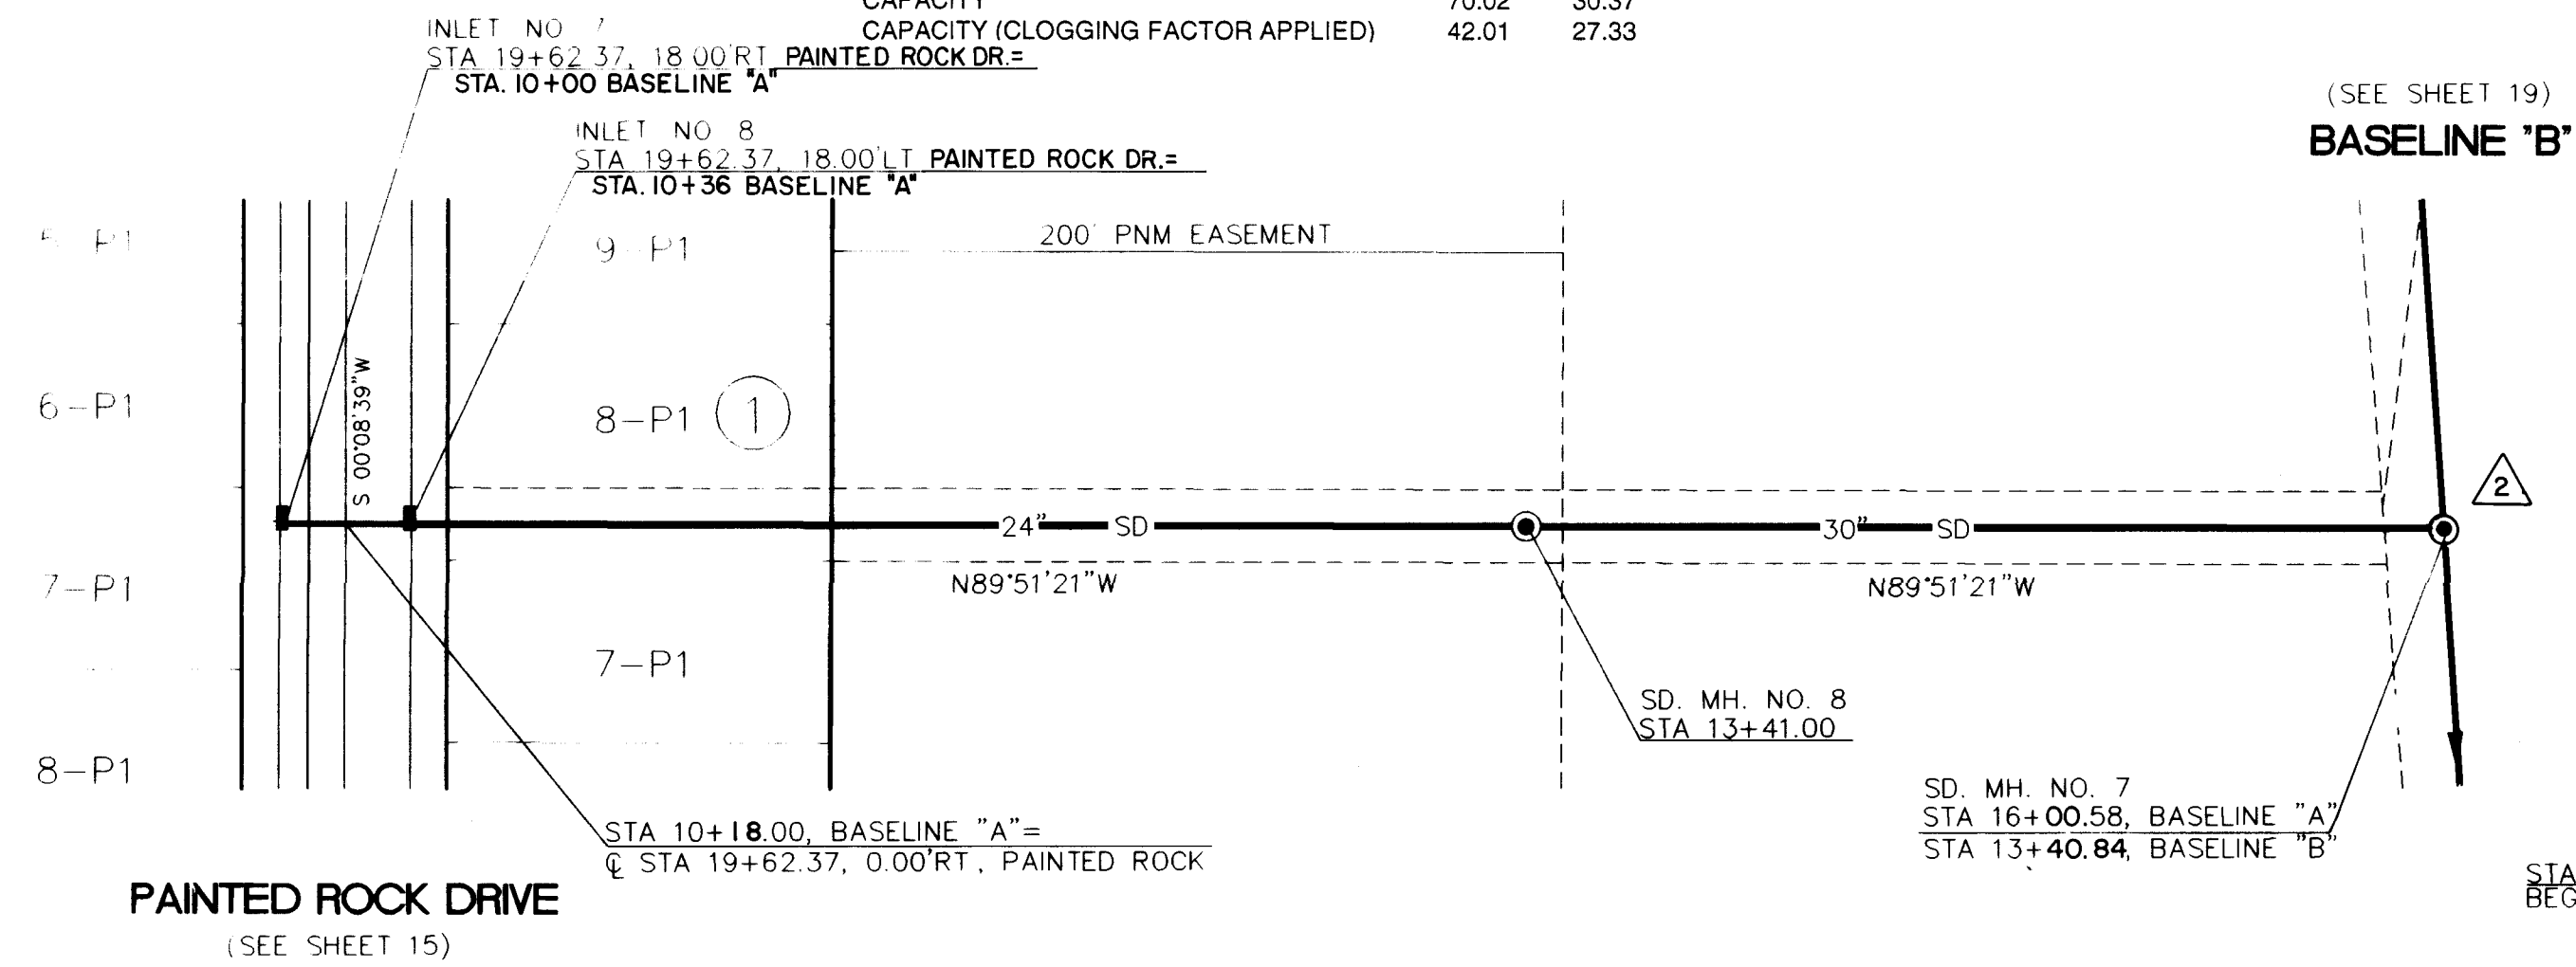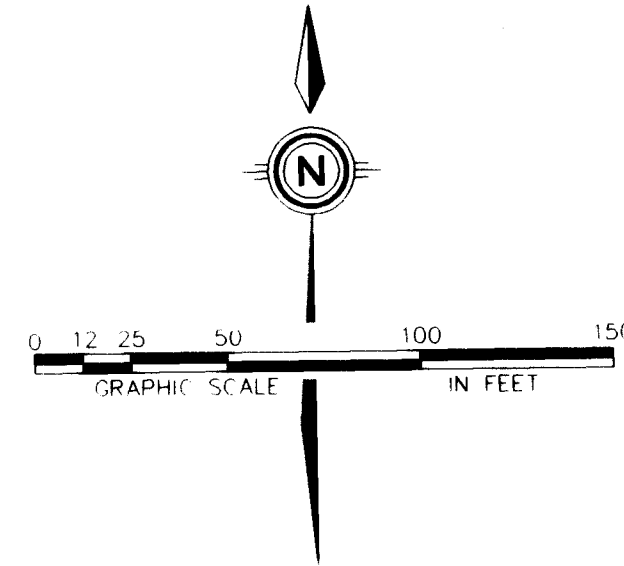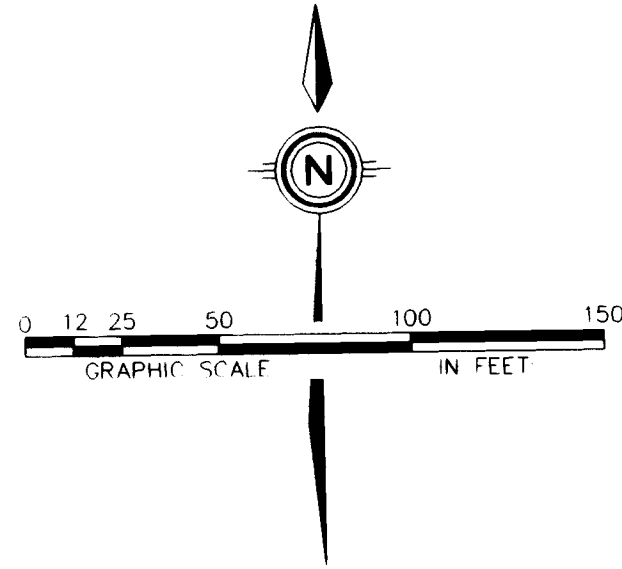

BASELINE 'A'

BASELINE 'C'

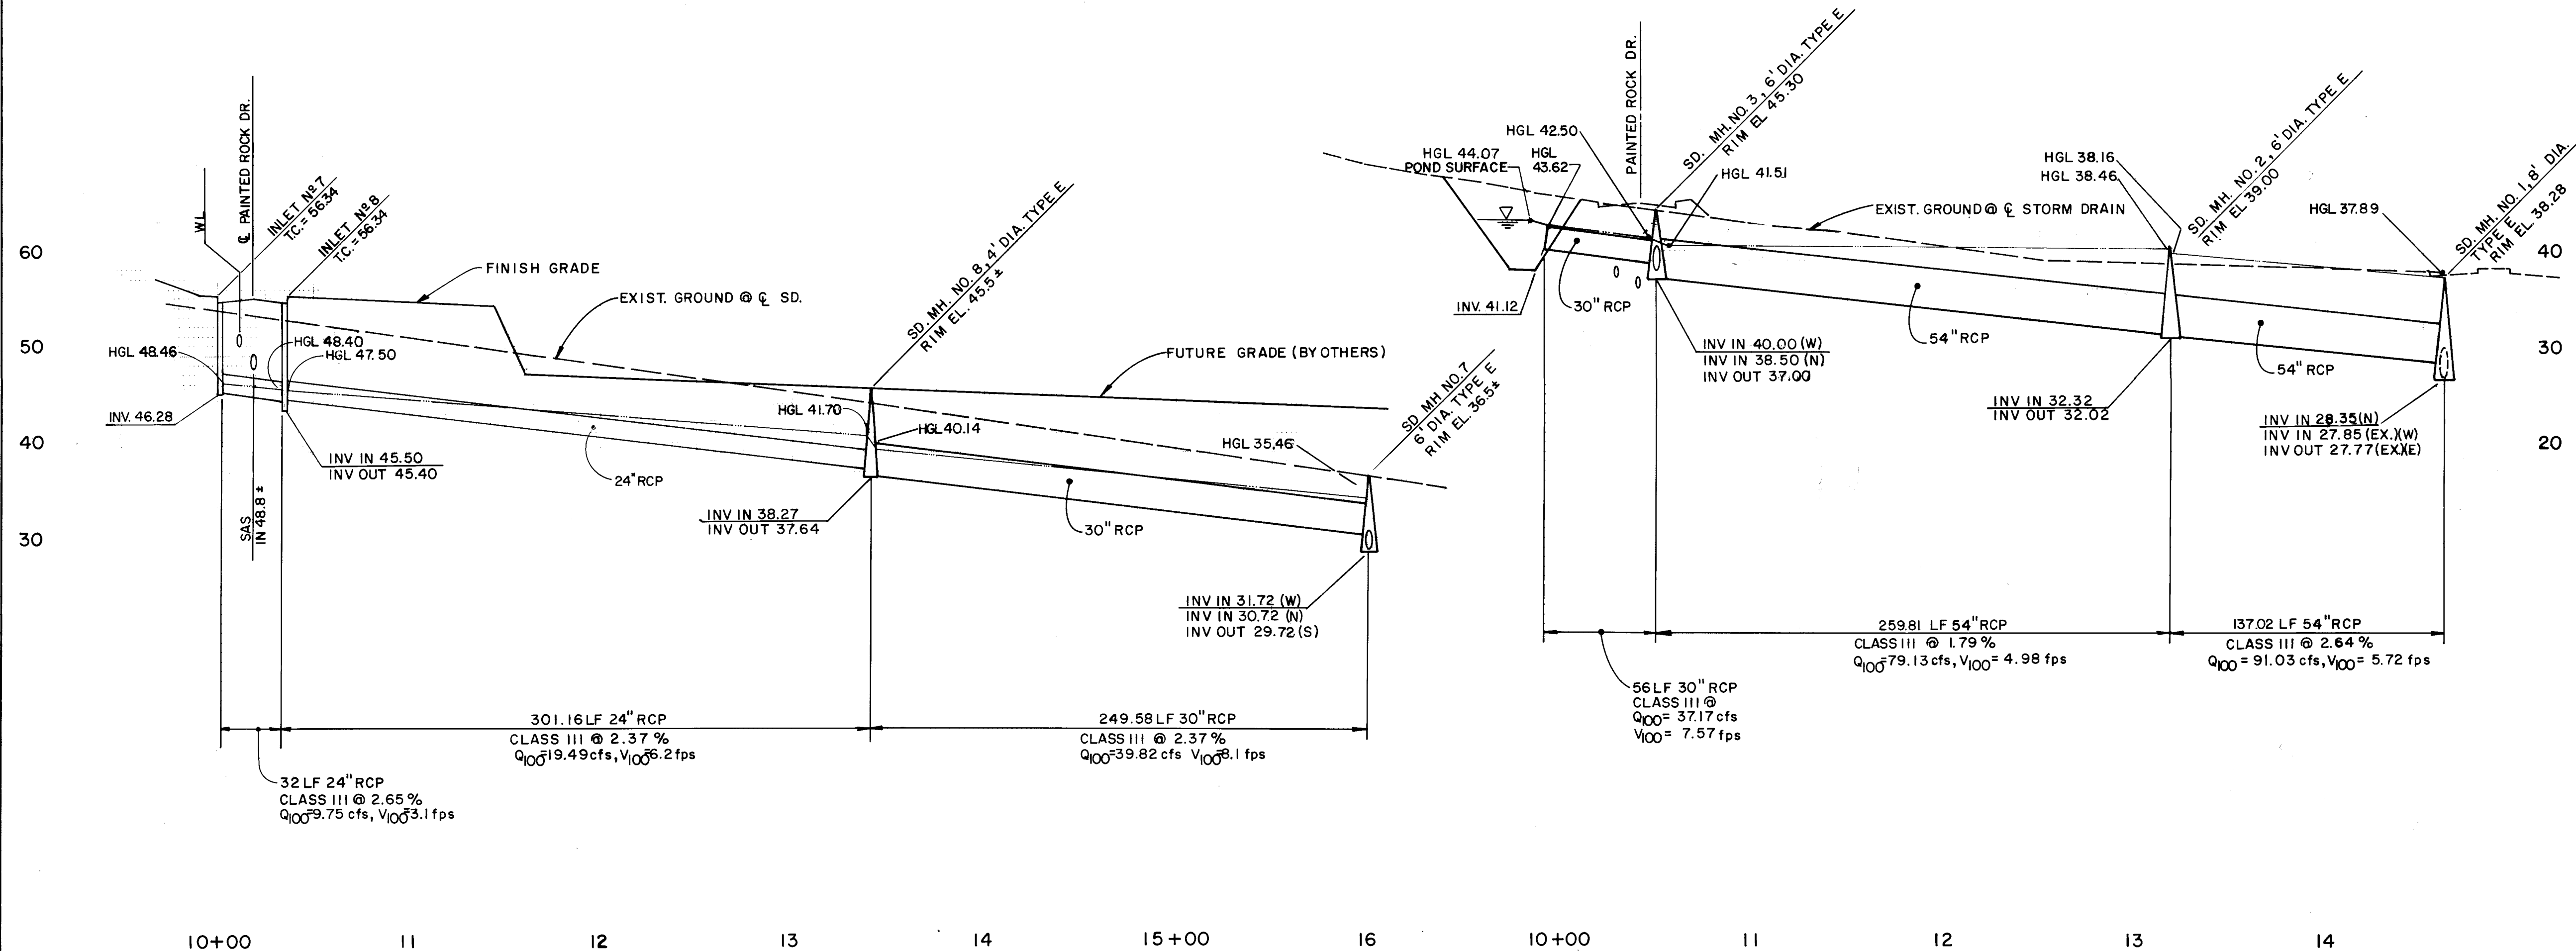

UTILITY LEGEND

DESCRIPTION	PROPOSED	EXISTING
SANITARY SEWER LINE	---	---
ENCASEMENT	---	---
SANITARY SEWER MANHOLE	○	○
SAS SERVICE CONNECTION	---	---
STORM DRAIN LINE	---	---
STORM DRAIN MANHOLE	○	○
STORM DRAIN INLETS	---	---
WATER LINE	---	---
GATE VALVE	---	---
BUTTERFLY VALVE	---	---
PIPE HYDRANTS	---	---
REDUCERS	---	---
WATER SERVICE / METER	---	---
TEES	---	---
CROSSES	---	---
BENDS	---	---
JAPS & PLUGS	---	---

AS BUILT INFORMATION CONTRACTOR: <i>New Concepts</i> WORK: <i>C.O.A.</i> DATE: <i>6/15/94</i> CHECKED BY: <i>Rick Duran</i> DATE: <i>6/15/94</i> CORRECTED BY: <i>TMD</i> DATE: <i>6/15/94</i> MICRO-FILM INFORMATION RECORDED BY: <i>NO</i> DATE: <i>NO</i>	
BENCH MARKS BENCHMARK STATION IS AN ACS BASS TABLE STAMPED "2-09" SET IN A 2" IRON PIPE 1 FT. ABOVE GROUND LOCATED ON TOP OF A VOLCANIC OUTCROP TO REACH THE STATION FROM THE INTERSECTION OF COORS RD. AND OURAY RD. NW GO WEST ON THE DIRT ROAD TO THE TOP OF THE DETENTION DAM ALONG THE N. BANK OF DAM 0.6 MI. TO A DIRT CROSS ROAD TURN RIGHT 60 N. ON DIRT ROAD 0.5 MI. SLD 1929 ELEVATION = 5334.50	
SURVEY INFORMATION FIELD NOTES NO. <i>1</i> BY <i>DATE</i> NO. <i>2</i> BY <i>DATE</i>	
ENGINEER'S SEAL 	
CHANGE ORDER NO. 2 DATE: <i>10/21/94</i> BY: <i>A.M.</i>	CHANGE ORDER NO. 1 DATE: <i>7/27/94</i> BY: <i>A.M.</i>
REVISIONS NO. <i>1</i> DATE <i>10/21/94</i> BY <i>A.M.</i> DESIGN NO. <i>2</i> DATE <i>7/27/94</i> BY <i>A.M.</i> DESIGN NO. <i>3</i> DATE <i>6/23/94</i> BY <i>A.M.</i> DESIGN	
DESIGNED BY: <i>CSC</i> DATE: <i>MAY 1993</i>	CHECKED BY: <i>CSC</i> DATE: <i>MAY 1993</i>
CITY OF ALBUQUERQUE PUBLIC WORKS DEPARTMENT ENGINEERING GROUP	
TITLE: RINCONADA POINT - UNIT 1 OFFSITE STORM DRAIN BASELINES "A" & "C"	
APPROVALS DRC CHAIRMAN: <i>R.W. Kane</i> DATE: <i>6-23-94</i> TRANSPORTATION: <i>R.W. Kane</i> DATE: <i>6-23-94</i> HYDROLOGY: <i>R.W. Kane</i> DATE: <i>6-23-94</i>	APPROVALS ENGINEER: <i>R.W. Kane</i> DATE: <i>6-23-94</i> WATER: <i>R.W. Kane</i> DATE: <i>6-23-94</i> WASTE WATER: <i>R.W. Kane</i> DATE: <i>6-23-94</i> MAINTENANCE: <i>R.W. Kane</i> DATE: <i>6-23-94</i>
PROJECT NO. 493390 MAP NO. G-10 SHEET 19 OF 19	SCALE: 1" = 50' HORIZ 1" = 10' VERT community sciences corporation LAND PLANNING: P.O. Box 1328 ENGINEERING: Corrales, N.M. 87046 SURVEYING: Corrales, N.M. 87046