

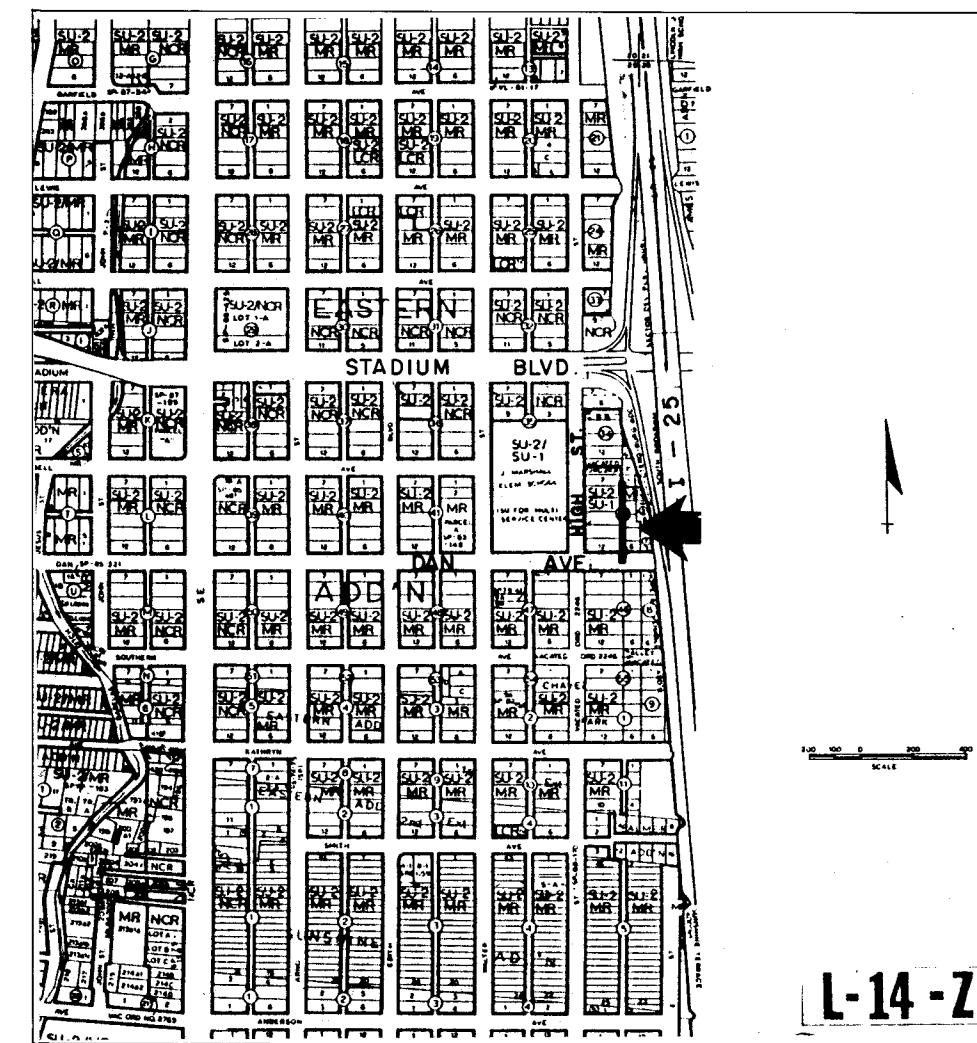


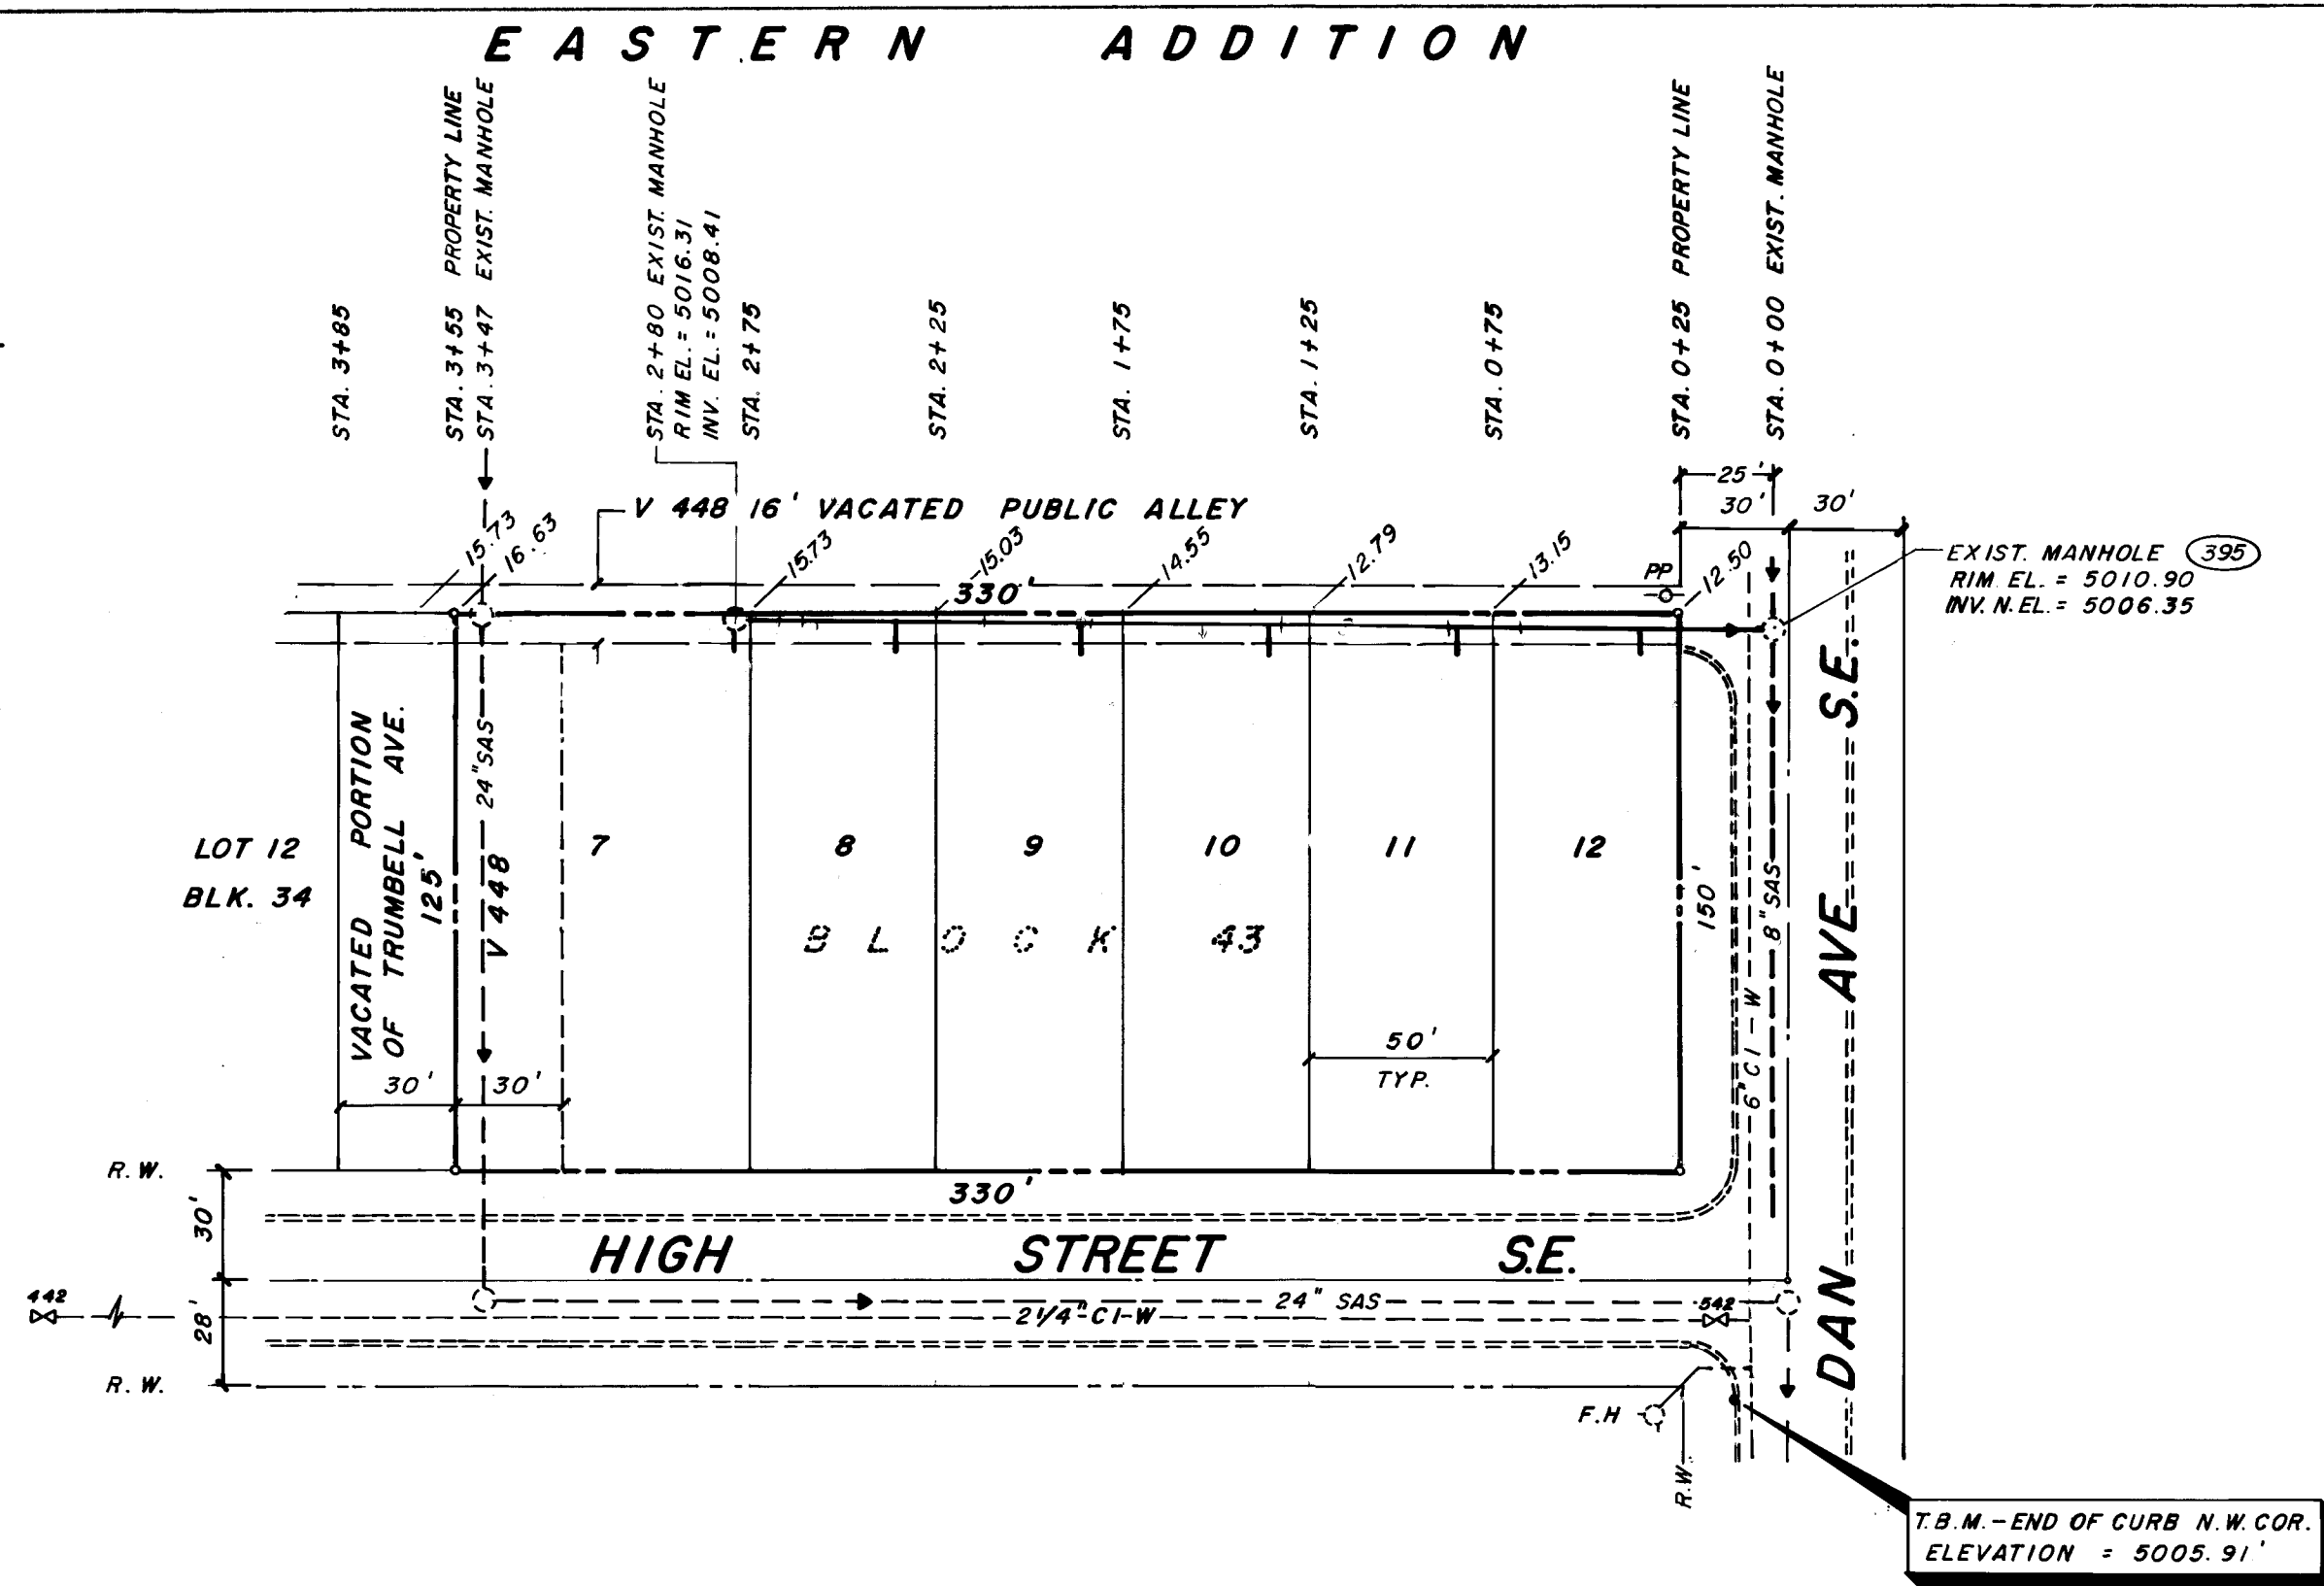

LOCATION MAP

PLAN :
SCALE : 1" = 50'
PROFILE :
SCALE : HOR. 1" = 50'
VERT. 1" = 10'

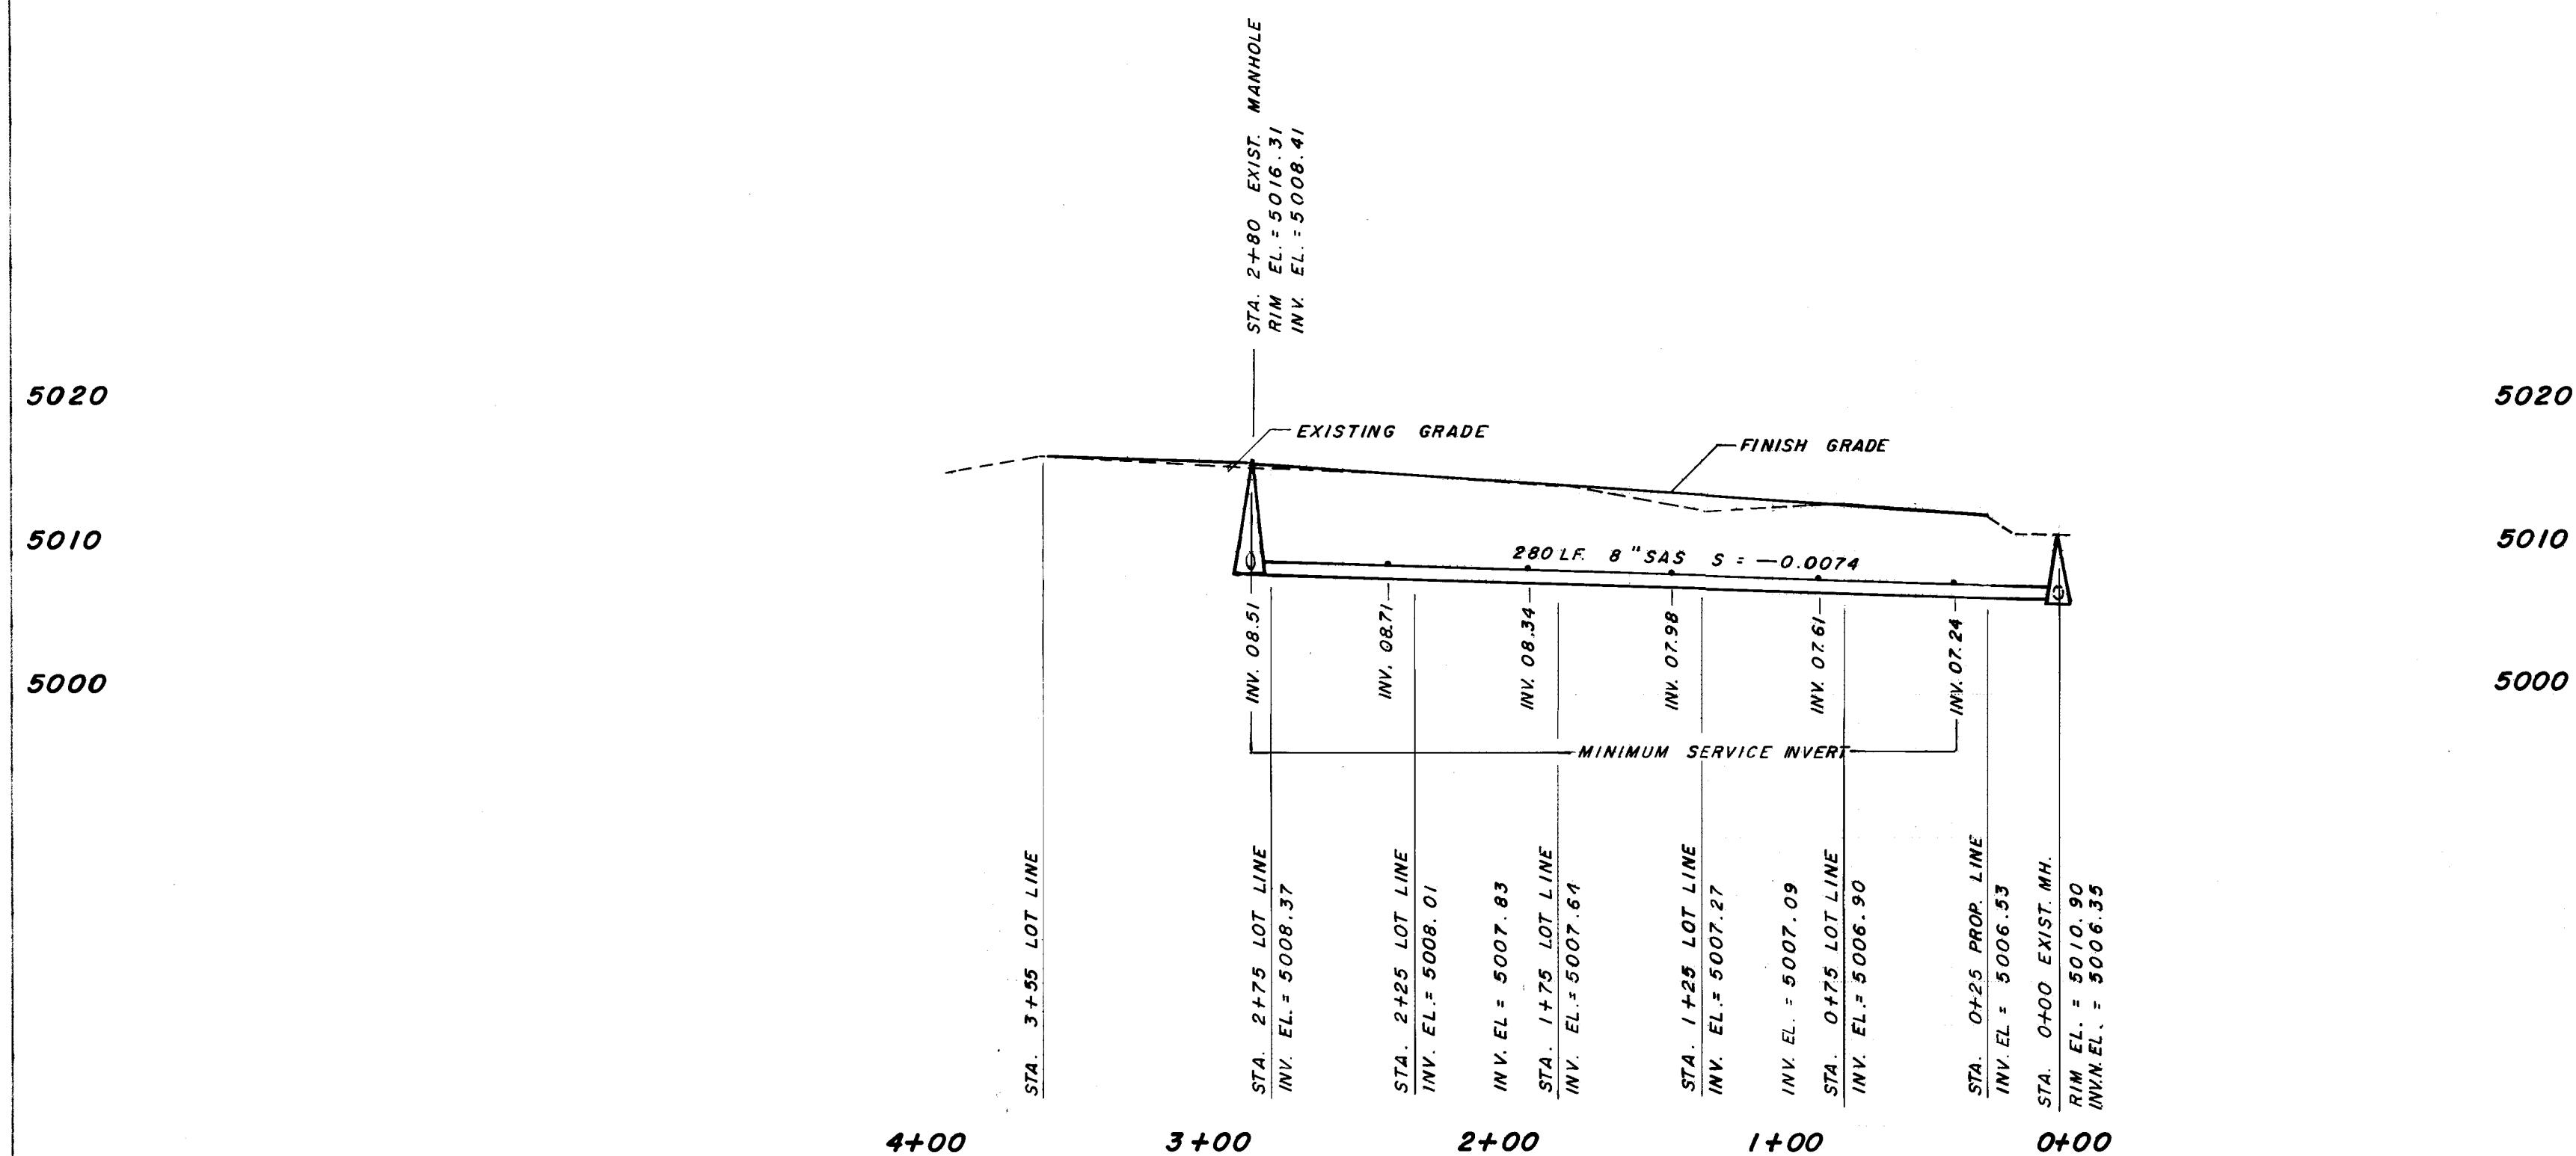

1 2 3 4 5 6 7 8 9 10 11 12 13 14 15
26 43 55 19 01 92

NOTE : THIS DRAWING IS FOR RECORD PURPOSE ONLY. IT STARTED AS AN D.R.C. ACTION TO DESIGN THIS SEWER SEGMENT WHICH WAS BELIEVED NOT TO EXIST. THE SANITARY SEWER SYSTEM IN THIS AREA WAS INSTALLED 30 TO 35 YEARS AGO AND THIS SEGMENT DID NOT APPEAR IN THE RECORD SYSTEM.

SURVEY INFORMATION		BENCH MARKS		AS-BUILT INFORMATION	
NO.	BY	DATE	NO.	DATE	NO.
00309	GARY GRISKO LS	8/8/96	1-25 - 29 S.E. QUAD. STADIUM BLVD. & I-25	ELEV. 5031.415	
ENGINEER'S SEAL		REVISIONS		MICRO-FILM INFORMATION	
REVISIONS		DESIGN		RECORDED BY	
NO.	DATE	REMARKS	BY	NO.	
DESIGNED BY	C. A. C.	DATE	11-08-91		
DRAWN BY	V. M.	DATE	11-08-91		
CHECKED BY	C. A. C.	DATE	11-08-91		

SCANNED BY LASON

CITY OF ALBUQUERQUE
PUBLIC WORKS DEPARTMENT
ENGINEERING GROUP

TITLE: **AS-BUILT SEWER P. & P.
TRACT 7-12, BLOCK 43, EASTERN ADDITION**

APPROVALS	ENGINEER	DATE	APPROVALS	ENGINEER	DATE
DRC CHAIRMAN			WATER		7-27-92
TRANSPORTATION			WASTE WATER		7-27-92
HYDROLOGY					

PROJECT NO. **4355.90** MAP NO. **L-14** SHEET **1** OF **1**