
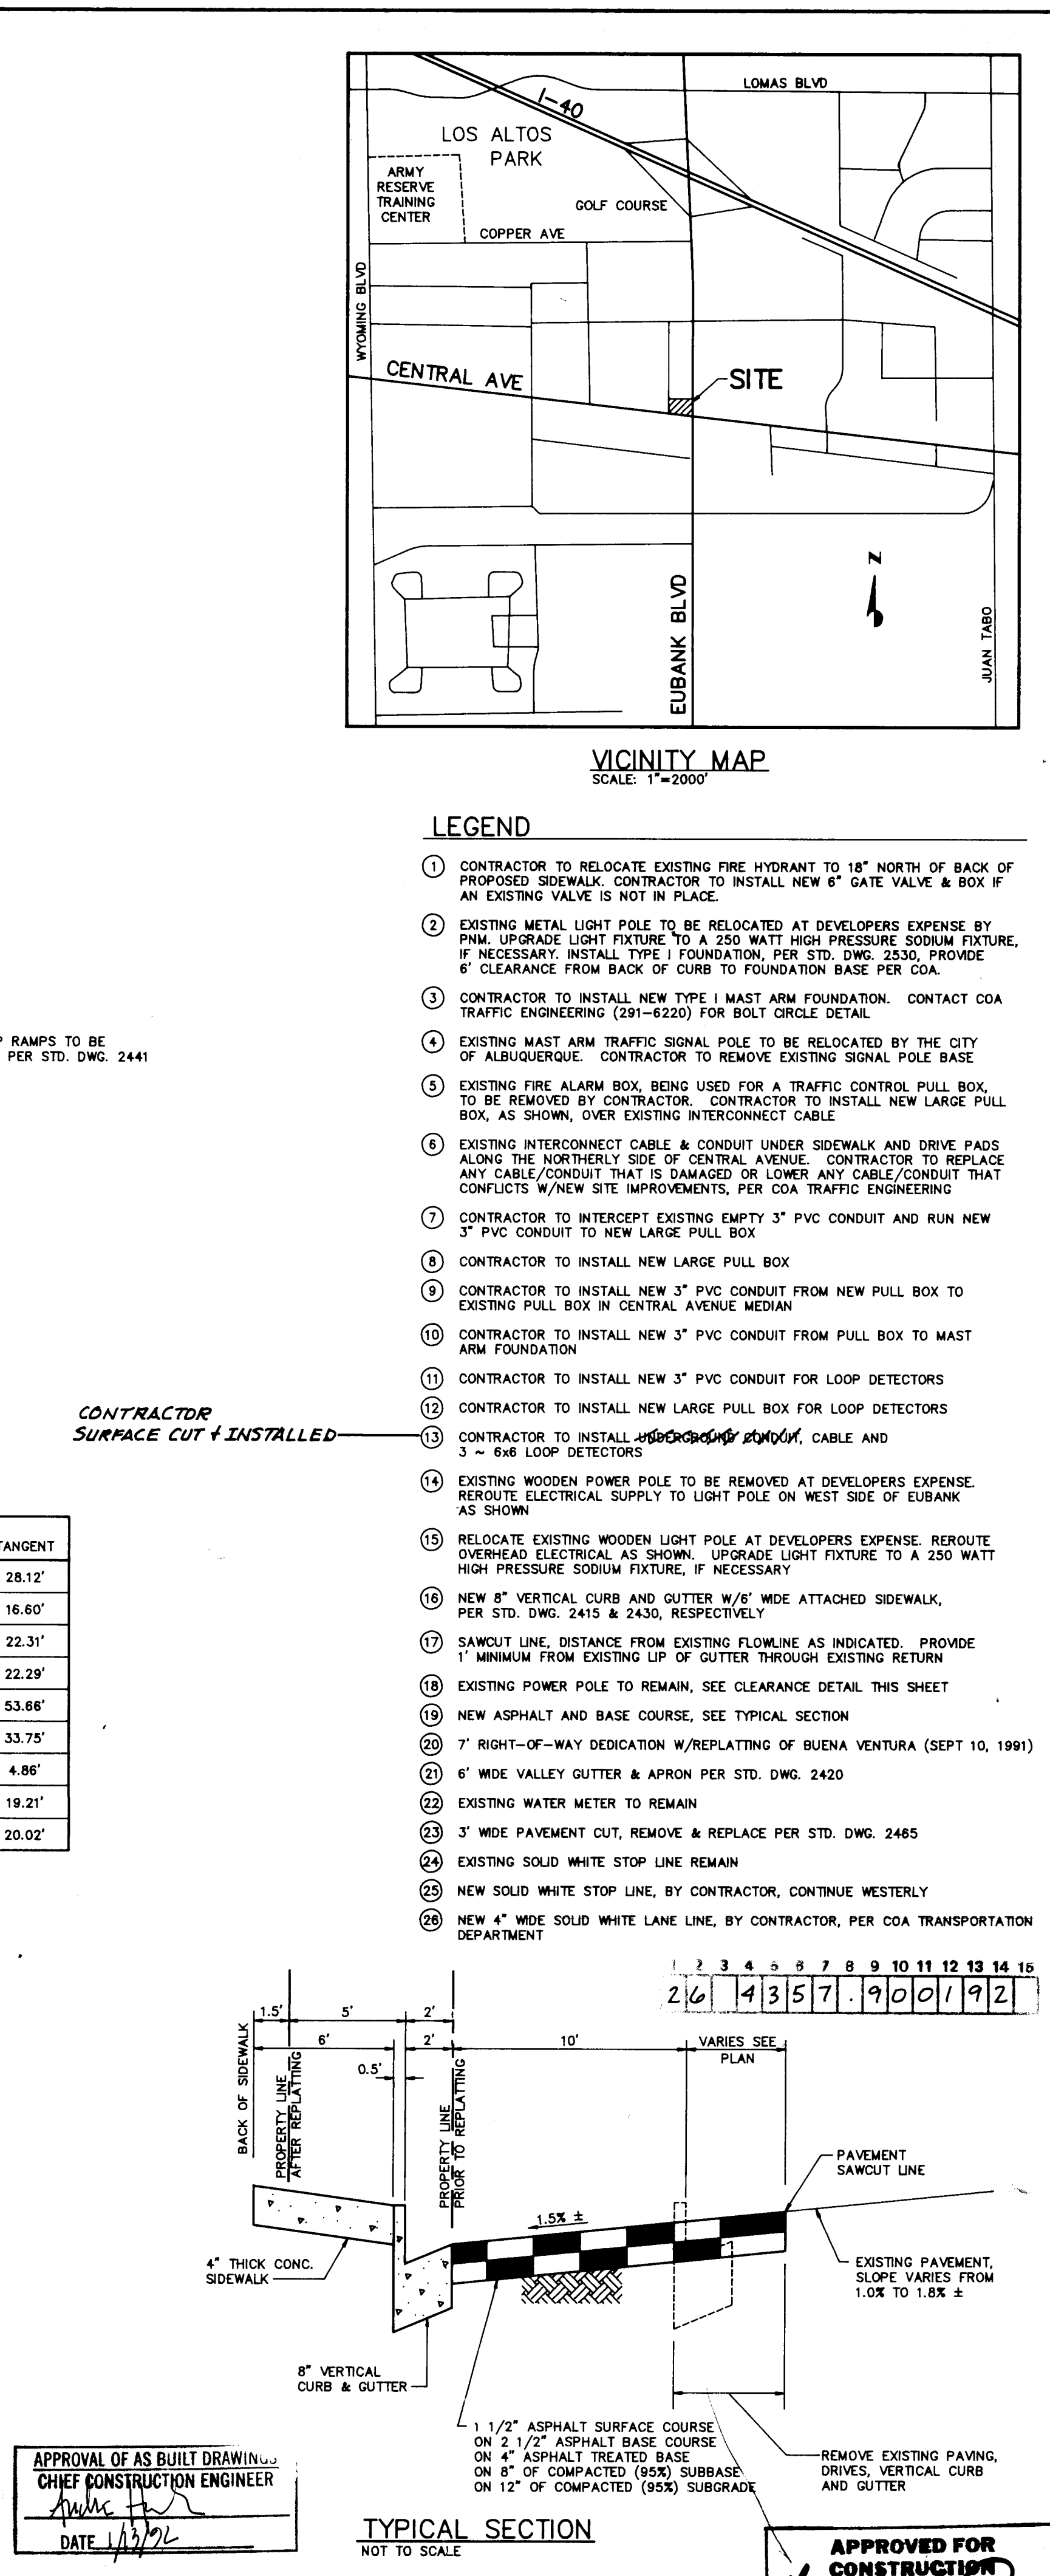


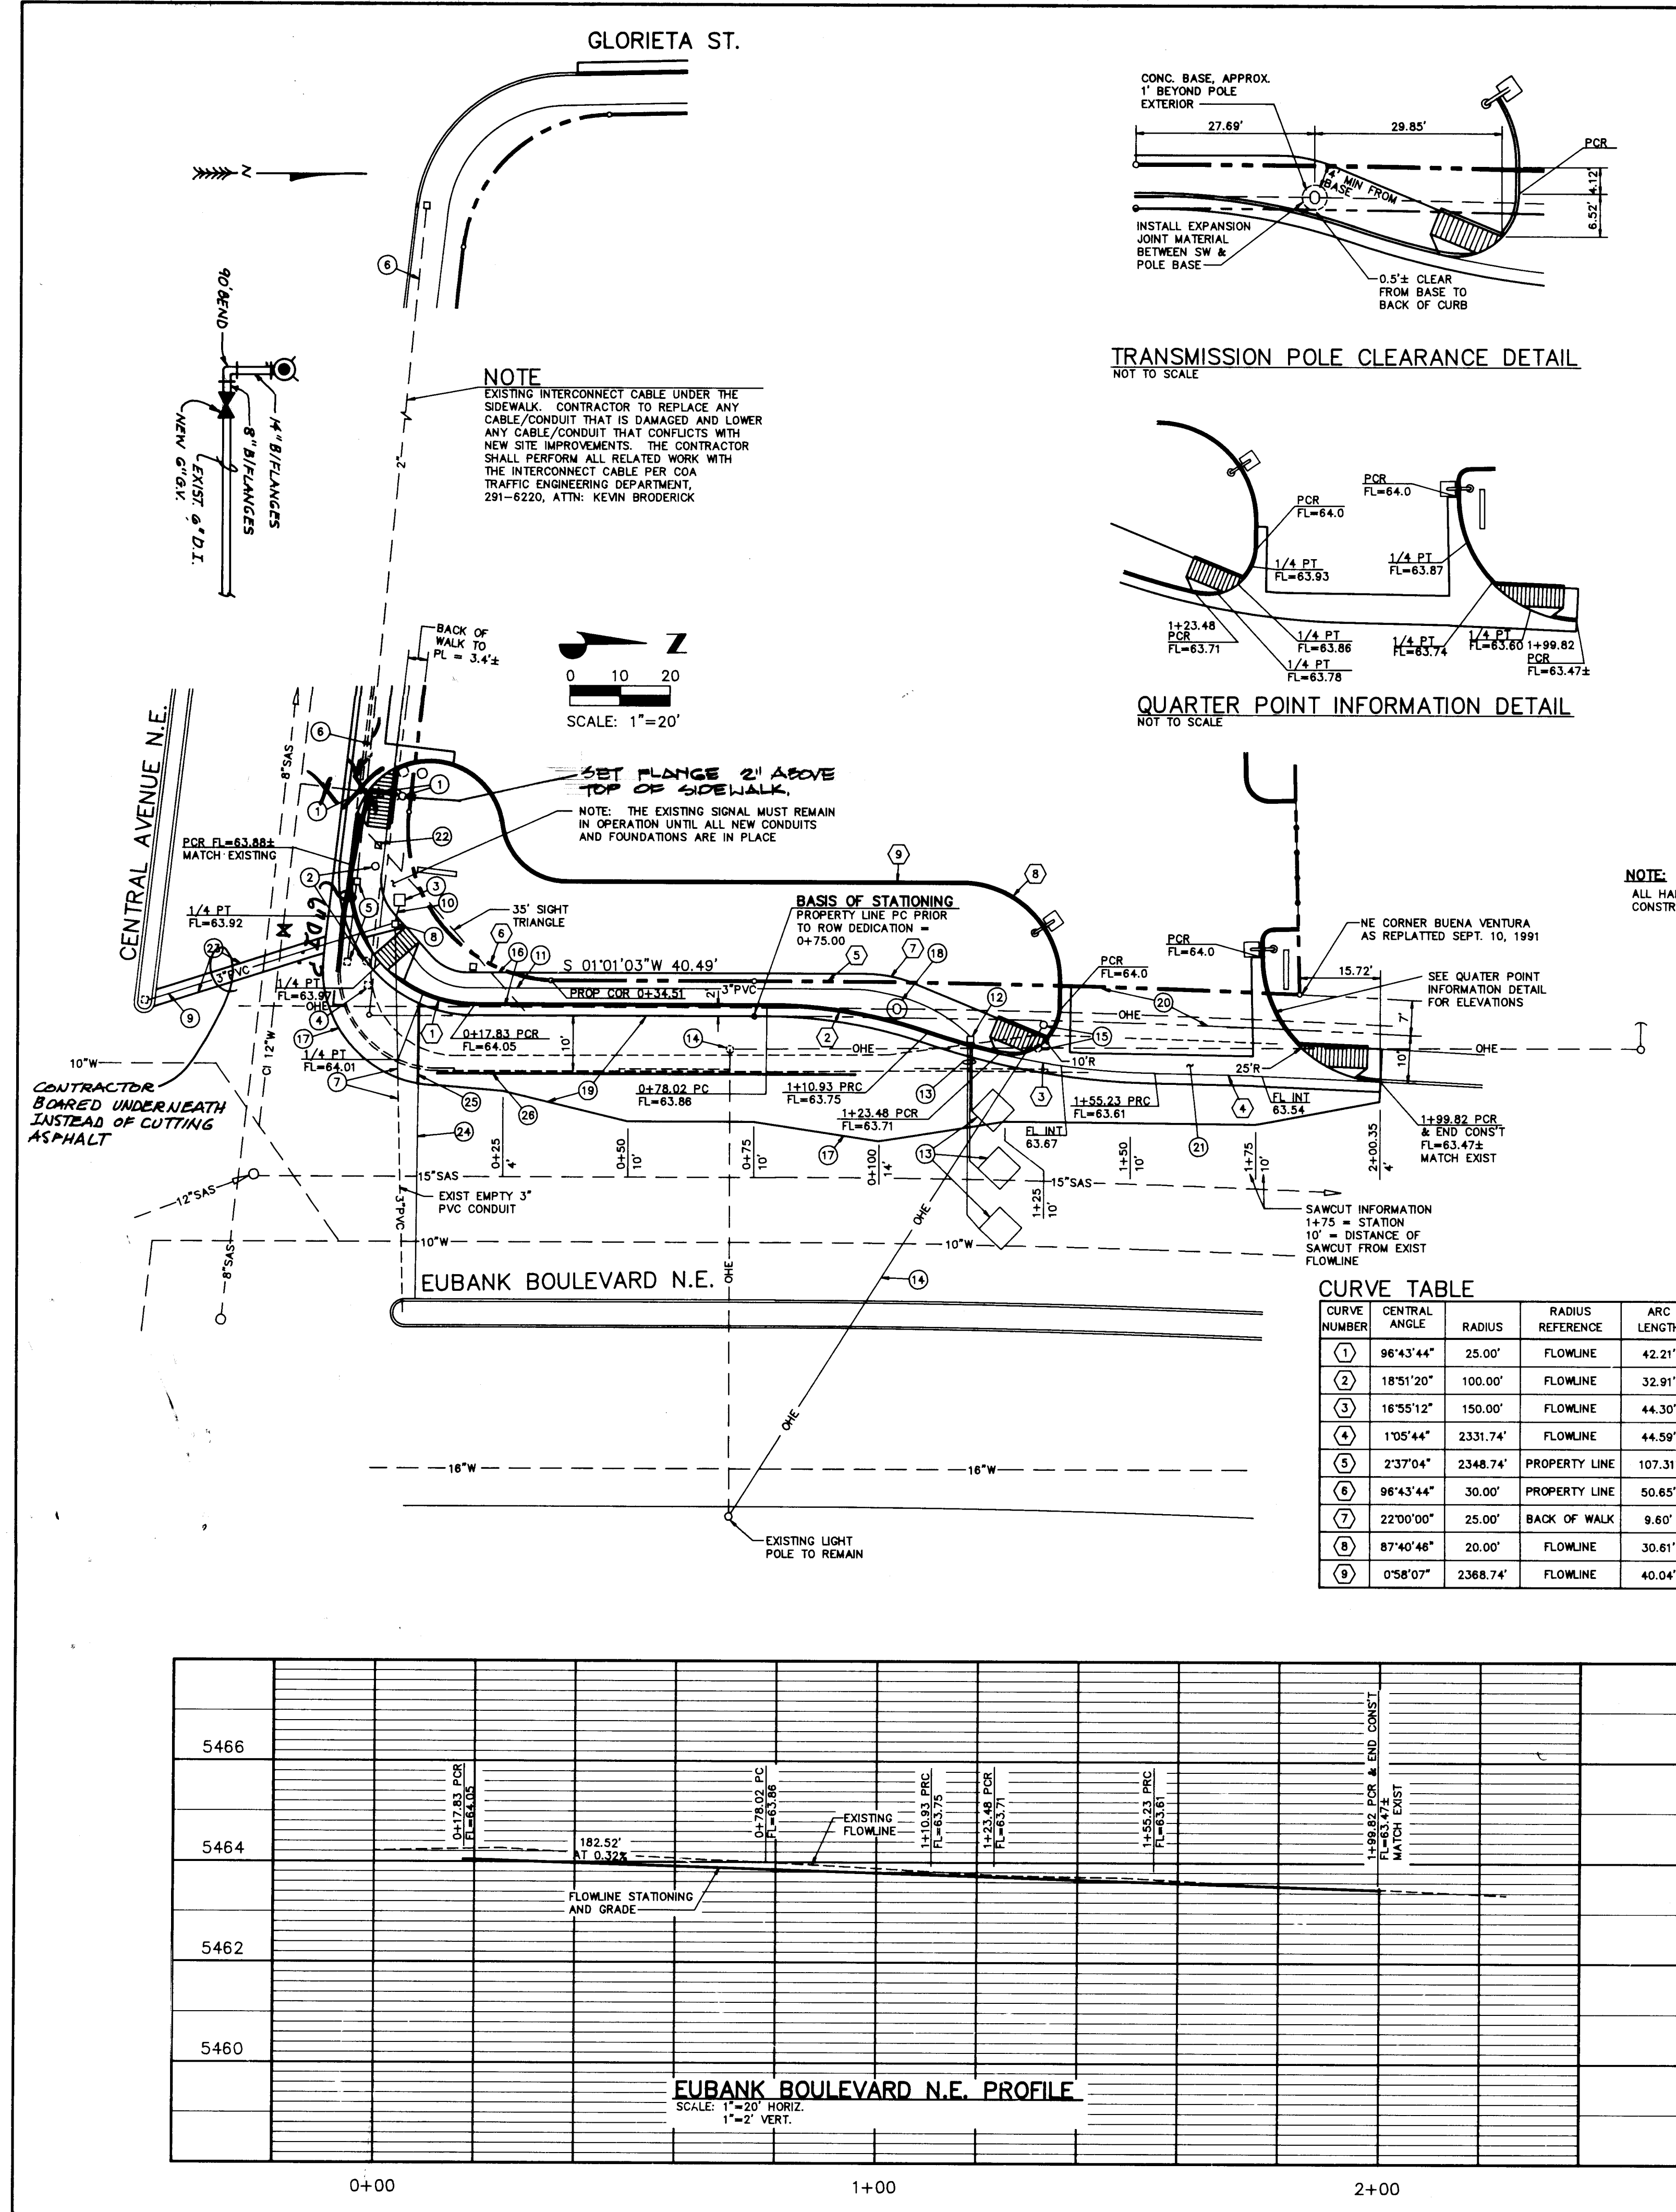

Notes and project information section. It includes:

- NOTES:** A list of 12 notes detailing construction requirements, materials, and safety measures.
- AS BUILT INFORMATION:** A table for recording construction details.
- ENGINEER'S SEAL:** A circular seal for the engineer's signature and stamp.
- REVISIONS:** A table for recording changes to the plan.
- APPROVALS:** A table for recording approvals from various stakeholders.
- PROJECT INFORMATION:** A table for recording project details such as title, location, and dates.