

PASEO DEL NORTE  PASEO	Ю				
NOTICE TO CONTRACTOR					
<ol> <li>All work detailed on these plans to be performed under contract shall, except as otherwise stated or provided for hereon, be constructed in accordance with the City of Albuquerque Standard Specifications for Public Works Construction 1986.</li> </ol>					
2. Two (2) working days prior to any excavation, contractor must contact. New Mexico One Call Line Locating Service, 260-1990, for location of existing utilities.					
3. Prior to construction, the contractor shall excavate and verify the horizontal and vertical location of all obstructions. Should a conflict exist, the contractor shall notify the engineer or surveyor so the conflict can be resolved with a minimum amount of delay.					
4. The contractor shall submit a detailed construction schedule & submit a construction signing & barricading plan to construction coordination a minimum of three (3) working days prior to construction to receive a barricading permit. Two (2) working days prior to construction, the contractor shall obtain a barricading permit from the barricade engineer (768-2551). Refer to section 19 of the general conditions of the standard specifications.  THE FOLLOWING NOTES ALSO APPLY WHEN CHECKED					
[ ] All utilities and utility service lines shall be installed prior to paving.	1				
☐ Backfill compaction shall be according to specified street use.					
► Tack coat requirements shall be determined by the City Engineer.					
[ ] Sidewalks and wheelchair ramps within the curb returns shall be constructed wherever a new curb return is constructed.					
[ ] If curb is depressed for a drivepad or a handicap ramp, the drivepad or ramp shall be constructed prior to acceptance of the curb and gutter.					
[ ] All storm drainage facilities shall be completed prior to final acceptance.					
NOTE: THESE DRAWINGS DO NOT INCLUDE NECESSARY COMPONENTS FOR CONSTRUCTION SAFETY WHICH SHALL REMAIN THE CONTRACTOR'S RESPONSIBILITY.					
26 4373 900192					
C.O.A. BM 11-N18 ELEV. 5235.67  A STANDARD BRASS TABLET STAMPED  "11-D18-1978" SET IN TOP OF A CONCRETE POST FLUSH WITH THE GROUND LOCATED NEAR THE SOUTHEAST CORNER OF THE INTERSECTION OF SAN PEDRO DR. & PASEO DEL NORTE BLVD. NE					
C.O.A. BM 11-N18 ELEV. 5235.67  A STANDARD BRASS TABLET STAMPED  "11-D18-1978" SET IN TOP OF A CONCRETE  POST FLUSH WITH THE GROUND LOCATED  NEAR THE SOUTHEAST CORNER OF THE  INTERSECTION OF SAN PEDRO DR. &  PASEO DEL NORTE BLVD. NE					
C.O.A. BM 11-N18  ELEV. 5235.67  A STANDARD BRASS TABLET STAMPED  "11-D18-1978" SET IN TOP OF A CONCRETE POST FLUSH WITH THE GROUND LOCATED NEAR THE SOUTHEAST CORNER OF THE INTERSECTION OF SAN PEDRO DR. & PASEO DEL NORTE BLVD. NE  PPROVED OR RECORD DRAWINGS  HIEF CONSTRUCTION FINGINEER DATE					
C.O.A. BM 11-N18 ELEV. 5235.67  A STANDARD BRASS TABLET STAMPED "11-D18-1978" SET IN TOP OF A CONCRETE POST FLUSH WITH THE GROUND LOCATED NEAR THE SOUTHEAST CORNER OF THE INTERSECTION OF SAN PEDRO DR. & PASEO DEL NORTE BLVD. NE  PPROVED OR RECORD DRAWINGS  HIEF CONSTRUCTION ENGINEER DATE  CITY ENGINEER  DATE					
C.O.A. BM 11-N18  A STANDARD BRASS TABLET STAMPED  "11-D18-1978" SET IN TOP OF A CONCRETE  POST FLUSH WITH THE GROUND LOCATED  NEAR THE SOUTHEAST CORNER OF THE  INTERSECTION OF SAN PEDRO DR. &  PASEO DEL NORTE BLVD. NE  PASEO DEL NORTE BLVD. NE  CITY OF ALBUQUERQUE  APPROVALS ENGINEER DATE TITLE-					
C.O.A. BM 11-N18  A STANDARD BRASS TABLET STAMPED "11-D18-1978" SET IN TOP OF A CONCRETE POST FLUSH WITH THE GROUND LOCATED NEAR THE SOUTHEAST CORNER OF THE INTERSECTION OF SAN PEDRO DR. & PASEO DEL NORTE BLVD. NE  PPROVED FOR CONSTRUCTION HIEF CONSTRUCTION ENGINEER DATE  CITY OF ALBUQUERQUE  APPROVALS  ENGINEER DATE  TITLE:  NEW MEXICO ACTIVITIES ASSOCIATION					
C.O.A. BM 11-N18  A STANDARD BRASS TABLET STAMPED "11-D18-1978" SET IN TOP OF A CONCRETE POST FLUSH WITH THE GROUND LOCATED NEAR THE SOUTHEAST CORNER OF THE INTERSECTION OF SAN PEDRO DR. & PASEO DEL NORTE BLVD. NE  PPROVED OR RECORD DRAWINGS  HIEF CONSTRUCTION ENGINEER DATE  CITY OF ALBUQUERQUE  APPROVALS  ENGINEER DATE  TITLE:  NEW MEXICO  ACCUMUNICATION  TO STANDARD BRASS TABLET STAMPED "11-D18-1978" SET IN TOP OF A CONCRETE POST FLUSH WITH THE GROUND LOCATED NEAR THE SOUTHEAST CORNER OF THE INTERSECTION OF SAN PEDRO DR. & PASEO DEL NORTE BLVD. NE  CITY OF ALBUQUERQUE  TITLE:  NEW MEXICO  ACCUMUNICATION  ACCUMUNI					

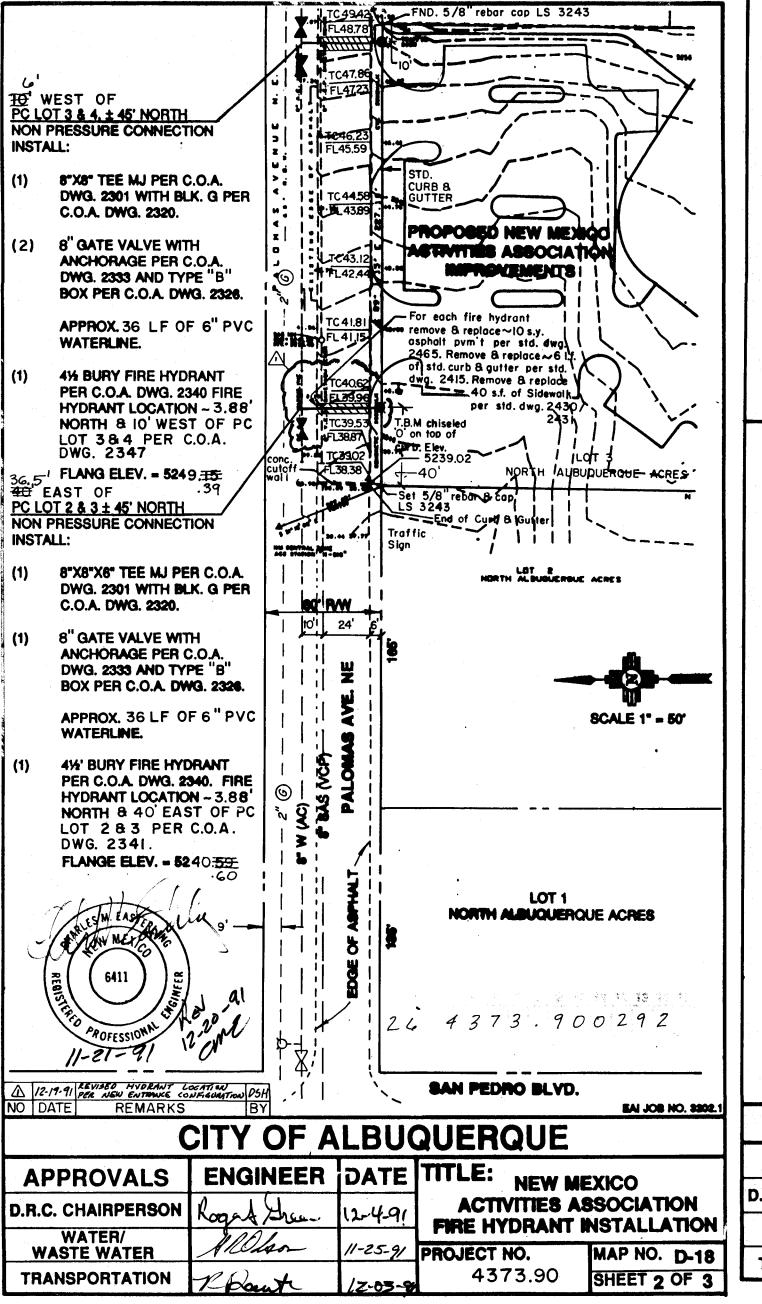

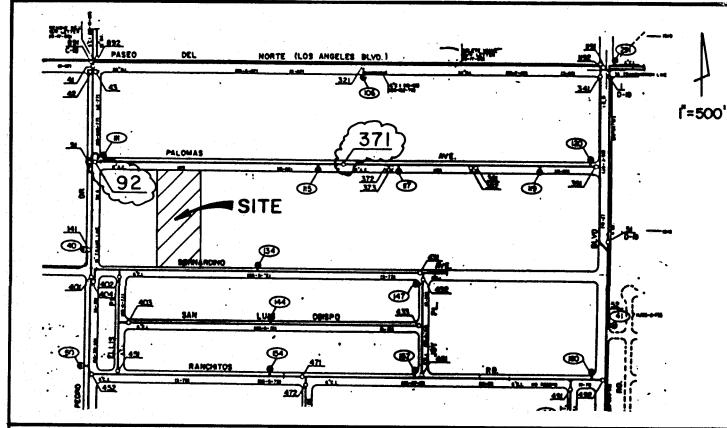


## WATER SHUT-OFF PLAN

## CONNECTIONS:

TO INSTALL NEW FIRE HYDRANTS - CLOSE VALVE 92 AND 371, NOTIFY EFFECTED USERS, CUT EXISTING 8" AC LINE AND MAKE REQUIRED CONNECTION.

## GENERAL NOTES:

- 1. CONTRACTOR SHALL SCHEDULE AND COORDINATE ALL WATER SYSTEM SHUT-OFFS AND CONNECTIONS WITH CITY OF ALBUQUERQUE WATER SYSTEMS AT 857-8200 A MINIMUM OF THREE (3) BUSINESS DAYS PRIOR TO PLANNED WATER SHUT-OFF DATE.
- 2. ONLY CITY OF ALBUQUERQUE WATER SYSTEMS PERSONNEL SHALL OPERATE WATER SYSTEM VALVES AND HYDRANTS. CITY OF ALBUQUERQUE PERSONNEL WILL IMPLEMENT THE WATER SHUT-OFF PLAN FOR THE CONTRACTOR BY OPENING AND CLOSING THE REQUIRED VALVES BEFORE AND AFTER THE CONNECTION IS MADE.
- 3. IN THE EVENT EMERGENCY SHUT-OFFS ARE REQUIRED DUE TO LEAKS OR BREAKS IN WATERLINES RESULTING FROM CONSTRUCTION ACTIVITIES, THE CONTRACTOR SHALL IMMEDIATELY NOTIFY THE CITY OF ALBUQUERQUE WATER SYSTEMS ENGINEER. THE CONTRACTOR SHALL COOPERATE FULLY WITH THE WATER SYSTEMS DEPARTMENT. THE CONTRACTOR SHALL NOTIFY ALL AFFECTED USERS OF THE EMERGENCY SHUT-OFF, AND THE ESTIMATED TIME SERVICE WILL BE RESTORED.

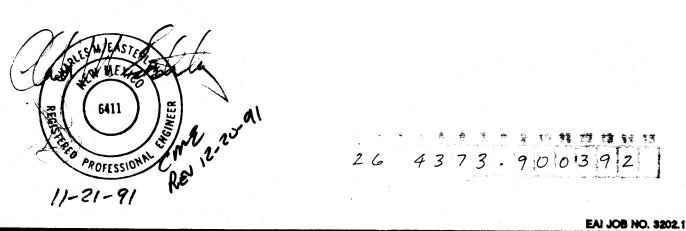

CITY OF ALBUQUERQUE

APPROVALS	<b>ENGINEER</b>	DATE	ACTIVITIES ASSOCIATION		
R.C. CHAIRPERSON	Roged Street	12-4-91			
WATER/ WASTE WATER	AlOka	11-25-91		MAP NO. D-18	
TRANSPORTATION	Dout	12.03-9	4373.90	SHEET 3 OF 3	

SCANNED BY BY LASON