

GENERAL NOTES

1. ALL WORK DETAILED ON THESE PLANS TO BE PERFORMED UNDER CONTRACT SHALL, EXCEPT AS OTHERWISE STATED OR PROVIDED FOR HEREON, BE CONSTRUCTED IN ACCORDANCE WITH THE CITY OF ALBUQUERQUE STANDARD SPECIFICATIONS--PUBLIC WORKS CONSTRUCTION--1986.
 2. ALL WORK ON THIS PROJECT SHALL BE PERFORMED IN ACCORDANCE WITH APPLICABLE FEDERAL, STATE AND LOCAL LAWS, RULES AND REGULATIONS CONCERNING CONSTRUCTION SAFETY AND HEALTH.
 3. UTILITIES LOCATIONS AS SHOWN ON THESE DRAWINGS ARE APPROXIMATE. IT IS POSSIBLE THAT THE EXACT LOCATION OF LINES AND UTILITY CONNECTION POINTS IN THE IMMEDIATE VICINITY OF THE PROPOSED SITE MAY BE SLIGHTLY DIFFERENT FROM THE LOCATION SHOWN ON THESE DRAWINGS. PRIOR TO CONSTRUCTION, THE CONTRACTOR SHALL EXCAVATE AND VERIFY THE HORIZONTAL AND VERTICAL LOCATIONS OF ALL EXISTING UTILITIES. SHOULD A CONFLICT EXIST, THE CONTRACTOR SHALL NOTIFY THE ENGINEER SO THAT THE CONFLICT CAN BE RESOLVED WITH A MINIMUM AMOUNT OF DELAY.
 4. SHOULD A CONFLICT EXIST BETWEEN THESE PLANS AND ACTUAL FIELD CONDITIONS, THE CONTRACTOR SHALL PROMPTLY NOTIFY THE ENGINEER IN WRITING SO THAT THE CONFLICT CAN BE RESOLVED WITH A MINIMUM AMOUNT OF DELAY FOR ALL PARTIES.
 5. THE CONTRACTOR SHALL MAINTAIN ACCESS TO ADJACENT PROPERTIES DURING CONSTRUCTION.
 6. THREE (3) WORKING DAYS PRIOR TO BEGINNING CONSTRUCTION, THE CONTRACTOR SHALL SUBMIT TO THE CONSTRUCTION COORDINATION DIVISION A DETAILED CONSTRUCTION SCHEDULE. TWO (2) WORKING DAYS PRIOR TO CONSTRUCTION, THE CONTRACTOR SHALL OBTAIN A BARRICADING PERMIT FROM THE CONSTRUCTION COORDINATION DIVISION. CONTRACTOR SHALL NOTIFY THE BARRICADE ENGINEER (768-2551) PRIOR TO OCCUPYING AN INTERSECTION. SEE SECTION 19 OF THE SPECIFICATIONS.
- ALL STREET STRIPING ALTERED OR DESTROYED SHALL BE REPLACED BY THE CONTRACTOR TO THE EXISTING PATTERNS OR AS INDICATED BY THIS PLAN SET.
7. TWO (2) WORKING DAYS PRIOR TO ANY EXCAVATION, CONTRACTOR MUST CONTACT LINE LOCATING SERVICE AT 260-1990 FOR LOCATION OF EXISTING UTILITIES.



CONSTRUCTION PLANS FOR LOMAS/WASHINGTON DRAINAGE IMPROVEMENTS

PUBLIC WORKS DEPARTMENT
CITY OF ALBUQUERQUE



INDEX TO DRAWINGS

SHEET NO.	TITLE
1	COVER SHEET
2	STORM DRAINAGE PLAN
3	CURB, GUTTER & PAVING DETAILS

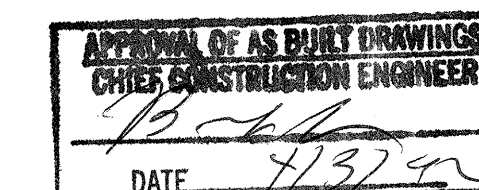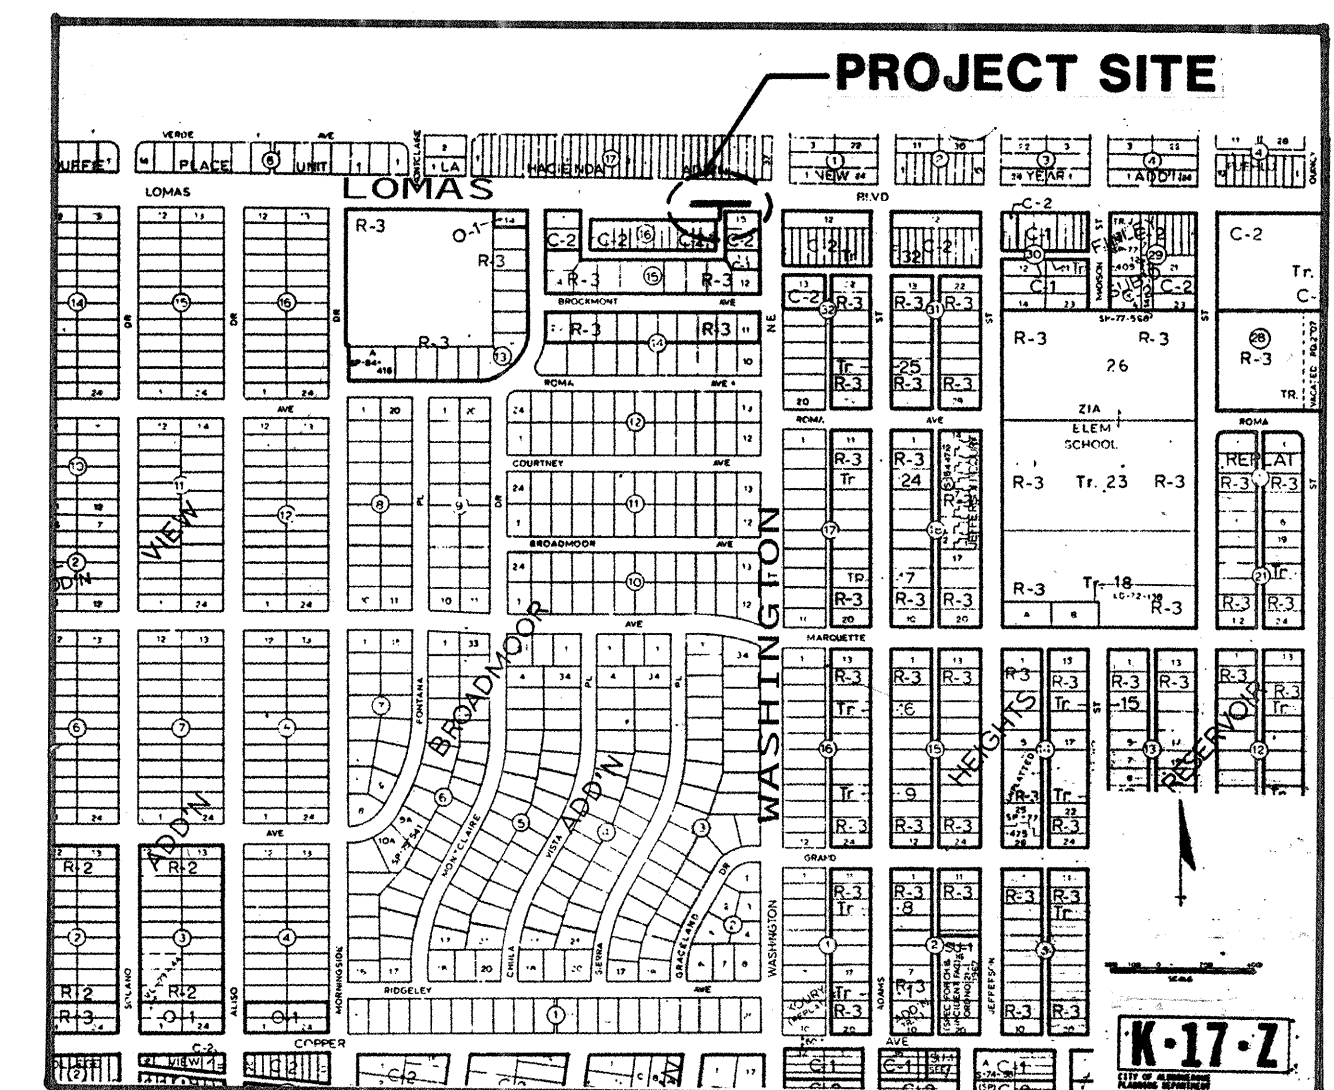


VICINITY MAP
1"=600'±

REV.	SHEETS	CITY ENGR.	DATE	USER DEPT.	DATE	USER DEPT.	DATE
APPROVAL OF REVISIONS							

1 2 3 4 5 6 7 8 9 10 11 12 13 14 15
26 43 75 90 01 92

		APPROVED FOR CONSTRUCTION <i>Isaacson & Arfman</i> 11/17/92
	PROJECT NO. 4375.90	SHEET 1 OF 3

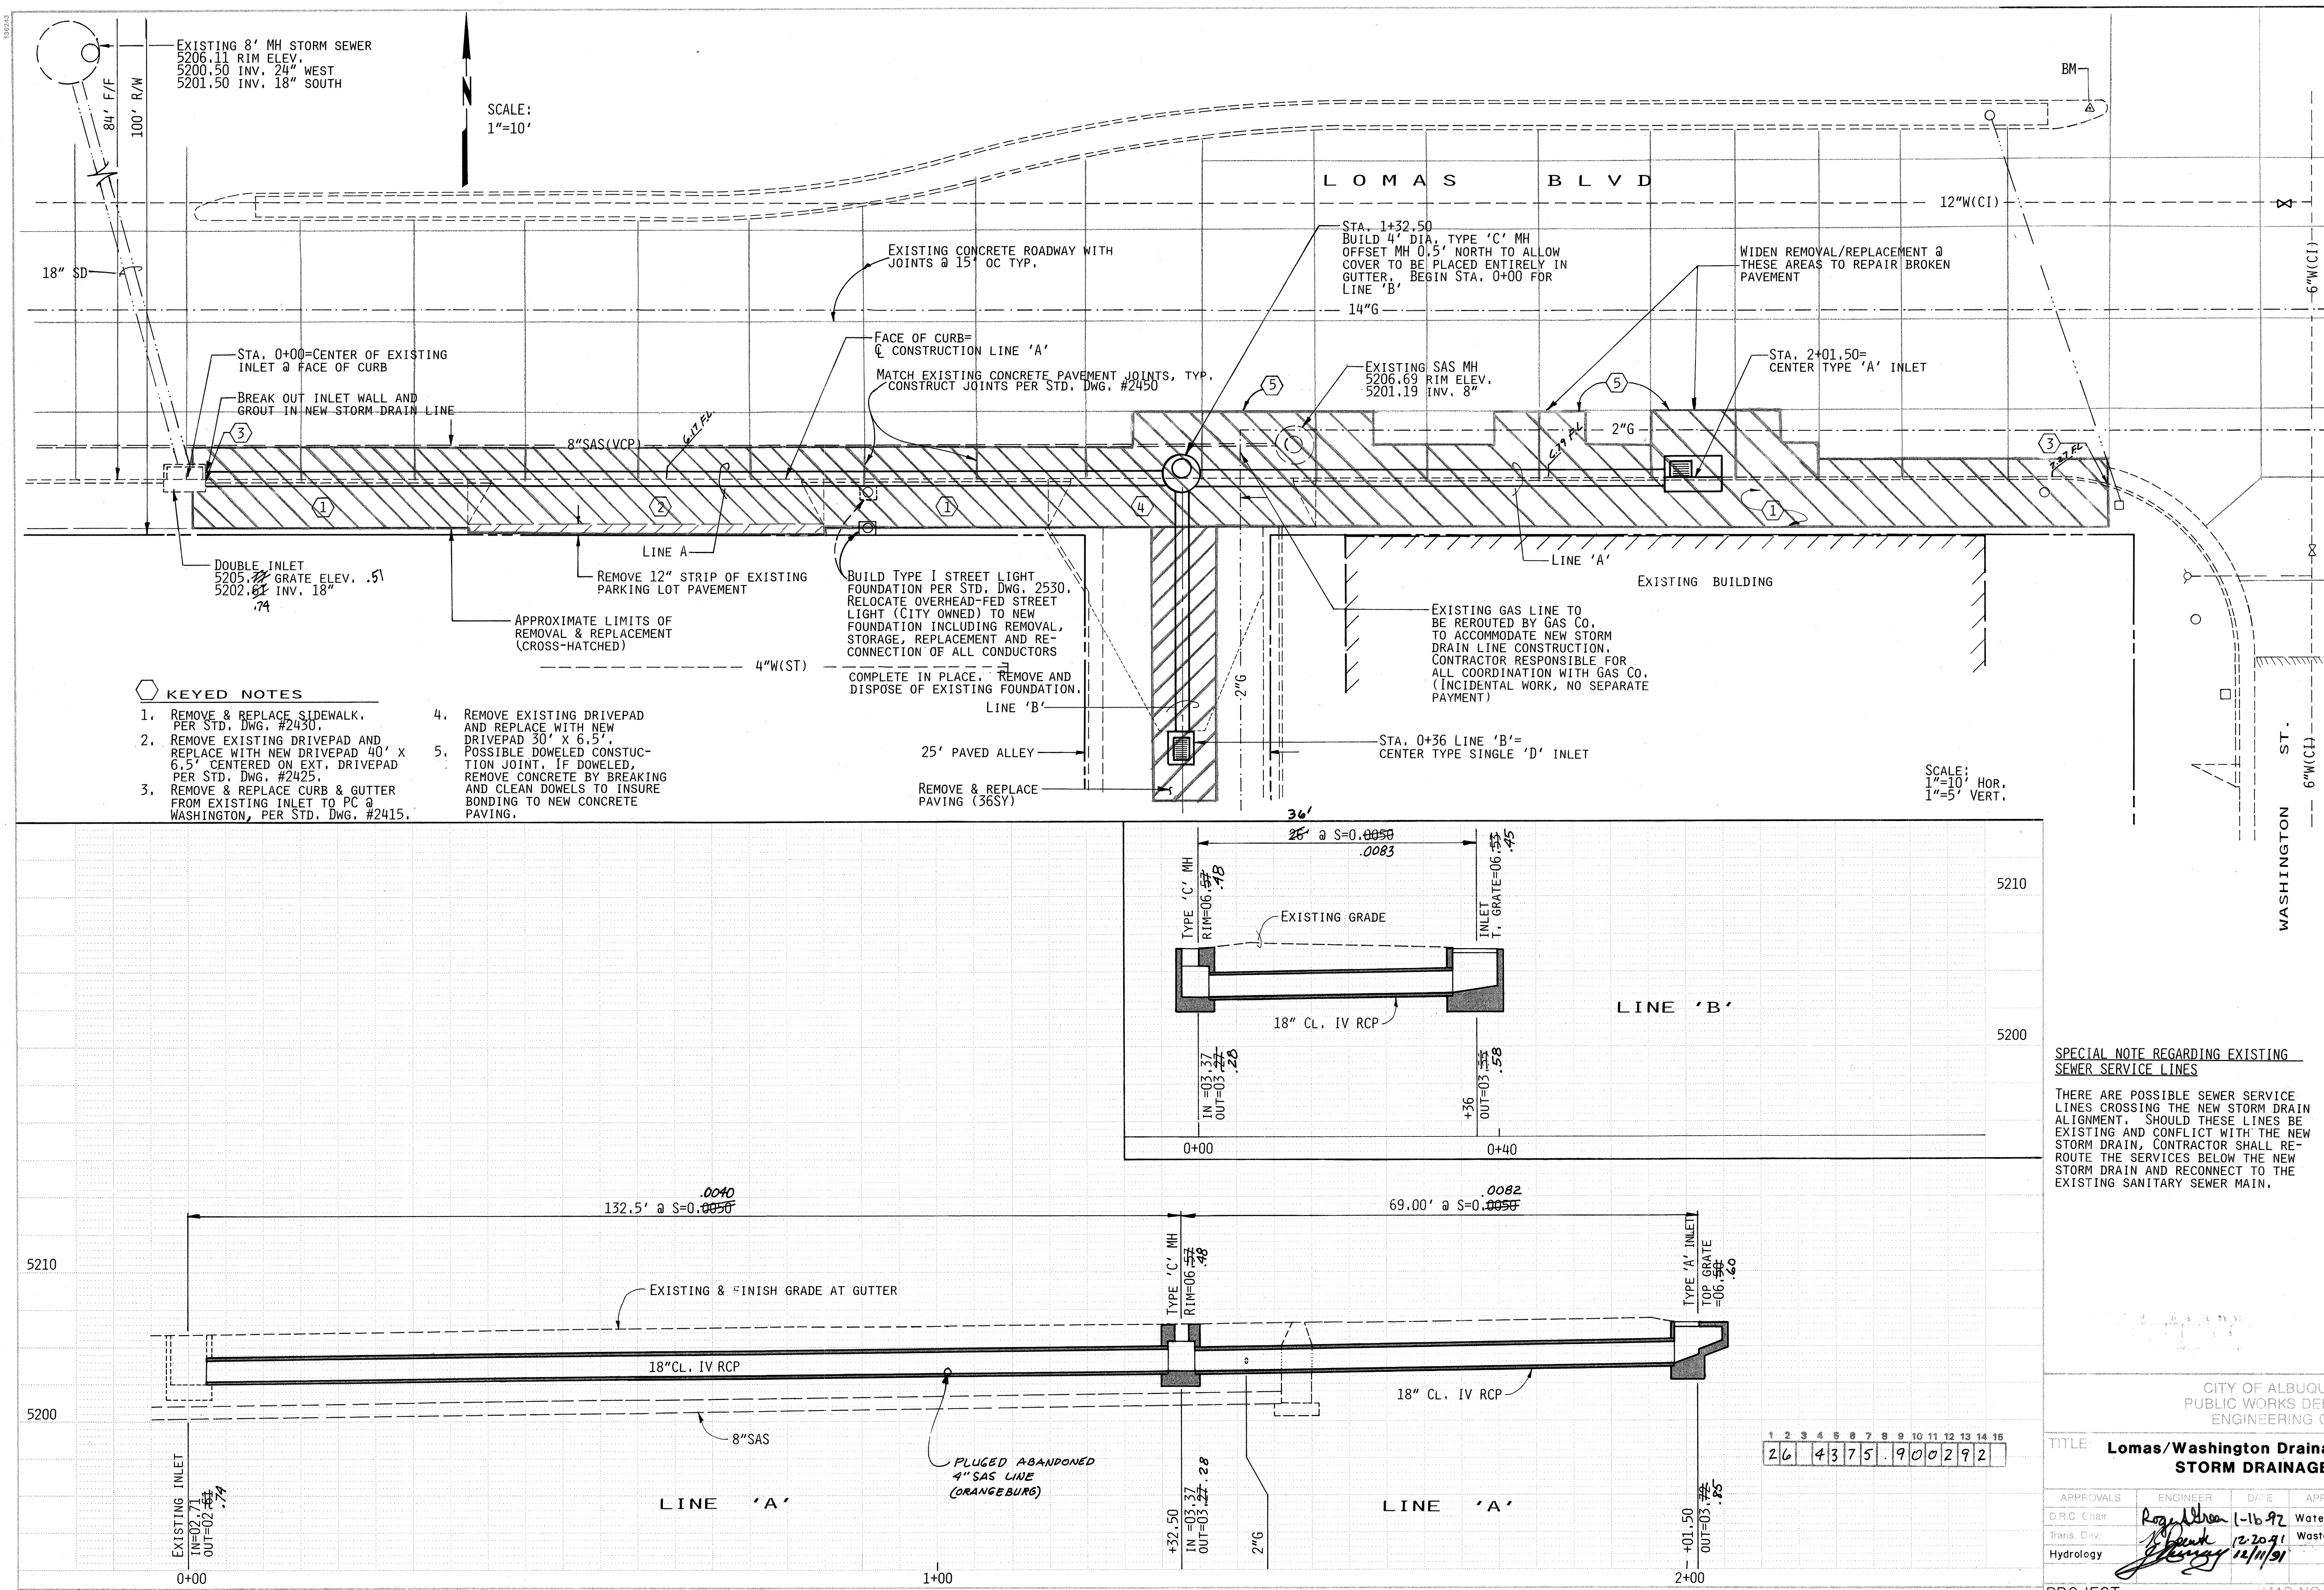

AS BUILT INFORMATION

CONTRACTOR: M.C.C. INC.

DATE: 3/92

INSPECTOR'S NAME: L. Romero

DATE: 3/92

FIELD ENGINEER: L. Romero

DATE: 3/92

VERIFICATION BY: L. Romero

DATE: 3/92

CORRECTED BY:

DATE:

RECORDED BY:

NO:

BENCH MARKS

ACS MONUMENT 9-117, WEST MEDIAN NOSE @ INTERSECTION OF WASHINGTON & LOMAS, ELEV. = 5208.28

SURVEY INFORMATION

FIELD NOTES

BY: J. GUTIERREZ

DATE: 9/91

NO. 1.

ENGINEER'S SEAL

REVISIONS


NO.	DATE	REMARKS	DESIGN	DATE
TO1	10/91			
NV	10/91			
TO1	10/91			

CITY OF ALBUQUERQUE
PUBLIC WORKS DEPARTMENT
ENGINEERING GROUP

TITLE: **Lomas/Washington Drainage Improvements
STORM DRAINAGE PLAN**


APPROVALS	ENGINEER	DATE	APPROVALS	ENGINEER	DATE
D.R.G. Chair	Rogelio	1-16-92	Water	Wolton	1-3-92
Trans. Div.	Sherry	12/20/91	Wastewater	AND	"
Hydrology	Sherry	12/11/91			

PROJECT NO. 4375.90 MAP NO. K-17 SHEET 2 OF 3

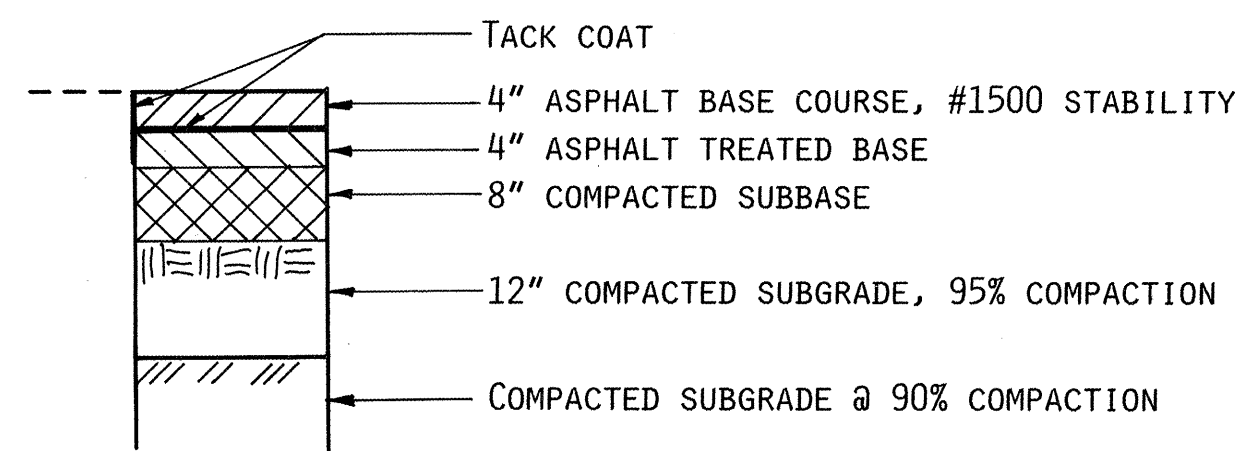

PAVEMENT REPLACEMENT AT ALLEY

NO SCALE

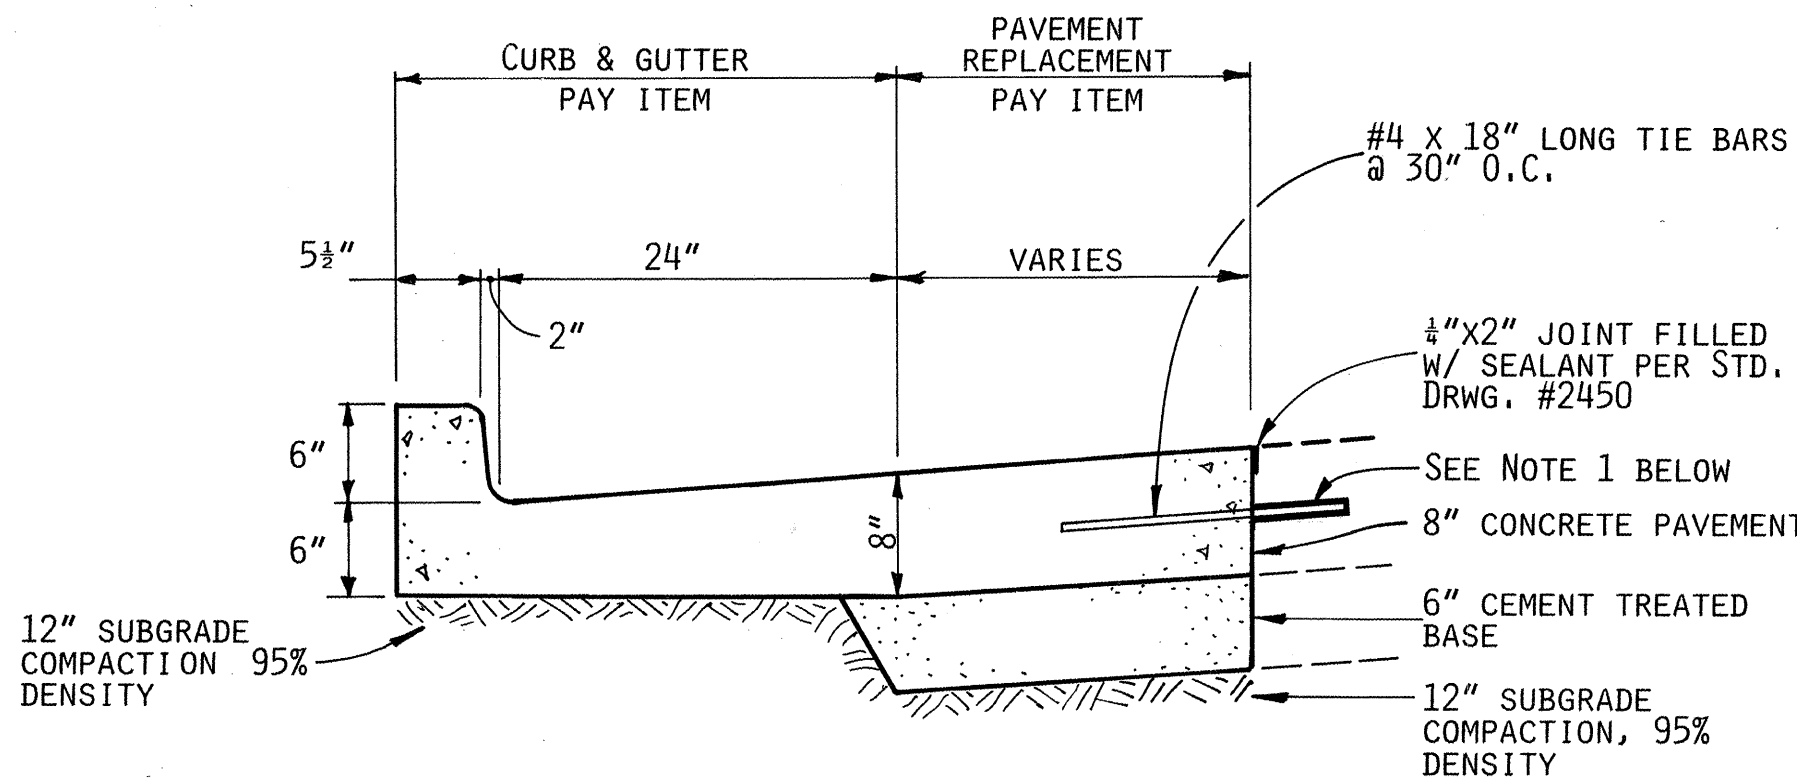


INTEGRAL CURB, GUTTER & PAVING

NO SCALE

NOTE :

1. DRILL 3/4" DIA. X 6" DEEP HOLES IN EXISTING CONCRETE, FLUSH CLEAN WITH AIR OR WATER, AND GROUT TIE BARS USING 2-PART EPOXY PASTE, REZI-WELD GEL PASTE(W.R. MEADOWS, INC) OR DURALCRETE EPOXY ADHESIVE CARTRIDGE SYSTEM, OR APPROVED EQUAL.

SCALE:
1"=10' HOR.
1"= 1' VERT.

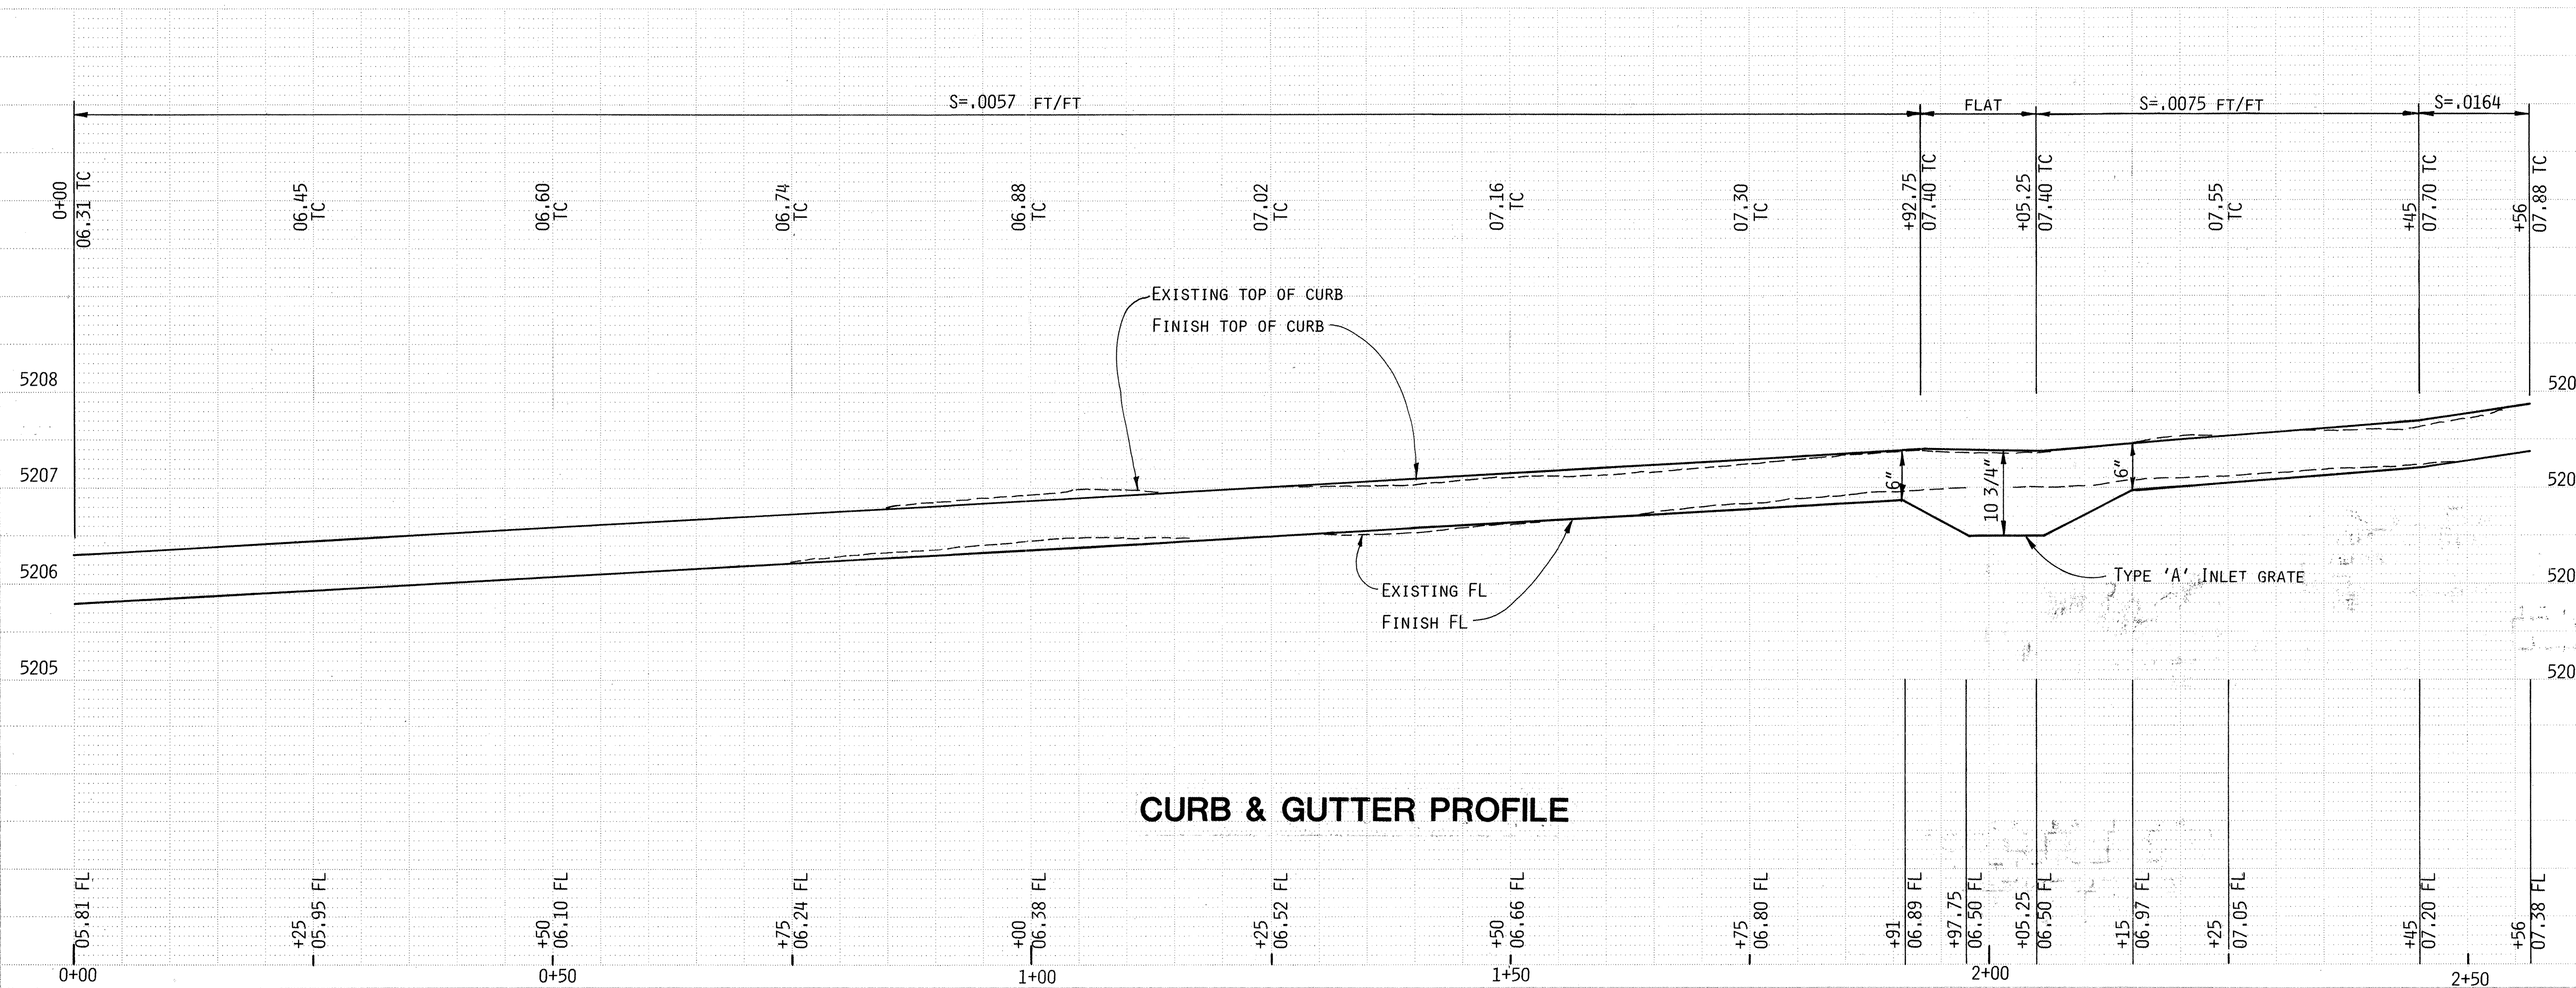

CURB & GUTTER PROFILE

CITY OF ALBUQUERQUE PUBLIC WORKS DEPARTMENT ENGINEERING GROUP							
TITLE: Lomas/Washington Drainage Improvements							
CURB, GUTTER & PAVING DETAILS							
APPROVALS	ENGINEER	DATE	APPROVALS	ENGINEER	DATE		
D.R.C. Chair	<i>Rogal</i>	1-16-92	Water	<i>MCD</i>	1-3-92		
Trans. Dev.	<i>Rogal</i>	1-29-92	Wastewater	<i>AKD</i>	"		
Hydrology	<i>Rogal</i>	12/1/91					
PROJECT NO.		4375.90		MAP NO.		K-17	
SHEET		3		OF		3	

AS BUILT INFORMATION		BENCH MARKS		SURVEY INFORMATION		ENGINEER'S SEAL	
CONTRACTOR	M.C.C. INC.	ACS MONUMENT	9-J17, WEST MEDIAN NOSE @ INTERSECTION OF WASHINGTON & LOMAS, ELEV.=5208.28	NO.	1	BY	J. GUTIERREZ
WORK BY	C.O.A.	DATE	9/91	NO.		BY	
INSPECTOR	C. Romero	DATE	3/92	NO.		BY	
FIELD SUPERVISOR	C. Romero	DATE	3/92	NO.		BY	
DRAWINGS		DATE		NO.		BY	
CORRECTIONS		DATE		NO.		BY	
MICRO-FILM INFORMATION		RECORDS BY		DATE			