

PER THE TERMS OF THE WATER/SANITARY SEWER AVAILABILITY LETTER (09/28/89), WATER SERVICE TO EITHER LOT 4A1 OR 4A2 WILL BE CONDITIONED UPON THE FOLLOWING:

1. SANITARY SEWER SERVICE BEING TAKEN AT THE SAME TIME, AND
2. ALL WORK SHOWN ON THIS PLAN BEING COMPLETED AND ACCEPTED BY THE CITY OF ALBUQUERQUE.

CONSTRUCTION NOTES

- A. METER BOX, COVER & LID.
- B. CONTRACTION JOINT.
- C. CURB STOP & BOX FOR SINGLE METER.
- D. LOCATION OF CURB STOP & BOX FOR DOUBLE METERS.




CAUTION:
THIS DRAWING DOES NOT INCLUDE NECESSARY COMPONENTS FOR
CONSTRUCTION SAFETY WHICH SHALL REMAIN THE RESPONSIBILITY
OF THE CONTRACTOR.

SCANNED BY
BY LASON

910911

I, Jeffrey G. Mortensen, Registered Professional Engineer in the State of New Mexico, do hereby certify that this "as-built" information was obtained by me or under my supervision and represents the "as-built" conditions of this project, and is true and correct to the best of my knowledge and belief. All vertical and horizontal dimensions should be field verified prior to use on future projects.

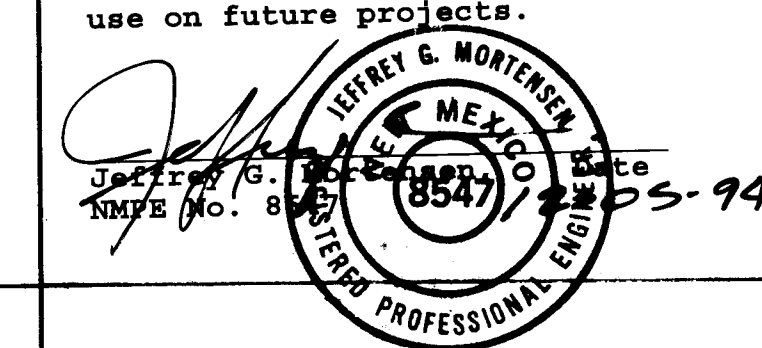

APPROVED FOR
CONSTRUCTION

J. D. Lusby
CITY ENGINEER

9-22-94
DATE

for Ricardo Roybal

CITY OF ALBUQUERQUE
PUBLIC WORKS DEPARTMENT
ENGINEERING GROUP

TITLE: LIVELY / J-H SUPPLY
WATER SERVICE INSTALLATIONS
1000 & 1500 OSUNA ROAD N.E.

APPROVALS	ENGINEER	DATE	APPROVALS	ENGINEER	DATE
ORC CHAIRMAN	<i>Roger A. Kline</i>	7-10-92	WATER	<i>W. A. Kline</i>	6-24-92
TRANSPORTATION	<i>John A. Kline</i>	6-25-92	WASTE WATER	<i>W. A. Kline</i>	"
HYDROLOGY	<i>John A. Kline</i>	6-25-92			
PROJECT NO.	4389.90	MAP NO.	E - 16	SHEET	1 OF 1