
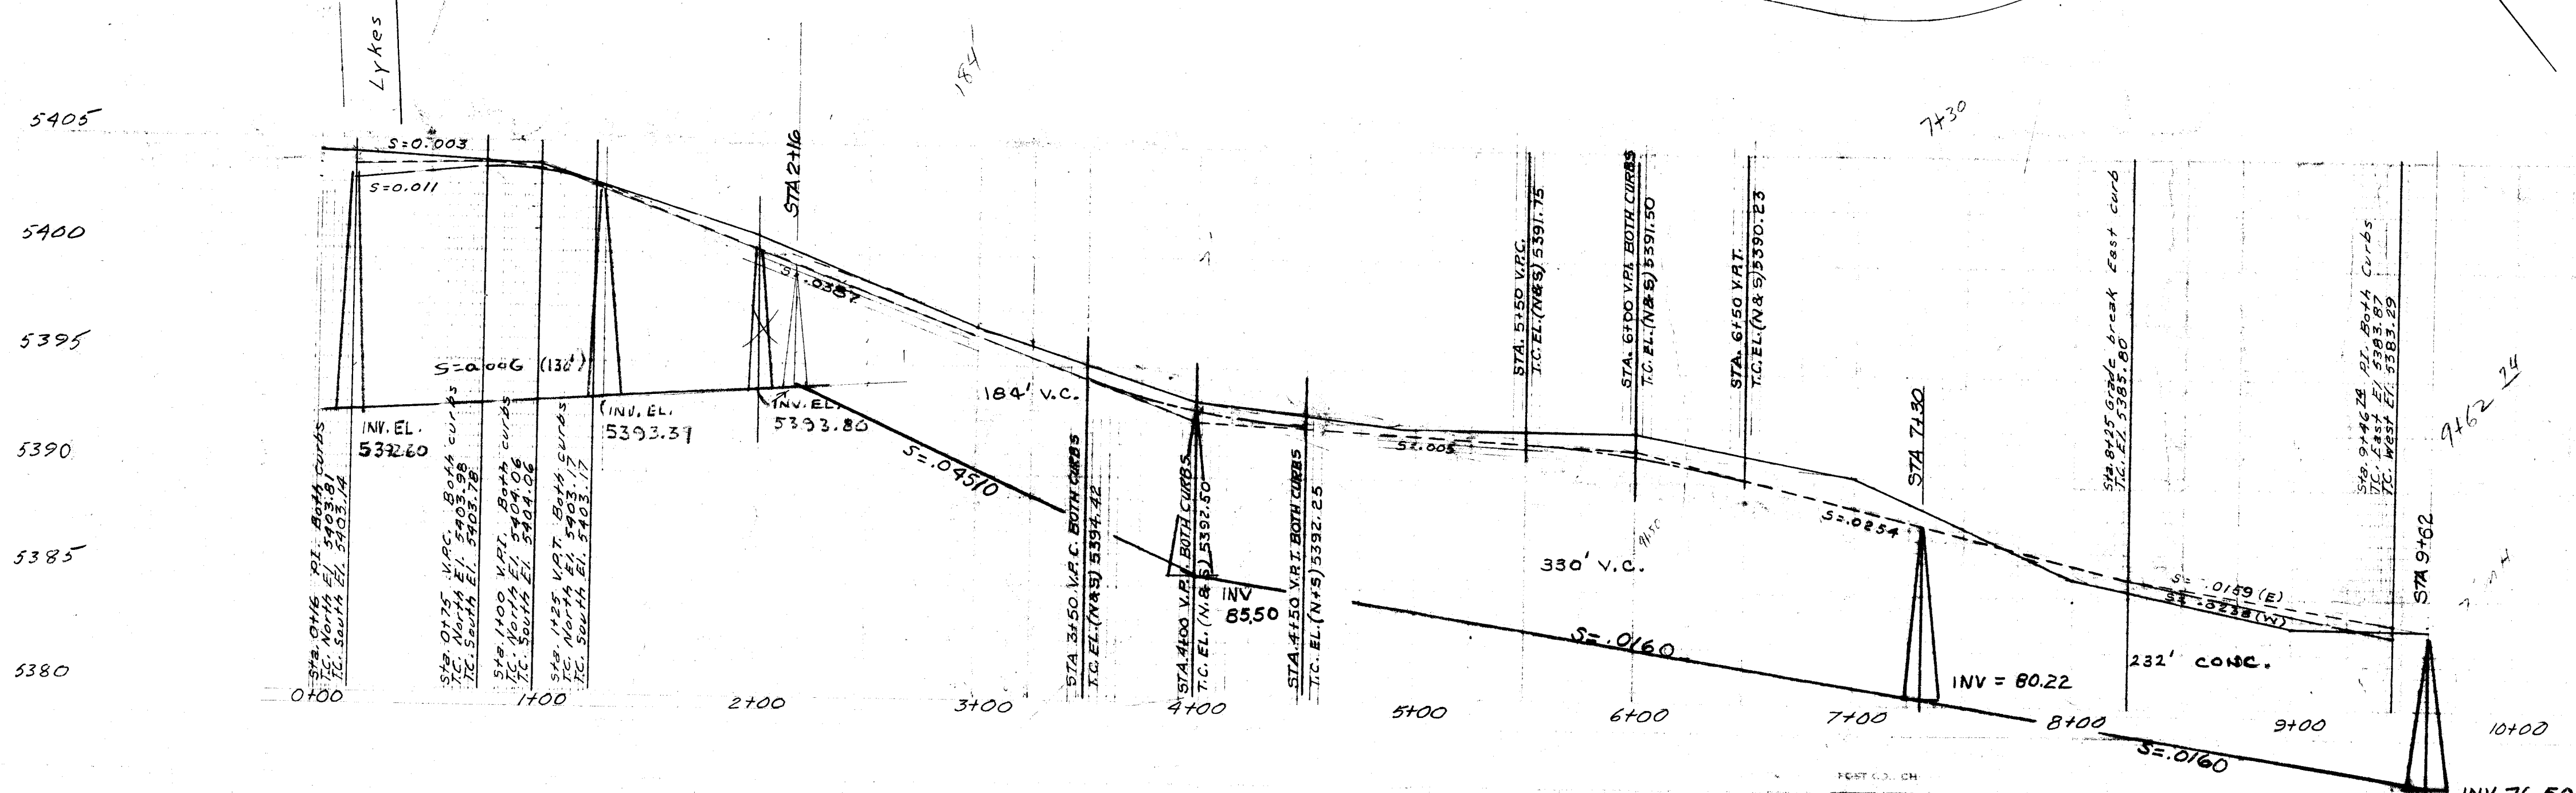


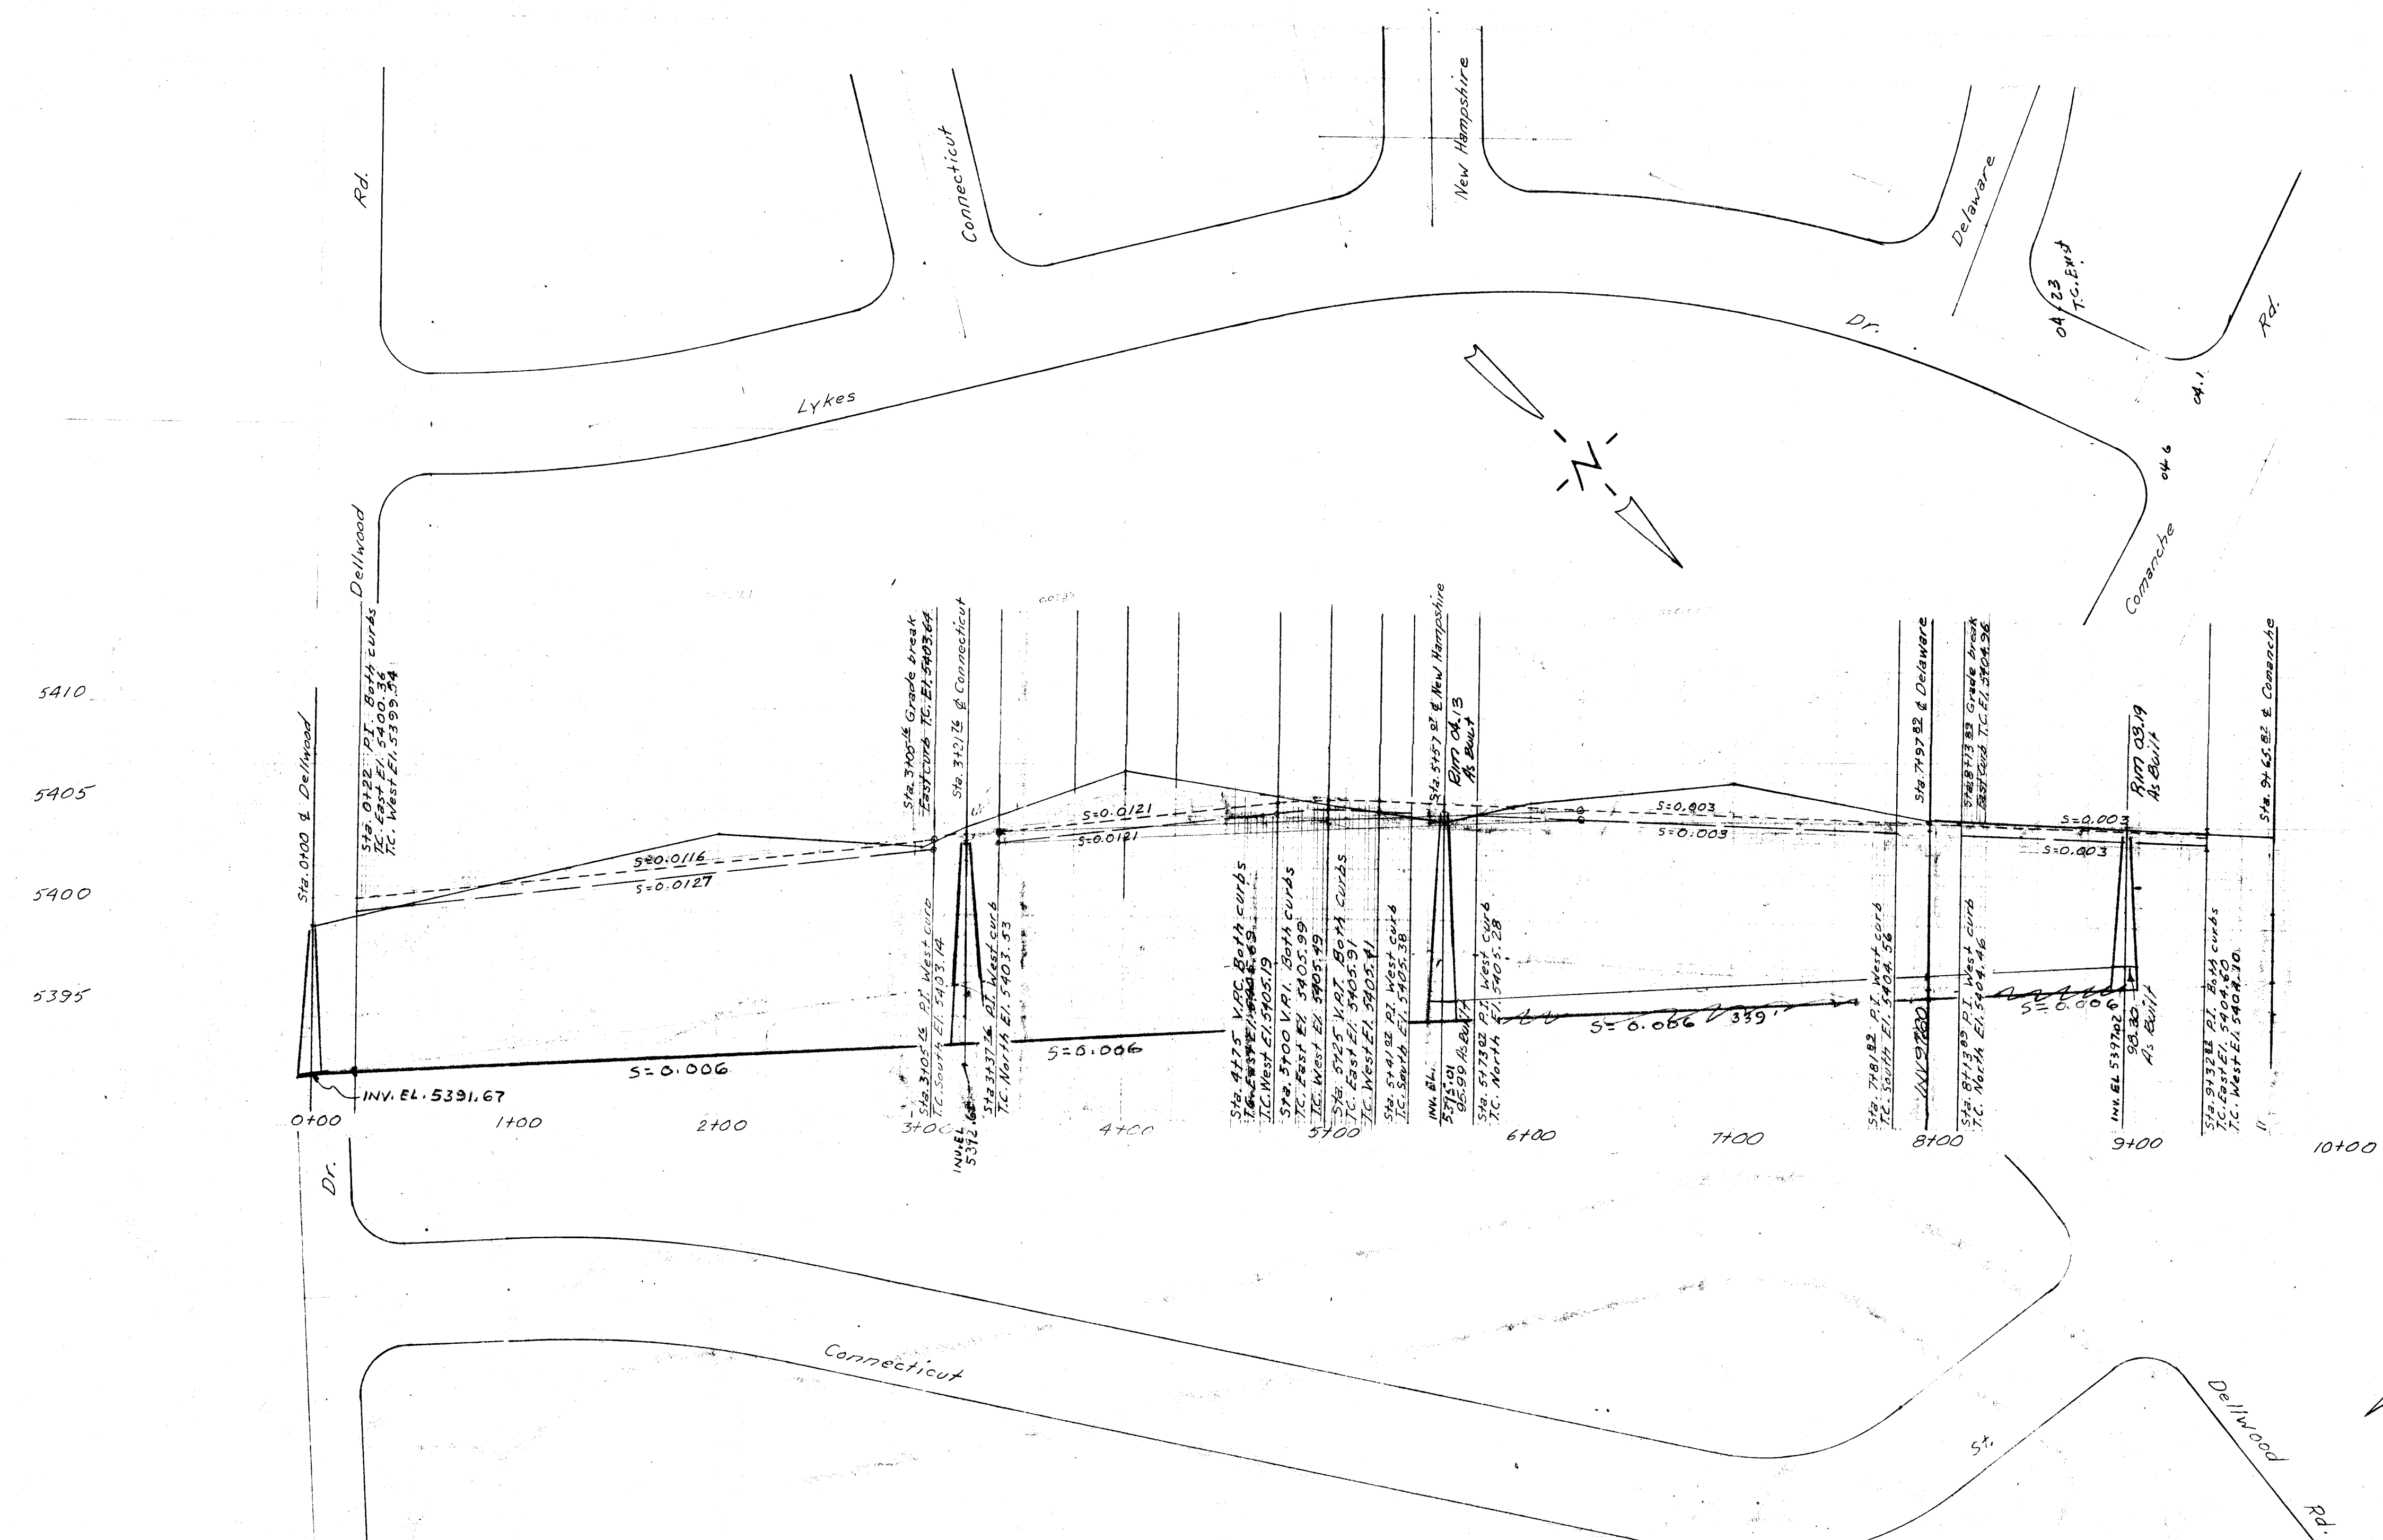

043	94	01	59	01	01	60	192
01							

SCANNED BY
BY LASON

Sewer Recommended CBR
OCT 29 59

REV. BY		DATE	
CITY OF ALBUQUERQUE NEW MEXICO DEPARTMENT OF PUBLIC WORKS FIELD & DESIGN DIVISION			
TITLE CURB GRADES - DELWOOD ADD.			
DESIGNED BY	DRAWN BY		
DATE	DATE		
RECOMMENDED BY	APPROVED BY		
DATE	DATE		
FILE NO.	SHEET		

ME-94