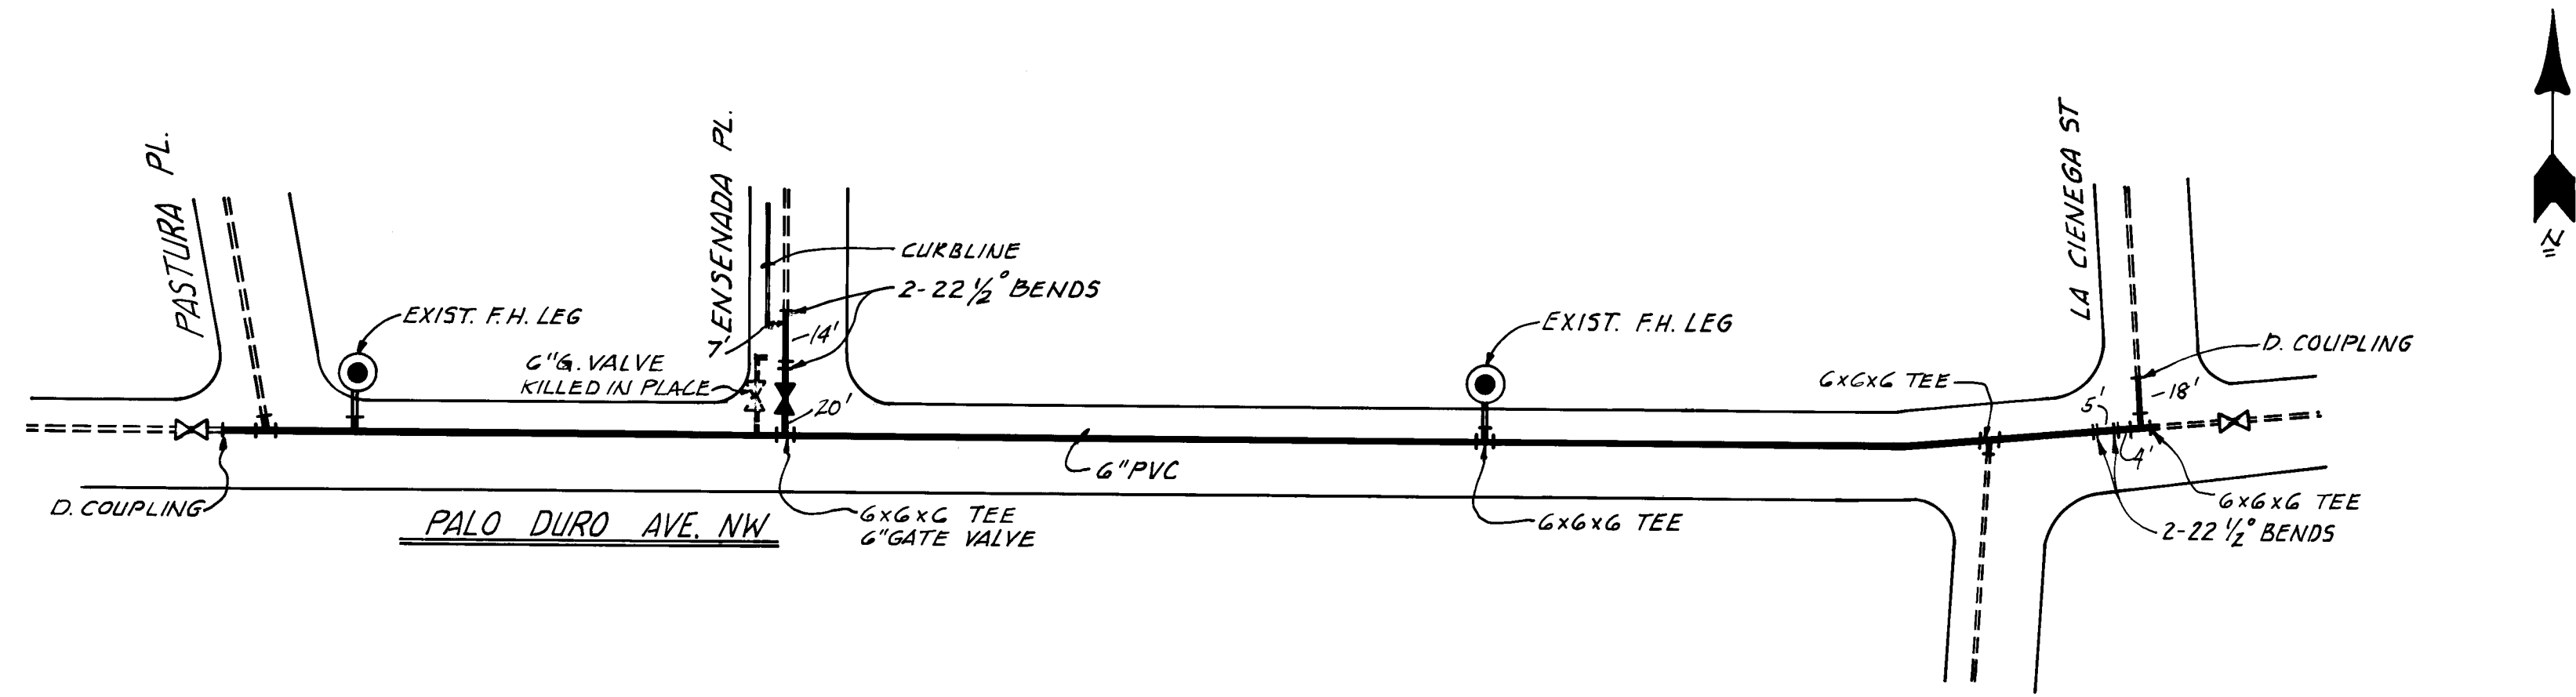


SCALE: NTS

NOTES:

WATERLINE WAS RELOCATED TO STREET SIDE OF CURB IN PALO DURO BETWEEN LA CIENEGA & PASTURA RD. NW. EXISTING LINE WAS KILLED IN PLACE. 27 SERVICES & 1" F.H. WERE TRANSFERRED.

26 4395.92 1994

APPROVAL OF AS BUILT DRAWINGS
CHIEF CONSTRUCTION ENGINEER
DATE 1-4-94
894 EN

CITY OF ALBUQUERQUE
MUNICIPAL DEVELOPMENT DEPARTMENT
ENGINEERING DIVISION

TITLE: PALO DURO W.L. REPLACEMENT

APPROVALS	ENGINEER	DATE	APPROVALS	ENGINEER	DATE
City Engineer			Liquid Waste		
A.C.E. - Design			Traffic		
A.C.E. - Hydrology			Water		

DRAWING NO. 4395.92 MAP NO. F-14 SHEET 1 OF 1

ENGINEER'S SEAL		SURVEY INFORMATION		BENCH MARKS		AS BUILT INFORMATION	
		FIELD NOTES				CONTRACTOR'S RECORD	
		NO.	BY	DATE		WORK	DATE
						STARTED BY	DATE
						ACCEPTANCE BY	DATE
						FIELD	DATE
						REVISIONS	DATE
						CORRECTED BY	DATE
						RECORDED BY	DATE
						NO.	DATE