
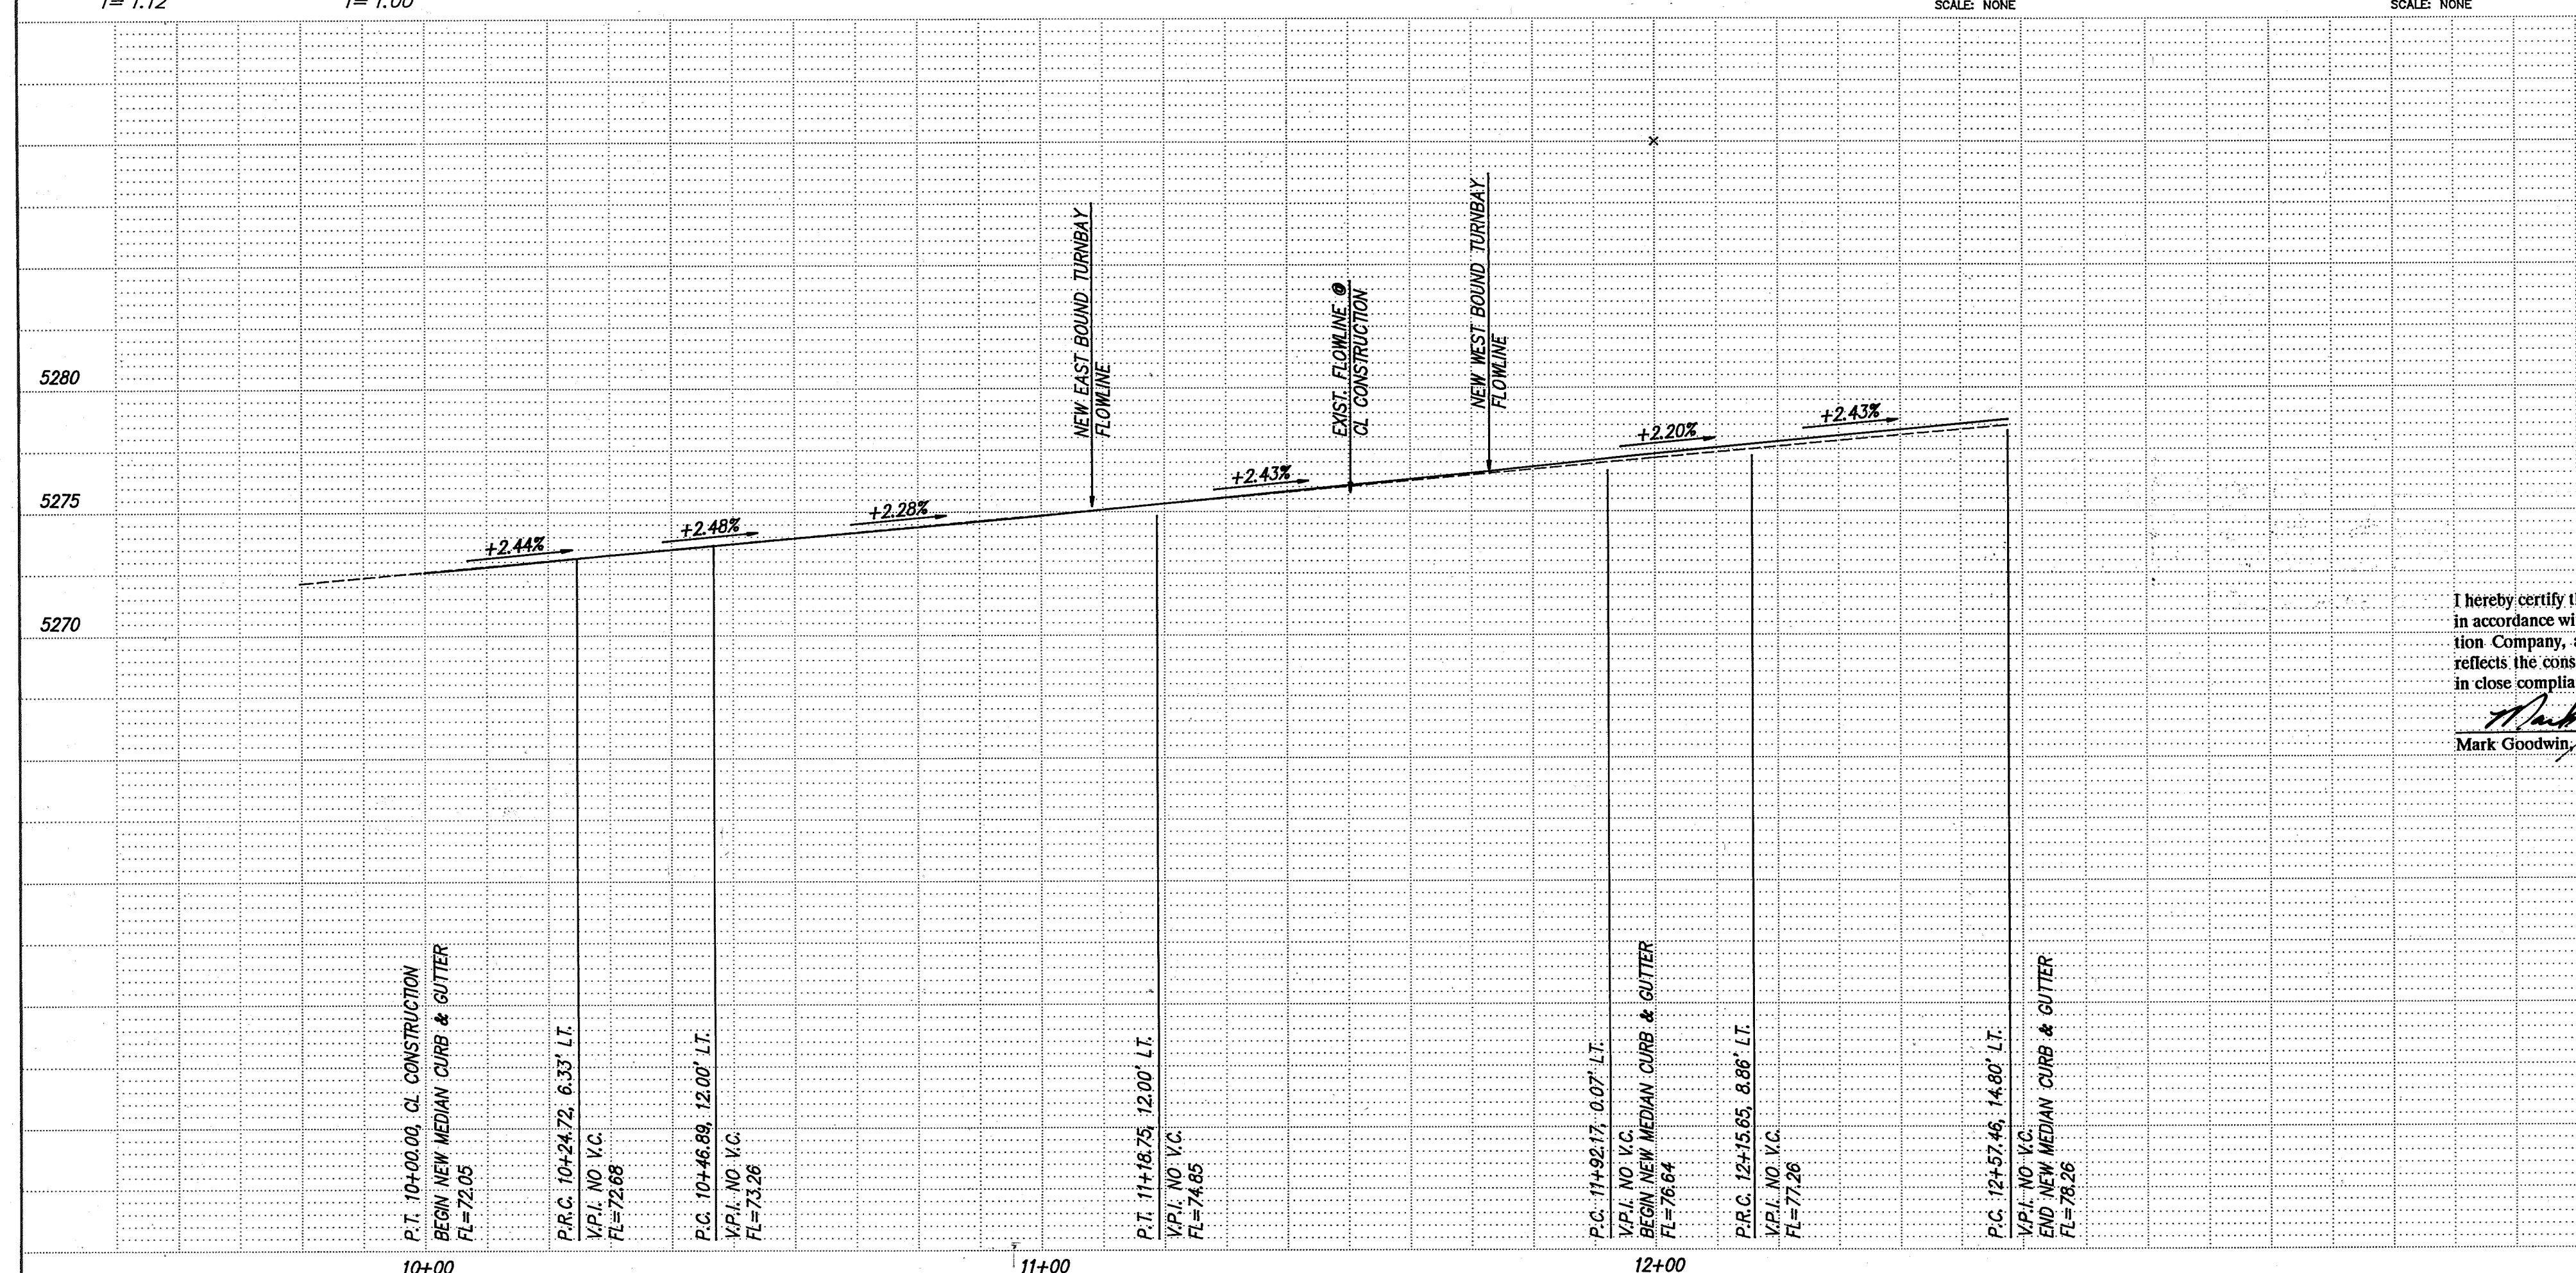


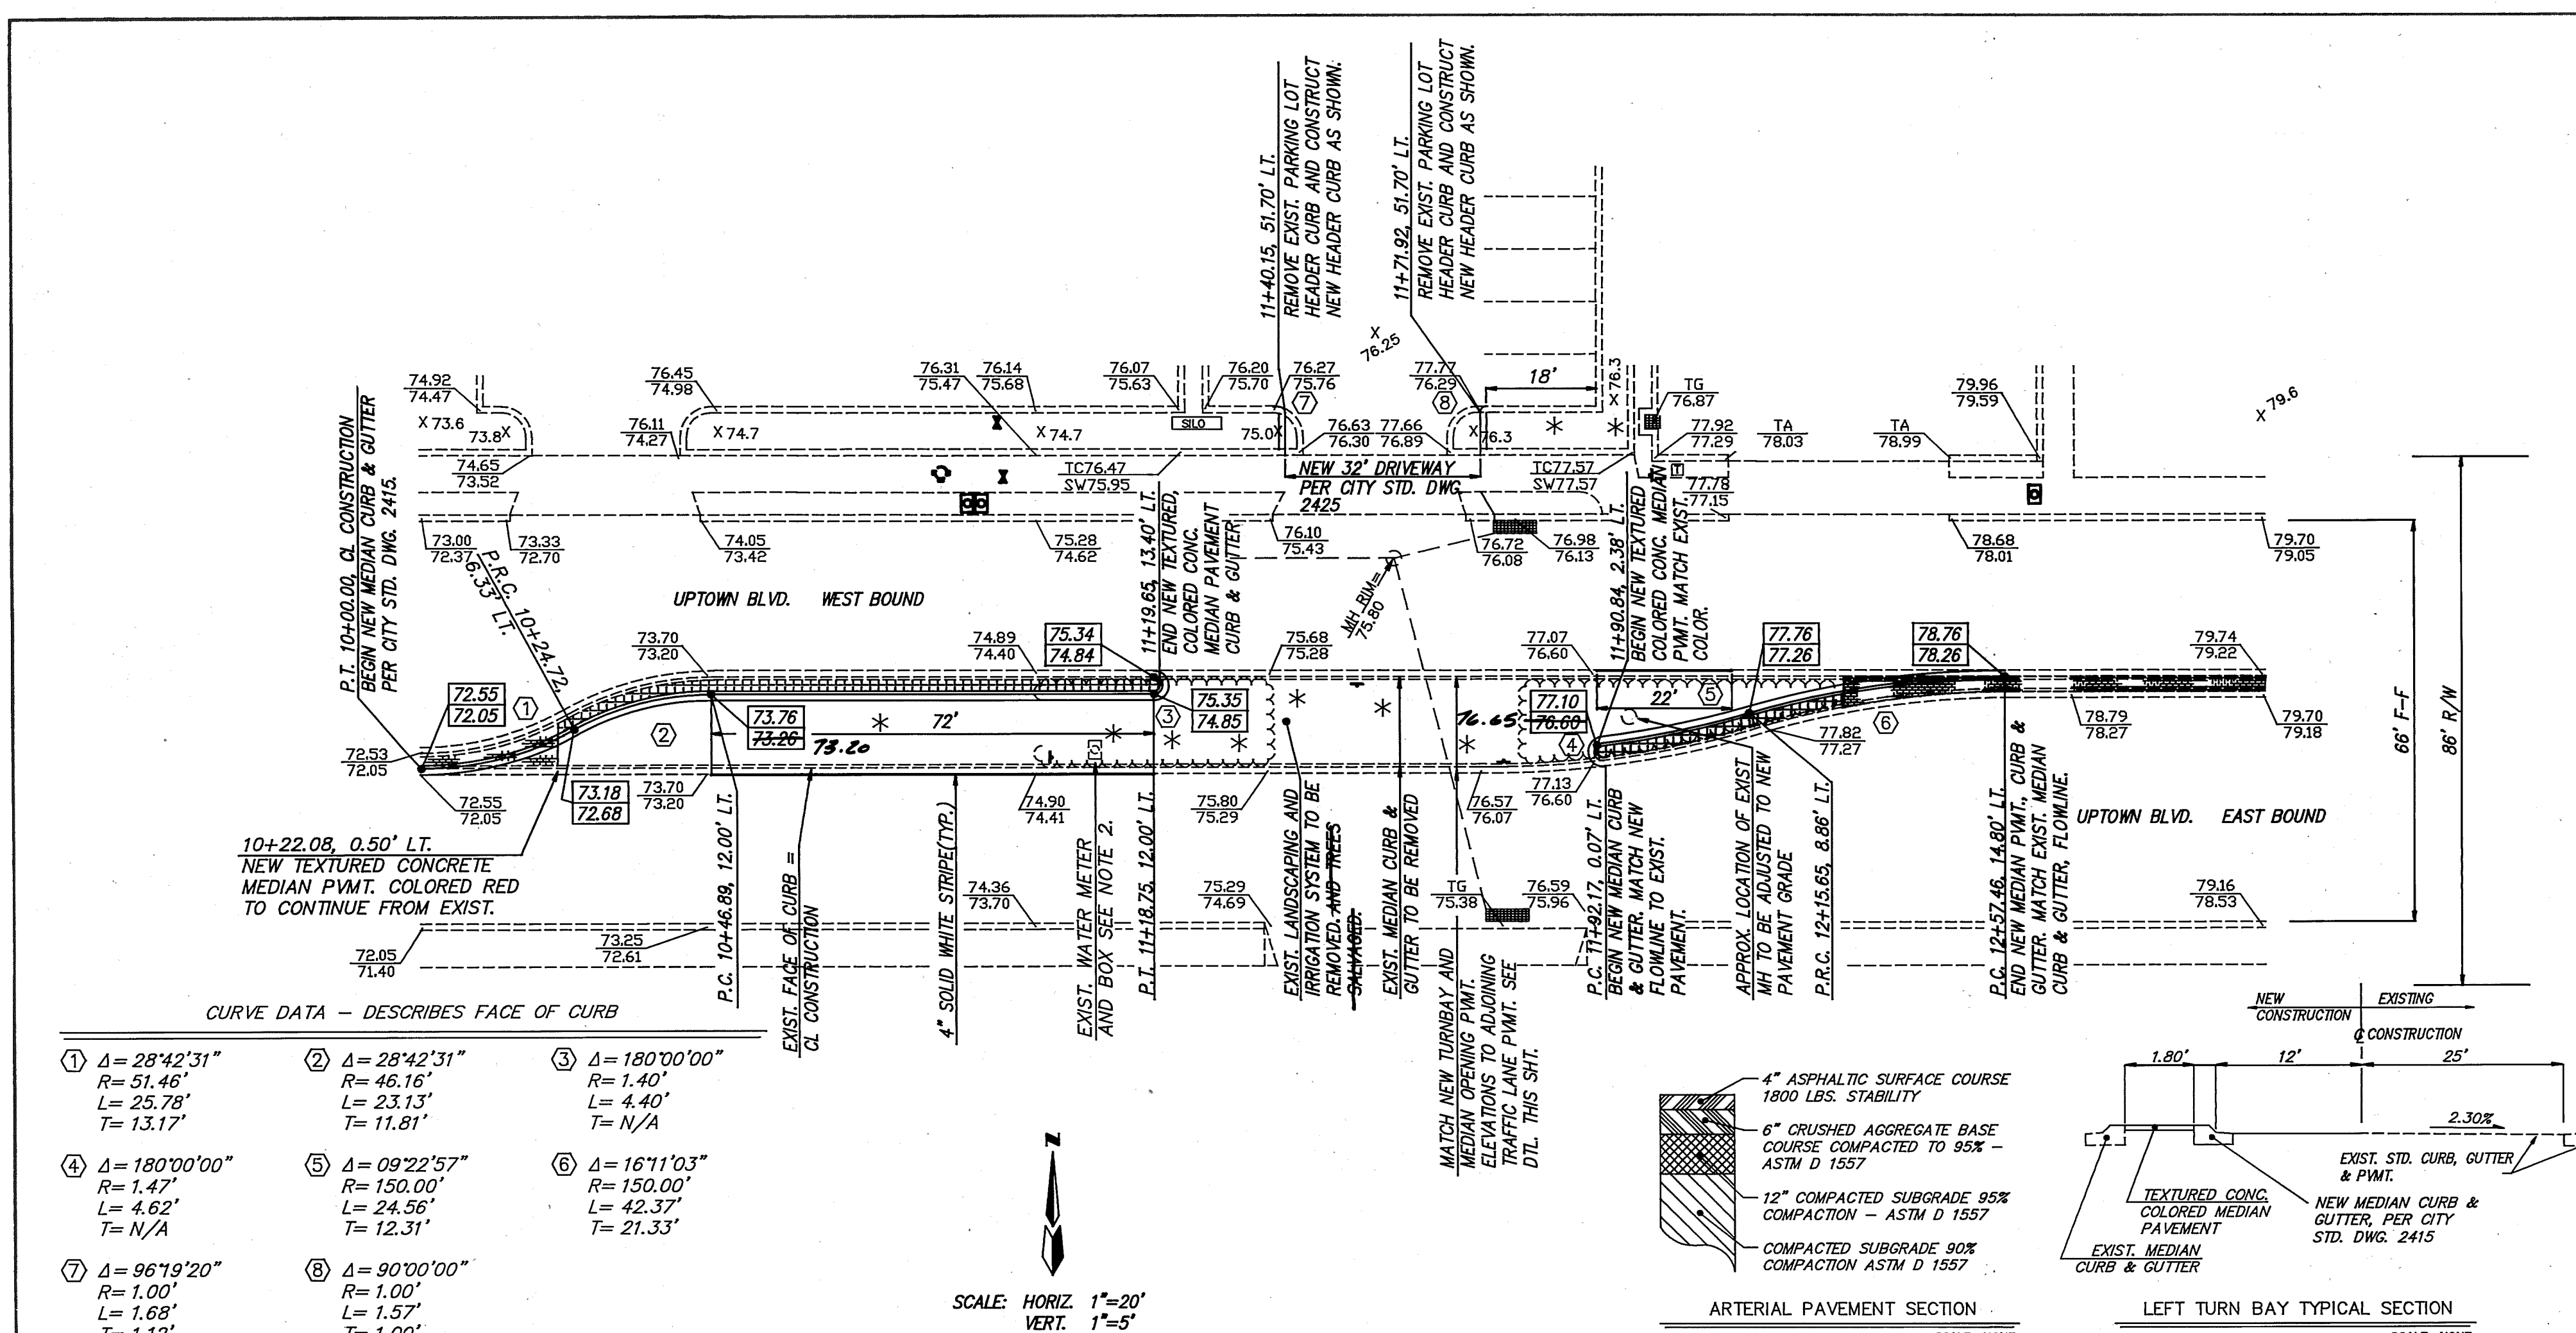

GENERAL NOTES

NOTICE TO CONTRACTORS

- CITY OF ALBUQUERQUE SPECIFICATIONS FOR PUBLIC WORKS CONSTRUCTION, 1986 EDITION WILL BE REFERRED TO HEREIN AS THE "STANDARD SPECIFICATIONS".
- TWO WORKING DAYS PRIOR TO ANY EXCAVATION, CONTRACTOR MUST CONTACT NEW MEXICO ONE CALL SYSTEM (260-1990) AND DETERMINE LOCATION OF EXISTING UTILITIES.
- PRIOR TO ANY CONSTRUCTION, THE CONTRACTOR SHALL EXCAVATE AND VERIFY THE HORIZONTAL AND VERTICAL LOCATIONS OF ALL OBSTRUCTIONS. SHOULD A CONFLICT EXIST, THE CONTRACTOR SHALL NOTIFY THE ENGINEER OR THE SURVEYOR SO THAT THE CONFLICT CAN BE RESOLVED WITHOUT DELAY.
- THREE (3) WORKING DAYS PRIOR TO BEGINNING CONSTRUCTION THE CONTRACTOR SHALL SUBMIT TO THE CONSTRUCTION CO-ORDINATION DIVISION A DETAILED CONSTRUCTION SCHEDULE. TWO (2) WORKING DAYS PRIOR TO CONSTRUCTION THE CONTRACTOR SHALL OBTAIN A BARRICADING PERMIT FROM THE CONSTRUCTION CO-ORDINATION DIVISION. CONTRACTOR SHALL NOTIFY BARRICADE ENGINEER (788-2551) PRIOR TO OCCUPYING AN INTERSECTION. SEE SECTION 19 OF THE STANDARD SPECIFICATIONS.

THE FOLLOWING NOTES ALSO APPLY WHEN CHECKED

- ☐ ALL UTILITIES AND UTILITY SERVICE LINES SHALL BE INSTALLED PRIOR TO PAVING.
- ☐ BACKFILL COMPACTION SHALL BE ACCORDING TO SPECIFIED STREET USE.
- ☐ TACK COAT REQUIREMENTS SHALL BE DETERMINED BY THE CITY ENGINEER.
- ☐ SIDEWALK AND WHEELCHAIR RAMPS WITHIN THE CURB RETURNS SHALL BE CONSTRUCTED WHEREVER A NEW CURB RETURN IS CONSTRUCTED.
- ☐ IF CURB IS DEPRESSED FOR A DRIVEPAD, THE DRIVEPAD SHALL BE CONSTRUCTED PRIOR TO ACCEPTANCE OF CURB AND GUTTER.
- ☐ ALL STORM DRAINAGE FACILITIES SHALL BE COMPLETED PRIOR TO FINAL ACCEPTANCE.
- ☐ THE REQUESTOR OR DEVELOPER SHALL BE RESPONSIBLE FOR REPAIR OR REPLACEMENT OF ALL CURB AND GUTTER OR SIDEWALK DAMAGE AFTER APPROVAL BY THE CITY ENGINEER OR WORK COMPLETED BY THE CONTRACTOR.

NOTES

- CONTRACTOR SHALL BE RESPONSIBLE FOR REMOVAL AND OFF-SITE DISPOSAL OF ALL EXIST. LANDSCAPING AND IRRIGATION SYSTEM.
- CUT & CAP EXISTING MEDIAN IRRIGATION WATERLINES. RETURN METER AND BOX TO CITY PARKS MANAGEMENT CUSTOMER SERVICE DEPARTMENT.

AS BUILT INFORMATION

CONTRACTOR: Sparling Const. DATE: 7/92

WORKED BY: MGA DATE: 7/92

INSPECTED BY: MGA DATE: 7/92

ACCEPTANCE BY: MGA DATE: 7/92

VERIFICATION BY: MGA DATE: 7/92

DRAWING NO. 10+00.00 DATE: 7/92

MICRO-FILM INFORMATION

RECORDED BY: MGA DATE: 7/92

NO. 944

ENGINEER'S SEAL

D. MARK GOODWIN, P.E. 8948

APPROVAL OF AS BUILT DRAWINGS

CHIEF-CONSTRUCTION ENGINEER

DATE 12-3-92

APPROVED FOR CONSTRUCTION

9-4-92

CITY ENGINEER

REVISIONS

NO.	DATE	REMARKS
1	7/92	DESIGN
2	7/92	DESIGN
3	7/92	DESIGN

DESIGNED BY: JMM DATE: 7/92

DRAWN BY: JMM DATE: 7/92

CHECKED BY: DMG DATE: 7/92

CITY OF ALBUQUERQUE

PUBLIC WORKS DEPARTMENT

ENGINEERING GROUP

TITLE: SILO - UPTOWN BLVD. N.E. MEDIAN & ACCESS MODIFICATIONS STA. 10+00.00 TO P.C. STA. 12+38.10

APPROVALS	ENGINEER	DATE	APPROVALS	ENGINEER	DATE
DRC CHAIRMAN	8/4/92	8/4/92	WATER	8/4/92	8/4/92
TRANSPORTATION	8/4/92	8/4/92	WASTE WATER	8/4/92	8/4/92
HYDROLOGY	8/4/92	8/4/92			

PROJECT NO. 4407.90 MAP NO. H18 SHEET 1 OF 1