


DRAWING NUMBER
20-444-29
Sht. - 1

DRAWING NUMBER
PLAN HOLD CORPORATION
IRVINE, CALIFORNIA
REGISTERED PROFESSIONAL ENGINEER
REPRODUCED BY NUMBER 07544
POSITION USE OF PRINT ON THIS LINE

DRAWING NUMBER
PLAN HOLD CORPORATION
IRVINE, CALIFORNIA
REGISTERED PROFESSIONAL ENGINEER
REPRODUCED BY NUMBER 07544
POSITION USE OF PRINT ON THIS LINE

DRAWING NUMBER
PLAN HOLD CORPORATION
IRVINE, CALIFORNIA
REGISTERED PROFESSIONAL ENGINEER
REPRODUCED BY NUMBER 07544
POSITION USE OF PRINT ON THIS LINE

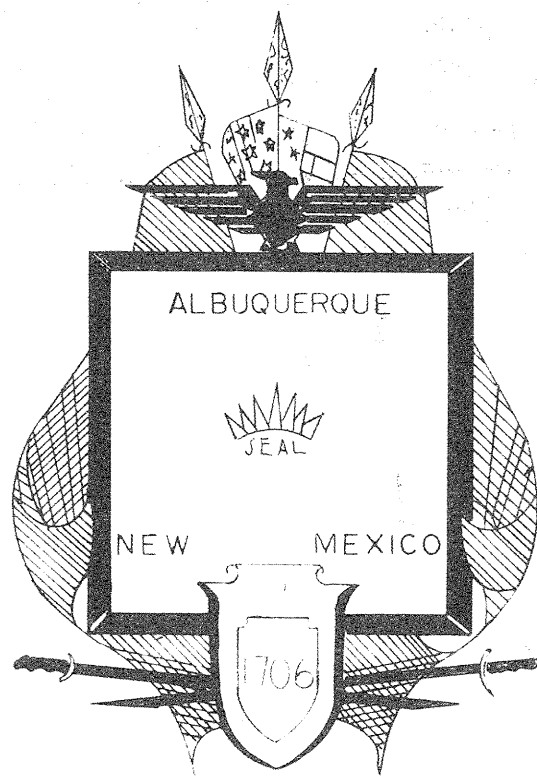

CITY OF ALBUQUERQUE

PLANS FOR CONSTRUCTION OF

CONCRETE SANITARY SEWER LINE REPLACEMENT S. E. HEIGHTS

NOTICE TO CONTRACTORS

1. New Mexico Standard Specifications for Public Works Construction-1979 Edition will be referred to hereon as the "Standard Specification".
2. All work detailed on these plans to be performed under contract shall, except as otherwise stated or provided for hereon, be constructed in accordance with Contract Documents for City-Wide Utilities and Cash Paving No. _____ and the Standard Specification.
3. Two working days prior to any excavation, contractor must contact Line Locating Service, 765-1234, for location of existing utilities.
4. Prior to construction, the contractor shall excavate and verify the horizontal and vertical locations of all obstructions. Should a conflict exist, the contractor shall notify the engineer or surveyor so that the conflict can be resolved with a minimum amount of delay.

THE FOLLOWING NOTES ALSO APPLY WHEN CHECKED

- ☒ All utilities and utility service lines shall be installed prior to paving.
- ☒ Backfill compaction shall be according to specified street use.
- ☒ Tack coat requirements shall be determined by the City Engineer.
- ☐ Sidewalks and wheelchair ramps within the curb returns shall be constructed wherever a new curb return is constructed.
- ☐ If curb is depressed for a driveway, the driveway shall be constructed prior to acceptance of curb and gutter.
- ☐ All storm drainage facilities shall be completed prior to final acceptance.

C of A PWD Maps & Records
20 444 29

WATER RESOURCES DEPARTMENT
APPROVAL OF AS BUILT DRAWINGS

WATER RESOURCES DEPARTMENT
APPROVAL OF AS BUILT DRAWINGS
Date 12-23-81

REC
DATE 12-23-81
BY David J. Larrow

APPROVED FOR CONSTRUCTION
CITY ENGINEER
APPROVED RECORD DRAWINGS





NO.	C-29-444	2	5
-----	----------	---	---

APPROVED FOR
CONSTRUCTION
Richard S. Hall 12/18/80
CITY ENGINEER DATE

AF 131574

CITY OF ALBUQUERQUE					
MUNICIPAL DEVELOPMENT DEPARTMENT					
CONCRETE SANITARY SEWER <u>LINE</u> REPLACEMENT					
TITLE:		S.E. HEIGHTS			
LEGEND AND GENERAL NOTES					
APPROVALS	ENGINEER	DATE	APPROVALS	ENGINEER	DATE
City Engr			Water	Walt J. [Signature]	10/1/80
Ass't City Engr	J. K. [Signature]	12 Dec 80			
			Sewer	Walt J. [Signature]	10/1/80
DRAWING NO. C-200-444			SHEET 3 OF 5		

SCANNED BY
MESA REPRO

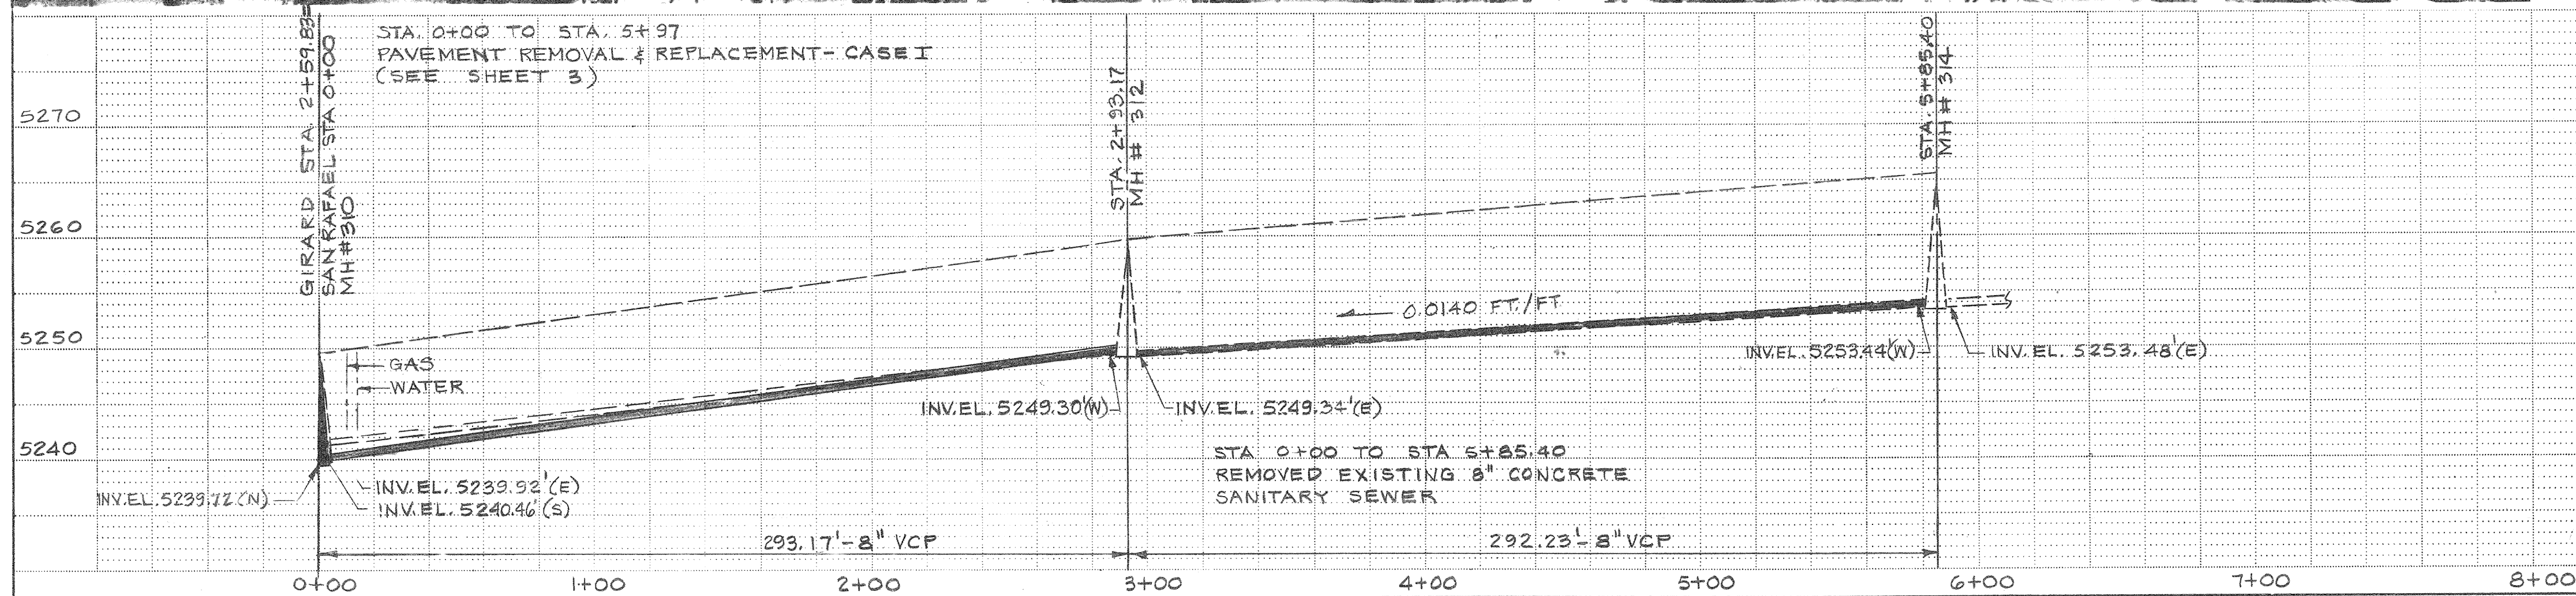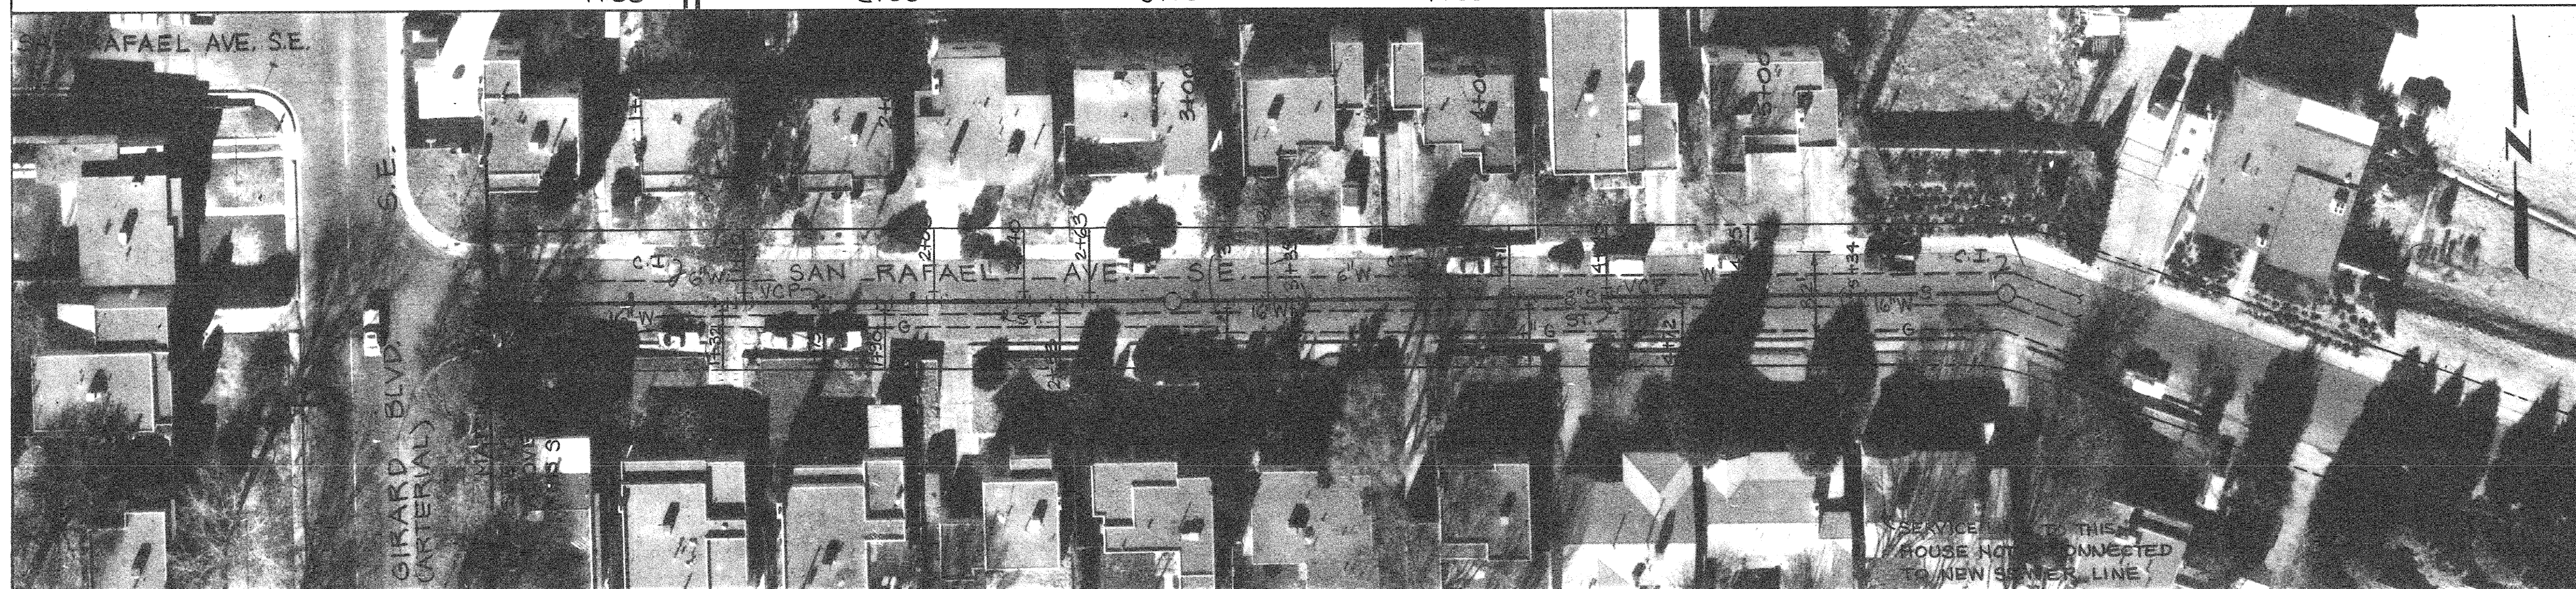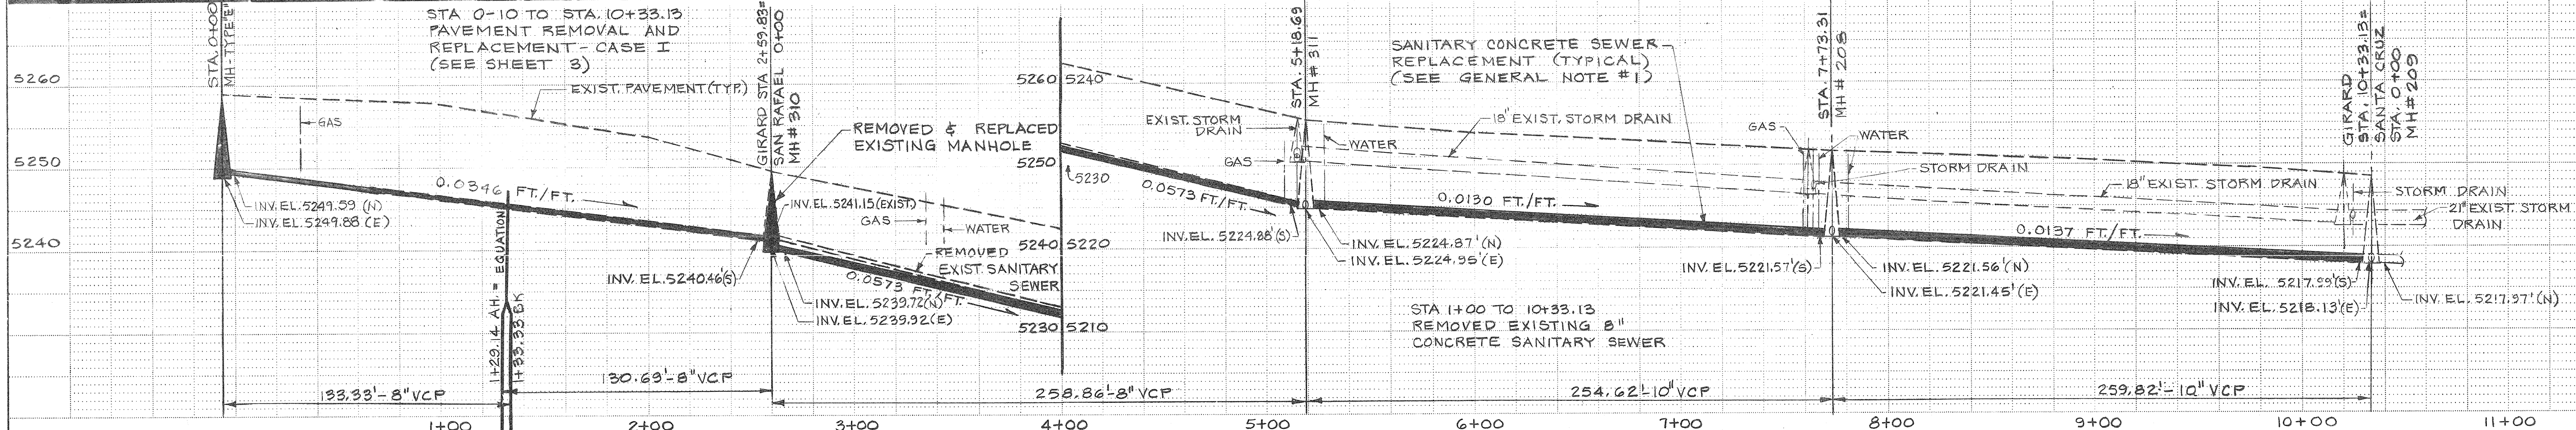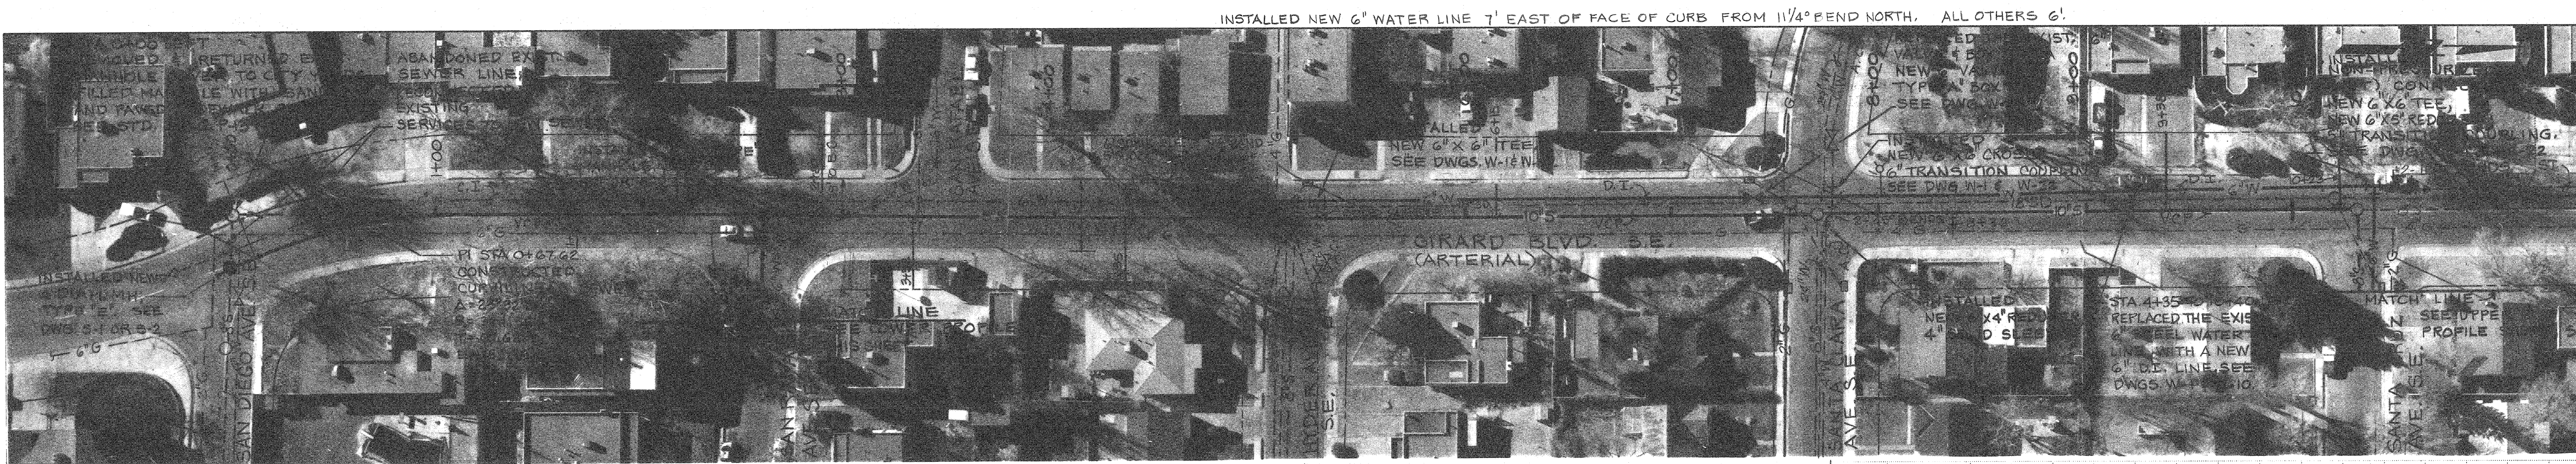

BM#5-L16 LOCATED AT THE INTERSECTION OF SANTA CRUZ AVE. S.E. & GIRARD BLVD. S.E. A SQUARE CHISELED IN TOP OF CONCRETE CURB AT THE NNE RETURN. ELEV. 5228.60'

BM#7-L16 LOCATED AT THE INTERSECTION OF WELLESLEY DR. S.E. & HYDER AVE. S.E. IN THE NE QUADRANT OF THE INTERSECTION. A SQUARE CHISELED ON TOP OF CONCRETE CURB AT THE ENE CURB RETURN. ELEV. 5302.06'


BM#13-L16 LOCATED AT THE INTERSECTION OF GIRARD BLVD. S.E. & KATHRYN AVE. S.E. A SQUARE CHISELED IN TOP OF CONCRETE CURB AT THE NNW RETURN. ELEV. 5259.81'

WATER RESOURCES DEPARTMENT APPROVAL OF AS BUILT DRAWINGS	
Date 12-23-81	
SCALE: HORIZ. 1"=40' VERT. 1"=10'	
C of A PWD Maps & Records 1 2 3 4 5 6 7 8 9 10 11 20 444 6429	
BOVAY ENGINEERS, INC. HOUSTON, TEXAS SACRAMENTO, CALIFORNIA BIRMINGHAM, ALABAMA	

CITY OF ALBUQUERQUE MUNICIPAL DEVELOPMENT DEPARTMENT CONCRETE SANITARY SEWER LINE REPLACEMENT S.E. HEIGHTS GIRARD BLVD. & SAN RAFAEL AVE.					
APPROVALS	ENGINEER	DATE	APPROVALS	ENGINEER	DATE
City Engineer	12/23/81	12/23/81	Sanitary Sewer	12/23/81	12/23/81
APPROVED FOR CONSTRUCTION CITY ENGINEER DATE 12/23/81					
DRAWING NO. C-29-444			SHEET 4 OF 5		

BENCH MARKS			AS BUILT INFORMATION		
BM#4-L16	AT THE INTERSECTION OF SANTA CLARA AVE. S.E. & COLUMBIA DR. S.E. IN THE NE QUADRANT OF THE INTERSECTION. A SQUARE CHISELED IN TOP OF CONCRETE CURB AT THE NNE RETURN.	DATE	CONTRACTOR	WORK	DATE
BM#5-L16	LOCATED AT THE INTERSECTION OF SANTA CRUZ AVE. S.E. & GIRARD BLVD. S.E. A SQUARE CHISELED IN TOP OF CONCRETE CURB AT THE NNE RETURN.	DATE	INSPECTOR	INSPECTION	DATE
BM#7-L16	LOCATED AT THE INTERSECTION OF WELLESLEY DR. S.E. & HYDER AVE. S.E. IN THE NE QUADRANT OF THE INTERSECTION. A SQUARE CHISELED ON TOP OF CONCRETE CURB AT THE ENE CURB RETURN.	DATE	FIELD	DRAWINGS	DATE
BM#13-L16	LOCATED AT THE INTERSECTION OF GIRARD BLVD. S.E. & KATHRYN AVE. S.E. A SQUARE CHISELED IN TOP OF CONCRETE CURB AT THE NNW RETURN.	DATE	REVISIONS	REVISIONS	DATE
			NO.	DATE	DATE
			BY	DATE	DATE
			REMARKS	REMARKS	REMARKS
			DESIGN	DESIGN	DESIGN
			DRAWN BY	DRAWN BY	DRAWN BY
			CHECKED BY	CHECKED BY	CHECKED BY

SCANNED BY
MESA REPRO

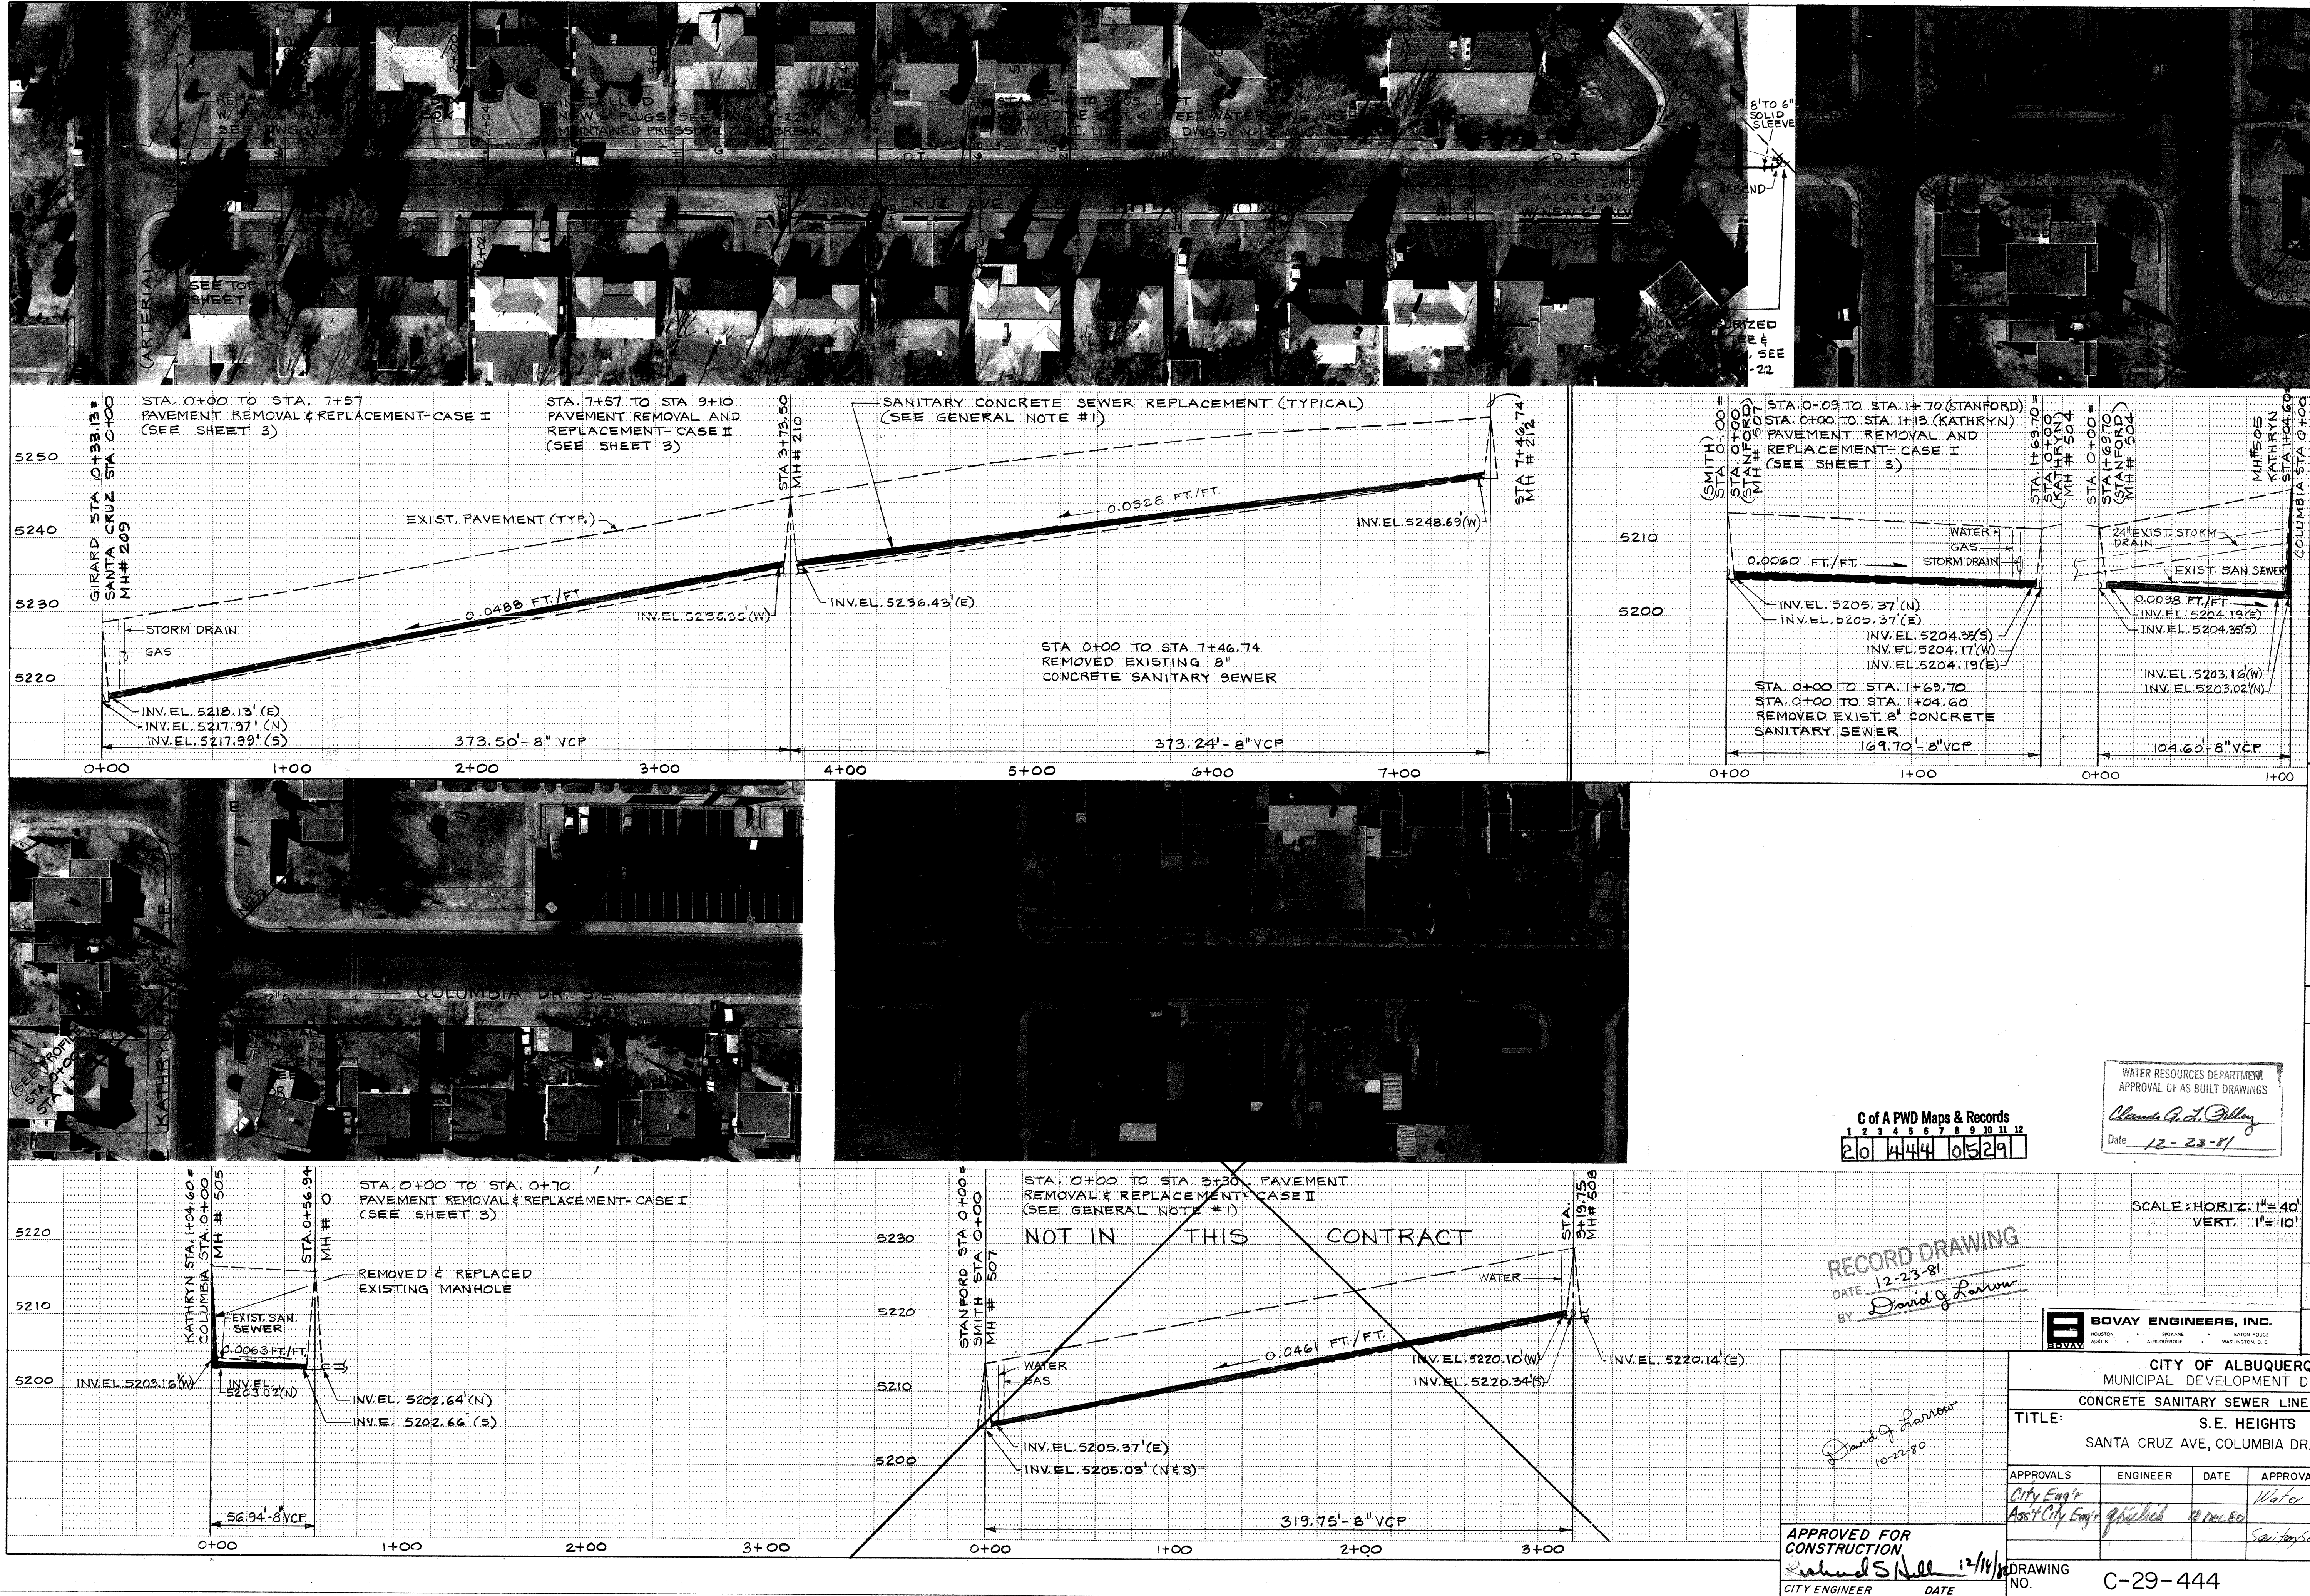

SURVEY INFORMATION			BENCH MARKS			AS BUILT INFORMATION		
MAP NO.	EST. NO.	W.O. NO.	CONTRACTOR	WORK	DATE	CONTRACTOR	WORK	DATE
L-16			SMITH-116	AT THE INTERSECTION OF KATHRYN AVE. & PRINCETON DR. S.E. IN THE NE QUADRANT		SMITH-116	AT THE INTERSECTION OF KATHRYN AVE. & PRINCETON DR. S.E. IN THE NE QUADRANT	
NO.	DATE	BY	NO.	DATE	BY	NO.	DATE	BY
REFERENCES			REVISIONS			MICRO-FILM INFORMATION		
NO.	DATE	REMARKS	DESIGNED BY	DATE		NO.	DATE	
			DUL	10/22/80				
			MEY	10/22/80				
			SWR	10/22/80				