



CONSTRUCTION PLANS
FOR
PARKLAND VIEW
SUBDIVISION — PHASE I
ALBUQUERQUE, NEW MEXICO

INDEX

SHEET NUMBER	DESCRIPTION
1	TITLE SHEET
2A-2B	PLAT
3A-3C	GRADING PLAN
4	OVERALL PAVING PLAN
5-6	PAVING PLAN AND PROFILE SHEETS PARKLAND VIEW DRIVE & (LOOP)
7	GLYNVIEW COURT
8	WYNVIEW COURT
9	OVERALL UTILITY PLAN
10-11	UTILITY PLAN AND PROFILE SHEETS PARKLAND VIEW DRIVE & (LOOP)
12	GLYNVIEW COURT
13	WYNVIEW COURT
14	UTILITIES EXTENSION GAVIN ROAD TO FUTURE SANDY ROAD (SAS)
15	FUTURE GAVIN ROAD (WL)
15A	SIGNING & CONSTRUCTION TRAFFIC CONTROL STANDARDS
15B	TYPICAL TRAFFIC CONTROL & SIGNING EXAMPLES



I, David C. Clausen, New Mexico Professional
Land Surveyor No. 6547, do hereby certify that
the as-built information shown hereon is the re-
sult of a field survey performed by me or under
my direct supervision, and that the same is true
and correct.

David C. Clausen
David C. Clausen N.M.L.S. # 6547

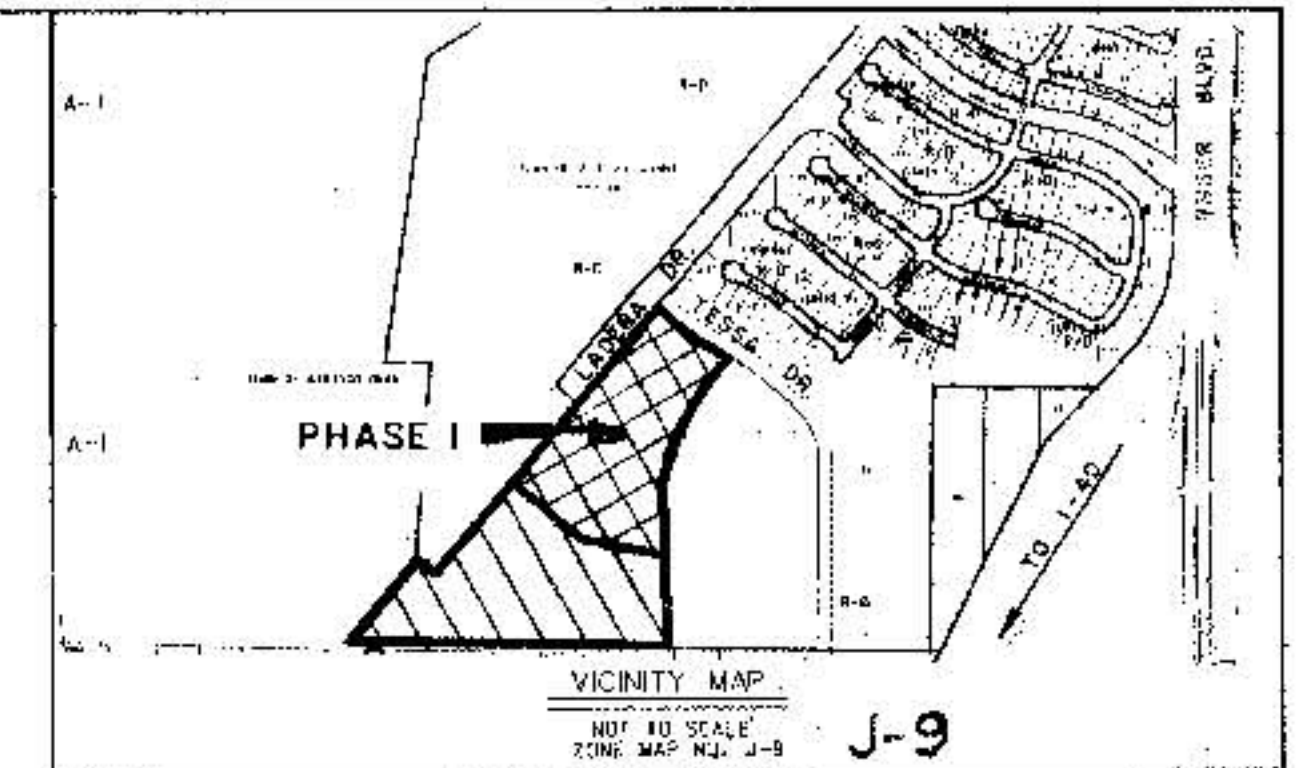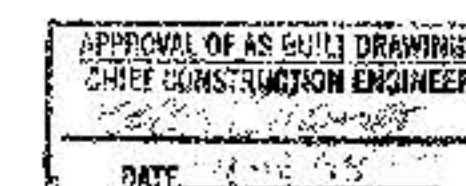

- NOTICE TO CONTRACTORS**
- ALL WORK DETAILED ON THESE PLANS TO BE PERFORMED UNDER CONTRACT SHALL, EXCEPT AS OTHERWISE STATED OR PROVIDED FOR HEREON, BE CONSTRUCTED IN ACCORDANCE WITH THE CITY OF ALBUQUERQUE STANDARD SPECIFICATIONS FOR PUBLIC WORKS CONSTRUCTION, 1986 EDITION AND SHALL INCLUDE UPDATE No. 6.
 - TWO WORKING DAYS PRIOR TO ANY EXCAVATION, THE CONTRACTOR MUST CONTACT NEW MEXICO ONE CALL SYSTEM (260-1990) FOR LOCATION OF EXISTING UTILITIES.
 - PRIOR TO CONSTRUCTION, THE CONTRACTOR SHALL EXCAVATE AND VERIFY THE HORIZONTAL AND VERTICAL LOCATIONS OF ALL OBSTRUCTIONS. SHOULD A CONFLICT EXIST, THE CONTRACTOR SHALL NOTIFY THE ENGINEER OR SURVEYOR IMMEDIATELY SO THAT THE CONFLICT CAN BE RESOLVED WITH A MINIMUM AMOUNT OF DELAY.
 - FIVE (5) WORKING DAYS PRIOR TO BEGINNING CONSTRUCTION, THE CONTRACTOR SHALL SUBMIT TO CONSTRUCTION COORDINATION DIVISION A DETAILED CONSTRUCTION SCHEDULE TWO (2) WORKING DAYS PRIOR TO CONSTRUCTION. THE CONTRACTOR SHALL OBTAIN A BARRICADE PERMIT FROM THE CONST. COORDINATION DIVISION. CONTRACTOR SHALL NOTIFY BARRICADE ENGINEER (768-2551) PRIOR TO OCCUPYING AN INTERSECTION. REFER TO SECTION 19 OF THE GENERAL CONDITIONS OF THE STANDARD SPECIFICATIONS.
 - ALL STREET STRIPING ALTERED OR DESTROYED SHALL BE REPLACED W/ PLASTIC REFLECTORIZED PAVEMENT MARKING BY CONTRACTOR TO LOCATION AS EXISTING OR AS INDICATED BY THIS PLAN SET.
 - CONTRACTOR SHALL NOTIFY THE ENGINEER NOT LESS THAN SEVEN (7) DAYS PRIOR TO STARTING WORK IN ORDER THAT THE CITY SURVEYOR MAY TAKE NECESSARY MEASURES TO INSURE THE PRESERVATION OF SURVEY MONUMENTS. CONTRACTOR SHALL NOT DISTURB PERMANENT SURVEY MONUMENTS WITHOUT THE CONSENT OF THE CITY SURVEYOR AND SHALL NOTIFY THE CITY SURVEYOR AND BEAR THE EXPENSE OF REPLACING ANY THAT MAY BE DISTURBED WITHOUT PERMISSION. REPLACEMENT SHALL BE DONE ONLY BY THE CITY SURVEYOR WHEN A CHANGE IS MADE IN THE FINISHED ELEVATIONS OF THE PAVEMENT OF ANY ROADWAY IN WHICH A PERMANENT SURVEY MONUMENT IS LOCATED. CONTRACTOR SHALL, AT HIS OWN EXPENSE, ADJUST THE MONUMENT COVER TO THE NEW GRADE UNLESS OTHERWISE SPECIFIED. REFER TO SECTION 4.4 OF THE GENERAL CONDITIONS OF THE STANDARD SPECIFICATIONS. ANY PERMANENT SURVEY MONUMENT LOCATED WITHIN 50' OF THE PROJECT LIMITS NOT SHOWN ON THE PLANS THAT IS DESTROYED DURING CONSTRUCTION WILL BE REPLACED AT DESIGNER'S EXPENSE.
 - ANY WORK WITHIN AN ARTERIAL ROADWAY REQUIRES TWENTY-FOUR HOUR CONSTRUCTION.
 - CONTRACTOR SHALL MAINTAIN A GRAFFITI-FREE WORK SITE. CONTRACTOR SHALL PROMPTLY REMOVE ANY GRAFFITI FROM ALL EQUIPMENT, WHETHER PERMANENT OR TEMPORARY.
- THE FOLLOWING NOTES ALSO APPLY WHEN CHECKED**
- ☒ ALL UTILITIES AND UTILITY SERVICE LINES SHALL BE INSTALLED PRIOR TO PAVING.
 - ☒ BACKFILL COMPACTION SHALL BE ACCORDING TO SPECIFIED STREET USE.
 - ☐ TACK COAT REQUIREMENTS SHALL BE DETERMINED BY THE CITY ENGINEER.
 - ☒ SIDEWALKS AND WHEELCHAIR RAMPS WITHIN THE CURB RETURNS SHALL BE CONSTRUCTED WHEREVER A NEW CURB RETURN IS CONSTRUCTED.
 - ☐ IF CURB IS DEEPENED FOR A DRIVEPAD, THE DRIVEPAD SHALL BE CONSTRUCTED PRIOR TO ACCEPTANCE OF CURB AND GUTTER.
 - ☐ ALL STORM DRAINAGE FACILITIES SHALL BE COMPLETED PRIOR TO FINAL ACCEPTANCE.
 - ☒ THE REQUESTOR OR DEVELOPER SHALL BE RESPONSIBLE FOR REPAIR OR REPLACEMENT OF ALL CURB AND GUTTER OR SIDEWALK DAMAGED AFTER APPROVAL BY THE CITY ENGINEER OF WORK COMPLETED BY THE CONTRACTOR.

REV.	SHEETS	CITY ENGINEER	DATE	USER DEPARTMENT	DATE	USER DEPARTMENT	DATE
1	15						
ENGINEERS STAMP & SIGNATURE		APPROVALS	ENGINEER	DATE	*****		
		DRC Chairman	William A. Gooding	3-26-98	APPROVED FOR CONSTRUCTION: <i>R. W. Kane</i> City Engineer		
		Transportation		3-10-98			
		Water/Wastewater	R. W. Kane	3-10-98			
		Hydrology	William A. Gooding	3-10-98			
		Perks		3-10-98			
		Const. Maint.	William A. Gooding	3-10-98			
		Const. Coord.		3-12-98			
		City Project Mgr.					
		4442.98			Sheet	1	15

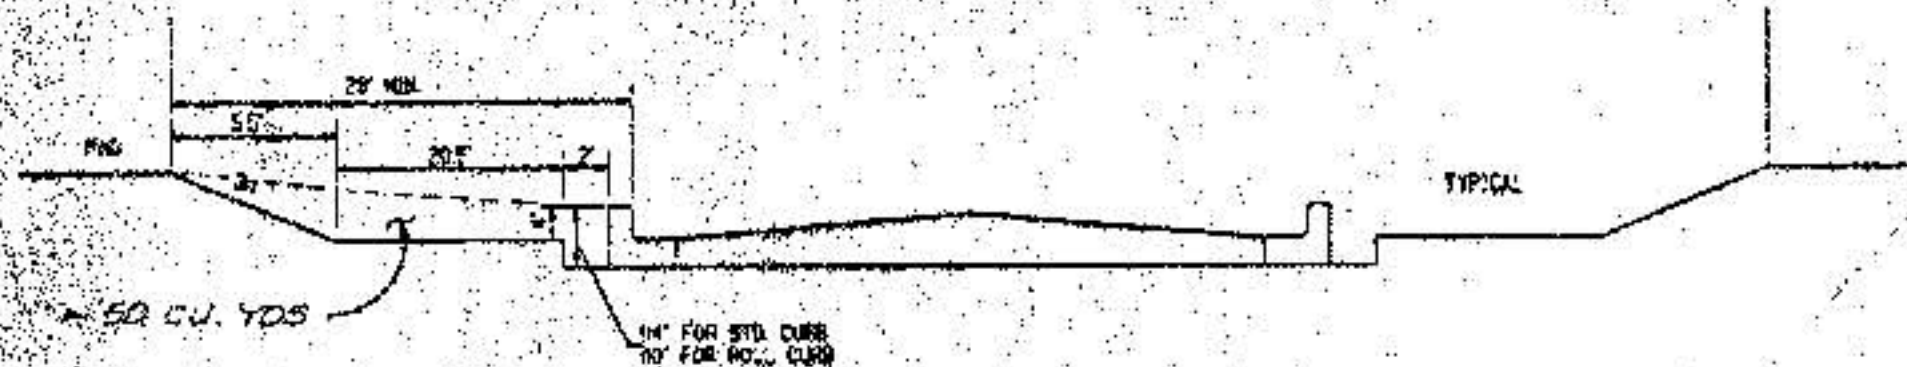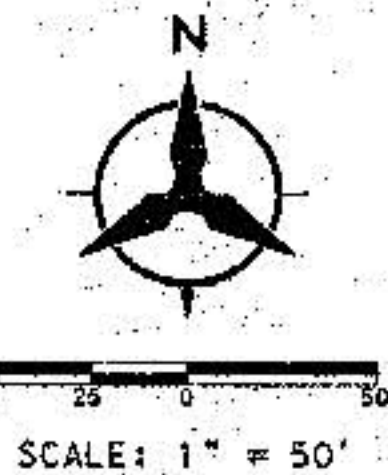

- NOTE:
1. CONTRACTOR IS TO MASS GRADE ROAD TO 2' BEYOND FUTURE CURB. EXCESS FROM DRY UTILITY TRENCH IS TO BE USED TO BACKFILL BEHIND CURB.
 2. FIRM'S YARDS ARE TO BE GRADED AS SHOWN ON THIS DETAIL FOR FINAL GRADING AND CERTIFICATION. THIS DETAIL TO BE COORDINATED WITH CIVIL ENGINEER'S DETAIL. (CIVIL ENGINEER'S PHONE NO. 1505) 821-3581.
 3. HOMEOWNER TO BRING FRONT YARD TO ULTIMATE FRONT YARD GRADES AFTER HOME CONSTRUCTION IS COMPLETED. SEE ULTIMATE FRONT YARD GRADING DETAIL ON THIS SHEET.

TYPICAL FRONT YARD GRADING DETAIL
NO SCALE

DRAINAGE CERTIFICATION

RICHARD L. BELTRAMO, OF BOHANNAN & HUSTON, N.M.P.E. # 10596, HEREBY CERTIFY THAT THE AS-BUILT DRAINAGE CONDITIONS OF THE SITE ARE IN SUBSTANTIAL COMPLIANCE WITH THE APPROVED GRADING AND DRAINAGE PLAN, TO THE BEST OF MY KNOWLEDGE AND BELIEF. AS-BUILT ELEVATIONS ARE SHOWN ON THIS PLAN WHERE THE ORIGINAL DESIGN ELEVATION HAS BEEN CROSSED OUT AND THE AS-BUILT ELEVATION ADDED. AS-BUILT ELEVATIONS WERE OBTAINED BY SPARKLING CONSTRUCTION, L.S.# 6247. THIS STATEMENT DOES NOT REPRESENT CERTIFICATION OF CONTRACTOR'S METHODS OR MATERIALS.

Richard L. Beltramo
DATE: 9/10/98



- GENERAL NOTES
1. CONTRACTOR MUST OBTAIN A TOPSOIL DISTURBANCE PERMIT FROM THE ENVIRONMENTAL HEALTH DIVISION PRIOR TO CONSTRUCTION.
 2. THE CONTRACTOR IS TO REFER TO EARTHWORK SPECIFICATION AS NOTED IN THE SOILS REPORT PREPARED BY GEO-TEST, INC. DATED 10-13-94 & APRIL 13, 1994.
 3. THE CONTRACTOR SHALL CONFORM TO ALL CITY, COUNTY, STATE, AND FEDERAL DUST CONTROL MEASURES AND REQUIREMENTS AND WILL BE RESPONSIBLE FOR PREPARING AND OBTAINING ALL NECESSARY APPLICATIONS AND APPROVALS.
 4. THE CONTRACTOR SHALL ENSURE THAT NO SOIL ERODES FROM THE LOTS INTO PUBLIC RIGHT-OF-WAY. THIS CAN BE ACHIEVED BY CONSTRUCTING TEMPORARY BERMS AS PER DETAIL SHEET 3 AND WETTING THE SOIL TO KEEP IT FROM BLOWING.
 5. ALL SPOT ELEVATIONS ARE TO FLOWLINE UNLESS OTHERWISE NOTED.
 6. BOULDERS, GREATER THAN 3 FEET IN DIAMETER, EXCAVATED DURING GRADING ACTIVITIES SHALL BE STOCKPILED AND DISPOSED OF AT THE DISCRETION OF THE OWNER.
 7. ALL WALLS SHOWN ARE TO BE PLACED ALONG PROPERTY LINE. (WALLS ARE SHOWN OFFSET FOR VISUAL PURPOSE ONLY.)

LEGEND

- PROPOSED GARDEN WALL
- PROPOSED RETAINING WALL
- PROPOSED SPOT ELEVATION
- EXISTING SPOT ELEVATION
- EXISTING ELEVATION
- DIRECTION OF FLOW
- SLOPE AREA
- WALL DRAIN

I, David C. Clausen, New Mexico Professional Land Surveyor No. 6547, do hereby certify that the as-built information shown hereon is the result of a field survey performed by me or under my direct supervision, and that the same is true and correct.

David C. Clausen
David C. Clausen N.M.L.S. # 6547



Bohannon & Huston

Courtyard One 7500 JEFFERSON NE ALBUQUERQUE NEW MEXICO 87109

ENGINEERS PLANNERS PHOTOGRAMMETRISTS SURVEYORS LANDSCAPE ARCHITECTS

CITY OF ALBUQUERQUE
PUBLIC WORKS DEPARTMENT
ENGINEERING DEVELOPMENT GROUP


**PARKLAND VIEW SUBDIVISION
GRADING PLAN**


DESIGN REVIEW BOARD NO. 97 / 312
APPROVAL DATE 12 / 16 / 97
LAST DESIGN UPDATE

CITY PROJECT NO. 4442.98
ZONE MAP NO. J-9
SHEET 3A OF 15

DESIGNED BY JSG/PIL
DRAWN BY TSC
CHECKED BY KP

COPYRIGHT BOHANNAN-HUSTON, INC. 1997
DATE: OCT. 1997

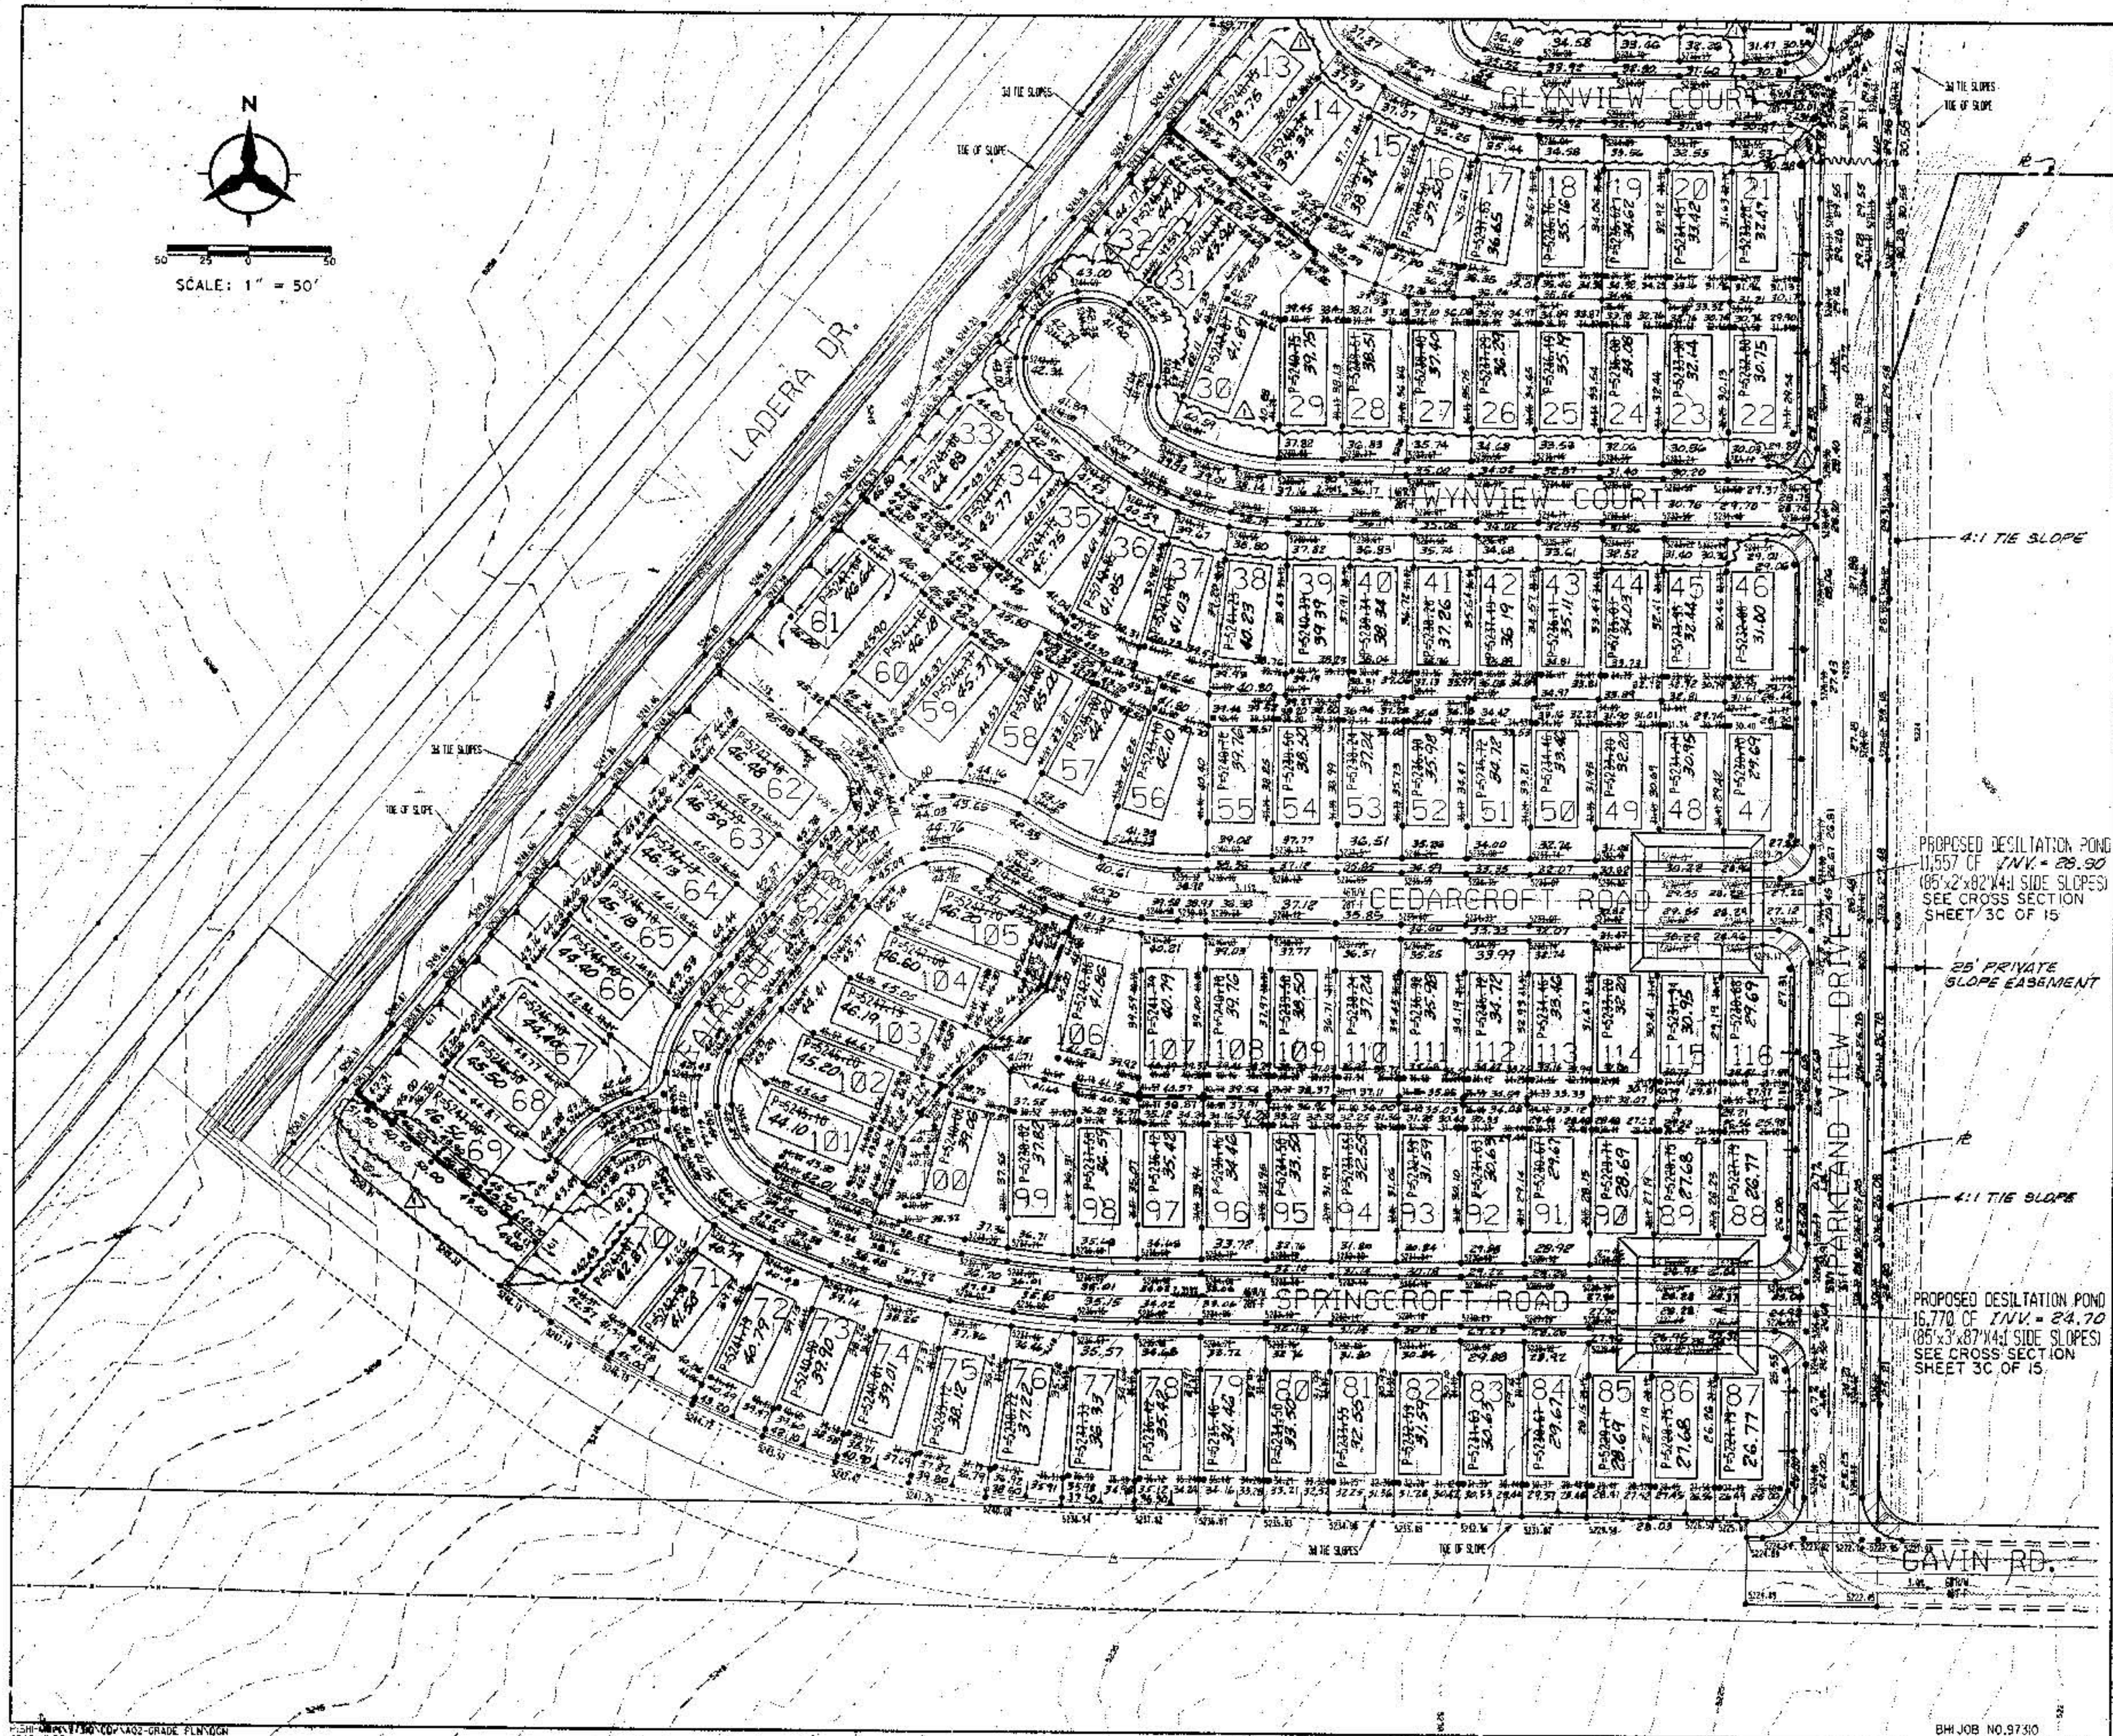

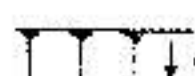- LEGEND
- PROPOSED SANDWICH WALL 
- PROPOSED RETAINING WALL 
- PROPOSED SPOT ELEVATION  34.25
- FUTURE SPOT ELEVATION 
- EXISTING CONTIGUOUS 
- DIRECTION OF FLOW 
- SLOPE AREA  4:1 MAX.
- WALL DRAIN 

PROPOSED DESILTATION POND
11,557 CF INV. = 28.90
(85'x2'x82'x4:1 SIDE SLOPES)
SEE CROSS SECTION
SHEET 3C OF 15

25' PRIVATE
SLOPE EASEMENT

PROPOSED DESILTATION POND
16,770 CF INV. = 24.70
(85'x3'x87'x4:1 SIDE SLOPES)
SEE CROSS SECTION
SHEET 3C OF 15.

Bohannon & Huston

 Courtyard One 7500 JEFFERSON NE Albuquerque NEW MEXICO 87109

ENGINEERS PLANNERS PHOTOGRAMMETRISTS SURVEYORS LANDSCAPE ARCHITECTS



CITY OF ALBUQUERQUE
PUBLIC WORKS DEPARTMENT
ENGINEERING DEVELOPMENT GROUP

PARKLAND VIEW SUBDIVISION
GRADING PLAN

DESIGN REVIEW BOARD NO.

APPROVAL DATE

97 / 312

12 / 16 / 97

LAST DESIGN
UPDATE

CITY PROJECT NO.

ZONE MAP NO.

SH

05



4442.98

J-9


38

15

COPYRIGHT BOHANNAN-HUSTON, LLC, 1997
DATE: OCT. 1997

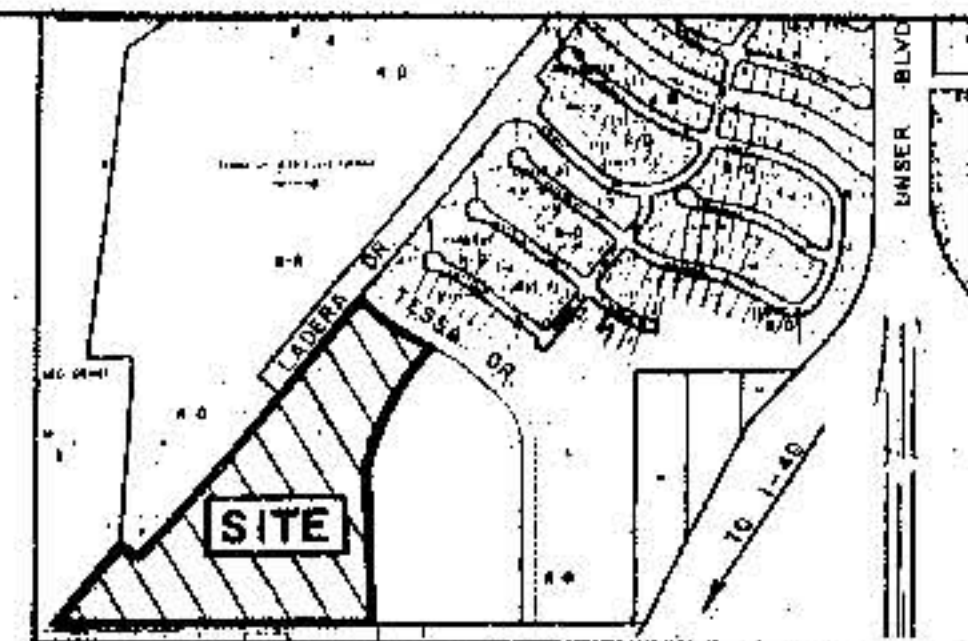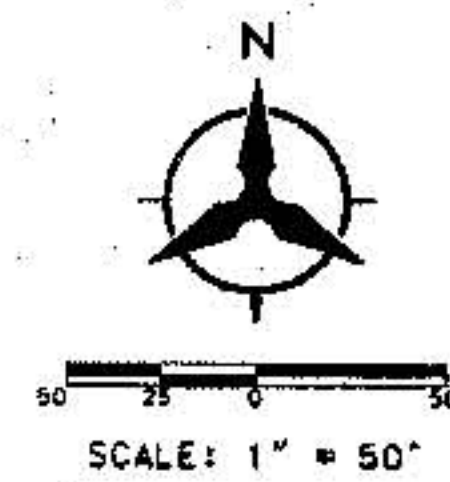


- GENERAL NOTES
1. CONTRACTOR MUST OBTAIN A TOPSOIL DISTURBANCE PERMIT FROM THE ENVIRONMENTAL HEALTH DIVISION PRIOR TO CONSTRUCTION.
 2. THE CONTRACTOR IS TO REFER TO EARTHWORK SPECIFICATION AS NOTED IN THE SOILS REPORT PREPARED BY GED-TEST, INC. DATED 10-13-94 & APRIL 13, 1994.
 3. THE CONTRACTOR SHALL CONFORM TO ALL CITY, COUNTY, STATE, AND FEDERAL DUST CONTROL MEASURES AND REQUIREMENTS AND WILL BE RESPONSIBLE FOR PREPARING AND OBTAINING ALL NECESSARY APPLICATIONS AND APPROVALS.
 4. THE CONTRACTOR SHALL ENSURE THAT NO SOIL ERODES FROM THE LOTS INTO PUBLIC RIGHT-OF-WAY. THIS CAN BE ACHIEVED BY CONSTRUCTING TEMPORARY BERMS AS PER DETAIL SHEET 3 AND NETTING THE SOIL TO KEEP IT FROM BLOWING.
 5. ALL SPOT ELEVATIONS ARE TO FLOWLINE UNLESS OTHERWISE NOTED.
 6. BOULDERS, GREATER THAN 3 FEET IN DIAMETER, EXCAVATED DURING GRADING ACTIVITIES SHALL BE STOCKPILED AND DISPOSED OF AT THE DISCRETION OF THE OWNER.
 7. ALL WALLS SHOWN ARE TO BE PLACED ALONG PROPERTY LINE. (WALLS ARE SHOWN OFFSET FOR VISUAL PURPOSE ONLY.)

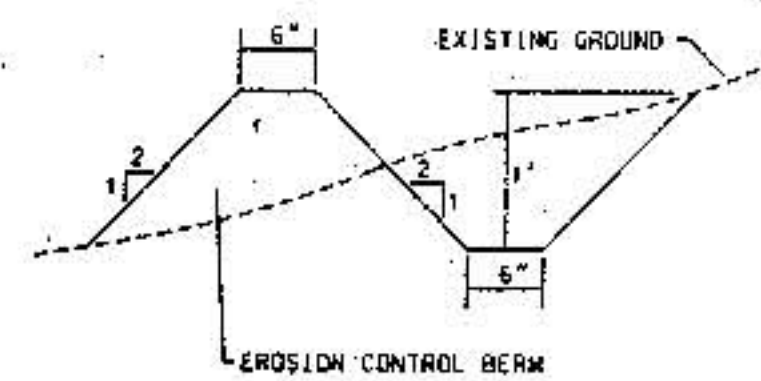

EROSION CONTROL PLAN


NO SCALE

A BERM WITH THE DIMENSIONS SHOWN SHALL BE MAINTAINED DURING CONSTRUCTION UNTIL COMPLETION OF INDIVIDUAL LOTS WITHIN THE PROJECT.

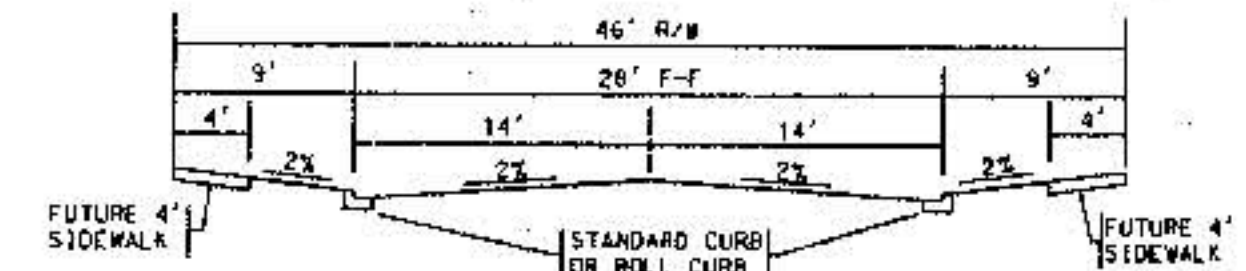

TYPICAL STREET SECTION

NO SCALE

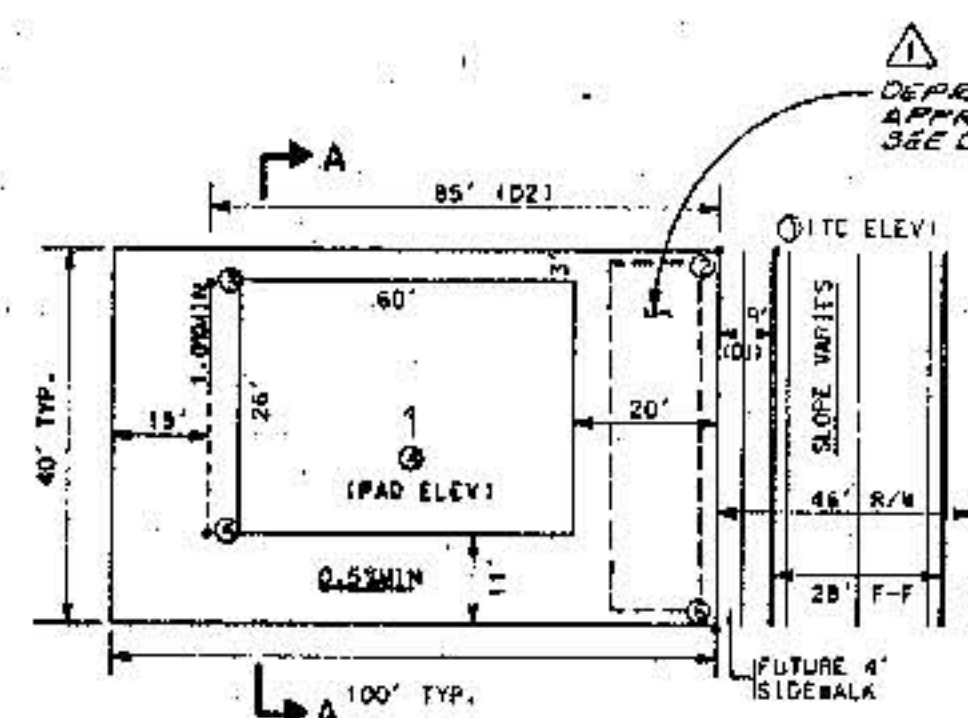

TYPICAL LOT GRADING PLAN

NO SCALE

TO SET SPOT ② - ADD 0.33' TO SPOT ① ON HIGH SIDE OF STREET


TO SET SPOT ③ - MULTIPLY D2 BY 0.5% AND ADD TO SPOT ②

TO SET SPOT ④ - ADD 0.30' TO SPOT ③

TO SET SPOT ⑤ - MULTIPLY D3 BY STREET SLOPE AND SUBTRACT FROM SPOT ④


(CHECK SLOPE FROM SPOT ⑤ TO SPOT ⑥ TO BE MIN 0.5%)

(NOTE: IF STREET SLOPE IS LESS THAN 1% THEN START FROM LOW SIDE OF STREET)

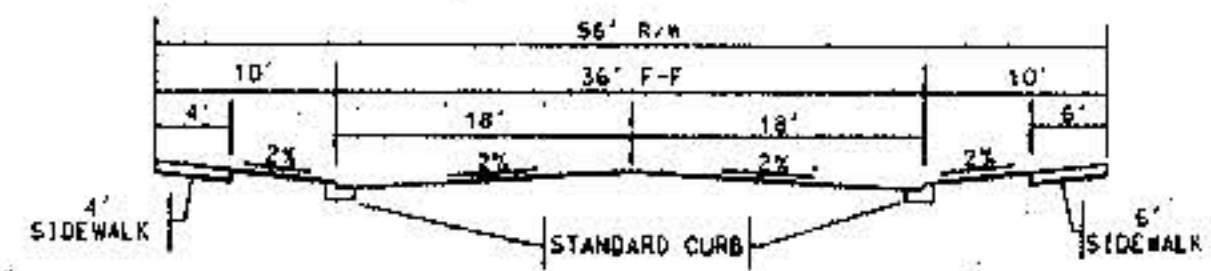


PARKLAND VIEW STREET SECTION

NO SCALE

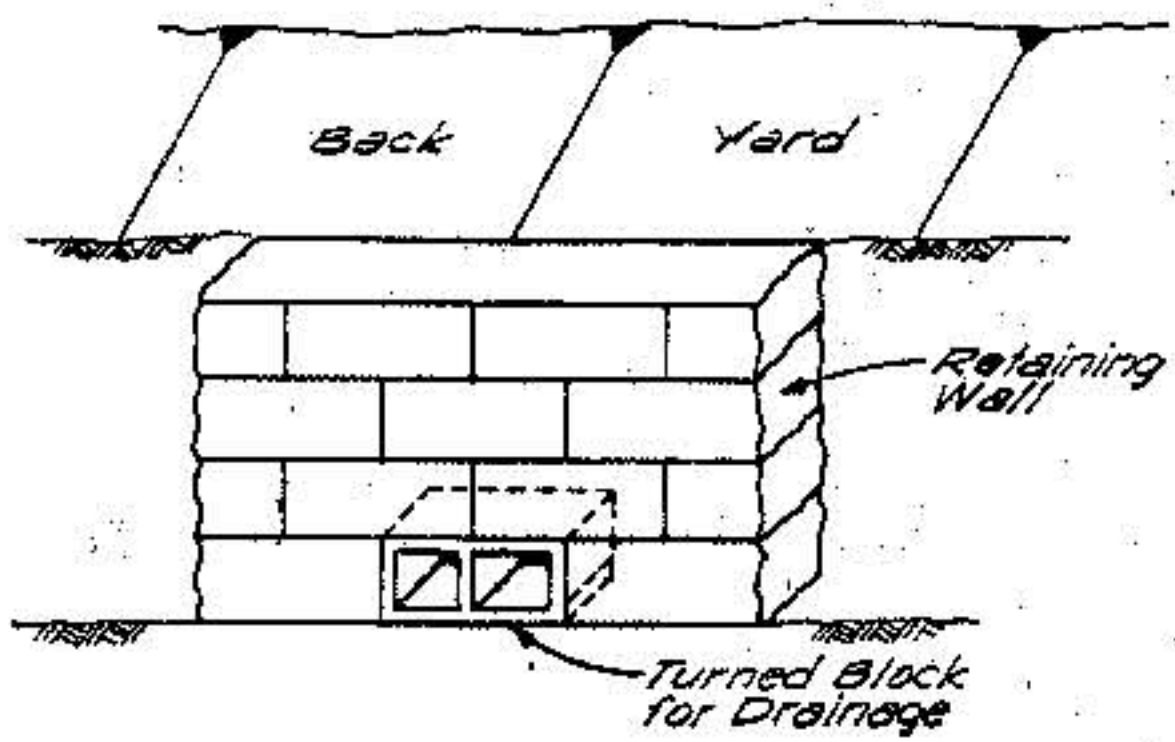


WALL DRAIN DETAIL

NO SCALE

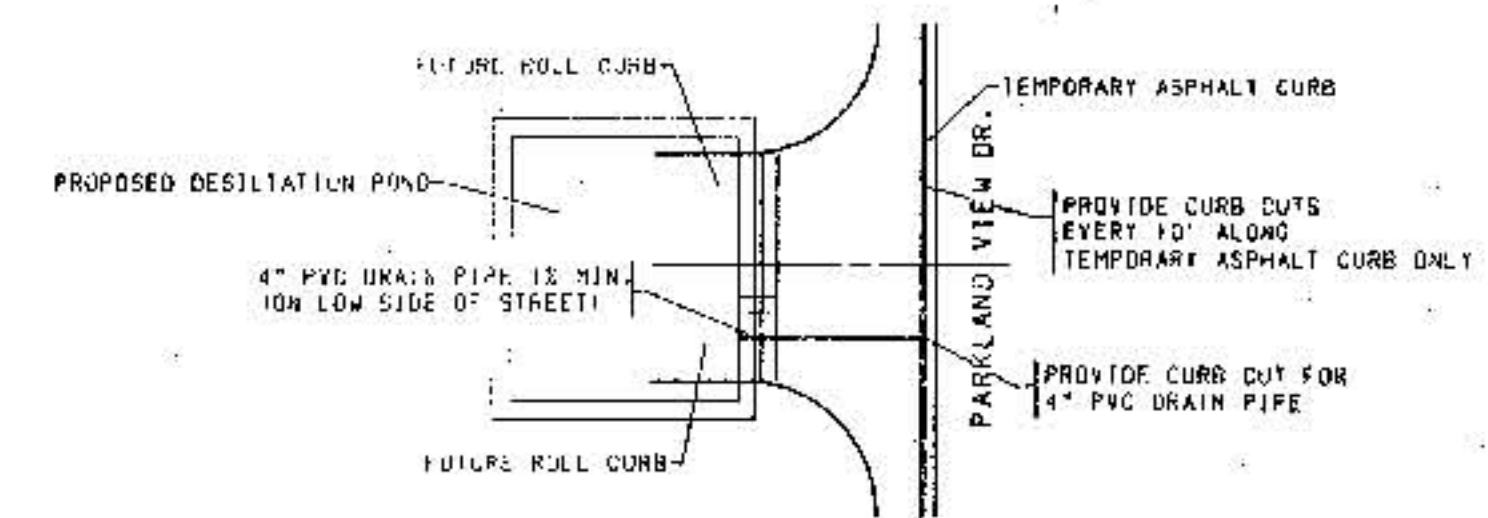


DESILTATION POND DETAIL

NO SCALE

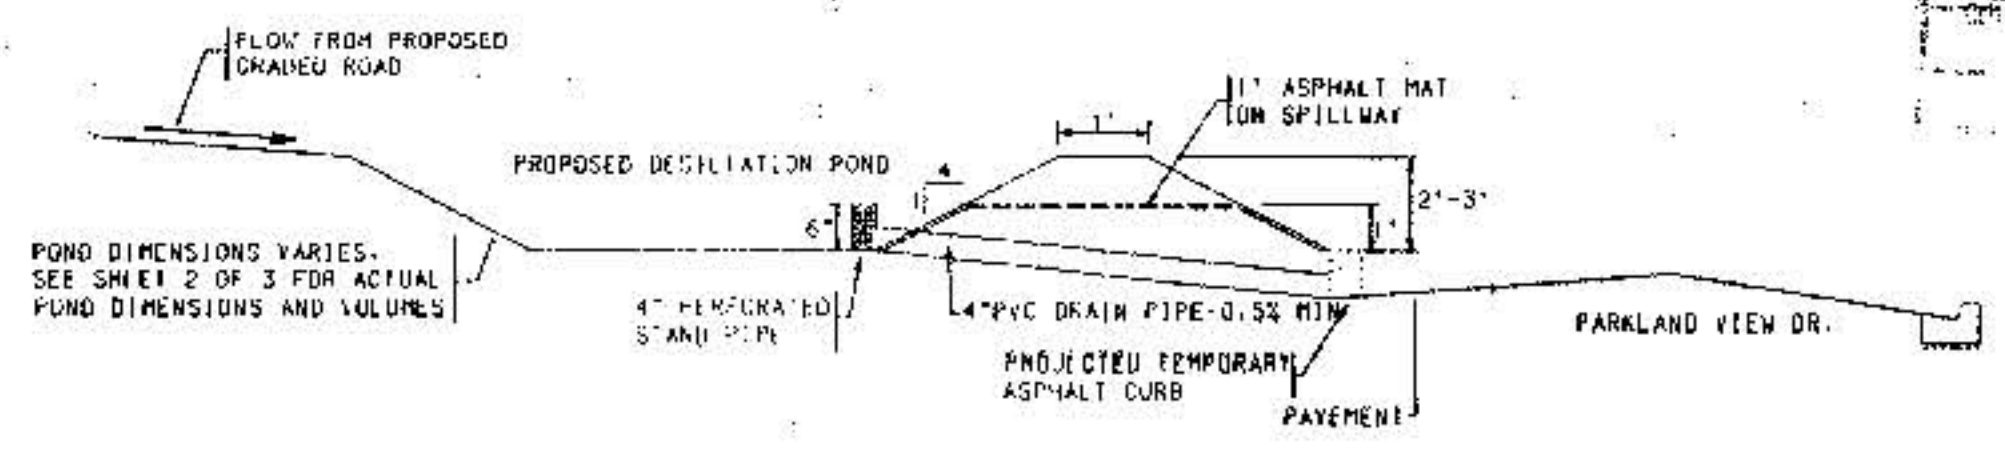

TYPICAL POND CROSS SECTION

NO SCALE

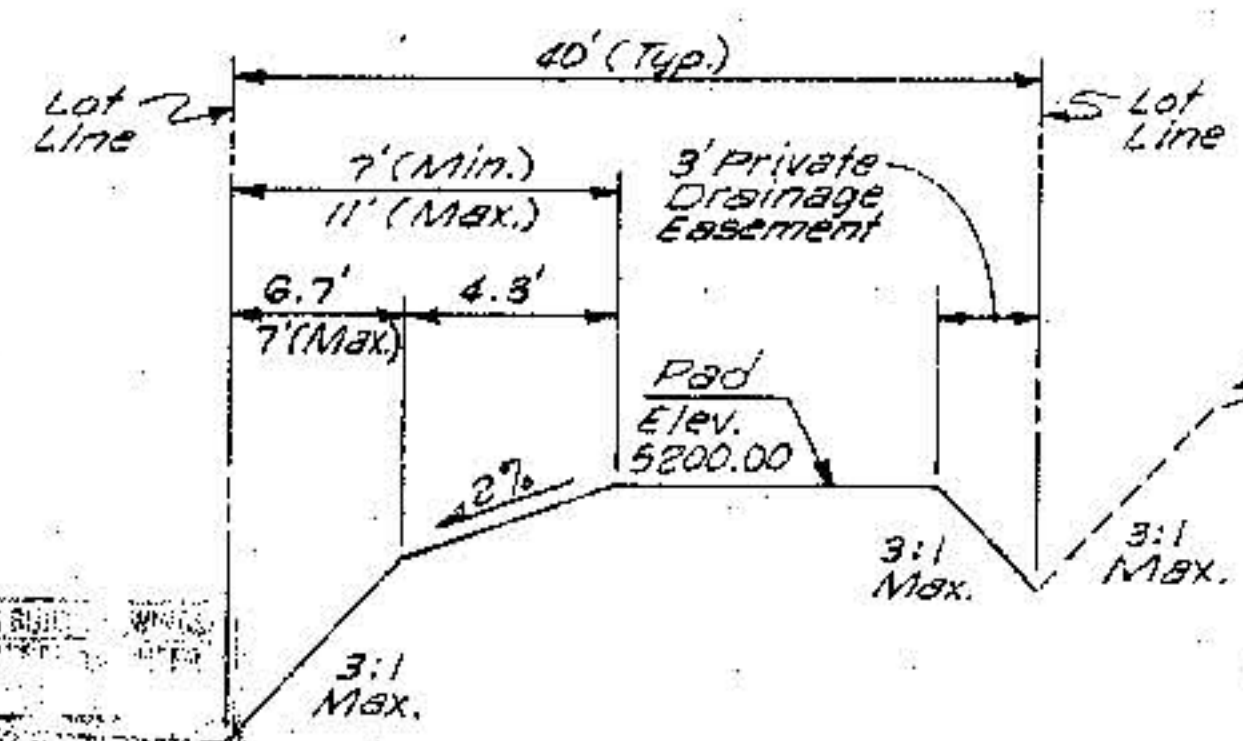

SECTION A-A

TYPICAL LOT CROSS SECTION

NO SCALE

Bohannon + Huston

Courtyard One 7500 JEFFERSON NE Albuquerque NEW MEXICO 87109

ENGINEERS PLANNERS PHOTOGRAMMETRISTS SURVEYORS LANDSCAPE ARCHITECTS

CITY OF ALBUQUERQUE
PUBLIC WORKS DEPARTMENT
ENGINEERING DEVELOPMENT GROUP







PARKLAND VIEW DRIVE
GRADING PLAN

DESIGN REVIEW BOARD NO.	APPROVAL DATE	LAST DESIGN UPDATE
97 / 312	12 / 16 / 97	

CITY PROJECT NO.	ZONE MAP NO.	SHEET	OF
4442.98	J-9	3C	15

NO.	DATE	REMARKS
		DESIGN
		REVISIONS

DESIGNED BY	DATE	CHECKED BY	DATE
PL/TSG	10/97	KP	10/97
PL/TSG	10/97		

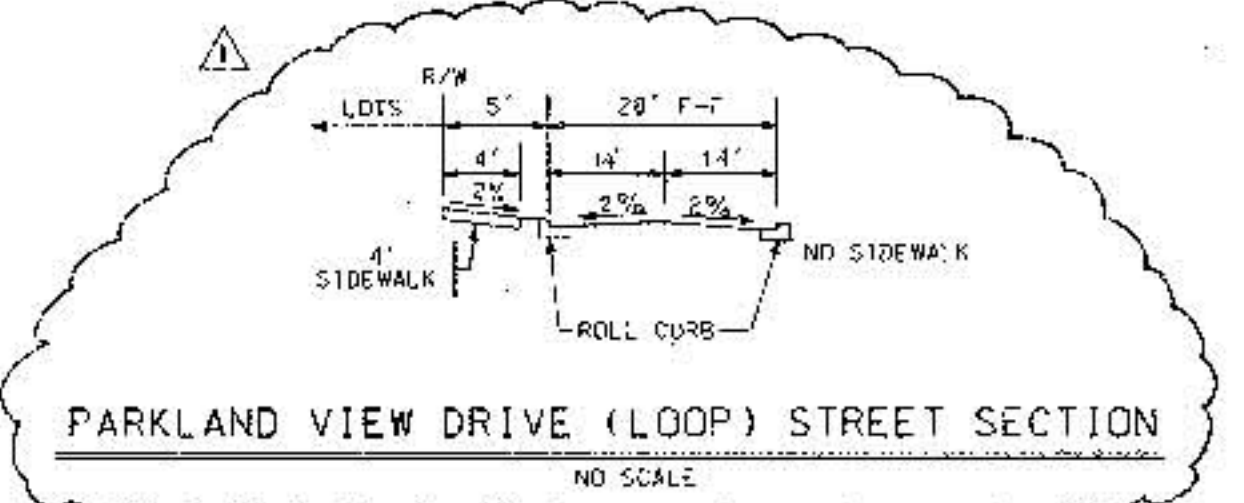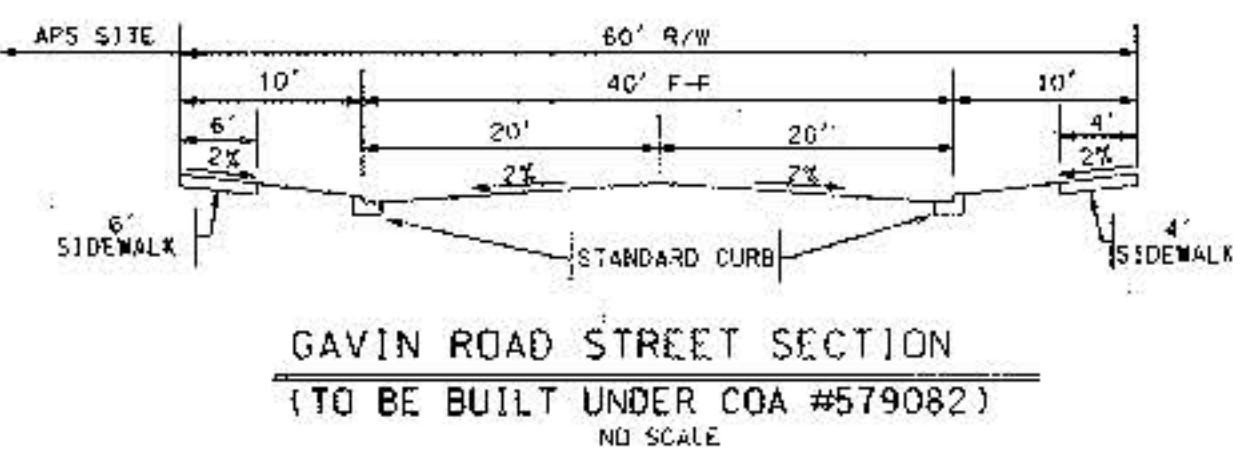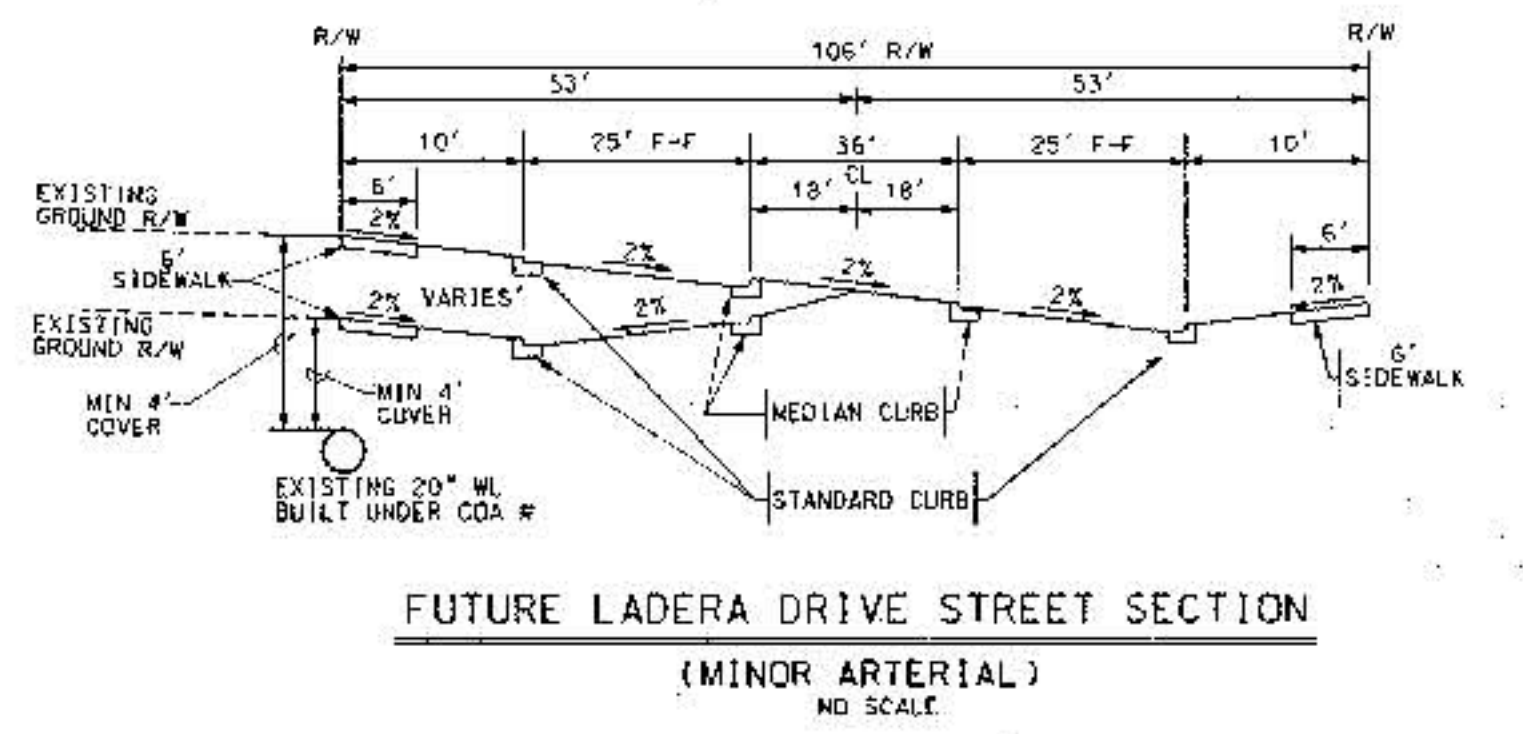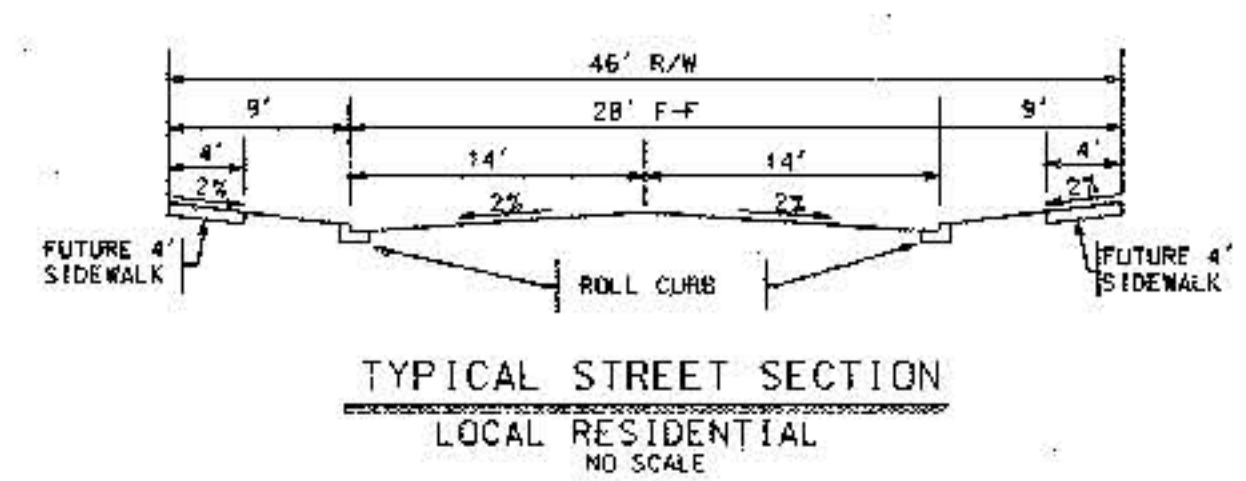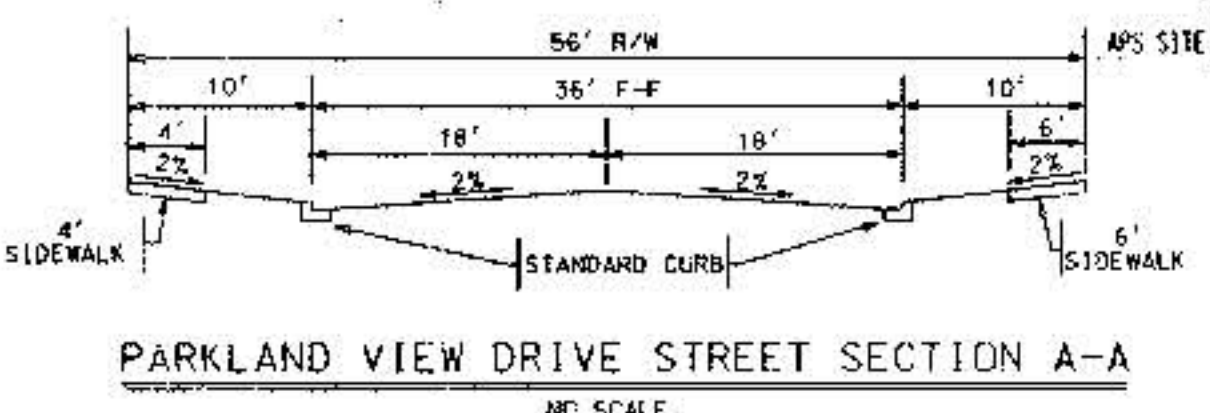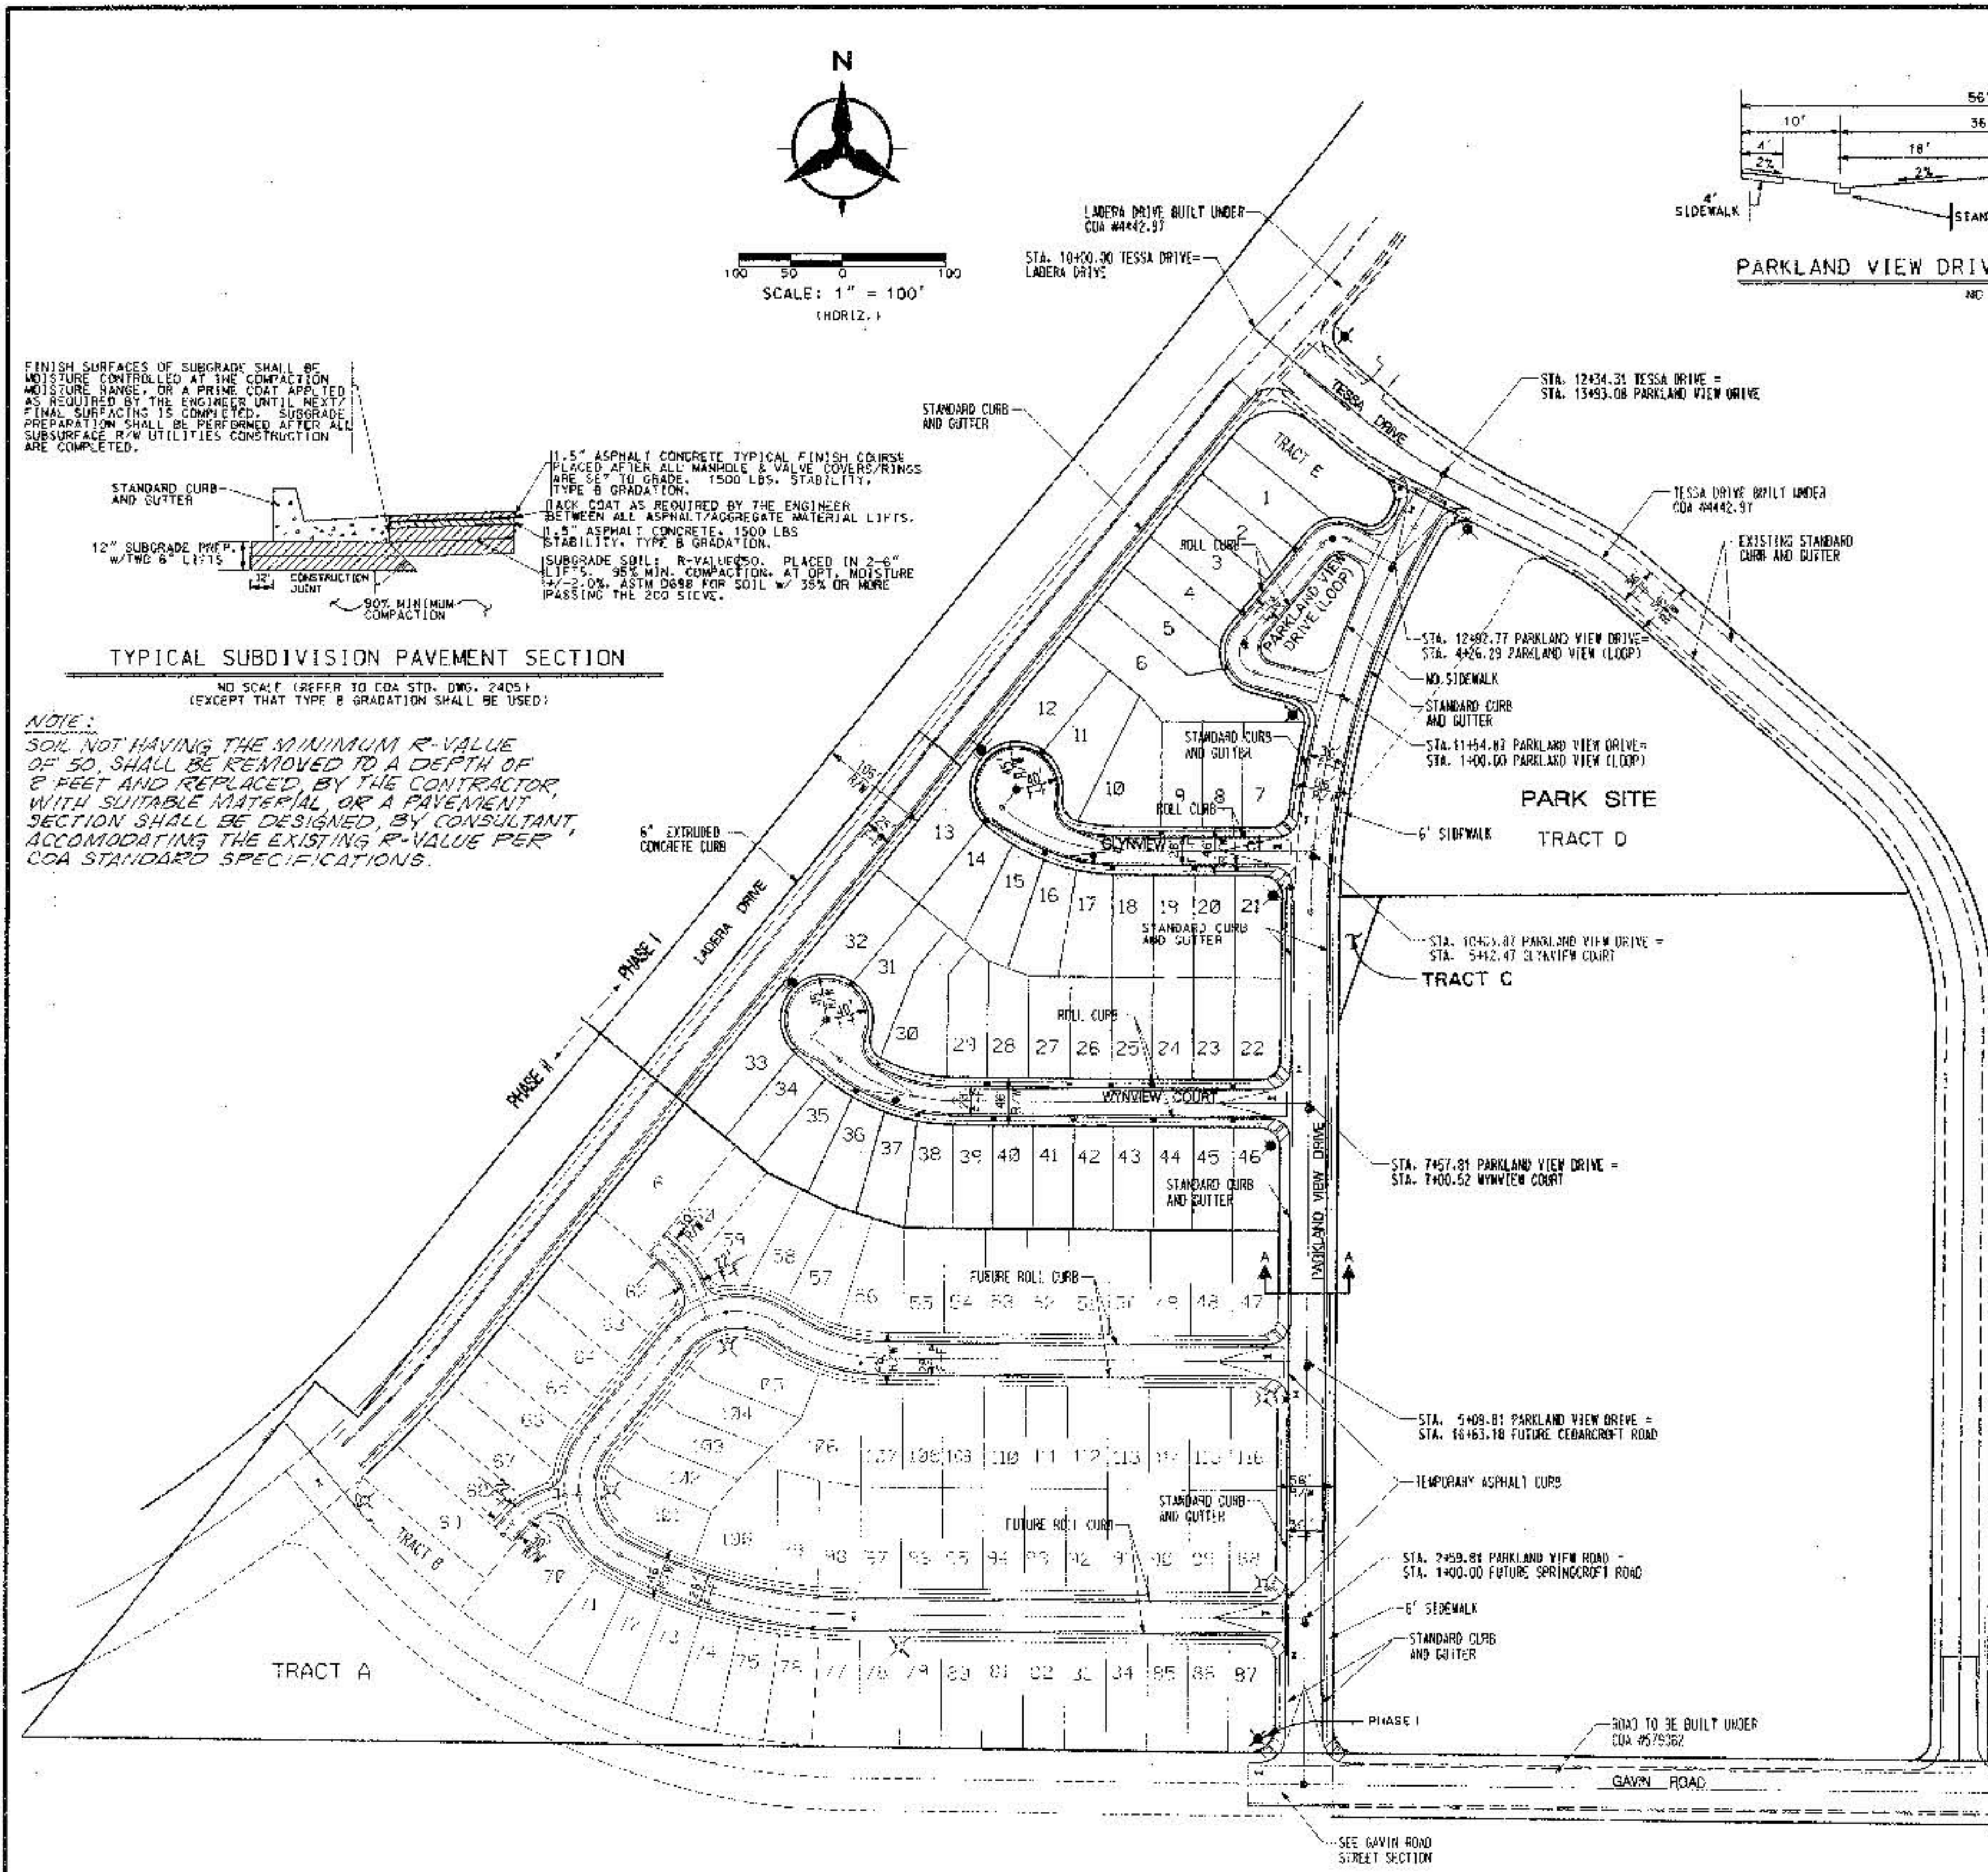

- LEGEND**
- PROPOSED CURB AND GUTTER
 - EXISTING CURB AND GUTTER
 - PROPOSED SANITARY SEWER MANHOLE
 - EXISTING SANITARY SEWER MANHOLE
 - PROPOSED FIRE HYDRANT
 - PROPOSED GATE VALVE
 - EXISTING GATE VALVE
 - PROPOSED STREET LIGHT (PHASE I)
 - FUTURE STREET LIGHT (PHASE II)

I, David C. Clausen, New Mexico Professional Land Surveyor No. 6547, do hereby certify that the as-built information shown herein is the result of a field survey performed by me or under my direct supervision, and that the same is true and correct.

David C. Clausen
 David C. Clausen N.M.L.S. # 6547



Bohannon & Huston
 Courtyard One 7500 JEFFERSON NE ALBUQUERQUE NEW MEXICO 87109
 ENGINEERS PLANNERS PHOTOGRAPHERS SURVEYORS LANDSCAPE ARCHITECTS

CITY OF ALBUQUERQUE PUBLIC WORKS DEPARTMENT ENGINEERING DEVELOPMENT GROUP

PARKLAND VIEW SUBDIVISION - PHASE I OVERALL PAVING PLAN


CITY ENGINEER APPROVAL: [Signature]

CITY PROJECT NO. 4442.98 ZONE MAP NO. J-9 SHEET 4 OF 15

DESIGNED BY TSC DATE 10/97
 DRAWN BY MKC/BJG DATE 10/97
 CHECKED BY KP DATE 10/97


ENGINEER'S SEAL		SURVEY INFORMATION		FIELD NOTES		BENCH MARKS		AS-BUILT INFORMATION	
NO.	DATE	BY	DATE	NO.	DATE	ACCS BRASS TABLE STAMPED "BM-10"	CONTRACTOR	STARTED BY	DATE
						GEOGRAPHIC POSITION (NAD 1983)	Spaulding Const. Co.	Spaulding	8/98
						N.M. STATE PLANE COORDINATES	INSPECTOR	Spaulding	8/98
						(CENTRAL ZONE) X=352,730.66	FIELD	Spaulding	8/98
						Y=1,492,346.53	VERIFICATION BY	Spaulding	8/98
						GROUND-TO-GRID FACTOR = .99961105	CORRECTED BY	Spaulding	8/98
						-000.16"/31"	MICRO-FILM INFORMATION		
						NOV 1999 ELEVATION = 5193.38'	RECORDED BY		



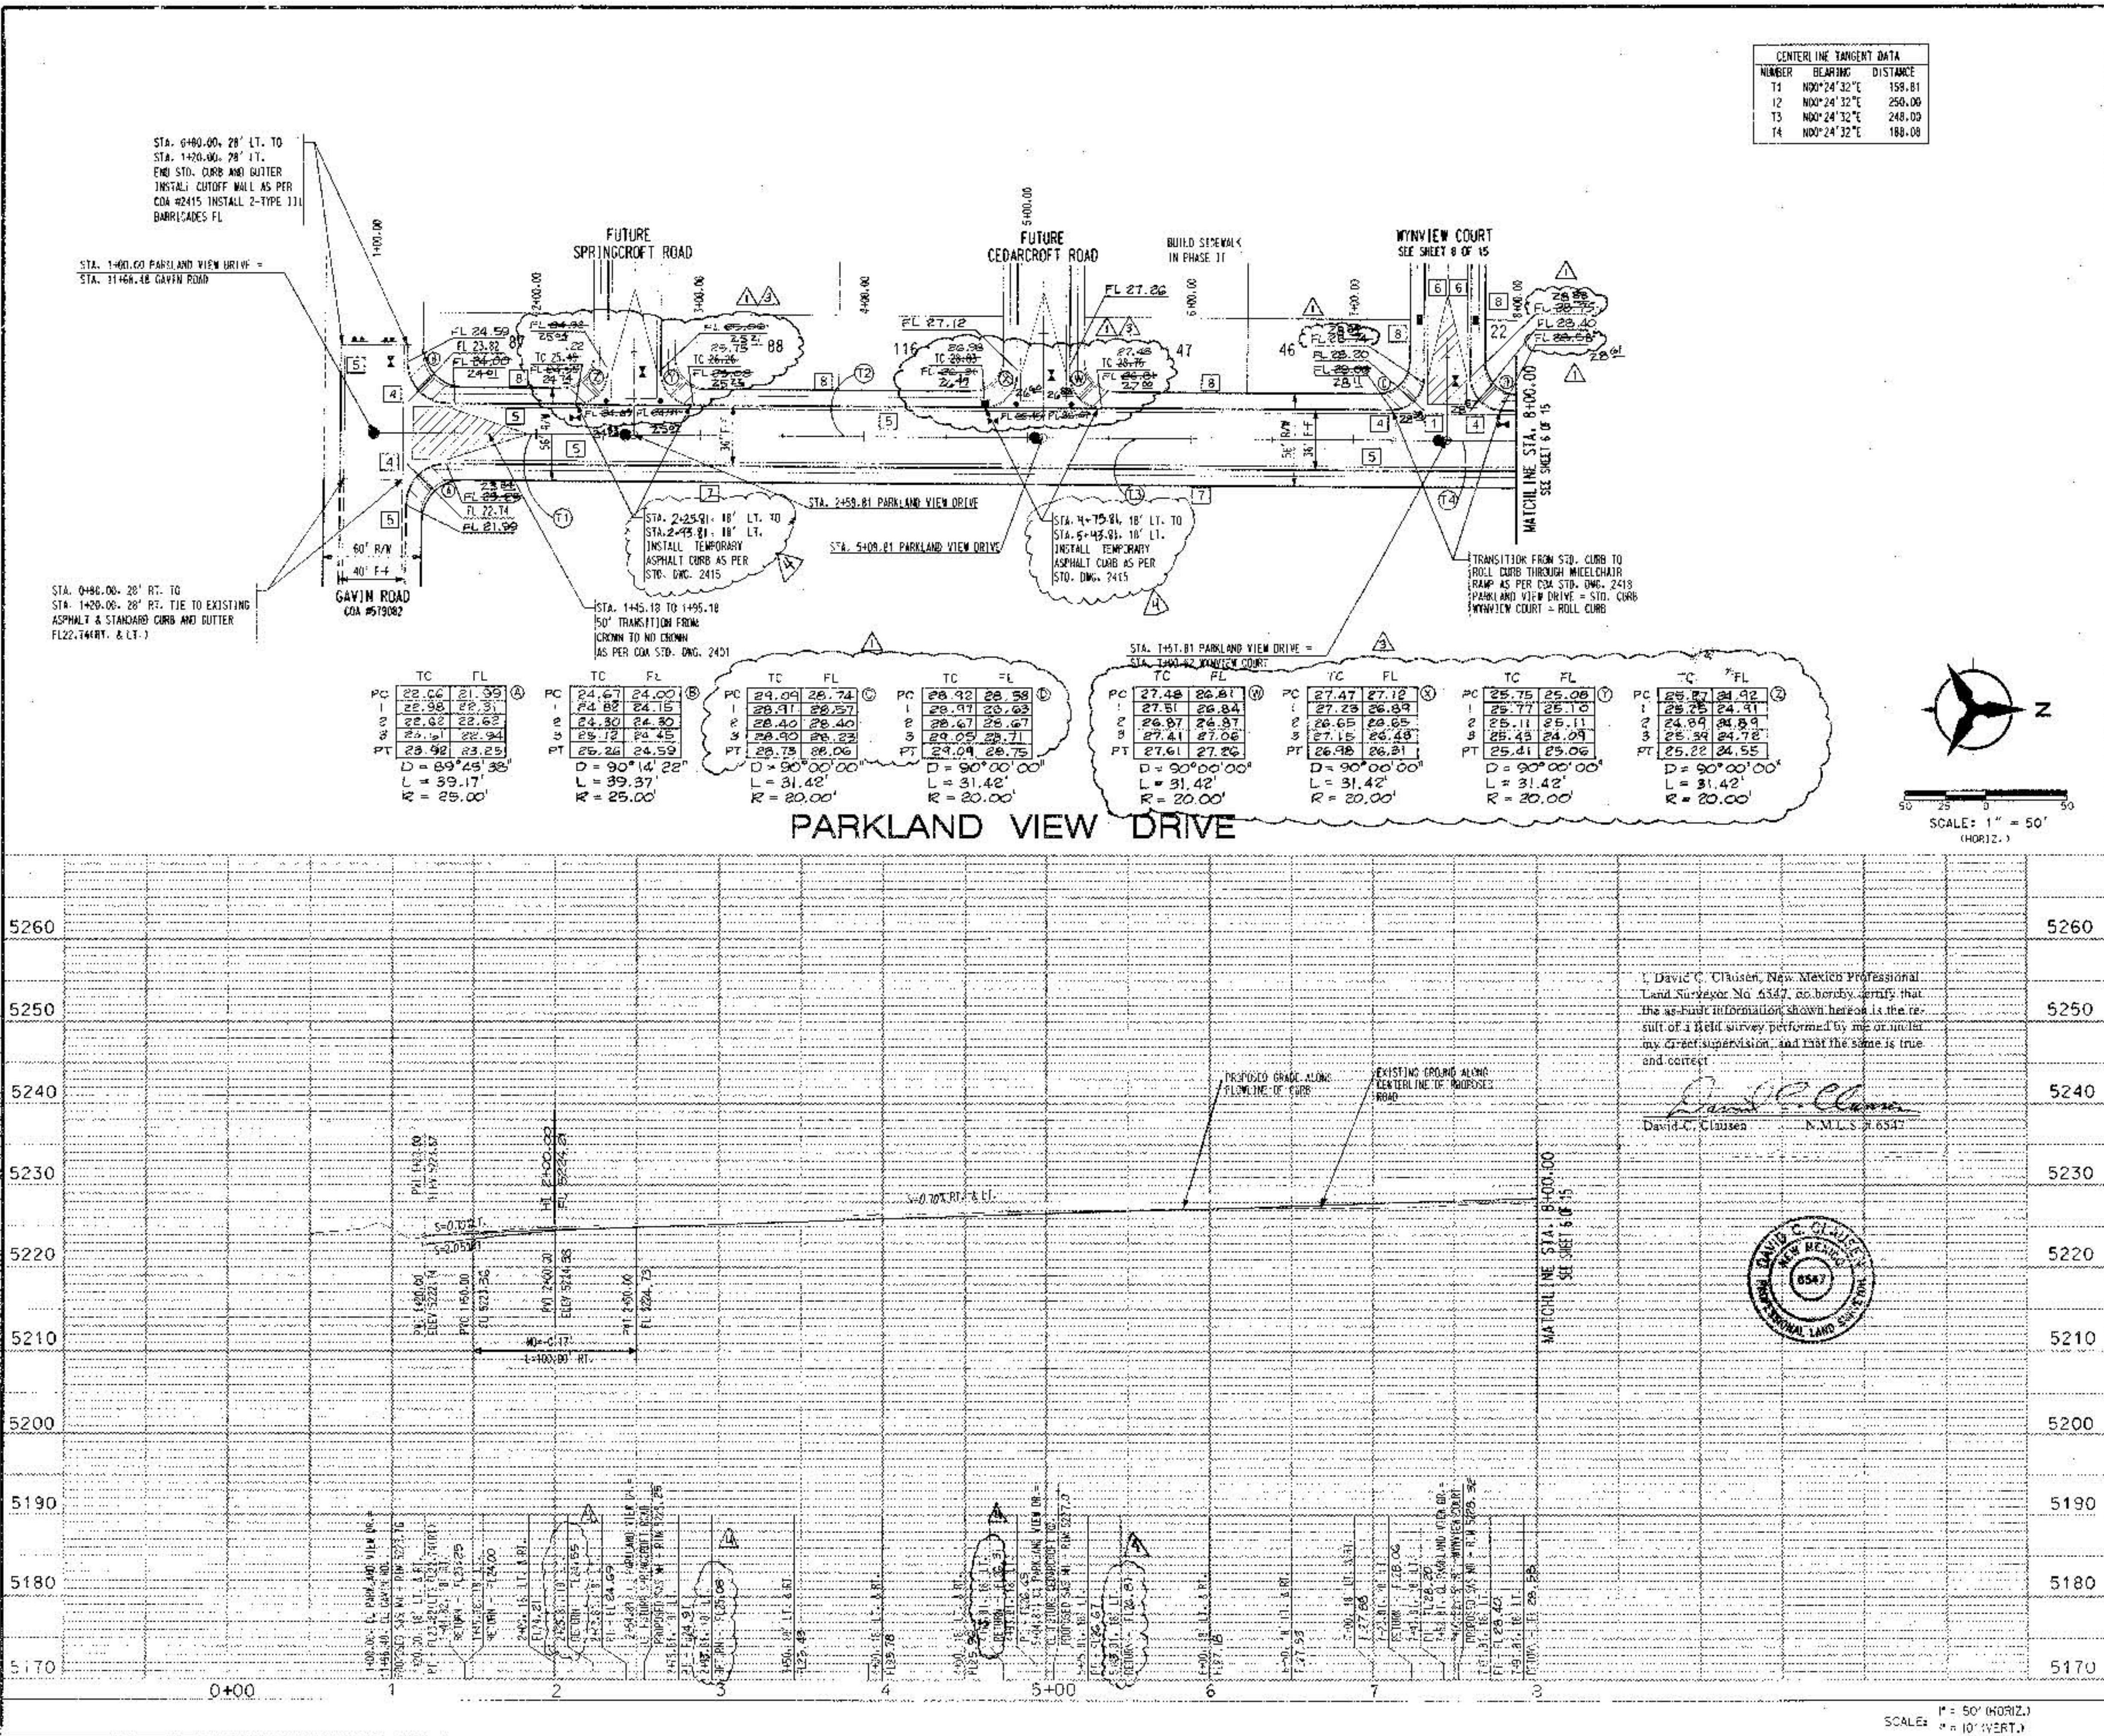

CENTERLINE TANGENT DATA		
NUMBER	BEARING	DISTANCE
T1	N00°24'32"E	159.81
T2	N00°24'32"E	250.00
T3	N00°24'32"E	248.00
T4	N00°24'32"E	188.08

- NOTES
1. THE CONTRACTOR SHALL FIELD VERIFY ALL EXISTING UTILITY LOCATIONS AND NOTIFY THE ENGINEER IMMEDIATELY OF ANY DISCREPANCIES.
 2. ALL CURB RETURN RADIUS SHALL BE 20' UNLESS OTHERWISE SPECIFIED.
 3. ALL CURVE DATA AND DIMENSIONS REFER TO FACE OF CURB UNLESS OTHERWISE SPECIFIED.
 4. GRADE ELEVATIONS, WHERE NOTED, ARE ALONG FLOWLINE OF CURB UNLESS OTHERWISE SPECIFIED.
 5. CONTRACTOR IS TO INSTALL A 4" X 4" X 5' POST AND END AT THE END OF EACH SANITARY SEWER SERVICE.
 6. CONTRACTOR IS RESPONSIBLE FOR REPAIR AND/OR REPLACEMENT OF ALL UTILITY CONDUITS AND EXISTING LINES.
 7. ANY ADDITIONAL GRADING REQUIRED TO MATCH PROPOSED STREET GRADES SHALL BE INCIDENTAL TO PAVING ITEMS.
 8. CONTRACTOR SHALL PROVIDE THE INSPECTORS, (CITY AND PRIVATE) WITH THE PROPOSED HYDROSTATIC TESTING PLAN. THE PLAN MUST BE APPROVED BEFORE TESTING OPERATIONS BEGIN.
 9. CONTRACTOR SHALL PARK EQUIPMENT AND VEHICLES AS NOT TO INTERFERE WITH NORMAL ACTIVITIES OF RESIDENTS OR OTHER CONTRACTORS ON SITE.
 10. ANY DAMAGE TO THE EXISTING FACILITIES (CURB & GUTTER), PAVEMENT, CONDUITS, LANDSCAPING, UTILITY LINES, ETC.) DURING CONSTRUCTION SHALL BE REPLACED AT THE CONTRACTORS EXPENSE.
 11. REMOVAL OF THE EXISTING CURB AND GUTTER SHALL BE AS PER COA STD. DWG. 2415 (SAW CUT ONLY).
 12. WHEELCHAIR RAMP SHALL BE CONSTRUCTED PRIOR TO ACCEPTANCE OF CURB & GUTTER.

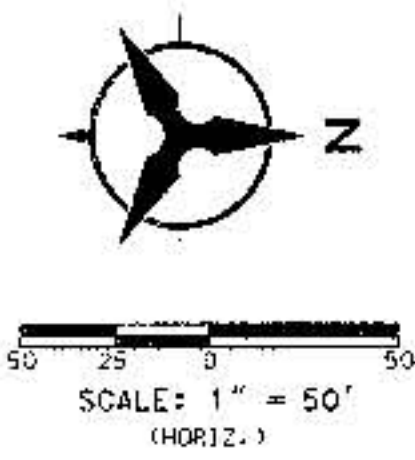

KEYED GENERAL NOTES

1. INSTALL CONCRETE VALLEY GUTTER AS PER STD. DWG. 2420
2. INSTALL CONCRETE VALLEY GUTTER AS PER STD. DWG. 2421
3. INSTALL WHEELCHAIR RAMP AS PER STD. DWG. 2441, CASE I
4. INSTALL WHEELCHAIR RAMP AS PER STD. DWG. 2441, CASE II WITH ALTERNATE SECTION AA
5. STD. CURB & GUTTER AS PER STD. DWG. 2415
6. ROLL CURB & GUTTER AS PER STD. DWG. 2415
7. BUILD 6' SIDEWALK
8. FUTURE 4' SIDEWALK
9. BUILD 4' SIDEWALK

Bohannon & Huston
7500 JEFFERSON NE ALBUQUERQUE NEW MEXICO 87109
ENGINEERS PLANNERS PHOTOGRAMMETRISTS SURVEYORS LANDSCAPE ARCHITECTS

CITY OF ALBUQUERQUE
PUBLIC WORKS DEPARTMENT
ENGINEERING DEVELOPMENT GROUP

PARKLAND VIEW SUBDIVISION - PHASE I
PAVING PLAN & PROFILE
PARKLAND VIEW DRIVE STA 0+70.00 TO 8+00.00

DESIGNED BY	TSG/PL	DATE	11/97
DRAWN BY	TSG/MKC/BIG	DATE	11/97
CHECKED BY	KP	DATE	11/97


AS-BUILT INFORMATION		BENCH MARKS		SURVEY INFORMATION		FIELD NOTES	
CONTRACTOR	Bohannon & Huston	ACS BRASS TABLET STAMPED	BM-40"	NO.	BY	NO.	BY
DATE	8/98	GEODETIC POSITION (NAD 1983)					
DATE	8/98	N.M. STATE PLANE COORDINATES					
DATE	8/98	(CENTRAL ZONE) X=3527790.66					
DATE	8/98	Y=1492346.53					
DATE	8/98	GROUND-TO-GRID FACTOR = .99967105					
DATE	8/98	NOVD 1929 ELEVATION = 5193.38'					

CENTERLINE TANGENT DATA			
NUMBER	BEARING	DISTANCE	
14	N00°24'33"E	188.00	
15	N30°07'20"E	56.24	
16	N55°04'41"W	87.00	
17	N39°30'01"E	117.76	
18	S61°30'17"E	50.63	

CENTERLINE CURVE DATA			
NUMBER	DELTA	TANGENT	ARC RADIUS
C1	15°51'50"	105.17	208.81
C2	11°32'42"	75.82	151.32
C3	10°32'01"	69.15	137.51
C4	07°12'43"	21.04	42.06
C5	114°34'42"	32.70	42.06
C6	78°51'31"	17.27	28.90

I, David C. Clausen, New Mexico Professional Land Surveyor No. 6547, do hereby certify that the as-built information shown hereon is the result of a field survey performed by me or under my direct supervision, and that the same is true and correct.

David C. Clausen
David C. Clausen N.M.L.S. #6547

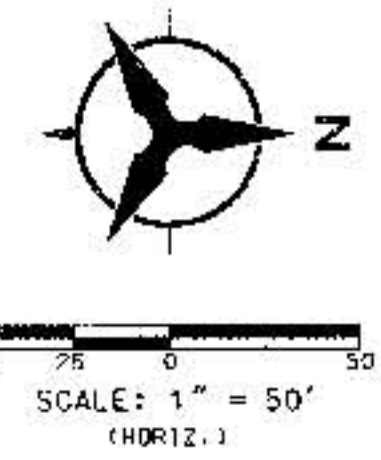

- NOTES
1. THE CONTRACTOR SHALL FIELD VERIFY ALL EXISTING UTILITY LOCATIONS AND NOTIFY THE ENGINEER IMMEDIATELY OF ANY DISCREPANCIES.
 2. ALL CURB RETURN RADII SHALL BE 20' UNLESS OTHERWISE SPECIFIED.
 3. ALL CURVE DATA AND DIMENSIONS REFER TO FACE OF CURB UNLESS OTHERWISE SPECIFIED.
 4. GRADE ELEVATIONS, WHERE NOTED, ARE ALONG FLOWLINE OF CURB UNLESS OTHERWISE SPECIFIED.
 5. CONTRACTOR IS TO INSTALL A 4" X 4" X 5' POST AND EMD AT THE END OF EACH SANITARY SEWER SERVICE.
 6. CONTRACTOR IS RESPONSIBLE FOR REPAIR AND/OR REPLACEMENT OF ALL UTILITY CONDUITS AND EXISTING LINES.
 7. ANY ADDITIONAL GRADING REQUIRED TO MATCH PROPOSED STREET GRADES SHALL BE INCIDENTAL TO PAVING ITEMS.
 8. CONTRACTOR SHALL PROVIDE THE INSPECTORS (CITY AND PRIVATE) WITH THE PROPOSED HYDROSTATIC TESTING PLAN. THE PLAN MUST BE APPROVED BEFORE TESTING OPERATIONS BEGIN.
 9. CONTRACTOR SHALL PARK EQUIPMENT AND VEHICLES AS NOT TO INTERFERE WITH NORMAL ACTIVITIES OF RESIDENTS OR OTHER CONTRACTORS ON SITE.
 10. ANY DAMAGE TO THE EXISTING FACILITIES (CURB & GUTTER), PAVEMENT, CONDUITS, LANDSCAPING, UTILITY LINES, ETC.) DURING CONSTRUCTION SHALL BE REPLACED AT THE CONTRACTORS' EXPENSE.
 11. REMOVAL OF THE EXISTING CURB AND GUTTER SHALL BE AS PER COA STD. DWG. 2415 (SAFETY ONLY).
 12. WHEELCHAIR RAMPS SHALL BE CONSTRUCTED PRIOR TO ACCEPTANCE OF CURB & GUTTER.

AS-BUILT INFORMATION			
CONTRACTOR	DATE	BY	NO.
Bohannon & Huston	8/98		
BENCH MARKS			
ACCS BRASS TABLE STAMPED	DATE	BY	NO.
1927	8/98		
SURVEY INFORMATION			
DATE	BY	NO.	NO.
8/98			
FIELD NOTES			
DATE	BY	NO.	NO.
8/98			
ENGINEER'S SEAL			
DATE	BY	NO.	NO.
8/98			

- KEYED GENERAL NOTES
1. INSTALL CONCRETE VALLEY GUTTER AS PER STD. DWG. 2420
 2. INSTALL CONCRETE VALLEY GUTTER AS PER STD. DWG. 2421
 3. INSTALL WHEEL CHAIR RAMP AS PER STD. DWG. 2441, CASE 1
 4. INSTALL WHEELCHAIR RAMP AS PER STD. DWG. 2441, CASE 11 WITH ALTERNATE SECTION AA
 5. STD. CURB & GUTTER AS PER STD. DWG. 2415
 6. ROLL CURB & GUTTER AS PER STD. DWG. 2415
 7. BUILD 6' SIDEWALK
 8. FUTURE 4' SIDEWALK
 9. BUILD 4' SIDEWALK



Bohannon & Huston
 Courtyard One 7500 JEFFERSON NE, ALBUQUERQUE, NEW MEXICO 87109
 ENGINEERS PLANNERS PHOTOGRAMMETRISTS SURVEYORS LANDSCAPE ARCHITECTS

CITY OF ALBUQUERQUE
 PUBLIC WORKS DEPARTMENT
 ENGINEERING DEVELOPMENT GROUP

PARKLAND VIEW SUBDIVISION - PHASE I
 PAVING PLAN & PROFILE
 PARKLAND VIEW DRIVE STA. 8+00.00 TO 13+93.08 & (LOOP)

DESIGNED BY TSC/PL DATE 11/97
 DRAWN BY TSC/ANK/PLG DATE 11/97
 CHECKED BY KP DATE 11/97

CITY PROJECT NO. 4442.98 ZONE MAP NO. J-9 SHEET 6 OF 15

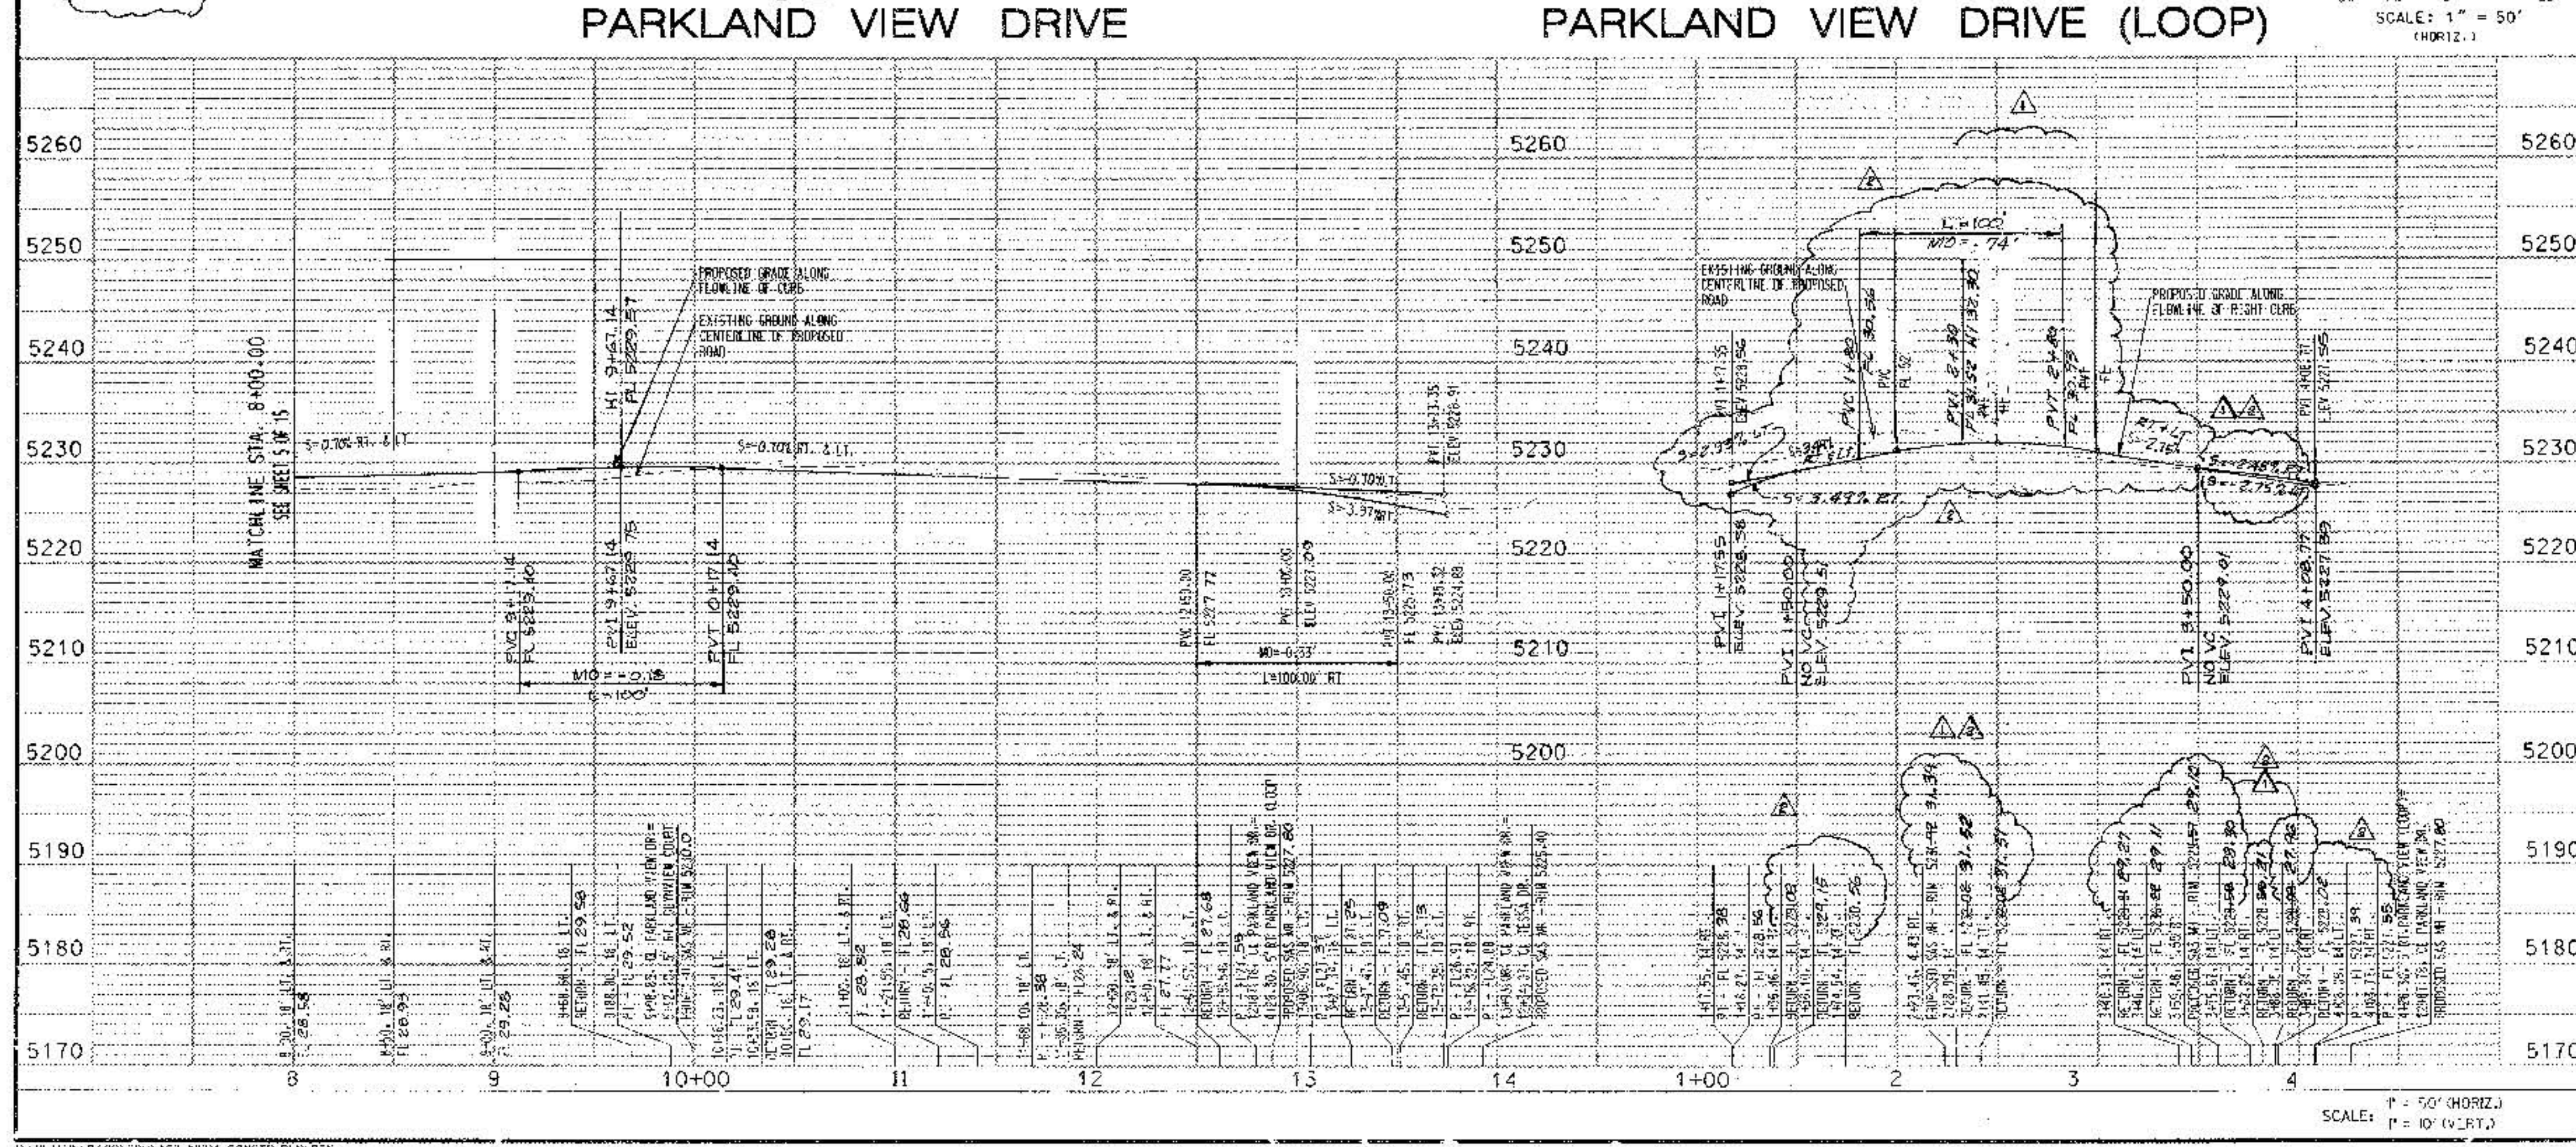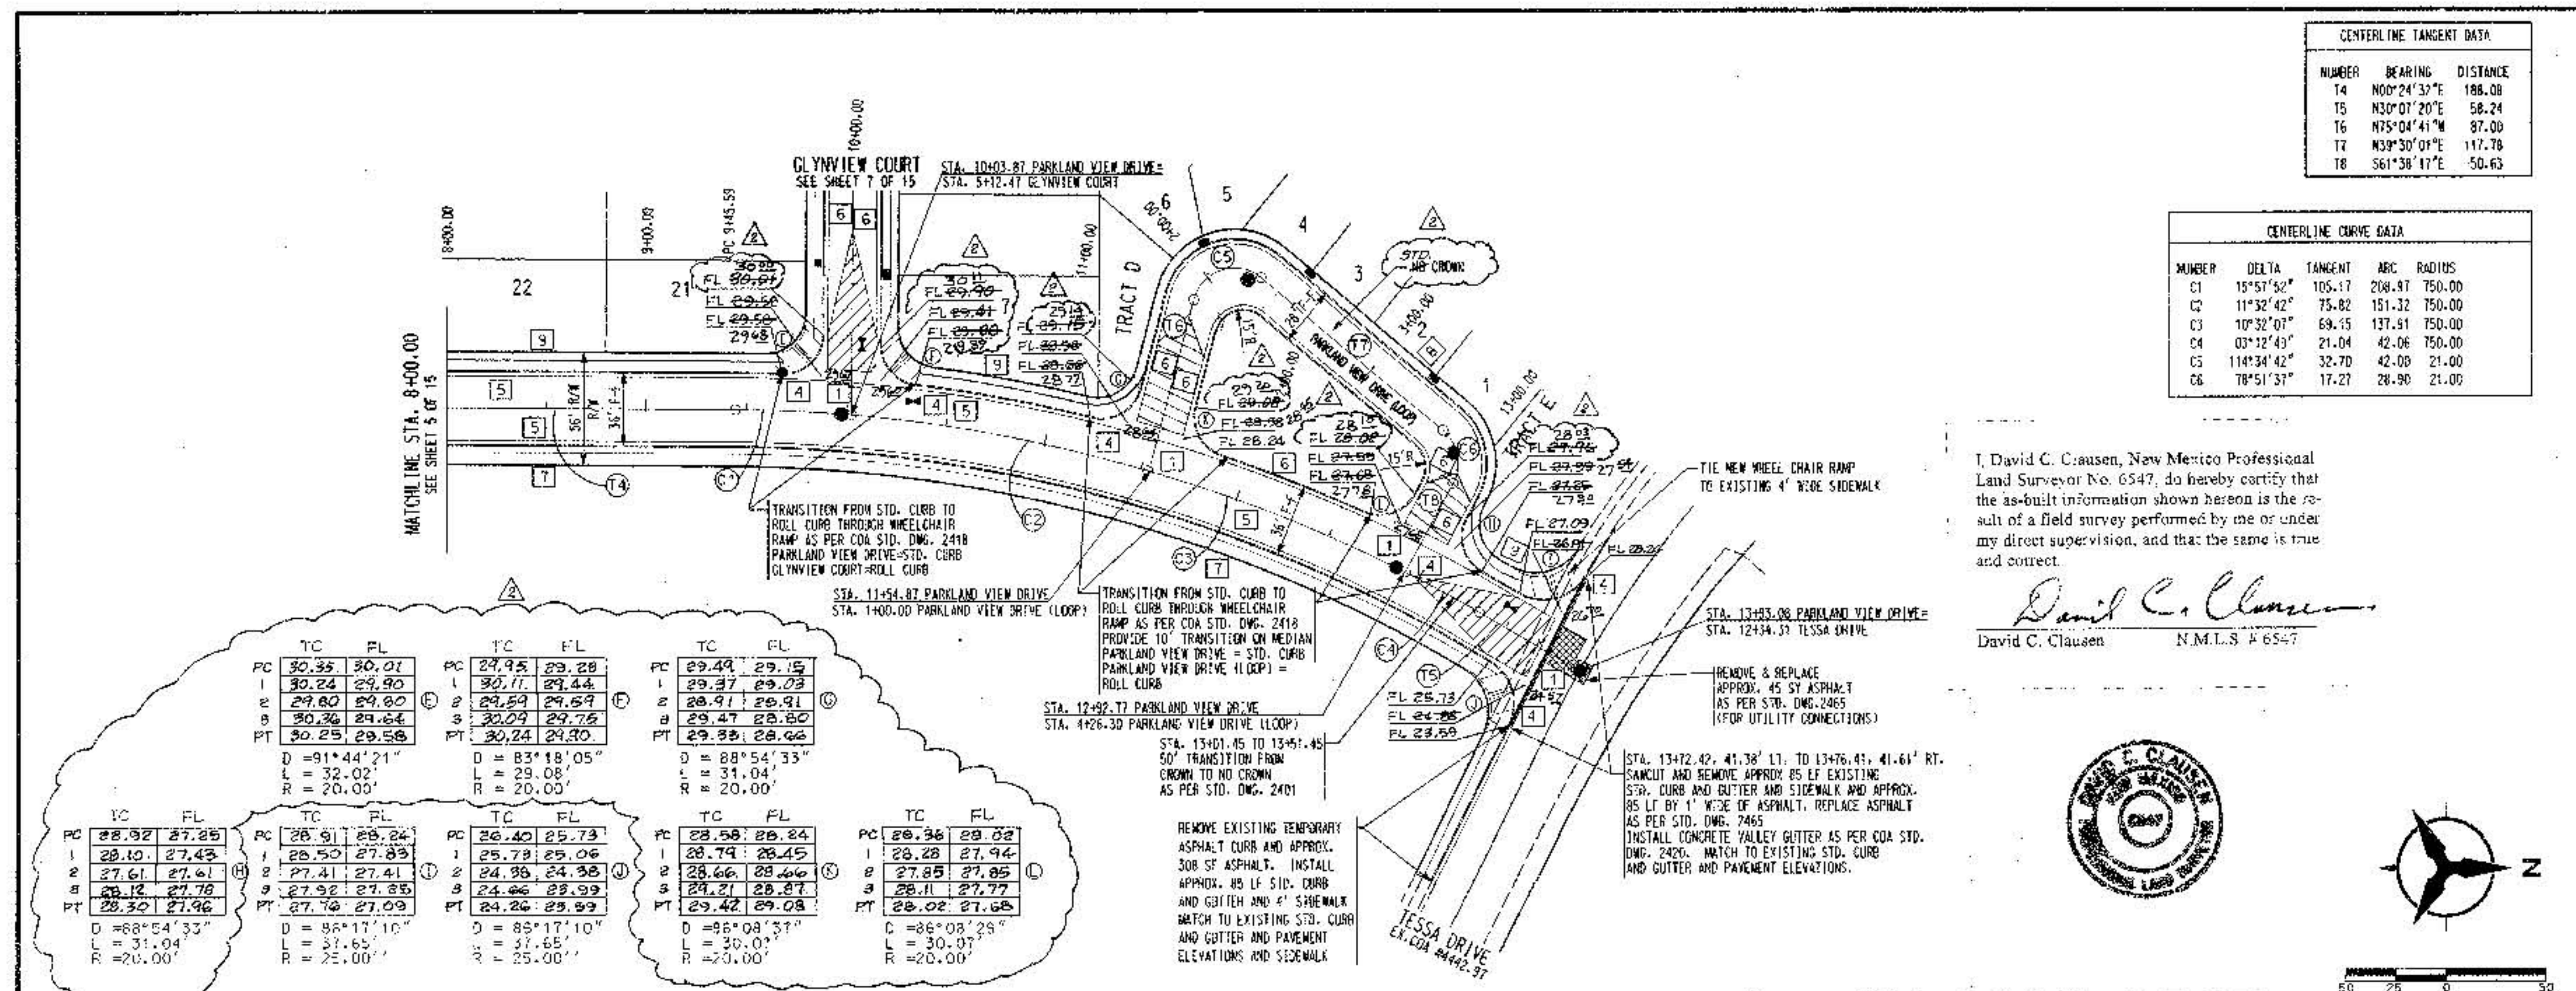

CENTERLINE TANGENT DATA		
NUMBER	BEARING	DISTANCE
T1	S39°28'32"W	22.00
T2	S89°35'28"E	189.55

CENTERLINE CURVE DATA				
NUMBER	DELTA	TANGENT	ARC	RADIUS
C1	39°07'21"	63.96	122.91	180.00

TC		FL		TC		FL	
PC	30.55	50.01	(E)	PC	29.95	29.83	(F)
1	30.24	28.90		1	30.11	27.79	
2	29.90	28.70		2	29.59	29.59	
3	30.56	29.16		3	30.05	29.75	
PT	30.25	29.38		PT	30.24	29.90	
D = 91°44'21"				D = 83°18'05"			
L = 32.02'				L = 29.08'			
R = 20.00'				R = 20.00'			

CUL-DE-SAC CURB DATA		
PI	FL	STATION & OFFSET
36.34	1	2445.00, 15.23' RT.
37.00	2	2445.00, 17.80' RT.
37.50	3	2445.00, 20.37' RT.
38.00	4	2445.00, 22.94' RT.
38.50	5	2445.00, 25.51' RT.
39.00	6	2445.00, 28.08' RT.
39.50	7	2445.00, 30.65' RT.
40.00	8	2445.00, 33.22' RT.

STA. 2476.24 TO 3424.24
50' TRANSITION FROM
NO CROWN TO CROWN
AS PER COA STD. DWG. 2401

TRANSITION FROM ROLL CURB TO
STANDARD CURB THROUGH WHEELCHAIR
RAMP AS PER COA STD. DWG. 2418
GLYNVIEW COURT = ROLL CURB
PARKLAND VIEW DRIVE = STD. CURB

GLYNVIEW COURT

I, David C. Clausen, New Mexico Professional
Land Surveyor No. 6347, do hereby certify that
the as-built information shown hereon is the re-
sult of a field survey performed by me or under
my direct supervision, and that the same is true
and correct.

David C. Clausen
David C. Clausen N.M.L.S. # 6347



SCALE: 1" = 50'
(HORIZ.)

NOTES

1. THE CONTRACTOR SHALL FIELD VERIFY ALL EXISTING UTILITY LOCATIONS AND NOTIFY THE ENGINEER IMMEDIATELY OF ANY DISCREPANCIES.
2. ALL CURB RETURN RADIUS SHALL BE 20' UNLESS OTHERWISE SPECIFIED.
3. ALL CURVE DATA AND DIMENSIONS REFER TO FACE OF CURB UNLESS OTHERWISE SPECIFIED.
4. GRADE ELEVATIONS, WHERE NOTED, ARE ALONG FLOWLINE OF CURB UNLESS OTHERWISE SPECIFIED.
5. CONTRACTOR IS TO INSTALL A 4" X 4" X 5' POST AND EMD AT THE END OF EACH SANITARY SEWER SERVICE.
6. CONTRACTOR IS RESPONSIBLE FOR REPAIR AND/OR REPLACEMENT OF ALL UTILITY CONDUITS AND EXISTING LINES.
7. ANY ADDITIONAL GRADING REQUIRED TO MATCH PROPOSED STREET GRADES SHALL BE INCIDENTAL TO PAVING ITEMS.
8. CONTRACTOR SHALL PROVIDE THE INSPECTORS (CITY AND PRIVATE) WITH THE PROPOSED HYDROSTATIC TESTING PLAN. THE PLAN MUST BE APPROVED BEFORE TESTING OPERATIONS BEGIN.
9. CONTRACTOR SHALL PARK EQUIPMENT AND VEHICLES AS NOT TO INTERFERE WITH NORMAL ACTIVITIES OF RESIDENTS OR OTHER CONTRACTORS ON SITE.
10. ANY DAMAGE TO THE EXISTING FACILITIES (CURB & GUTTER), PAVEMENT, CONDUITS, LANDSCAPING, UTILITY LINES, ETC.) DURING CONSTRUCTION SHALL BE REPLACED AT THE CONTRACTORS' EXPENSE.
11. REMOVAL OF THE EXISTING CURB AND GUTTER SHALL BE AS PER COA STD. DWG. 2415 (SAW CUT ONLY).
12. WHEELCHAIR RAMPS SHALL BE CONSTRUCTED PRIOR TO ACCEPTANCE OF CURB & GUTTER.

KEYED GENERAL NOTES

1. INSTALL CONCRETE VALLEY GUTTER AS PER STD. DWG. 2420
2. INSTALL CONCRETE VALLEY GUTTER AS PER STD. DWG. 2421
3. INSTALL WHEELCHAIR RAMP AS PER STD. DWG. 2441, CASE 1
4. INSTALL WHEELCHAIR RAMP AS PER STD. DWG. 2441, CASE II WITH A. TERNATE SECTION AA
5. STD. CURB & GUTTER AS PER STD. DWG. 2415
6. ROLL CURB & GUTTER AS PER STD. DWG. 2415
7. BUILD 6' SIDEWALK
8. FUTURE 4' SIDEWALK
9. BUILD 4' SIDEWALK

Bohannon & Huston

Courtyard One 1500 JEFFERSON NE ALBUQUERQUE NEW MEXICO 87109

ENGINEERS PLANNERS PHOTOGRAMMETRISTS SURVEYORS LANDSCAPE ARCHITECTS



CITY OF ALBUQUERQUE
PUBLIC WORKS DEPARTMENT
ENGINEERING DEVELOPMENT GROUP

PARKLAND VIEW SUBDIVISION - PHASE I PAVING PLAN & PROFILE GLYNVIEW COURT



DESIGN REVIEW COMMITTEE	CITY ENGINEER APPROVAL	NO. / DAY / YR.	NO. / DAY / YR.
DATE	DATE	DATE	DATE
DATE	DATE	DATE	DATE

CITY PROJECT NO. 4442.98 ZONE MAP NO. J-9 SHEET 7 OF 15

SCALE: 1" = 50' (HORIZ.)
1" = 10' (VERT.)

PH. NO. 815-6003

COPYRIGHT BOHANNON & HUSTON 1997
DATE: NOVEMBER 1997

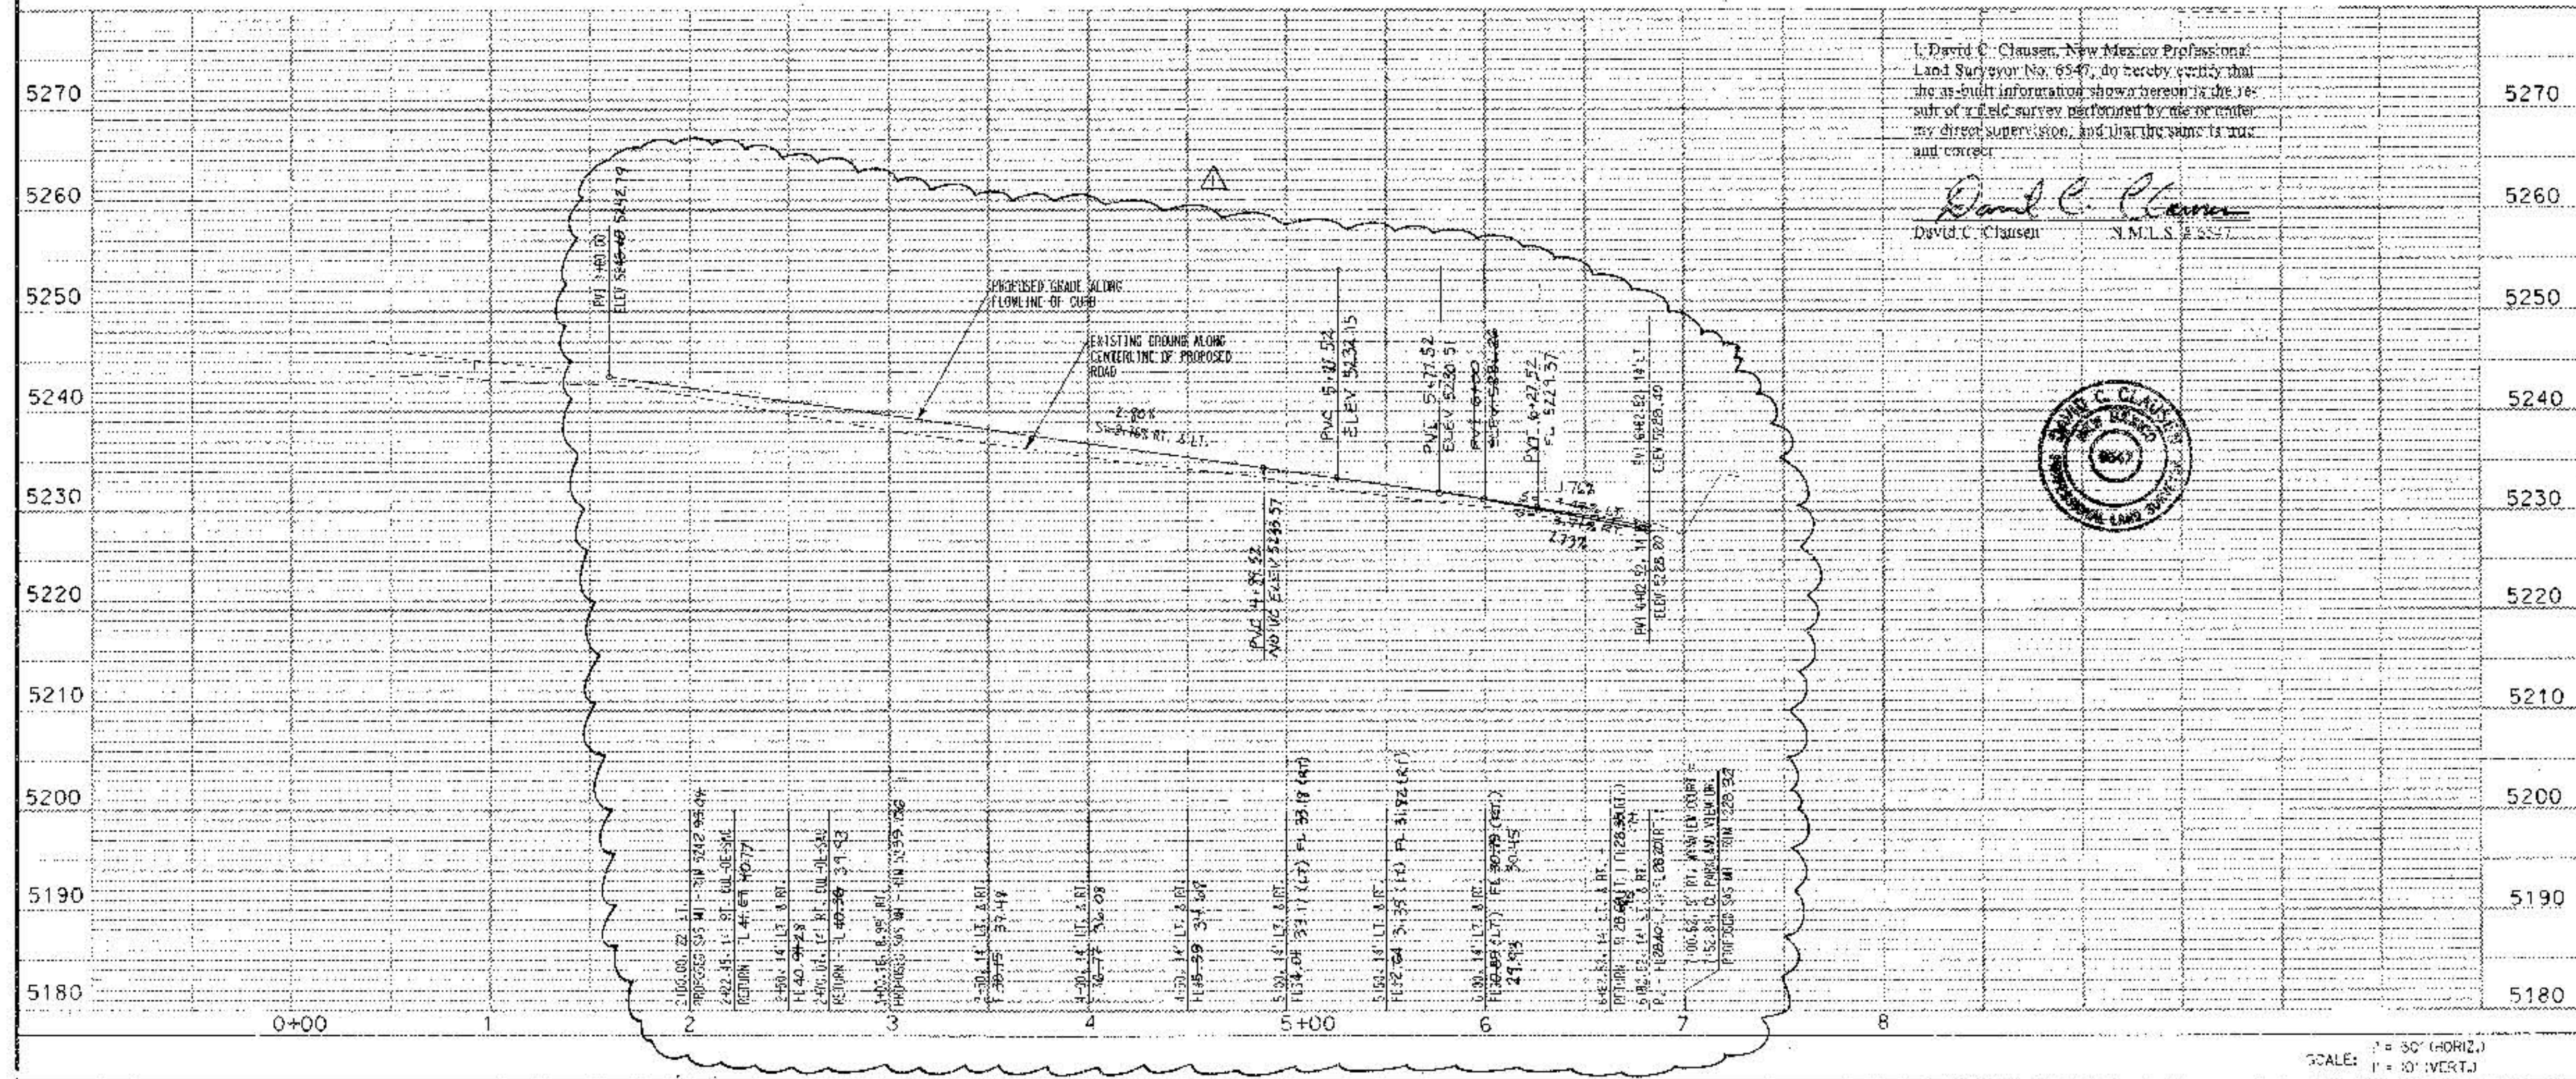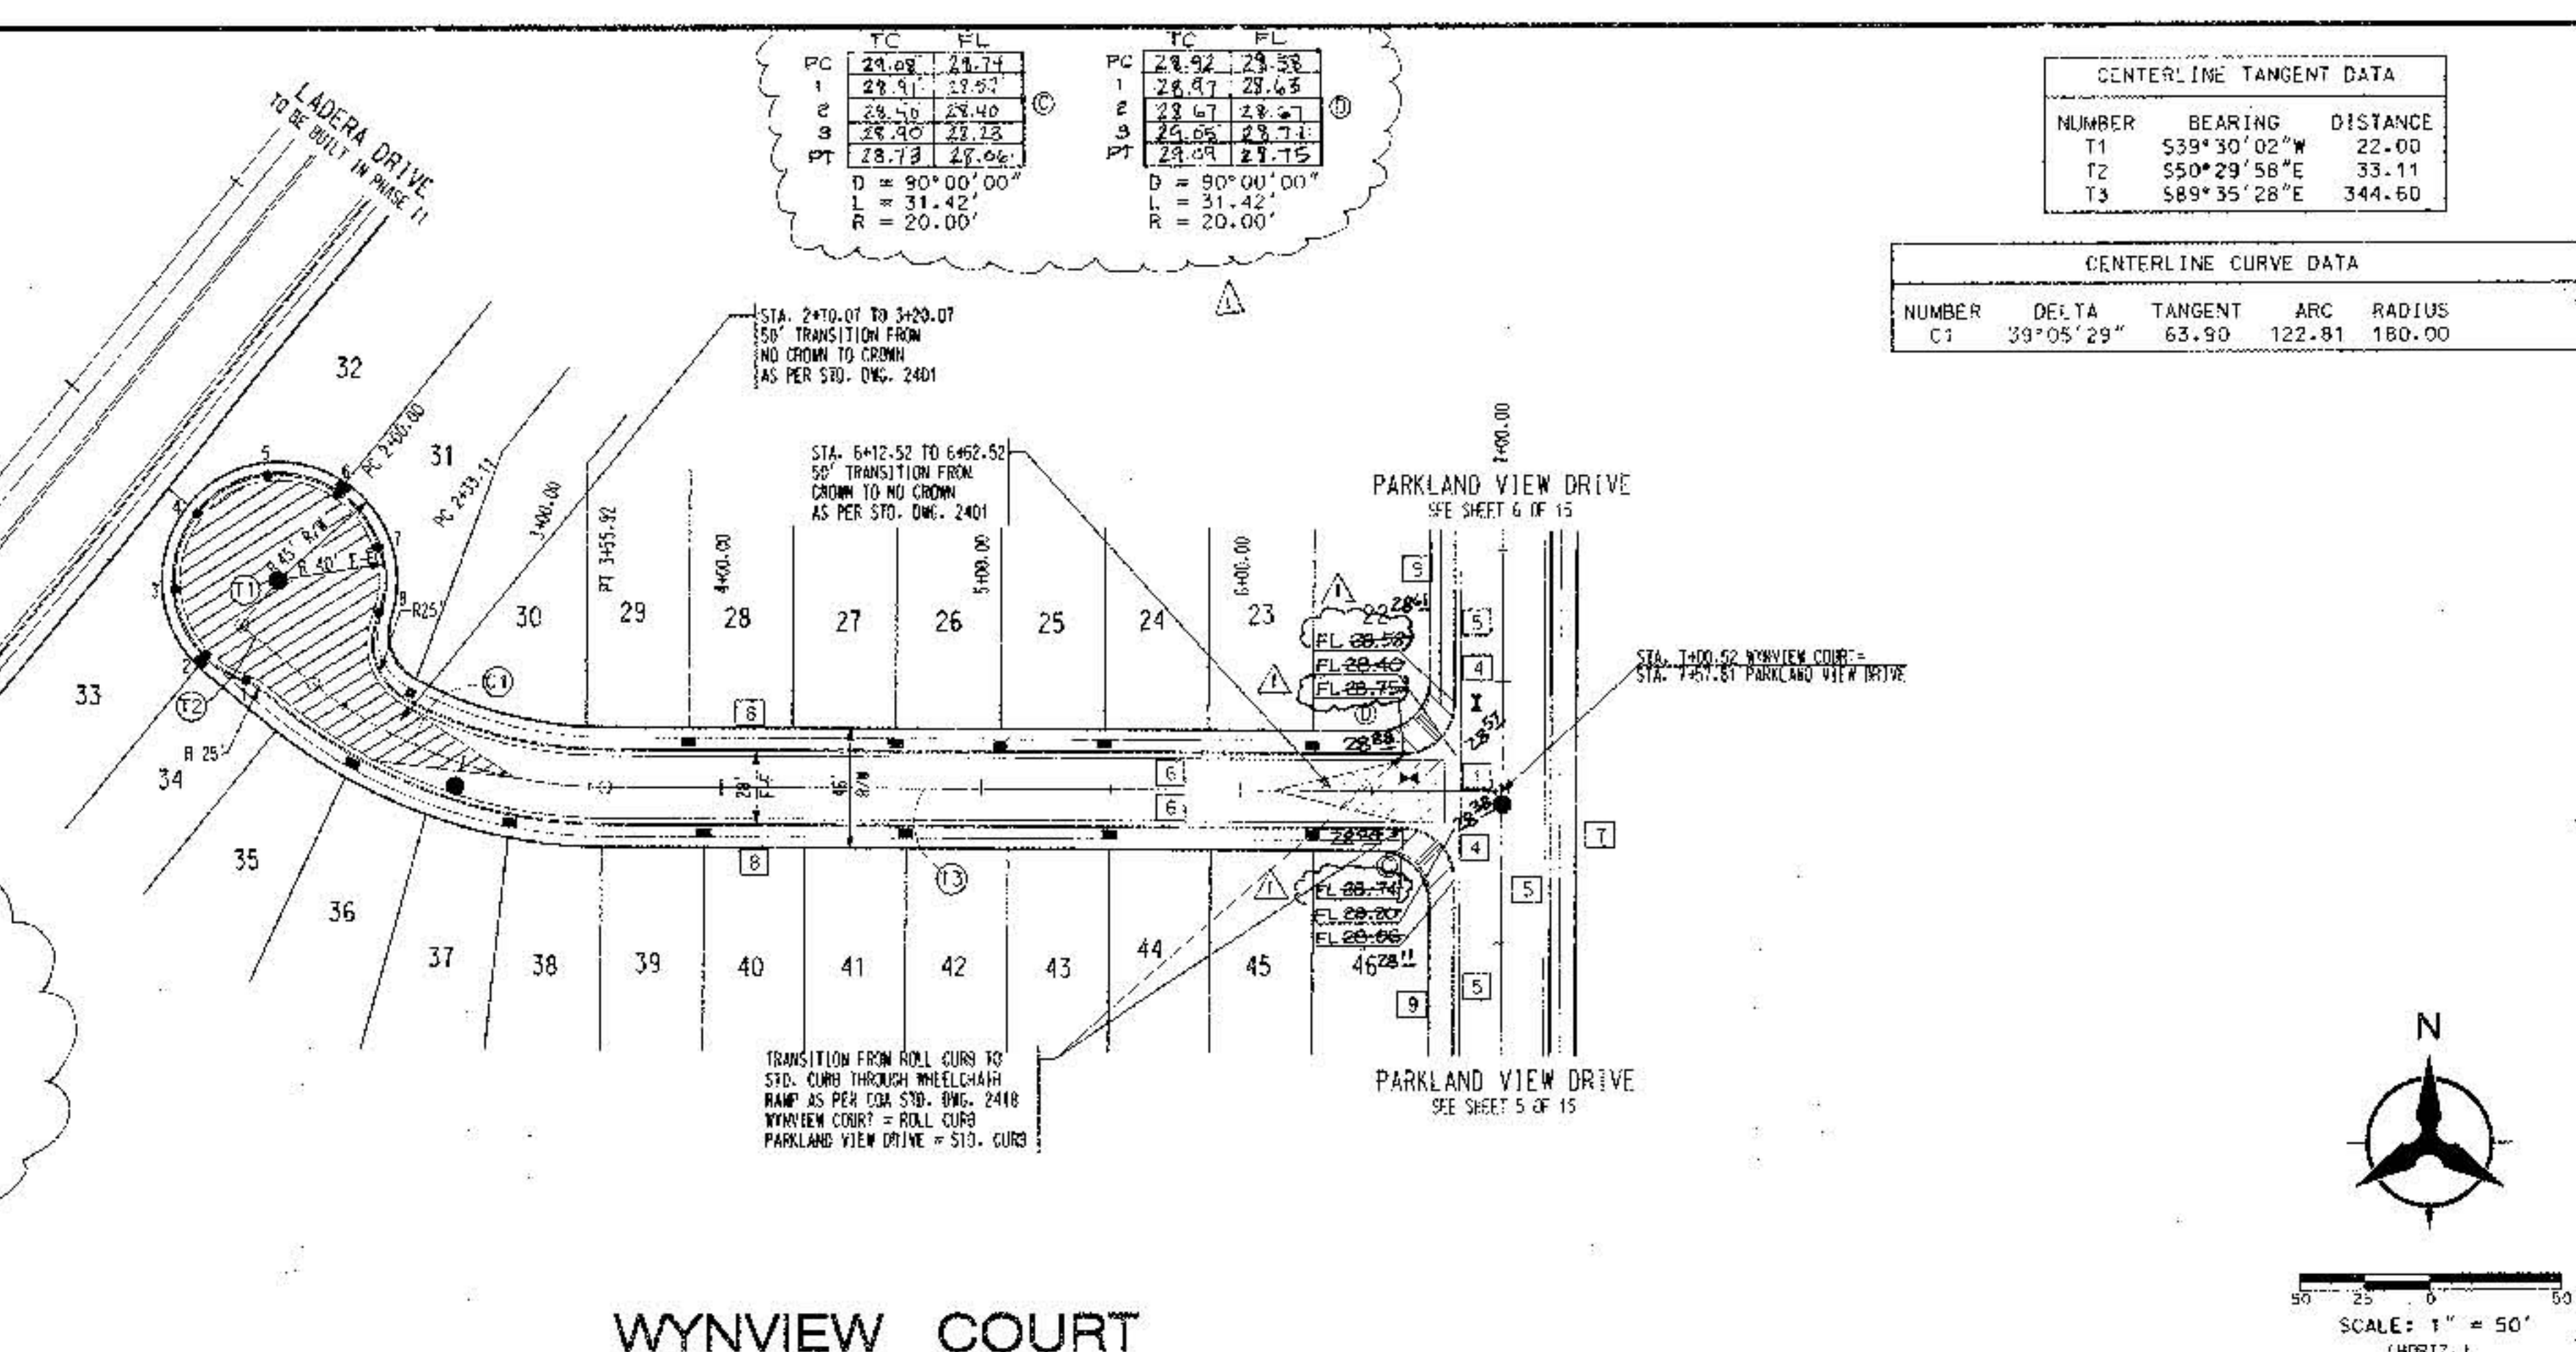

I, David C. Clausen, New Mexico Professional Land Surveyor No. 6547, do hereby certify that the as-built information shown hereon is the result of a field survey performed by me or under my direct supervision, and that the same is true and correct.

David C. Clausen N.M.L.S. # 5537



1. THE CONTRACTOR SHALL FIELD VERIFY ALL EXISTING UTILITY LOCATIONS AND NOTIFY THE ENGINEER IMMEDIATELY OF ANY DISCREPANCIES.
2. ALL CURB RETURN RADII SHALL BE 20' UNLESS OTHERWISE SPECIFIED.
3. ALL CURVE DATA AND DIMENSIONS REFER TO FACE OF CURB UNLESS OTHERWISE SPECIFIED.
4. GRADE ELEVATIONS, WHERE NOTED, ARE ALONG FLOWLINE OF CURB UNLESS OTHERWISE SPECIFIED.
5. CONTRACTOR IS TO INSTALL A 4" X 4" X 5' POST AND LMD AT THE END OF EACH SANITARY SEWER SERVICE.
6. CONTRACTOR IS RESPONSIBLE FOR REPAIR AND/OR REPLACEMENT OF ALL UTILITY CONDUITS AND EXISTING LINES.
7. ANY ADDITIONAL GRADING REQUIRED TO MATCH PROPOSED STREET GRADES SHALL BE INCIDENTAL TO PAVING ITEMS.
8. CONTRACTOR SHALL PROVIDE THE INSPECTORS, (CITY AND PRIVATE) WITH THE PROPOSED HYDROSTATIC TESTING PLAN. THE PLAN MUST BE APPROVED BEFORE TESTING OPERATIONS BEGIN.
9. CONTRACTOR SHALL PARK EQUIPMENT AND VEHICLES AS NOT TO INTERFERE WITH NORMAL ACTIVITIES OF RESIDENTS OR OTHER CONTRACTORS ON SITE.
10. ANY DAMAGE TO THE EXISTING FACILITIES (CURB & GUTTER), PAVEMENT, CONDUITS, LANDSCAPING, UTILITY LINES, ETC.) DURING CONSTRUCTION SHALL BE REPLACED AT THE CONTRACTORS' EXPENSE.
11. REMOVAL OF THE EXISTING CURB AND GUTTER SHALL BE AS PER COA STD. DWG. 2415 (SAW CUT ONLY).
12. WHEELCHAIR RAMPS SHALL BE CONSTRUCTED PRIOR TO ACCEPTANCE OF CURB & GUTTER.

- KEYED GENERAL NOTES
- | | |
|---|---|
| 1 | INSTALL CONCRETE VALLEY GUTTER
AS PER STD. DWG. 2420 |
| 2 | INSTALL CONCRETE VALLEY GUTTER
AS PER STD. DWG. 2421 |
| 3 | INSTALL WHEE. CHAIR RAMP AS
PER STD. DWG. 2441, CASE I |
| 4 | INSTALL WHEE. CHAIR RAMP AS
PER STD. DWG. 2441, CASE II
WITH ALTERNATE SECTION AA |
| 5 | STD. CURB & GUTTER
AS PER STD. DWG. 2415 |
| 6 | ROLL CURB & GUTTER
AS PER STD. DWG. 2415 |
| 7 | BUILD 6' SIDEWALK |
| 8 | FUTURE 4' SIDEWALK |
| 9 | BUILD 4' SIDEWALK |

Bohannon & Huston

 **Courtyard One** 7500 JEFFERSON NE Albuquerque NEW MEXICO 87109

ENGINEERS PLANNERS PHOTOGRAMMETRISTS SURVEYORS LANDSCAPE ARCHITECTS



CITY OF ALBUQUERQUE
PUBLIC WORKS DEPARTMENT
ENGINEERING DEVELOPMENT GROUP

PARKLAND VIEW SUBDIVISION - PHASE I
PAVING PLAN & PROFILE
WYNVIEW COURT

DESIGN REVIEW COMMITTEE


CITY PROJECT NO.	4442.98
------------------	---------


ZONE MAP NO.	SHEET	OF
J-9	8	15

0 9 8
COPYRIGHT BOHANNAN HUSTON 1997
DATE: NOVEMBER, 1997

~~P:8H-12MKN-yt3-(U)CCP^603-N-FR-CO^NS-T-P-LN^LDON
BT3D6F^K^04,9CM~~

5-1.35 NO. 9750403

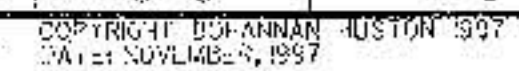

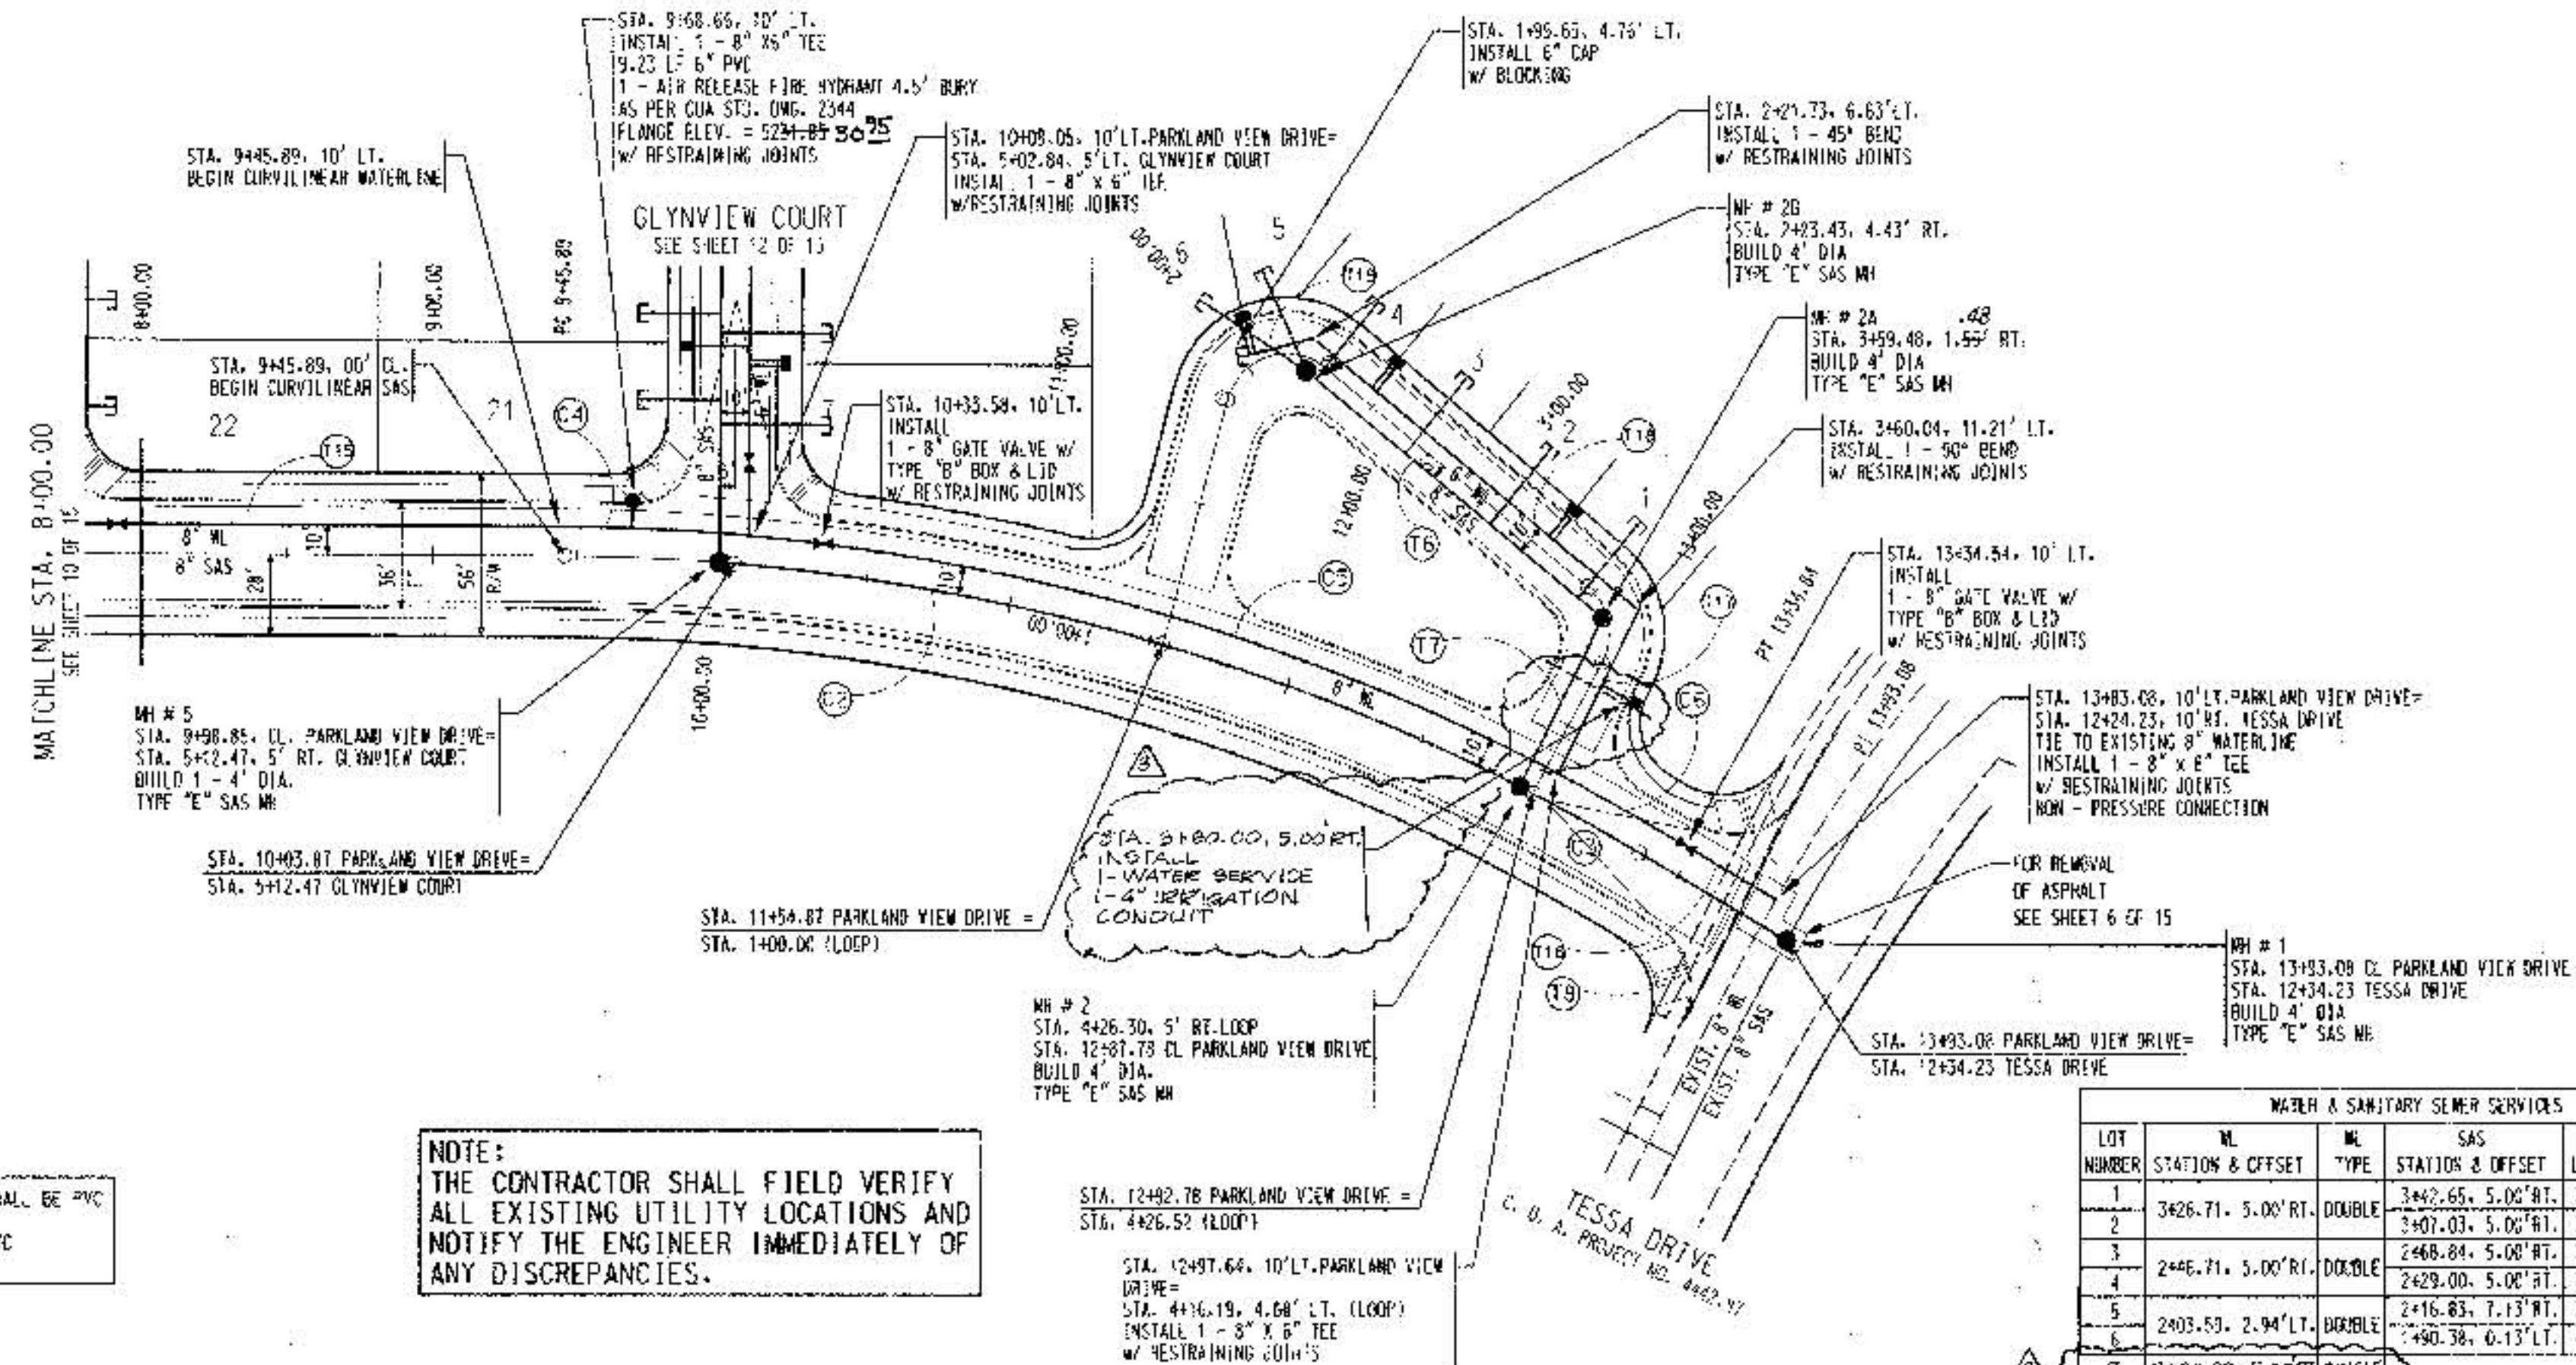

WATERLINE CURVE DATA

NUMBER	ARC	RADIUS	DELTA	TANGENT
C4	62.99'	760.00'	04°44'55.3"	31.51'
C5	285.87'	760.00'	21°32'55.3"	144.64'
C6	45.30'	760.00'	03°24'52.8"	22.66'

SAS CURVE DATA

NUMBER	ARC	RADIUS	DELTA	TANGENT
C2	288.95'	750.00'	22°04'27"	288.92'
C3	47.07'	750.00'	03°35'44"	47.06'

WATERLINE TANGENT DATA


NUMBER	BEARING	LENGTH
T14	N00°04'12"E	185.08'
T16	N00°07'20"E	48.32'
T17	S63°28'21"E	62.38'
T18	N39°29'57"E	146.11'
T19	S13°53'29"E	26.84'

SAS TANGENT DATA

NUMBER	BEARING	LENGTH
T6	N39°29'57"E	133.18'
T7	S63°28'21"E	64.22'
T8	N00°07'20"E	58.24'

WATER & SANITARY SEWER SERVICES

LOT NUMBER	STATION & OFFSET	TYPE	SAS	TOP OF PIPE AT	TOP
1	3426.71, 5.00' RT.	DOUBLE	3426.65, 5.00' RT.	34.00'	25.00'
2	3407.03, 5.00' RT.	DOUBLE	3407.03, 5.00' RT.	34.15'	26.00'
3	2446.71, 5.00' RT.	DOUBLE	2446.84, 5.00' RT.	34.00'	27.15'
4	2429.00, 5.00' RT.	DOUBLE	2429.00, 5.00' RT.	34.00'	27.77'
5	2416.83, 7.13' RT.	DOUBLE	2416.83, 7.13' RT.	37.15'	27.31'
6	2403.50, 2.94' LT.	DOUBLE	2403.50, 2.94' LT.	43.45'	27.45'
7	3400.00, 5.00' RT.	SINGLE			

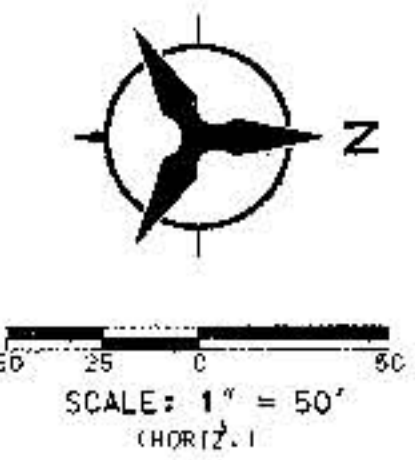


NOTE:
THE CONTRACTOR SHALL FIELD VERIFY
ALL EXISTING UTILITY LOCATIONS AND
NOTIFY THE ENGINEER IMMEDIATELY OF
ANY DISCREPANCIES.

ALL SANITARY SEWER LINES SHALL BE PVC
UNLESS OTHERWISE NOTED.
ALL WATER LINES SHALL BE PVC
UNLESS OTHERWISE NOTED.

PARKLAND VIEW DRIVE

PARKLAND VIEW DRIVE (LOOP)

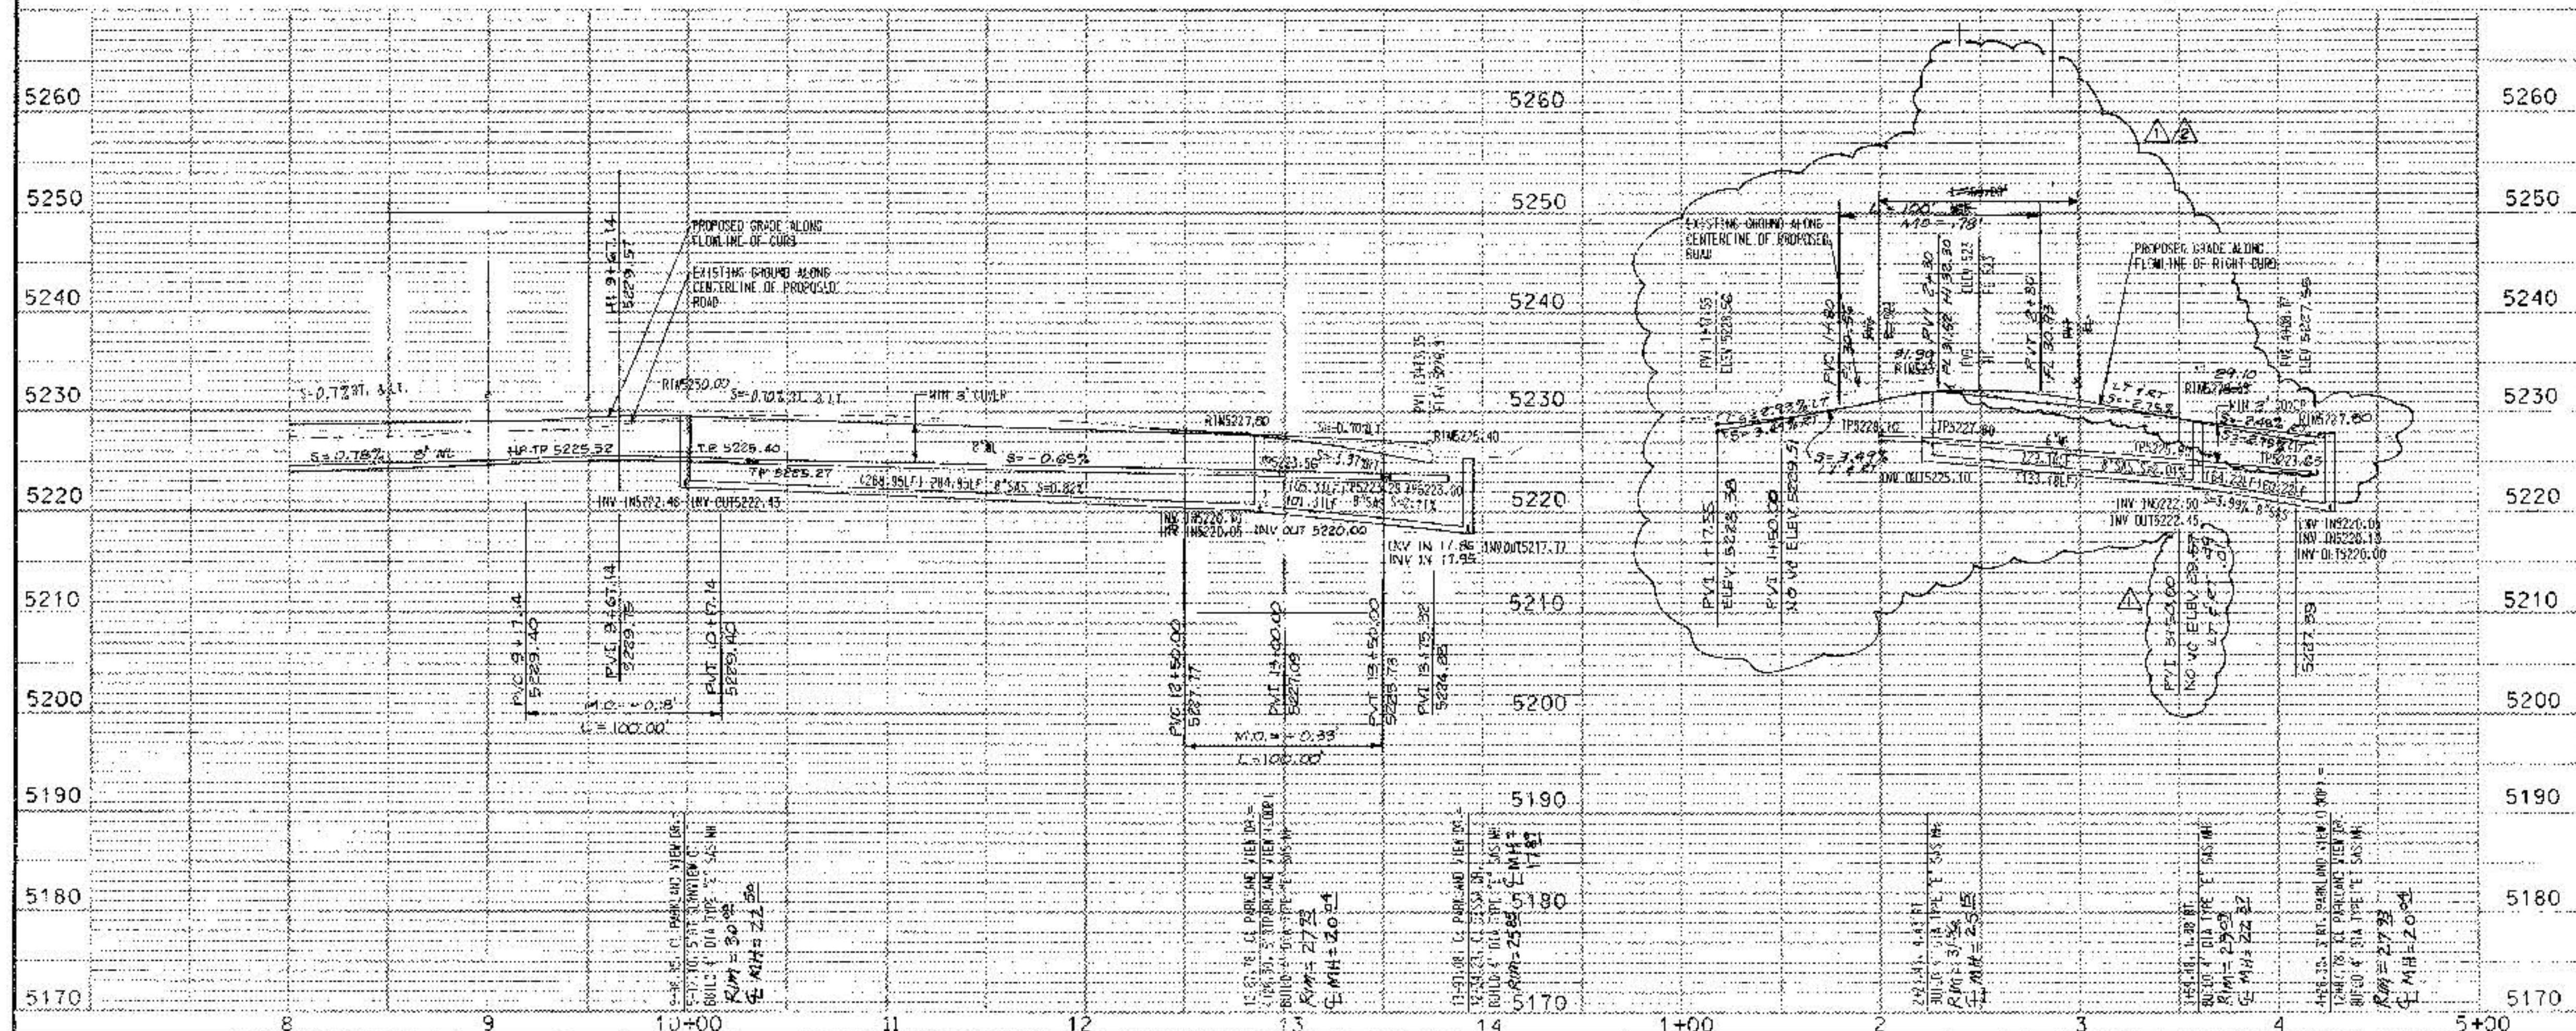

- NOTES
- THE CONTRACTOR SHALL FIELD VERIFY ALL EXISTING UTILITY LOCATIONS AND NOTIFY THE ENGINEER IMMEDIATELY OF ANY DISCREPANCIES.
 - ALL CURB RETURN RADII SHALL BE 20' UNLESS OTHERWISE SPECIFIED.
 - ALL CURVE DATA AND DIMENSIONS REFER TO FACE OF CURB UNLESS OTHERWISE SPECIFIED.
 - GRADE ELEVATIONS, WHERE NOTED, ARE ALONG FLOW LINE OF CURB UNLESS OTHERWISE SPECIFIED.
 - CONTRACTOR IS TO INSTALL A 4" X 4" X 5' POST AND END AT THE END OF EACH SANITARY SEWER SERVICE.
 - CONTRACTOR IS RESPONSIBLE FOR REPAIR AND/OR REPLACEMENT OF ALL UTILITY CONDUITS AND EXISTING LINES.
 - ANY ADDITIONAL GRADING REQUIRED TO MATCH PROPOSED STREET GRADES SHALL BE INCIDENTAL TO PAVING ITEMS.
 - CONTRACTOR SHALL PROVIDE THE INSPECTORS, (CITY AND PRIVATE) WITH THE PROPOSED HYDRAULIC TESTING PLAN. THE PLAN MUST BE APPROVED BEFORE TESTING OPERATIONS BEGIN.
 - CONTRACTOR SHALL PARK EQUIPMENT AND VEHICLES AS NOT TO INTERFERE WITH NORMAL ACTIVITIES OF RESIDENTS OR OTHER CONTRACTORS ON SITE.
 - ANY DAMAGE TO THE EXISTING FACILITIES (CURB & GUTTER, PAVEMENT, CONDUITS, LANDSCAPING, UTILITY LINES, ETC.) DURING CONSTRUCTION SHALL BE REPLACED AT THE CONTRACTORS' EXPENSE.
 - REMOVAL OF THE EXISTING CURB AND GUTTER SHALL BE AS PER COA STD. DWG. 2415 (SAWCUT ONLY).
 - WHEELCHAIR RAMPS SHALL BE CONSTRUCTED PRIOR TO ACCEPTANCE OF CURB & GUTTER.

I, David C. Clausen, New Mexico Professional Land Surveyor No. 6547, do hereby certify that the as-built information shown herein is the result of a field survey performed by me or under my direct supervision, and that the same is true and correct.

David C. Clausen
David C. Clausen N.M.L.S. #6547



Bohannon & Huston
Courtney One 7500 JEFFERSON NE ALBUQUERQUE NEW MEXICO 87109
ENGINEERS PLANNERS PHOTOGRAMMETRISTS SURVEYORS LANDSCAPE ARCHITECTS


CITY OF ALBUQUERQUE
PUBLIC WORKS DEPARTMENT
ENGINEERING DEVELOPMENT GROUP

PARKLAND VIEW SUBDIVISION - PHASE I UTILITY PLAN & PROFILE

PARKLAND VIEW DRIVE STA. 8+00.00 TO 13+93.08 & (LOOP)
DESIGNED BY: TSC/PL PG
DRAWN BY: PG
CHECKED BY: KP

AS-BUILT INFORMATION		BENCH MARKS		FIELD NOTES		ENGINEER'S SEAL	
CONTRACTOR: <i>Bohannon & Huston</i>	DATE: <i>8/98</i>	ACCS BRASS TABLE STAMPED "BH-40"	DATE: <i>8/98</i>	NO.:	BY:	NO.:	BY:
STATIONED BY: <i>Bohannon & Huston</i>	DATE: <i>8/98</i>	GEOGRAPHIC POSITION (NAD 1983)	DATE: <i>8/98</i>	NO.:	BY:	NO.:	BY:
ACCEPTED BY: <i>Bohannon & Huston</i>	DATE: <i>8/98</i>	N.M. STATE PLANE COORDINATES	DATE: <i>8/98</i>	NO.:	BY:	NO.:	BY:
DATE: <i>8/98</i>	DATE: <i>8/98</i>	CENTRAL ZONE) X=352,790.66	DATE: <i>8/98</i>	NO.:	BY:	NO.:	BY:
DATE: <i>8/98</i>	DATE: <i>8/98</i>	Y=1,432,346.53	DATE: <i>8/98</i>	NO.:	BY:	NO.:	BY:
DATE: <i>8/98</i>	DATE: <i>8/98</i>	GROUND-TO-GRID FACTOR = .99967105	DATE: <i>8/98</i>	NO.:	BY:	NO.:	BY:
DATE: <i>8/98</i>	DATE: <i>8/98</i>	-00216' 31"	DATE: <i>8/98</i>	NO.:	BY:	NO.:	BY:
DATE: <i>8/98</i>	DATE: <i>8/98</i>	NGVD 1929 ELEVATION = 5193.38	DATE: <i>8/98</i>	NO.:	BY:	NO.:	BY:
DATE: <i>8/98</i>	DATE: <i>8/98</i>		DATE: <i>8/98</i>	NO.:	BY:	NO.:	BY:

ALL SANITARY SEWER LINES SHALL BE PVC UNLESS OTHERWISE NOTED.
ALL WATER LINES SHALL BE PVC UNLESS OTHERWISE NOTED.

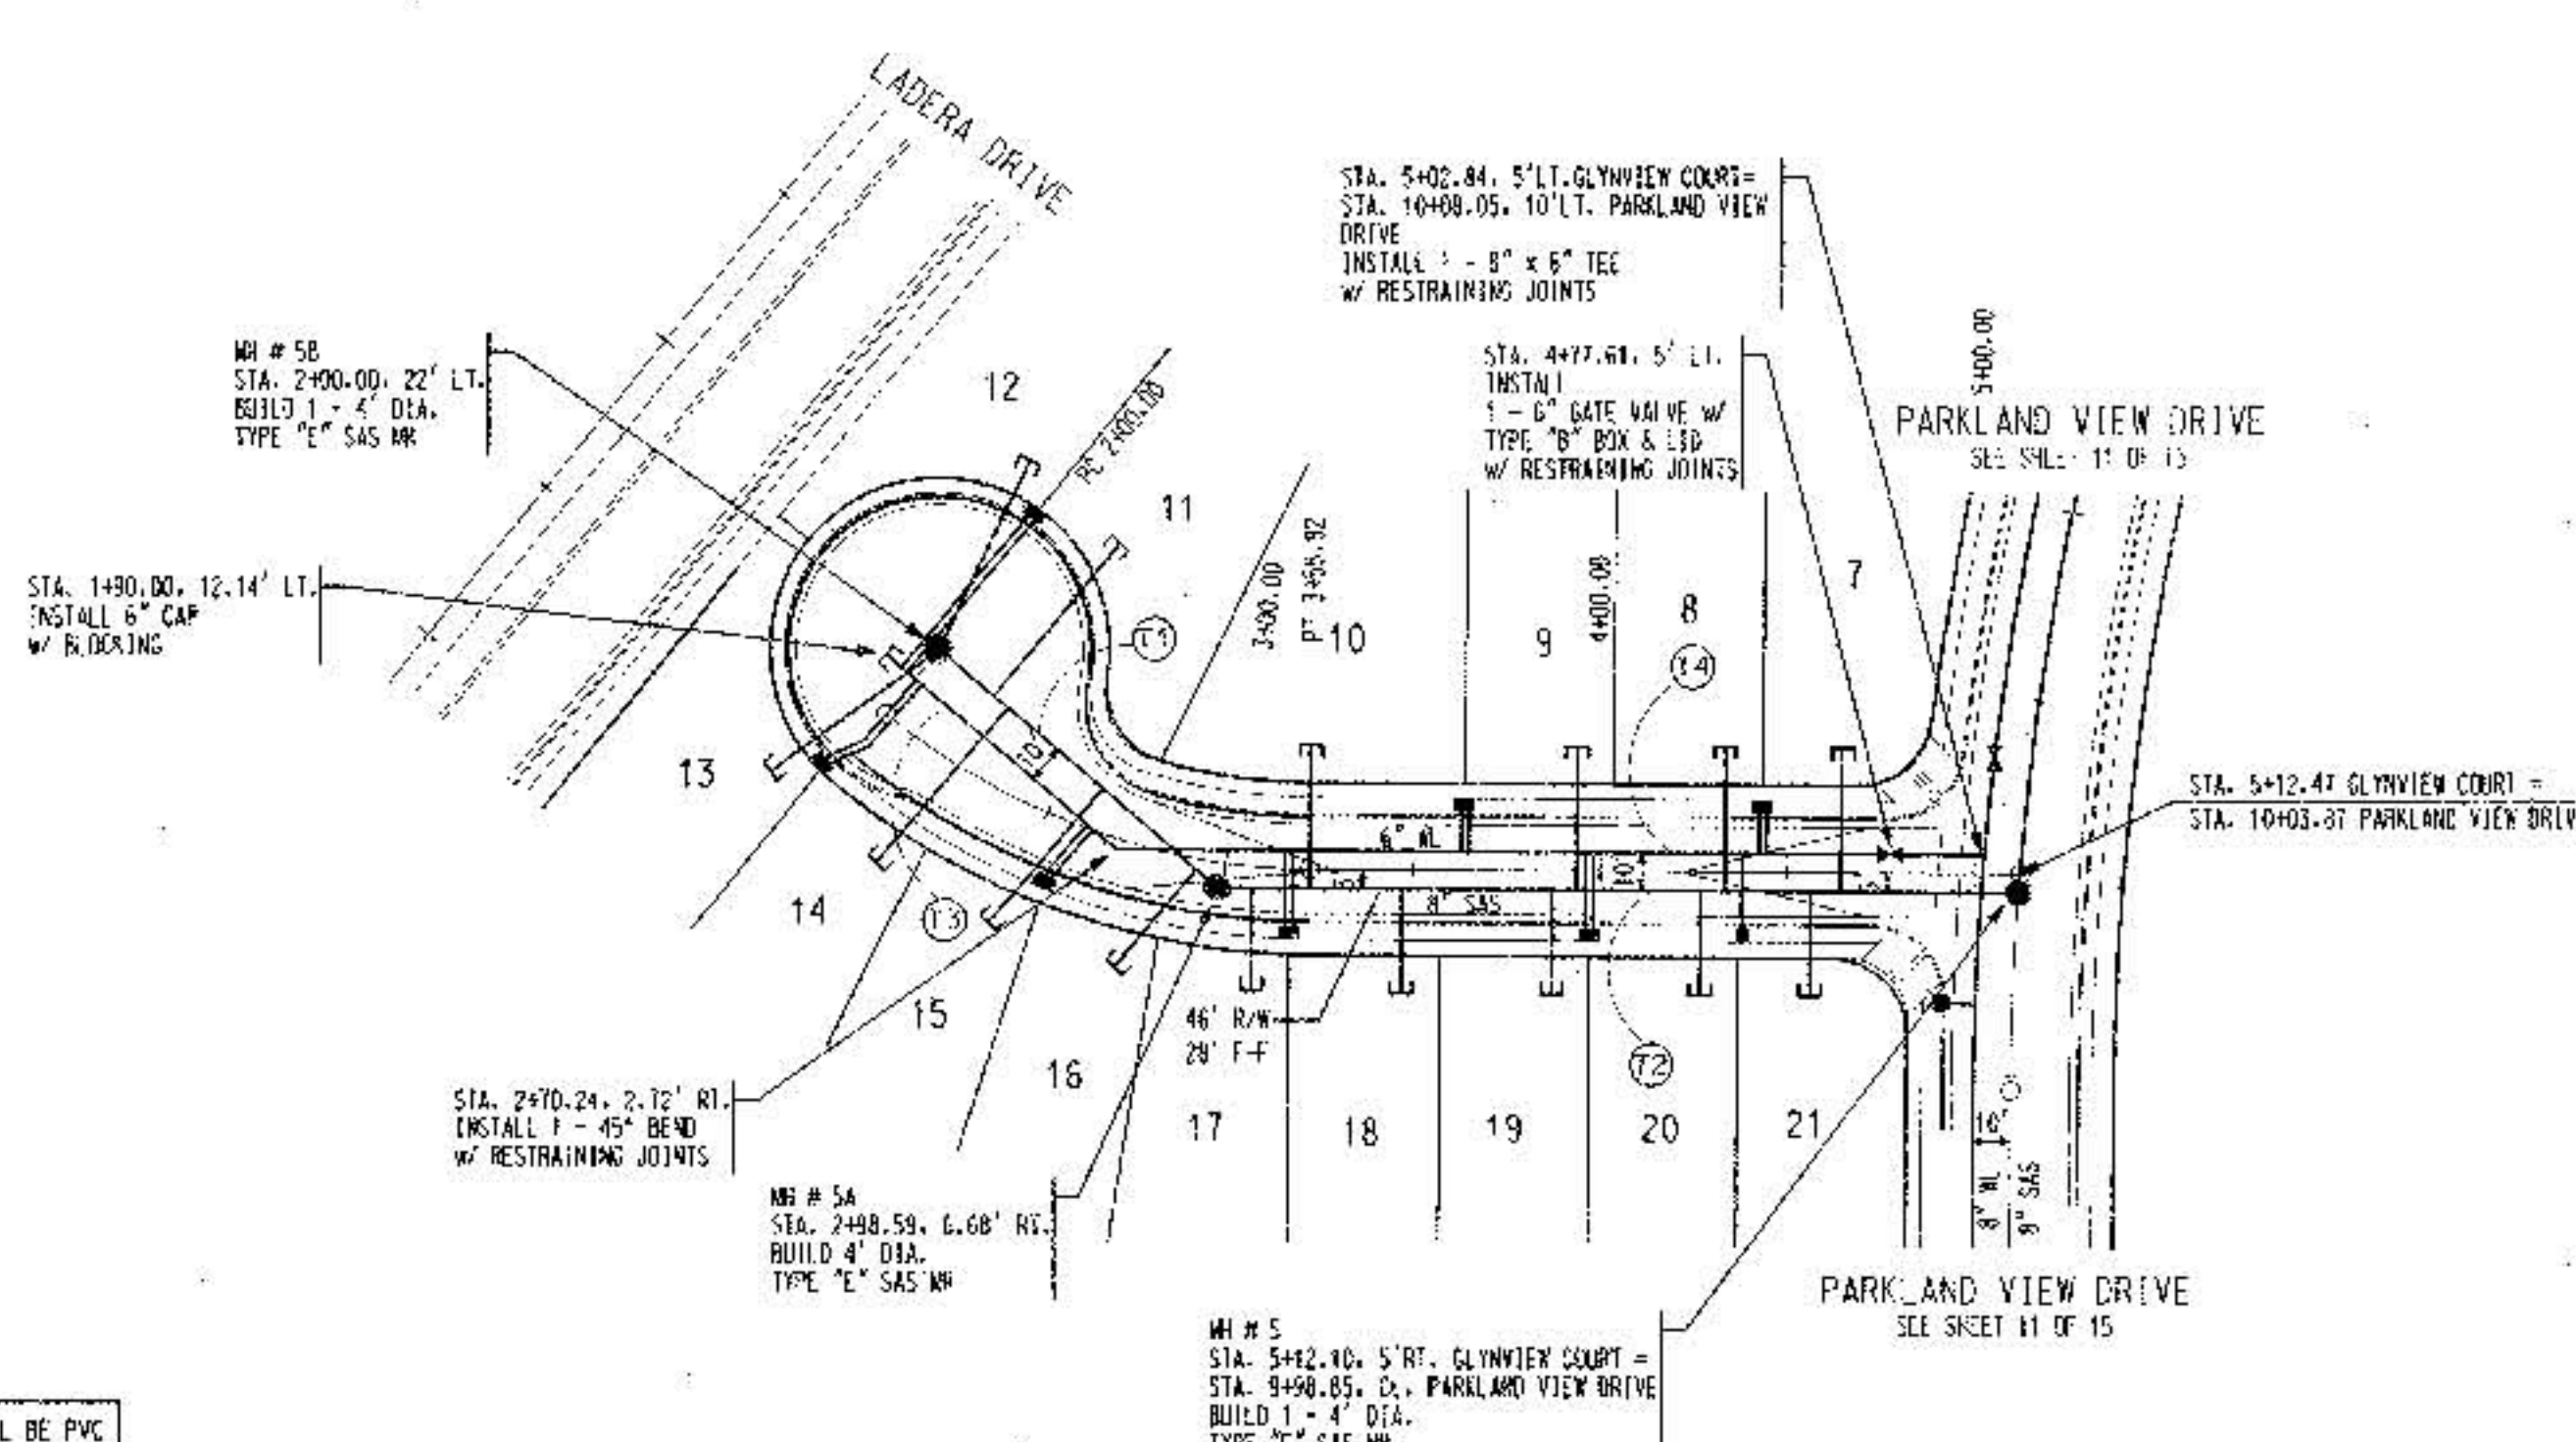

WATER & SANITARY SEWER SERVICES					
LOT NUMBER	STATION & OFFSET	TYPE	SAS	LENGTH	TOP OF PIPE AT PLUG (W/IRISER)
7	437.23, 5.00' LT.	DOUBLE	444.62, 5.00' RT.	38.00'	26.44' (-12.64')
8	437.23, 5.00' LT.	DOUBLE	443.77, 5.00' RT.	38.00'	26.55' (-12.64')
9	343.77, 5.00' LT.	DOUBLE	343.77, 5.00' RT.	38.00'	26.09' (-12.64')
10	343.77, 5.00' LT.	DOUBLE	343.77, 5.00' RT.	38.00'	26.09' (-12.64')
11	1436.25, 12.05' LT.	DOUBLE	2400.00, 22.00' ST.	55.00'	34.48' (-34.48')
12	1436.25, 12.05' LT.	DOUBLE	2400.00, 22.00' ST.	55.00'	34.48' (-34.48')
13	2401.40, 11.98' LT.	DOUBLE	2400.00, 22.00' ST.	55.00'	34.48' (-34.48')
14	2401.40, 11.98' LT.	DOUBLE	2400.00, 22.00' ST.	55.00'	34.48' (-34.48')
15	2461.33, 0.64' LT.	DOUBLE	2461.75, 11.38' LT.	46.70'	33.04' (-32.18')
16	2461.33, 0.64' LT.	DOUBLE	2461.75, 11.38' LT.	46.70'	33.04' (-32.18')
17	3417.07, 5.00' LT.	DOUBLE	3417.23, 5.00' RT.	28.00'	26.09' (-12.64')
18	3417.07, 5.00' LT.	DOUBLE	3417.23, 5.00' RT.	28.00'	26.09' (-12.64')
19	3417.07, 5.00' LT.	DOUBLE	3417.23, 5.00' RT.	28.00'	26.09' (-12.64')
20	3417.07, 5.00' LT.	DOUBLE	3417.23, 5.00' RT.	28.00'	26.09' (-12.64')
21	4443.77, 5.00' LT.	SINGLE	4456.39, 5.00' RT.	28.00'	26.09' (-12.64')


WATERLINE TANGENT DATA		
NUMBER	BEARING	LENGTH
13	S49°42'57"E	79.51'
14	S89°35'28"E	232.63'

SAS TANGENT DATA		
NUMBER	BEARING	LENGTH
11	S49°42'57"E	97.22'
12	S89°35'28"E	214.32'



SCALE: 1" = 50'
(HORIZ.)


GLYNVIEW COURT

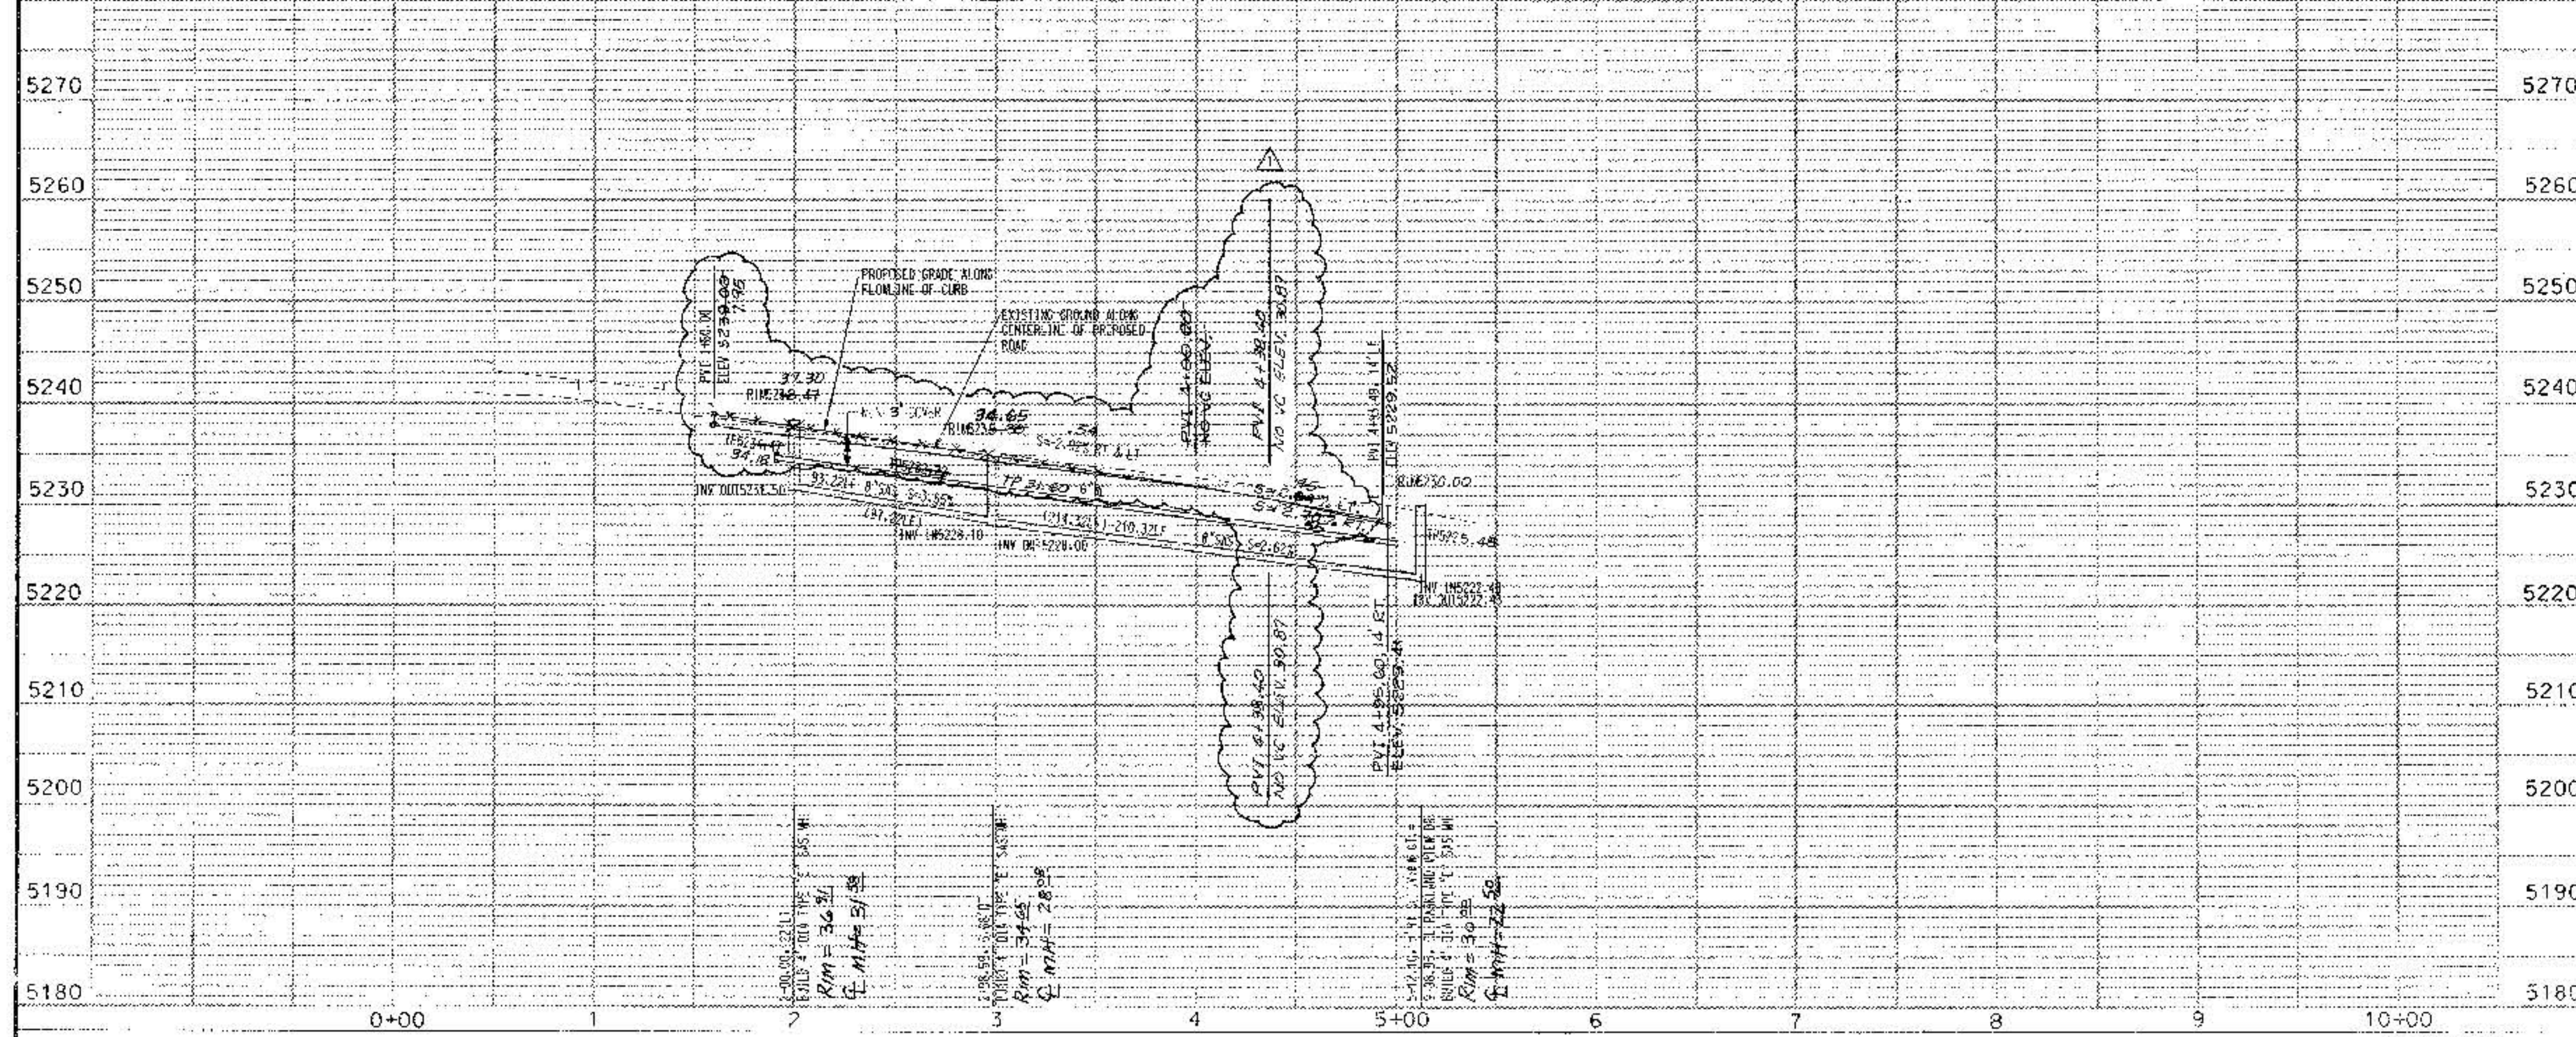

- NOTES
1. THE CONTRACTOR SHALL FIELD VERIFY ALL EXISTING UTILITY LOCATIONS AND NOTIFY THE ENGINEER IMMEDIATELY OF ANY DISCREPANCIES.
 2. ALL CURB RETURN RADII SHALL BE 20' UNLESS OTHERWISE SPECIFIED.
 3. ALL CURVE DATA AND DIMENSIONS REFER TO FACE OF CURB UNLESS OTHERWISE SPECIFIED.
 4. GRADE ELEVATIONS, WHERE NOTED, ARE ALONG FLOW LINE OF CURB UNLESS OTHERWISE SPECIFIED.
 5. CONTRACTOR IS TO INSTALL A 1" X 4" X 5' POST AND END AT THE END OF EACH SANITARY SEWER SERVICE.
 6. CONTRACTOR IS RESPONSIBLE FOR REPAIR AND/OR REPLACEMENT OF ALL UTILITY CONDUITS AND EXISTING LINES.
 7. ANY ADDITIONAL GRADING REQUIRED TO MATCH PROPOSED STREET GRADES SHALL BE INCIDENTAL TO PAVING ITEMS.
 8. CONTRACTOR SHALL PROVIDE THE INSPECTORS (CITY AND PRIVATE) WITH THE PROPOSED HYDROSTATIC TESTING PLAN. THE PLAN MUST BE APPROVED BEFORE TESTING OPERATIONS BEGIN.
 9. CONTRACTOR SHALL PARK EQUIPMENT AND VEHICLES AS NOT TO INTERFERE WITH NORMAL ACTIVITIES OF RESIDENTS OR OTHER CONTRACTORS ON SITE.
 10. ANY DAMAGE TO THE EXISTING FACILITIES (CURB & GUTTER), PAVEMENT, CONDUITS, LANDSCAPING, UTILITY LINES, ETC., DURING CONSTRUCTION SHALL BE REPLACED AT THE CONTRACTOR'S EXPENSE.
 11. REMOVAL OF THE EXISTING CURB AND GUTTER SHALL BE AS PER COA STD. DWG. 2415 (SAW CUT ONLY).
 12. WHEELCHAIR RAMP SHALL BE CONSTRUCTED PRIOR TO ACCEPTANCE OF CURB & GUTTER.

I, David C. Clausen, New Mexico Professional Land Surveyor No. 6547, do hereby certify that the as-built information shown herein is the result of a field survey performed by me or under my direct supervision, and that the same is true and correct.

David C. Clausen
David C. Clausen N.M.L.S. # 6547

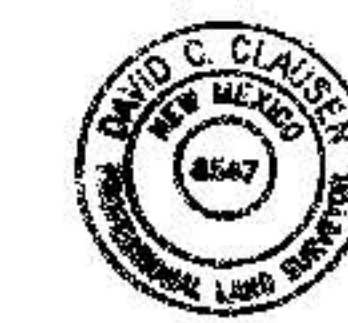

Bohannon & Huston
Courtyard One 7500 JEFFERSON NE Albuquerque NEW MEXICO 87109
ENGINEERS PLANNERS PHOTOGRAMMETRISTS SURVEYORS LANDSCAPE ARCHITECTS

CITY OF ALBUQUERQUE
PUBLIC WORKS DEPARTMENT
ENGINEERING DEVELOPMENT GROUP


PARKLAND VIEW SUBDIVISION - PHASE I
UTILITY PLAN & PROFILE
GLYNVIEW COURT

DESIGNED BY	TSG/PLL	DATE	11/97
DRAWN BY	PG	DATE	11/97
CHECKED BY	KP	DATE	11/97

ENGINEER'S SEAL		SURVEY INFORMATION		FIELD NOTES		BENCH MARKS		AS-BUILT INFORMATION	
NO.	DATE	NO.	DATE	NO.	DATE	NO.	DATE	NO.	DATE
1	4-16-98	1	4-16-98	1	4-16-98	1	4-16-98	1	4-16-98
2	4-16-98	2	4-16-98	2	4-16-98	2	4-16-98	2	4-16-98
3	4-16-98	3	4-16-98	3	4-16-98	3	4-16-98	3	4-16-98
4	4-16-98	4	4-16-98	4	4-16-98	4	4-16-98	4	4-16-98
5	4-16-98	5	4-16-98	5	4-16-98	5	4-16-98	5	4-16-98
6	4-16-98	6	4-16-98	6	4-16-98	6	4-16-98	6	4-16-98
7	4-16-98	7	4-16-98	7	4-16-98	7	4-16-98	7	4-16-98
8	4-16-98	8	4-16-98	8	4-16-98	8	4-16-98	8	4-16-98
9	4-16-98	9	4-16-98	9	4-16-98	9	4-16-98	9	4-16-98
10	4-16-98	10	4-16-98	10	4-16-98	10	4-16-98	10	4-16-98
11	4-16-98	11	4-16-98	11	4-16-98	11	4-16-98	11	4-16-98
12	4-16-98	12	4-16-98	12	4-16-98	12	4-16-98	12	4-16-98
13	4-16-98	13	4-16-98	13	4-16-98	13	4-16-98	13	4-16-98
14	4-16-98	14	4-16-98	14	4-16-98	14	4-16-98	14	4-16-98
15	4-16-98	15	4-16-98	15	4-16-98	15	4-16-98	15	4-16-98
16	4-16-98	16	4-16-98	16	4-16-98	16	4-16-98	16	4-16-98
17	4-16-98	17	4-16-98	17	4-16-98	17	4-16-98	17	4-16-98
18	4-16-98	18	4-16-98	18	4-16-98	18	4-16-98	18	4-16-98
19	4-16-98	19	4-16-98	19	4-16-98	19	4-16-98	19	4-16-98
20	4-16-98	20	4-16-98	20	4-16-98	20	4-16-98	20	4-16-98
21	4-16-98	21	4-16-98	21	4-16-98	21	4-16-98	21	4-16-98

NOTE:
THE CONTRACTOR SHALL FIELD VERIFY
ALL EXISTING UTILITY LOCATIONS AND
NOTIFY THE ENGINEER IMMEDIATELY OF
ANY DISCREPANCIES.

SAS TANGENT DATA		
NUMBER	BEARING	LENGTH
11	N89°21'06"E	271.22'
12	N28°54'43"E	244.76'
13	N28°54'43"E	63.36'

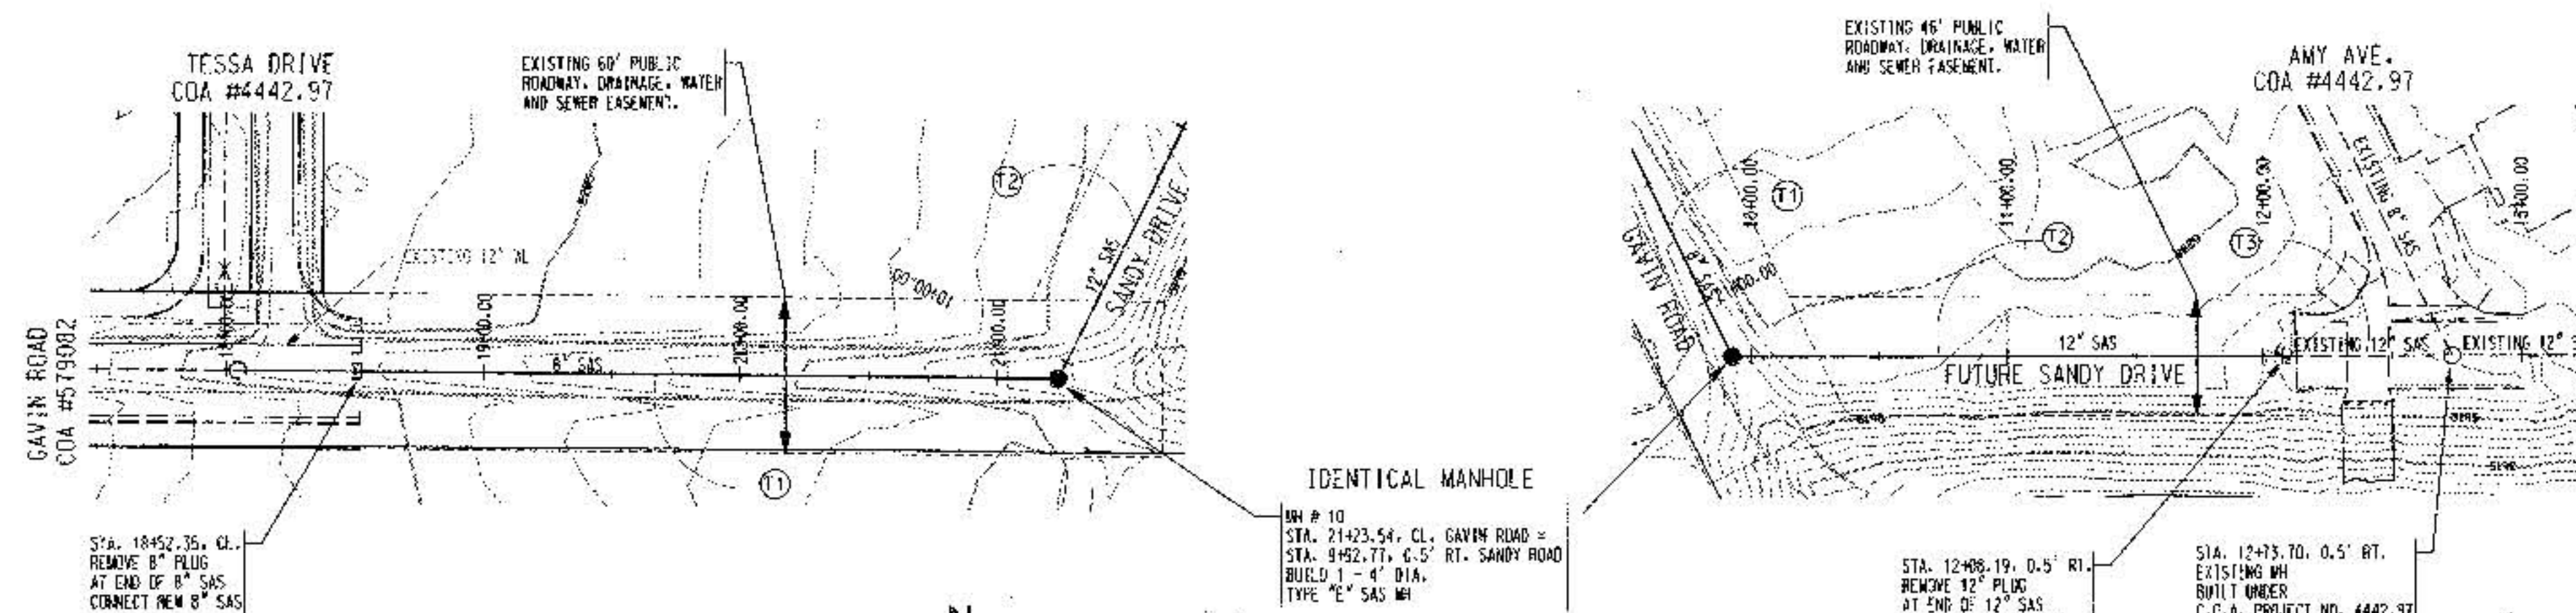


ALL SANITARY SEWER LINES SHALL BE PVC
UNLESS OTHERWISE NOTED.
ALL WATER LINES SHALL BE PVC
UNLESS OTHERWISE NOTED.



SCALE: 1" = 50'
(HORIZ.)

SAS EXTENSION FUTURE SANDY ROAD

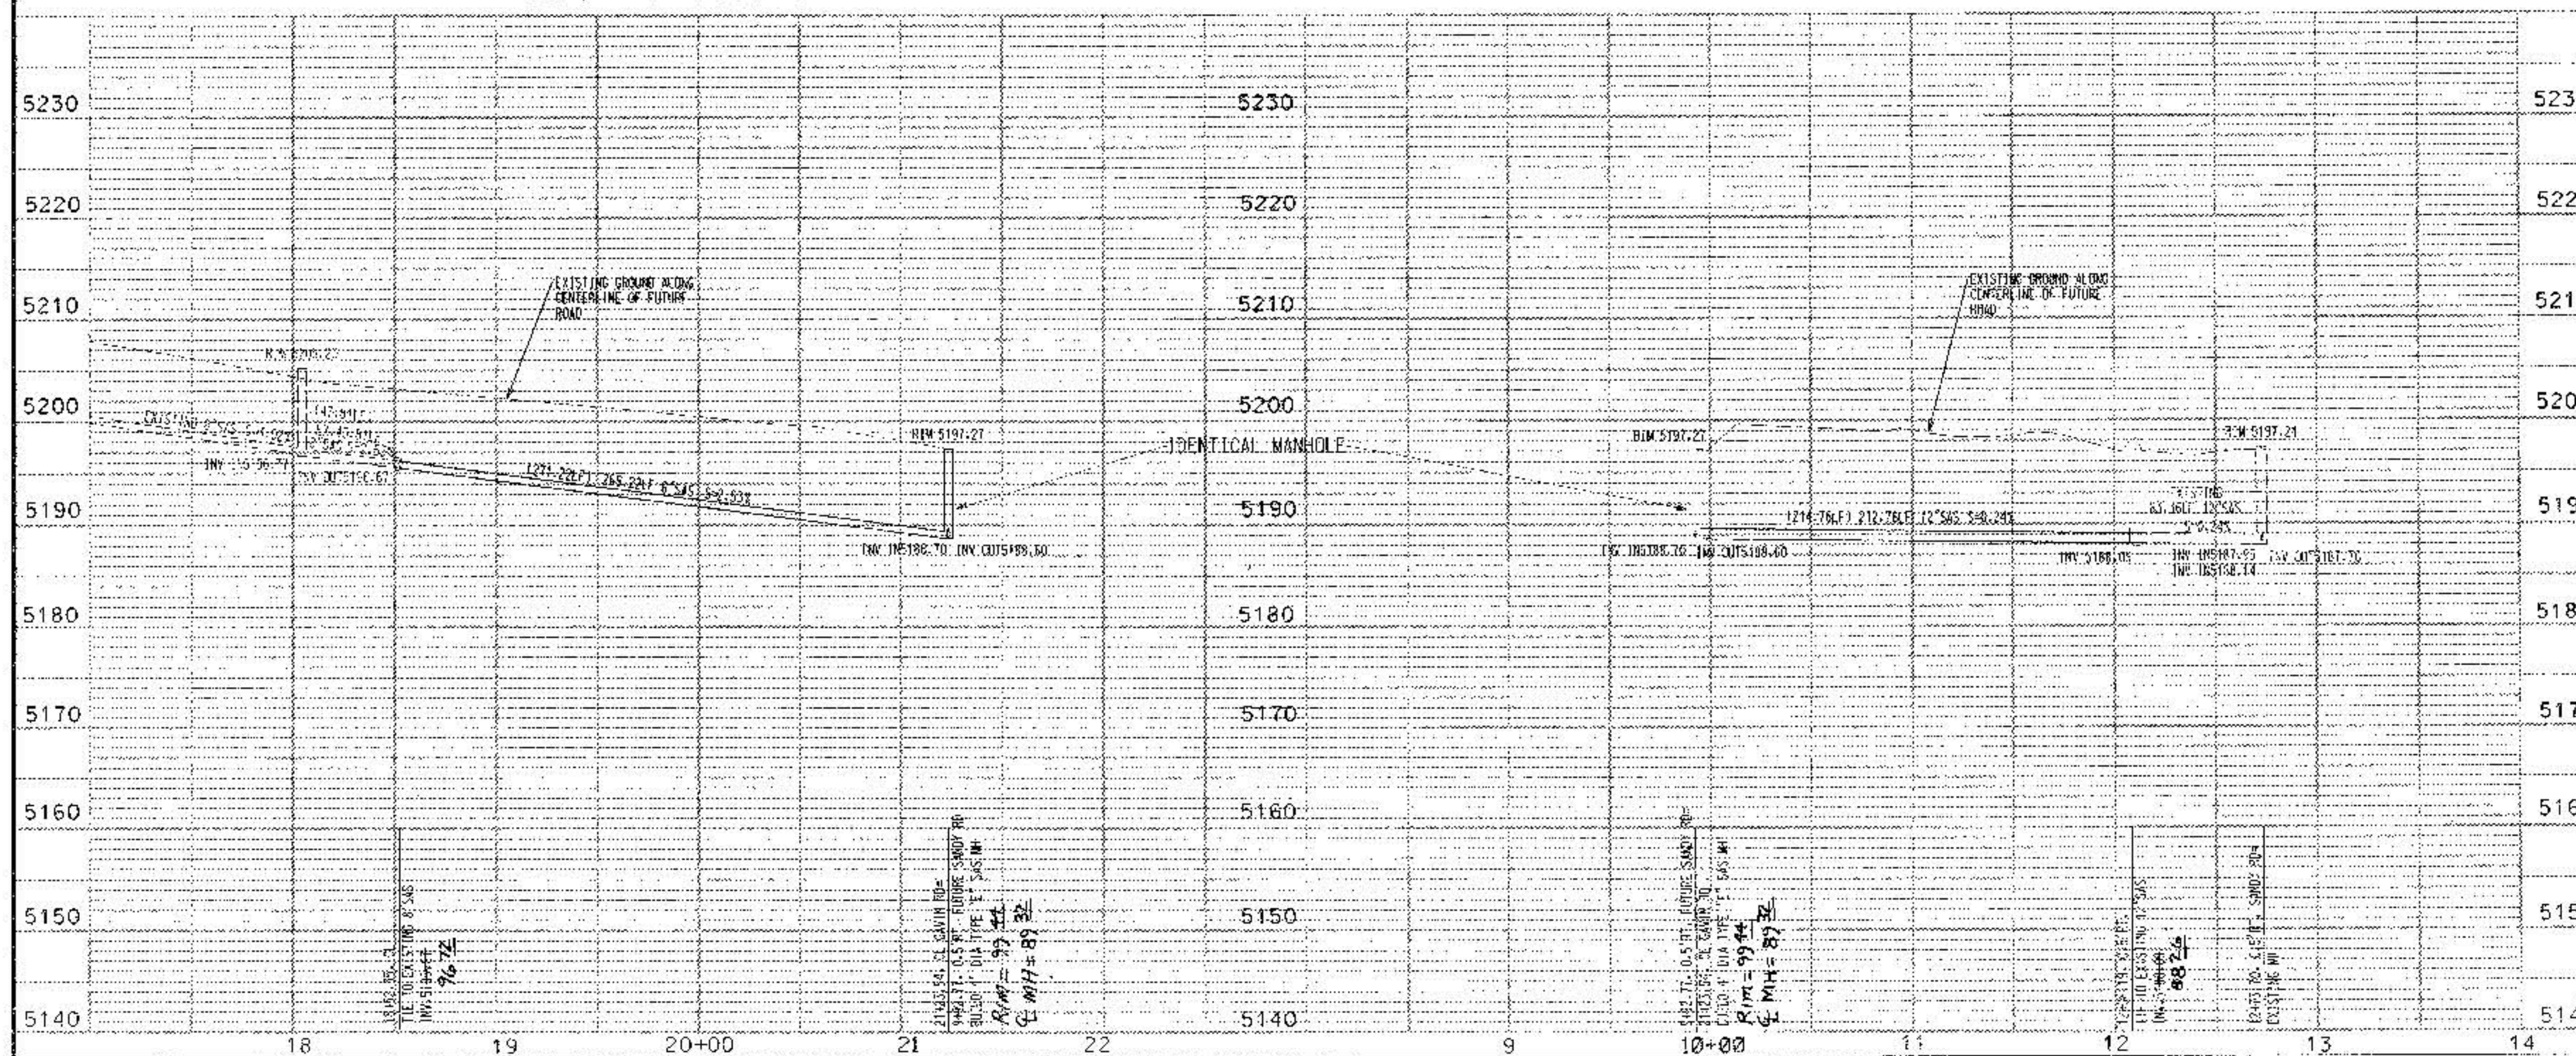

SCALE: 1" = 50' HORIZ.
1" = 10' VERT.

NOTES

- THE CONTRACTOR SHALL FIELD VERIFY ALL EXISTING UTILITY LOCATIONS AND NOTIFY THE ENGINEER IMMEDIATELY OF ANY DISCREPANCIES.
- ALL CURB RETURN RADII SHALL BE 20' UNLESS OTHERWISE SPECIFIED.
- ALL CURVE DATA AND DIMENSIONS REFER TO FACE OF CURB UNLESS OTHERWISE SPECIFIED.
- GRADE ELEVATIONS, WHERE NOTED, ARE ALONG FLOW LINE OF CURB UNLESS OTHERWISE SPECIFIED.
- CONTRACTOR IS TO INSTALL A 4" X 4" X 5' POST AND END AT THE END OF EACH SANITARY SEWER SERVICE.
- CONTRACTOR IS RESPONSIBLE FOR REPAIR AND/OR REPLACEMENT OF ALL UTILITY CONDUITS AND EXISTING LINES.
- ANY ADDITIONAL GRADING REQUIRED TO MATCH PROPOSED STREET GRADES SHALL BE INCIDENTAL TO PAVING ITEMS.
- CONTRACTOR SHALL PROVIDE THE INSPECTORS, (CITY AND PRIVATE) WITH THE PROPOSED HYDROSTATIC TESTING PLAN. THE PLAN MUST BE APPROVED BEFORE TESTING OPERATIONS BEGIN.
- CONTRACTOR SHALL PARK EQUIPMENT AND VEHICLES AS NOT TO INTERFERE WITH NORMAL ACTIVITIES OF RESIDENTS OR OTHER CONTRACTORS ON SITE.
- ANY DAMAGE TO THE EXISTING FACILITIES (CURB & GUTTER), PAVEMENT, CONDUITS, LANDSCAPING, UTILITY LINES, ETC.) DURING CONSTRUCTION SHALL BE REPLACED AT THE CONTRACTOR'S EXPENSE.
- REMOVAL OF THE EXISTING CURB AND GUTTER SHALL BE AS PER COA STD. DWG. 2415 (SAWCUT ONLY).
- WHEELCHAIR RAMPS SHALL BE CONSTRUCTED PRIOR TO ACCEPTANCE OF CURB & GUTTER.

I, David C. Clausen, New Mexico Professional
Land Surveyor No. 6547, do hereby certify that
the as-built information shown hereon is the re-
sult of a field survey performed by me or under
my direct supervision, and that the same is true
and correct.

David C. Clausen N.M.L.S. # 6547



Bohannon & Huston
County One 7500 JEFFERSON NE ALBUQUERQUE NEW MEXICO 87109
ENGINEERS PLANNERS PHOTOGRAMMETRISTS SURVEYORS LANDSCAPE ARCHITECTS

**CITY OF ALBUQUERQUE
PUBLIC WORKS DEPARTMENT
ENGINEERING DEVELOPMENT GROUP**


**PARKLAND VIEW SUBDIVISION - PHASE I
UTILITY PLAN & PROFILE
GAVIN ROAD TO FUTURE SANDY ROAD (SAS)**

DESIGNED BY	TSG/PL	DATE	11/97
DRAWN BY	TSG/PG	DATE	11/97
CHECKED BY	KP	DATE	11/97

CITY PROJECT NO. 4442.98 ZONE MAP NO. J-9 SHEET 14 OF 15

COPYRIGHT BOHANNON & HUSTON 1997
DATE: NOV 11, 1997

AS-BUILT INFORMATION		BENCH MARKS		FIELD NOTES	
CONTRACTOR	Bohannon & Huston	ACS BRASS TABLET STAMPED	784-40"	NO.	BY
DATE	8/98	GEOGRAPHIC POSITION (NAD 1927)			
ACCEPTANCE BY	Bohannon & Huston	N.M. STATE PLANE COORDINATES			
DATE	8/98	(CENTRAL ZONE) X=532,190.66			
FIELD LOCATION BY	Bohannon & Huston	Y=1,482,346.53			
DATE	8/98	GROUND-TO-GRID FACTOR = .99967105			
RECORDED BY	Bohannon & Huston	NOVD 1929 ELEVATION = 5193.38'			
DATE	8/98				

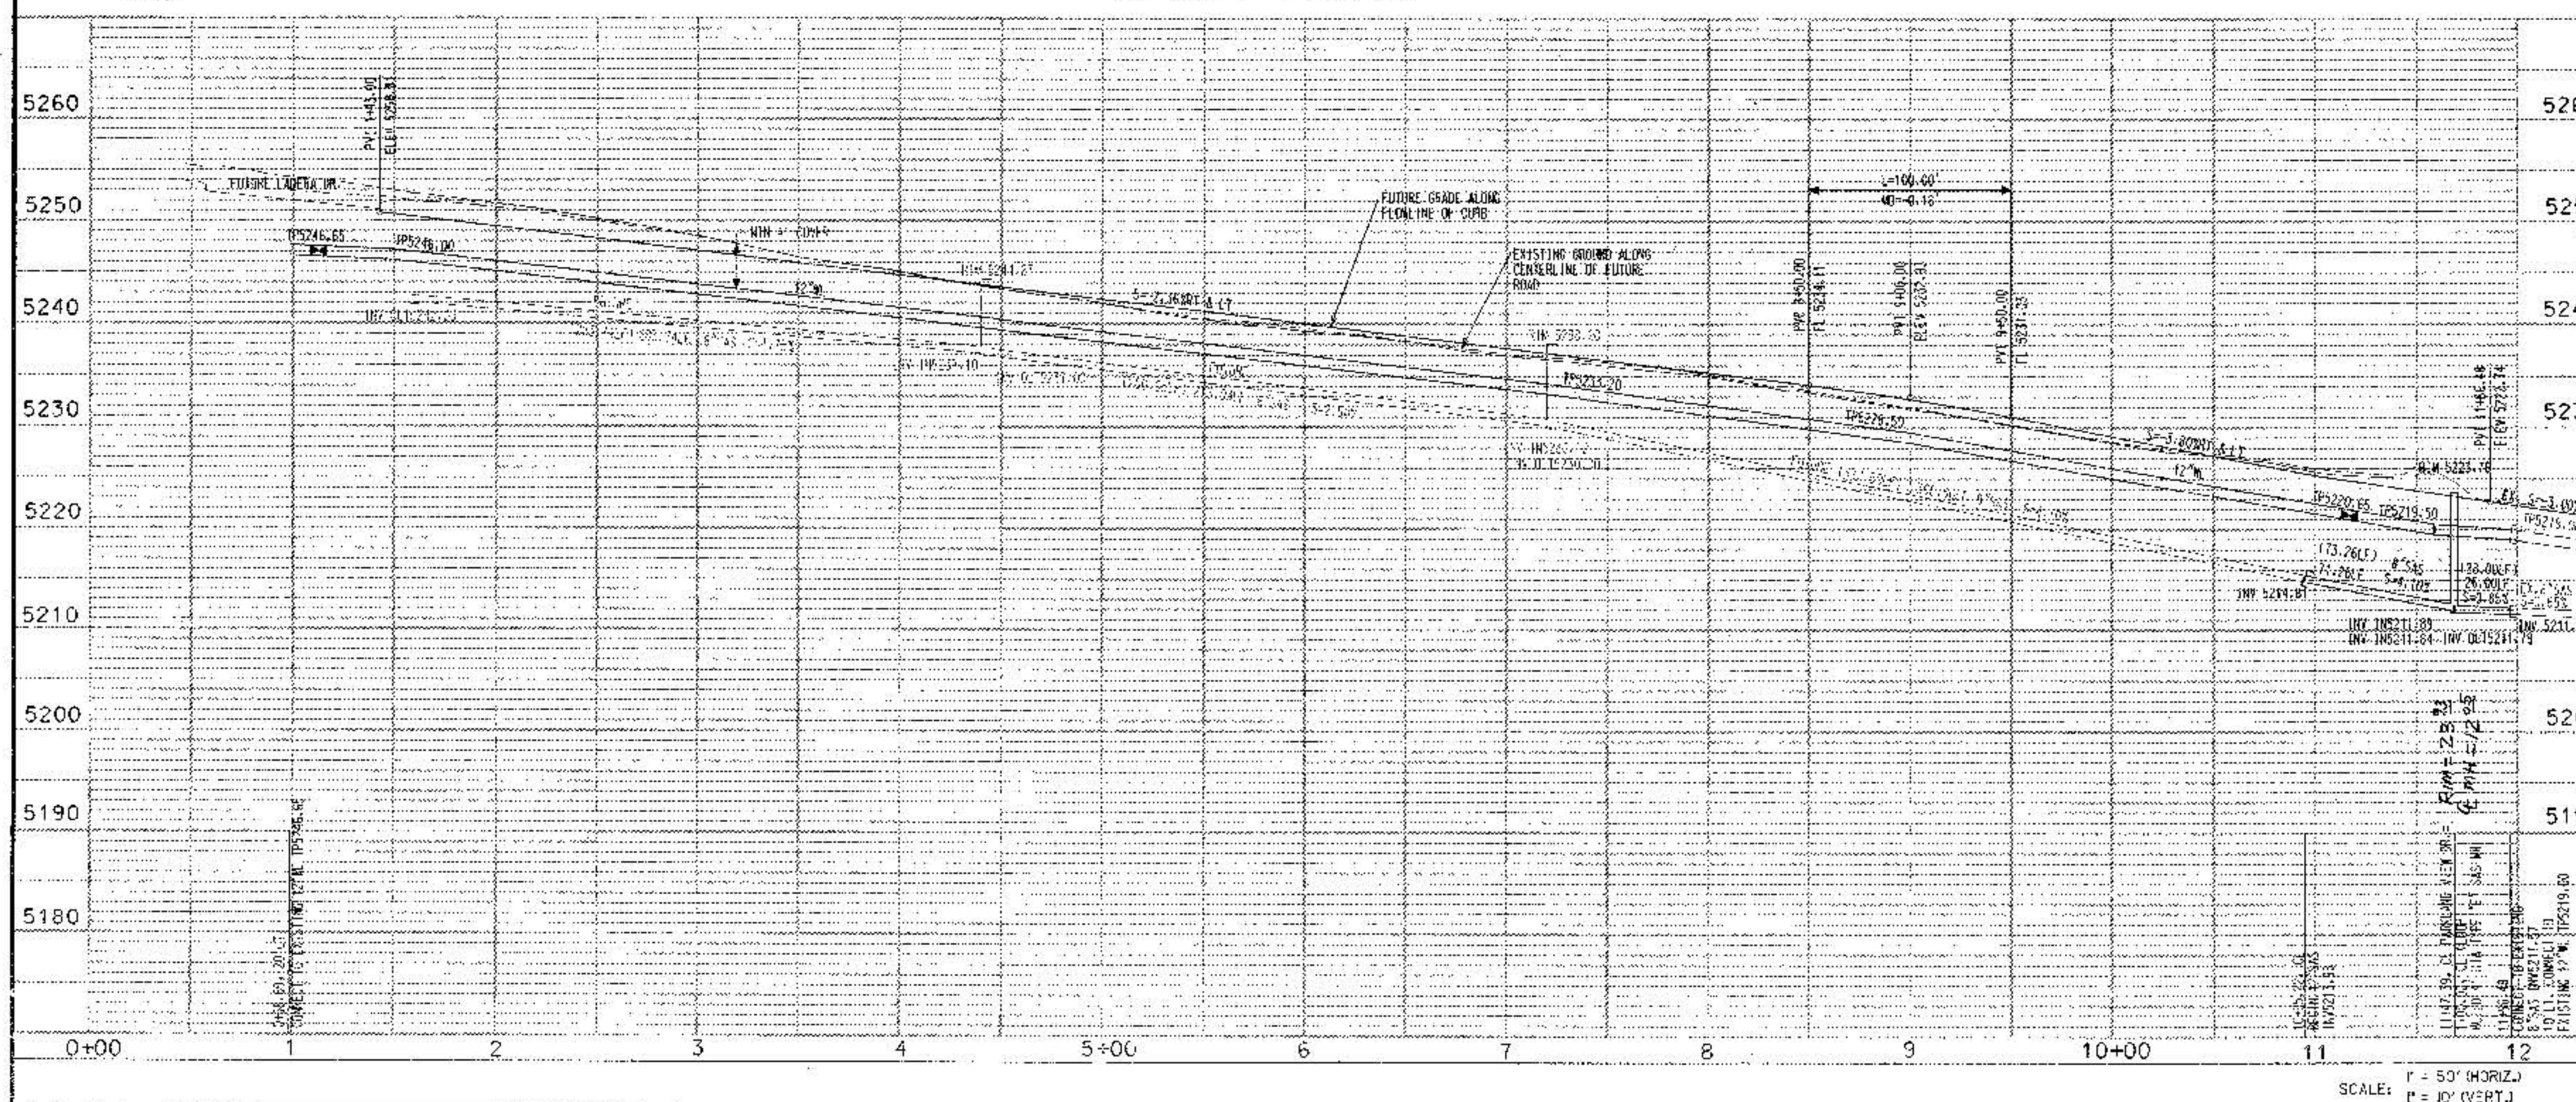

WATERLINE TANGENT DATA		
NUMBER	BEARING	LENGTH
T1	S28°24'24"E	51.24'
T2	S39°39'25"E	10.00'
T3	S89°21'06"E	177.29'
T4	S89°21'06"E	258.43'

- I, David C. Clausen, New Mexico Professional Land Surveyor No. 6547, do hereby certify that the as-built information shown hereon is the result of a field survey performed by me or under my direct supervision, and that the same is true and correct.



City of _____ State of _____

ENGINEERS PLANNERS PHOTOGRAMMETRISTS SURVEYORS LANDSCAPE ARCHITECTS



CITY OF ALBUQUERQUE
PUBLIC WORKS DEPARTMENT
ENGINEERING DEVELOPMENT GROUP

PARKLAND VIEW SUBDIVISION - PHASE I
UTILITY PLAN & PROFILE
FUTURE GAVIN ROAD (WL)

	CITY ENGINEER'S APPROVAL	MO./DAY/YR.	MO./DAY/YR.
	LAST DESIGN UPDATE		

CITY PROJECT NO.	ZONE MAP NO.	SHEET	OF
4442.98	J-9	15	15

COPYRIGHT BOHANNAN HUSTON 1997
DATE: NOVEMBER, 1997

CONSTRUCTION TRAFFIC CONTROL GENERAL NOTES

1. CONTRACTOR MUST OBTAIN FROM CONSTRUCTION COORDINATION AN EXCAVATION/BARRICADING PERMIT BEFORE ENGAGING IN ANY CONSTRUCTION, MAINTENANCE OR REPAIR WORK IN ANY OF THE CITY OF ALBUQUERQUE'S RIGHTS-OF-WAY. EMERGENCY WORK THAT WOULD PRESERVE LIFE OR PROPERTY IS EXCLUDED WITH THE UNDERSTANDING, THAT A PERMIT SHALL BE OBTAINED WITHIN 24 TO 48 HOURS.

2. CONTRACTOR SHALL AT THE TIME OF PERMIT REQUEST, SUBMIT FOR APPROVAL BY CONSTRUCTION COORDINATION, A TRAFFIC CONTROL PLAN, DETAILING ALL EXISTING TOPOGRAPHY SUCH AS LANE WIDTHS, DRIVEWAYS, AND BUSINESS/RESIDENTIAL ACCESSES. THE TRAFFIC CONTROL PLAN SHALL INCLUDE ALL PHASES OF WORK AND SCHEDULES INVOLVED IN THE CONSTRUCTION PROJECT. ANY SEPARATE PHASES OF A CONSTRUCTION PROJECT SHALL BE GIVEN AN INDIVIDUAL PERMIT EACH. BLANKET PERMITS WILL NOT BE ISSUED.

3. THESE TYPICAL TRAFFIC CONTROL PLANS DO NOT REFLECT THE EXISTING TOPOGRAPHY SUCH AS DRIVEWAYS, LANE WIDTHS, AND BUSINESS/RESIDENTIAL ACCESSES. EVERY LOCATION THAT REQUIRES CONSTRUCTION TRAFFIC CONTROL SHALL HAVE A DETAILED TRAFFIC CONTROL PLAN SHOWING ALL EXISTING TOPOGRAPHY.

4. CONSTRUCTION SHALL NOT BEGIN UNLESS A TRAFFIC CONTROL PLAN HAS BEEN APPROVED AND VERIFIED BY CONSTRUCTION COORDINATION.

5. CONSTRUCTION COORDINATION SHALL BE NOTIFIED 48 HOURS PRIOR TO ANY TRAFFIC CONTROL CHANGES NEEDED BY CONTRACTOR, THAT WERE NOT PREVIOUSLY APPROVED. THESE TRAFFIC CONTROL CHANGES SHALL BE REQUESTED IN WRITING ACCOMPANIED WITH A TRAFFIC CONTROL PLAN REFLECTING SUCH CHANGES.

6. ALL CONSTRUCTION TRAFFIC CONTROL DEVICES SHALL COMPLY TO THE MANUAL ON UNIFORM TRAFFIC CONTROL DEVICES (MUTCD), LATEST EDITION. IT IS THE RESPONSIBILITY OF THE CONTRACTOR TO INSTALL, SERVICE AND MAINTAIN ALL TRAFFIC CONTROL DEVICES. TRAFFIC CONTROL DEVICES SHALL NOT BE REMOVED OR ALTERED IN ANY WAY WITHOUT THE APPROVAL OF CONSTRUCTION COORDINATION, PER SECTION 6A-4 OF THE MUTCD, LATEST EDITION.

7. THE CONSTRUCTION TRAFFIC CONTROL INITIAL SET-UP SHALL BE BY AN AMERICAN TRAFFIC SAFETY SERVICES ASSOCIATION (ATSSA) CERTIFIED WORKSITE TRAFFIC SUPERVISOR. THE MAINTENANCE AND SERVICING SHALL ALSO BE DONE BY AN ATSSA CERTIFIED WORKSITE TRAFFIC SUPERVISOR OR EQUIVALENT.

8. CONTRACTOR IS RESPONSIBLE TO MAINTAIN AND SERVICE ALL TRAFFIC CONTROL DEVICES 24 HOURS A DAY, 7 DAYS A WEEK THROUGHOUT LENGTH OF PROJECT. CONTRACTOR IS RESPONSIBLE THAT ALL TRAFFIC CONTROL DEVICES COMPLY WITH THE MUTCD, LATEST EDITION.

9. ALL ADVANCE WARNING SIGNS SHALL BE DOUBLE INDICATED WHENEVER THERE ARE MULTI-LANE TRAFFIC IN ANY ONE GIVEN DIRECTION AND THERE IS SUFFICIENT MEDIAN SPACE.

10. ALL BARRICADES IN ALL TAPERS AND TANGENTS SHALL BE PLACED APART, A DISTANCE MEASURED IN FEET, EQUAL TO THAT OF THE POSTED SPEED LIMIT. NO EXCEPTIONS UNLESS APPROVED BY CONSTRUCTION COORDINATION PER MUTCD SECTION 6A-4.

11. ALL WORK IN ARTERIAL ROADWAYS SHALL BE ON A CONTINUOUS 24 HOUR PER DAY BASIS UNTIL COMPLETED.

12. CONTRACTOR IS RESPONSIBLE TO PROVIDE CONSTRUCTION COORDINATION, A WEEKLY LOG OF DAILY INSPECTIONS OF BARRICADE AND MAINTENANCE SCHEDULES ON PROJECTS THAT ARE OVER ONE WEEK DURATION.

13. EQUIPMENT OR MATERIALS SHALL NOT BE STORED WITHIN 15 FEET OF A TRAVELLED TRAFFIC LANE DURING NON-WORKING HOURS WITHOUT THE APPROVAL OF CONSTRUCTION COORDINATION.

14. CONTRACTOR SHALL PROVIDE AND MAINTAIN A SAFE AND ADEQUATE MEANS OF CHANNELIZING PEDESTRIAN TRAFFIC AROUND AND THROUGH THE CONSTRUCTION AREA.

15. CONTRACTOR IS RESPONSIBLE FOR OBLITERATION OF ANY CONFLICTING STRIPING AND RESPONSIBLE FOR ALL TEMPORARY STRIPING.

16. CONTRACTOR SHALL MAINTAIN ACCESS TO ALL FACILITIES, BUSINESSES AND/OR RESIDENTS AT ALL TIMES.

17. CONTRACTOR SHALL PROVIDE ACCESS SIGNS FOR BUSINESSES LOCATED WITHIN THE CONSTRUCTION AREA UNDER THE SUPERVISION OF CONSTRUCTION COORDINATION. EACH ACCESS SIGN SHALL HAVE 5 INCH, WHITE OPAQUE LETTERING ON BLUE REFLECTORIZED BACKGROUND. ACCESS SIGNS SHALL BE CONSIDERED INCIDENTAL TO THE BID AND NOT PART OF THE CONTRACT UNLESS OTHERWISE STATED. NO MORE THAN 3 BUSINESSES SHALL BE LISTED ON A ACCESS SIGN. SHOPPING CENTERS AND MALLS SHALL BE LISTED AS SUCH.

18. ALL ADVANCE WARNING SIGNS SHALL MEET THE MINIMUM REFLECTIVE INTENSITY REQUIREMENTS SET FORTH BY THE CITY OF ALBUQUERQUE. CONSTRUCTION COORDINATION SHALL DETERMINE ALL REQUIREMENTS AND APPROVE OR DISAPPROVE ANY ADVANCE WARNING SIGN PER SECTION 6A-4 OF THE MUTCD, LATEST EDITION.

19. 48 HOURS PRIOR TO OCCUPYING OR CLOSING OF A RIGHT-OF-WAY, CONTRACTOR SHALL NOTIFY: POLICE, FIRE DEPARTMENT, SCHOOLS, HOSPITALS, TRANSIT AUTHORITY, BUSINESSES AND/OR RESIDENTS THAT WILL BE AFFECTED BY THE CONSTRUCTION.

20. ANY FIELD ADJUSTMENTS SHALL BE APPROVED BY CONSTRUCTION COORDINATION.

21. EXCAVATIONS SHALL BE PLATED, TEMPORARILY PATCHED OR RESURFACED PRIOR TO OPENING OF TRAFFIC. A MINIMUM OF 11 FEET SHALL BE PROVIDED FOR TRAFFIC IN ANY GIVEN DIRECTION. CONTRACTOR IS RESPONSIBLE FOR ANY WORK INVOLVED IN SATISFYING THESE REQUIREMENTS.

22. CONTRACTOR SHALL AT ALL TIMES COMPLY WITH THE FOLLOWING:
1. STANDARDS AND REQUIREMENTS SET FORTH IN THE MANUAL ON UNIFORM TRAFFIC CONTROL DEVICES, LATEST EDITION.
2. THE CITY OF ALBUQUERQUE TRAFFIC CODE, LATEST EDITION.
3. SECTION 19 OF THE CITY OF ALBUQUERQUE'S STANDARD SPECIFICATIONS FOR PUBLIC WORK CONSTRUCTION, AS WELL AS OTHER SECTIONS.


23. FAILURE TO COMPLY WITH ANY OF THE ABOVE MENTIONED, WILL BE ADEQUATE CAUSE TO CEASE ALL WORK ON ANY CONSTRUCTION PROJECT. WORK WILL NOT RESUME UNTIL ALL REQUIREMENTS ARE ADDRESSED AND APPROVED BY CONSTRUCTION COORDINATION.

24. ALL TRAFFIC CONTROL DEVICES SHALL BE KEPT IN NEW-CLEAN CONDITION. WASHING OF EQUIPMENT IS INCIDENTAL TO ITS PLACEMENT AND MAINTENANCE.



25. TRAFFIC CONTROL STANDARDS APPLY ONLY WHERE THE CONSTRUCTION TRAFFIC CONTROL PLANS ARE NOT SPECIFIC.

26. ADVANCE WARNING SIGNS SHALL BE 36"x36" MIN. WITH SUPER ENGINEERING GRADE SHEETING OR BETTER. MOUNTING HEIGHT AT TOP OF SIGN SHALL BE THE SAME AS FOR A 48" SIGN AS INDICATED IN THE MUTCD.


27. CONTRACTOR SHALL MAINTAIN A GRAFFITI-FREE WORKSITE. ALL GRAFFITI SHALL BE PROMPTLY REMOVED FROM ALL EQUIPMENT, BOTH PERMANENT AND TEMPORARY.

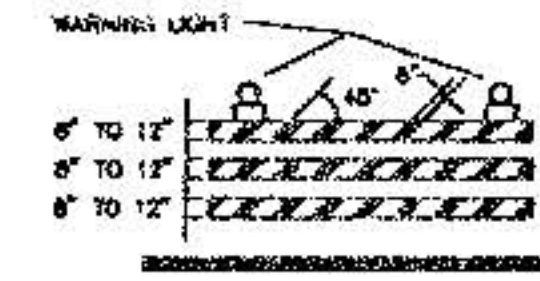


TYPE III BARRICADE

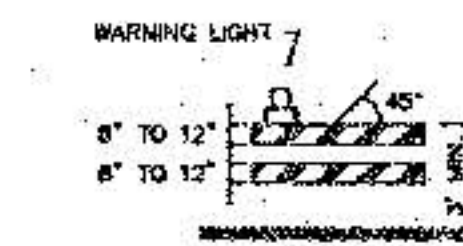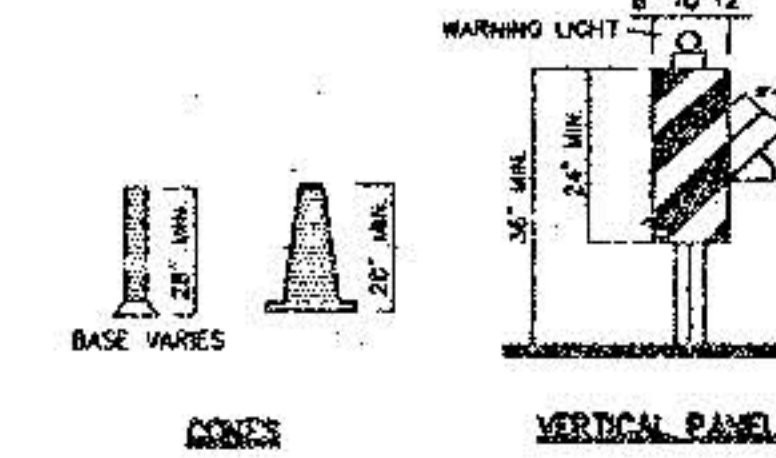


TYPE I BARRICADE

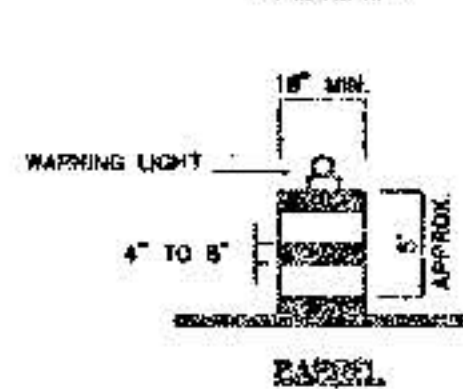

TYPE II BARRICADE

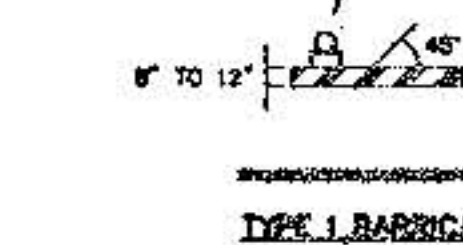

TYPE I BARRICADE

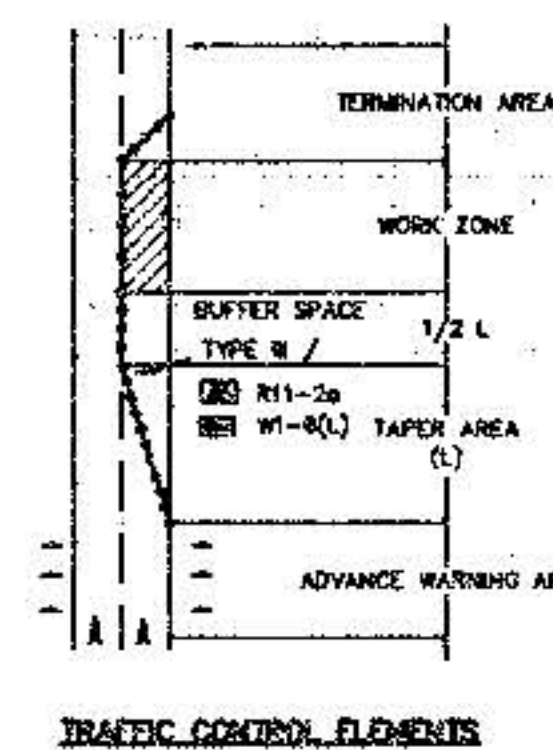

TRAFFIC CONTROL ELEMENTS

LEGEND

- WORK AREA
- BARRICADE - TYPE I, TYPE II, OR BARREL
- BARRICADE - TYPE III
- VERTICAL PANEL
- WARNING SIGN
- DISTANCE BETWEEN SIGNS - A DISTANCE MEASURED IN FEET EQUAL TO A VALUE OF TEN TIMES THE SPEED LIMIT OF THE STREET
- FLAGMAN POSITION
- SPACING BETWEEN BARRICADES - A DISTANCE MEASURED IN FEET EQUAL TO THE SPEED LIMIT OF THE STREET
- TAPER LENGTH - SEE CHART BELOW
- THE TANGENT LENGTH IS EQUAL TO THE TAPER LENGTH FOR A GIVEN STREET.

TAPER REQUIREMENTS

SPEED LIMIT (MPH)	TAPER LENGTH (L) (FEET)			MINIMUM NUMBER OF DEVICES FOR TAPER	MAXIMUM DEVICE SPACING IN FEET	
	10' LANE	11' LANE	12' LANE		ALONG TAPER	AFTER TAPER
20	70	75	80	5	20	20
25	105	115	125	6	25	25
30	150	165	180	7	30	30
35	205	225	245	8	35	35
40	270	295	320	9	40	40
45	450	495	540	13	45	45
50	500	550	600	13	50	50
55	550	605	660	13	55	55

RECOMMENDED SIGN SPACING (D) FOR ADVANCE WARNING SIGN SERIES

SPEED LIMIT (MPH)	MINIMUM DISTANCE IN FEET BETWEEN SIGNS	FROM LAST SIGN TO TAPER
0-20	10 X SPEED LIMIT	10 X SPEED LIMIT
25-30	10 X SPEED LIMIT	10 X SPEED LIMIT
30-35	10 X SPEED LIMIT	10 X SPEED LIMIT
40-45	10 X SPEED LIMIT	10 X SPEED LIMIT
50-60	10 X SPEED LIMIT	10 X SPEED LIMIT

TAPER CRITERIA


TYPE OF TAPER	TAPER LENGTH
UPSTREAM TAPER:	
MERGING TAPER	L MINIMUM
SHIFTING TAPER	1/2 L MINIMUM
SHOULDER TAPER	1/2 L MINIMUM
TWO-WAY TRAFFIC TAPER	100 FEET MAXIMUM
DOWNSTREAM TAPERS	100 FEET PER LANE

TAPER LENGTH COMPUTATION


SPEED LIMIT	L =
40 MPH OR LESS	$L = \frac{WS^2}{60}$
45 MPH OR GREATER	$L = W \times S$

L = TAPER LENGTH
W = WIDTH OF OFFSET IN FEET
S = POSTED SPEED OR OFF-PEAK, 85-PERCENTILE SPEED IN MPH


SIGN FACE DETAILS

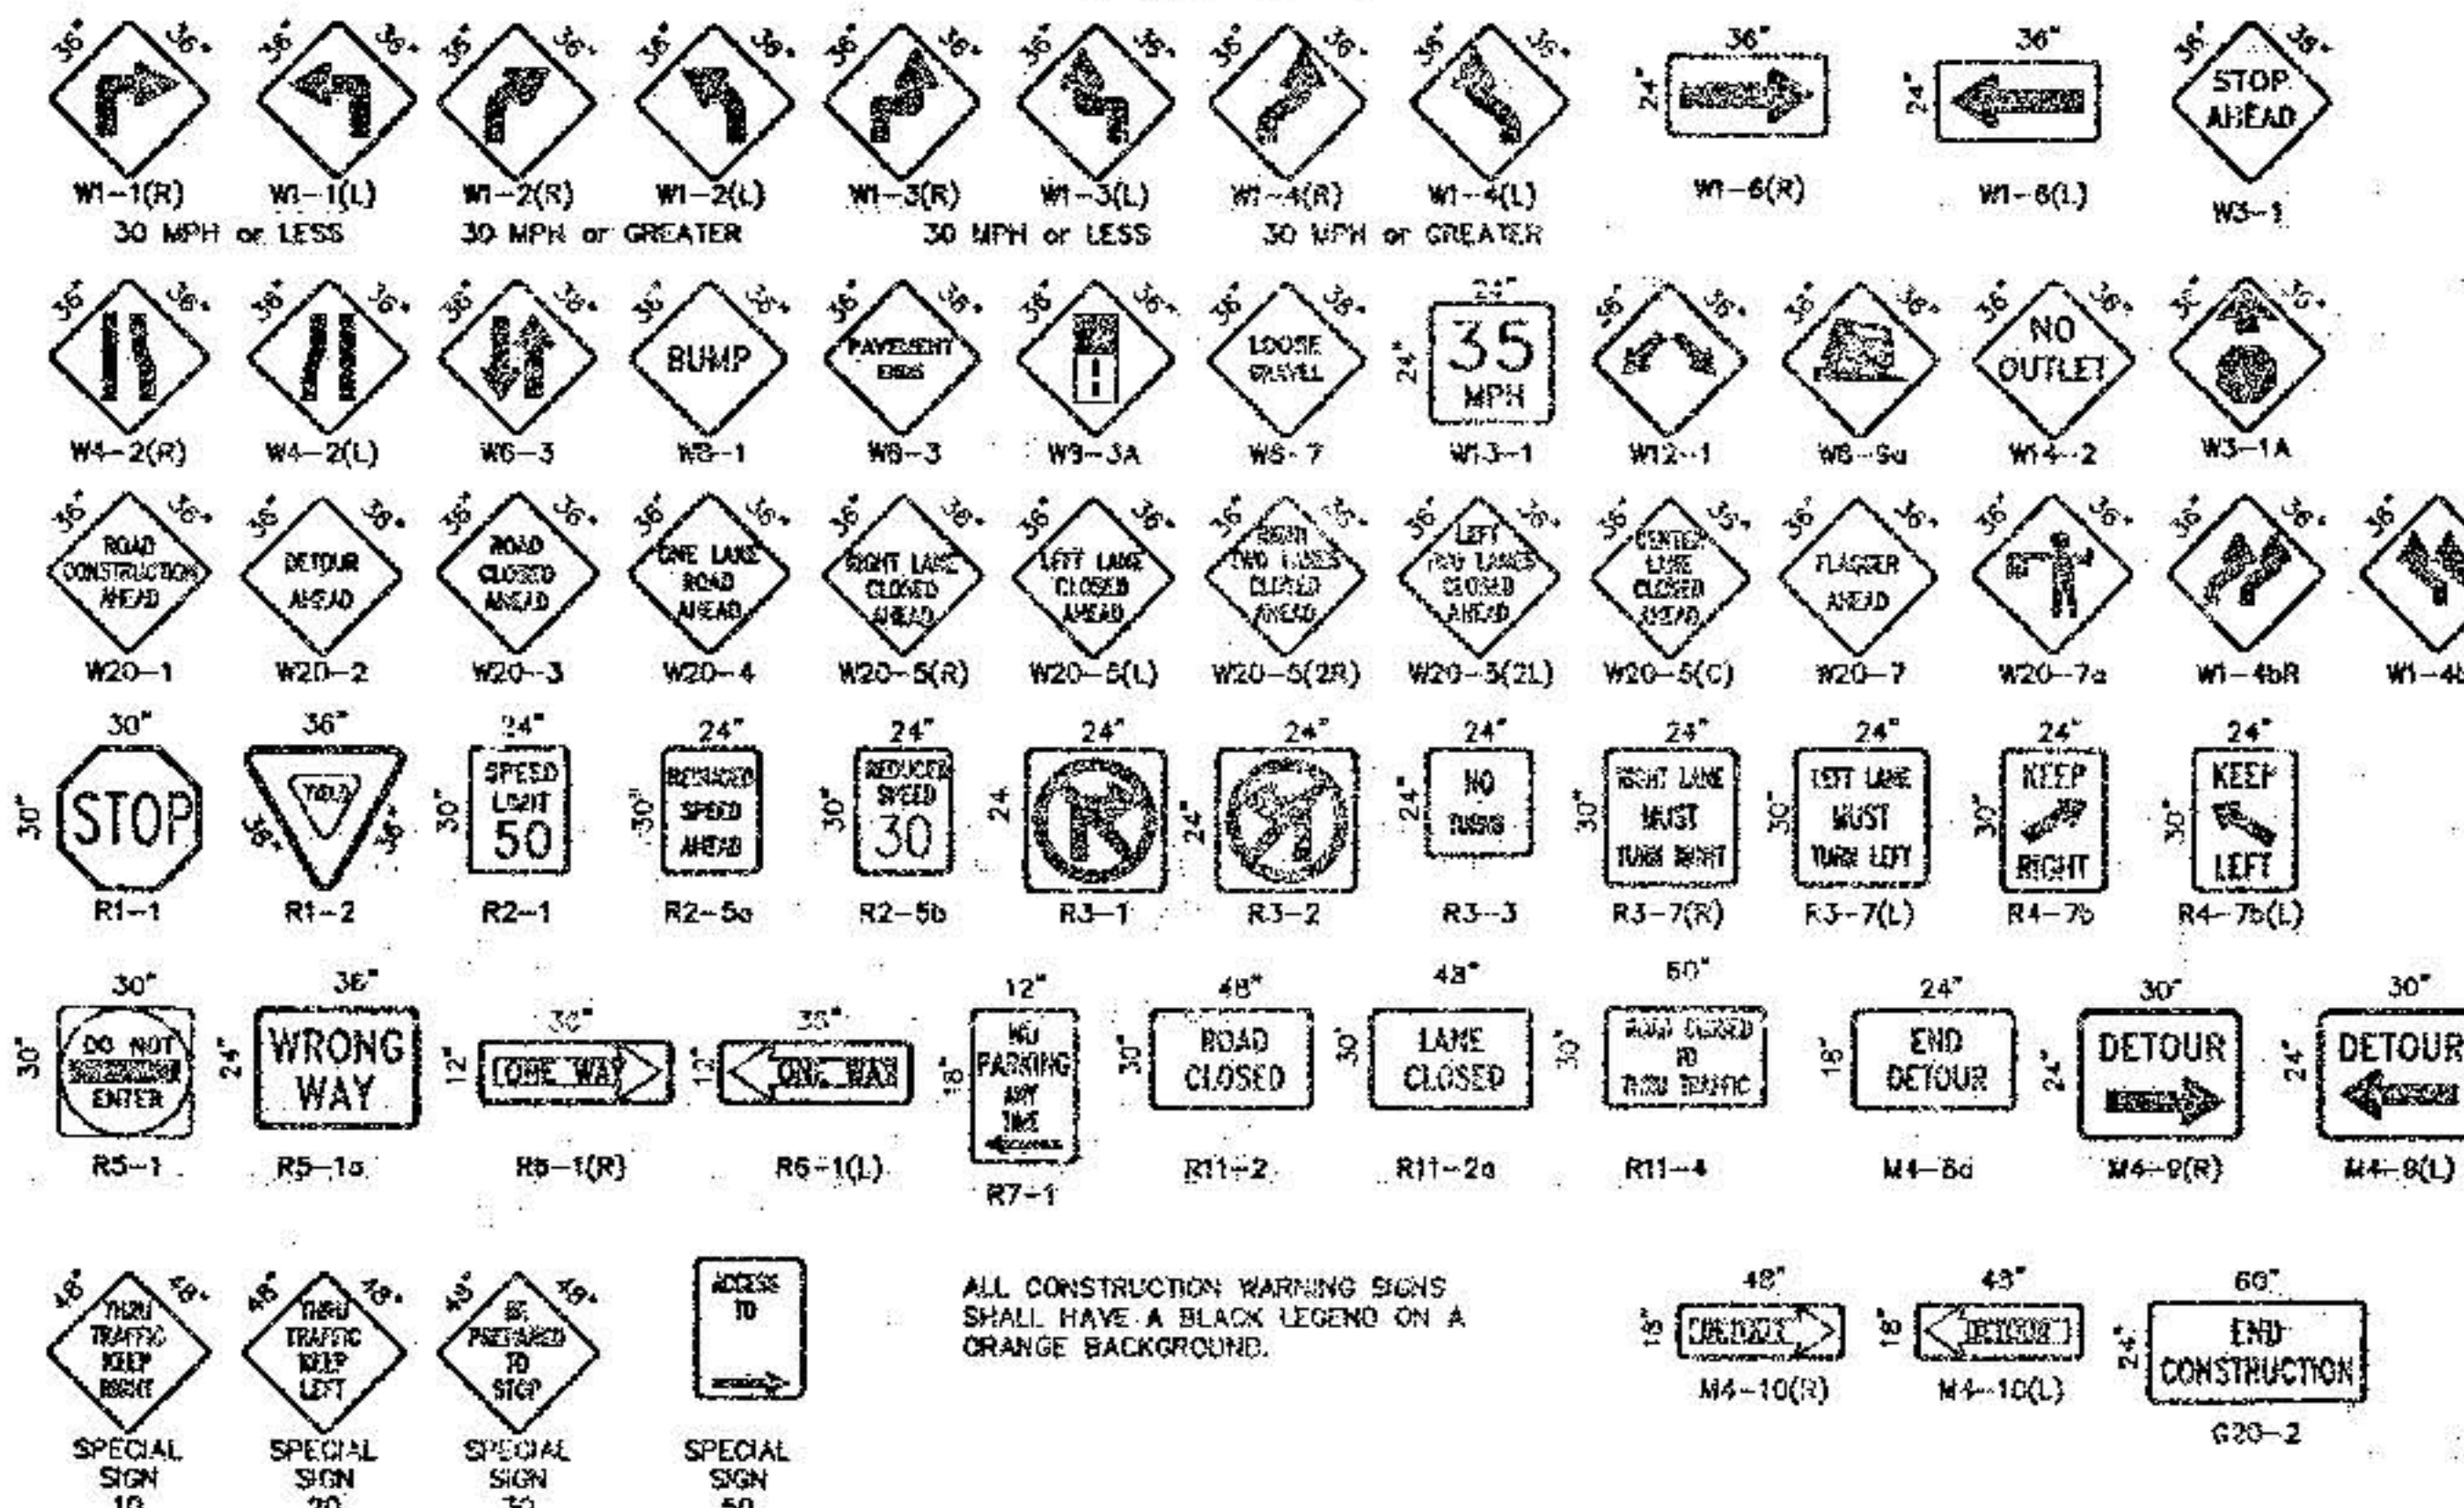


ALL CONSTRUCTION WARNING SIGNS SHALL HAVE A BLACK LEGEND ON A ORANGE BACKGROUND.

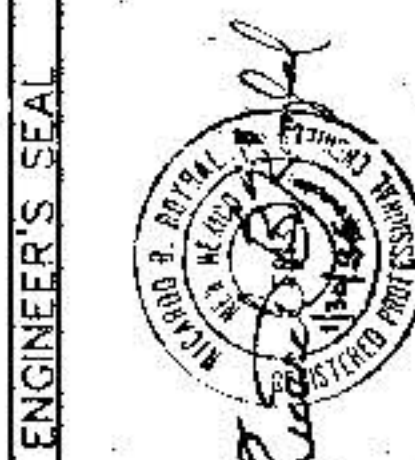

CITY OF ALBUQUERQUE PUBLIC WORKS DEPARTMENT ENGINEERING DEVELOPMENT GROUP			
TITLE: SIGNING AND CONSTRUCTION TRAFFIC CONTROL STANDARDS			
DESIGN REVIEW COMMITTEE	CITY ENGINEER APPROVAL	NO. 2047/18	NO. 2047/18
COA Standard		LAST UPDATE	
PROJECT NO. 4442.98	MAP NO. J-9	SHEET 15A OF 15	

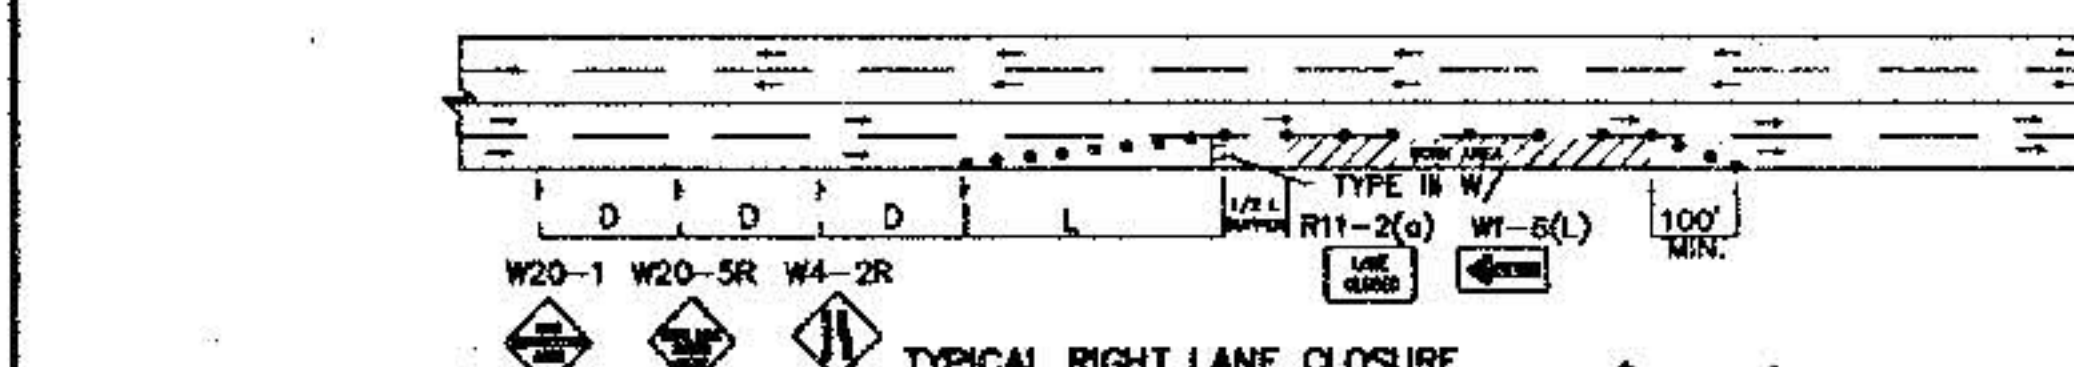


TYPICAL RIGHT LANE CLOSURE

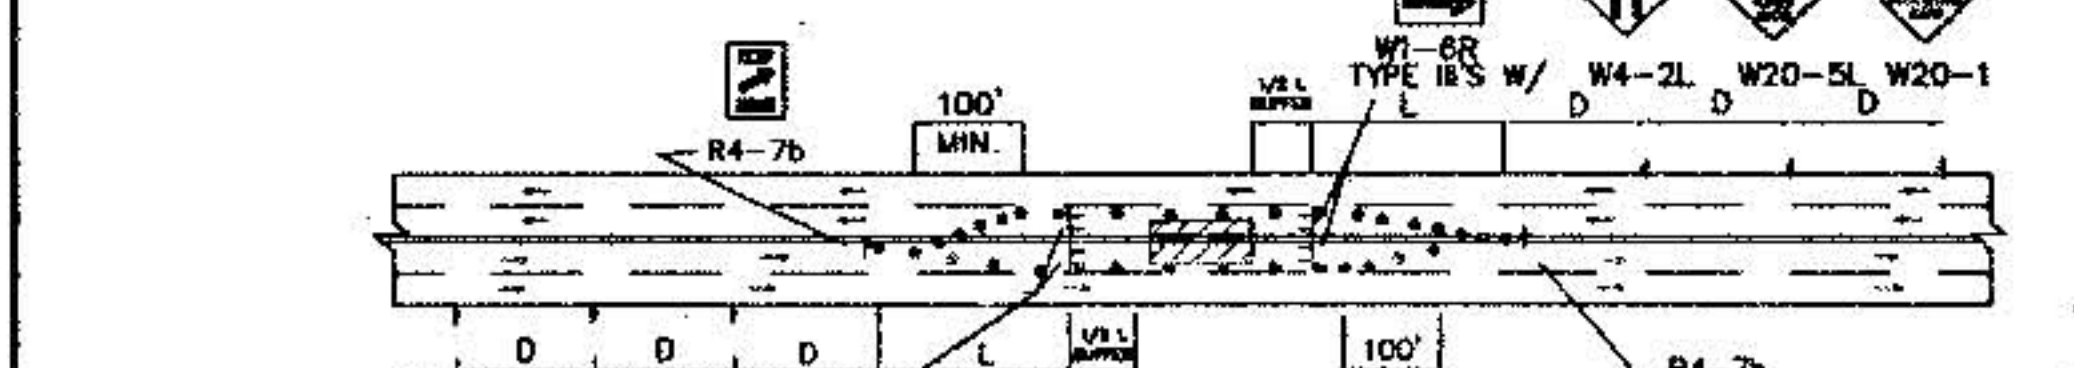


TYPICAL LEFT LANE CLOSURE




TYPICAL ONE DIRECTION DETOUR

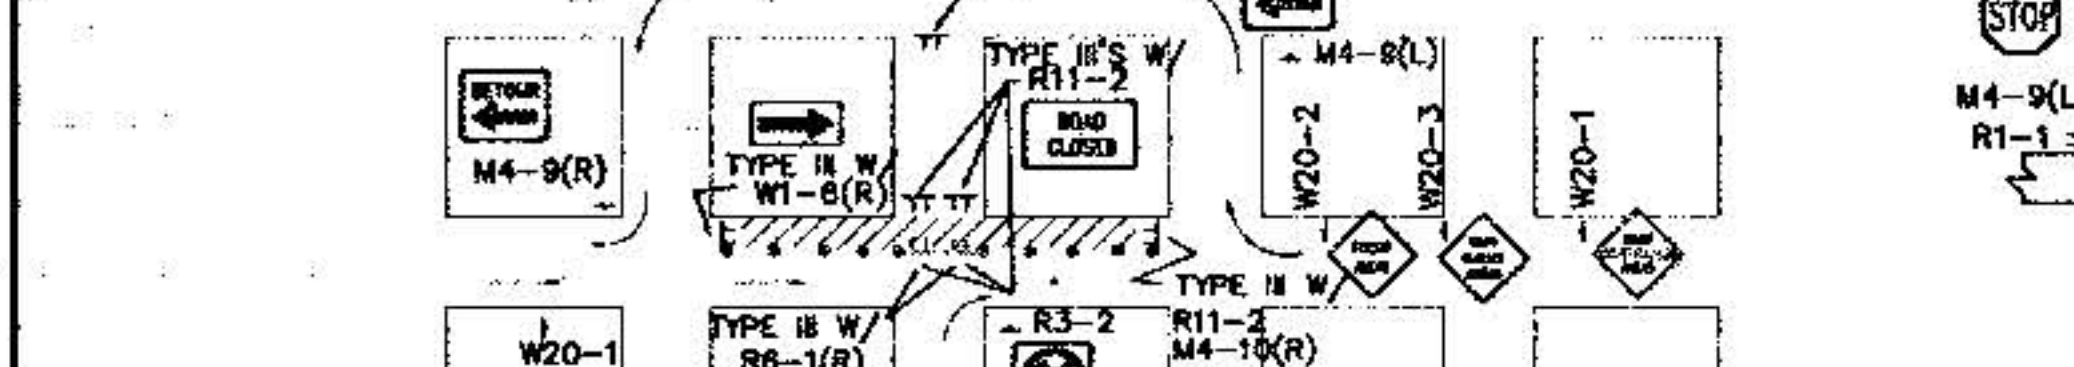


TYPICAL TRAFFIC SPLIT (PAINTED MEDIAN)

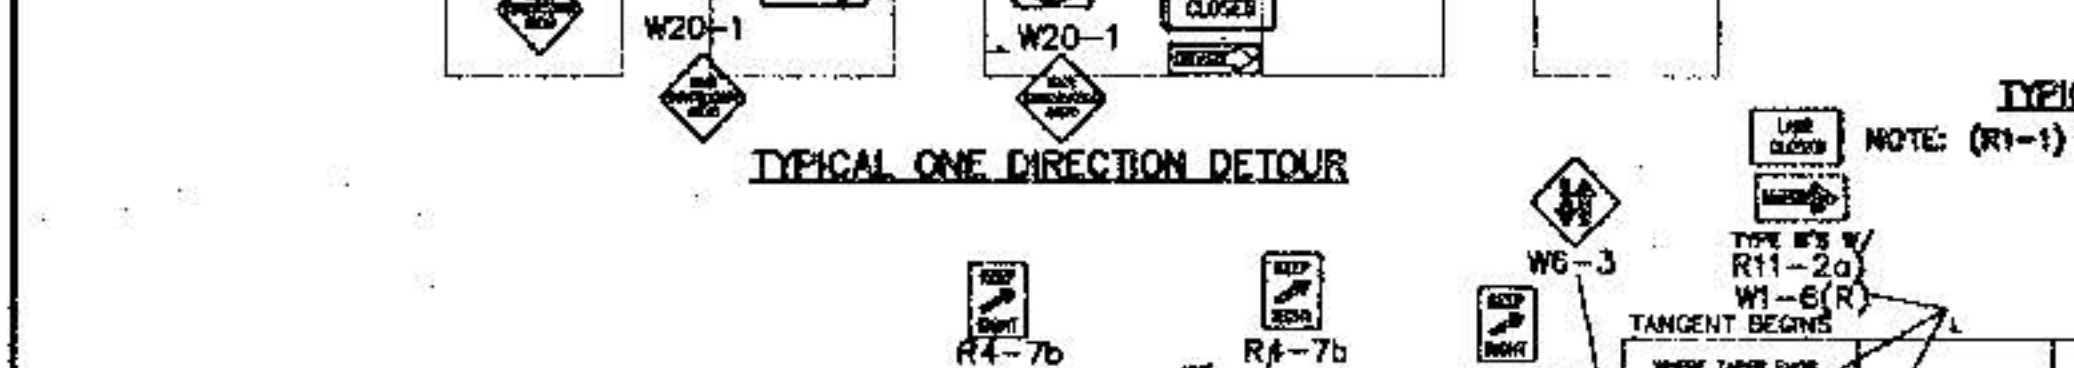


TYPICAL TRAFFIC SPLIT (RAISED MEDIAN)

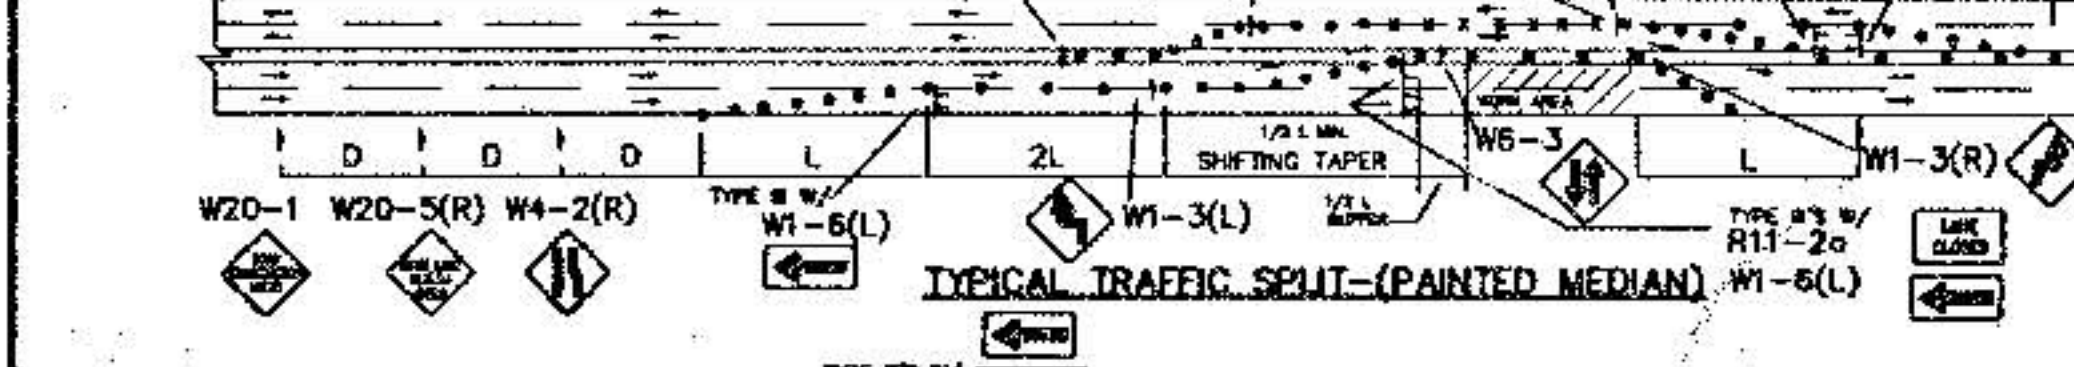


TYPICAL SANITARY SEWER SYPHONING OPERATION

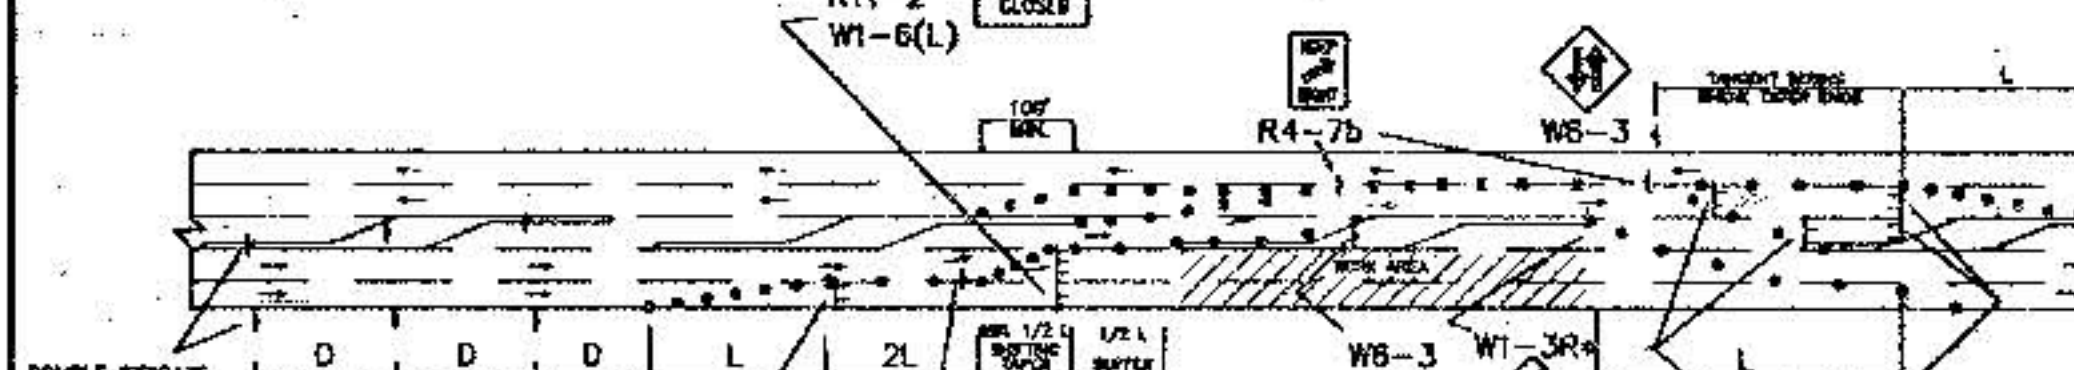


TYPICAL STREET CLOSURE

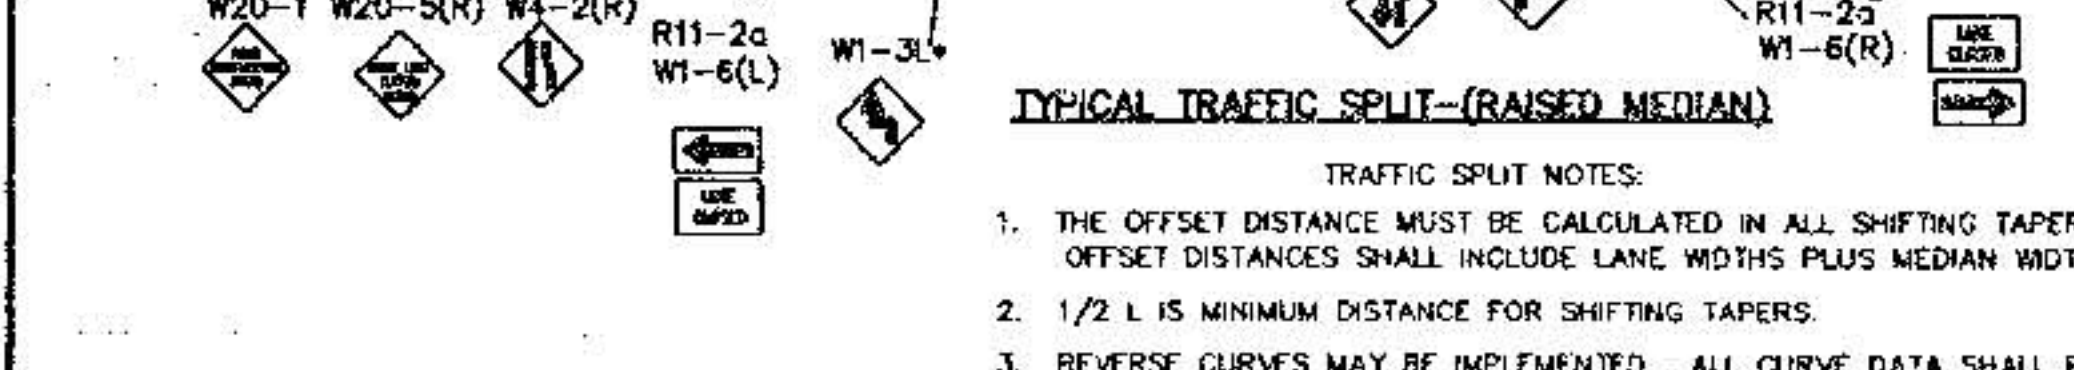


TYPICAL STREET CLOSURE

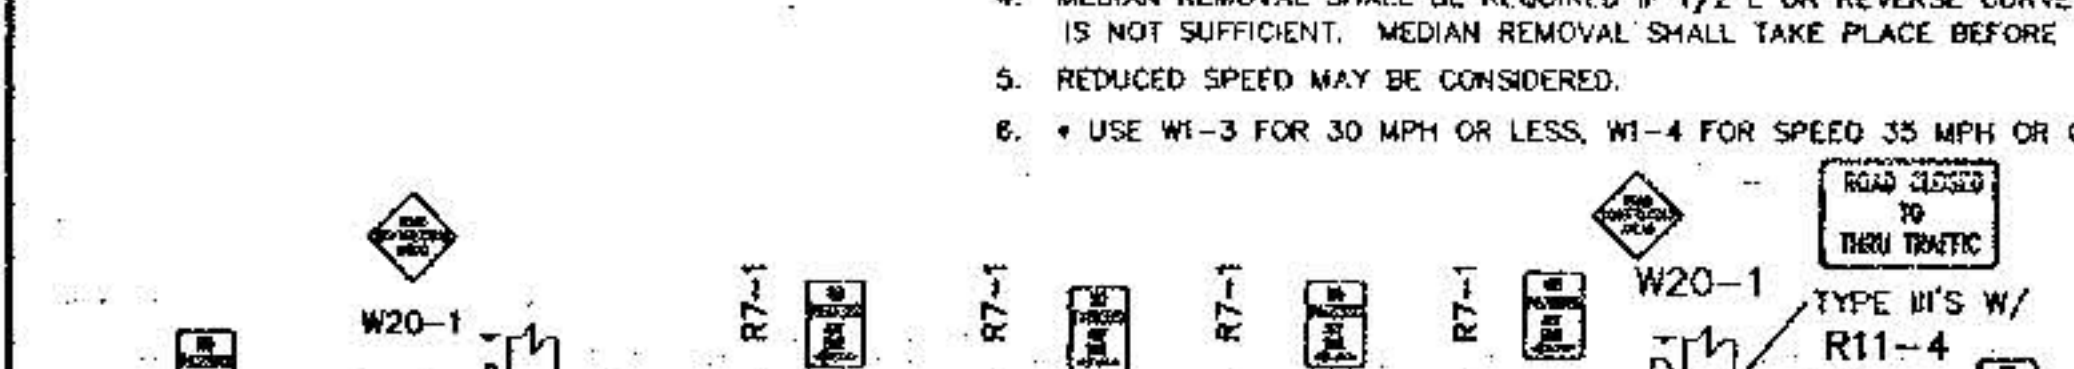


TYPICAL STREET CLOSURE

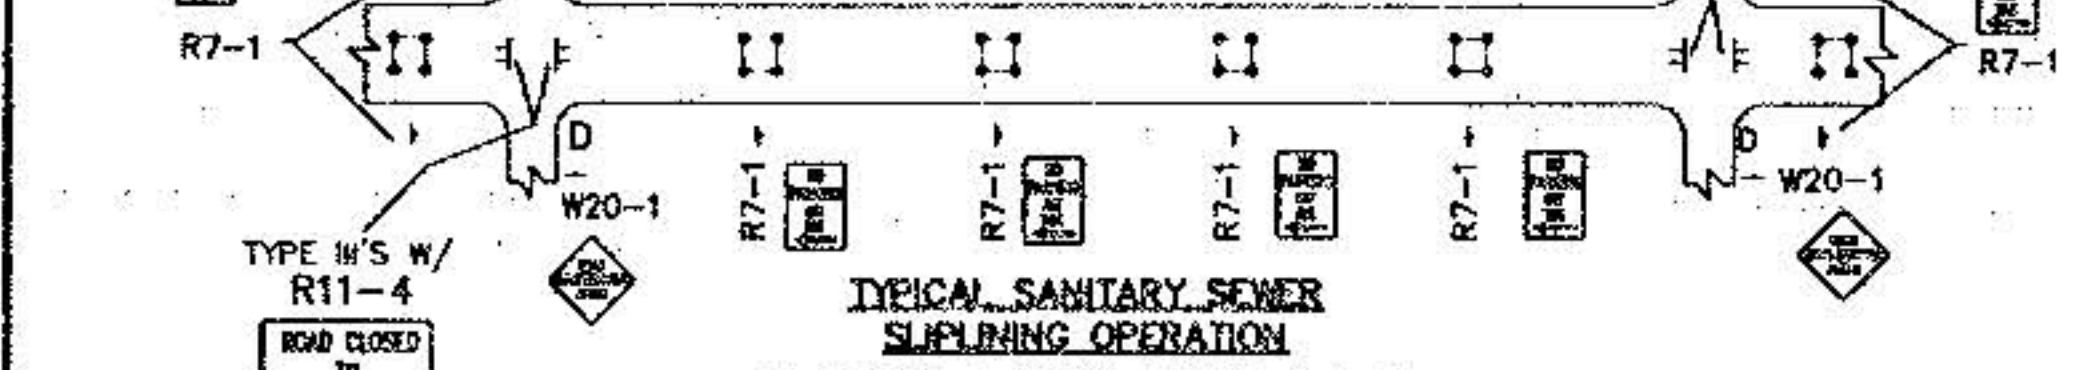


TYPICAL STREET CLOSURE

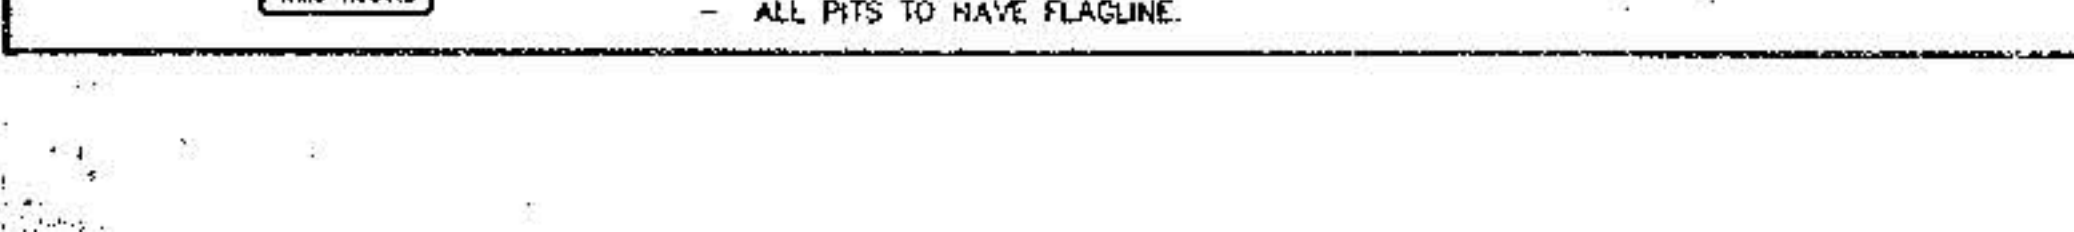


TYPICAL STREET CLOSURE

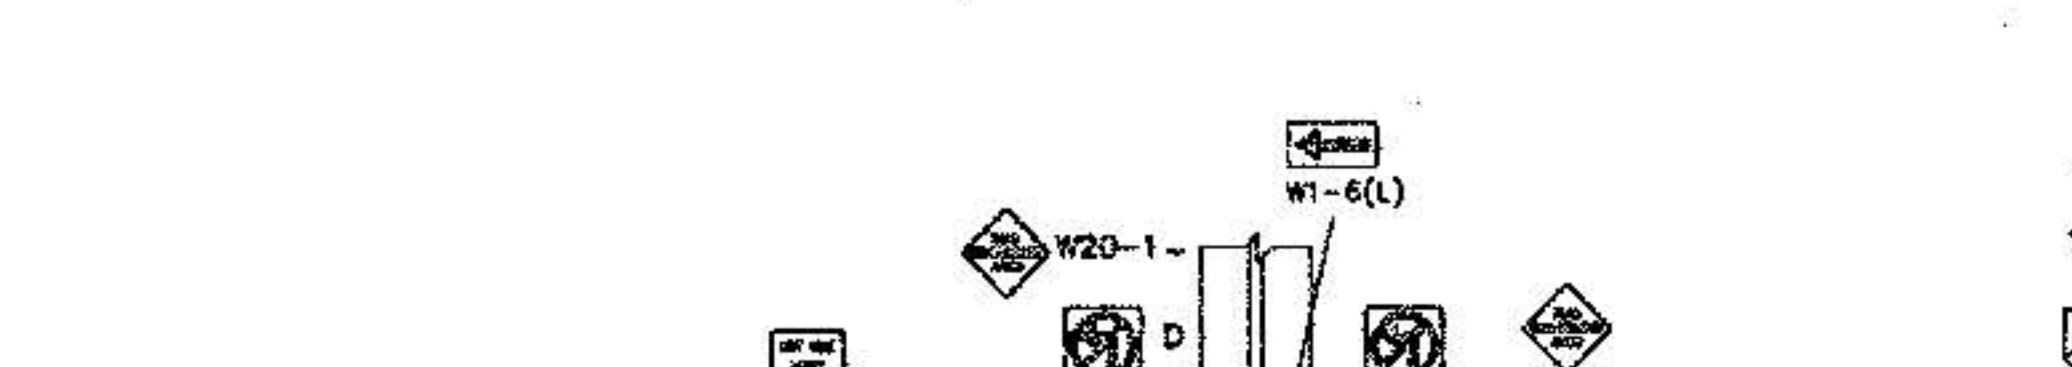


TYPICAL LANE CLOSURE AT INTERSECTION

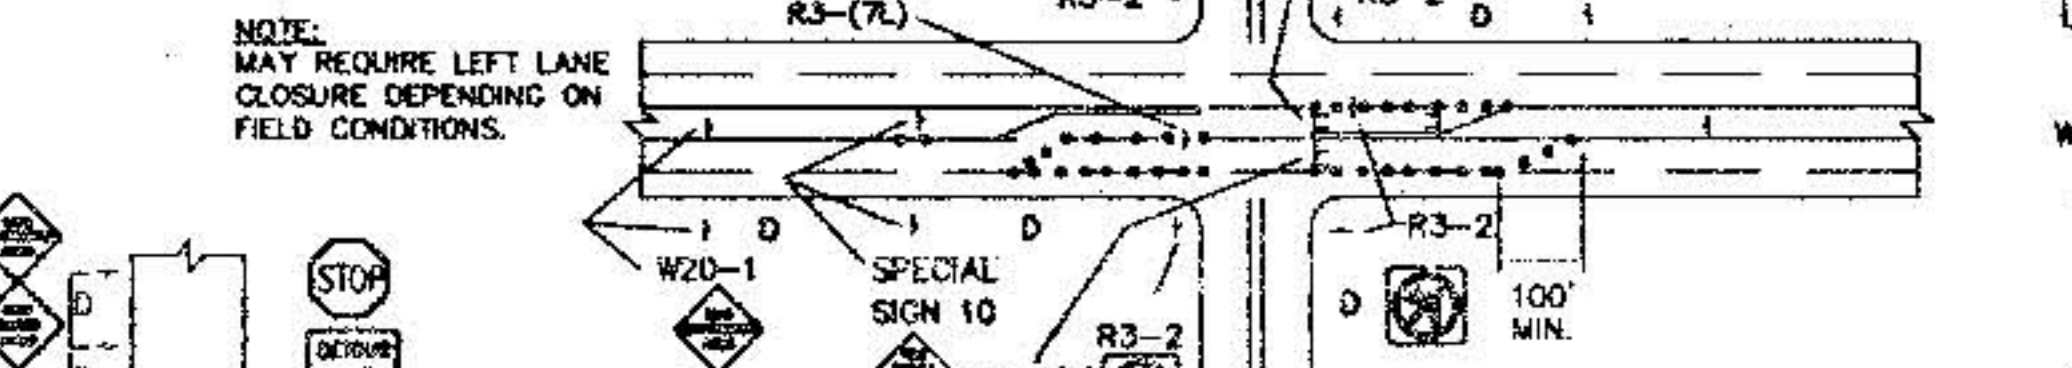


TYPICAL LANE CLOSURE AT INTERSECTION

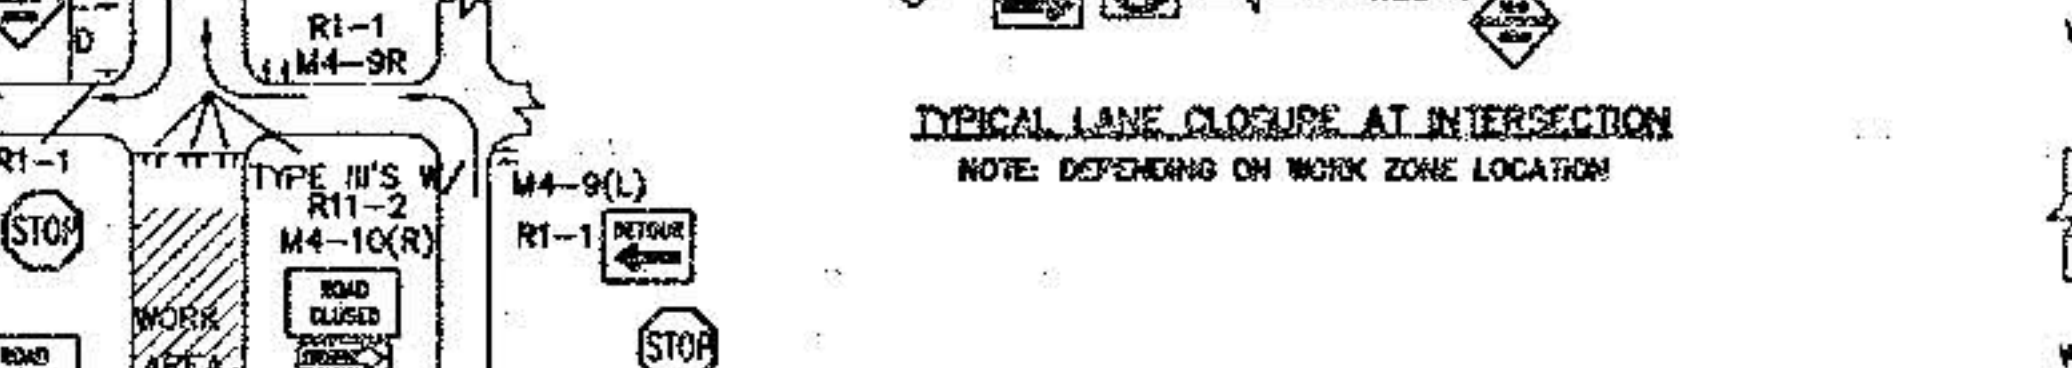


TYPICAL LANE CLOSURE AT INTERSECTION

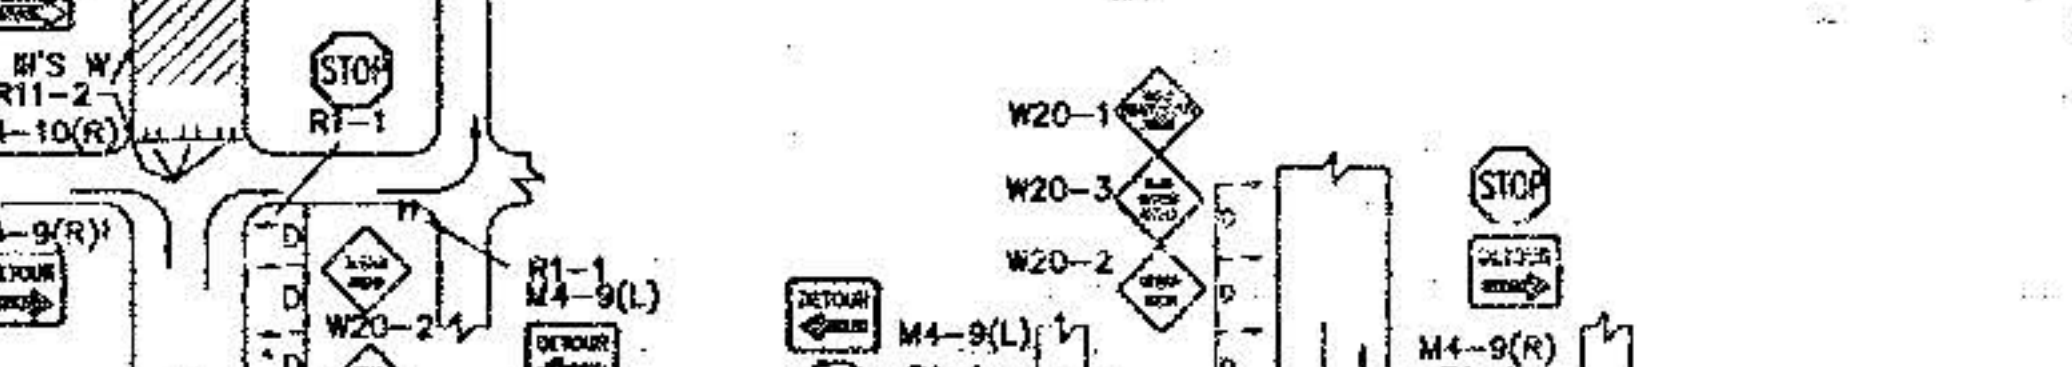


TYPICAL LANE CLOSURE AT INTERSECTION

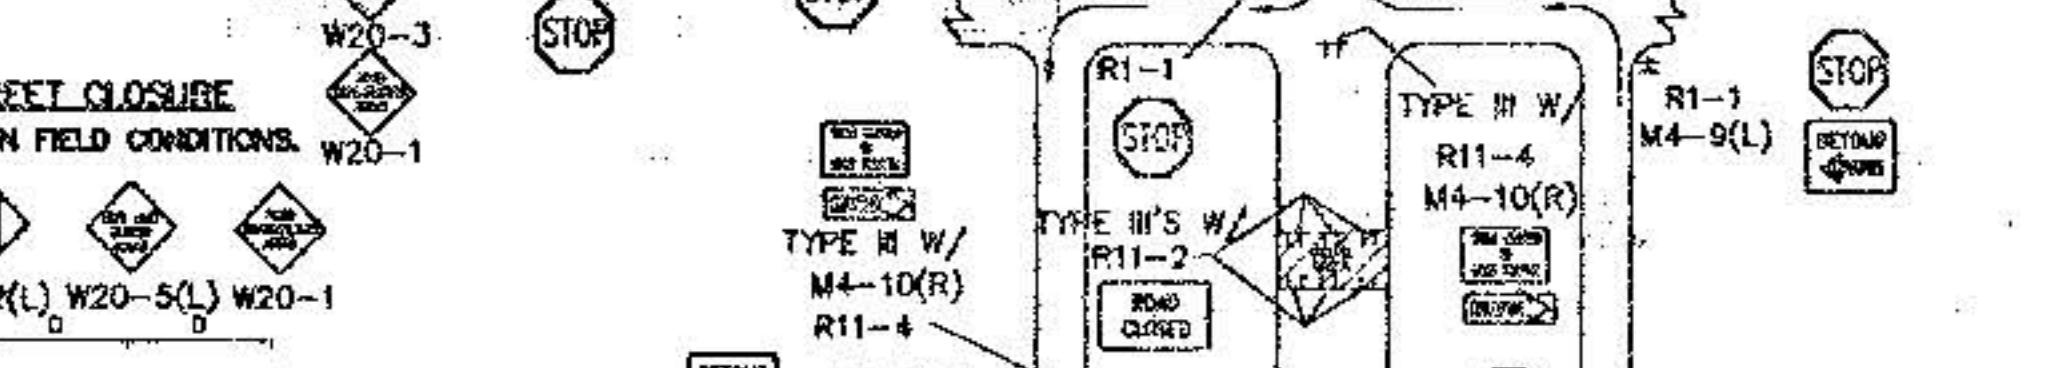


TYPICAL LANE CLOSURE AT INTERSECTION

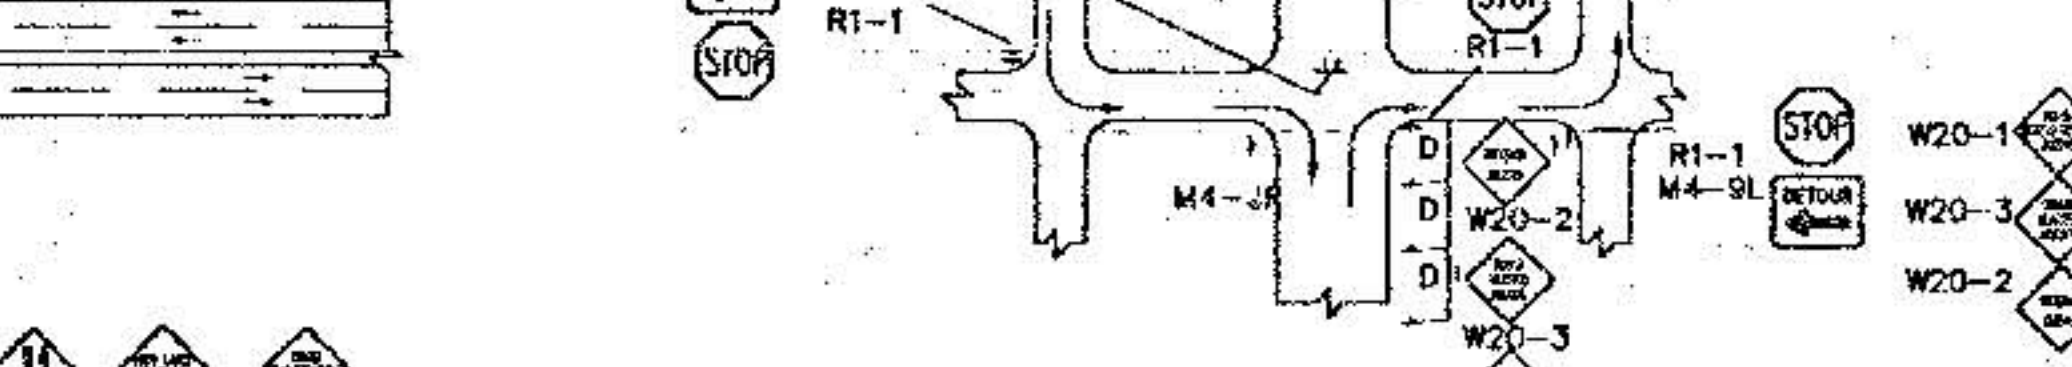


TYPICAL LANE CLOSURE AT INTERSECTION

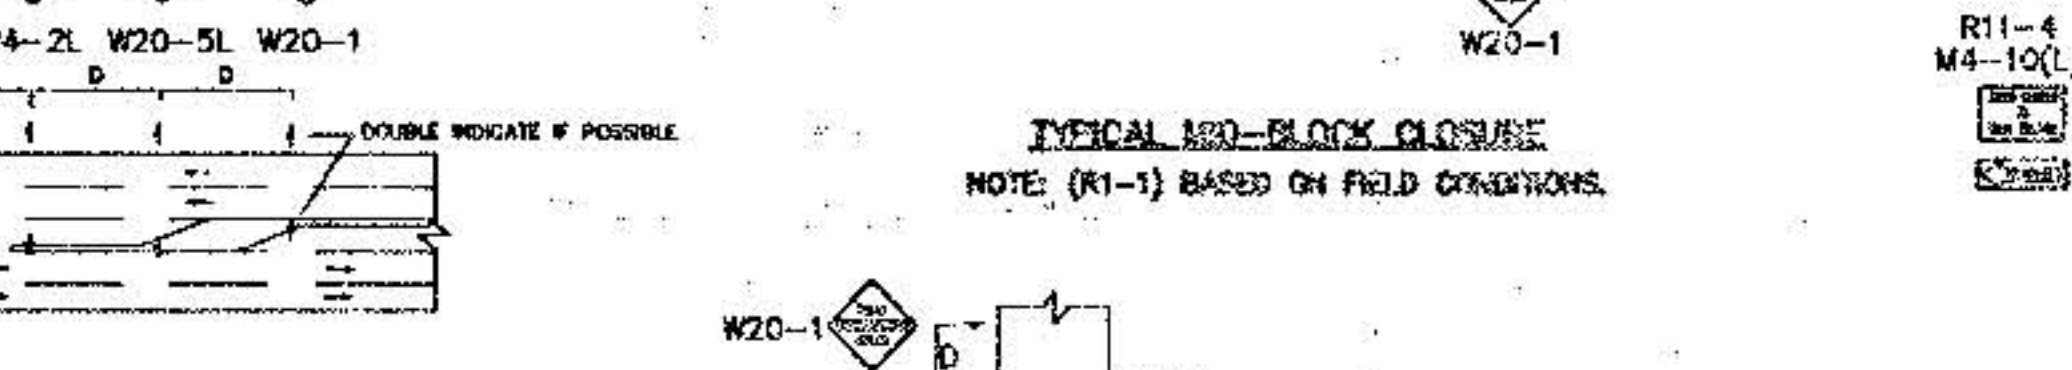


TYPICAL LANE CLOSURE AT INTERSECTION

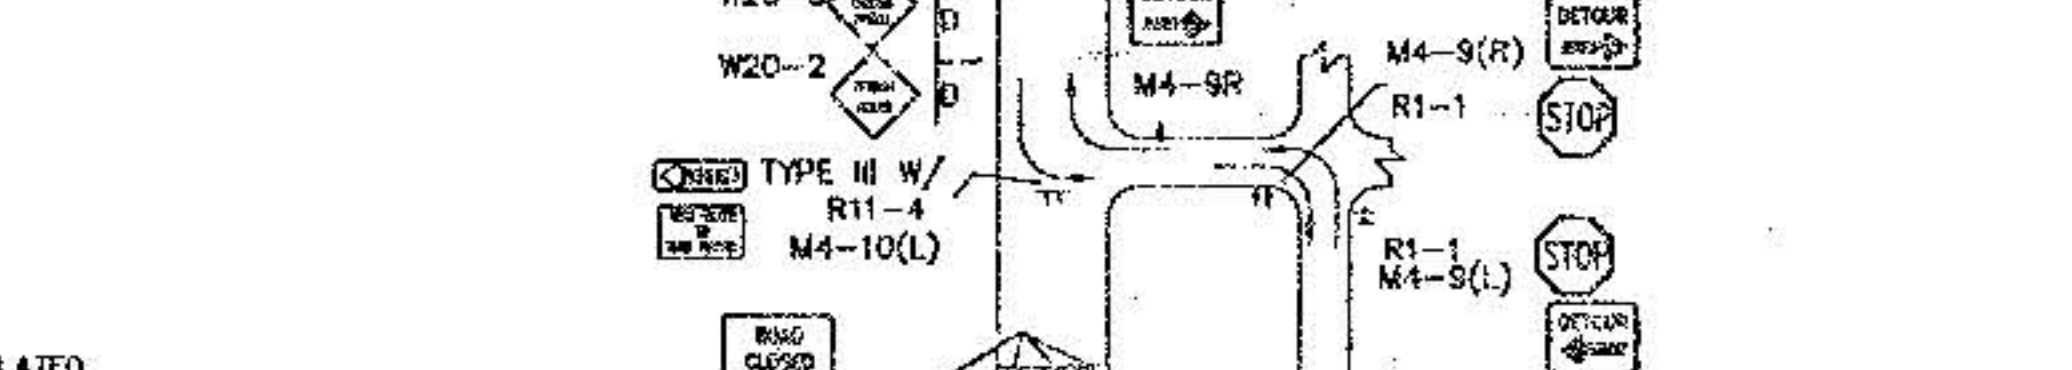

TYPICAL LANE CLOSURE AT INTERSECTION

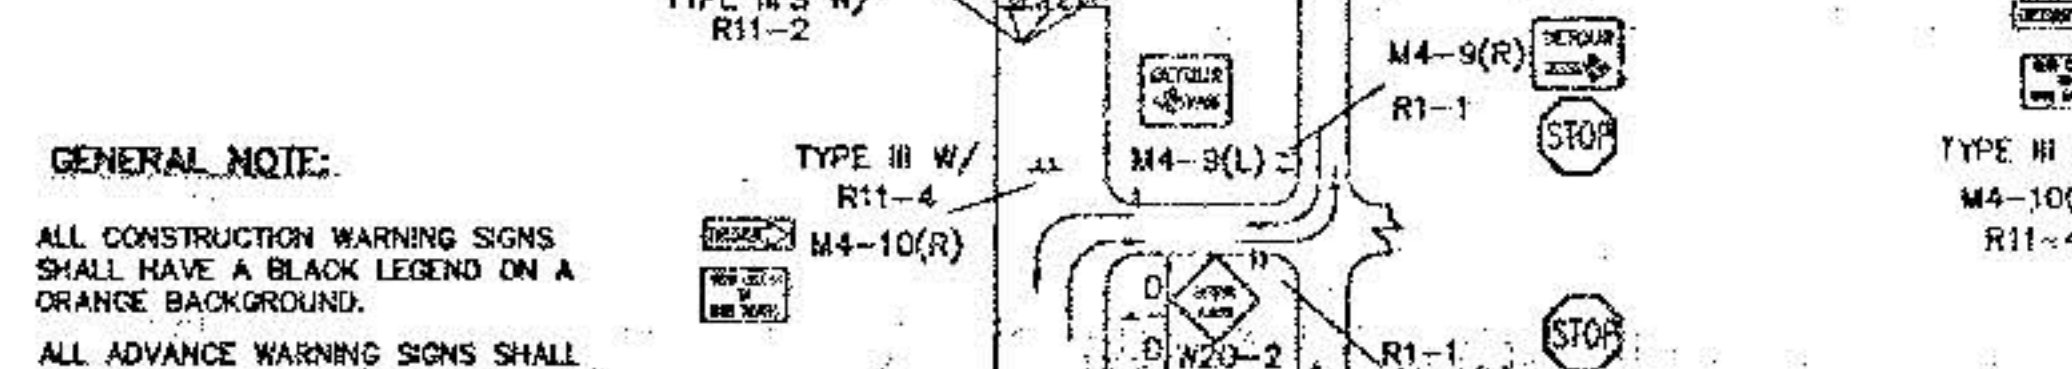


TYPICAL LANE CLOSURE AT INTERSECTION

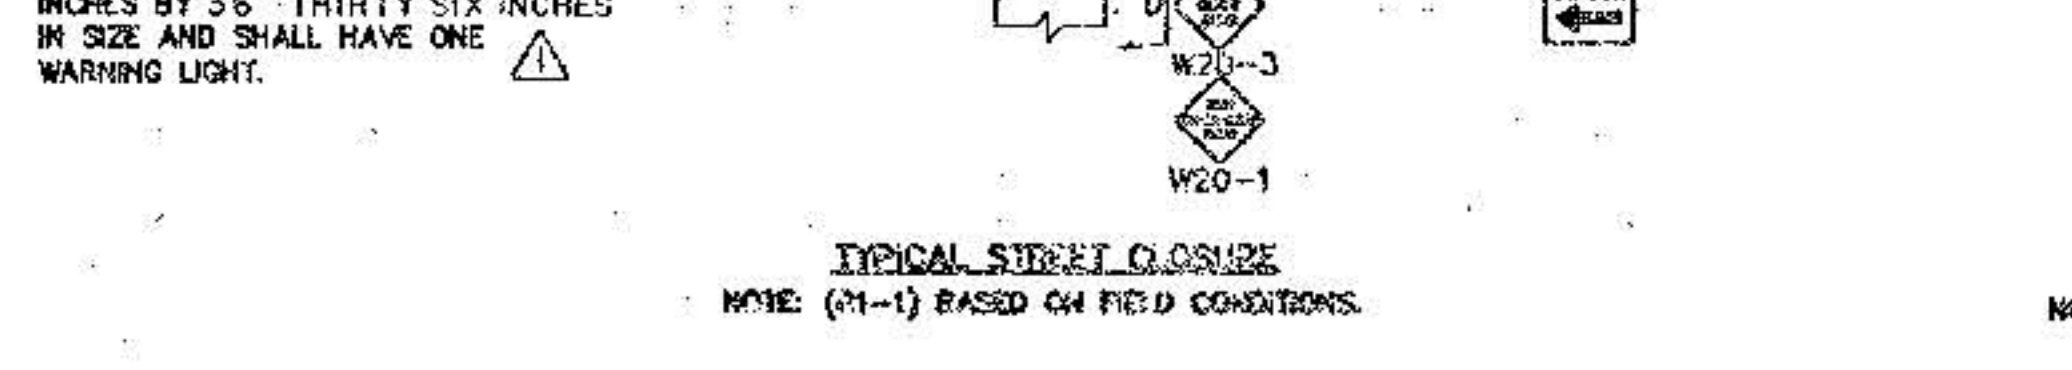


TYPICAL LANE CLOSURE AT INTERSECTION




TYPICAL LANE CLOSURE AT INTERSECTION

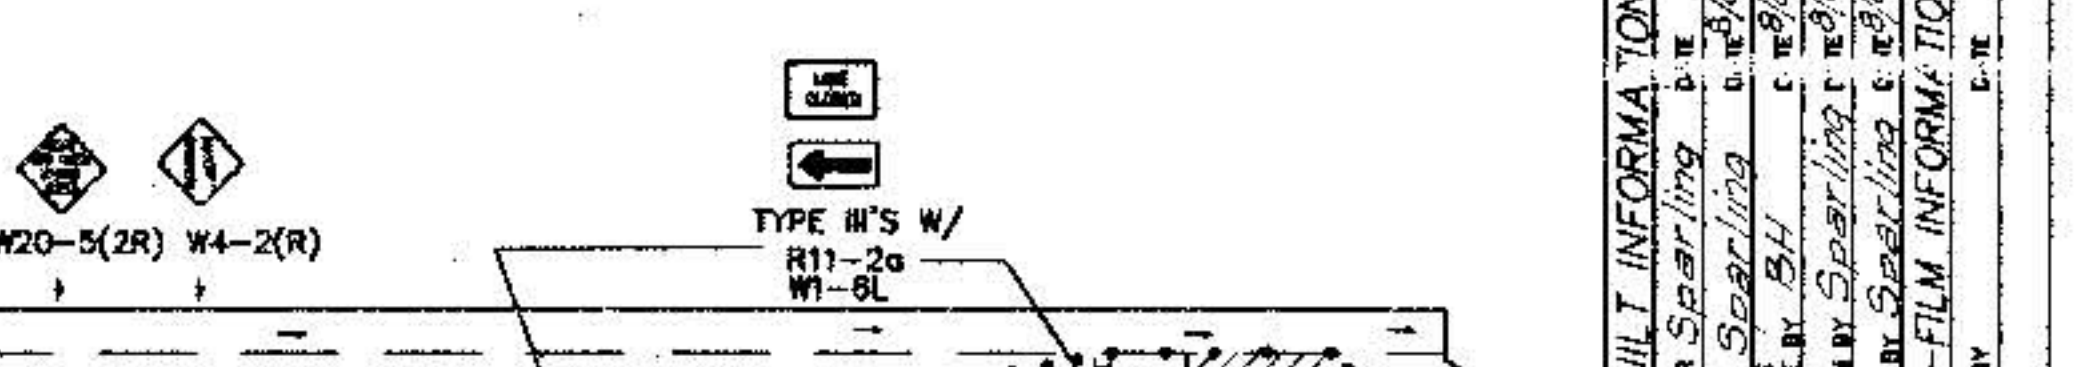

TYPICAL DOUBLE RIGHT LANE CLOSURE

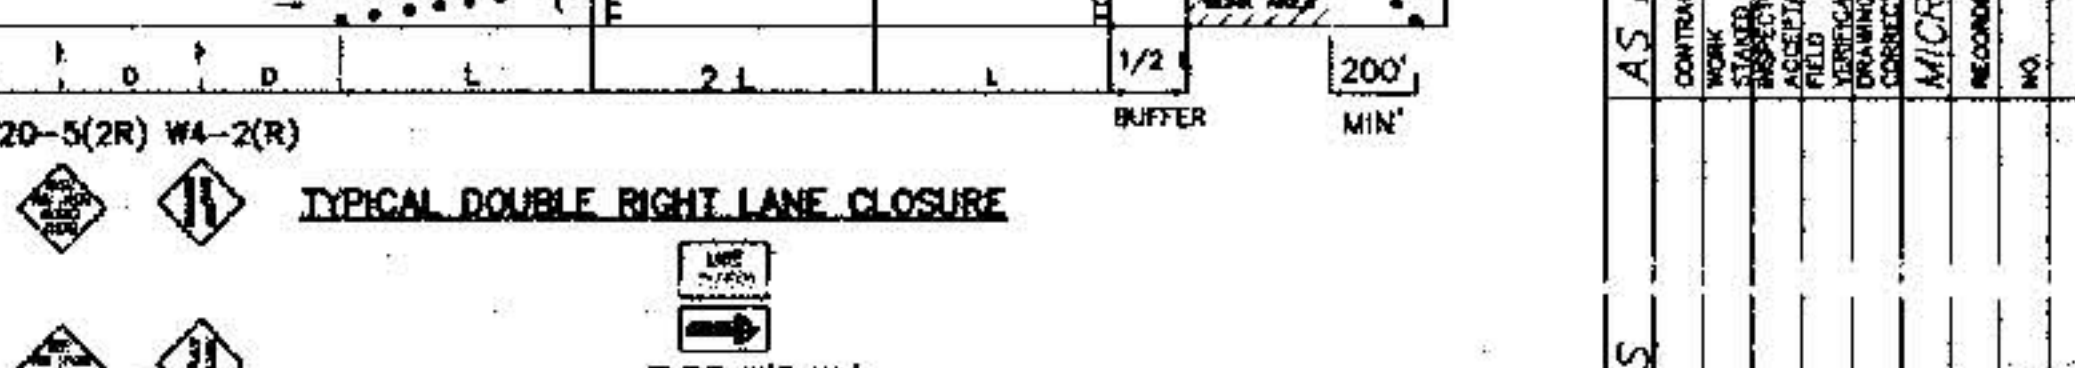


TYPICAL DOUBLE RIGHT LANE CLOSURE

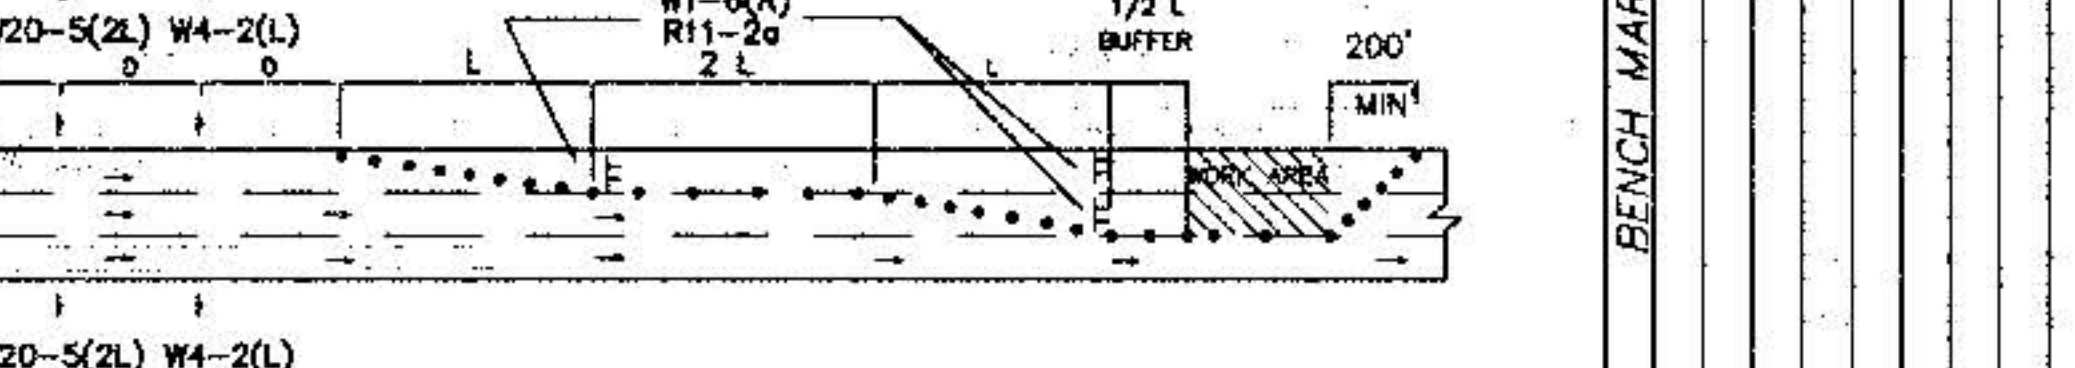


TYPICAL DOUBLE RIGHT LANE CLOSURE




TYPICAL DOUBLE RIGHT LANE CLOSURE

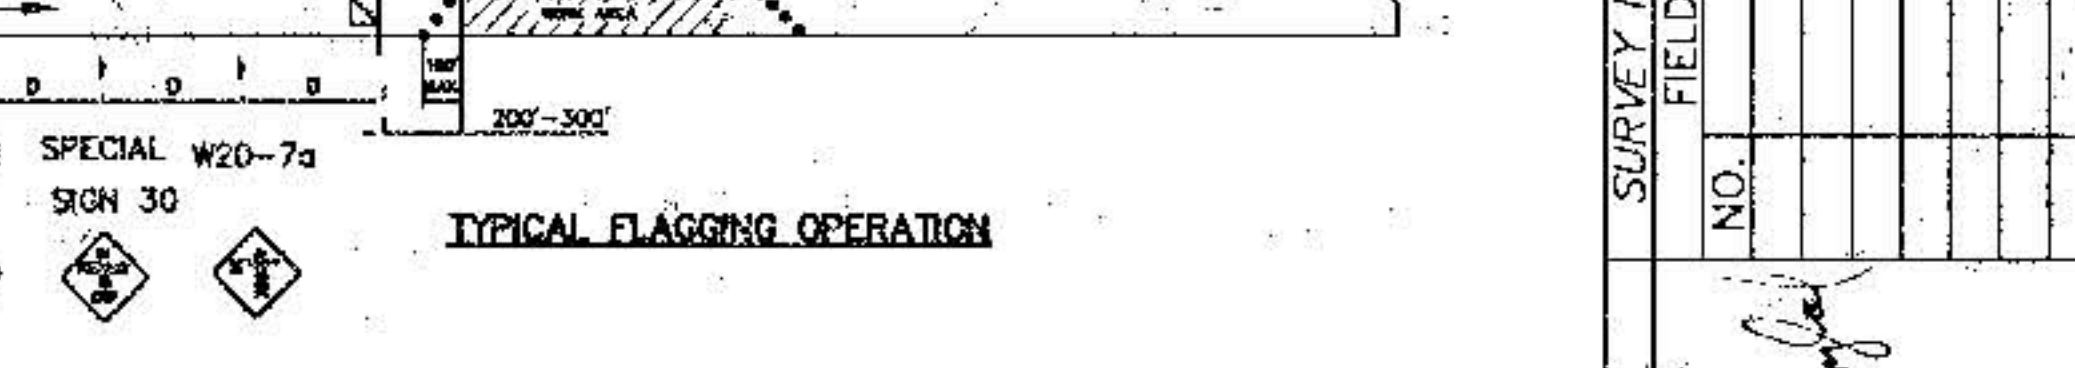


TYPICAL DOUBLE RIGHT LANE CLOSURE

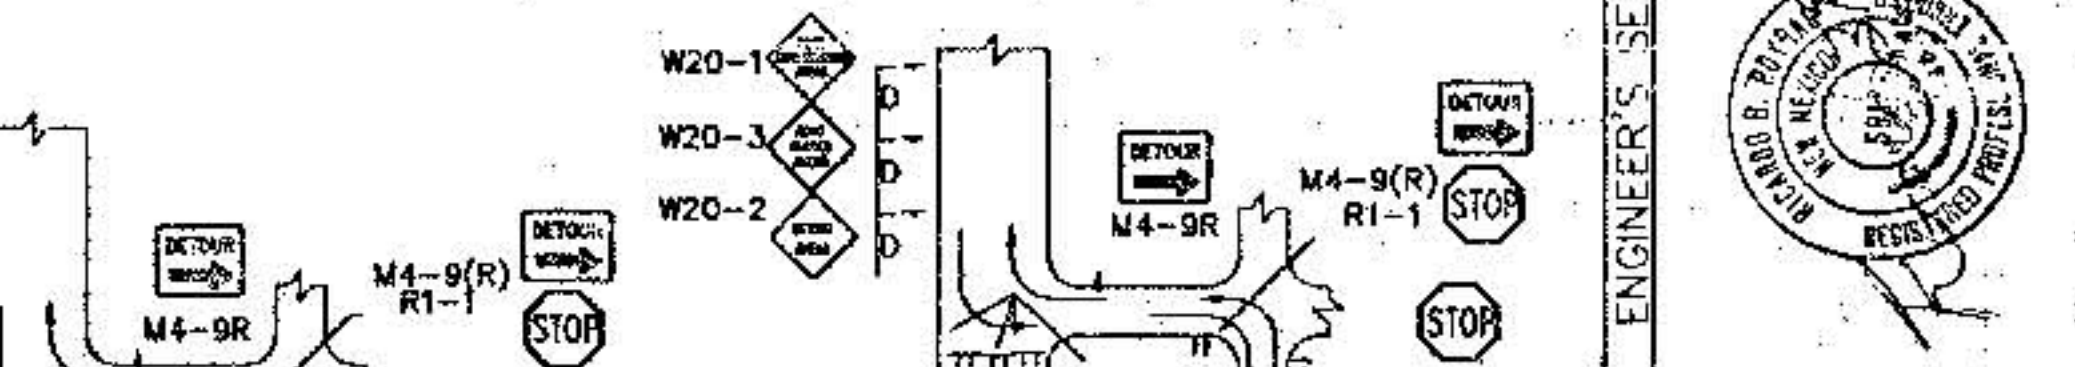


TYPICAL DOUBLE RIGHT LANE CLOSURE

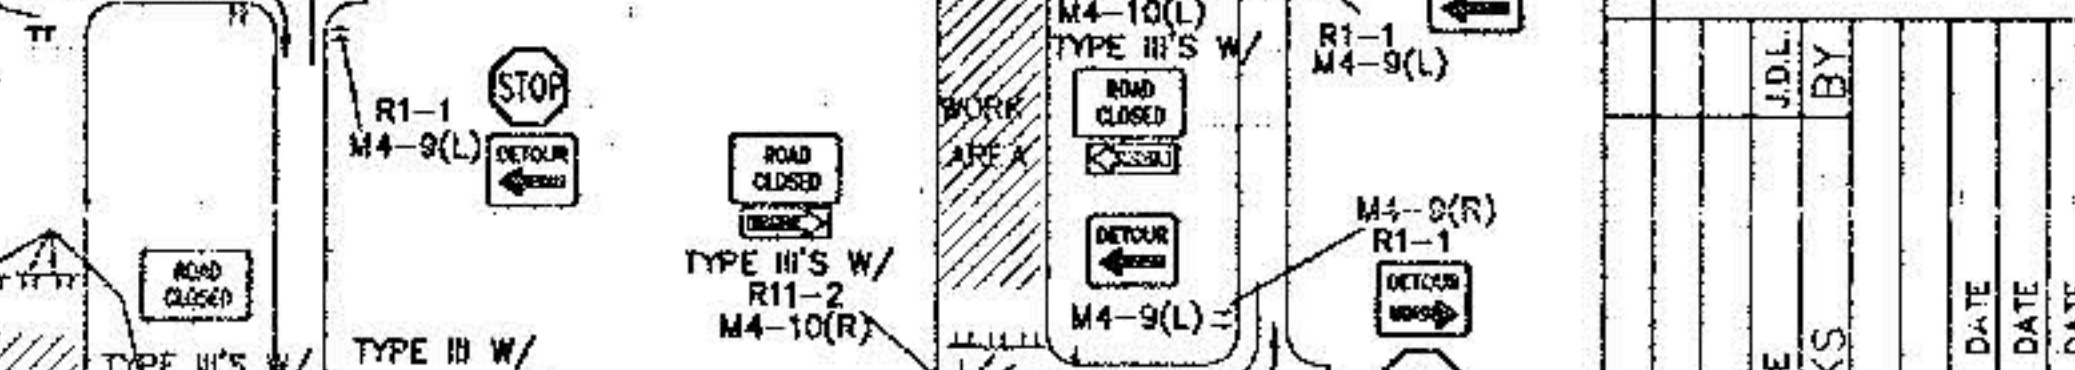


TYPICAL DOUBLE RIGHT LANE CLOSURE

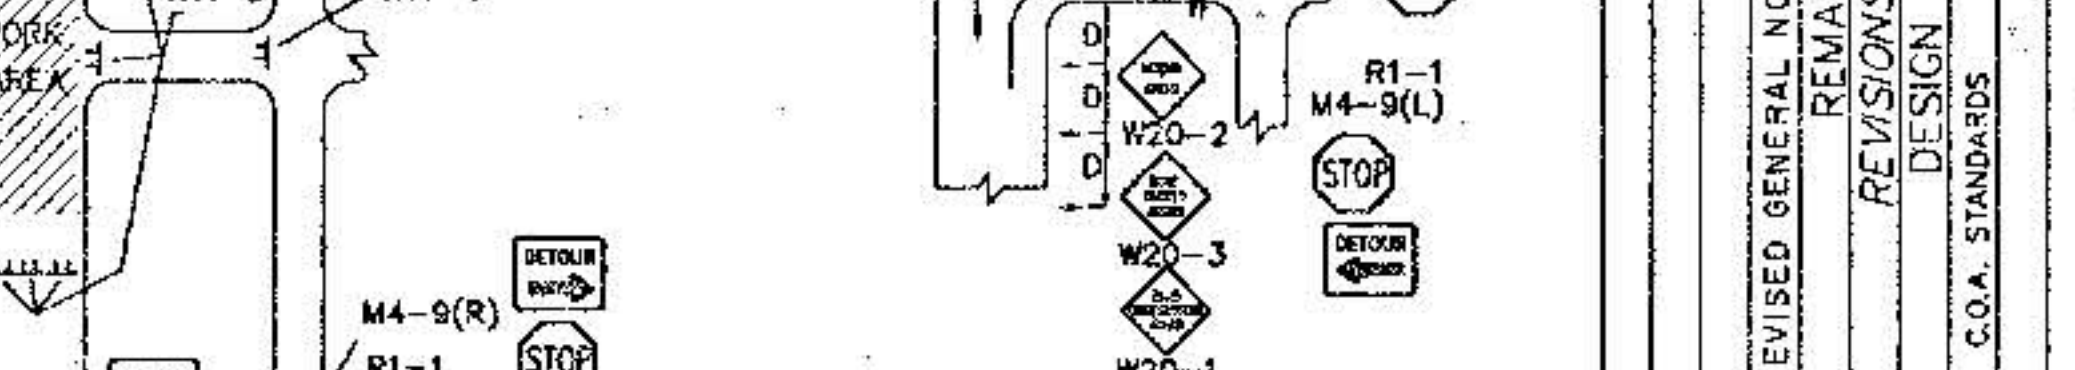


TYPICAL DOUBLE RIGHT LANE CLOSURE

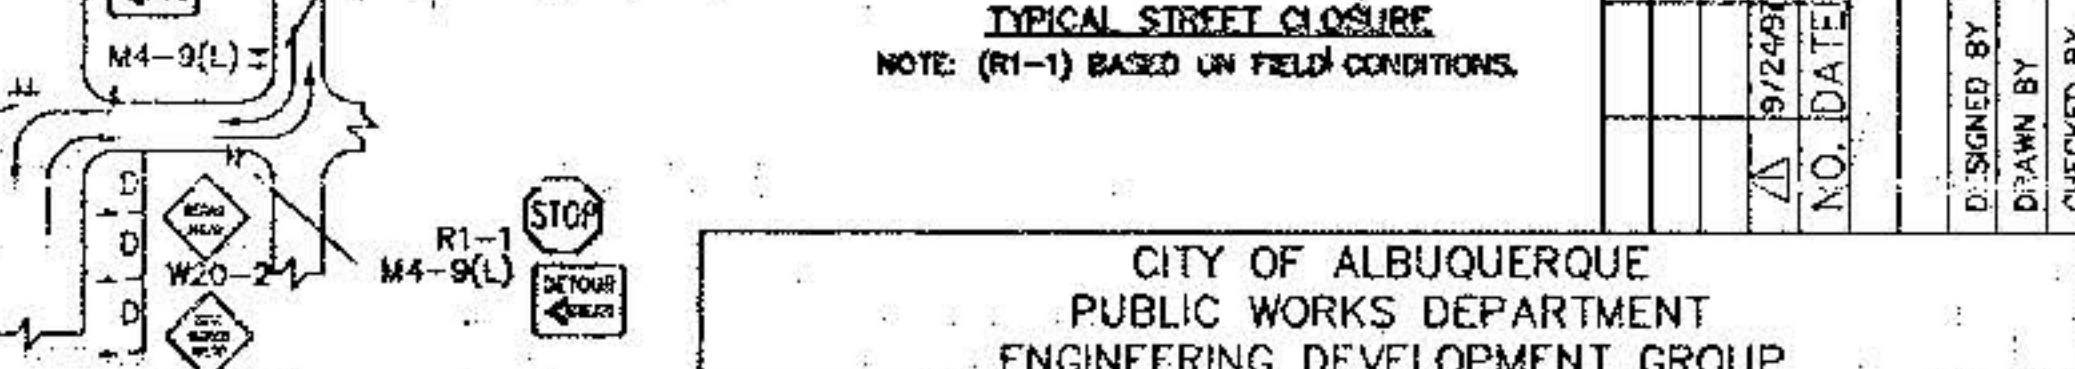

TYPICAL DOUBLE RIGHT LANE CLOSURE

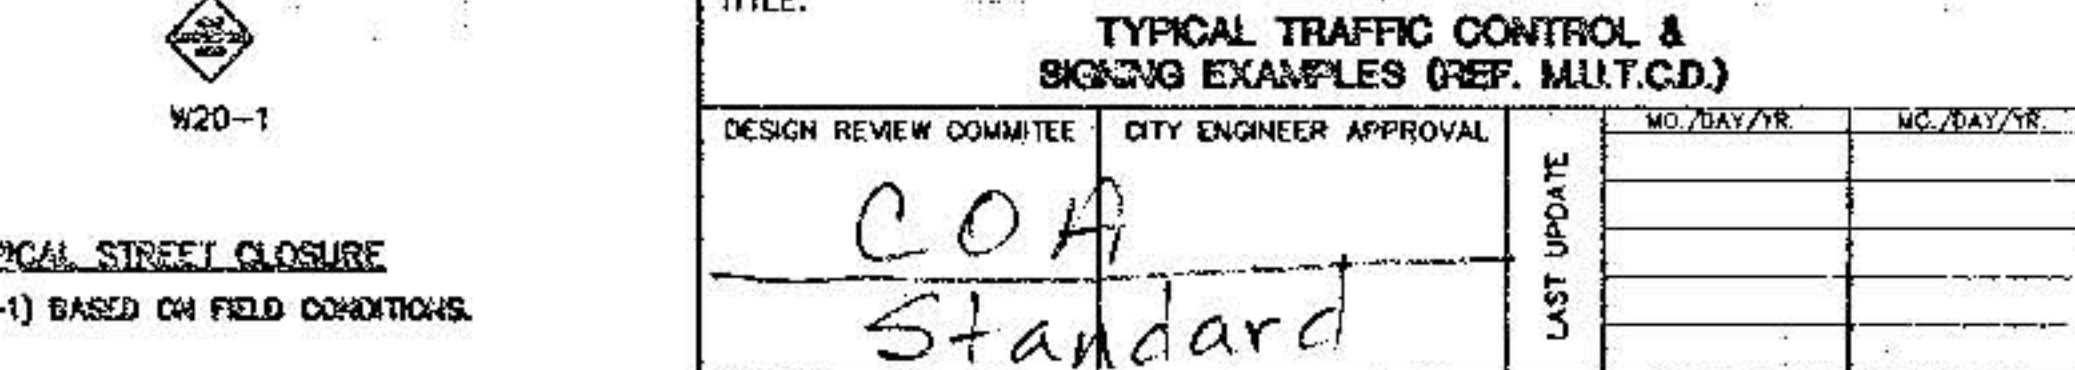

TYPICAL DOUBLE RIGHT LANE CLOSURE

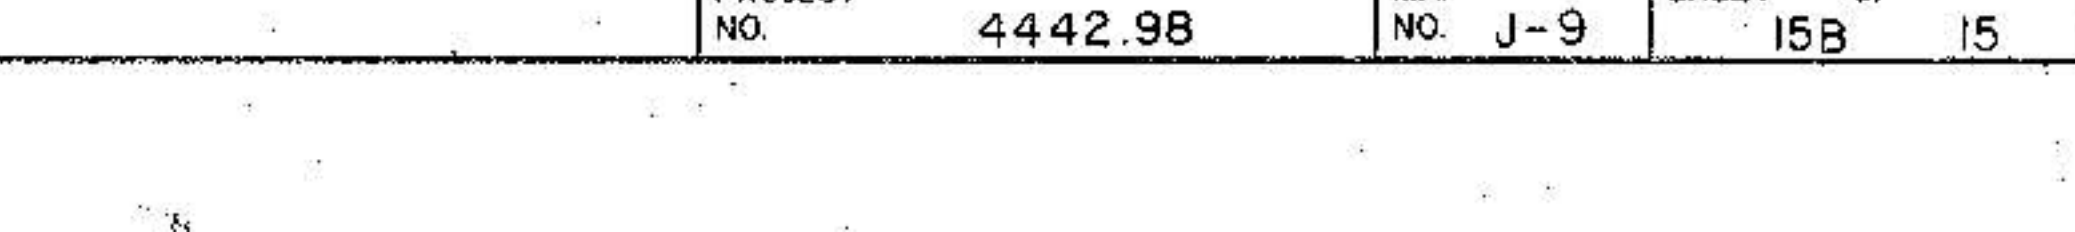

TYPICAL DOUBLE RIGHT LANE CLOSURE

NOTE: MAY REQUIRE LEFT LANE CLOSURE DEPENDING ON FIELD CONDITIONS.

NOTE: MAY REQUIRE LEFT LANE CLOSURE DEPENDING ON FIELD CONDITIONS.

NOTE: DEPENDING ON WORK ZONE LOCATION

NOTE: (R1-1) BASED ON FIELD CONDITIONS.

NOTE: (R1-1) BASED ON FIELD CONDITIONS.

- TRAFFIC SPLIT NOTES:
1. THE OFFSET DISTANCE MUST BE CALCULATED IN ALL SHIFTING TAPERS. THE OFFSET DISTANCES SHALL INCLUDE LANE WIDTHS PLUS MEDIAN WIDTHS.
 2. 1/2 L IS MINIMUM DISTANCE FOR SHIFTING TAPERS.
 3. REVERSE CURVES MAY BE IMPLEMENTED. ALL CURVE DATA SHALL BE CALCULATED.
 4. MEDIAN REMOVAL SHALL BE REQUIRED IF 1/2 L OR REVERSE CURVE IS NOT SUFFICIENT. MEDIAN REMOVAL SHALL TAKE PLACE BEFORE SPLITS.
 5. REDUCED SPEED MAY BE CONSIDERED.
 6. * USE W1-3 FOR 30 MPH OR LESS, W1-4 FOR SPEED 35 MPH OR GREATER.

GENERAL NOTE:

ALL CONSTRUCTION WARNING SIGNS SHALL HAVE A BLACK LEGEND ON A ORANGE BACKGROUND.

ALL ADVANCE WARNING SIGNS SHALL BE A MINIMUM OF 36" THIRTY SIX INCHES BY 36" THIRTY SIX INCHES IN SIZE AND SHALL HAVE ONE WARNING LIGHT.

CITY OF ALBUQUERQUE
PUBLIC WORKS DEPARTMENT
ENGINEERING DEVELOPMENT GROUP

TITLE: TYPICAL TRAFFIC CONTROL & SIGNING EXAMPLES (REF. M.U.T.C.D.)

DESIGN REVIEW COMMITTEE: CITY ENGINEER APPROVAL

PROJECT NO. 4442.98

MAP NO. J-9

SHEET 15B OF 15

AS BUILT INFORMATION

CONTRACTOR: Spaulding

DATE: 10/1/98

REVISIONS

NO. DATE

REMARKS

DESIGN

DATE

C.O.A. STANDARDS

CHECKED BY

DATE