

CONSTRUCTION DOCUMENTS

MADISON MIDDLE SCHOOL:
NEW PARK DEVELOPMENT

CITY PROJECT NO. 4451.92

INDEX OF DRAWINGS
TITLE

SHEET NO.

COVER SHEET

C-1 OF 7

LAYOUT / DIMENSION PLAN

2 OF 7

GRADING PLAN

3 OF 7

DRAINAGE PLAN

4 OF 7

PLANTING PLAN

5 OF 7

IRRIGATION PLAN

6 OF 7

SITE / LANDSCAPE DETAILS


7 OF 7

THE FOLLOWING ALSO APPLY WHEN CHECKED

- ☒ All utilities and utility service lines shall be installed prior to paving.
- ☒ Backfill compaction shall be according to specified street use.
- ☒ Tack coat requirements shall be determined by the city engineer.
- ☐ Sidewalks and wheelchair ramps within the curb returns shall be constructed wherever a new curb return is constructed.
- ☐ If curb is depressed for a driveway or ramp, it shall be constructed prior to acceptance of the curb and gutter.
- ☒ All storm drainage facilities shall be completed prior to final acceptance.

GENERAL NOTES

- ALL WORK TO BE IN ACCORDANCE WITH THE CITY OF ALBUQUERQUE STANDARD SPECIFICATIONS, 1986 EDITION (AS UPDATED WITH REVISION #6), OR PER ATTACHED SPECIFICATIONS.
- CONTRACTOR SHALL COORDINATE WITH THE WATER SYSTEM DIVISION FOR THE EXECUTION OF THE VALVE SHUT-OFF PLAN, NOT LESS THAN FIVE (5) WORKING DAYS IN ADVANCE OF ANY WORK THAT MAY AFFECT THE EXISTING PUBLIC WATER UTILITIES. ONLY WATER SYSTEM DIVISION PERSONNEL SHALL OPERATE EXISTING VALVES, REFER TO SECTION 18 OF THE SPECIFICATIONS.
- TWO (2) WORKING DAYS PRIOR TO ANY EXCAVATION, CONTRACTOR MUST CONTACT NEW MEXICO ONE CALL SYSTEM, 260-1990, FOR LOCATION OF EXISTING UTILITIES.
- UTILITY LINES AND COVERS ARE SHOWN ON THESE DRAWINGS IN AN APPROXIMATE MANNER ONLY. LINES MAY EXIST WHERE NONE ARE SHOWN. THE CONTRACTOR IS FULLY RESPONSIBLE FOR ANY AND ALL DAMAGE CAUSED BY FAILURE TO LOCATE, IDENTIFY AND PRESERVE ANY AND ALL EXISTING UTILITIES, PIPELINES AND UNDERGROUND UTILITY LINES. IN PLANNING AND CONDUCTING EXCAVATION, THE CONTRACTOR SHALL COMPLY WITH STATE STATUTES, MUNICIPAL AND LOCAL ORDINANCES, RULES AND REGULATIONS, IF ANY, PERTAINING TO THE LOCATION OF THESE LINES AND FACILITIES.
- SHOULD A CONFLICT EXIST BETWEEN THE PLANS AND THE ACTUAL FIELD CONDITIONS, THE CONTRACTOR SHALL PROMPTLY NOTIFY THE LANDSCAPE ARCHITECT IN WRITING SO THAT THE CONFLICT CAN BE RESOLVED WITH THE MINIMUM AMOUNT OF DELAY FOR ALL PARTIES.
- ALL EXISTING IMPROVEMENTS ARE TO REMAIN UNLESS SPECIFICALLY NOTED TO BE REMOVED. CONTRACTOR SHALL REPAIR ANY CONTRACTOR CAUSED DAMAGE TO THE SATISFACTION OF THE OWNER AT THE CONTRACTOR'S EXPENSE. ALL REPAIRS WITHIN THE CITY RIGHT-OF-WAY SHALL BE IN ACCORDANCE WITH CITY OF ALBUQUERQUE STANDARDS.

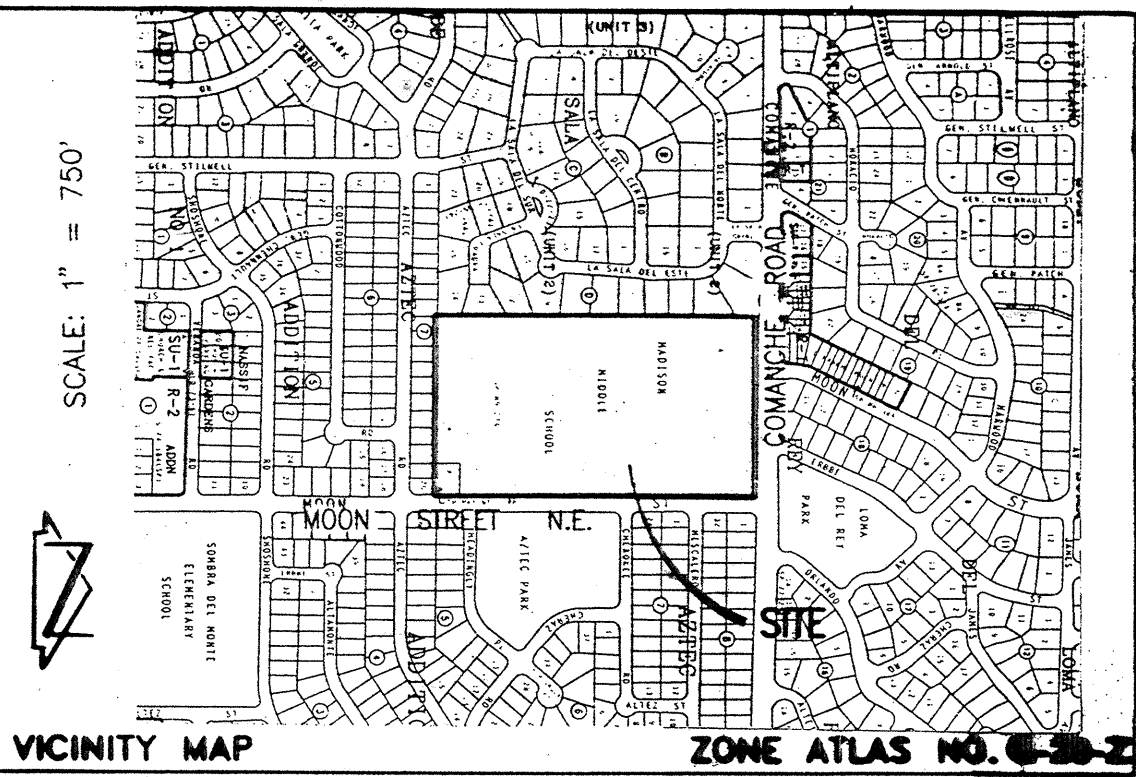


- PRIOR TO CONSTRUCTION, THE CONTRACTOR SHALL CHECK ALL DIMENSIONS, BOTH HORIZONTAL AND VERTICAL, AND SHALL EXCAVATE AND VERIFY THE HORIZONTAL AND VERTICAL DIMENSIONS OF ALL OBSTRUCTIONS.
- THE CONTRACTOR SHALL MAINTAIN ACCESS TO ADJACENT PROPERTIES DURING CONSTRUCTION.
- ALL STORM DRAINAGE FACILITIES SHALL BE COMPLETED PRIOR TO FINAL ACCEPTANCE.
- CONTRACTOR SHALL NOTIFY CITY SURVEYING NOT LESS THAN SEVEN (7) DAYS PRIOR TO STARTING WORK IN ORDER THAT CITY SURVEYING MAY TAKE NECESSARY MEASURES TO INSURE THE PRESERVATION OF SURVEY MONUMENTS. CONTRACTOR SHALL NOT DISTURB PERMANENT SURVEY MONUMENTS WITHOUT THE CONSENT OF CITY SURVEYING AND SHALL NOTIFY CITY SURVEYING AND BEAR THE EXPENSE OF REPLACING ANY THAT MAY BE DISTURBED WITHOUT PERMISSION. REPLACEMENT SHALL BE DONE ONLY BY CITY SURVEYING. WHEN A CHANGE IS MADE IN THE FINISHED ELEVATION OF THE PAVEMENT OF ANY ROADWAY IN WHICH A PERMANENT SURVEY MONUMENT IS LOCATED, CONTRACTOR SHALL AT HIS OWN EXPENSE, ADJUST THE MONUMENT COVER TO THE NEW GRADE UNLESS OTHERWISE SPECIFIED. REFER TO SECTION 4.4 OF THE STANDARD SPECIFICATIONS.
- ANY WORK AFFECTING AN ARTERIAL ROADWAY REQUIRES TWENTY-FOUR HOUR CONSTRUCTION.
- THREE (3) WORKING DAYS PRIOR TO BEGINNING CONSTRUCTION THE CONTRACTOR SHALL SUBMIT TO THE CONSTRUCTION CO-ORDINATION DIVISION A DETAILED CONSTRUCTION SCHEDULE. TWO (2) WORKING DAYS PRIOR TO CONSTRUCTION THE CONTRACTOR SHALL OBTAIN A BARRICADING PERMIT FROM THE CONSTRUCTION CO-ORDINATION DIVISION. CONTRACTOR SHALL NOTIFY BARRICADE ENGINEER (768-2551) PRIOR TO OCCUPYING AN INTERSECTION.


RECORD DRAWINGS


Revisions Drawn by N/A Date 3/13/97


G. Robert Johns, ASLA
Landscape Architect
3218 Silver Ave. SE
Albuquerque, N.M. 87106
Ph: (505) 266-8027

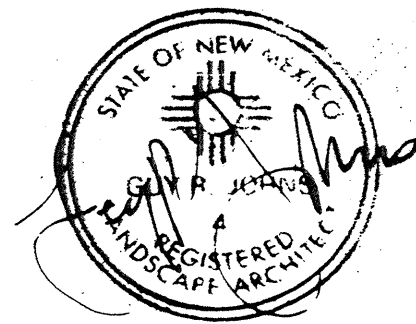

January 1, 1996

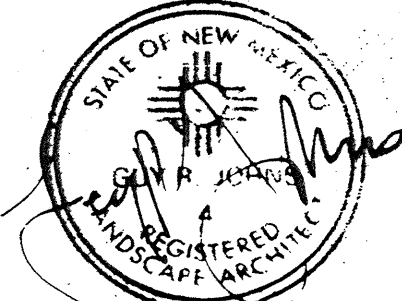REV.	SHEETS	CITY ENGINEER	DATE	USER	DEPARTMENT	DATE	USER	DEPARTMENT	DATE
ENGINEERS STAMP & SIGNATURE		APPROVALS	ENGINEER	DATE	APPROVED FOR CONSTRUCTION City Engineer Date				
		DRC Chairman	B. G. Hopkins	2-5-96					
		Transportation	J. B.	1-29-96					
		Water/ Wastewater	R. W. Kane	1-23-96					
		Hydrology	C. Monty	2-1-96					
		Parks	D. McVane	1/17/96					
		Constr. Mngt.							
		City Project No.	4451.92	Sheet		Of			
January 1, 1996				C-1		7			

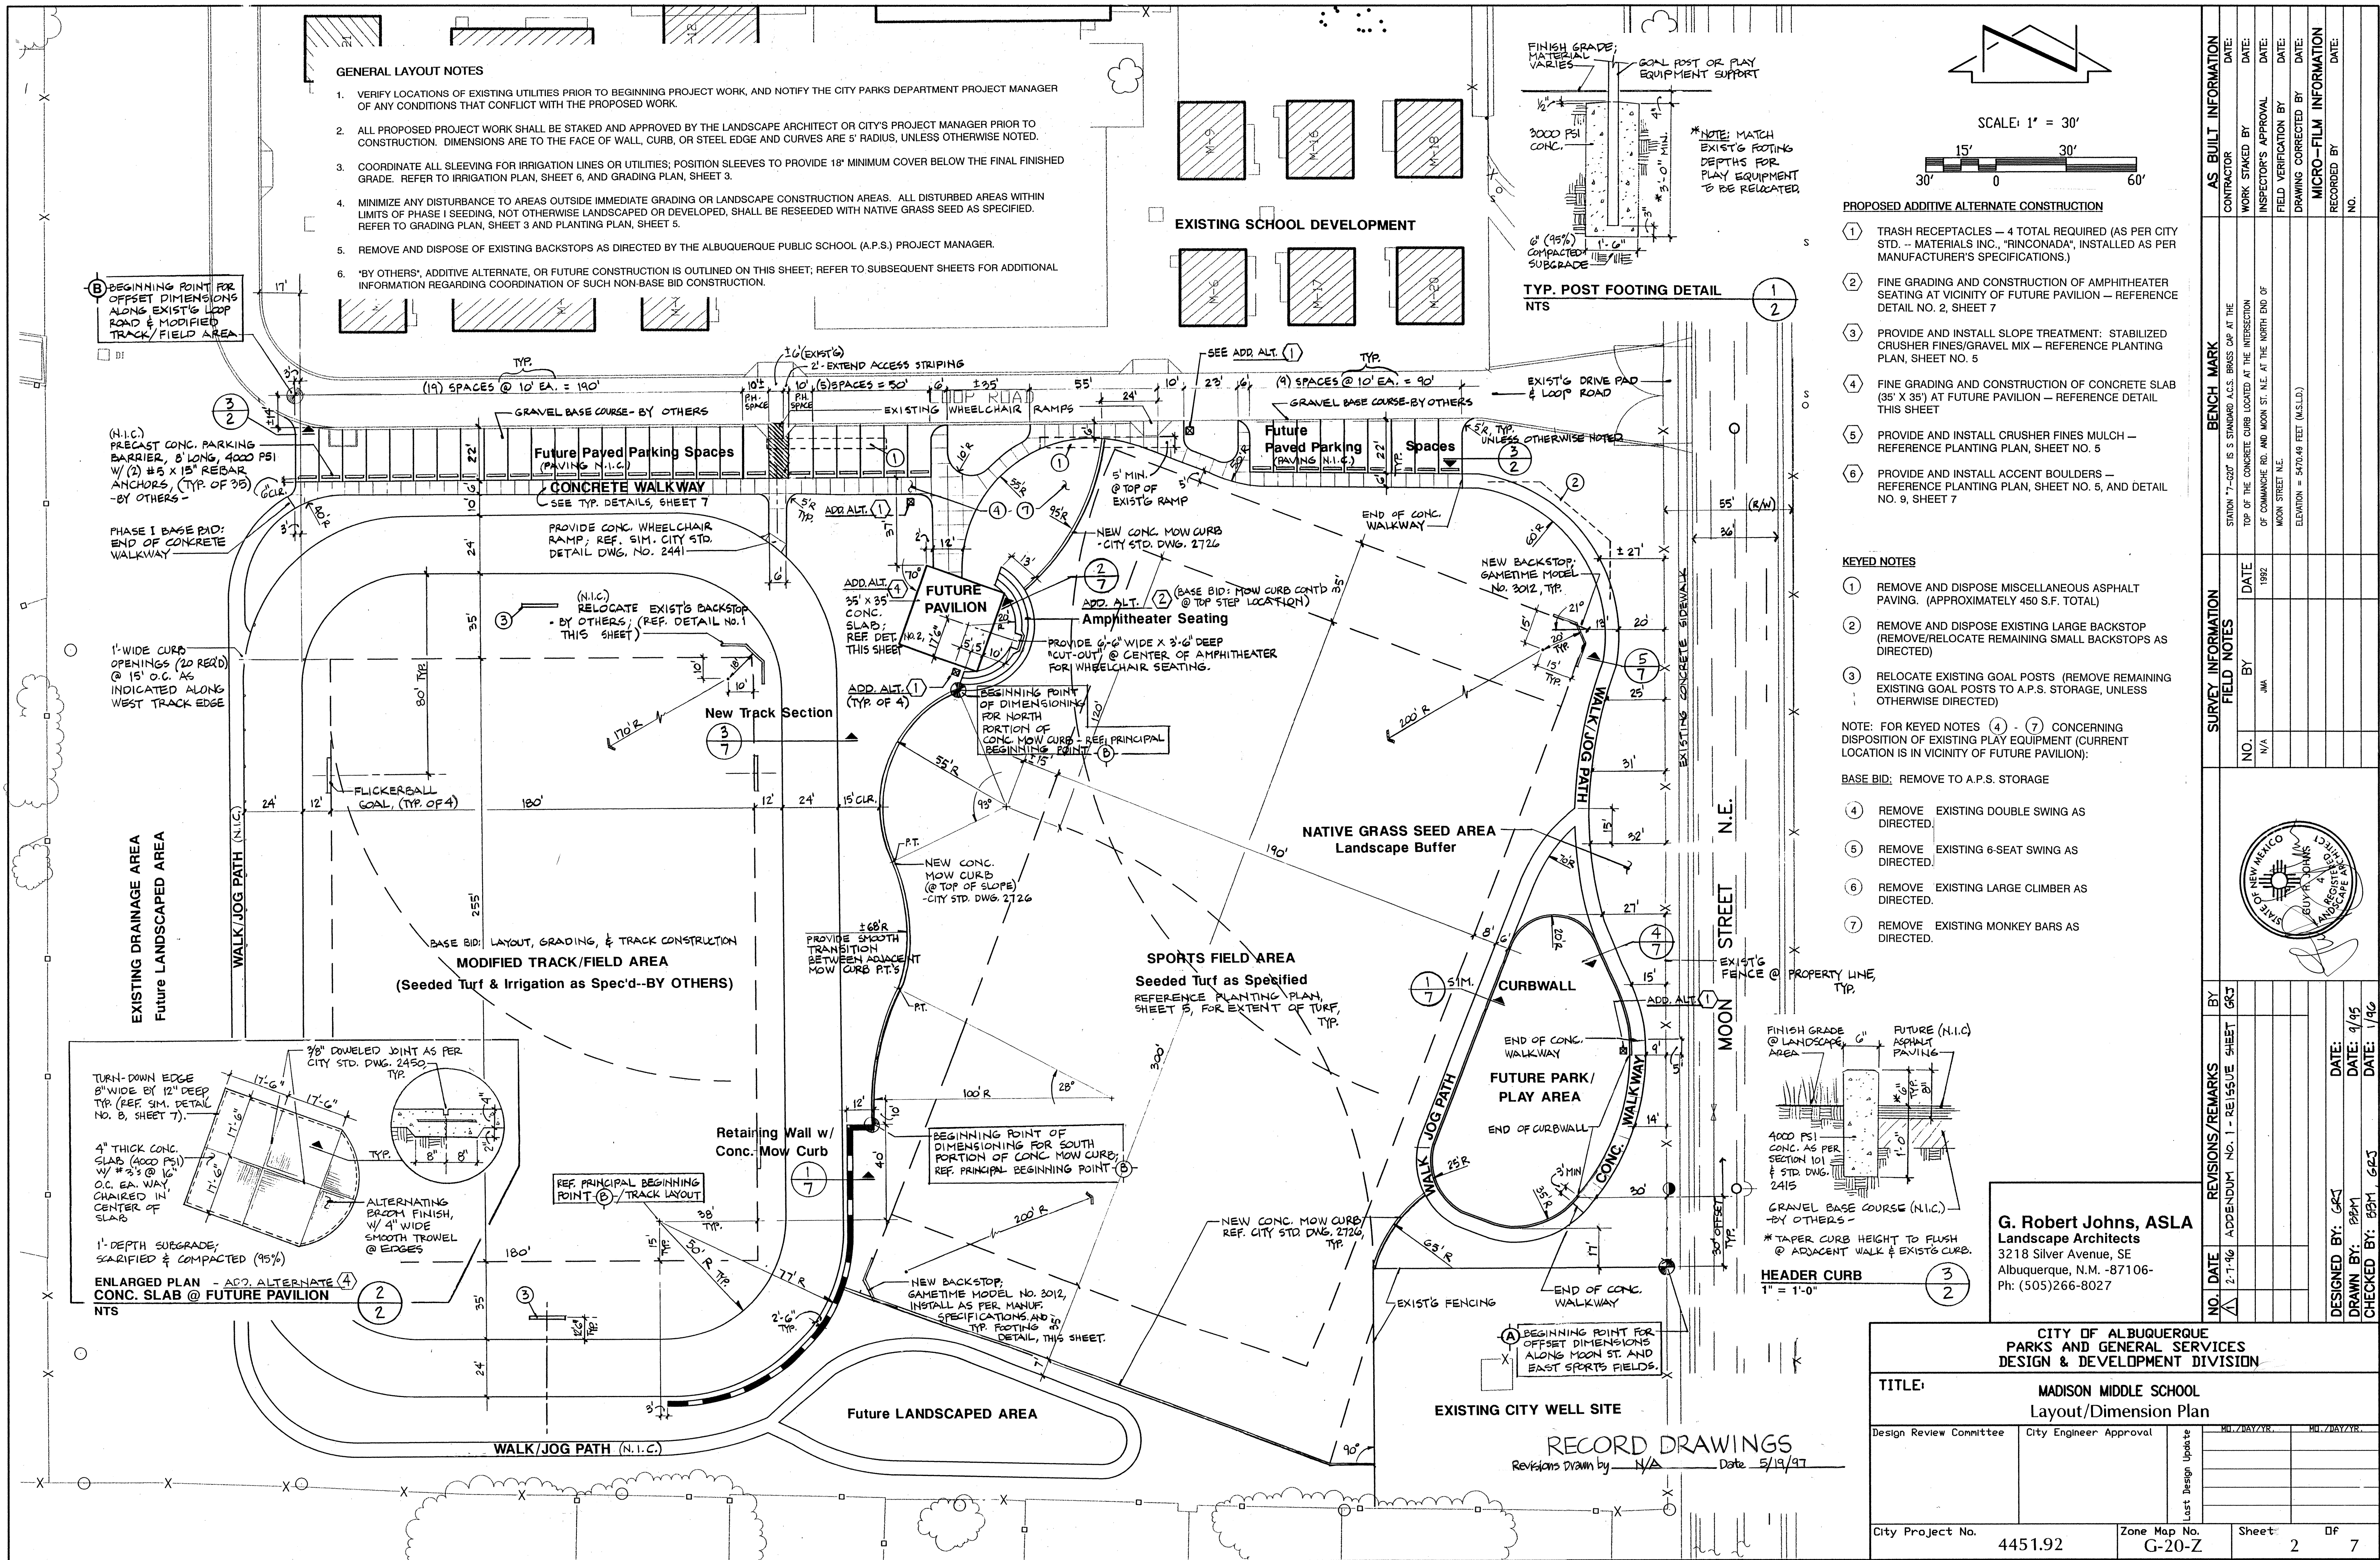

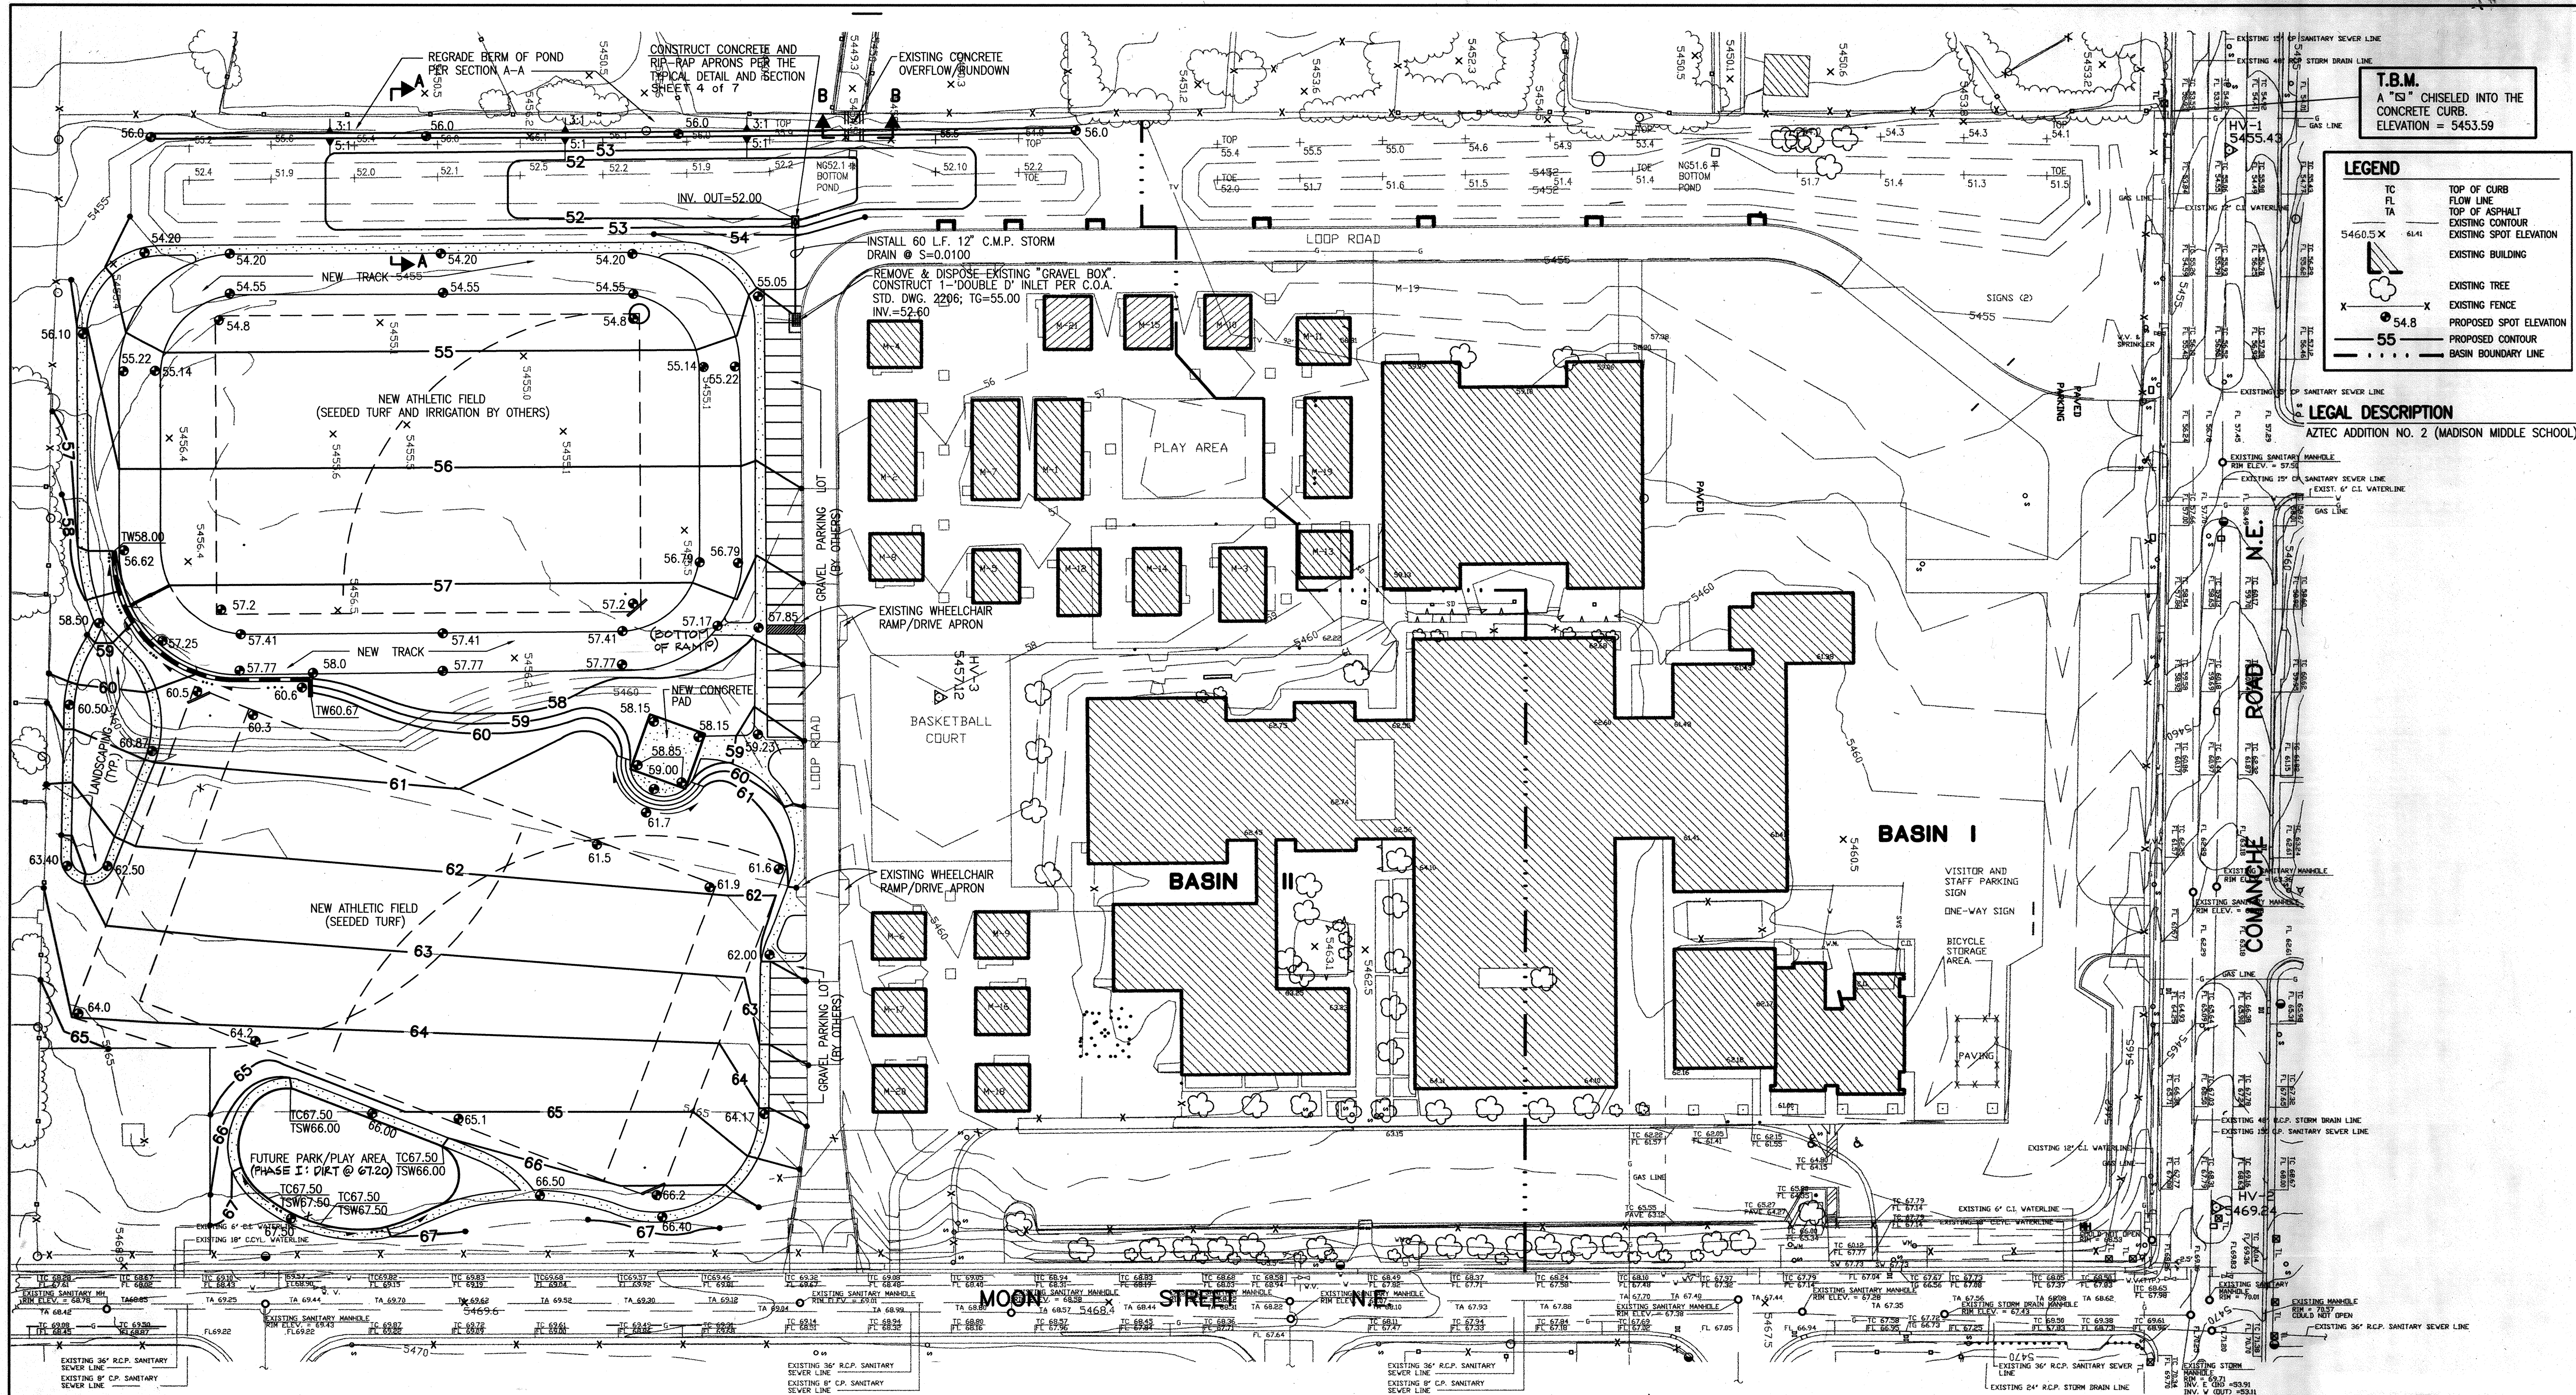


T.B.M.
A "3" CHISELED INTO THE
CONCRETE CURB.
ELEVATION = 5453.59

LEGEND

TC	TOP OF CURB
FL	FLOW LINE
TA	TOP OF ASPHALT
---	EXISTING CONTOUR
---	EXISTING SPOT ELEVATION
---	EXISTING BUILDING
---	EXISTING TREE
---	EXISTING FENCE
---	PROPOSED SPOT ELEVATION
---	PROPOSED CONTOUR
---	BASIN BOUNDARY LINE

LEGAL DESCRIPTION
AZTEC ADDITION NO. 2 (MADISON MIDDLE SCHOOL)

AS BUILT INFORMATION		BENCH MARK		SURVEY INFORMATION	
CONTRACTOR	DATE:	STATION	DATE:	NO.	BY
WORK STAKED BY	DATE:	INSPECTOR'S APPROVAL	DATE:	901895	JMA
INSPECTOR'S APPROVAL	DATE:	FIELD VERIFICATION BY	DATE:		
DRAWING CORRECTED BY	DATE:	DRAWING CORRECTED BY	DATE:		
MICRO-FILM INFORMATION		RECORDED BY			
		NO.			

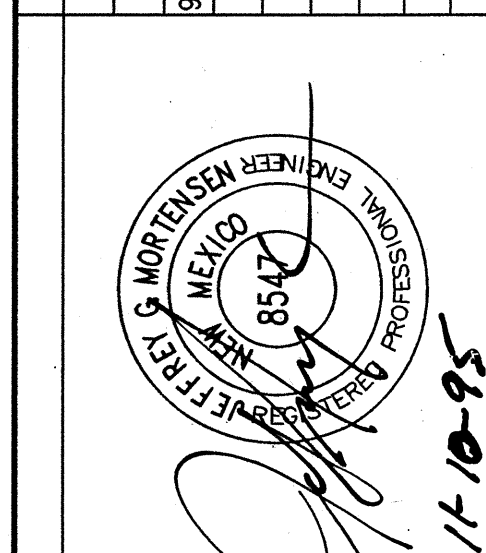

REVISIONS/REMARKS		BY	
NO.	DATE		

DESIGNED BY: G.E.B.		DATE: 10/1995	
DRAWN BY: S.C.H.		DATE: 10/1995	
CHECKED BY: J.G.M.		DATE: 11-10-95	

Construction Notes:

- Two (2) working days prior to any excavation, contractor must contact New Mexico One Call System 260-1990, for location of existing utilities.
- Prior to construction, the contractor shall excavate and verify the horizontal and vertical location of all potential obstructions. Should a conflict exist, the contractor shall notify the engineer in writing so that the conflict can be resolved with a minimum amount of delay.
- All work on this project shall be performed in accordance with applicable federal, state and local laws, rules and regulations concerning construction safety and health.
- All construction within public right-of-way shall be performed in accordance with applicable City of Albuquerque Standards and Procedures.
- If any utility lines, pipelines, or underground utility lines are shown on these drawings, they are shown in an approximate manner only, and such lines may exist where none are shown. If any such existing lines are shown, the location is based upon information provided by the owner of said utility, and the information may be incomplete, or may be obsolete by the time construction commences. The engineer has conducted only preliminary investigation of the location, depth, size, or type of existing utility lines, pipelines, or underground utility lines. This investigation is not conclusive, and may not be complete, therefore, makes no representation pertaining thereto, and assumes no responsibility or liability thereof. The contractor shall inform itself of the location of any utility line, pipeline, or underground utility line in or near the area of the work in advance of and during excavation work. The contractor is fully responsible for any and all damage caused by its failure to locate, identify and preserve any and all existing utilities, pipelines, and underground utility lines. In planning and conducting excavation, the contractor shall comply with state statutes, municipal and local ordinances, rules and regulations, if any, pertaining to the location of these lines and facilities.
- The design of planters and landscaped areas is not part of this plan. All planters and landscaped areas adjacent to the building(s) shall be provided with positive drainage to avoid any ponding adjacent to the structure. For construction details, refer to landscaping plan.

Erosion Control Measures:

- The contractor shall ensure that no soil erodes from the site into public right-of-way or onto private property.
- The contractor shall promptly clean up any material excavated within the public right-of-way so that the excavated material is not susceptible to being washed down the street.
- The contractor shall secure "Topsoil Disturbance Permit" prior to beginning construction.

NOTE:


ALL GRADING SHOWN HEREON SHALL BE CONSTRUCTED DURING PHASE I CONSTRUCTION (BASE BID). REFER TO LAYOUT/DIMENSION PLAN (SHEET 2) FOR SCOPE OF CONSTRUCTION TO BE CONSIDERED AS ALTERNATES, FUTURE CONSTRUCTION, AND OTHER WORK TO BE PERFORMED BY OTHERS.



JEFF MORTENSEN & ASSOCIATES, INC.
6010-B MIDWAY PARK BLVD. N.E.
ALBUQUERQUE, N.M. 87109
ENGINEERS SURVEYORS (505) 345-4250

VICINITY MAP

SCALE: 1" = 750'

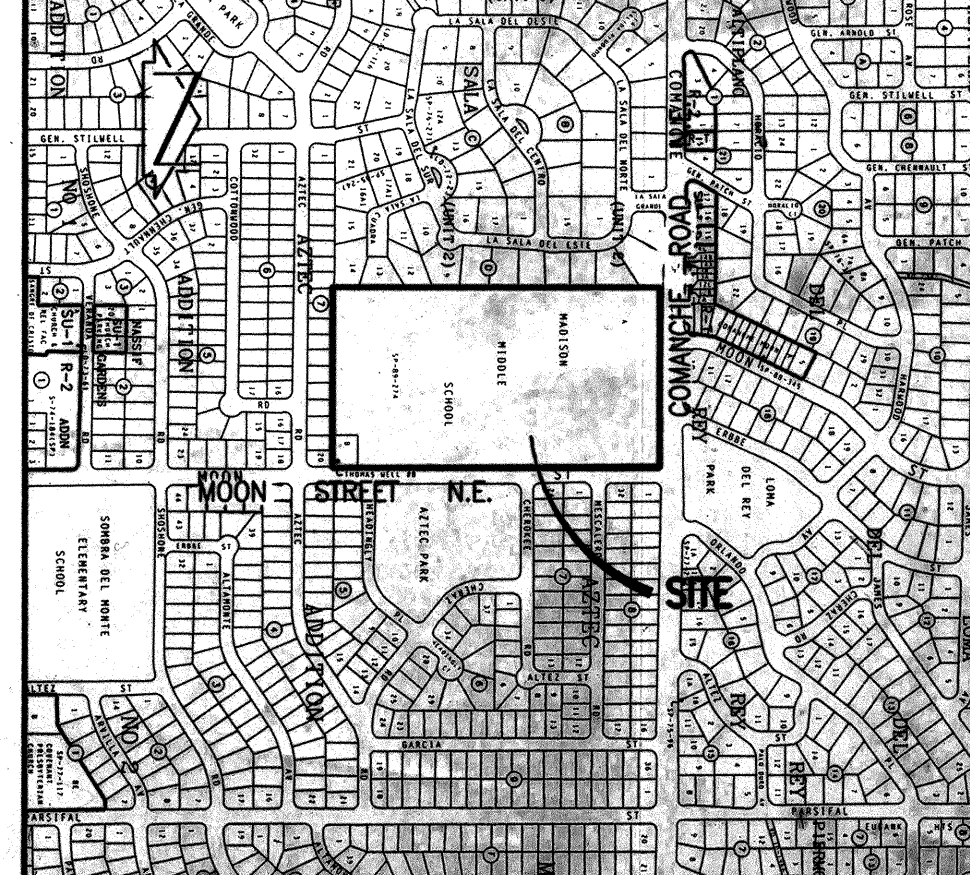

G-20

RECORD DRAWINGS

Revisions Drawn by: N/A Date: 5/19/97

**CITY OF ALBUQUERQUE
PARKS AND GENERAL SERVICES
DESIGN & DEVELOPMENT DIVISION**

**TITLE: MADISON MIDDLE SCHOOL PARK DEVELOPMENT
GRADING PLAN**

Design Review Committee City Engineer Approval

B.G.B. 2/5/96

City Project No. 4451.92

Zone Map No. G-20

Sheet 3 of 7

950501

GENERAL PLANTING NOTES

1. THE CONTRACTOR SHALL VERIFY THE LOCATIONS OF ALL EXISTING UTILITIES PRIOR TO BEGINNING PLANTING OPERATIONS, AND SHALL NOTIFY THE CITY'S PROJECT MANAGER OF ANY CONDITIONS THAT CONFLICT WITH THE PROPOSED WORK.
2. PLANTING INSTALLATION SHALL BE IN ACCORDANCE WITH THE CITY OF ALBUQUERQUE STANDARD SPECIFICATIONS AND DETAILS UNLESS OTHERWISE NOTED.
3. WEED REMOVAL — ALL PLANTING AREAS ARE TO HAVE ALL WEEDS AND COMPETITIVE VEGETATION REMOVED PRIOR TO BEGINNING ANY PREPARATION FOR PLANTING.
4. IN CASE OF A DISCREPANCY IN THE PLANT QUANTITIES SHOWN ON THE PLANT SCHEDULE AND THOSE ILLUSTRATED ON THE PLANTING PLAN, THE QUANTITIES ON THE PLANTING PLAN SHALL GOVERN.
5. THE BOTANICAL NAME WILL TAKE PRECEDENCE OVER THE COMMON NAME IF A DISCREPANCY OCCURS.
6. ALL PLANT SPECIMENS OF THE SAME SPECIES SHALL BE MATCHING IN PROPER AND APPROPRIATE SIZE AND CHARACTER AS PER THE AMERICAN NURSERYMAN'S ASSOCIATION STANDARDS.
7. ALL SEEDING AREAS SHALL BE PROTECTED FROM EROSION BY THE USE OF A MULCH OR BINDER APPLIED AS SPECIFIED DURING SEEDING.


SECTION 1012 - SUPPLEMENTAL NATIVE GRASS SEEDING

The following revisions and/or additions to the Technical Specifications of the Standard Specifications are hereby made a part of the Contract Documents.

1012.4.1.2 Native Seed for clay, clay loam, and sandy gravelly clay loam soils:

[The specified Native Seed mix shall be amended as follows:]

- Reduce "Paloma" Indian rice grass (*Oryzopsis hymenoides*) to 1.0 PLS/ACRE
- Omit Four-wing saltbush *Atriplex canescens*
- Add Buffalograss (*Buchloe dactyloides*), (New Mexico Region), 2.0 PLS/ACRE

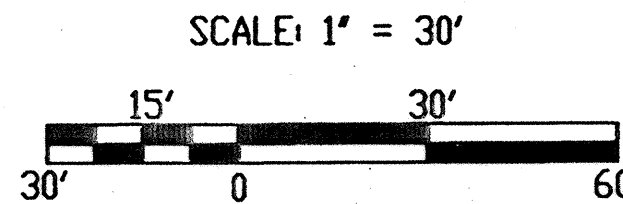

LEGEND

- LIMITS OF PHASE I LANDSCAPING/SEEDING
- NEW DECIDUOUS TREES (AS PER CITY STD. DWGS. 2713, 2714)
- NEW EVERGREEN TREES (AS PER CITY STD. DWGS. 2713, 2714)
- NEW SHRUB PLANTINGS (AS PER CITY STD. DWG. 2717)
- ACCENT BOULDERS (8 TOTAL REQ'D: 4 @ ± 28" ROUGH DIA.; 4 @ ± 42" ROUGH DIA. "RIVER BOULDERS" AS AVAIL. FROM ROCKY MOUNTAIN STONE CO., ALBUQUERQUE, N.M. OR APPROVED EQUAL.) SEE DETAIL 9/7.
- ADD. ALT. (6) SEE DETAIL NO. 9, SHEET 7.
- NEW SEEDING TURF AS SPEC'D (C.O.A. STD. SPEC. SECTION 1011)
- ADD. ALT. (3) SLOPE TREATMENT: INSTALL 4" DEPTH MIXTURE OF 1 PART STABILIZED CRUSHER FINES WITH 1 PART GRAY GRAVEL AS SPEC'D.

PLANTING SCHEDULE

KEY	PLANT NAME	QUANTITY	INSTALLED SIZE	REMARKS
TREES				
RA	Fraxinus velutina 'Rio Grande'	11	2 1/2" cal, 24" box or B & B	
OO	Rio Grande/Fan-Tex Ash	2	2" cal, 24" box or B & B	
AP	Maclura pomifera	5	10'-12" ht, B & B	
TO	Osage Orange	2	2" cal, 24" box or B & B	
PL	Pinus eldarica	7	2 1/2" cal, 24" box or B & B	
SHRUBS/GROUNDCOVERS				
Tsa	Artemisia filifolia	18	5 gallon	plant 4" o.c., typ.
DBr	Threadleaf Sage	8	1 gallon	plant 3" o.c., typ.
Cha	Baccharis pilularis	61	5 gallon	plant 5" o.c., typ.
BJu	Chrysothamnus nauseosus	27	5 gallon	plant 2'7" o.c., typ.
RSa	Chamaea/Rubber Rabbitbrush	55	5 gallon	plant 40" o.c., typ.
PSu	Juniperus sabina 'Broadmoor'	125	5 gallon	plant 30" o.c., typ.
ASa	Broadmoor Juniper	13	1 gallon	plant 30" o.c., typ.
SBr	Peroovskia atriplicifolia	2	5 gallon	plant 30" o.c., typ.
PERENNIALS				
Gay	Rhus trilobata 'Prostrata'	95	1 gallon	plant 20" o.c., typ.
RVe	Spartium junceum	45	4" pots	plant 24" o.c., typ.
	Raspberry Verbena			

CRUSHER FINES BETWEEN EXIST'G FENCE & SIDEWALK (4" DEPTH, TYP.); OTHER LOCATIONS AS INDICATED.

ADD. ALTERNATE (5)

G. Robert Johns, ASLA
Landscape Architects
3218 Silver Avenue, SE
Albuquerque, N.M. 87106-
Ph: (505)266-8027

CITY OF ALBUQUERQUE
PARKS AND GENERAL SERVICES
DESIGN & DEVELOPMENT DIVISION

**TITLE: MADISON MIDDLE SCHOOL
Planting Plan**

Design Review Committee City Engineer Approval

City Project No. 4451.92 Zone Map No. C-20-Z

Sheet 5 of 7

RECORD DRAWINGS

Revisions Drawn by N/A Date 5/19/97

EXISTING DRAINAGE AREA

Future LANDSCAPED AREA (N.I.C.)
-TEMPORARY NATIVE GRASS SEEDING AS PER CITY STD. SPEC. 1012 - BY OTHERS.

MODIFIED TRACK/FIELD AREA
(Seeded Turf & Irrigation as Spec'd-BY OTHERS)

4" DEPTH CRUSHER FINES
ADD. ALT. (5)

Future LANDSCAPED AREA (N.I.C.)
-TEMPORARY NATIVE GRASS SEEDING AS PER CITY STD. SPEC. 1012 - BY OTHERS.

LOOP ROAD

FUTURE PAVILION

Amphitheater Seating
ADD. ALTERNATE (2)

REF. ABOVE:
(C.O.A. SPEC. SECTION 1012 - SUPPLEMENTAL)
NATIVE GRASS SEED AREA
Landscape Buffer - TO REMAIN UNMOWN, TYP.


SPORTS FIELD AREA
Seeded Turf as Specified
(C.O.A. STD. SPEC. SECTION 1011)

**FUTURE PARK/
PLAY AREA**

EXISTING CITY WELL SITE

Future WALK/JOG PATH

MOON STREET N.E.

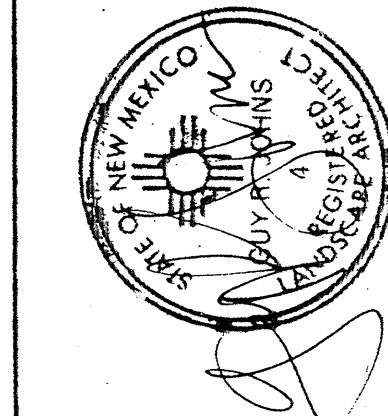

DESIGNED BY: G.R.J. PSM DATE: 10/95
DRAWN BY: PSM DATE: 1/96
CHECKED BY: PSM, G.R.J. DATE: 1/96

NO.	DATE	REVISIONS/REMARKS

AS BUILT INFORMATION	
CONTRACTOR	DATE
WORK STATED BY	DATE
INSPECTOR'S APPROVAL	DATE
FIELD VERIFICATION BY	DATE
DRAWING CORRECTED BY	DATE
MICRO-FILM INFORMATION	
RECORDED BY	DATE
NO.	

BENCH MARK	
STATION	DATE
STATION 7+600 IS 5 STANDARD A.C.S. BRASS 3"p AT THE TOP OF THE CONCRETE CURB LOCATED AT THE INTERSECTION OF COMMUNHE RD. AND MOON ST. N.E. AT THE NORTH END OF MOON STREET N.E.	1992
ELEVATION = 5470.48 FEET (M.S.L.D.)	

SURVEY INFORMATION	
FIELD NOTES	DATE

BY	
NO.	DATE


BY	
NO.	DATE

BY	
NO.	DATE


BY	
NO.	DATE

GENERAL NOTE:

TOP SURFACES SHALL BE BROOM FINISH CONCRETE; VERTICAL SURFACES SHALL BE SANDED OR GROUND SMOOTH WITH FORM-TIE HOLES LEFT UNFILLED. CONTROL JOINTS SHALL BE PLACED @ 5' O.C.; 1/2" EXPANSION JOINTS SHALL BE DOWELED (REF. SIM. CITY STD. DWG 2450), AND PLACED @ 20' O.C. (4000 PSI CONCRETE, TYP.)

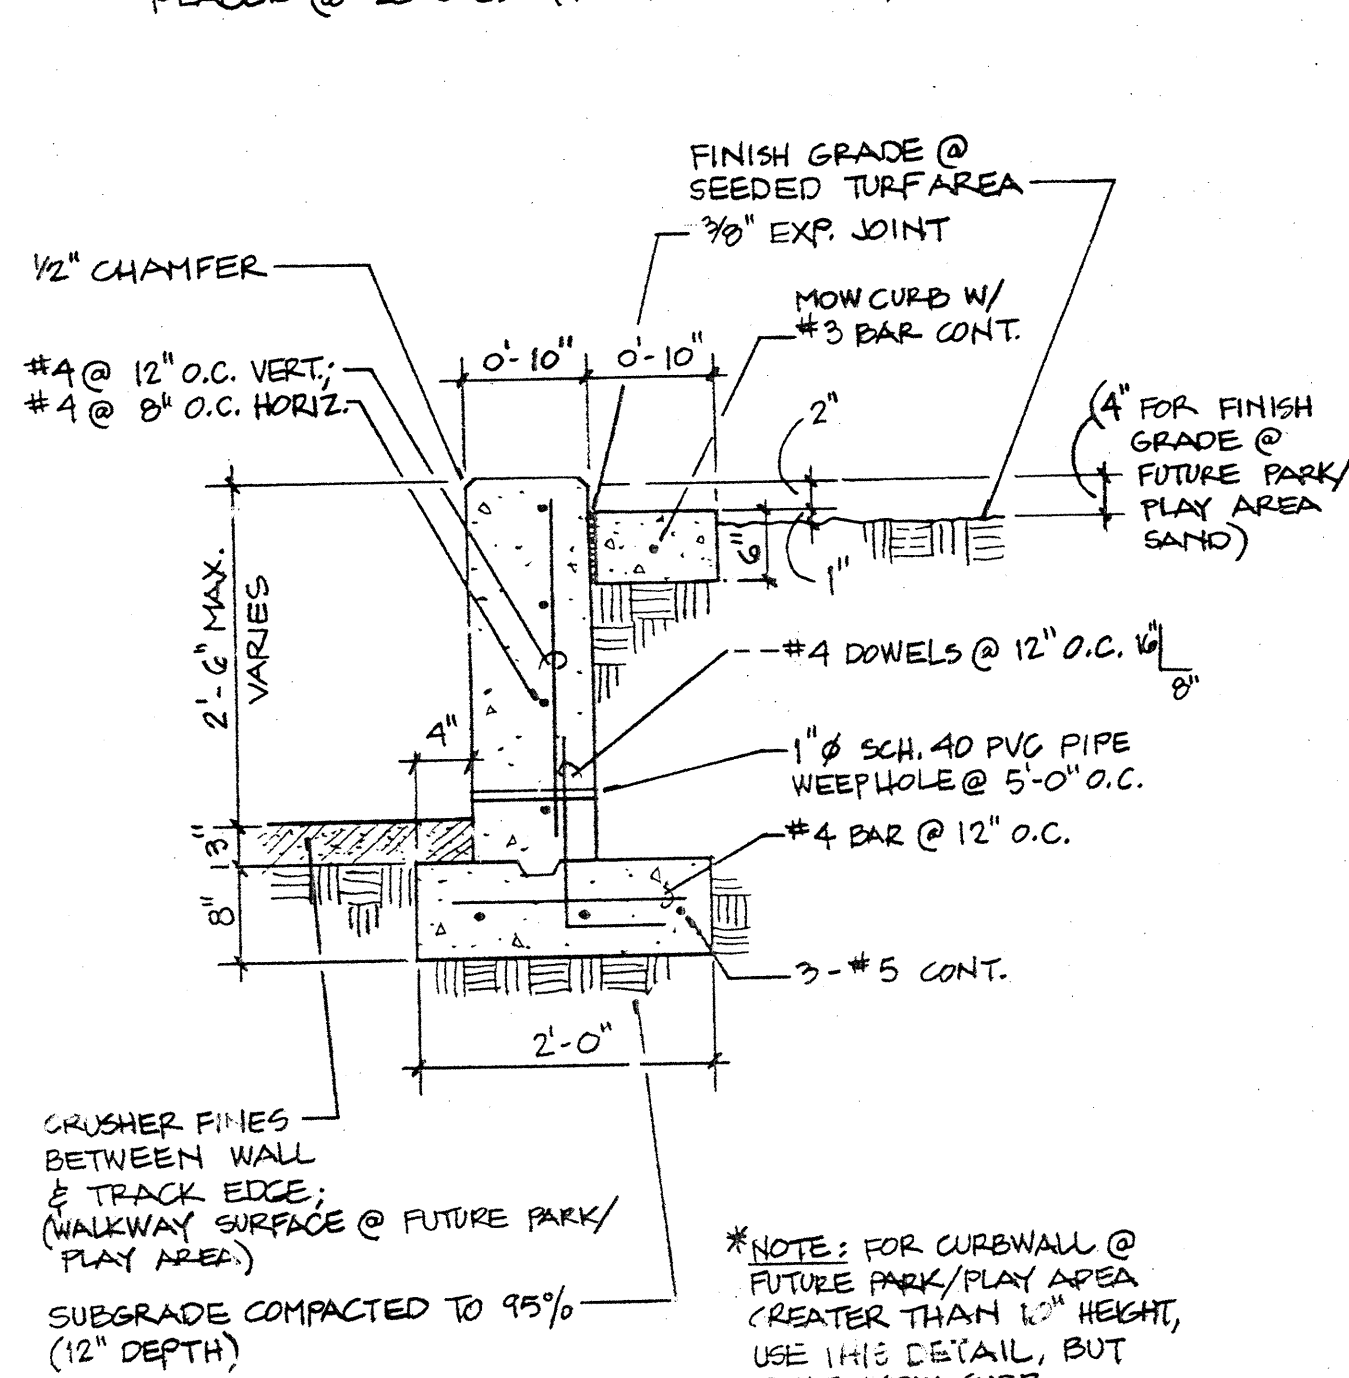


RETAINING WALL W/ MOW CURB
3/4" = 1'-0"

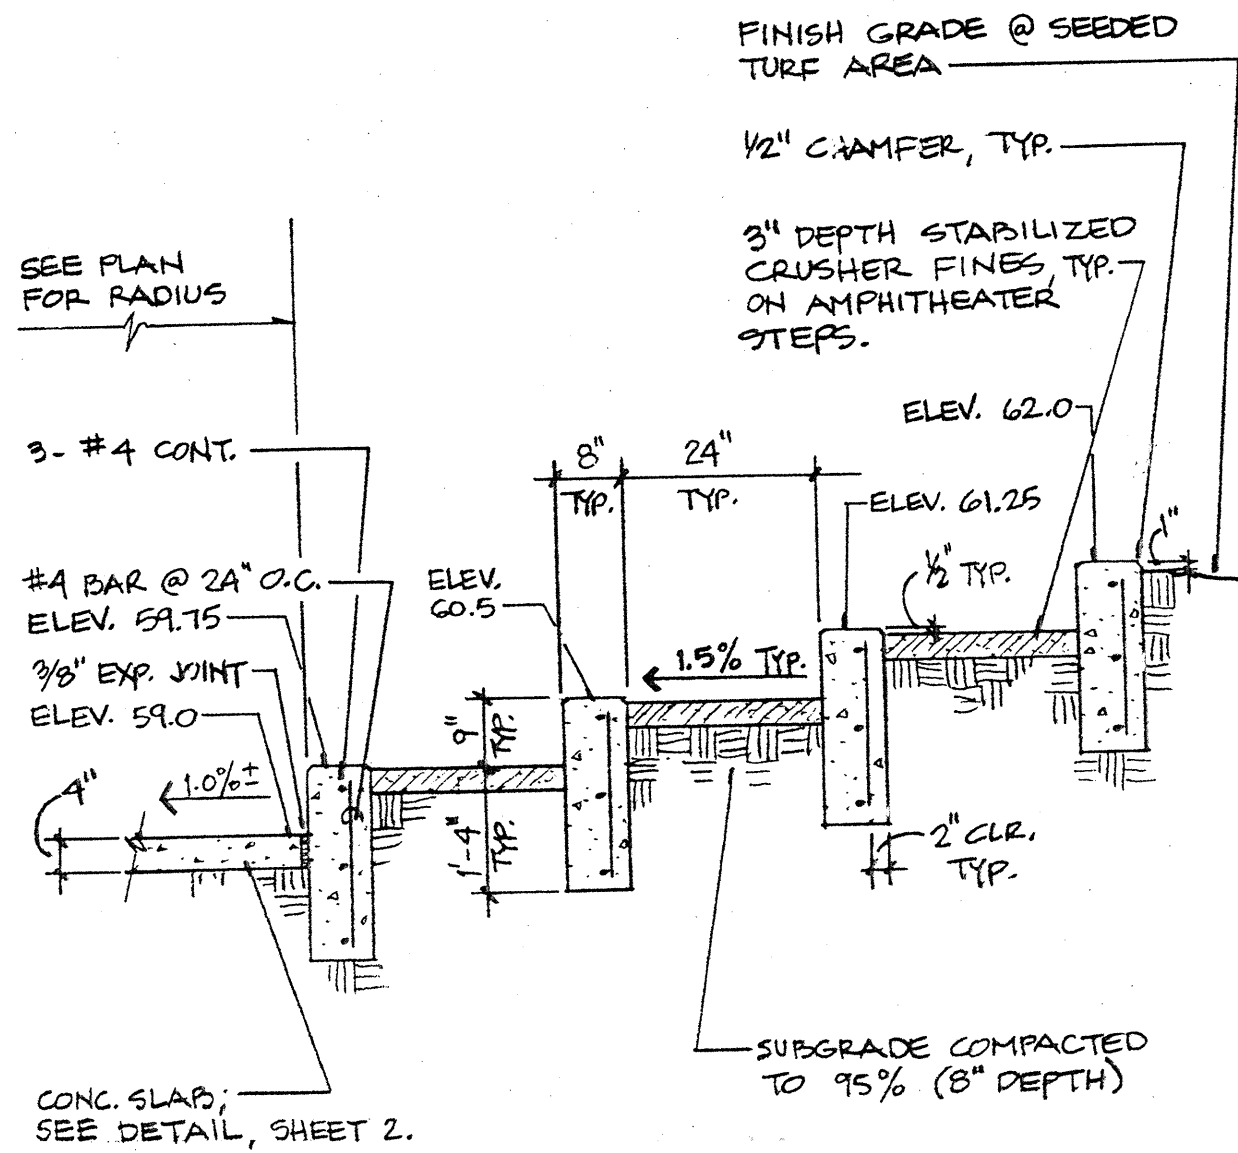

ADDITIVE ALTERNATE (2)
AMPHITHEATER SEATING @ PAVILION
1/2" = 1'-0"

GENERAL NOTES:

- CONTROL JOINTS SHALL BE PLACED AT 5' O.C.
- EXPANSION JOINTS SHALL BE PLACED AT 20' O.C. AND WHERE THE MOWSTRIP ABUTS ANOTHER HARD SURFACE.
- THE CONCRETE MOWSTRIP MAY BE EXTRUDED, BUT SHALL MEET THE STANDARD OF THIS DETAIL.
- A SAMPLE OF THE TRACK SURFACE SHALL BE SUBMITTED TO THE OWNER'S REPRESENTATIVE FOR APPROVAL PRIOR TO INSTALLATION.

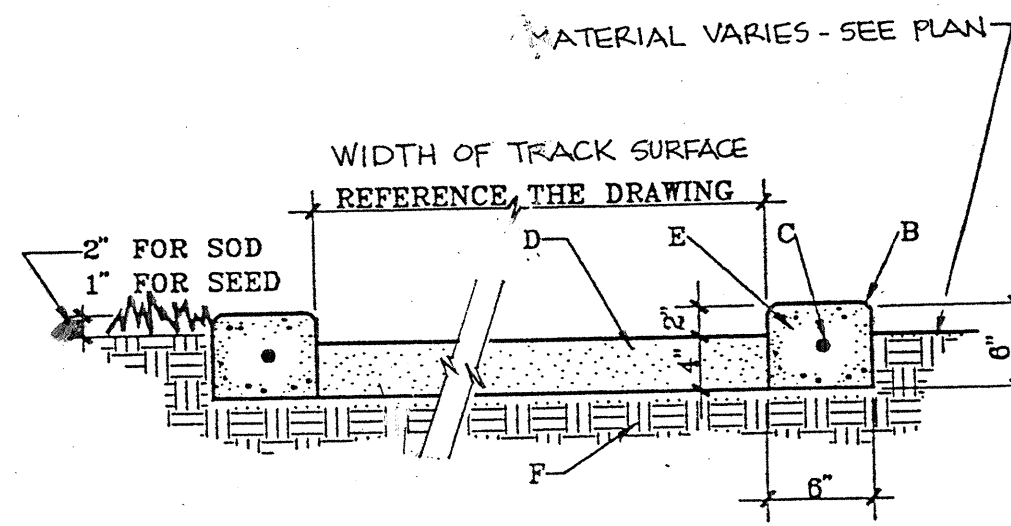


CONSTRUCTION NOTES:

- SOD OR SEEDS TURF (REFERENCE THE DRAWING).
- TOOLED EDGE (TYP.)
- #3 REBAR, HORIZONTAL AND CONTINUOUS.
- CRUSHED SAND OR CINDERS, ROLLED FOR COMPACTION.
- 4000 PSI CONCRETE MOWSTRIP WITH BRUSH FINISH. (SEE SECTION 101).
- SUBGRADE COMPACTED TO 95% (SEE SECTION 501).

NOTE: PROVIDE 1'-0" WIDE CURB OPENINGS @ 15' O.C. AS INDICATED ON SHEET 2 LAYOUT/DIMENSION PLAN.

CROSS SECTION @ RUNNING TRACK
1" = 1'-0"

DIMENSION VARIES: 2" MIN. - 10" MAX.; FOR CURB WALL HEIGHT GREATER THAN 10", USE DETAIL 1/7, BUT OMIT MOW CURB.

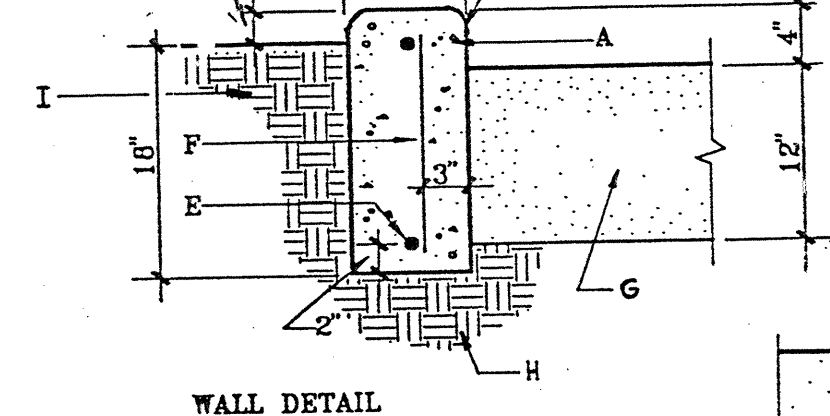

GENERAL NOTES:


- CONTROL JOINTS SHALL BE PLACED AT 5' O.C.
- EXPANSION JOINTS SHALL BE PLACED AT 20' O.C.

- CONSTRUCTION NOTES:
- 4000 PSI CONCRETE WITH SPEED FINISH. (SEE SECTION 101).
 - 1" CHAMFER.
 - 1/2" EXPANSION JOINT MATERIAL.
 - TOOLED EDGE.
 - #4 REBAR, HORIZONTAL AND CONTINUOUS.
 - #4 REBAR AT 4' O.C.
 - BRICK SAND. (FUTURE)
 - SUBGRADE COMPACTED TO 95%. (SEE SECTION 501).
 - MATERIAL VARIES. (REFERENCE THE DRAWINGS).

*NOTE: FOR CURB WALL HEIGHT GREATER THAN 10", USE DETAIL NO. 1/7 THIS SHEET, BUT OMIT MOW CURB.

FOR CURB WALL HEIGHT 10" OR LESS:
CONC. CURB WALL @ FUTURE PARK / PLAY AREA
NTS

NOTE: SEE PLANS FOR PATH DIMENSIONS.

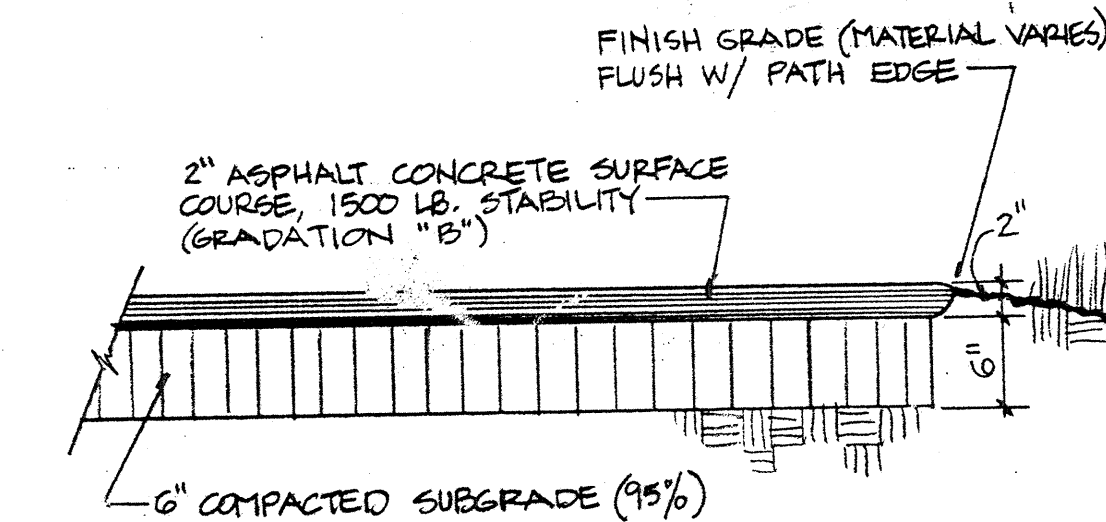

ASPHALT WALK/JOG PATH
1" = 1'-0"

GENERAL NOTES:

- Swing joint assembly shall be Lasco-manuf. by Philips Industries Inc., Denver, Co., Dallas, Tx. et al.
- All glue fittings shall be assembled & dry prior to assembly of threaded fittings.
- No teflon tape or pipe dope shall be used.
- All threaded fittings shall be hand tightened only & then loosened one full turn prior to installation in trench.
- Lateral line pressure testing shall be completed prior to installation of swing joint assembly. Lateral line testing shall be accomplished by installing a plug in the first male adapters downstream of the tees and elbows.
- Top of sprinkler head shall be set flush with finish grade.

CONSTRUCTION NOTES:

- Finish grade.
- Sprinkler head (reference the drawing).
- Sch. 80 PVC toe nipple. Size length as required.
- 90° elbow with Acme threads.
- 90° street ell with Acme M&F threads.
- Male adapter with Acme threads.
- Sch. 40 PVC pipe.
- Sch. 40 PVC SxSxT tee or SxT ell.
- Lateral Pipe.

GEAR-DRIVEN SPRINKLER HEAD
W/ SWING JOINT ASSEMBLY
NTS

GENERAL NOTES:

- Lateral line pressure testing shall be completed prior to installation of flex pipe assembly. Lateral line testing shall be accomplished by installing a plug in the outlet of lateral line tees and elbows.
- FOR BUBBLER LOCATIONS IN NATIVE SEED AREAS OR PLANTING AREAS, REFERENCE CITY STD. DETAIL 2710.
- LOCATE BUBBLER 12" OUT FROM EDGE OF ROOTBALL, ON UPHILL SIDE, TYP.

CONSTRUCTION NOTES:

- Finish grade.
- Bubbler head (reference the Drawings).
- 4" PVC slip cap. Do not weld.
- 4" perforated pvc drain pipe. Pipe shall be wrapped in Teflar filter fabric. Secure filter fabric to pipe with 3 evenly spaced plastic snap ties.
- 1/2" - 3/4" washed rock.
- Sch. 80 PVC nipple.
- Sch. 40 PVC threaded ell.
- Sch. 40 PVC MIP adapter.
- PVC flexible vinyl pipe, std., IPS from Agricultural Products, Inc., (818)768-3303.
- Sch. 40 PVC SxSxT tee or SxT ell.
- Lateral pipe.

BUBBLER HEAD @ TREE IN SEED/SOD TURF AREA
NTS


GENERAL NOTES:

- CONTROL JOINTS SHALL BE PLACED AT 5' O.C.
- EXPANSION JOINTS SHALL BE PLACED AT 20' O.C.

CONSTRUCTION NOTES:

- TOOLED EDGE, 1/2" CHAMFER.
- MATERIAL VARIES - SEE PLAN.
- SUBGRADE COMPACTED TO 95%. (SEE SECTION 501).
- #4 REBAR AT 12" O.C.
- 4000 PSI CONCRETE WITH BRUSH FINISH. (SEE SECTION 101).
- #4 REBAR, HORIZONTAL AND CONTINUOUS, TOP & BOTTOM.
- DIMENSION VARIES: 4" FOR WALK EDGE ADJACENT TO PLAY AREA;
- 6" MAX. FOR WALK EDGE ADJACENT TO SIDES OF PARKING SPACES;
- 1" MAX. FOR WALK EDGE ADJACENT TO ENDS OF PARKING SPACES.

TYP. CONCRETE WALKWAY W/ TURN-DOWN EDGE
1" = 1'-0"

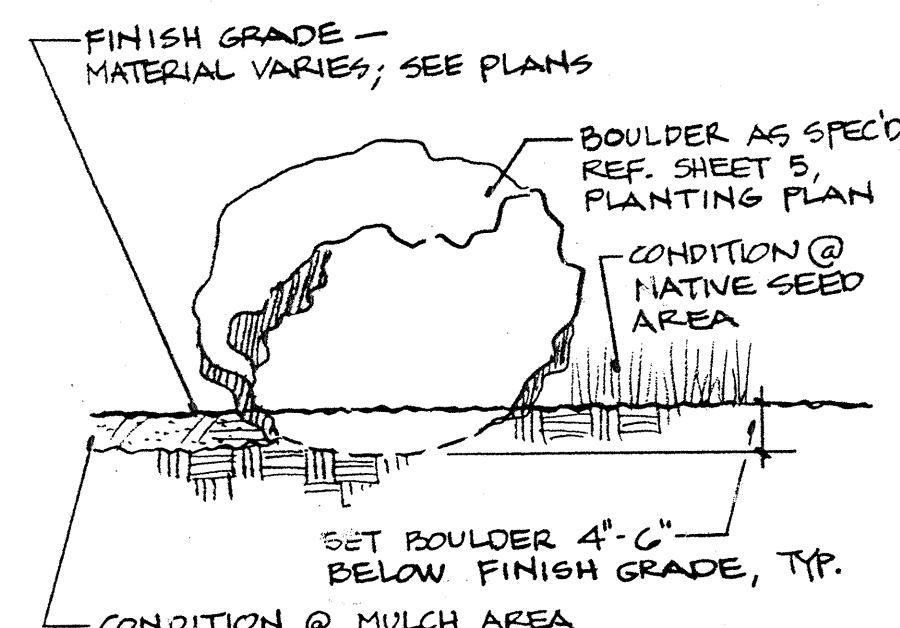

ADDITIVE ALTERNATE (6)
ACCENT BOULDER INSTALLATION
NTS

RECORD DRAWINGS

Revisions Drawn by: N/A Date: 3/19/97

G. Robert Johns, ASLA
Landscape Architects
3218 Silver Avenue, SE
Albuquerque, N.M. -87106-
Ph: (505)266-8027

CITY OF ALBUQUERQUE
PARKS AND GENERAL SERVICES
DESIGN & DEVELOPMENT DIVISION

TITLE:		MADISON MIDDLE SCHOOL Site / Landscape Details	
Design Review Committee	City Engineer Approval	NO. / DATE / YR.	NO. / DATE / YR.
DESIGNED BY: G.R.J., DBM	DRAWN BY: DBM	CHECKED BY: DBM	DATE: 10/95
CITY PROJECT NO. 4451.92	Zone Map No. G-20-Z	Sheet 7	OF 7

SURVEY INFORMATION			BENCH MARK		AS BUILT INFORMATION		
FIELD NOTES						CONTRACTOR	
NO.	BY	DATE				WORK STATED BY	
						INSPECTORS APPROVAL	
						DATE:	
						DATE:	
						DATE:	
						MICRO-FILM INFORMATION	
						RECORDED BY	
						DATE	
						NO.	

