

TC	FL
1 94.80	94.26
2 94.80	94.21
3 94.80	94.17

TC	FL
1 94.48	93.85
2 94.56	93.97
3 94.62	94.08

STA. 1+07
INSTALL 30' OF 8" PVC
SANITARY SEWER, CAP
AT R. TIE TO EXIST-
ING 10" SAS AT MH
PER STD. DWG. 2118
INV. @ R = 90.70
INV. @ MH = 90.47

STA. 0+1.57 BEGIN
NEW CURB & GUTTER,
6" VALLEY GUTTER PER
COA DWG 2420. MATCH
EXISTING CURB & GUTTER
ELEV. TC94.78 FL94.11

INSTALL 5.5" PMBP OR
4" PMBP OVER 6" AGGREGATE
BASE COURSE COMPACTED
TO 95%

INSTALL 8" STD.
CURB & GUTTER
PER COA DWG 2415

INSTALL WC RAMP PER COA STD. DWG. 2441
TRANSITION FROM 6" MEDIAN
TO 8" STANDARD CURB.

INSTALL
6" S/W @ R

STA. 2+40
20.25 LT

EXIST. 18" SD LINE
TO MANHOLE IN COORS BLVD.

R&R EXIST. S/W
PER STD. DWG.
2430

FUTURE STAND PIPE
BY OTHERS

SD PRIVATE SD BY OTHERS

INSTALL TEMPORARY
PLUG AT PROPERTY
LINE. INV. @ 88.62


STA. 1+00
CONNECT TO EXIST.
INLET PER C.O.A. STD. DWG. 2237
INLET INV. @ 87.4
INSTALL 10 LF 18" STORM DRAIN

MAKE NEAT CUT IN
FROM LIP OF EXIST.
GUTTER. REMOVE &
DISPOSE OF EXIST.
PAVEMENT AND
GUTTER. REPLACE PAVE.

STA. 0+25.5 INSTALL NEW PRIVATE
ENTRANCE
AS PER C.O.A. STD. DWG. NO. 2426
MATCH EXIST. CURB & GUTTER ELEV.

TC	FL
1 94.89	94.35
2 94.79	94.20
3 94.68	94.06

TC	FL
1 94.83	94.2
2 94.89	94.3
3 94.94	94.4

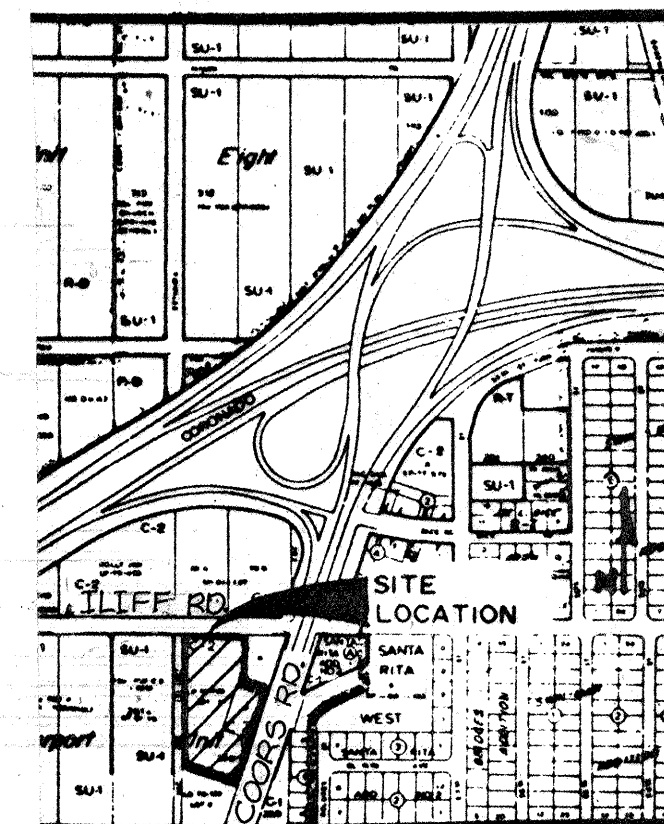

LOCATION MAP
ZONE ATLAS MAP NO. H-11

NOTES

ALL WORK DETAILED ON THESE PLANS TO BE
PERFORMED UNDER CONTRACT SHALL, EXCEPT
AS OTHERWISE STATED OR PROVIDED FOR
HEREON, BE CONSTRUCTED IN ACCORDANCE WITH
THE COA STANDARD SPECIFICATIONS FOR PUBLIC
WORKS CONSTRUCTION, 1986 EDITION (REFERRED
TO HEREIN AS THE STANDARD SPECIFICATIONS).

TWO (2) WORKING DAYS PRIOR TO ANY
EXCAVATION, CONTRACTOR MUST CONTACT LINE
LOCATING SERVICE, 260-1990, FOR LOCATION OF
EXISTING UTILITIES.

PRIOR TO CONSTRUCTION, THE CONTRACTOR
SHALL EXCAVATE AND VERIFY THE HORIZONTAL
AND VERTICAL LOCATIONS OF ALL OBSTRUCTIONS
SHOULD A CONFLICT EXIST, THE CONTRACTOR
SHALL NOTIFY THE ENGINEER OR SURVEYOR SO
THAT THE CONFLICT CAN BE RESOLVED WITH
MINIMUM AMOUNT OF DELAY.

TRAFFIC CONTROL

THREE (3) WORKING DAYS PRIOR TO BEGINNING
CONSTRUCTION, THE CONTRACTOR SHALL SUBMIT
TO THE CONSTRUCTION CO-ORDINATION DIVISION
A DETAILED CONSTRUCTION SCHEDULE. TWO (2)
WORKING DAYS PRIOR TO CONSTRUCTION, THE
CONTRACTOR SHALL OBTAIN A BARRICADE
PERMIT. CONTRACTOR SHALL NOTIFY BARRICADE
ENGINEER (768-2551) PRIOR TO OCCUPANCY AN
INTERSECTION. SEE SECTION 19 OF THE
SPECIFICATIONS.

ALL STREET STRIPING ALTERED OR DESTROYED
SHALL BE REPLACED IN KIND BY CONTRACTOR
IN LOCATION AND IN KIND AS EXISTING OR AS
INDICATED BY THIS PLAN SET.

APPROVAL OF AS-BUILT DRAWINGS
CHIEF CONSTRUCTION ENGINEER
DATE 12-11-92

26 4459.90 01/92

APPROVED FOR
CONSTRUCTION

Roger A. Green 7-9-92
CITY ENGINEER

CITY OF ALBUQUERQUE
PUBLIC WORKS DEPARTMENT
ENGINEERING GROUP

NICKOLSON PROPERTY
PAVING & STORM DRAIN IMPROVEMENTS


APPROVALS	ENGINEER	DATE	APPROVALS	ENGINEER	DATE
D.R.C. Chair	Roger A. Green	5-7-92	Water	ADD	5-7-92
Transportation	ADD	5-7-92	Waste Water	ADD	"
Hydrology	ADD	5-7-92			

DRAWING NO. 4459.90 MAP NO. H-11 SHEET 1 OF 1

WILSON
& COMPANY

WCEA # 92507A
APRIL 1992

ARTERIAL STREET PAVEMENT SECTION (FROM PROJ. 3241 SHT. 4 of 9)

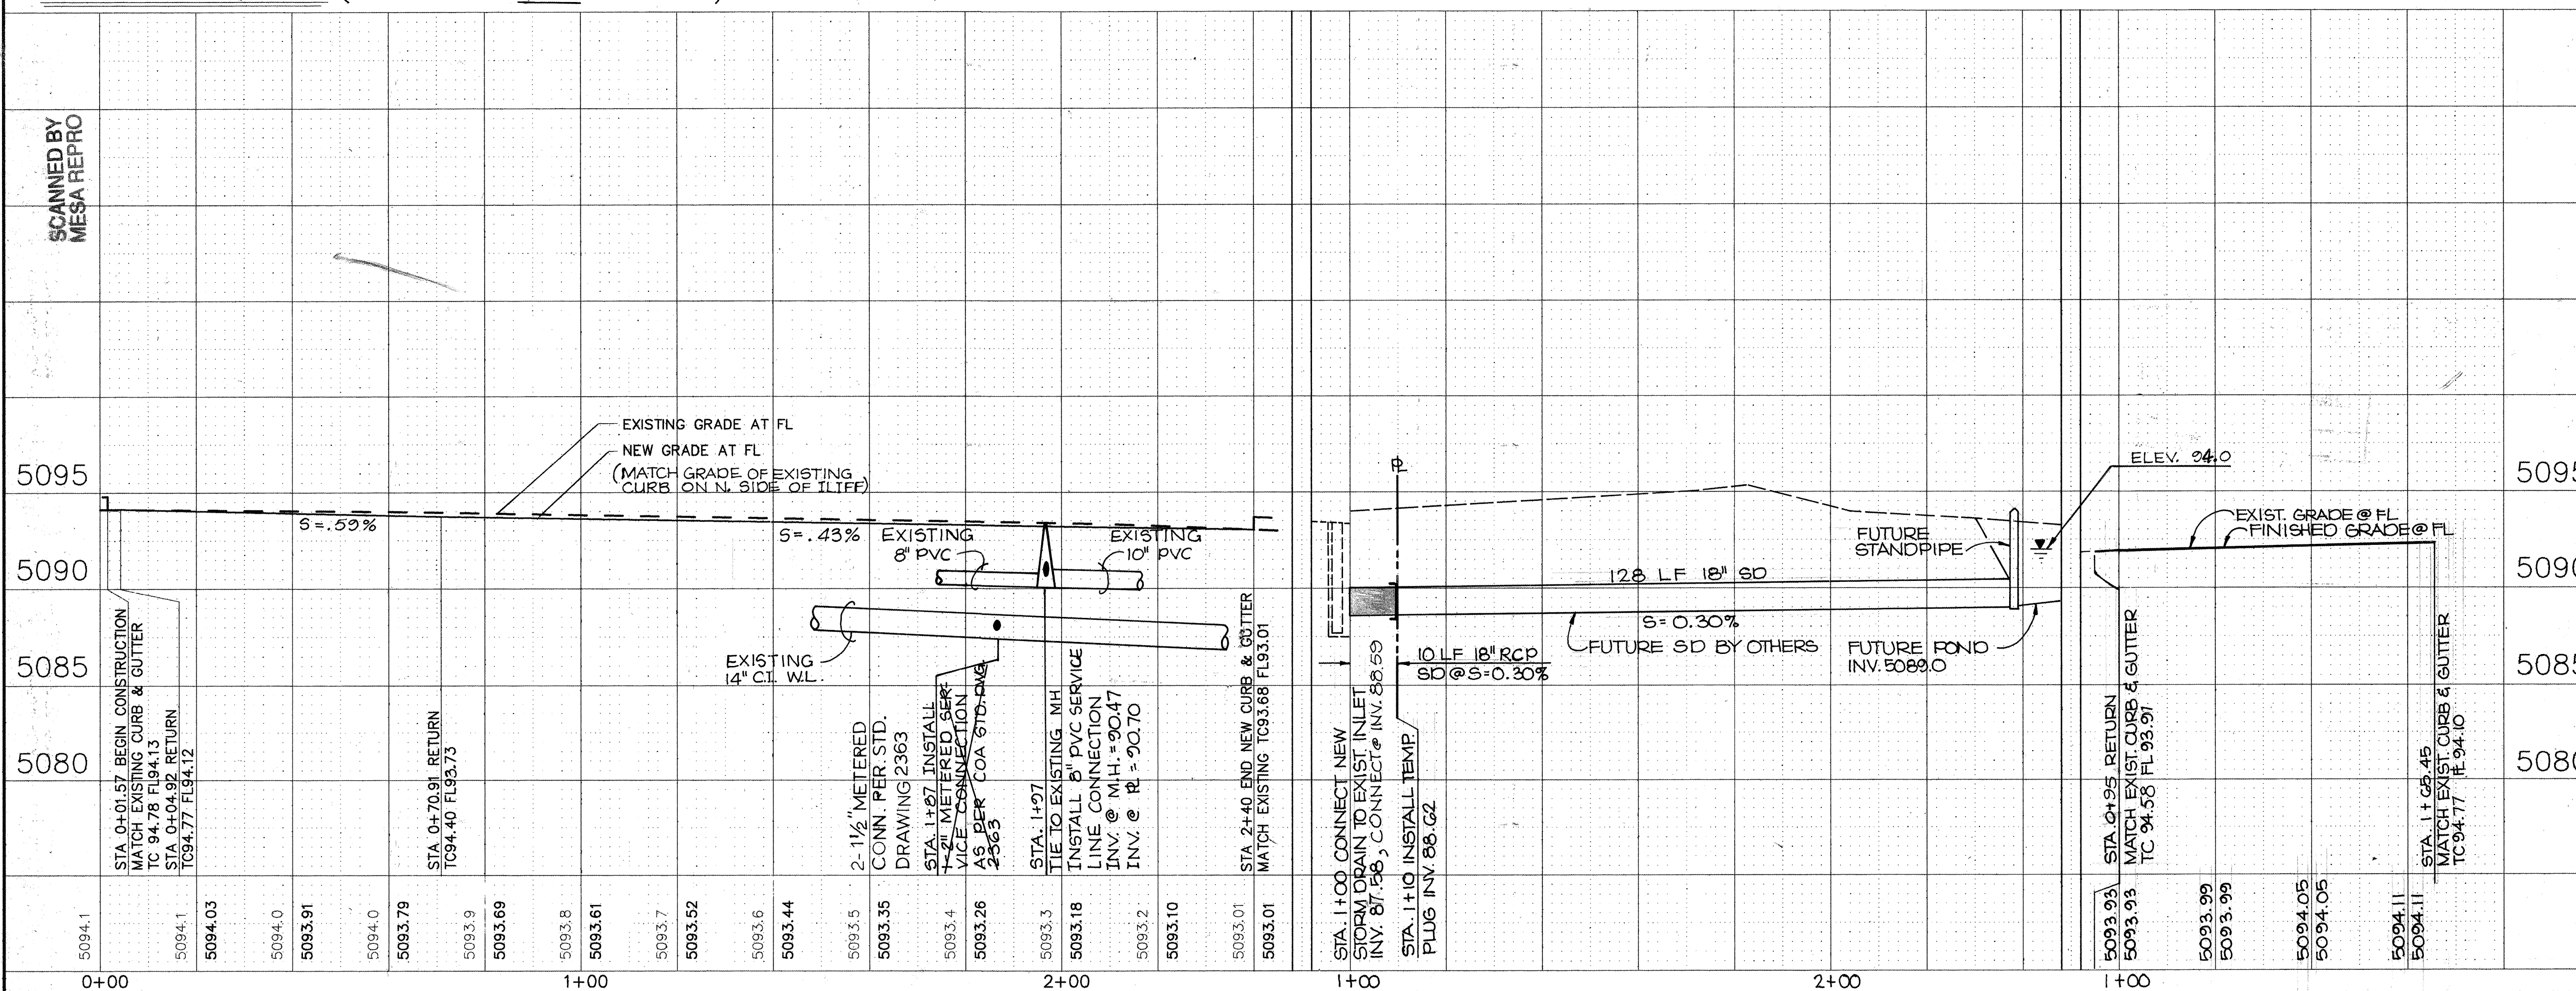

SCANNED BY
MESA REPRO