


CONSTRUCTION PLANS
FOR
HUNTERS RIDGE SUBDIVISION

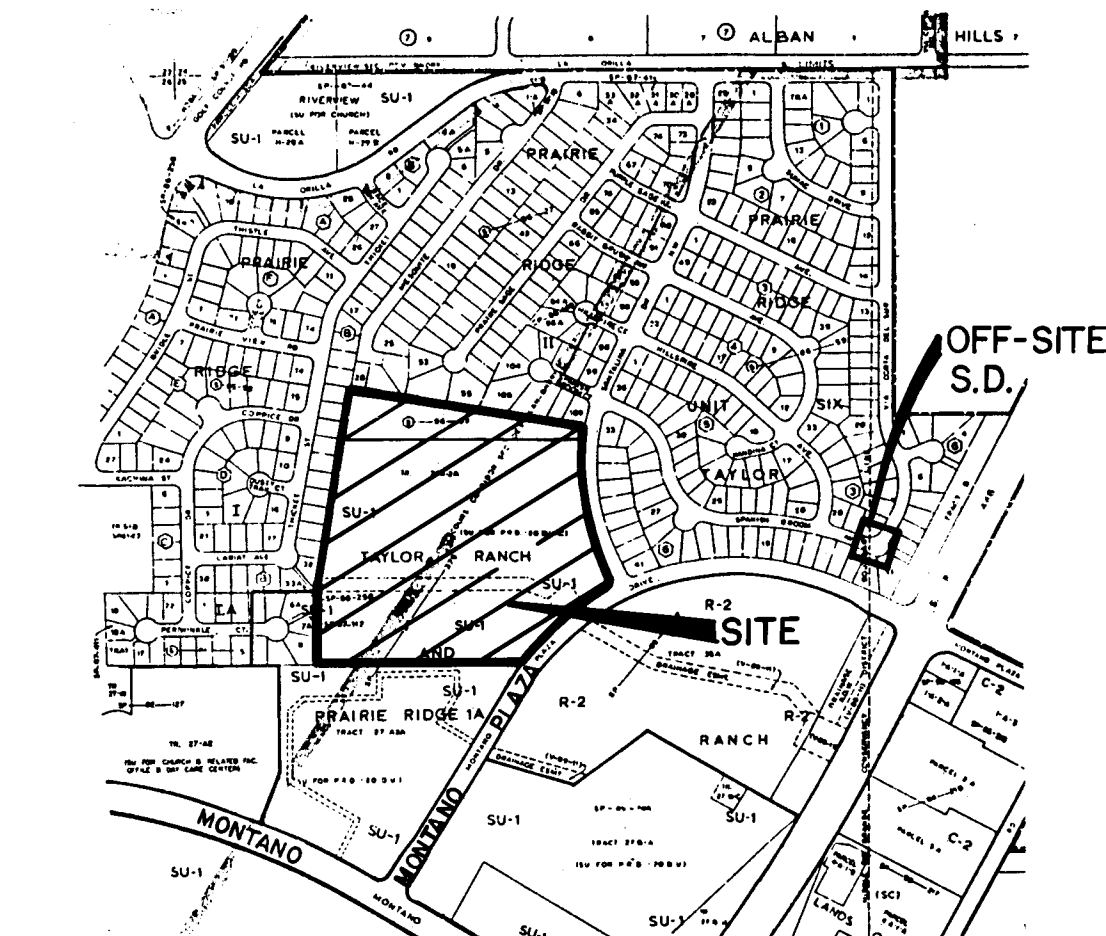

VICINITY MAP ZONE ATLAS E-12-7
SCALE: NONE

GENERAL NOTES

NOTICE TO CONTRACTORS

- CITY OF ALBUQUERQUE SPECIFICATIONS FOR PUBLIC WORKS CONSTRUCTION, 1986 EDITION WILL BE REFERRED TO HEREIN AS THE "STANDARD SPECIFICATIONS".
- TWO WORKING DAYS PRIOR TO ANY EXCAVATION, CONTRACTOR MUST CONTACT NEW MEXICO ONE CALL SYSTEM (260-1990) AND DETERMINE LOCATION OF EXISTING UTILITIES.
- PRIOR TO ANY CONSTRUCTION, THE CONTRACTOR SHALL EXCAVATE AND VERIFY THE HORIZONTAL AND VERTICAL LOCATIONS OF ALL OBSTRUCTIONS. SHOULD A CONFLICT EXIST, THE CONTRACTOR SHALL NOTIFY THE ENGINEER OR THE SURVEYOR SO THAT THE CONFLICT CAN BE RESOLVED WITHOUT DELAY.
- THREE (3) WORKING DAYS PRIOR TO BEGINNING CONSTRUCTION THE CONTRACTOR SHALL SUBMIT TO THE CONSTRUCTION CO-ORDINATION DIVISION A DETAILED CONSTRUCTION SCHEDULE. TWO (2) WORKING DAYS PRIOR TO CONSTRUCTION THE CONTRACTOR SHALL OBTAIN A BARRICADE PERMIT FROM THE CONSTRUCTION CO-ORDINATION DIVISION. CONTRACTOR SHALL NOTIFY BARRICADE ENGINEER (768-2551) PRIOR TO OCCUPYING AN INTERSECTION. SEE SECTION 19 OF THE STANDARD SPECIFICATIONS.

THE FOLLOWING NOTES ALSO APPLY WHEN CHECKED

- ☐ ALL UTILITIES AND UTILITY SERVICE LINES SHALL BE INSTALLED PRIOR TO PAVING.
- ☐ BACKFILL COMPACTION SHALL BE ACCORDING TO SPECIFIED STREET USE.
- ☐ TACK COAT REQUIREMENTS SHALL BE DETERMINED BY THE CITY ENGINEER.
- ☐ SIDEWALK AND WHEELCHAIR RAMPS WITHIN THE CURB RETURNS SHALL BE CONSTRUCTED WHEREVER A NEW CURB RETURN IS CONSTRUCTED.
- ☐ IF CURB IS DEPRESSED FOR A DRIVEPAD, THE DRIVEPAD SHALL BE CONSTRUCTED PRIOR TO ACCEPTANCE OF CURB AND GUTTER.
- ☐ ALL STORM DRAINAGE FACILITIES SHALL BE COMPLETED PRIOR TO FINAL ACCEPTANCE.
- ☐ THE REQUESTOR OR DEVELOPER SHALL BE RESPONSIBLE FOR REPAIR OR REPLACEMENT OF ALL CURB AND GUTTER OR SIDEWALK DAMAGE AFTER APPROVAL BY THE CITY ENGINEER OR WORK COMPLETED BY THE CONTRACTOR.

LEGEND

	NEW CURB & GUTTER
	WATERLINE
	SANITARY SEWER
	PROPERTY LINE
	CONTOUR
	WATER VALVE
	WATER METER
	SANITARY SEWER MANHOLE
	STORM SEWER MANHOLE
	FINISHED FLOOR
	PROPOSED SPOT ELEVATION

INDEX TO DRAWINGS

SHEET NO.	TITLE
1	TITLE SHEET
2	PLAT
3	GRADING PLAN
4	MASTER PAVING PLAN
5-10	PAVING PLAN & PROFILES
11	MASTER UTILITY PLAN
12-17	UTILITY PLAN & PROFILES

26 4467.900192

APPROVAL OF AS BUILT DRAWINGS
CHIEF CONSTRUCTION ENGINEER
DATE 11-20-92

RECORD DRAWING

I hereby certify that the information contained on this drawing has been revised in accordance with information furnished by the Contractor, CCM, Inc., and by the Surveyor, Aldrich Land Surveying Company, and reflects the construction as actually accomplished. This plan as constructed is in close compliance with the Approved Plan.



Mark Goodyin, NMPE 8948


dmg D. MARK GOODWIN & ASSOCIATES, P.A.
CONSULTING ENGINEERS & SURVEYORS
P. O. BOX 90606
ALBUQUERQUE, NEW MEXICO 87199
(505) 828-2200

REV.	SHEETS	CITY ENGINEER	DATE	USER DEPT.	DATE	USER DEPT.	DATE

APPROVAL OF REVISIONS

	APPROVED FOR CONSTRUCTION
	PROJECT NO. 4467.90
SHEET 1 OF 17	

SCANNED BY
BY LASON

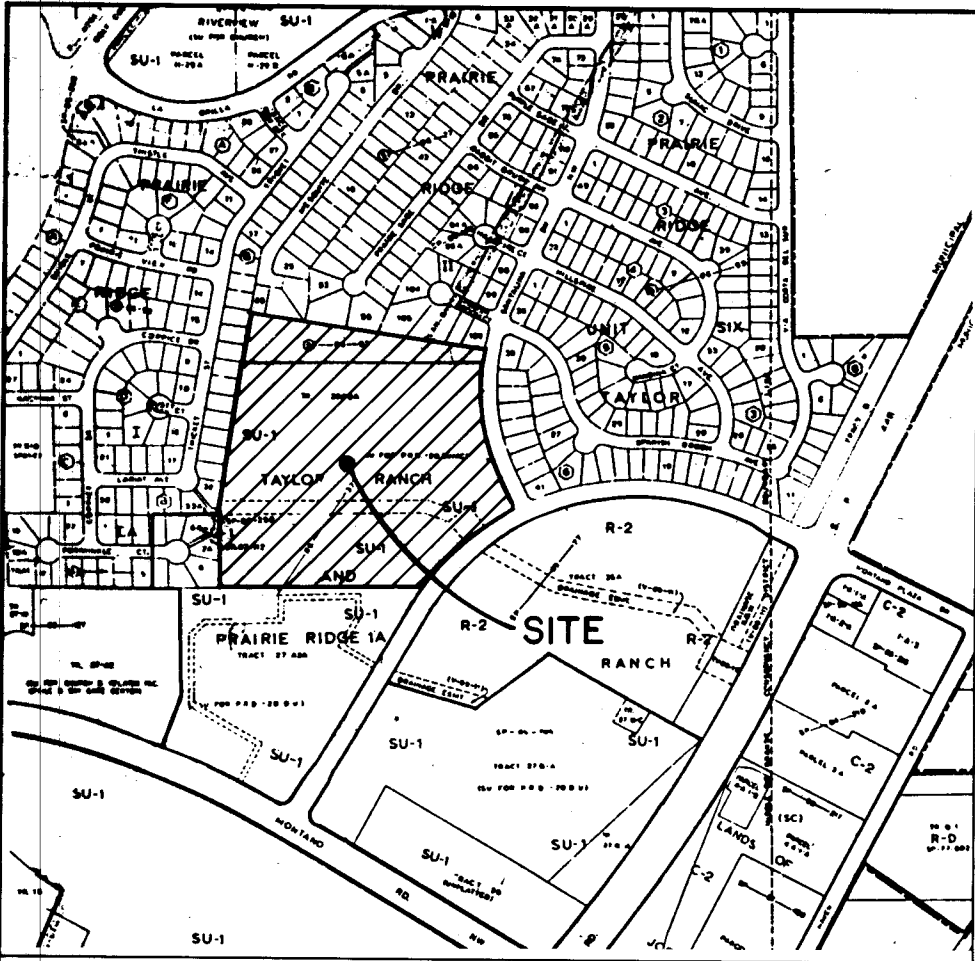

LOCATION MAP ZONE ATLAS MAP NO. E-12-Z
NOT TO SCALE

SUBDIVISION DATA

PLAT CASE NOS. DRB.92-0089, SP.920010, V.92-0018
GROSS ACREAGE 21.5597
ZONE ATLAS NO. E-12-Z
NO. OF EXISTING TRACTS/LOTS 1
NO. OF TRACTS/LOTS CREATED 96
NO. OF TRACTS/LOTS ELIMINATED 0
MILES OF FULL WIDTH STREETS CREATED 0.7129
AREA DEDICATED TO CITY OF ALBUQUERQUE 4.3718
DATE OF SURVEY MARCH, 1992
UTILITY CONTROL LOCATION SYSTEM LOG NUMBER 9203130920001

NOTES


- THE PURPOSE OF THIS PLAT IS TO REPLAT TRACT 33A-2A INTO HUNTERS RIDGE SUBDIVISION, COMPRISED OF 95 RESIDENTIAL LOTS, AND TO VACATE THE DRAINAGE EASEMENT NOW RUNNING THROUGH THE PROPERTY.
- BASIS OF BEARINGS IS FROM N.G.S. STATION 'HUGHES' AND ITS AZIMUTH MARK.
- PLAT SHOWS ALL EASEMENTS OF RECORD.
- ALL BEARINGS ARE GRID. ALL DISTANCES ARE GROUND.
- CITY OF ALBUQUERQUE WATER AND SANITARY SEWER SERVICE TO HUNTERS RIDGE MUST BE VERIFIED AND COORDINATED WITH THE PUBLIC WORKS DEPARTMENT, CITY OF ALBUQUERQUE.
- VACATION ORDINANCE NO. 92-0018

FREE CONSENT AND DEDICATION

THE SUBDIVISION OF THE LAND HEREIN DESCRIBED IS WITH THE FREE CONSENT AND IN ACCORDANCE WITH THE WISHES AND DESIRES OF THE UNDERSIGNED OWNER(S) AND PROPRIETOR(S) THEREOF, AND SAID OWNER(S) AND PROPRIETOR(S) DO HEREBY DEDICATE THE STREET AND DRAINAGE RIGHT-OF-WAY TO THE CITY OF ALBUQUERQUE, IN FEE SIMPLE AND GRANT THE EASEMENTS AS SHOWN ON THIS PLAT ALONG WITH THE RIGHT OF INGRESS AND EGRESS AND THE RIGHT TO TRIM INTERFERING TREES.

OWNER(S) JOE E. MOCK MOCK HOMES, INC.
OWNER'S ACKNOWLEDGMENT

STATE OF NEW MEXICO
COUNTY OF BERNALILLO

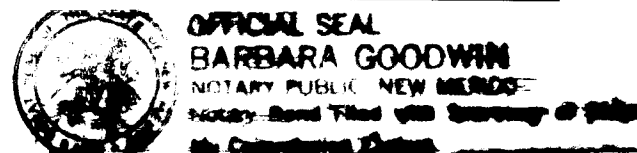

THE FOREGOING INSTRUMENT WAS ACKNOWLEDGED BEFORE ME ON THIS

24 DAY OF March, 1992.

Barbara Goodwin
NOTARY PUBLIC

10-1-94
MY COMMISSION EXPIRES

LEGAL DESCRIPTION

THAT CERTAIN TRACT OF LAND SITUATE WITHIN SECTION 25, T11N, R2E, N.M.P.M., CITY OF ALBUQUERQUE, BERNALILLO COUNTY, NEW MEXICO, BEING AND COMPRISING TRACT 33A-2A AS SUCH TRACT IS SHOWN AND SO DESIGNATED ON THE PLAT OF TRACTS 27-A3A & 33A-2A TAYLOR RANCH AND LOTS 8A & 9A PRAIRIE RIDGE 1A FILED IN THE OFFICE OF THE BERNALILLO COUNTY CLERK ON OCTOBER 20, 1986, VOL. C-31, FOLIO 176 AND BEING MORE PARTICULARLY DESCRIBED AS FOLLOWS.

BEGINNING AT THE NORTHEAST CORNER OF THE TRACT HEREIN DESCRIBED, SAID POINT BEING A POINT ON A CURVE, AND THE SOUTHEAST CORNER OF PRAIRIE RIDGE II, TAYLOR RANCH, FILED IN THE OFFICE OF THE BERNALILLO COUNTY CLERK ON DECEMBER 30, 1986, VOL. C-32, FOLIO 117, WHENCE N.G.S. STATION 'HUGHES' BEARS N48°29'51"E, 2945.94 FEET, AND RUNNING ALONG SAID CURVE; THENCE,

SOUTHEASTERLY, 507.45 FEET ALONG THE ARC OF A CURVE BEARING TO THE LEFT, SAID ARC HAVING A DELTA OF 23°01'48", A RADIUS OF 830.00 FEET AND A LONG CHORD BEARING S08°25'27"E, 499.59 FEET TO A POINT OF TANGENCY; THENCE,

S25°56'21"E, 97.66 FEET TO A POINT OF CURVATURE; THENCE,

SOUTHWESTERLY, 37.92 FEET ALONG THE ARC OF A CURVE BEARING TO THE RIGHT, SAID ARC HAVING A DELTA OF 86°54'05", A RADIUS OF 25.00 FEET AND A LONG CHORD BEARING S17°30'41"W, 34.39 FEET TO A POINT OF REVERSE CURVE; THENCE,

SOUTHWESTERLY, 412.33 FEET ALONG THE ARC OF A CURVE BEARING TO THE LEFT, SAID ARC HAVING A DELTA OF 23°48'11", A RADIUS OF 992.52 FEET AND A LONG CHORD BEARING S49°03'39"W, 409.37 FEET TO A POINT ON THE CURVE AND THE SOUTHEAST CORNER OF THE TRACT HEREIN DESCRIBED; THENCE,

N52°50'26"W, 5.54 FEET; THENCE, N89°46'49"W, 596.96 FEET; THENCE, N86°51'23"W, 42.74 FEET; THENCE, S89°50'50"W, 188.40 FEET TO THE SOUTHWEST CORNER; THENCE, N00°13'11"E, 270.44 FEET; THENCE, N10°48'58"E, 761.40 FEET TO THE NORTHWEST CORNER; THENCE,

S80°54'33"E, 904.66 FEET TO THE NORTHEAST CORNER AND POINT OF BEGINNING OF THE TRACT HEREIN DESCRIBED AND CONTAINING 21.5597 ACRES MORE OR LESS.

ACCEPTED BY:

US WEST COMMUNICATIONS
PUBLIC SERVICE COMPANY OF NEW MEXICO

GAS COMPANY OF NEW MEXICO

JONES INTERCABLE INC.

3-25-92
DATE

3-26-92
DATE

3-25-92
DATE

DATE

APPROVED AND ACCEPTED BY:

TRAFFIC ENGINEER, TRANSPORTATION DEPARTMENT

DATE

PARKS AND RECREATION DEPARTMENT

DATE

CITY SURVEYOR, ENGINEERING DIVISION

DATE

WATER RESOURCES DEPARTMENT

DATE

PROPERTY MANAGEMENT

DATE

ALBUQUERQUE METROPOLITAN ARROYO FLOOD CONTROL AUTHORITY

DATE

CITY ENGINEER, ENGINEERING DIVISION

DATE

APPROVAL AND CONDITIONAL ACCEPTANCE as specified by the Albuquerque Subdivision Ordinance, Article XI of Chapter 7 of the Revised Ordinances of Albuquerque, New Mexico.

CITY PLANNER, ALBUQUERQUE/BERNALILLO COUNTY PLANNING DIVISION

DATE

SURVEYOR'S CERTIFICATION

I, RICHARD A. BORDEL, A REGISTERED PROFESSIONAL LAND SURVEYOR, LICENSED UNDER THE LAWS OF THE STATE OF NEW MEXICO, DO HEREBY CERTIFY THAT THIS PLAT WAS PREPARED BY ME OR UNDER MY DIRECTION FROM NOTES OF ACTUAL FIELD SURVEYS PERFORMED BY ME, IS TRUE AND CORRECT TO THE BEST OF MY KNOWLEDGE AND BELIEF, MEETS THE MINIMUM REQUIREMENTS MONUMENTATION AND SURVEYS OF THE ALBUQUERQUE SUBDIVISION ORDINANCE AND THE STATE BOARD OF REGISTRATION FOR PROFESSIONAL ENGINEERS AND LAND SURVEYORS FOR LAND SURVEYS IN THE STATE OF NEW MEXICO.


Richard A. Borge
RICHARD A. BORDEL, R.P.L.S. NO. 7429

3-23-92
DATE



HUNTERS RIDGE SUBDIVISION	
D. MARK GOODWIN & ASSOCIATES, P.A. CONSULTING ENGINEERS & SURVEYORS P.O. BOX 90606 ALBUQUERQUE, NEW MEXICO 87199 (505) 828-2200	
Designed: RAB	Drawn: DSP
Scale: 1"=20'	Date: 3/92
Checked: RAB	Job: 9217
Sheet	of
1	2

DSP 9217A

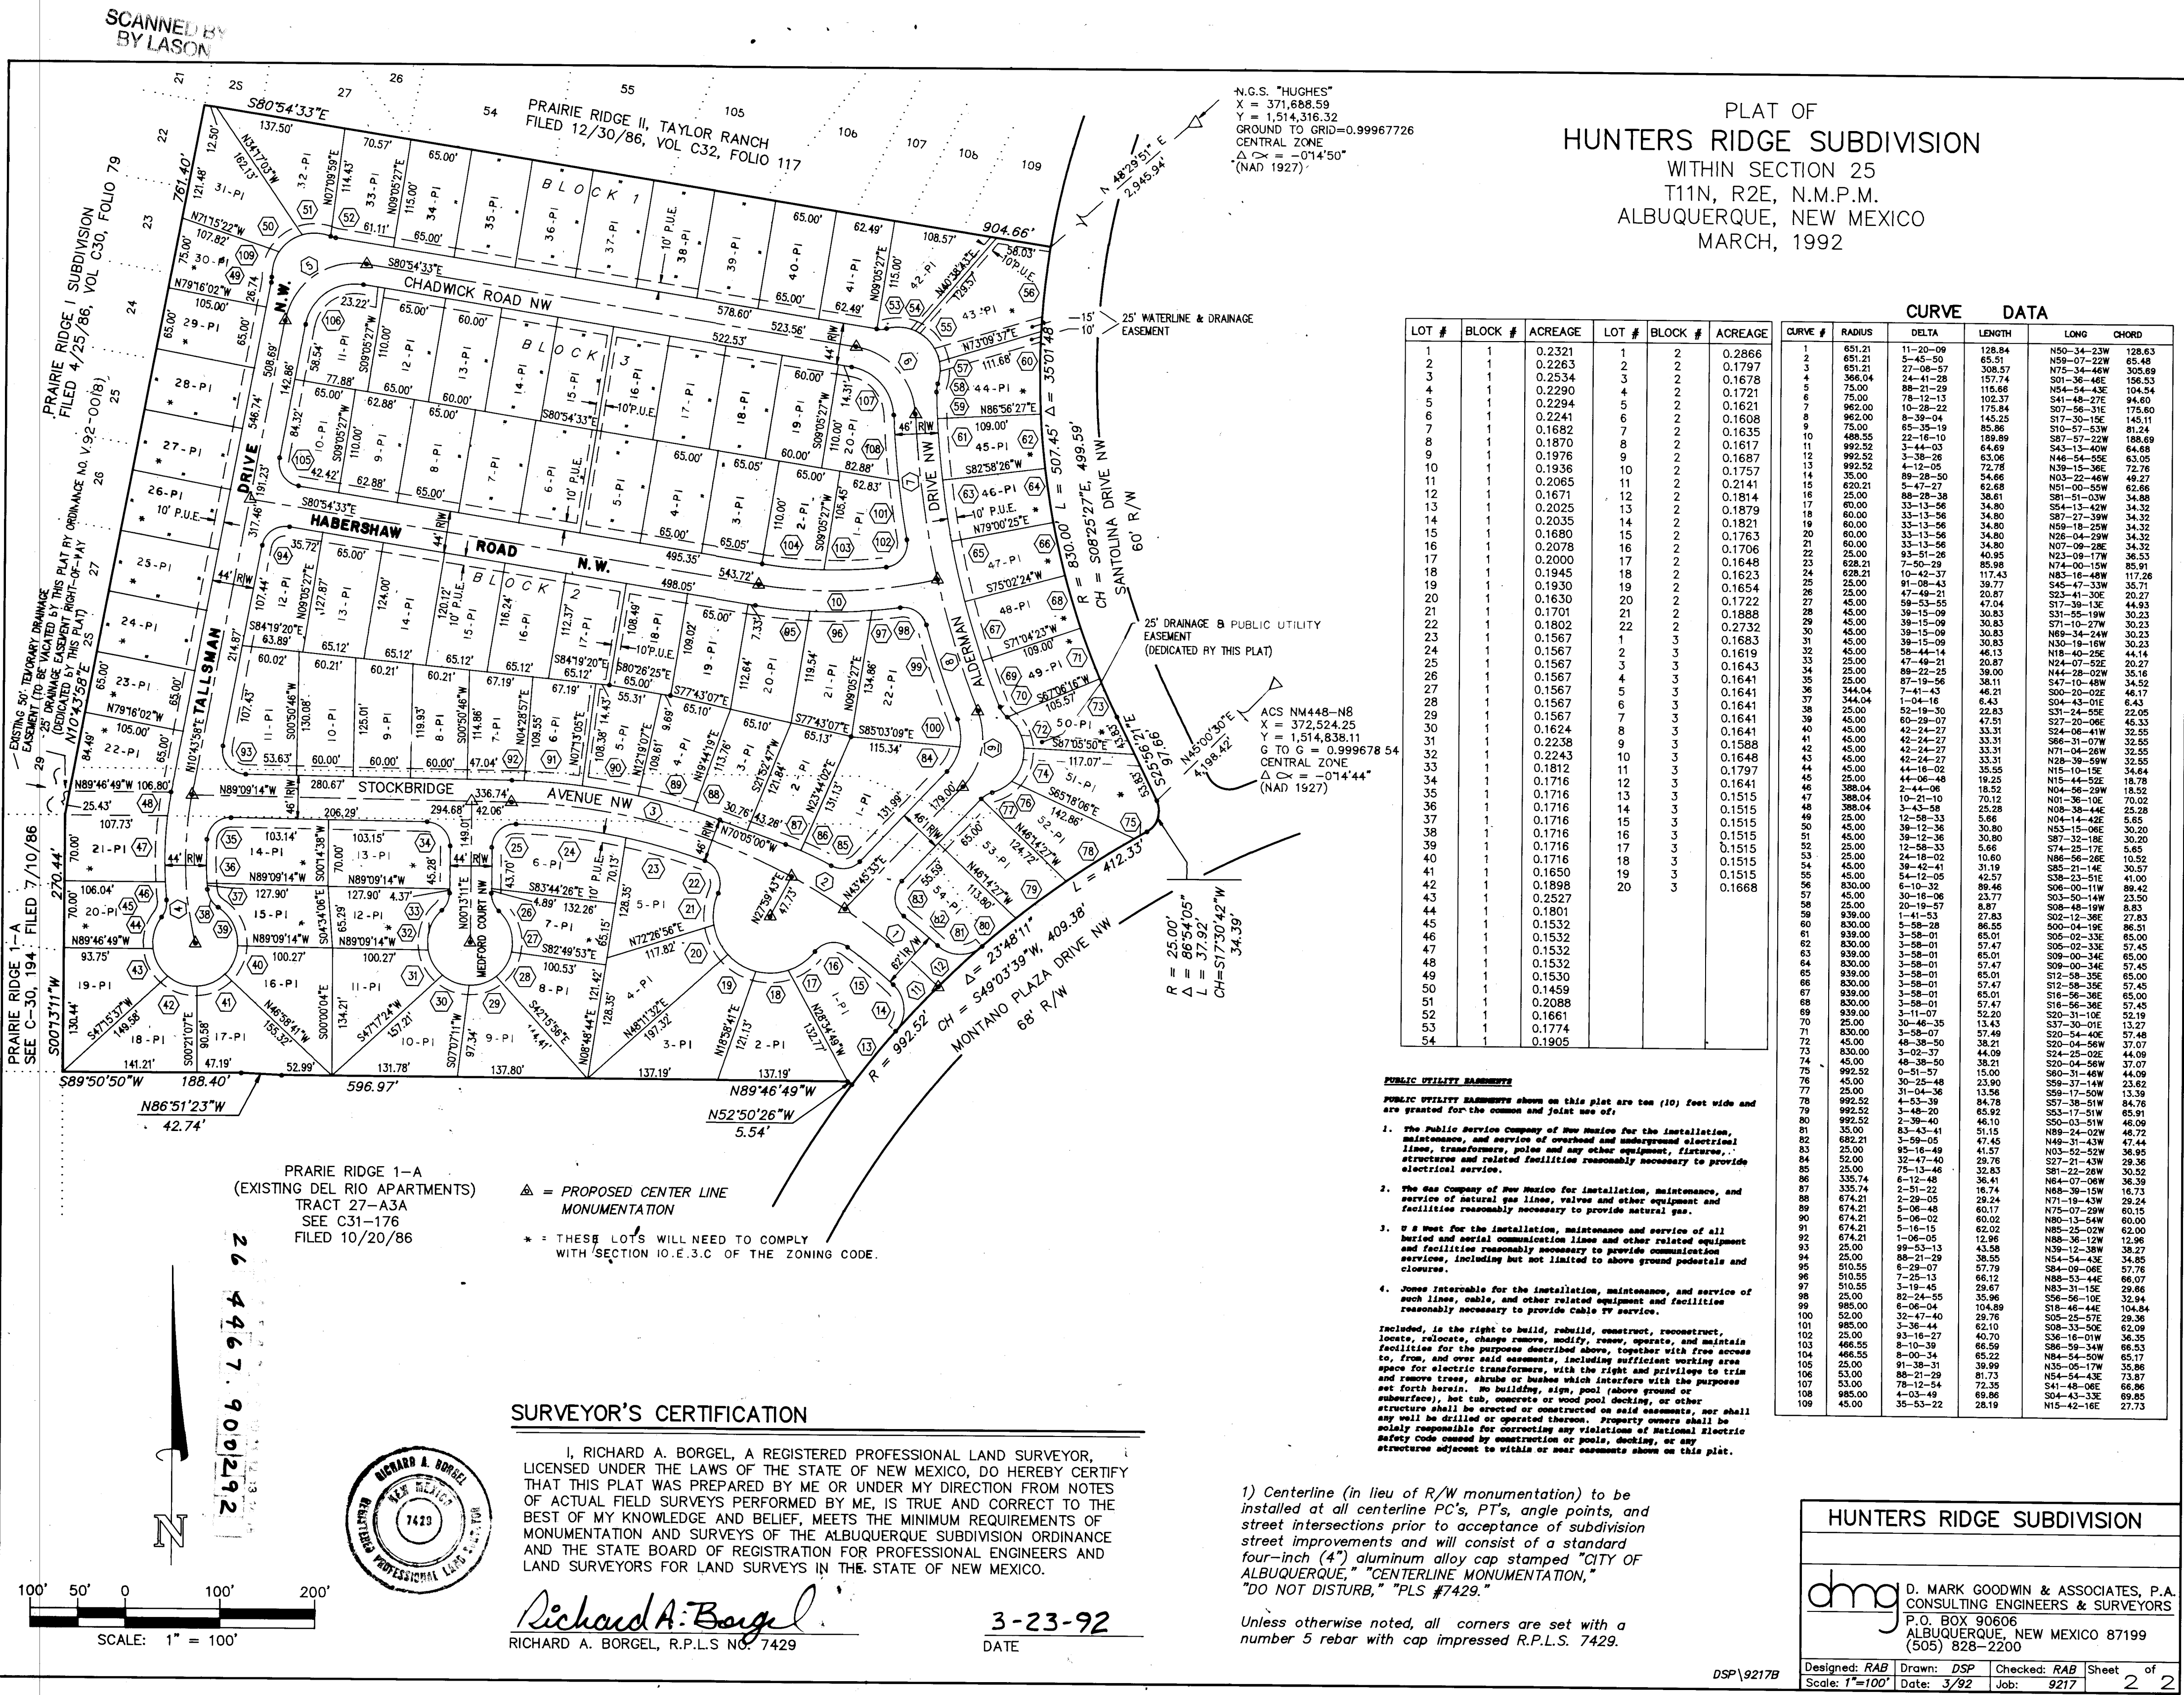

SURVEYOR'S CERTIFICATION

I, RICHARD A. BORDEL, A REGISTERED PROFESSIONAL LAND SURVEYOR, LICENSED UNDER THE LAWS OF THE STATE OF NEW MEXICO, DO HEREBY CERTIFY THAT THIS PLAT WAS PREPARED BY ME OR UNDER MY DIRECTION FROM NOTES OF ACTUAL FIELD SURVEYS PERFORMED BY ME, IS TRUE AND CORRECT TO THE BEST OF MY KNOWLEDGE AND BELIEF, MEETS THE MINIMUM REQUIREMENTS MONUMENTATION AND SURVEYS OF THE ALBUQUERQUE SUBDIVISION ORDINANCE AND THE STATE BOARD OF REGISTRATION FOR PROFESSIONAL ENGINEERS AND LAND SURVEYORS FOR LAND SURVEYS IN THE STATE OF NEW MEXICO.

Richard A. Borge
RICHARD A. BORDEL, R.P.L.S. NO. 7429

3-23-92
DATE

1) Centerline (in lieu of R/W monumentation) to be installed at all centerline PC's, PT's, angle points, and street intersections prior to acceptance of subdivision street improvements and will consist of a standard four-inch (4") aluminum alloy cap stamped "CITY OF ALBUQUERQUE, CENTERLINE MONUMENTATION," "DO NOT DISTURB," "PLS #7429."

Unless otherwise noted, all corners are set with a number 5 rebar with cap impressed R.P.L.S. 7429.

DSP 9217B

HUNTERS RIDGE SUBDIVISION	
D. MARK GOODWIN & ASSOCIATES, P.A. CONSULTING ENGINEERS & SURVEYORS P.O. BOX 90606 ALBUQUERQUE, NEW MEXICO 87199 (505) 828-2200	
Designed: RAB	Drawn: DSP
Scale: 1"=100'	Date: 3/92
Checked: RAB	Job: 9217
Sheet	of
2	2

SCALE: 1"=60'

RECORD DRAWING

I hereby certify that the information contained on this drawing has been revised in accordance with information furnished by the Contractor, CCM, Inc., and by the Surveyor, Aldrich Land Surveying Company, and reflects the construction as actually accomplished. This plan as constructed is in close compliance with the Approved Plan.

Mark Goodwin, NMPE 8948
1/4/92



TYPICAL LOT LAYOUT
N.T.S.

SECTION
TYPICAL LOT LAYOUT
N.T.S.

- GENERAL NOTES
1. CONTRACTOR MUST OBTAIN A TOPSOIL DISTURBANCE PERMIT FROM THE ENVIRONMENTAL HEALTH DIVISION PRIOR TO CONSTRUCTION.
 2. CITY OF ALBUQUERQUE STANDARD SPECIFICATIONS FOR PUBLIC WORKS CONSTRUCTION, LATEST EDITION SHALL GOVERN ALL WORK.
 3. THE CONTRACTOR SHALL CONFORM TO ALL CITY, COUNTY, STATE AND FEDERAL DUST CONTROL MEASURES AND REQUIREMENTS AND WILL BE RESPONSIBLE FOR PREPARING AND OBTAINING ALL NECESSARY APPLICATIONS AND APPROVALS.
 4. THE CONTRACTOR SHALL ENSURE THAT NO SOIL ERODES FROM THE LOTS INTO PUBLIC RIGHT-OF-WAY. THIS CAN BE ACHIEVED BY CONSTRUCTING TEMPORARY BERMS AS PER DETAIL SHT. 2 AND WETTING THE SOIL TO KEEP IT FROM BLOWING.
 5. ALL LOTS WITH REAR YARD PONDS SHALL BE GRADED SUCH THAT ONLY THE REAR YARD SHALL DRAIN TO PONDS. ALL ROOFS SHALL DRAIN TO FRONT.
 6. SITE DOES NOT LIE WITHIN A FLOOD HAZARD ZONE.
 7. ALL RUBBLE, RIPRAP AND EXISTING DE-SILTING BASINS ARE TO BE REMOVED FROM SITE.

AS BUILT INFORMATION		BENCH MARKS		STATION MARK IS A STANDARD USGS BRASS TABLET, STAMPED	
CONTRACTOR	CCM	STATION MARK	"HUGHES 1954", SET IN TOP OF A CONCRETE POST PROJECTING 0.3 FT ABOVE THE GROUND. TO REACH THE STATION FROM THE INTERSECTION OF CENTRAL AVE. AND STATE RD. 448, GO NORTH ON STATE RD. 448, 6.1 MILES. THE STATION IS WEST OF THIS POINT.	DATE	DATE
WORK	ALS	INSPECTOR	MEGA	DATE	DATE
FIELD ENGINEER	ALS	CERTIFICATION BY	ALS	DATE	DATE
REVISIONS	ALS	CORRECTION BY	ALS	DATE	DATE
MICRO-FILM INFORMATION		RECORDED BY		NO.	

SURVEY INFORMATION		ENGINEER'S SEAL	
FIELD NOTES	NO.	DATE	DATE
BY	BY	DATE	DATE

DESIGNED BY	DWG	DATE	4/92
DRAWN BY	JMB	DATE	4/92
CHECKED BY	DWG	DATE	4/92

APPROVED FOR ROUGH GRADING
DATE 5-6-92

EARTHWORK QUANTITIES
EXCAVATION = 62,100 CU.YD.
COMPACTED EMBANKMENT = 58,200 CU.YD.

D. MARK GOODWIN & ASSOCIATES, P.A.
CONSULTING ENGINEERS & SURVEYORS
P.O. BOX 90606
ALBUQUERQUE, NEW MEXICO 87199
(505) 828-2200

CITY OF ALBUQUERQUE
PUBLIC WORKS DEPARTMENT
ENGINEERING GROUP


TITLE: HUNTERS RIDGE SUBDIVISION
GRADING PLAN

APPROVALS	ENGINEER	DATE	APPROVALS	ENGINEER	DATE
DRG CHAIRMAN	R. W. Kane	6/8/92	WATER	R. W. Kane	6-3-92
TRANSPORTATION	R. W. Kane	5-27-92	WASTE WATER	R. W. Kane	6-3-92
HYDROLOGY	R. W. Kane	5-27-92			




PROJECT NO.	4467.90	MAP NO.	E-12-Z	SHEET	3	OF	17
-------------	---------	---------	--------	-------	---	----	----

SCANNED BY
BY LASON


SCALE: 1"=60'

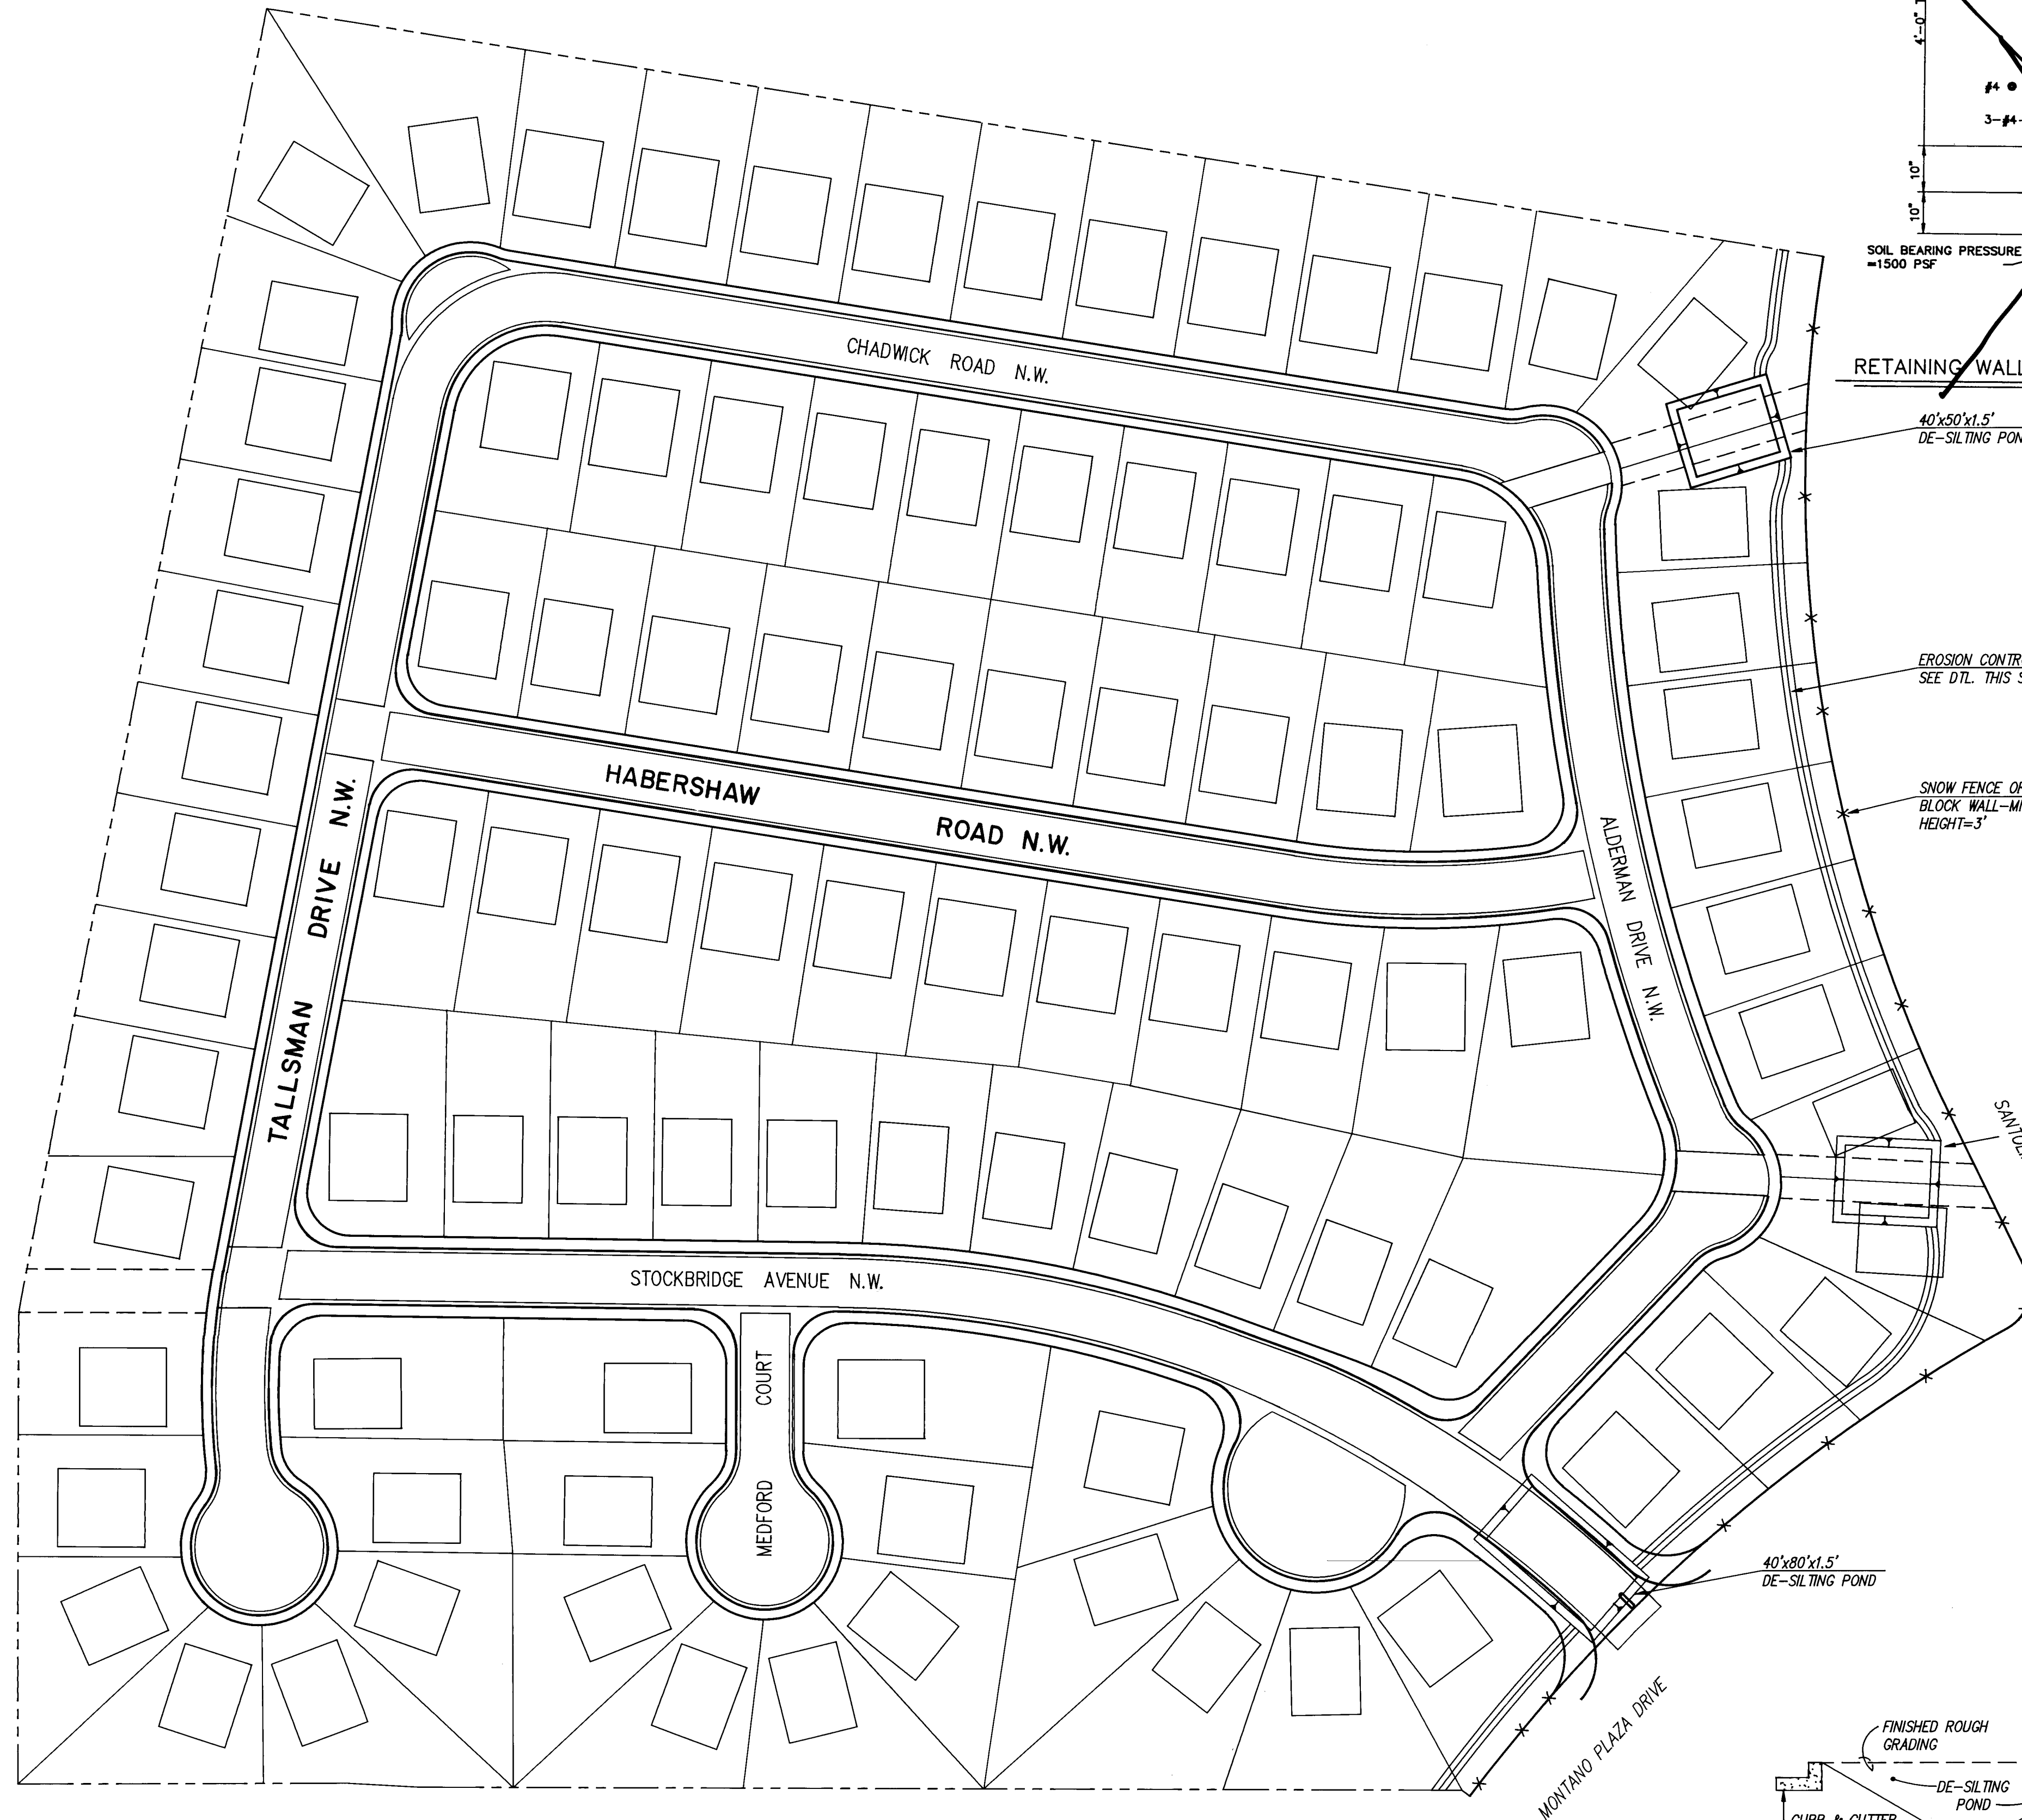

NOTES:
1. SOIL TYPE IS BLUEPOINT, TYPE "A"

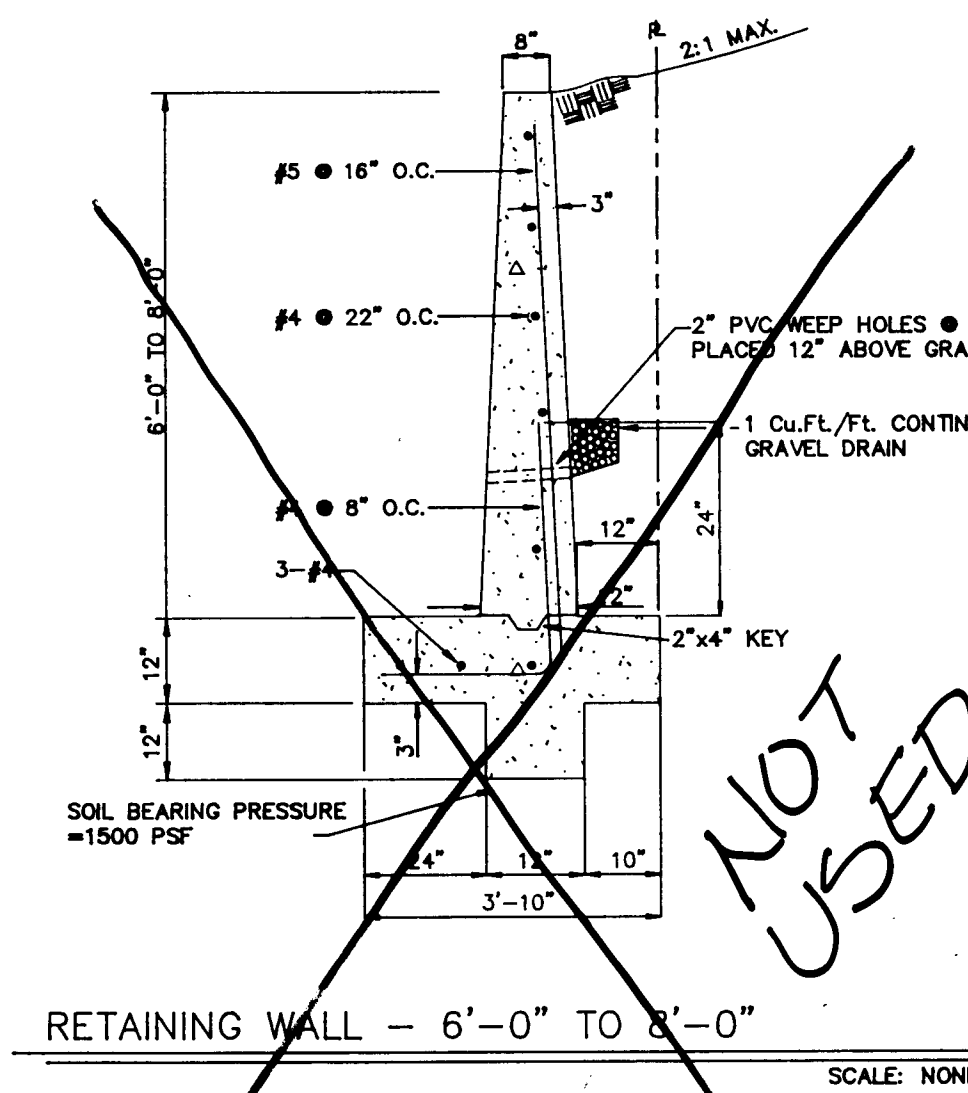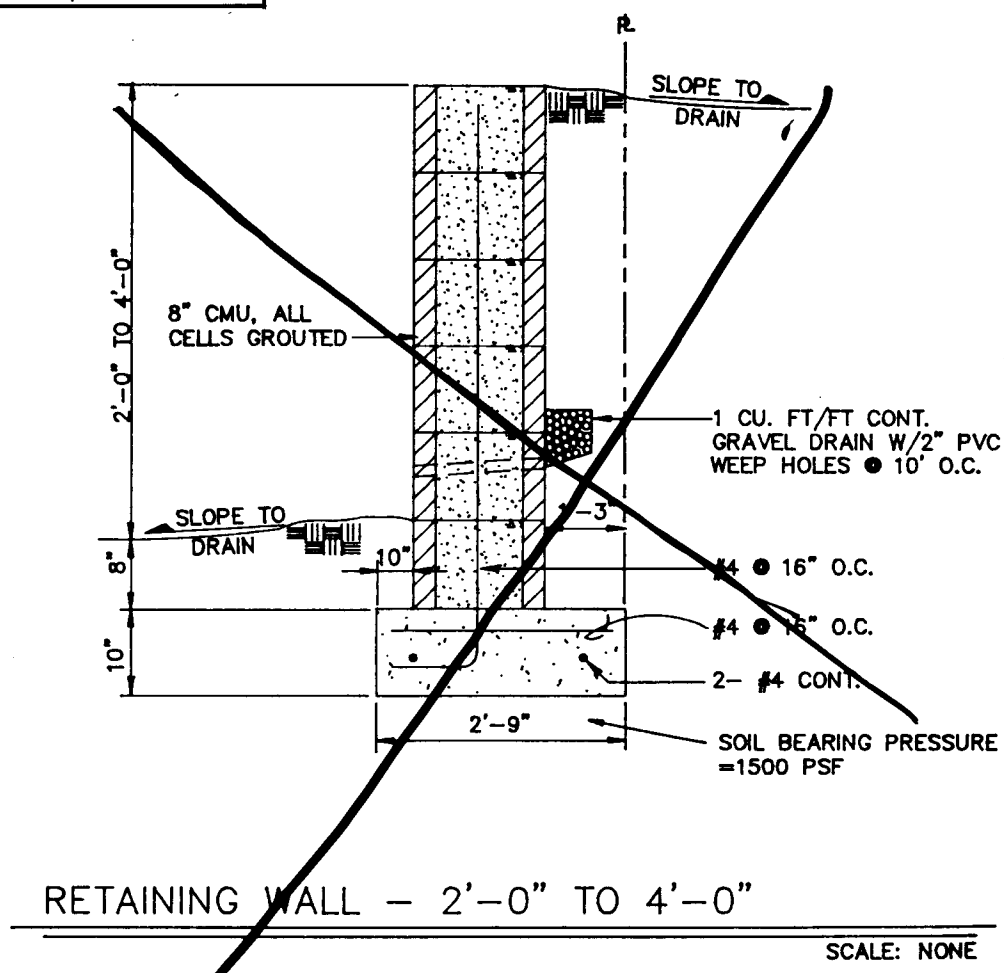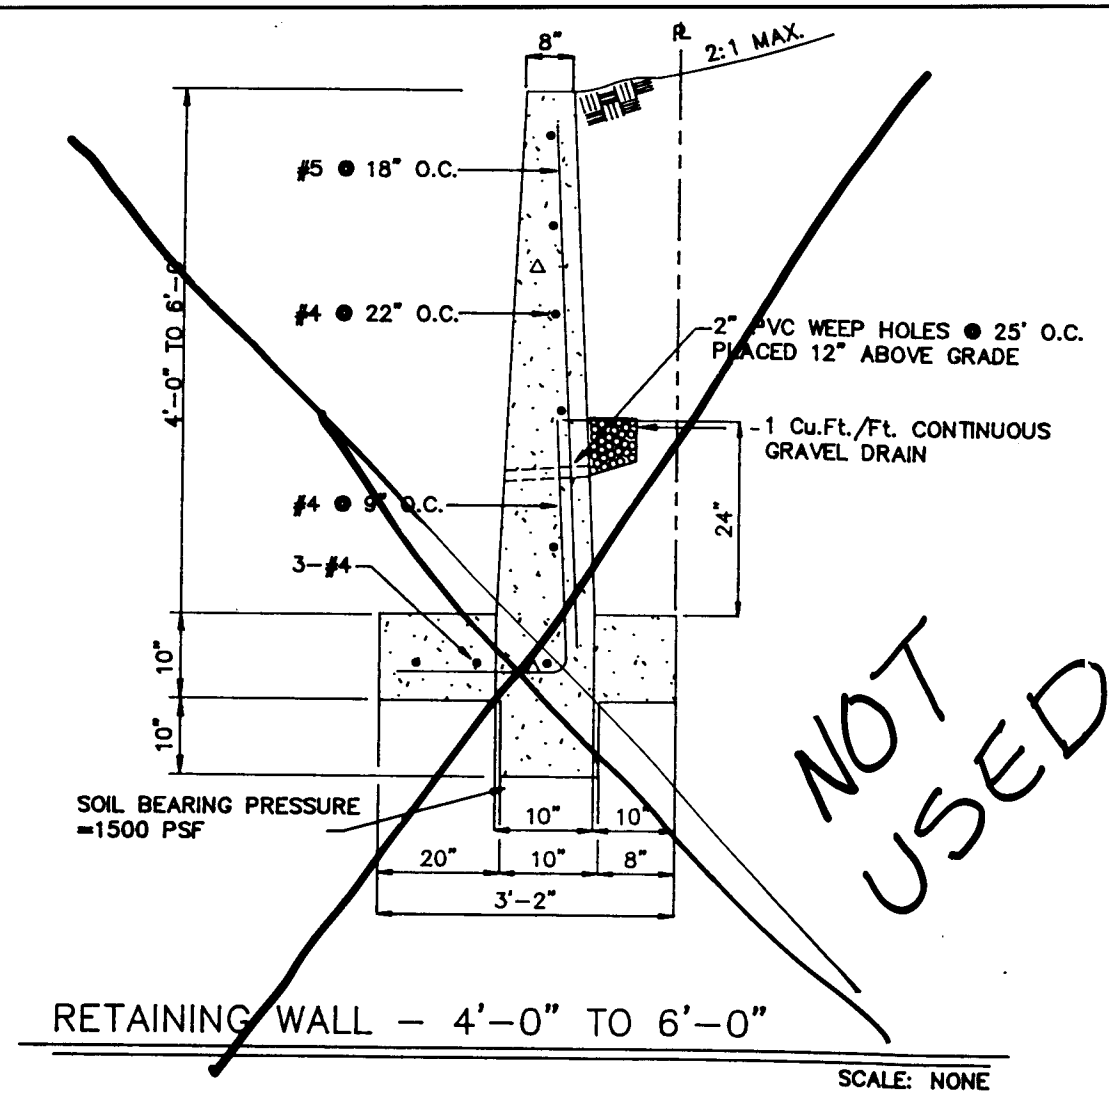


- GENERAL NOTES:
1. ALL CONCRETE IS TO BE 3000 PSI @ 28 DAYS.
 2. MINIMUM COMPACTION UNDER FOOTINGS IS TO BE 95% PER ASTM D 1557 FOR A DEPTH OF 12". MOISTURE CONTENT IS TO BE 2.0%.
 3. BACKFILL AGAINST WALLS IS TO BE HAND-PLACED AND COMPACTED.
 4. ALL BARS ARE TO BE GRADE 60, ASTM 615.
 5. 2'-0" TO 4'-0" WALL IS TO HAVE 12" CMU PILASTERS @ 12" CENTERS. PLACE NO. 4'S IN WITH CONCRETE. THIS WALL SECTION IS TO HAVE TRUSS TYPE DUR-O-WALL EVERY OTHER COURSE.

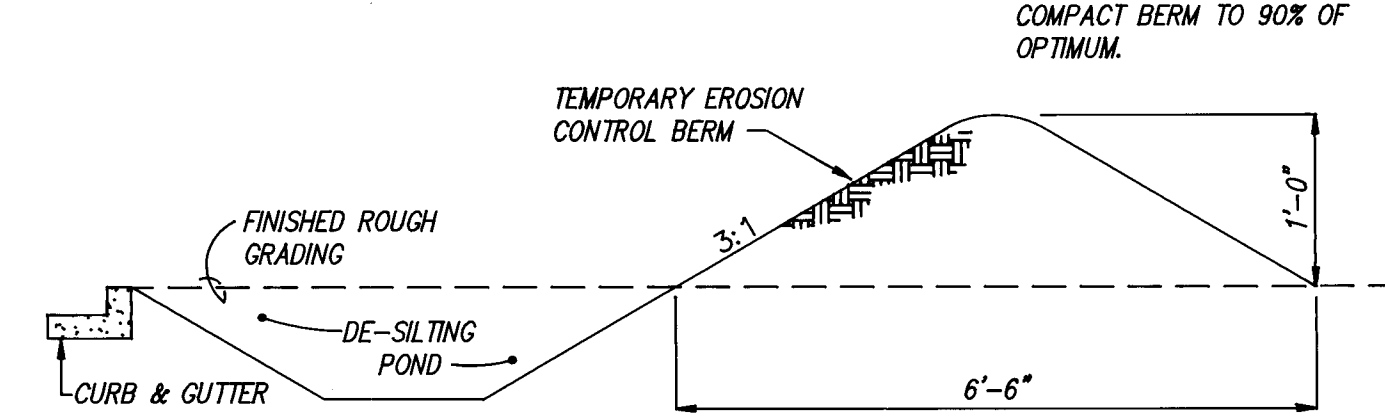

RECORD DRAWING

I hereby certify that the information contained on this drawing has been revised in accordance with information furnished by the Contractor, CCM, Inc., and by the Surveyor, Aldrich Land Surveying Company, and reflects the construction as actually accomplished. This plan as constructed is in close compliance with the Approved Plan.

Mark Goodwin, NMPE 8948

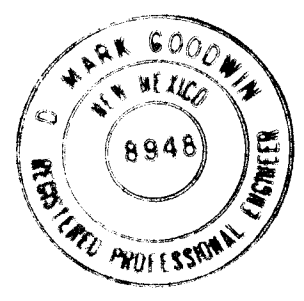

SECTION 26 4467.90 03924

EROSION CONTROL BERM DETAIL

N.T.S.


APPROVED FOR ROUGH GRADING

DATE 5-6-92


dmg D. MARK GOODWIN & ASSOCIATES, P.A.
CONSULTING ENGINEERS & SURVEYORS
P.O. BOX 90606
ALBUQUERQUE, NEW MEXICO 87199
(505) 828-2200

CITY OF ALBUQUERQUE PUBLIC WORKS DEPARTMENT ENGINEERING GROUP					
TITLE: HUNTERS RIDGE SUBDIVISION EROSION CONTROL PLAN					
APPROVALS	ENGINEER	DATE	APPROVALS	ENGINEER	DATE
DRC CHAIRMAN	R. W. Kane	6-3-92	WATER	R. W. Kane	6-3-92
TRANSPORTATION	R. W. Kane	5-22-92	WASTE WATER	R. W. Kane	6-3-92
HYDROLOGY	R. W. Kane	5-22-92			
PROJECT NO.	4467.90	MAP NO.	E-12-Z	SHEET OF	3A 17

SCANNED BY LASON

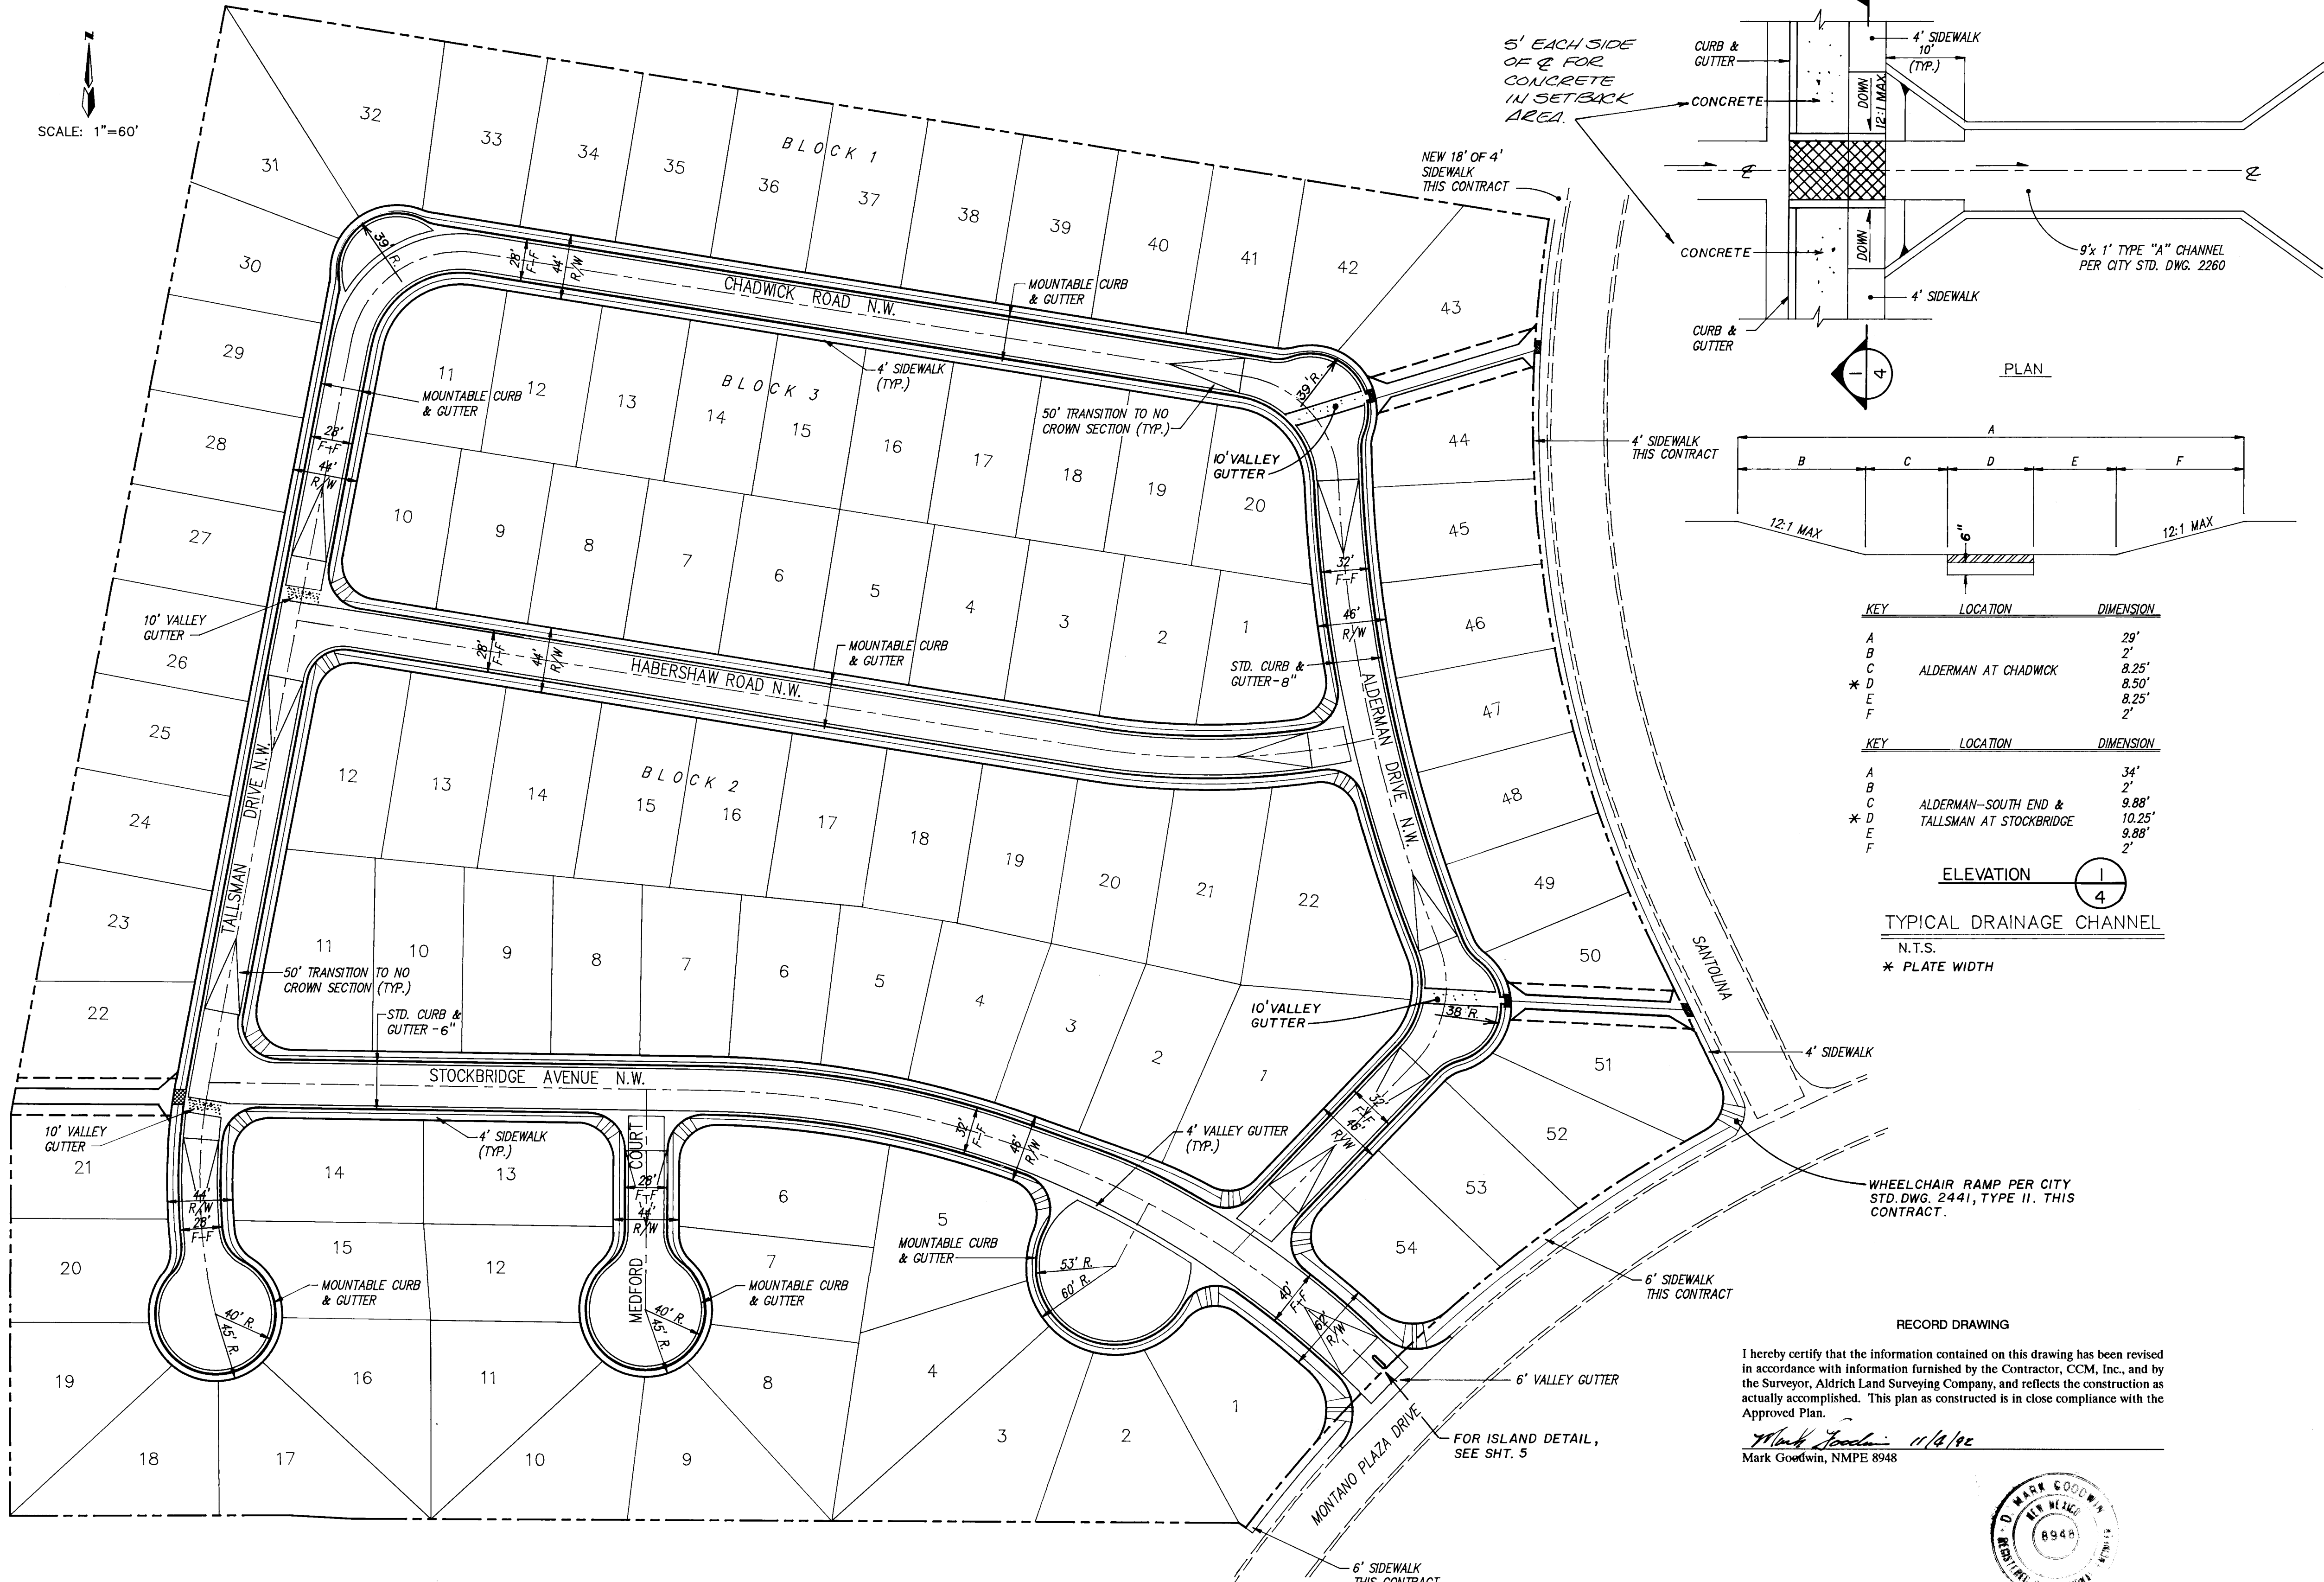

NOTES:
1. 4' SIDEWALK ON SANTOLINA AND 6' SIDEWALK ON MONTANO PLAZA DR. ARE TO BE CONSTRUCTED THIS PROJECT. ALL OTHER SIDEWALKS ARE DEFERRED.
2. UTILITY CROSSINGS ARE PART OF THIS PROJECT.

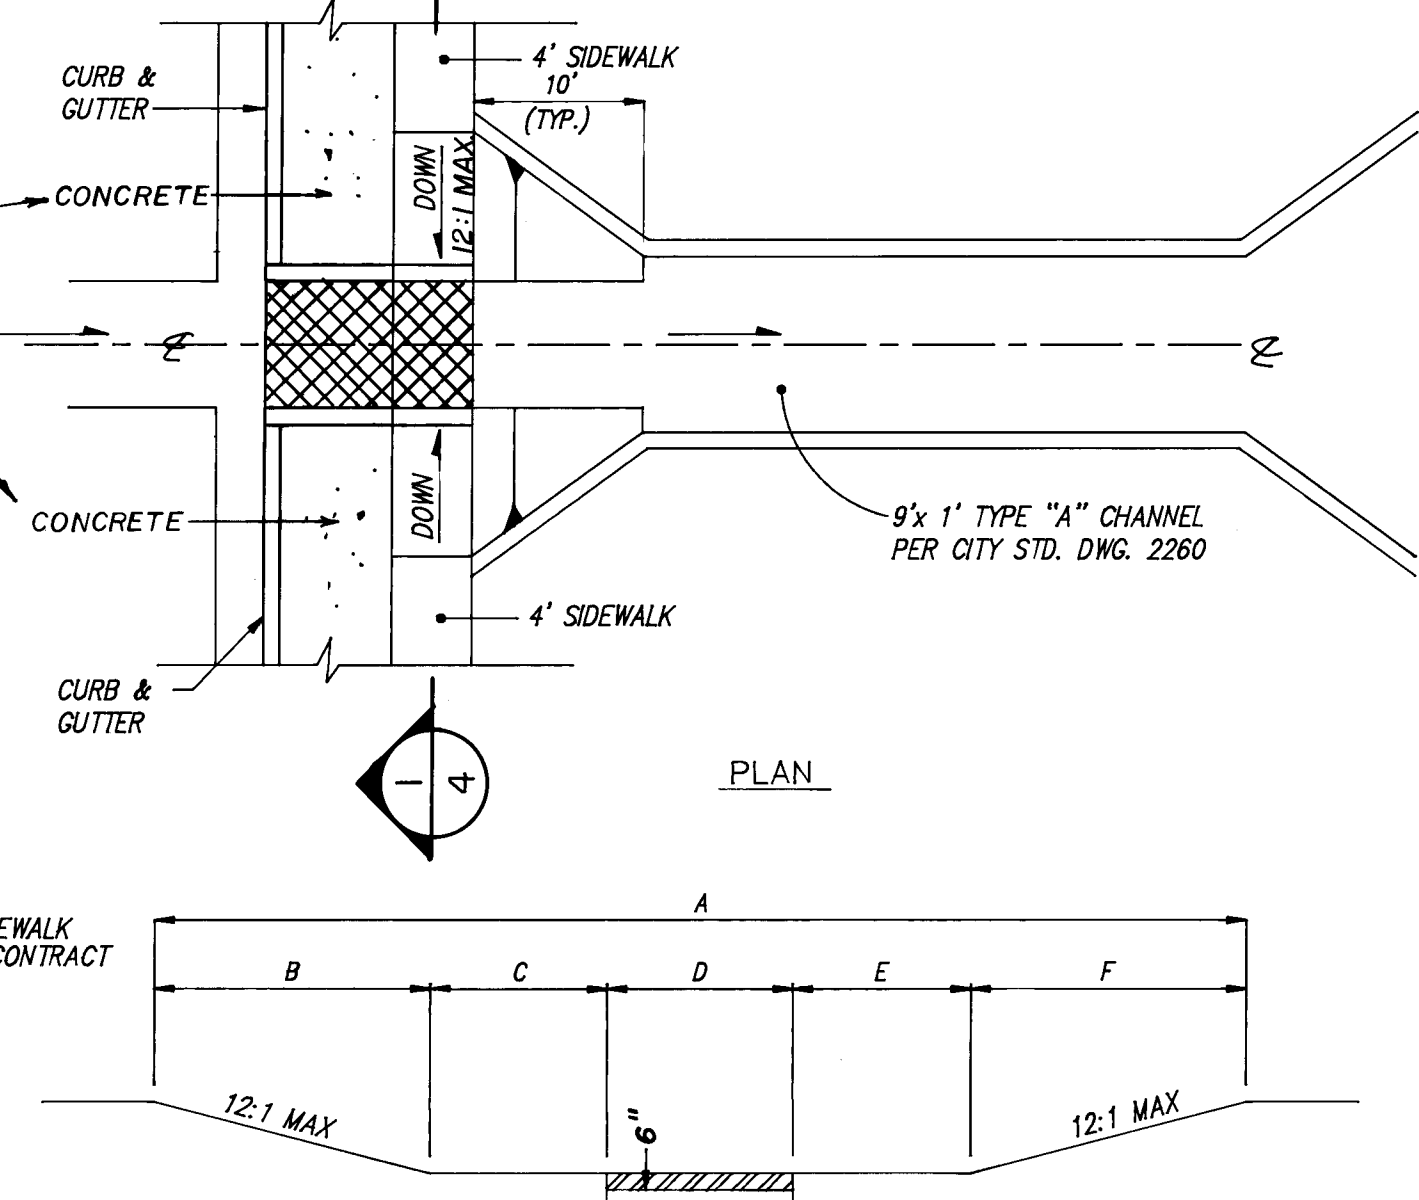


KEY	LOCATION	DIMENSION
A	ALDERMAN AT CHADWOK	29'
B		2'
C		8.25'
D		8.50'
E		8.25'
F		2'


KEY	LOCATION	DIMENSION
A	ALDERMAN-SOUTH END & TALLSMAN AT STOCKBRIDGE	34'
B		2'
C		9.88'
D		10.25'
E		9.88'
F		2'

ELEVATION 1/4
TYPICAL DRAINAGE CHANNEL
N.T.S.
* PLATE WIDTH


RECORD DRAWING
I hereby certify that the information contained on this drawing has been revised in accordance with information furnished by the Contractor, CCM, Inc., and by the Surveyor, Aldrich Land Surveying Company, and reflects the construction as actually accomplished. This plan as constructed is in close compliance with the Approved Plan.
Mark Goodwin, NMPE 8948

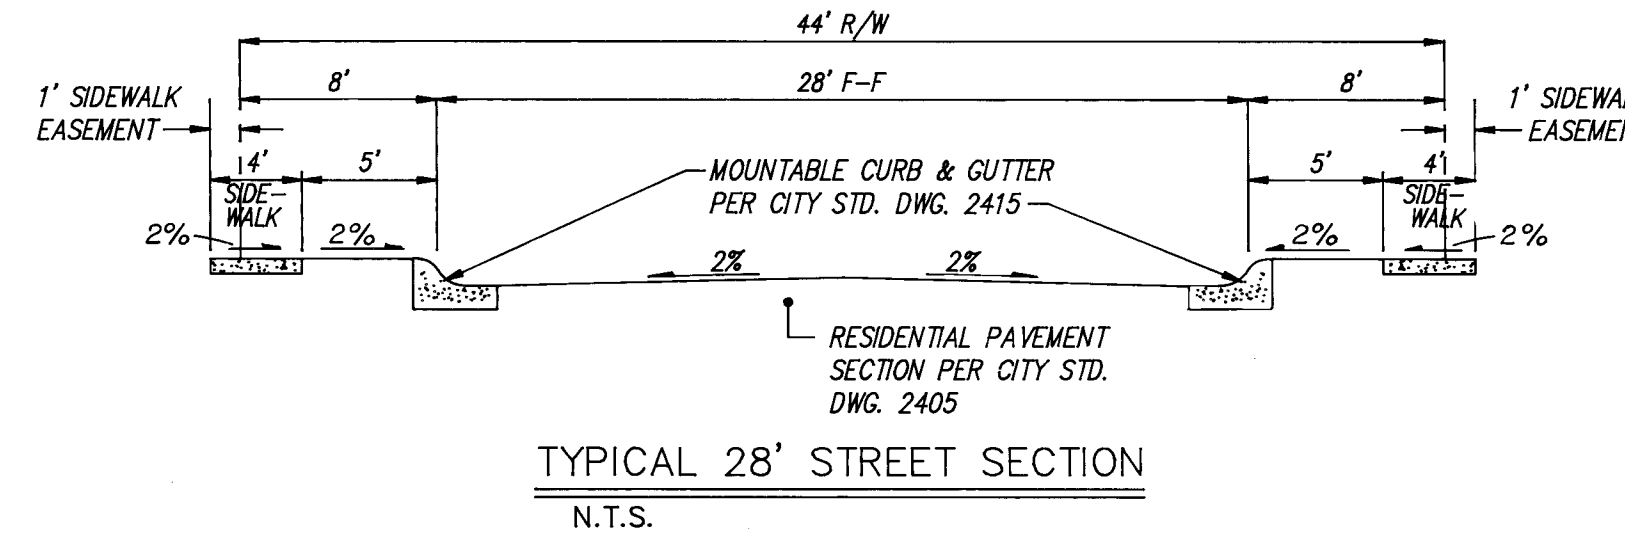

TYPICAL 28' STREET SECTION
N.T.S.

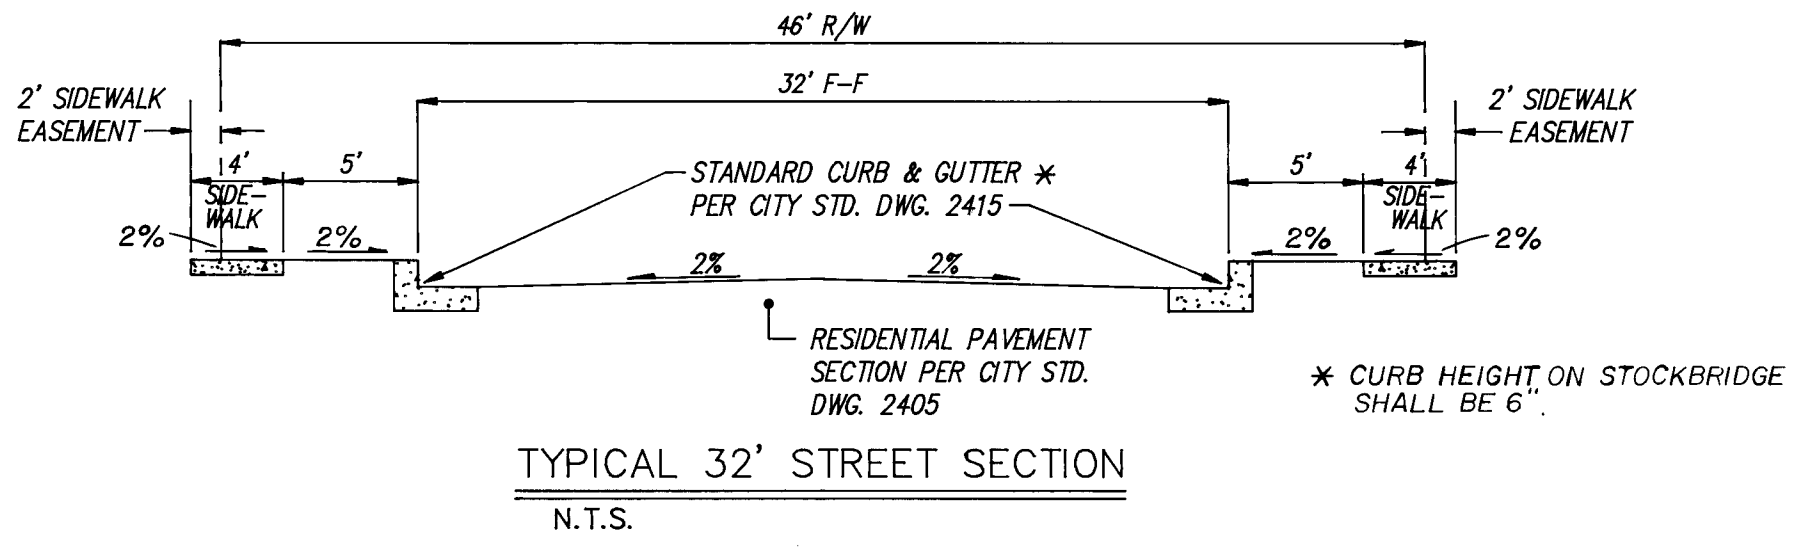

TYPICAL 32' STREET SECTION
N.T.S.

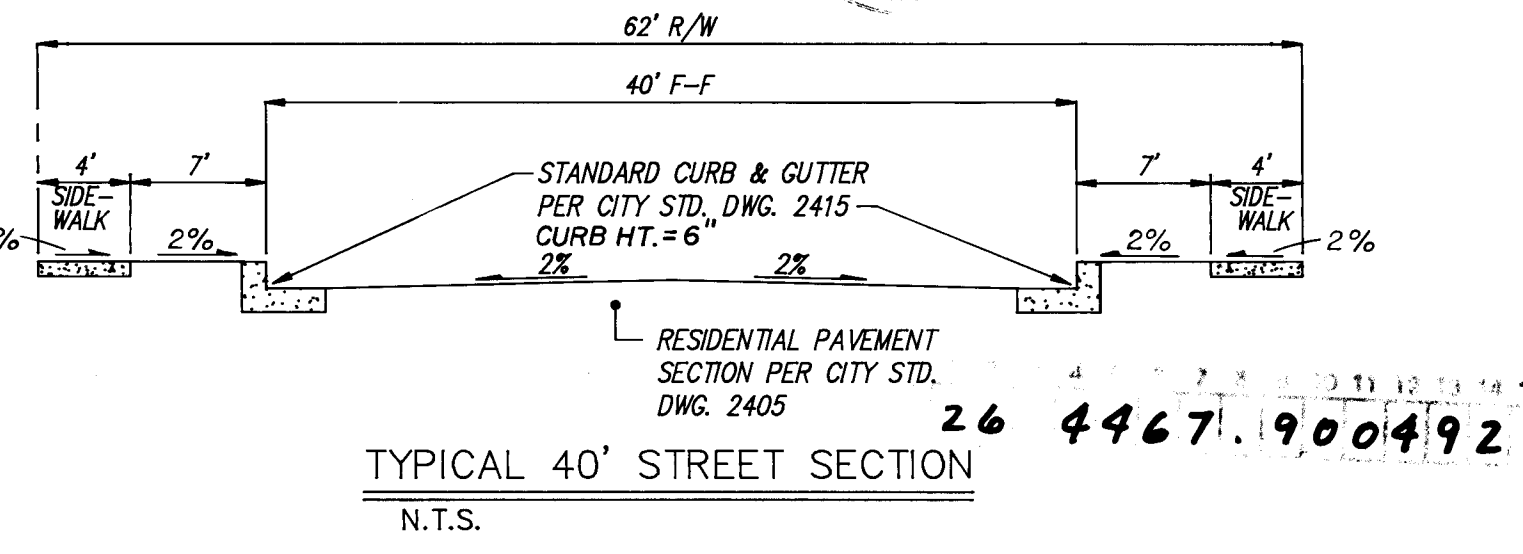


TYPICAL 40' STREET SECTION
N.T.S.

AS BUILT INFORMATION			BENCH MARKS			SURVEY INFORMATION			ENGINEER'S SEAL		
CONTRACTOR	WORK	DATE	STATION MARK	IS A STANDARD USCS&S BRASS TABLET, STAMPED	DATE	BY	NO.	937		REMARKS	BY
CCM	ALS	92	"HUGHES, 1964", SET IN TOP OF A CONCRETE POST PROJECTING 0.3 FT. ABOVE THE GROUND. TO REACH THE STATION FROM THE INTERSECTION OF CENTRAL AVE. AND STATE RD. 448, GO NORTH ON STATE RD. 448, 6.1 MILES. THE STATION IS WEST OF THIS POINT.	DATE	4/92	D.M.G.A.				DESIGN	DATE
CCM	ALS	92	FIELD VERIFICATION BY	DATE	4/92					REVISIONS	DATE
CCM	ALS	92	DRAWINGS	DATE	4/92					DESIGNED BY DMG	DATE
CCM	ALS	92	CORRECTED BY	DATE	4/92					DRAWN BY STAFF	DATE
CCM	ALS	92	MICRO-FILM INFORMATION	DATE	4/92					CHECKED BY DMG	DATE

dmg D. MARK GOODWIN & ASSOCIATES, P.A.
CONSULTING ENGINEERS & SURVEYORS
P.O. BOX 90606
ALBUQUERQUE, NEW MEXICO 87199
(505) 828-2200


CITY OF ALBUQUERQUE PUBLIC WORKS DEPARTMENT ENGINEERING GROUP					
TITLE: HUNTERS RIDGE SUBDIVISION MASTER PAVING PLAN					
APPROVALS	ENGINEER	DATE	APPROVALS	ENGINEER	DATE
DRC CHAIRMAN	R. W. Kane	6/8/92	WATER	R. W. Kane	6-3-92
TRANSPORTATION	R. W. Kane	5-27-92	WASTE WATER	R. W. Kane	6-3-92
HYDROLOGY	R. W. Kane	5-27-92			
PROJECT NO.	4467.90	MAP NO.	E-12-Z	SHEET OF	4 17

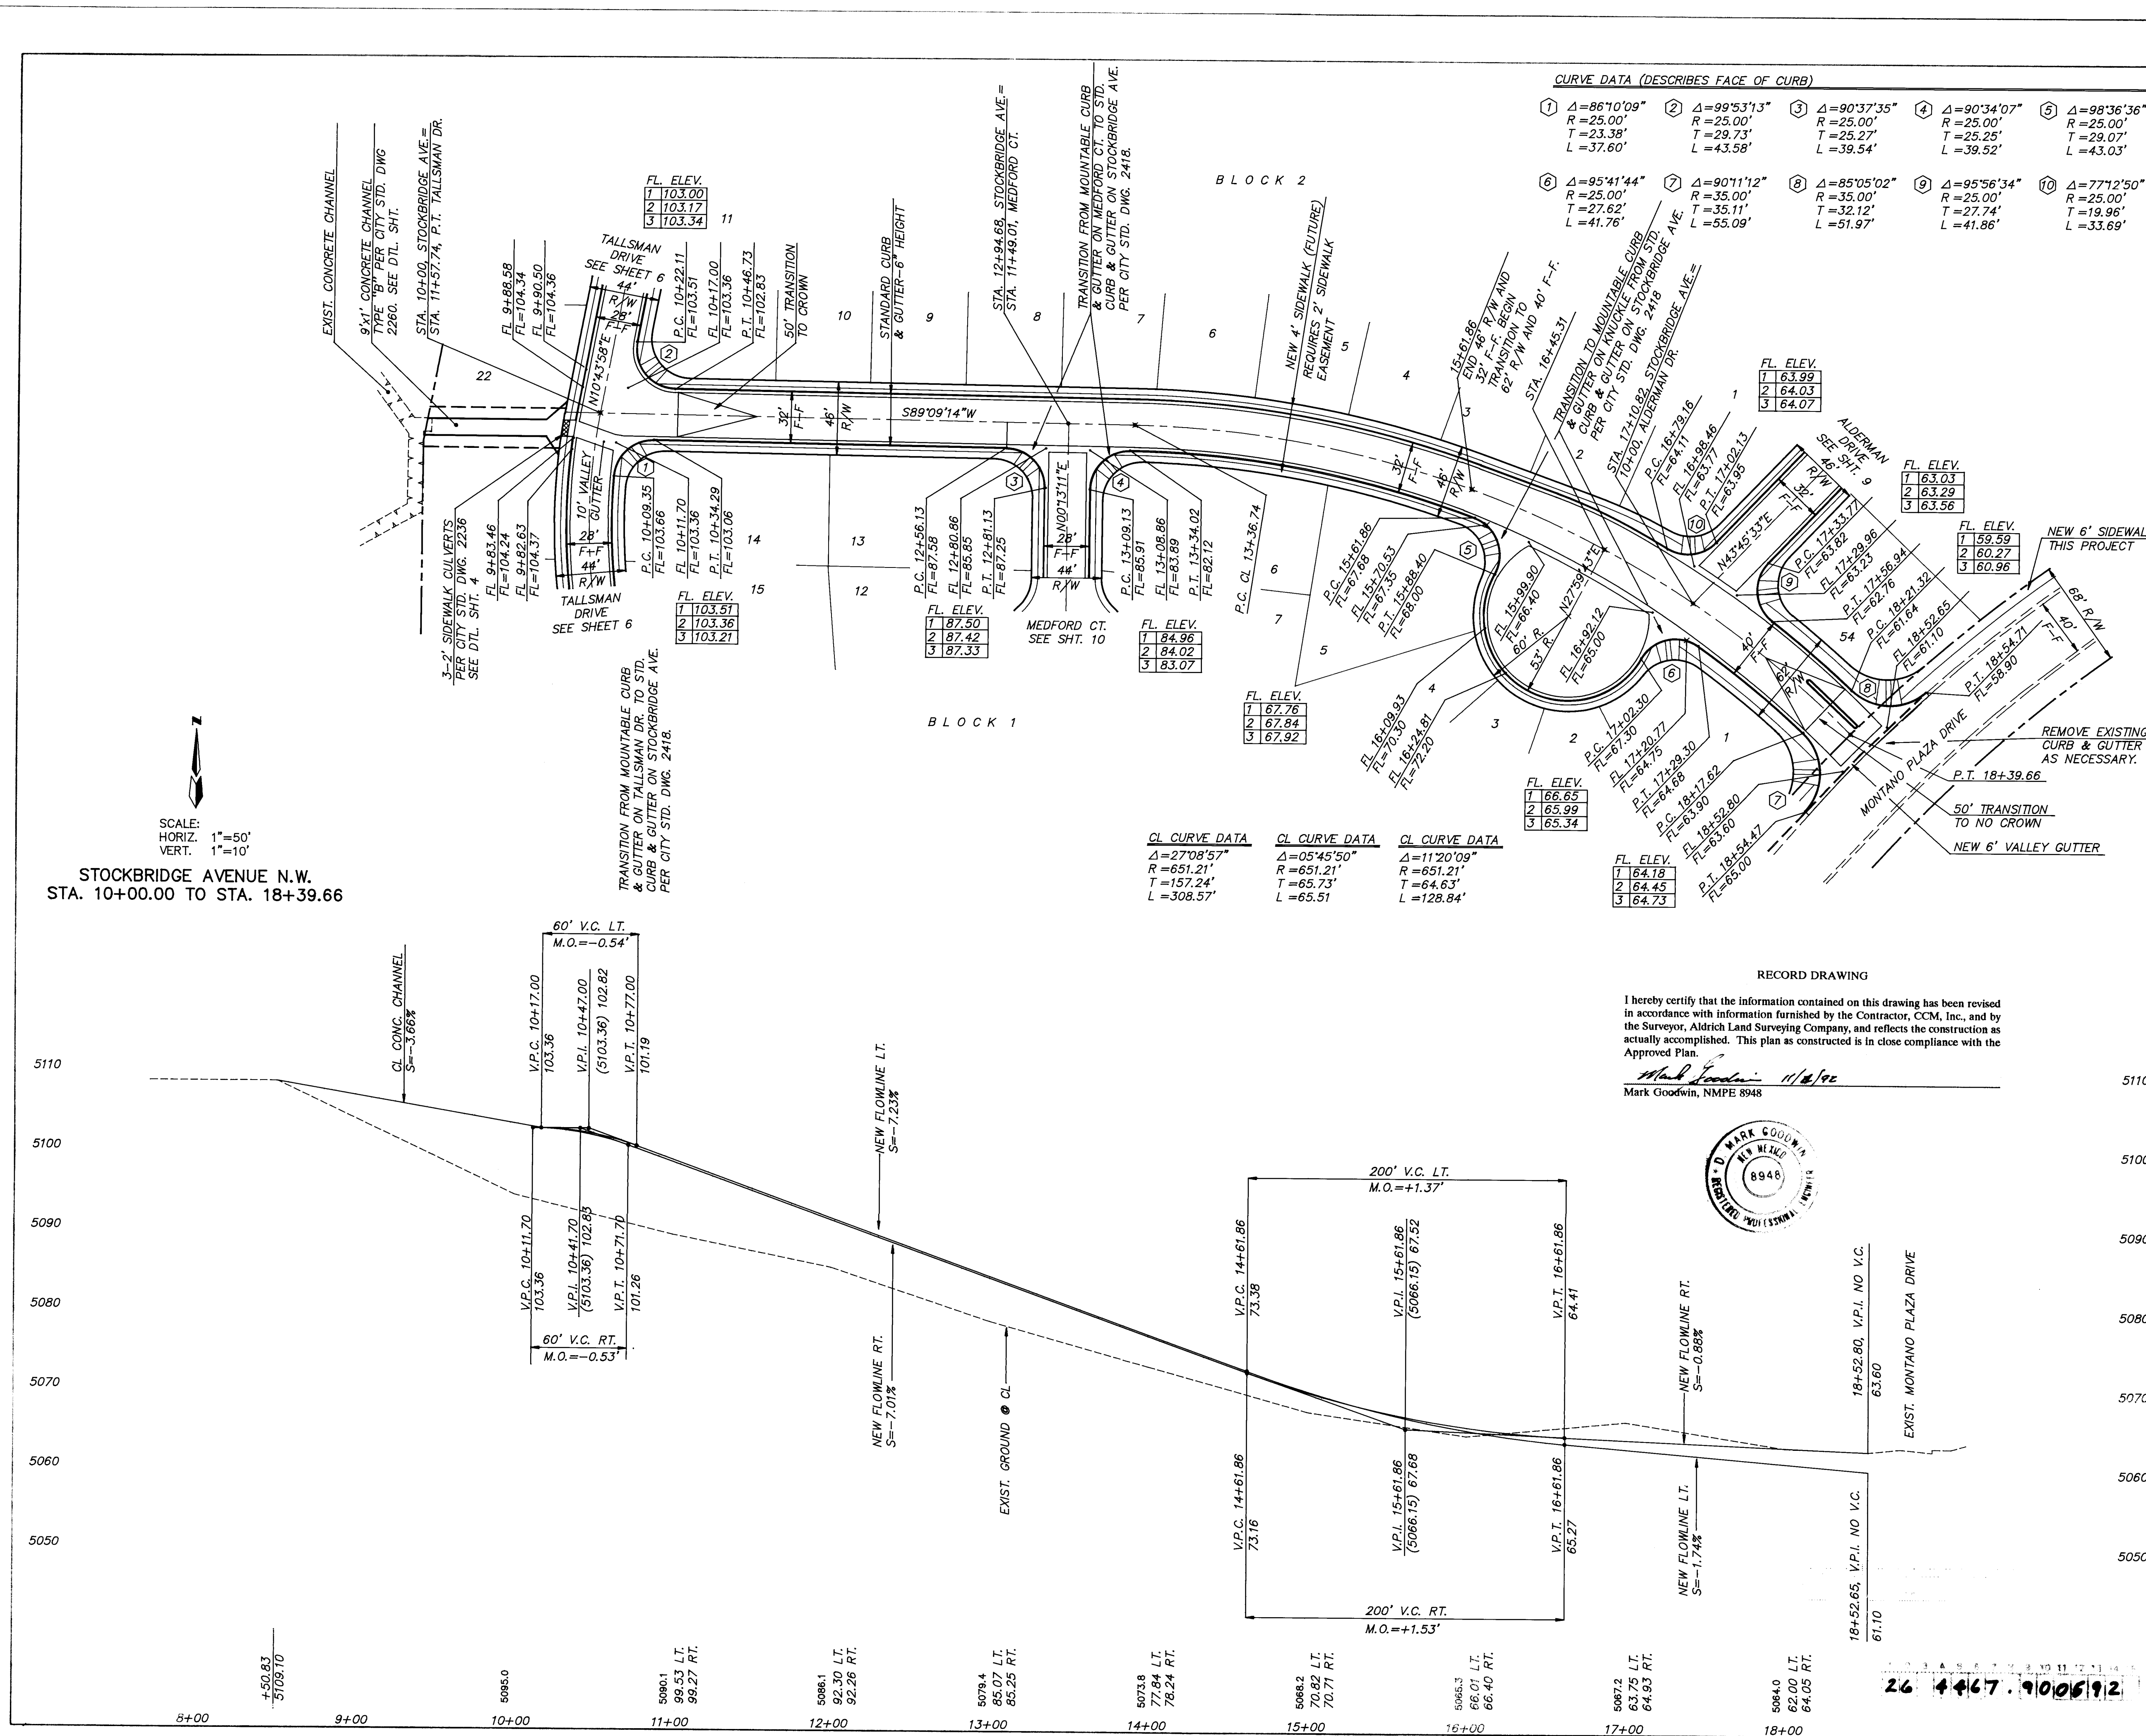

CURVE DATA (DESCRIBES FACE OF CURB)

1	2	3	4	5	6	7	8	9	10
$\Delta=86^{\circ}10'09''$ R=25.00' T=23.38' L=37.80'	$\Delta=99^{\circ}53'13''$ R=25.00' T=29.73' L=43.58'	$\Delta=90^{\circ}37'35''$ R=25.00' T=25.27' L=39.54'	$\Delta=90^{\circ}34'07''$ R=25.00' T=25.25' L=39.52'	$\Delta=98^{\circ}36'36''$ R=25.00' T=29.07' L=43.03'	$\Delta=85^{\circ}41'44''$ R=25.00' T=27.62' L=41.76'	$\Delta=90^{\circ}11'12''$ R=35.00' T=35.11' L=55.09'	$\Delta=85^{\circ}05'02''$ R=35.00' T=32.12' L=51.97'	$\Delta=95^{\circ}56'34''$ R=25.00' T=27.74' L=41.86'	$\Delta=77^{\circ}12'50''$ R=25.00' T=19.96' L=33.69'

- NOTE:
- FOR TYPICAL STREET SECTIONS, SEE SHT. 4
 - ALL VALLEY GUTTERS ARE TO HAVE 3/4" INVERTS.
 - ALL H.C. RAMPS PER CITY STD. DWG. 2441, TYPE II. THIS APPLIES TO ALL SHEETS.

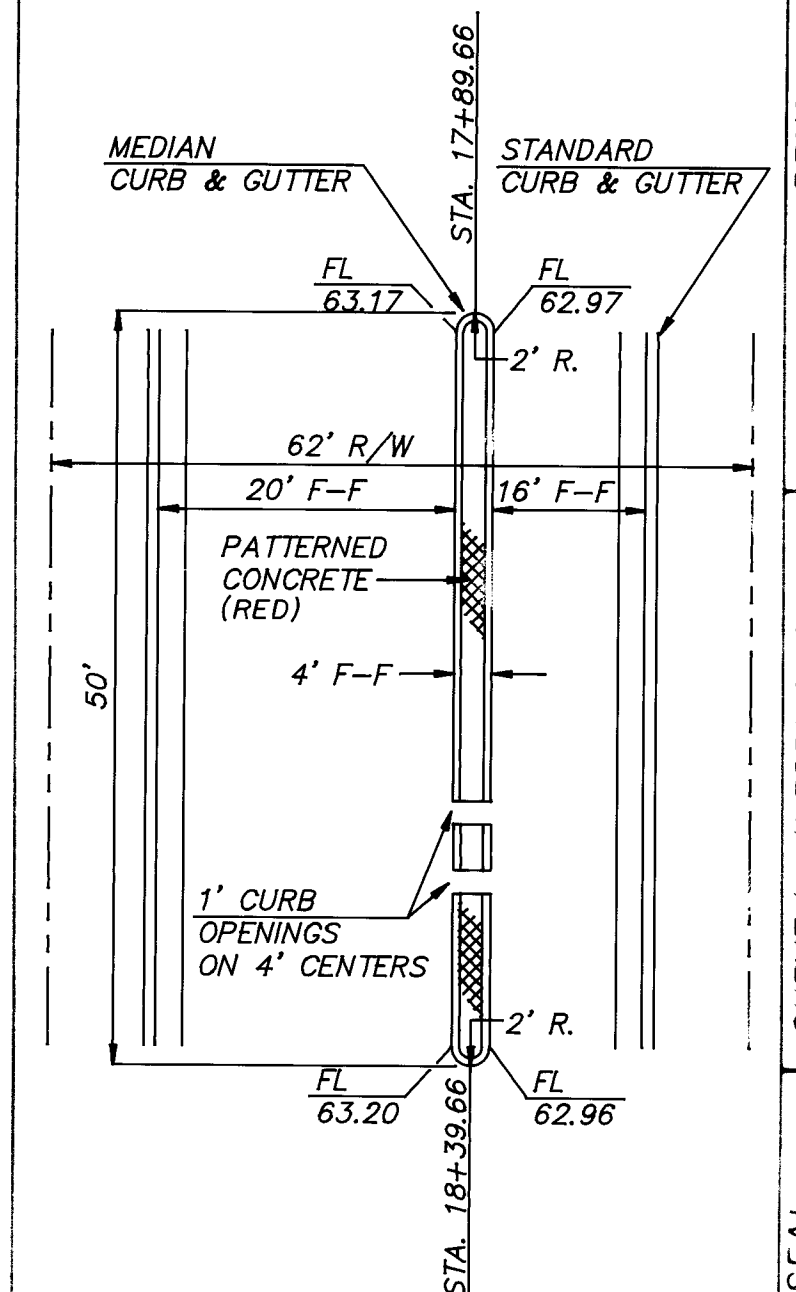

RECORD DRAWING

I hereby certify that the information contained on this drawing has been revised in accordance with information furnished by the Contractor, CCM, Inc., and by the Surveyor, Aldrich Land Surveying Company, and reflects the construction as actually accomplished. This plan as constructed is in close compliance with the Approved Plan.

Mark Goodwin 11/12/92
Mark Goodwin, NMPE 8948




ISLAND DETAIL
N.T.S.

dmg
D. MARK GOODWIN & ASSOCIATES, P.A.
CONSULTING ENGINEERS & SURVEYORS
P.O. BOX 90606
ALBUQUERQUE, NEW MEXICO 87199
(505) 828-2200

CITY OF ALBUQUERQUE PUBLIC WORKS DEPARTMENT ENGINEERING GROUP					
TITLE HUNTERS RIDGE SUBDIVISION STOCKBRIDGE AVE. N.W. STA. 10+00.00 TO STA. 18+39.66 PAVING IMPROVEMENTS					
APPROVALS	ENGINEER	DATE	APPROVALS	ENGINEER	DATE
DIST. CHAIRMAN	<i>R.W. Kane</i>	<i>6/18/92</i>	WATER	<i>R.W. Kane</i>	<i>6-3-92</i>
TRANSPORTATION	<i>R.W. Kane</i>	<i>6-3-92</i>	WASTE WATER	<i>R.W. Kane</i>	<i>6-3-92</i>
HYDROLOGY	<i>HA</i>				
PROJECT NO.		MAP NO.		SHEET OF	
4467.90		E12		5 17	

SCANNED BY
BY LASON

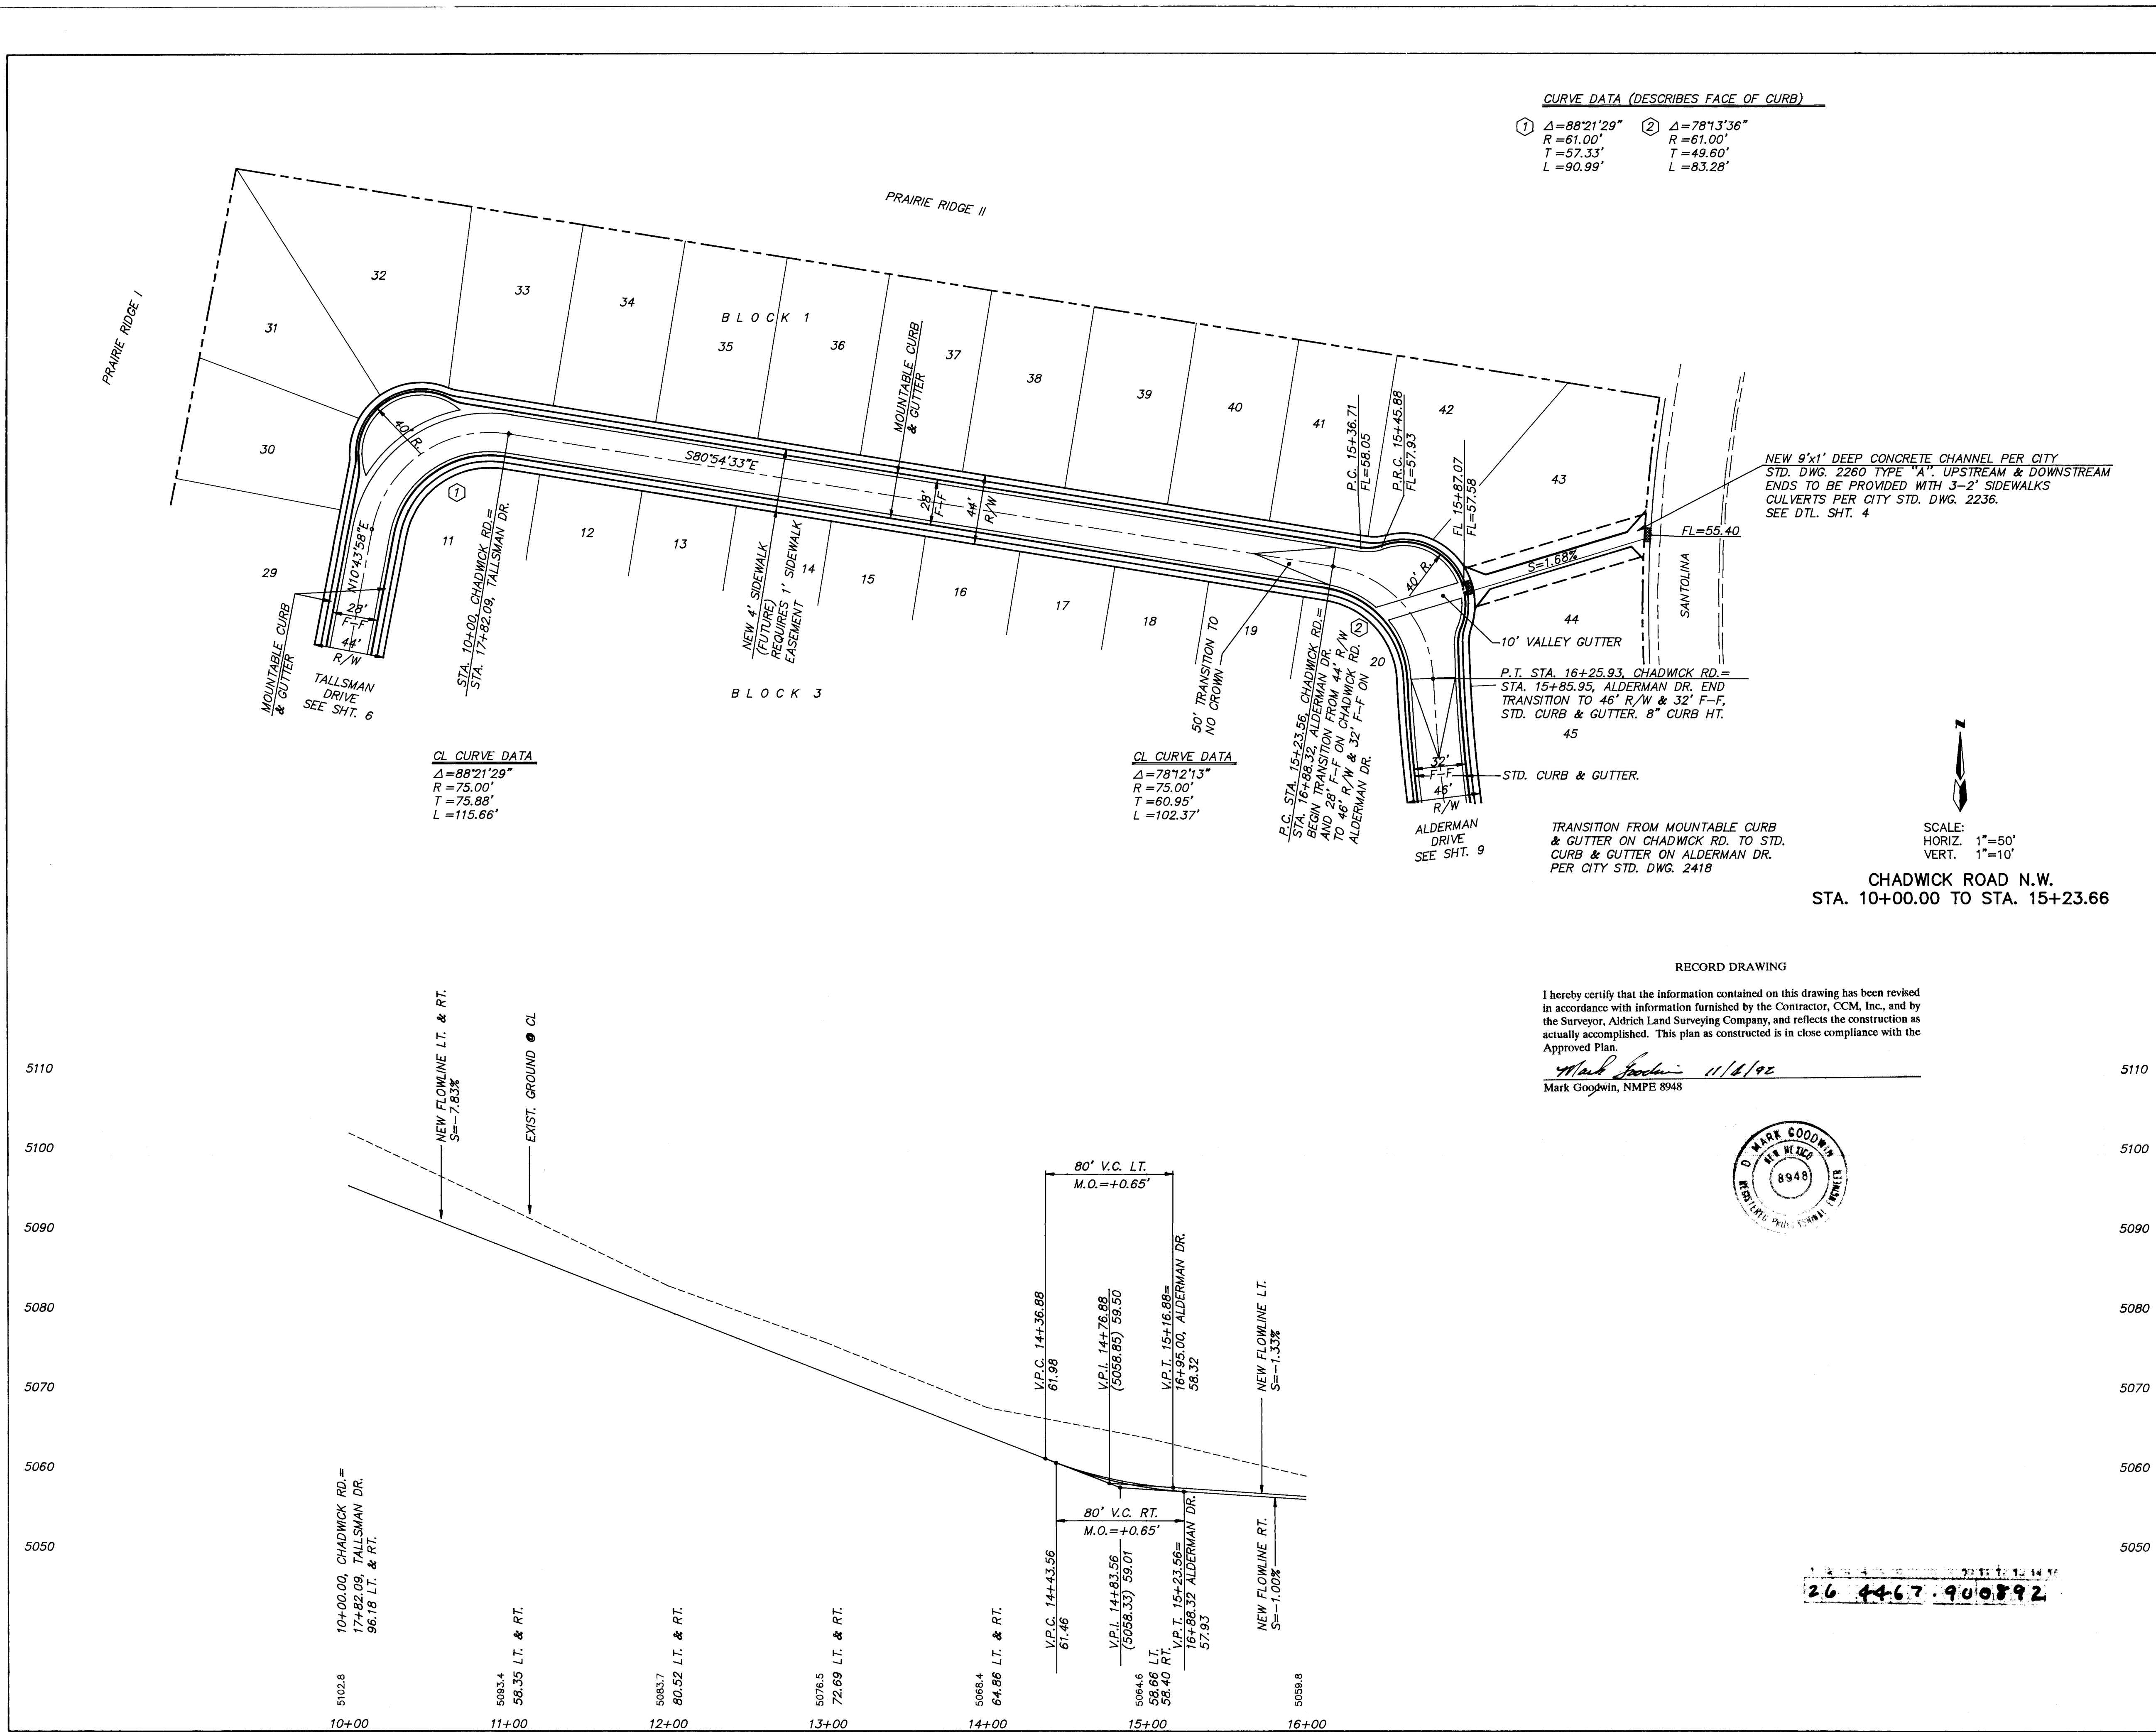

AS BUILT INFORMATION		BENCH MARKS		SURVEY INFORMATION		ENGINEER'S SEAL	
CONTRACTOR	DATE	STATION MARK IS A STANDARD USGS BRASS TABLET, STAMPED "HUGHES 1964", SET IN TOP OF A CONCRETE POST PROJECTING 0.3 FT. ABOVE THE GROUND. TO REACH THE STATION FROM THE INTERSECTION OF CENTRAL AVE. AND STATE RD. 448, GO NORTH ON STATE RD. 448, 6.1 MILES. THE STATION IS WEST OF THIS POINT. X=371,688.59, Y=1,514,316.32, Z=5049.83	DATE	BY	NO	REMARKS	BY
WORK	DATE		DATE	BY	NO	REMARKS	BY
INSPECTED BY	DATE		DATE	BY	NO	REMARKS	BY
ACCEPTANCE BY	DATE		DATE	BY	NO	REMARKS	BY
REVISIONS	DATE		DATE	BY	NO	REMARKS	BY
DESIGNED BY	DATE		DATE	BY	NO	REMARKS	BY
DRAWN BY	DATE		DATE	BY	NO	REMARKS	BY
CHECKED BY	DATE		DATE	BY	NO	REMARKS	BY

26 4467 900892

PROJECT NO. 4467.90

MAP NO. E12


SHEET 8 OF 17

CITY OF ALBUQUERQUE
PUBLIC WORKS DEPARTMENT
ENGINEERING GROUP

TITLE HUNTERS RIDGE SUBDIVISION
CHADWICK ROAD N.W. STA. 10+00.00 TO STA. 15+23.66
PAVING IMPROVEMENTS

APPROVALS	ENGINEER	DATE	APPROVALS	ENGINEER	DATE
TRANSPORTATION	6/1/92		WATER	6/3/92	
HYDROLOGY	6/1/92		WASTEWATER	6/3/92	

DESIGNED BY DMG DATE 4/92
DRAWN BY DMG DATE 4/92
CHECKED BY DMG DATE 4/92

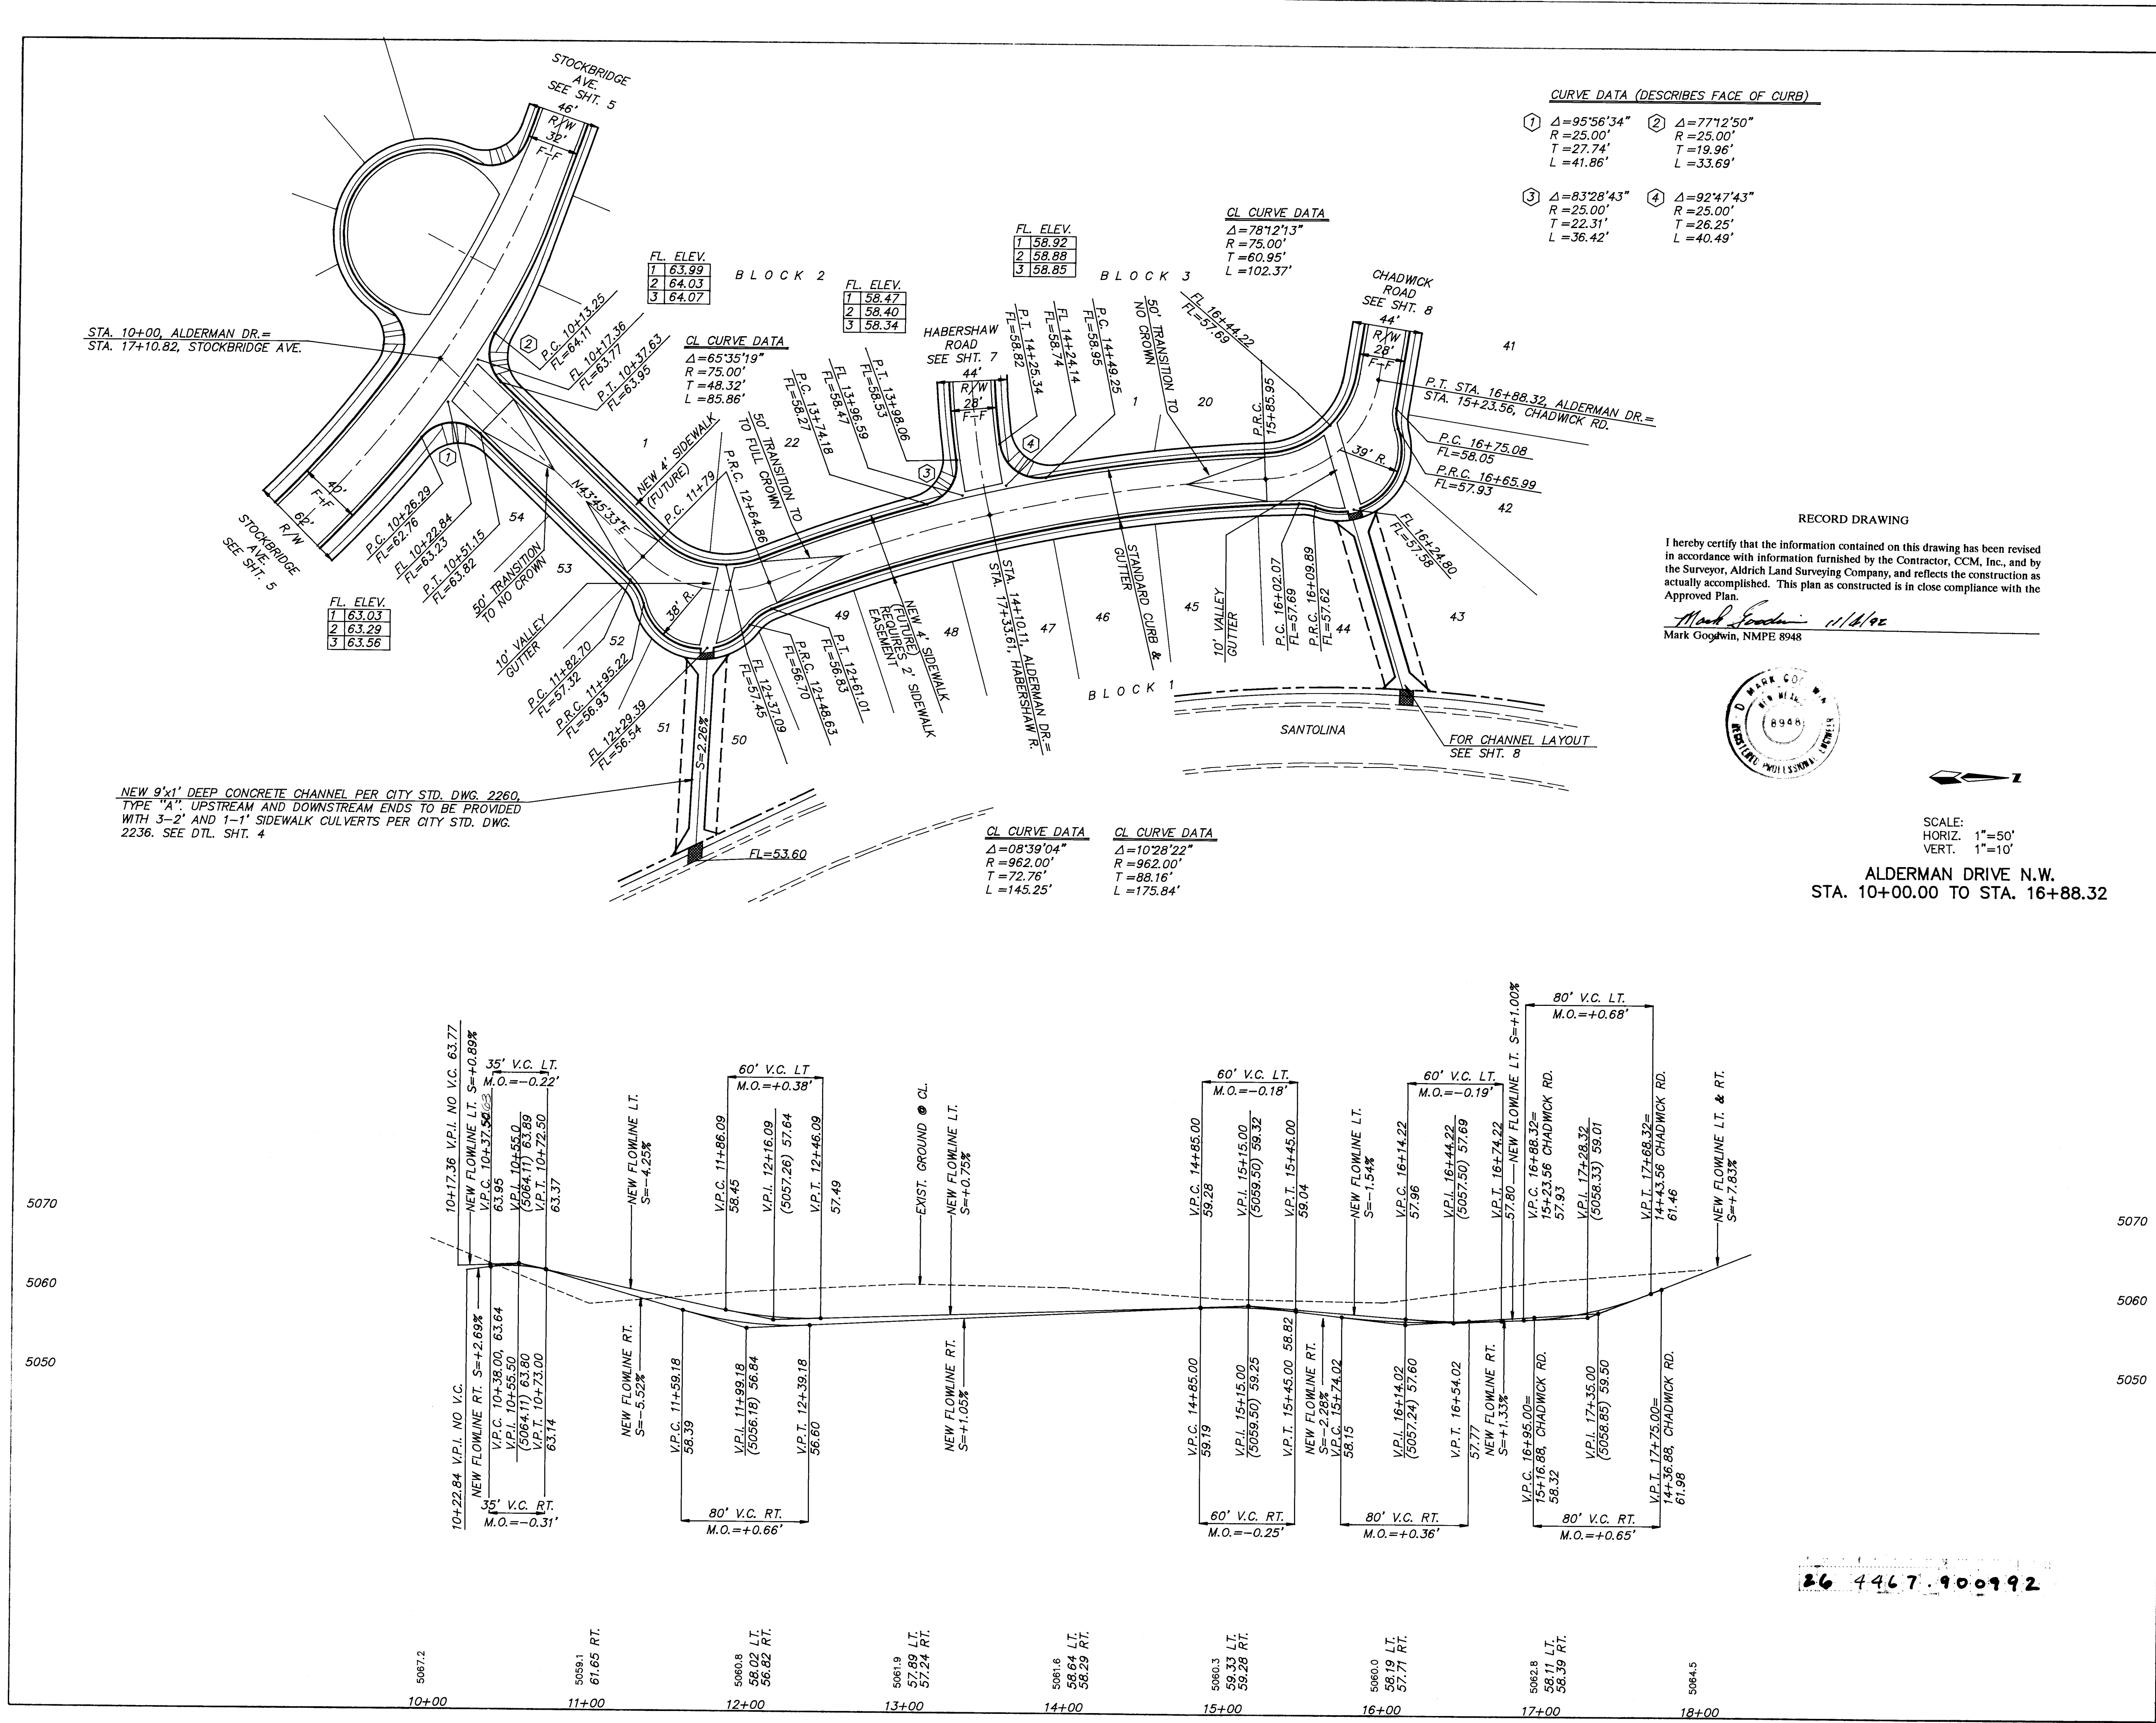

CURVE DATA (DESCRIBES FACE OF CURB)

1	$\Delta=95^{\circ}56'34''$ R=25.00' T=27.74' L=41.86'	2	$\Delta=77^{\circ}12'50''$ R=25.00' T=19.96' L=33.69'
3	$\Delta=83^{\circ}28'43''$ R=25.00' T=22.31' L=36.42'	4	$\Delta=92^{\circ}47'43''$ R=25.00' T=26.25' L=40.49'

CL CURVE DATA

$\Delta=65^{\circ}35'19''$ R=75.00' T=48.32' L=85.86'
--

FL ELEV.

1	63.99
2	64.03
3	64.07

FL ELEV.

1	58.92
2	58.88
3	58.85

FL ELEV.

1	58.47
2	58.40
3	58.34

CL CURVE DATA

$\Delta=78^{\circ}12'13''$ R=75.00' T=60.95' L=102.37'

FL ELEV.

1	58.85
2	58.82
3	58.79

FL ELEV.

1	58.74
2	58.74
3	58.74

FL ELEV.

1	58.95
2	58.95
3	58.95

FL ELEV.

1	58.95
2	58.95
3	58.95

RECORD DRAWING


I hereby certify that the information contained on this drawing has been revised in accordance with information furnished by the Contractor, CCM, Inc., and by the Surveyor, Aldrich Land Surveying Company, and reflects the construction as actually accomplished. This plan as constructed is in close compliance with the Approved Plan.

Mark Goodwin 11/14/92
Mark Goodwin, NMPE 8948



SCALE:
HORIZ. 1"=50'
VERT. 1"=10'

ALDERMAN DRIVE N.W.
STA. 10+00.00 TO STA. 16+88.32

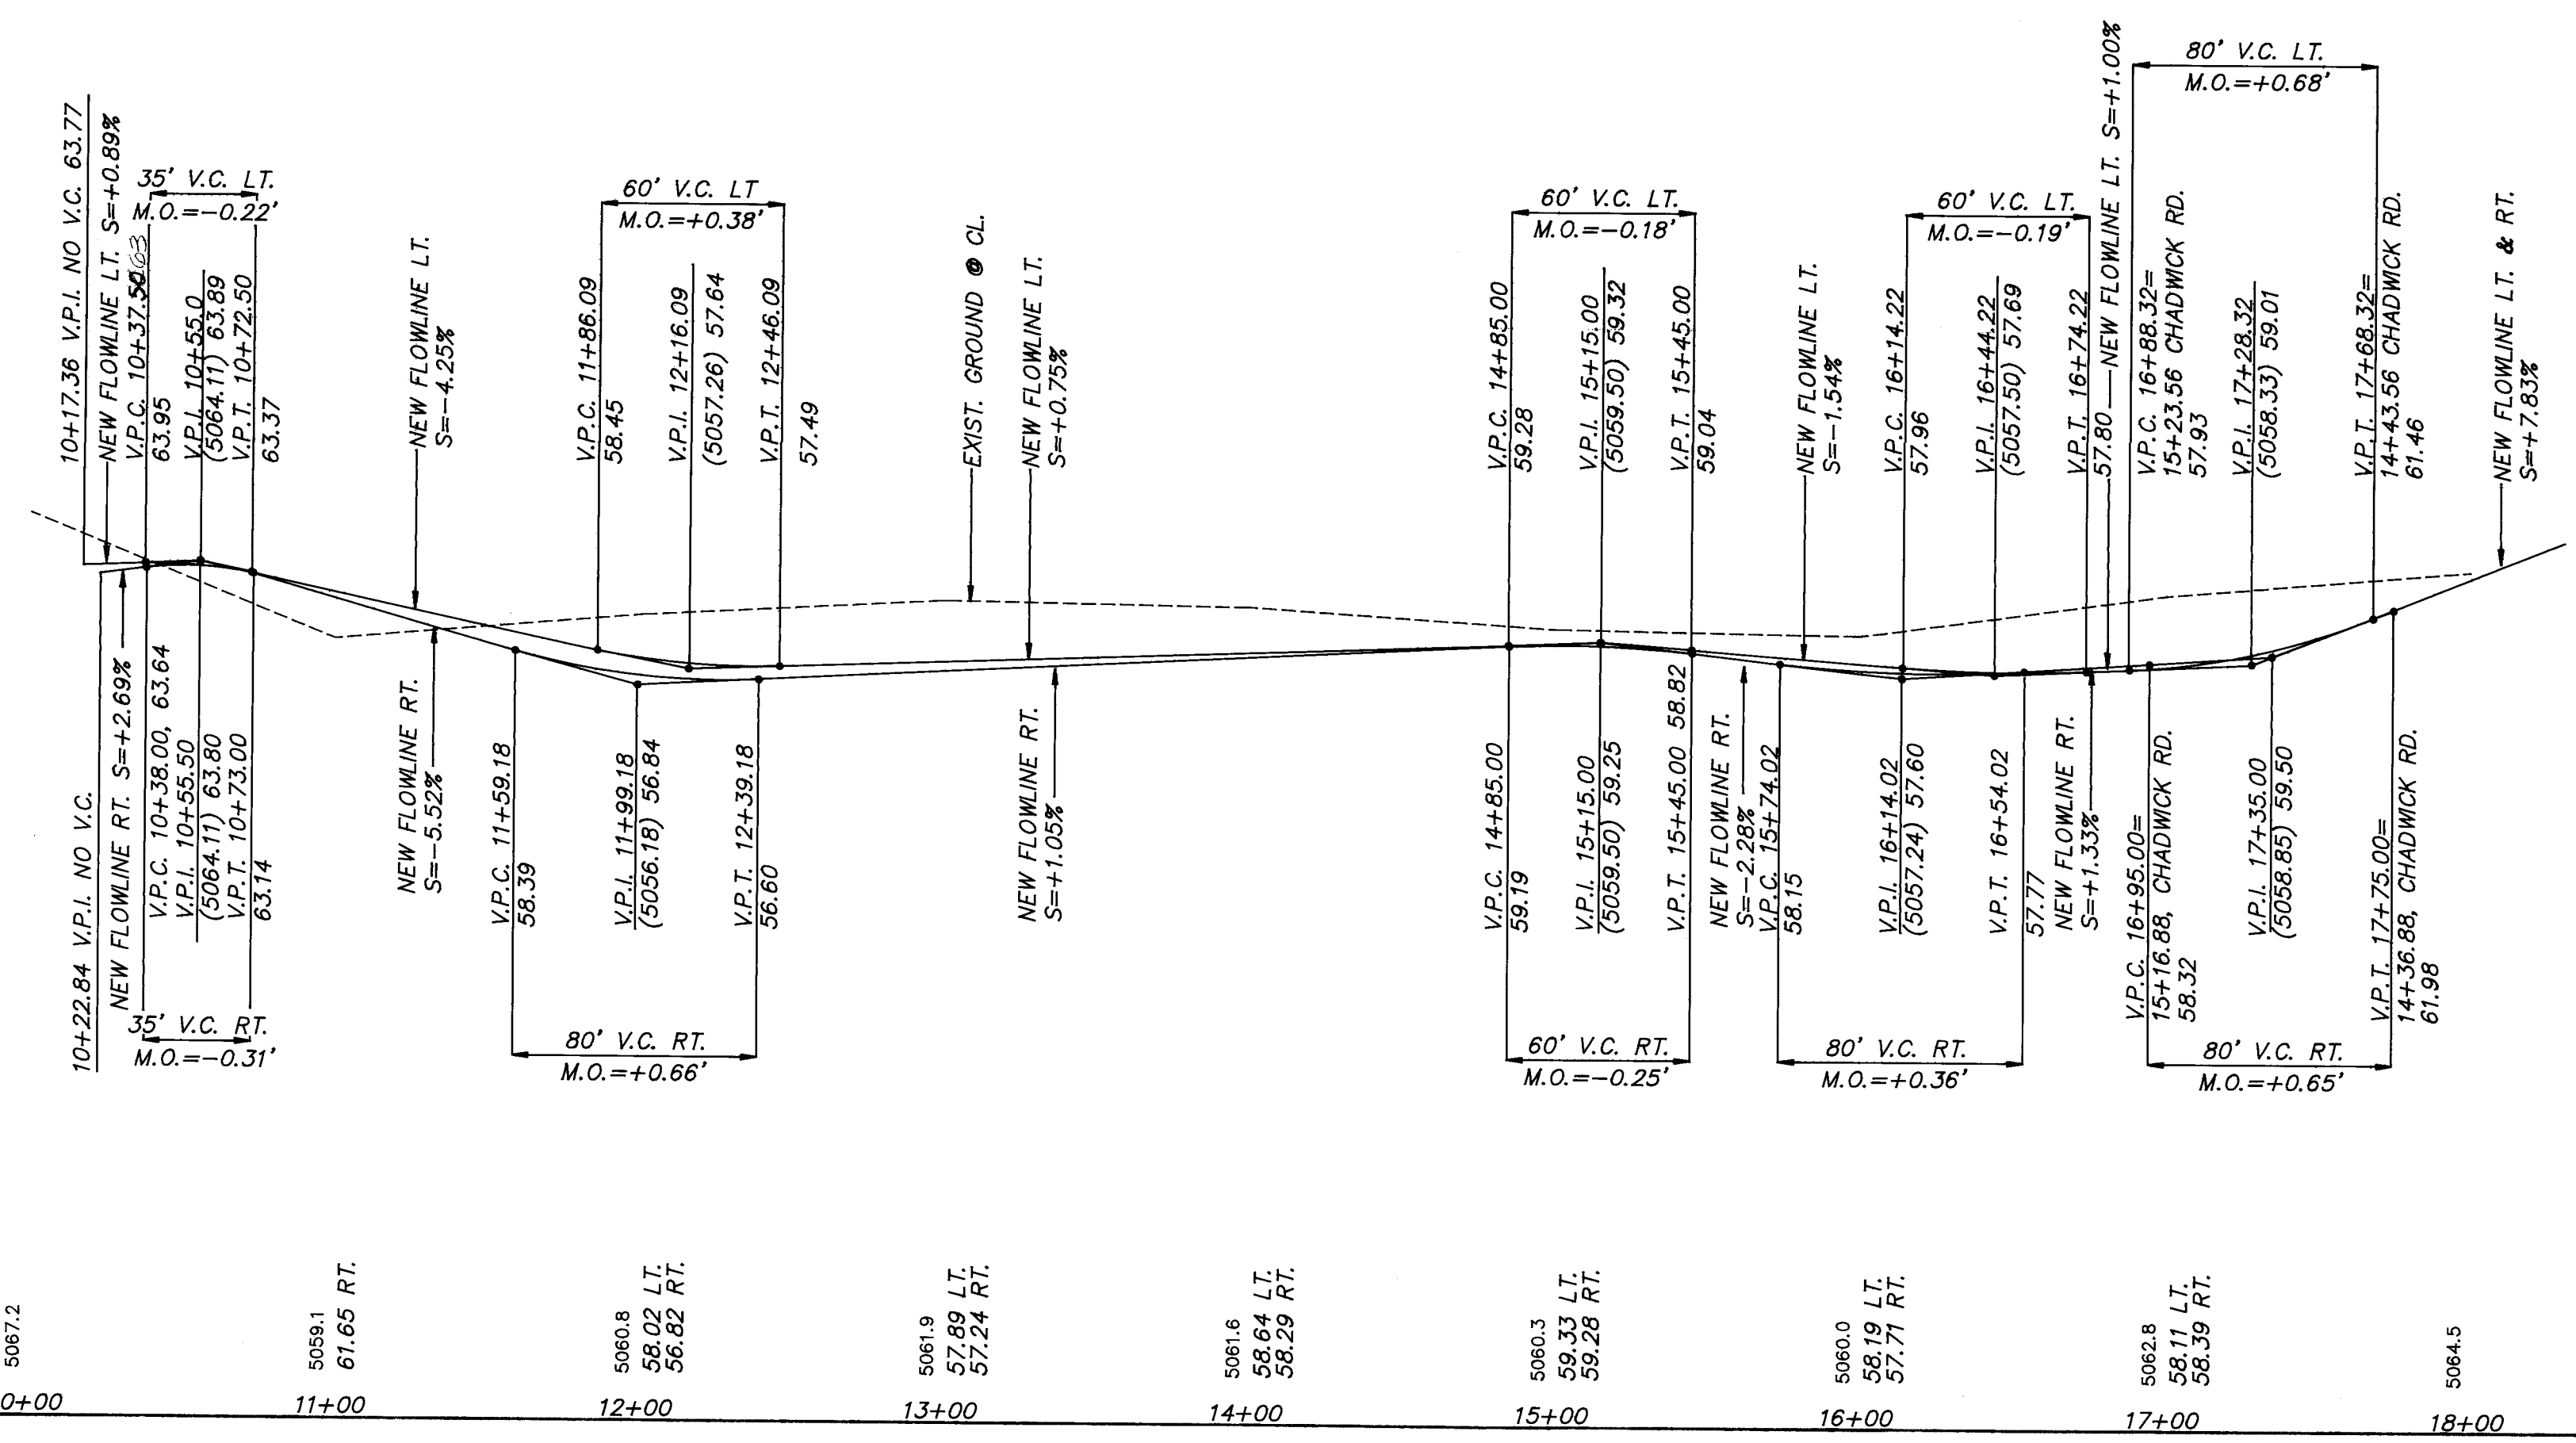


26 4467.90 0992


dmg
D. MARK GOODWIN & ASSOCIATES, P.A.
CONSULTING ENGINEERS & SURVEYORS
P.O. BOX 90606
ALBUQUERQUE, NEW MEXICO 87199
(505) 828-2200

CITY OF ALBUQUERQUE PUBLIC WORKS DEPARTMENT ENGINEERING GROUP			
TITLE HUNTERS RIDGE SUBDIVISION ALDERMAN DRIVE N.W. STA. 10+00.00 TO STA. 16+88.32 PAVING IMPROVEMENTS			
APPROVAL	ENGINEER	DATE	APPROVAL
DRG. CHAIRMAN	<i>R.W. Kane</i>	6/8/92	WATER
TRANSPORTATION	<i>Donk</i>	6-01-92	WASTE WATER
HYDROLOGY	<i>N/A</i>		
PROJECT NO.	4467.90	MAP NO.	E12
SHEET	9	OF	17


SCANNED BY
BY LASON

HRS\RDPP4

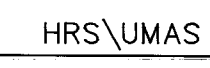

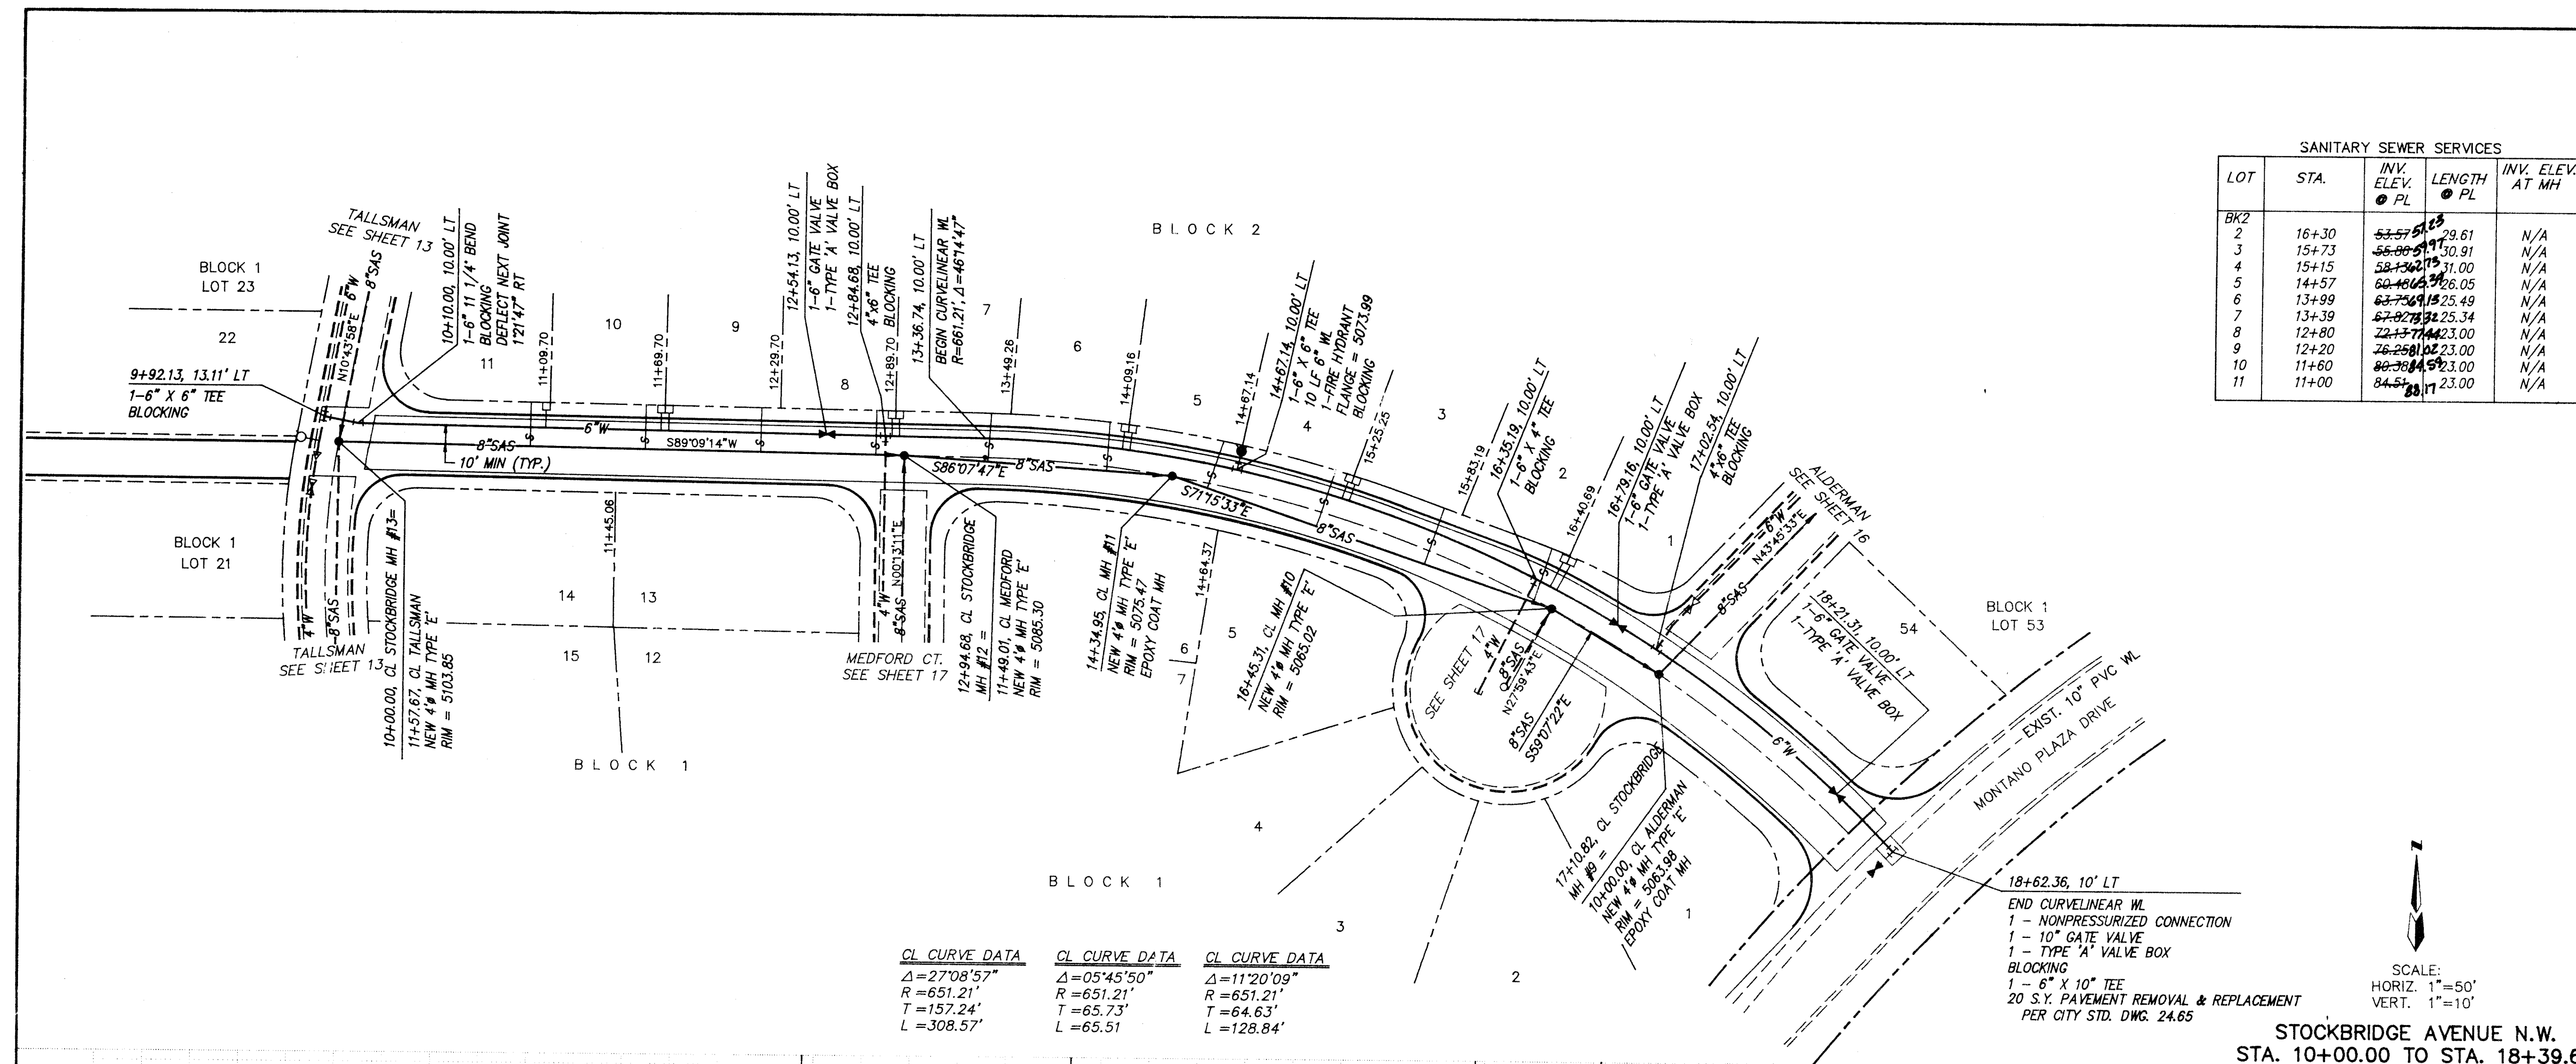

SANITARY SEWER SERVICES				
LOT	STA.	INV. ELEV. PL	LENGTH PL	INV. ELEV. AT MH
BK2				
2	16+30	53.57	29.61	N/A
3	15+73	56.00	30.91	N/A
4	15+15	58.00	31.00	N/A
5	14+57	60.40	26.05	N/A
6	13+99	63.70	25.49	N/A
7	13+39	67.02	25.34	N/A
8	12+80	72.13	23.00	N/A
9	12+20	76.25	23.00	N/A
10	11+60	80.36	23.00	N/A
11	11+00	84.51	23.00	N/A

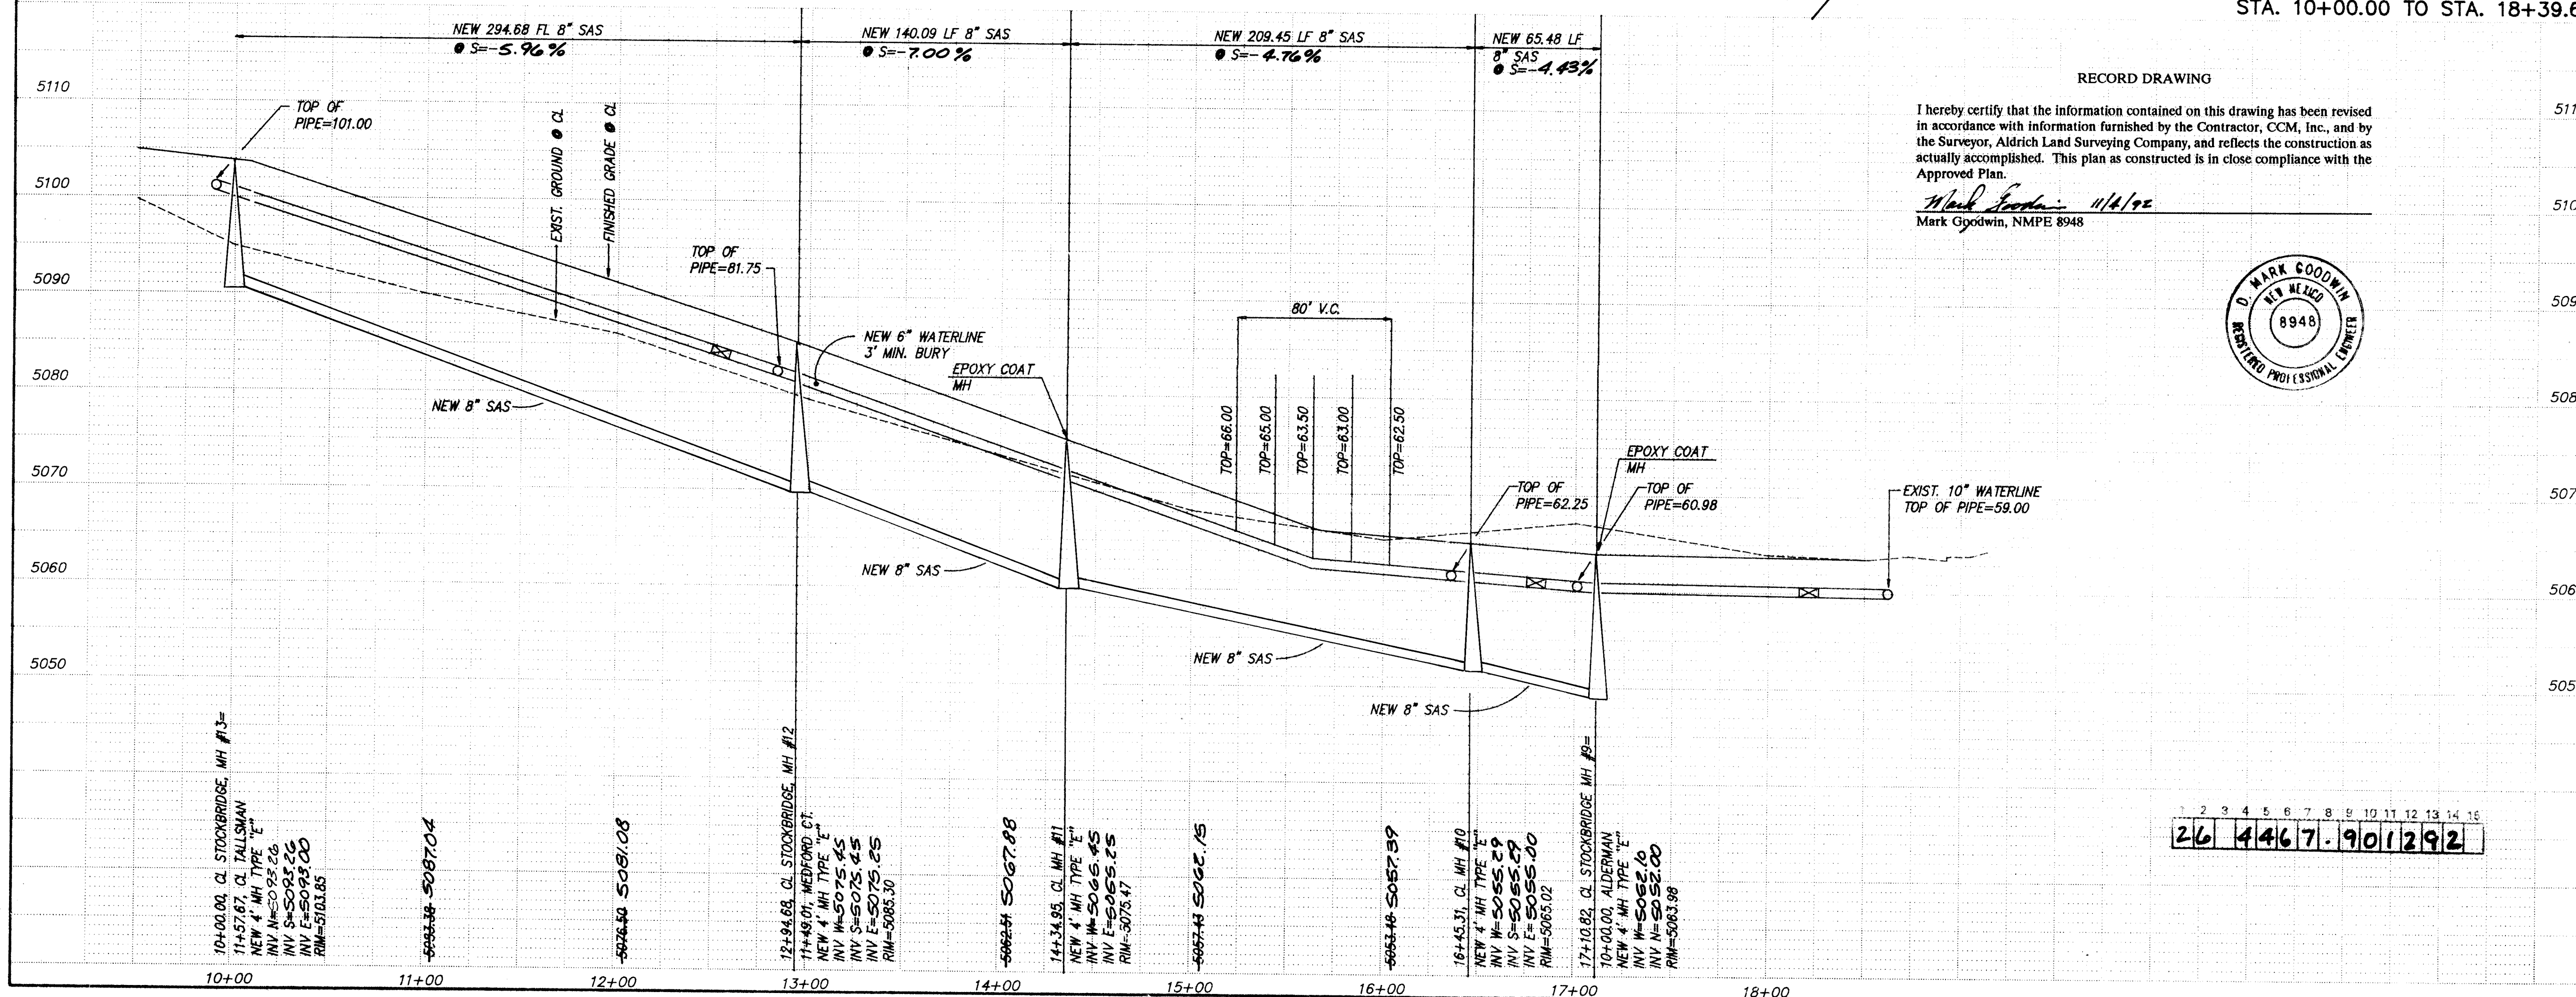

RECORD DRAWING

I hereby certify that the information contained on this drawing has been revised in accordance with information furnished by the Contractor, CCM, Inc., and by the Surveyor, Aldrich Land Surveying Company, and reflects the construction as actually accomplished. This plan as constructed is in close compliance with the Approved Plan.

Mark Goodwin 11/12/92
Mark Goodwin, NMPE 8948



NOTES

1. ALL STATIONING IS CENTERLINE STATIONING.

2. SEE SHT. 11 FOR SAS SERVICE DTL.

AS BUILT INFORMATION		BENCH MARKS		SURVEY INFORMATION		ENGINEER'S SEAL	
CONTRACTOR	CCM	STATION MARK IS A STANDARD USGS BRASS TABLET, STAMPED "HUGHES 1964", SET IN TOP OF A CONCRETE POST PROJECTING 0.3 FT. ABOVE THE GROUND TO REACH THE STATION FROM THE INTERSECTION OF CENTRAL AVE. AND STATE RD. 448. GO NORTH ON STATE RD. 448. 6.1 MILES. THE STATION IS WEST OF THIS POINT.	NO.	BY	DATE		
WORK STARTED BY	ALS	DATE	801	D.M.G.	4/92		
FIELD ACCEPTANCE BY	NBA	DATE	REVISIONS		DESIGN		
CORRECTED BY	ALS	DATE	NO.	DATE	DATE	DATE	DATE
MICRO-FILM INFORMATION			DESIGNED BY	DWG	4/92	DRAWN BY	4/92
			CHECKED BY	DWG	4/92		

CITY OF ALBUQUERQUE
PUBLIC WORKS DEPARTMENT
ENGINEERING GROUP


TITLE:
HUNTERS RIDGE SUBDIVISION
STOCKBRIDGE AVE. N.W. STA. 10+00.00 TO STA. 18+39.66
UTILITY IMPROVEMENTS

APPROVALS	ENGINEER	DATE	APPROVALS	ENGINEER	DATE
DRG CHAIRMAN	<i>R. W. Kame</i>	6-3-92	WATER	<i>R. W. Kame</i>	6-3-92
TRANSPORTATION	<i>NBA</i>	6-01-92	WASTE WATER	<i>R. W. Kame</i>	6-3-92
HYDROLOGY	<i>N/A</i>				

PROJECT NO. 4467.90


MAP NO. E12

SHEET 12 OF 17

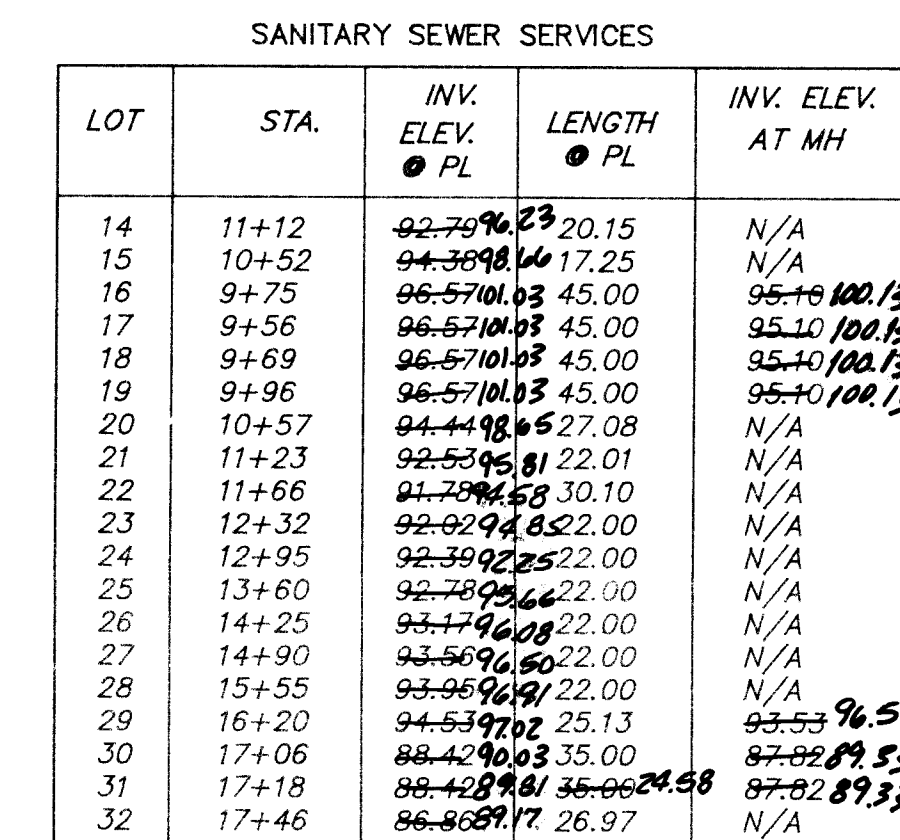



 SCALE:
 HORIZ. 1" = 50'
 VERT. 1" = 10'
 TALLSMAN DRIVE NW
 STA. 10+00.00 TO PT STA. 17+82.09

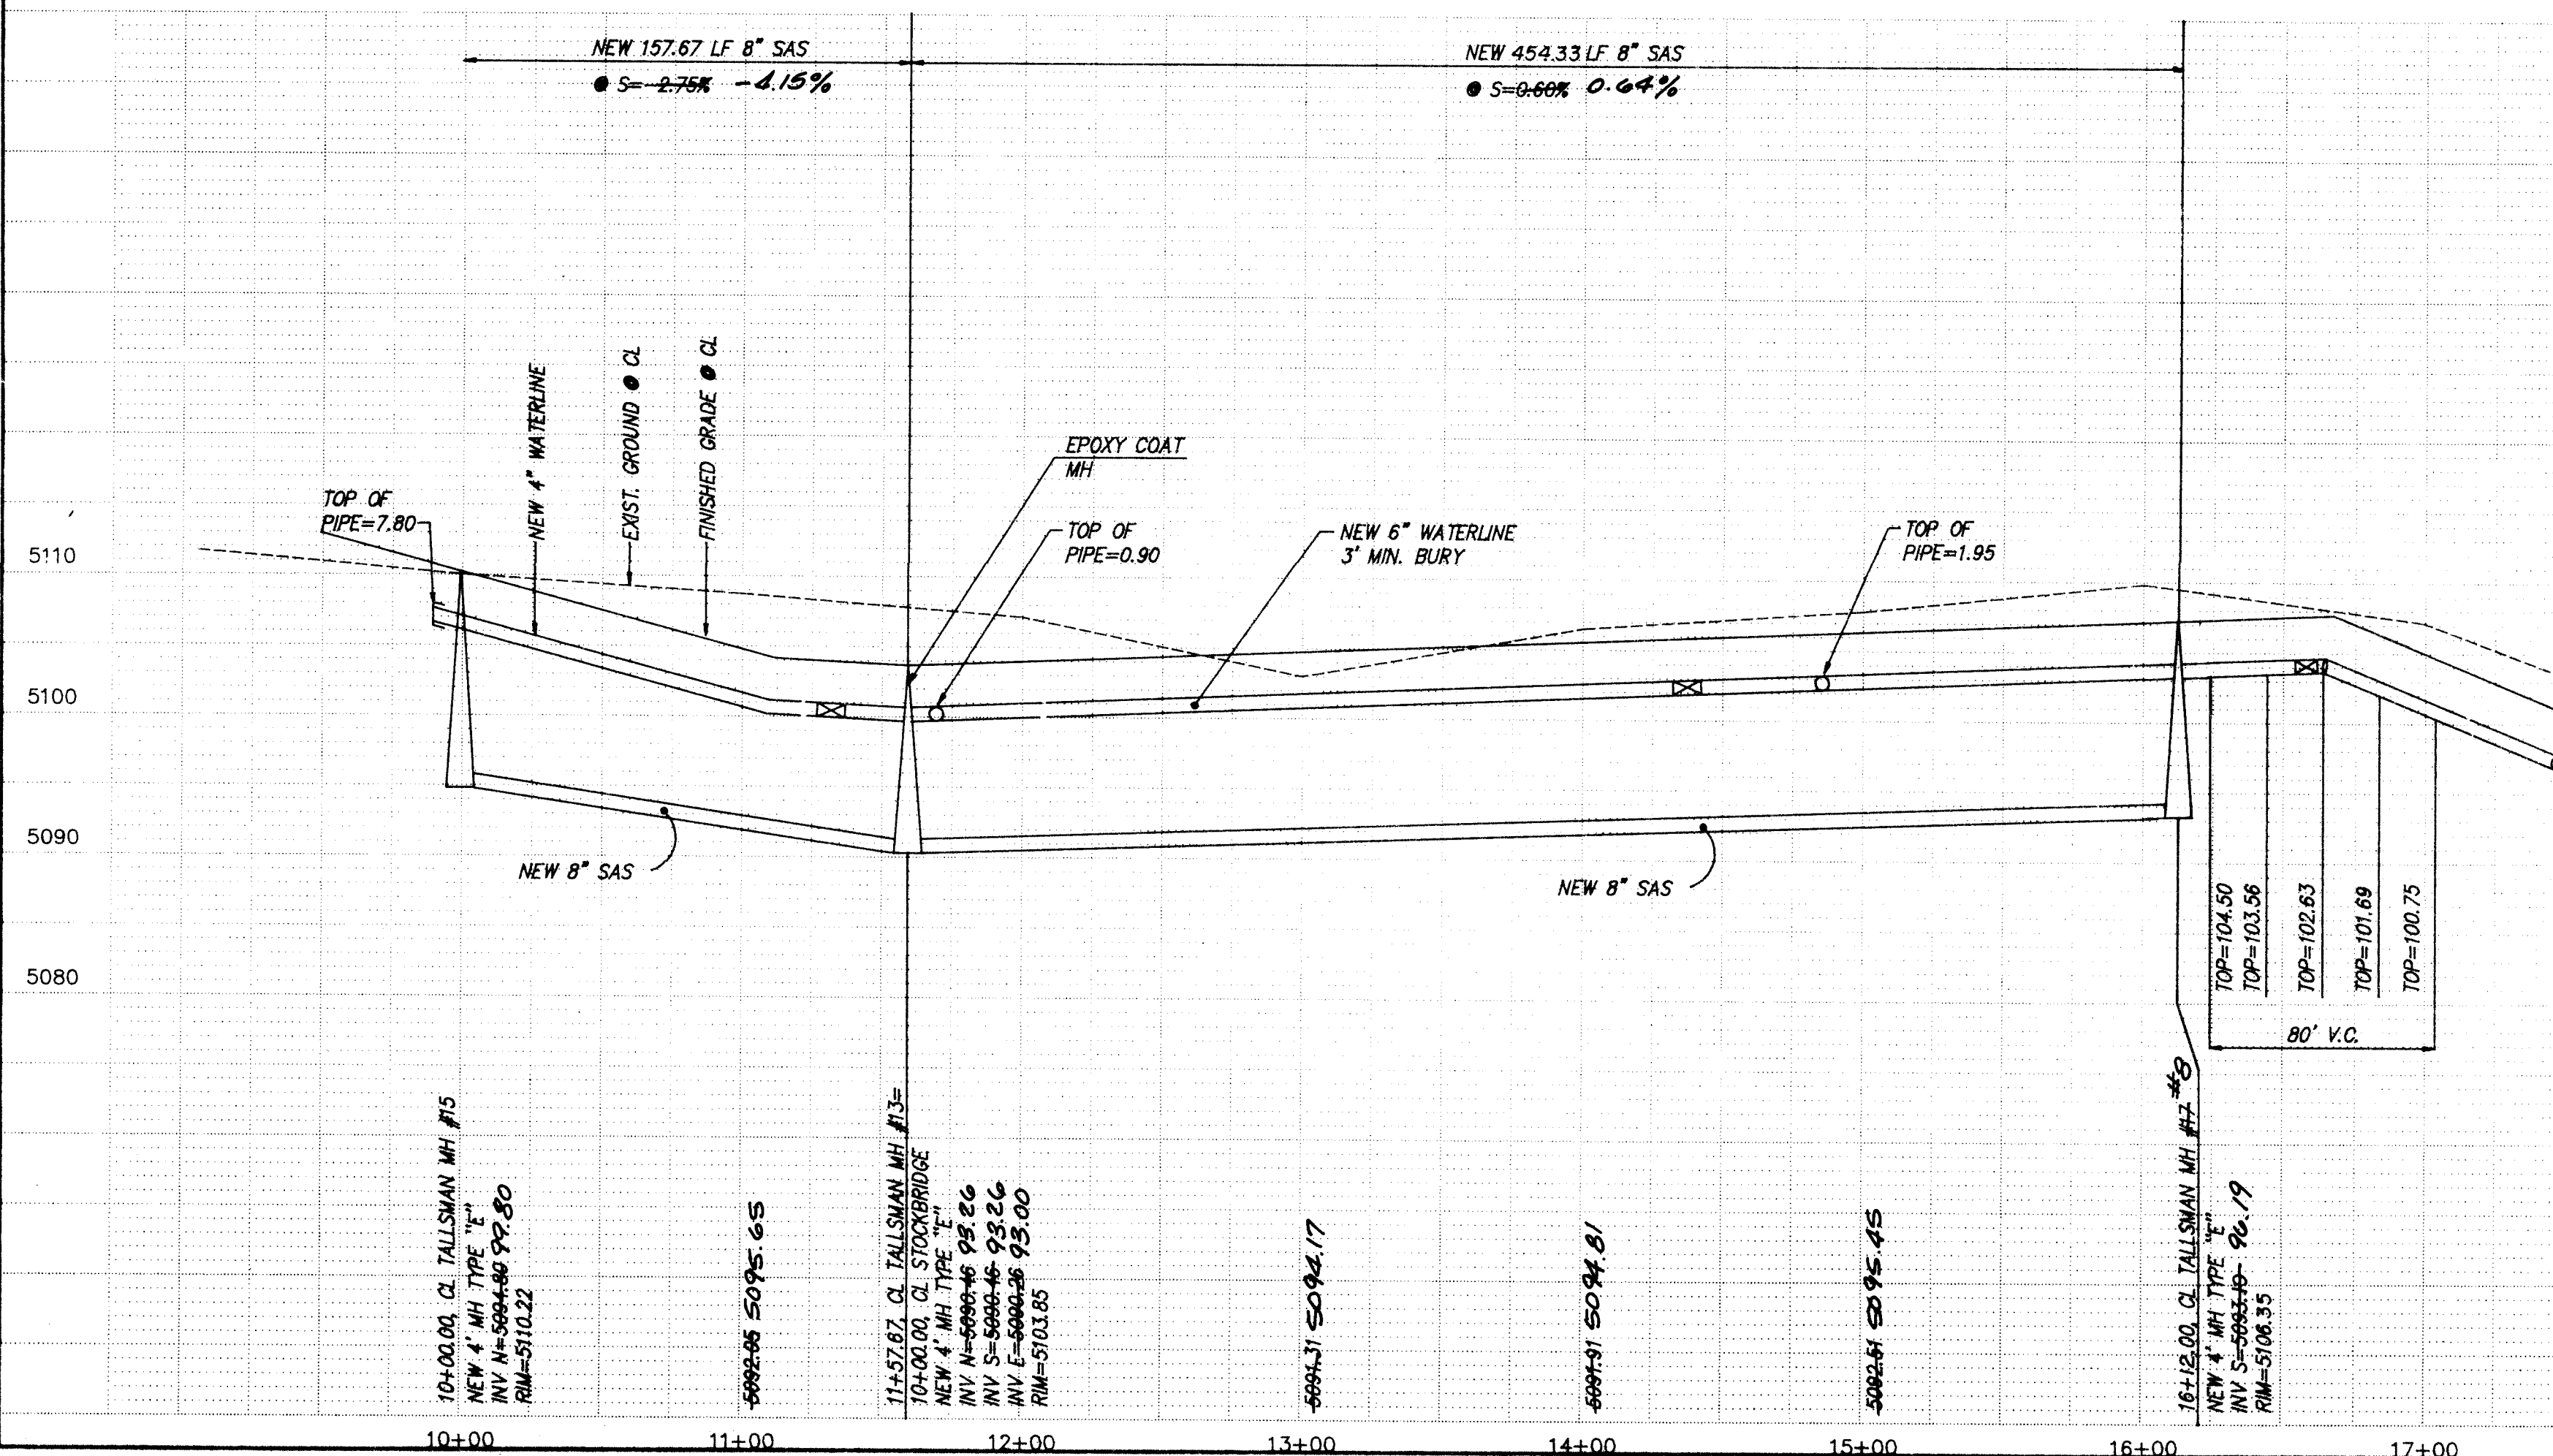

RECORD DRAWING

I hereby certify that the information contained on this drawing has been revised in accordance with information furnished by the Contractor, CCM, Inc., and by the Surveyor, Aldrich Land Surveying Company, and reflects the construction as actually accomplished. This plan as constructed is in close compliance with the Approved Plan.

Mark Goodwin, NMPE 8948



NOTES

1. ALL STATIONING IS CENTERLINE STATIONING.

[illegible]


dmg D. MARK GOODWIN & ASSOCIATES, P.A.
CONSULTING ENGINEERS & SURVEYORS
P.O. BOX 90606
ALBUQUERQUE, NEW MEXICO 87199
(505) 828-2200

CITY OF ALBUQUERQUE
PUBLIC WORKS DEPARTMENT
ENGINEERING GROUP

TITLE: HUNTERS RIDGE SUBDIVISION
TALLSMAN DRIVE N.W. STA. 10+00.00 TO STA. 17+82.09
UTILITY IMPROVEMENTS

CHECKLIST IMPROVEMENTS					
APPROVALS		ENGINEER	DATE	APPROVALS	
				ENGINEER	DATE
DRC CHAIRMAN		<i>Robert Green</i>	6/8/92	WATER	<i>R.W. Kane</i> 6-3-92
TRANSPORTATION		<i>N/A RHD</i>	6-01-92	WASTE WATER	<i>R.W. Kane</i> 6-3-92
HYDROLOGY		<i>n/a</i>			

PROJECT NO.	4467.90	MAP NO.	E12	SHEET OF	13 17
-------------	---------	---------	-----	----------	-------

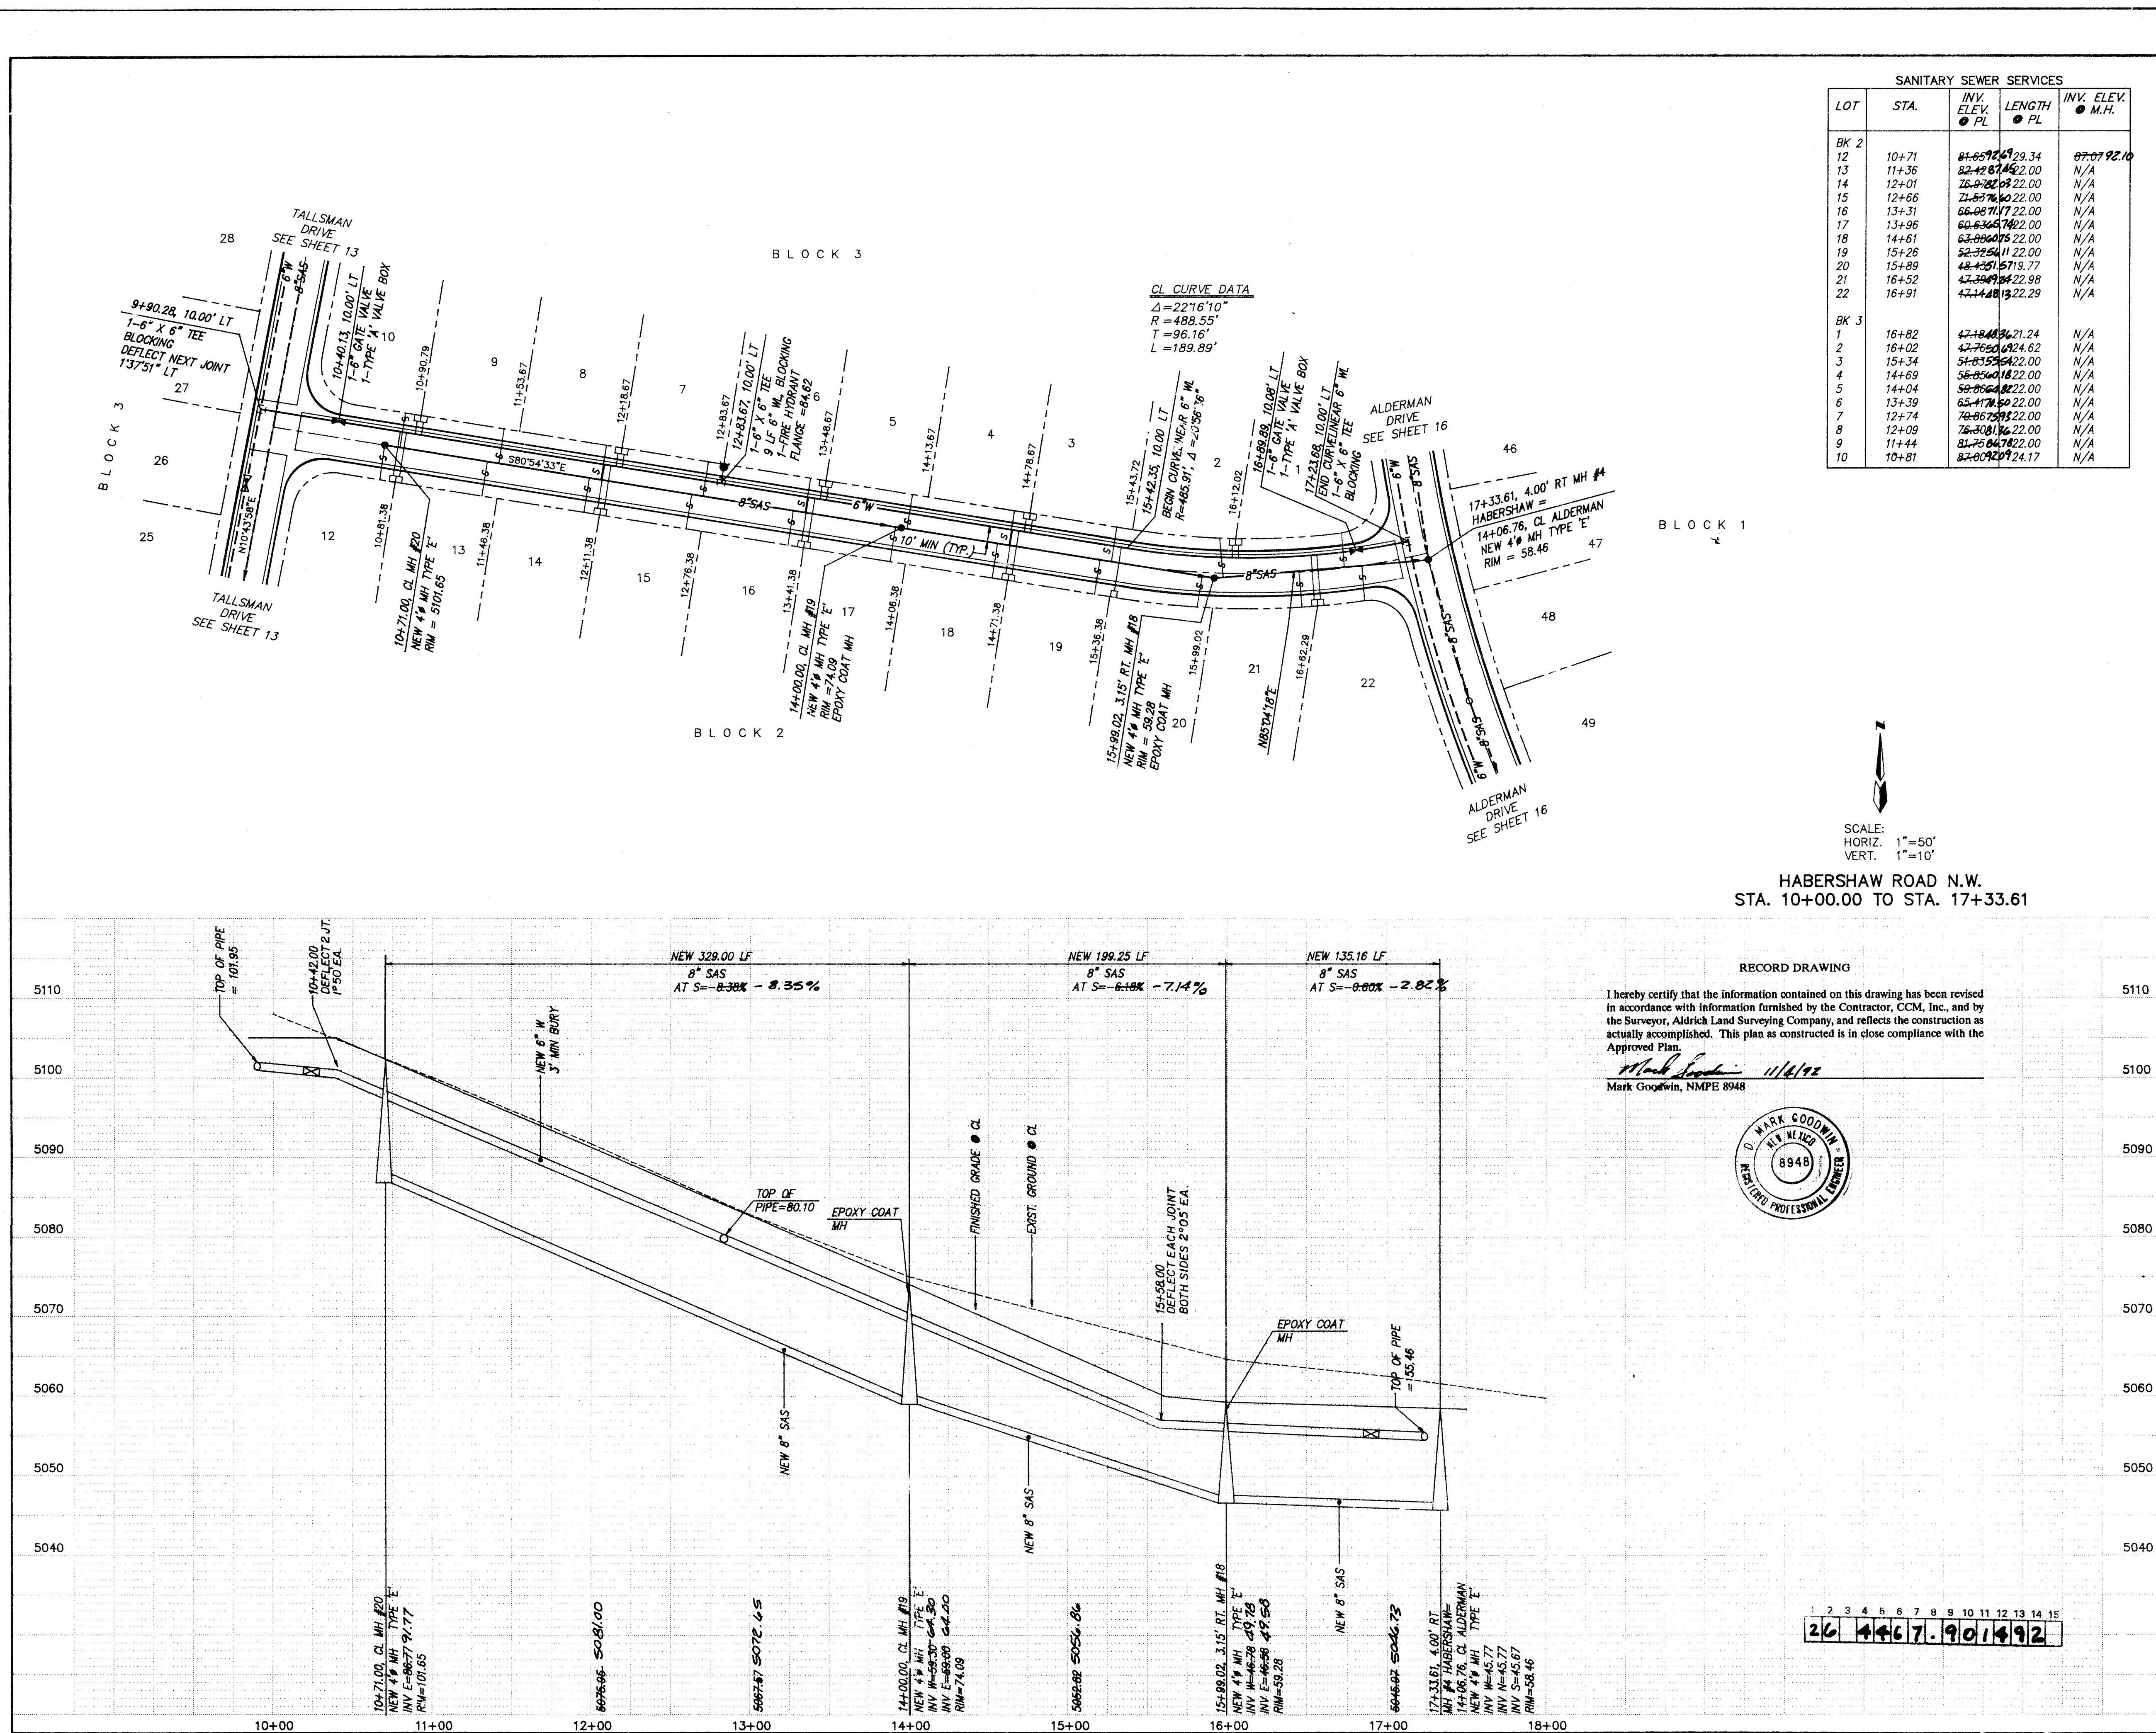

SANITARY SEWER SERVICES				
LOT	STA.	INV. ELEV. PL	LENGTH PL	INV. ELEV. M.H.
BK 2				
12	10+71	81.65	12.34	87.07
13	11+36	82.42	12.00	N/A
14	12+01	76.02	12.00	N/A
15	12+66	71.63	12.00	N/A
16	13+31	66.08	12.00	N/A
17	13+96	60.63	12.00	N/A
18	14+61	63.06	12.00	N/A
19	15+26	52.32	12.00	N/A
20	15+89	48.43	12.00	N/A
21	16+52	42.34	12.00	N/A
22	16+91	42.14	12.29	N/A
BK 3				
1	16+82	47.84	12.24	N/A
2	16+02	47.76	12.62	N/A
3	15+34	51.83	12.00	N/A
4	14+69	56.05	12.00	N/A
5	14+04	58.06	12.00	N/A
6	13+39	65.17	12.00	N/A
7	12+74	70.06	12.00	N/A
8	12+09	76.30	12.00	N/A
9	11+44	81.70	12.00	N/A
10	10+81	87.07	12.17	N/A

HABERSHAW ROAD N.W.
STA. 10+00.00 TO STA. 17+33.61

RECORD DRAWING

I hereby certify that the information contained on this drawing has been revised in accordance with information furnished by the Contractor, CCM, Inc., and by the Surveyor, Aldrich Land Surveying Company, and reflects the construction as actually accomplished. This plan as constructed is in close compliance with the Approved Plan.


Mark Goodwin, NMPE 8948



NOTES

1. ALL STATIONING IS CENTERLINE STATIONING.

AS BUILT INFORMATION		BENCH MARKS		SURVEY INFORMATION		ENGINEER'S SEAL		
CONTRACTOR	CCM	STATION MARK IS A STANDARD USCS BRASS TABLET, STAMPED		NO.	337			
WORK BY	CCM	DATE	4/92	BY	D.M.G.			
INSPECTED BY	ALS	DATE	4/92	REMARKS		DESIGNED BY DMC DATE 4/92 DRAWN BY STAFF DATE 4/92 CHECKED BY DMC DATE 4/92		
ACCEPTANCE BY	ALS	DATE	4/92	REVISIONS				
VERIFICATION BY	ALS	DATE	4/92	DESIGN				
RECORDING BY	ALS	DATE	4/92					
PROJECT NO.	4467.90	MAP NO.	E12	SHEET	14			
OF	17							

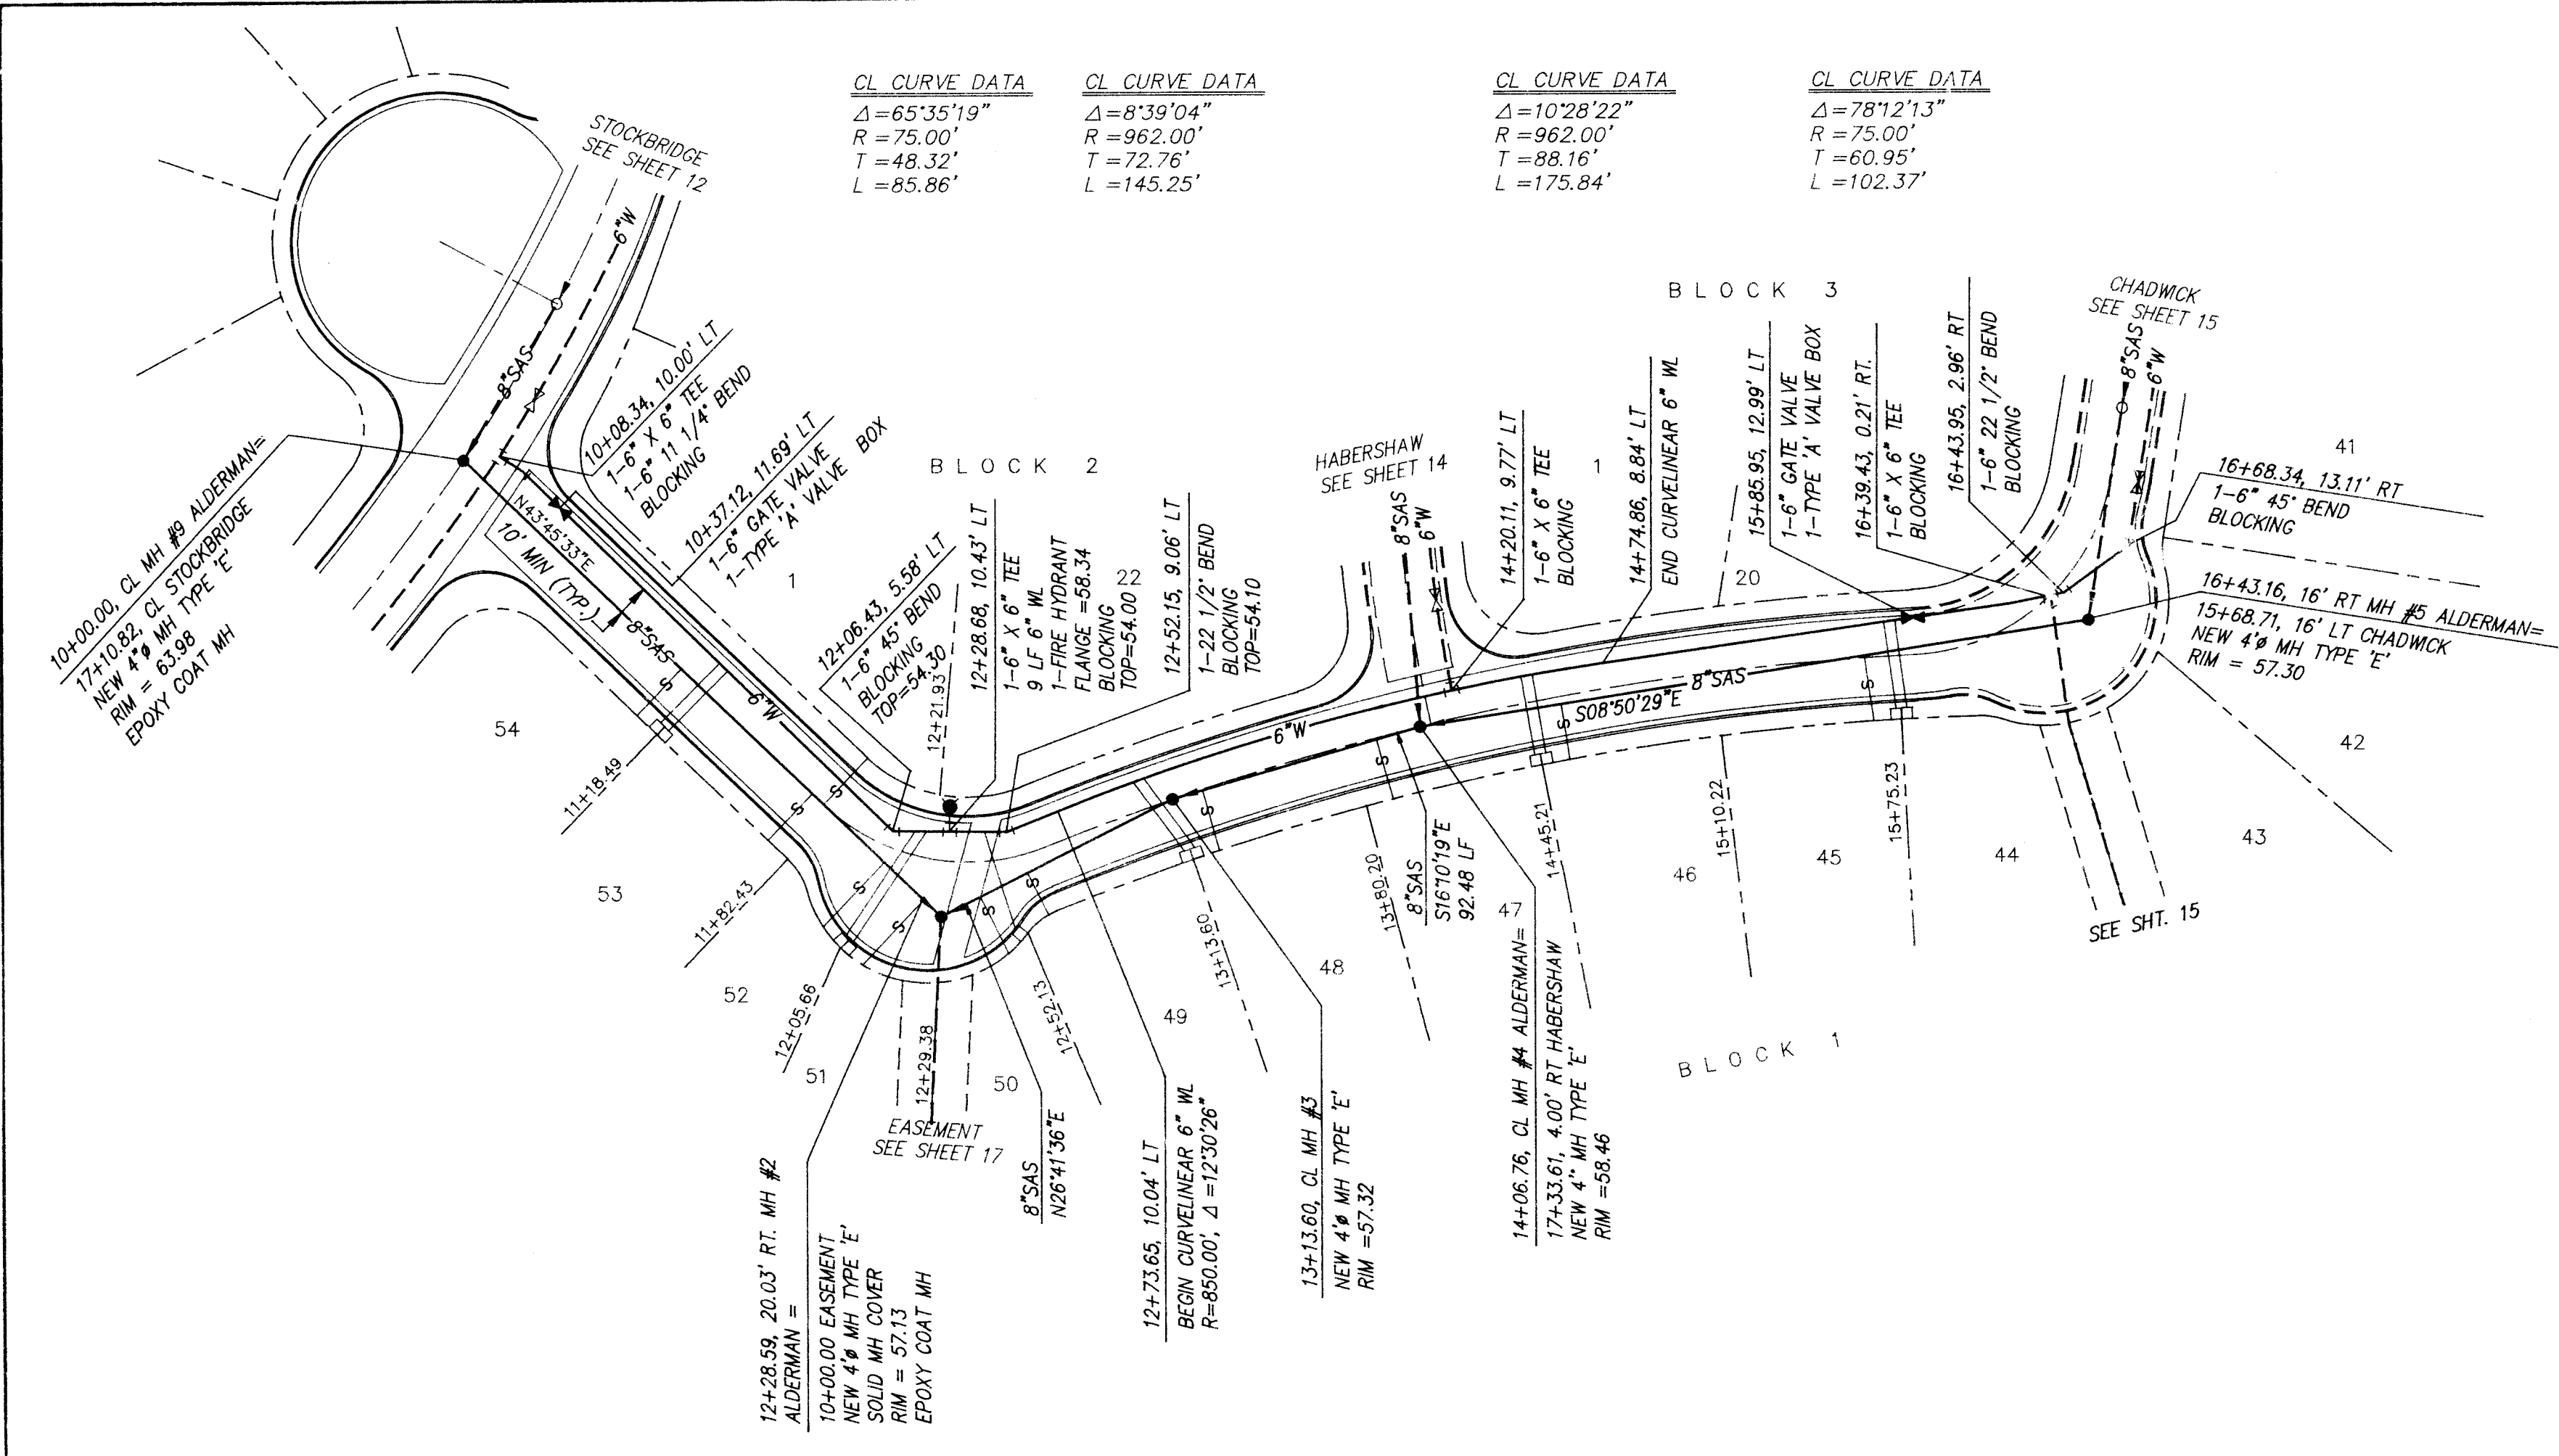

CL CURVE DATA	CL CURVE DATA	CL CURVE DATA	CL CURVE DATA
$\Delta=65^{\circ}35'19''$ $R=75.00'$ $T=48.32'$ $L=85.86'$	$\Delta=8^{\circ}39'04''$ $R=962.00'$ $T=72.76'$ $L=145.25'$	$\Delta=10^{\circ}28'22''$ $R=962.00'$ $T=88.16'$ $L=175.84'$	$\Delta=78^{\circ}12'13''$ $R=75.00'$ $T=60.95'$ $L=102.37'$

SANITARY SEWER SERVICES				
LOT	STA.	INV. ELEV. @ PL	LENGTH @ PL	INV. ELEV. AT MH
BK 1				
	15+65	47.69	23.76	N/A
	14+55	46.96	20.27	N/A
	13+90	46.52	22.36	N/A
	13+24	46.12	22.55	N/A
	12+59	45.59	22.05	N/A
	12+46	45.69	29.57	N/A
	12+12	45.90	32.05	N/A
	12+00	46.11	31.82	N/A
	11+72	46.52	23.00	N/A
54	11+08	47.01	23.00	N/A
BK 2				
1	11+79	46.28	23.00	N/A


SCALE:
HORIZ. 1" = 50'
VERT. 1" = 10'

ALDERMAN DRIVE NW
STA. 10+00.00 TO STA. 16+68.34

RECORD DRAWING

I hereby certify that the information contained on this drawing has been revised in accordance with information furnished by the Contractor, CCM, Inc., and by the Surveyor, Aldrich Land Surveying Company, and reflects the construction as actually accomplished. This plan as constructed is in close compliance with the Approved Plan.

Mark Goodwin 11/2/92
Mark Goodwin, NMPE 8948

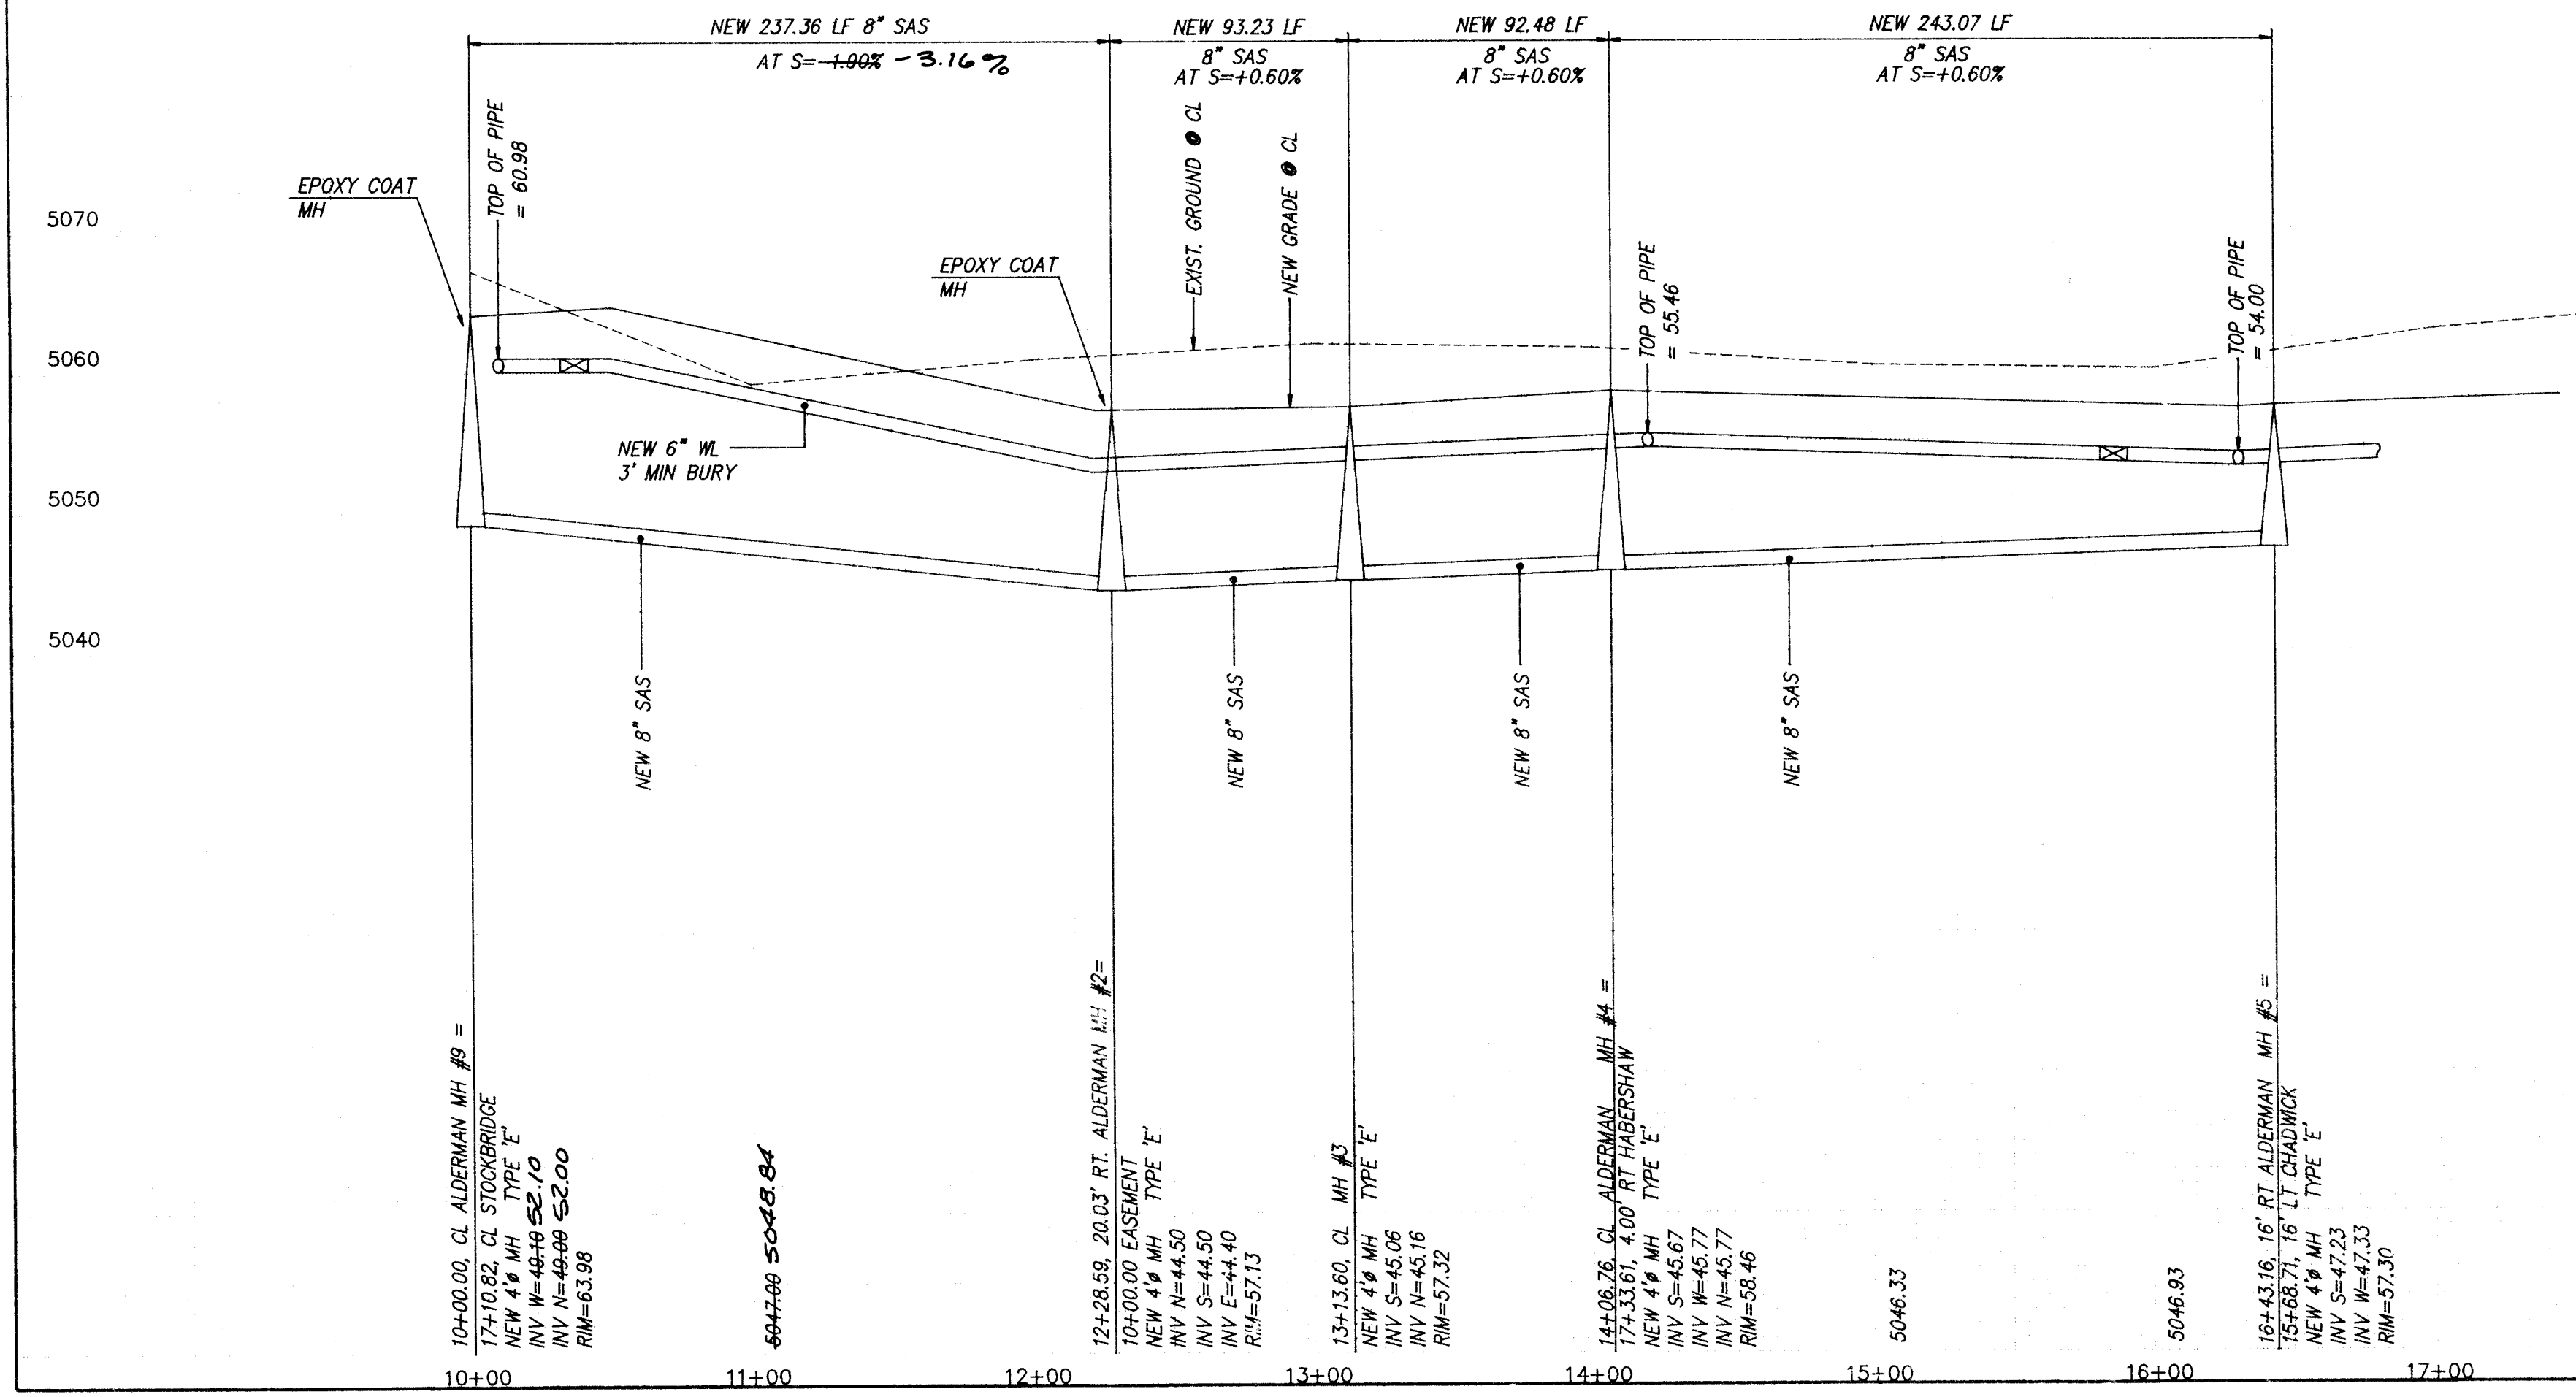

NOTES

1. ALL STATIONING IS CENTERLINE STATIONING.

AS BUILT INFORMATION		BENCH MARKS		SURVEY INFORMATION		ENGINEER'S SEAL	
CONTRACTOR	CCM	STATION MARK IS A STANDARD US&S BRASS ABILET, STAMPED "HUGHES, 1954", SET IN TOP OF A CONCRETE POST PROJECTING 0.3 FT. ABOVE THE GROUND, TO REACH THE STATION FROM THE INTERSECTION OF CENTRAL AVE. AND STATE RD. 448, GO NORTH ON STATE RD. 448, 0.7 MILES THE STATION IS WEST OF THIS POINT.	DATE	DATE	DATE	DATE	DATE
INSPECTED BY	ALS	DATE	4/92	BY	D.M.G.A.	DATE	4/92
REVIEWED BY	ALS	DATE	4/92	NO.	931	REMARKS	DESIGN
CHECKED BY	ALS	DATE	4/92	NO.		DESIGNED BY	DMG
RECORDED BY		DATE		NO.		DRAWN BY	DMG
		DATE		NO.		CHECKED BY	DMG

CITY OF ALBUQUERQUE PUBLIC WORKS DEPARTMENT ENGINEERING GROUP			
TITLE: HUNTERS RIDGE SUBDIVISION ALDERMAN DRIVE NW STA. 10+00.00 TO STA. 16+68.34 UTILITY IMPROVEMENTS			
APPROVALS	ENGINEER	DATE	APPROVALS
DRG CHAIRMAN	<i>Raymond</i>	6/1/92	WATER
TRANSPORTATION	<i>Alfred</i>	6-01-92	WASTE WATER
HYDROLOGY	N/A		
PROJECT NO.	4467.90	MAP NO.	E12
SHEET	16	OF	17

