

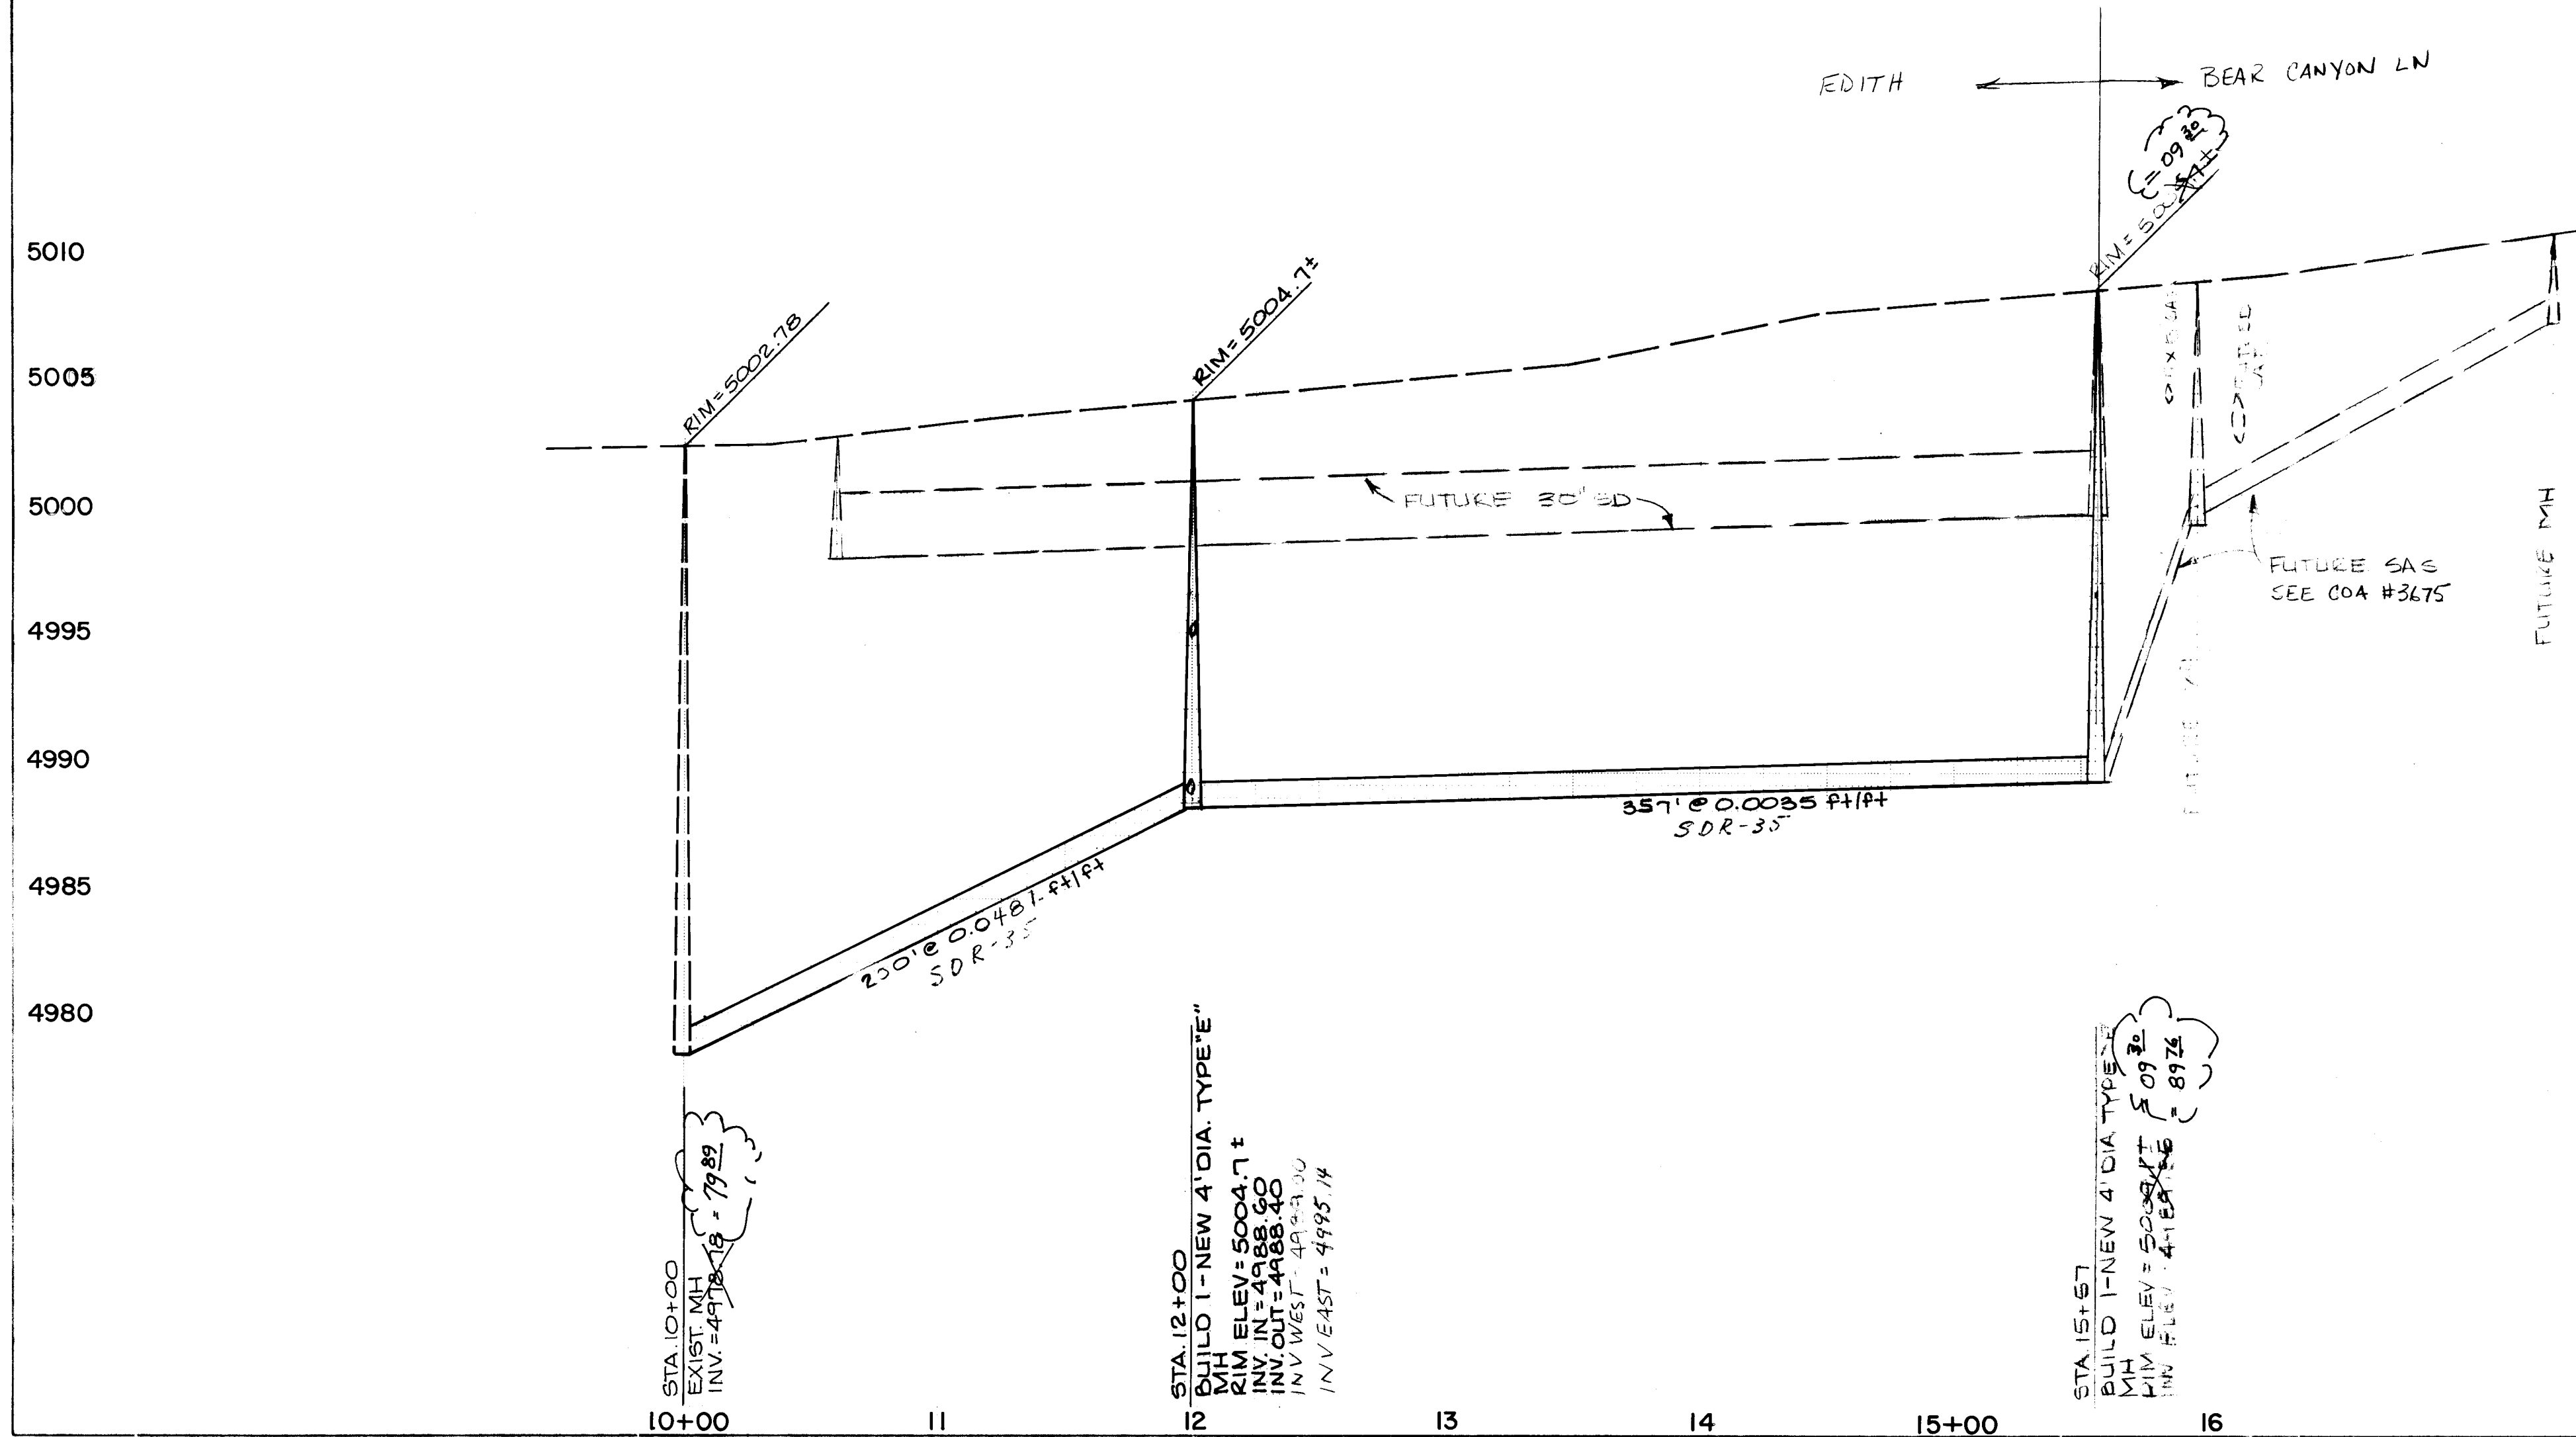


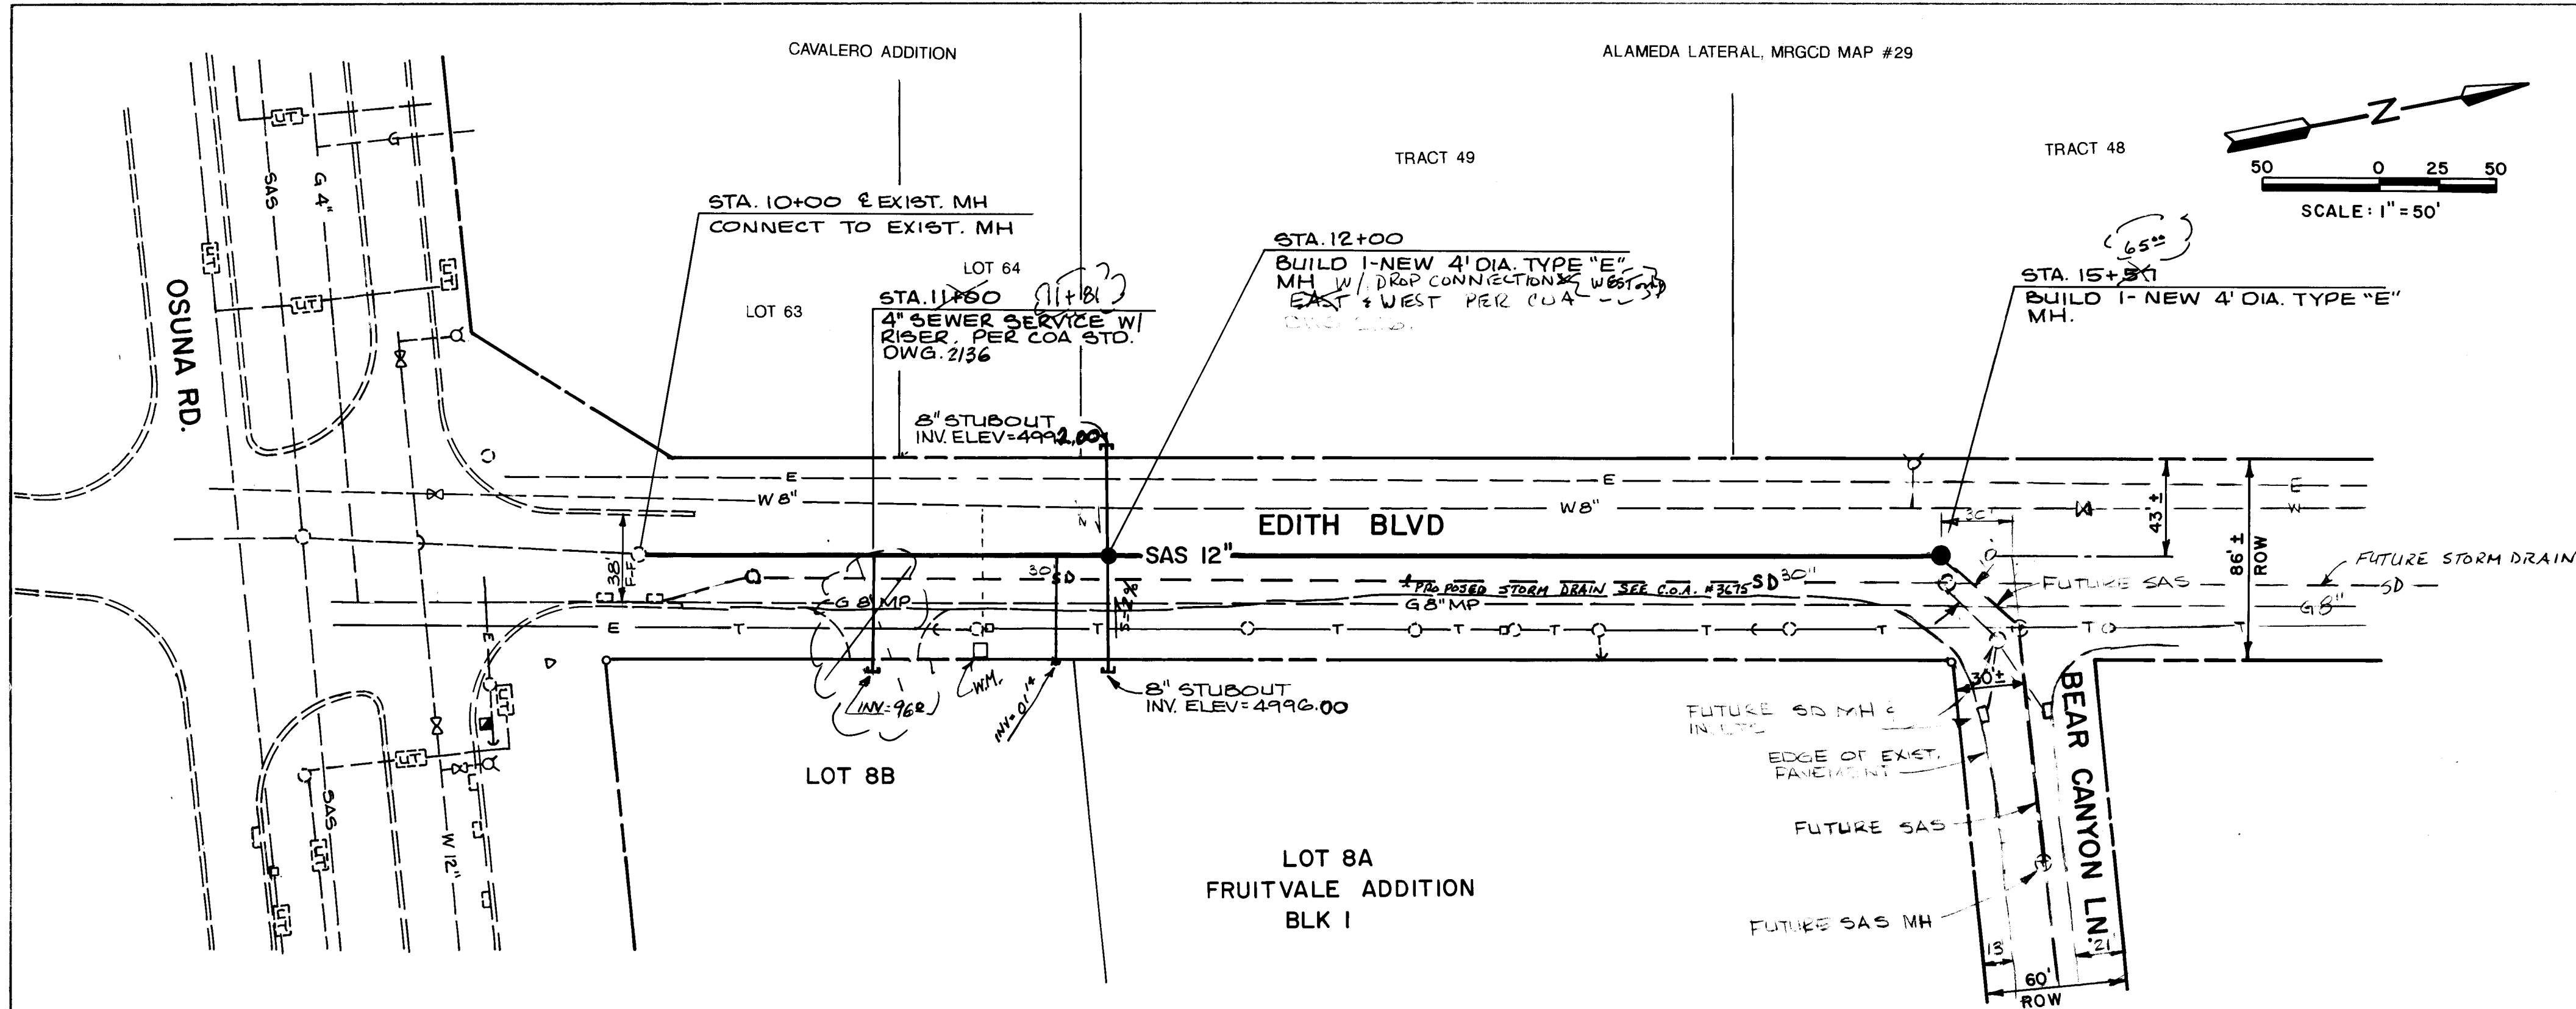

AS CONSTRUCTED

SCALE: 1"= 50' HORIZ.
1"= 5' VERT.

26 4475.900192

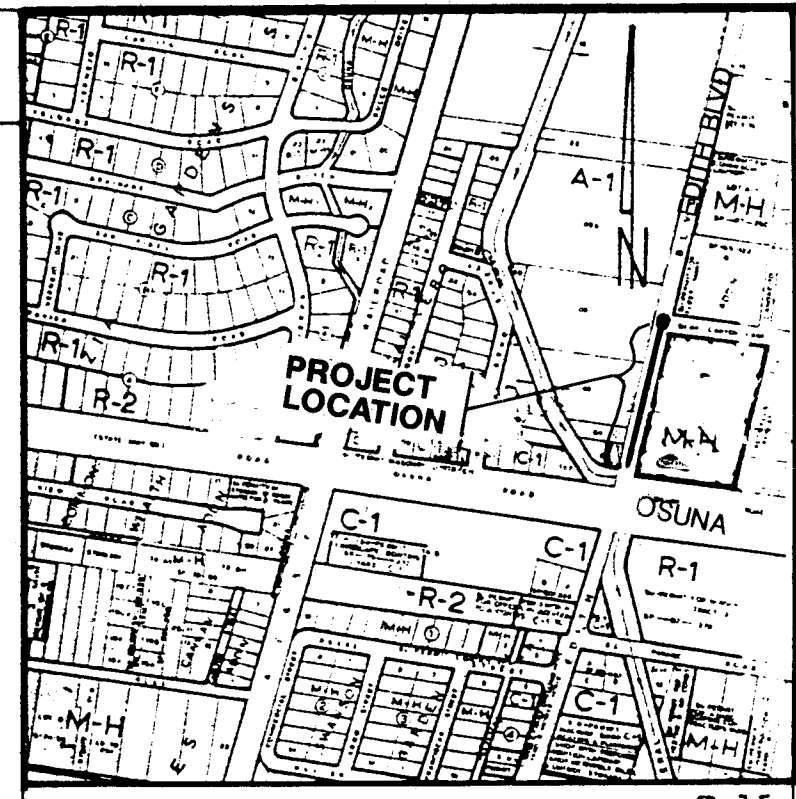

EXISTING	NEW
WATER LINE	— W —
OVERHEAD TELEPHONE OR ELECTRIC	— T —
UNDERGROUND TELEPHONE	— U —
SANITARY SEWER LINE	— SAS —
GAS LINE	— G —
POLE	○
ANCHOR	+
EDGE OF PAVEMENT	—
CURB AND GUTTER	—
FIRE HYDRANT	⊗
VALVE	⊗
STREET LIGHT	⊗
TRAFFIC SIGNAL	⊗
STORM DRAIN INLET	⊗
MANHOLE	○

ENGINEER'S SEAL	DATE
NO.	BY
REMARKS	REVISIONS
DESIGN	DATE
DATE	DATE

CITY OF ALBUQUERQUE PUBLIC WORKS DEPARTMENT ENGINEERING GROUP					
TITLE EDITH SAS EXTENSION					
APPROVALS	ENGINEER	DATE	APPROVALS	ENGINEER	DATE
DR. CHAPMAN	Rogers	9-21-92	WATER	W. H. H.	9-21-92
TRANSPORTATION	N/A		WASTE WATER	N/A	
HYDROLOGY	N/A				
PROJECT NO.	4475.90	MAP NO.	E15	SHEET	1 OF 1