


CITY OF ALBUQUERQUE, NEW MEXICO
PUBLIC WORKS DEPARTMENT

CONSTRUCTION PLANS
FOR

TRAMWAY VILLAGE APARTMENTS
FIRE HYDRANT INSTALLATION

PUBLIC
INFRASTRUCTURE IMPROVEMENTS

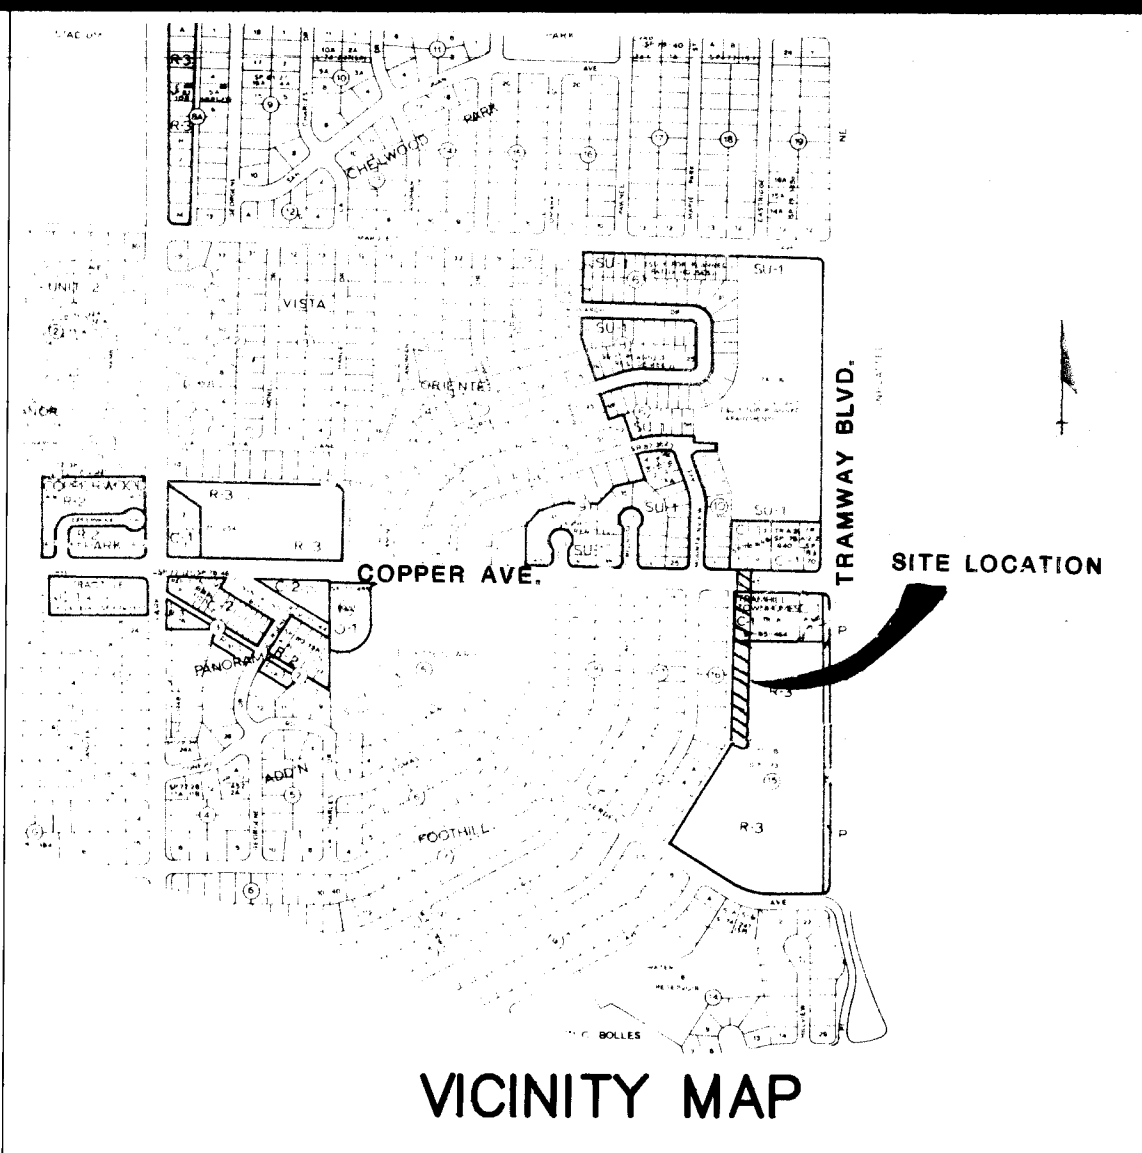

NOTES

ALL WORK DETAILED ON THESE PLANS TO BE PERFORMED UNDER CONTRACT SHALL, EXCEPT AS OTHERWISE STATED OR PROVIDED FOR HEREON, BE CONSTRUCTED IN ACCORDANCE WITH THE C.O.A. STANDARD SPECIFICATIONS FOR PUBLIC WORKS CONSTRUCTION, 1986 EDITION (REFERRED HEREIN AS THE STANDARD SPECIFICATIONS).

TWO (2) WORKING DAYS PRIOR TO ANY EXCAVATION, CONTRACTOR MUST CONTACT LINE LOCATING SERVICE, 260-1990, FOR LOCATION OF EXISTING UTILITIES.

PRIOR TO CONSTRUCTION, THE CONTRACTOR SHALL EXCAVATE AND VERIFY THE HORIZONTAL AND VERTICAL LOCATIONS OF ALL OBSTRUCTIONS. SHOULD A CONFLICT EXIST, THE CONTRACTOR SHALL NOTIFY THE ENGINEER OR SURVEYOR SO THAT THE CONFLICT CAN BE RESOLVED WITH MINIMUM AMOUNT OF DELAY.

INDEX

SHEET NO.	DESCRIPTION
1	COVER SHEET
2	WATERLINE EXTENSION P&P
3	WATERLINE EXTENTION P&P

City of Albuquerque



WILSON
& COMPANY

RECORD DRAWING
DATE 12-3-93


FILE NO. 92-512

1 2 3 4 5 6 7 8 9 10 11 12 13 14
26 4477.900193

APPROVAL OF AS BUILT DRAWINGS
CHIEF CONSTRUCTION ENGINEER
James B. Smith
DATE 12-14-93

SCANNED BY
BY LASON

REV	SHEETS	CITY ENGINEER	DATE	USER DEPT.	DATE	USER DEPT.

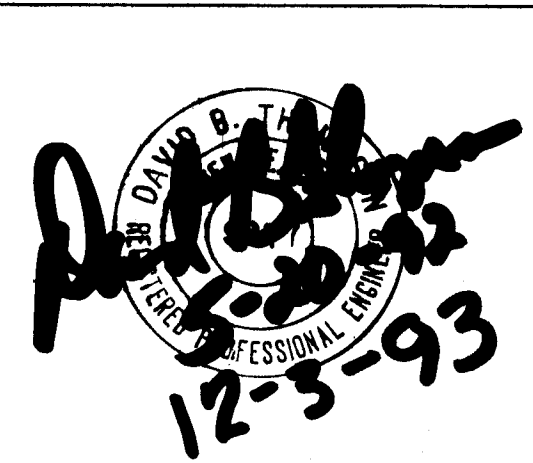


WILSON
& COMPANY
6611 GILTON CT
ALBUQUERQUE, NEW MEXICO
87109
(505) 345-9345

PROJECT No. 4477.90

APPROVED FOR
CONSTRUCTION

SHEET NO.
1 OF 3

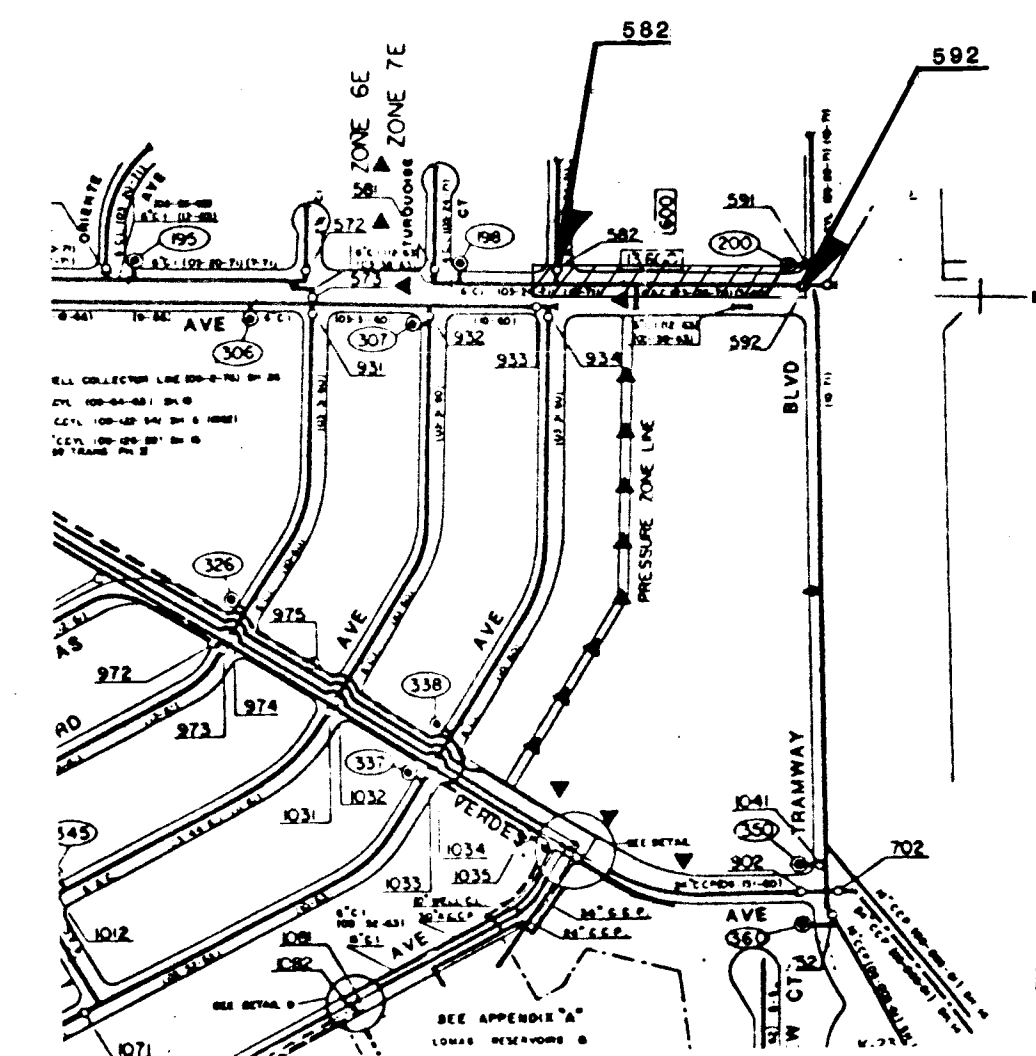

NOTES

ALL WORK DETAILED ON THESE PLANS TO BE PERFORMED UNDER CONTRACT SHALL, EXCEPT AS OTHERWISE STATED OR PROVIDED FOR HEREON, BE CONSTRUCTED IN ACCORDANCE WITH THE COA STANDARD SPECIFICATIONS FOR PUBLIC WORKS CONSTRUCTION, 1986 EDITION (REFERRED TO HEREIN AS THE STANDARD SPECIFICATIONS).

TWO (2) WORKING DAYS PRIOR TO ANY EXCAVATION, CONTRACTOR MUST CONTACT LINE LOCATING SERVICE, 260-1990, FOR LOCATION OF EXISTING UTILITIES.

PRIOR TO CONSTRUCTION, THE CONTRACTOR SHALL EXCAVATE AND VERIFY THE HORIZONTAL AND VERTICAL LOCATIONS OF ALL OBSTRUCTIONS. SHOULD A CONFLICT EXIST, THE CONTRACTOR SHALL NOTIFY THE ENGINEER OR SURVEYOR SO THAT THE CONFLICT CAN BE RESOLVED WITH MINIMUM AMOUNT OF DELAY.

TRAFFIC CONTROL

THREE (3) WORKING DAYS PRIOR TO BEGINNING CONSTRUCTION, THE CONTRACTOR SHALL SUBMIT TO THE CONSTRUCTION CO-ORDINATION DIVISION A DETAILED CONSTRUCTION SCHEDULE. TWO (2) WORKING DAYS PRIOR TO CONSTRUCTION, THE CONTRACTOR SHALL OBTAIN A BARRICADING PERMIT. CONTRACTOR SHALL NOTIFY BARRICADE ENGINEER (768-2551) PRIOR TO OCCUPANCY AN INTERSECTION. SEE SECTION 19 OF THE SPECIFICATIONS.

ALL STREET STRIPING ALTERED OR DESTROYED SHALL BE REPLACED IN KIND BY CONTRACTOR IN LOCATION AND IN KIND AS EXISTING OR AS INDICATED BY THIS PLAN SET.

WATER SHUT - OFF

THE CONTRACTOR SHALL NOTIFY WATER SYSTEMS DIVISION AT LEAST TWO WORKING DAYS IN ADVANCE OF WATERLINE IMPROVEMENTS. CALL WATER SYSTEMS DIVISION 857-8200.

SCANNED BY
BY LASON

1	2	3	4	5	6	7	8	9	10	11	12	13	14	15
26			44	77	.	9	0	0	2	9	3			

RECORD DRAWING
DATE **12-3-93**

CITY OF ALBUQUERQUE
PUBLIC WORKS DEPARTMENT
ENGINEERING GROUP

TRAMWAY VILLAGE APARTMENTS FIRE HYDRANT INSTALLATION

APPROVALS	ENGINEER	DATE	APPROVALS	ENGINEER	DATE
D.R.C. Choir.	<i>Rachel Green</i>	6/9/92	Water	<i>NLD</i>	6-2-92
Transportation	<i>R. Green</i>	6-8-92	Waste Water	<i>NLD</i>	..
Hydrology	<i>Paul Davis</i>	5/28/92			

DRAWING NO.	4477.90	MAP NO. K-22	SHEET 2	OF 3
----------------	---------	-----------------	------------	---------

CONTRACTOR	ASBESTOS REMEDIATION
WORK ORDER NO.	1013
DATE	12/11/93
ACCEPTED BY	WILSON & CO
ACCEPTANCE DATE	12/11/93
VERIFIED BY	WILSON & CO
VERIFICATION DATE	12/13/93
CORRECTED BY	WILSON & CO
CORRECTION DATE	12/13/93
NO.	

BENCH MARKS


STANDARD ACS BRASS CAP STAMPED "16-423" LOCATED
50 FEET NORTH OF THE INTERSECTION OF TRAMWAY AND
COPPER RD. IN THE NORTH MEDIAN IN TRAMWAY

[illegible][illegible]

CITY OF ALBUQUERQUE PUBLIC WORKS DEPARTMENT ENGINEERING GROUP					
TRAMWAY VILLAGE APARTMENTS FIRE HYDRANT INSTALLATION					
APPROVALS	ENGINEER	DATE	APPROVALS	ENGINEER	DATE
D.R.C. Chair.	<i>Rogel Soria</i>	<i>6/9/92</i>	Water	<i>AKL</i>	<i>6-2-92</i>
Transportation	<i>Rogel Soria</i>	<i>6-8-92</i>	Waste Water	<i>AKL</i>	..
Hydrology	<i>Paul H. Jorgensen</i>	<i>5/8/92</i>			
DRAWING NO.	4477.90	MAP NO.	K-22	SHEET	OF 3
					2 -


MATCHLINE
STA 2+12.13

SAWCUT EXISTING ASPHALT
TO PROVIDE SMOOTH EDGE
REMOVE AND REPLACE RESIDENTIAL PAVE.
SURFACE PER C.O.A. STD DWG
2465

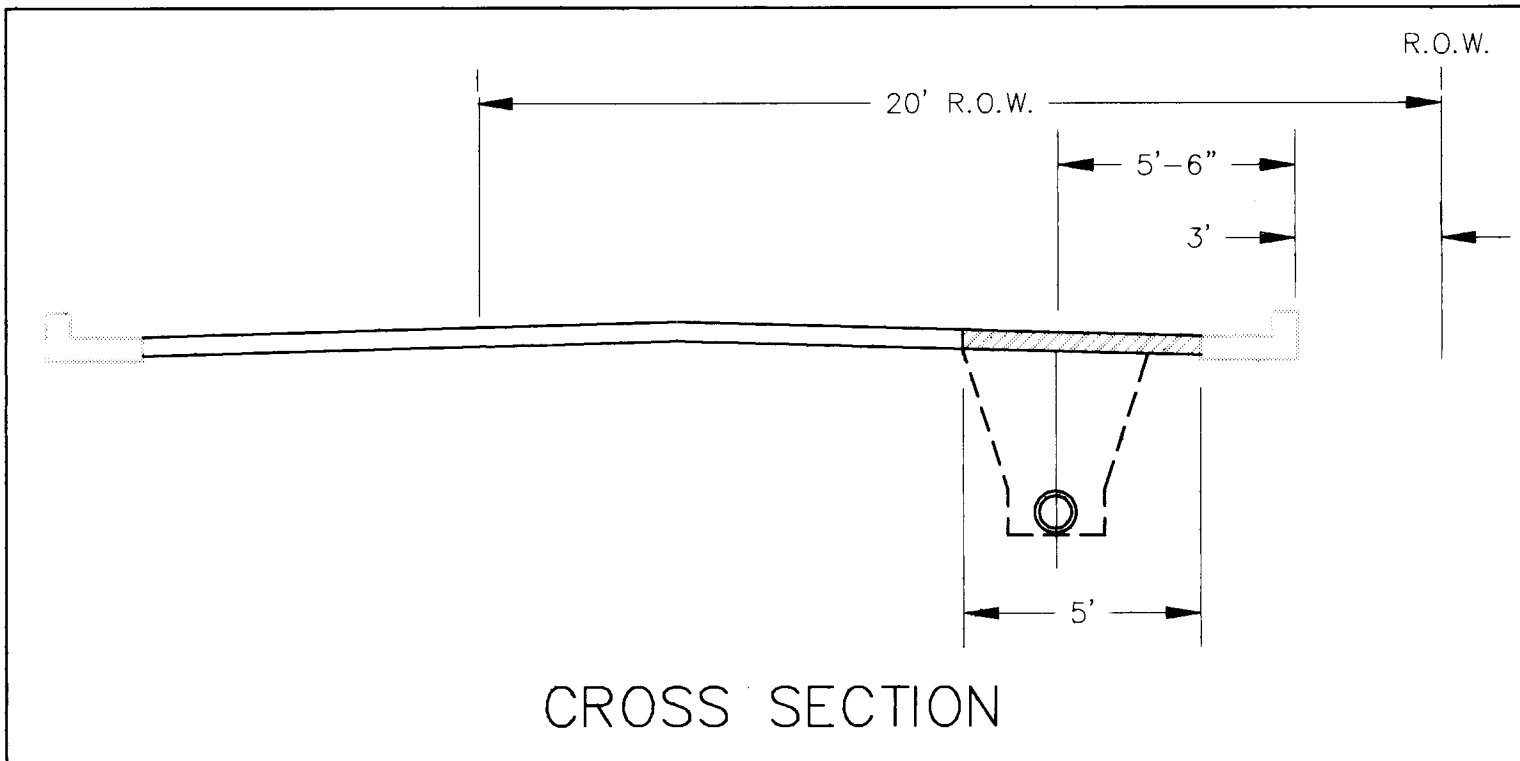

FUTURE WORK TO BE DONE BY OTHERS
INSTALL FIRE HYDRANT
REMOVE 6" CAP AND BLOCKING
INSTALL 10 LF OF 6" PVC
REMOVE APPROXIMATELY 11 FEET OF
EXISTING 6" WOOD SLAT FENCE.
RECONSTRUCT IN NEW LOCATION
NEW FENCE SHALL BE LOCATED AT MIN
OF 5' FROM THE FIRE HYDRANT

AS-BUILT
INFORMATION

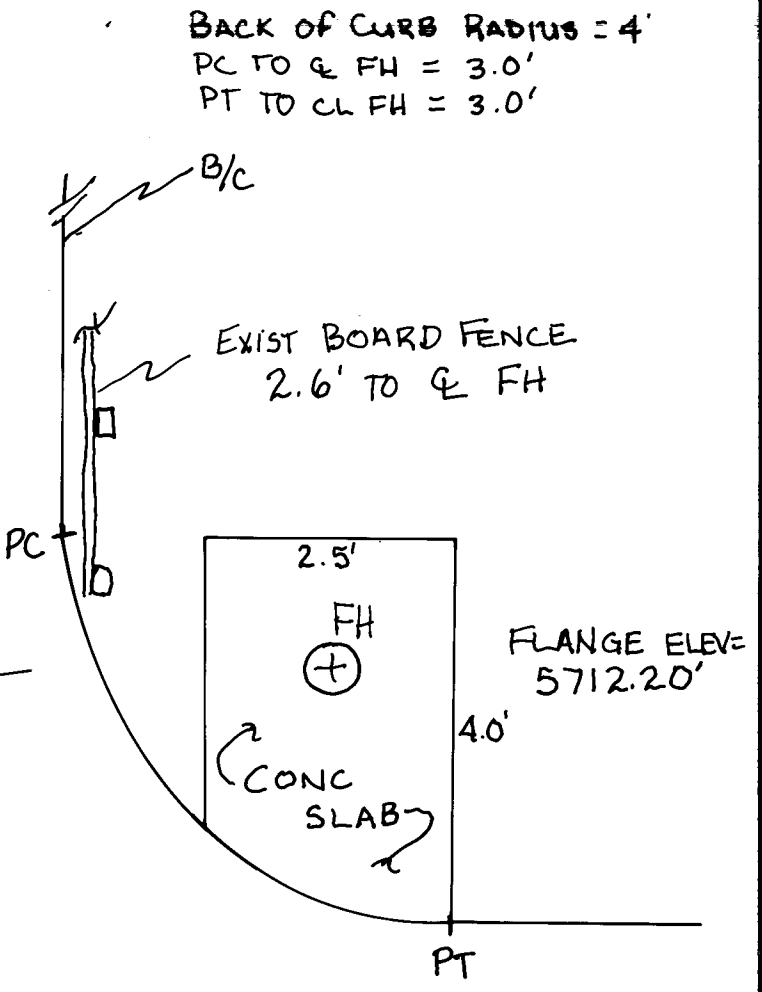

NOTES

ALL WORK DETAILED ON THESE PLANS TO BE PERFORMED UNDER CONTRACT SHALL, EXCEPT AS OTHERWISE STATED OR PROVIDED FOR HEREON, BE CONSTRUCTED IN ACCORDANCE WITH THE COA STANDARD SPECIFICATIONS FOR PUBLIC WORKS CONSTRUCTION, 1986 EDITION (REFERRED TO HEREIN AS THE STANDARD SPECIFICATIONS).

TWO (2) WORKING DAYS PRIOR TO ANY EXCAVATION, CONTRACTOR MUST CONTACT LINE LOCATING SERVICE, 260-1990, FOR LOCATION OF EXISTING UTILITIES.

PRIOR TO CONSTRUCTION, THE CONTRACTOR SHALL EXCAVATE AND VERIFY THE HORIZONTAL AND VERTICAL LOCATIONS OF ALL OBSTRUCTIONS. SHOULD A CONFLICT EXIST, THE CONTRACTOR SHALL NOTIFY THE ENGINEER OR SURVEYOR SO THAT THE CONFLICT CAN BE RESOLVED WITH MINIMUM AMOUNT OF DELAY.

TRAFFIC CONTROL

THREE (3) WORKING DAYS PRIOR TO BEGINNING CONSTRUCTION, THE CONTRACTOR SHALL SUBMIT TO THE CONSTRUCTION CO-ORDINATION DIVISION A DETAILED CONSTRUCTION SCHEDULE. TWO (2) WORKING DAYS PRIOR TO CONSTRUCTION, THE CONTRACTOR SHALL OBTAIN A BARRICADING PERMIT. CONTRACTOR SHALL NOTIFY BARRICADING ENGINEER (768-2551) PRIOR TO OCCUPYING AN INTERSECTION. SEE SECTION 19 OF THE SPECIFICATIONS.

ALL STREET STRIPING ALTERED OR DESTROYED SHALL BE REPLACED IN KIND BY CONTRACTOR IN LOCATION AND IN KIND AS EXISTING OR AS INDICATED BY THIS PLAN SET.

WATER SHUT - OFF

THE CONTRACTOR SHALL NOTIFY WATER SYSTEMS DIVISION AT LEAST TWO WORKING DAYS IN ADVANCE OF WATERLINE IMPROVEMENTS. CALL WATER SYSTEMS DIVISION 857-8200.

SCANNED BY
BY LASON

RECORD DRAWING
DATE 12-3-93

CITY OF ALBUQUERQUE PUBLIC WORKS DEPARTMENT ENGINEERING GROUP					
TRAMWAY VILLAGE APARTMENTS FIRE HYDRANT INSTALLATION					
APPROVALS	ENGINEER	DATE	APPROVALS	ENGINEER	DATE
D.R.C. Chair	Roy A. Brown	6/9/92	Water	Hudson	6-2-92
Transportation	Robert G. Brown	6/9/92	Waste Water	ADD	..
Hydrology	John J. Brown	5/18/92			
DRAWING NO.	4477.90	MAP NO.	K-22	SHEET	OF 3 - 3

AS-BUILT INFORMATION		BENCH MARKS		SURVEY INFORMATION		ENGINEER'S SEAL	
CONTRACTOR	ASHCRAFT, MECHANICAL	STANDARD ACS BRASS CAP STAMPED "16-423" LOCATED	50 FEET NORTH OF THE INTERSECTION OF TRAMWAY AND COPPER RD. IN THE NORTH MEDIAN IN TRAMWAY	DATE	4-8-92	NO.	
WORK	STATED BY WILSON	DATE	10/93	BY	WILSON & COMPANY	NO.	
DESIGNED BY	WILSON	DATE	12/93	REVISIONS	REVISIONS	NO.	
FIELD	WILSON	DATE	12/93	DESIGNED BY	WILSON & COMPANY, ENGINEERS & ARCHITECTS	NO.	
DRAWINGS	WILSON	DATE	12/93	DRAWN BY	WILSON & COMPANY, ENGINEERS & ARCHITECTS	NO.	
RECORDED BY	WILSON	DATE	12/93	CHECKED BY	WILSON & COMPANY, ENGINEERS & ARCHITECTS	NO.	
MICRO-FILM INFORMATION							