
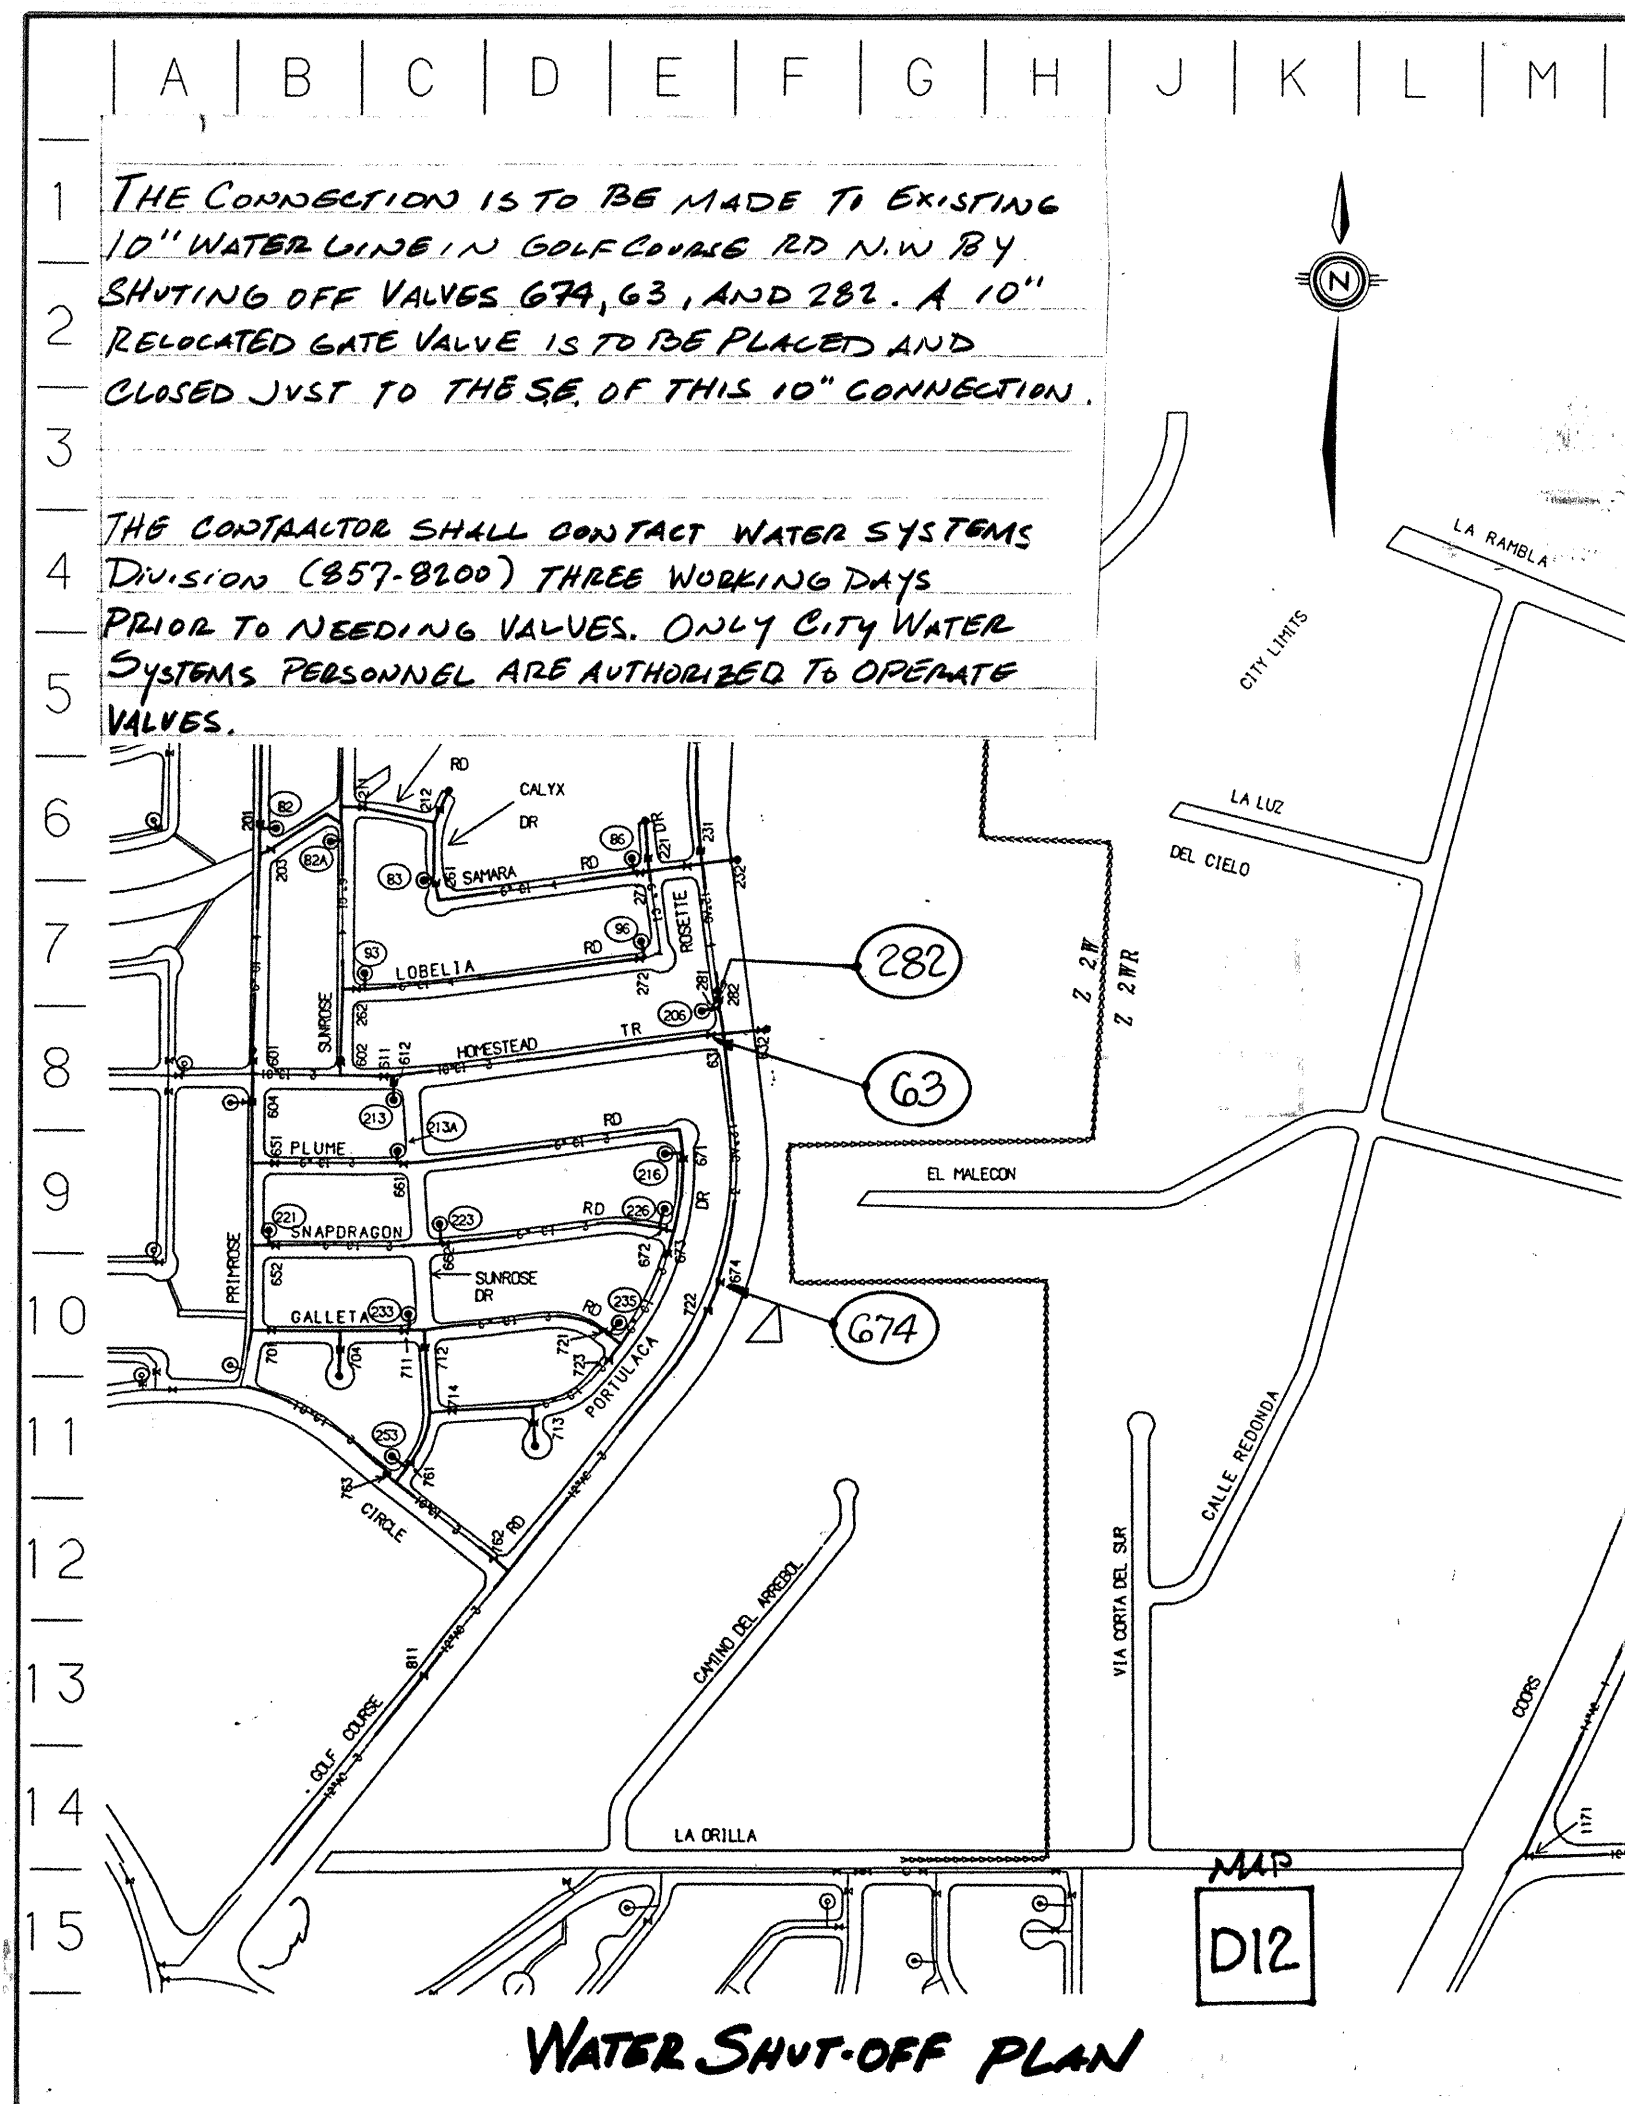
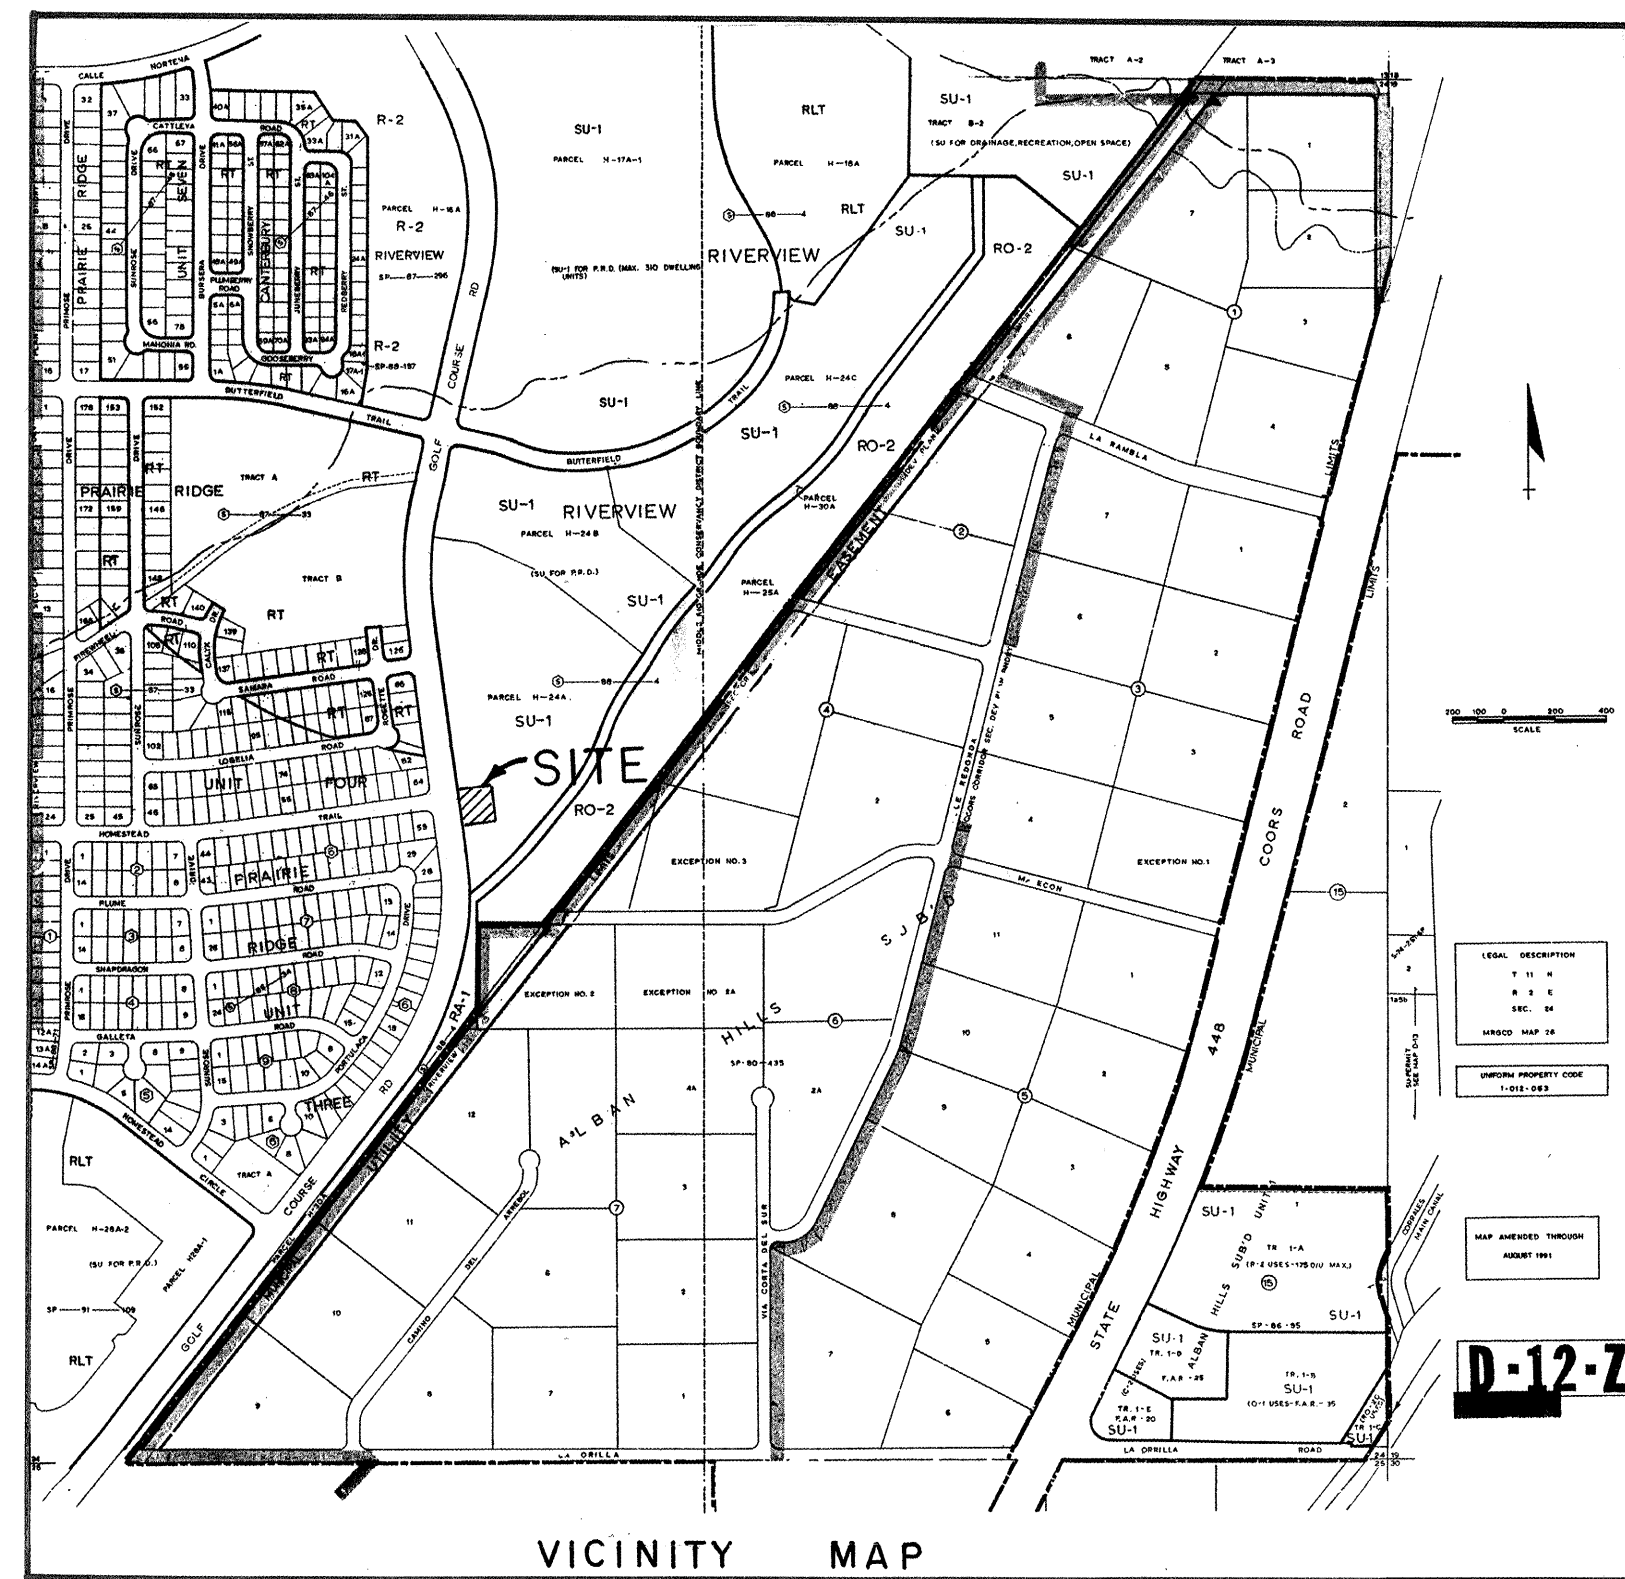
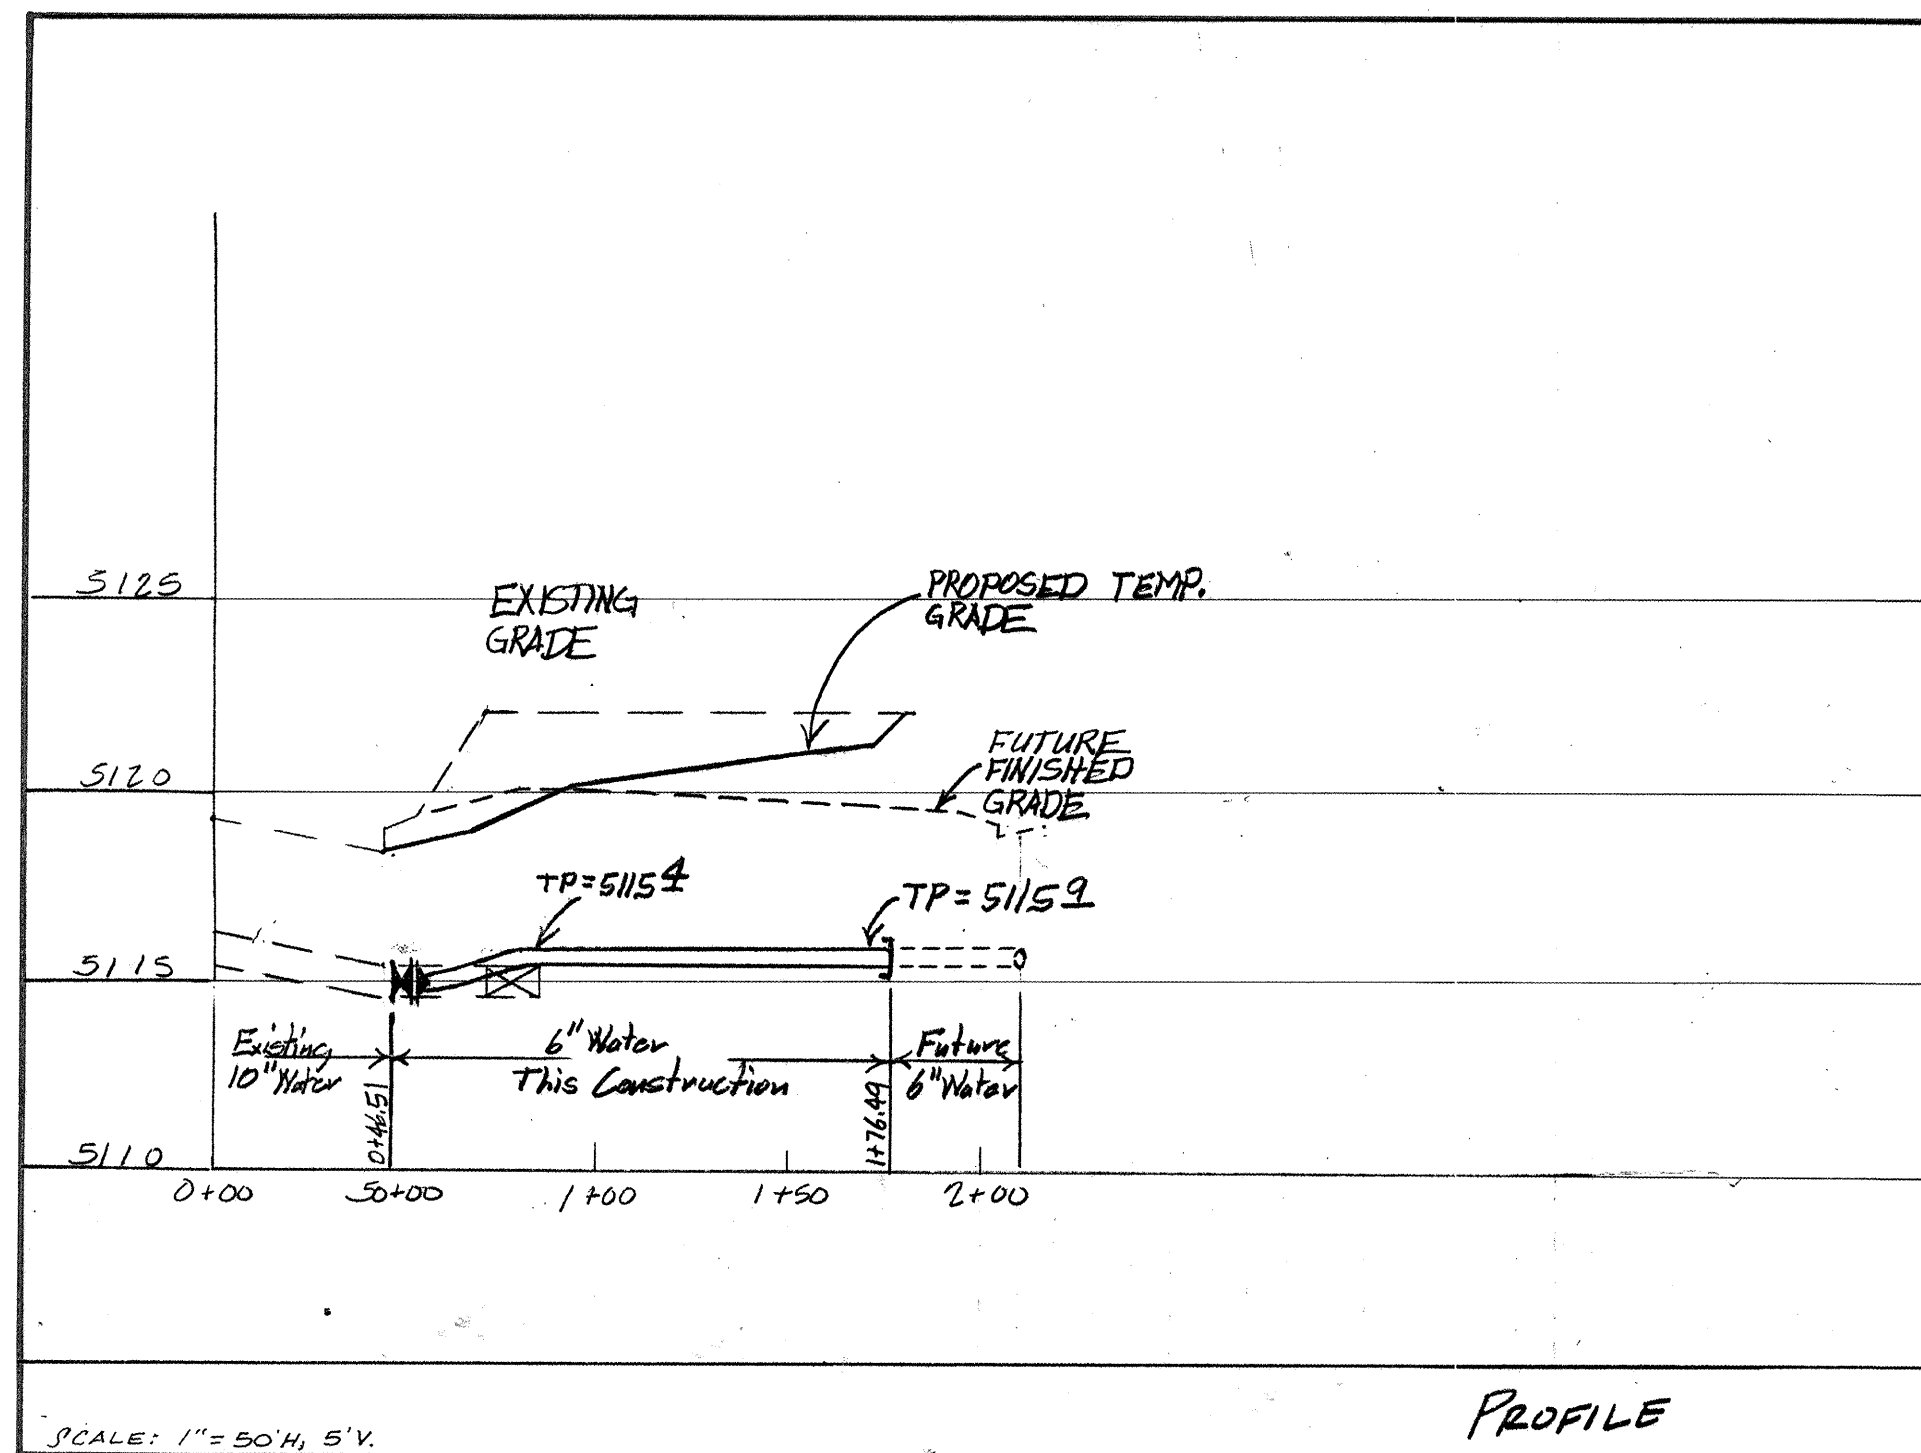


SCANNED BY
MESA REPRO

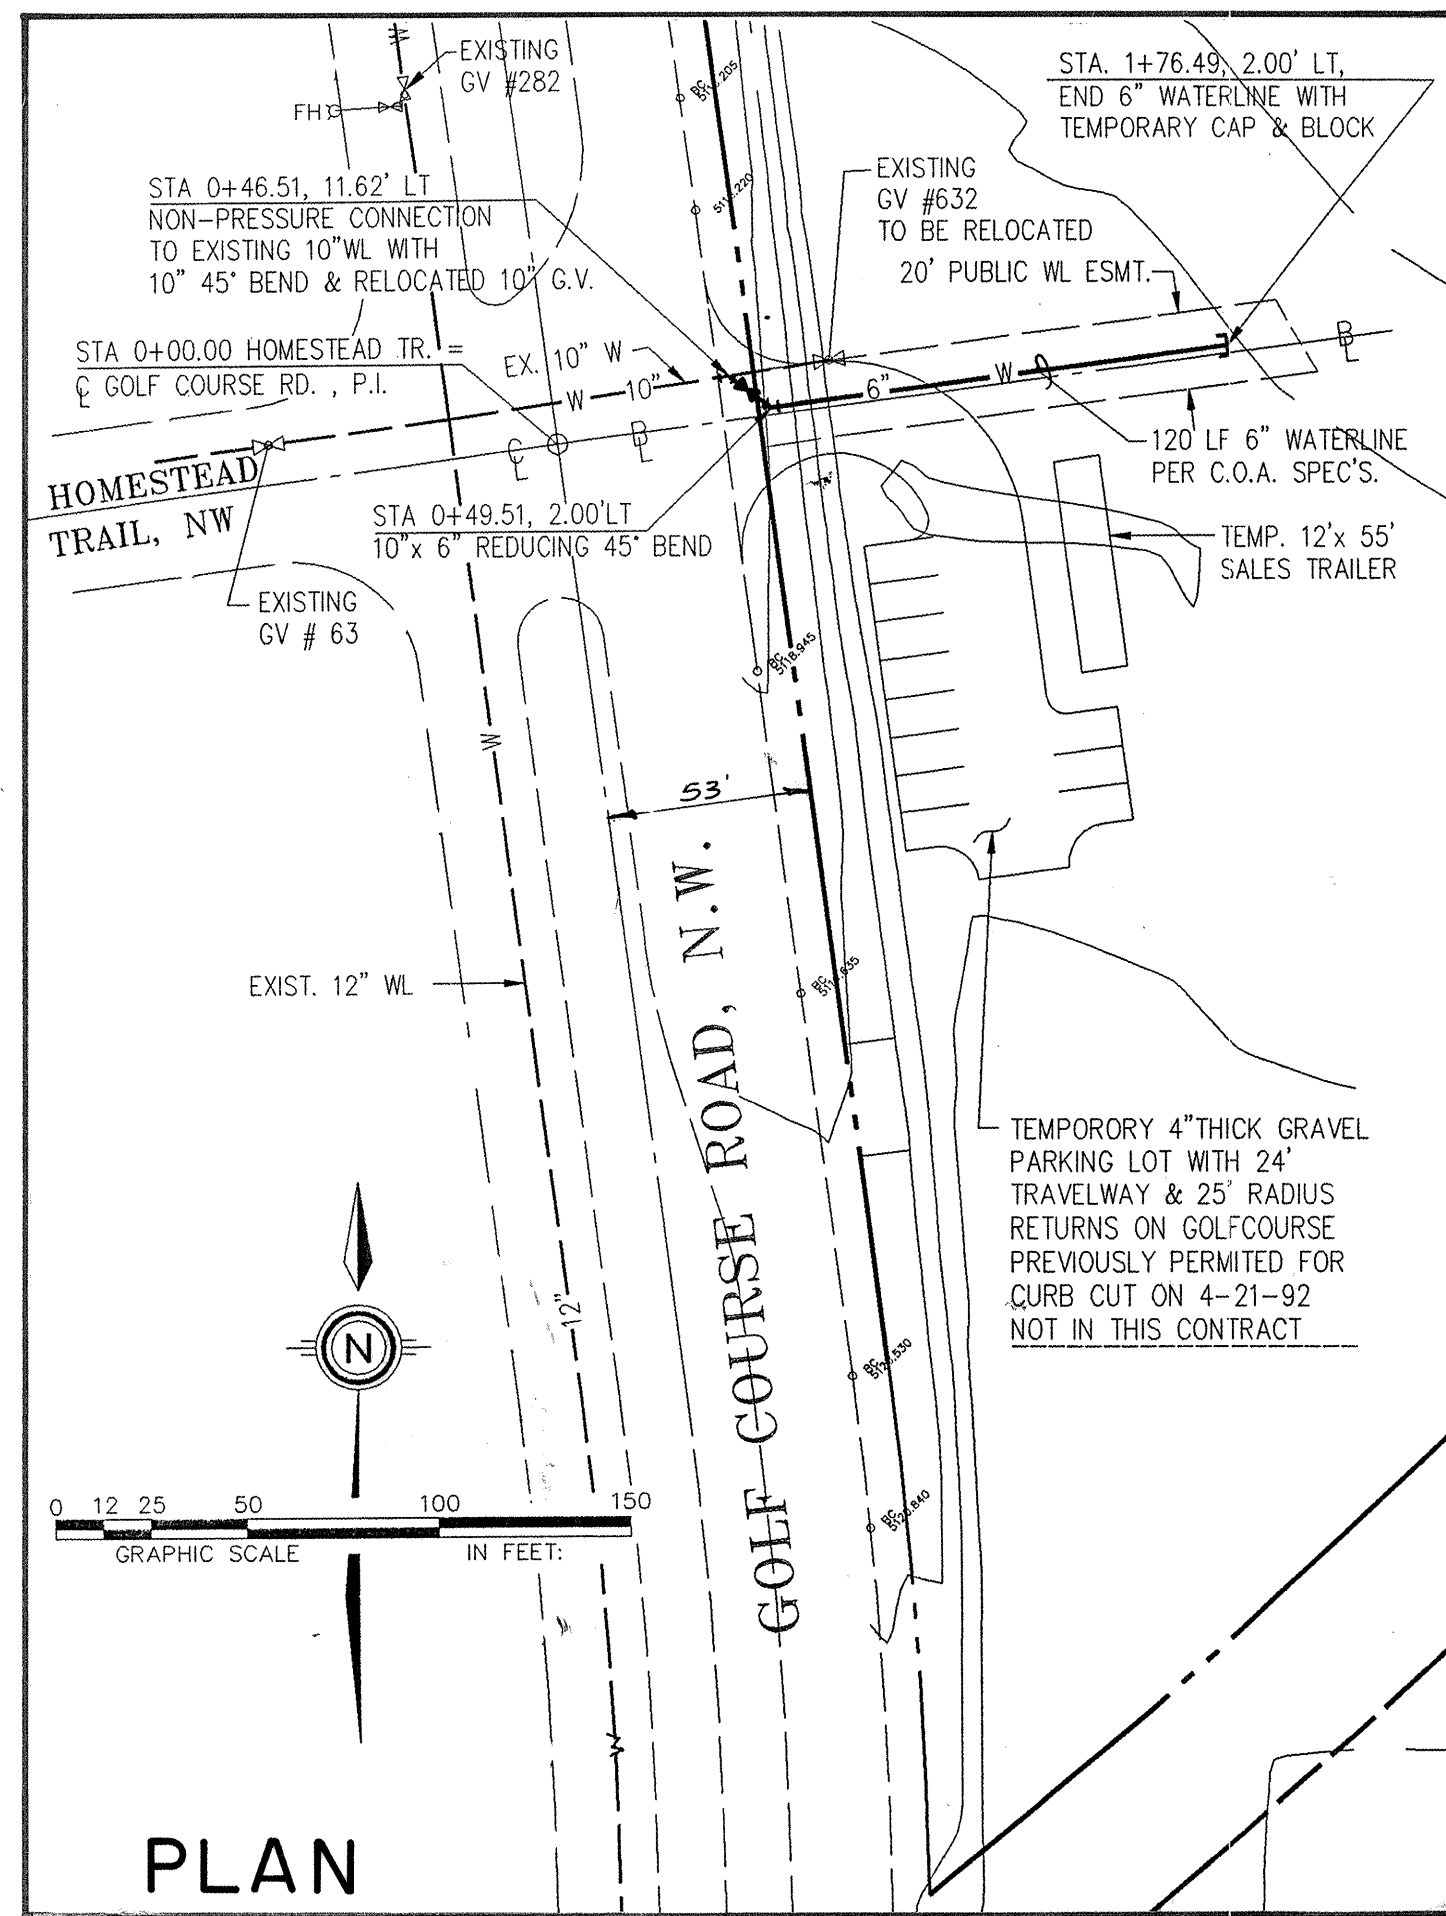

FOR INFORMATION ONLY
APPROVAL OF AS-BUILT DRAWINGS
CHIEF CONSTRUCTION ENGINEER
[Signature]
DATE 8/26/99

* RIVERTON SUBDIVISION
DRB - 91 - 392

Roger Green 6-19-92

- NOTES:
1. ALL WORK DETAILED ON THESE PLANS TO BE PERFORMED UNDER CONTRACT SHALL, EXCEPT AS OTHERWISE STATED OR PROVIDED FOR HEREON, BE CONSTRUCTED IN ACCORDANCE WITH THE CITY OF ALBUQUERQUE STANDARD SPECIFICATIONS FOR PUBLIC WORKS CONSTRUCTION 1986.
 2. TWO (2) WORKING DAYS PRIOR TO ANY EXCAVATION, CONTRACTOR MUST CONTACT LINE LOCATING SERVICE (260-1990) FOR LOCATION OF EXISTING UTILITIES.
 3. PRIOR TO CONSTRUCTION, THE CONTRACTOR SHALL EXCAVATE AND VERIFY THE HORIZONTAL AND VERTICAL LOCATIONS OF ALL OBSTRUCTIONS. SHOULD A CONFLICT EXIST, THE CONTRACTOR SHALL NOTIFY THE ENGINEER OR SURVEYOR SO THAT THE CONFLICT CAN BE RESOLVED WITH MINIMUM AMOUNT OF DELAY.
 4. THREE (3) WORKING DAYS PRIOR TO BEGINNING CONSTRUCTION, THE CONTRACTOR SHALL SUBMIT TO THE CONSTRUCTION COORDINATION DIVISION A DETAILED CONSTRUCTION SCHEDULE. TWO (2) WORKING DAYS PRIOR TO CONSTRUCTION THE CONTRACTOR SHALL OBTAIN A BARRICADING PERMIT FROM THE CONSTRUCTION COORDINATION DIVISION. CONTRACTOR SHALL NOTIFY BARRICADE ENGINEER (788-2551) PRIOR TO OCCUPANCY AN INTERSECTION. SEE SECTION 19 OF THE SPECIFICATIONS.
- ALL STREET STRIPING ALTERED OR DESTROYED SHALL BE REPLACED IN KIND BY CONTRACTOR TO LOCATION AND IN KIND AS EXISTING OR AS INDICATED BY THIS PLAN SET.

AS BUILT INFORMATION			BENCH MARKS			SURVEY INFORMATION			ENGINEER'S SEAL		
CONTRACTOR	DATE	WORKED BY	CSC TBM - NAIL & SHINER LOCATED ON EAST SIDE OF	FIELD NOTES	DATE	NO.	BY	REMARKS	NO.	DATE	BY
			MEDIAN TOP OF ASPHALT CURB GOLF COURSE					DESIGN			
			ROAD, N.W. APPROXIMATELY 90' NORTH OF THE					REVISIONS			
			INTERSECTION OF GOLF COURSE ROAD & HOMESTEAD					DESIGNED BY D.H.		DATE 5-92	
			TRAIL, N.W. ELEVATION = 5118.34					DRAWN BY J.M.B., D.H.		DATE 5-92	
								CHECKED BY		DATE	
MICRO-FILM INFORMATION											
RECORDED BY											
NO.											

DATE: 5-22-92

SCALE: AS NOTED

DESIGNED: D.H.

DRAWN: J.M.B.

JOB NO: 4487-90

LAND PLANNING: P.O. Box 1328

ENGINEERING: Corrales, N.M. 87048

SURVEYING: Corrales, N.M. 87048

community sciences corporation

CITY OF ALBUQUERQUE
PUBLIC WORKS DEPARTMENT
ENGINEERING GROUP

TITLE: RIVERTON SUBDIVISION
WATERLINE CONSTRUCTION PLANS
FOR TEMPORARY SIVAGE THOMAS HOME SALE SITE

APPROVALS	ENGINEER	DATE	APPROVALS	ENGINEER	DATE
DRG CHAIRMAN	Roger Green	6-4-92	WATER	W.B. Green	6-3-92
TRANSPORTATION	W.B. Green	6-4-92	WASTE WATER	W.B. Green	6-3-92
HYDROLOGY	J. M. B.	5-27-92			

PROJECT NO. 4487.90

MAP NO. D-12

SHEET 1 OF 1