


CONSTRUCTION PLANS
FOR
PALOMAS PARK - PHASE I & 1A
SUBDIVISION
ALBUQUERQUE, NEW MEXICO

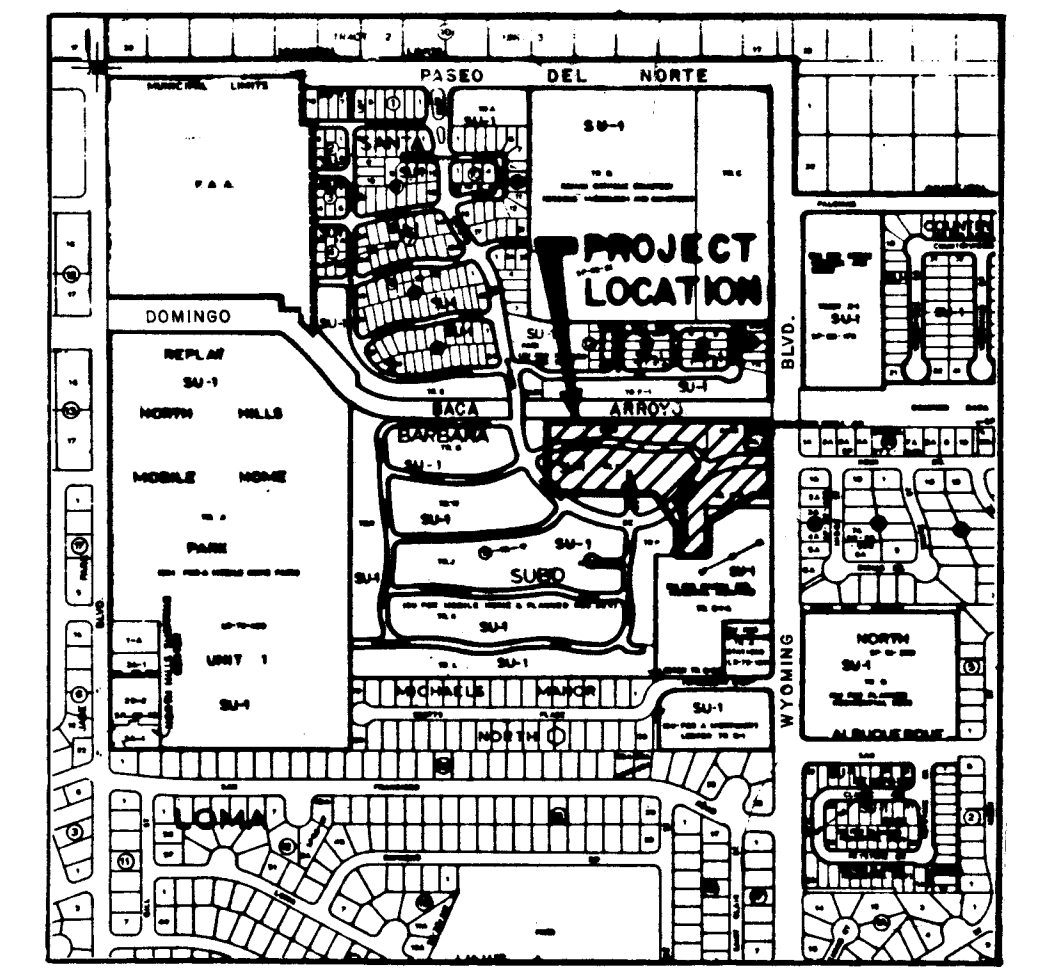

VICINITY MAP
NOT TO SCALE
D-19

NOTICE TO CONTRACTORS

- ALL WORK DETAILED ON THESE PLANS TO BE PERFORMED UNDER CONTRACT SHALL, EXCEPT AS OTHERWISE STATED OR PROVIDED FOR HEREON, BE CONSTRUCTED IN ACCORDANCE WITH THE CITY OF ALBUQUERQUE STANDARD SPECIFICATIONS FOR PUBLIC WORKS CONSTRUCTION, 1986 EDITION.
- TWO WORKING DAYS PRIOR TO ANY EXCAVATION, THE CONTRACTOR MUST CONTACT NEW MEXICO ONE CALL SYSTEM (260-1990) FOR LOCATION OF EXISTING UTILITIES.
- PRIOR TO CONSTRUCTION, THE CONTRACTOR SHALL EXCAVATE AND VERIFY THE HORIZONTAL AND VERTICAL LOCATIONS OF ALL OBSTRUCTIONS. SHOULD A CONFLICT EXIST, THE CONTRACTOR SHALL NOTIFY THE ENGINEER OR SURVEYOR IMMEDIATELY SO THAT THE CONFLICT CAN BE RESOLVED WITH A MINIMUM AMOUNT OF DELAY.
- THREE (3) WORKING DAYS PRIOR TO BEGINNING CONSTRUCTION, THE CONTRACTOR SHALL SUBMIT TO CONSTRUCTION COORDINATION DIVISION A DETAILED CONSTRUCTION SCHEDULE. TWO (2) WORKING DAYS PRIOR TO CONSTRUCTION, THE CONTRACTOR SHALL OBTAIN A BARRICADING PERMIT FROM THE CONST. COORDINATION DIVISION. CONTRACTOR SHALL NOTIFY BARRICADE ENGINEER (768-2551) PRIOR TO OCCUPYING AN INTERSECTION. SEE SECT. 19 OF THE SPECIFICATIONS. ALL STREET STRIPING ALTERED/DESTROYED SHALL BE REPLACED IN KIND BY CONTRACTOR TO LOCATION AND IN KIND AS EXISTING OR AS INDICATED BY THIS PLAN SET.
- CONTRACTOR SHALL NOTIFY THE ENGINEER NOT LESS THAN SEVEN (7) DAYS PRIOR TO STARTING WORK IN ORDER THAT THE ENGINEER MAY TAKE NECESSARY MEASURES TO INSURE THE PRESERVATION OF SURVEY MONUMENTS. CONTRACTOR SHALL NOT DISTURB PERMANENT SURVEY MONUMENTS WITHOUT THE CONSENT OF THE ENGINEER AND SHALL NOTIFY THE ENGINEER AND BEAR THE EXPENSE OF REPLACING ANY THAT MAY BE DISTURBED WITHOUT PERMISSION. REPLACEMENT SHALL BE DONE ONLY BY THE ENGINEER. WHEN A CHANGE IS MADE IN THE FINISHED ELEVATIONS OF THE PAVEMENT OF ANY ROADWAY IN WHICH A PERMANENT SURVEY MONUMENT IS LOCATED, CONTRACTOR SHALL, AT HIS OWN EXPENSE, ADJUST THE MONUMENT COVER TO THE NEW GRADE UNLESS OTHERWISE SPECIFIED. REFER TO SECTION 4.4 OF THE GENERAL CONDITIONS OF THE STANDARD SPECIFICATIONS.

THE FOLLOWING NOTES ALSO APPLY WHEN CHECKED

- ☒ ALL UTILITIES AND UTILITY SERVICE LINES SHALL BE INSTALLED PRIOR TO PAVING.
- ☒ BACKFILL COMPACTION SHALL BE ACCORDING TO SPECIFIED STREET USE.
- ☐ JACK COAT REQUIREMENTS SHALL BE DETERMINED BY THE CITY ENGINEER.
- ☒ SIDEWALKS AND WHEELCHAIR RAMPS WITHIN THE CURB RETURNS SHALL BE CONSTRUCTED WHEREVER A NEW CURB RETURN IS CONSTRUCTED.
- ☐ IF CURB IS DEPRESSED FOR A DRIVEPAD, THE DRIVEPAD SHALL BE CONSTRUCTED PRIOR TO ACCEPTANCE OF CURB AND GUTTER.
- ☒ ALL STORM DRAINAGE FACILITIES SHALL BE COMPLETED PRIOR TO FINAL ACCEPTANCE.
- ☐ THE REQUESTOR OR DEVELOPER SHALL BE RESPONSIBLE FOR REPAIR OR REPLACEMENT OF ALL CURB AND GUTTER OR SIDEWALK DAMAGED AFTER APPROVAL BY THE CITY ENGINEER OF WORK COMPLETED BY THE CONTRACTOR.

1 2 3 4 5 6 7 8 9 10 11 12 13 14 15
26 4510.900194

APPROVAL OF AS-BUILT DRAWINGS
CHIEF CONSTRUCTION ENGINEER
DATE 9-9-92

7 & 12	Deleted 16" Butterfly Valve				R.W. Kane	10-12
REV	SHEETS	CITY ENGINEER	DATE	USER DEPARTMENT	DATE	USER DEPARTMENT

APPROVAL OF REVISIONS




SURVEYOR'S CERTIFICATION

"I, Timothy Aldrich, a duly qualified Registered Professional Land Surveyor under the laws of the State of New Mexico, do hereby certify that the 'as-built' information shown on these drawings was obtained from field construction and 'as-built' surveys performed by me or under my supervision, that the 'as-built' information shown on these drawings was added by me or under my supervision, and that this 'as-built' information is true and correct to the best of my knowledge and belief." Aldrich Land Surveying is not responsible for any of the design concepts, calculations, engineering, or intent of the record drawings.

Timothy Aldrich, P.S. No. 7719 Date 4-6-93

BHI JOB NO. 91181-04

Maria A. Hays 8-7-92 SCANNED BY BY LASON	 BOHANNAN HUSTON INC. ALBUQUERQUE, NEW MEXICO ENGINEERS PLANNERS PHOTOGRAMMETRISTS	APPROVED FOR CONSTRUCTION B.L. C.E.
		PROJECT NUMBER 4510.90 SHEET 1 OF 14

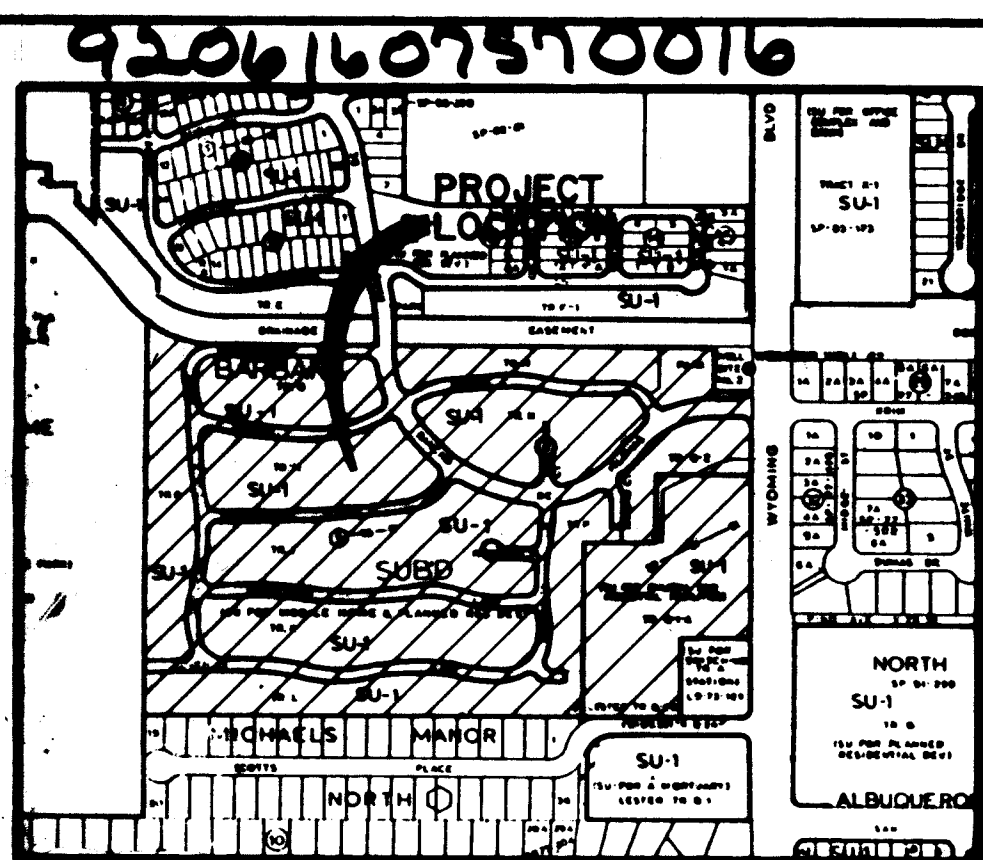

LOCATION MAP
ZONE ATLAS INDEX MAP D-19
NOT TO SCALE

SUBDIVISION DATA

1. DBB No. 91-174
2. Zone Atlas Index Number D-19-Z
3. Gross Subdivision Acres 35.3370 Acres.
4. Number of Lots Created: 19 Lots and 4 Tracts.
5. Dedicated Right-of-Way: 1.431 Acres.

NOTES

1. Bearings are New Mexico State Plane Grid Bearings (Central Zone).
2. Distances are ground distances.
3. Date of Survey: May 28, 1992.
4. Temporary Easement is shown with the granting of downstream easements and construction of a conveyance system by adjacent properties to the west.
5. Land (1.9219 Acres) dedicated to the City of Albuquerque, New Mexico for public park and a public street by Dedication and Acceptance of Dedication recorded as Document No. 88-5333, in Misc. Bk. 632-A, pages 75-79, and re-recorded as Document No. 89-50100, in Misc. Bk. 755-A, pages 950-954, records of Bernalillo County, New Mexico.
6. The 30' emergency access easement shall be for the benefit of Palomas Park Subdivision. Maintenance of said easement shall be the responsibility of Tract E.
7. City of Albuquerque water and sanitary sewer service to Palomas Park Subdivision must be verified and coordinated with the Public Works Department, City of Albuquerque.

DISCLOSURE STATEMENT

The purpose of this Report is to vacate private streets and public right-of-way redivide Tracts G, H, J, K, L, M, N, P, R, Q-2 and D-1-A, Santa Barbara Subdivision, dedicate new right-of-way and grant easements.

PUBLIC UTILITY EASEMENTS

PUBLIC UTILITY EASEMENTS shown on this plat are for the common joint use of:

- A. The Public Service Company of New Mexico for the installation, maintenance, and service of overhead and underground electrical lines, transformers, and other equipment, structures, and related facilities reasonably necessary to provide electrical service.
- B. The Gas Company of New Mexico for installation, maintenance, and service of natural gas lines, valves and other equipment and facilities reasonably necessary to provide natural gas.
- C. U.S. West for the installation, maintenance, and service of all buried and aerial communication lines and other related equipment and facilities reasonably necessary to provide communication services, including but not limited to above ground pedestals and closures.
- D. Jones Interconnect for the installation, maintenance, and service of such lines, cables, and other related equipment and facilities reasonably necessary to provide Cable TV service.

Included is the right to build, rebuild, construct, reconstruct, locate, relocate, change, remove, modify, renew, operate, and maintain facilities for the purposes described above, together with free access to, from, and over said easements, including sufficient working area space for electric transformers, with the right and privilege to trim and remove trees, shrubs or bushes which interfere with the purposes set forth herein. No building, sign, pool (above ground or subsurface), hot tub, canopy or wood pool decking, or other structure shall be erected or constructed on said easements, nor shall any well be drilled or operated thereon. Property owners shall be solely responsible for correcting any violations of National Electric Safety Code caused by construction of pools, decking, or any structures adjacent to or near easements shown on this plat.

DESCRIPTION

A certain tract of land situated within the Elena Gallages Grant, in the northwest one-quarter (1/4) of projected Section 19, Township 11 North, Range 4 East, New Mexico Principal Meridian, Bernalillo County, Albuquerque, New Mexico, being and comprising all of Tracts G, H, J, K, L, M, N, P, R, Q-2 and D-1-A, together with the interior private streets lying south of the Domingo Baca Arroyo (Rancho De Palomas, Hummingbird Lane, Skylark Avenue, Mockingbird Lane, Kingfisher Lane, Lovebird Lane, Partridge Drive, Partridge Place, Partridge Court, Golden Eagle Drive and Rancho Court), together with a Public Park as the same are shown and designated on the plat of SANTA BARBARA SUBDIVISION recorded in the office of the County Clerk of Bernalillo County, New Mexico on January 21, 1986, in Volume C29, Folio 85, together with Tract Q-2 and Tract Q-1-A, SANTA BARBARA SUBDIVISION as the same is shown and designated on the plat recorded in the office of the County Clerk of Bernalillo County, on July 1, 1991 in Volume 91C, Folio 134, together with the remaining portion of Rancho De Palomas, a public street, now comprising PALOMAS PARK SUBDIVISION is with free consent and in accordance with the desires of the undersigned owner(s) and/or proprietor(s) thereof, and said owner(s) and/or proprietor(s) do hereby dedicate additional road right-of-way and do hereby grant all easements shown on this plat. Electrical Power and Communication easements are reserved for overhead distribution lines for pole type utilities and buried distribution lines, conduits, and pipes for underground utilities and other related equipment shown or indicated, and including the right of ingress and egress for construction and maintenance, and the right to trim interfering trees and shrubs.

BEGINNING at the northeasterly corner of said Public Park, a point on the southerly right-of-way line of the Domingo Baca Arroyo, and the northeasterly corner of the Alameda Zone, Lot 11-A, 2, whence the Central Monument "HEAVEN 1969", a U.S.C. and G.S. brass cap (having New Mexico State Plane Coordinates, Central Zone, X=407.051-31 and Y=1,518.737-03) bears N15°01'24"W, a distance of 1336.98 feet and from said point of beginning running along the southerly boundary line of the tract herein described:

S00°08'23"W, a distance of 115.00 feet to the southwest corner of said Wall Site, thence: S89°54'17"E, a distance of 90.73 feet to a point on curve (containing) thence:

3.66 feet along the arc of a curve to the left having a radius of 25.00 feet and a chord bearing N04°20'15"E a distance of 3.66 feet to a point on the westerly right-of-way line of the Domingo Baca Arroyo, thence leaving said Wall Site and running along said right-of-way line and said southerly boundary line:

S00°08'23"W, a distance of 667.47 feet to the northeast corner of Tract A, MOUNTAIN BELL, as described in a Warranty Deed filed in the office of the County Clerk of Bernalillo County, New Mexico on April 13, 1973, in Deed Book 940, page 278; thence leaving said right-of-way line and continuing along said southerly boundary line:

N89°37'37"W, a distance of 176.00 feet to the northeast corner of said Tract A, thence:

S00°08'23"W, a distance of 208.00 feet to a point on the northerly boundary line of MICHAELS MANOR NORTH as the same is shown and designated on the plat recorded in the office of the County Clerk of Bernalillo County, New Mexico on February 22, 1980 in Volume D9, Folio 197, being the southeast corner of said Tract A, the southeasterly corner of said Tract Q-1-A, and the southeasterly corner of the tract herein described; thence running along the northerly boundary line of said MICHAELS MANOR NORTH and the southerly boundary line of the tract herein described:

N89°37'37"W, a distance of 1435.07 feet to a point on the southerly boundary line of UNIT 1, NORTH HILLS MOBILE HOME PARK as the same is shown and designated on the plat recorded in the office of the County Clerk of Bernalillo County, New Mexico on December 12, 1973 in Volume D5, Folio 187 and the southeasterly corner of the tract herein described; thence running along the southerly boundary line of said UNIT 1, NORTH HILLS MOBILE HOME PARK and the westerly boundary line of the tract herein described:

N00°08'23"E, a distance of 1029.77 feet to a point on a curve on the southerly right-of-way line of the Domingo Baca Arroyo and the northeasterly corner of the tract herein described; thence running along said southerly right-of-way line and the northerly boundary line of the tract herein described:

182.35 feet along the arc of a curve to the left having a radius of 318.70 feet and a chord bearing S73°30'46"E, a distance of 179.88 feet to a point of tangency thence:

S89°54'17"E, a distance of 1347.45 feet to the point and place of beginning.

Tract contains 35.3370 acres, more or less.

APPROVALS

PLAT NUMBER

PLANNING DIRECTOR

DATE

CITY ENGINEER

DATE

A.M.P. P.E.A.

DATE

TRAFFIC ENGINEER

DATE

CITY SURVEYOR

DATE

PROPERTY MANAGEMENT

DATE

UTILITY DEVELOPMENT DEPARTMENT

DATE

PARK AND RECREATION DEPARTMENT

DATE

PUBLIC SERVICE COMPANY OF NEW MEXICO

DATE

U.S. WEST COMMUNICATIONS

DATE

GAS COMPANY OF NEW MEXICO

DATE

THIS IS TO CERTIFY THAT TAXES ARE CURRENT AND PAID

ON UPC#

PROPERTY OWNER OF RECORD:

BERNALILLO COUNTY TREASURER'S OFFICE

DATE

PLAT OF PALOMAS PARK SUBDIVISION ALBUQUERQUE, NEW MEXICO JUNE, 1992

FREE CONSENT AND DEDICATION

The foregoing Report of that certain tract of land situated within the Elena Gallages Grant, in the northwest one-quarter (1/4) of projected Section 19, Township 11 North, Range 4 East, New Mexico Principal Meridian, Bernalillo County, Albuquerque, New Mexico, being and comprising all of Tracts G, H, J, K, L, M, N, P, R, Q-2 and D-1-A, together with the interior private streets lying south of the Domingo Baca Arroyo (Rancho De Palomas, Hummingbird Lane, Skylark Avenue, Mockingbird Lane, Kingfisher Lane, Lovebird Lane, Partridge Drive, Partridge Place, Partridge Court, Golden Eagle Drive and Rancho Court), together with a Public Park as the same are shown and designated on the plat of SANTA BARBARA SUBDIVISION recorded in the office of the County Clerk of Bernalillo County, New Mexico on January 21, 1986, in Volume C29, Folio 85, together with Tract Q-2 and Tract Q-1-A, SANTA BARBARA SUBDIVISION as the same is shown and designated on the plat recorded in the office of the County Clerk of Bernalillo County, on July 1, 1991 in Volume 91C, Folio 134, together with the remaining portion of Rancho De Palomas, a public street, now comprising PALOMAS PARK SUBDIVISION is with free consent and in accordance with the desires of the undersigned owner(s) and/or proprietor(s) thereof, and said owner(s) and/or proprietor(s) do hereby dedicate additional road right-of-way and do hereby grant all easements shown on this plat. Electrical Power and Communication easements are reserved for overhead distribution lines for pole type utilities and buried distribution lines, conduits, and pipes for underground utilities and other related equipment shown or indicated, and including the right of ingress and egress for construction and maintenance, and the right to trim interfering trees and shrubs.

BROWN & ASSOCIATES, INC. Owner of Tracts A, B, and C and Lots 11-18, Lot 11-A, and Lots 22-31)

RON BROWN, PRESIDENT

State of New Mexico)
County of Bernalillo)

The foregoing instrument was acknowledged before me this 5th day of June, 1992 by Ron Brown, President of Brown and Associates, Inc.

My Commission Expires 5/5/93 Notary Public

ROMAN CATHOLIC CHURCH, ARCHDIOCESE OF SANTA FE (Owner of Tracts D, E, F, G, H, I, J, K, L, M, N, P, R, Q-2 and D-1-A)

ROBERT F. SANCHEZ, ARCHBISHOP

State of New Mexico)
County of Santa Fe)

The foregoing instrument was acknowledged before me, on June 16, 1992, by Robert F. Sanchez, Archbishop of the Roman Catholic Church, Archdiocese of Santa Fe.

My Commission Expires 9/16/95 Notary Public

DISCLAIMER

By approving this document, P&H does NOT waive or release any easement or easement rights which may have been granted by prior plat, report, or document.

SURVEYOR'S CERTIFICATION

I, A. Duane Weaver, a registered Professional New Mexico Surveyor, certify that this plat was prepared by me or under my supervision, that all measurements of record, and conforms to the Minimum Requirements of the Standards for Land Surveys in New Mexico as adopted by the New Mexico Board of Registration for Professional Engineers and Professional Surveyors in November 1989 and meets the minimum requirements for monumentation and surveys contained in the Albuquerque Subdivision Ordinance, and is true and accurate to the best of my knowledge and belief.

A. Duane Weaver
Behnen-Huston, Inc.
County Clerk
7500 Jafferson Street, N.E.
Albuquerque, New Mexico 87109
Date: June 16, 1992
JOB NO. 91181-80

SHEET 1 OF 2 SHEETS


NUMBER	ARC	RADIUS	DELTA	CHORD	CHORD BEARING	TANGENT
C1	3.66	25.00	32°47'01"	3.66	N04°20'15"E	93.75
C2	182.35	318.70	32°47'01"	179.88	S73°30'46"E	93.75
C3	293.08	300.00	55°58'25"	281.56	N62°09'10"E	159.42
C4	55.08	125.00	25°14'43"	54.63	N43°12'41"W	27.98
C5	129.40	125.00	59°18'53"	123.70	N60°14'42"W	71.18
C6	153.22	148.00	59°18'54"	146.47	S60°14'43"E	84.27
C7	50.30	25.00	11°16'23"	42.23	S88°13'27"E	39.45
C8	207.37	300.00	39°36'21"	203.27	N53°56'31"E	108.02
C9	95.00	332.00	16°14'26"	94.68	N81°56'32"E	47.83
C10	40.97	30.00	78°14'26"	37.86	N51°01'10"E	24.40
C11	172.70	250.00	39°34'45"	169.28	N53°57'19"E	89.95
C12	47.12	30.00	90°00'00"	42.43	N44°51'37"W	30.00
C13	76.69	268.00	16°23'42"	76.43	S81°56'32"W	38.61
C14	172.70	250.00	39°34'45"	169.28	S53°57'19"W	89.95
C15	26.40	148.00	10°13'25"	26.37	S84°47'28"E	13.24
C16	47.95	148.00	18°33'47"	47.74	S70°23'52"E	24.19
C17	59.44	148.00	23°00'43"	59.04	S49°36'37"E	30.13
C18	19.42	148.00	7°31'00"	19.40	S34°20'46"E	9.72
C19	105.59	102.00	59°18'51"	100.94	N60°14'41"W	58.08
C20	32.77	25.00	77°23'54"	31.26	N04°31'59"W	20.03
C21	32.66	148.00	12°38'38"	32.59	N36°54'38"W	16.40
C22	16.09	25.00	36°52'12"	15.81	S15°43'52"W	8.33
C23	177.14	40.00	25°34'43"	64.00	N55°50'02"W	0.00
C24	16.09	25.00	36°52'12"	15.81	N52°36'04"E	8.33
C25	18.50	25.00	42°23'57"	18.08	S68°53'43"W	9.70
C26	184.86	40.00	26°47'58"	59.08	N00°05'43"E	0.00
C27	18.50	25.00	42°23'57"	18.08	S68°42'18"E	9.70
C28	108.24	318.70	19°02'57"	105.75	N80°21'18"W	53.62
C29	36.28	318.70	17°18'40"	95.92	S65°46'36"E	48.51
C30	41.23	100.00	23°37'20"	40.94	N78°17'03"E	20.91
C31	56.02	50.00	64°11'34"	53.13	S57°59'56"W	31.36

NUMBER	BEARING	DISTANCE
T1	N55°50'02"W	14.26
T2	N59°24'44"E	15.98
T3	S89°54'15"E	16.50
T4	N89°54'17"W	15.23
T5	N30°35'16"W	13.75
T6	S34°49'18"W	11.50
T7	N73°44'41"E	5.24
T8	S89°51'37"E	55.46
T9	N89°51'37"W	55.46
T10	S73°44'41"W	12.75
T11	S34°49'18"W	87.41
T12	S34°09'58"W	80.71
T13	N55°50'02"W	27.00
T14	N73°50'35"E	42.88
T15	S89°51'37"E	55.00
T16	N61°47'35"W	27.17
T17	N00°05'43"E	23.00
T18	S34°09'58"W	39.00
T19	S89°54'17"E	43.83
T20	S19°56'14"E	20.81
T21	N00°08'23"E	10.63

LEGEND
SUBDIVISION BOUNDARY LINE
NEW LOT LINE
ADJOINING PROPERTY LINE
EXISTING (OLD) LOT LINE
NEW EASEMENT LINE
EXISTING EASEMENT LINE
5/8" REBAR WITH PLASTIC SURVEY CAP STAMPED "WEAVER LS 6544"
CITY OF ALBUQUERQUE SURVEY CONTROL MONUMENT
FOUND CONCRETE NAIL WITH SURVEY WASHER STAMPED "LS 5340"
FOUND CITY OF ALBUQUERQUE 2-3/4" X 2-3/4" SURVEY CAP STAMPED "LS 5340"



"HEAVEN 1969"
USC & GS Brass Cap
N.M. State Plane Coordinates (Central Zone)
X= 407.051-31 Y= 1,518.737-03
Ground-to-Grid Factor = 0.9996263
Gauss-Krüger Zone = 18
Elev. = 5378.787

PLAT OF PALOMAS PARK SUBDIVISION ALBUQUERQUE, NEW MEXICO JUNE, 1992

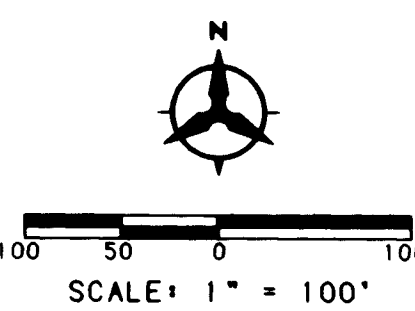

DETAIL "A"


NOT TO SCALE

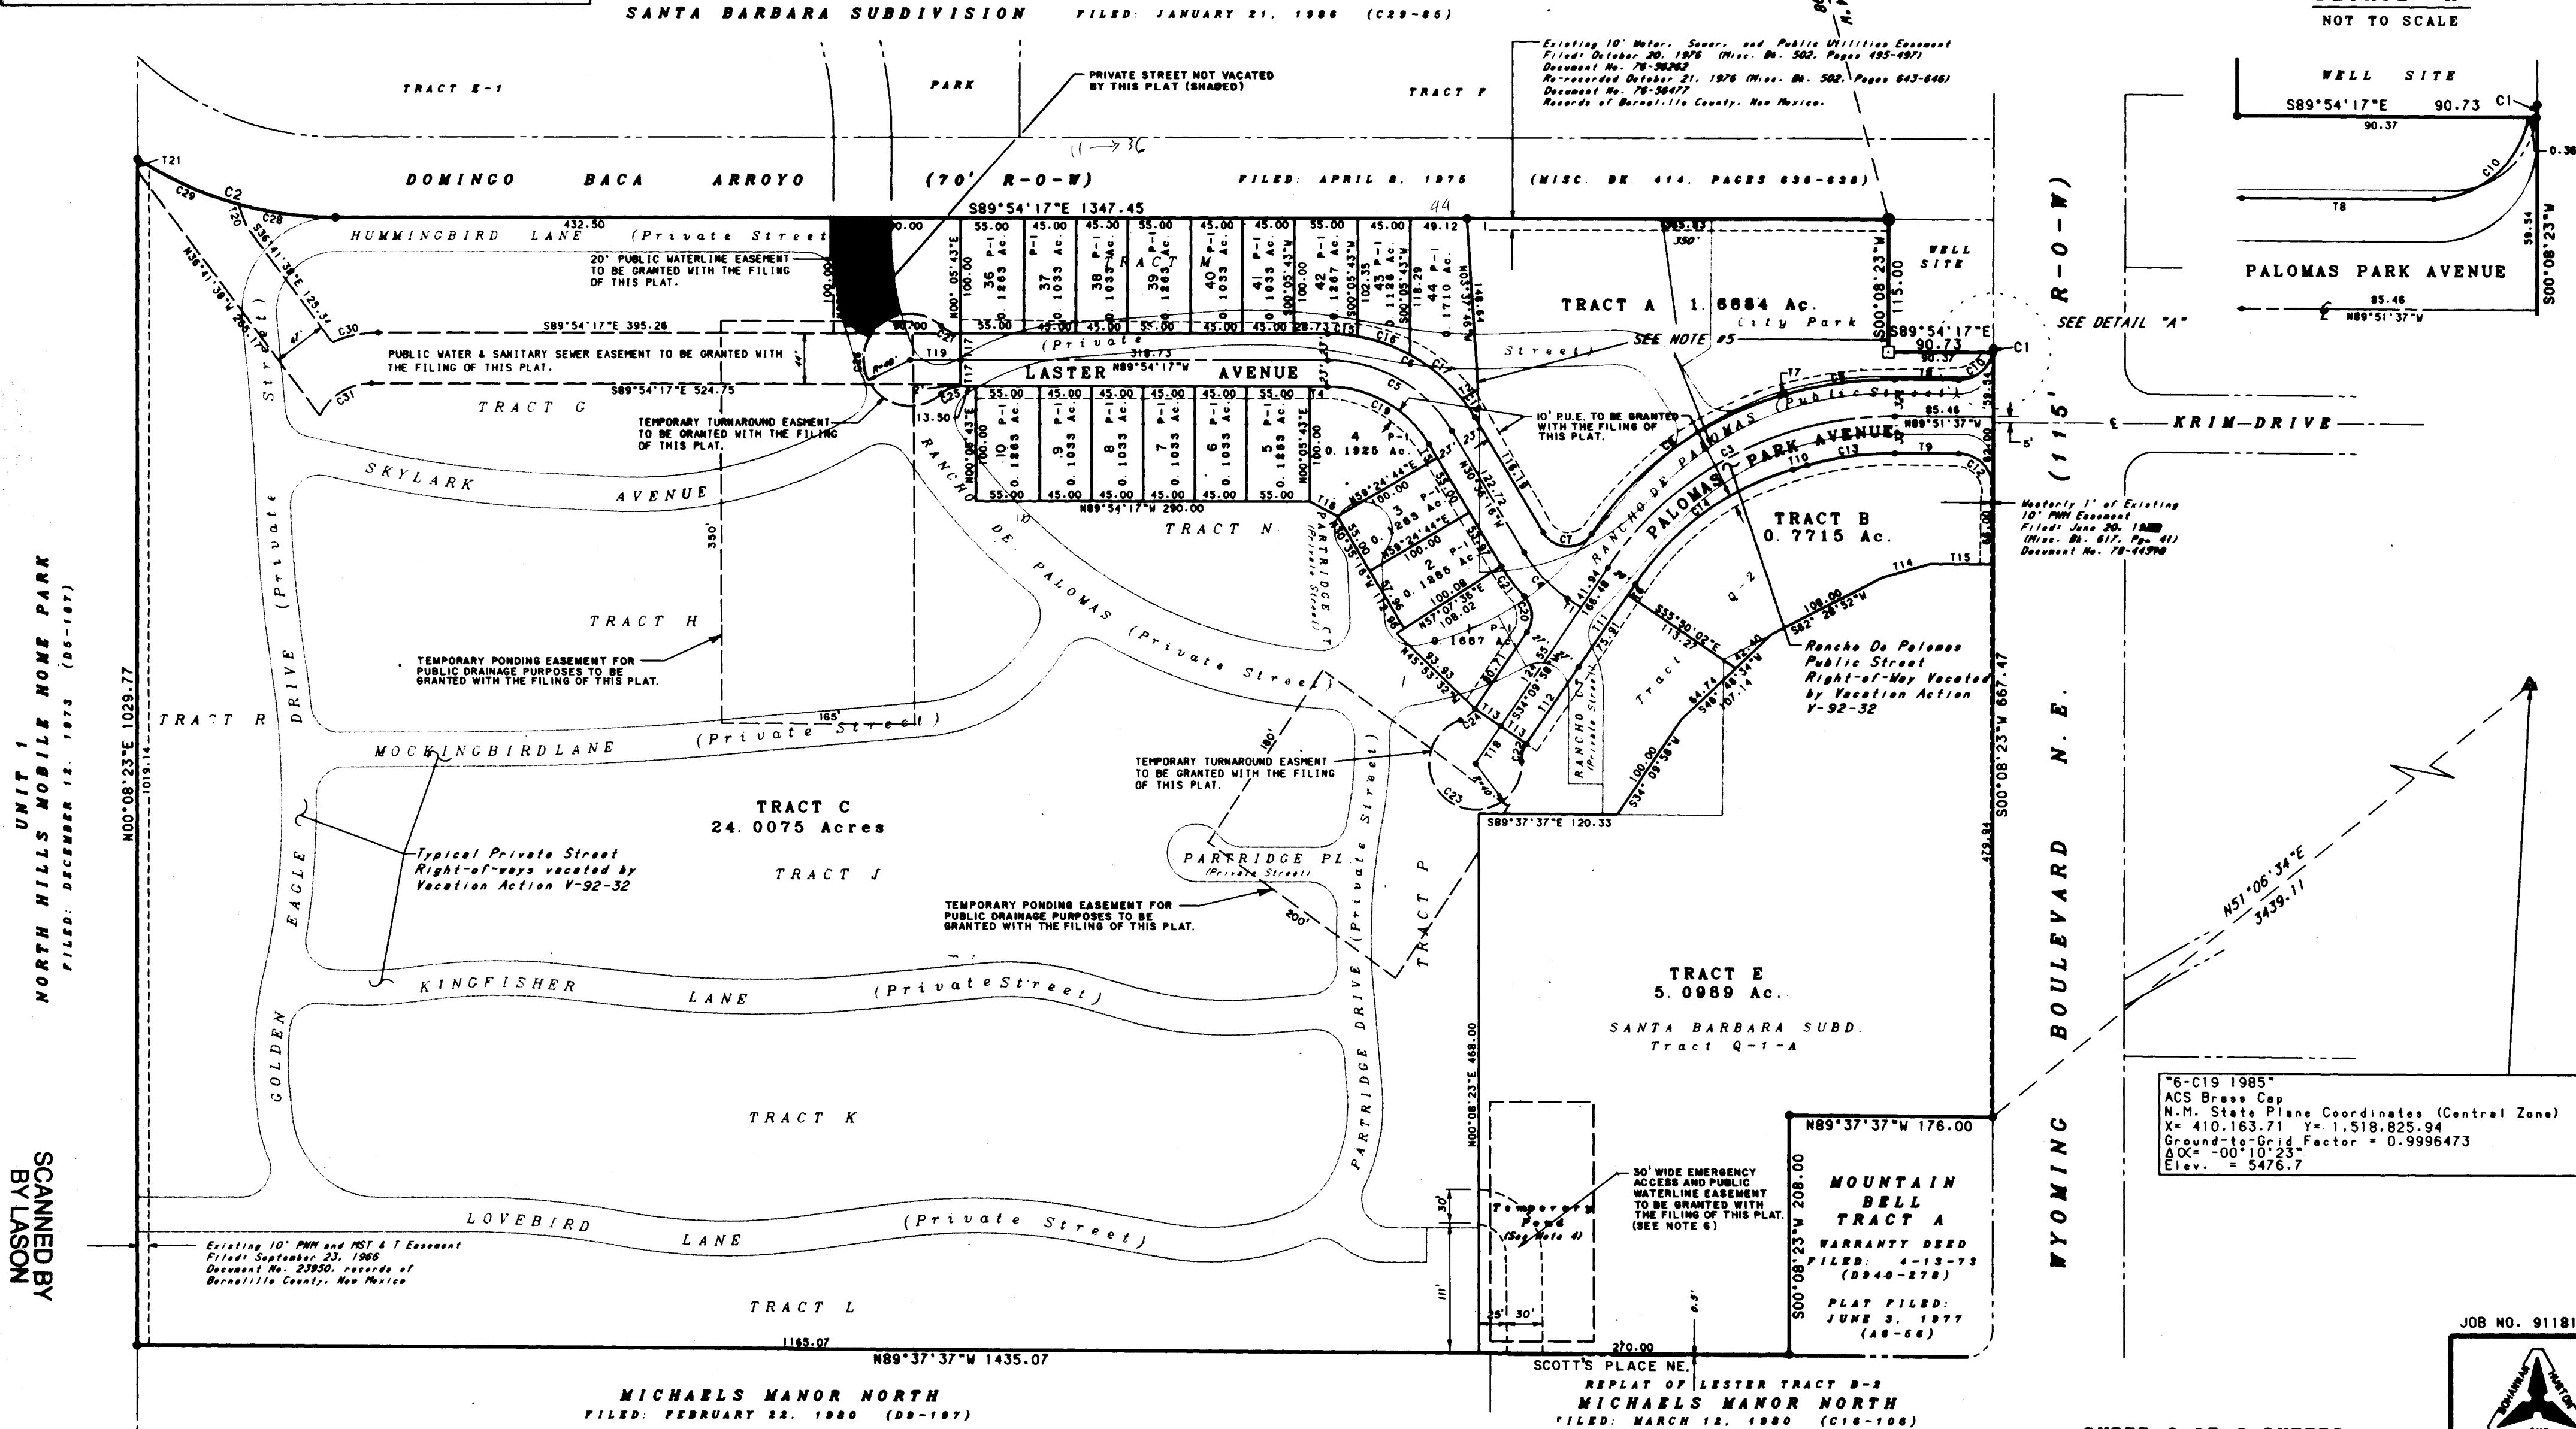
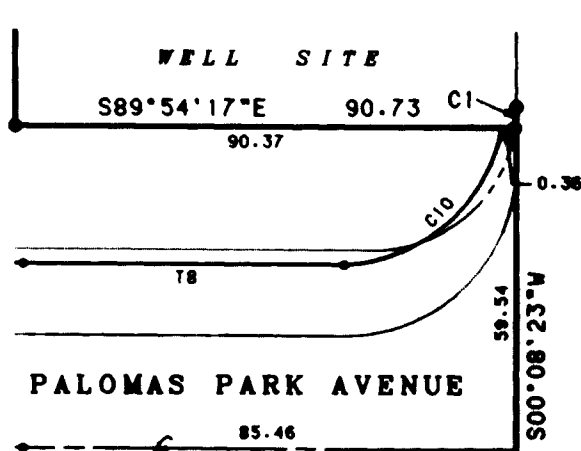


MICHAELS MANOR NORTH
FILED: FEBRUARY 22, 1980 (D9-187)

SCOTT'S PLACE NE
REPLAT OF LESTER TRACT B-2
MICHAELS MANOR NORTH
FILED: MARCH 12, 1980 (C18-108)


SHEET 2 OF 2 SHEETS

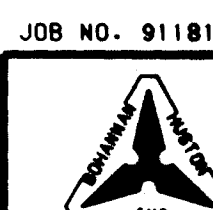

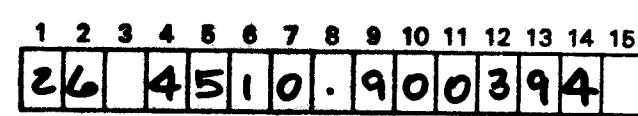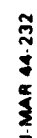



		CITY OF ALBUQUERQUE					
		TITLE: PRELIMINARY PLAT					
APPROVALS	ENGINEER	DATE	APPROVALS	ENGINEER	DATE		
DR. CHAIRMAN	<i>Robert H. [unclear]</i>	8-26-92	WATER	<i>N/A RWK</i>	8-25-92		
TRANSPORTATION	<i>NACHO</i>	8-24-92	WASTE WATER	<i>N/A RWK</i>	8-25-92		
HYDROLOGY	<i>S. [unclear]</i>	8-20-92	PARKS				
DRAWING NO.		4510.90		MAP NO. D-19-Z		SHEET 3 OF 14	

[illegible]

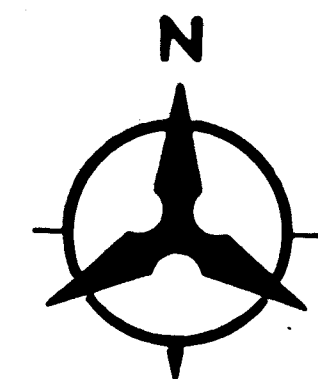


SCALE: 1" = 50'

"HEAVEN 1989"
USC & GS Brass Cap
N.M. State Plane Coordinates (Central Zone)
X = 407,051.31 Y = 1,518,737.03
Ground-to-Grid Factor = 0.99965263
= -00°10'45"
Elev. = 5378.787

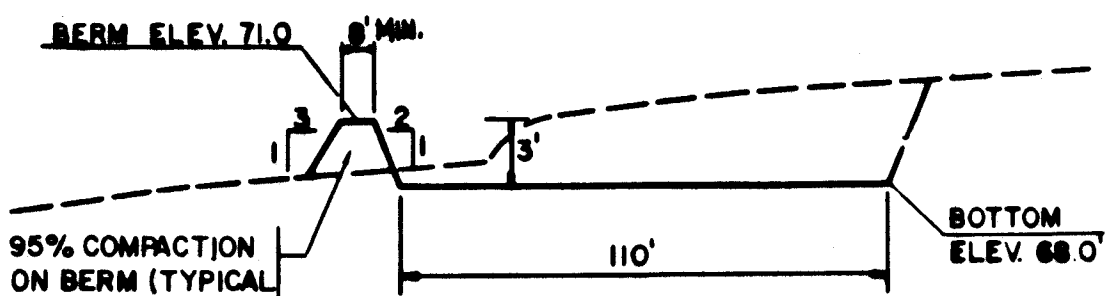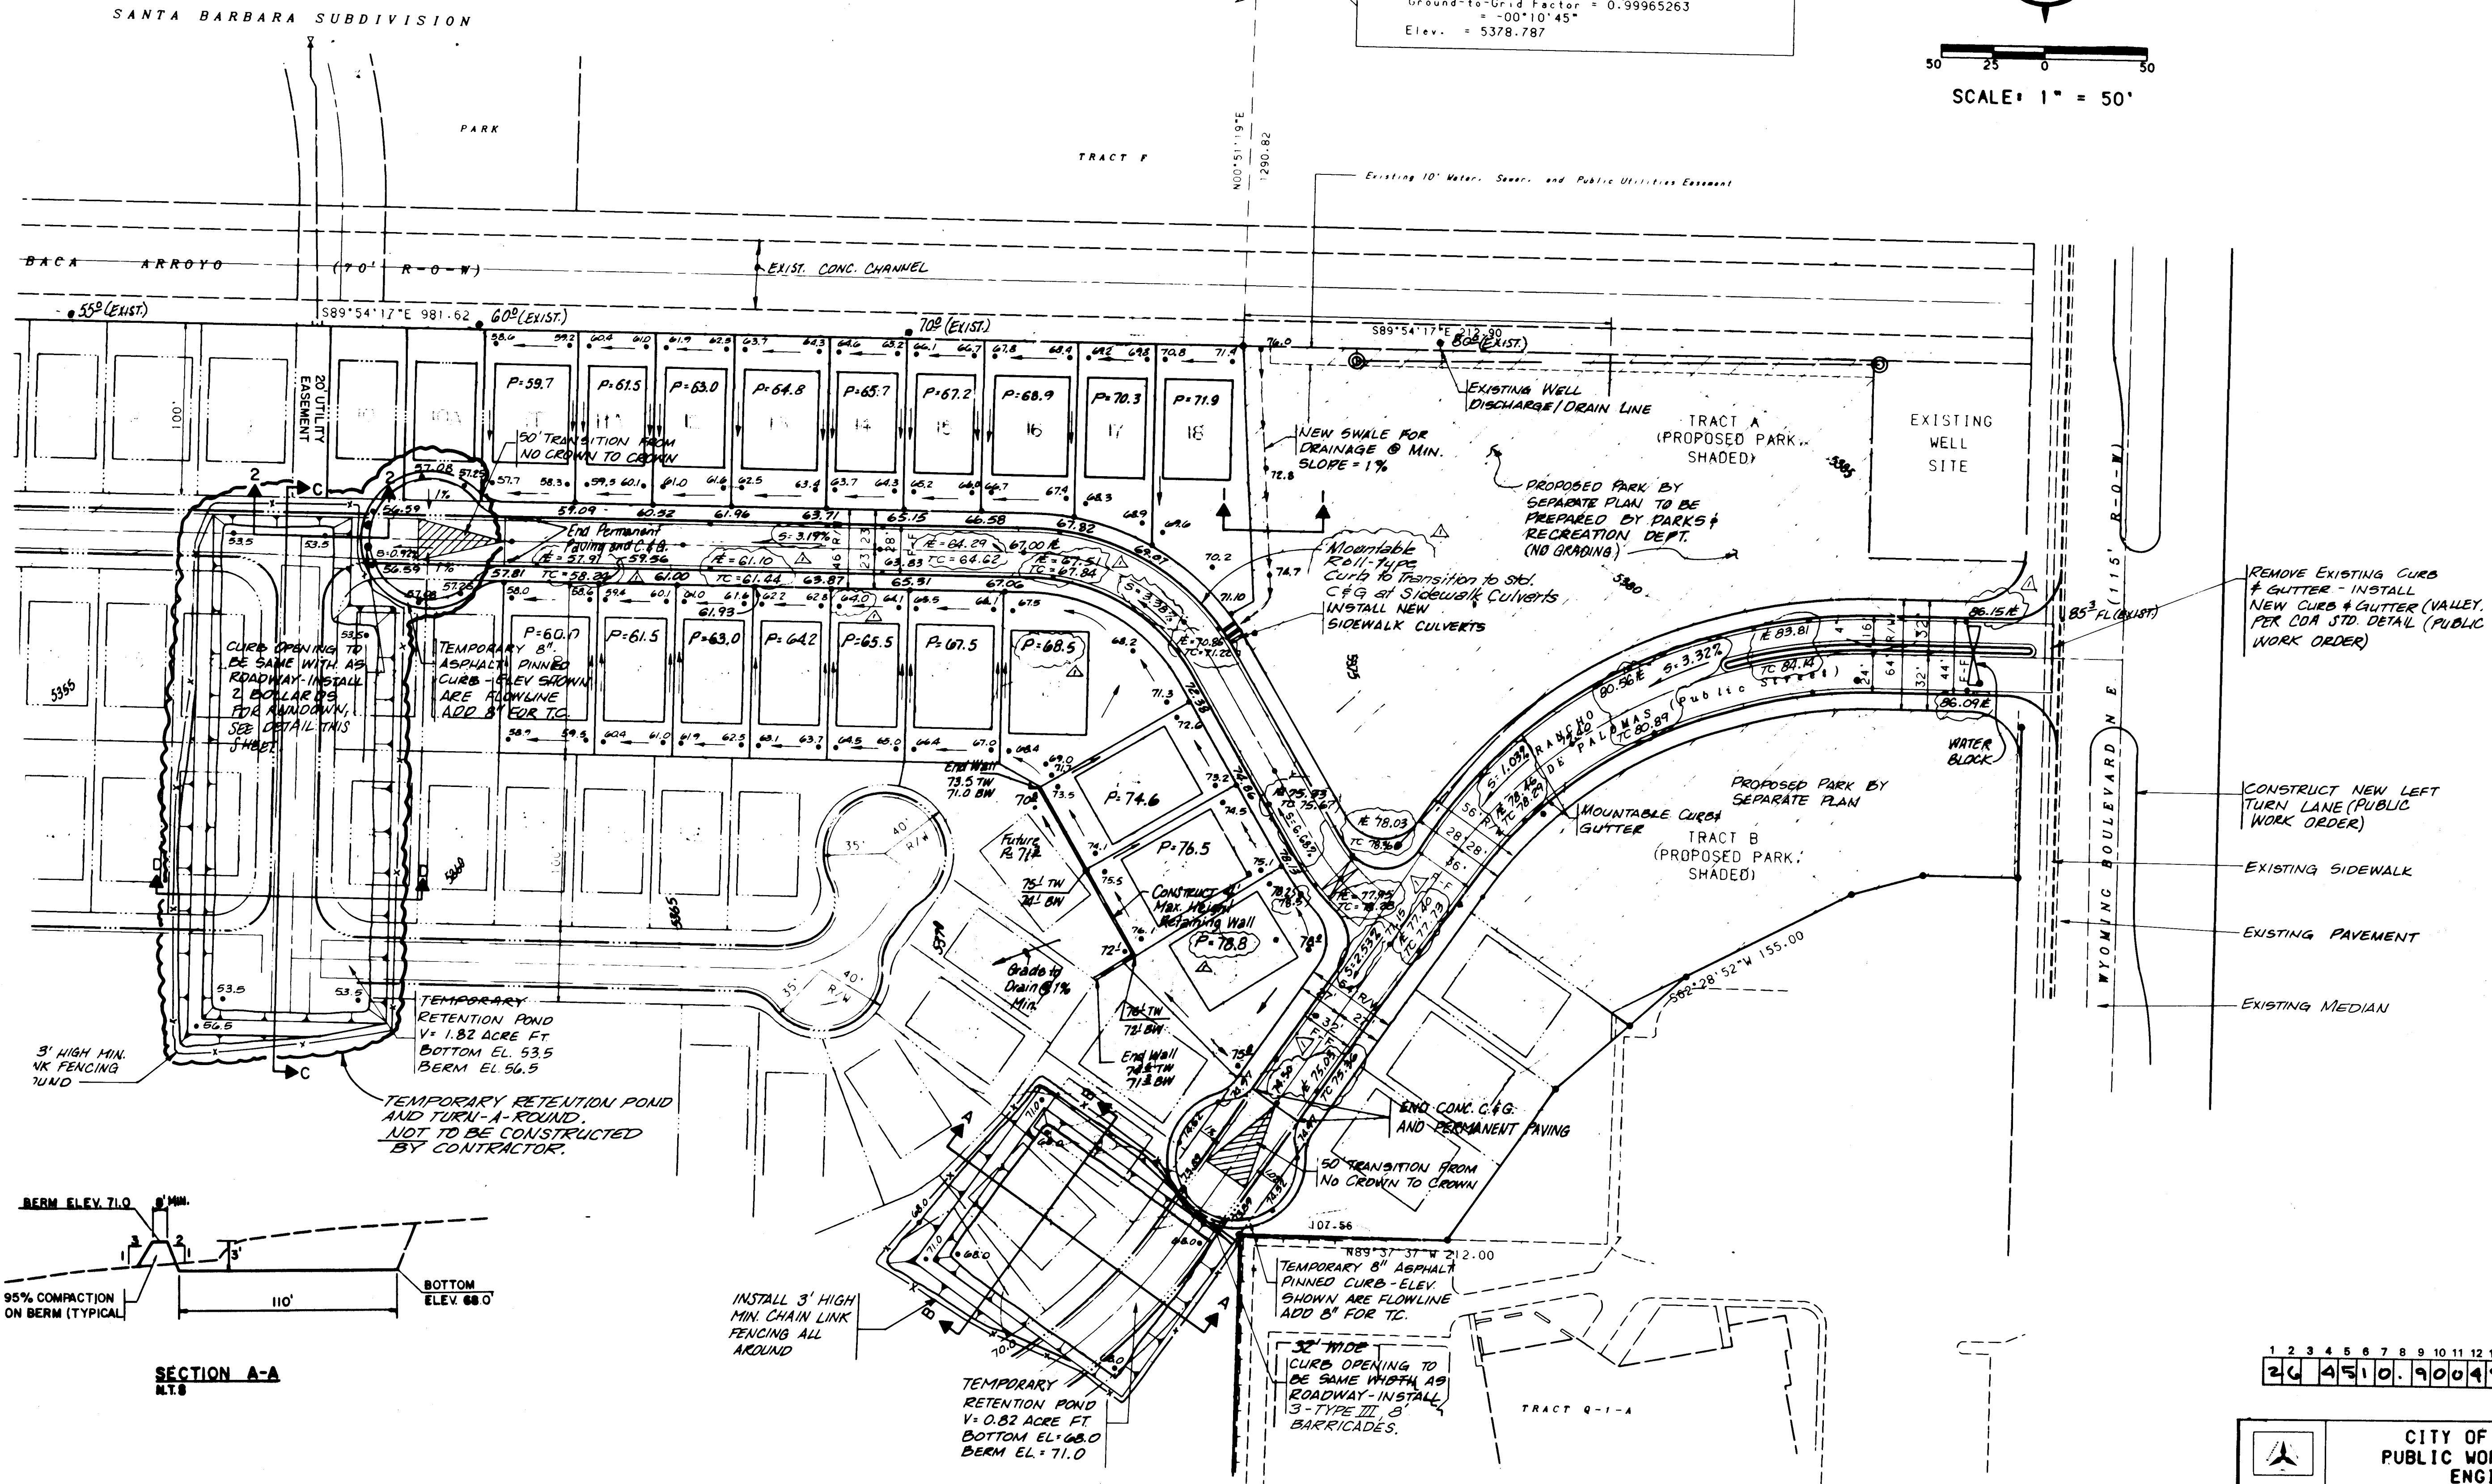

SECTION A-A
N.T.S.

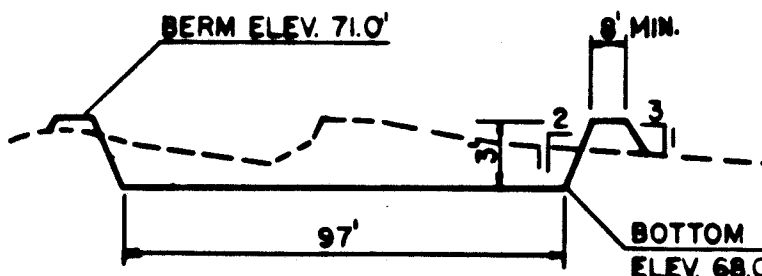

SECTION B-B
N.T.S.

REMOVE EXISTING CURB & GUTTER - INSTALL NEW CURB & GUTTER (VALLEY PER COA STD. DETAIL (PUBLIC WORK ORDER))

CONSTRUCT NEW LEFT TURN LANE (PUBLIC WORK ORDER)

EXISTING SIDEWALK

EXISTING PAVEMENT

EXISTING MEDIAN

AS-BUILT INFORMATION	
CONTRACTOR	DATE
WORK	DATE
STAKED BY	DATE
FIELD BY	DATE
ACCEPTANCE BY	DATE
FIELD BY	DATE
REVISIONS	DATE
DESIGNED BY	DATE
DRAWN BY	DATE
CHECKED BY	DATE


BENCH MARKS	
CONTRACTOR	DATE
WORK	DATE
STAKED BY	DATE
FIELD BY	DATE
ACCEPTANCE BY	DATE
FIELD BY	DATE
REVISIONS	DATE
DESIGNED BY	DATE
DRAWN BY	DATE
CHECKED BY	DATE

SURVEY INFORMATION	
CONTRACTOR	DATE
WORK	DATE
STAKED BY	DATE
FIELD BY	DATE
ACCEPTANCE BY	DATE
FIELD BY	DATE
REVISIONS	DATE
DESIGNED BY	DATE
DRAWN BY	DATE
CHECKED BY	DATE


ENGINEER'S SEAL	
CONTRACTOR	DATE
WORK	DATE
STAKED BY	DATE
FIELD BY	DATE
ACCEPTANCE BY	DATE
FIELD BY	DATE
REVISIONS	DATE
DESIGNED BY	DATE
DRAWN BY	DATE
CHECKED BY	DATE

REVISIONS	
NO.	DATE
1	8-25-92
2	8-25-92
CITY OF ALBUQUERQUE PUBLIC WORKS DEPARTMENT ENGINEERING					
TITLE: PALOMAS PARK SUBDIVISION DRAINAGE/GRADING PLAN (DEVELOPED CONDITIONS) PHASE 1					
APPROVALS	ENGINEER	DATE	APPROVALS	ENGINEER	DATE
DR. CHAIRMAN	Rogelio	8-26-92	WATER	MA RWK	8-25-92
TRANSPORTATION	MA RWK	8-25-92	WASTE WATER	MA RWK	8-25-92
HYDROLOGY	MA RWK	8-25-92	PARKS	MA RWK	8-25-92
DRAWING NO.	4510.90	MAP NO.	D-19-Z	SHEET	4 OF 14

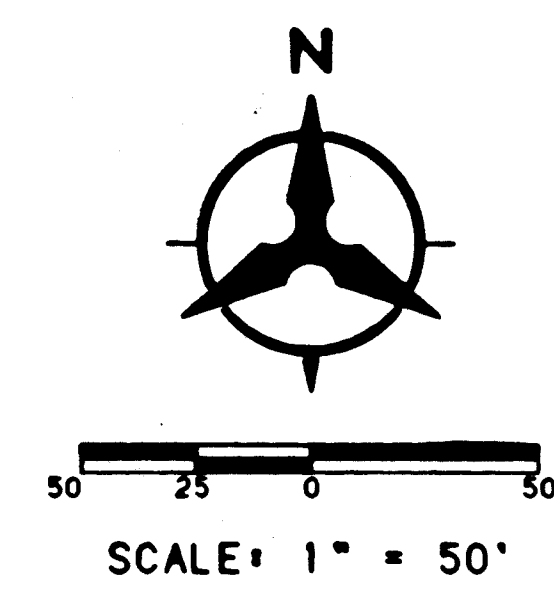

NOTE: Storm Drainage System is Public.
Final location and design of
storm drains and inlets to be
coordinated through construction
plan review & DRC.

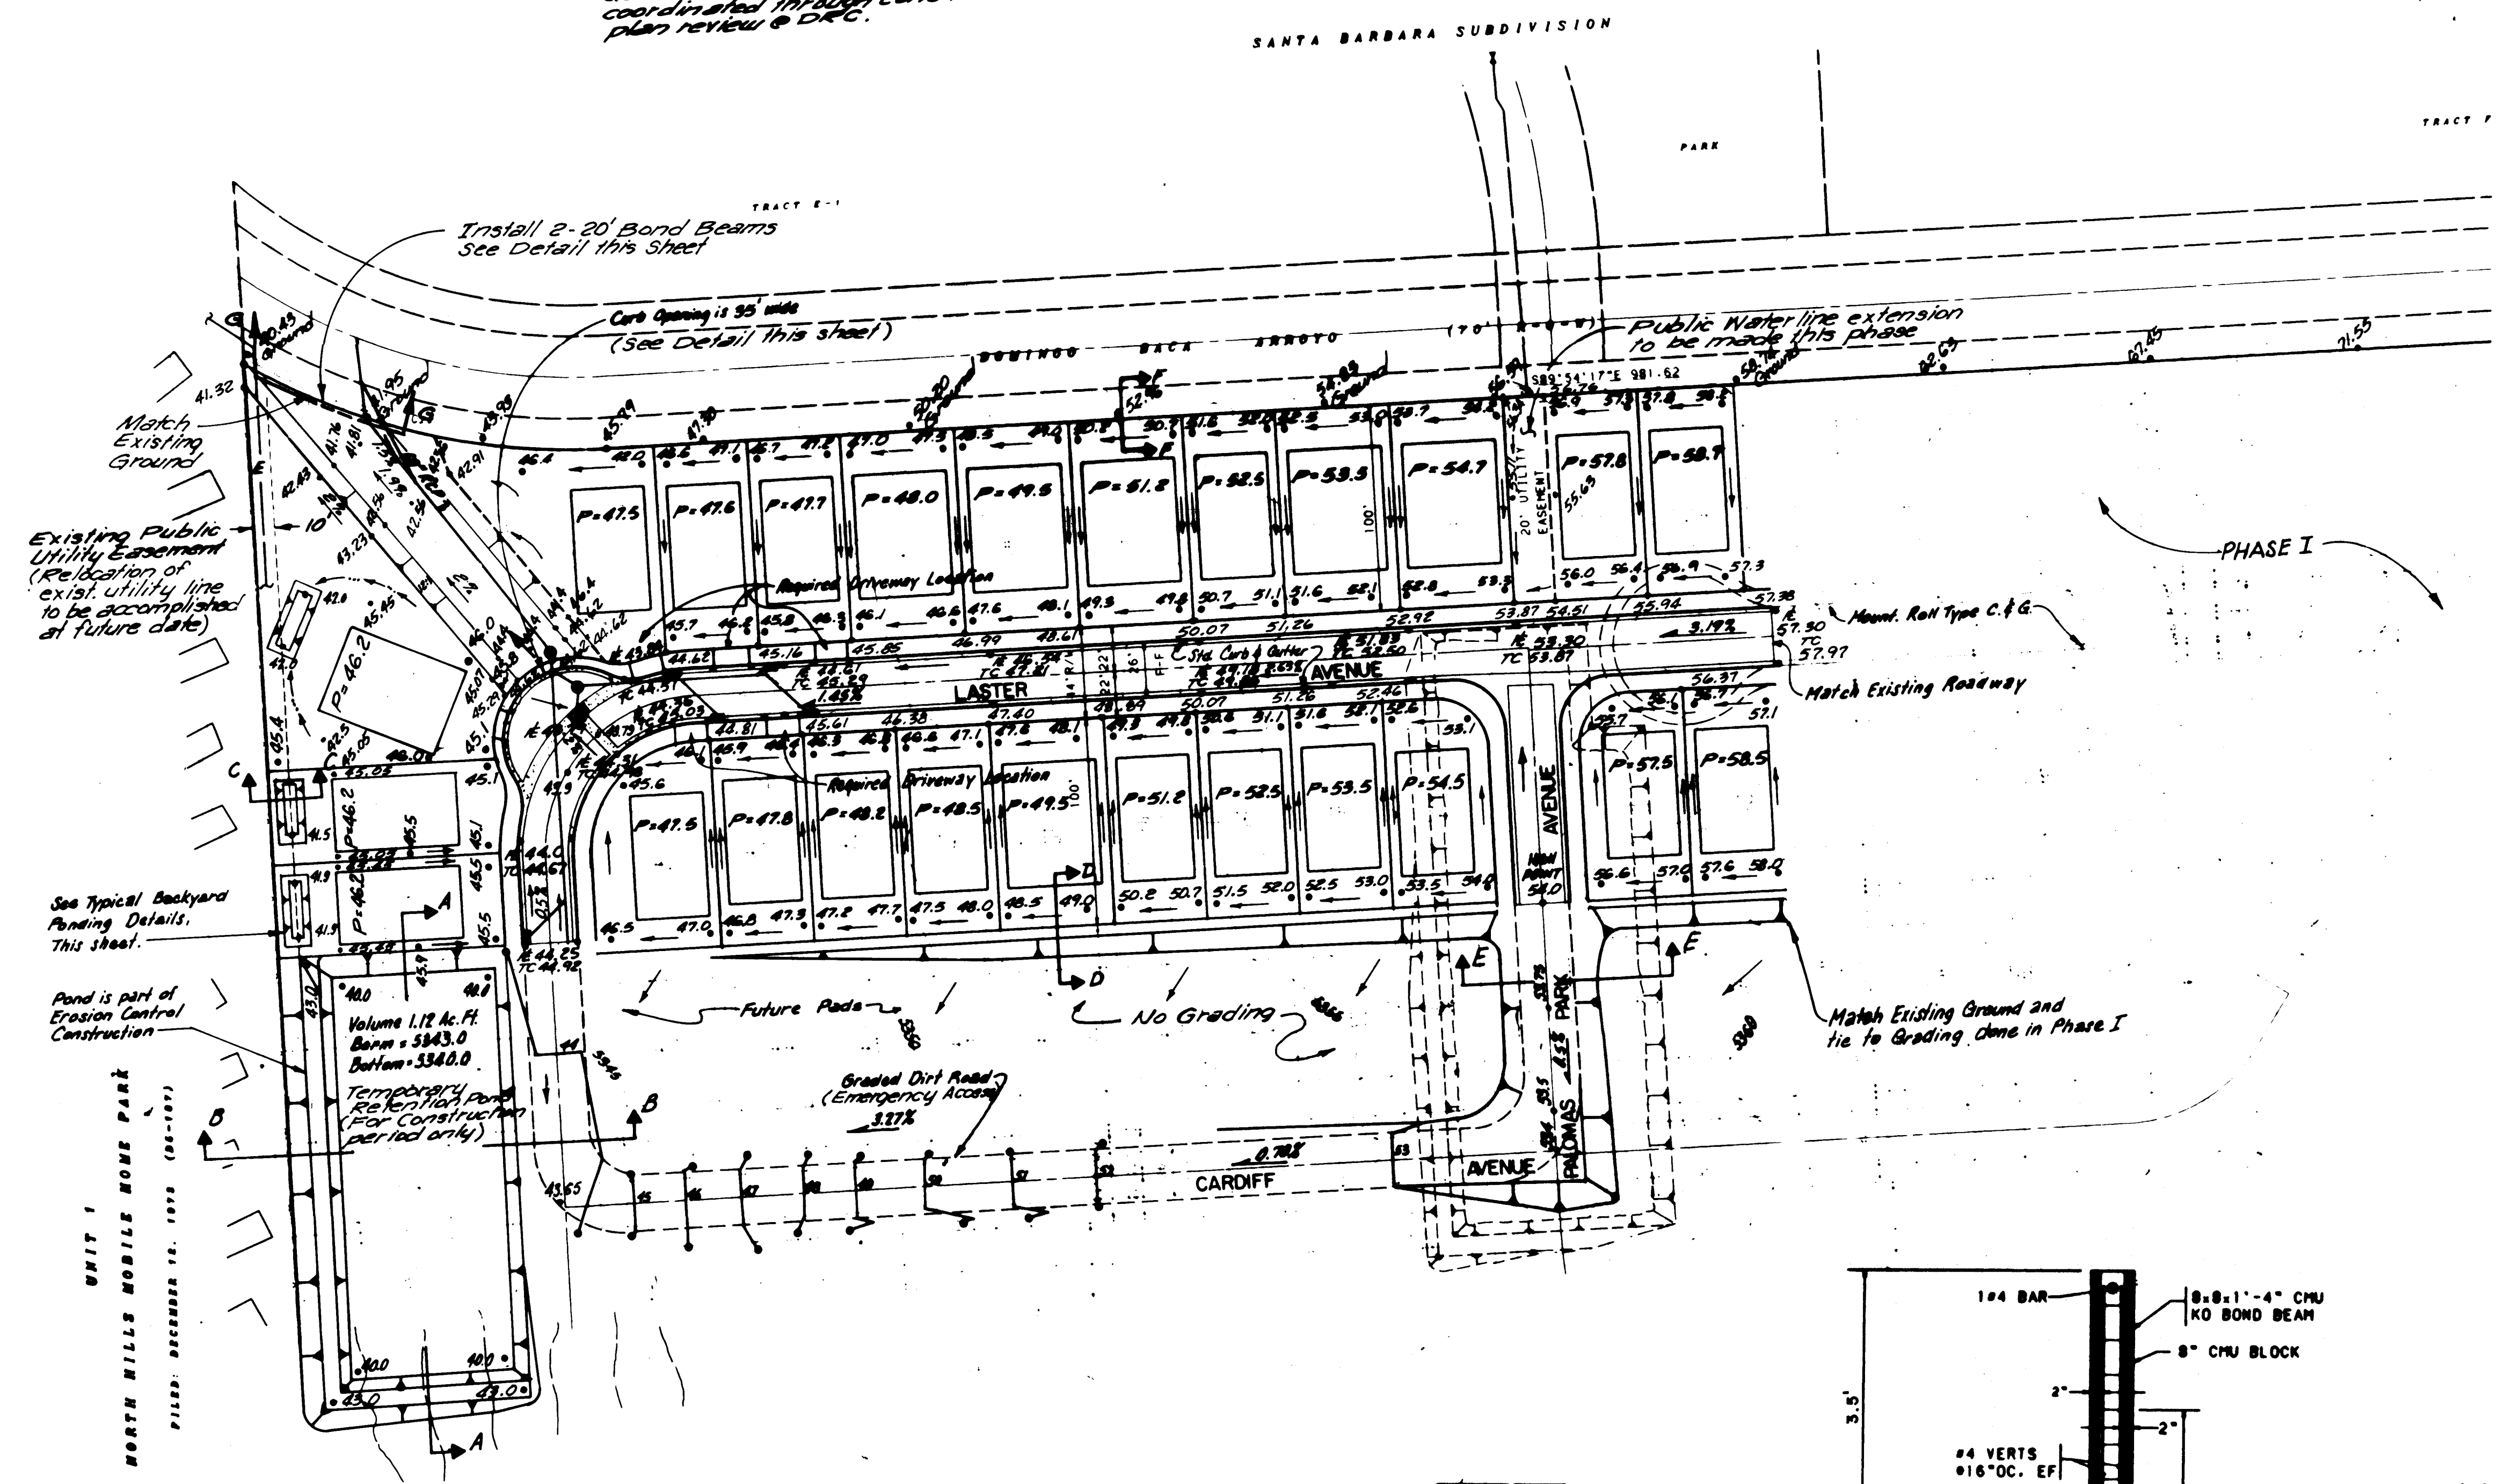


See Typical Backyard
Ponding Details,
This sheet.


Pond is part of
Erosion Control
Construction

Volume 1.12 Ac. Ft.
Bottom = 5343.0
Bottom = 5340.0
Temporary
Retention Pond
(For Construction
period only)


UNIT 1
NORTH HILLS MOBILE HOME PARK
FILED: DECEMBER 12, 1992 (26-100)

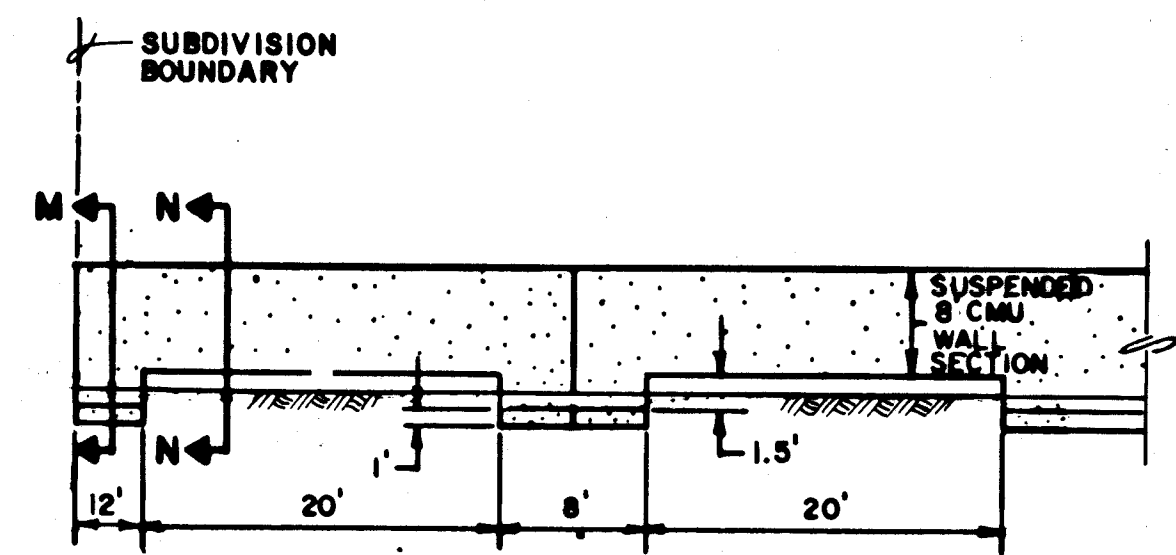

SECTION G-G
NO SCALE

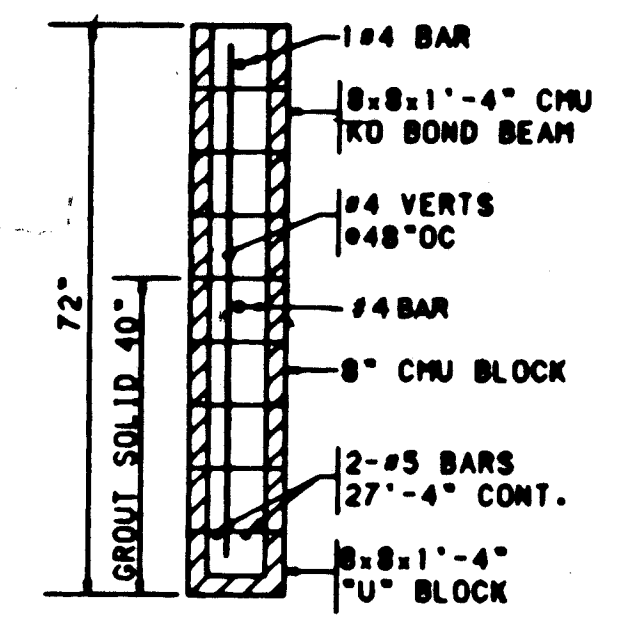

BOND BEAM
SECTION N-N
NO SCALE

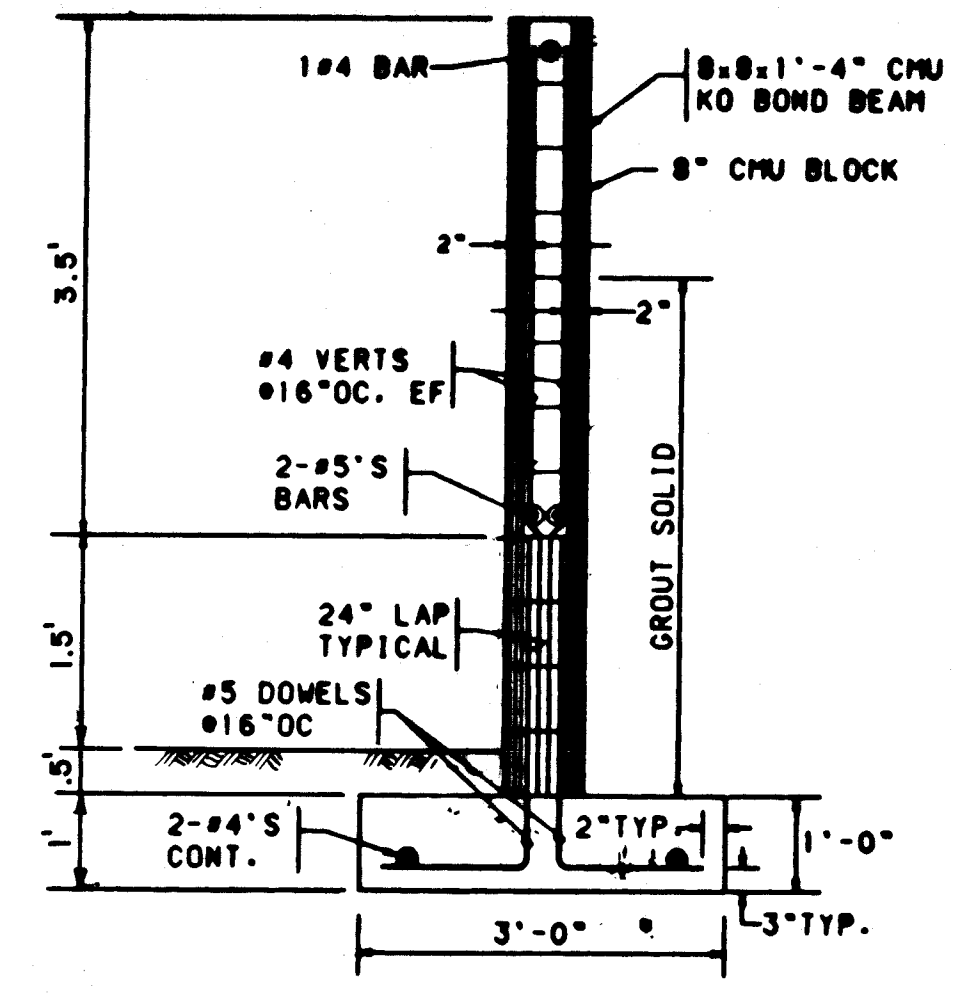








BOND BEAM
SECTION H-H
NO SCALE

1 2 3 4 5 6 7 8 9 10 11 12 13 14 15
26 4510.900594

CITY OF ALBUQUERQUE PUBLIC WORKS DEPARTMENT ENGINEERING			
TITLE: PALOMAS PARK SUBDIVISION DRAINAGE/GRADING PLAN (DEVELOPED CONDITIONS) PHASE 1A			
APPROVALS	ENGINEER	DATE	APPROVALS
DRL CHAIRMAN	Roger R. Rios	8-26-92	WATER
TRANSPORTATION	N/A CVD	8-24-92	WASTE WATER
HYDROLOGY	N/A Wldg	8-20-92	PARKS
DRAWING NO. 4510.90		MAP NO. D-19-Z	SHEET 5 OF 14

--	--	
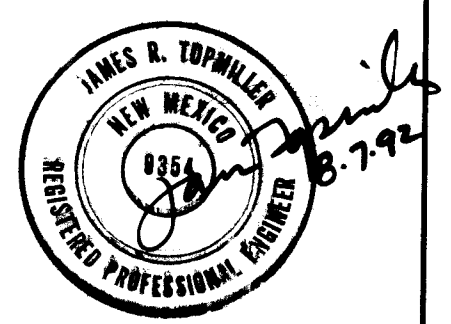

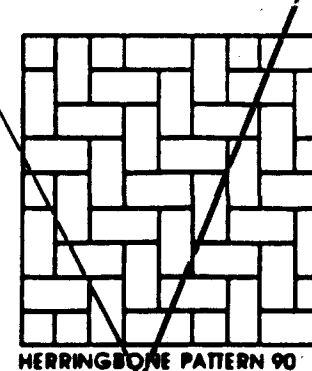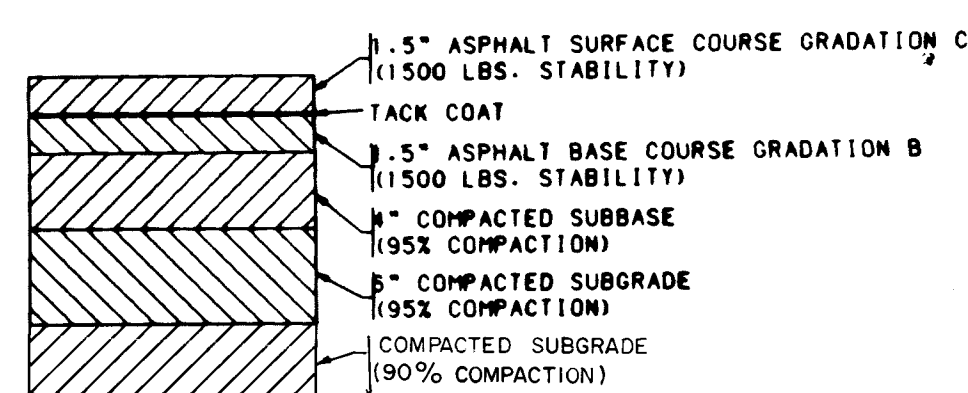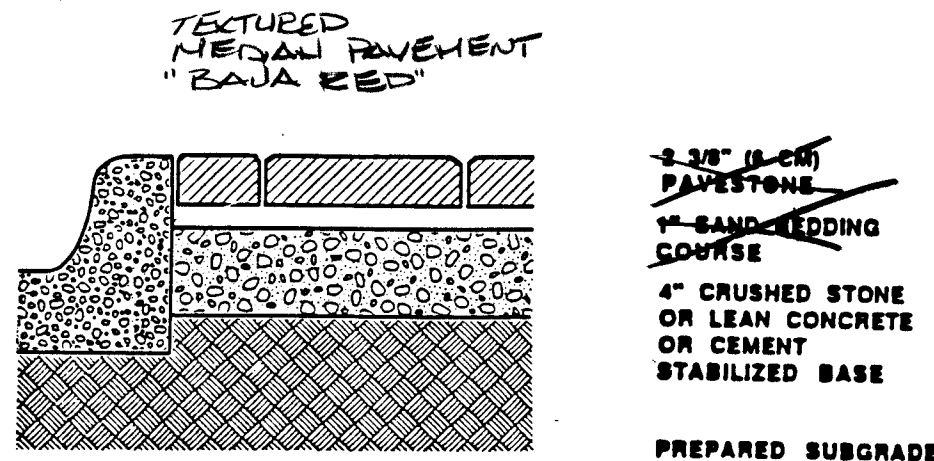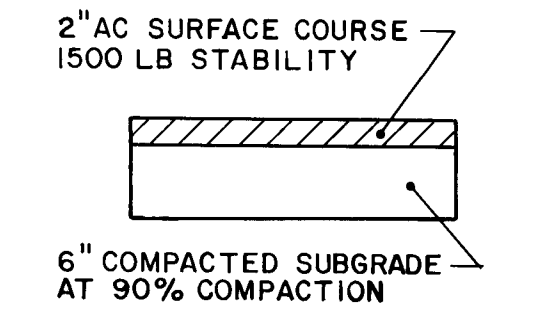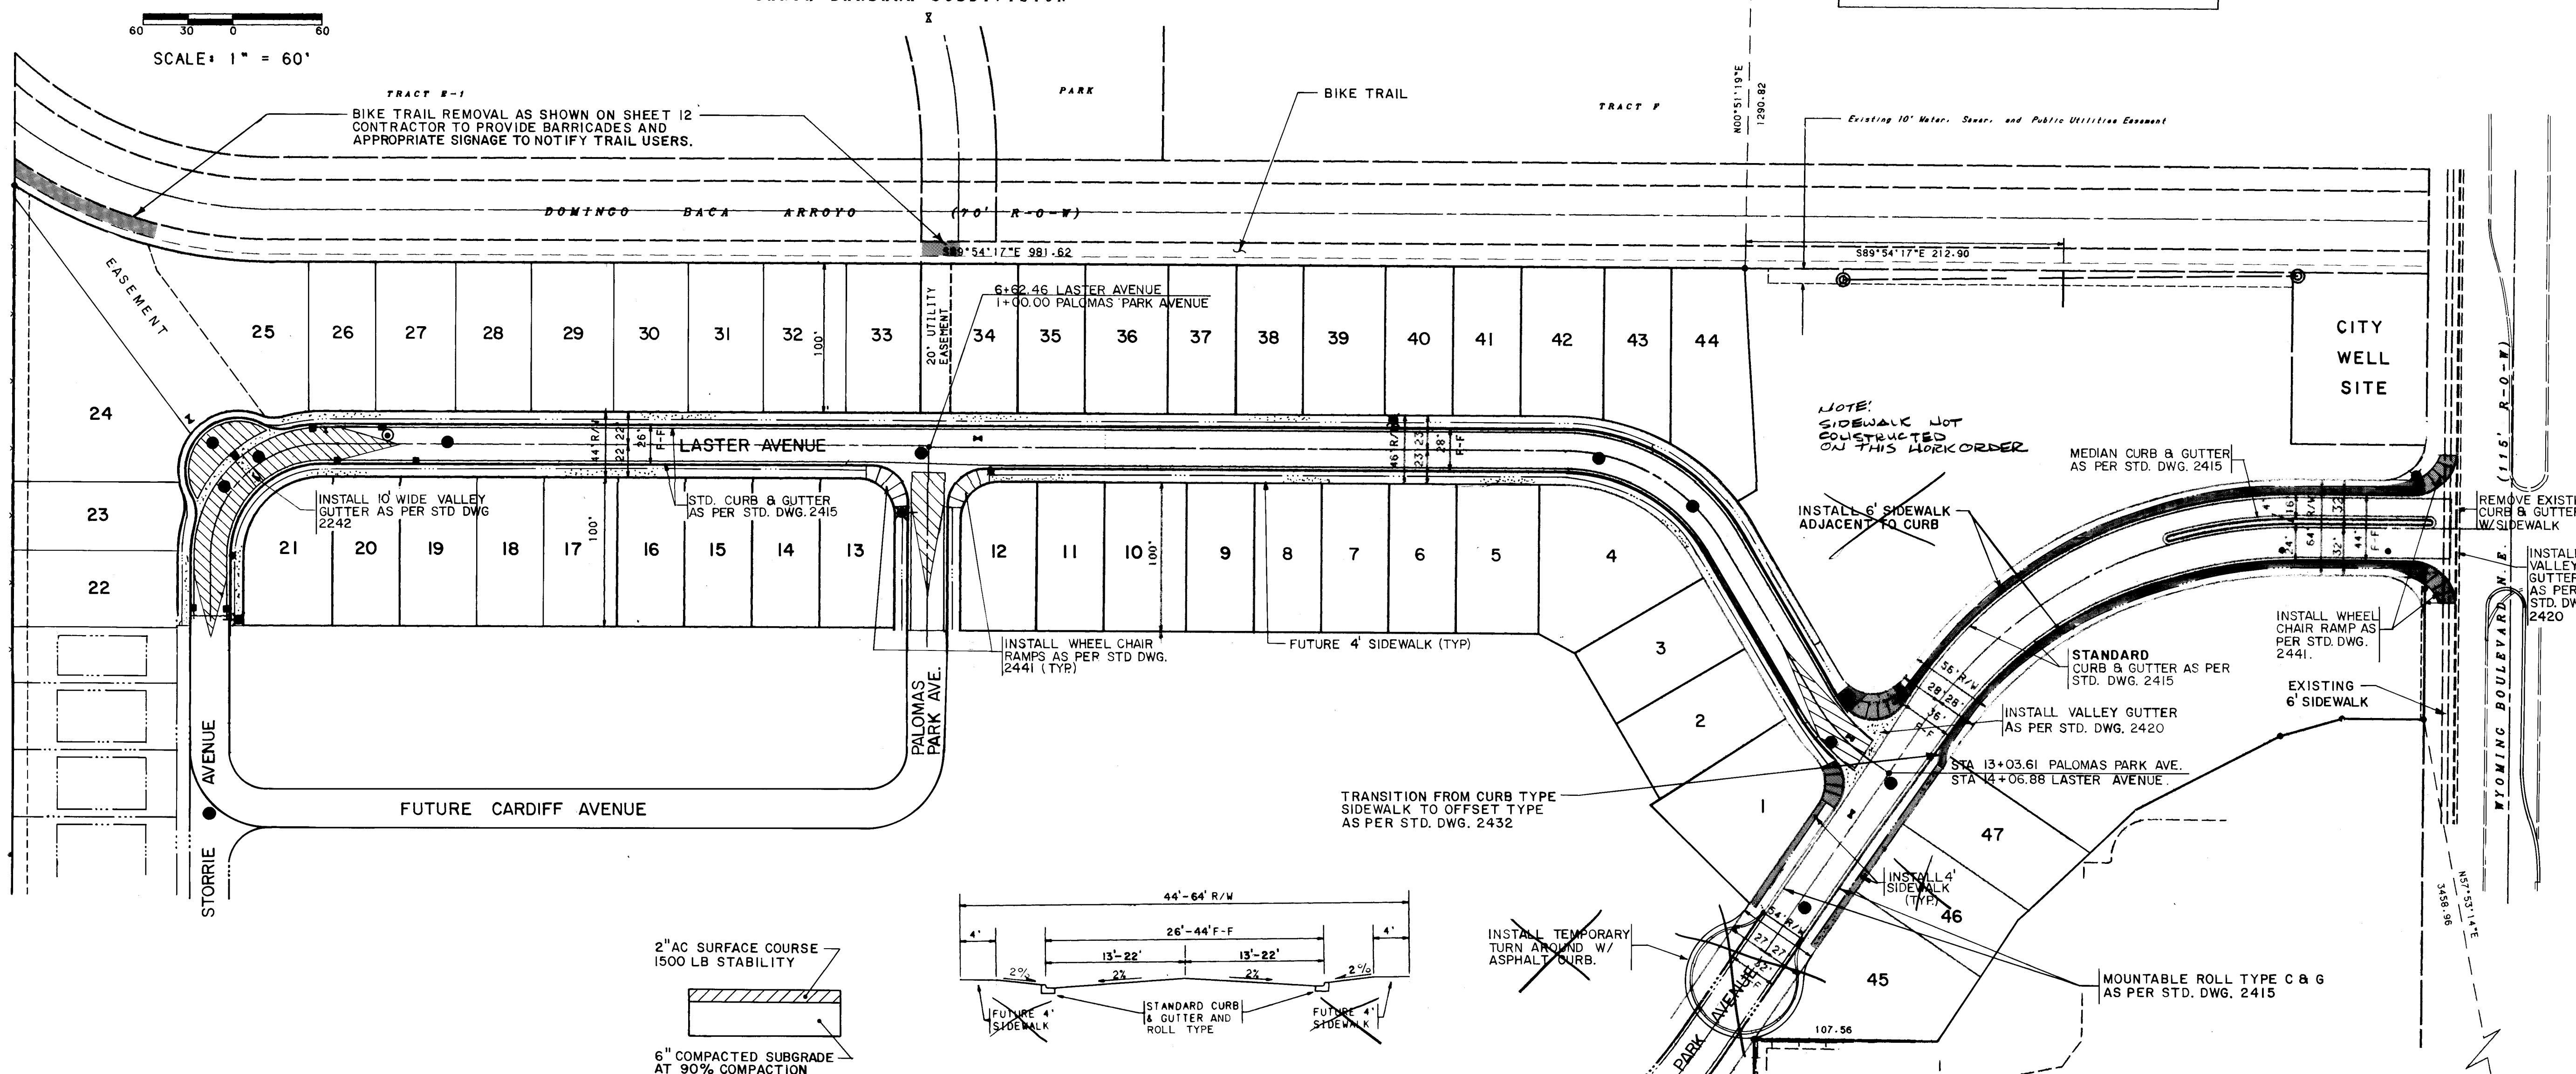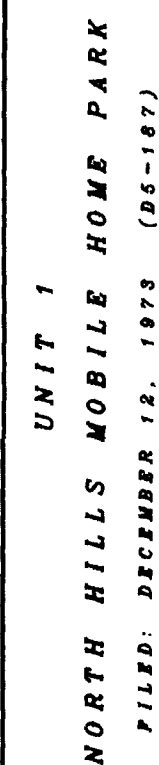


Composition and Manufacture
Holland-Stone™ is made from a "no slump" concrete mix. Made under extreme pressure and high frequency vibrations, Holland-Stone™ has a compressive strength greater than 8000psi, a water absorption maximum of 5% and will meet or exceed ASTM C-936-82 and freeze-thaw testing per section 8 of ASTM C-67-73.

Dimensions:
Height/Thickness 2 3/4" = 60mm
 or 3 1/4" = 80mm

Width Approx. 4" = 100mm
Length Approx. 7 3/4" = 200mm

Quantity needed per sq. ft. approx. 4.6 pieces


COLOR: OLD TOWN BLEND

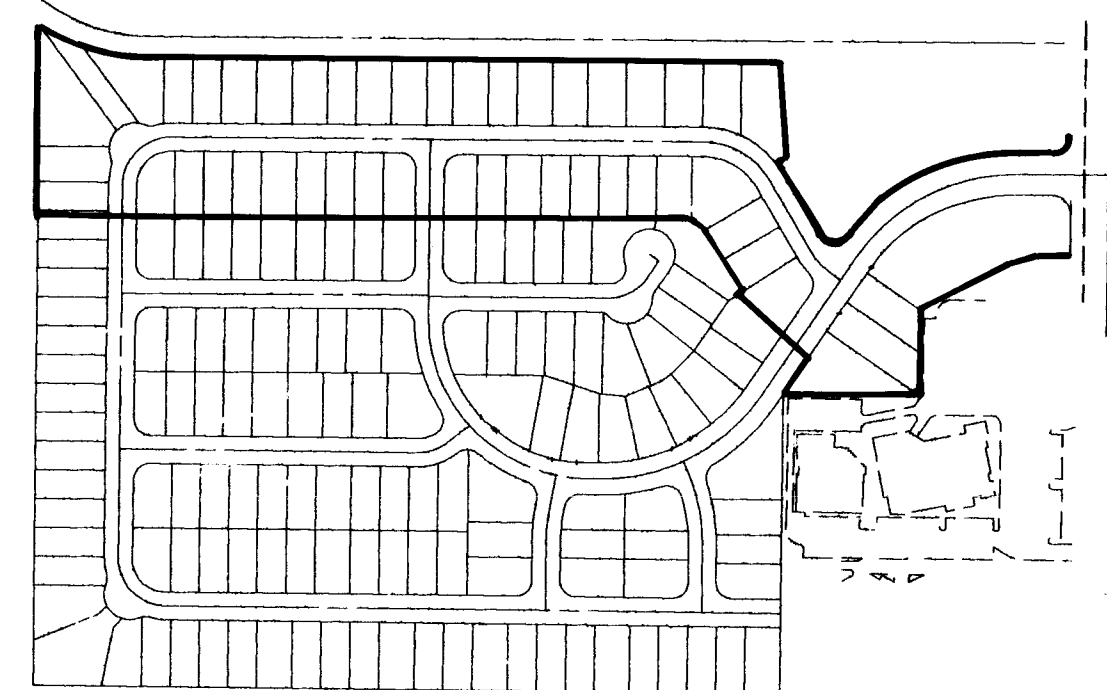


LEGEND	
PROPOSED CURB & GUTTER	
PROPOSED PROPERTY LINE	
PROPOSED FIRE HYDRANT	
PROPOSED SANITARY SEWER MANHOLE	
PROPOSED GATE VALVE	
PROPOSED STORM DRAIN MANHOLE	
PROPOSED STORM DRAIN INLET	
PROPOSED STREET LIGHTS	

[illegible]


		CITY OF ALBUQUERQUE PUBLIC WORKS DEPARTMENT ENGINEERING GROUP					
TITLE: PALOMAS PARK - PHASE I PAVING PLAN							
APPROVALS	ENGINEER	DATE	APPROVALS	ENGINEER	DATE		
DRC CHAIRMAN	<i>Rogelio</i>	8-26-92	WATER	<i>N/A RWE</i>	8-25-92		
TRANSPORTATION	<i>P. Dwyer</i>	8-24-92	WASTE WATER	<i>N/A RWE</i>	8-25-92		
HYDROLOGY	<i>H. Ahlby</i>	8-20-92	PARKS	<i>Calvin K. Fry</i>	8-20-92		
DRAWING NO.		4510 90		MAP NO.		D 19-7	
				SHEET		6 OF 14	

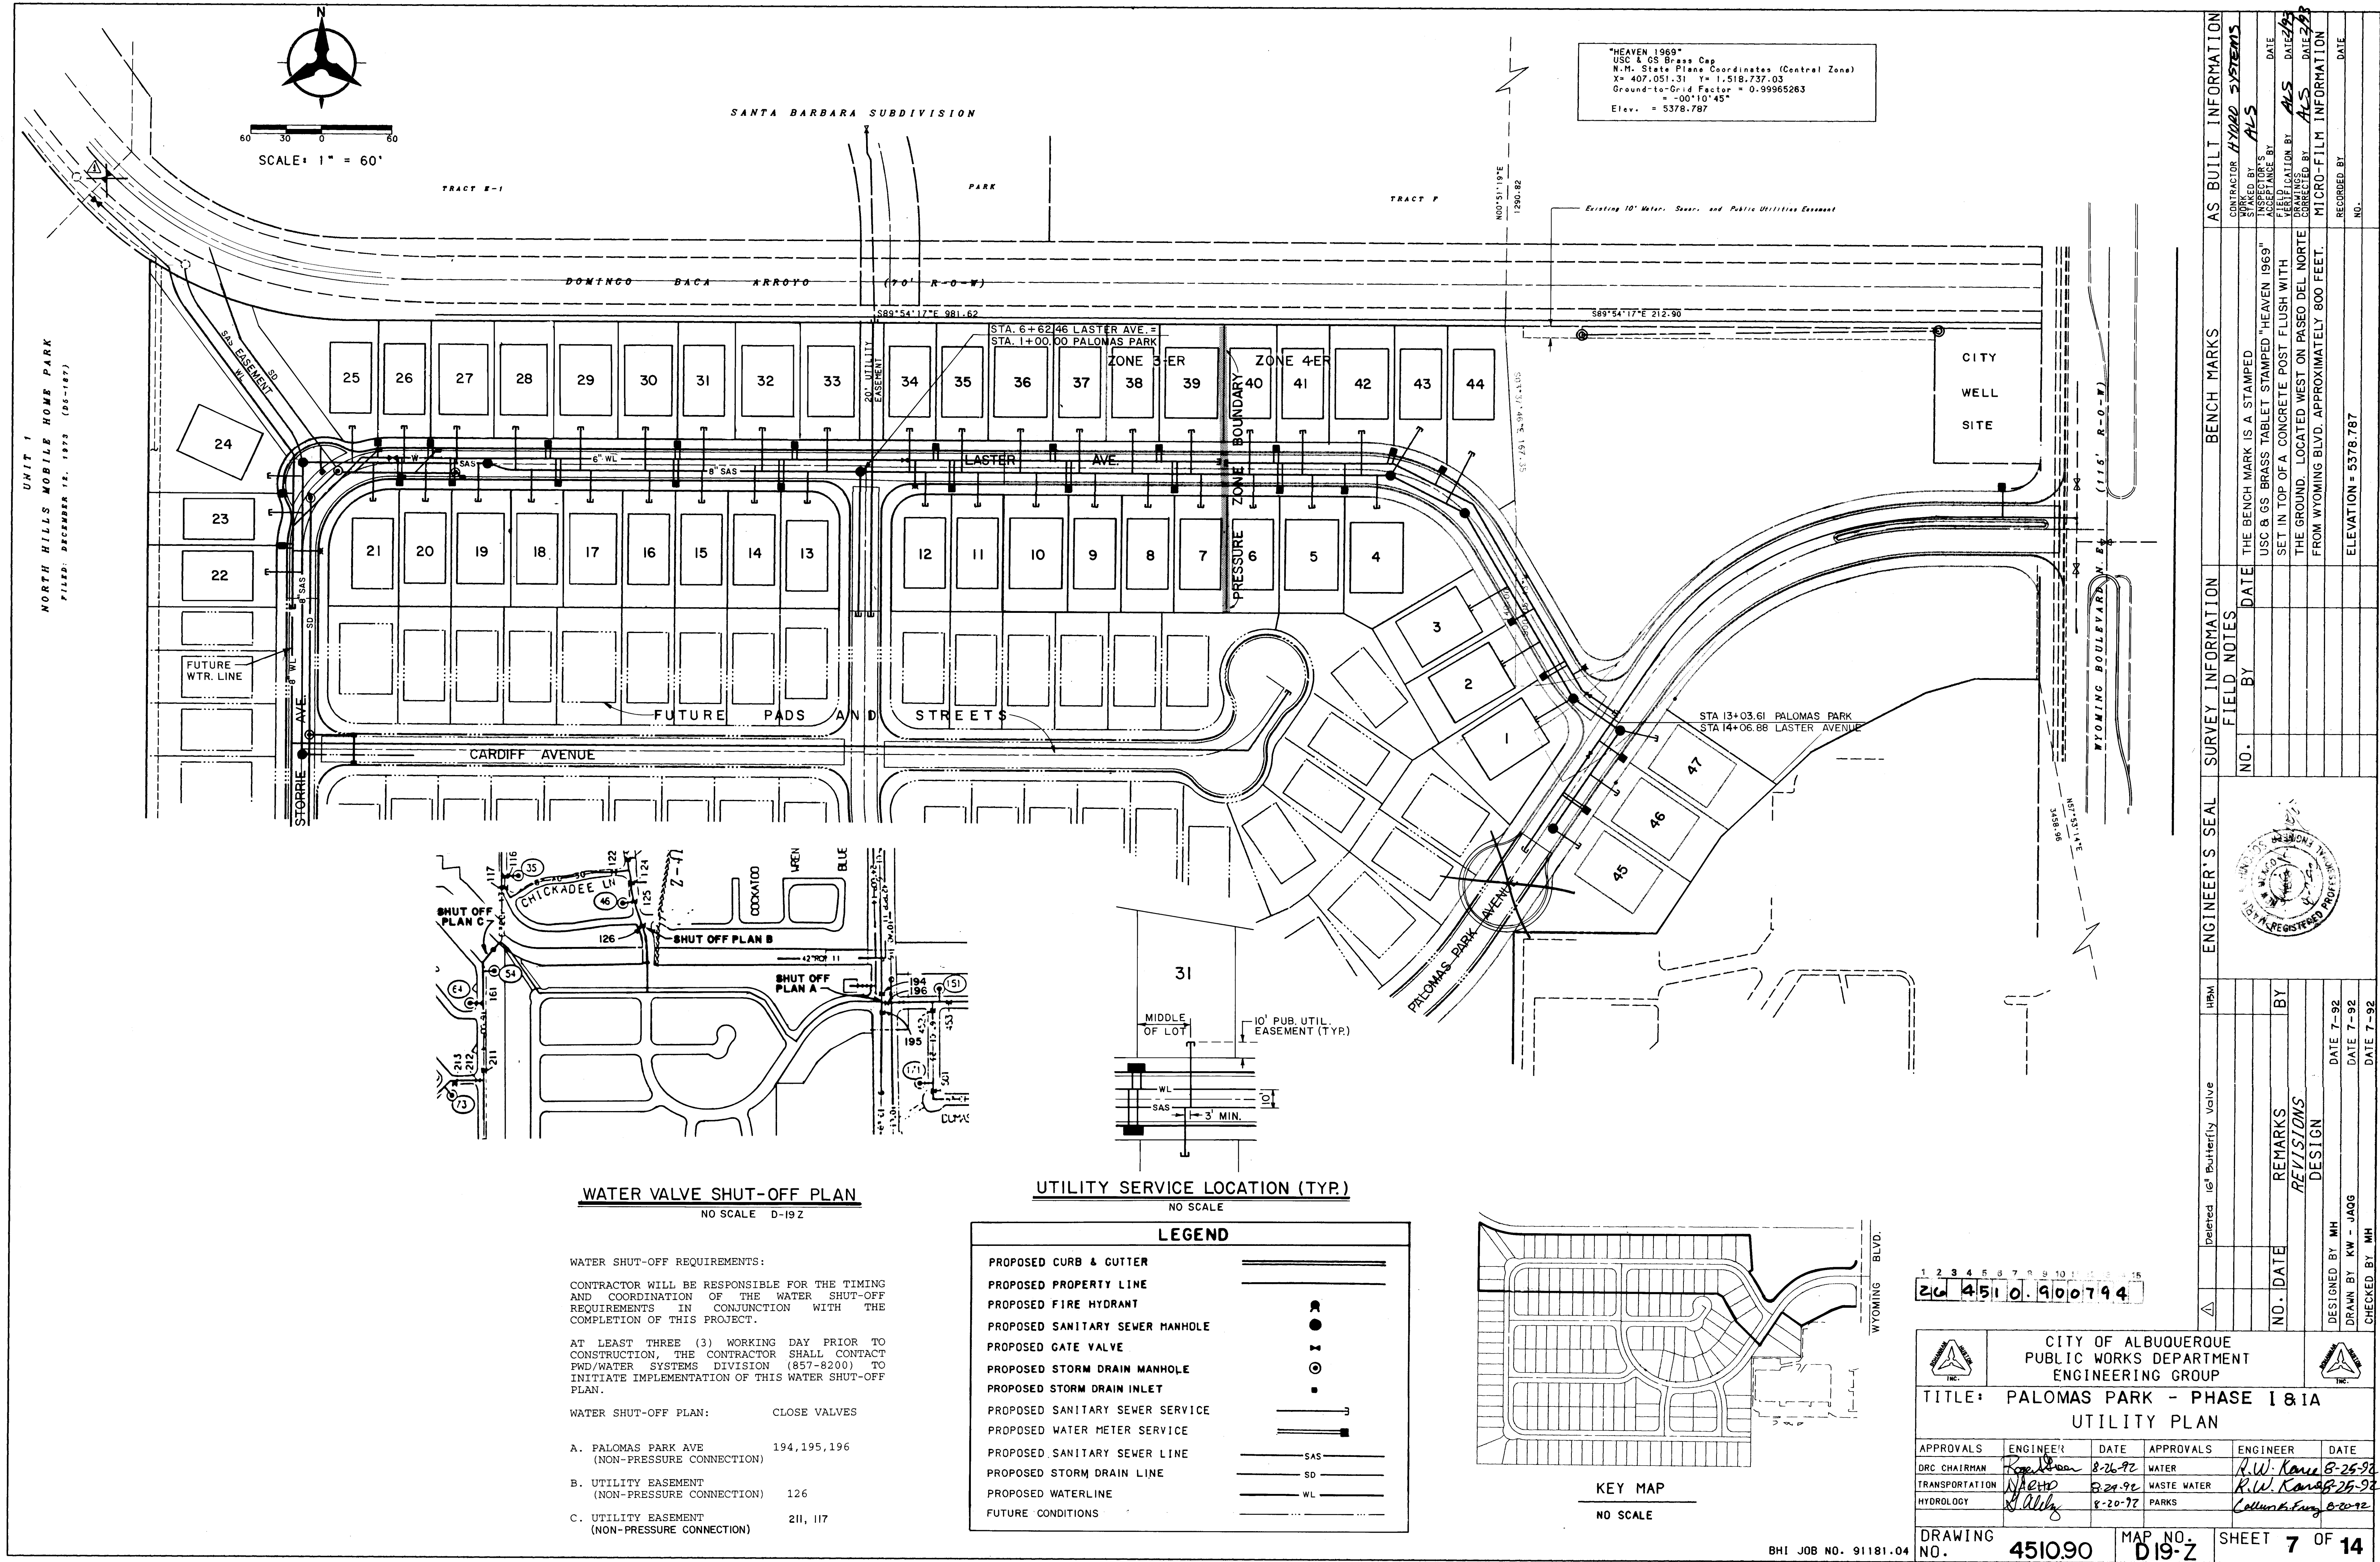

TEMPORARY CUL-DE-SAC CURB DATA				
STATION & OFFSET	FL	PT	DELTA	
II+49.99, 33.56' RT	74.12	1	30°25'18"	
II+31.63, 33.97' RT	73.73	2	60°50'36"	
II+15.59, 25.02' RT	73.33	3	91°15'54"	
II+06.29, 9.18' LT	73.00	4	121°41'13"	
II+06.29, 9.18' LT	73.00	5	152°06'31"	
II+15.59, 25.02' LT	73.33	6	182°31'49"	
II+31.63, 33.97' LT	73.73	7	212°67'07"	
II+49.99, 33.56' LT	74.12	8	243°22'25"	
			273°47'43"	

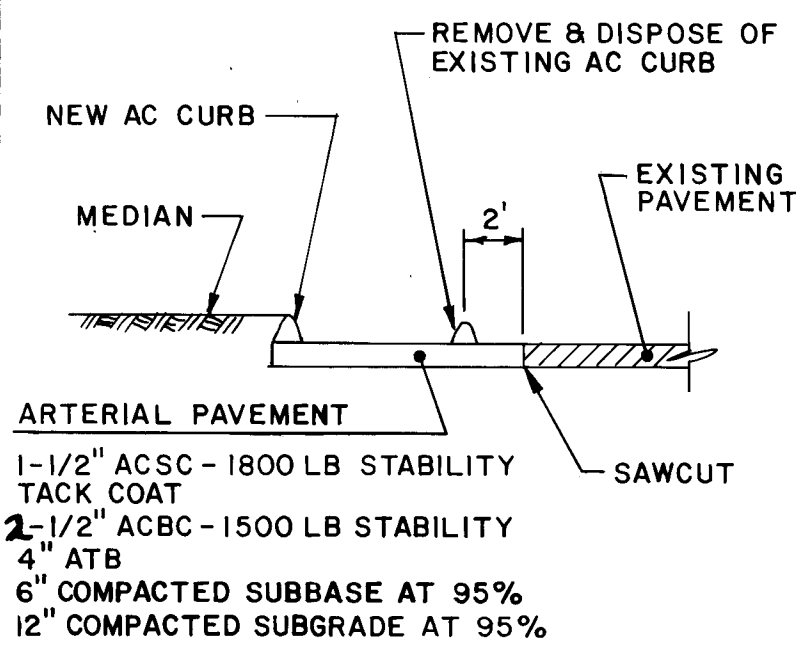


PAVEMENT SECTION (TYP.)
NTS

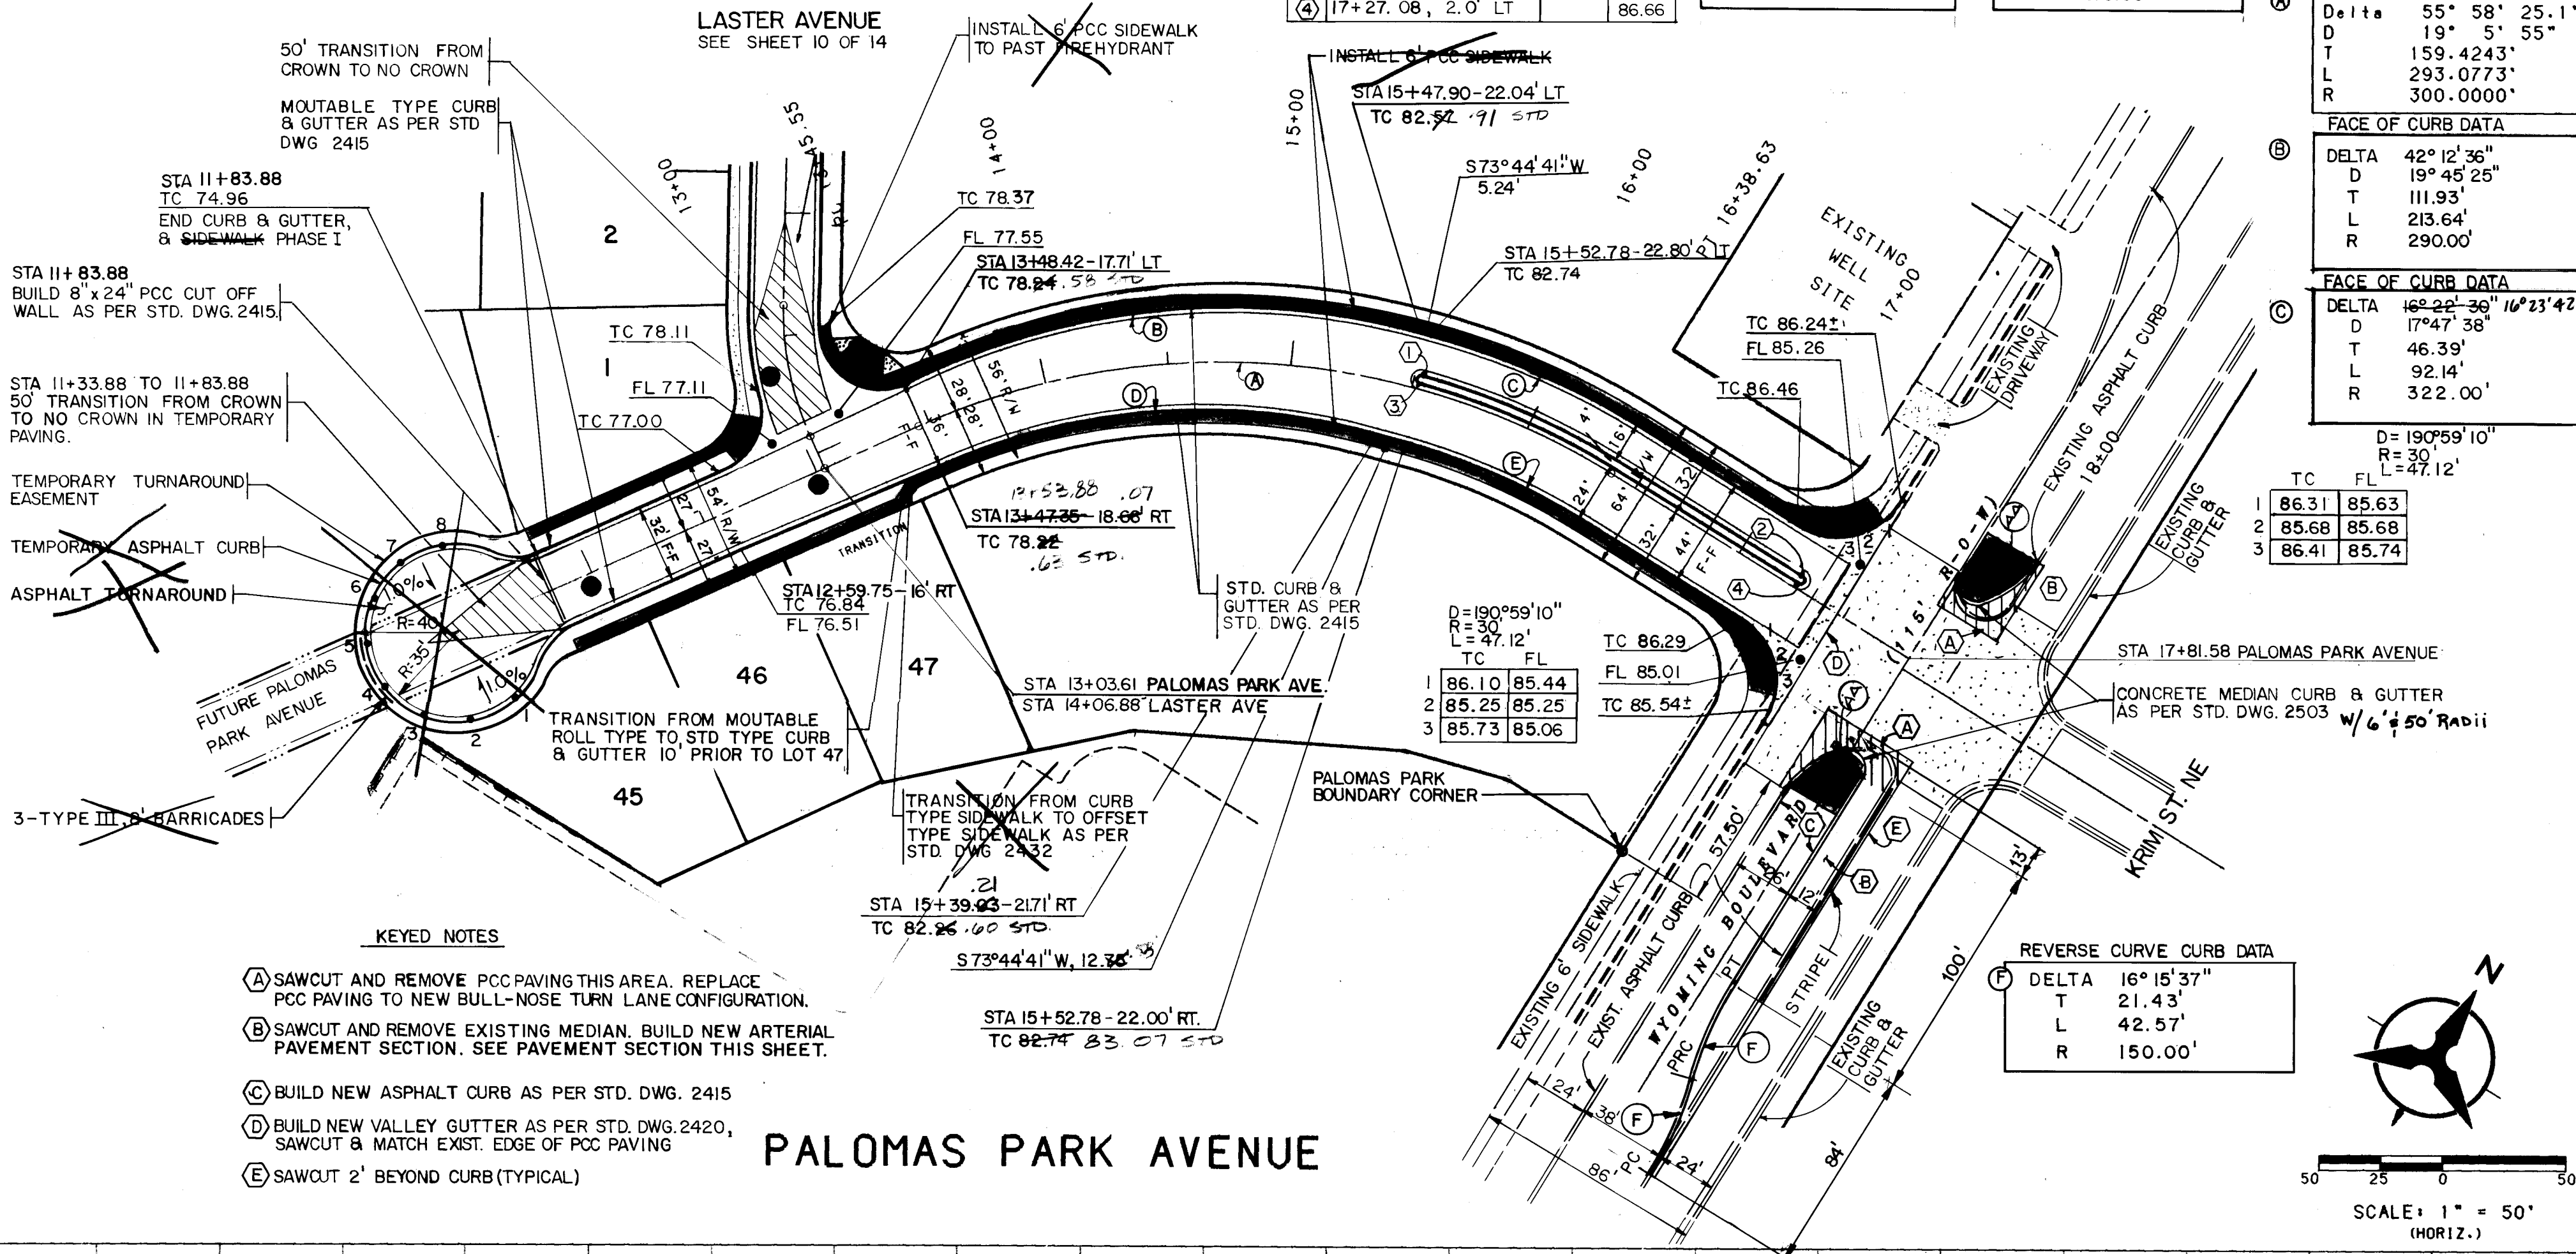

- KEYED NOTES**
- (A) SAWCUT AND REMOVE PCC PAVING THIS AREA. REPLACE PCC PAVING TO NEW BULL-NOSE TURN LANE CONFIGURATION.
 - (B) SAWCUT AND REMOVE EXISTING MEDIAN. BUILD NEW ARTERIAL PAVEMENT SECTION. SEE PAVEMENT SECTION THIS SHEET.
 - (C) BUILD NEW ASPHALT CURB AS PER STD. DWG. 2415
 - (D) BUILD NEW VALLEY GUTTER AS PER STD. DWG. 2420, SAWCUT & MATCH EXIST. EDGE OF PCC PAVING
 - (E) SAWCUT 2' BEYOND CURB (TYPICAL)

PALOMAS PARK AVENUE

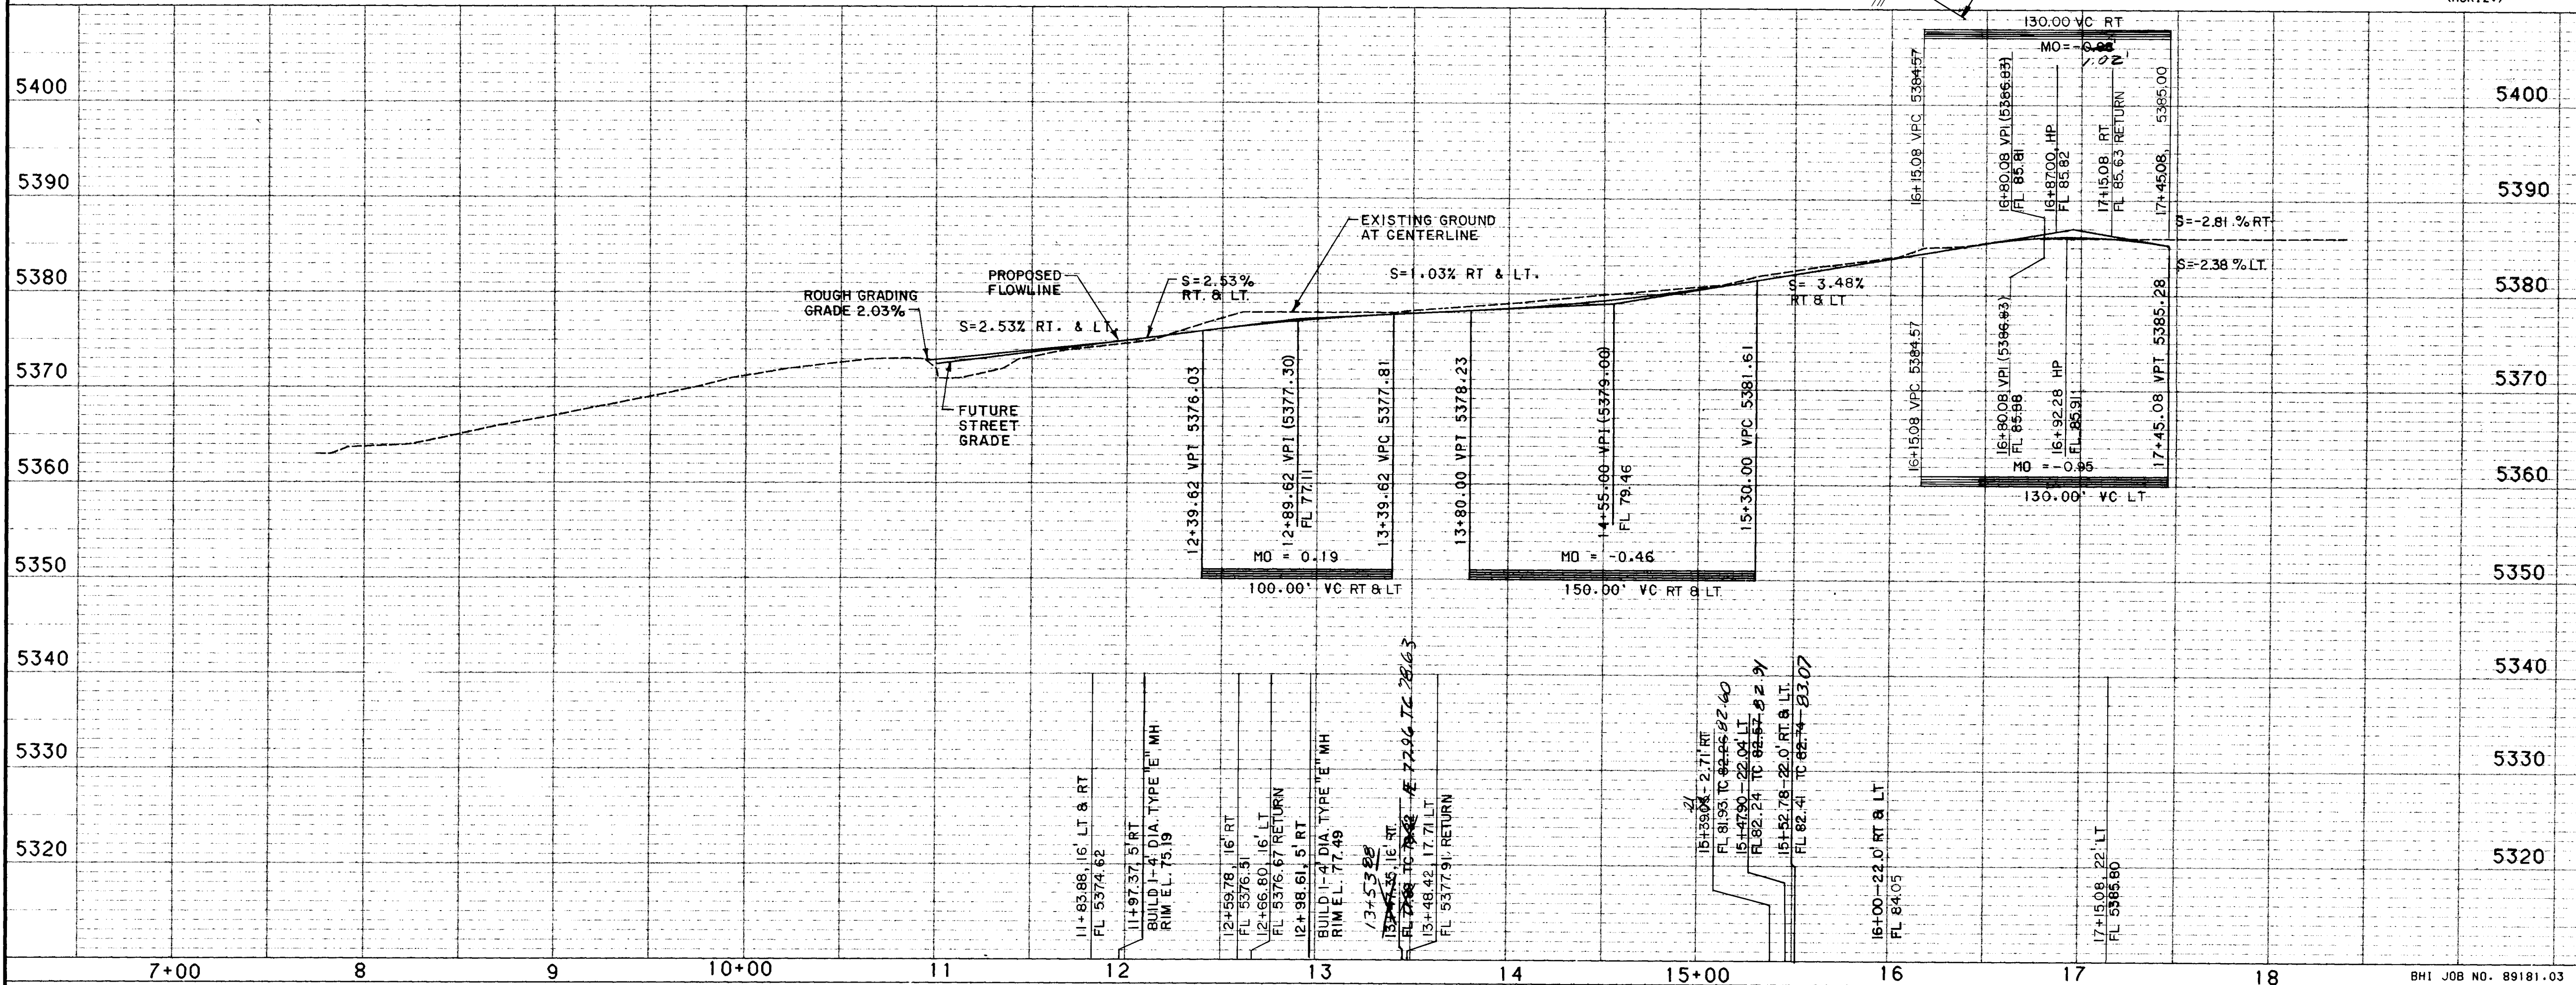

- NOTES**
- THE CONTRACTOR SHALL FIELD VERIFY ALL EXISTING UTILITY LOCATIONS AND NOTIFY THE ENGINEER IMMEDIATELY OF ANY DISCREPANCIES.
 - ALL CURB RETURN RADII SHALL BE 25' TO FACE OF CURB UNLESS OTHERWISE SPECIFIED.
 - ALL CURVE DATA AND DIMENSIONS REFER TO FACE OF CURB UNLESS OTHERWISE SPECIFIED.
 - GRADE ELEVATIONS, WHERE NOTED, ARE FOR FLOW LINE UNLESS OTHERWISE SPECIFIED.
 - CONTRACTOR IS TO INSTALL A 4"x4"x5' POST AND END AT THE END OF EACH SANITARY SEWER SERVICE.
 - CONTRACTOR IS RESPONSIBLE FOR REPAIR AND/OR REPLACEMENT OF ALL UTILITY CONDUITS AND EXISTING LINES.
 - ANY ADDITIONAL GRADING REQUIRED TO MATCH PROPOSED STREET GRADES SHALL BE INCIDENTAL TO PAVING ITEMS.
 - CONTRACTOR SHALL PROVIDE THE INSPECTORS, (CITY AND PRIVATE) WITH THE PROPOSED HYDROSTATIC TESTING PLAN. THE PLAN MUST BE APPROVED BEFORE TESTING OPERATIONS BEGIN.
 - CONTRACTOR SHALL PARK EQUIPMENT AND VEHICLES AS NOT TO INTERFERE WITH NORMAL ACTIVITIES OF RESIDENTS OR OTHER CONTRACTORS ON SITE.
 - ANY DAMAGE TO THE EXISTING FACILITIES (CURB AND GUTTER, PAVEMENT, CONDUITS, LANDSCAPING, UTILITY LINES, ETC.) DURING CONSTRUCTION SHALL BE REPLACED AT THE CONTRACTORS EXPENSE.
 - REMOVAL OF THE EXISTING CURB AND GUTTER SHALL BE AS PER COA STD. DWG. 2415 (SAWCUT ONLY).
 - WHEEL CHAIR RAMPS SHALL BE CONSTRUCTED PRIOR TO ACCEPTANCE OF CURB AND GUTTER.

NOTE:
STREET LIGHTS TO BE INSTALLED BY PMH.

NOTE:
TURNAROUND & SIDEWALK NOT CONSTRUCTED OUT THIS WORK ORDER

(A) INSTALLED TEXTURED MEDIAN PAVEMENT "BAJA RED" (10' LONG)

26 4510 900894

CITY OF ALBUQUERQUE PUBLIC WORKS DEPARTMENT ENGINEERING			
PALOMAS PARK - PHASE I&IIA PAVING PLAN & PROFILE PALOMAS PARK - STA. II+83.88 TO STA. II+81.58			
APPROVALS	ENGINEER	DATE	APPROVALS
DRG CHAIRMAN	Roger D. Moore	8-26-92	WATER
TRANSPORTATION	8-26-92	WASTE WATER	N/A RWK 8-25-92
HYDROLOGY	8-20-92	PARKS	8-20-92


DRAWING NO.	4510.90	MAP NO.	D-19-Z	SHEET	8 OF 14
-------------	---------	---------	--------	-------	---------

SCANNED BY
BY LASON

AS-BUILT INFORMATION			
CONTRACTOR	H1000 SYSTEMS	DATE	8/26/92
DESIGNED BY	PMH	DATE	7/92
DRAWN BY	KW	DATE	7/92
CHECKED BY	JLW	DATE	7/92
BENCH MARKS			
THE BENCH MARK IS A STAMPED "HEAVEN 1989".	DATE	NO.	
SURVEY INFORMATION			
FIELD NOTES	DATE	NO.	
REMARKS	BY	DATE	
REVISIONS			
DESIGN			


*NOTE
SEE SHEET 14 OF 14 FOR
ADDITIONAL INFORMATION
ON KNUCKLE.

CUL-DE-SAC CURB DATA				
STATION & OFFSET	TC	PT	DELTA	
1+79.50, 30.49' LT	44.99	1	21° 07' 33"	
1+87.18, 36.88' LT	45.29	2	42° 15' 05"	
1+95.38, 40.16' LT	44.62	3	63° 22' 38"	
2+03.74, 40.16' LT	44.62	4	84° 30' 10"	
2+11.94, 36.88' LT	44.62	5	105° 37' 43"	
2+19.63, 30.48' LT	45.29	6	126° 45' 15"	

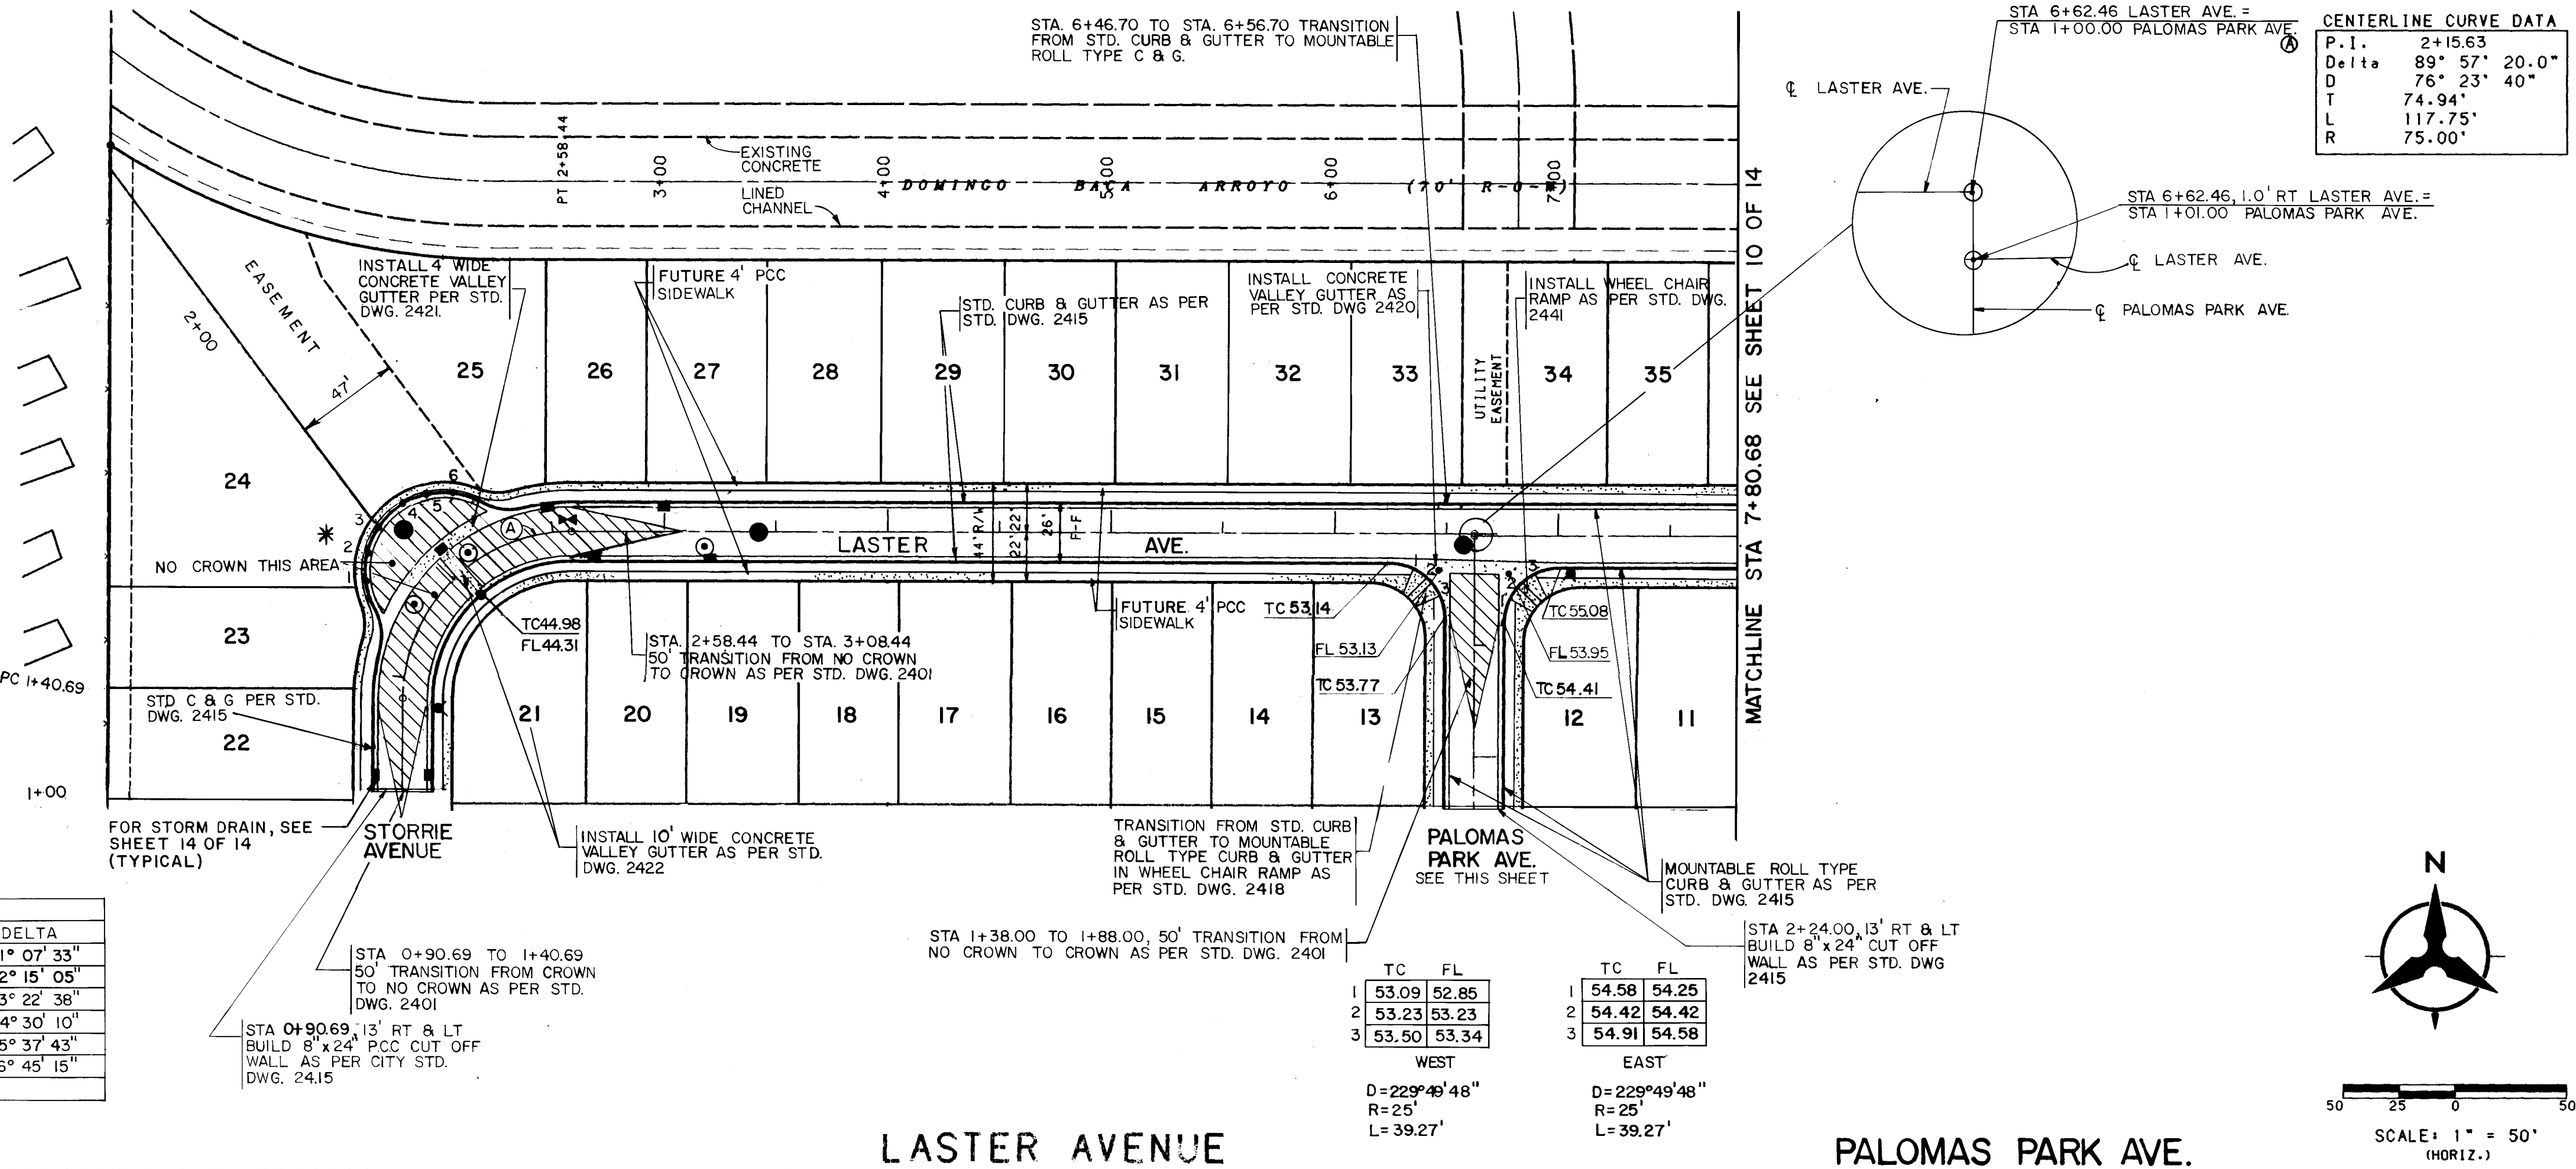

- NOTES
1. THE CONTRACTOR SHALL FIELD VERIFY ALL EXISTING UTILITY LOCATIONS AND NOTIFY THE ENGINEER IMMEDIATELY OF ANY DISCREPANCIES.
 2. ALL CURB RETURN RADI SHALL BE 25' TO FACE OF CURB UNLESS OTHERWISE SPECIFIED.
 3. ALL CURVE DATA AND DIMENSIONS REFER TO FACE OF CURB UNLESS OTHERWISE SPECIFIED.
 4. GRADE ELEVATIONS, WHERE NOTED, ARE FOR FLOW LINE UNLESS OTHERWISE SPECIFIED.
 5. CONTRACTOR IS TO INSTALL A 4"x4"x5' POST AND END AT THE END OF EACH SANITARY SEWER SERVICE.
 6. CONTRACTOR IS RESPONSIBLE FOR REPAIR AND/OR REPLACEMENT OF ALL UTILITY CONDUITS AND EXISTING LINES.
 7. ANY ADDITIONAL GRADING REQUIRED TO MATCH PROPOSED STREET GRADES SHALL BE INCIDENTAL TO PAVING ITEMS.
 8. CONTRACTOR SHALL PROVIDE THE INSPECTORS, (CITY AND PRIVATE) WITH THE PROPOSED HYDROSTATIC TESTING PLAN. THE PLAN MUST BE APPROVED BEFORE TESTING OPERATIONS BEGIN.
 9. CONTRACTOR SHALL PARK EQUIPMENT AND VEHICLES AS NOT TO INTERFERE WITH NORMAL ACTIVITIES OF RESIDENTS OR OTHER CONTRACTORS ON SITE.
 10. ANY DAMAGE TO THE EXISTING FACILITIES (CURB AND GUTTER, PAVEMENT, CONDUITS, LANDSCAPING, UTILITY LINES, ETC.) DURING CONSTRUCTION SHALL BE REPLACED AT THE CONTRACTORS EXPENSE.
 11. REMOVAL OF THE EXISTING CURB AND GUTTER SHALL BE AS PER COA STD. DWG. 2415 (SAWCUT ONLY).
 12. WHEEL CHAIR RAMPS SHALL BE CONSTRUCTED PRIOR TO ACCEPTANCE OF CURB AND GUTTER.

NOTE:
STREET LIGHTS TO BE INSTALLED BY PNM.

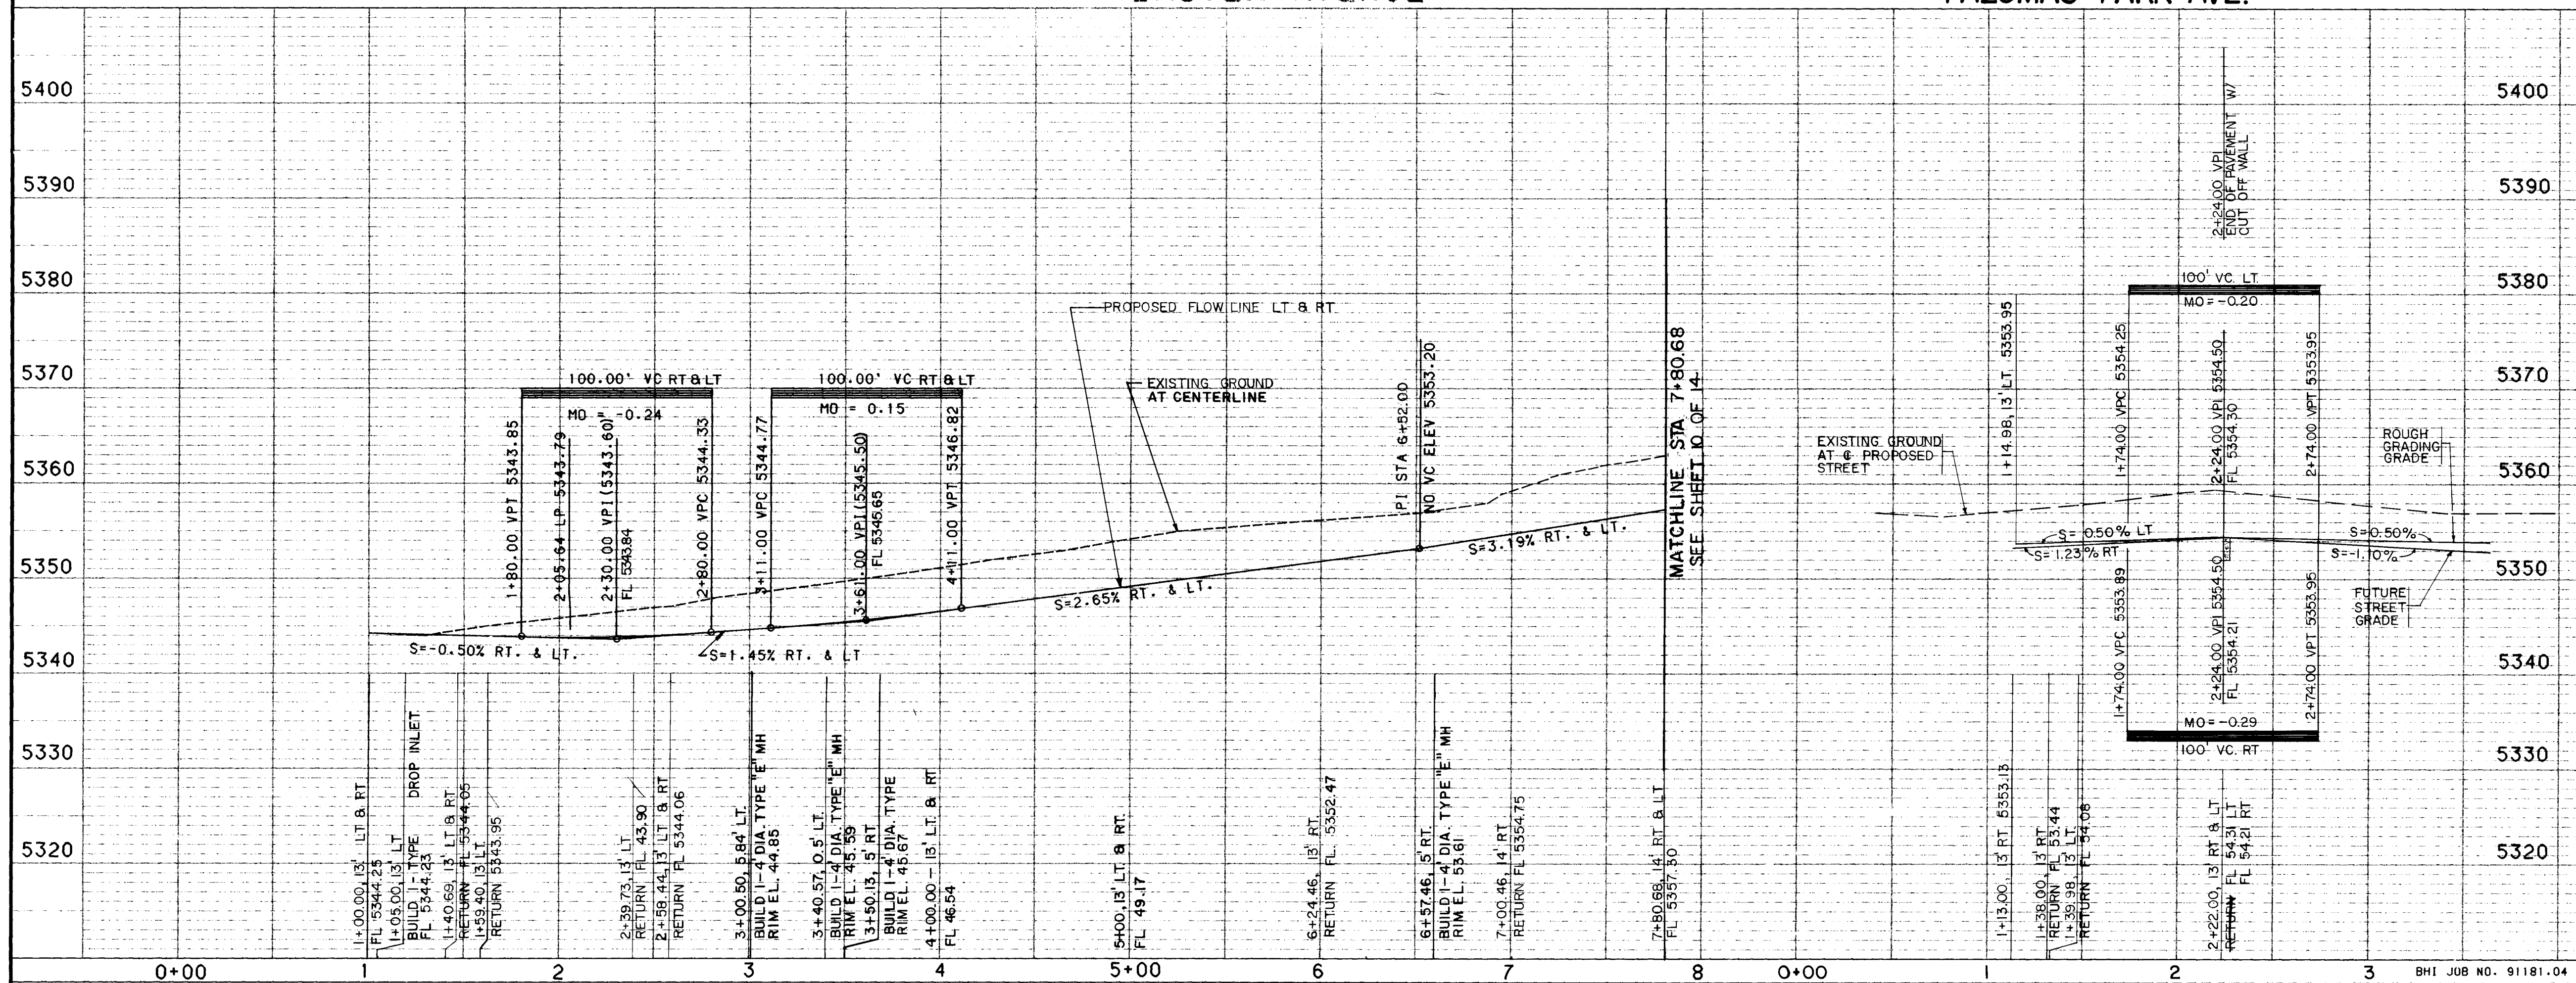

CITY OF ALBUQUERQUE PUBLIC WORKS DEPARTMENT ENGINEERING			
PALOMAS PARK - PHASE 1 & 2A PAVING PLAN & PROFILE LASTER AVE. - STA. 0+95.00 TO STA. 7+80.68			
APPROVALS	ENGINEER	DATE	APPROVALS
DRG CHAIRMAN	8-24-92	WATER	MA RWK 8-25-92
TRANSPORTATION	8-24-92	WASTE WATER	MA RWK 8-25-92
HYDROLOGY	8-20-92	PARKS	Camryn K. Fung 8-20-92

DESIGNED BY: HW
DRAWN BY: KW
CHECKED BY: JTMH

DATE 7/92
DATE 7/92
DATE 7/92

REVISIONS
NO. DATE
BY



26 4510.900994

USERNAME: CDP\CS118104.PWP
FILENAME: LASTER.GRF


SCALE: 1" = 50' (HORIZ.)
1" = 10' (VERT.)


DRAWING NO. 4510.90
MAP NO. D-19-Z
SHEET 9 OF 14

SCANNED BY
BY LASOW

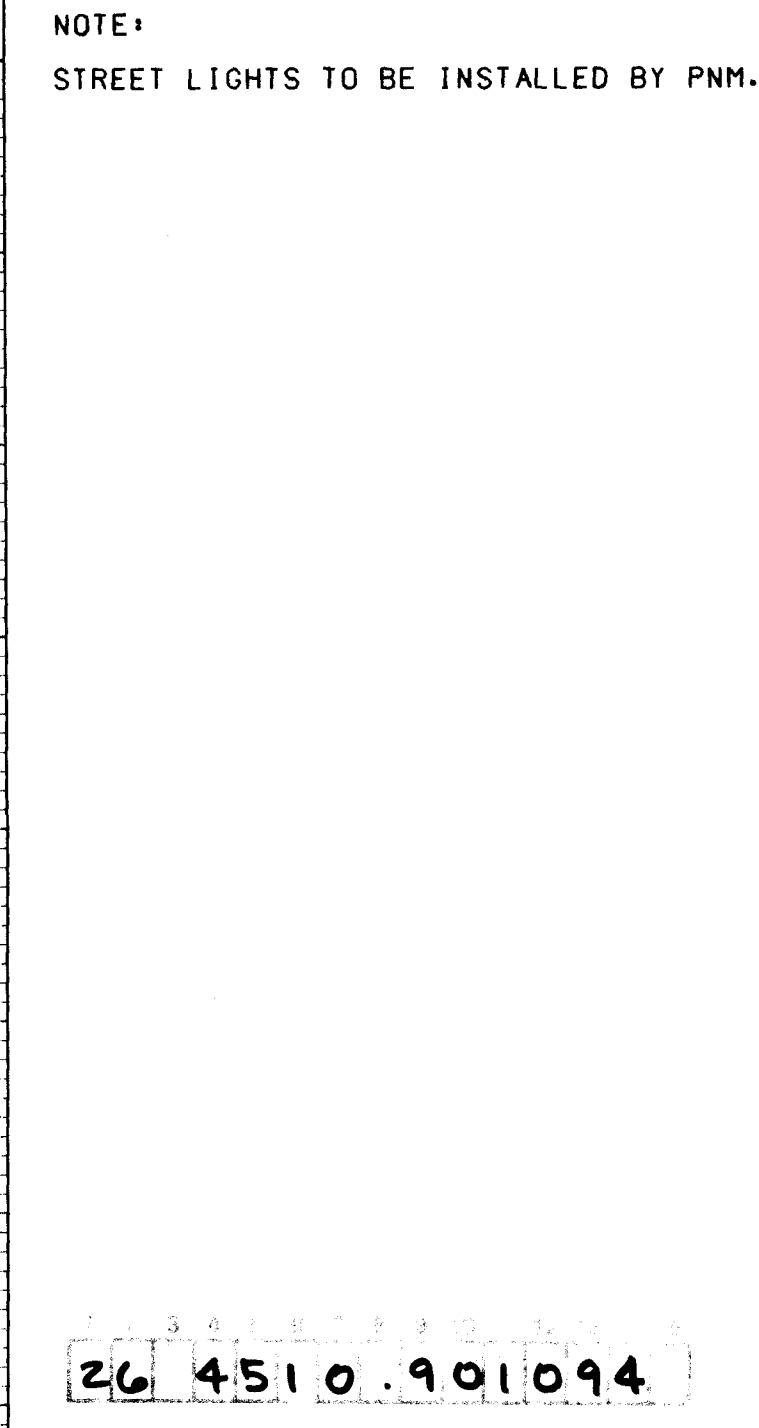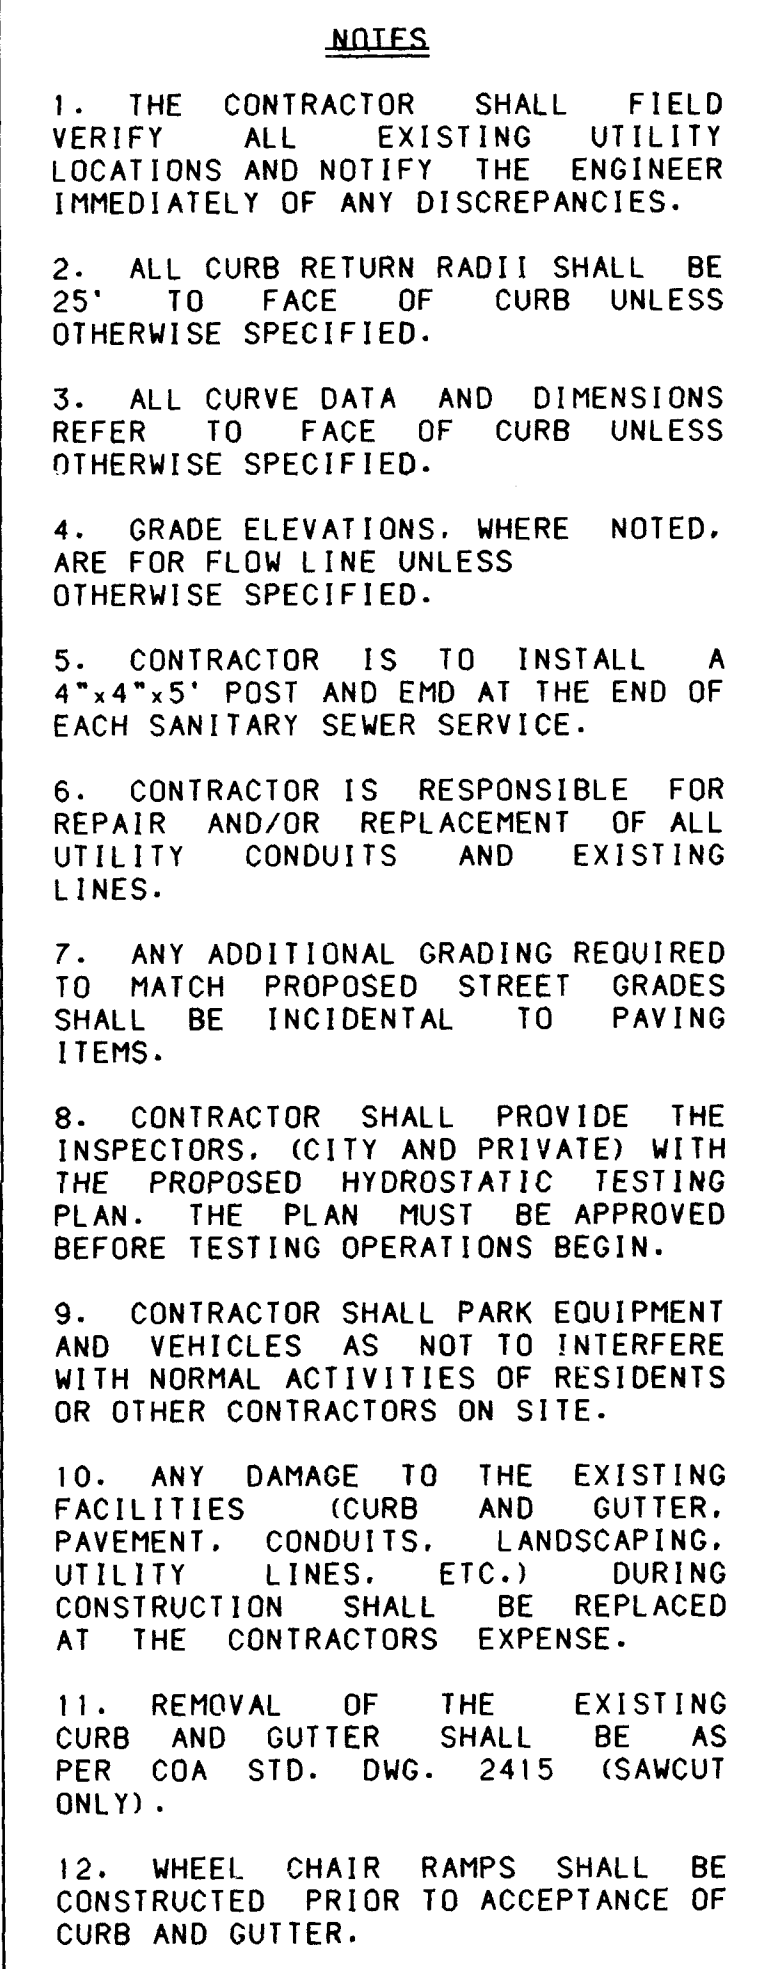


		CITY OF ALBUQUERQUE PUBLIC WORKS DEPARTMENT ENGINEERING					
PALOMAS PARK - PHASE 1&1A PAVING PLAN & PROFILE LASTER AVE. - STA. 7+06.68 TO STA. 14+06.89							
APPROVALS	ENGINEER	DATE	APPROVALS	ENGINEER	DATE		
DRC CHAIRMAN	<i>[Signature]</i>	8-26-92	WATER	N/A RWK	8-25-92		
TRANSPORTATION	<i>[Signature]</i>	8-24-92	WASTE WATER	N/A RWK	8-25-92		
HYDROLOGY	<i>[Signature]</i>	8-20-92	PARKS	<i>[Signature]</i>	8-20-92		
DRAWING NO.		4510.90		MAP NO. D-19-Z		SHEET 10 OF 14	

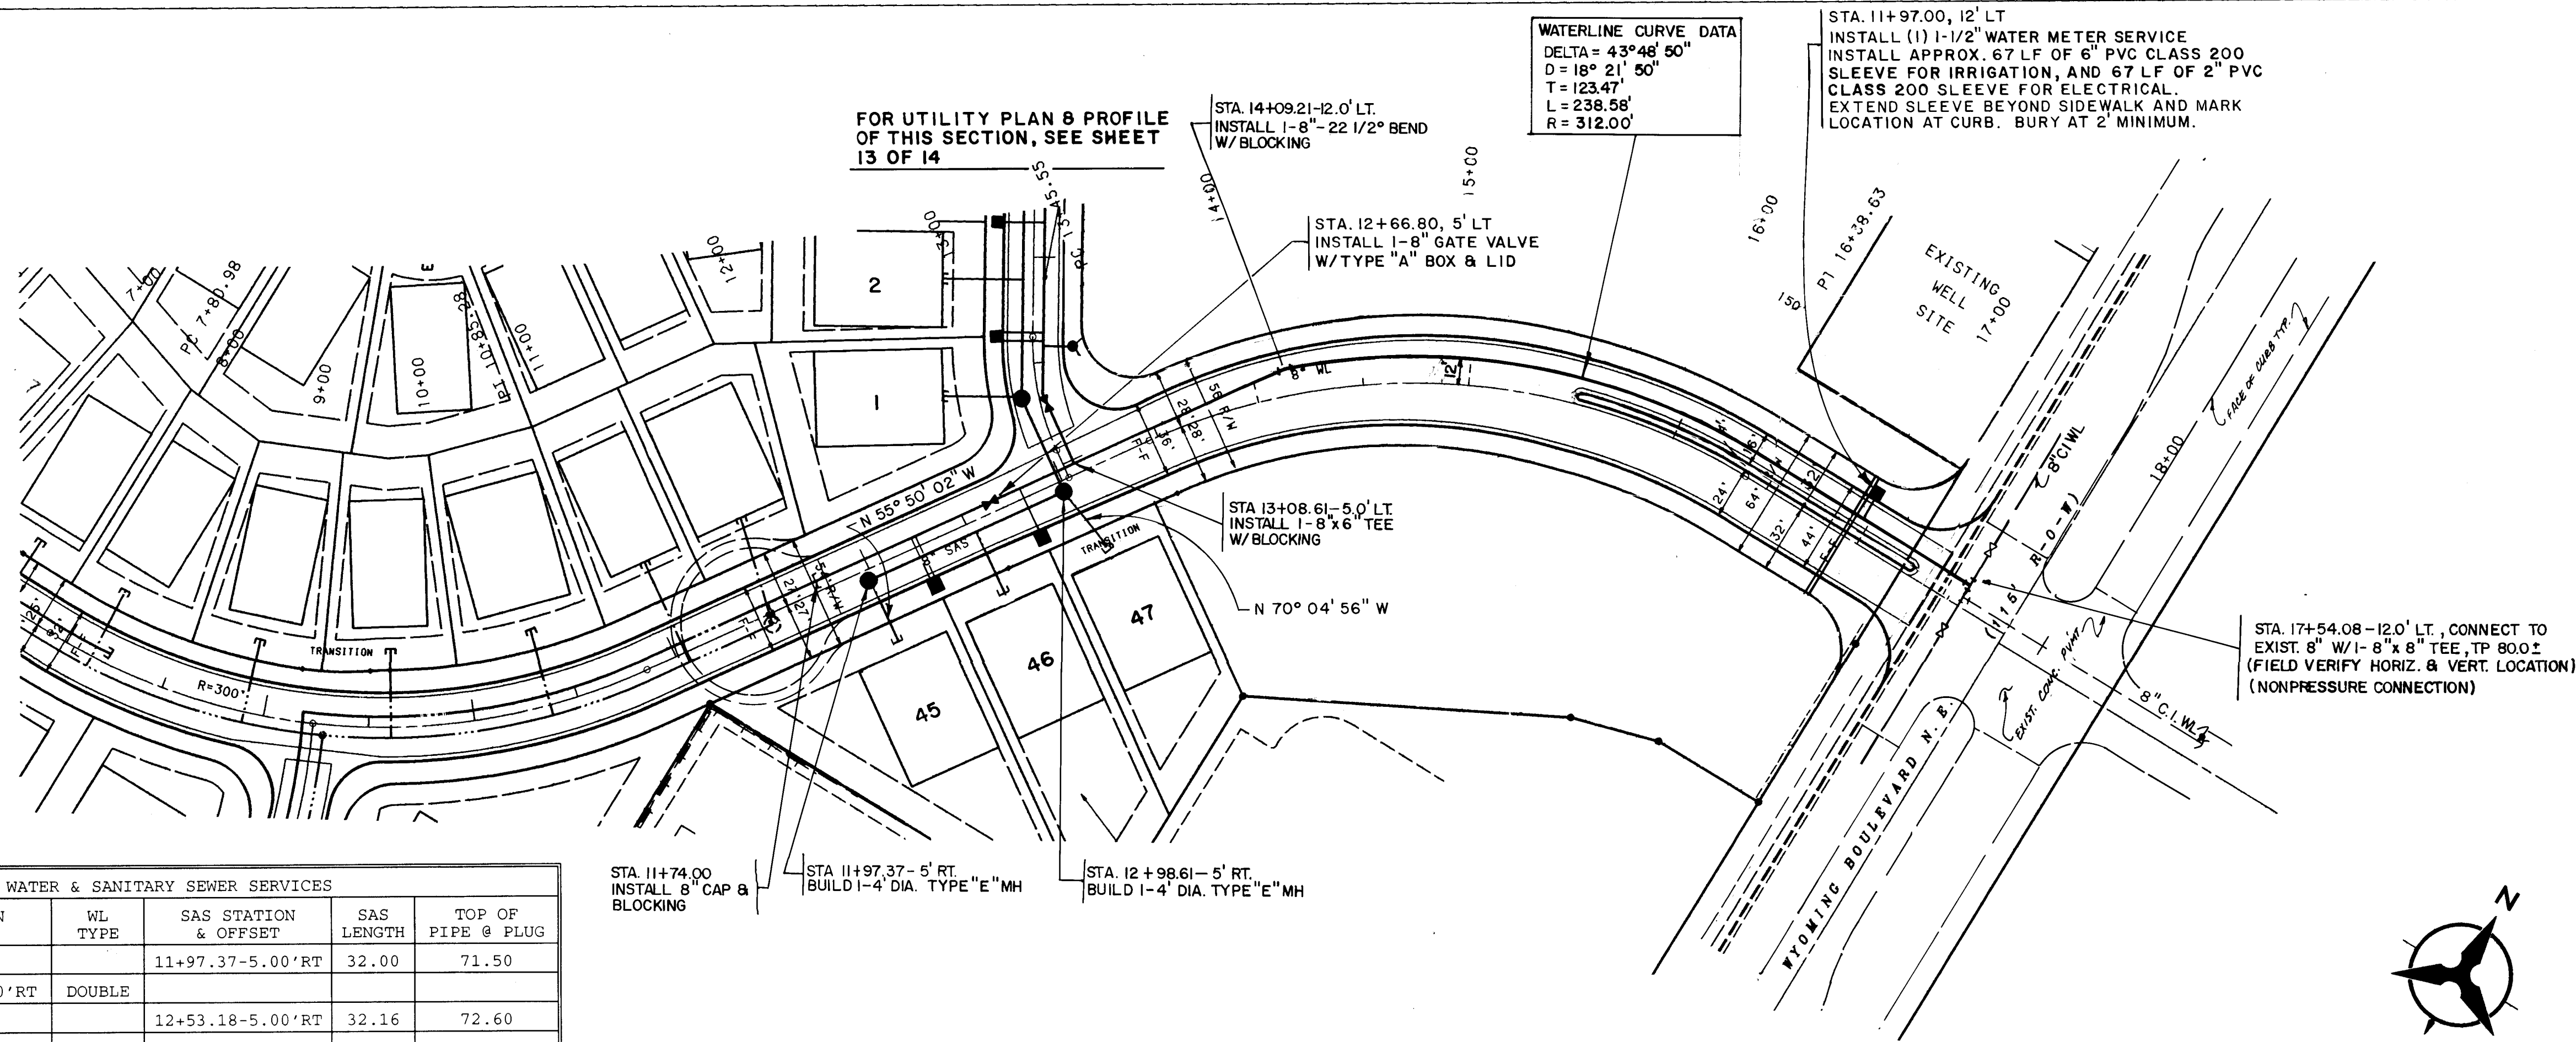

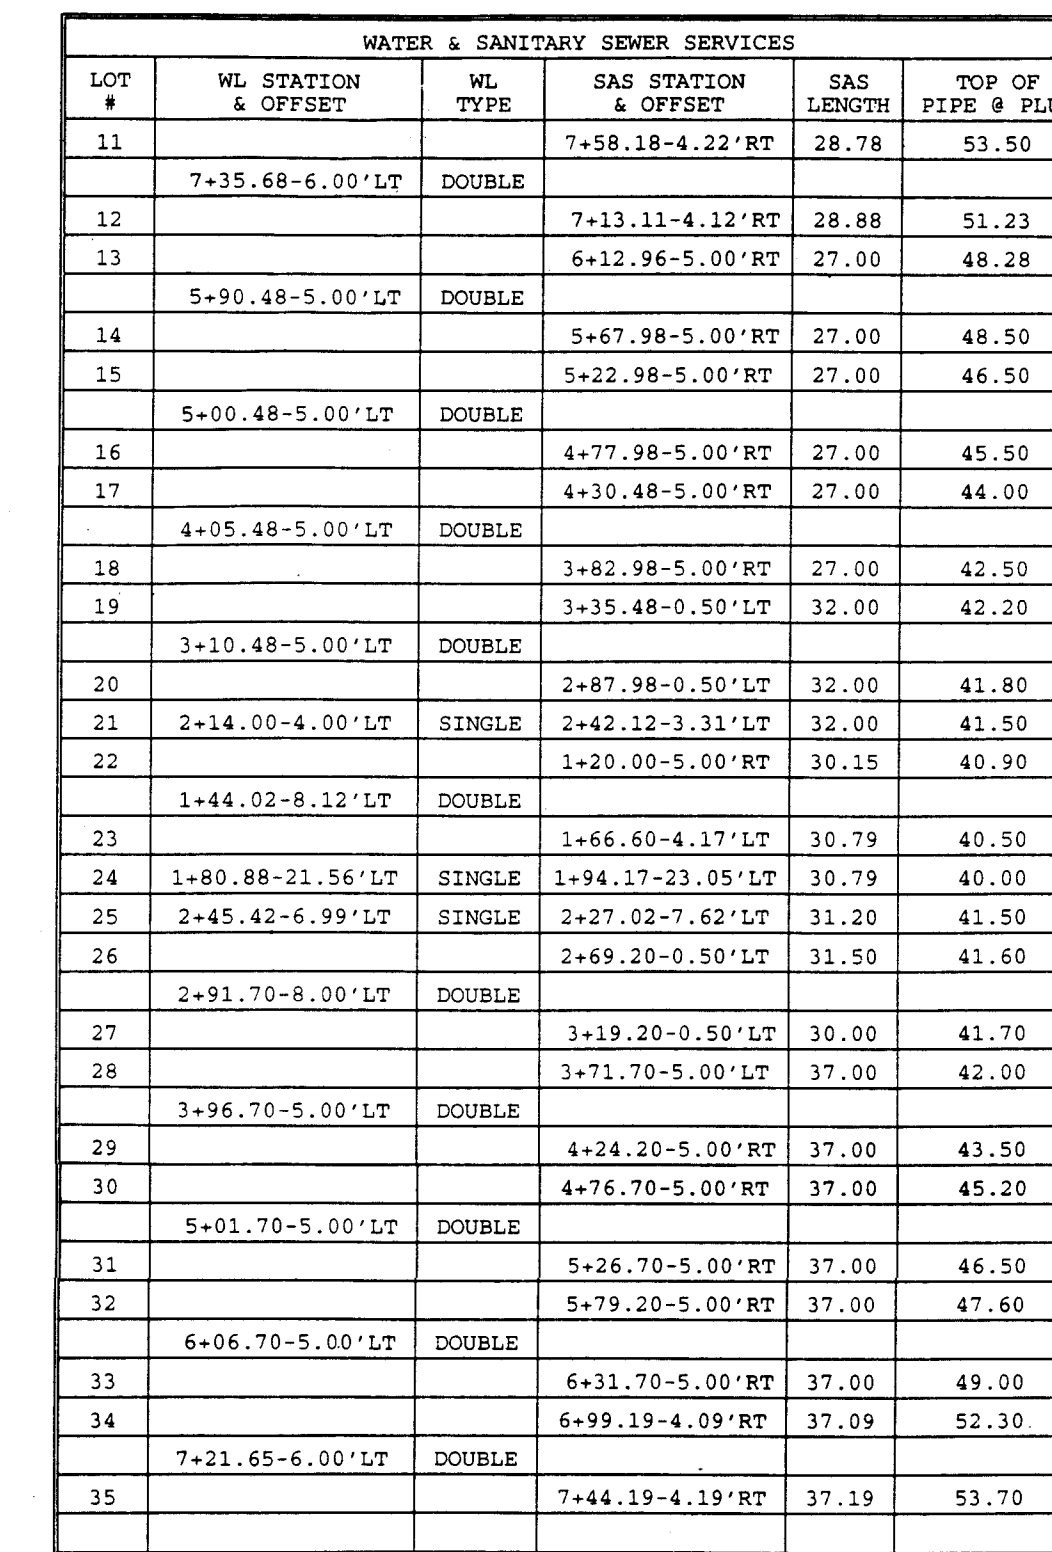


WATER & SANITARY SEWER SERVICES						
LOT #	WL STATION & OFFSET	WL TYPE	SAS STATION & OFFSET	SAS LENGTH	PIPE OF PIPES	TOP OF FL
11	7+35.68-6.00'LT	DOUBLE	7+58.18-4.22'RT	28.78		53.50
12			7+13.11-4.12'RT	28.88		51.23
13	5+90.48-5.00'LT	DOUBLE	6+12.96-5.00'RT	27.00		48.28
14			5+67.98-5.00'RT	27.00		48.50
15	5+00.48-5.00'LT	DOUBLE	5+22.98-5.00'RT	27.00		46.50
16			4+77.98-5.00'RT	27.00		45.50
17	4+05.48-5.00'LT	DOUBLE	4+30.48-5.00'RT	27.00		44.00
18			3+82.98-5.00'RT	27.00		42.50
19	3+10.48-5.00'LT	DOUBLE	3+35.48-0.50'LT	32.00		42.20
20			2+87.98-0.50'LT	32.00		41.80
21	2+14.00-4.00'LT	SINGLE	2+42.12-3.31'LT	32.00		41.50
22			1+20.00-5.00'RT	30.15		40.90
23	1+44.02-8.12'LT	DOUBLE	1+66.60-4.17'LT	30.79		40.50
24	1+80.88-21.56'LT	SINGLE	1+94.17-23.05'LT	30.79		40.00
25	2+45.42-6.99'LT	SINGLE	2+27.02-7.62'LT	31.20		41.50
26	2+91.70-8.00'LT	DOUBLE	2+69.20-0.50'LT	31.50		41.60
27			3+19.20-0.50'LT	30.00		41.70
28	3+96.70-5.00'LT	DOUBLE	3+71.70-5.00'LT	37.00		42.00
29			4+24.20-5.00'RT	37.00		43.50
30	5+01.70-5.00'LT	DOUBLE	4+76.70-5.00'RT	37.00		45.20
31			5+26.70-5.00'RT	37.00		46.50
32	6+06.70-5.00'LT	DOUBLE	5+79.20-5.00'RT	37.00		47.60
33			6+31.70-5.00'RT	37.00		49.00
34	7+21.65-6.00'LT	DOUBLE	6+99.19-4.09'RT	37.09		52.30
35			7+44.19-4.19'RT	37.19		53.70

NOTE
STREET LIGHTS TO BE INSTALLED BY PNM.

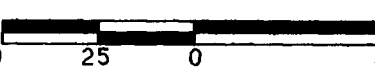

SCALE: 1" = 50'
(HORIZ.)

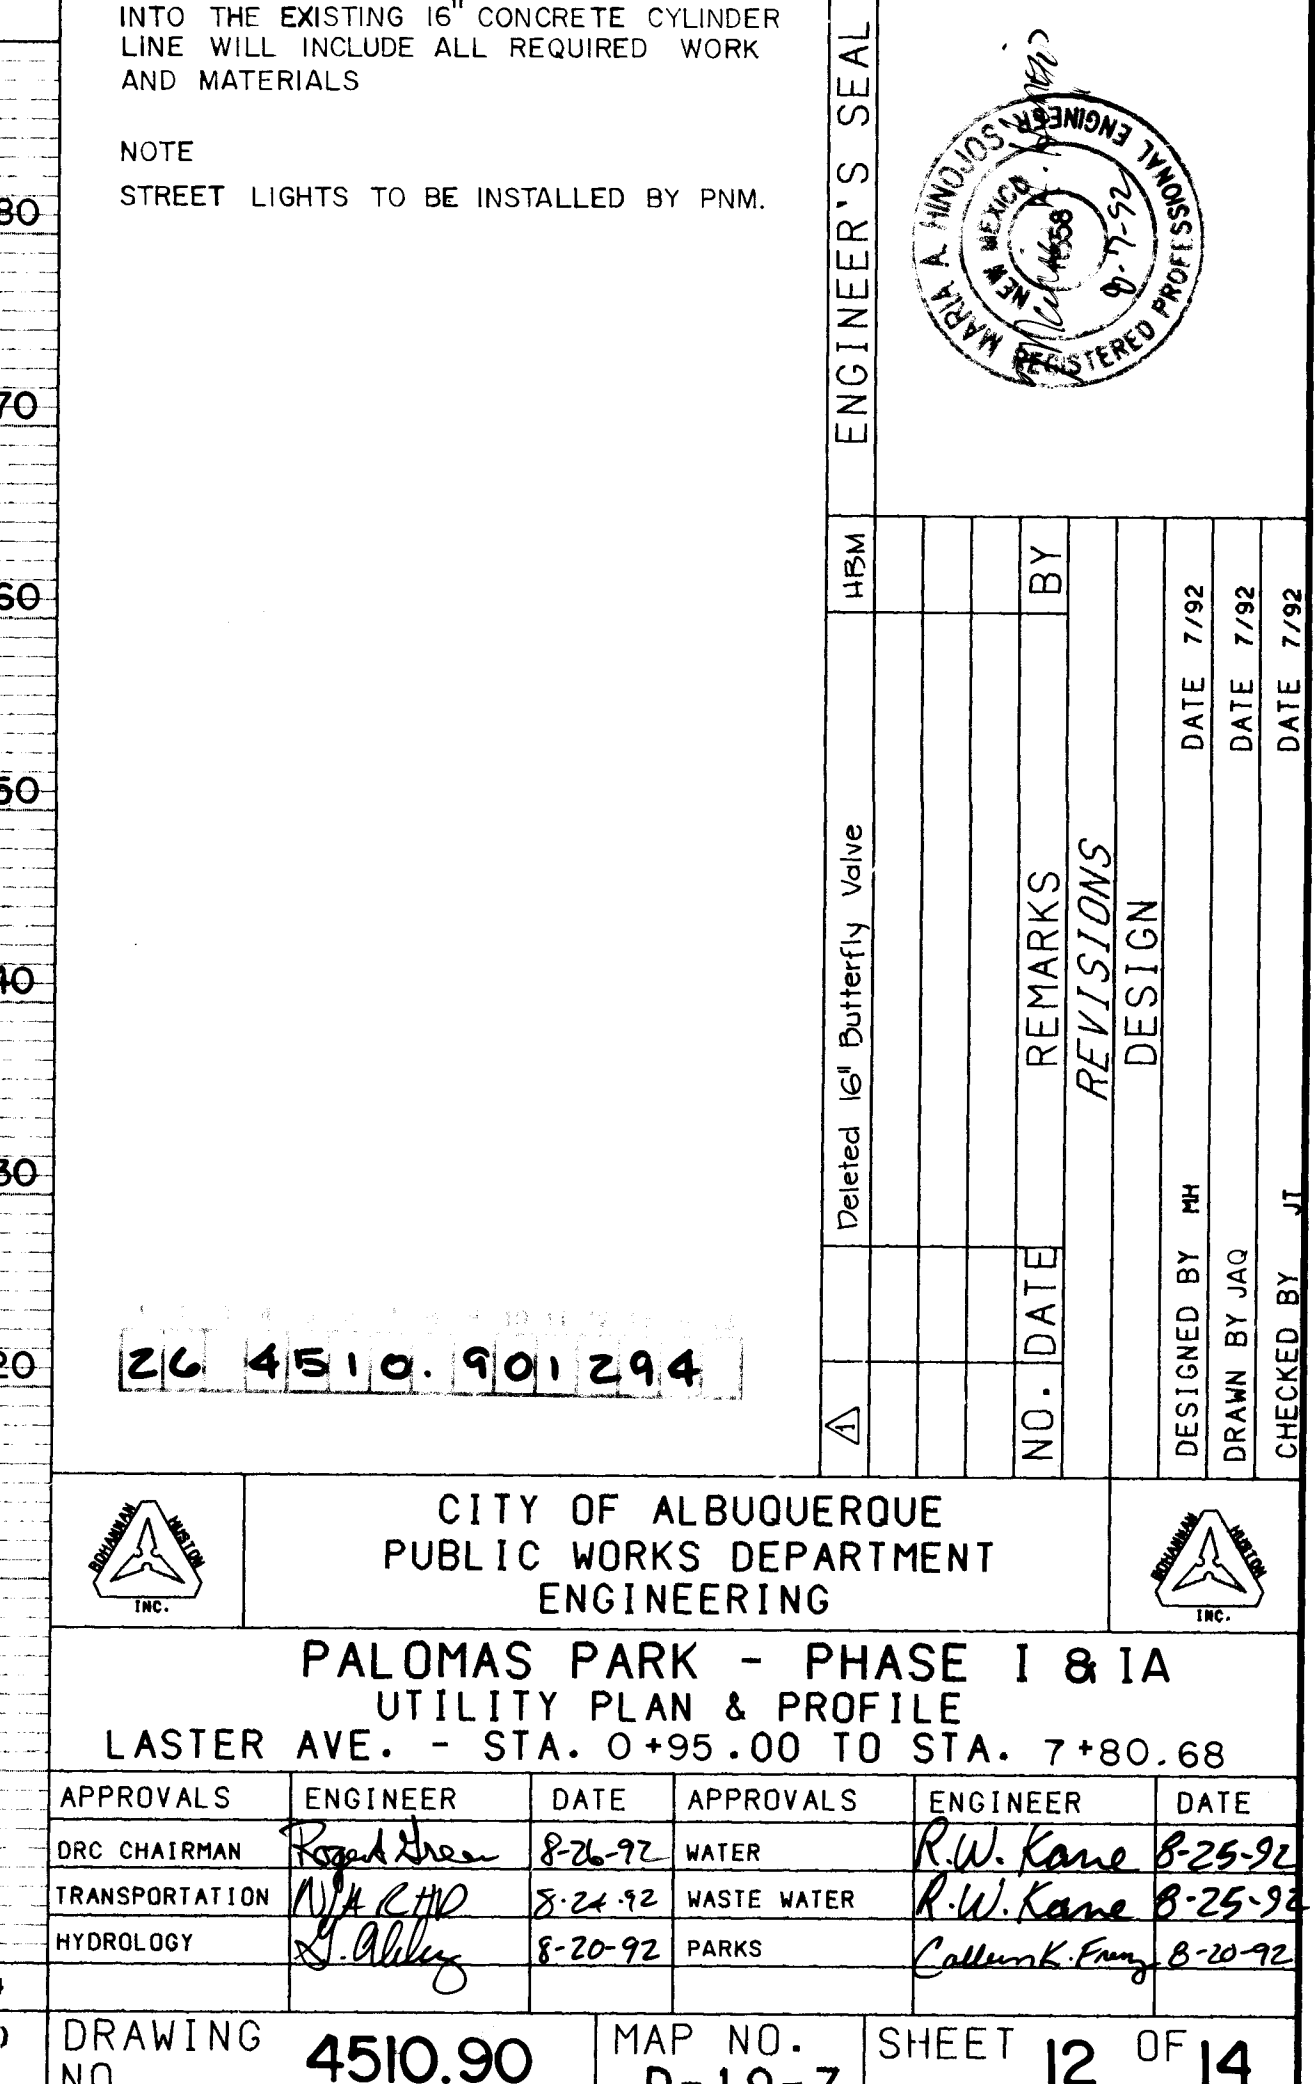

NOTE
STREET LIGHTS TO BE INSTALLED BY PNM.

		CITY OF ALBUQUERQUE PUBLIC WORKS DEPARTMENT ENGINEERING					
PALOMAS PARK - PHASE I & IA UTILITY PLAN & PROFILE LASTER AVE. - STA. 0+95.00 TO STA. 7+80.68							
APPROVALS	ENGINEER	DATE	APPROVALS	ENGINEER	DATE		
DRC CHAIRMAN	<i>Rogel Huen</i>	8-26-92	WATER	<i>R.W. Kane</i>	8-25-92		
TRANSPORTATION	<i>N.A. & H.D.</i>	8-26-92	WASTE WATER	<i>R.W. Kane</i>	8-25-92		
HYDROLOGY	<i>J. Alby</i>	8-20-92	PARKS	<i>Colleen K. Fung</i>	8-20-92		
DRAWING NO.	4510.90		MAP NO.	D-10-7		SHEET 12 OF 14	

STA 9+63.75 - 5' LT.
 INSTALL 1-6" CAP W/BLOCKING

STA 9+68.06 - 5' LT.
 INSTALL 1-6" CAP W/BLOCKING

STA 11+09.78 - 2.68' RT.
 BUILD 1-4' DIA. TYPE "E" MH

STA 11+82.70 - 0.92' RT.
 BUILD 1-4' DIA. TYPE "E" MH

STA 11+07.23
 INSTALL 1-22 1/2" BEND
 W/BLOCKING

STA 11+82.70
 INSTALL 1-6"/22 1/2" BEND,
 W/BLOCKING

STA 13+65.09 - 8.22' RT.
 BUILD 1-4' DIA. TYPE "E" MH


STA 13+69.00
 INSTALL 1-6"/22 1/2" BEND W/BLOCKING
 INSTALL 1-6" GATE VALVE W/TYPE "A" VALVE BOX & LID

STA 14+02
 INSTALL 1-8x6 TEE W/BLOCKING

STA 13+37.55 - 11.65' LT.
 INSTALL 1-6x6 TEE APPROX.
 11.63 LF OF 6" PVC, 1- FIRE
 HYDRANT 4' BURY AS PER
 STD DWG 2340
 FLANGE EL 5378.87 W/BLOCKING

PALOMAS PARK AVE.
 SEE SHEET 11 OF 14

SAS MH - SEE SHEET 11 OF 14

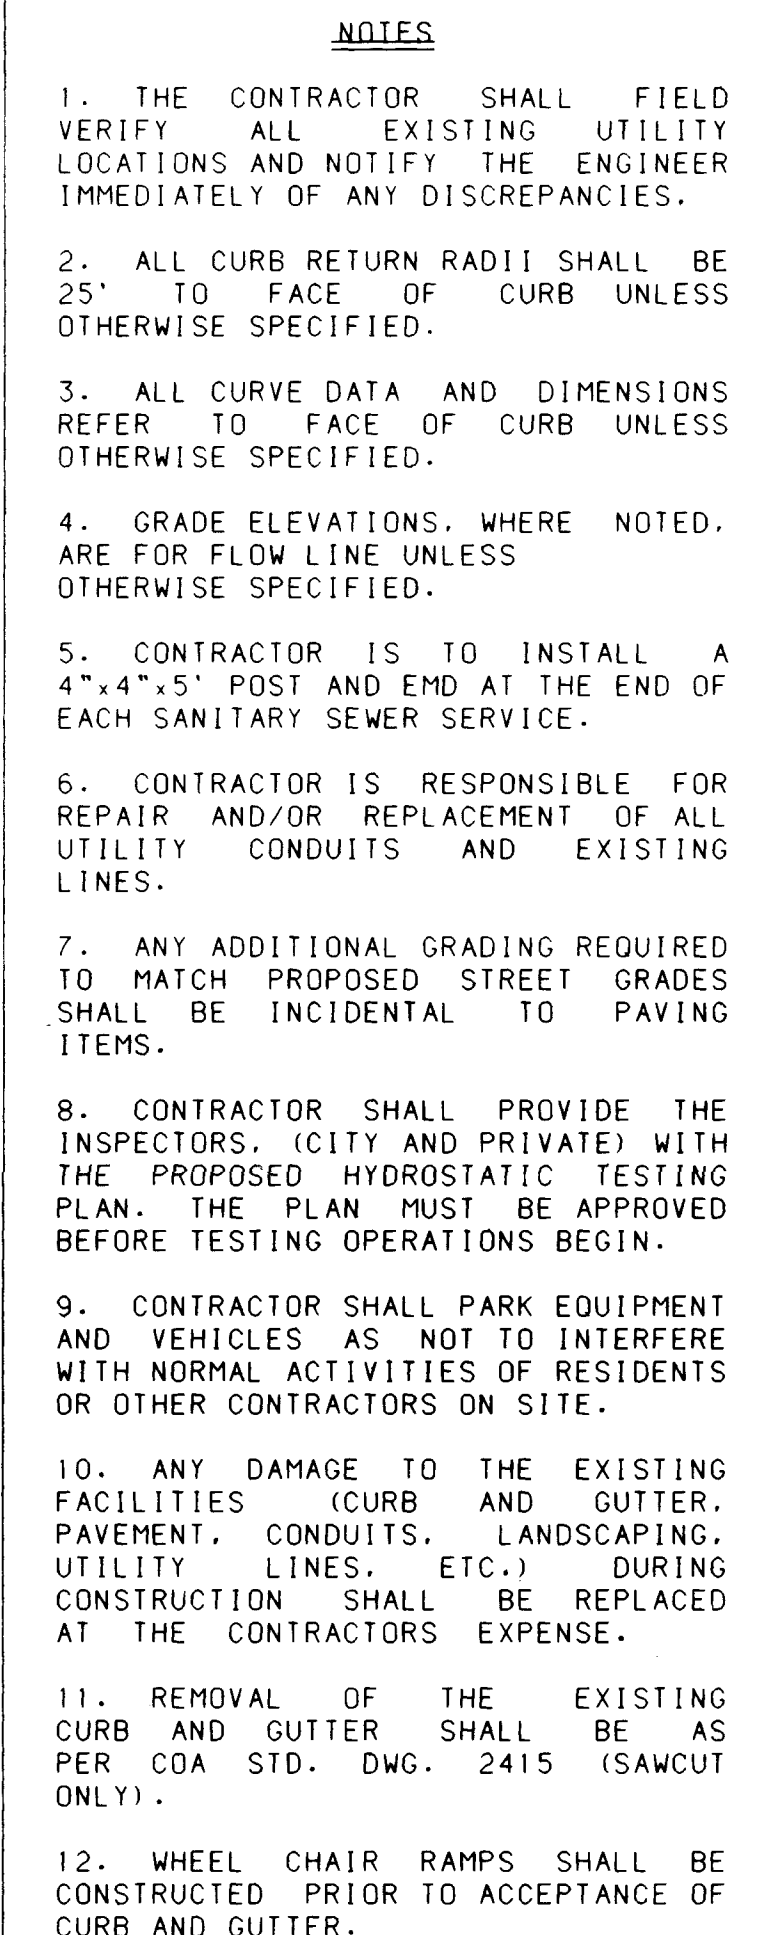


NOTE:
STREET LIGHTS TO BE INSTALLED BY PNM.

ENGINEER'S SEAL		SURVEY INFORMATION		BENCH MARKS		AS-BUILT INFORMATION	
		FIELD NOTES					
		NO.	BY	DATE			
					THE BENCH MARK IS A STAMPED		CONTRACTOR
					USC&GS BRASS TABLET STAMPED "HEAVEN 1969"		WORKED BY
					SET IN TOP OF A CONCRETE POST FLUSH WITH		SURVEYOR'S
					FIELD CATION BY		ACCEPTANCE BY
					THE GROUND. LOCATED WEST ON PASEO DEL NORTE		DATE
					CORRECTED BY		DATE
					FROM WYOMING BLVD APPROXIMATELY 800 FEET.		MICRO-FILM INFORMATION
					RECORDED BY		DATE
					ELEVATION = 5378.787		NO.

Muri. b. Herzs
8-792


	CITY OF ALBUQUERQUE PUBLIC WORKS DEPARTMENT ENGINEERING	
PALOMAS PARK - PHASE I & II UTILITY PLAN & PROFILE LASTER AVE. - STA. 7+80.68 TO STA. 14+06.88		
APPROVALS	ENGINEER	DATE
DRC CHAIRMAN	<i>Rogelio Rios</i>	<i>8-26-92</i>
TRANSPORTATION	<i>N/A C.H.D.</i>	<i>8-24-92</i>
HYDROLOGY	<i>S. Alkley</i>	<i>8-20-92</i>
DRAWING NO.	MAP NO.	SHEET
4510.90	D-19-7	13 OF 14


SCANNED BY
BY LASON

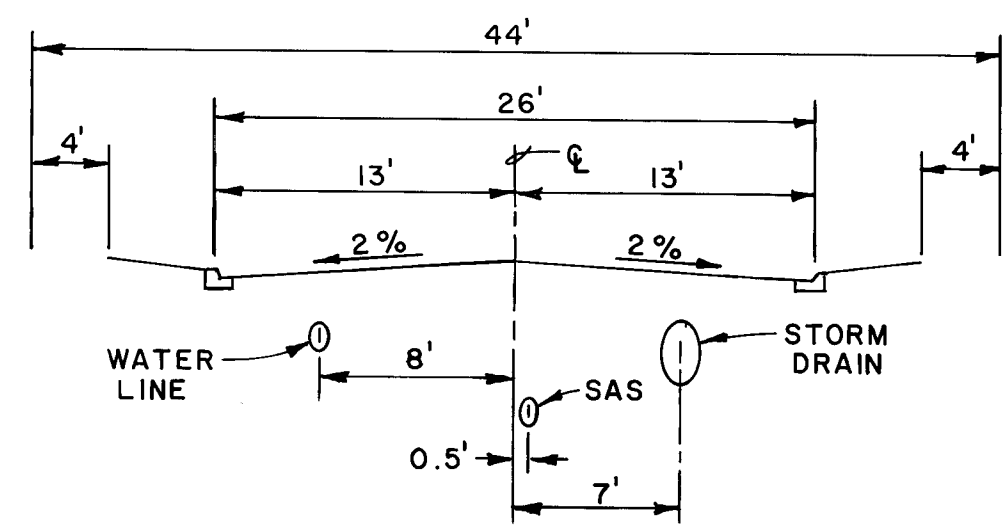

UTILITY LAYOUT

- ## KEYED NOTES
- (A) STA. 2 + 60.00 (SD)
 INSTALL 1-60" x 60" x 18" WYE
 INV. (60") 35.27
 INV. (18") 37.02
 INSTALL 18.00 LF OF 18" RCP AT S=15.39%
 - (B) STA. 2 + 87.00, 7' RT (SD) =
 STA. 2 + 05.64, 13' LT (LASTER AVE.)
 BUILD 1- DOUBLE "D" INLET
 GRATE EL. 43.79
 INV. 39.79
 - (C) INSTALL 1-22"²⁰ BEND & 1-11¼" BEND
 WITH BLOCKING
 - (D) INSTALL 1- 8" x 6" TEE WITH BLOCKING

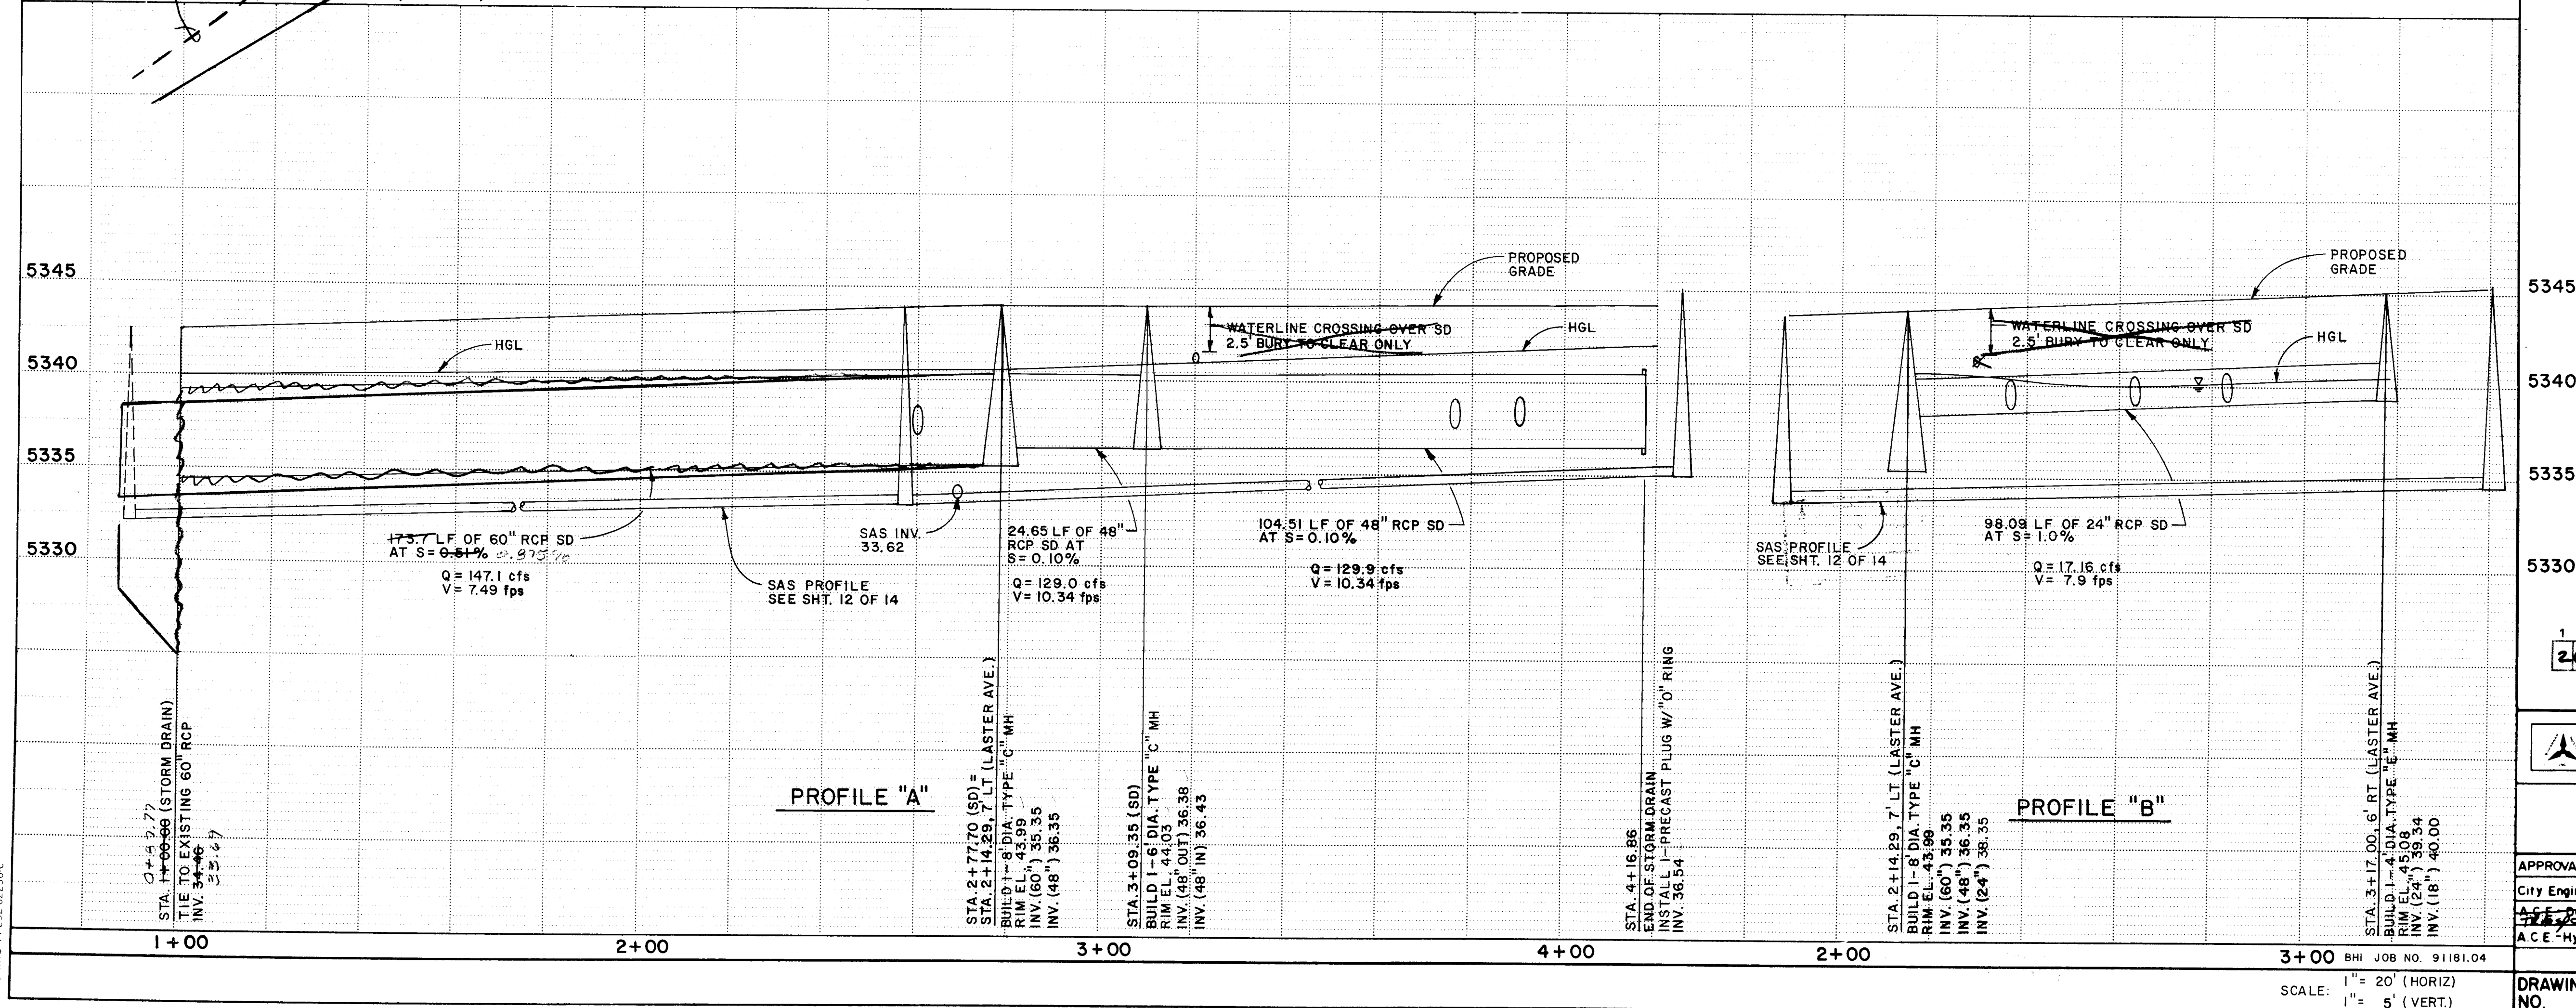

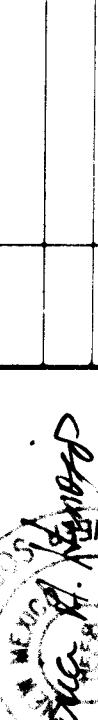ENGINEER'S SEAL				SURVEY INFORMATION				BENCH MARKS				AS BUILT INFORMATION			
				FIELD NOTES				THE BENCH MARK IS A STAMPED USGCS BRASS TABLET STAMPED "HEAVEN 1989". SET IN TOP OF A CONCRETE POST FLUSH WITH THE GROUND. LOCATED WEST ON PASEO DEL NORTE FROM NYOMING BLVD APPROXIMATELY 800 FEET. ELEVATION = 5378.787				CONTRACTOR <u>HYDRO-SYSTEMS</u> WORK DONE BY INSPECTORS <u>ALS</u> DATE <u>93</u> FIELD LOCATION BY <u>ALS</u> DATE <u>2/93</u> DRAWINGS CORRECTED BY <u>ALS</u> DATE <u>2/93</u> <u>MICRO-FILM</u> INFORMATION RECORDED BY _____ DATE _____			
				NO.	BY	DATE									
				NO.	DATE	REMARKS	BY								
								REVISIONS							
								DESIGN							
				DESIGNED BY MH				DATE 8/92							
				DRAWN BY MM				DATE 8/92							
				CHECKED BY MH				DATE 8/92							
															
AUERQUE PARTNERSHIP															
PHASE I & IA															
PROFILE															
4+16.86															
DOALS		ENGINEER				DATE									
Poste		<u>NA RWK</u>				<u>8-25-92</u>									
		<u>NA RWK</u>				<u>8-25-92</u>									
		<u>Callum K. Fay</u>				<u>8-10-92</u>									
SHEET		OF													
14		14													