


CITY OF ALBUQUERQUE, NEW MEXICO  
PUBLIC WORKS DEPARTMENT  
ENGINEERING GROUP

CONSTRUCTION PLANS  
FOR  
SOUTH VALLEY WATER AND SEWER  
SYSTEM IMPROVEMENT PROJECT  
SOUTHWESTERN SKIES ADDITION

SHEET INDEX

SHEET NO.	DESCRIPTION & STREET NAME
1	COVER & INDEX
2-3	OVERALL WATER & SEWER PLAN
4	WATER SHUT-OFF PLAN/SEQUENCE OF CONSTRUCTION
5-7	COORS BLVD. S.W.
8-10	SAGE ROAD S.W.
11	75TH STREET S.W.
12-13	AMALIA ROAD S.W.
14-15	BLANDFORD ROAD S.W.
16-17	EDUARDO ROAD S.W.
18	AIRPORT ROAD S.W.
19	COORS BYPASS-BLANDFORD COURT S.W.
20	WEST EASEMENT S.W.
21	MISCELLANEOUS DETAILS
<del>22</del>	<del>TEMPORARY FLUSHING STATION (NOT IN THIS SET)</del>
23-26	TRAFFIC CONTROL

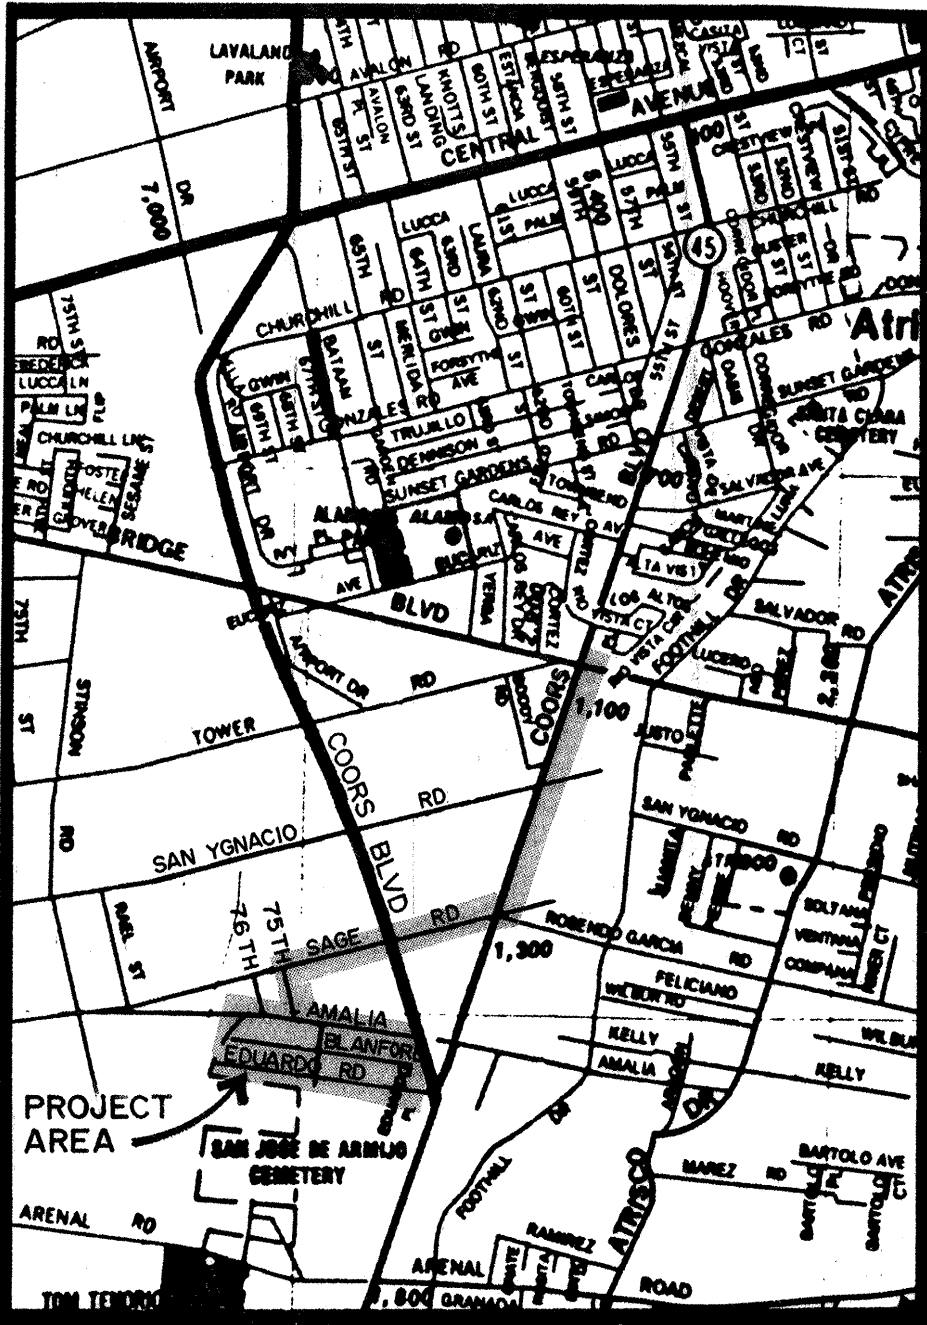

ZONE ATLAS MAP: L-10, L-11  
VICINITY MAP

GENERAL NOTES:

THE CONTRACTOR WILL BE RESPONSIBLE FOR COORDINATING THE EXECUTION OF THE WATER VALVE SHUT-OFF PLAN WITH THE WATER SYSTEMS DIVISION (857-8200) 3 WORKING DAYS IN ADVANCE OF ANY WORK THAT MAY AFFECT EXISTING PUBLIC WATER UTILITIES. SEE SHEET 4 OF 29 FOR WATER SHUT-OFF PLAN.

ALL WORK DETAILED ON THESE PLANS TO BE PERFORMED UNDER CONTRACT SHALL, EXCEPT AS OTHERWISE STATED OR PROVIDED FOR HEREON, BE CONSTRUCTED IN ACCORDANCE WITH THE C.O.A. STANDARD SPECIFICATIONS FOR PUBLIC WORKS CONSTRUCTION, 1986 EDITION (AS AMENDED WITH UPDATE #4) AND THE BERNALILLO COUNTY STANDARDS FOR PUBLIC WORKS CONSTRUCTION. WHERE CONFLICTS ARISE, THE MORE STRINGENT REQUIREMENT WILL BE ENFORCED.

TWO (2) WORKING DAYS PRIOR TO ANY EXCAVATION, CONTRACTOR MUST CONTACT LINE LOCATING SERVICE, 260-1990, FOR LOCATION OF EXISTING UTILITIES.

PRIOR TO CONSTRUCTION, THE CONTRACTOR SHALL EXCAVATE AND VERIFY THE HORIZONTAL AND VERTICAL LOCATIONS OF ALL OBSTRUCTIONS. THE LOCATIONS OF ALL GAS, ELECTRIC, CABLE TV, AND TELEPHONE WERE OBTAINED FROM THEIR RESPECTIVE ORGANIZATIONS. SHOULD A CONFLICT EXIST, THE CONTRACTOR SHALL NOTIFY THE ENGINEER OR SURVEYOR SO THAT THE CONFLICT CAN BE RESOLVED WITH MINIMUM AMOUNT OF DELAY. THE CONTRACTOR SHALL COORDINATE ALL UTILITY CROSSINGS WITH THEIR RESPECTIVE ORGANIZATIONS.


ALL COMPACTION FOR THIS PROJECT WILL BE 95% OF THE MAXIMUM DRY DENSITY PER ASTM D 1557.

THIS PROJECT IS SUBJECT TO THE TERMS AND CONDITIONS OF THE MASTER UTILITY EASEMENT AND RIGHT-OF-WAY AGREEMENT ENTERED INTO BETWEEN THE COUNTY OF BERNALILLO AND THE CITY OF ALBUQUERQUE, EFFECTIVE 08-20-90.

TRAFFIC CONTROL

THREE (3) WORKING DAYS PRIOR TO BEGINNING CONSTRUCTION, THE CONTRACTOR SHALL SUBMIT TO THE CONSTRUCTION COORDINATOR. A DETAILED CONSTRUCTION SCHEDULE. TWO (2) WORKING DAYS PRIOR TO CONSTRUCTION, THE CONTRACTOR SHALL OBTAIN A BARRICADING PERMIT FROM THE NEW MEXICO STATE HIGHWAY AND TRANSPORTATION DEPARTMENT (841-2700) & BERNALILLO COUNTY PUBLIC WORKS DEPARTMENT (843-6120).

ALL STREET STRIPING ALTERED OR DESTROYED SHALL BE REPLACED IN KIND BY CONTRACTOR TO LOCATION AND IN KIND AS EXISTING OR AS INDICATED BY THIS PLAN SET. THIS WORK SHALL BE INCIDENTAL TO THE TRAFFIC CONTROL. ALL RESTRIPING MUST MEET THE REQUIREMENTS OF THE SPECIFICATIONS AND MUST BE APPROVED BY THE CONSTRUCTION COORDINATOR.

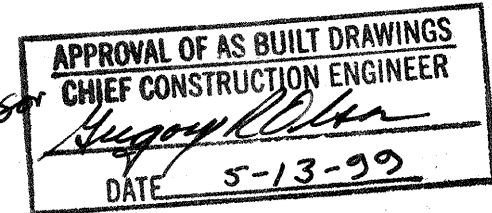

RECORD DRAWINGS

THE DRAWING HAVE BEEN REVISED TO REFLECT THE CONSTRUCTED FIELD CONDITIONS IN ACCORDANCE WITH INFORMATION PROVIDED BY CONTRACTOR AND CITY OF ALBUQUERQUE PUBLIC WORKS DEPARTMENT.





Gregory R. Olson, P.E.  
5/13/99

City of Albuquerque



APPROVED FOR CONSTRUCTION	
<i>Charles R. Bowman</i>	12/10/93
BERNALILLO COUNTY	DATE
<i>Richard B. Rye</i>	12/10/93
CITY OF ALBUQUERQUE	DATE

REVISION SHEETS	CITY ENGINEER	DATE	USER DEPARTMENT	DATE	USER DEPARTMENT	DATE
APPROVAL OF REVISIONS						
<b>WILSON &amp; COMPANY</b>						
PROJECT NO. 4515.94				SHEET 1 OF 26		

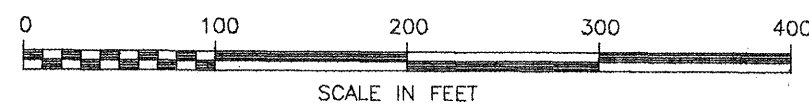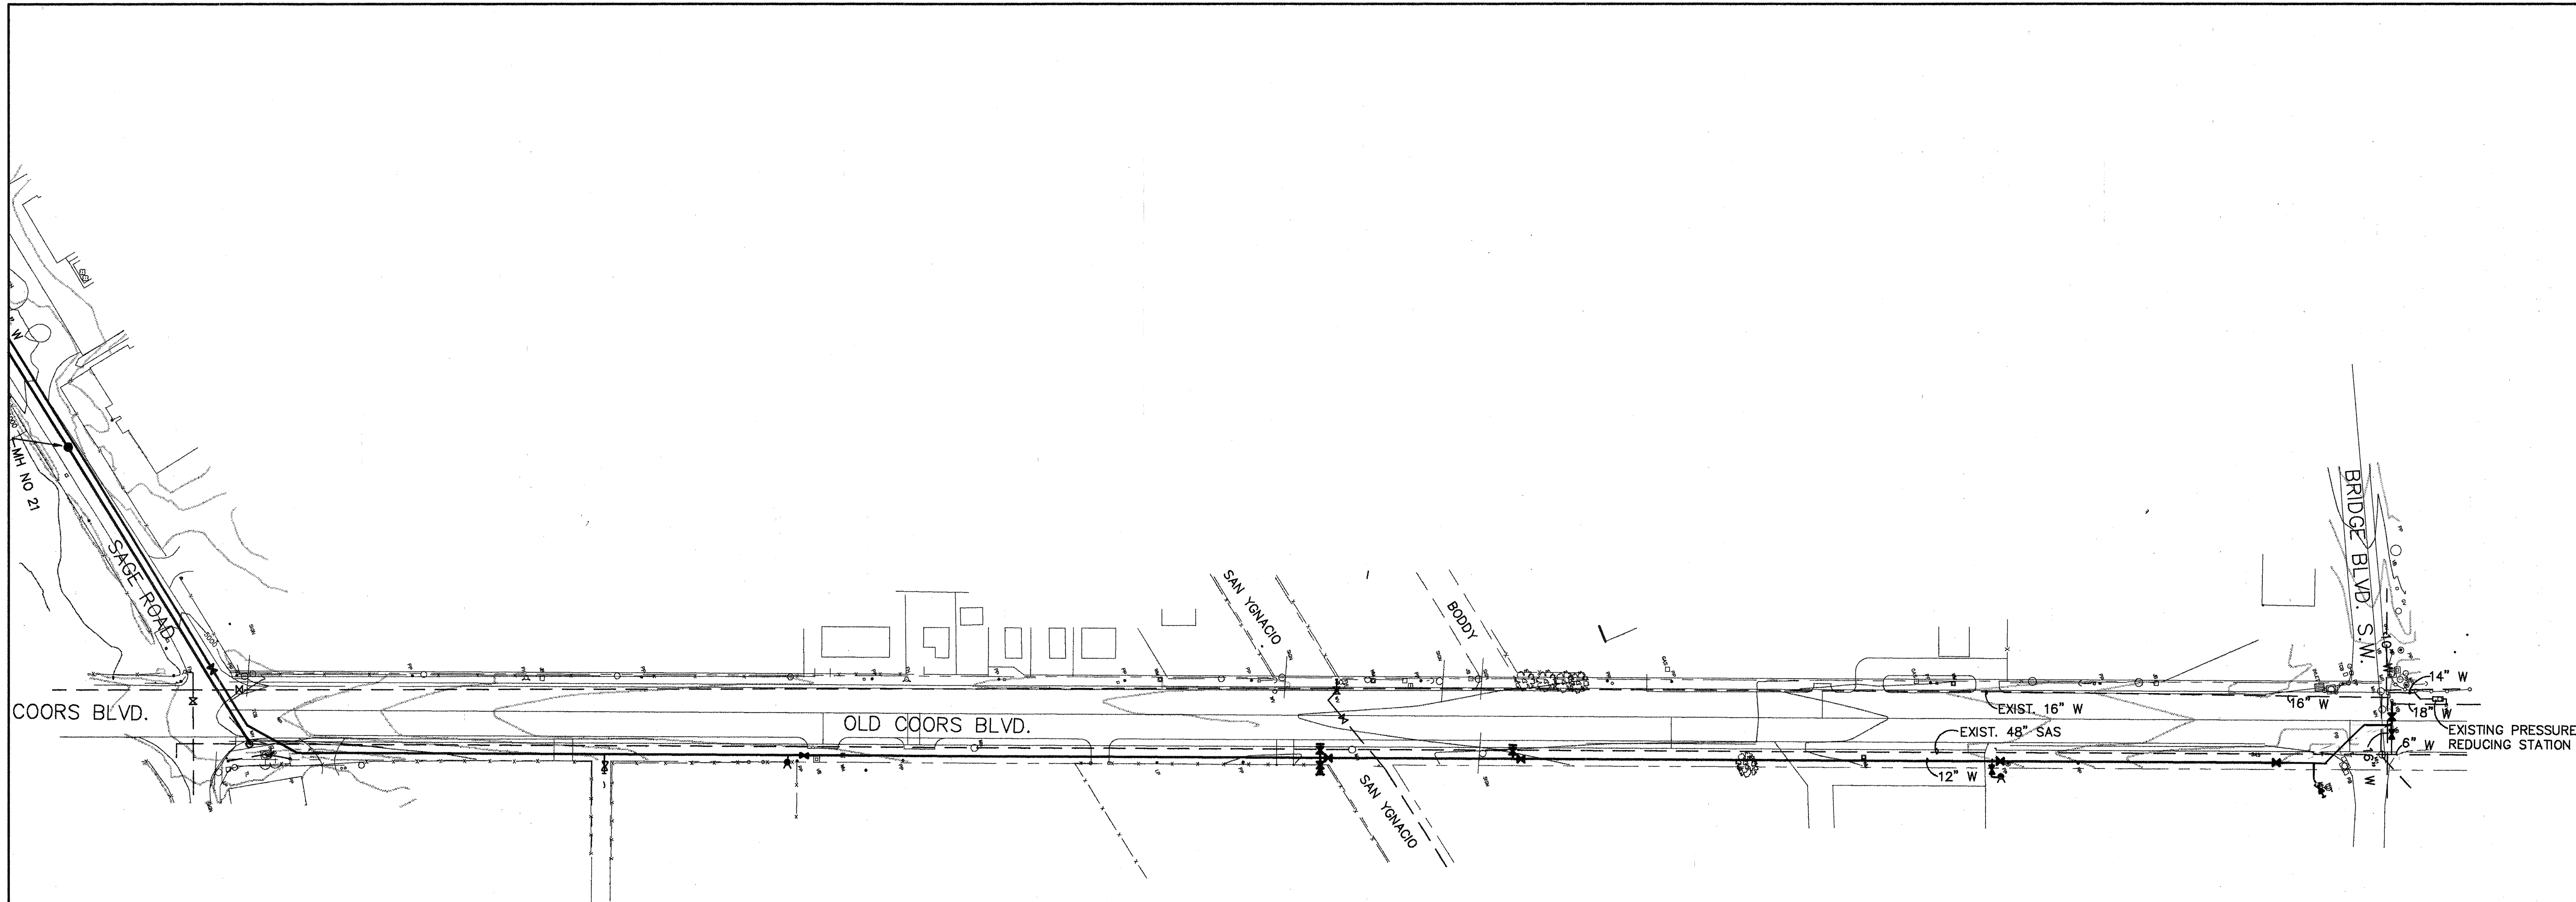


SOUTH VALLEY  
SEWER  
93-504  
NORTH AREA

AS BUILT MATERIALS

WATER MAINS 6"-12" = C-900 PVC  
SEWER MAINS 8"-12" = SDR-35 PVC  
SEWER SERVICES 4"-6" = CAST IRON  
WATER SERVICES 3/4" - 2" = P.E. TUBING

																																																																																																																																																																																																																																																																																																																																																																																																																																																																																																																																																																																																																																																																																																																																																																																																																																																																																																																																																																																																																																																																																																																																																																																																																																																																																																																																																																																																																															</
--	--	----



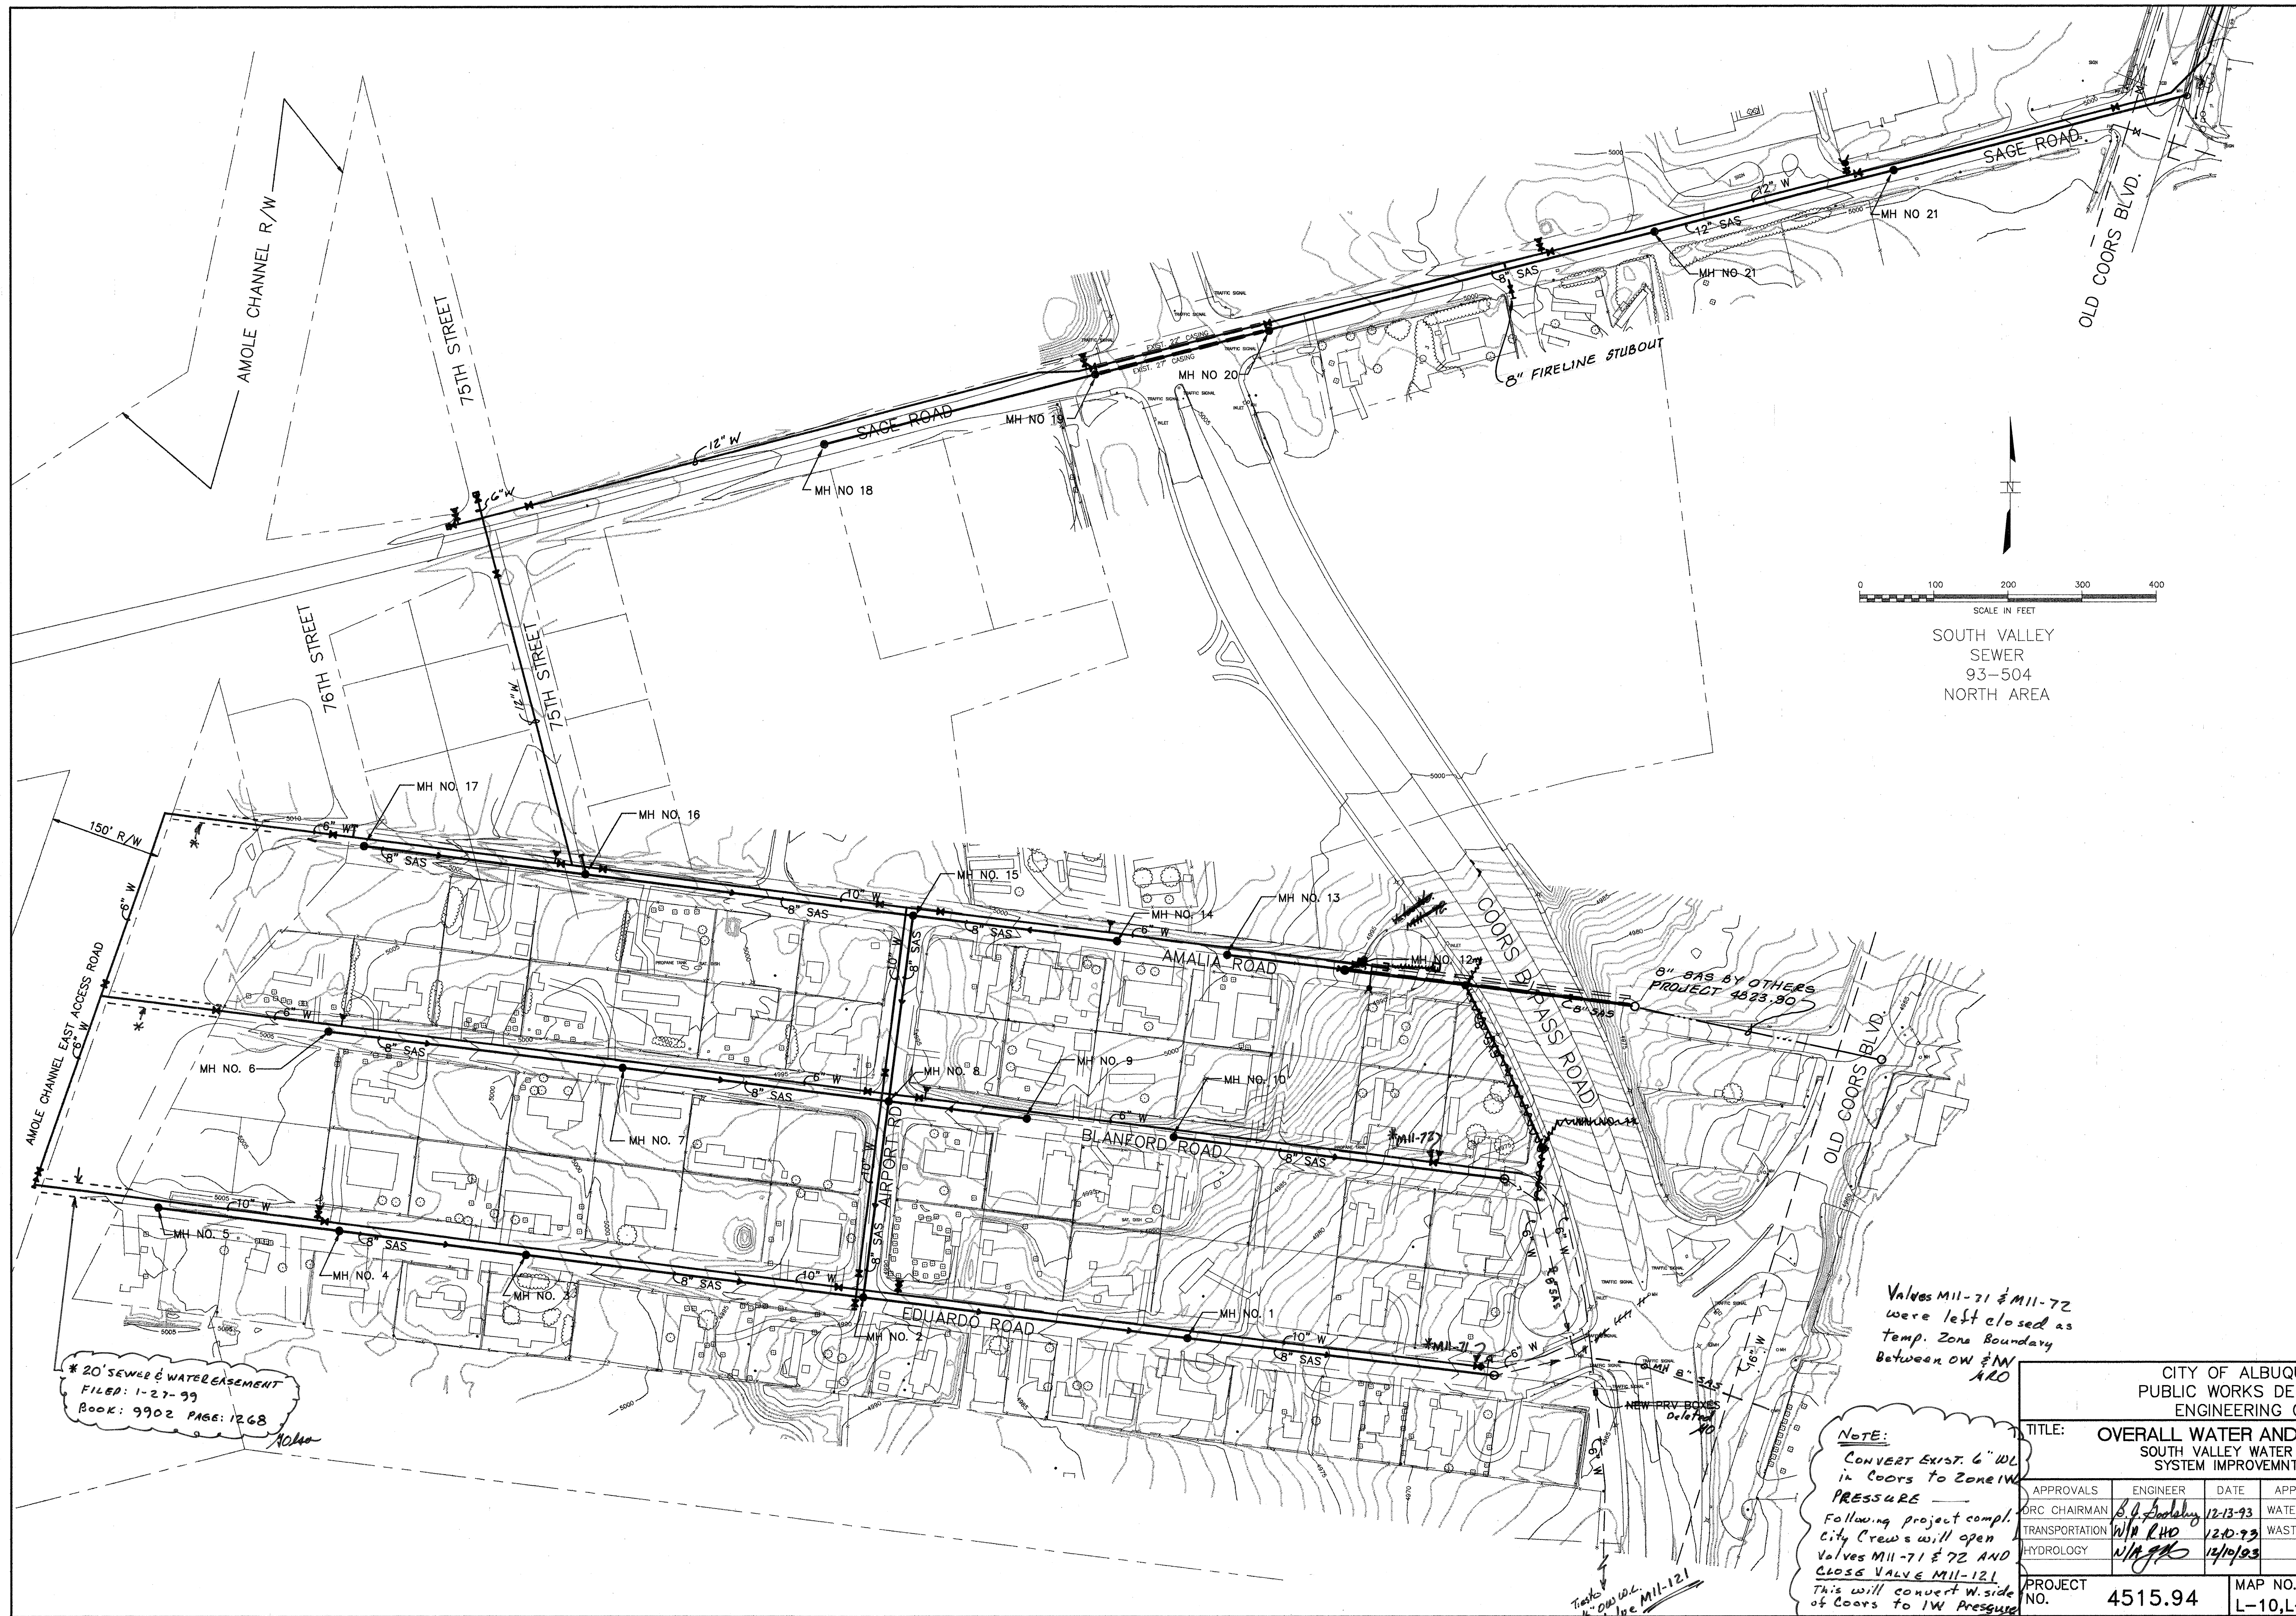

0 100 200 300 400  
SCALE IN FEET  
SOUTH VALLEY  
SEWER  
93-504  
NORTH AREA

\* 20' SEWER WATEREASEMENT  
FILED: 1-27-99  
BOOK: 9902 PAGE: 1268

NOTE:  
CONVERT EXIST. 6" WL  
in Coors to Zone I W  
PRESSURE  
Following project compl.  
City Crews will open  
Valves MII-71 & 72 AND  
CLOSE VALVE MII-121.  
This will convert W. side  
of Coors to 1W Pressure


Valves MII-71 & MII-72  
were left closed as  
Temp. Zone Boundary  
Between OW & 1W  
ARO

CITY OF ALBUQUERQUE PUBLIC WORKS DEPARTMENT ENGINEERING GROUP					
TITLE: OVERALL WATER AND SEWER PLAN SOUTH VALLEY WATER AND SEWER SYSTEM IMPROVEMNT PROJECT					
APPROVALS	ENGINEER	DATE	APPROVALS	ENGINEER	DATE
ORC CHAIRMAN	<i>B. J. [Signature]</i>	12-13-93	WATER	<i>M. [Signature]</i>	12/1/93
TRANSPORTATION	<i>W. R. [Signature]</i>	12-10-93	WASTE WATER		
HYDROLOGY	<i>N. [Signature]</i>	12/10/93			
PROJECT NO.	4515.94	MAP NO.	L-10, L-11	SHEET	3 OF 26


--	--	


- A. SHUT OFF VALVE NUMBERS 452, 453, AND 454. DRAIN EXISTING 6" WATER LINE. REMOVE AND SALVAGE EXISTING 6" VALVE.
- B. CUT EXISTING 6" WATER LINE AND INSTALL NEW 6" VALVE.
- C. INSTALL 12" GATE VALVE AND FITTINGS PER CONSTRUCTION PLAN SHEET 7. INSTALLATION OF 12" WATER LINE TO FOLLOW SEQUENCE OF CONSTRUCTION ON THIS SHEET
- D. EXTEND 12" WATER LINE PER SEQUENCE OF CONSTRUCTION AND TRAFFIC CONTROL PLANS.
- E. CONTRACTOR TO COMPLETE ALL TESTING REQUIREMENTS FOR ACCEPTANCE OF NEW 12" WATER LINE. UPON ACCEPTANCE OF WATER LINE, PRESSURIZE LINE TO ALLOW FOR OPENING OF INTERSECTION.
- F. CONTINUE WITH WATER LINE INSTALLATION, TESTING AND ACCEPTANCE PER SEQUENCE OF CONSTRUCTION AND COA SPECIFICATIONS.
- G. SHUT VALVES 121 AND 122 FOR INSTALLATION OF TEMPORARY PRV STATION.
- H. ALL WATER VALVE SHUT OFFS FOR PROJECT TO BE COORDINATED WITH WATER SYSTEMS AND COA PROJECT MANAGER.

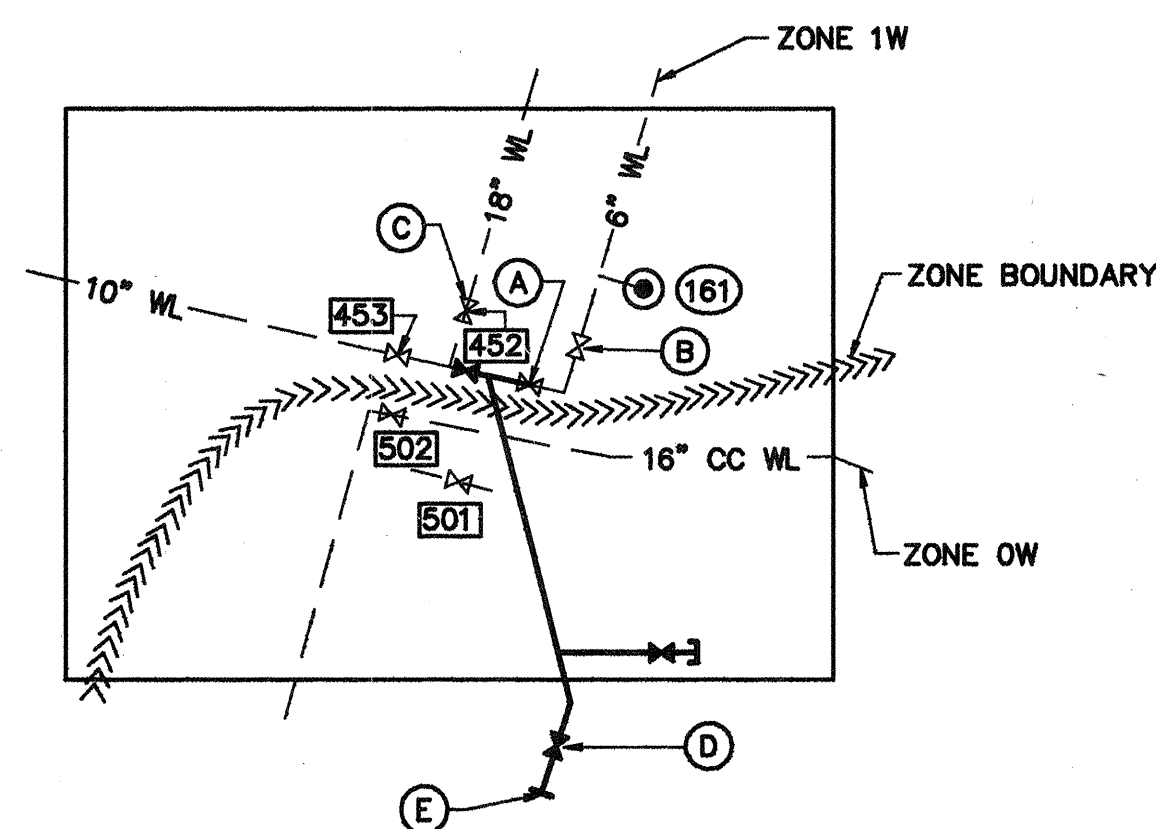

DETAIL "A"

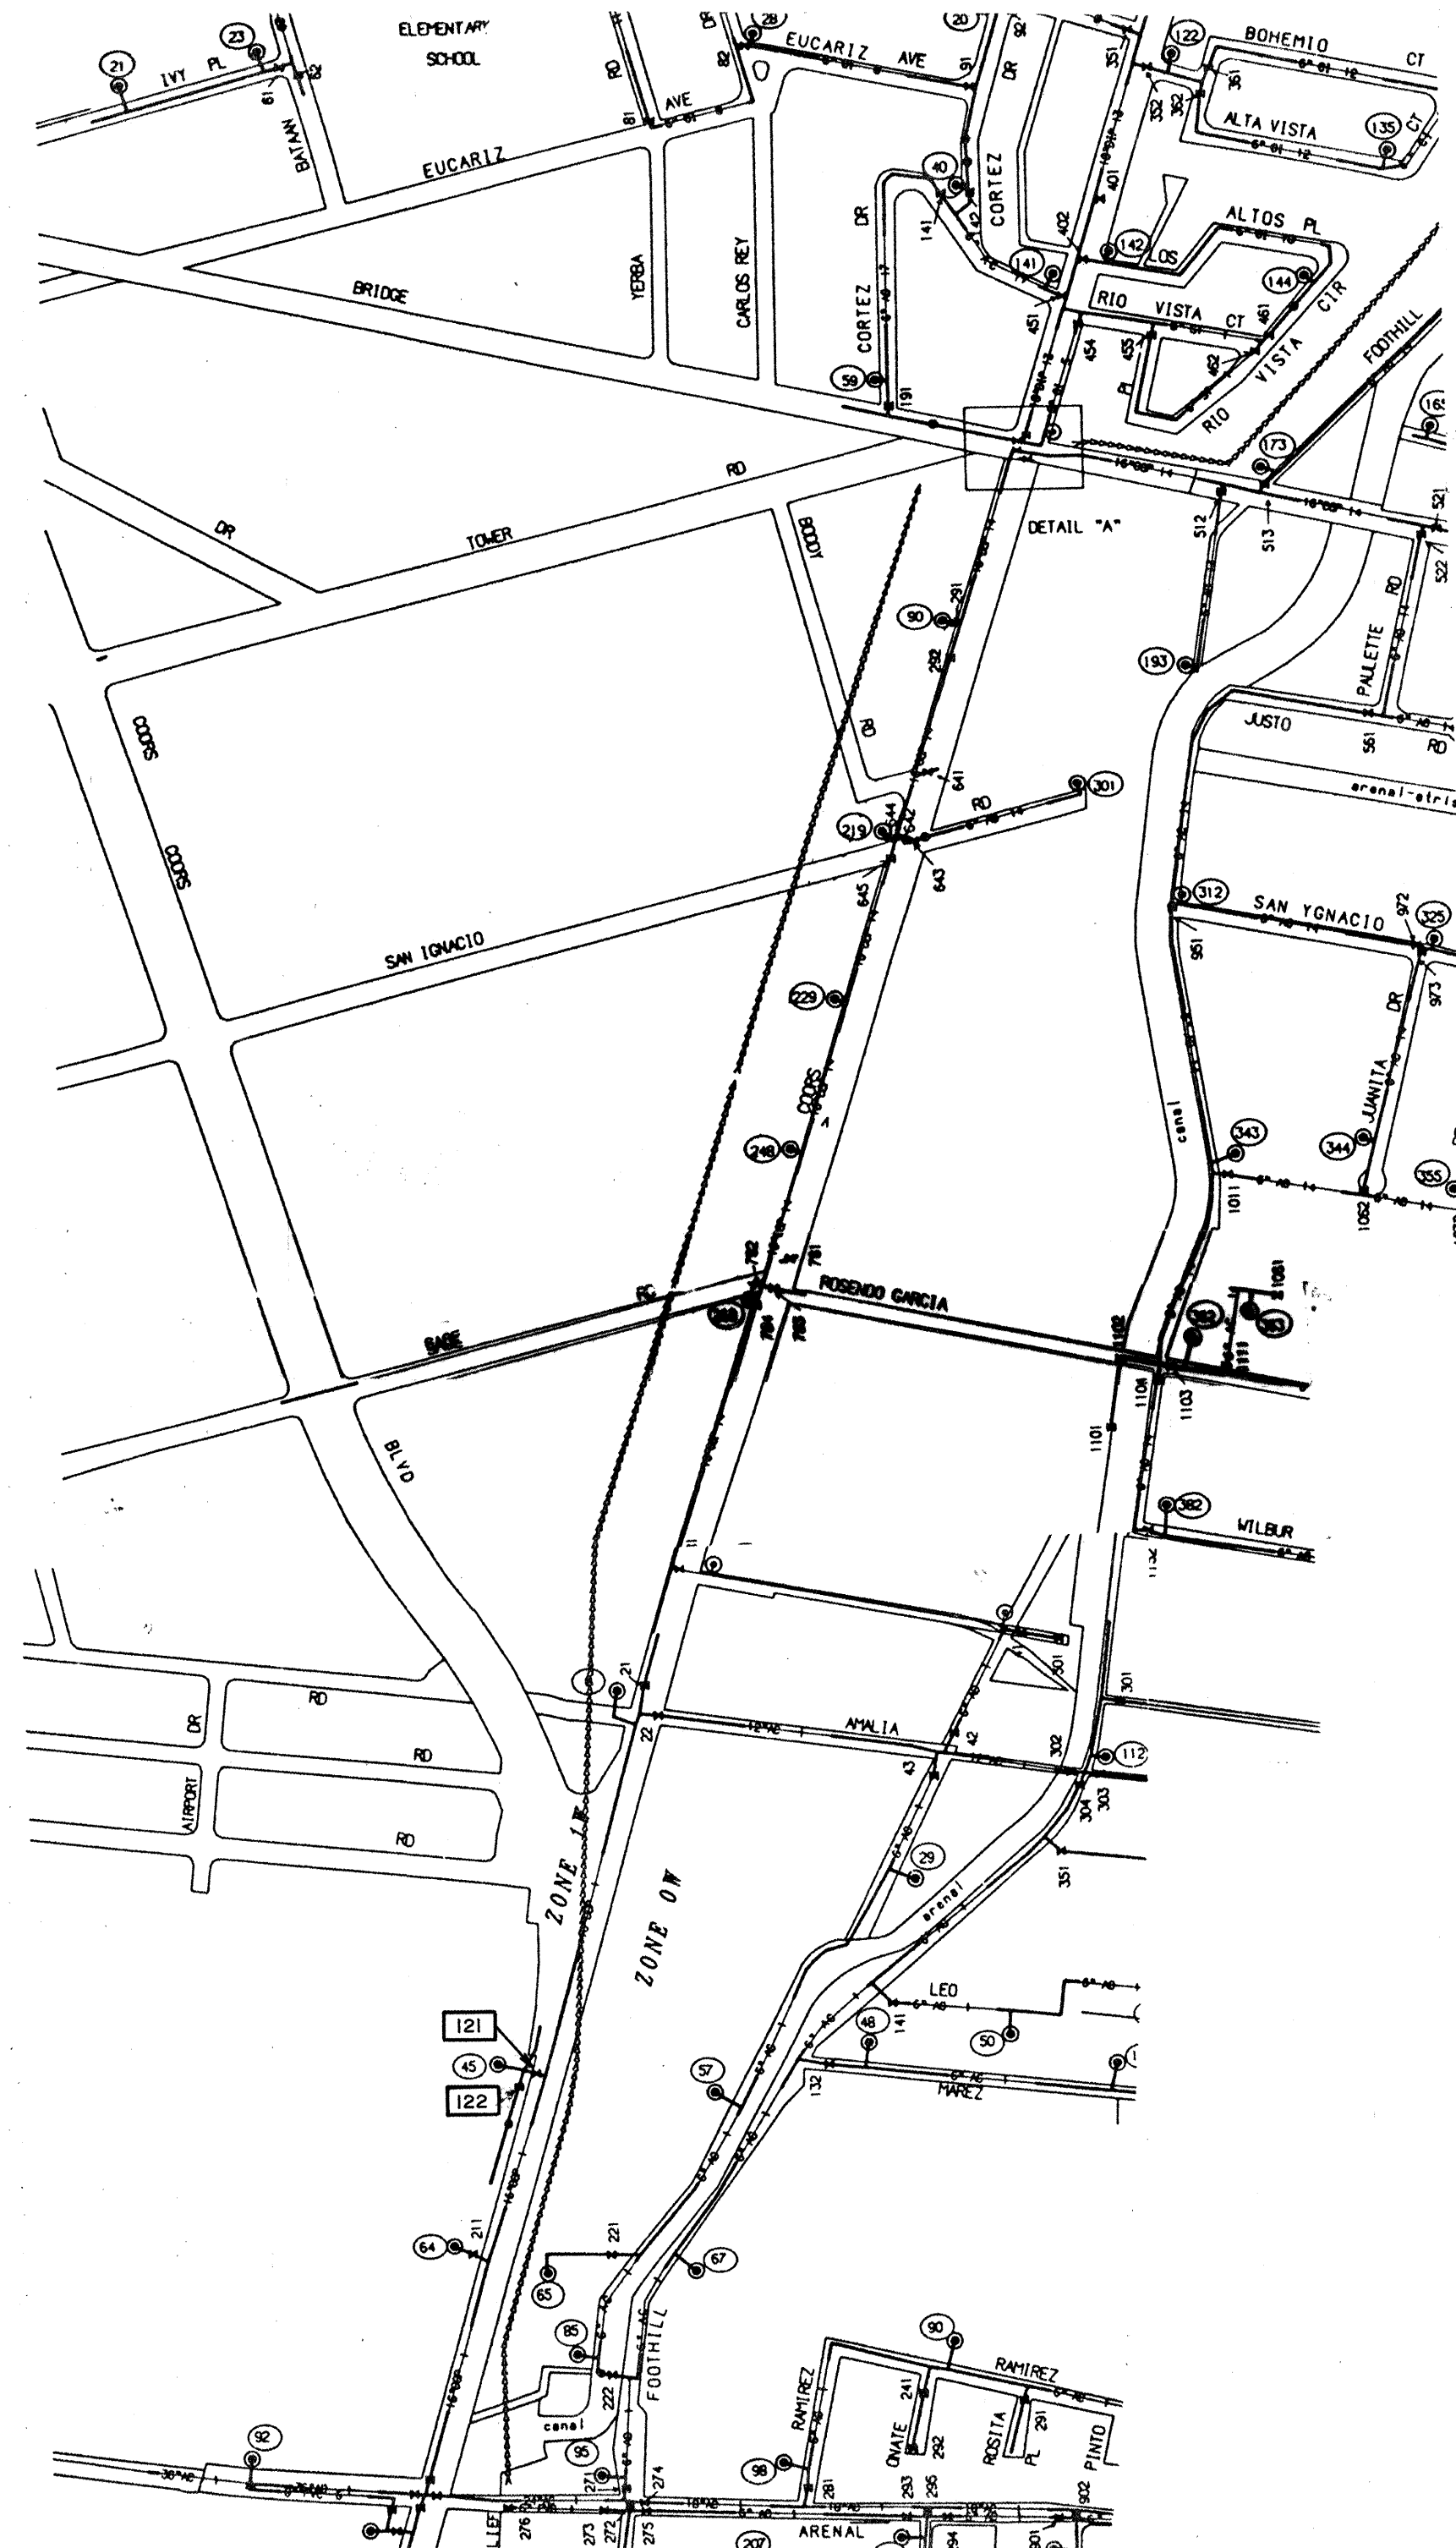

INTERSECTION BRIDGE AND OLD COORS  
CONSTRUCTION PHASE I  
 BUILD PORTION OF WATERLINE FROM MEDIAN TO OUTSIDE LANE  
 SOUTHBOUND OLD COORS

TRAFFIC PHASE I

CLOSE CONTINUOUS LEFT TURN LANE & SOUTHBOUND LANES,  
PLACE TWO-WAY TRAFFIC ON NORTHBOUND LANES USING TRAFFIC  
SPLIT. SEE SHEET 24 AND 27 OF THE PLANS.

## CONSTRUCTION PHASE II

BUILD WATERLINE SOUTHEASTERLY FROM MEDIAN ACROSS THE NORTHBOUND LANES TO THE EAST SIDE OF SANITARY SEWER.

TRAFFIC PHASE II

CLOSE CONTINUOUS LEFT TURN LANE AND NORTHBOUND LANES.  
PLACE TWO-WAY TRAFFIC ON SOUTHBOUND LANES USING  
TRAFFIC SPLIT.

### CONSTRUCTION PHASE III

BUILD WATERLINE FROM STA. 10+82 TO STA. 34+25. 45.5' RT.  
TO 48' RT. CENTERLINE OLD COORS.

TRAFFIC PHASE II

TRAFFIC NORMAL ON OLD COORS USE TYPICAL SHOULDER WORK  
OPERATION. SEE SHEET 28 OF THE PLANS.

#### PHASE IV CONSTRUCTION

**BUILD SANITARY SEWER & WATERLINE CROSSINGS AT INTERSECTION OF OLD COORS ROAD & SAGE ROAD. BUILD WATERMAIN & SANITARY SEWER FROM OLD COORS TO NEW COORS ROAD.**

## TRAFFIC PHASE IV

CLOSE OLD COORS ROAD SOUTH FROM BRIDGE AND AT  
INTERSECTION OLD COORS AND NEW COORS TO THRU TRAFFIC.

DETOURS (SEE SHEET 29 OF THE PLANS)

AT BRIDGE AND OLD COORS FOR SOUTHBOUND OLD COORS TRAFFIC  
WEST ON BRIDGE TO NEW COORS, SOUTH ON NEW COORS.

AT OLD COORS AND NEW COORS FOR NORTHBOUND TRAFFIC CLOSE  
OLD COORS NORTHBOUND TO THRU TRAFFIC DETOUR NORTH ON  
NEW COORS TO BRIDGE, EAST ON BRIDGE TO OLD COORS.

NOTE:

PLACE BARRICADES AT SAGE AND NEW COORS. CLOSE SAGE TO THRU TRAFFIC. BUILD SEWER AND WATERLINE TO MANHOLE AT NEW COORS.

## PHASE V CONSTRUCTION

SLIPLINE WATER & SEWER ACROSS NEW COORS ON SAGE. COMPLETE  
SEWER LINE AND WATERLINE CONSTRUCTION ON EAST SAGE AND  
WEST SAGE. CROSSOVER WATERLINE AT 75TH STREET AND BUILD  
WATERLINE ON 75TH STREET TO AMALIA ROAD.

TRAFFIC PHASE V (FOR DETOUR SEE SHEET 30 OF THE PLANS)


- A. CLOSE SAGE ROAD EAST AND WEST OF NEW COORS AND WEST OF OLD COORS TO THRU TRAFFIC. COMPLETE WORK ON EAST SAGE AND OPEN TO TRAFFIC. COMPLETE SEWER LINE TO MANHOLE ON WEST SAGE AND OPEN TO TRAFFIC.
- B. BUILD WATERLINE NORTH OF EDGE OF PAVEMENT ON EAST SAGE TO 75TH STREET USING SHOULDER WORK OPERATIONS.
- C. CROSS WATERLINE TO 75TH STREET USING ONE-LANE CLOSURE OPERATIONS.
- D. USING SHOULDER WORK OPERATIONS ON 75TH STREET, MAINTAIN TWO-WAY TRAFFIC. IF NECESSARY DO A TEMPORARY GRAVEL WIDENING.

## PHASE VI CONSTRUCTION

- PHASE IV CONSTRUCTION
- A. BUILD SEWER AND WATERLINE AMALIA ROAD.
  - B. BUILD SEWER AND WATERLINE BLANFORD ROAD.
  - C. BUILD SEWER AND WATERLINE EDUARDO ROAD.
  - D. BUILD SEWER AND WATERLINE AIRPORT ROAD.
  - E. SEWER CONNECTIONS EAST EDGE OF COORS BETWEEN AMALIA ROAD AND BLANFORD ROAD.

PHASE VI TRAFFIC

- A. CLOSE 75TH STREET AND 76TH STREET TO THRU TRAFFIC.  
AMALIA ROAD NOT A THRU STREET USE CONSTRUCTION SIGNING  
AND BARRICADES AS NEEDED. (SEE TYPICALS) CONTRACTOR  
TO MAINTAIN ACCESS TO RESIDENTS.
- B. C, AND D, NOT THRU STREETS, USE CONSTRUCTION SIGNING  
AND BARRICADES AS NEEDED (SEE TYPICALS) CONTRACTOR TO  
MAINTAIN ACCESS TO RESIDENTS.
- E. USE SHOULDER WORK OPERATIONS SOUTHBOUND LANES NEW  
COORS ROAD WITH LANE CLOSURE AS NEEDED.  
SEE TYPICALS SHEET 24 & 25 OF THE PLANS.

					ENGINEER'S SEAL	SURVEY INFORMATION		BENCH MARKS		AS BUILT INFORMATION		
						FIELD NOTES						
						NO.	BY	DATE				
									BENCHMARK USED IS A 3 1/4" ALUMINUM TABLET SET IN CONCRETE 0.5' ABOVE THE GROUND. STATION IS STAMPED "ACS, MM45-4A, 1985".		WORK CONTRACTOR <i>L.R. HALE</i> DATE <i>11/94</i>	
									LOCATED IN THE INTERSECTION OF COORS BLVD. AND BRIDGE BLVD.		DRAWN BY'S <i>L.R. HALE</i> DATE	
									ELEVY=5003.02		FIELD LOCATION BY <i>COA</i> DATE	
											CORRECTED BY <i>WILSON CO.</i> DATE <i>11/94</i>	
		REMARKS	BY							<b>MICRO-FILM INFORMATION</b>		
		REVIEWS								RECORDED BY		
		DESIGN								NO.		
DESIGNED BY	JMS	DATE	NOV. 1993									
DRAWN BY	PAS	DATE	NOV. 1993									
CHECKED BY	WFZ	DATE	NOV. 1993									

CITY OF ALBUQUERQUE  
PUBLIC WORKS DEPARTMENT  
ENGINEERING GROUP


TITLE:  
WATER SHUT-OFF PLAN/SEQUENCE OF CONSTRUCTION  
SOUTH VALLEY WATER AND SEWER  
SYSTEM IMPROVEMENT PROJECT

SYSTEM IMPLEMENTATION PROGRESS						
APPROVALS	ENGINEER	DATE	APPROVALS	ENGINEER	DATE	
DRC CHAIRMAN	<i>S. P. Arachchi</i>	12-13-93	WATER	<i>MR Khan</i>	12/16/93	
TRANSPORTATION	<i>N/A RHO</i>	12-10-93	WASTE WATER			
HYDROLOGY	<i>N/A RHO</i>	12/10/93				

PROJECT NO.	4515.94	MAP NO.	1-10 1-11	SHEET	4	OF	26
-------------	---------	---------	-----------	-------	---	----	----




FOR CONTINUATION SEE SHEET 13

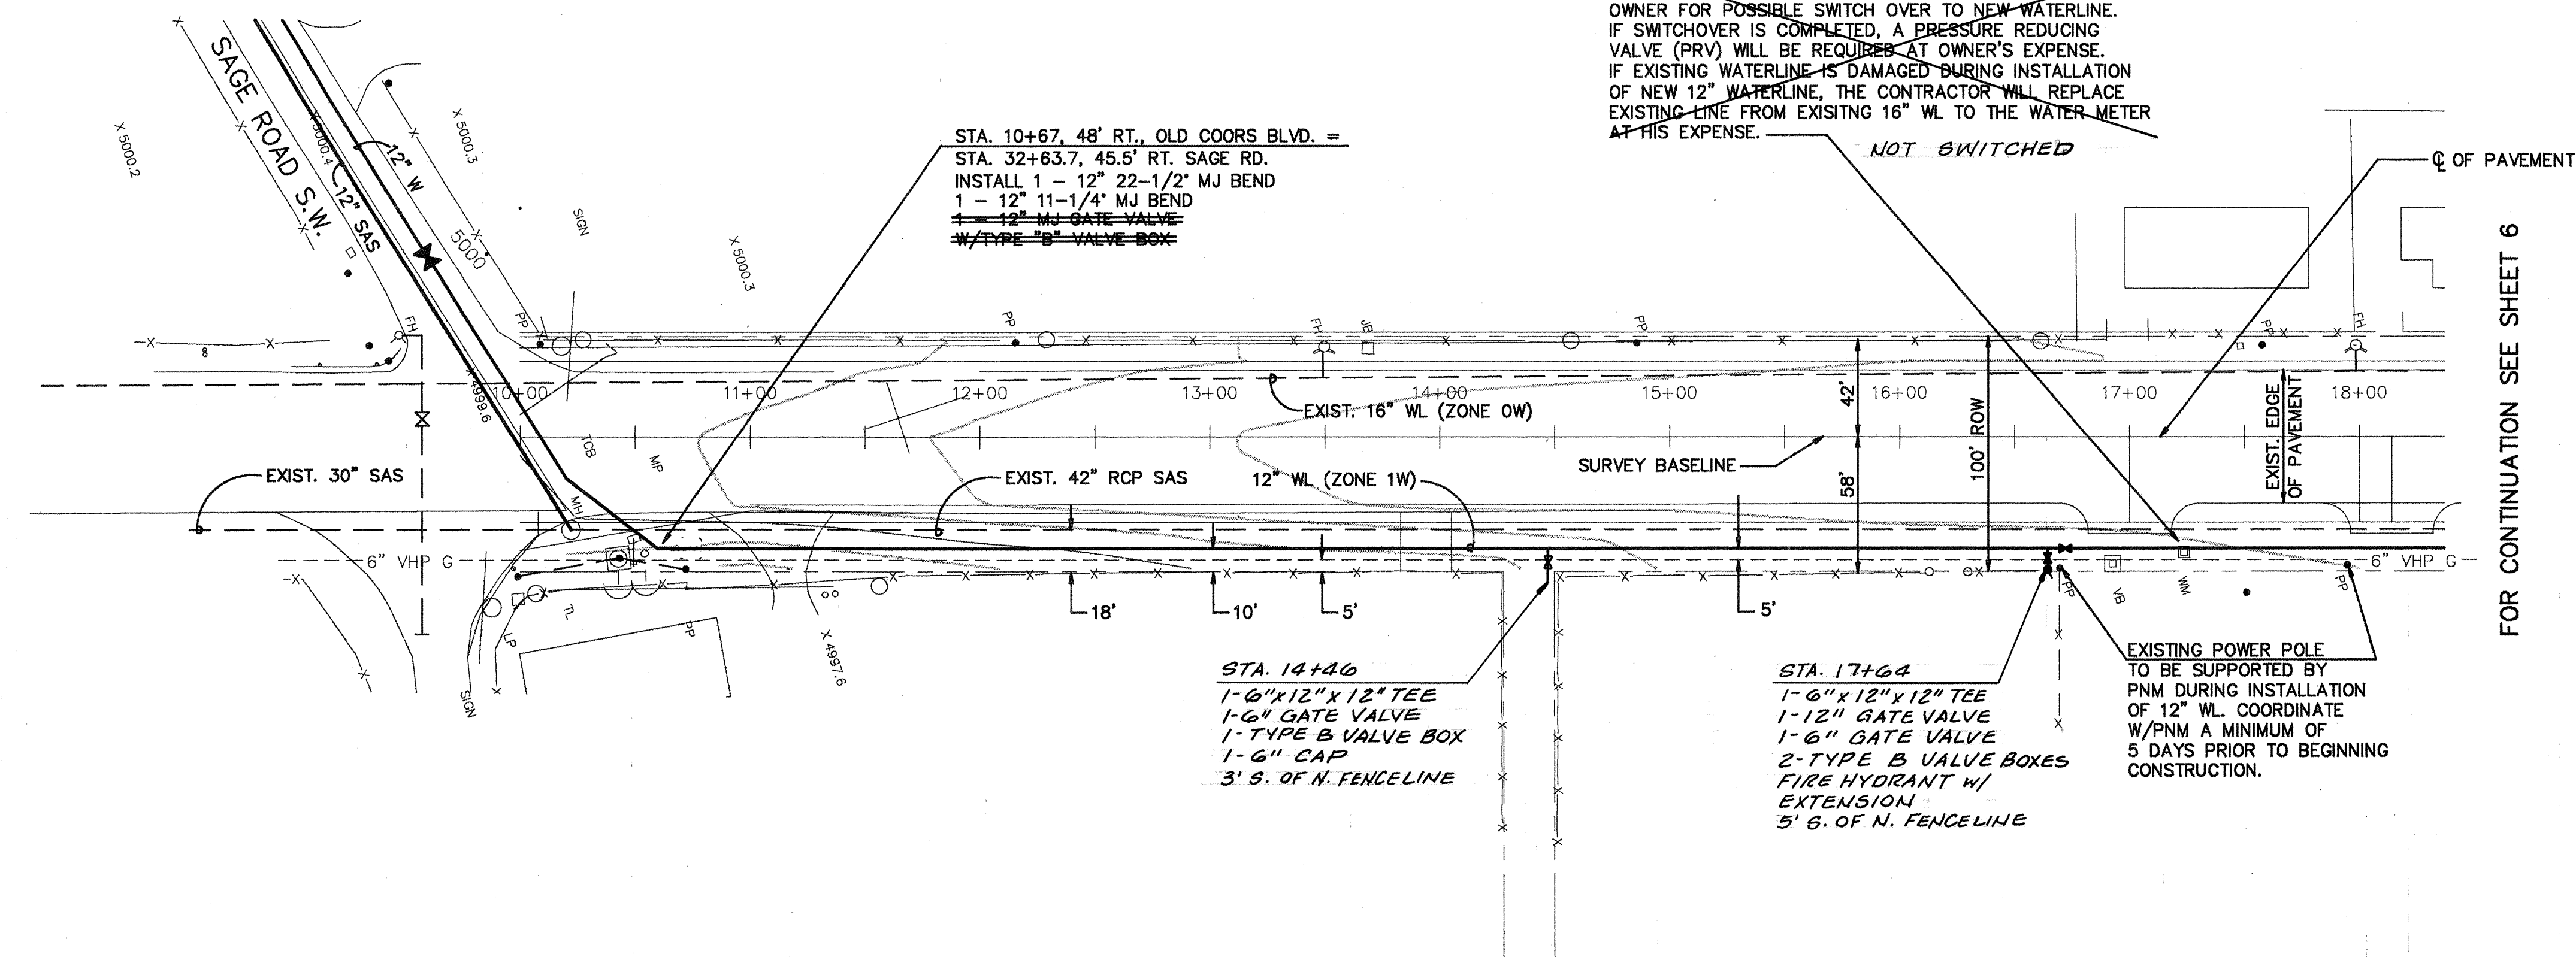


OLD COORS BOULEVARD, S.W.

NOTE:  
CONTRACTOR TO COORDINATE  
W/ BUSINESSES ALONG COORS  
TO ALLOW ACCESS AT ALL  
TIMES DURING CONSTRUCTION.

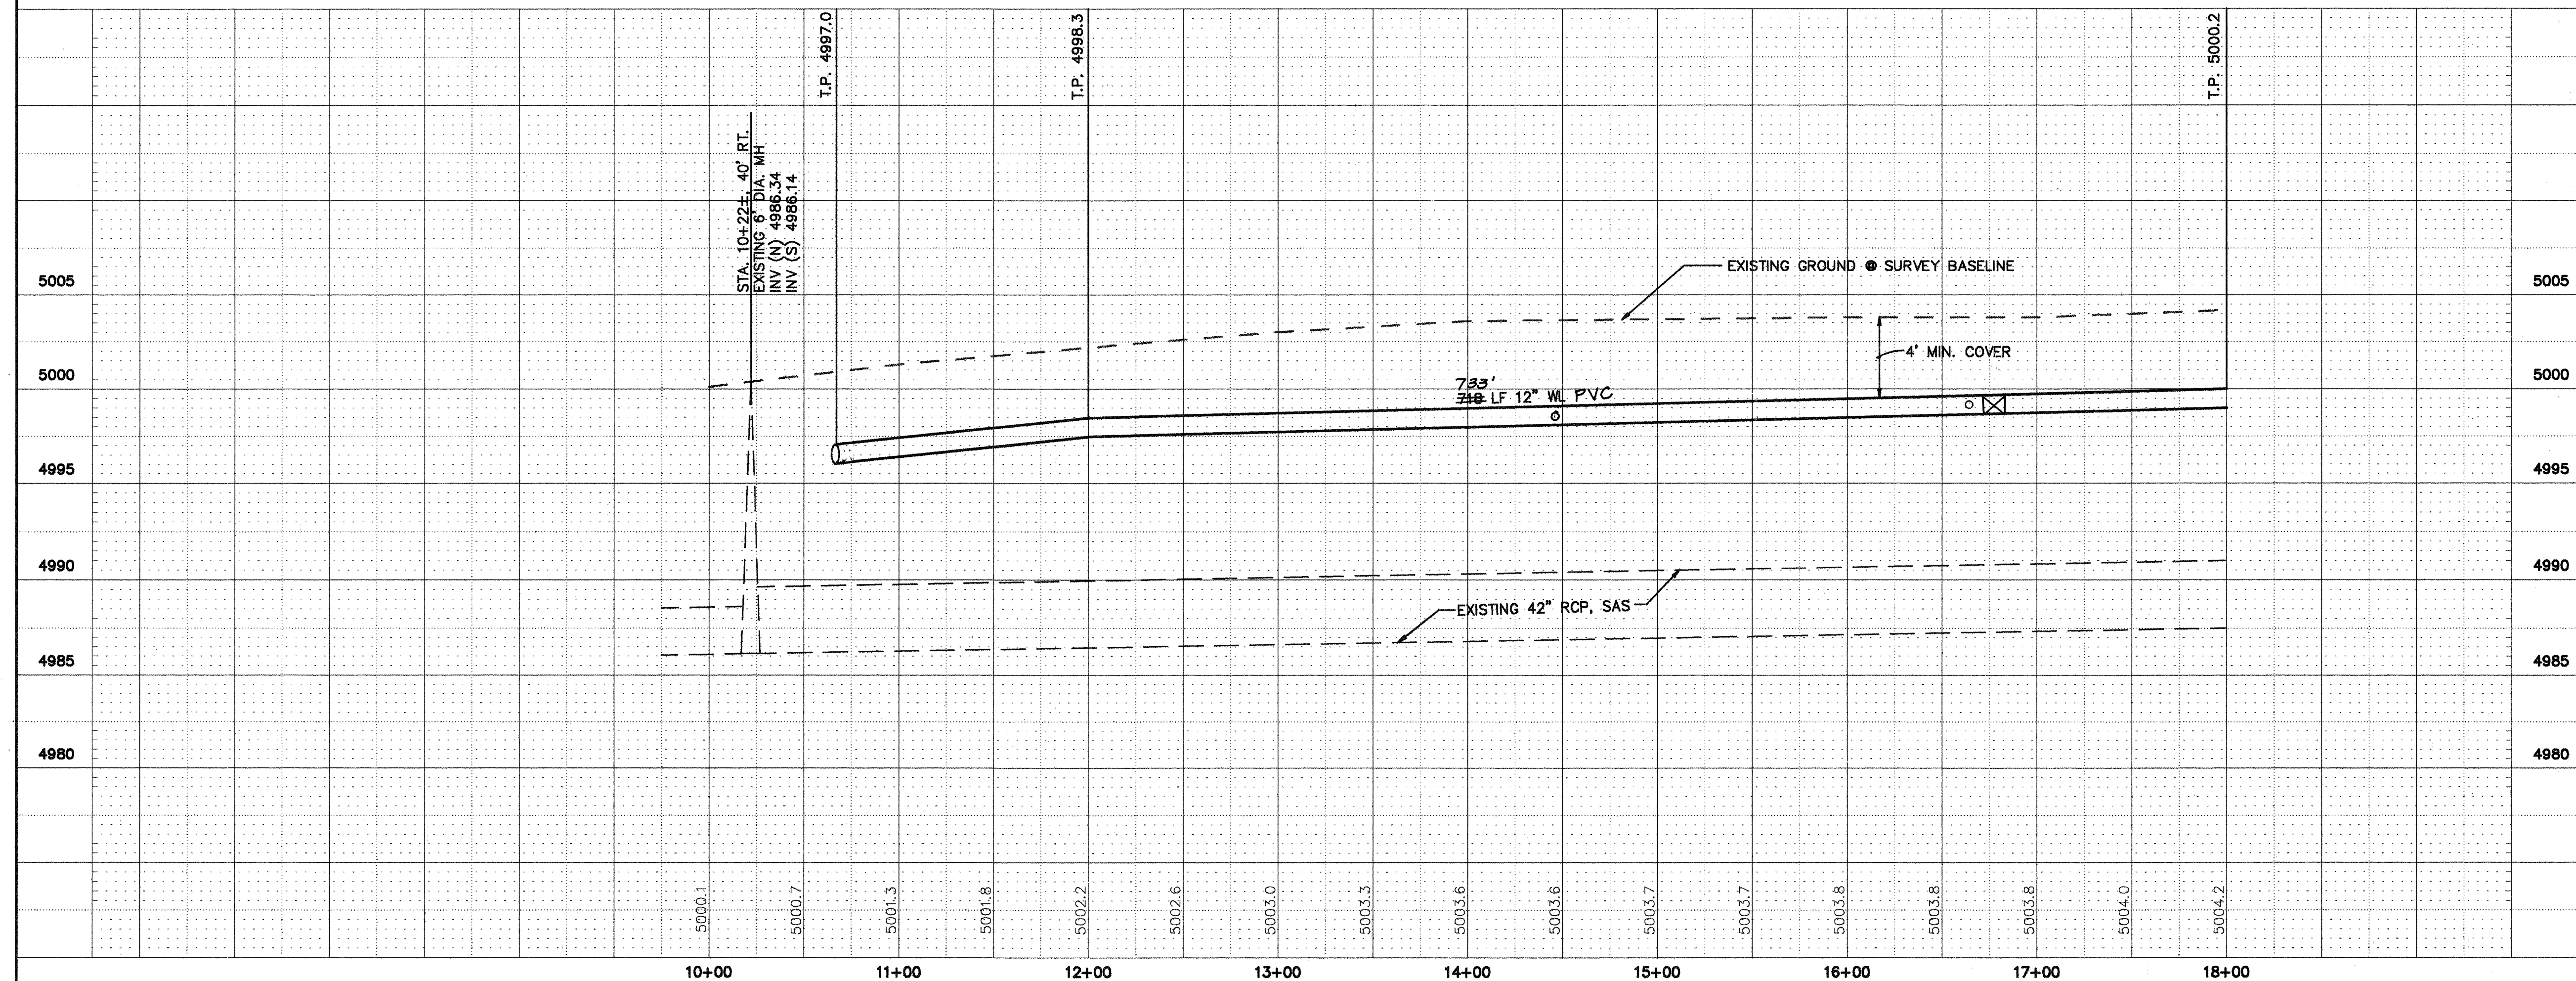

PLAN  
SCALE: 1"=50'  
PROFILE  
SCALE: 1"=5' HORIZ.  
1"=5' VERT.

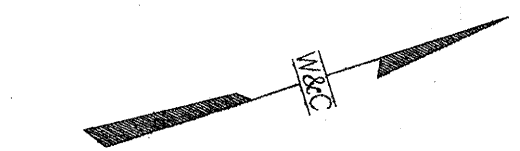

LEGEND

- NEW EXIST.
- SAS SANITARY SEWER
  - W WATER LINE
  - MH SANITARY SEWER MANHOLE
  - WV WATER VALVE
  - WM WATER METER
  - FH FIRE HYDRANT
  - TREE/SHRUB
  - G GAS LINE
  - SD STORM DRAIN
  - UT UNDERGROUND TELEPHONE LINE
  - UE UNDERGROUND ELECTRICAL LINE
  - UC UNDERGROUND CABLE TV LINE

AS BUILT INFORMATION		BENCH MARKS		SURVEY INFORMATION		ENGINEER'S SEAL	
CONTRACTOR	J.R. HALE	DATE	11/1/94	FIELD NOTES	NO.	NO.	DATE
INSPECTOR	J.R. HALE	DATE		BY		BY	
FIELD	J.R. HALE	DATE					
VERIFICATION	J.R. HALE	DATE					
CORRECTION	J.R. HALE	DATE					
RECORDED BY	J.R. HALE	DATE					
NO.							

REMARKS		DESIGN		NO. DATE	
REVISIONS		DESIGN		NO. DATE	
DESIGNED BY		PAS		NOV. 1993	
DRAWN BY		WJZ		NOV. 1993	
CHECKED BY					

CITY OF ALBUQUERQUE  
PUBLIC WORKS DEPARTMENT  
ENGINEERING GROUP

TITLE:  
OLD COORS BOULEVARD  
SOUTH VALLEY WATER AND SEWER  
SYSTEM IMPROVEMENT PROJECT

APPROVALS	ENGINEER	DATE	APPROVALS	ENGINEER	DATE
DRC CHAIRMAN	J.R. HALE	12-13-93	WATER	J.R. HALE	12/13/93
TRANSPORTATION	J.R. HALE	12-13-93	WASTE WATER	J.R. HALE	12/13/93
HYDROLOGY	J.R. HALE	12-13-93			


PROJECT NO.	4515.94	MAP NO.	L-10,L-11	SHEET	5	OF	26
-------------	---------	---------	-----------	-------	---	----	----

WILSON  
& COMPANY

WCEA #93-504




FOR CONTINUATION SEE SHEET 5

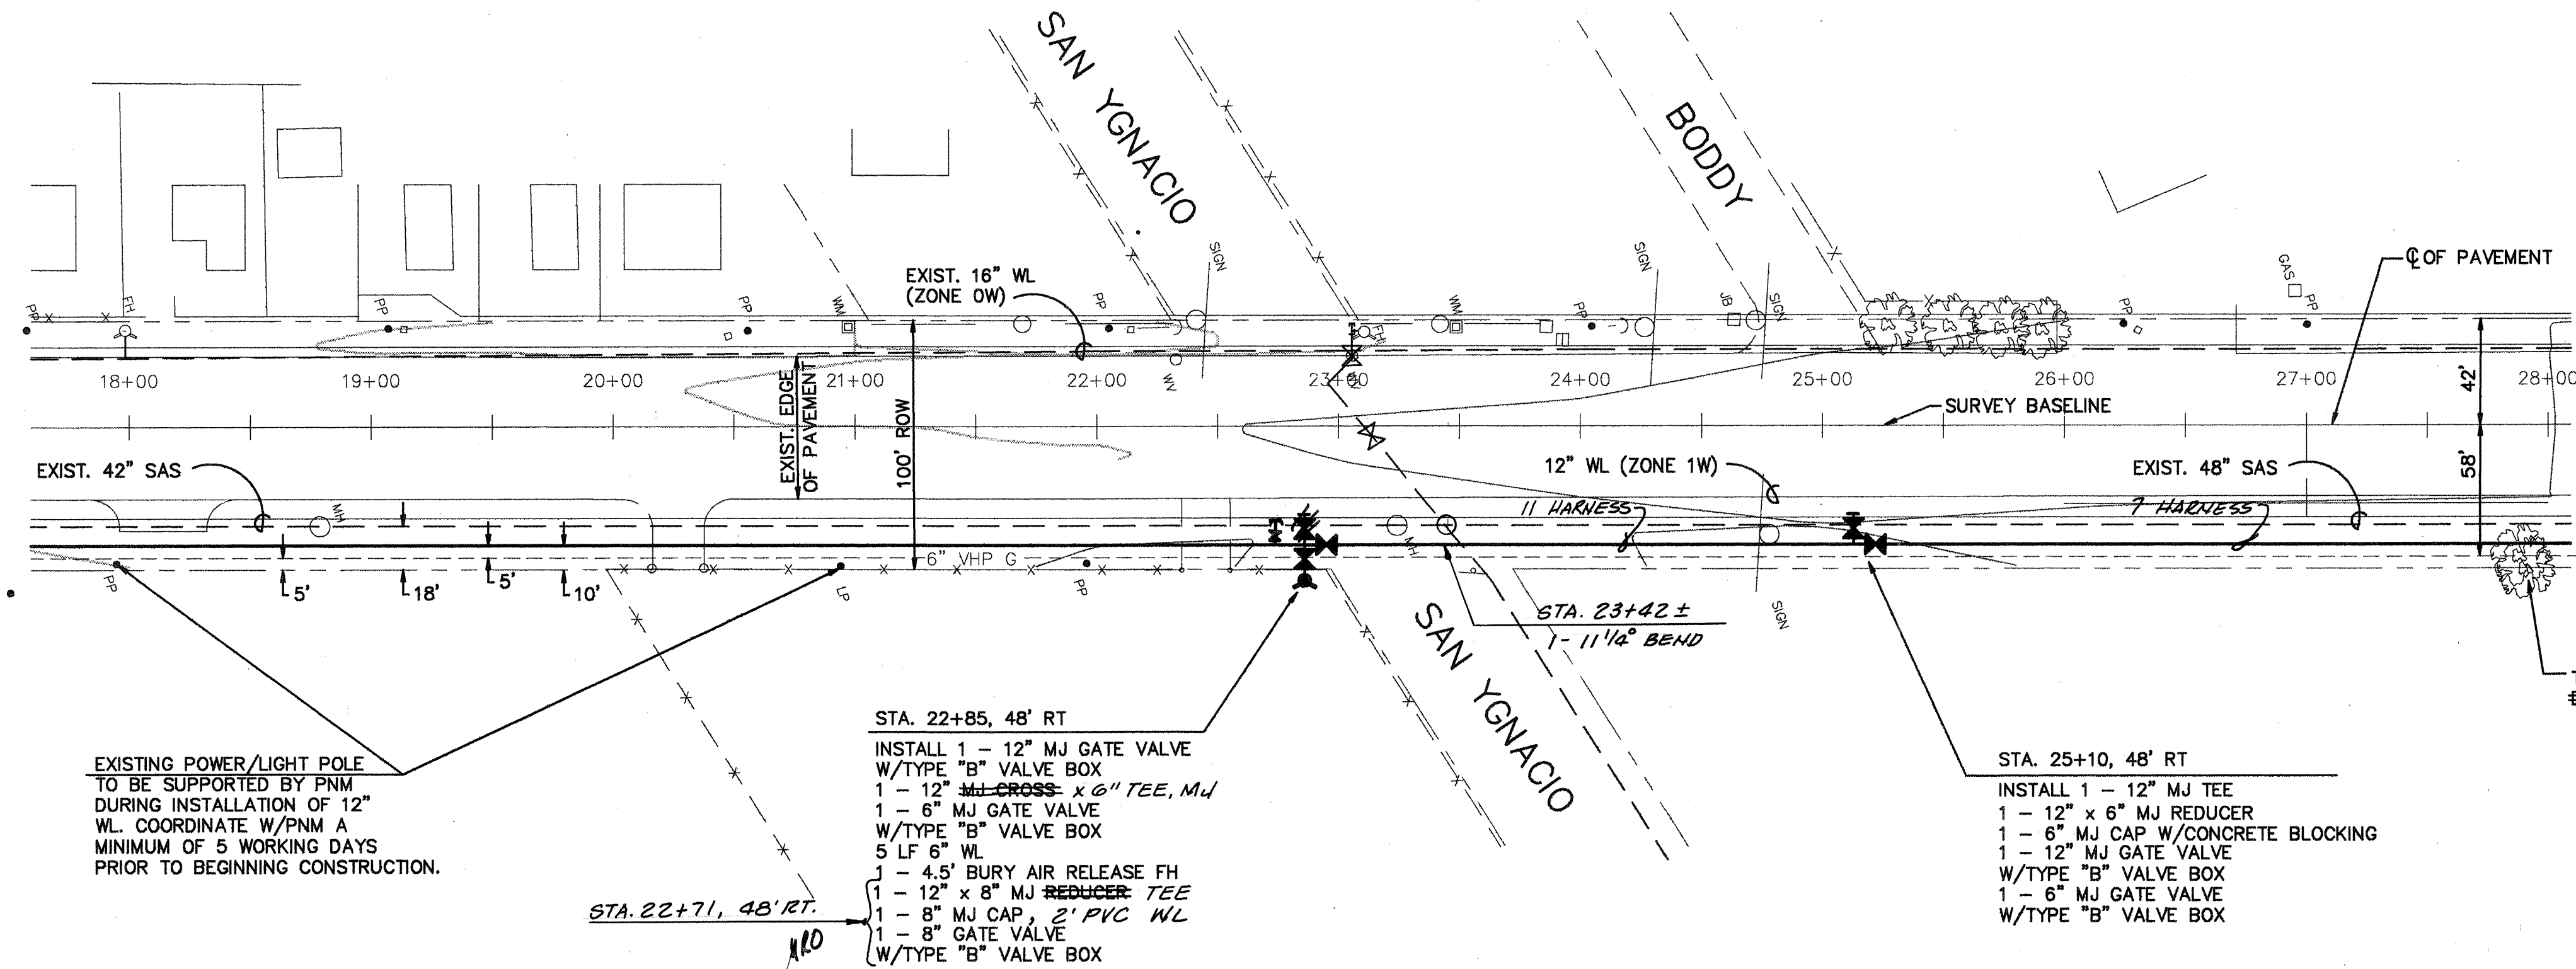

FOR CONTINUATION SEE SHEET 7


PLAN  
SCALE: 1"=50'  
PROFILE  
SCALE: 1"=5' HORIZ.  
1"=5' VERT.

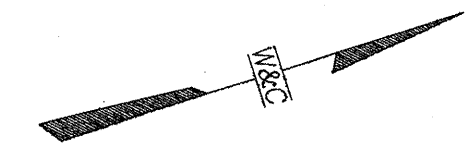

- LEGEND**
- |     |        |                             |
|-----|--------|-----------------------------|
| NEW | EXIST. |                             |
| SAS | SAS    | SANITARY SEWER              |
| W   | W      | WATER LINE                  |
| MH  | MH     | SANITARY SEWER MANHOLE      |
| WV  | WV     | WATER VALVE                 |
| WM  | WM     | WATER METER                 |
| GH  | GH     | GAS HYDRANT                 |
| SD  | SD     | STORM DRAIN                 |
| UT  | UT     | UNDERGROUND TELEPHONE LINE  |
| UE  | UE     | UNDERGROUND ELECTRICAL LINE |
| UC  | UC     | UNDERGROUND CABLE TV LINE   |

OLD COORS BOULEVARD, S.W.

NOTE:  
CONTRACTOR TO COORDINATE  
W/ BUSINESSES ALONG COORS  
TO ALLOW ACCESS AT ALL  
TIMES DURING CONSTRUCTION.

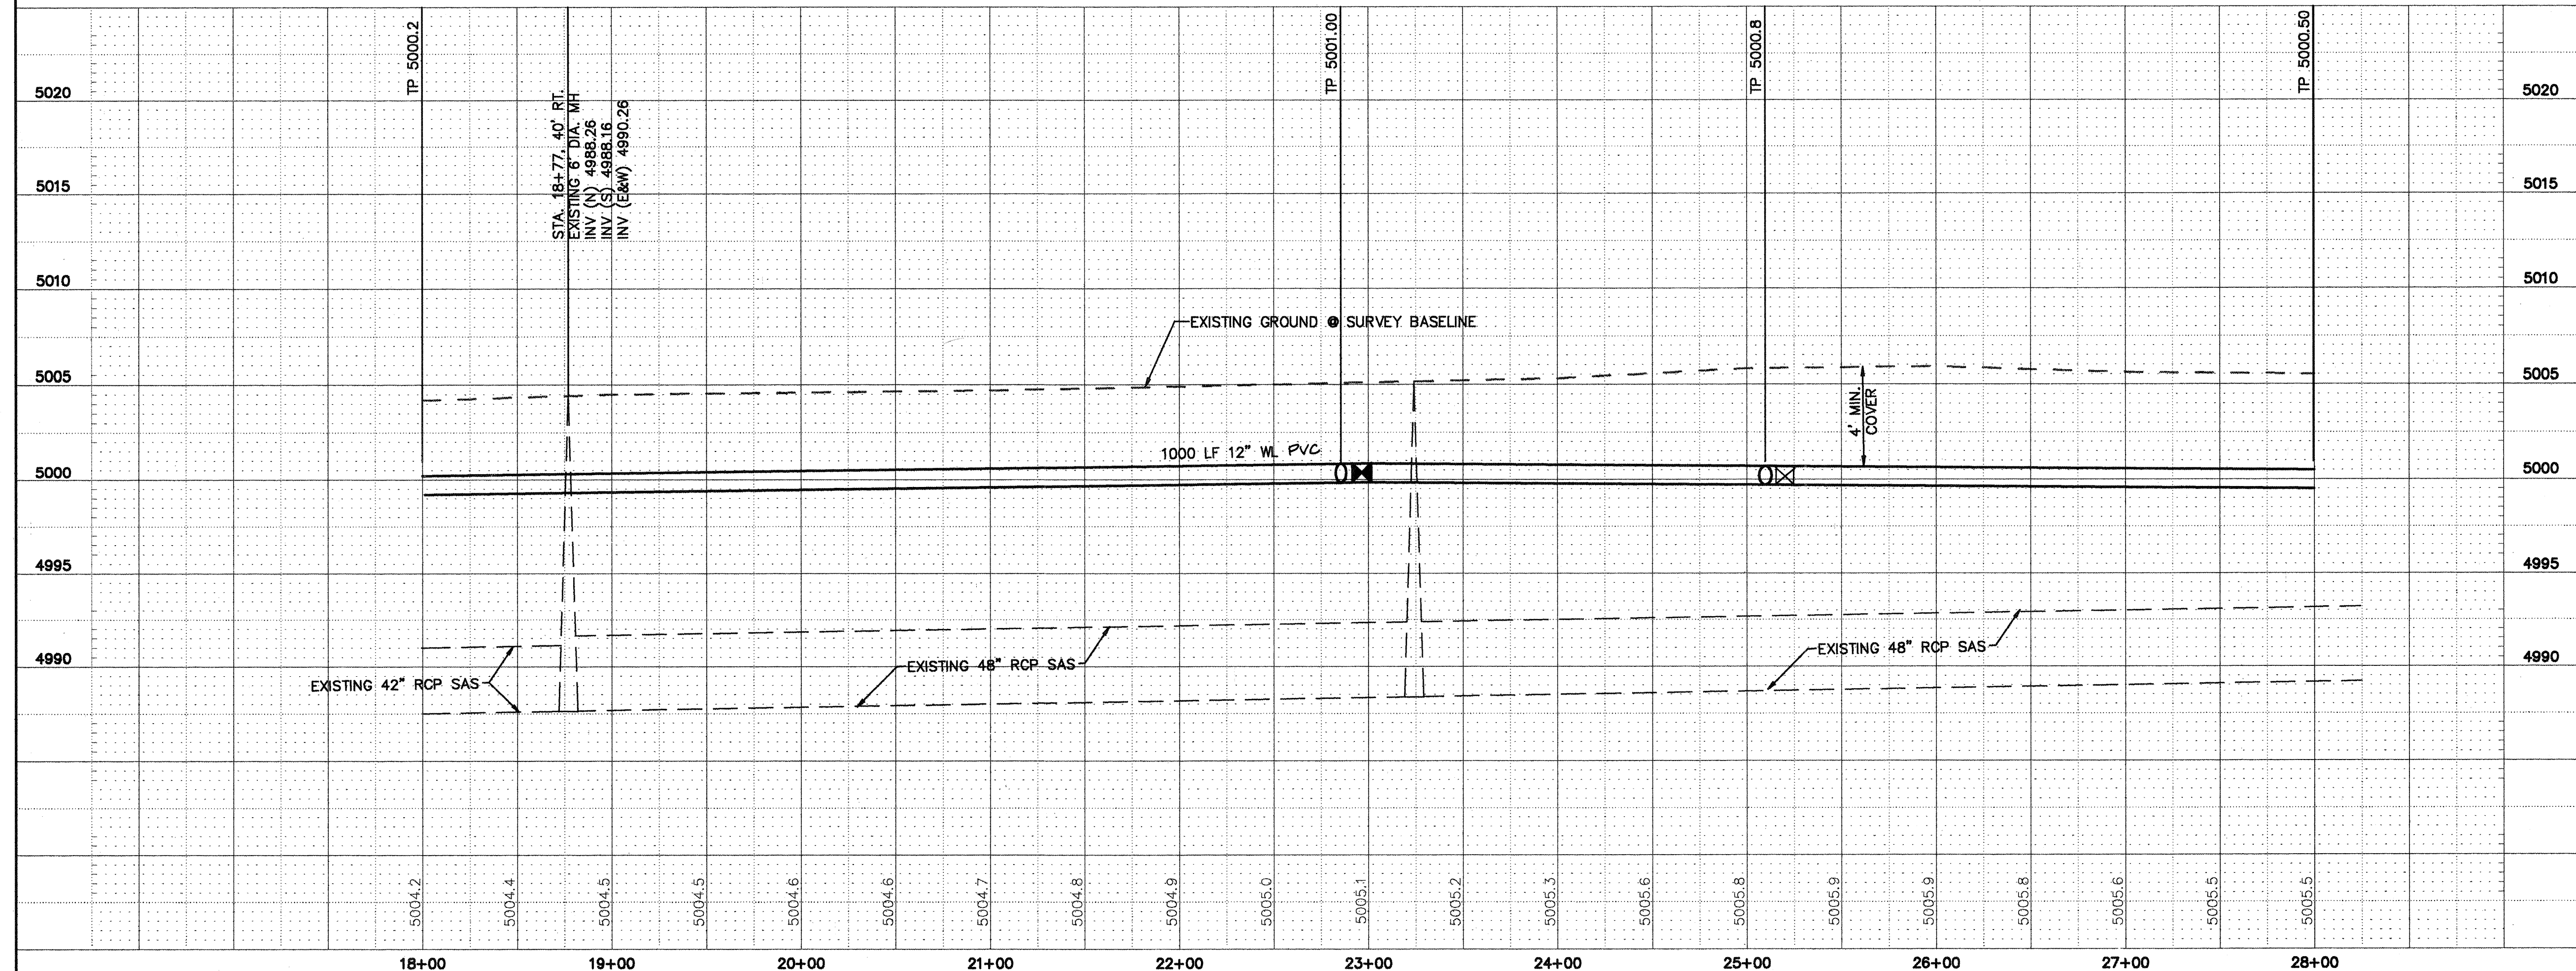

AS BUILT INFORMATION		BENCH MARKS		SURVEY INFORMATION		ENGINEER'S SEAL	
CONTRACTOR	J.R. HALE	DATE	11/1/93	FIELD NOTES	DATE		
WORK	BY J.R. HALE	DATE		NO.			
DESIGNED BY	J.R. HALE	DATE		REVISIONS	BY		
ACCEPTANCE BY	A. OSTAPACK	DATE		NO.	DATE		
FIELD	LOCATED IN THE INTERSECTION OF COORS BLVD. AND BRIDGE BLVD.	DATE		DESIGNED BY	JMS	DATE	NOV. 1993
DRAWING	ELEV=5003.02	DATE		DRAWN BY	PAS	DATE	NOV. 1993
CORRECTED BY	WILSON CO.	DATE		CHECKED BY	WJZ	DATE	NOV. 1993
MICRO-FILM INFORMATION		RECORDED BY					
		NO.					

CITY OF ALBUQUERQUE  
PUBLIC WORKS DEPARTMENT  
ENGINEERING GROUP

TITLE:  
OLD COORS BOULEVARD  
SOUTH VALLEY WATER AND SEWER  
SYSTEM IMPROVEMENT PROJECT



APPROVALS	ENGINEER	DATE	APPROVALS	ENGINEER	DATE
DRC CHAIRMAN	A. P. Rodriguez	12-13-93	WATER	M. J. Stoltz	12/1/93
TRANSPORTATION	N/A	12/10/93	WASTE WATER		
HYDROLOGY	N/A	12/10/93			

PROJECT NO. 4515.94 MAP NO. L-10, L-11 SHEET 6 OF 26

WILSON  
& COMPANY

WCEA #93-504



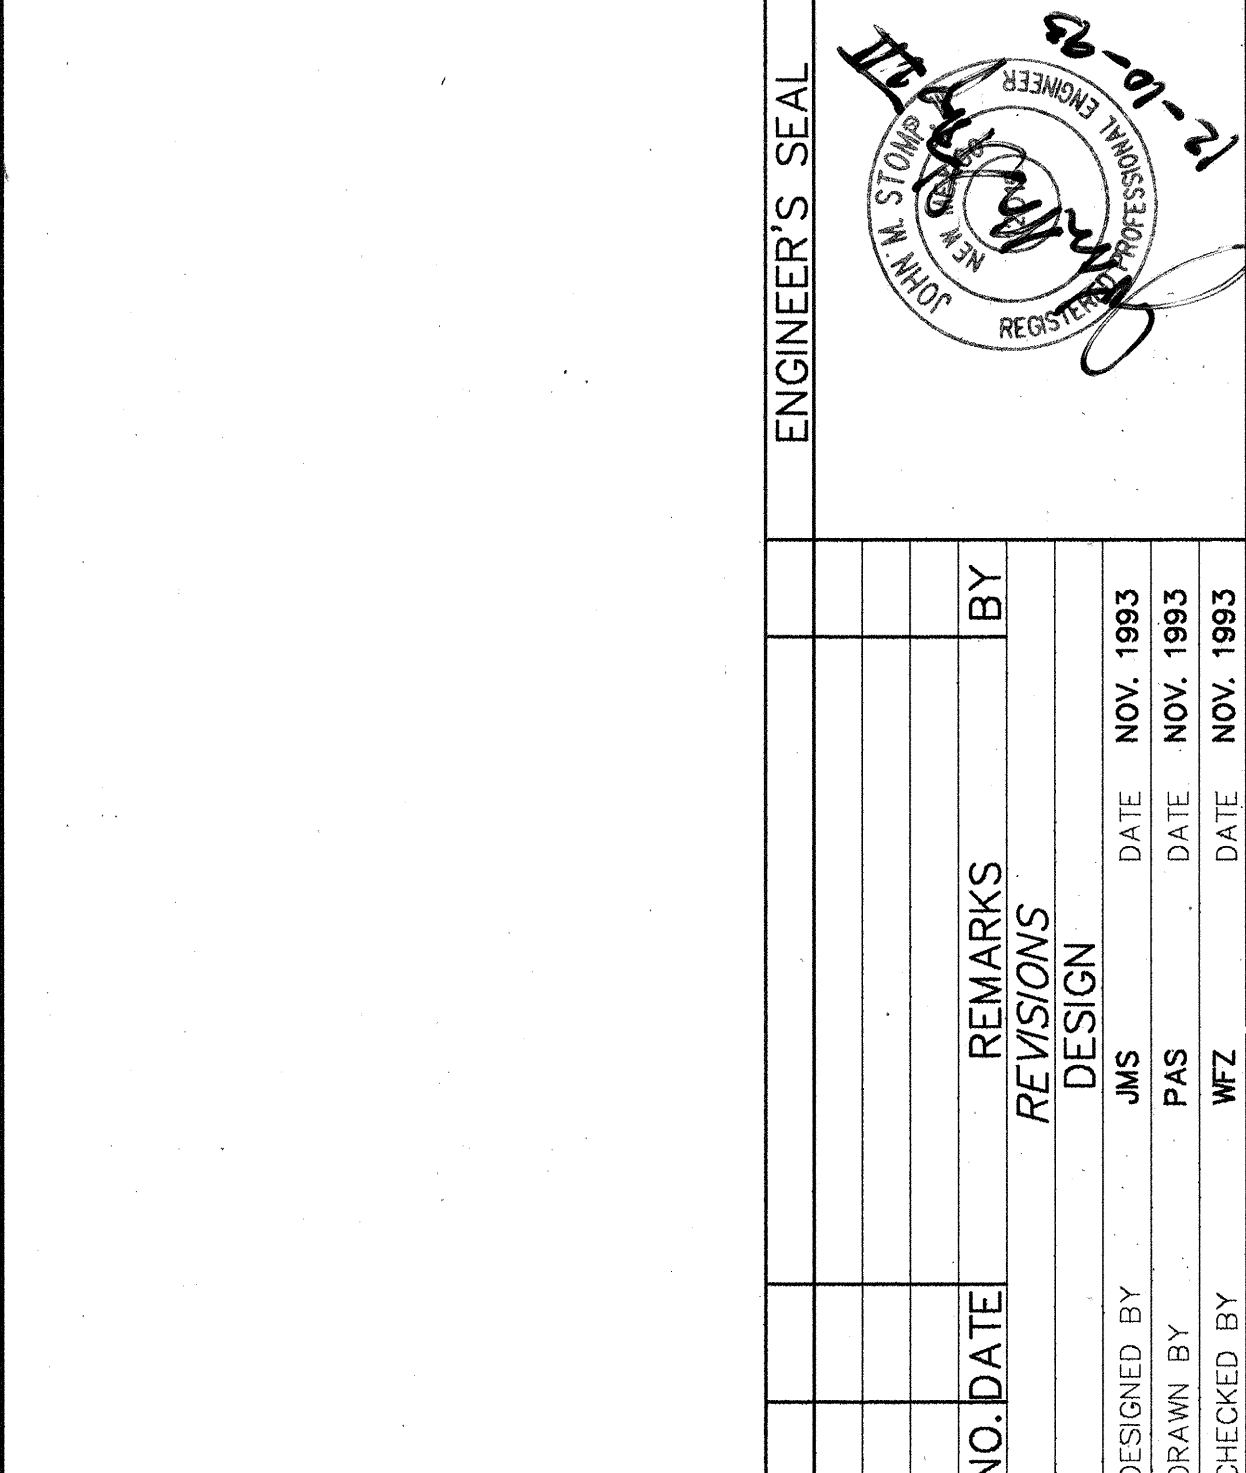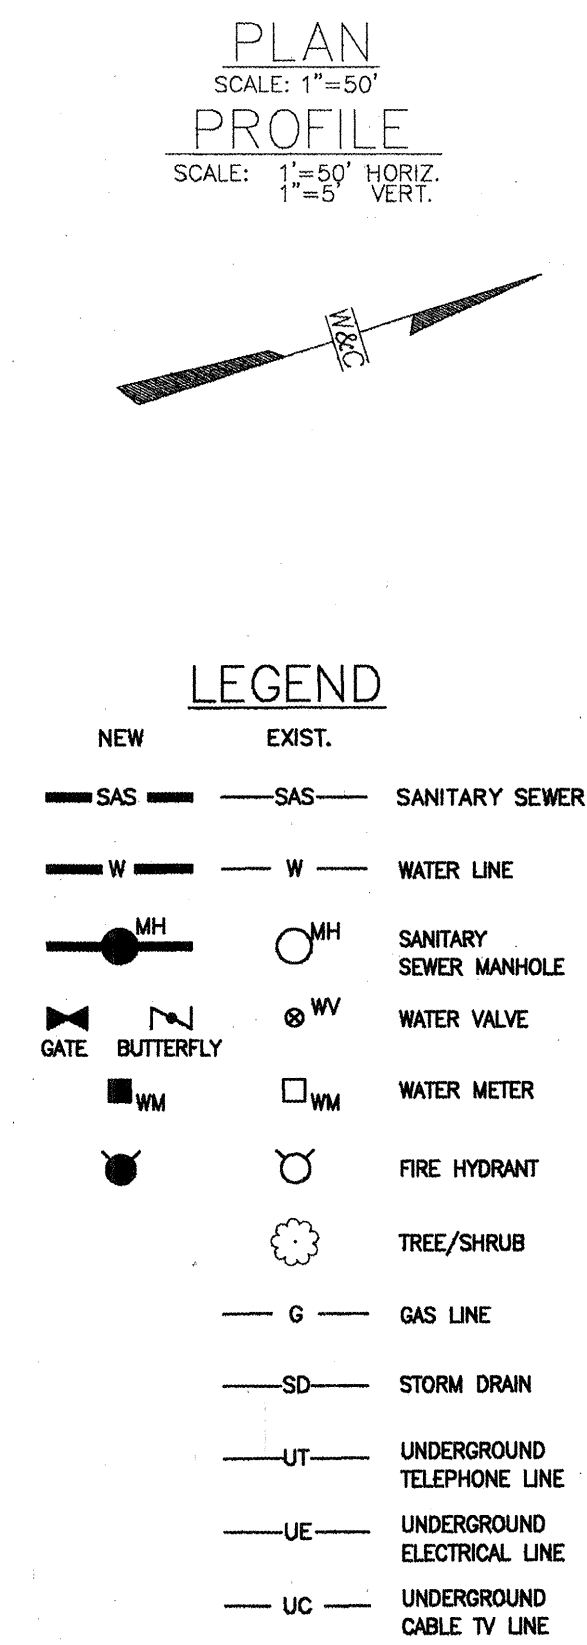

CITY OF ALBUQUERQUE PUBLIC WORKS DEPARTMENT ENGINEERING GROUP					
TITLE: OLD COORS BOULEVARD SOUTH VALLEY WATER AND SEWER SYSTEM IMPROVEMENT PROJECT					
APPROVALS	ENGINEER	DATE	APPROVALS	ENGINEER	DATE
DRC CHAIRMAN	<i>B.G. Baskley</i>	12/13-93	WATER	<i>W.C. Chen</i>	12/16/93
TRANSPORTATION	<i>N/A LHC</i>	12/12-93	WASTE WATER		
HYDROLOGY	<i>N/A JHC</i>	12/10/93			
PROJECT NO. 4515.94		MAP NO. L-10, L-11		SHEET 7 OF 26	



STA. 8+20, 20' LT  
INSTALL 1-12" X 6" MJ TEE  
1- 12" MJ GATE VALVE  
W/ TYPE "B" VALVE BOX  
5 L.F. 6" WL  
1-4.5' BURY AIR RELEASE FH  
1- 6" MJ GATE VALVE  
W/ TYPE "B" VALVE BOX  
1-12" X 6" REDUCER  
1- 12" CAP W/  
CONCRETE BLOCKING

STA. 8+60, 20' LT  
INSTALL 1-12" MJ CROSS  
1- 12" X 6" REDUCER

STA. 9+20, 20' LT  
INSTALL 1-12" GATE VALVE  
W/TYPE "B" VALVE BOX

STA. 13+00  
LIMIT OF PAVEMENT  
REMOVAL AND REPLACEMENT

STA. 16+56  
INSTALL 1-12" MJ BEND  
22 1/2°

STA. 16+38  
INSTALL 1-12" MJ BEND  
22 1/2°

STA. 16+98, 10' LT  
INSTALL 1-12" X 6" MJ TEE  
1- 12" MJ GATE VALVES  
W/TYPE "A" VALVE BOX  
1- 6" MJ GATE VALVES  
W/TYPE "A" VALVE BOX  
15 L.F. 6" WL  
1- 4.5' BURY FH

REMOVE AND REPLACE  
50 SY OF ASPHALT  
PAVEMENT

STA. 8+71.00, SAGE ROAD  
= STA. 14+80 75TH STREET

LOT 1

LOT 2

LOT 3

FOR CONTINUATION SEE SHEET 11

## SAGE ROAD S.W.

NOTE: DOUBLE YELLOW ROAD CENTERLINE  
STRIPING REPLACED WHERE DISTURBED

NOTE:  
INSTALL CENTERED STEEL CASING INSULATORS  
AND CASING END SEALS FOR 12" WATERMAIN  
AND 8" SEWER LINE. THE INSULATORS AND SEALS SHALL BE  
INSTALLED PER MANUFACTURER'S SPECIFICATIONS.  
(PIPELINE SEAL AND INSULATOR, INC.,  
MODEL A12 INSULATORS AND MODEL  
S END SEALS, 1-713-747-6948 OR  
APPROVED EQUAL)

PLAN  
SCALE: 1"=50'  
PROFILE  
SCALE: 1"=5' HORIZ.  
1"=5' VERT.

### LEGEND

- NEW EXIST.
- SAS SANITARY SEWER
  - W WATER LINE
  - MH SANITARY SEWER MANHOLE
  - WV WATER VALVE
  - WM WATER METER
  - FH FIRE HYDRANT
  - T/S TREE/SHRUB
  - G GAS LINE
  - SD STORM DRAIN
  - UT UNDERGROUND TELEPHONE LINE
  - UE UNDERGROUND ELECTRICAL LINE
  - UC UNDERGROUND CABLE TV LINE

FOR CONTINUATION SEE SHEET 9

AS-BUILT INFORMATION		DATE
CONTRACTOR	L.R. HALE	DATE
WORK	SEWER	DATE
DESIGNED BY	J.R. HALE	DATE
CHECKED BY	J.R. HALE	DATE
APPROVED BY	J.R. HALE	DATE
REVISIONS	DATE	BY
1	12-13-93	JMS
2	12-10-93	PAS
3	12-10-93	WJZ

BENCH MARKS		DATE
BENCHMARK USED IS A STANDARD ACS BRASS CAP STAMPED	DATE	BY
"ACS 45-7A, 1976" LOCATED 42.3' WEST OF THE INTERSECTION OF	DATE	BY
S. COORS RD. & BLAKE RD., S.W. ELEV. = 4853.487	DATE	BY
TBM #1 = PAINT SPOT AT TOP OF CURB @ S. CURB - END OF	DATE	BY
CURB ON EDUARDO RD., S.W. ELEV. = 4866.27	DATE	BY
TBM #2 = NE CORNER CONC. FENCE POST @ 3930 EDUARDO RD., S.W.	DATE	BY
ELEV. = 4884.57	DATE	BY

SURVEY INFORMATION		DATE
FIELD NOTES	DATE	BY
NO.	DATE	BY

ENGINEER'S SEAL		DATE
NO.	DATE	BY
REVISIONS	DATE	BY
DESIGNED BY	DATE	BY
DRAWN BY	DATE	BY
CHECKED BY	DATE	BY

SEWER SERVICES				
LOT	STATION	SIZE	LENGTH	INV. @ PL
1				
2	14+45	4"	30'	5'
3	16+10	4"	30'	5'

WATER SERVICES			
LOT	STATION	SIZE	LENGTH
1			
2	14+85	3/4"	50'
3	14+85	3/4"	50'

CITY OF ALBUQUERQUE  
PUBLIC WORKS DEPARTMENT  
ENGINEERING GROUP

TITLE:				
SAGE ROAD SOUTH VALLEY WATER AND SEWER SYSTEM IMPROVEMENT PROJECT				
APPROVALS	ENGINEER	DATE	APPROVALS	ENGINEER
DRC CHAIRMAN	J.R. HALE	12-13-93	WATER	WJZ
TRANSPORTATION	N.D. RMD	12-10-93	WASTE WATER	WJZ
HYDROLOGY	N.D. RMD	12-10-93		

PROJECT NO.	4515.94	MAP NO.	L-10, L-11	SHEET	8	OF	26
-------------	---------	---------	------------	-------	---	----	----

WILSON  
& COMPANY

WCEA #93-504




FOR CONTINUATION SEE SHEET 8

SEE SHEET 8  
STA. 16+98, 10' LT  
INSTALL 1-12" MJ TEE  
1-12" MJ GATE VALVE  
W/TYPE "A" VALVE BOX  
1-6" MJ GATE VALVE  
W/TYPE "A" VALVE BOX  
15 LF 6" WL  
1-4.5' BURY FH

COORS  
BYPASS

NOTE: FIELD AGREEMENT  
WITH OWNER TO LEAVE 8"  
STUB FOR FUTURE FIRE  
PROTECTION LINE ON SITE  
IN LIEU OF 2" METER  
BOX.

STA. 23+40, 10' LT  
INSTALL 1-12" MJ TEE  
1-12" MJ GATE VALVE  
1-6" MJ GATE VALVE  
1-TYPE "B" VALVE BOX  
1-TYPE "A" VALVE BOX  
10 LF 6" WL  
1-4.5' BURY FH

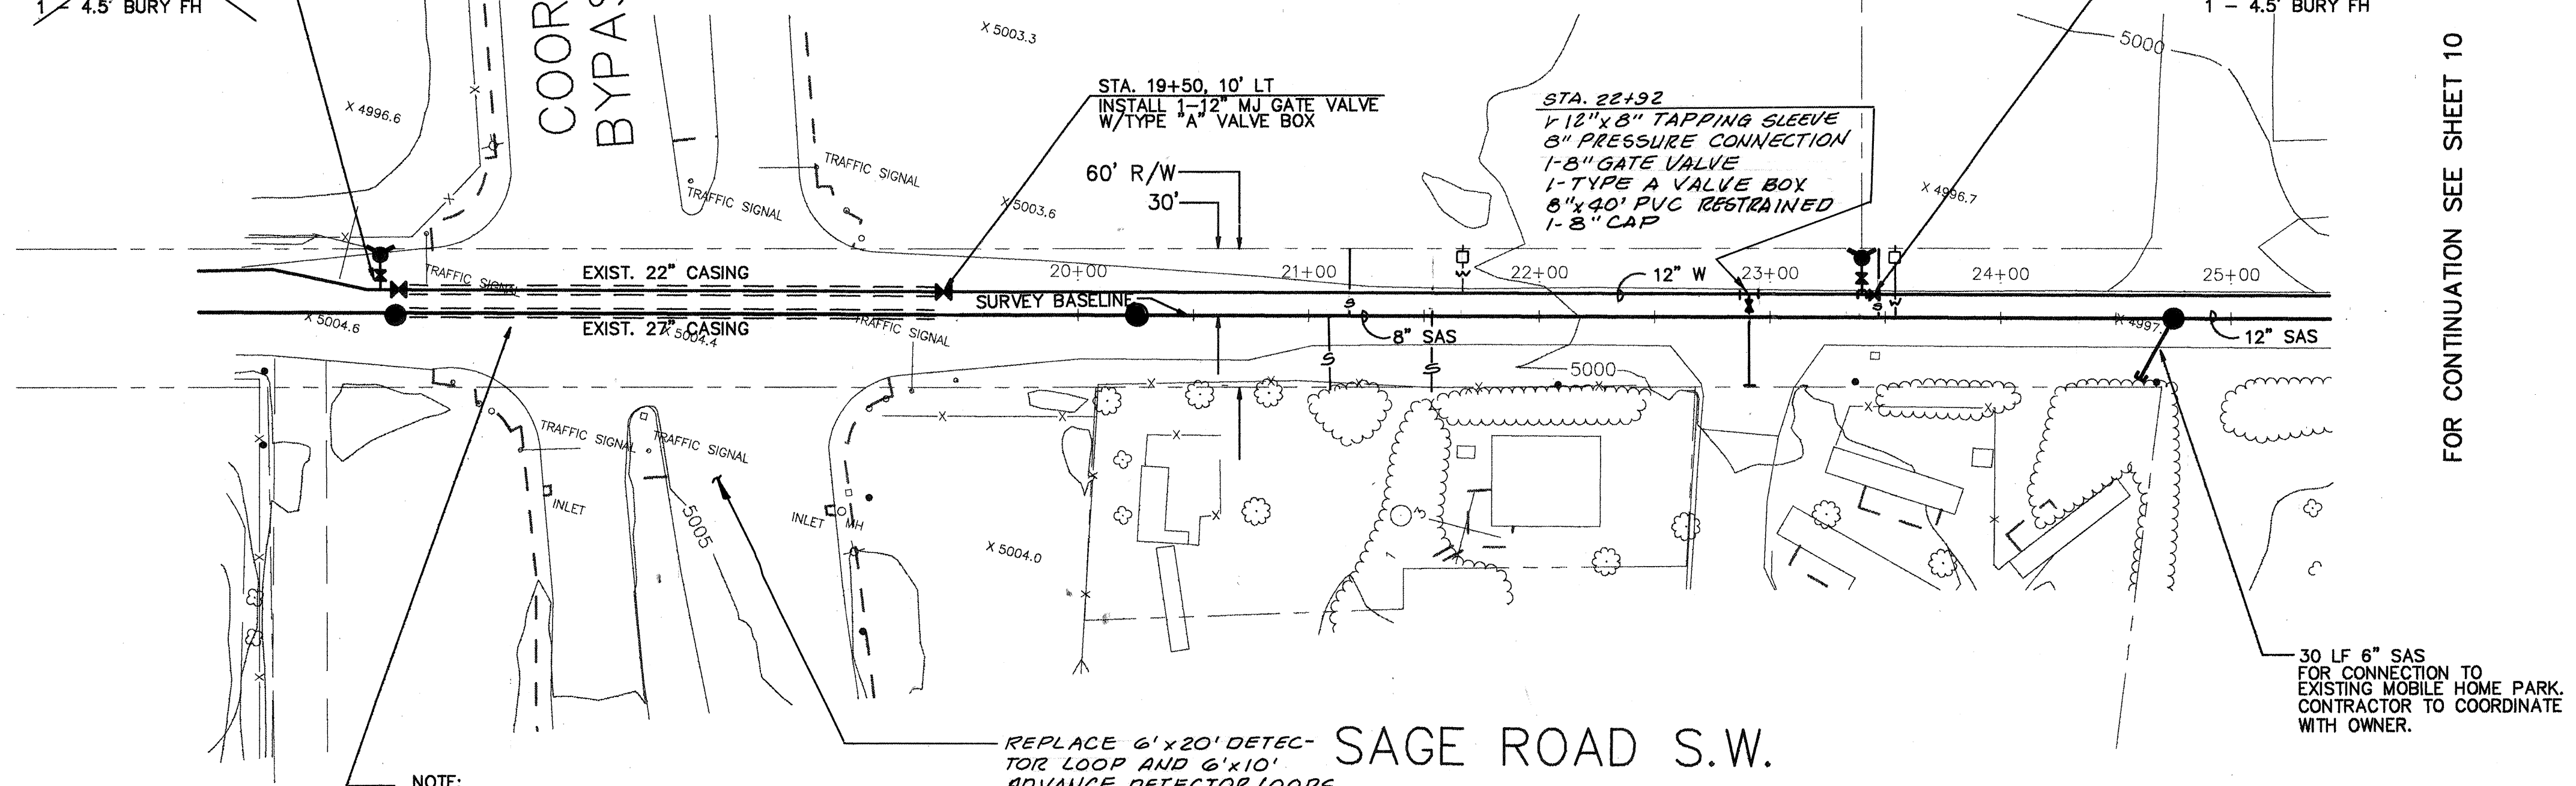

NOTE:  
INSTALL CENTERED STEEL CASING INSULATORS  
AND CASING END SEALS FOR 10" WATERMAIN  
AND 8" SEWER LINE. THE INSULATORS AND SEALS SHALL BE  
INSTALLED PER MANUFACTURER'S SPECIFICATIONS.  
(PIPELINE SEAL AND INSULATOR, INC.,  
MODEL A12 INSULATORS AND MODEL  
S END SEALS, 1-713-747-6948 OR  
APPROVED EQUAL)

REPLACE 6'x20' DETEC-  
TOR LOOP AND 6'x10'  
ADVANCE DETECTOR LOOPS  
IN SAGE RD. PAVING ON  
BOTH SIDES OF COORS  
INTERSECTION. CO-ORD.  
WITH BERNALILLO  
COUNTY TRAFFIC DIVI-  
SION & TIE TO EXISTING  
SIGNAL SYSTEM.

SAGE ROAD S.W.

NOTE: DOUBLE YELLOW CENTERLINE  
REPLACED ON SAGE ROAD.

FOR CONTINUATION SEE SHEET 10

PLAN  
SCALE: 1"=50'  
PROFILE  
SCALE: 1"=50' HORIZ.  
1"=5' VERT.

- LEGEND
- |     |        |                             |
|-----|--------|-----------------------------|
| NEW | EXIST. |                             |
| SAS | SAS    | SANITARY SEWER              |
| W   | W      | WATER LINE                  |
| MH  | MH     | SANITARY SEWER MANHOLE      |
| WV  | WV     | WATER VALVE                 |
| WM  | WM     | WATER METER                 |
| FM  | FM     | FIRE HYDRANT                |
| TS  | TS     | TREE/SHRUB                  |
| G   | G      | GAS LINE                    |
| SD  | SD     | STORM DRAIN                 |
| UT  | UT     | UNDERGROUND TELEPHONE LINE  |
| UE  | UE     | UNDERGROUND ELECTRICAL LINE |
| UC  | UC     | UNDERGROUND CABLE TV LINE   |

SEWER SERVICES				
LOT	STATION	SIZE	LENGTH	INV. @ PL
23+46	4"	30'	5'-6"	
21+17	4"	30'	5'	
21+53	4"	30'	5'	
21+08	4"	30'	5'	

WATER SERVICES			
LOT	STATION	SIZE	LENGTH
21+65	3/4"	30'	
23+55	3/4"	30'	

AS BUILT INFORMATION		BENCH MARKS		SURVEY INFORMATION		ENGINEER'S SEAL	
CONTRACTOR	J.R. HALE	DATE	11/11/94	NO.	BY	DATE	12-19-94
WORKED BY	J.R. HALE	DATE					
INSPECTED BY	A. OSTAPAK	DATE					
APPROVED BY	C.O.A.	DATE					
VERIFICATION BY	C.O.A.	DATE					
DRAWN BY	WILSON CO.	DATE	11/11/94				
CHECKED BY		DATE					
RECORDED BY		DATE					
NO.							
BENCHMARK USED IS A STANDARD ACS BRASS CAP STAMPED		DATE		NO.		BY	
"ACS 45-7A, 1976" LOCATED 42.3' WEST OF THE INTERSECTION OF							
S. COORS RD. & BLAKE RD., S.W. ELEV. = 4953.487							
TBM #1 = PAINT SPOT AT TOP OF CURB @ S. CURB - END OF							
CURB ON EDUARDO RD., S.W. ELEV. = 4982.27							
TBM #2 = NE CORNER CONC. FENCE POST @ 3930 EDUARDO RD., S.W.							
ELEV. = 4984.57							

REVISIONS	NO.	DATE	REMARKS
DESIGN	JMS	NOV. 1993	
PAS	PAS	NOV. 1993	
WFS	WFS	NOV. 1993	

APPROVALS	ENGINEER	DATE	APPROVALS	ENGINEER	DATE
DRC CHAIRMAN	A. J. Rodolay	12-13-93	WATER	WILSON	12/1/93
TRANSPORTATION	N/A	12-10-93	WASTE WATER		
HYDROLOGY	N/A	12/1/93			

PROJECT NO.	4515.94	MAP NO.	L-10, L-11	SHEET	9	OF	26
-------------	---------	---------	------------	-------	---	----	----

WILSON  
& COMPANY

WCEA #93-504



T.I.W. Fabrication  
& Manufacturing  
1255 Coors Rd. NW

STA. 31+25, 10' LT  
INSTALL 1 - 12" MJ VALVE  
1 - TYPE "B" VALVE BOX  
INSTALL 1 - 12" MJ 22-1/2' BEND

STA. 27+55, 10' LT  
INSTALL 1 - 12" x 6 MJ TEE  
1 - 12" MJ GATE VALVE  
W/TYPE "A" VALVE BOX  
1 - 6" MJ GATE VALVE  
W/TYPE "B" VALVE BOX  
15 LF 6" WL  
1 - 4.5' BURY FH W/ 12" EXTENSION

NOTE: DOUBLE YELLOW CENTER LINE  
STRIPE REPLACED.



















REPLACED 6" x 20'  
TRAFFIC DETECTOR LOOP  
IN PAVEMENT AND RE-  
CONNECTED TO EXISTING  
SIGNAL.

NOTE: SEE TRAFFIC CONTROL SHEETS  
FOR COORS BLVD. CLOSING

FOR CONTINUATION SEE SHEET 5

PLAN  
SCALE: 1"=50'  
PROFILE  
SCALE: 1"=50' HORIZ.  
1"=5' VERT.

LEGEND

NEW	EXIST.	
 SAS	 SAS	SANITARY SEWER
 W	 W	WATER LINE
 MH	 MH	SANITARY SEWER MANHOLE
 GATE	 WV	WATER VALVE
 HM	 WM	WATER METER
		FIRE HYDRANT
		TREE/SHRUB
	 G	GAS LINE
	 SD	STORM DRAIN
	 UT	UNDERGROUND TELEPHONE LINE
	 UE	UNDERGROUND ELECTRICAL LINE
	 UC	UNDERGROUND CABLE TV LINE

CONTRACTOR <i>J.R. HALE</i>		DATE <i>11-94</i>
WORK ORDER NO.	DATE	
INSPECTED BY <i>J.R. HALE</i>	DATE	
INSPECTOR'S	DATE	
NOTE BY <i>A.OSTAPACK</i>	DATE	
FIELD INFORMATION BY <i>C.O.A.</i>	DATE	
TRANS. NO.	DATE	
CORRECTED BY <i>WILSON CO.</i>	DATE <i>11-96</i>	
MICRO-FILM INFORMATION		
RECORDED BY	DATE	
NO.		

BENCH MARKS

BENCHMARK USED IS A STANDARD AAS BRASS CAP STAMPED  
"AAS 45-7A, 1976" LOCATED 42.3' WEST OF THE INTERSECTION OF  
S. COORS RD. & BLAKE RD., S.W. ELEV.=6953.467  
TBM #1 = PAINT SPOT AT TOP OF CURB @ S. CURB - END OF  
CURB ON EDUARDO RD., S.W. ELEV.=4869.27  
TBM #2 = NE CORNER CONC. FENCE POST @ 3950 EDUARDO RD., S.W.  
ELEV.=4984.57

[illegible]

SEWER SERVICES				
LOT	STATION	SIZE	LENGTH	INV. @ PL
	24+16	4"	30'	5'-6"
	25+15	4"	30'	5'-6"
	29+92	4"	27'	6'-6"
	20+95	4"	30'	5'-6"

WATER SERVICES			
LOT	STATION	SIZE	LENGTH
	24+72		
	25+26	1"	
	27 ± 78	1 1/2"	

NO. DATE		REMARKS	BY
		REVISIONS	
		DESIGN	
DESIGNED BY	JMS	DATE	NOV. 1993
DRAWN BY	PAS	DATE	NOV. 1993
CHECKED BY	W.F.Z.	DATE	NOV. 1993

CITY OF ALBUQUERQUE	
PUBLIC WORKS DEPARTMENT	
ENGINEERING GROUP	
TITLE:	<p><b>SAGE ROAD</b></p> <p>SOUTH VALLEY WATER AND SEWER SYSTEM IMPROVEMENT PROJECT</p>



APPROVALS	ENGINEER	DATE	APPROVALS	ENGINEER	DATE
DRC CHAIRMAN	<i>A.G. Goodley</i>	<i>12-19-93</i>	WATER	<i>Mulligan</i>	<i>12/16/93</i>
TRANSPORTATION	<i>N/A CUD</i>	<i>12-10-93</i>	WASTE WATER		
HYDROLOGY	<i>N/A gmo</i>	<i>12/10/93</i>			

PROJECT NO.	4515.94	MAP NO.	L-10, L-11	SHEET	10	OF	26
-------------	---------	---------	------------	-------	----	----	----


**WILSON**  
& COMPANY

WCEA #93-504



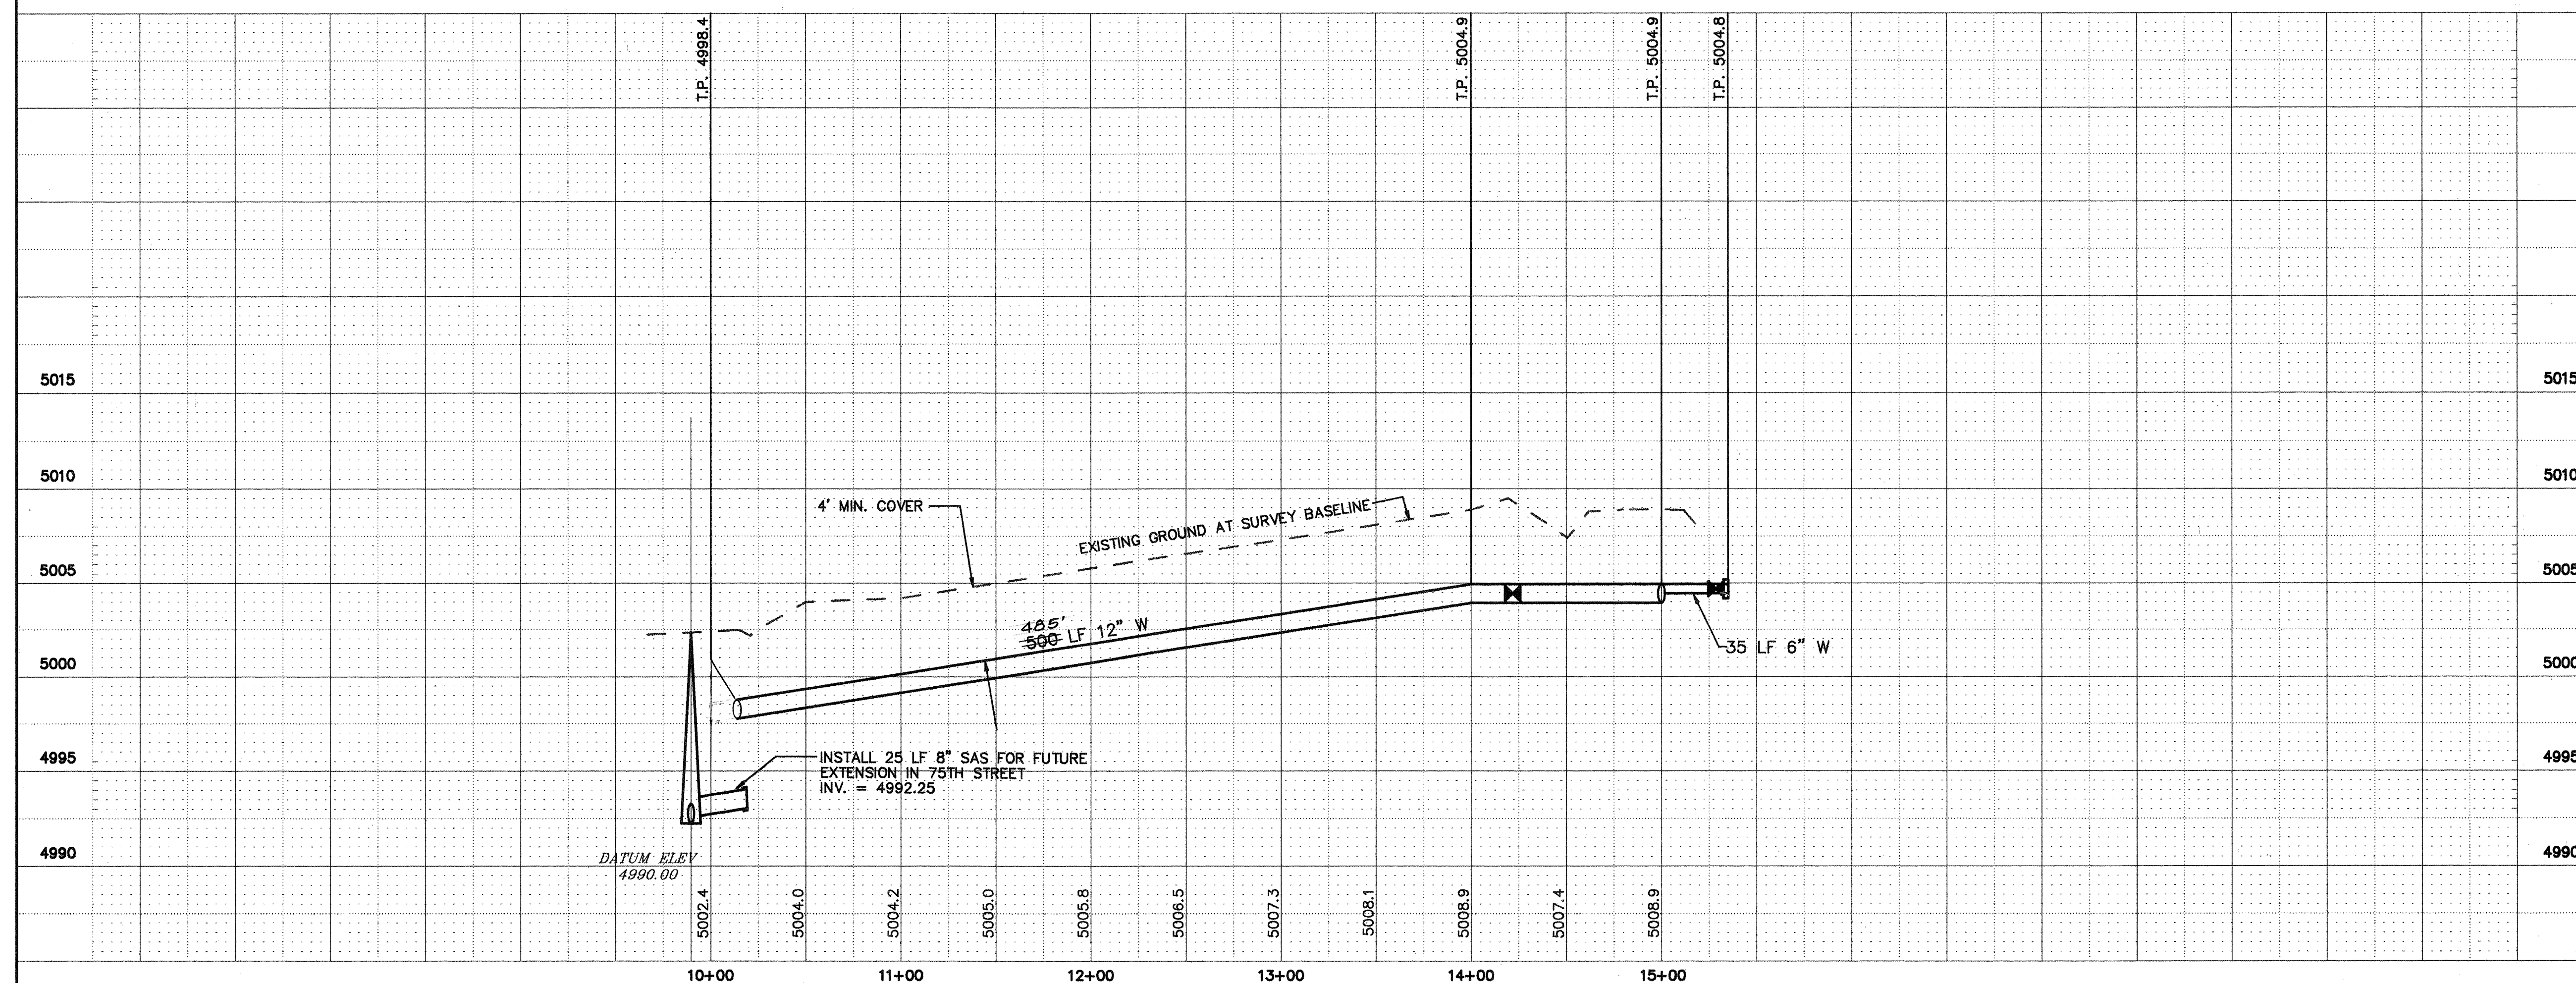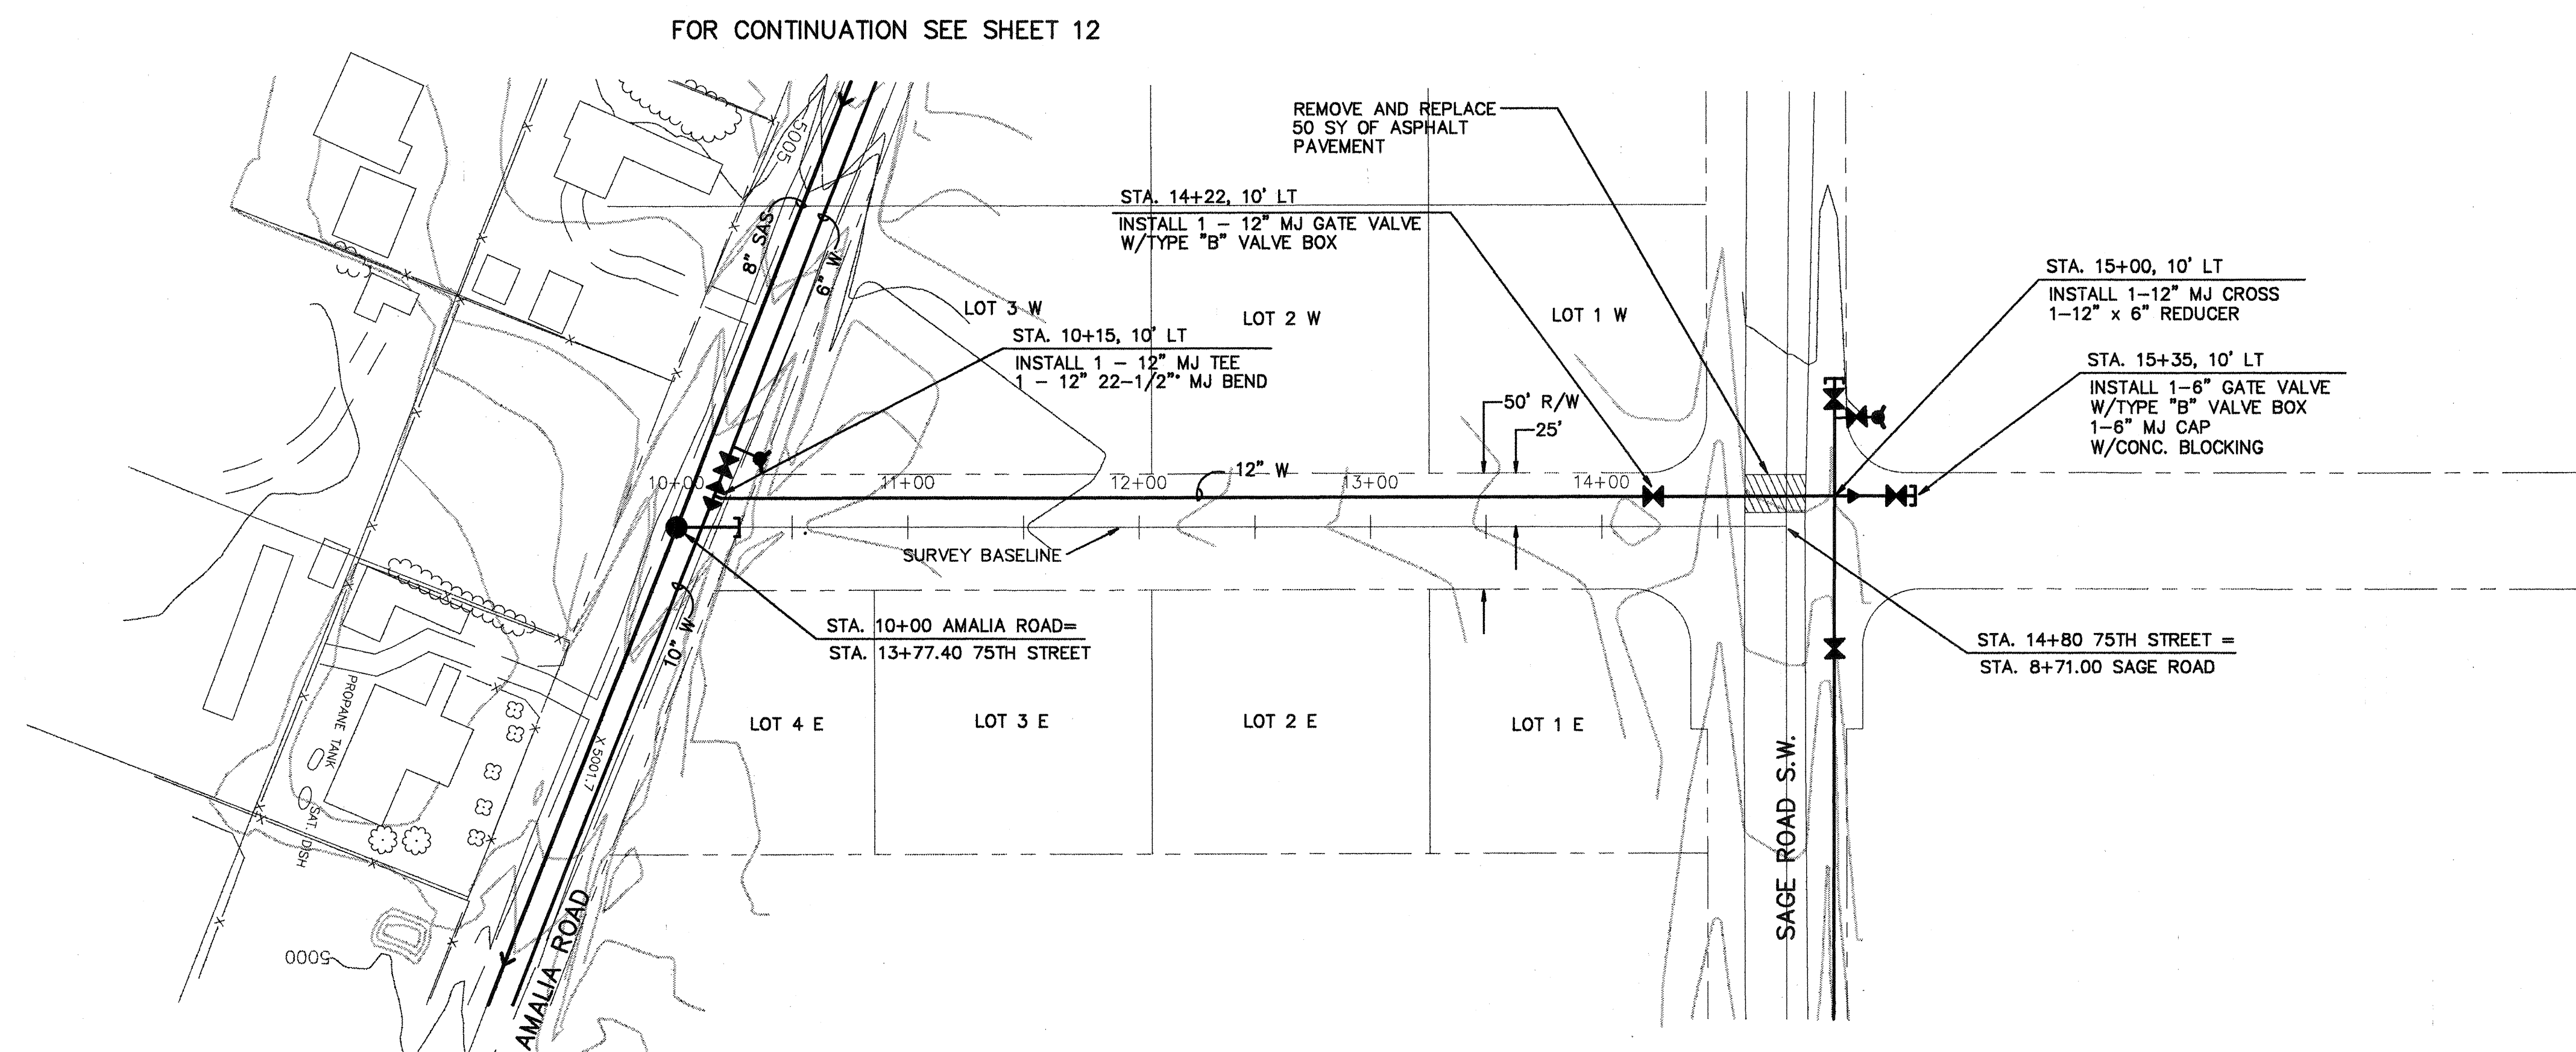

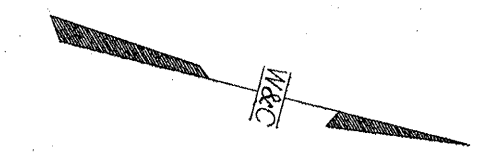


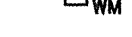














PLAN  
SCALE: 1"=50'  
PROFILE  
SCALE: 1"=50' HORIZ.  
1"=5' VERT.




LEGEND

NEW	EXIST.	
 — SAS —	 — SAS —	SANITARY SEWER
 — W —	 — W —	WATER LINE
 MH	 MH	SANITARY SEWER MANHOLE
 GATE	 BUTTERFLY	WATER VALVE
 WM	 WM	WATER METER
		FIRE HYDRANT
		TREE/SHRUB
	 — G —	GAS LINE
	 — SD —	STORM DRAIN
	 — UT —	UNDERGROUND TELEPHONE LINE
	 — UE —	UNDERGROUND ELECTRICAL LINE
	 — UC —	UNDERGROUND CABLE TV LINE


S.W. AND SEWER PROJECT		ENGINEER'S SEAL		SURVEY INFORMATION		BENCH MARKS		AS BUILT INFORMATION	
NO. DATE	REVISIONS	BY		NO.	BY	DATE			
DESIGNED BY		JMS	DATE	NOV. 1993					
DRAWN BY		PAS	DATE	NOV. 1993					
CHECKED BY		WFZ	DATE	NOV. 1993					
VALVES		ENGINEER		DATE					
WATER		<i>Michael</i>		12/1/93					
SHEET		11		OF		26			



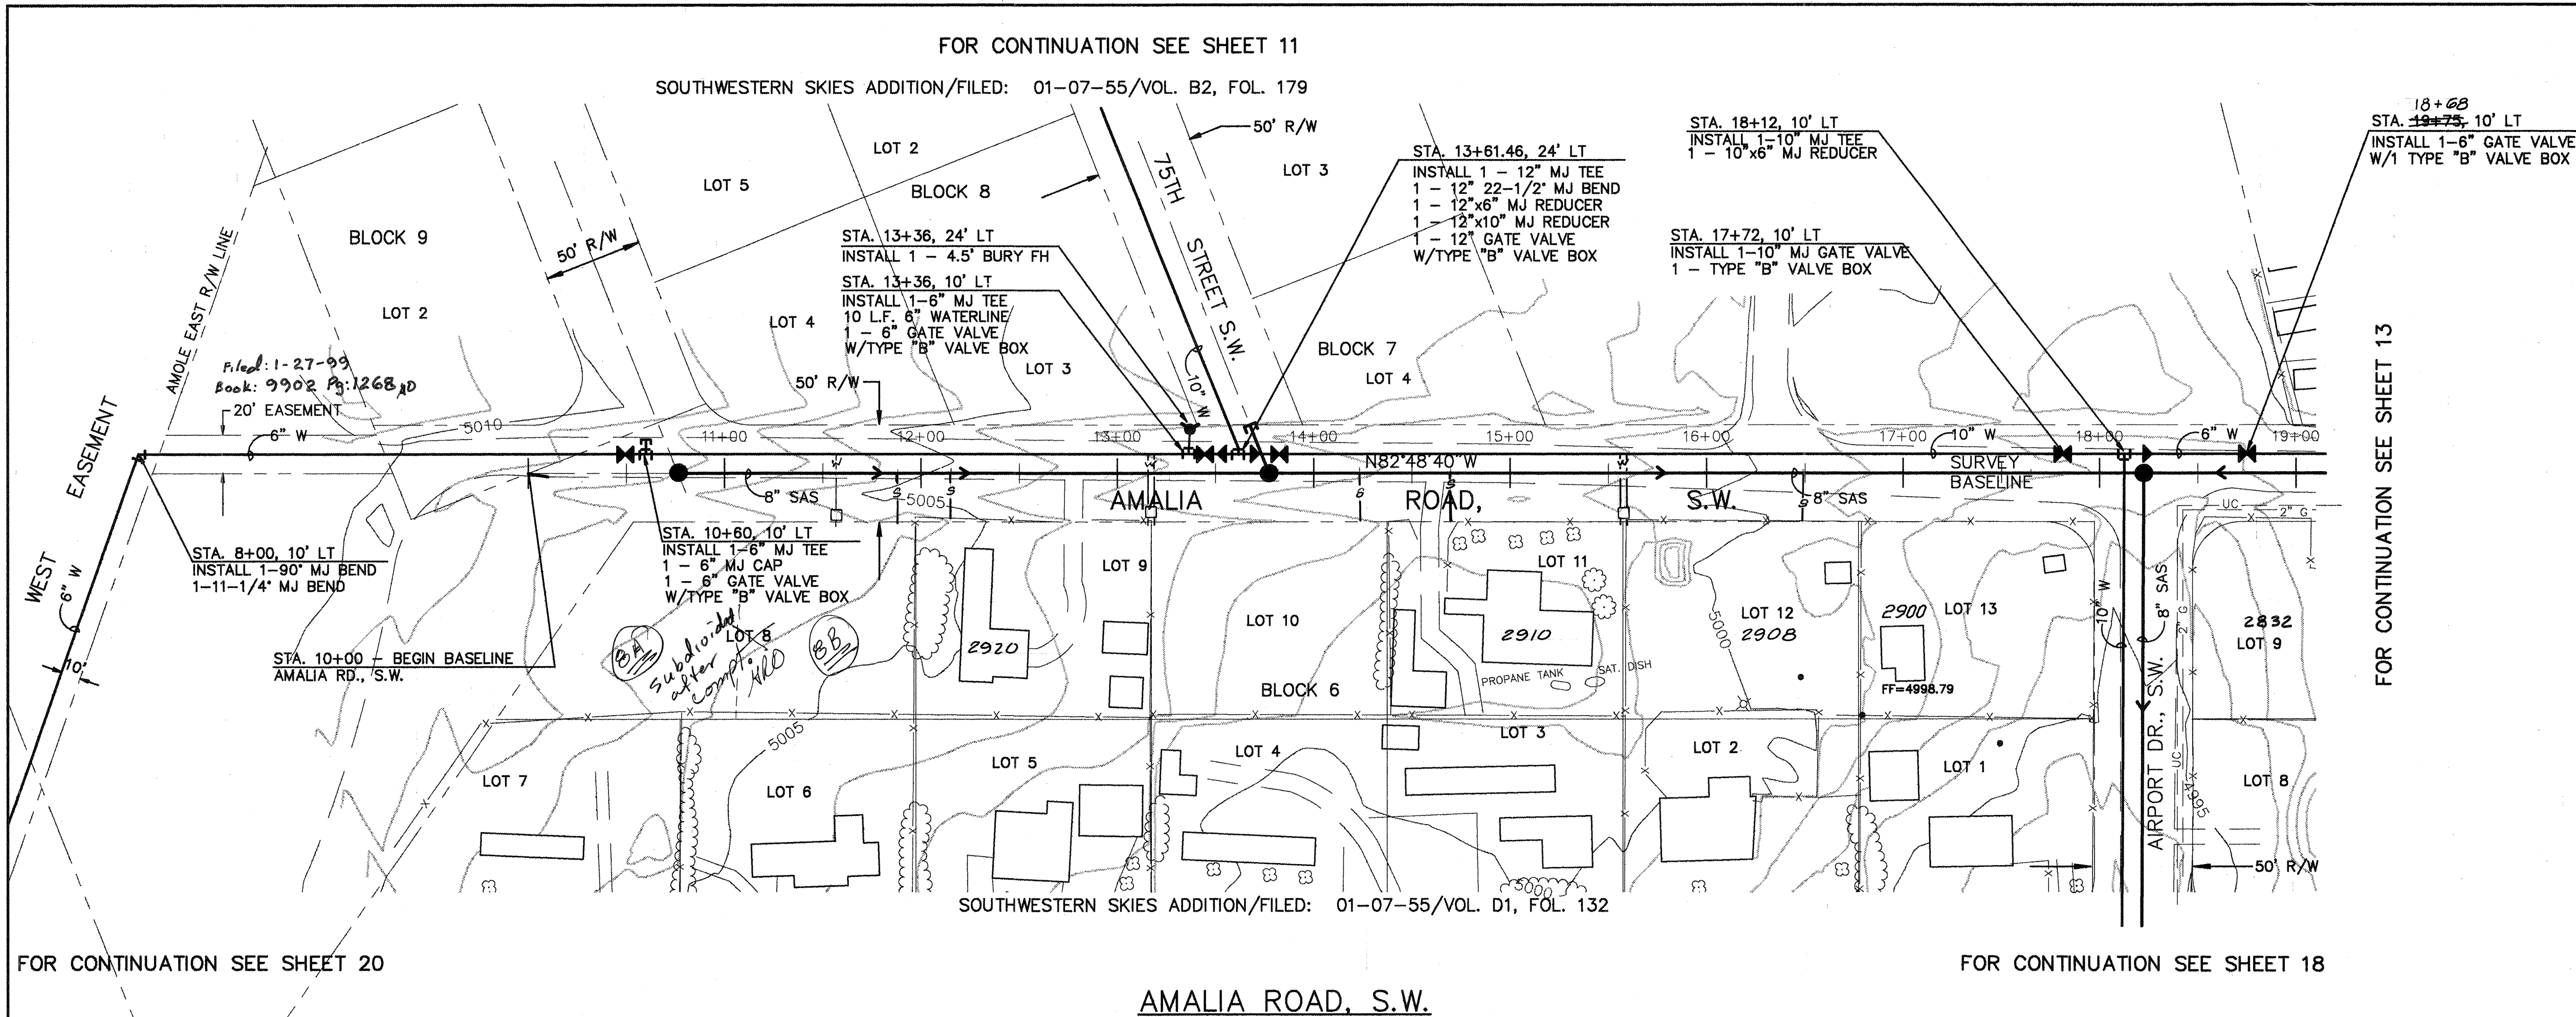

PLAN  
SCALE: 1"=50'  
PROFILE  
SCALE: 1"=50' HORIZ.  
1"=5' VERT.

LEGEND

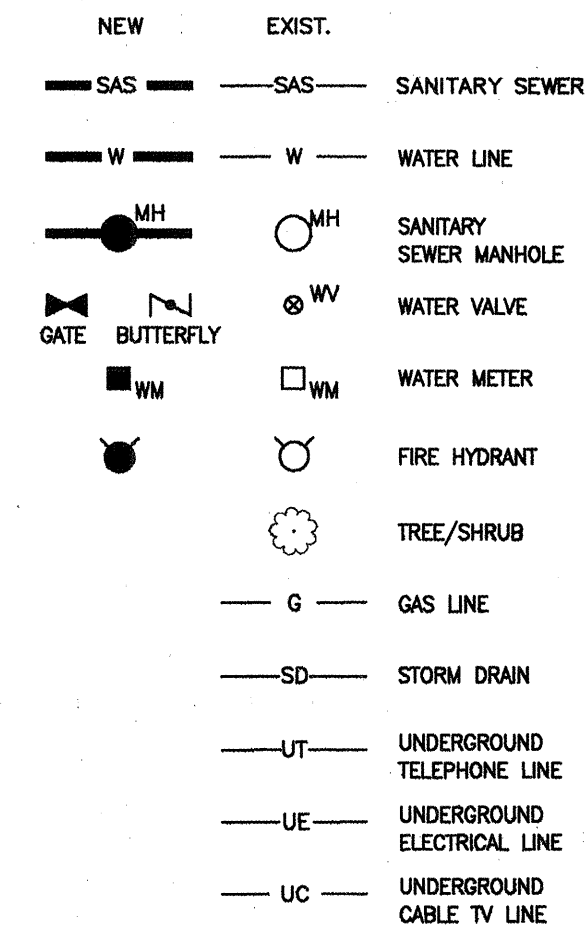

SEWER SERVICES				
LOT	STATION	SIZE	LENGTH	INV. @ PL
8	11+87	4"	30'	5'
9	12+15	4"	30'	5'
10	14+24	4"	30'	5'
11	14+69	4"	30'	5'
12	16+49	4"	30'	5'
13	17+64	4"	30'	5'

WATER SERVICES			
LOT	STATION	SIZE	LENGTH
8	11±57	3/4"	
9	13±19	1 1/2"	
10	13±19	3/4"	
11	15±57		
12	15±57		
13			

CITY OF ALBUQUERQUE  
PUBLIC WORKS DEPARTMENT  
ENGINEERING GROUP

TITLE: AMALIA ROAD, S.W.  
SOUTH VALLEY WATER AND SEWER  
SYSTEM IMPROVEMENT PROJECT


APPROVALS	ENGINEER	DATE	APPROVALS	ENGINEER	DATE
DRC CHAIRMAN	<i>[Signature]</i>	11/13/93	WATER	<i>[Signature]</i>	12/10/93
TRANSPORTATION	<i>[Signature]</i>	12/10/93	WASTE WATER		
HYDROLOGY	<i>[Signature]</i>	12/10/93			

PROJECT NO.	4515.94	MAP NO.	L-10, L-11	SHEET	12	OF	26
-------------	---------	---------	------------	-------	----	----	----


WILSON  
& COMPANY

WCEA #93-504



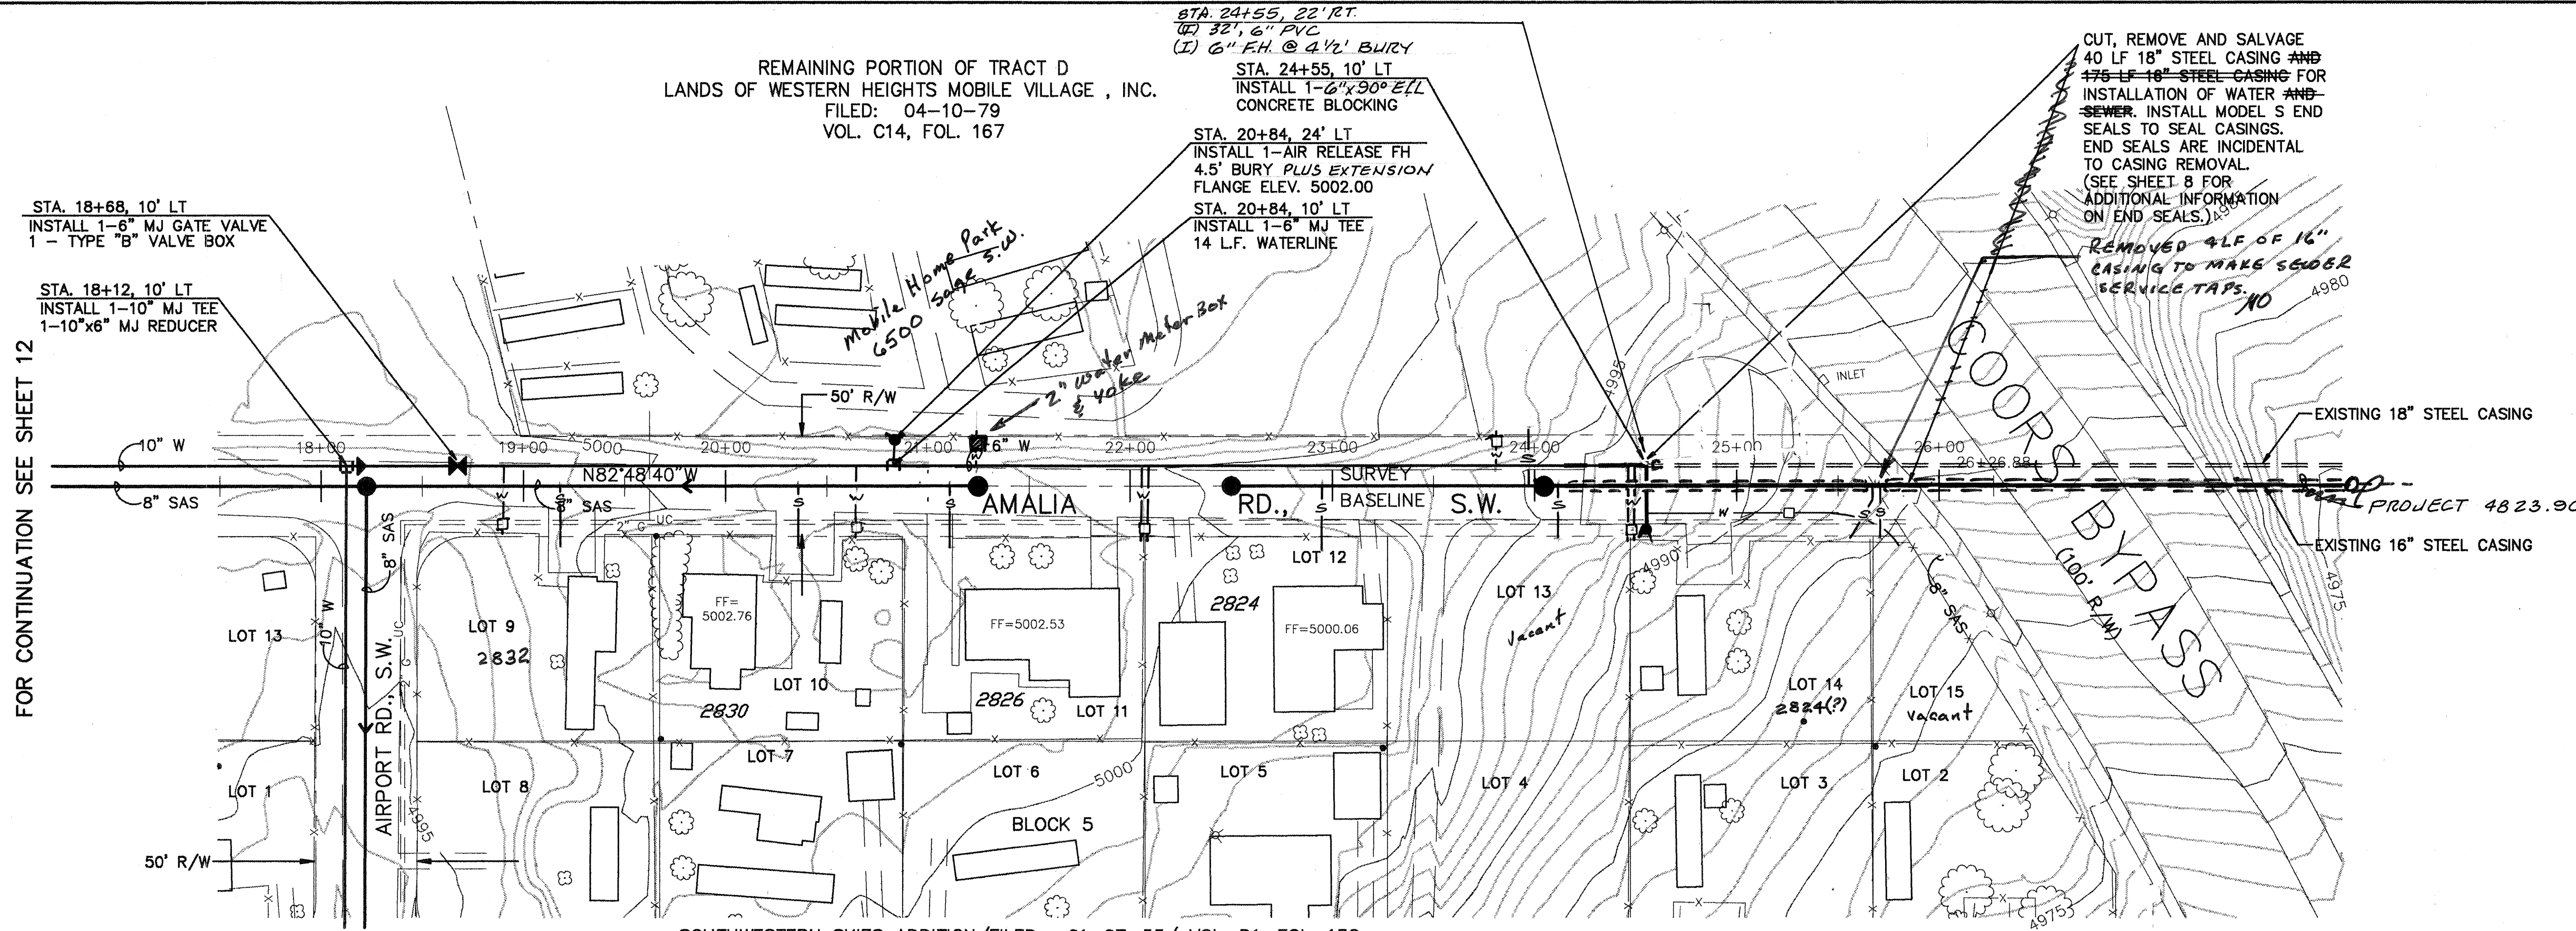

PLAN  
SCALE: 1"=50'  
PROFILE  
SCALE: 1"=5' HORIZ.  
1"=5' VERT.

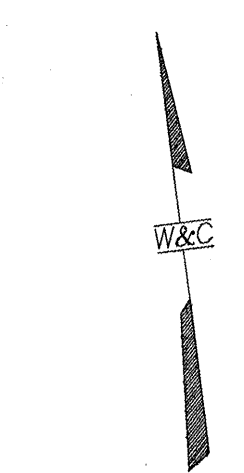

LEGEND

- NEW EXIST.
- SAS SANITARY SEWER
- W WATER LINE
- MH SANITARY SEWER MANHOLE
- WV WATER VALVE
- WM WATER METER
- FM FIRE HYDRANT
- TREE/SHRUB
- G GAS LINE
- SD STORM DRAIN
- UT UNDERGROUND TELEPHONE LINE
- UE UNDERGROUND ELECTRICAL LINE
- UC UNDERGROUND CABLE TV LINE


AS BUILT INFORMATION		BENCH MARKS		SURVEY INFORMATION		FIELD NOTES		ENGINEER'S SEAL		REVISIONS		NO. DATE		DESIGNED BY		DRAWN BY		CHECKED BY	
CONTRACTOR	DATE	WORK	DATE	NO.	BY	DATE	NO.	DATE	NO.	DATE	NO.	DATE	NO.	DATE	NO.	DATE	NO.	DATE	NO.
W.R. HALE	11/1/94	W.R. HALE	11/1/94																
INSPECTOR	DATE	ACCEPTANCE	DATE																
W.R. HALE	11/1/94	W.R. HALE	11/1/94																
VERIFICATION	DATE	VERIFICATION	DATE																
C.O.A.	11/1/94	C.O.A.	11/1/94																
CONTRACTED BY	DATE	CONTRACTED BY	DATE																
W.R. HALE	11/1/94	W.R. HALE	11/1/94																
RECORDED BY	DATE	RECORDED BY	DATE																
W.R. HALE	11/1/94	W.R. HALE	11/1/94																

FOR CONTINUATION SEE SHEET 12

SOUTHWESTERN SKIES ADDITION/FILED: 01-07-55/ VOL. D1, FOL. 132

FOR CONTINUATION SEE SHEET 10

AMALIA ROAD, S.W.

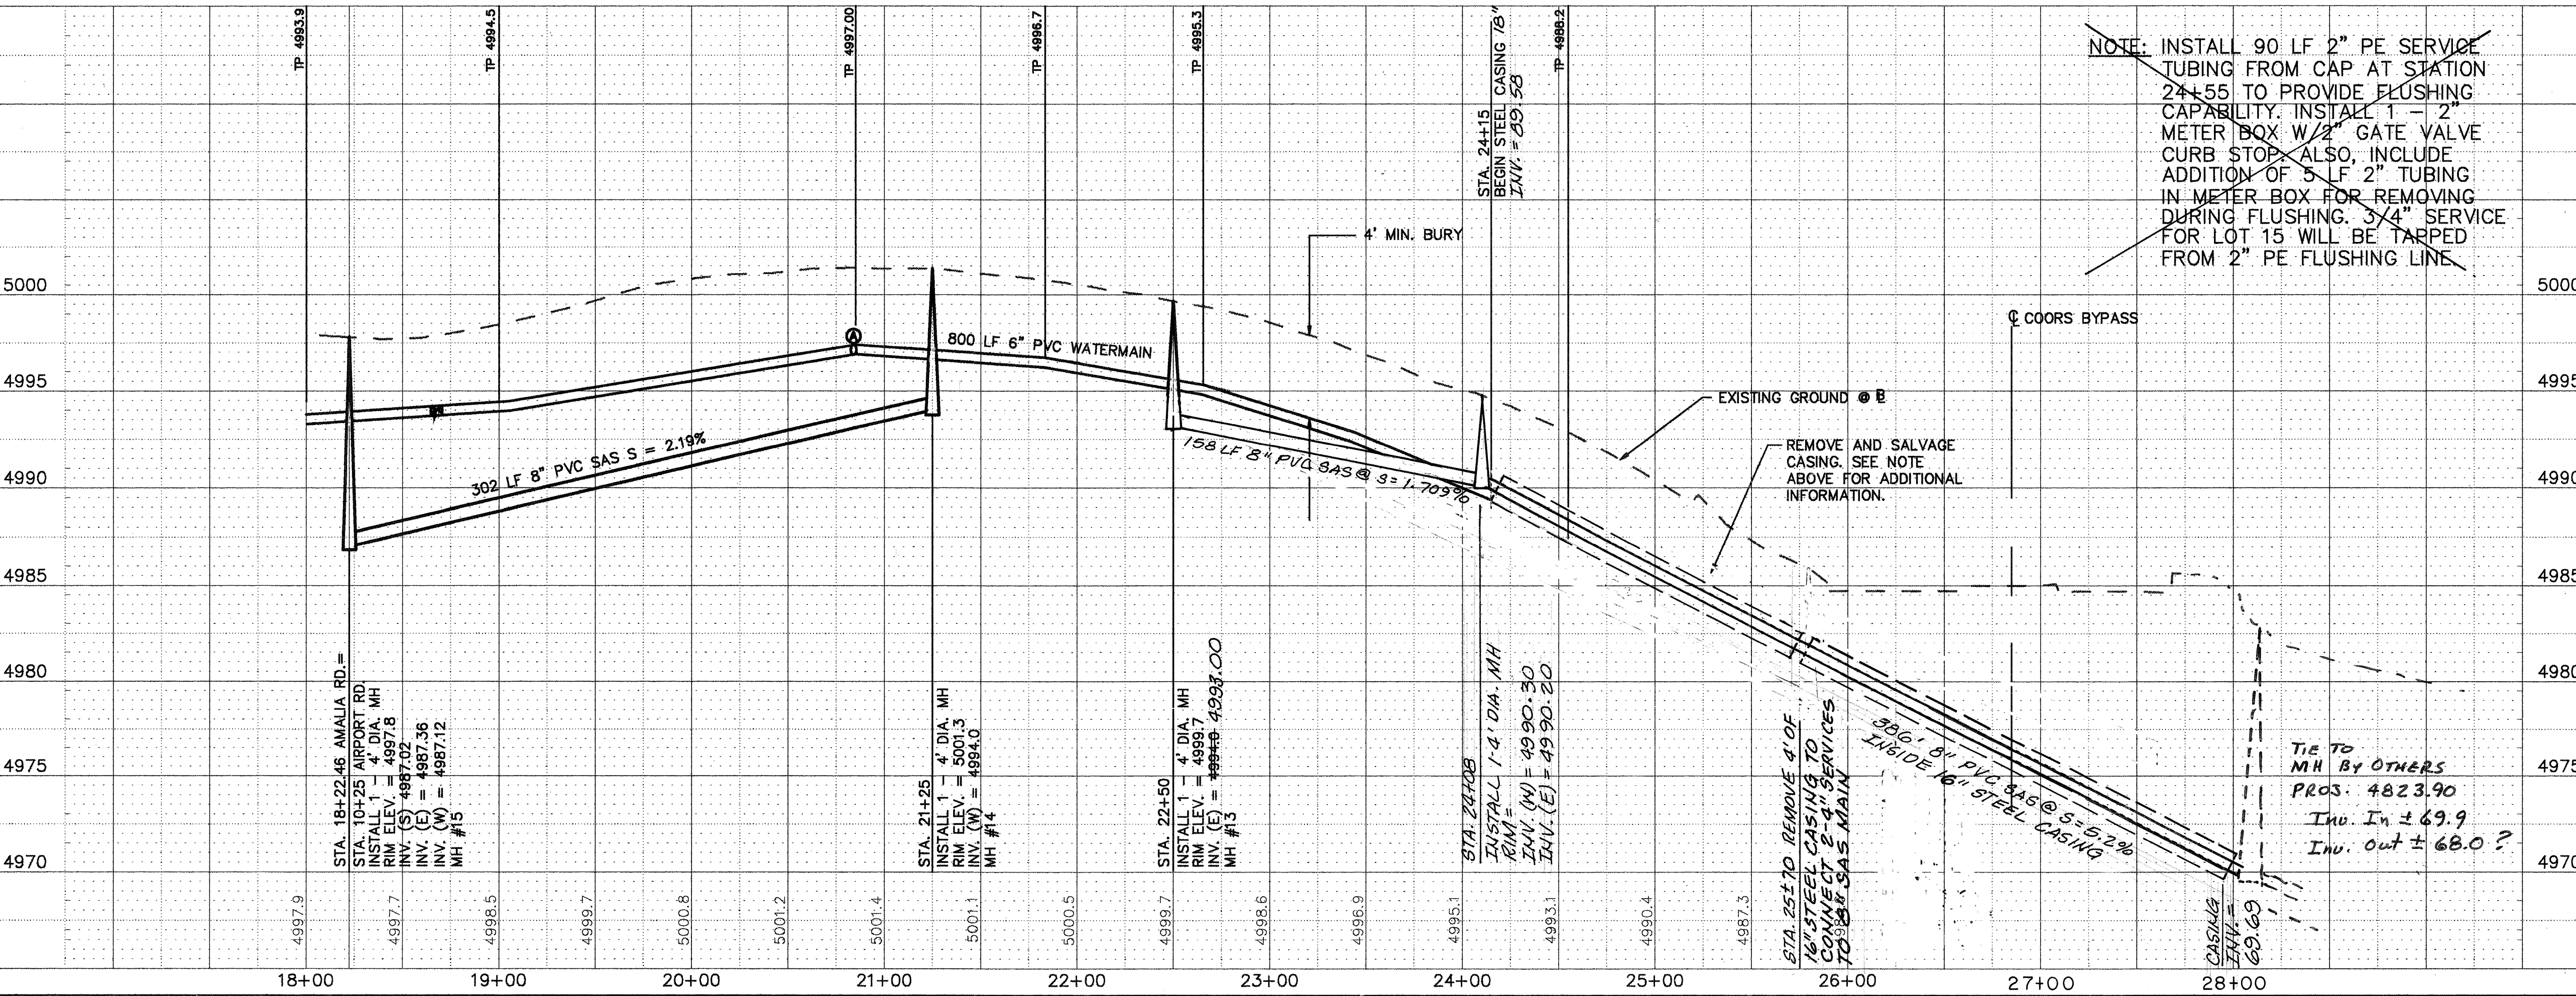

NOTE: INSTALL 90 LF 2" PE SERVICE TUBING FROM CAP AT STATION 24+55 TO PROVIDE FLUSHING CAPABILITY. INSTALL 1 - 2" METER BOX W/ 2" GATE VALVE CURB STOP. ALSO, INCLUDE ADDITION OF 5 LF 2" TUBING IN METER BOX FOR REMOVING DURING FLUSHING. 3/4" SERVICE FOR LOT 15 WILL BE TAPPED FROM 2" PE FLUSHING LINE.

SEWER SERVICES				
LOT	STATION	SIZE	LENGTH	INV. @ PL
9	19+18	4"	30'	5'
10	20+36	4"	30'	5'
11	21+11	4"	30'	5'
12	22+95	4"	30'	5'
LT.	23+97	4"	30'	5'
13	24+11	4"	25'	5'
14	26+68	4"	25'	3.5'
15	25+70	4"	25'	3.5'

WATER SERVICES			
LOT	STATION	SIZE	LENGTH
9	18+90	3/4"	
10	20+65	3/4"	
LT.	21+13	2"	
11	22+05		
12	22+05		
LT.	23+80	3/4"	
13	24+46		
14	24+46		
15	24+55	3/4"	

CITY OF ALBUQUERQUE  
PUBLIC WORKS DEPARTMENT  
ENGINEERING GROUP

TITLE: AMALIA ROAD, S.W.  
SOUTH VALLEY WATER AND SEWER  
SYSTEM IMPROVEMENT PROJECT

APPROVALS	ENGINEER	DATE	APPROVALS	ENGINEER	DATE
DRC CHAIRMAN	W.R. HALE	12/13/93	WATER	W.R. HALE	12/13/93
TRANSPORTATION	W.R. HALE	12/13/93	WASTE WATER	W.R. HALE	12/13/93
HYDROLOGY	W.R. HALE	12/13/93			

PROJECT NO. 4515.94 MAP NO. L-10, L-11 SHEET 13 OF 26

WILSON  
& COMPANY

WCEA #93-504




FOR CONTINUATION SEE SHEET 18



SOUTHWESTERN SKIES ADDITION/FILED: 01-07-55/VOLUME D1, FOLIO 132


FOR CONTINUATION SEE SHEET 18

BLANDFORD ROAD, S.W.

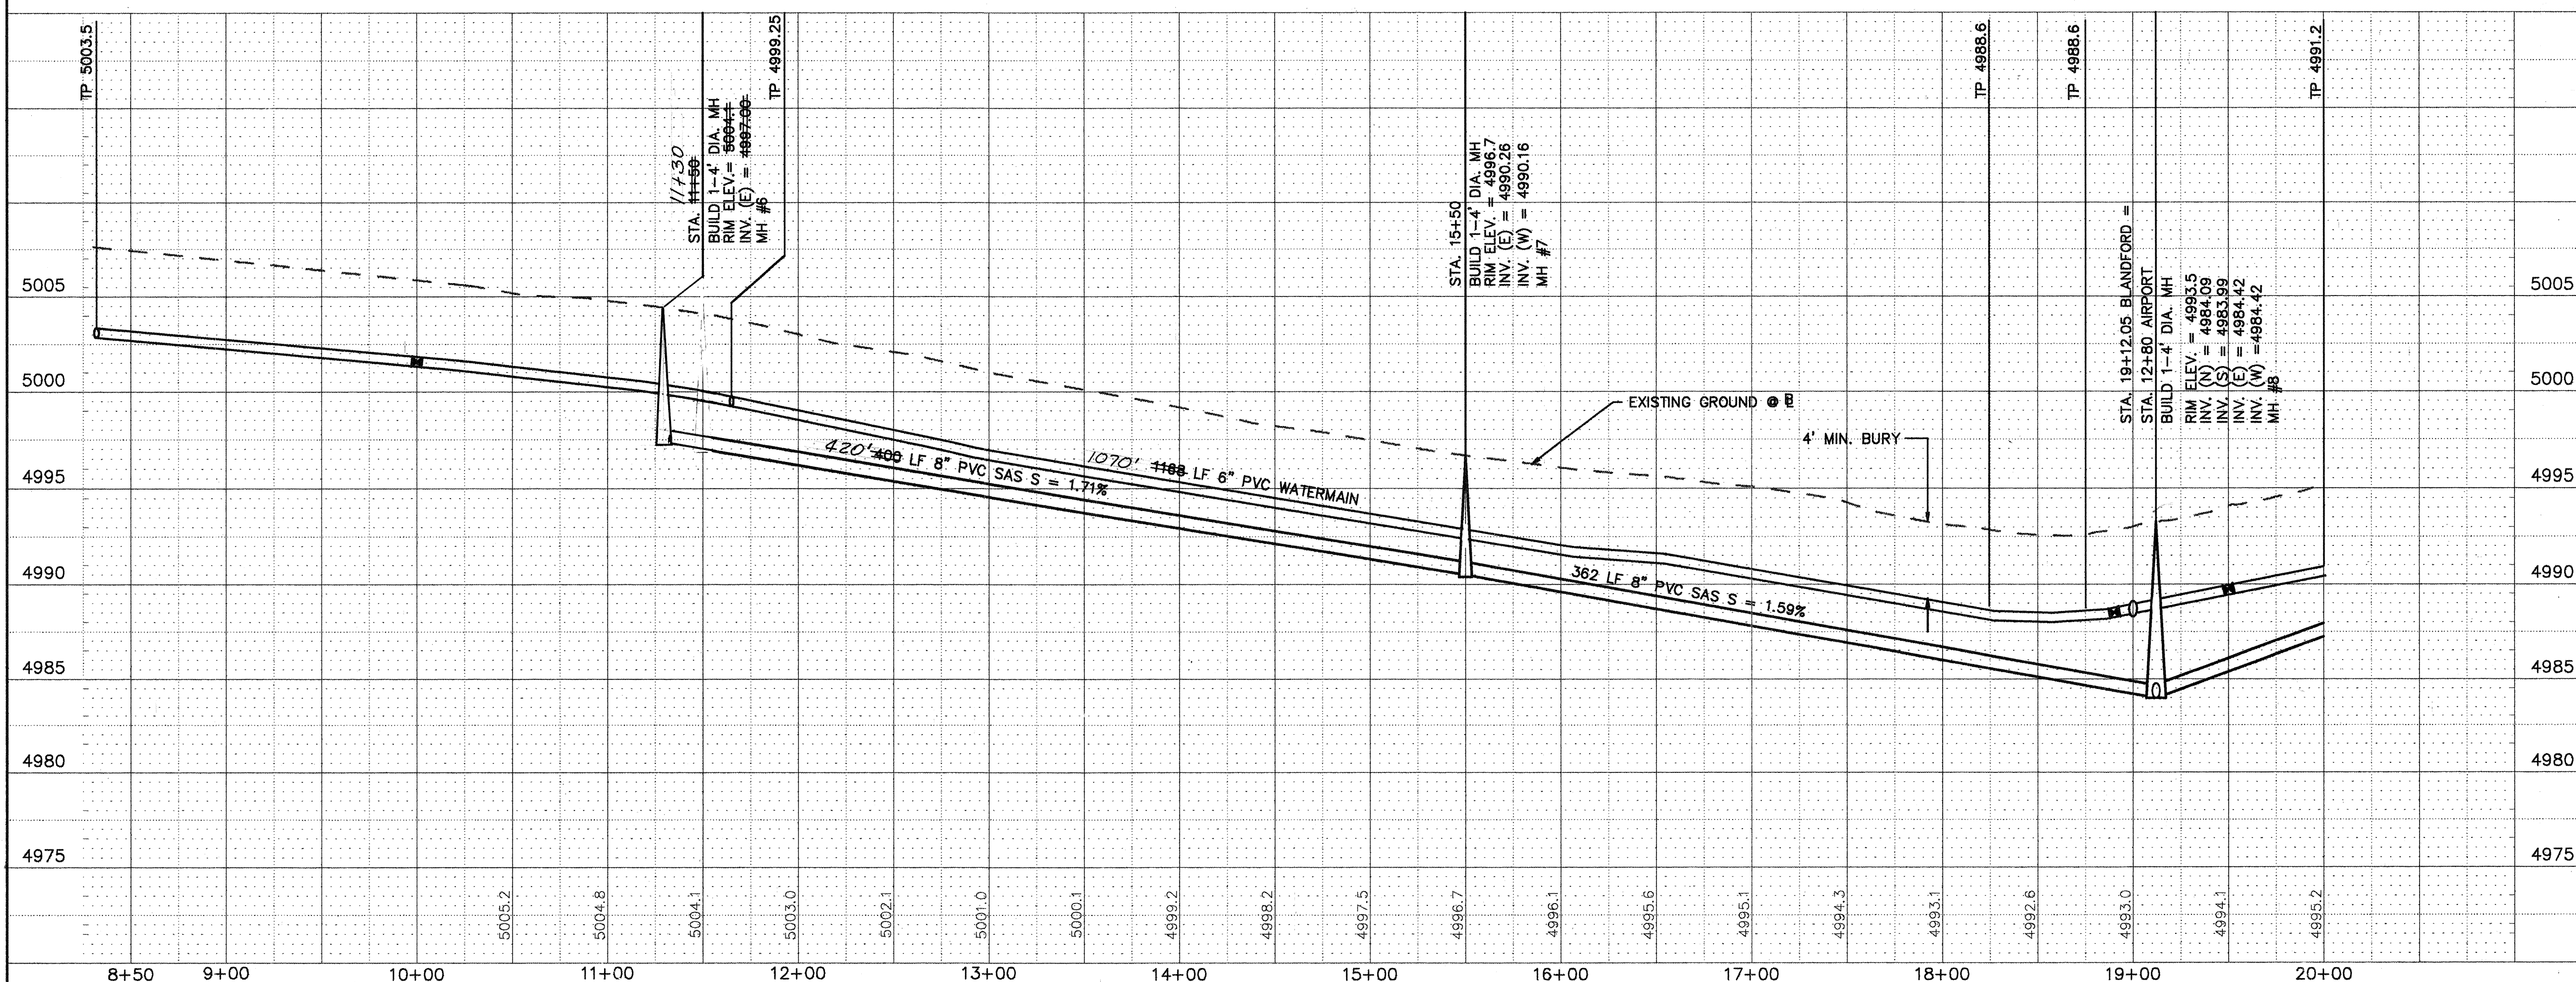

W.

### LEGEND

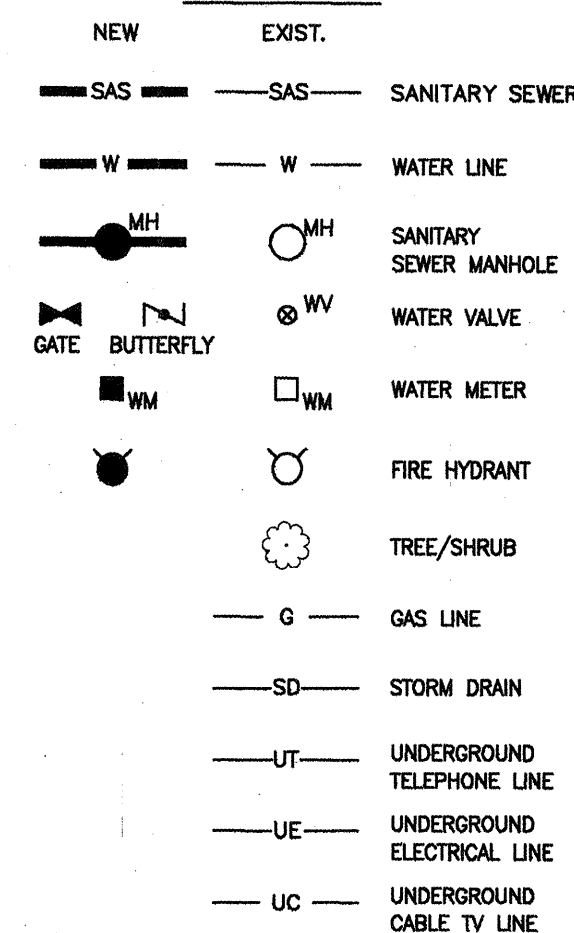

SEWER SERVICES				
LOT	STATION	SIZE	LENGTH	INV. ● PL
2	17+52	4"	25'	5'
3	18+53	4"	25'	5'
4	14+73	4"	25'	5'
5	13+15	4"	25'	5'
6	12+90	4"	25'	5'
7	17+36	4"		
9	11+68	4"	25'	5'
10	12+40	4"	25'	5'
11	14+06	4"	25'	5'
12	14+29	4"	25'	5'
13	16+11	4'	25'	5'
14	17+31	4'	25'	5'
15	17+97	4'	25'	5'

[illegible]

CITY OF ALBUQUERQUE  
PUBLIC WORKS DEPARTMENT  
ENGINEERING GROUP

TITLE: **BLANDFORD ROAD, S.W.**  
**SOUTH VALLEY WATER AND SEWER**  
**SYSTEM IMPROVEMENT PROJECT**

APPROVALS	ENGINEER	DATE	APPROVALS	ENGINEER	DATE
DRC CHAIRMAN	<i>B. J. Gendley</i>	12/13/93	WATER	<i>William</i>	12/10/93
TRANSPORTATION	<i>N/A C.H.D.</i>	12/10/93	WASTE WATER		
HYDROLOGY	<i>N/A J.H.</i>	12/10/93			

PROJECT NO.	4515.94	MAP NO.	L-10, L-11	SHEET	14	OF	26
-------------	---------	---------	------------	-------	----	----	----

**WILSON**  
**& COMPANY**


WCEA #93-50



FOR CONTINUATION SEE SHEET 18

SOUTHWESTERN SKIES ADDITION/FILED: 01-07-55/VOL. D1, FOL. 132

FOR CONTINUATION SEE SHEET 14

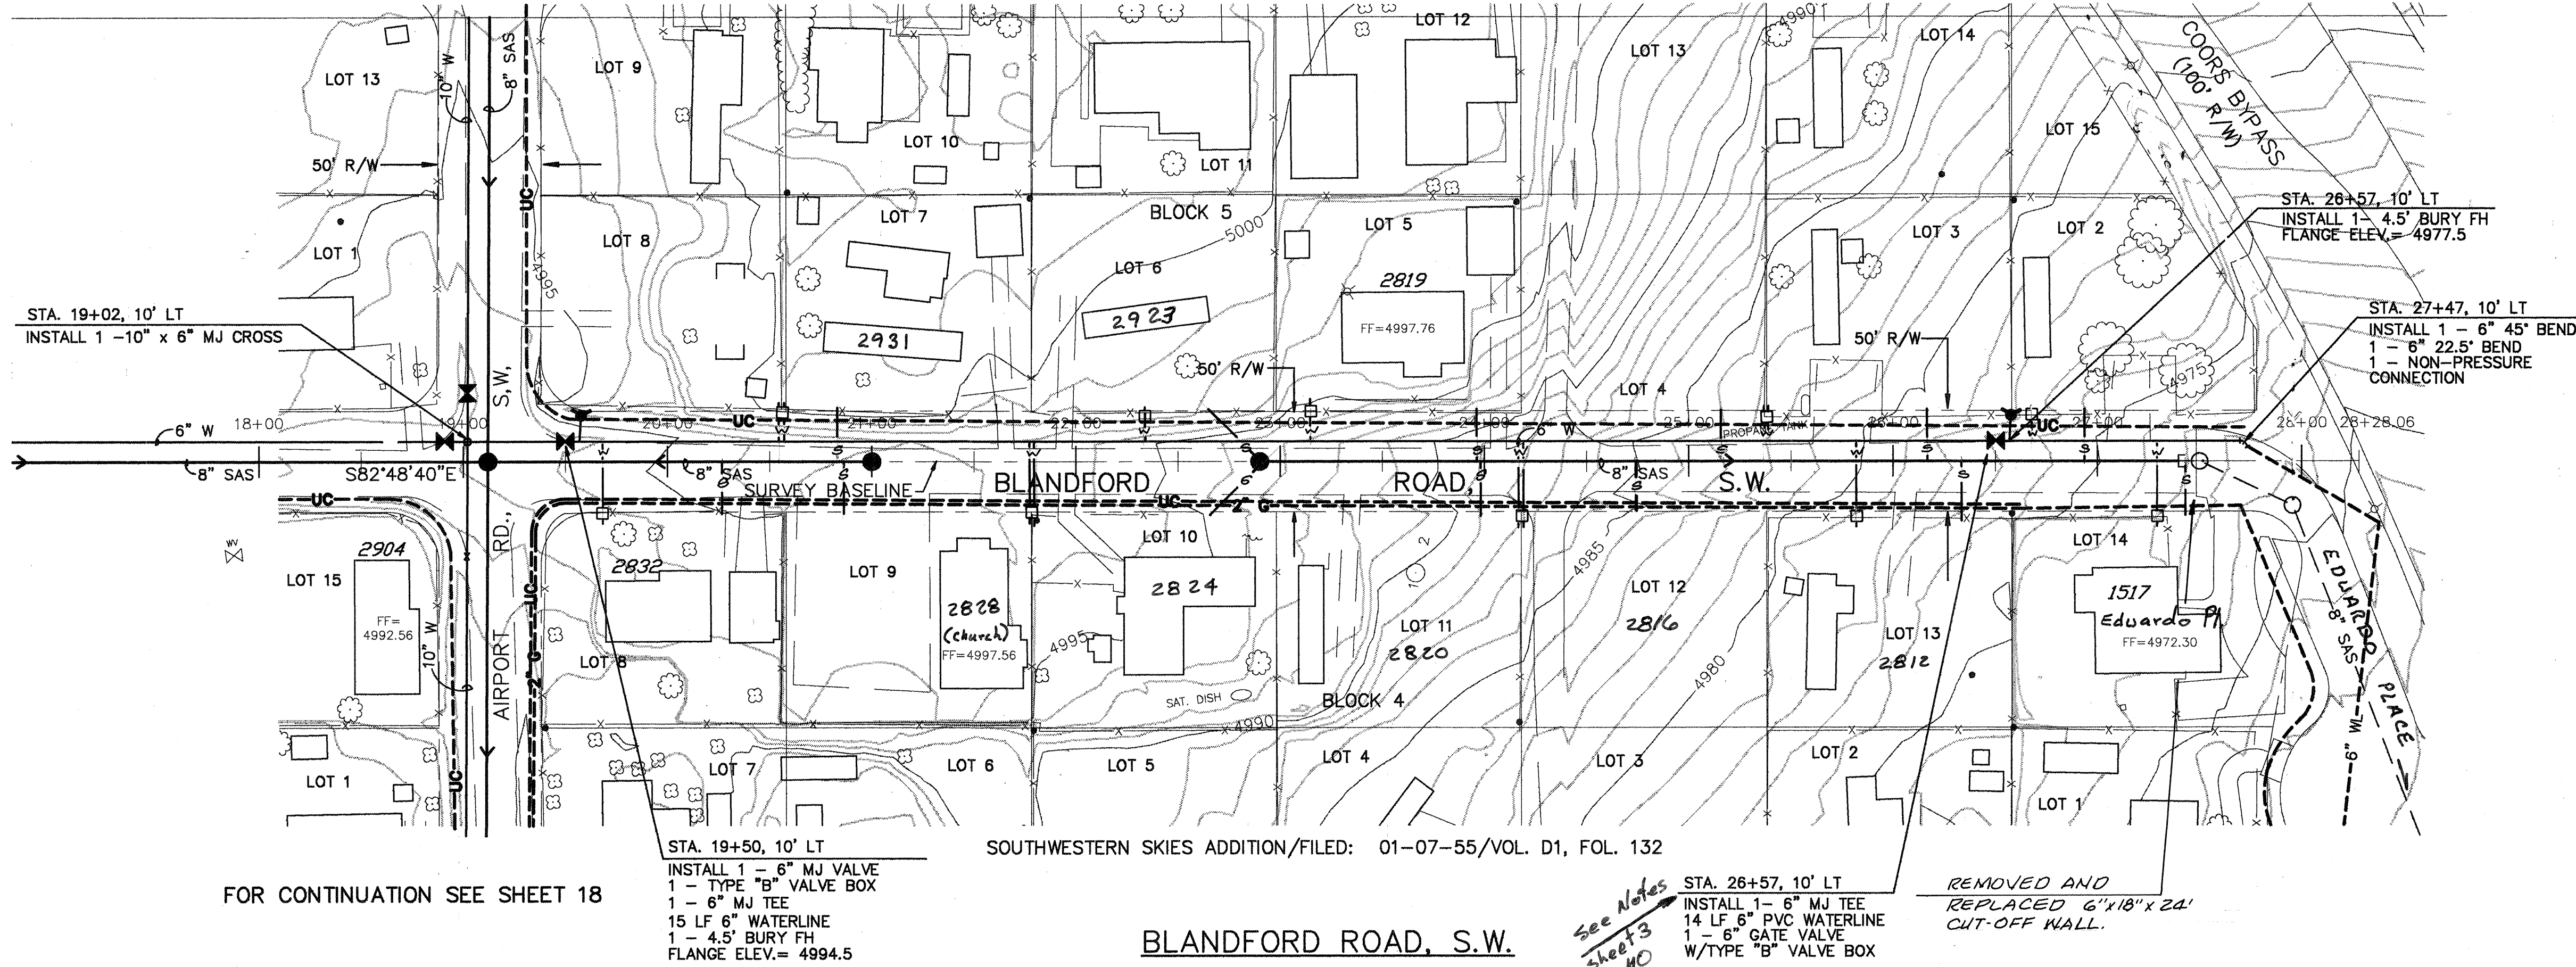

FOR CONTINUATION SEE SHEET 18

SOUTHWESTERN SKIES ADDITION/FILED: 01-07-55/VOL. D1, FOL. 132

BLANDFORD ROAD, S.W.

See Notes sheet 3 NO

PLAN  
SCALE: 1"=50'  
PROFILE  
SCALE: 1"=50' HORIZ.  
1"=5' VERT.

LEGEND

- NEW EXIST.
- SAS - SANITARY SEWER
- W - WATER LINE
- MH - SANITARY SEWER MANHOLE
- WV - WATER VALVE
- WM - WATER METER
- FM - FIRE HYDRANT
- TS - TREE/SHRUB
- G - GAS LINE
- SD - STORM DRAIN
- UT - UNDERGROUND TELEPHONE LINE
- UE - UNDERGROUND ELECTRICAL LINE
- UC - UNDERGROUND CABLE TV LINE

SEWER SERVICES					
LOT	STATION	SIZE	LENGTH	INV.	PL
2	26+93	4"	25'	4'-6"	
3	26+10	4"	25'	4'-6"	
4	25+10	4"	25'	4'-6"	
5	23+85	4"	25'	4'-6"	
6	22+90	4"	25'	4'-6"	
7	20+83	4"	25'	5'	
8	SERVICE FROM AIRPORT RD.				
8(S)	20+27	4"	25'	5'	
9	20+80	4"	25'	5'	
10	22+90	4"	28'	5'	
11	23+99	4"	28'	5'	
12	24+73	4"	28'	4'-6"	
13	23+33	4"	28'	4'-6"	
14	27+43	4"	28'	4'-6"	

WATER SERVICES			
LOT	STATION	SIZE	LENGTH
2	26+67	3/4"	
3	25+38		
4	25+38		
5	23+14	3/4"	
6	22+33	3/4"	
7	20+56		
8	20+56		
8(S)	19+69	3/4"	
9	21+79		
10	21+79		
11	24+19		
12	24+19		
13	25+82	3/4"	
14	27+29	3/4"	

AS BUILT INFORMATION  
CONTRACTOR: J.R. HALE  
DATE: 11/94  
INSPECTOR: L.R. HALE  
DATE: 11/94  
FIELD VERIFICATION: A. OSTAPACK  
DATE: 11/94  
CORRECTION: C.O.A.  
DATE: 11/94  
CORRECTION: WILSON CO.  
DATE: 11/94  
MICRO-FILM INFORMATION  
RECORDED BY: [Signature]  
DATE: [Blank]  
NO. [Blank]

BENCH MARKS  
BENCHMARK USED IS A STANDARD ACS BRASS CAP STAMPED  
"ACS 45-7A, 1976" LOCATED 42.3' WEST OF THE INTERSECTION OF  
S. COORS RD. & BLAKE RD., S.W. ELEV. = 4953.487  
TBM IS A 5/8" BAR W/CAP STAMPED "PANEL PT. 14" SET AT THE  
W. END OF EDUARDO ROAD, S.W. ELEV. = 5004.94

SURVEY INFORMATION  
FIELD NOTES  
DATE: [Blank]  
BY: [Blank]  
NO. [Blank]

ENGINEER'S SEAL  
[Seal]



REVISIONS  
NO. DATE  
1 11/94  
2 11/94  
CITY OF ALBUQUERQUE  
PUBLIC WORKS DEPARTMENT  
ENGINEERING GROUP  
TITLE: BLANDFORD ROAD, S.W.  
SOUTH VALLEY WATER AND SEWER  
SYSTEM IMPROVEMENT PROJECT  
APPROVALS: [Signatures]  
ENGINEER: [Signature]  
DATE: 12-13-93  
WATER  
WASTE WATER  
HYDROLOGY  
PROJECT NO. 4515.94  
MAP NO. L-10, L-11  
SHEET 15 OF 26

WILSON & COMPANY

WCEA #93-504



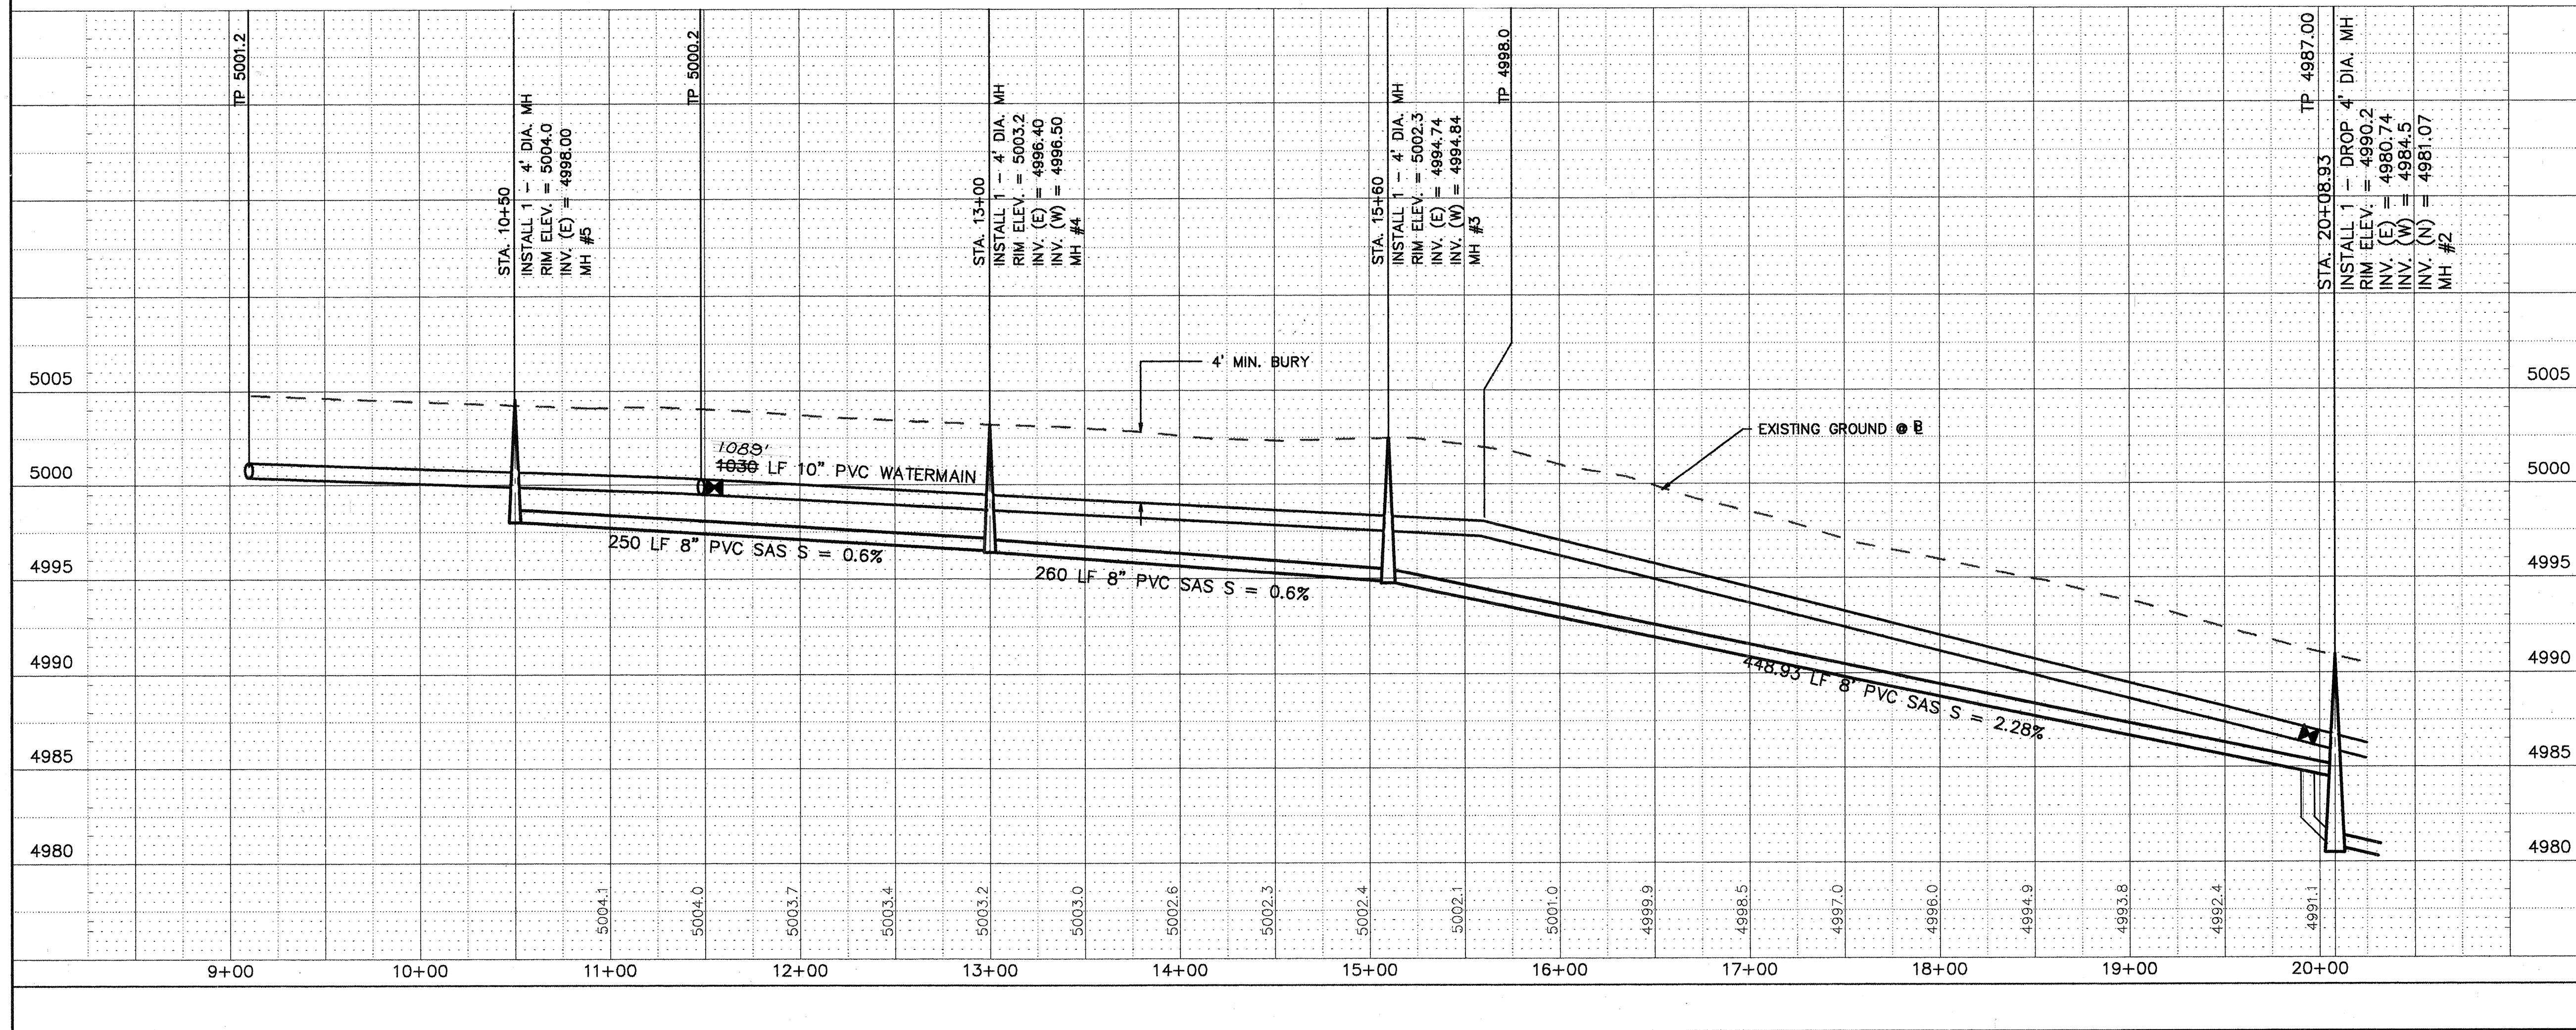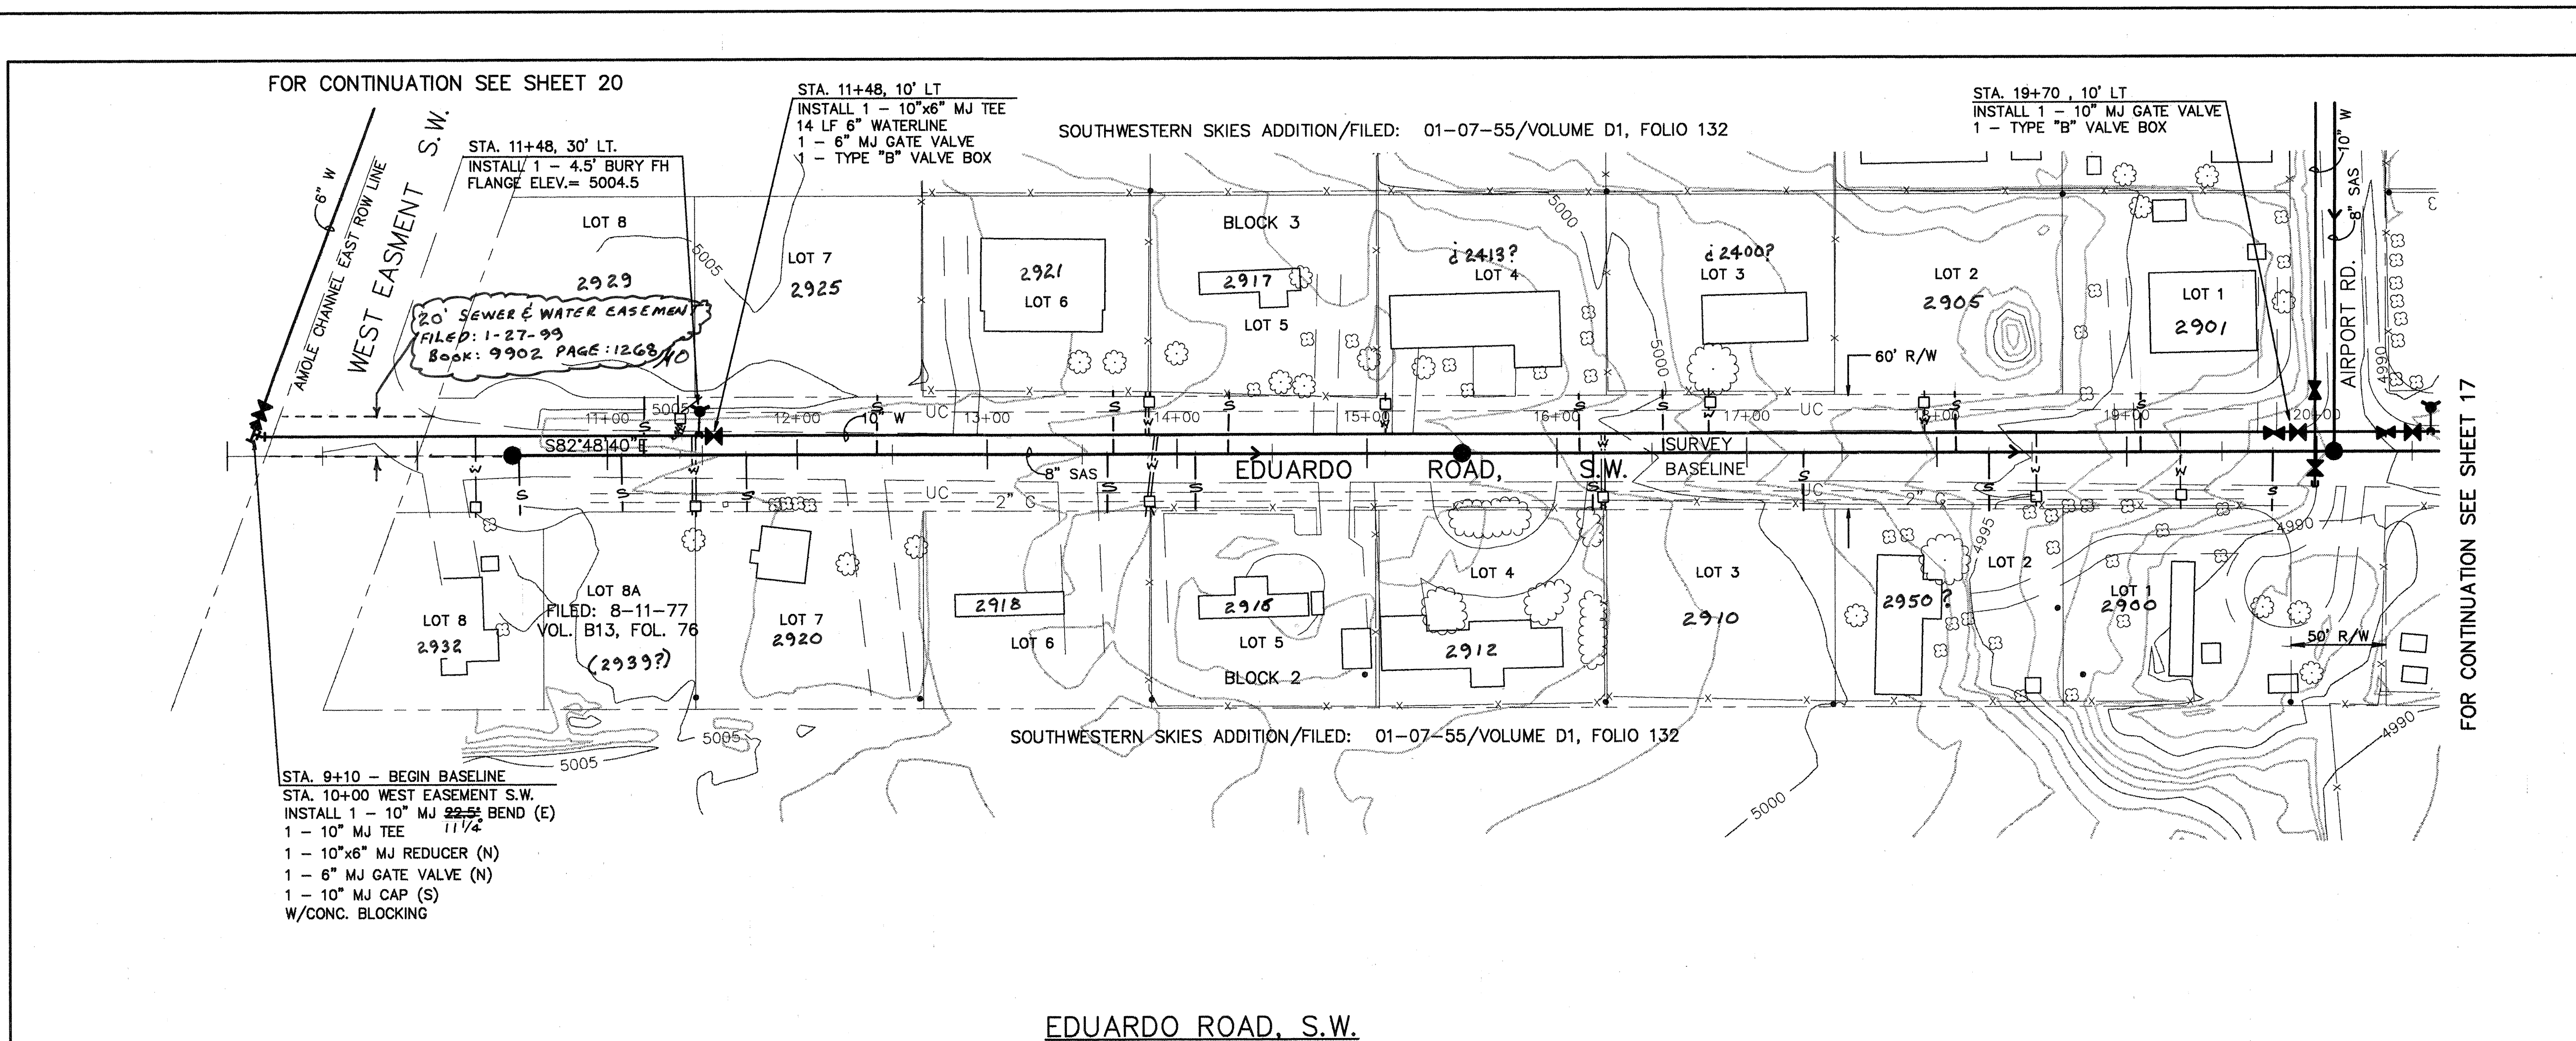

PLAN  
SCALE: 1"=50'  
PROFILE  
SCALE: 1"=50' VERT.

LEGEND

- NEW EXIST.
- SAS - SANITARY SEWER  
W - WATER LINE  
MH - SANITARY SEWER MANHOLE  
GATE BUTTERFLY  
WM - WATER METER  
FIRE HYDRANT  
TREE/SHRUB  
G - GAS LINE  
SD - STORM DRAIN  
UT - UNDERGROUND TELEPHONE LINE  
UE - UNDERGROUND ELECTRICAL LINE  
UC - UNDERGROUND CABLE TV LINE

SEWER SERVICES

LOT	STATION	SIZE	LENGTH	INV. @ PL
1	19+07	4"	30'	5'
2	18+09	4"	30'	5'
3	16+56	4"	30'	5'
4	16+12	4"	30'	5'
5	14+24	4"	30'	5'
6	13+65	4"	30'	5'
7	12+41	4"	30'	5'
8	11+13	4"	30'	5'
1(S)	19+70	4"	30'	5'
2(S)	18+27	4"	30'	5'
3(S)	17+30	4"	30'	5'
4(S)	16+19	4"	30'	5'
5(S)	14+09	4"	30'	5'
6(S)	13+62	4"	30'	5'
7(S)	11+72	4"	30'	5'
8(S)	10+53	4"	30'	5'
8A(S)	11+07	4"	30'	5'

WATER SERVICES

LOT	STATION	SIZE	LENGTH
1			
2	17+95	3/4"	
3	16+81	3/4"	
4	15+09	3/4"	
5	13+85	3/4"	
6	13+85	3/4"	
7	11+38	3/4"	
8	11+38	3/4"	
1(S)	19+28	3/4"	
2(S)	18+53	3/4"	
3(S)	16+24	3/4"	
4(S)	16+24	3/4"	
5(S)	13+86	3/4"	
6(S)	13+86	3/4"	
7(S)	11+45	3/4"	
8(S)	10+31	3/4"	
8A(S)	11+45	3/4"	

CITY OF ALBUQUERQUE  
PUBLIC WORKS DEPARTMENT  
ENGINEERING GROUP

TITLE: EDUARDO ROAD, S.W.  
SOUTH VALLEY WATER AND SEWER  
SYSTEM IMPROVEMENT PROJECT

APPROVALS	ENGINEER	DATE	APPROVALS	ENGINEER	DATE
DRS CHAIRMAN	A. J. Anderson	12-13-93	WATER		
TRANSPORTATION	N/A RWD	12-10-93	WASTE WATER		
HYDROLOGY	N/A JAC	12-10-93			

PROJECT NO. 4515.94 MAP NO. L-10, L-11 SHEET 16 OF 26


WILSON  
& COMPANY

WCEA #93-504




FOR CONTINUATION SEE SHEET 18

SOUTHWESTERN SKIES ADDITION/FILED: 01-07-55/VOL. D1, FOL. 132

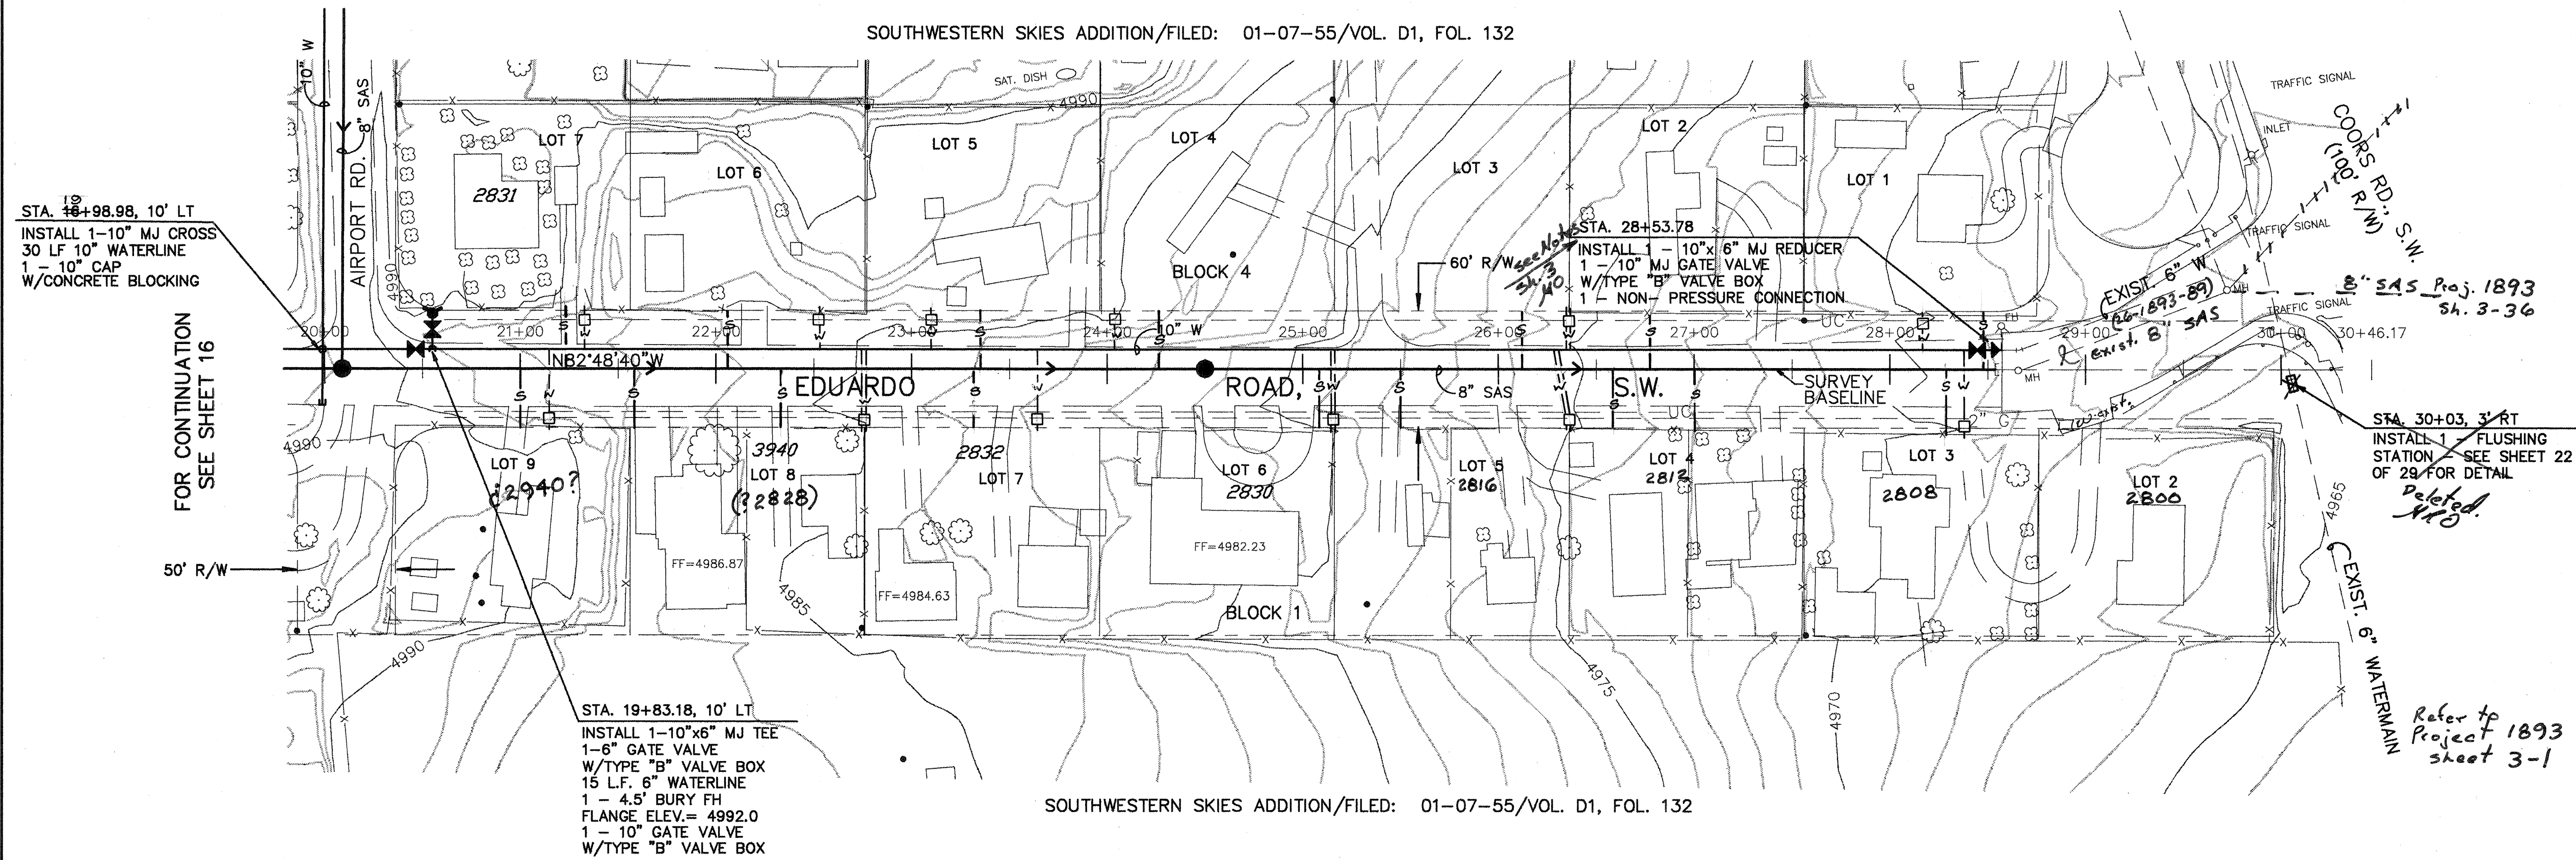

EDUARDO ROAD, S.W.

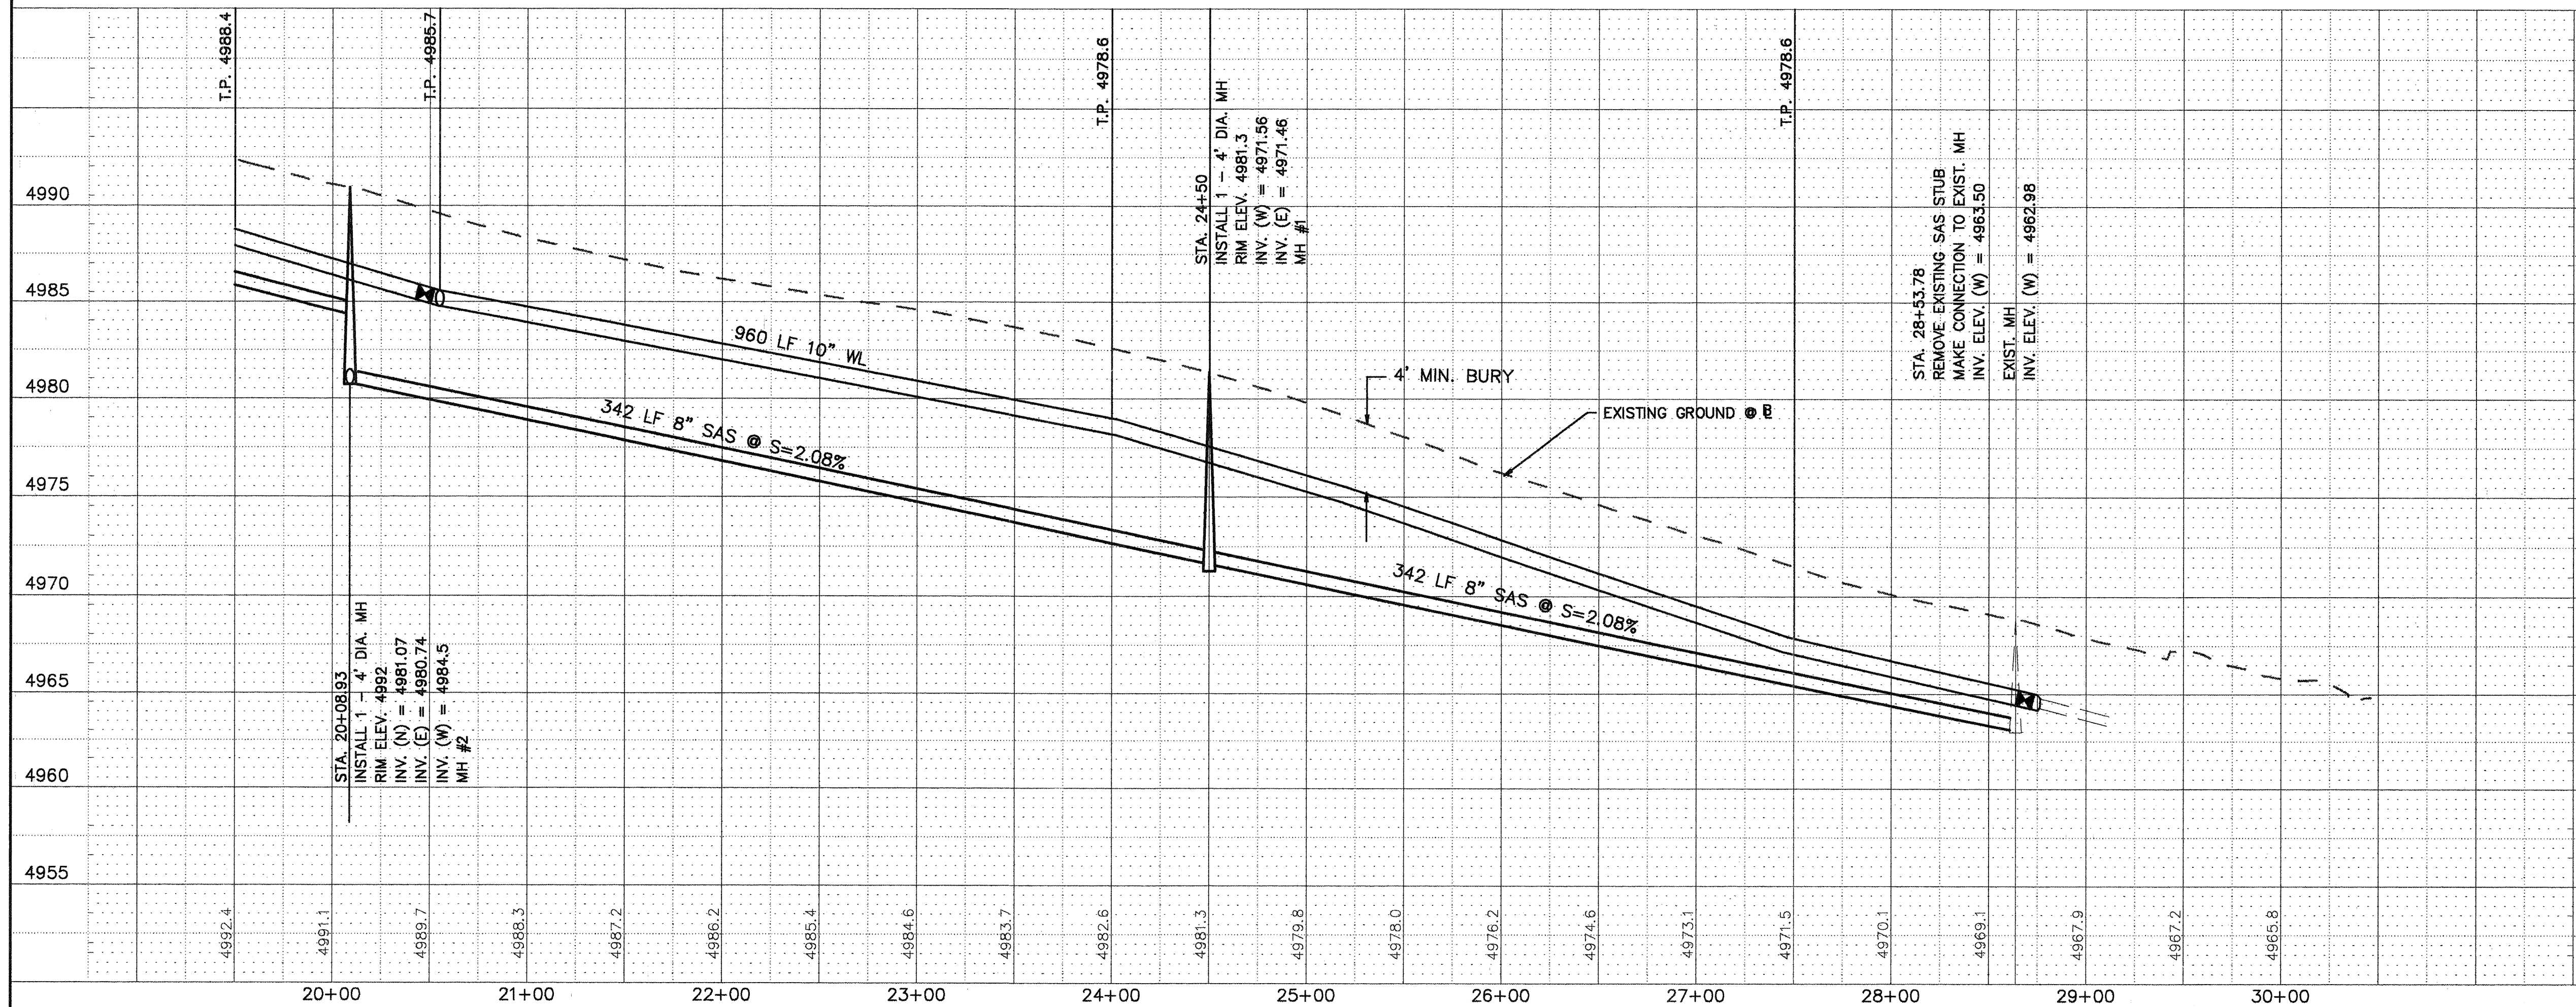

SEWER SERVICES				
LOT	STATION	SIZE	LENGTH	INV. @ PL
1	28+28	4"		
2	28+77	4"		
3	28+12	4"		
4	28+26	4"		
5	28+36	4"		
6	28+06	4"		
7	21+23	4"		
8(S)	21+58	4"		
4(S)	21+00	4"		
3(S)	28+28	4"		
4(S)	28+58	4"		
5(S)	28+50	4"		
6(S)	28+09	4"		
7(S)	28+32	4"		
8(S)	28+35	4"		
9(S)	21+00	4"		

WATER SERVICES			
LOT	STATION	SIZE	LENGTH
1	28+17	3/4"	EXISTING
2	28+35		
3	28+35		
4	28+04	3/4"	
5	28+10	3/4"	
6	28+63	3/4"	
7	21+33	3/4"	
2(S)			
3(S)	28+38	3/4"	EXISTING
4(S)	28+35		
5(S)	28+35		
5(S)	28+16		
7(S)	28+64	3/4"	
7(S)	28+76	3/4"	
9(S)	21+15	3/4"	


CITY OF ALBUQUERQUE PUBLIC WORKS DEPARTMENT ENGINEERING GROUP				
TITLE: EDUARDO ROAD, S.W. SOUTH VALLEY WATER AND SEWER SYSTEM IMPROVEMENT PROJECT				
APPROVALS	ENGINEER	DATE	APPROVALS	ENGINEER
DR. CHAIRMAN	B. J. Rodriguez	12-13-93	WATER	
TRANSPORTATION	N. P. RHO	12-10-93	WASTE WATER	
HYDROLOGY	N. P. RHO	12-10-93		
DESIGNED BY	JMS	DATE	NOV. 1993	
DRAWN BY	PAS	DATE	NOV. 1993	
CHECKED BY	WFZ	DATE	NOV. 1993	

PROJECT NO.	4515.94	MAP NO.	L-10, L-11	SHEET	17 OF 26
-------------	---------	---------	------------	-------	----------

WILSON  
& COMPANY

WCEA #93-504



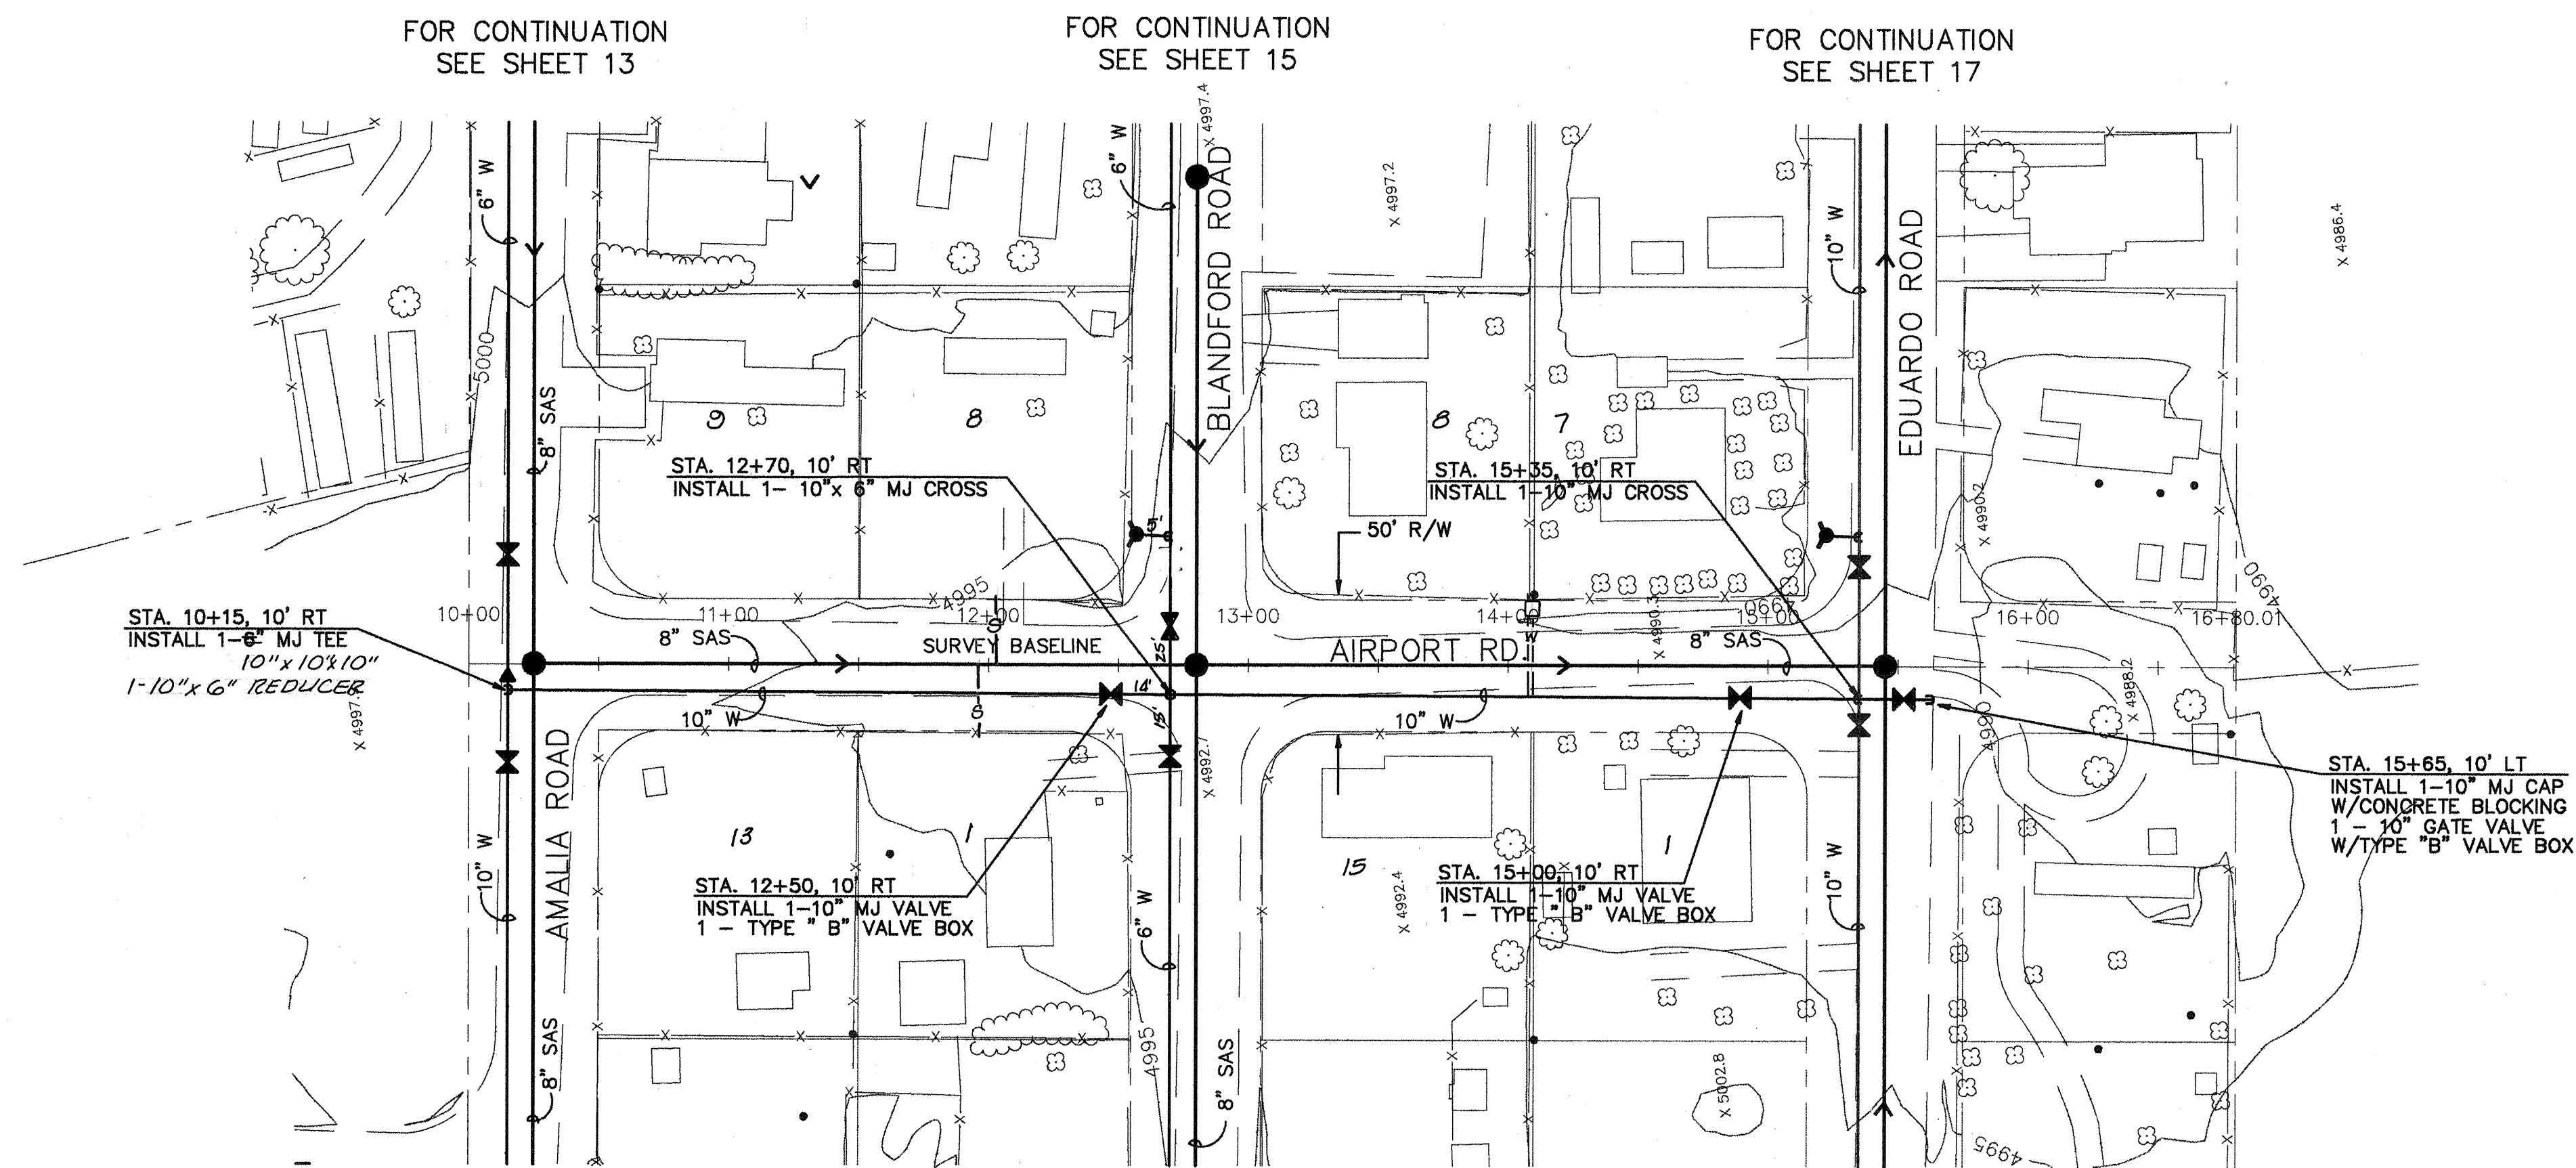


PLAN  
SCALE: 1"=50'  
PROFILE  
SCALE: 1"=5' HORIZ.  
1"=5' VERT.



FOR CONTINUATION  
SEE SHEET 12

FOR CONTINUATION  
SEE SHEET 14

FOR CONTINUATION  
SEE SHEET 16

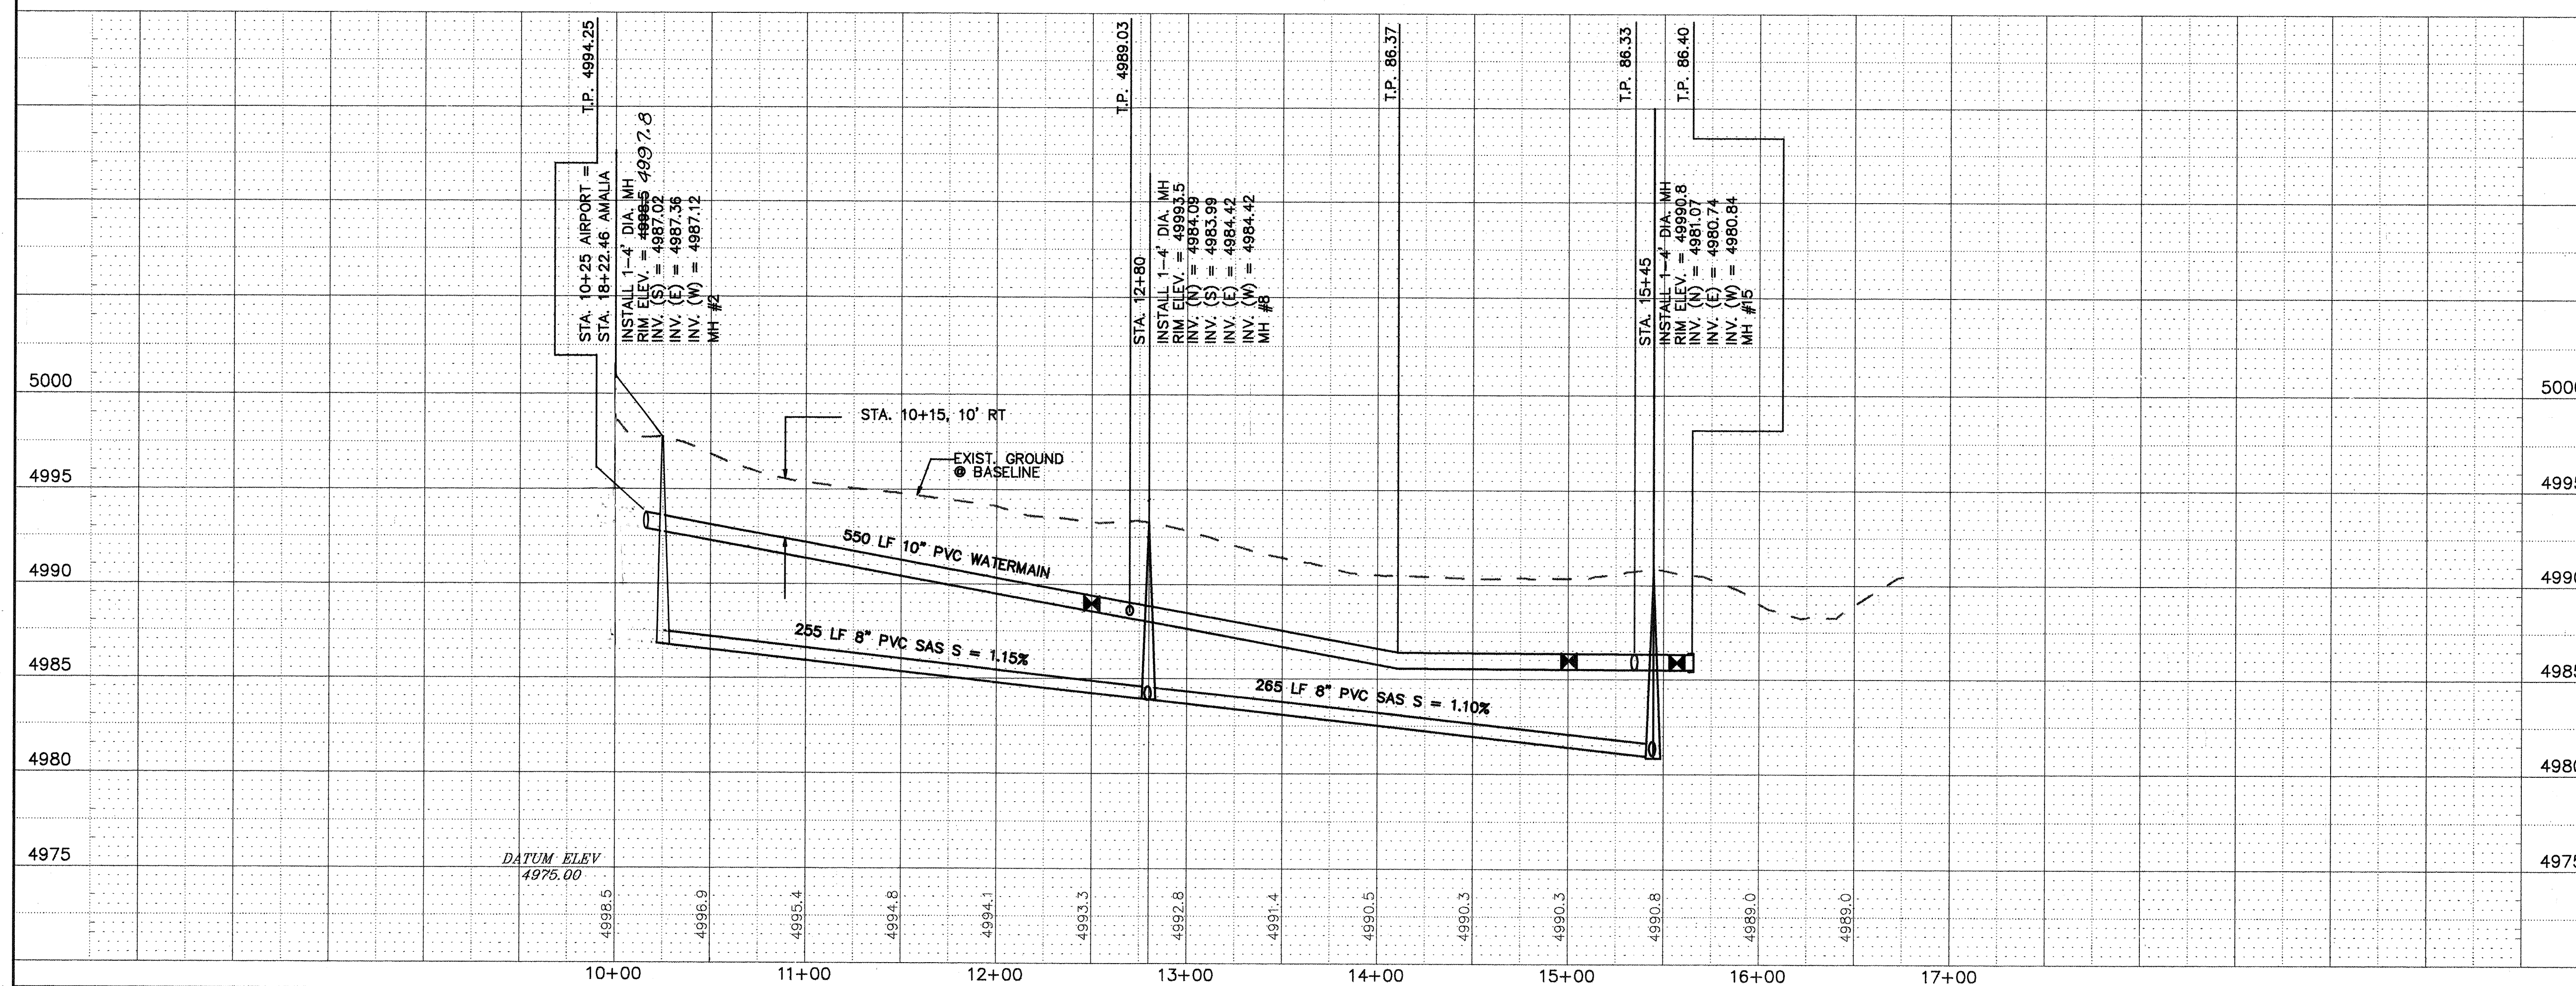


SEWER SERVICES				
LOT	STATION	SIZE	LENGTH	INV. @ PL
1	11+97	4"		
8	12+02	4"		

WATER SERVICES				
LOT	STATION	SIZE	LENGTH	
8	14+09			
7	14+09			

ENGINEER'S SEAL		SURVEY INFORMATION		BENCH MARKS		AS BUILT INFORMATION					
	REMARKS REVISIONS DESIGN JMS PAS WFL	NO. DATE 1 11/97 8 12/02	FIELD NOTES BY DATE NO. DATE	BENCHMARK USED IS A STANDARD ACS BRASS CAP STAMPED *ACS 45-7A, 1976 LOCATED 42.3' WEST OF THE INTERSECTION OF S. COORS RD. & BLAKE RD., S.W. ELEV.=4953.487 TBM #1 = PAINT SPOT AT TOP OF CURB @ S. CURB - END OF CURB ON EDUARDO RD., S.W. ELEV.=4988.27 TBM #2 = NE CORNER CONC. FENCE POST @ 3930 EDUARDO RD., S.W. ELEV.=4884.57	CONTRACTOR J.R. HALE DATE 11/94 WORK BY J.R. HALE DATE INSPECTOR'S VERIFICATION BY C.O.A. DATE DRAWINGS CORRECTED BY WILSON CO. DATE 11/94 MICRO-FILM INFORMATION RECORDED BY NO.	DATE	DATE				

CITY OF ALBUQUERQUE PUBLIC WORKS DEPARTMENT ENGINEERING GROUP					
TITLE: AIRPORT ROAD, S.W. SOUTH VALLEY WATER AND SEWER SYSTEM IMPROVEMENT PROJECT					
APPROVALS	ENGINEER	DATE	APPROVALS	ENGINEER	DATE
DRC CHAIRMAN	B.G. Keady	12/12/93	WATER		
TRANSPORTATION	N.R. Lugo	12/10/93	WASTE WATER		
HYDROLOGY	N.R. Lugo	12/10/93			
PROJECT NO.	4515.94	MAP NO.	K-12	SHEET	18 OF 26




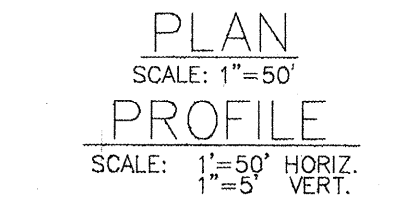

NEW	EXIST.	
— SAS —	— SAS —	C & G
— W —	— W —	SANITARY SEWER
— G —	— G —	WATER LINE
— SD —	— SD —	GAS LINE
	— UT —	STORM DRAIN
	— UE —	UNDERGROUND TELEPHONE LINE
	— CATV —	UNDERGROUND ELECTRICAL LINE
	— TC —	UNDERGROUND CABLE TV LINE
	— TR	TRAFFIC SIGNAL CONDUIT
	BOX	TELEPHONE BOX



NOTES:

1. SEE TRAFFIC CONTROL SHEETS FOR LANE CLOSURE ON THE GOORS BYPASS ROAD.
2. CONTRACTOR TO COORDINATE WITH OWNERS FOR BACKFILLING AND COMPACTING TRENCH FOR INSTALLATION OF SAS LINES.

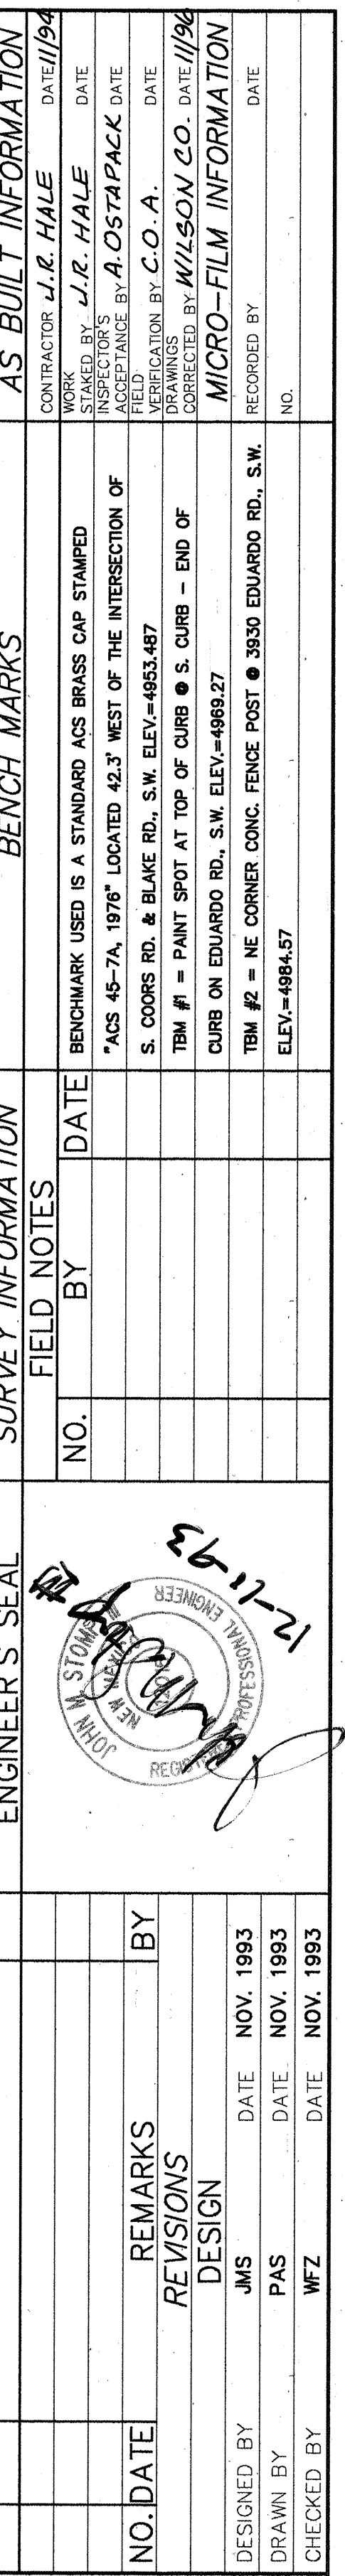

CITY OF ALBUQUERQUE PUBLIC WORKS DEPARTMENT ENGINEERING GROUP					
TITLE: COORS BYPASS-BLANDFORD COURT SOUTH VALLEY WATER AND SEWER SYSTEM IMPROVEMENT PROJECT					
APPROVALS	ENGINEER	DATE	APPROVALS	ENGINEER	DATE
DRC CHAIRMAN	<i>B. J. Santiago</i>	12-15-93	WATER	<i>M. L. Lina</i>	12/16/93
TRANSPORTATION	<i>N/A LHO</i>	12-10-93	WASTE WATER		
HYDROLOGY	<i>N/A JST</i>	12/10/93			
PROJECT NO. 4515.94		MAP NO. L-10, L-11		SHEET 19 OF 26	



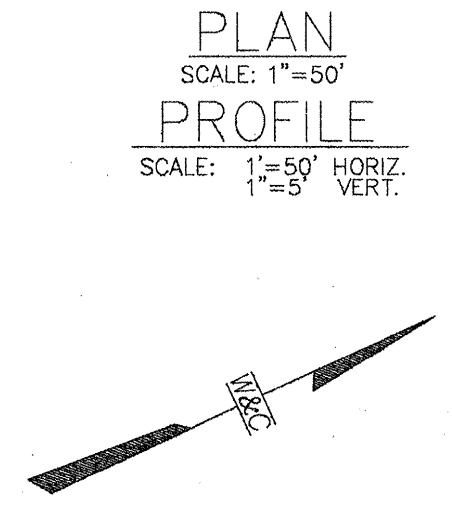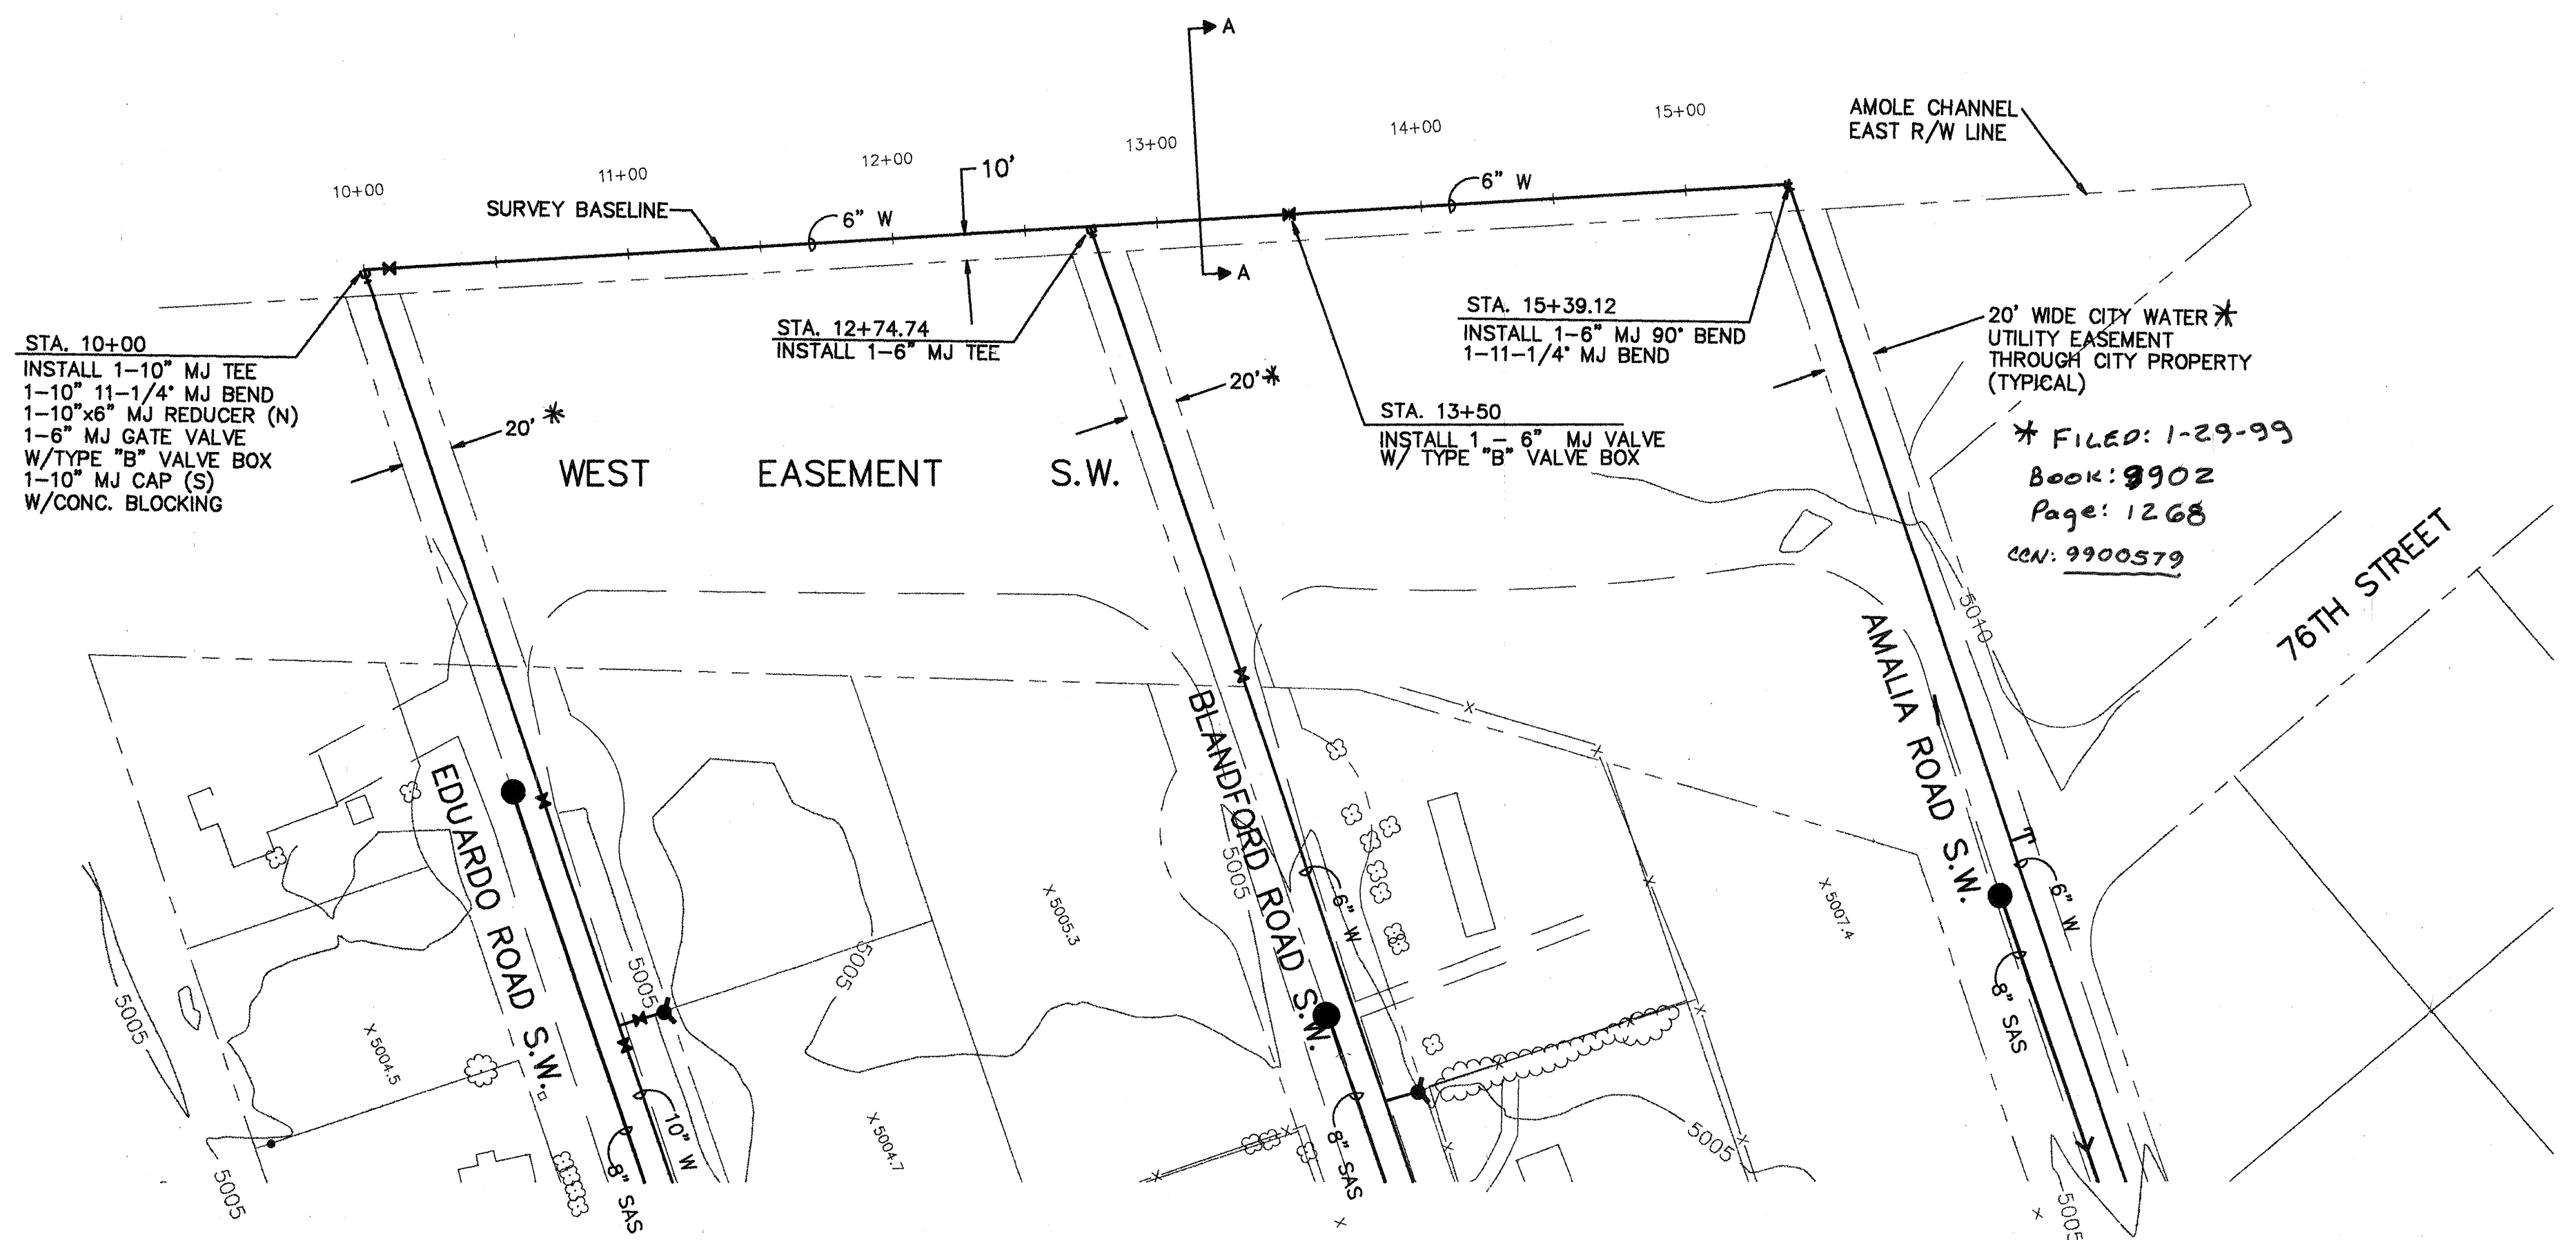



PLAN  
SCALE: 1"=50'

PROFILE  
SCALE: 1"=5' HORIZ.  
1"=5' VERT.

LEGEND

NEW	EXIST.	
— SAS —	— SAS —	C & G
— W —	— W —	SANITARY SEWER
— G —	— G —	WATER LINE
— SD —	— SD —	GAS LINE
— UT —	— UT —	STORM DRAIN
— UE —	— UE —	UNDERGROUND TELEPHONE LINE
— CATV —	— CATV —	UNDERGROUND ELECTRICAL LINE
— TC —	— TC —	UNDERGROUND CABLE TV LINE
— TR —	— TR —	TRAFFIC SIGNAL CONDUIT
		TELEPHONE BOX

FOR CONTINUATION SEE SHEET 16      FOR CONTINUATION SEE SHEET 14      FOR CONTINUATION SEE SHEET 12

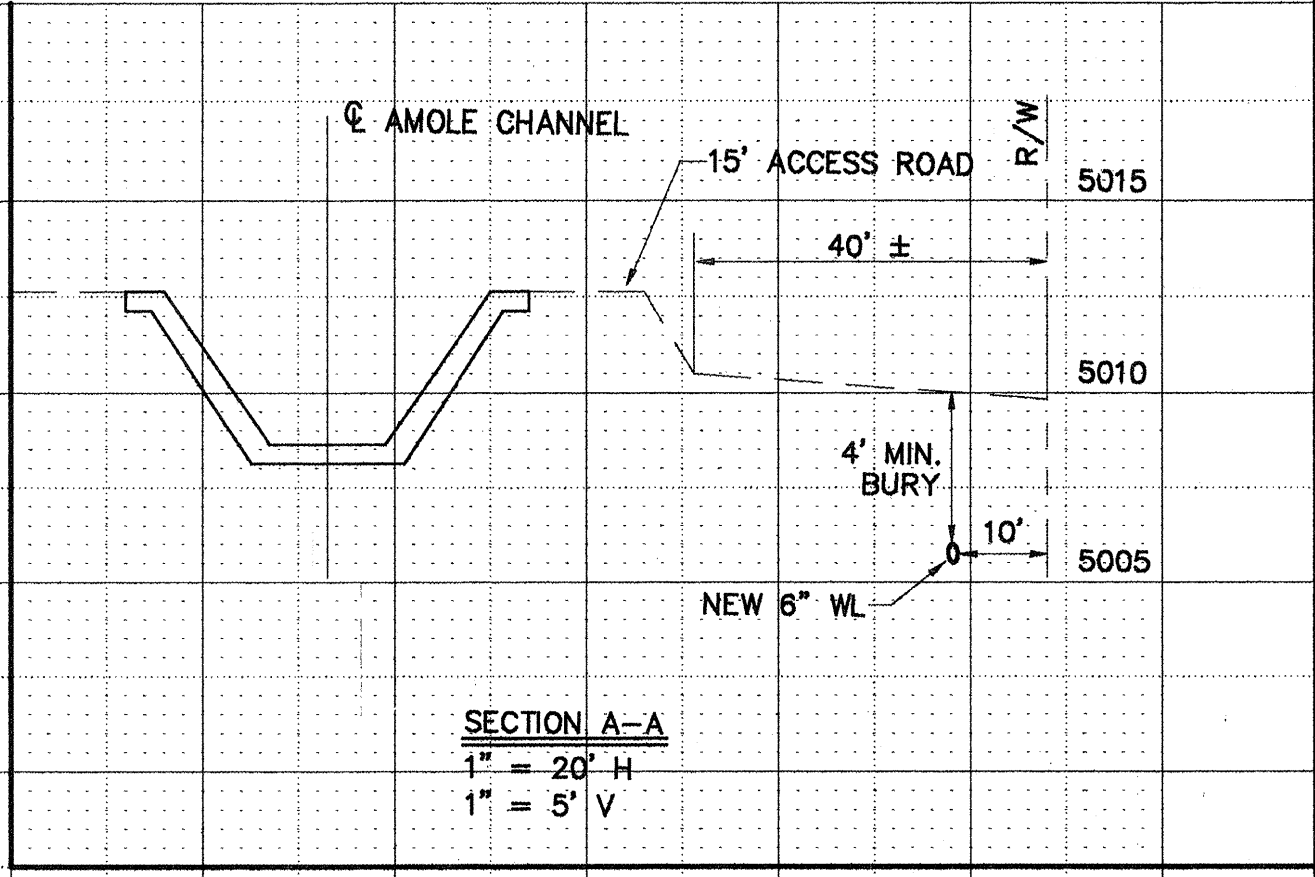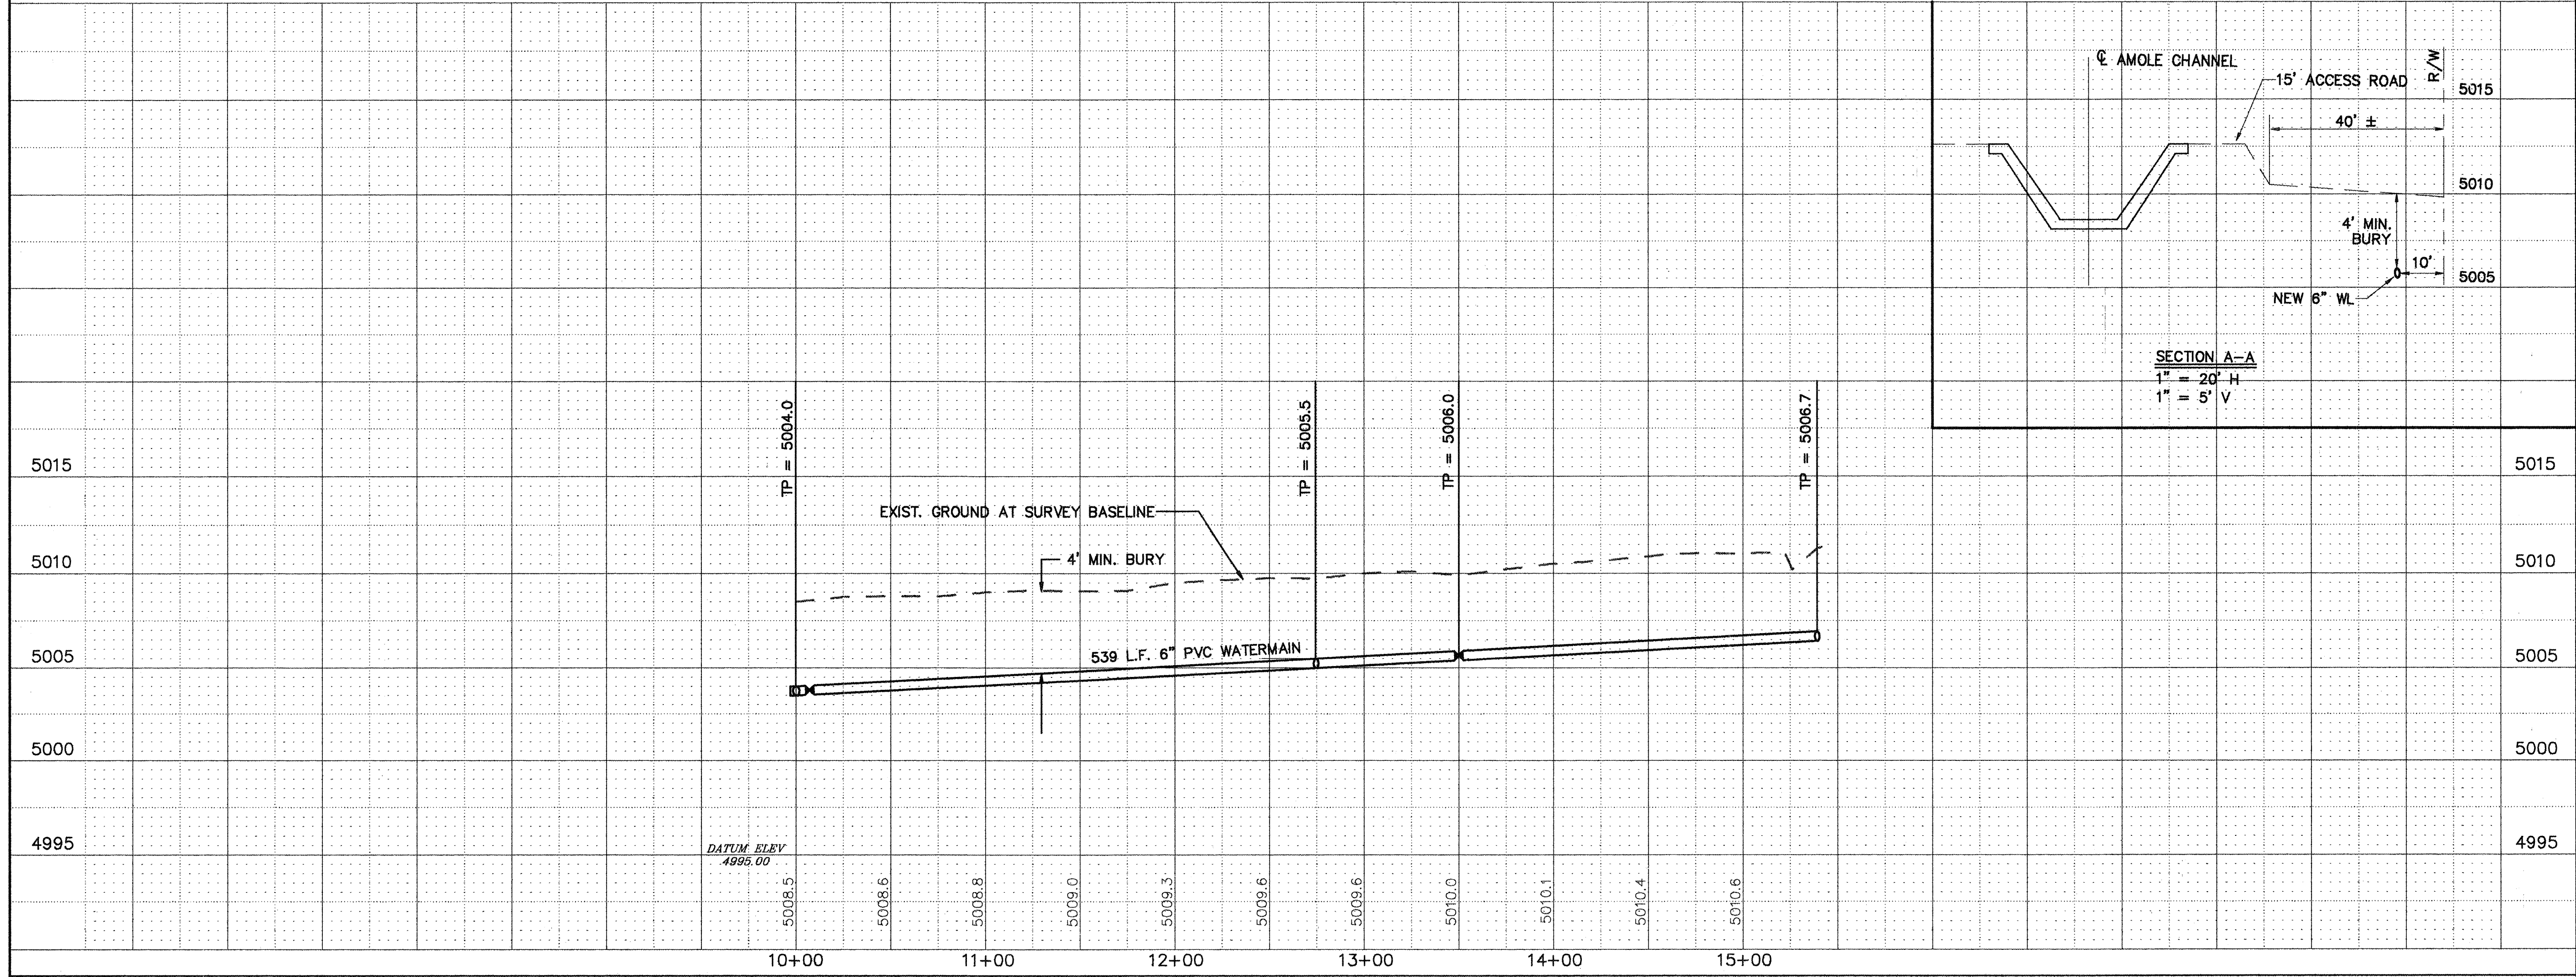

AS BUILT INFORMATION		BENCH MARKS		SURVEY INFORMATION		ENGINEER'S SEAL	
CONTRACTOR	J.R. HALE	DATE	11/94	NO.		REMARKS	NO. DATE
WORK	STANDARD	DATE		BY		REVISIONS	DESIGNED BY
INSPECTOR	J.R. HALE	DATE				DESIGN	DRAWN BY
FIELD	NO. 45-7A	DATE					CHECKED BY
REVISION	LOCATED 42.3' WEST OF THE INTERSECTION OF S. COORS RD. & BLAKE RD. S.W. ELEV. = 4833.487	DATE					
REVISION	TBM #1 = PAINT SPOT AT TOP OF CURB @ S. CURB - END OF CURB ON EDUARDO RD., S.W. ELEV. = 4869.27	DATE					
REVISION	TBM #2 = NE CORNER CONC. FENCE POST @ 3830 EDUARDO RD., S.W. ELEV. = 4864.57	DATE					
MICRO-FILM INFORMATION		RECORDED BY		DATE			

CITY OF ALBUQUERQUE  
PUBLIC WORKS DEPARTMENT  
ENGINEERING GROUP

TITLE: WEST EASEMENT S.W.  
SOUTH VALLEY WATER AND SEWER  
SYSTEM IMPROVEMENT PROJECT

APPROVALS	ENGINEER	DATE	APPROVALS	ENGINEER	DATE
DRC CHAIRMAN	N/A	12/13/93	WATER	ADDON	12/13/93
TRANSPORTATION	N/A	12/10/93	WASTE WATER		
HYDROLOGY	N/A	12/10/93			

PROJECT NO. 4515.94      MAP NO. F-11,G-11      SHEET 20 OF 26







## CONSTRUCTION TRAFFIC CONTROL GENERAL NOTES

1. CONTRACTOR MUST OBTAIN FROM CONSTRUCTION COORDINATION AN EXCAVATION/BARRICADING PERMIT BEFORE ENGAGING IN ANY CONSTRUCTION, MAINTENANCE OR REPAIR WORK IN ANY OF THE CITY OF ALBUQUERQUE'S RIGHTS-OF-WAY. EMERGENCY WORK THAT WOULD PRESERVE LIFE OR PROPERTY IS EXCLUDED WITH THE UNDERSTANDING, THAT A PERMIT SHALL BE OBTAINED WITHIN 24 TO 48 HOURS.

2. CONTRACTOR SHALL AT THE TIME OF PERMIT REQUEST, SUBMIT FOR APPROVAL BY CONSTRUCTION COORDINATION, A TRAFFIC CONTROL PLAN DETAILING ALL EXISTING TOPOGRAPHY SUCH AS LANE WIDTHS, DRIVEWAYS, AND BUSINESS/RESIDENTIAL ACCESSES. THE TRAFFIC CONTROL PLAN SHALL INCLUDE ALL PHASES OF WORK AND SCHEDULES INVOLVED IN THE CONSTRUCTION PROJECT. ANY SEPARATE PHASES OF A CONSTRUCTION PROJECT SHALL BE GIVEN AN INDIVIDUAL PERMIT EACH. BLANKET PERMITS WILL NOT BE ISSUED.

3. THESE TYPICAL TRAFFIC CONTROL PLANS DO NOT REFLECT THE EXISTING TOPOGRAPHY SUCH AS DRIVEWAYS, LANE WIDTHS, AND BUSINESS/RESIDENTIAL ACCESSES. EVERY LOCATION THAT REQUIRES CONSTRUCTION TRAFFIC CONTROL SHALL HAVE A DETAILED TRAFFIC CONTROL PLAN SHOWING ALL EXISTING TOPOGRAPHY.

4. CONSTRUCTION SHALL NOT BEGIN UNLESS A TRAFFIC CONTROL PLAN HAS BEEN APPROVED AND VERIFIED BY CONSTRUCTION COORDINATION.

5. CONSTRUCTION COORDINATION SHALL BE NOTIFIED 48 HOURS PRIOR TO ANY TRAFFIC CONTROL CHANGES NEEDED BY CONTRACTOR, THAT WERE NOT PREVIOUSLY APPROVED. THESE TRAFFIC CONTROL CHANGES SHALL BE REQUESTED IN WRITING ACCOMPANIED WITH A TRAFFIC CONTROL PLAN REFLECTING SUCH CHANGES.

6. ALL CONSTRUCTION TRAFFIC CONTROL DEVICES SHALL COMPLY TO THE MANUAL ON UNIFORM TRAFFIC CONTROL DEVICES (MUTCD), LATEST EDITION. IT IS THE RESPONSIBILITY OF THE CONTRACTOR TO INSTALL, SERVICE AND MAINTAIN ALL TRAFFIC CONTROL DEVICES. TRAFFIC CONTROL DEVICES SHALL NOT BE REMOVED OR ALTERED IN ANY WAY WITHOUT THE APPROVAL OF CONSTRUCTION COORDINATION, PER SECTION GA-4 OF THE MUTCD, LATEST EDITION.

7. THE CONSTRUCTION TRAFFIC CONTROL INITIAL SET-UP SHALL BE BY AN AMERICAN TRAFFIC SAFETY SERVICES ASSOCIATION (ATSSA) CERTIFIED WORKSITE TRAFFIC SUPERVISOR. THE MAINTENANCE AND SERVICING SHALL ALSO BE DONE BY AN ATSSA CERTIFIED WORKSITE TRAFFIC SUPERVISOR OR EQUIVALENT.

8. CONTRACTOR IS RESPONSIBLE TO MAINTAIN AND SERVICE ALL TRAFFIC CONTROL DEVICES 24 HOURS A DAY, 7 DAYS A WEEK THROUGHOUT LENGTH OF PROJECT. CONTRACTOR IS RESPONSIBLE THAT ALL TRAFFIC CONTROL DEVICES COMPLY WITH THE MUTCD, LATEST EDITION.

9. ALL ADVANCE WARNING SIGNS SHALL BE DOUBLE INDICATED WHENEVER THERE ARE MULTI-LANE TRAFFIC IN ANY ONE GIVEN DIRECTION AND THERE IS SUFFICIENT MEDIAN SPACE.

10. ALL BARRICADES IN ALL TAPERS AND TANGENTS SHALL BE PLACED APART, A DISTANCE MEASURED IN FEET, EQUAL TO THAT OF THE POSTED SPEED LIMIT. NO EXCEPTIONS UNLESS APPROVED BY CONSTRUCTION COORDINATION PER MUTCD SECTION GA-4.

11. CONTRACTOR SHALL NOT BEGIN WORK BEFORE 8:30 A.M. OR END WORK AFTER 4:00 P.M. WITHOUT THE APPROVAL OF CONSTRUCTION COORDINATION.

12. CONTRACTOR IS RESPONSIBLE TO PROVIDE CONSTRUCTION COORDINATION, A WEEKLY LOG OF DAILY INSPECTIONS OF BARRICADE AND MAINTENANCE SCHEDULES ON PROJECTS THAT ARE OVER ONE WEEK DURATION.

13. EQUIPMENT OR MATERIALS SHALL NOT BE STORED WITHIN 15 FEET OF A TRAVELLED TRAFFIC LANE DURING NON-WORKING HOURS WITHOUT THE APPROVAL OF CONSTRUCTION COORDINATION.

14. CONTRACTOR SHALL PROVIDE AND MAINTAIN A SAFE AND ADEQUATE MEANS OF CHANNELIZING PEDESTRIAN TRAFFIC AROUND AND THROUGH THE CONSTRUCTION AREA.

15. CONTRACTOR IS RESPONSIBLE FOR OBLITERATION OF ANY CONFLICTING STRIPING AND RESPONSIBLE FOR ALL TEMPORARY STRIPING.

16. CONTRACTOR SHALL MAINTAIN ACCESS TO ALL FACILITIES, BUSINESSES AND/OR RESIDENTS AT ALL TIMES.

17. CONTRACTOR SHALL PROVIDE ACCESS SIGNS FOR BUSINESSES LOCATED WITHIN THE CONSTRUCTION AREA UNDER THE SUPERVISION OF CONSTRUCTION COORDINATION. EACH ACCESS SIGN SHALL HAVE 5 INCH, WHITE LETTERING ON BLUE REFLECTORIZED BACKGROUND WITH A 5/8" WHITE BORDER INSET 3/8". ACCESS SIGNS SHALL BE CONSIDERED INCIDENTAL TO THE BID AND NOT PART OF THE CONTRACT UNLESS OTHERWISE STATED. NO MORE THAN 3 BUSINESSES SHALL BE LISTED ON AN ACCESS SIGN. SHOPPING CENTERS AND MALLS SHALL BE LISTED AS SUCH.

18. ALL ADVANCE WARNING SIGNS SHALL MEET THE MINIMUM REFLECTIVE INTENSITY REQUIREMENTS SET FORTH BY THE CITY OF ALBUQUERQUE. CONSTRUCTION COORDINATION SHALL DETERMINE ALL REQUIREMENTS AND APPROVE OR DISAPPROVE ANY ADVANCE WARNING SIGN PER SECTION GA-4 OF THE MUTCD, LATEST EDITION.

19. 24 HOURS PRIOR TO OCCUPYING OR CLOSING OF A RIGHT-OF-WAY, CONTRACTOR SHALL NOTIFY: POLICE, FIRE DEPARTMENT, SCHOOLS, HOSPITALS, TRANSIT AUTHORITY, BUSINESSES AND/OR RESIDENTS THAT WILL BE AFFECTED BY THE CONSTRUCTION.


20. ANY FIELD ADJUSTMENTS SHALL BE APPROVED BY CONSTRUCTION COORDINATION.

21. EXCAVATIONS SHALL BE PLATED, TEMPORARILY PATCHED OR RESURFACED PRIOR TO OPENING OF TRAFFIC. A MINIMUM OF 11 FEET SHALL BE PROVIDED FOR TRAFFIC IN ANY GIVEN DIRECTION. CONTRACTOR IS RESPONSIBLE FOR ANY WORK INVOLVED IN SATISFYING THESE REQUIREMENTS.


22. CONTRACTOR SHALL AT ALL TIMES COMPLY WITH THE FOLLOWING:  
1. STANDARDS AND REQUIREMENTS SET FORTH IN THE MANUAL ON UNIFORM TRAFFIC CONTROL DEVICES, LATEST EDITION.  
2. THE CITY OF ALBUQUERQUE TRAFFIC CODE, LATEST EDITION.  
3. SECTION 19 OF THE CITY OF ALBUQUERQUE'S STANDARD SPECIFICATIONS FOR PUBLIC WORK CONSTRUCTION, AS WELL AS OTHER SECTIONS.

23. FAILURE TO COMPLY WITH ANY OF THE ABOVE MENTIONED, WILL BE ADEQUATE CAUSE TO CEASE ALL WORK ON ANY CONSTRUCTION PROJECT. WORK WILL NOT RESUME UNTIL ALL REQUIREMENTS ARE ADDRESSED AND APPROVED BY CONSTRUCTION COORDINATION.

## PROJECT CONSTRUCTION TRAFFIC CONTROL GENERAL NOTES

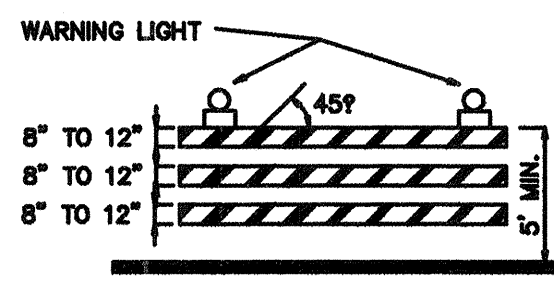


TYPE III BARRICADE

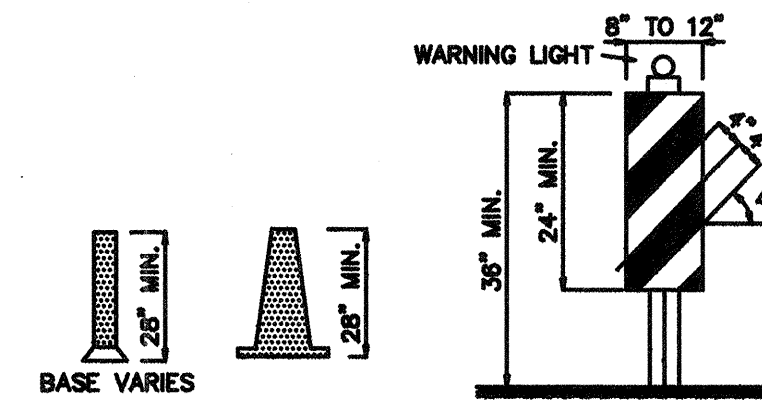

VERTICAL PANEL

CONES

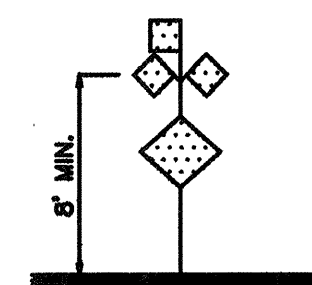

HIGH LEVEL WARNING DEVICE

## LEGEND

- WORK AREA  
BARRICADE - TYPE I, TYPE II, OR BARREL  
BARRICADE - TYPE III  
VERTICAL PANEL  
WARNING SIGN  
DISTANCE BETWEEN SIGNS - A DISTANCE MEASURED IN FEET EQUAL TO A VALUE OF TEN TIMES THE SPEED LIMIT OF THE STREET  
FLAGMAN POSITION  
SPACING BETWEEN BARRICADES- A DISTANCE MEASURED IN FEET EQUAL TO THE SPEED LIMIT OF THE STREET  
TAPER LENGTH - SEE CHART BELOW  
THE TANGENT LENGTH IS EQUAL TO THE TAPER LENGTH FOR A GIVEN STREET.

## TAPER REQUIREMENTS

SPEED LIMIT (MPH)	TAPER LENGTH (FEET)			MINIMUM NUMBER OF DEVICES FOR TAPER	MAXIMUM DEVICE SPACING IN FEET	
	10' LANE	11' LANE	12' LANE		ALONG TAPER	AFTER TAPER
20	70	75	80	5	20	50
25	105	115	125	6	25	60
30	150	165	180	7	30	70
35	205	225	245	8	35	80
40	270	295	320	9	40	90
45	450	495	540	13	45	100
50	500	550	600	13	50	100
55	550	605	660	13	55	40

## RECOMMENDED SIGN SPACING FOR ADVANCE WARNING SIGN SERIES

SPEED PER HOUR	MINIMUM DISTANCE IN FEET	
	BETWEEN SIGNS	FROM LAST SIGN TO TAPER
0-20	200	200
25-30	300	250
30-35	300	300
40-45	500	400
50-60	500-1600	500-1000

## TAPER CRITERIA


TYPE OF TAPER	TAPER LENGTH
UPSTREAM TAPER:	
MERGING TAPER	L MINIMUM
SHIFTING TAPER	2 L MINIMUM
SHOULDER TAPER	2 L MINIMUM
TWO-WAY TRAFFIC TAPER	100 FEET MAXIMUM
DOWNSTREAM TAPERS	100 FEET PER LANE

## TAPER LENGTH COMPUTATION

SPEED LIMIT	
40 MPH OR LESS	$L = \frac{WS^2}{60}$
45 MPH OR GREATER	$L = W \times S$

L = TAPER LENGTH  
W = WIDTH OF OFFSET IN FEET  
S = POSTED SPEED OR OFF-PEAK 85-PERCENTILE SPEED IN MPH

## SIGN FACE DETAILS

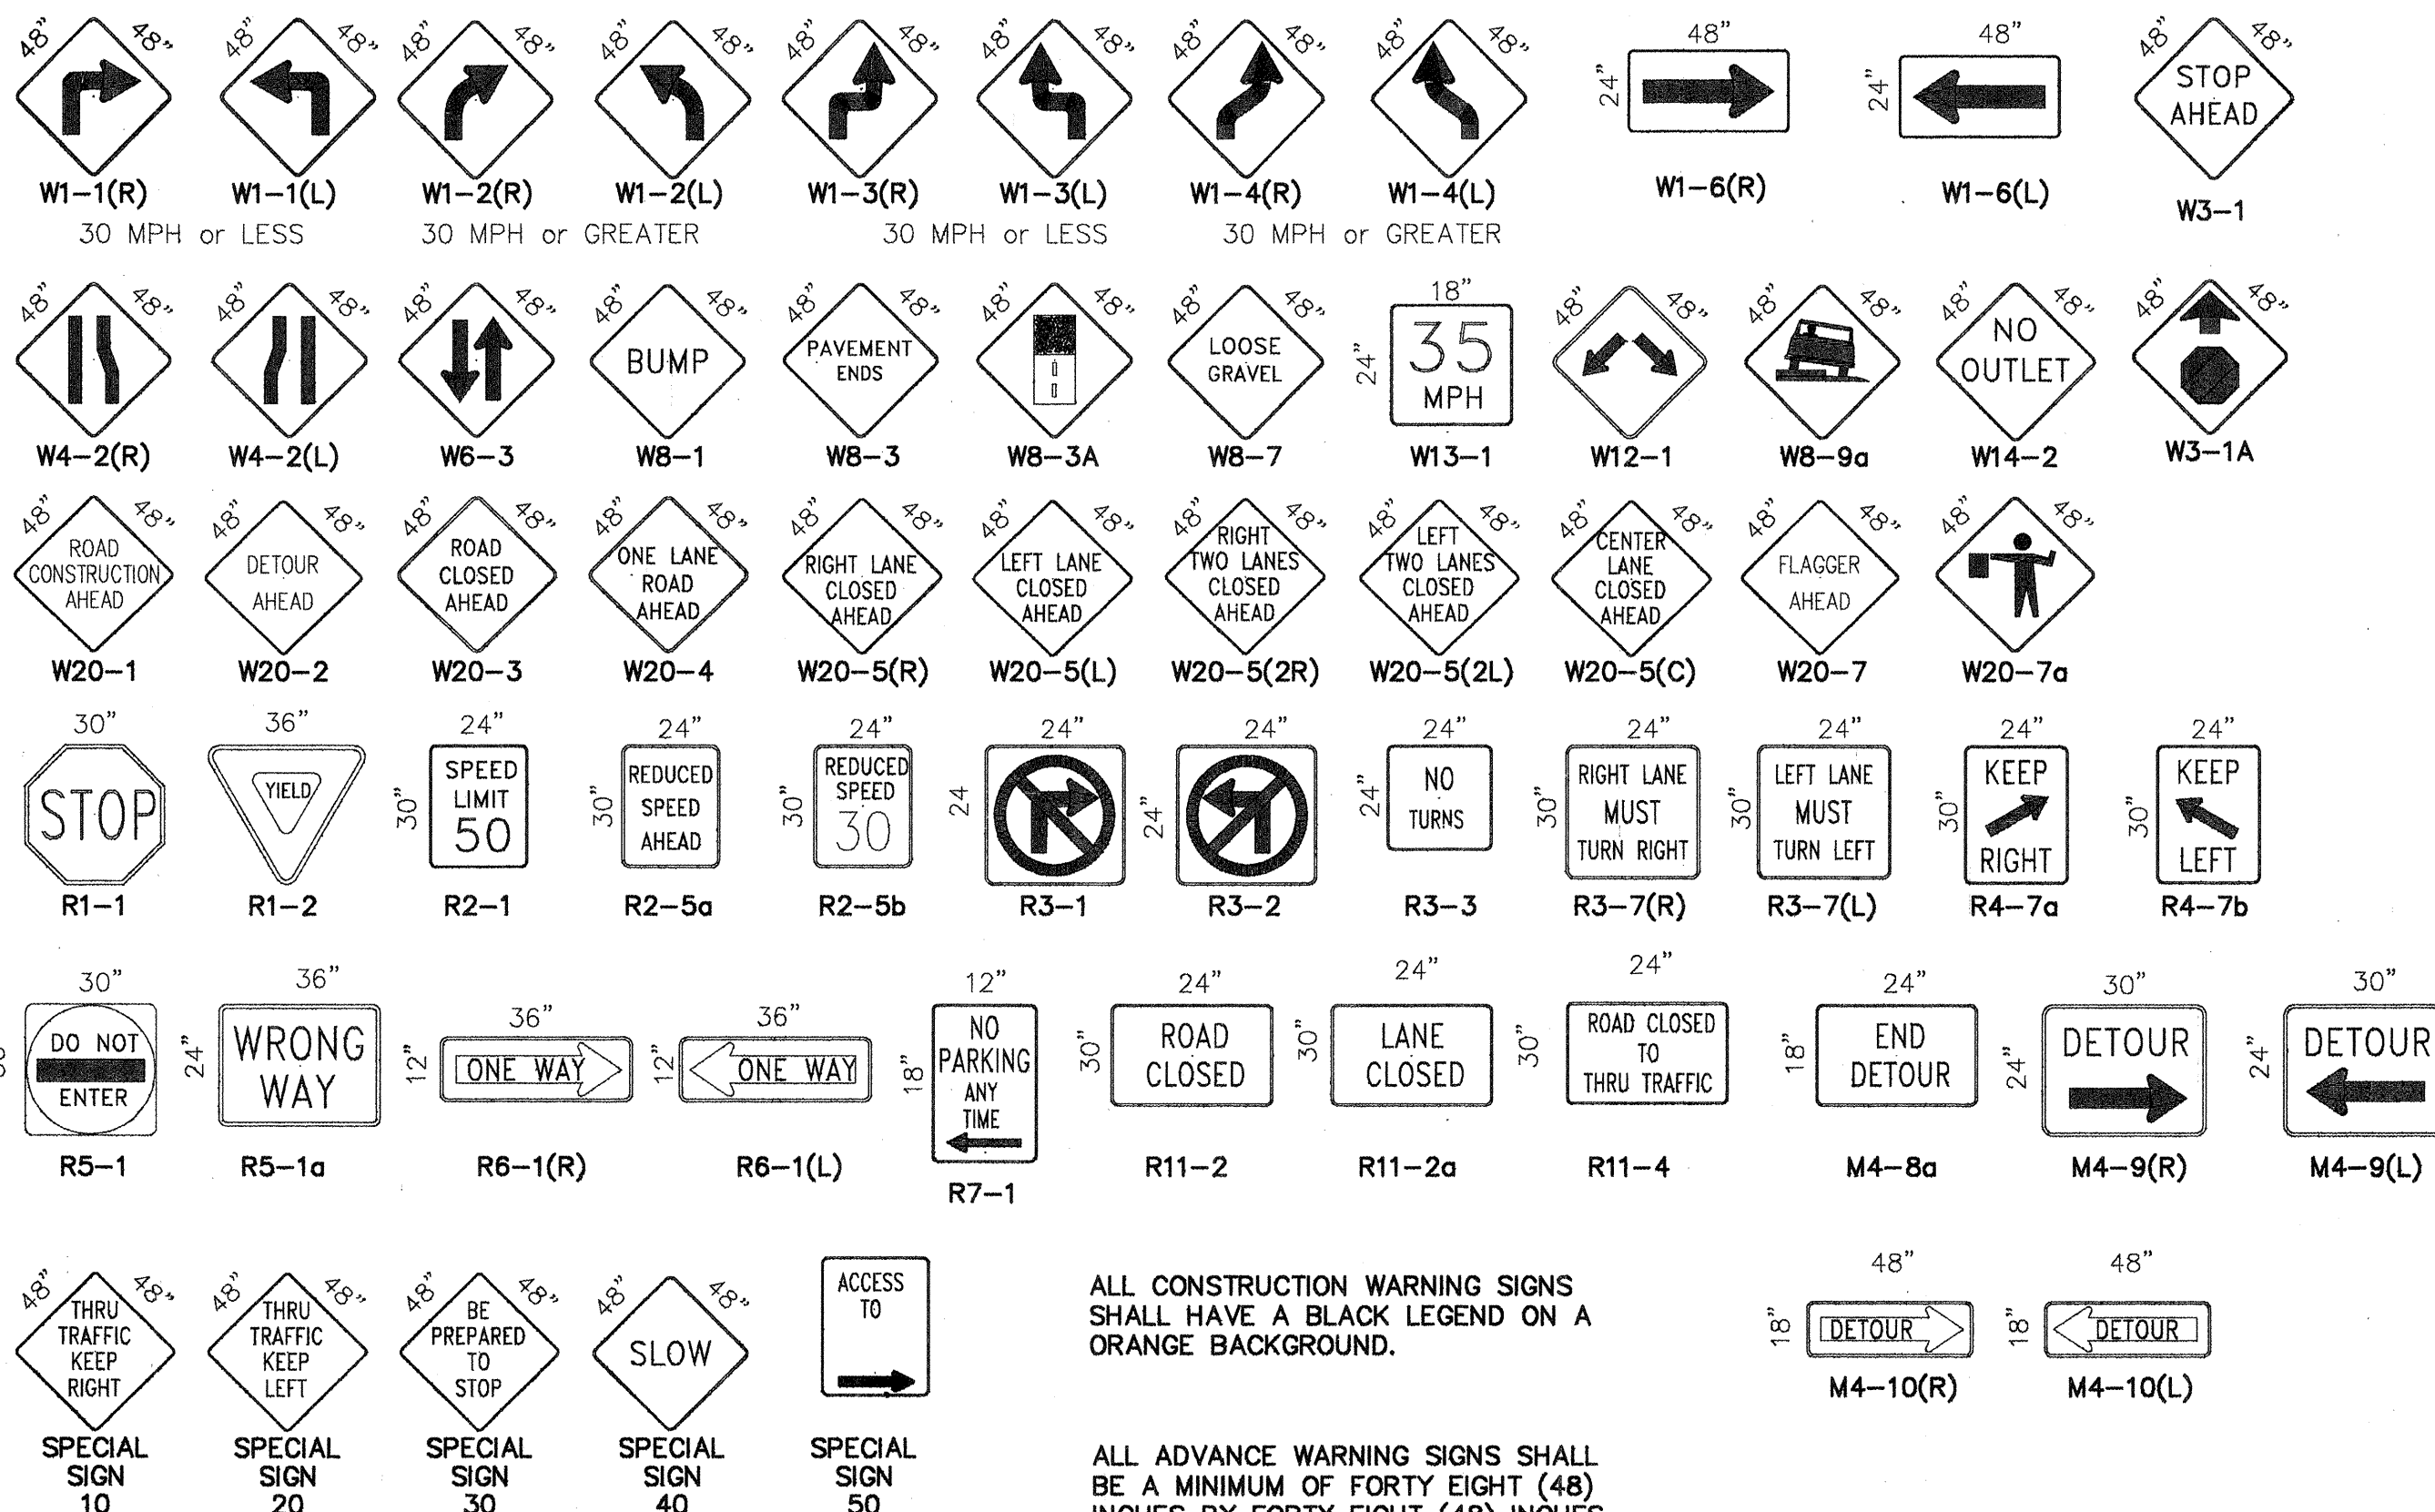

ALL CONSTRUCTION WARNING SIGNS SHALL HAVE A BLACK LEGEND ON A ORANGE BACKGROUND.


ALL ADVANCE WARNING SIGNS SHALL BE A MINIMUM OF FORTY EIGHT (48) INCHES BY FORTY EIGHT (48) INCHES IN SIZE AND SHALL HAVE ONE WARNING LIGHT.

AS BUILT INFORMATION			BENCH MARKS			SURVEY INFORMATION			ENGINEER'S SEAL		
CONTRACTOR	DATE	NO.	CONTRACTOR	DATE	NO.	NO.	BY	DATE	NO.	BY	DATE
WORK	DATE	NO.	WORK	DATE	NO.	NO.	BY	DATE	NO.	BY	DATE
STAMPED BY	DATE	NO.	STAMPED BY	DATE	NO.	NO.	BY	DATE	NO.	BY	DATE
FIELD	DATE	NO.	FIELD	DATE	NO.	NO.	BY	DATE	NO.	BY	DATE
ACCEPTANCE BY	DATE	NO.	ACCEPTANCE BY	DATE	NO.	NO.	BY	DATE	NO.	BY	DATE
REVISION BY	DATE	NO.	REVISION BY	DATE	NO.	NO.	BY	DATE	NO.	BY	DATE
CORRECTED BY	DATE	NO.	CORRECTED BY	DATE	NO.	NO.	BY	DATE	NO.	BY	DATE
RECORDED BY	DATE	NO.	RECORDED BY	DATE	NO.	NO.	BY	DATE	NO.	BY	DATE
MICRO-FILM INFORMATION											
NO.											



REMARKS  
DESIGN  
NO. DATE  
DESIGNED BY RICARDO ROYBAL P.E. DATE NOV. 1991  
DRAWN BY CAD, - A.F.V. DATE NOV. 1991  
CHECKED BY

CITY OF ALBUQUERQUE PUBLIC WORKS DEPARTMENT ENGINEERING GROUP					
TITLE: SOUTH VALLEY WATER AND SEWER SYSTEM IMPROVEMENT PROJECT SIGNING AND CONSTRUCTION TRAFFIC CONTROL STANDARDS					
APPROVALS	ENGINEER	DATE	APPROVALS	ENGINEER	DATE
DRC CHAIRMAN	B.G. Smith	12-13-93	WATER	W. Smith	12/13/93
TRANSPORTATION	N/A	12-10-93	WASTE WATER		
HYDROLOGY	N/A	12-10-93			
PROJECT NO. 4515.94		MAP NO. L-10, L-11 M-10, M-11		SHEET 23 OF 26	



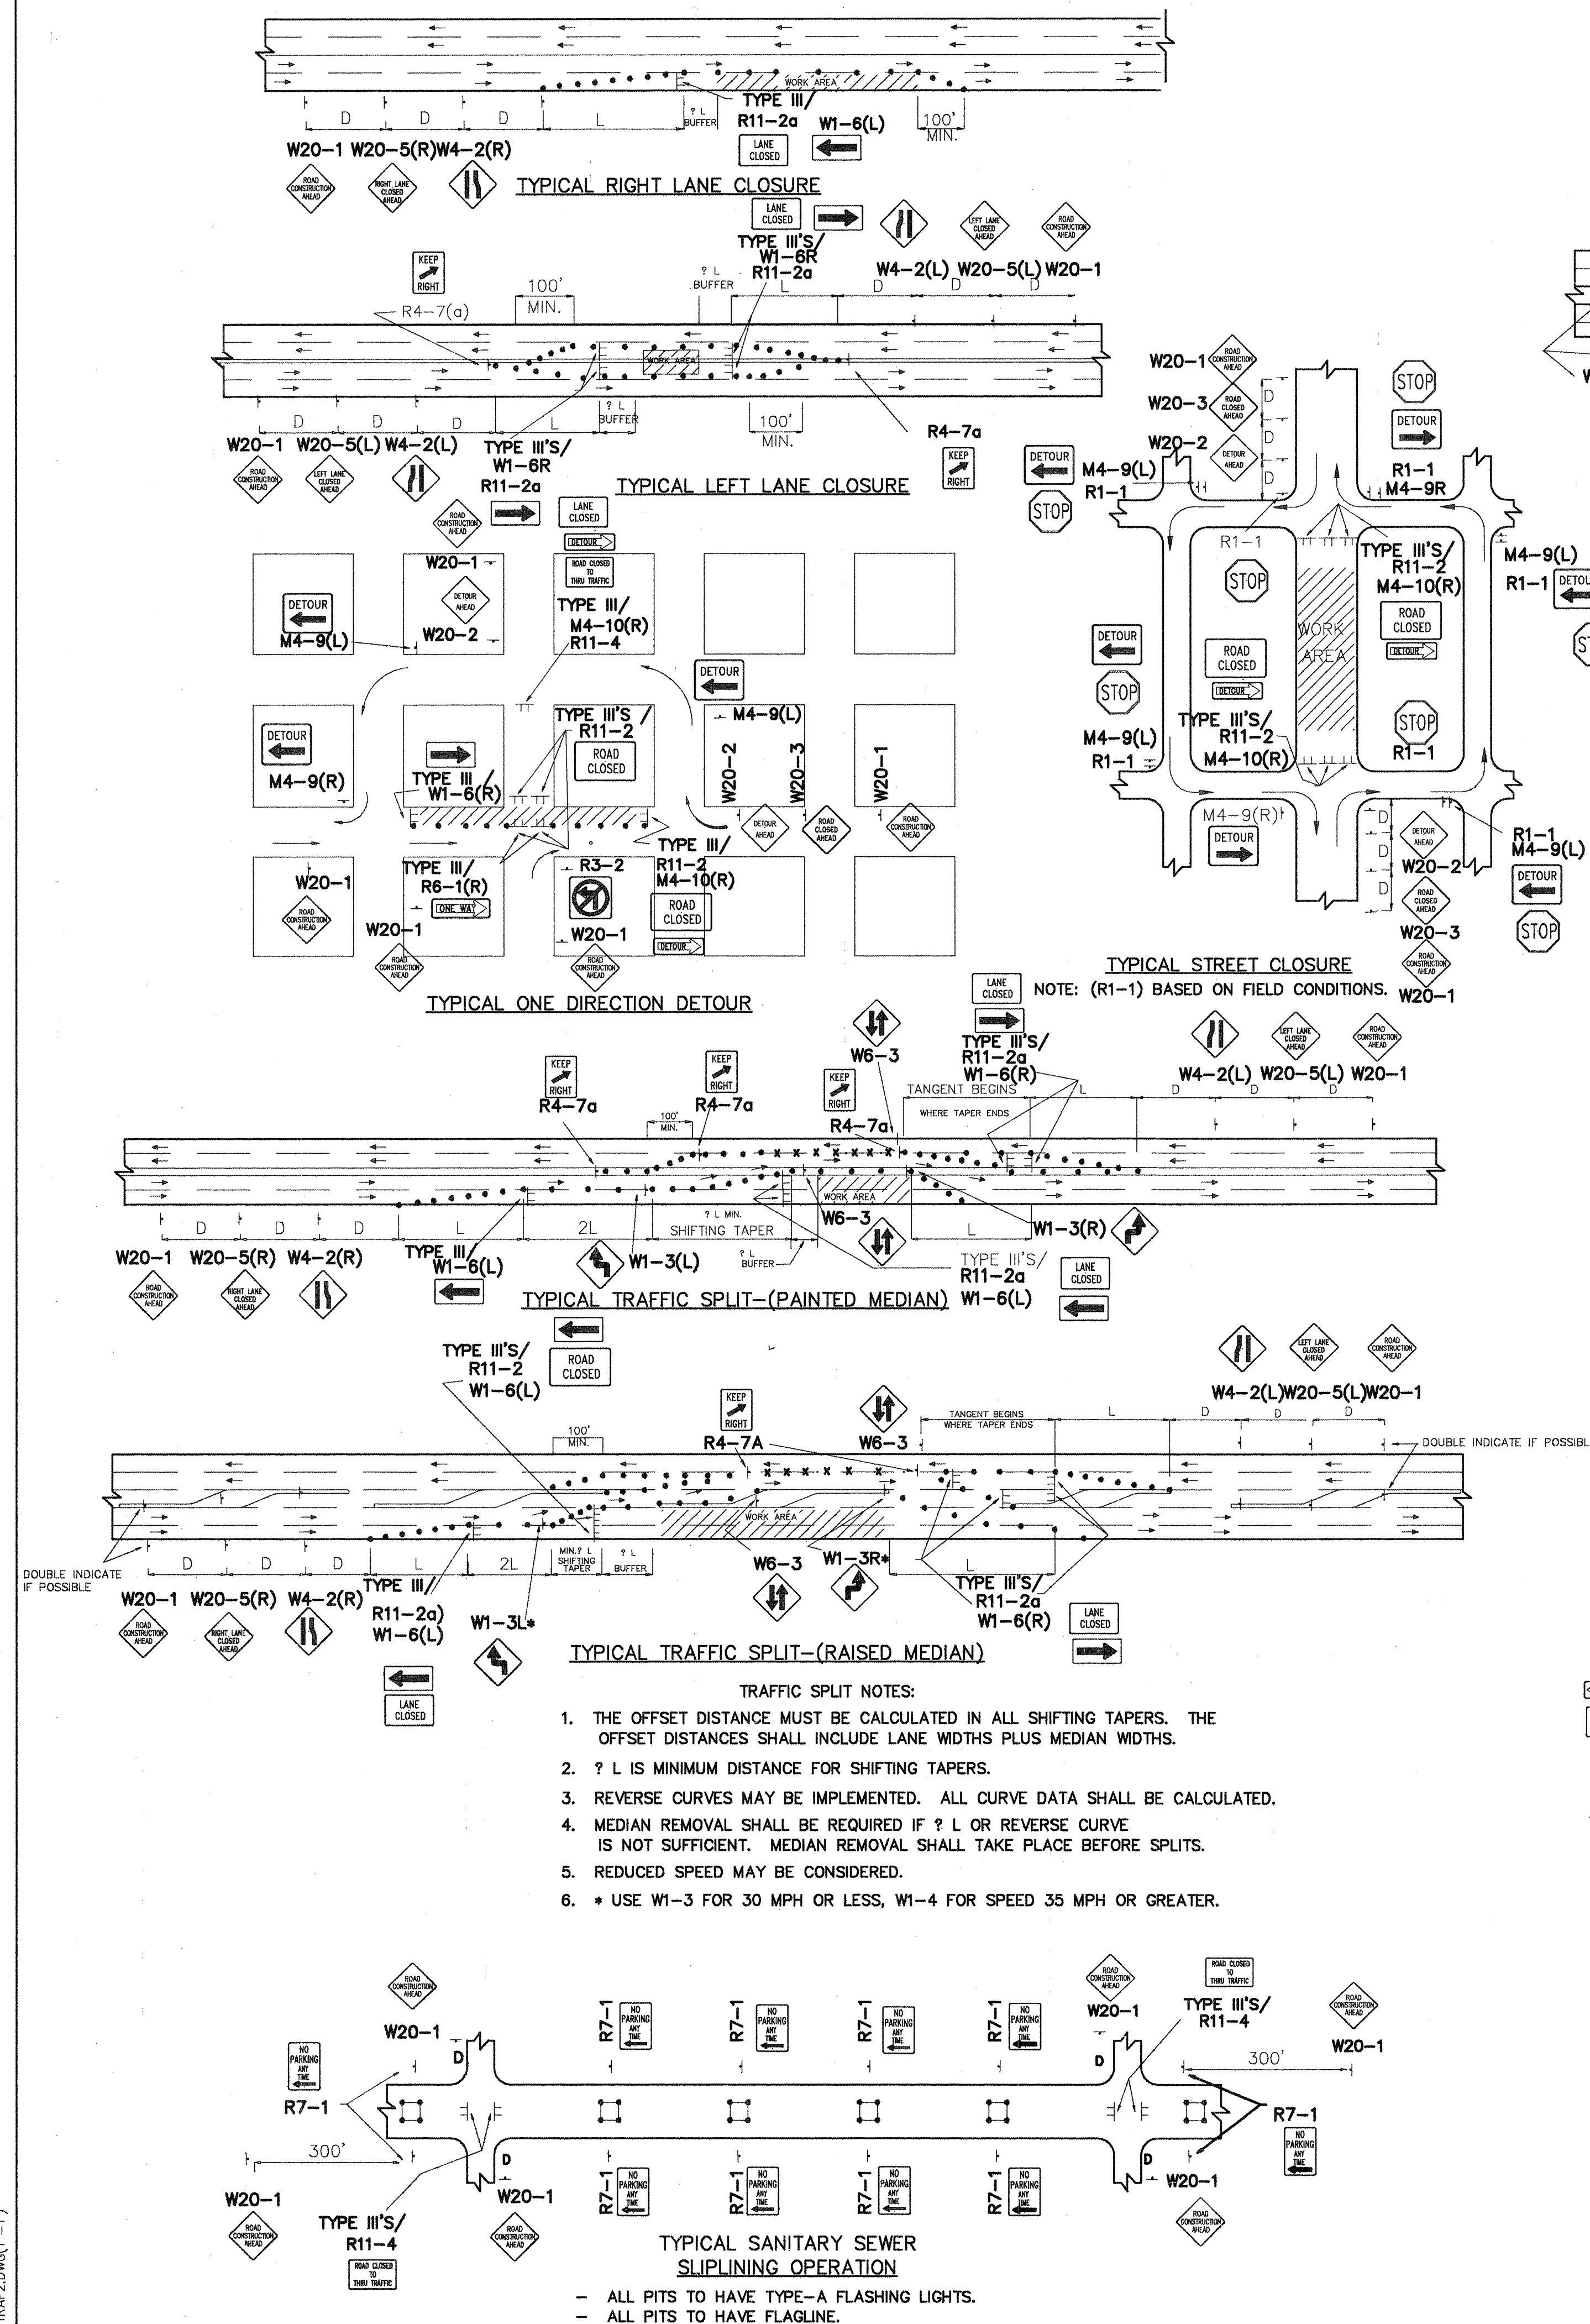



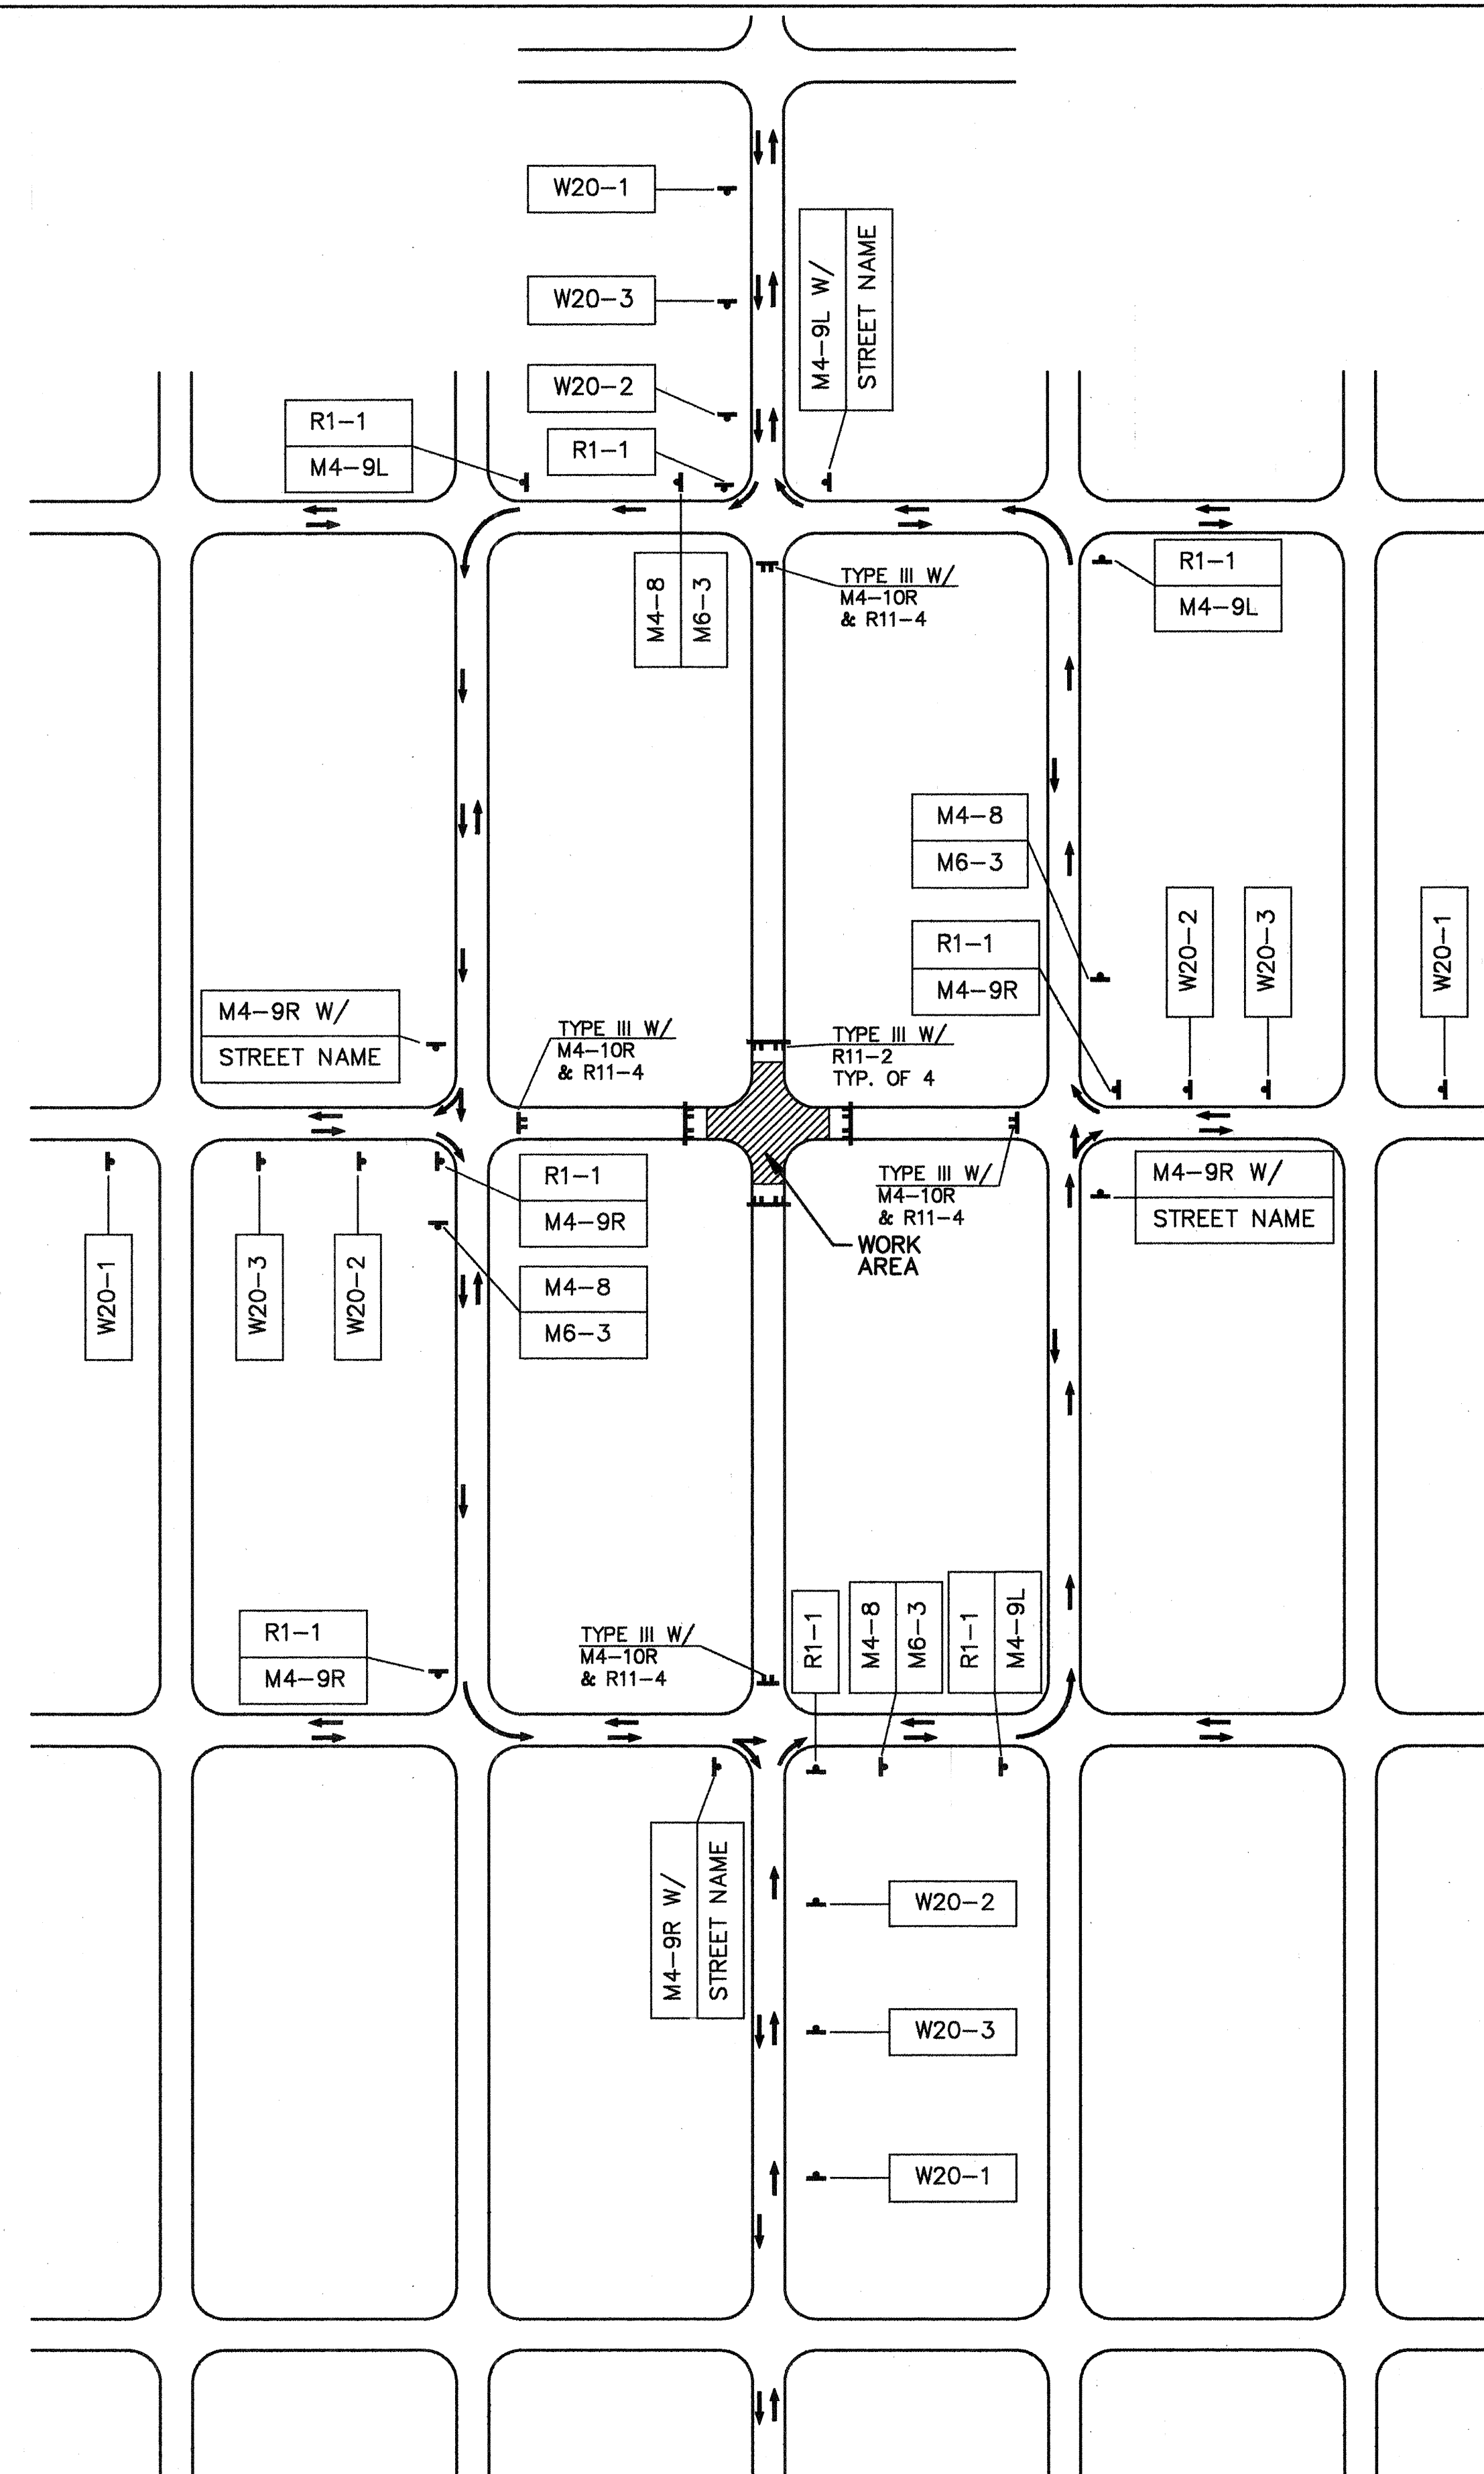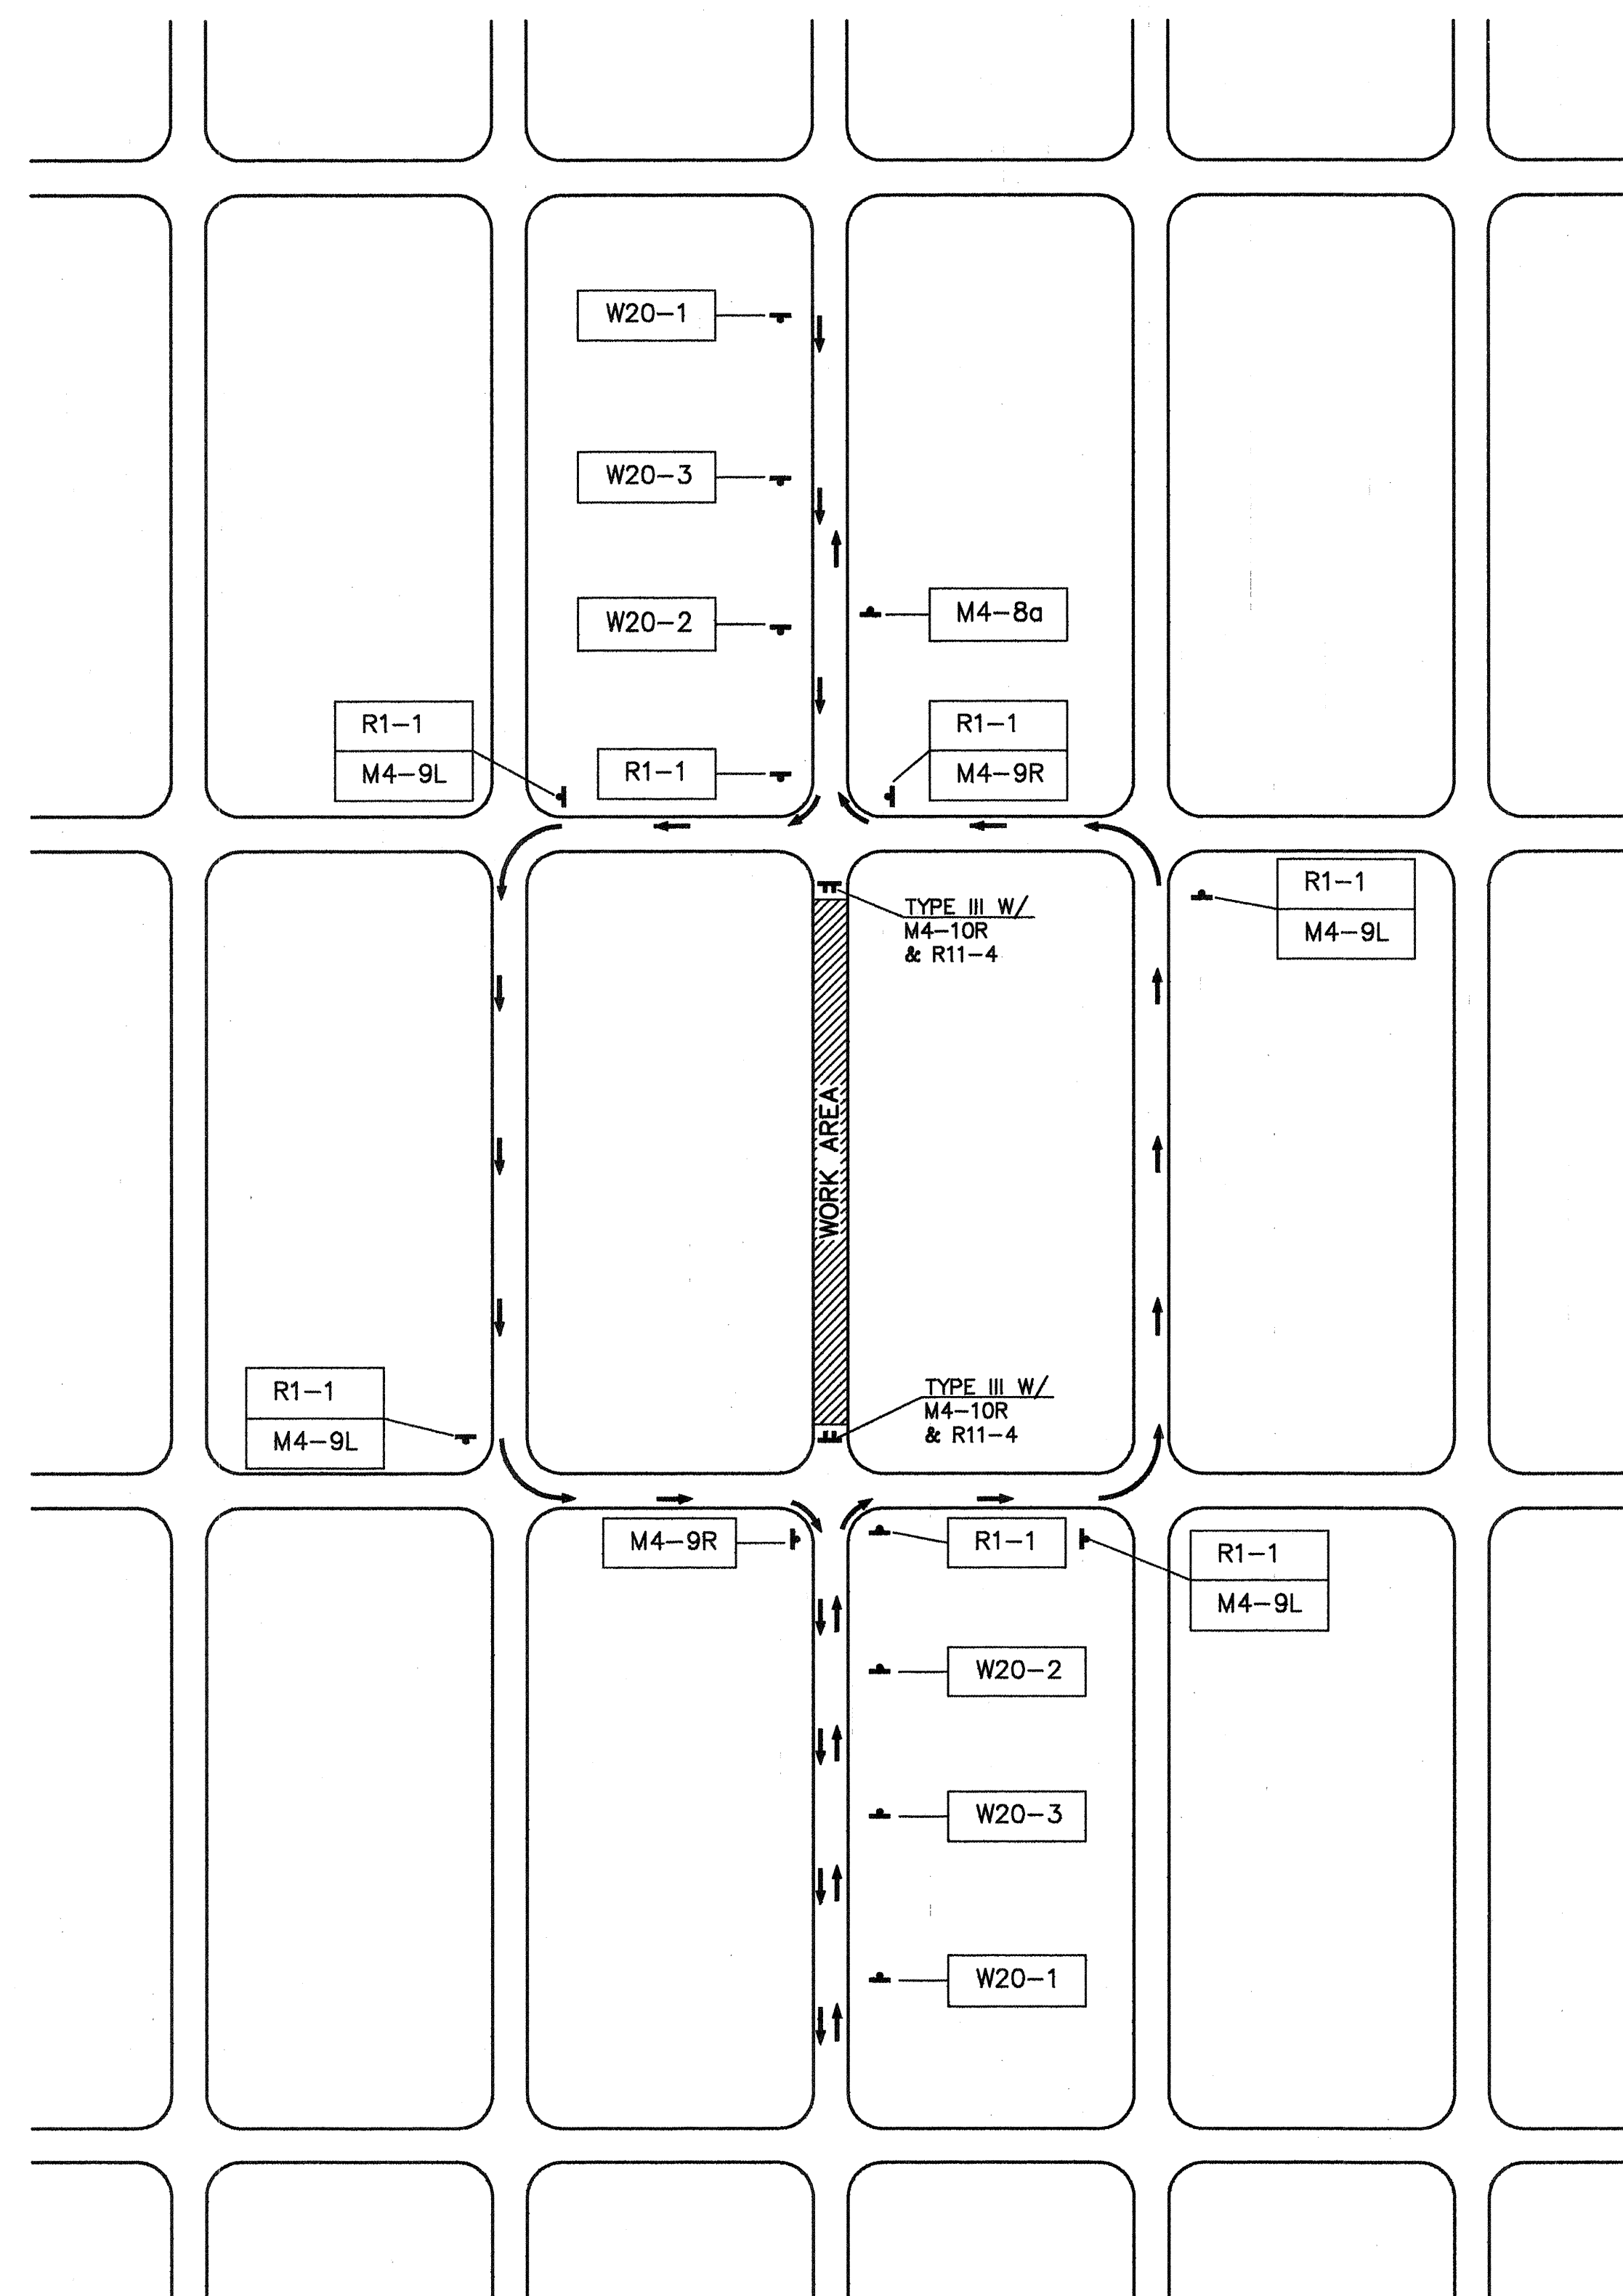

NOTES:

ENGINEER'S SEAL		SURVEY INFORMATION		BENCH MARKS		AS-BUILT INFORMATION	
		FIELD NOTES					
		NO.	BY	DATE			
						WORK	DATE
						STAKED BY	DATE
						ACCEPTANCE BY	DATE
						FIELD	DATE
						VERIFICATION BY	DATE
						RECORDED BY	DATE
						MICRO-FILM INFORMATION	
						RECORDED BY	
						DATE	
						NO.	

WILSON & COMPANY, ENGINEERS & ARCHITECTS

REVISIONS





NO. DATE REMARKS BY

DESIGNED BY DATE

DRAWN BY DATE

CITY OF ALBUQUERQUE PUBLIC WORKS DEPARTMENT ENGINEERING GROUP					
TITLE SOUTH VALLEY WATER AND SEWER SYSTEM IMPROVEMENT PROJECT TRAFFIC CONTROL TYPICAL RESIDENTIAL STREET CLOSURES					
APPROVALS	ENGINEER	DATE	APPROVALS	ENGINEER	DATE
DRC CHAIRMAN	<i>B. G. Goodley</i>	12-13-93	WATER	<i>K. L. Lee</i>	12-13-93
TRANSPORTATION	<i>N/A RHO</i>	12-10-93	WASTE WATER		
HYDROLOGY	<i>N/A JLO</i>	12/10/93			
PROJECT NO.	4515.94		MAP NO. L-10-11 M-10, M-11	SHEET 25 OF 26	

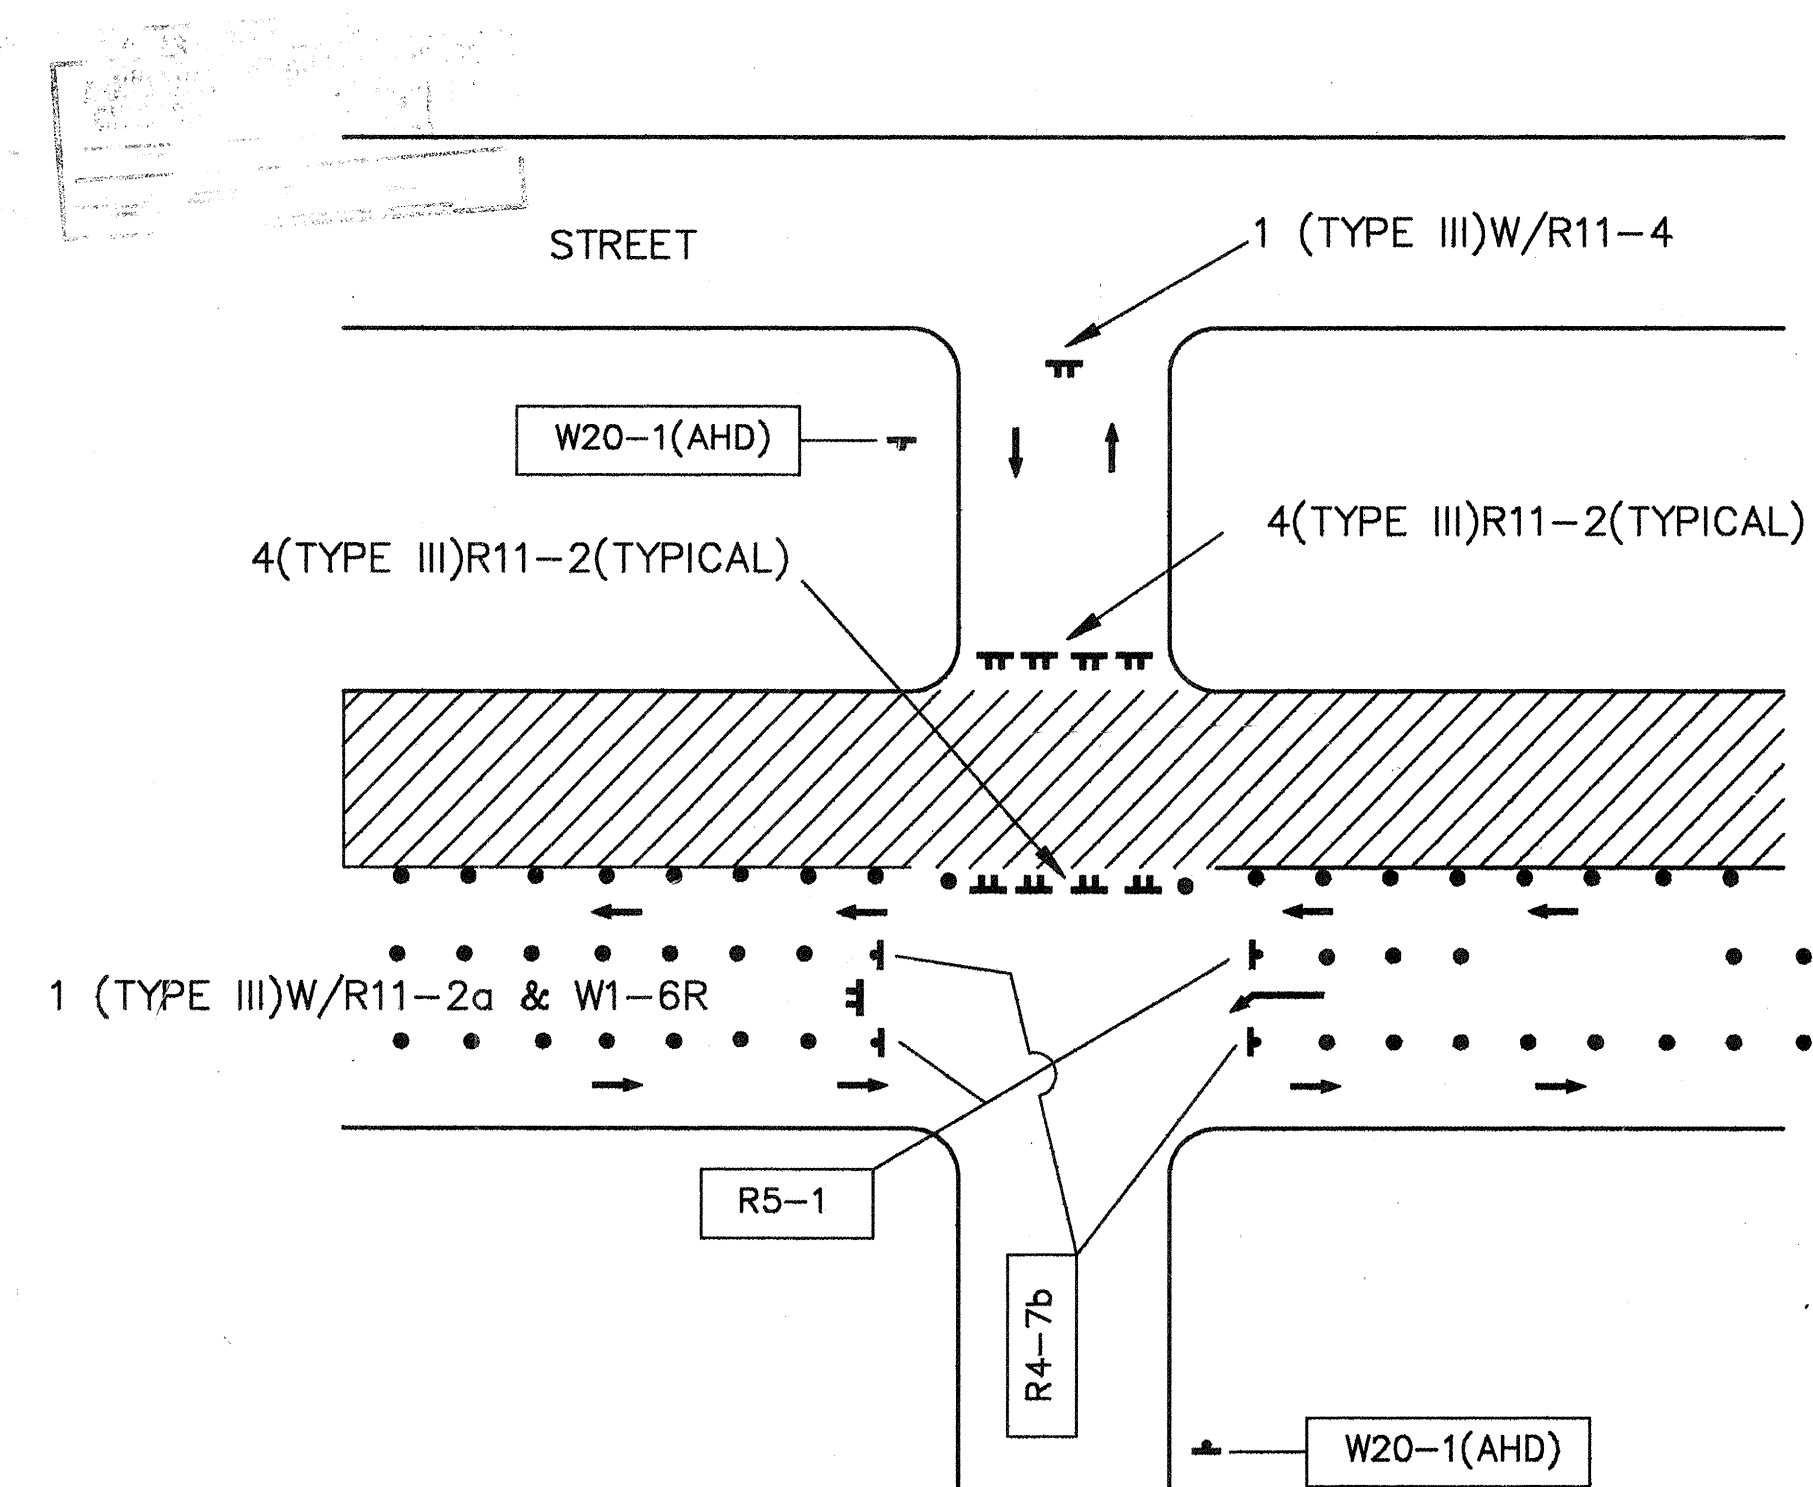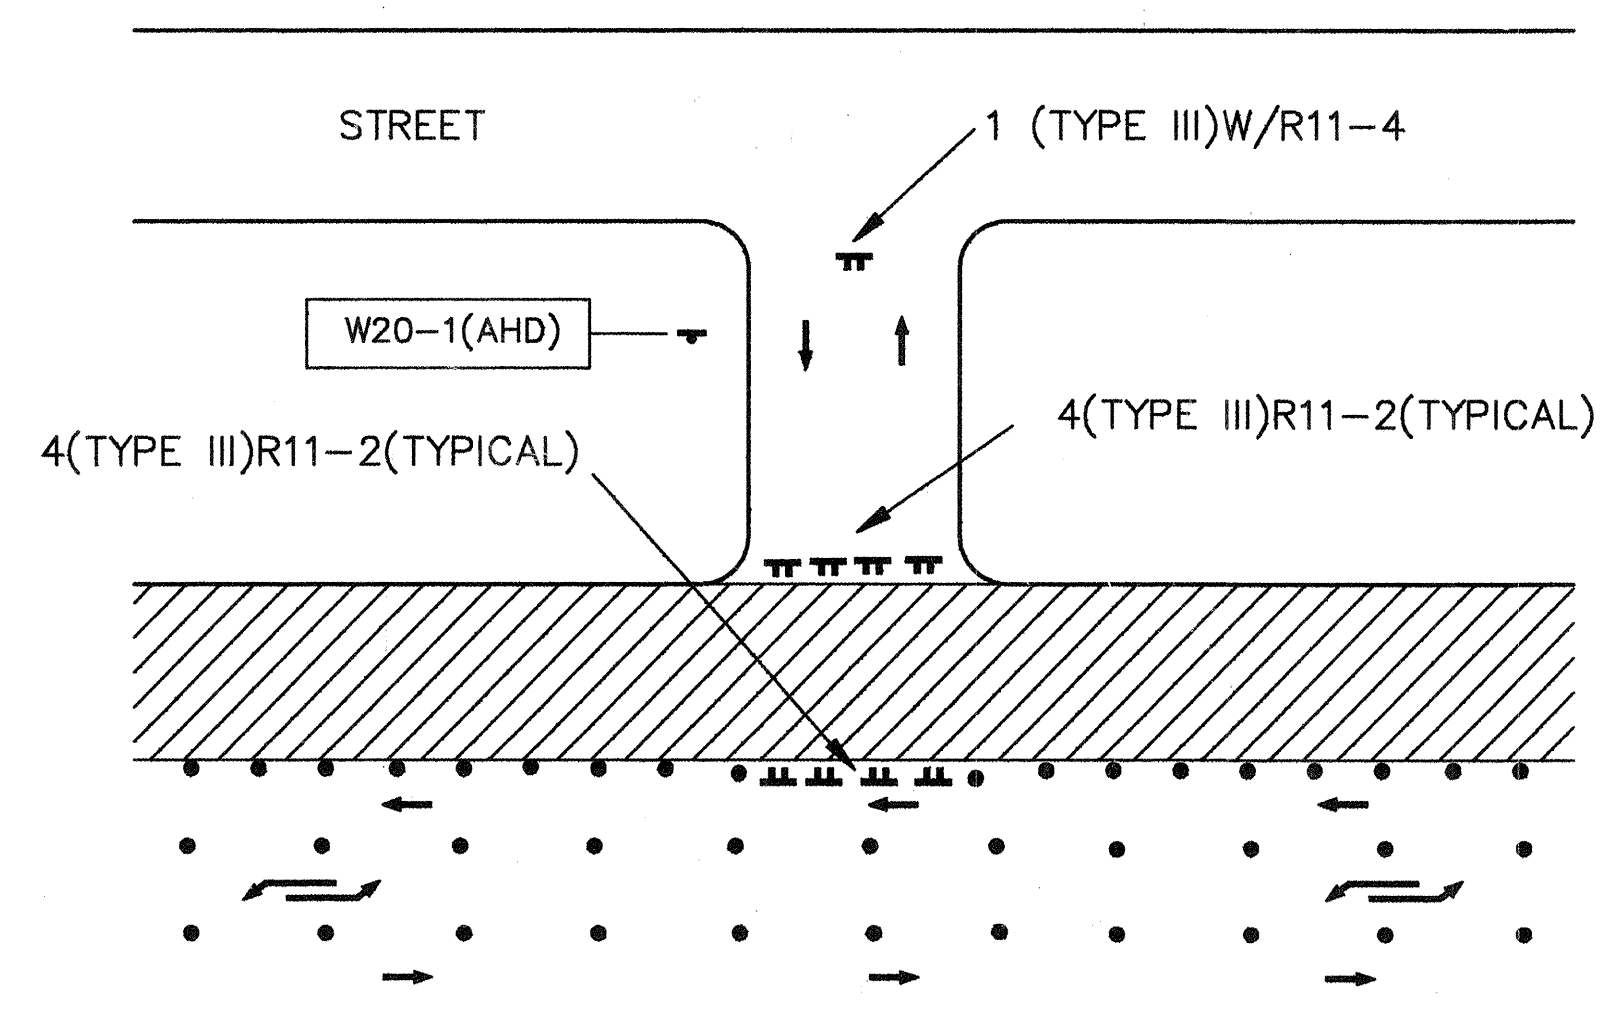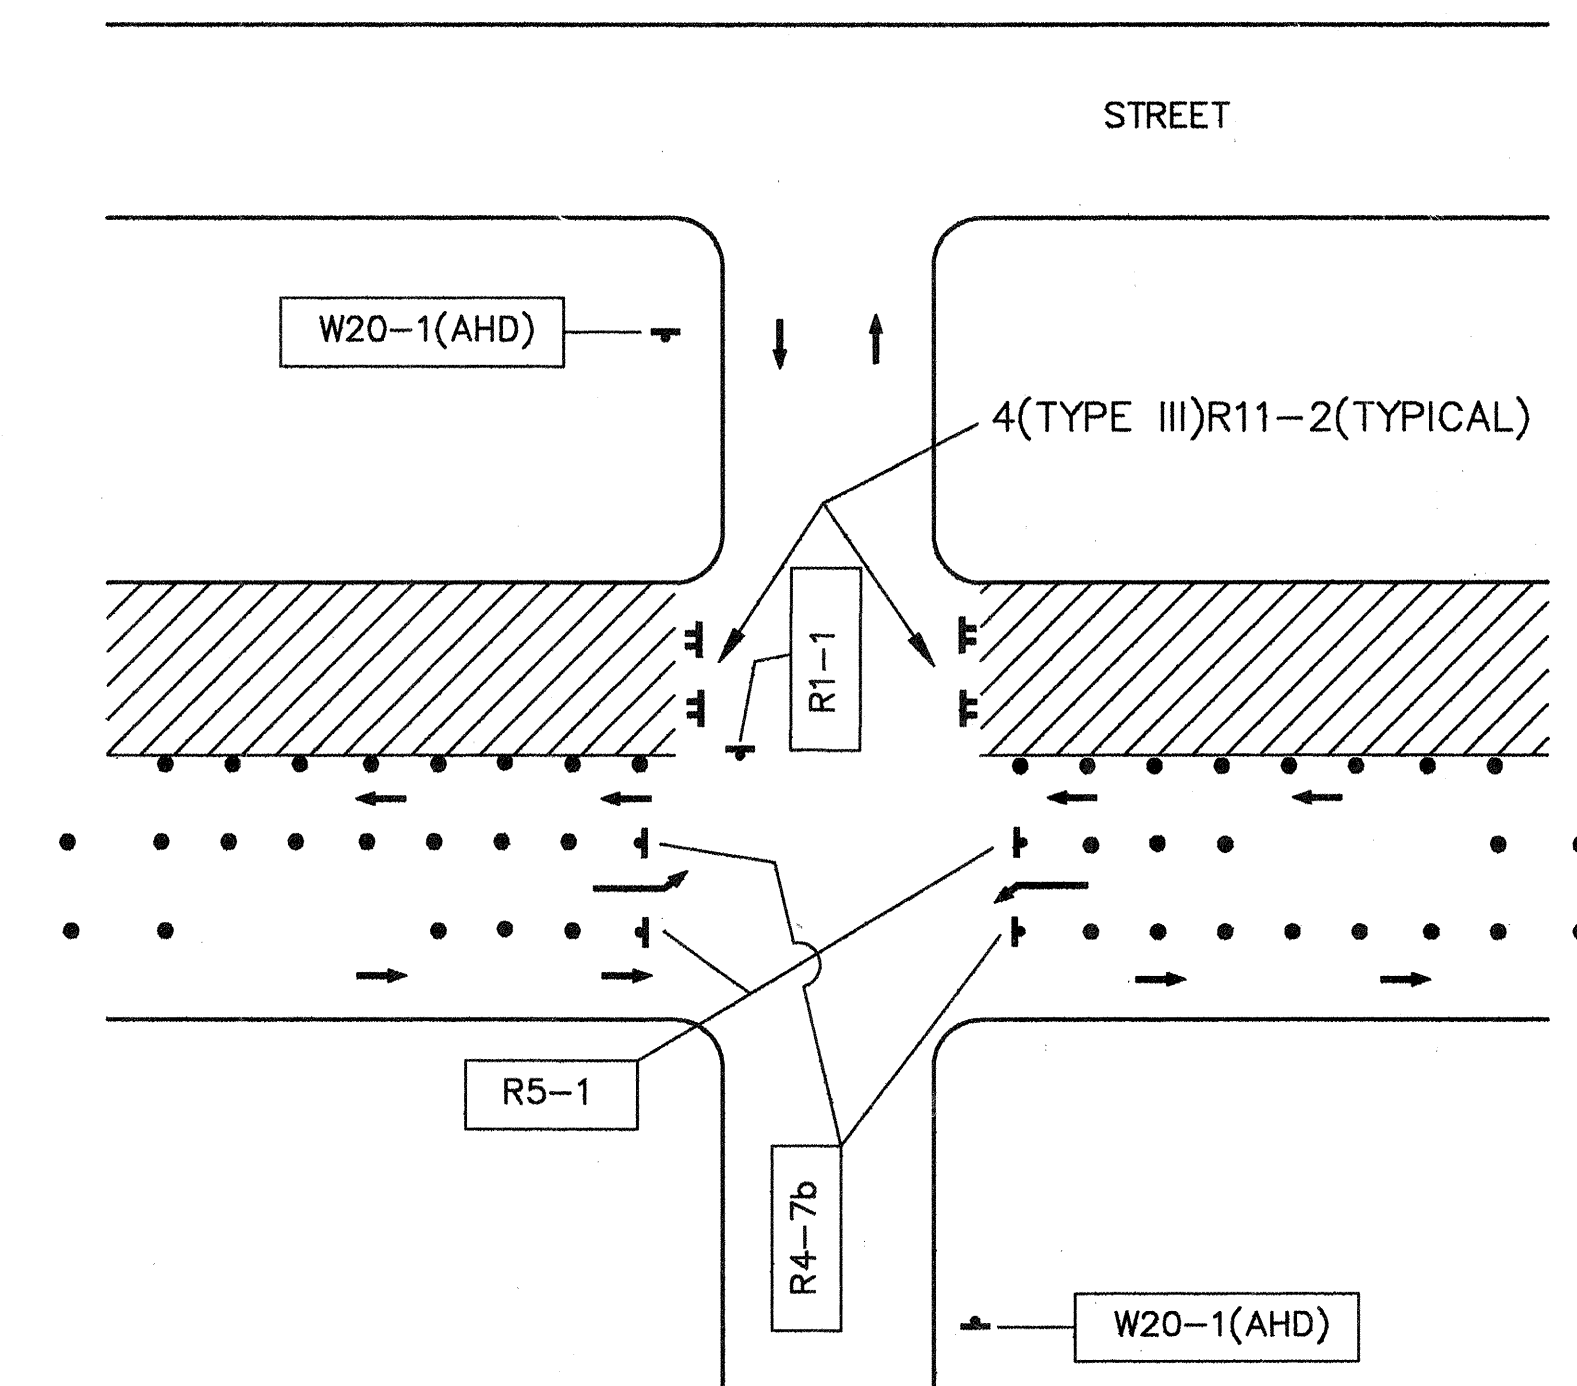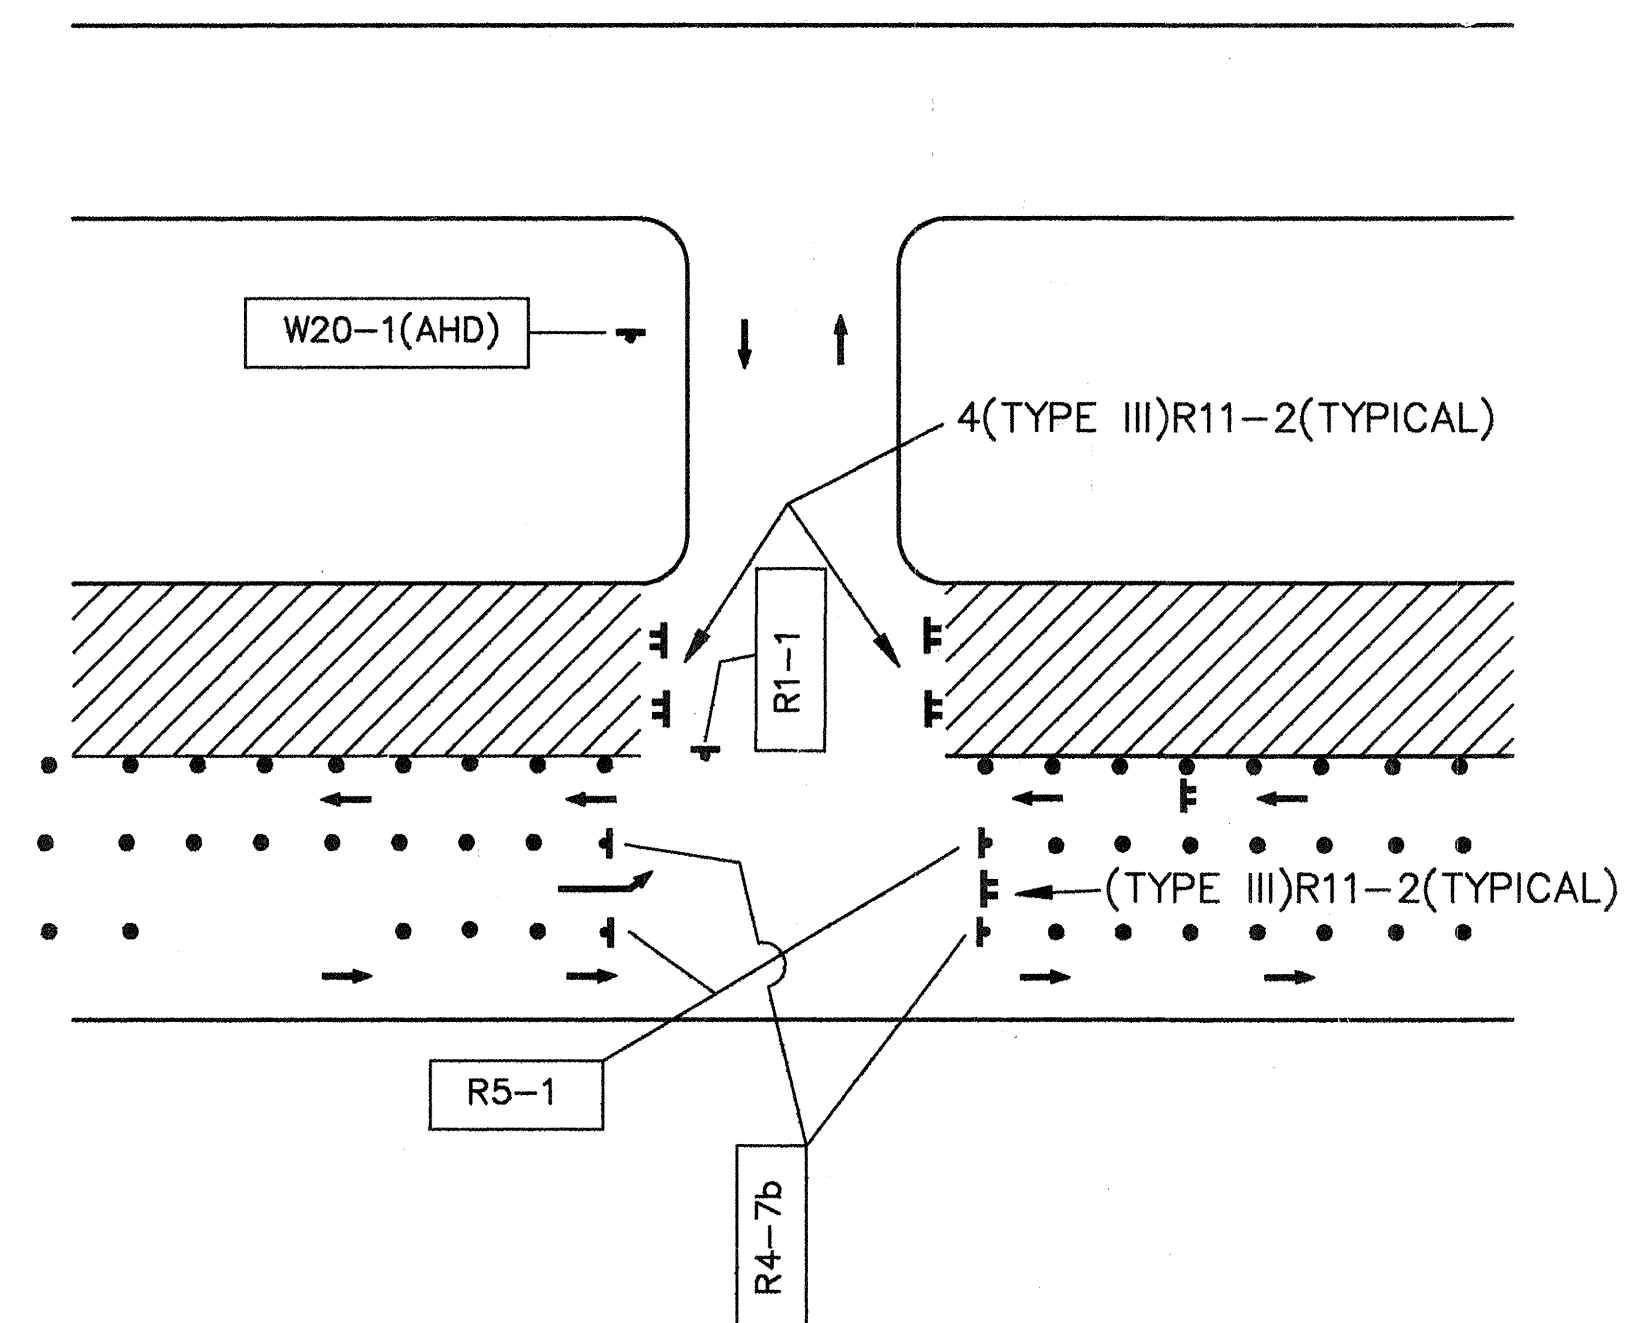

[illegible]

<p style="text-align: center;">CITY OF ALBUQUERQUE PUBLIC WORKS DEPARTMENT ENGINEERING GROUP</p>					
<p style="text-align: center;">TITLE SOUTH VALLEY WATER AND SEWER SYSTEM IMPROVEMENT PROJECT TRAFFIC CONTROL TYPICAL SIDE STREET INTERSECTION SIGNING</p>					
APPROVALS	ENGINEER	DATE	APPROVALS	ENGINEER	DATE
DRC CHAIRMAN	<i>B.G. Goodley</i>	<i>12-13-93</i>	WATER	<i>H.H. Olson</i>	<i>12/10/93</i>
TRANSPORTATION	<i>N/A R.H.O.</i>	<i>12-10-93</i>	WASTE WATER		
HYDROLOGY	<i>N/A J.G.C.</i>	<i>12/10/93</i>			
PROJECT NO.	4515.94		MAP NO. L-10, M-11 M-10, M-11	SHEET	26 OF 26