

NOTICE TO CONTRACTORS

1. ALL WORK DETAILED ON THESE PLANS TO BE PERFORMED UNDER CONTRACT SHALL, EXCEPT AS OTHERWISE STATED OR PROVIDED FOR HEREON, BE CONSTRUCTED IN ACCORDANCE WITH THE CITY OF ALBUQUERQUE STANDARD SPECIFICATIONS FOR PUBLIC WORKS CONSTRUCTION, 1986 EDITION AND SHALL INCLUDE UPDATE No. 4 REVISIONS, DELETIONS, AND ADDITIONS DATED JAN. 28, 1993.
2. TWO WORKING DAYS PRIOR TO ANY EXCAVATION, THE CONTRACTOR MUST CONTACT NEW MEXICO ONE CALL SYSTEM (260-1990) FOR LOCATION OF EXISTING UTILITIES.
3. PRIOR TO CONSTRUCTION, THE CONTRACTOR SHALL EXCAVATE AND VERIFY THE HORIZONTAL AND VERTICAL LOCATIONS OF ALL OBSTRUCTIONS. SHOULD A CONFLICT EXIST, THE CONTRACTOR SHALL NOTIFY THE ENGINEER OR SURVEYOR IMMEDIATELY SO THAT THE CONFLICT CAN BE RESOLVED WITH A MINIMUM AMOUNT OF DELAY.
4. THREE (3) WORKING DAYS PRIOR TO BEGINNING CONSTRUCTION, THE CONTRACTOR SHALL SUBMIT TO CONSTRUCTION COORDINATION DIVISION A DETAILED CONSTRUCTION SCHEDULE. TWO (2) WORKING DAYS PRIOR TO CONSTRUCTION, THE CONTRACTOR SHALL OBTAIN A BARRICADING PERMIT FROM THE CONST. COORDINATION DIVISION. CONTRACTOR SHALL NOTIFY BARRICADE ENGINEER (768-2551) PRIOR TO OCCUPYING AN INTERSECTION. REFER TO SECTION 19 OF THE GENERAL CONDITIONS OF THE STANDARD SPECIFICATIONS.
5. ALL STREET STRIPING ALTERED OR DESTROYED SHALL BE REPLACED IN KIND BY CONTRACTOR TO LOCATION AND IN KIND AS EXISTING OR AS INDICATED BY THIS PLAN SET.
6. CONTRACTOR SHALL NOTIFY THE ENGINEER NOT LESS THAN SEVEN (7) DAYS PRIOR TO STARTING WORK IN ORDER THAT THE ENGINEER MAY TAKE NECESSARY MEASURES TO INSURE THE PRESERVATION OF SURVEY MONUMENTS. CONTRACTOR SHALL NOT DISTURB PERMANENT SURVEY MONUMENTS WITHOUT THE CONSENT OF THE ENGINEER AND SHALL NOTIFY THE ENGINEER AND BEAR THE EXPENSE OF REPLACING ANY THAT MAY BE DISTURBED WITHOUT PERMISSION. REPLACEMENT SHALL BE DONE ONLY BY THE ENGINEER. WHEN A CHANGE IS MADE IN THE FINISHED ELEVATIONS OF THE PAVEMENT OF ANY ROADWAY IN WHICH A PERMANENT SURVEY MONUMENT IS LOCATED, CONTRACTOR SHALL, AT HIS OWN EXPENSE, ADJUST THE MONUMENT COVER TO THE NEW GRADE UNLESS OTHERWISE SPECIFIED. REFER TO SECTION 4.4 OF THE GENERAL CONDITIONS OF THE STANDARD SPECIFICATIONS.
7. CONTRACTOR SHALL CONTACT AND COORDINATE LANDSCAPING EFFORTS (SHEETS 13-18) WITH RICK TRUJILLO, PARKS AND GENERAL SERVICES, 857-8640.

THE FOLLOWING NOTES ALSO APPLY WHEN CHECKED

- ☒ ALL UTILITIES AND UTILITY SERVICE LINES SHALL BE INSTALLED PRIOR TO PAVING.
- ☐ BACKFILL COMPACTION SHALL BE ACCORDING TO SPECIFIED STREET USE.
- ☐ TACK COAT REQUIREMENTS SHALL BE DETERMINED BY THE CITY ENGINEER.
- ☒ SIDEWALKS AND WHEELCHAIR RAMPS WITHIN THE CURB RETURNS SHALL BE CONSTRUCTED WHEREVER A NEW CURB RETURN IS CONSTRUCTED.
- ☒ IF CURB IS DERESSED FOR A DRIVEPAD, THE DRIVEPAD SHALL BE CONSTRUCTED PRIOR TO ACCEPTANCE OF CURB AND GUTTER.
- ☒ ALL STORM DRAINAGE FACILITIES SHALL BE COMPLETED PRIOR TO FINAL ACCEPTANCE.
- ☒ THE REQUESTOR OR DEVELOPER SHALL BE RESPONSIBLE FOR REPAIR OR REPLACEMENT OF ALL CURB AND GUTTER OR SIDEWALK DAMAGED AFTER APPROVAL BY THE CITY ENGINEER OF WORK COMPLETED BY THE CONTRACTOR.

INDEX	
SHEET NUMBER	DESCRIPTION
1	TITLE SHEET
2-3	PLAT
4-5	FINAL GRADING AND DRAINAGE PLAN
6-8	GRADING & DRAINAGE DETAILS
9	OVERALL UTILITY PLAN (For Information Only)
10-12	TRAIL/CHANNEL/STORM DRAIN PLAN & PROFILE SHEETS
13-18	LANDSCAPING PLANS & DETAILS

SCANNED BY
BY LASON

1	2	3	4	5	6	7	8	9	10	11	12	13	14	15
2	6	-	4	5	6	9	.	9	1	0	1	9	4	

APPROVAL OF AS BUILT DRAWINGS
CHIEF CONSTRUCTION ENGINEER
Conrad B. Sisk
DATE *6-22-94*

SURVEYOR'S CERTIFICATION

"I, Timothy Aldrich, a duly qualified Registered Professional Land Surveyor under the laws of the State of New Mexico, do hereby certify that the 'as-built' information shown on these drawings was obtained from field construction and that the surveys performed by me or under my supervision, that the 'as-built' information shown on these drawings was added by me or under my supervision, and that this 'as-built' information is true and correct to the best of my knowledge and belief." Aldrich Land Surveying is not responsible for any of the design concepts, calculations, engineering, or content of the record drawings.

Timothy Aldrich, P.S. No. 7719

1.17.94

BHI JOB NO. 92236.01



BOHANNAN HUSTON INC.

ALBUQUERQUE, NEW MEXICO

ENGINEERS PLANNERS PHOTOGRAMETRISTS


APPROVED FOR
CONSTRUCTION

Records B/P 7/38
C.F.

PROJECT NUMBER

4569.91

SHEET 1 OF 18

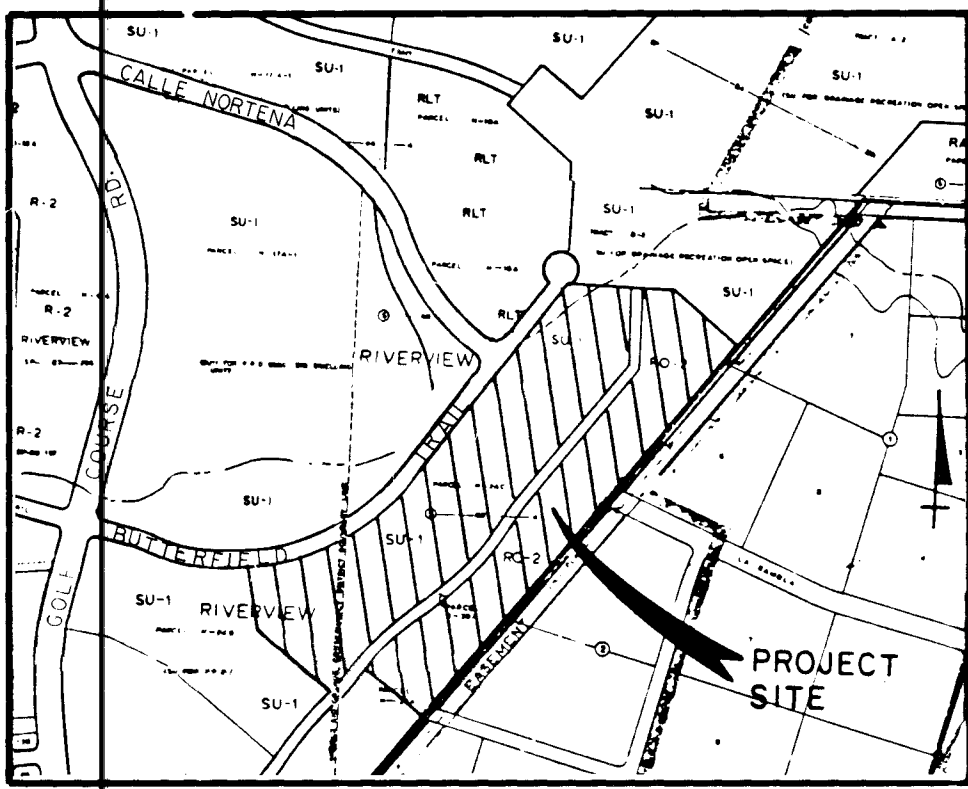

LOCATION MAP
ZONE ATLAS INDEX MAP Nos D-12
NOT TO SCALE

NOTES

- DRB No. 92-0109
- Grass subdivision acreage: 26.0374 Acres.
- Date of survey: December, 1992.
- City of Albuquerque Water and Sanitary Sewer Service to Lots 1-85 must be verified and coordinated with the Public Works Department, City of Albuquerque.
- Total number of lots created: 85 Lots and 3 Tracts.
- Boundaries are New Mexico State Plane Grid Bearings (Central Zone).
- Distances are ground distances.
- This site is located within Section 24, T11N, R2E, N.M.P.M., City of Albuquerque.
- All lots designated "P1" shall conform to Item 11, Intermittent Parking Criteria. This requires four off street parking spaces per lot for homes containing four bedrooms or less, which can be provided by a two-car garage with driveway. Homes containing five bedrooms will require three-car garages.
- Private Access Easement for Lots 81-85, to be maintained by said owners.
- Public Access Easement granted for pedestrian, equestrian, and bicycle access to Piedras Marcadas Dam to be maintained by the respective owners.
- Tracts A, B and C are dedicated to the City of Albuquerque as Permanent Trails. Maintenance and easements are reserved for construction and maintenance of trails, open spaces, landscaping, recreational uses, utilities, access and service roads.
- No lot shall be allowed direct access to Butterfield Trail.
- Owner of Lot 9 shall maintain the public drainage easement on Lot 9.
- Private access easement to be maintained by owners of lots encumbered. Public utilities within these easements to be maintained by the owners of the utilities.
- Public street right-of-way dedicated by this plat: 3.8210 Ac.
- Public access right-of-way dedicated by this plat: 0.1271 Ac.
- Centerline (in lieu of R/W monumentation) to be installed at all centerline, P.C.'s, P.T.'s, angle points and street intersections prior to acceptance of subdivision improvements and will consist of a standard four (4) inch (4") aluminum alloy cap stamped "City of Albuquerque", "Centerline Monumentation", "Survey Marker", "Do Not Disturb", "PLS 5000".

DISCLOSURE STATEMENT

The purpose of this plat is to subdivide Parcel H-24C-1 and Parcel H-25A-2, dedicate public street right-of-way, dedicate public access right-of-way, grant easements, and to vacate the blanket drainage easements upon Tracts H-24C-1 and Tract H-25A-2, record by Quilleya Deeds from the AMAFCA Board of Directors, filed March 2, 1993 as Document Nos. 0005663 and 0005664 respectively, and approved by the DRB as V-92-60.

PUBLIC UTILITY EASEMENTS

PUBLIC UTILITY EASEMENTS (PUE) shown on this plat are granted for the common joint use of:

- The Public Service Company of New Mexico for the installation, maintenance, and service of overhead and underground electrical lines, transformers, and other equipment, structures and related facilities reasonably necessary to provide electrical service.
- The Gas Company of New Mexico for installation, maintenance, and service of natural gas lines, buildings, and other equipment and facilities reasonably necessary to provide natural gas.
- US West for the installation, maintenance and service of all buried and aerial communication lines and other related equipment and facilities reasonably necessary to provide communication services including but not limited to above ground pedestals and closures.
- Jones Interconnect for the installation, maintenance, and service of such lines, cables and other related equipment and facilities reasonably necessary to provide Cable TV service.

Included is the right to build, rebuild, construct, reconstruct, locate, relocate, change, remove, modify, renew, operate, and maintain facilities for the purposes described above, together with free access to and use of said easements, including sufficient working area space for electric transformers, with the right and privilege to trim and remove trees, shrubs or bushes which interfere with the purposes set forth herein. No building, sign, pool, above ground or subterranean, hot tub, concrete or wood pool decking, or other structure shall be erected or constructed on said easements, nor shall any well be drilled or operated thereon. Property owners shall be solely responsible for correcting any violations of National Electric Safety Code caused by construction of pools, decking or other structures adjacent to or on said easements shown on this plat.

DESCRIPTION

Certain tracts of land situate within Section 24, T11N, R2E, N.M.P.M., City of Albuquerque, Bernalillo County, New Mexico, being PARCEL H-24C-1 of RIVERVIEW ESTATES, H-17A-1B1, H-17A-1B2, H-18A-1 and H-24C-1 as the same is shown and designated on the plat thereof filed in the office of the County Clerk of Bernalillo County, New Mexico on May 20, 1992 in Volume 92C, folio 35 together with PARCEL H-25A-1 of RIVERVIEW ESTATES, H-25A-1 and H-25A-2 as the same is shown and designated on the plat thereof filed in the office of the County Clerk of Bernalillo County, New Mexico on March 6, 1992 in Volume 92C, folio 36, said PARCEL H-24C-1 being more particularly described by New Mexico State Plane Grid Bearings (Central Zone) and ground distances as follows:

BEGINNING at a 5/8" rebar with a yellow plastic survey cap stamped "WEAVER LS 6544" at the northeast corner of said PARCEL H-24C-1, being a point on the southerly right-of-way line of the Piedras Marcadas Arroyo, whence the ACS monument "R. Alameda B", No. 27, a metal tablet set in concrete having New Mexico State Plane Grid Coordinates for Central Zone: X=373,513.20 and Y=1,520,142.81 bears N50°28'16"E a distance of 2411.52 feet and from said point of beginning, leaving said Arroyo right-of-way line and running along the easterly boundary line of said PARCEL H-24C-1, 500°00'44"E a distance of 258.17 feet to a 5/8" rebar as described above thence, S38°33'40"W a distance of 655.35 feet to a 1-1/2" alloy cap stamped "CSC LS 7270" at a point of tangency thence, 78.52 feet along the arc of a curve to the left having a radius of 440.00 feet and a chord bearing S33°26'55"W a distance of 78.42 feet to a 1-1/2" alloy cap as described above, at a point of reverse curvature thence, 203.93 feet along the arc of a curve to the right having a radius of 895.00 feet and a chord bearing S34°51'49"W a distance of 203.49 feet to a 1-1/2" alloy cap as described above, at a point of compound curvature thence, 286.90 feet along the arc of a curve to the right having a radius of 1310.58 feet and a chord bearing S41°51'W a distance of 270.17 feet to a 1-1/2" alloy cap as described above, at a point of tangency thence, S38°33'40"W a distance of 123.20 feet to a 1-1/2" alloy cap as described above, at a point of curvature thence, 36.75 feet along the arc of a curve to the right having a radius of 250.00 feet and a chord bearing S42°46'22"W a distance of 36.72 feet to a 1-1/2" alloy cap as described above, at a point of reverse curvature thence, 20.78 feet along the arc of a curve to the left having a radius of 1256.25 feet and a chord bearing S45°30'35"W a distance of 20.78 feet to a 1-1/2" alloy cap as described above, at a point of tangency thence, southerly corner of said PARCEL H-24C-1 thence running along the southerly boundary line of said PARCEL H-24C-1, N51°26'20"W a distance of 368.66 feet to a 1-1/2" alloy cap as described above thence, N10°57'40"W a distance of 236.51 feet to a 5/8" rebar as described above, at a point on curve on the easterly right-of-way line of Butterfield Trail N.W. thence running along said right-of-way line and the northerly boundary line of said PARCEL H-24C-1, 296.60 feet along the arc of a curve to the left having a radius of 772.53 feet and a chord bearing N75°04'49"E a distance of 294.78 feet to a 5/8" rebar as described above, at a point of compound curvature thence, 372.50 feet along the arc of a curve to the left having a radius of 940.58 feet and a chord bearing N52°44'10"E a distance of 370.07 feet to a 5/8" rebar as described above, at a point of compound curvature thence, 134.25 feet along the arc of a curve to the left having a radius of 525.00 feet and a chord bearing N34°03'53"E a distance of 133.89 feet to a 5/8" rebar as described above, at a point of reverse curvature thence, 97.94 feet along the arc of a curve to the right having a radius of 475.00 feet and a chord bearing N32°38'45"E a distance of 97.77 feet to a 5/8" rebar as described above, at a point of tangency thence, N38°33'11"E a distance of 665.21 feet to a point of curvature thence, 9.32 feet along the arc of a curve to the right having a radius of 25.00 feet and a chord bearing N49°14'08"E a distance of 9.27 feet to a 5/8" rebar as described above, at a point of reverse curvature thence, 47.07 feet along the arc of a curve to the left having a radius of 45.00 feet and a chord bearing N29°57'10"E a distance of 44.95 feet to an A.M.A.F.C.A. brass cap at the northeast corner of said PARCEL H-24C-1 thence leaving said easterly right-of-way line and running along the said southerly right-of-way line of the Piedras Marcadas Arroyo and the northerly boundary line of said PARCEL H-24C-1, S89°58'25"E a distance of 273.70 feet to the point and place of beginning.

PARCEL H-24C-1 contains 16.0237 acres, more or less together with PARCEL H-25A-2, which is more particularly described by New Mexico State Plane Grid Bearings (Central Zone) and ground distances as follows:

BEGINNING at an A.M.A.F.C.A. brass cap at the most easterly corner of said PARCEL H-25A-2, being a point on the southerly right-of-way line of the Piedras Marcadas Arroyo, whence the ACS monument "R. Alameda B", No. 27, a metal tablet set in concrete having New Mexico State Plane Grid Coordinates for Central Zone: X=373,513.20 and Y=1,520,142.81 bears N40°17'18"E a distance of 2262.51 feet and from said point of beginning, leaving said Arroyo right-of-way line and running along the southerly boundary line of said PARCEL H-25A-2, S38°33'52"W a distance of 1767.32 feet to a rebar with blue survey cap stamped "LS 7270" at the most southerly corner of said PARCEL H-25A-2 thence running along the southerly boundary line of said PARCEL H-25A-2, N51°26'08"W a distance of 289.52 feet to a rebar with blue survey cap stamped "LS 7270" at a point on curve on the most easterly corner of said PARCEL H-25A-2 thence running along the northerly boundary line of said PARCEL H-25A-2, 240.66 feet along the arc of a curve to the right having a radius of 970.00 feet and a chord bearing N45°49'33"E a distance of 240.04 feet to a 1-1/2" alloy cap stamped "CSC LS 7270" at a point of reverse curvature thence, 295.66 feet along the arc of a curve to the left having a radius of 1350.58 feet and a chord bearing N47°39'45"E a distance of 295.06 feet to a 1-1/2" alloy cap as described above, at a point of compound curvature thence, 213.04 feet along the arc of a curve to the left having a radius of 935.00 feet and a chord bearing N34°51'49"E a distance of 212.58 feet to a 1-1/2" alloy cap as described above, at a point of tangency thence, 71.38 feet along the arc of a curve to the right having a radius of 400.00 feet and a chord bearing N33°26'55"E a distance of 71.29 feet to a 1-1/2" alloy cap as described above, at a point of tangency thence, N38°33'40"W a distance of 669.35 feet to a 5/8" rebar as described above thence, N00°00'44"W a distance of 272.14 feet to a 5/8" rebar as described above, at the northerly corner of said PARCEL H-25A-2 thence running along the said southerly right-of-way line of the Piedras Marcadas Arroyo and the northerly boundary line of said PARCEL H-25A-2, S89°58'25"E a distance of 98.23 feet to an A.M.A.F.C.A. brass cap thence, S53°34'07"E a distance of 321.58 feet to the point and place of beginning.

PARCEL H-25A-2 contains 10.0137 acres, more or less.

TOTAL ACREAGE is 26.0374 acres, more or less.

PLAT OF RANCHO SERENO SUBDIVISION UNIT 1

ALBUQUERQUE, NEW MEXICO

DECEMBER, 1992

FREE CONSENT AND DEDICATION

Being Replat of those certain tracts of land situate within Section 24, T11N, R2E, N.M.P.M., City of Albuquerque, Bernalillo County, New Mexico, being PARCEL H-24C-1 of RIVERVIEW ESTATES, H-17A-1B1, H-17A-1B2, H-18A-1 and H-24C-1 as the same is shown and designated on the plat thereof filed in the office of the County Clerk of Bernalillo County, New Mexico on May 20, 1992 in Volume 92C, folio 35 together with PARCEL H-25A-1 of RIVERVIEW ESTATES, H-25A-1 and H-25A-2 as the same is shown and designated on the plat thereof filed in the office of the County Clerk of Bernalillo County, New Mexico on March 6, 1992 in Volume 92C, folio 36, and now hereon comprising RANCHO SERENO SUBDIVISION, UNIT 1 is with free consent and in accordance with the desires of the undersigned owner(s) and/or proprietor(s) thereof, and said owner(s) and/or proprietor(s) hereby dedicate additional public street and public access right-of-way and do also hereby grant all easements shown on this plat. Electrical Power and Communication easements are reserved for buried distribution lines, conduits, and pipes for underground utilities and other related equipment where shown or indicated, and including the right of ingress and egress for construction, and maintenance, and the right to trim interfering trees and shrubs.

Richard Mallett
Richard Mallett, President
CENTEX REAL ESTATE CORPORATION

State of New Mexico)
County of Bernalillo)

I, Richard Mallett, instrument was acknowledged before me this 24th day of December, 1993 by Richard Mallett, President of CENTEX REAL ESTATE CORPORATION.

My Commission Expires 9/23/96 Richard M. Mallett
Notary Public

APPROVALS

PLAT NUMBER	DATE
<u>S-92-38</u>	<u>9/21/93</u>
<u>Planning Director</u>	<u>9/21/93</u>
<u>City Engineer</u>	<u>9/21/93</u>
<u>A.M.A.F.C.A.</u>	<u>9/21/93</u>
<u>Tract Engineer</u>	<u>9/21/93</u>
<u>City Engineer</u>	<u>9/21/93</u>
<u>Property Management</u>	<u>9/21/93</u>
<u>Utility Development</u>	<u>9/21/93</u>
<u>Parks and Recreation</u>	<u>9/21/93</u>
<u>Public Service Company of New Mexico</u>	<u>9/21/93</u>
<u>U.S. West Communications</u>	<u>9/21/93</u>
<u>Gas Company of New Mexico</u>	<u>9/21/93</u>

THIS IS TO CERTIFY THAT TAXES ARE CURRENT AND PAID
ON UPON 4 Code Numbers - See Attached Tax Certificate
PROPERTY OWNER OF RECORD: Bellamont Comm. Dev. + City of Albany
William Savanna 4-22-93
BERNALILLO COUNTY TREASURER'S OFFICE DATE

CERTIFICATION


I, Thomas G. Klingenhagen, a registered Professional New Mexico Surveyor, certify that this plat was prepared by me or under my supervision, shows all necessary records, meets the minimum requirements for monumentation and surveys contained in the Albuquerque Subdivision Ordinance, and is true and accurate to the best of my knowledge and belief.

Thomas G. Klingenhagen
New Mexico Surveyor 5978

Date:


Bohannon-Huston, Inc.
Courtland
7500 Jefferson Street, N.E.
Albuquerque, New Mexico 87109

JOB NO. 92-36-81

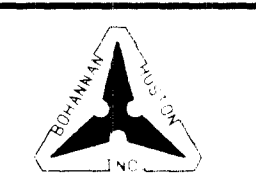

SHEET 1 OF 3 SHEETS

1914 (1)

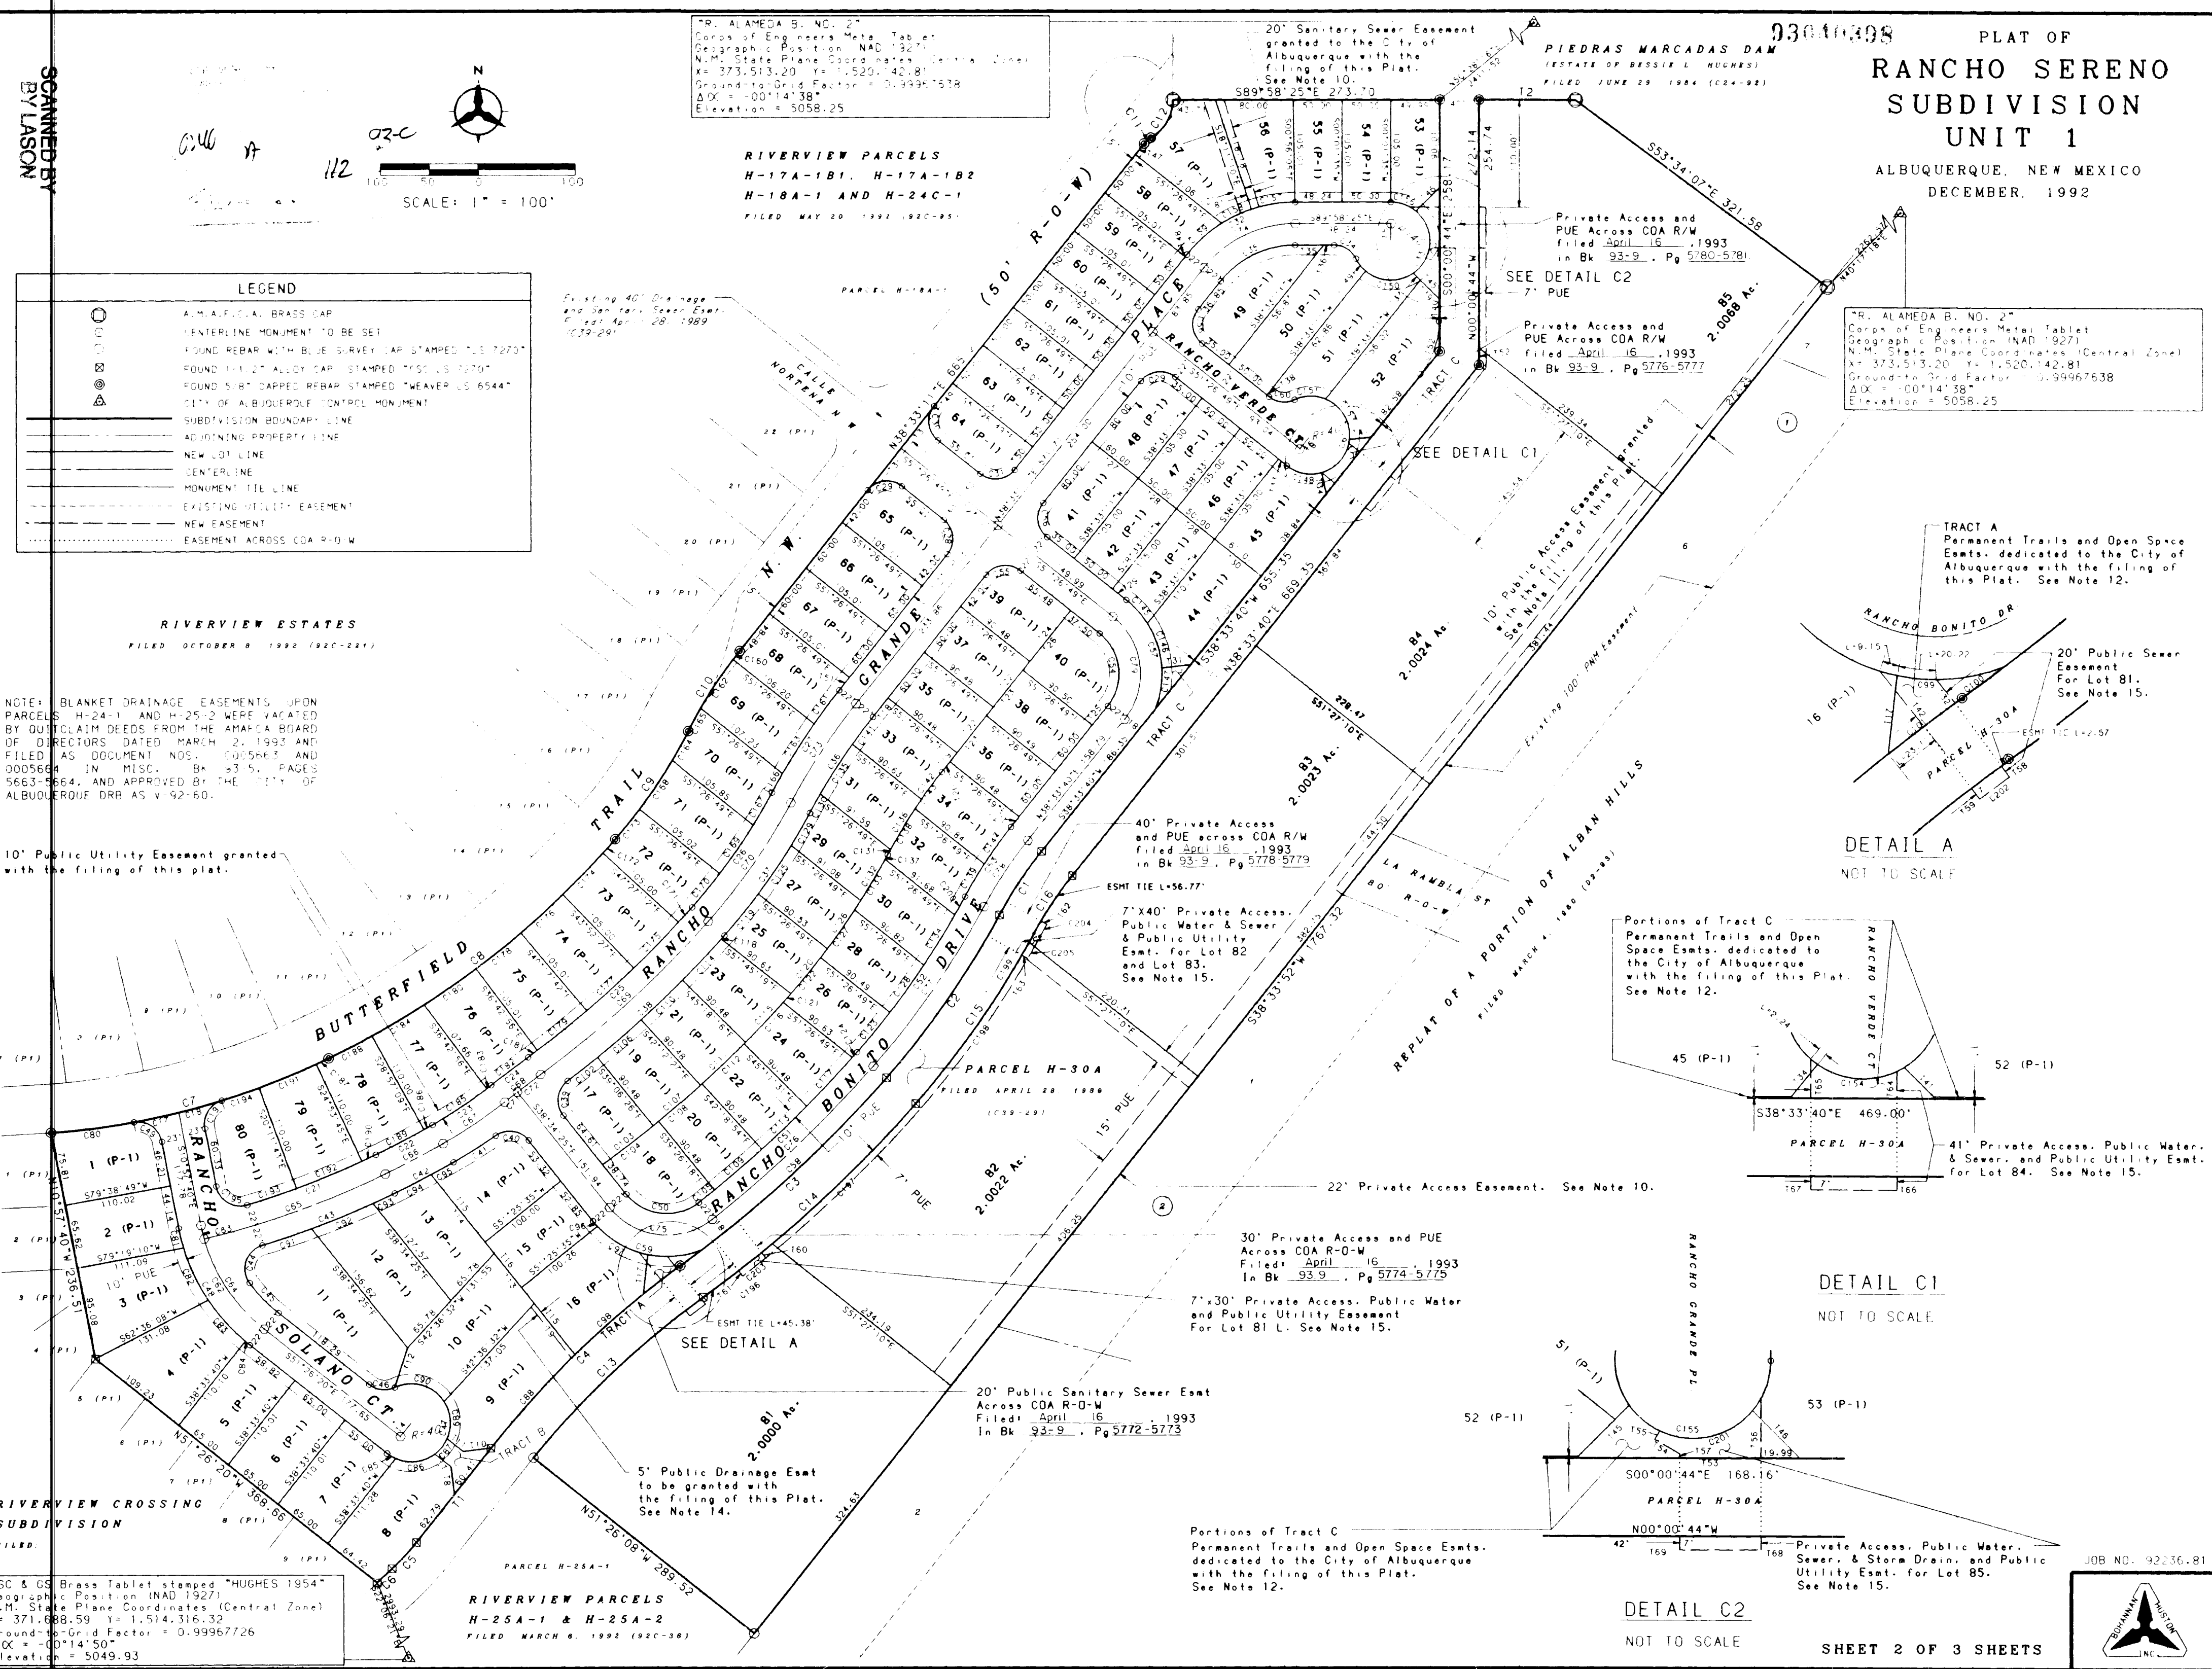

NOT TO SCALE

SHEET 2 OF 3 SHEETS

1914 (2)






159236812 SHEET 2 OF 3

1 2 3 4 5 6 7 8 9 10 11 12 13 14 15
16 17 18 19 20 21 22 23 24 25 26 27 28 29 30
31 32 33 34 35 36 37 38 39 40 41 42 43 44 45
46 47 48 49 50 51 52 53 54 55 56 57 58 59 60
61 62 63 64 65 66 67 68 69 70 71 72 73 74 75
76 77 78 79 80 81 82 83 84 85 86 87 88 89 90
91 92 93 94 95 96 97 98 99 100

AREAS	
LOT	ACREAGE
1	0.1794
2	0.1651
3	0.2084
4	0.2189
5	0.1642
6	0.1641
7	0.1642
8	0.2047
9	0.2221
10	0.2181
11	0.3011
12	0.2114
13	0.1718
14	0.1840
15	0.1378
16	0.2110
17	0.1322
18	0.1386
19	0.1275
20	0.1278
21	0.1275
22	0.1278
23	0.1308
24	0.1315
25	0.1242
26	0.1247
27	0.1250
28	0.1248
29	0.1261
30	0.1256
31	0.1254
32	0.1259
33	0.1247
34	0.1248
35	0.1246
36	0.1246
37	0.1246
38	0.1246
39	0.1361
40	0.1493
41	0.1416
42	0.1205
43	0.1218
44	0.1205
45	0.1529
46	0.1205
47	0.1205
48	0.1416
49	0.1728
50	0.1897
51	0.1828
52	0.1994
53	0.1208
54	0.1205
55	0.1184
56	0.1560
57	0.1902
58	0.1234
59	0.1205
60	0.1205
61	0.1205
62	0.1205
63	0.1205
64	0.1205
65	0.1205
66	0.1205
67	0.1446
68	0.1451
69	0.1473
70	0.1469
71	0.1451
72	0.1501
73	0.1495
74	0.1496
75	0.1496
76	0.1578
77	0.1748
78	0.1704
79	0.1714
80	0.1756
81	2.0006
82	2.0022
83	2.0023
84	2.0024
85	2.0068
TRACT A	0.0213
TRACT B	0.0278
TRACT C	0.0780
ROADS	3.8210

CURVE DATA									
NUMBER	ARC	RADIUS	DELTA	CHORD	CHORD BEARING	TANGENT	NUMBER	ARC	RADIUS
C1	78.52	440.00	10°13'30"	78.42	S33°26'55"W	39.37	C103	65.66	1180.10
C2	203.93	895.00	13°03'18"	203.49	S34°51'49"W	102.41	C104	72.48	1180.10
C3	296.90	1310.58	12°32'33"	286.32	S47°39'45"W	144.02	C105	20.90	1270.58
C4	270.98	1010.00	15°22'21"	270.17	S46°14'51"W	136.31	C106	58.92	1089.62
C5	36.75	250.00	8°25'23"	36.72	S42°46'22"W	18.41	C107	63.82	1180.10
C6	20.79	1256.25	0°56'54"	20.79	S46°30'35"W	10.40	C108	59.25	1180.10
C7	296.60	772.53	21°59'53"	294.98	N73°04'40"E	150.15	C109	63.80	1270.58
C8	372.50	940.58	22°41'27"	370.07	N52°44'10"E	188.72	C110	58.93	1089.62
C9	134.25	525.00	14°39'07"	133.89	N34°03'53"E	67.50	C111	63.82	1180.10
C10	97.94	475.00	11°48'52"	97.77	N32°38'45"E	49.15	C112	59.25	1180.10
C11	9.32	25.00	1°21'50"	9.27	N49°14'08"E	4.72	C113	63.80	1270.58
C12	47.07	45.00	59°55'41"	44.95	N29°57'10"E	25.94	C114	57.96	1089.62
C13	240.66	970.00	14°12'55"	240.04	N46°49'33"E	120.95	C115	68.06	1180.10
C14	295.66	1350.58	12°32'33"	295.06	N47°39'45"E	148.42	C116	58.37	1180.10
C15	213.04	935.00	13°03'18"	212.58	N34°51'49"E	106.98	C117	68.25	1270.58
C16	71.38	400.00	10°13'30"	71.29	N33°26'55"E	35.79	C118	4.97	1089.62
C17	47.71	772.53	3°32'19"	47.70	N77°57'54"E	23.86	C119	55.05	674.04
C18	75.44	772.53	3°32'19"	75.44	N76°30'38"E	22.73	C120	59.53	764.52
C19	36.56	25.00	83°47'11"	33.39	S30°55'56"W	22.43	C121	12.01	1180.10
C20	41.79	25.00	95°46'38"	37.09	S58°50'59"E	27.66	C122	48.03	764.52
C21	141.41	182.53	9°10'49"	141.25	N68°40'17"E	70.85	C123	52.51	955.00
C22	65.49	1050.58	3°34'17"	65.47	N62°17'44"E	32.75	C124	7.52	1270.58
C23	72.73	478.00	8°43'03"	72.66	N56°09'05"E	36.43	C125	60.20	674.04
C24	47.64	1274.96	2°08'28"	47.64	N52°51'47"E	23.82	C126	60.15	764.52
C25	1045.62	1045.62	12°32'33"	1045.44	N47°39'45"E	114.91	C127	60.10	764.52
C26	143.56	630.04	13°03'18"	143.25	N34°51'49"E	72.09	C128	60.08	855.00
C27	125.71	704.96	10°13'30"	125.54	N33°26'40"E	63.02	C129	38.33	674.04
C28	39.27	25.00	90°00'00"	35.36	N06°26'49"E	25.00	C130	22.39	660.96
C29	39.27	25.00	90°00'00"	35.36	S03°33'11"E	25.00	C131	57.05	674.04
C30	39.27	25.00	90°00'00"	35.36	S06°26'49"E	25.00	C132	54.51	764.52
C31	39.27	25.00	90°00'00"	35.36	N83°33'11"E	25.00	C133	60.54	764.52
C32	127.57	142.00	51°28'24"	123.32	N64°17'23"E	68.45	C134	60.43	855.00
C33	170.00	40.00	24°3'30"10"	68.03	S31°46'40"W	0.00	C135	60.32	660.96
C34	27.71	25.00	63°30'10"	26.31	N58°13'20"W	15.47	C136	60.42	570.48
C35	88.04	98.00	51°28'24"	85.11	S64°17'23"E	47.24	C137	5.53	764.52
C36	117.86	660.96	10°13'30"	117.71	S33°26'40"W	59.09	C138	55.04	570.48
C37	153.58	674.04	13°03'18"	153.25	S34°51'49"W	77.12	C139	38.88	480.00
C38	219.83	1089.62	11°33'34"	219.46	S47°10'15"E	110.29	C140	0.45	480.00
C39	39.93	25.00	91°31'26"	35.82	S07°11'13"E	25.67	C141	35.16	660.96
C40	37.75	25.00	86°30'22"	34.26	N81°49'37"W	23.52	C142	35.16	570.48
C41	50.93	522.00	5°35'24"	50.91	S57°42'54"W	25.48	C143	46.69	570.48
C42	68.23	1094.58	3°34'17"	68.22	S62°17'44"W	34.13	C144	46.78	480.00
C43	145.73	926.53	9°00'43"	145.58	S68°15'14"W	73.62	C145	32.63	97.00
C44	47.53	25.00	108°55'37"	40.69	S13°37'47"E	35.00	C146	48.53	97.00
C45	42.76	157.00	15°36'19"	42.63	S43°38'17"E	21.51	C147	43.28	97.00
C46	25.77	25.00	91°31'26"	26.32	S83°10'35"E	15.48	C148	40.56	40.00
C47	169.99	40.00	24°3'30"10"	168.03	S06°48'08"E	0.00	C149	68.01	40.00
C48	143.41	203.00	40°28'40"	140.45	S31°12'00"W	74.85	C150	52.80	40.00
C49	38.97	25.00	89°18'17"	35.14	N55°36'48"W	24.70	C151	33.15	40.00
C50	53.18	25.00	89°55'20"	105.99	S83°32'05"E	74.90	C152	27.92	40.00
C51	224.26	1270.58	10°06'46"	223.97	N46°26'51"E	112.42	C153	51.75	40.00
C52	194.81	855.00	13°03'18"	194.39	N34°51'49"E	97.83	C154	44.54	40.00
C53	100.13	480.00	10°13'30"	100.00	S33°26'55"E	42.94	C155	73.17	40.00
C54	83.26	53.00	90°00'00"	74.96	N06°26'49"E	23.01	C156	74.96	40.00
C55	39.27	25.00	90°00'00"	35.36	S83°33'17"W	25.00	C157	45.60	142.00
C56	39.27	25.00	90°00'00"	35.36	S06°26'49"E	25.00	C158	33.90	142.00
C57	124.43	97.00	73°29'48"	116.07	S14°41'55"E	72.43	C159	48.06	142.00
C58	259.92	1310.58	11°21'47"	259.49	S47°04'22"W	130.39	C160	11.17	475.00
C59	123.20	97.00	72°46'28"	11.509	N74°57'39"W	71.48	C161	43.17	704.96
C60	27.71	25.00	63°30'10"	26.31	N83°11'54"E	15.47	C162	60.27	475.00
C61	170.00	40.00	24°3'30"10"	168.03	S06°48'08"E	0.00	C163	60.34	704.96
C62	127.16	180.00	40°28'40"	124.54	S31°12'00"W	66.37	C164	34.43	525.00
C63	14.36	180.00	4°34'12"	14.35	S13°14'46"E	7.18	C165	26.51	475.00
C64	112.81	180.00	35°54'28"	110.97	S33°29'06"E	58.33	C166	22.20	704.96
C65	97.23	904.53	12°29'35"	196.84	N70°19'41"E	99.01	C167	38.52	530.04
C66	66.86	1072.58	3°34'17"	66.85	N62°17'44"E	33.44	C168	60.24	525.00
C67	76.07	500.00	8°43'03"	76.00	N56°09'05"E	38.11	C169	60.17	630.04
C68	46.82	1252.96	2°08'28"	46.82	N52°51'47"E	23.41	C170	44.87	630.04
C69	233.71	1067.62	12°32'33"	233.24	N47°39'45"E	117.32	C171	21.08	1045.62
C70	46.57	652.04	13°03'18"	46.25	N34°51'49"E	74.61	C172	19.05	940.58
C71	18.86	1252.96	0°46'16"	18.86	N22°10'40"E	8.43	C173	39.58	525.00
C72	29.86	1252.96	1°22'11"	29.86	N53°14'56"E	14.98	C174	58.76	940.58
C73	121.79	682.96	10°13'30"	121.62	N33°26'40"E	61.05	C175	65.32	1045.62
C74	107.81	120.00	51°28'24"	104.22	N64°17'23"E	57.85	C176	58.76	940.58
C75	117.71	75.00	89°55'20"	105.99	S83°32'05"E	74.90	C177	105.52	1045.62
C76	228.15	1292.58	10°06'46"	227.85	N46°26'51"E	114.37	C178	58.76	940.58
C77	199.82	877.01	13°03'17"	199.39	N34°51'41"E	100.35	C179	65.32	1045.62
C78	27.73	458.00	63°30'10"	81.63	N33°26'55"E	40.98	C180	65.05	940.58
C79	170.00	40.00	24°3'30"10"	168.03	S06°48'08"E	0.00	C181	11.85	1045.62
C80	85.55	772.53	6°20'42"	85.51	N82°54'25"E	42.82	C182	47.64	1274.96
C81	20.90	203.00	5°53'58"	20.89	S13°54'39"E	10.46	C183	5.51	478.00
C82	59.50	203.00	16°47'32"	59.28	S25°15'23"E	29.96	C184	62.30	940.58
C83	56.83	203.00	16°02'27"	56.65	S41°40'23"E	28.60	C185	47.22	475.00
C84	6.18	203.00	1°44'43"	6.18	S50°33'58"E	3.09	C186	9.85	1050.58
C85	10.11	40.00	14°28'39"	10.08	S58°40'40"E	5.08	C187	13.78	772.53
C86	42.62	40.00	61°02'42"	40.63	N83°33'40"E	23.58	C188	49.81	940.58
C87	20.21	40.00	28°57'18"	20.00	N38°33'40"E	10.33	C189	55.64	1050.58
C88	29.51	1010.00	7°20'48"	129.42	S42°14'04"W	64.84	C190	15.75	882.53
C89	39.65	1010.00	56°47'56"	38.05	N04°10'57"W	21.63	C191	63.38	882.53
C90	57.40	40.00	82°13'34"	52.60	N73°49'43"W	34.91	C192	72.40	882.53

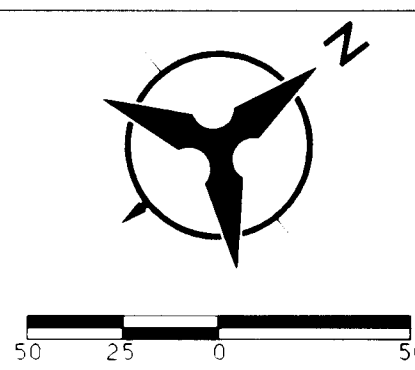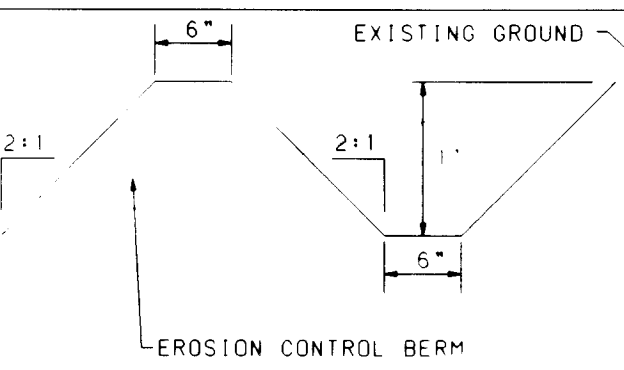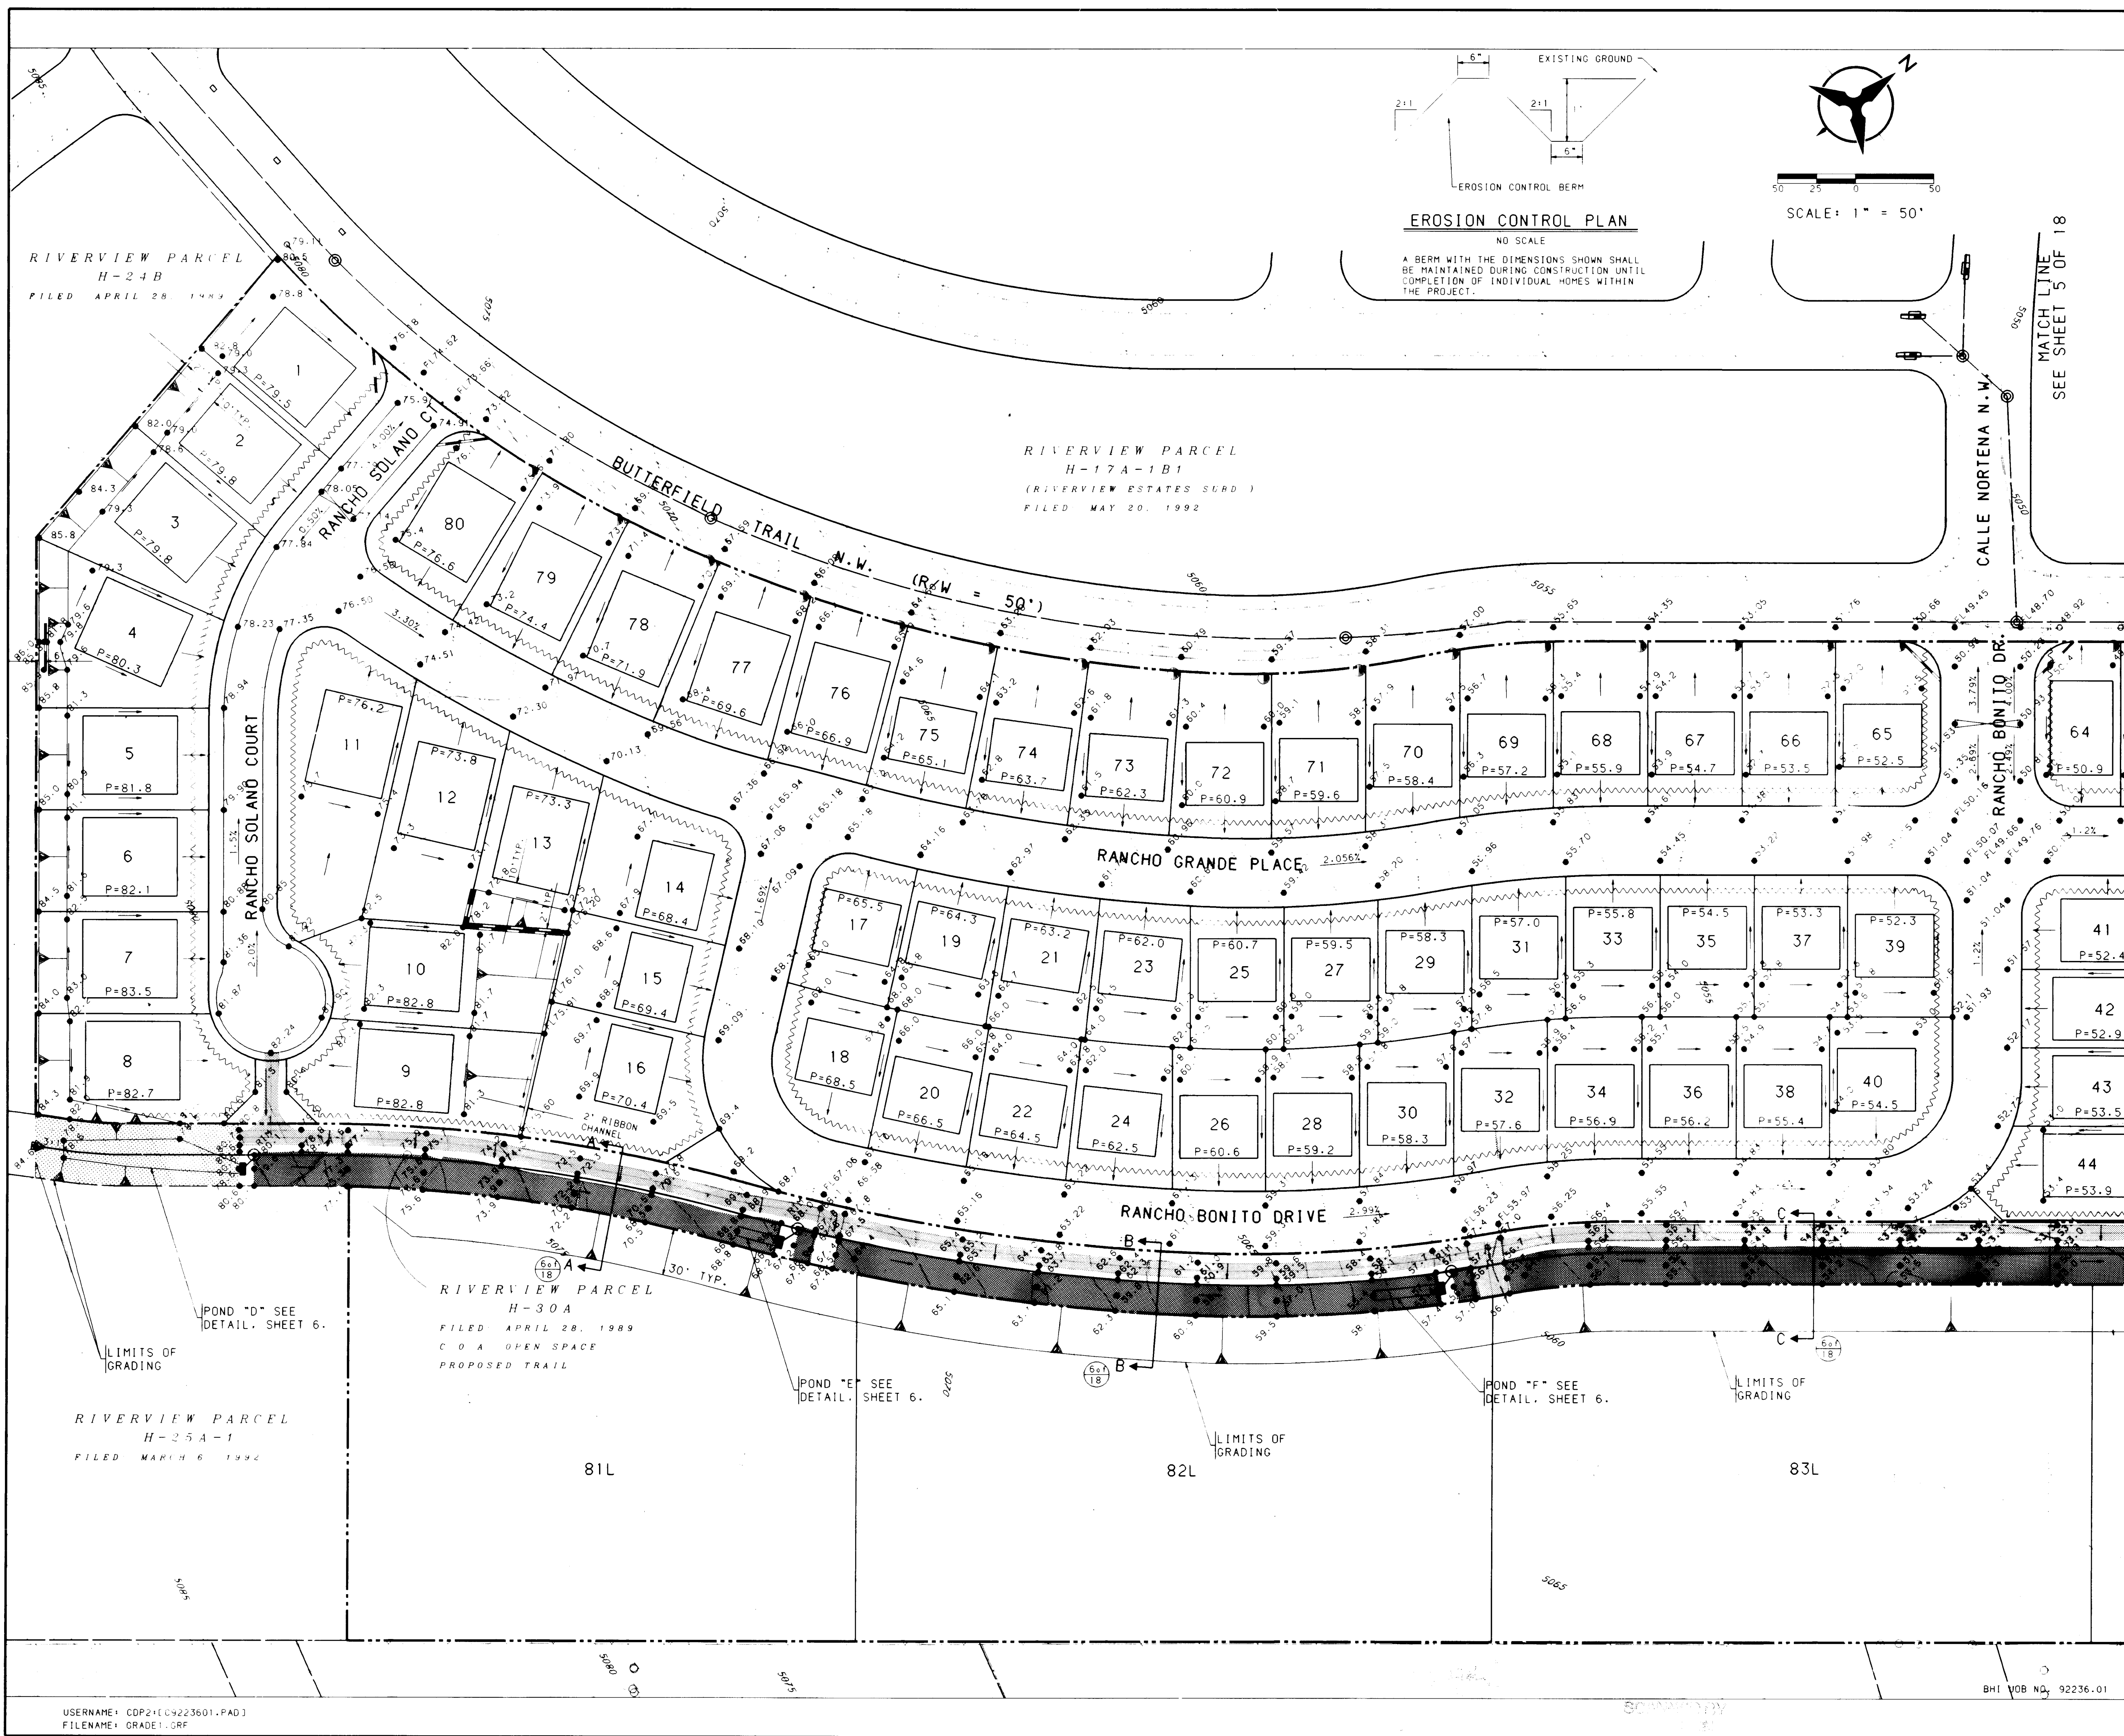

SCALE: 1" = 50'

MATCH LINE
SEE SHEET 5 OF 18

GENERAL GRADING NOTES

1. CONTRACTOR MUST OBTAIN A TOPSOIL DISTURBANCE PERMIT FROM THE ENVIRONMENTAL HEALTH DIVISION PRIOR TO CONSTRUCTION.

2. THE CONTRACTOR IS TO REFER TO THE EARTHWORK SPECIFICATIONS NOTED IN THE SOILS REPORT SUPPLIED BY CENTEX HOMES.

3. THE CONTRACTOR SHALL CONFORM TO ALL CITY, COUNTY, STATE AND FEDERAL DUST CONTROL MEASURES AND REQUIREMENTS AND WILL BE RESPONSIBLE FOR PREPARING AND OBTAINING ALL NECESSARY APPLICATIONS AND APPROVALS.

4. THE CONTRACTOR SHALL ENSURE THAT NO SOIL ERODES FROM THE LOTS INTO PUBLIC RIGHT-OF-WAY. THIS CAN BE ACHIEVED BY CONSTRUCTING TEMPORARY BERMS AS PER DETAIL THIS SHEET AND WETTING THE SOIL TO KEEP IT FROM BLOWING.

5. THE TOLERANCES FOR ROUGH GRADING SHALL CONFORM TO THE FOLLOWING:

TRAIL SUBGRADE	+0.2'
CHANNEL SUBGRADE	+0.2'
PAD SUBGRADE	+0.2'
STREET SUBGRADE	+0.2'
ALL OTHER AREAS	+0.5'

6. RETAINING WALLS TO BE CONSTRUCTED UNDER THESE WORK ORDER PLAN IMPROVEMENTS WITH FINAL GRADING, DRAINAGE, UTILITY AND STREET CONSTRUCTION. CONTRACTOR SHALL PROVIDE SHOP DRAWINGS TO CENTEX HOMES FOR APPROVAL PRIOR TO CONSTRUCTION. SHOP DRAWINGS SHALL CONSIST OF RETAINING WALL PROFILES SHOWING GROUND ELEVATIONS ADJACENT TO WALL, TOP OF WALL, AND BOTTOM OF FOOTING.

7. CONSTRUCTION WITHIN AMAFCA'S PIEDRAS MARCADAS DAM PROPERTY SHALL NOT COMMENCE UNTIL A LICENSE AGREEMENT FOR EACH LOT IS OBTAINED FROM AMAFCA. A LICENSE AGREEMENT FOR TRAIL IMPROVEMENTS MUST BE APPROVED BY AMAFCA'S BOARD OF DIRECTORS.

8. BACKYARD DRAIN TO BE PROVIDED AS DESIGNATED. PROPERTY OWNER TO MAINTAIN BACKYARD DRAIN. SEE BACKYARD DRAIN DETAIL SHEET.

9. UPON COMPLETION (AND ACCEPTANCE BY THE CITY AND AMAFCA), THE TRAIL PARCEL AND UNDERGROUND STORM SEWER SYSTEM UP TO THE AMAFCA PROPERTY LINE (STATION 20+34.61) WILL BE MAINTAINED BY THE CITY OF ALBUQUERQUE. AMAFCA WILL MAINTAIN THE STORM DRAIN SYSTEM FROM THEIR PROPERTY LINE (STATION 20+34.61) UP TO AND INCLUDING THE ENERGY DISSIPATOR (STATION 21+35.61). THE SURFACE OF THE DAM BASIN (EXCLUDING THE TRAIL SURFACE) WILL BE MAINTAINED BY AMAFCA.

LEGEND

PROJECT BOUNDARY	---
EXISTING CONTOUR	---
EXISTING SPOT ELEVATION	025.42
PROPOSED SPOT ELEVATION	•25.42
DIRECTION OF FLOW	→
PROPOSED EROSION CONTROL BERM	~~~~~
WATER BLOCK	
PROPOSED RETAINING WALL	=====
EXISTING STORM DRAIN LINE	—SD—
EXISTING STORM DRAIN MANHOLE	⊙
EXISTING STORM DRAIN INLET	⊙
PROPOSED STORM DRAIN LINE	—SD—
PROPOSED STORM DRAIN MANHOLE	⊙
PROPOSED STORM DRAIN INLET	⊙
BACKYARD DRAIN	—
STANDARD CURB	—
ROLL CURB (RANCHO SOLANO CT.)	—
TEMPORARY RIPRAP	▨
RIPRAP CHANNEL LINING	▨
ASPHALT PAVING	▨

AS BUILT INFORMATION

CONTRACTOR	CH2M
DATE	7-28-93
INSPECTOR	ALS
DATE	7-28-93
FIELD ENGINEER	ALS
DATE	7-28-93
CHECKED BY	ALS
DATE	7-28-93
RECORDED BY	ALS
DATE	7-28-93
NO.	

BENCH MARKS

STATION MARK IS A STANDARD USCS BRASS TABLET, STAMPED "HUGHES, 1954", SET IN TOP OF A CONCRETE POST PROJECTING 0.3 FT. ABOVE THE GROUND. TO REACH THE STATION FROM THE INTERSECTION OF CENTRAL AVE. AND STATE RD. 448, GO NORTH ON STATE RD. 448, 6.1 MILES. THE STATION IS 450' WEST OF STATE RD. 448 IN A FENCED-IN PRAIRIE. ELEV. = 5049.93
--

SURVEY INFORMATION

FIELD NOTES	NO.	DATE	BY

ENGINEER'S SEAL

[Signature]
7-28-93



**CITY OF ALBUQUERQUE
PUBLIC WORKS DEPARTMENT
ENGINEERING GROUP**

**TITLE: RANCHO SERENO SUBDIVISION
FINAL GRADING & DRAINAGE PLAN**

APPROVALS	ENGINEER	DATE	APPROVALS	ENGINEER	DATE
DRC CHAIRMAN			WATER	R. U. Kano	7-28-93
TRANS. DEV.			WASTE WATER	R. U. Kano	7-28-93
HYDROLOGY					
PARKS					


PROJECT NO. 4569.91 MAP NO. D-12 SHEET 4 OF 18

1 2 3 4 5 6 7 8 9 10 11 12 13 14 15
06-4569-19104611

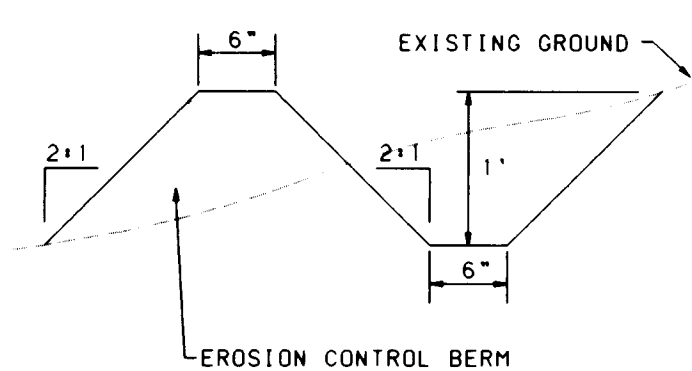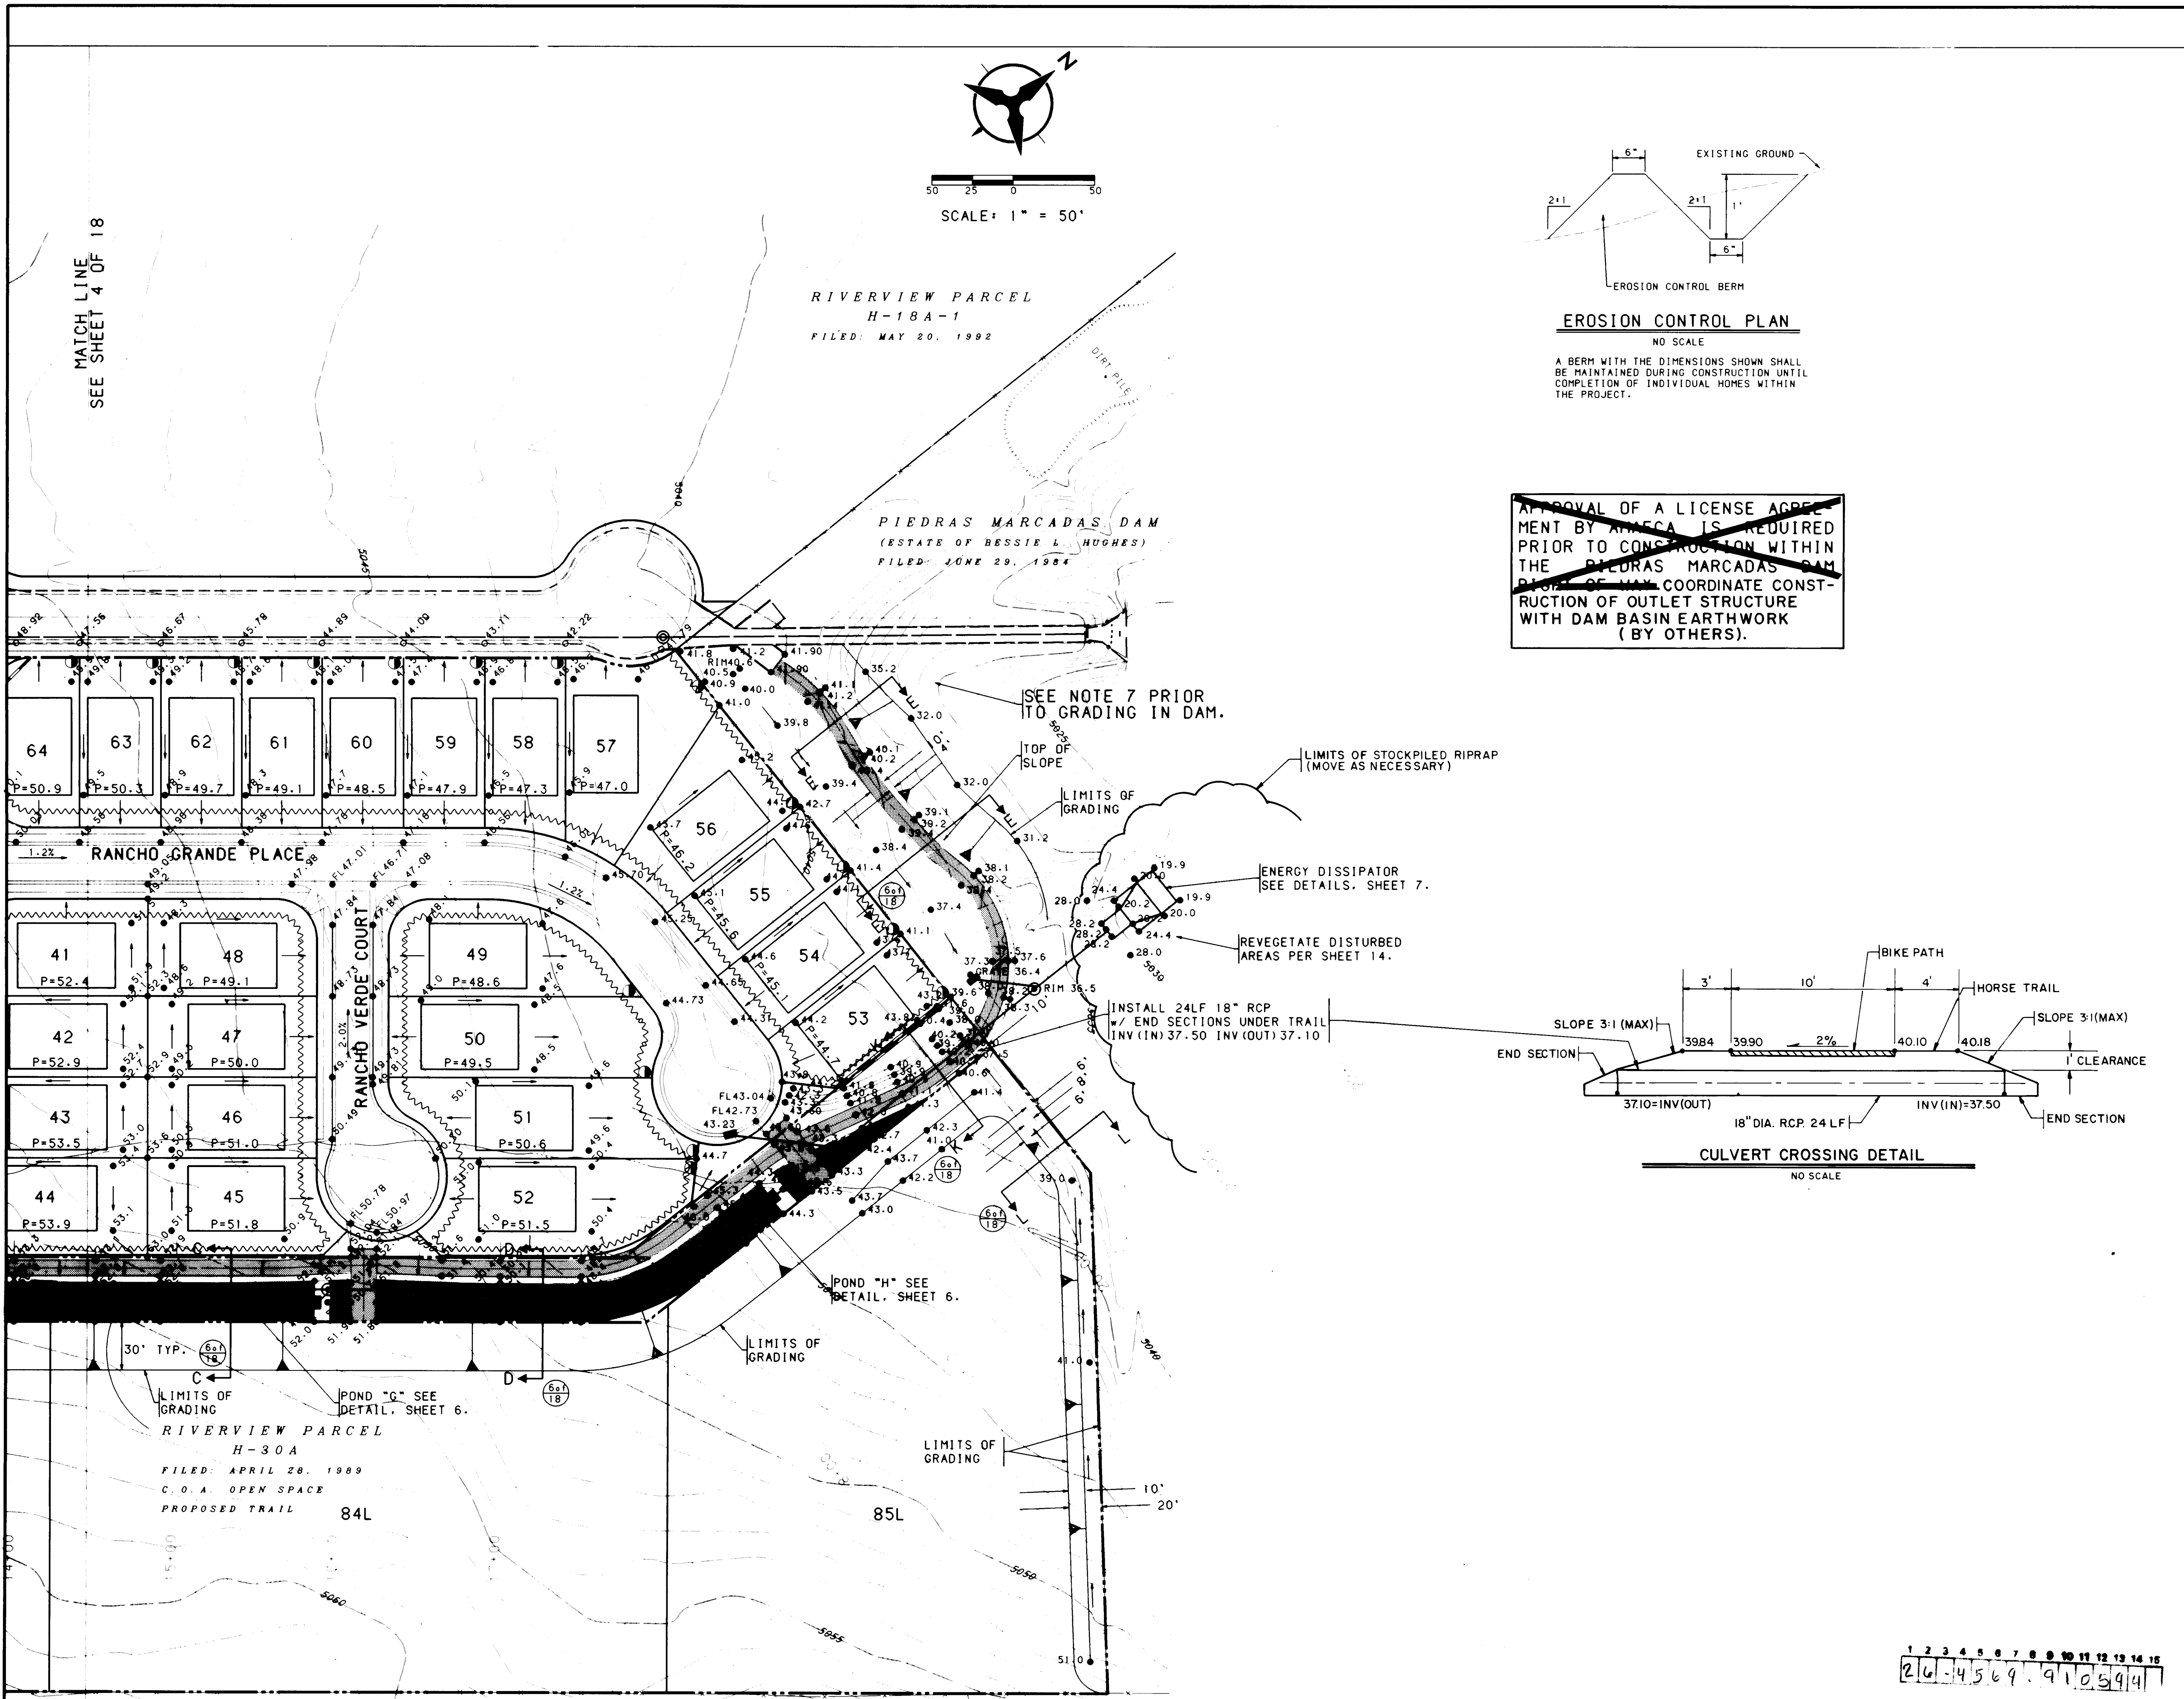

EROSION CONTROL PLAN
NO SCALE
A BERM WITH THE DIMENSIONS SHOWN SHALL BE MAINTAINED DURING CONSTRUCTION UNTIL COMPLETION OF INDIVIDUAL HOMES WITHIN THE PROJECT.

~~APPROVAL OF A LICENSE AGREEMENT BY AMAFCA IS REQUIRED PRIOR TO CONSTRUCTION WITHIN THE PIEDRAS MARCADAS DAM BASIN OF ANY COORDINATE CONSTRUCTION OF OUTLET STRUCTURE WITH DAM BASIN EARTHWORK (BY OTHERS).~~

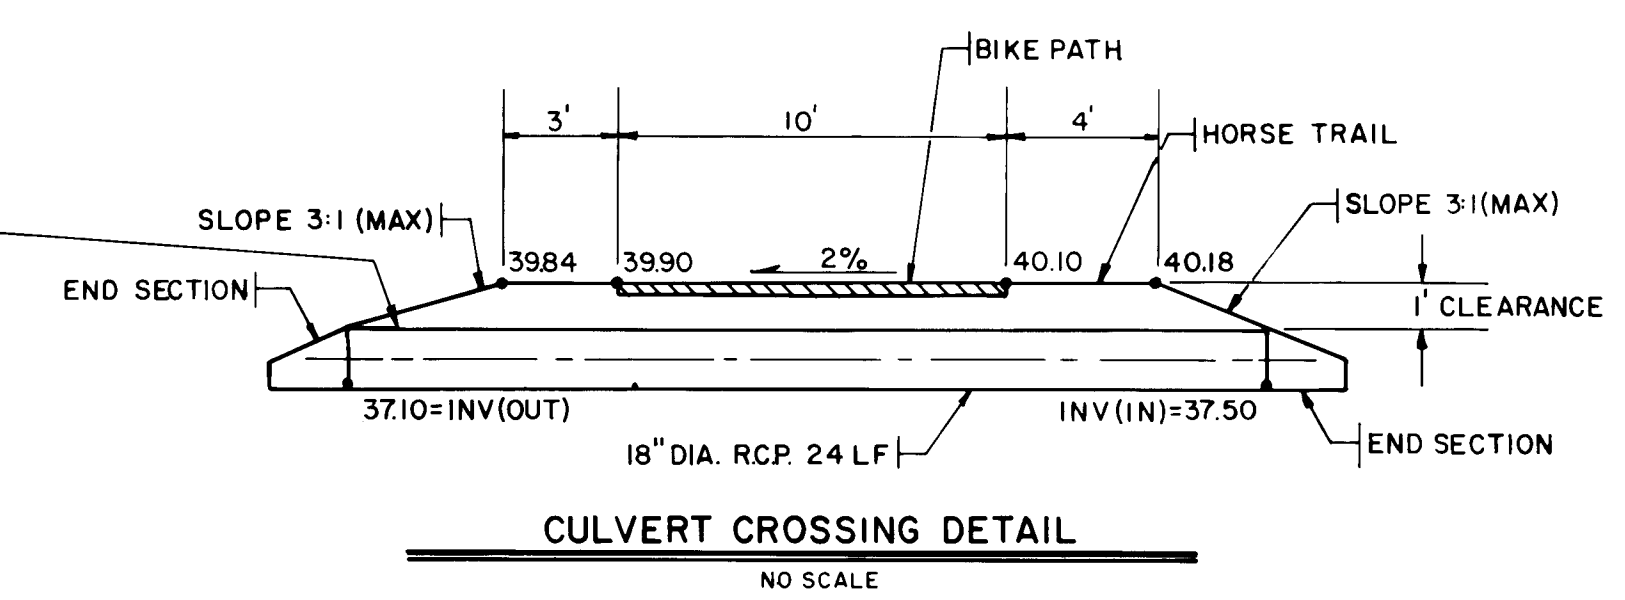

GENERAL GRADING NOTES

- CONTRACTOR MUST OBTAIN A TOPSOIL DISTURBANCE PERMIT FROM THE ENVIRONMENTAL HEALTH DIVISION PRIOR TO CONSTRUCTION.
- THE CONTRACTOR IS TO REFER TO THE EARTHWORK SPECIFICATIONS NOTED IN THE SOILS REPORT SUPPLIED BY CENTEX HOMES.
- THE CONTRACTOR SHALL CONFORM TO ALL CITY, COUNTY, STATE AND FEDERAL DUST CONTROL MEASURES AND REQUIREMENTS AND WILL BE RESPONSIBLE FOR PREPARING AND OBTAINING ALL NECESSARY APPLICATIONS AND APPROVALS.
- THE CONTRACTOR SHALL ENSURE THAT NO SOIL ERODES FROM THE LOTS INTO PUBLIC RIGHT-OF-WAY. THIS CAN BE ACHIEVED BY CONSTRUCTING TEMPORARY BERMS AS PER DETAIL THIS SHEET AND WETTING THE SOIL TO KEEP IT FROM BLOWING.
- THE TOLERANCES FOR ROUGH GRADING SHALL CONFORM TO THE FOLLOWING:

TRAIL SUBGRADE	+0.2'
CHANNEL SUBGRADE	+0.2'
PAD SUBGRADE	+0.2'
STREET SUBGRADE	+0.2'
ALL OTHER AREAS	+0.5'
- RETAINING WALLS TO BE CONSTRUCTED UNDER THESE WORK ORDER PLAN IMPROVEMENTS WITH FINAL GRADING, DRAINAGE, UTILITY AND STREET CONSTRUCTION. CONTRACTOR SHALL PROVIDE SHOP DRAWINGS TO CENTEX HOMES FOR APPROVAL PRIOR TO CONSTRUCTION. SHOP DRAWINGS SHALL CONSIST OF RETAINING WALL PROFILES SHOWING GROUND ELEVATIONS ADJACENT TO WALL TOP OF WALL, AND BOTTOM OF FOOTING.
- ~~CONSTRUCTION WITHIN AMAFCA PIEDRAS MARCADAS DAM PROPERTY SHALL NOT COMMENCE UNTIL A LICENSE AGREEMENT FOR EXERCISE OF THE SEPARATE IMPROVEMENTS IS OBTAINED BY AMAFCA. A LICENSE AGREEMENT FOR TRAIL IMPROVEMENTS SHALL BE APPROVED BY AMAFCA'S BOARD OF DIRECTORS.~~
- BACKYARD DRAIN TO BE PROVIDED AS DESIGNATED. PROPERTY OWNER TO MAINTAIN BACKYARD DRAIN. SEE BACKYARD DRAIN DETAIL, SHEET
- UPON COMPLETION (AND ACCEPTANCE BY THE CITY AND AMAFCA), THE TRAIL PARCEL AND UNDERGROUND STORM SEWER SYSTEM UP TO THE AMAFCA PROPERTY LINE (STATION 20+34.81) WILL BE MAINTAINED BY THE CITY OF ALBUQUERQUE. AMAFCA WILL MAINTAIN THE STORM DRAIN SYSTEM FROM THEIR PROPERTY LINE (STATION 20+34.81) UP TO AND INCLUDING THE ENERGY DISSIPATOR (STATION 21+35.81). THE SURFACE OF THE DAM BASIN (EXCLUDING THE TRAIL SURFACE) WILL BE MAINTAINED BY AMAFCA.

LEGEND

PROJECT BOUNDARY	---
EXISTING CONTOUR	---
EXISTING SPOT ELEVATION	○25.42
PROPOSED SPOT ELEVATION	●25.42
DIRECTION OF FLOW	---
PROPOSED EROSION CONTROL BERM	---
WATER BLOCK	---
PROPOSED RETAINING WALL	---
EXISTING STORM DRAIN LINE	---
EXISTING STORM DRAIN MANHOLE	○
EXISTING STORM DRAIN INLET	□
PROPOSED STORM DRAIN LINE	---
PROPOSED STORM DRAIN MANHOLE	○
PROPOSED STORM DRAIN INLET	□
BACKYARD DRAIN	---
STANDARD CURB	---
ROLL CURB (RANCHO SOLANO CT.)	---
TEMPORARY RIPRAP	---
RIPRAP CHANNEL LINING	---
ASPHALT PAVING	---

AS BUILT INFORMATION

CONTRACTOR	DATE
INSPECTOR'S	DATE
ACCEPTANCE BY	DATE
VERIFICATION BY	DATE
DRAWN BY	DATE
CHECKED BY	DATE

ENGINEER'S SEAL

REVISIONS

NO.	DATE	REMARKS
1	10/92	DESIGN
2	10/92	DESIGN
3	7/93	DESIGN

DESIGNED BY JPK **DATE** 10/92
DRAWN BY SAR **DATE** 10/92
CHECKED BY KLD **DATE** 7/93


CITY OF ALBUQUERQUE
PUBLIC WORKS DEPARTMENT
ENGINEERING GROUP

TITLE: RANCHO SERENO SUBDIVISION
FINAL GRADING & DRAINAGE PLAN


APPROVALS

ENGINEER	DATE	APPROVALS	ENGINEER	DATE
DRG CHAIRMAN	9-17-93	WATER	N/A RWC	7-28-93
TRANS. DEV.	9-17-93	WASTE WATER	N/A RWC	7-28-93
HYDROLOGY	8-23-93	A.M.A.F.C.A.	9-17-93	13 AUG 93
PARKS				


PROJECT NO. 4569.91 **MAP NO.** D-12 **SHEET** 5 **OF** 18

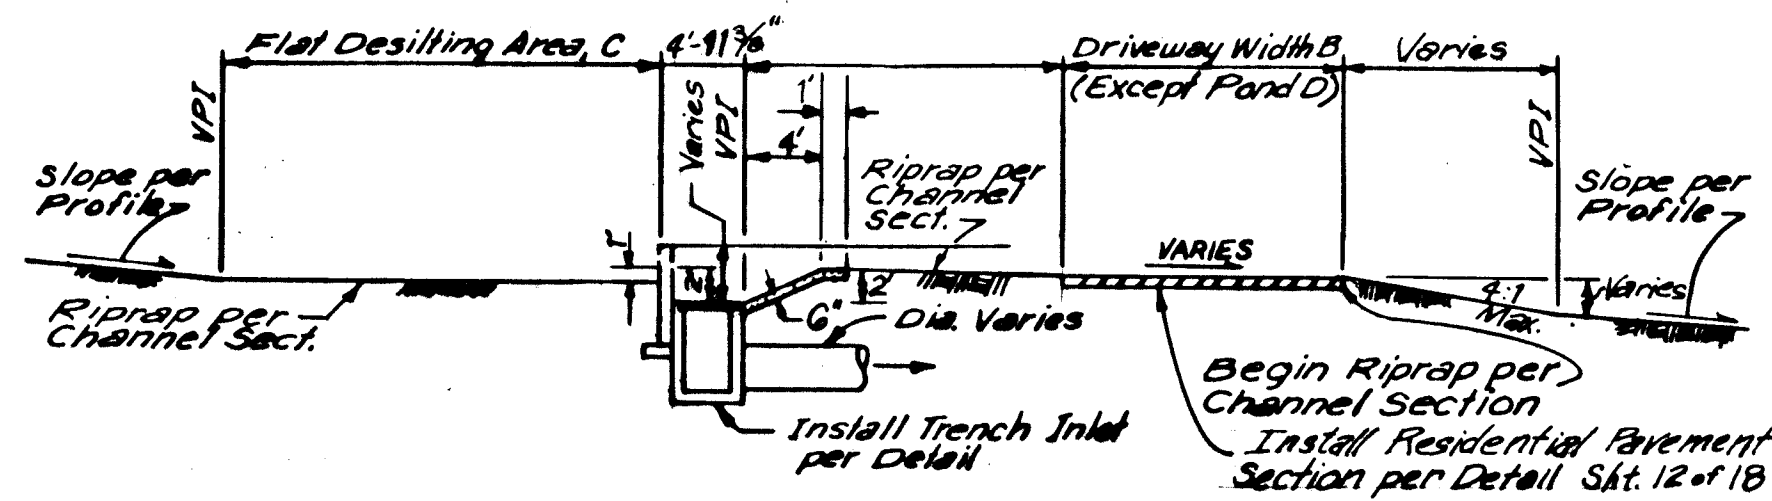


DESILTING PONDS D-H PROFILE
NTS

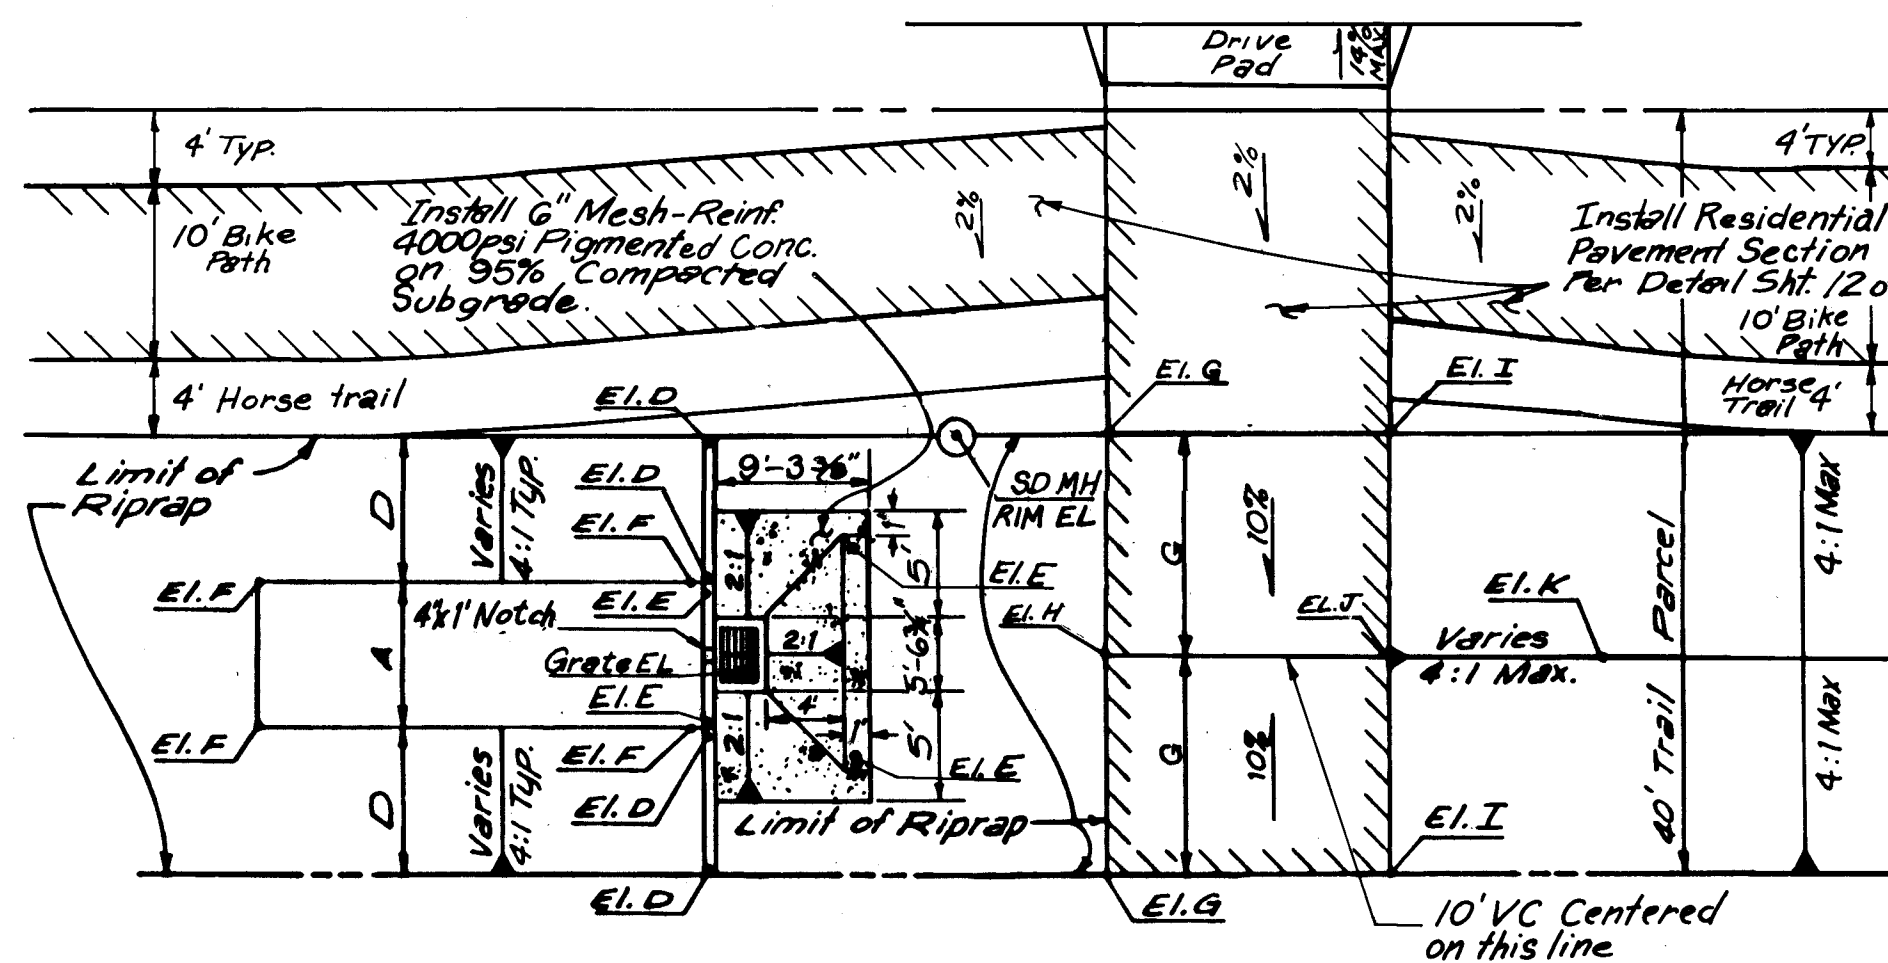


DESILTING PONDS D-H PLAN
NTS

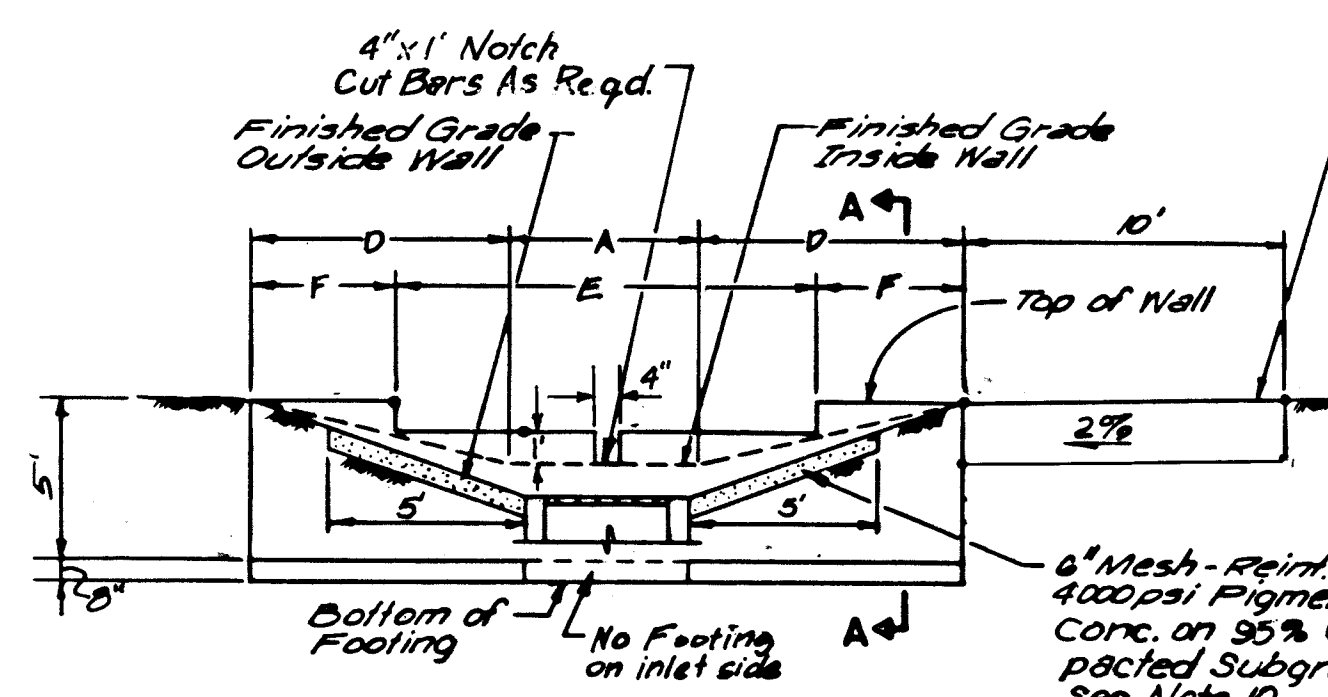

DESILTING PONDS D-H HEADWALL
NTS

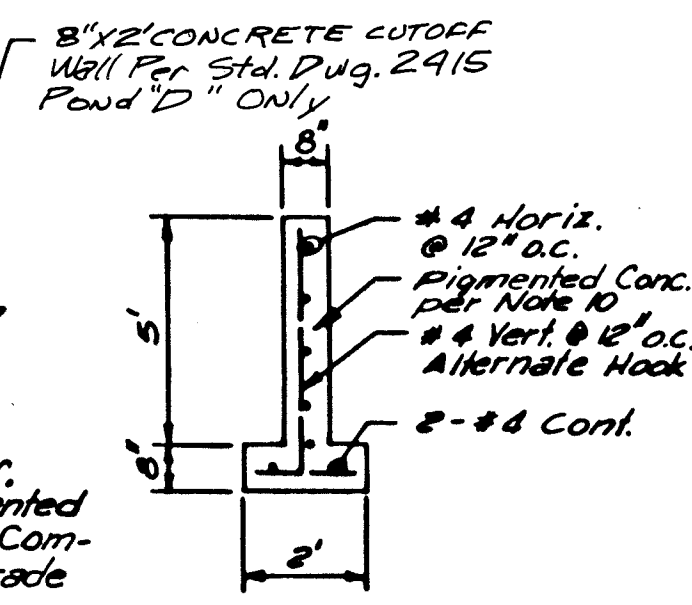

WALL SECTION A-A
NTS

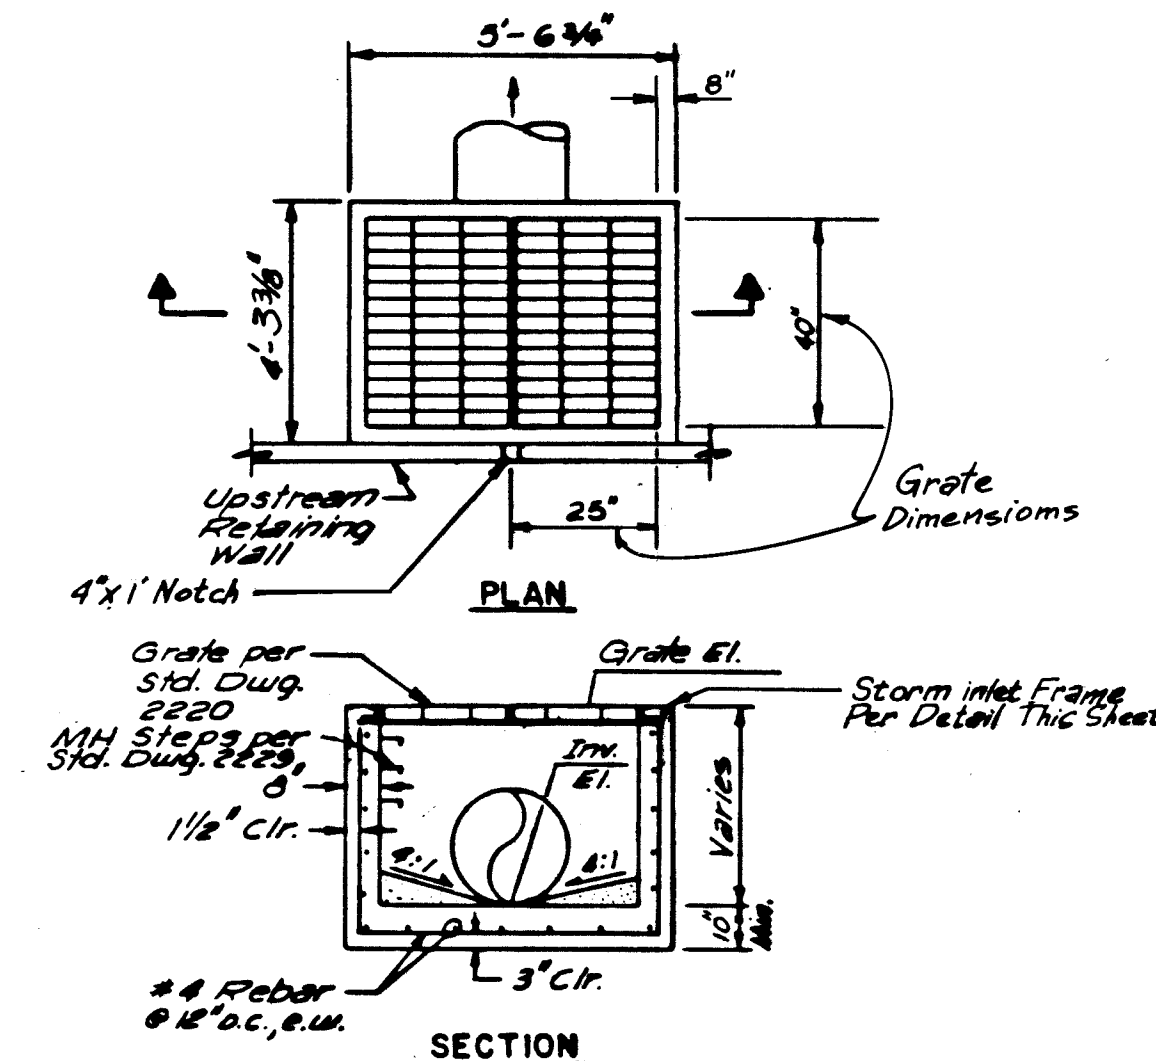


DOUBLE GRATE TRENCH INLET
NTS

POND DATA TABLE

POND	D	E	F	G	H
Q ₁₀₀	38.6	1.6	8.4	19.2	3.7
Depth Over Weir (ft)	0.99	0.16	0.50	0.86	0.29
Freeboard (ft)	0.01	0.84	0.50	0.64	0.71
Dist. A (ft)	6+	2	4	4	0-8
Dist. B (ft)	N/A	16	22	16	16
Dist. C (ft)	113	25	40	95	40
Dist. D (ft)	8	8	8	10	11
Dist. E (ft)	13	8	8	8	8
Dist. F (ft)	4.5	5	6	8	8
Dist. G (ft)	11	9	10	12	10
Grate EL.	77.60	65.22	54.42	48.52	41.32
Inv. EL.	70.60	62.22	51.42	44.52	33.04
EL. D	80.60	68.22	57.42	52.02	44.32
EL. E	79.60	67.22	56.42	50.52	43.32
EL. F	78.60	66.22	55.42	49.52	42.32
EL. G	N/A	67.76	57.85	51.88	43.53
EL. H	N/A	67.11	56.30	50.93	42.78
EL. I	N/A	67.44	56.70	51.79	43.27
EL. J	N/A	66.79	55.95	50.84	42.52
EL. K	75.32	64.40	54.12	49.35	N/A
RIM SAS (Existing)	N/A	N/A	57.76	52.58	45.15
RIM SAS (Proposed)	N/A	N/A	56.75	51.88	43.30
RIM SD	80.15	68.30	57.40	51.40	43.70

* This pond has been designed for a temporary situation. Future flows will be reduced when the trail and storm drain network are continued upstream.

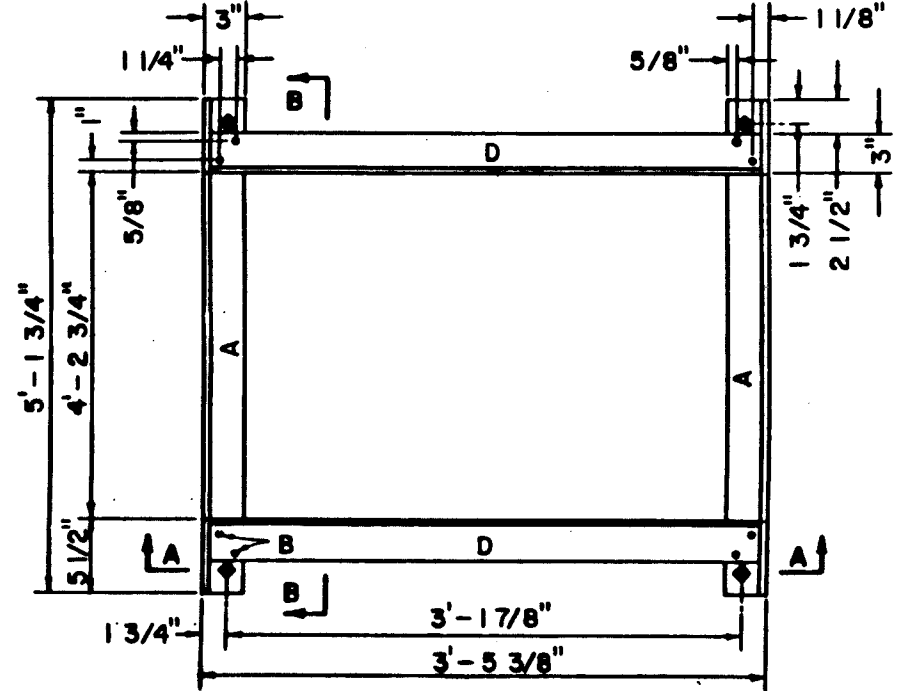

STORM INLET FRAME DETAIL
(Modified Std. Dwg. 2216)
NO SCALE

GENERAL NOTES


- ALL EXPOSED METAL PARTS SHALL BE PAINTED PRIOR TO ASSEMBLY. WELDING, MACHINING AND DRILLING SHALL BE DONE PRIOR TO PAINTING. ALL DIMENSIONS ARE FINISH DIMENSIONS.
- ALL PARTS SHALL BE OF STRUCTURAL STEEL, GRADE 36.
- FOR CLEANING AND PAINTING OF FRAME, SEE STD. DWG. 2215, GENERAL NOTE NO. 4.
- FRAME MAY BE WELDED OR RIVETED.

CONSTRUCTION NOTES


- 4" x 3" x 1/2" x 5'-1 3/4" L
- TWO (2) 3/8" RIVETS AT EACH CORNER. SEE GENERAL NOTE NO. 4.
- FOUR (4) 1/2" x 8" BOLTS WITH SQUARE HEAD AND NUT AT EACH CORNER FOR ANCHORING FRAME INTO CONCRETE WALL.
- 3 1/2" x 3" x 3/8" x 3'-4 3/8" L

CHANNEL TABLE


SECTION	Q ₁₀₀ (CFS)	Q ₁₀₀ (CFS)	"A" (FT)	S (FT/FT)	Water Depth (FT)	Manning's (N)	Velocity (FPS)	Froude Number	B	Freeboard (FT)
A-A	1.6	122.7	18	0.0342	0.42	0.045	2.07	0.56	4.7	1.74
B-B	8.4	156.5	20	0.0278	0.83	0.045	3.00	0.58	4.0	1.67
C-C	19.2	98.6	24	0.0055	1.49	0.045	1.99	0.29	4.36	1.26
D-D	3.72	281.5	24	0.0340	0.59	0.045	2.66	0.61	4.0	2.41

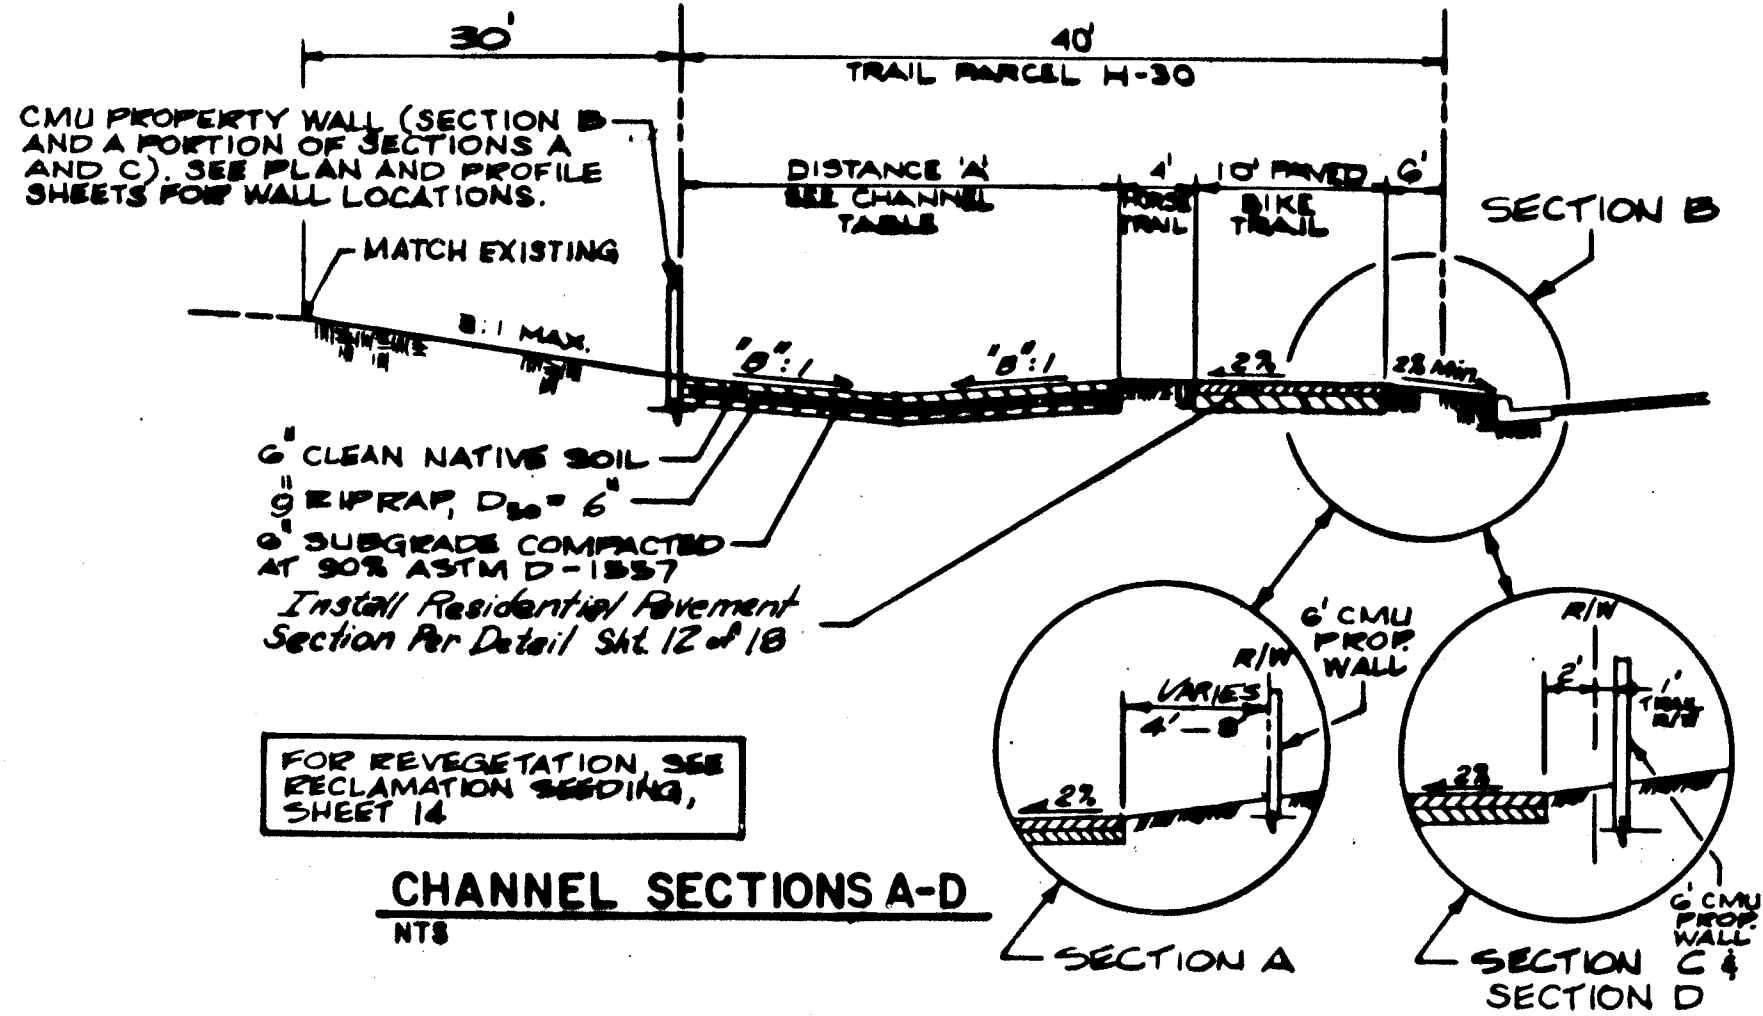


CHANNEL SECTIONS A-D
NTS

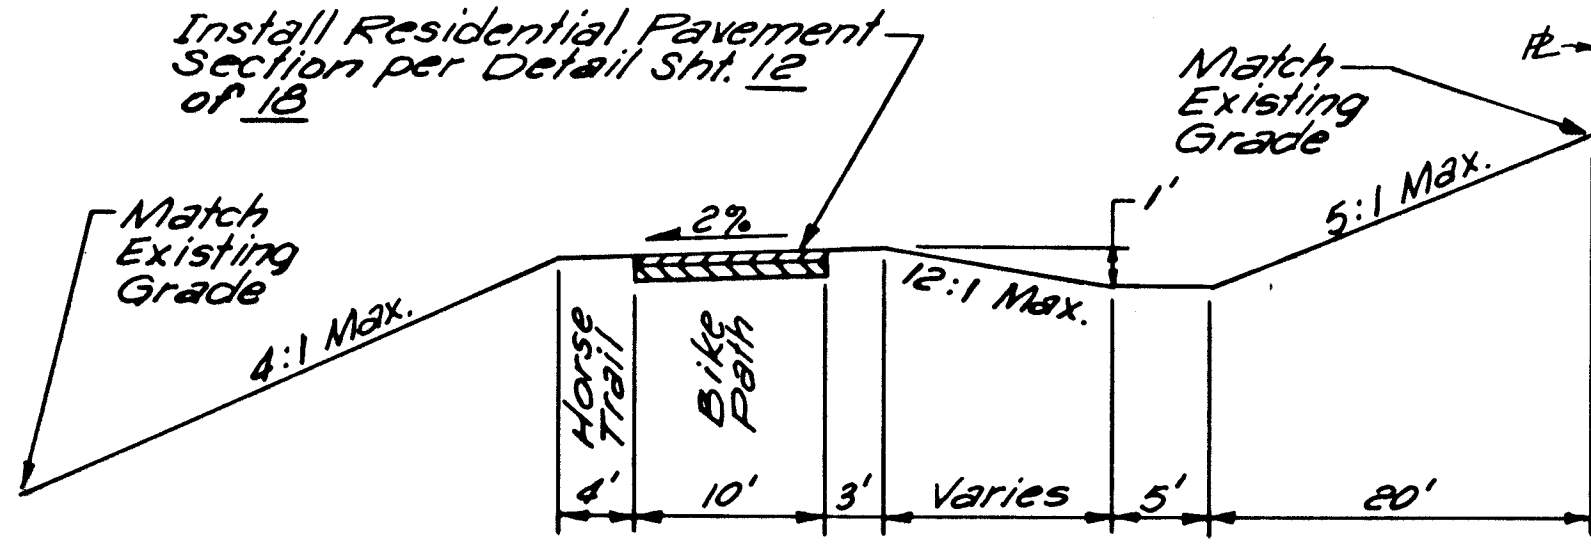

SECTION E-E (AMAFCA MAINTENANCE)
NTS

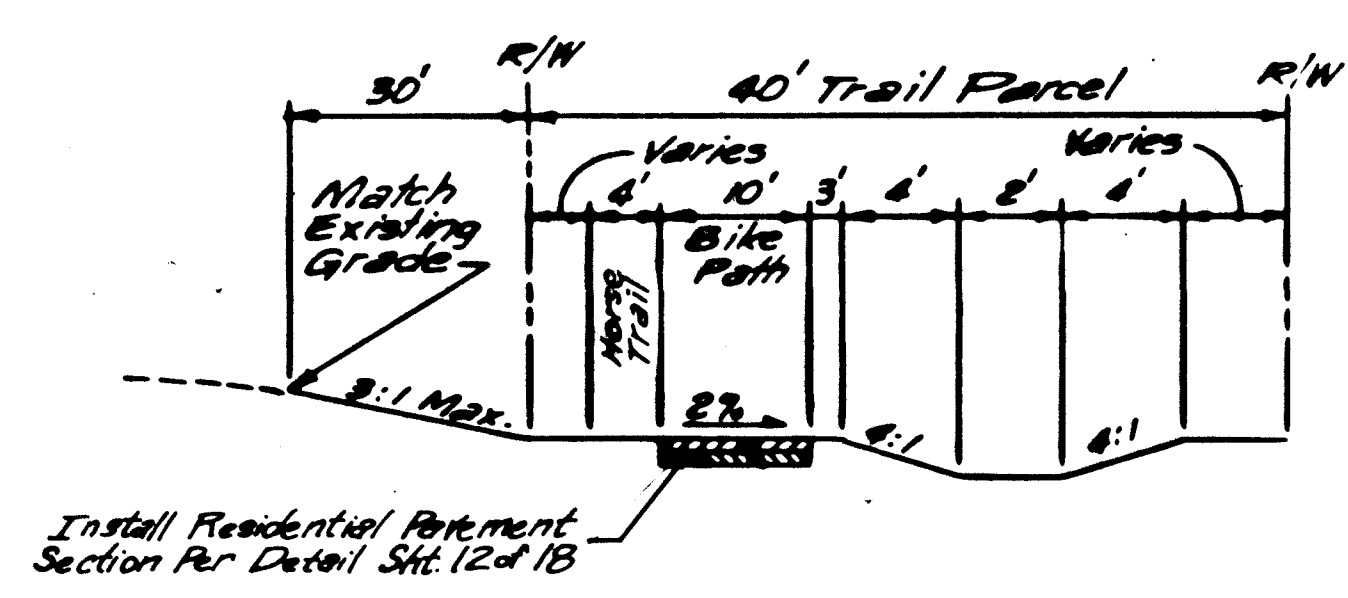

SECTION K-K
NTS

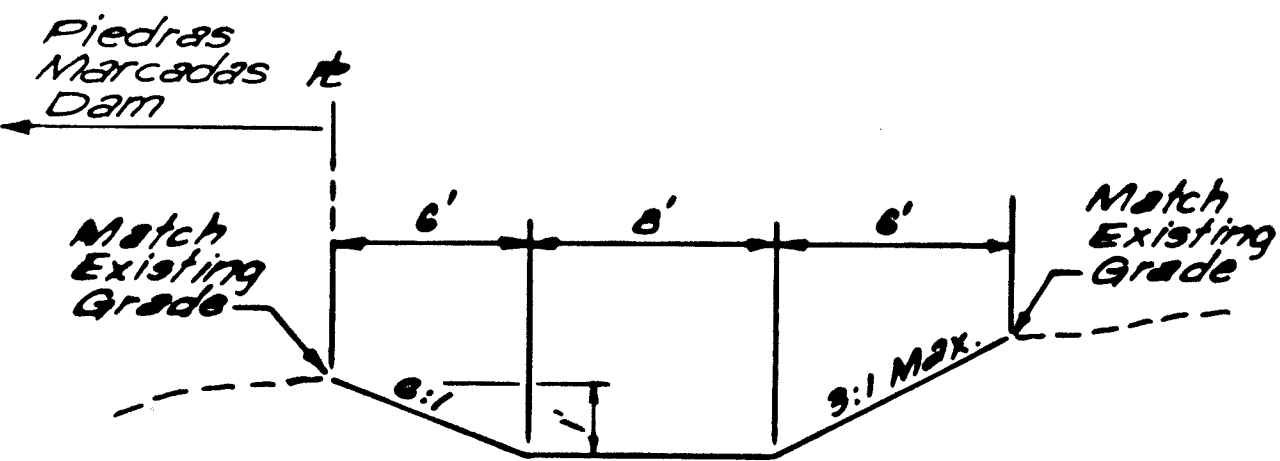

SECTION L-L
NTS



CHANNEL NOTES

- THE CHANNEL AND DESILTING BASINS SHALL RECEIVE A LAYERED SURFACE TREATMENT.
 - THE BOTTOM LAYER SHALL CONSIST OF CHANNEL SUBGRADE, SCARIFIED AND RECOMPACTED TO A DEPTH OF 6" AT MINIMUM 90% ASTM D-1557 DENSITY.
 - THE SECOND LAYER SHALL CONSIST OF RIPRAP SUPPLIED AND INSTALLED IN ACCORDANCE WITH SECTIONS 109 & 603 OF THE STANDARD SPECIFICATIONS. THE MEDIAN PARTICLE SIZE SHALL BE 6". THE GRADATION SHALL BE AS FOLLOWS:

MINIMUM DIMENSION (INCHES)	PERCENT SMALLER BY WEIGHT
9"	100
6"	35-55
3"	10
 - THE TOP LAYER SHALL CONSIST OF 6" OF CLEAN NATIVE SOILS "NOT CONTAINING EXTRANEOUS DEBRIS THAT ARE DETRIMENTAL TO PLANT GROWTH OR SEED GERMINATION." THIS LAYER SHALL BE RESEEDING IN ACCORDANCE WITH THE RECLAMATION SEEDING PLAN, SHEET 14.
- BACKFILL, COMPACTION, AND RE-GRADING OF CHANNEL AFTER STORM DRAIN, CULVERT, TRAIL, OR WALL CONSTRUCTION SHALL BE DONE AS NECESSARY TO BRING THE CHANNEL WITHIN THE GRADING TOLERANCE. SUCH REGRADING SHALL BE CONSIDERED INCIDENTAL TO THE COMPLETION OF THE CHANNEL. NO ADDITIONAL PAYMENT WILL BE MADE THEREFOR.
- THE CONTRACTOR SHALL FIELD VERIFY ALL EXISTING UTILITY LOCATIONS AND NOTIFY THE ENGINEER IMMEDIATELY OF ANY DISCREPANCIES.
- CONTRACTOR IS RESPONSIBLE FOR REPAIR AND/OR REPLACEMENT OF ALL UTILITY CONDUITS AND EXISTING LINES DISTURBED BY CONSTRUCTION ACTIVITIES.
- CONTRACTOR SHALL PARK EQUIPMENT AND VEHICLES SO AS NOT TO INTERFERE WITH NORMAL ACTIVITIES OF RESIDENTS OR OTHER CONTRACTORS ON SITE.
- ANY DAMAGE TO THE EXISTING FACILITIES (CURB & GUTTER, PAVEMENT, CONDUITS, LANDSCAPING, UTILITY LINES, ETC.) DURING CONSTRUCTION SHALL BE REPLACED AT THE CONTRACTOR'S EXPENSE.
- SOME CHANNEL AREAS WILL HAVE ADDITIONAL LANDSCAPE IMPROVEMENTS CONSTRUCTED WITHIN THEM. LANDSCAPING CONSTRUCTION WITHIN THESE AREAS SHALL BE COORDINATED WITH RIPRAP INSTALLATION. SEE THE PLANTING ENLARGEMENT SHEET FOR DETAILS PRIOR TO RIPRAP INSTALLATION.
- CONTACT AMAFCA'S FIELD ENGINEER (884-2215) TWO DAYS PRIOR TO WORKING IN AMAFCA RIGHT-OF-WAY. CONTRACTOR SHALL SHOW AMAFCA AS ADDITIONALLY INSURED FOR LIABILITY COVERAGE.
- SEE SHEET 14 FOR REVEGETATION PLAN.
- CONCRETE:
 - CONCRETE FOR HEADWALLS AND SLOPE PAVING SHALL BE 4000 PSI CONCRETE FOR HYDRAULIC STRUCTURES PER TABLE 101.C OF THE CITY OF ALBUQUERQUE STANDARD SPECIFICATIONS FOR PUBLIC WORKS CONSTRUCTION. CONCRETE SHALL BE PIGMENTED PER DAVIS COLORS #5447 MESA BUFF, 2 LBS. PER SACK CEMENT.
 - CHAMFER ALL EXPOSED CORNERS. 3/4" TYP.







1 2 3 4 5 6 7 8 9 10 11 12 13 14 15
26-4569.91-10694

CITY OF ALBUQUERQUE PUBLIC WORKS DEPARTMENT ENGINEERING GROUP			
TITLE: RANCHO SERENO SUBDIVISION GRADING & DRAINAGE DETAILS CHANNEL AND TRAIL			
APPROVALS	ENGINEER	DATE	APPROVALS
DRC CHAIRMAN	B.G. Sandoval	9-07-93	WATER
TRANS. DEV.	N/A	9-17-93	WASTE WATER
HYDROLOGY	A. Webb	8-23-93	AMAFCA
DESIGNED BY	JPK	DATE	10/92
DRAWN BY	RZM	DATE	10/92
CHECKED BY	KLD	DATE	7/93
PROJECT NO. 4569.91		MAP NO. D-12	
SHEET 6		OF 18	

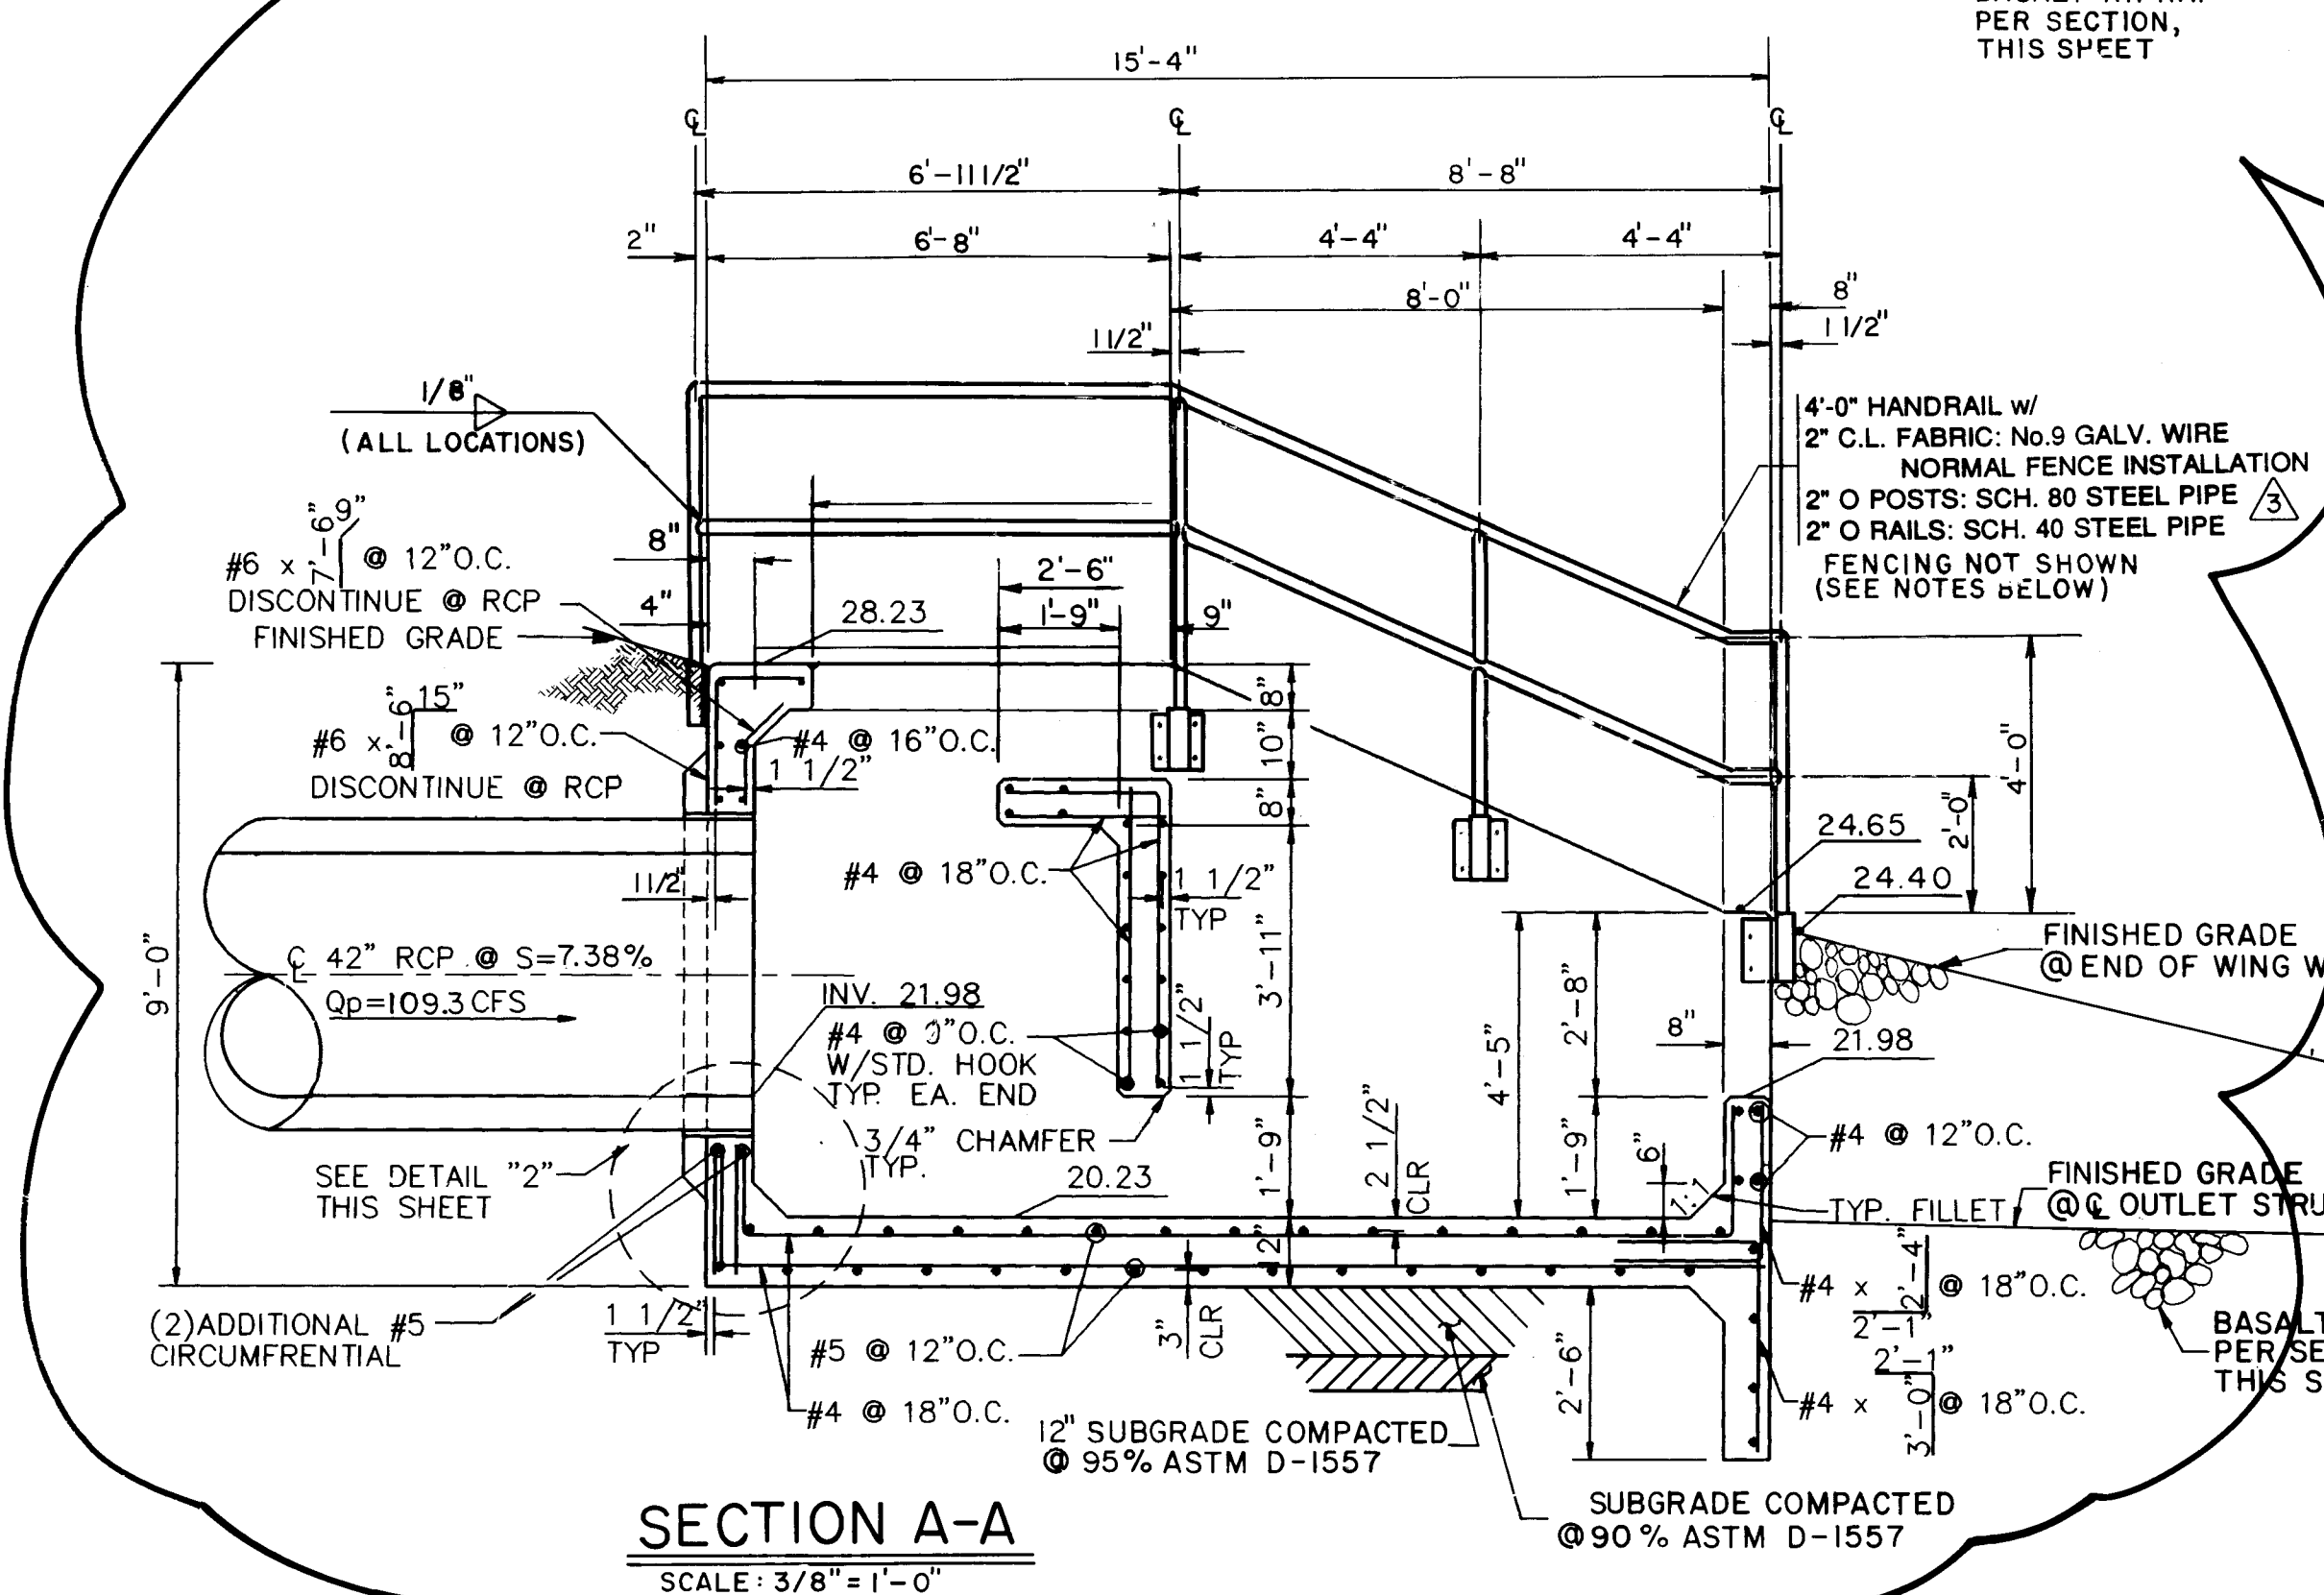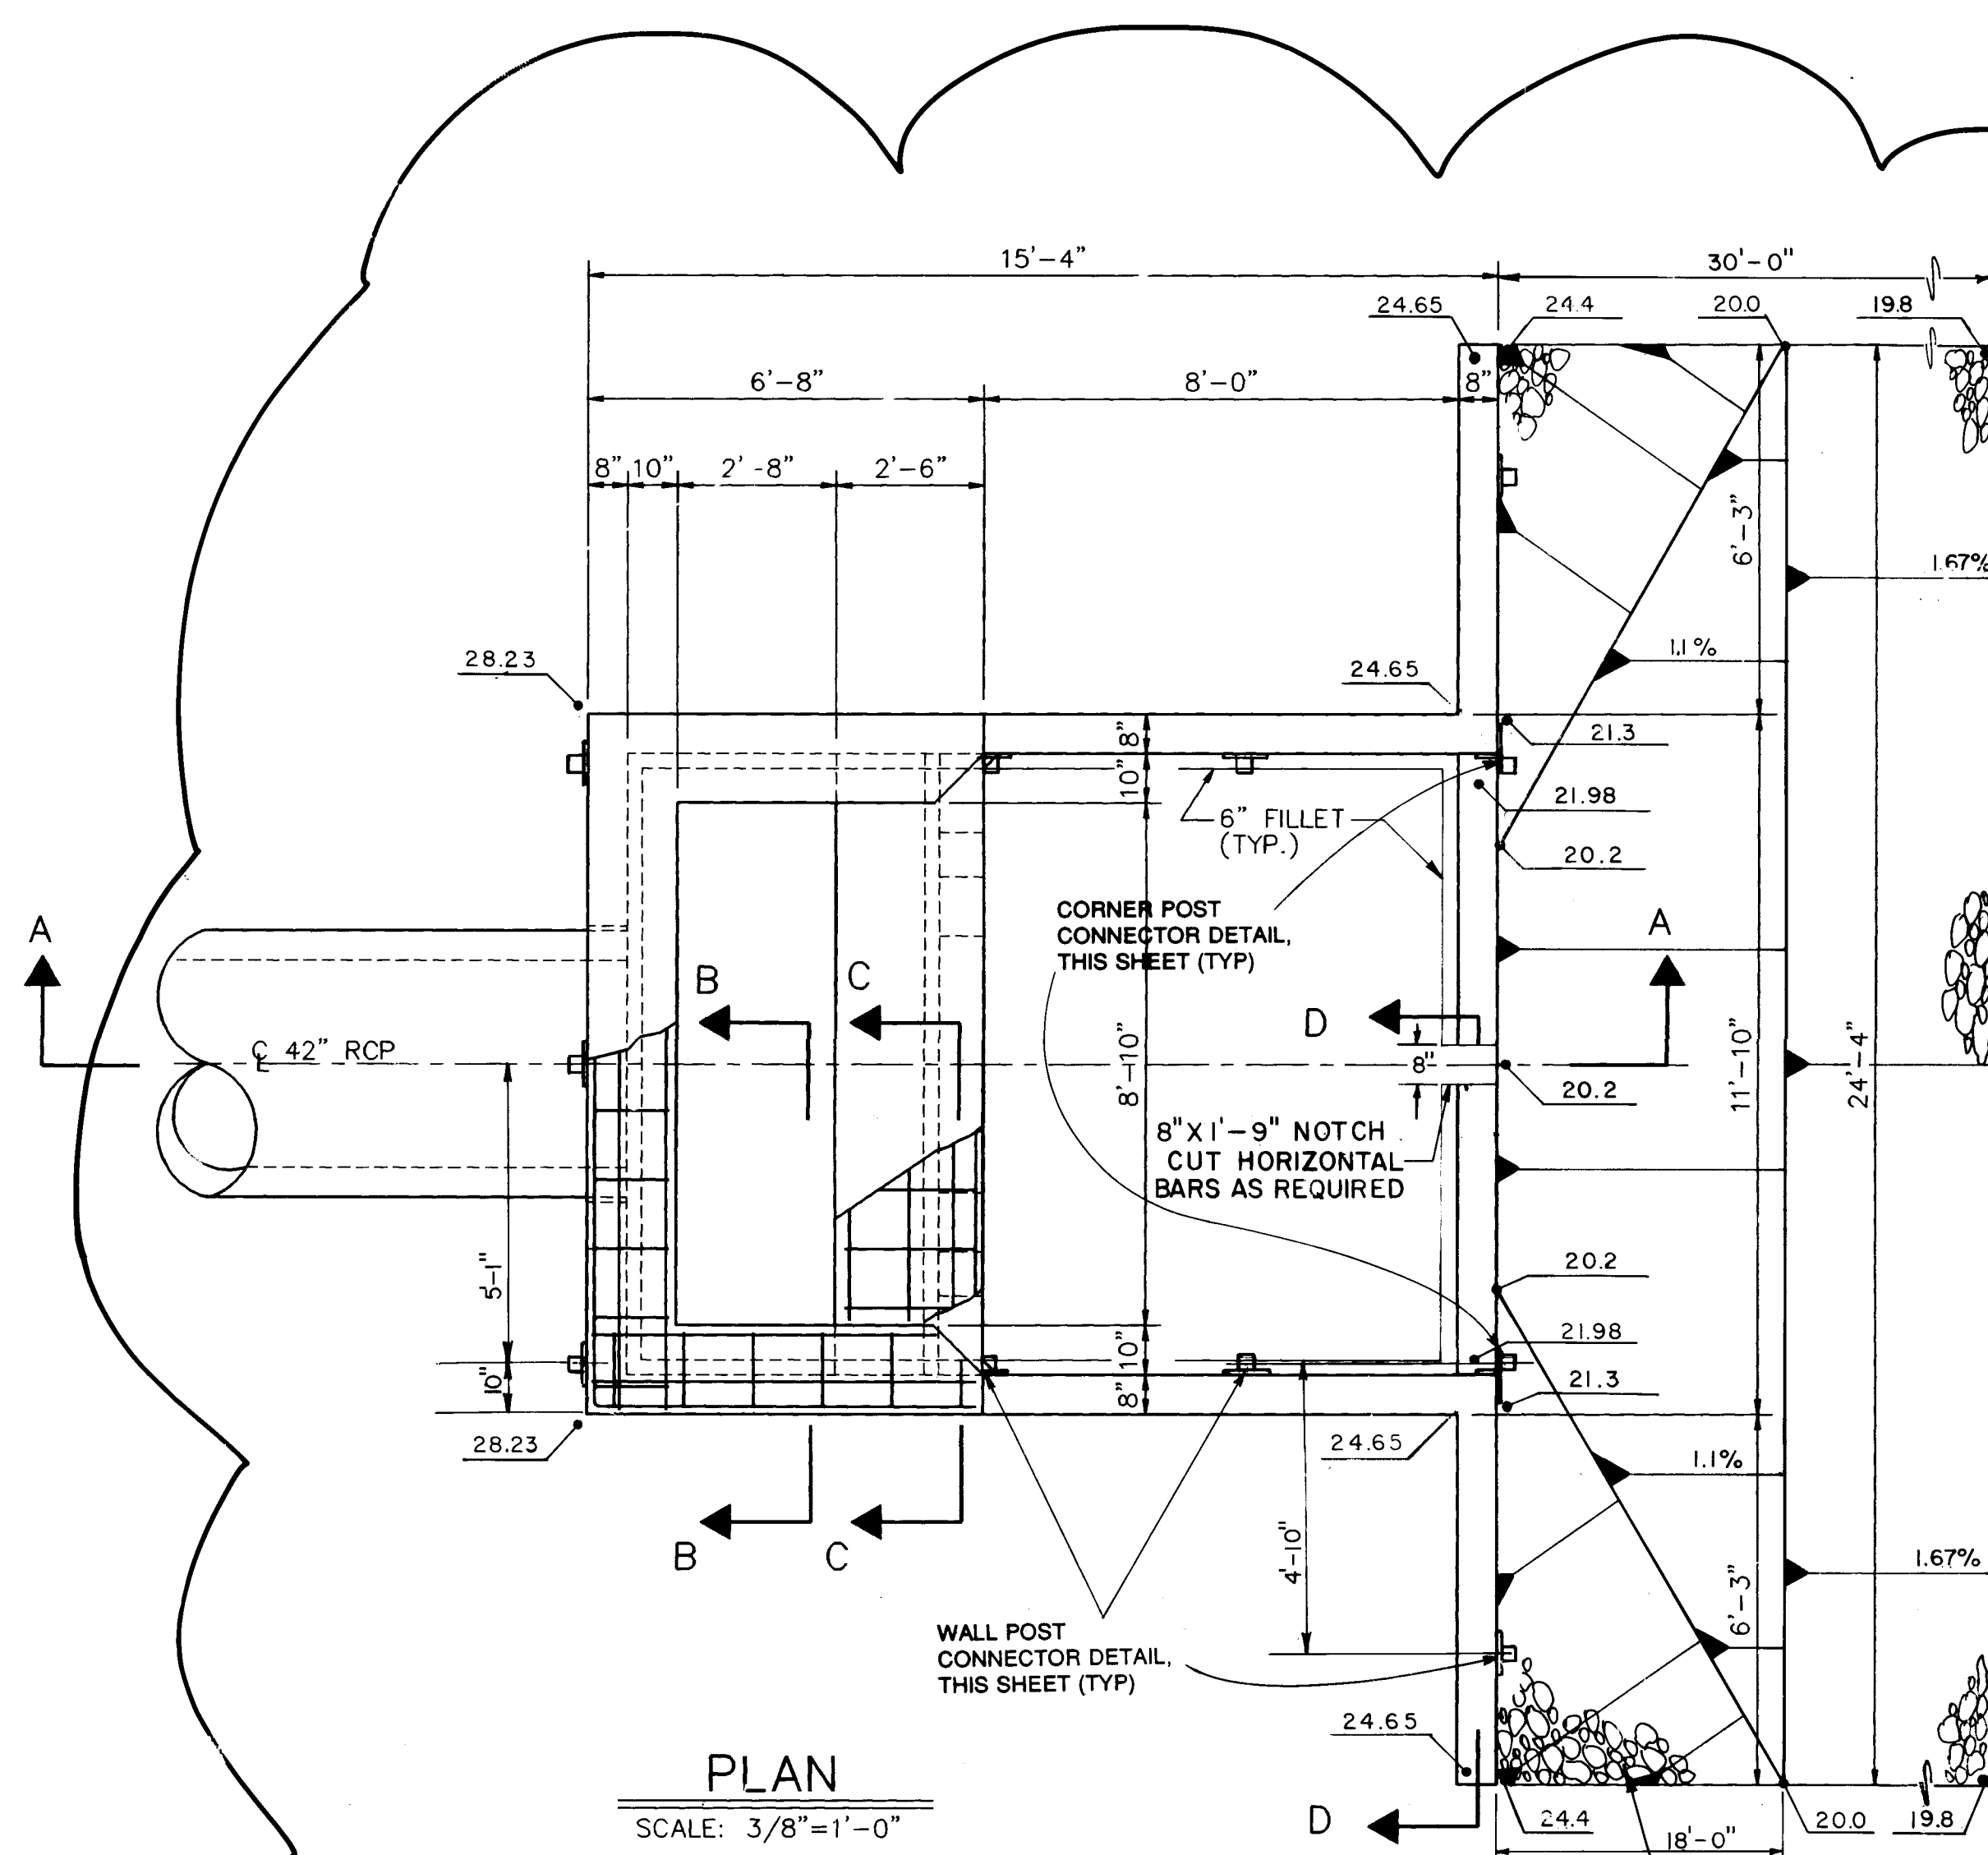

HANDRAIL NOTES:

- ALL POSTS, RAILS, PLATES, ANGLES, BOLTS, ETC., SHALL BE OF STRUCTURAL STEEL AND GALVANIZED PER C.O.A. STANDARDS.
- 3"x3" SQUARE STRUCTURAL STEEL TUBING SHALL HAVE 1/4" WALL THICKNESS.
- INSTALL CHAIN LINK FABRIC ON OUTSIDE OF PIPE RAIL.
- TENSION WIRE SHALL BE 7 ga. SPRING STEEL w/ 11 ga. WIRE TIES @ 24" c.c.
- TENSION BAR AND THREE (3) CLAMPS AT EACH CORNER POST.
- TACK WELD CHAIN LINK FABRIC @ 3 POINTS ALONG EACH FRAME MEMBER.
- PAINT ALL FIELD WELDS WITH GALVANIZING COATING.
- RAIL CENTER LINES INTERSECT AT DIRECTION CHANGES; THIS IS NOT NECESSARILY AT POST LOCATIONS.

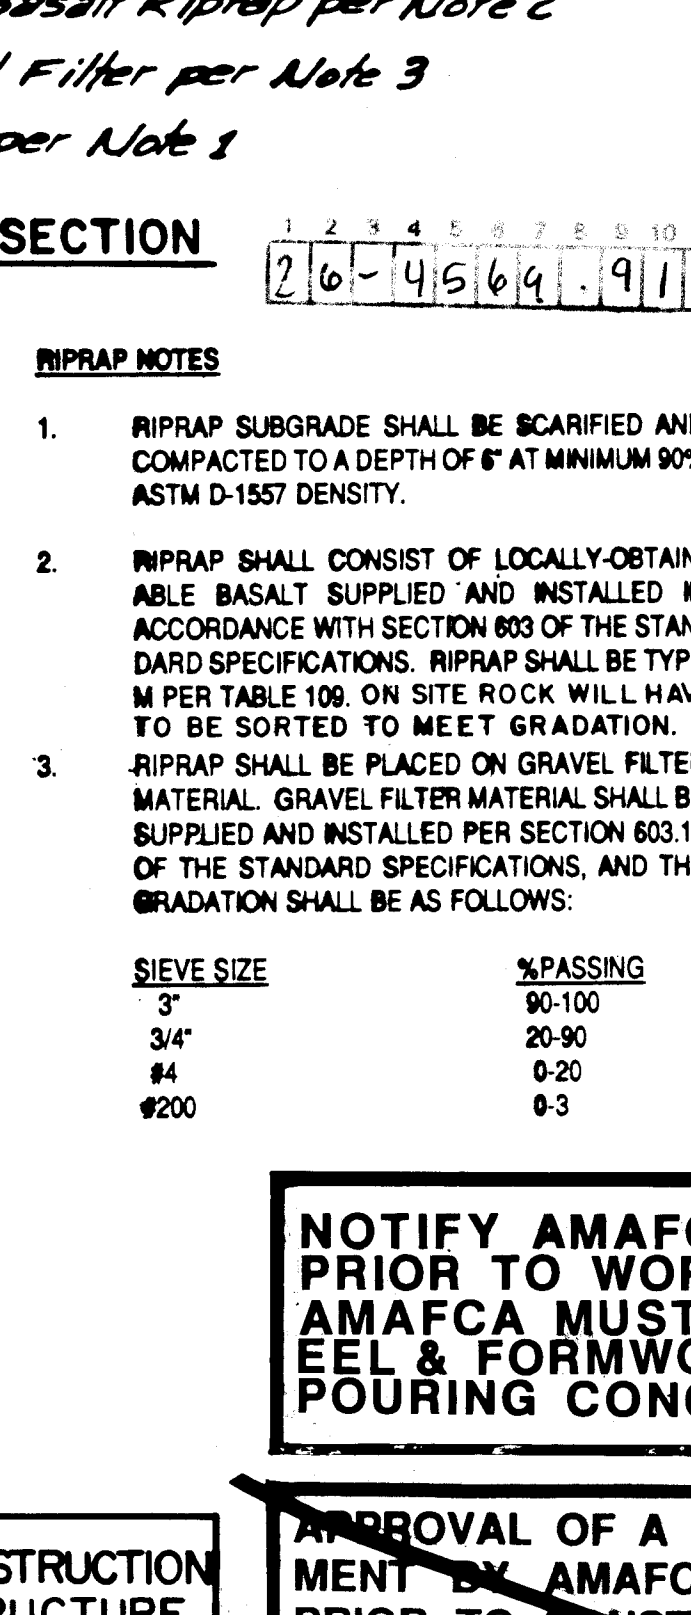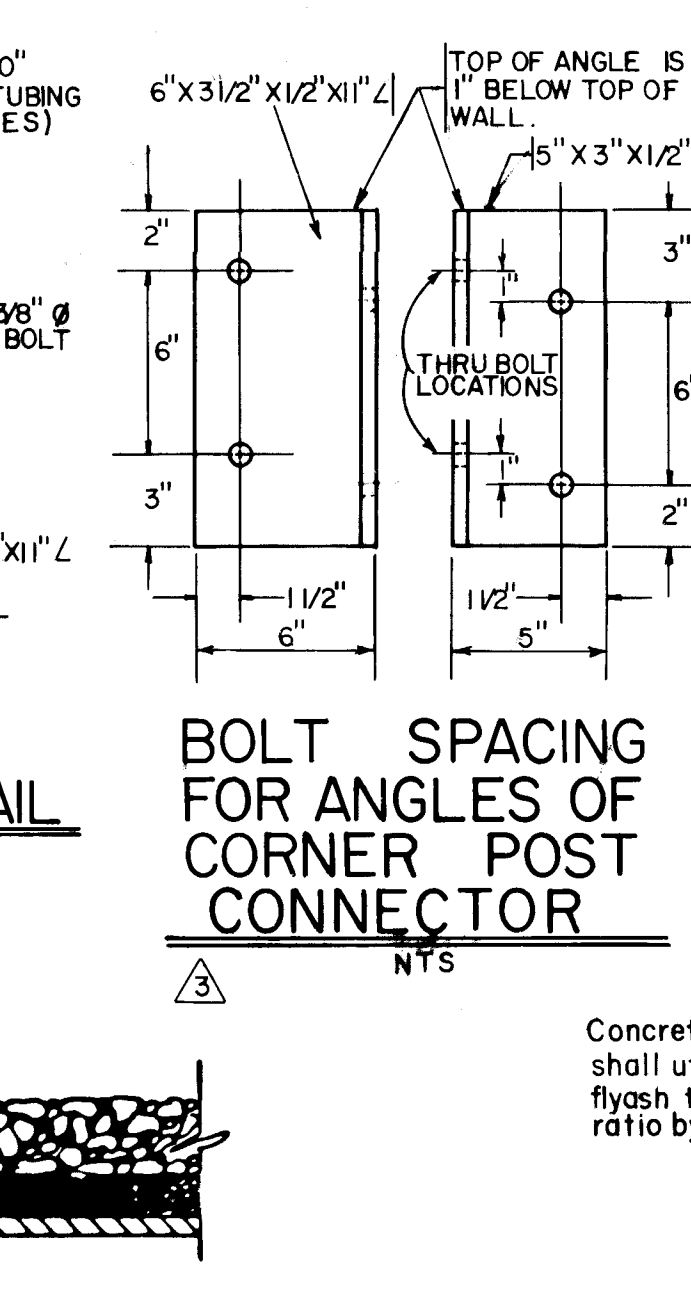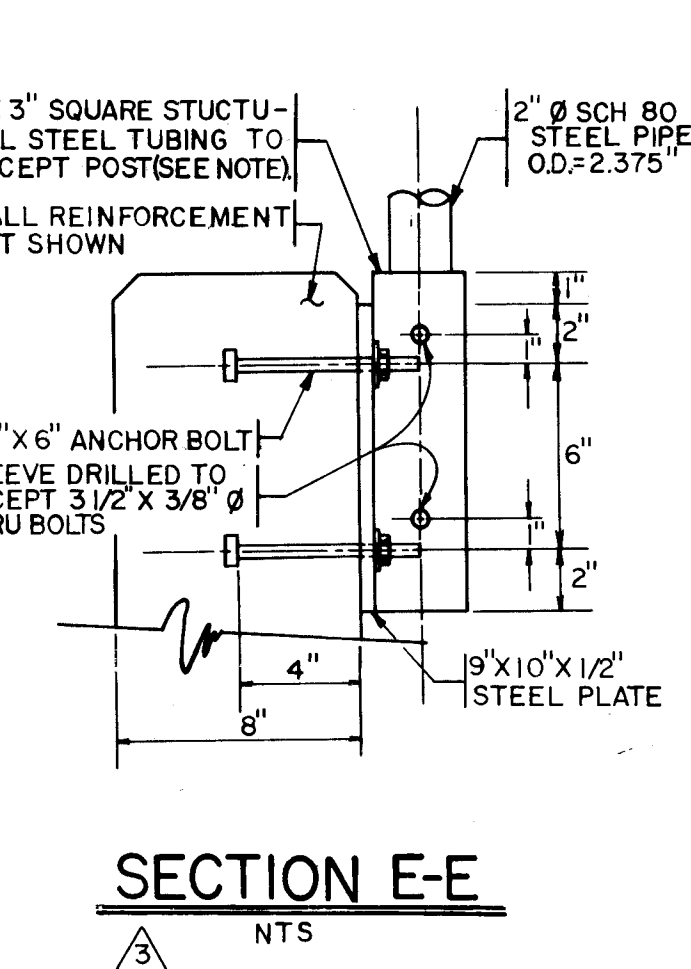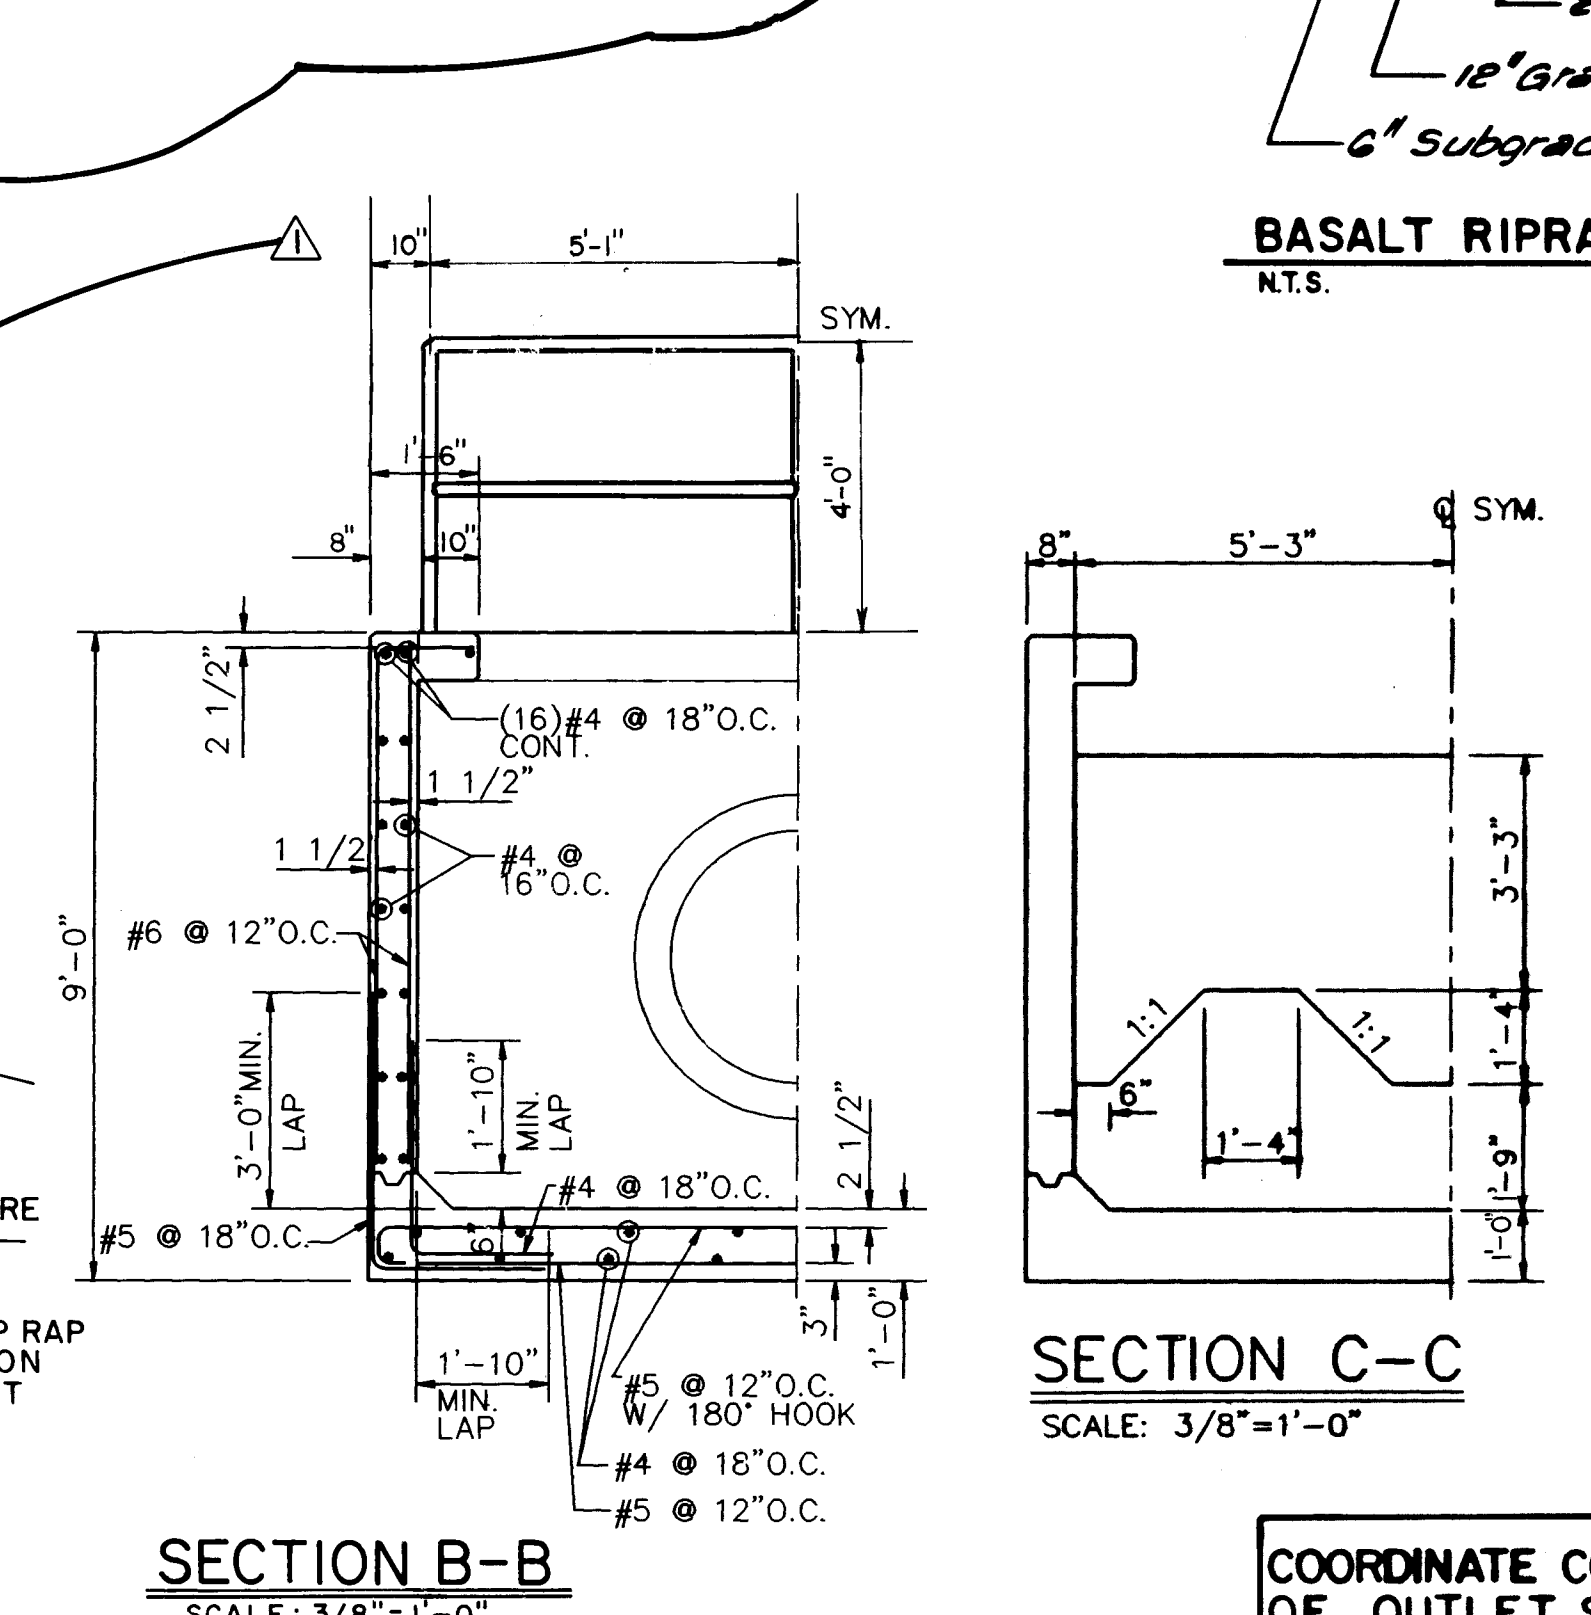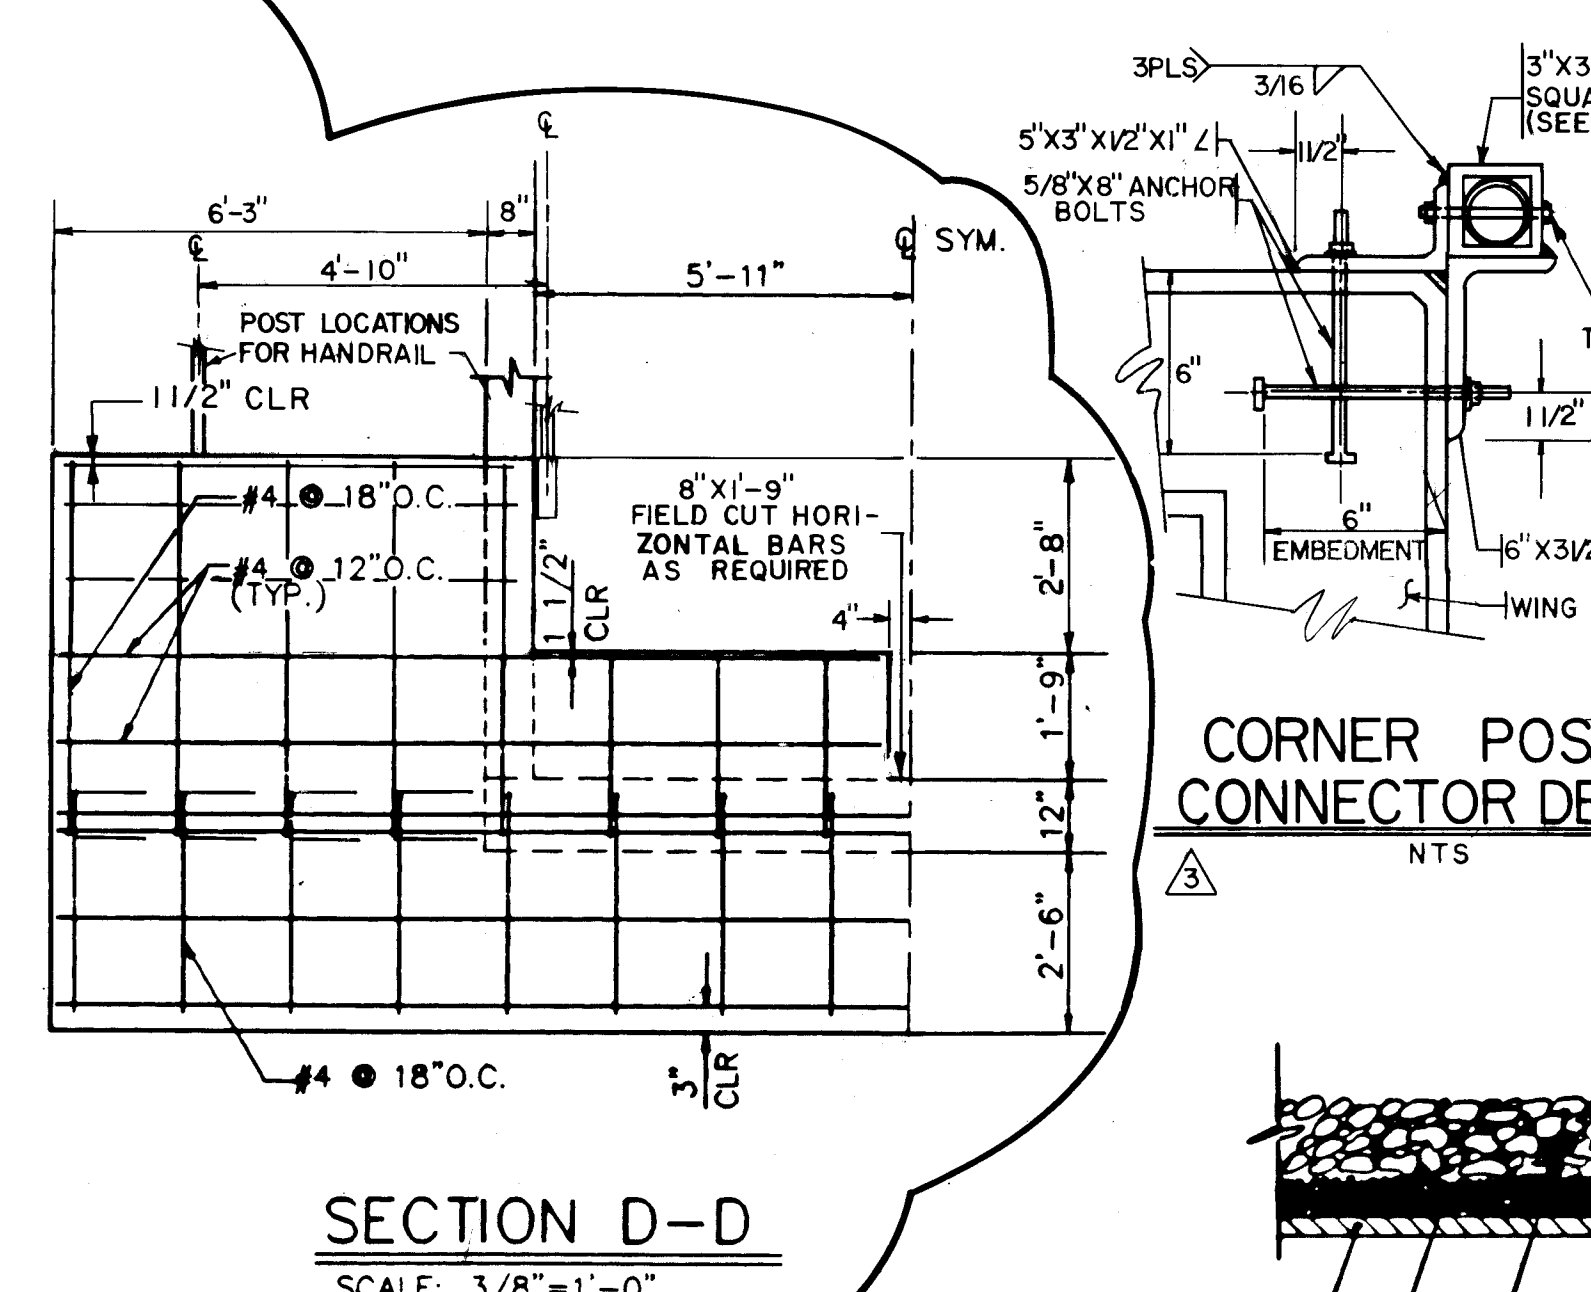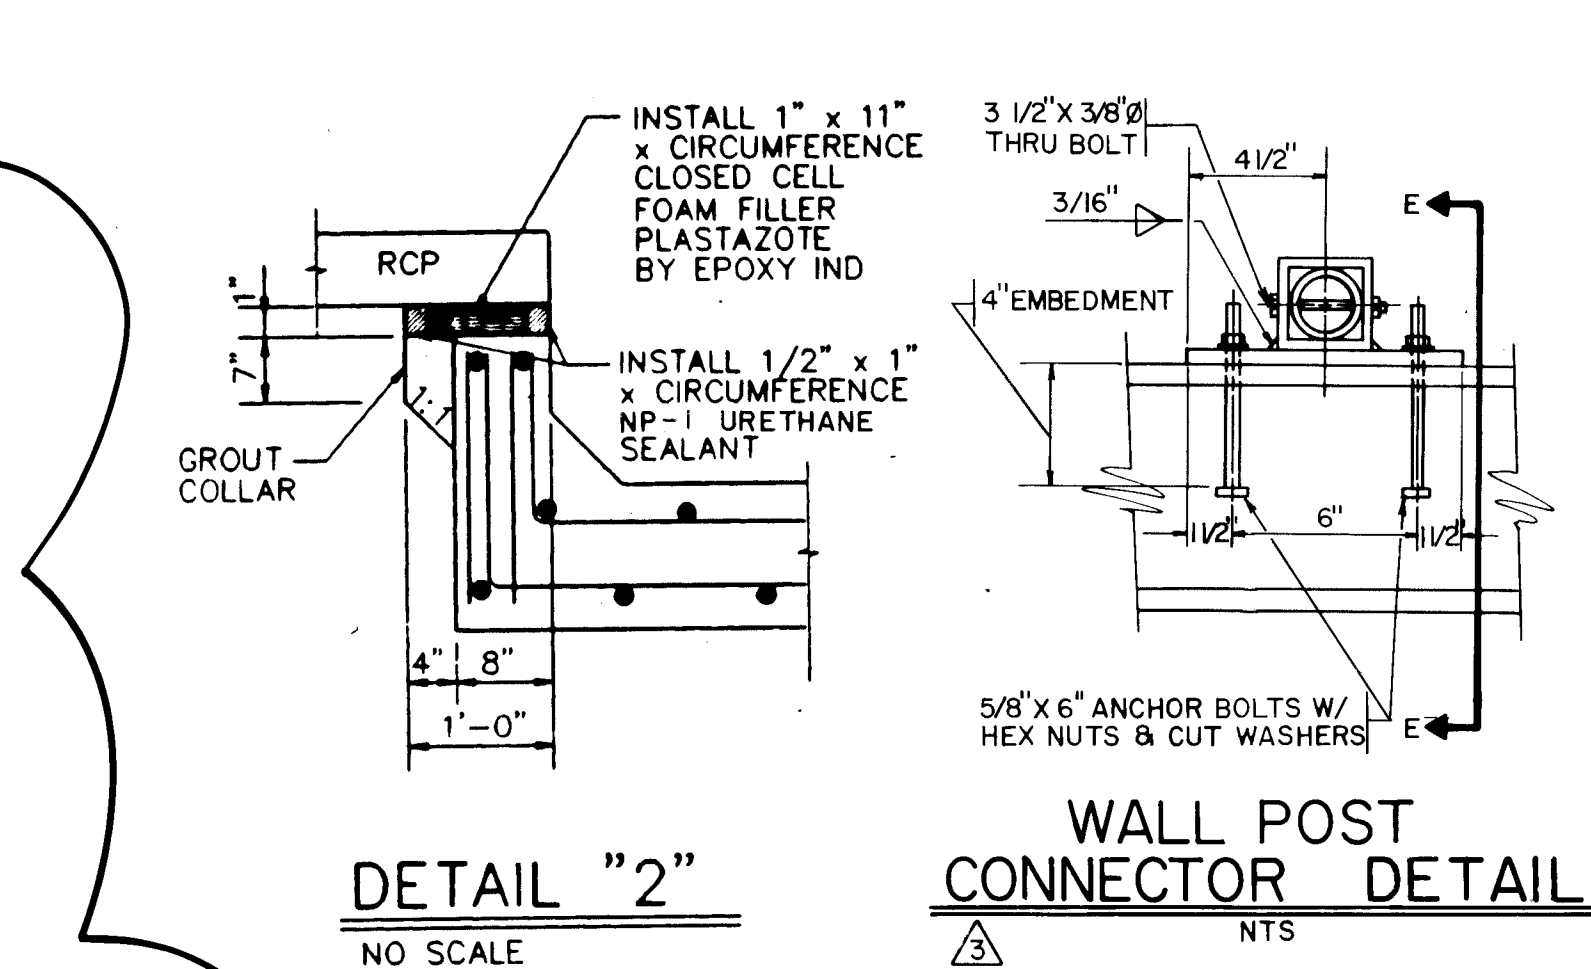

RIPRAP NOTES

- RIPRAP SUBGRADE SHALL BE SCARIFIED AND COMPACTED TO A DEPTH OF 6" AT MINIMUM 90% ASTM D-1557 DENSITY.
- RIPRAP SHALL CONSIST OF LOCALLY OBTAINABLE BASALT SUPPLIED AND INSTALLED IN ACCORDANCE WITH SECTION 603 OF THE STANDARD SPECIFICATIONS. RIPRAP SHALL BE TYPE M PER TABLE 100. ON SITE ROCK WILL HAVE TO BE SORTED TO MEET GRADATION.
- RIPRAP SHALL BE PLACED ON GRAVEL FILTER MATERIAL. GRAVEL FILTER MATERIAL SHALL BE SUPPLIED AND INSTALLED PER SECTION 603.10 OF THE STANDARD SPECIFICATIONS, AND THE GRADATION SHALL BE AS FOLLOWS:

SIEVE SIZE	% PASSING
3"	90-100
3/4"	20-30
#4	0-20
#200	0-3

GENERAL STRUCTURAL NOTES

- CODES AND MANUALS:
Uniform Building Code, 1991 Edition
ACI 318, Latest Edition, Building Code Requirements for Reinforced Concrete.
- DESIGN LOADS:
A. Live Loads:
Soil Weight = 120 pcf
Equiv lateral = 40 pcf
B. Maximum Allowable soil bearing pressure: 2000psf*
*Allowable 1/3 stress increase for gravity and/or lateral loading.
- GENERAL:
A. The Contractor shall verify all dimensions in the field.
B. Shop drawings shall be furnished for review before any fabrication and erection is started. Poorly executed shop drawings shall be rejected and re submitted.
C. The Contractor shall be responsible for providing safe and adequate shoring for all parts of the wall and adjacent structures during construction, as well as worker safety and compliance with OSHA or other agency safety guidelines.
D. The contractor shall field verify all existing utility locations and notify the engineer immediately of any discrepancies.
E. Grade elevations, where noted, are for top of curb, unless otherwise noted.
F. The contractor is responsible for repair and/or replacement of all utility conduits and existing lines.
G. Any additional grading required to match proposed street grades shall be incidental to paving items.
H. The contractor shall park equipment and vehicles as not to interfere with normal activities of residents or other contractors on site.
I. Any damage to existing facilities (curb and gutter, pavement, conduits, landscaping, utilities, etc.) during construction shall be replaced at the contractors expense.
J. Removal of the existing curb and gutter shall be as per COA standard drawing 2415 (sawcut only).
K. Chamfer all exposed corners 3/4" TYP.
- MATERIALS:
A. Cast-in-Place Concrete:
(1) All concrete shall conform to the specifications for Structural Concrete, ACI 301 Latest Edn.
(2) Hardrock Concrete: Dry unit weight = 145 pcf
a. $f_c = 4000$ psi @ 28 days (air entrained 4-6%)
All exterior concrete including side walks, slabs, pads, curbs, gutters, and retaining walls.
b. Maximum dry unit weight = 145 pcf.
c. Maximum slump = 4 inches.
d. Maximum aggregate size = 3/4 inch.
e. Minimum cement content, per ACI 301 design methods.
f. Use Type I & II cement.
g. Class I ordinary surface finish on all walls.
C. Reinforcing Steel:
(1) All reinforcing steel shall conform to ASTM A615 Grade 60; except stirrups, ties, may conform to ASTM A615 Grade 40.
(2) Reinforcing shall be stored in such a manner as to inhibit rusting or the deposit of oils or other bond inhibiting deposits.
(3) Reinforcing steel shall be fabricated and placed in accordance with the Building Code Requirements for Reinforced Concrete (ACI 318) and the CRSI Standard Manual.
(4) Bar supports and spacers for rebar shall be provided in accordance with ACI and CRSI.
(5) All lap splices shall be class B.
(6) Concrete cover for reinforcing shall be as follows:
a. Concrete poured against earth 3 inches
b. Concrete poured in forms but exposed to weather or earth:
1. If bars are larger than No. 5 2 inches
2. If bars are No. 5 or smaller 1-1/2 inches
(7) The Contractor shall be responsible to see that all rebar is properly aligned and tied in place before placing concrete. All column wall dowels and vertical steel shall be accurately located and secured in place so that it remains in the position shown during the concrete placing operation. Any rebar found to be improperly installed shall be removed at no additional cost to the Owner.
(8) Form ties shall be either of the threaded or snap-off type or other approved equal so that no metal will be left within 1 inch of the surface of the wall. Following removal of form ties, recesses are to be carefully filled and pointed with mortar.

AS-BUILT INFORMATION

CONTRACTOR	DATE	REVISION	DATE
CCO	11/92	1	11/92
AKS	11/92	2	11/92
AKS	11/92	3	11/92
AKS	11/92	4	11/92
AKS	11/92	5	11/92

BENCH MARKS

STATION MARK	IS A STANDARD USGS BRASS	TABLET, STAMPED "HUGHES, 1954", SET IN TOP OF CONCRETE POST PROJECTING 0.3 FT. ABOVE THE GROUND, TO REACH THE STATION FROM THE INTERSECTION OF CENTRAL AVE. AND STATE RD. 448.	DATE
50 NORTH ON STATE RD. 448, 6.1 MILES. <td></td> <td></td> <td>11/92</td>			11/92
THE STATION IS 450' WEST OF STATE RD. 448 IN A FENCED-IN PRAIRIE. <td></td> <td></td> <td>11/92</td>			11/92

ENGINEER'S SEAL

REVISIONS

NO.	DATE	REVISION
1	11/92	DESIGN
2	11/92	REVISION
3	11/92	REVISION

DESIGNED BY DMW
DRAWN BY MUT
CHECKED BY DMW

CITY OF ALBUQUERQUE
PUBLIC WORKS DEPARTMENT
ENGINEERING GROUP

TITLE: * RANCHO SERENO SUBDIVISION
GRADING & DRAINAGE DETAILS
ENERGY DISSIPATOR PLAN & SECTIONS








APPROVALS	ENGINEER	DATE	APPROVALS	ENGINEER	DATE
D.R.C. CHAIR	<i>[Signature]</i>	2-23-93	WATER	N/A RWK	1-21-93
TRANS. DEV.	N/A RHO	1-21-93	WASTE WATER	N/A RWK	1-21-93
HYDROLOGY	<i>[Signature]</i>	1-21-93	AMAFCA	<i>[Signature]</i>	11/92

PROJECT NO. 4569.91 **MAP NO.** D-12 **SHEET** 7 **OF** 18

NOTIFY AMAFCA 2 DAYS PRIOR TO WORK IN R.O.W. AMAFCA MUST INSPECT STEEL & FORMWORK PRIOR TO POURING CONCRETE


COORDINATE CONSTRUCTION OF OUTLET STRUCTURE W/ DAM BASIN EARTHWORK (BY OTHERS)

APPROVAL OF A LICENSE AGREEMENT BY AMAFCA IS REQUIRED PRIOR TO CONSTRUCTION WITHIN THE PIEDRAS MARCADAS DAM RIGHT-OF-WAY.

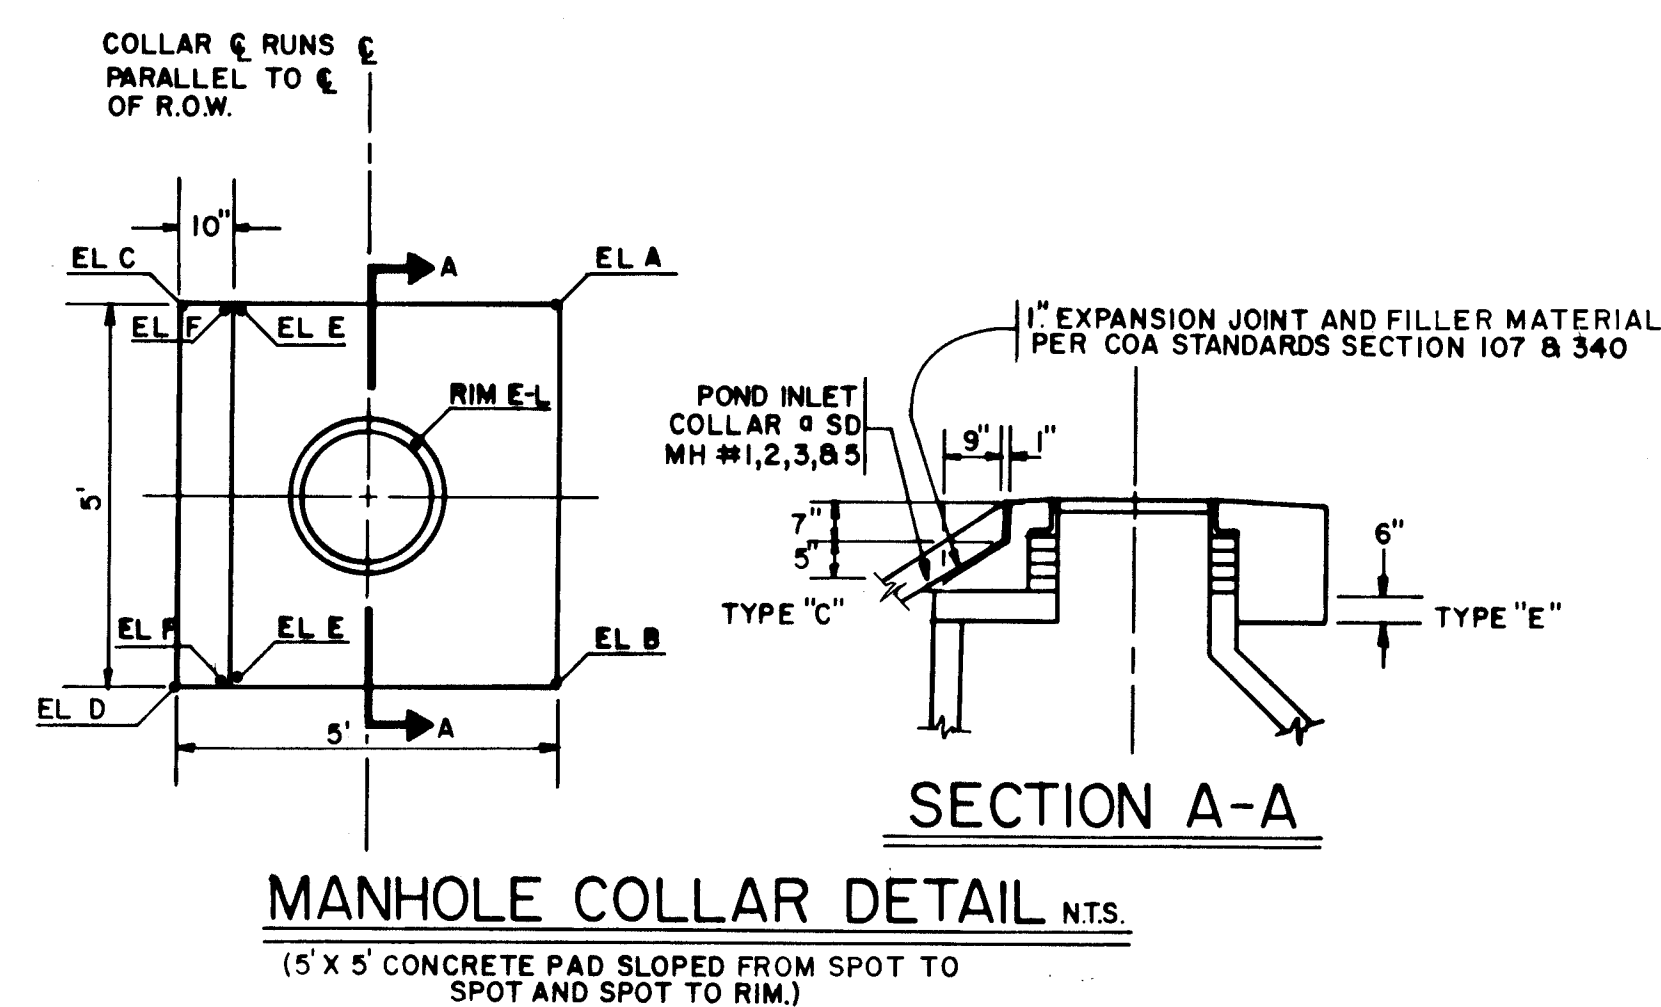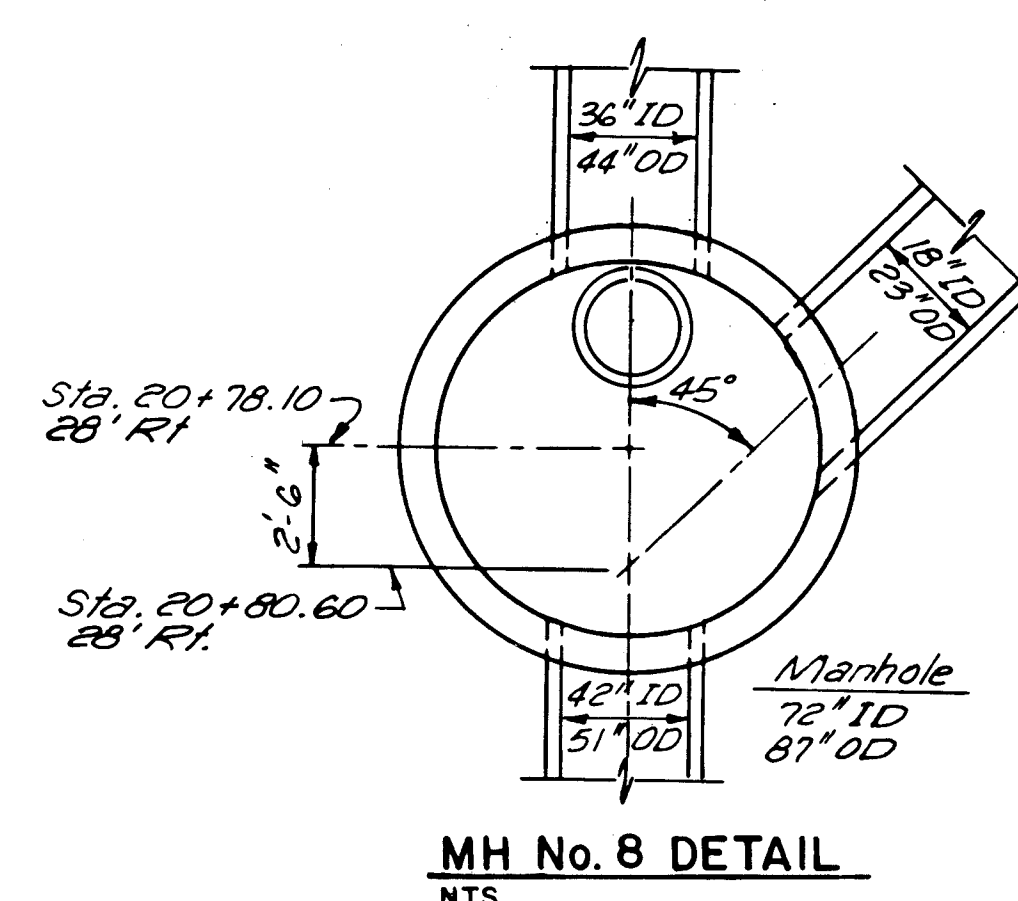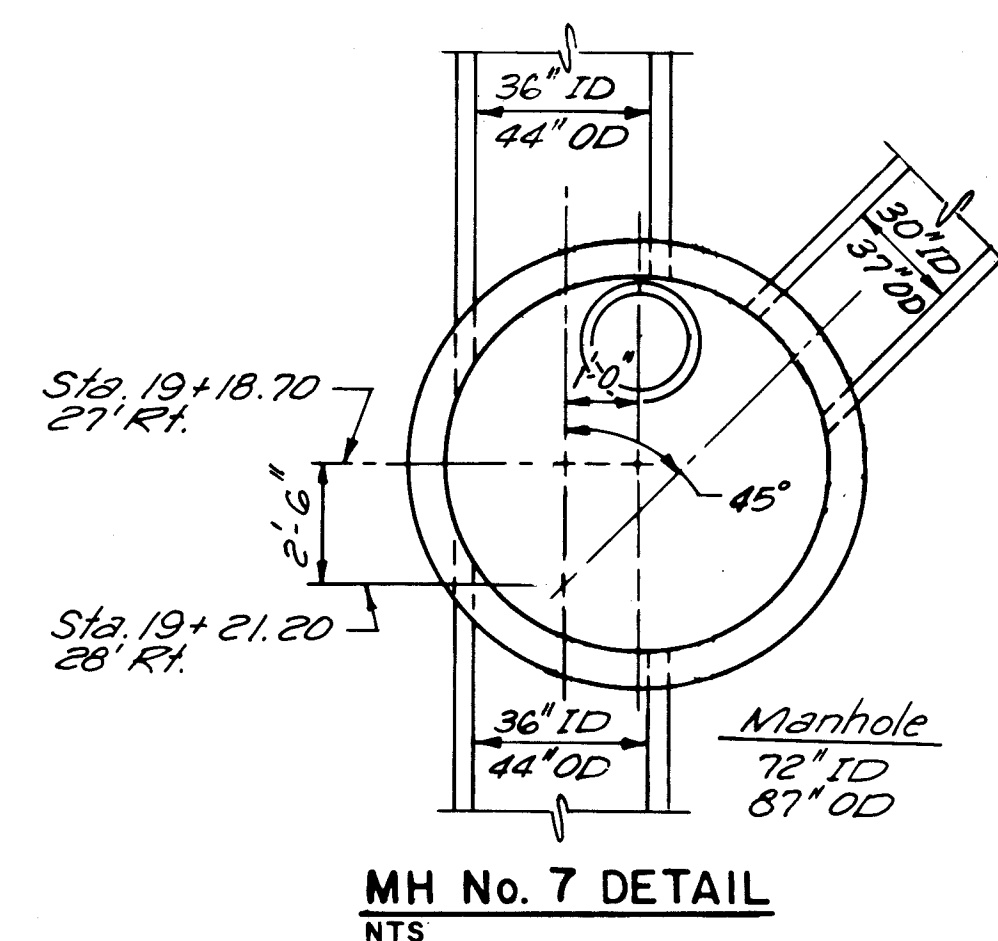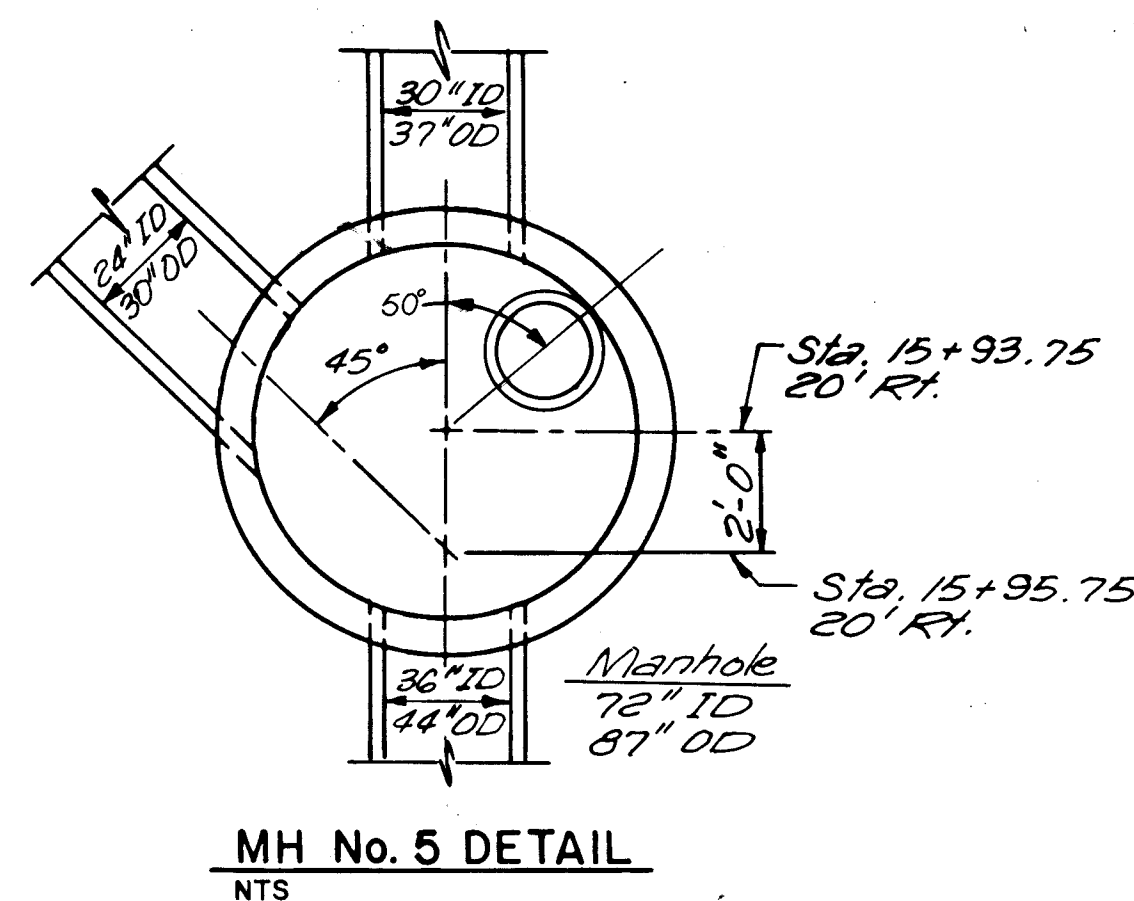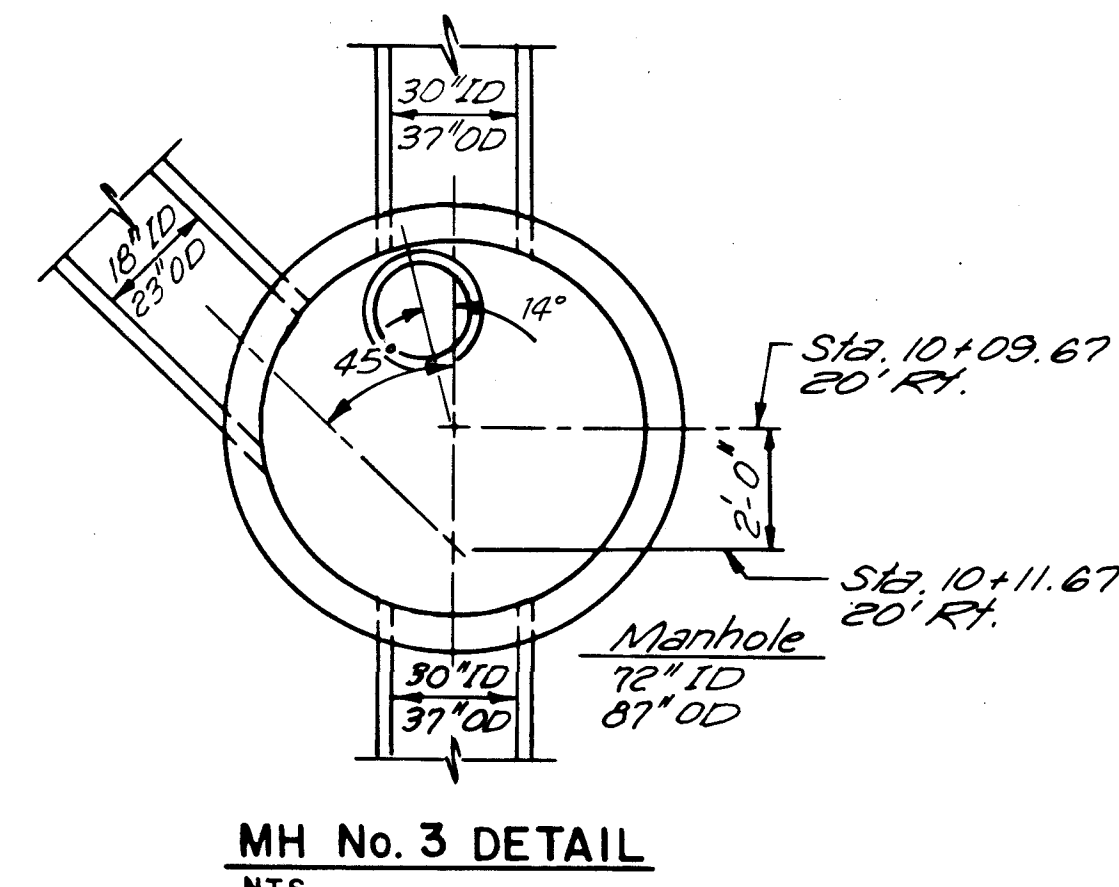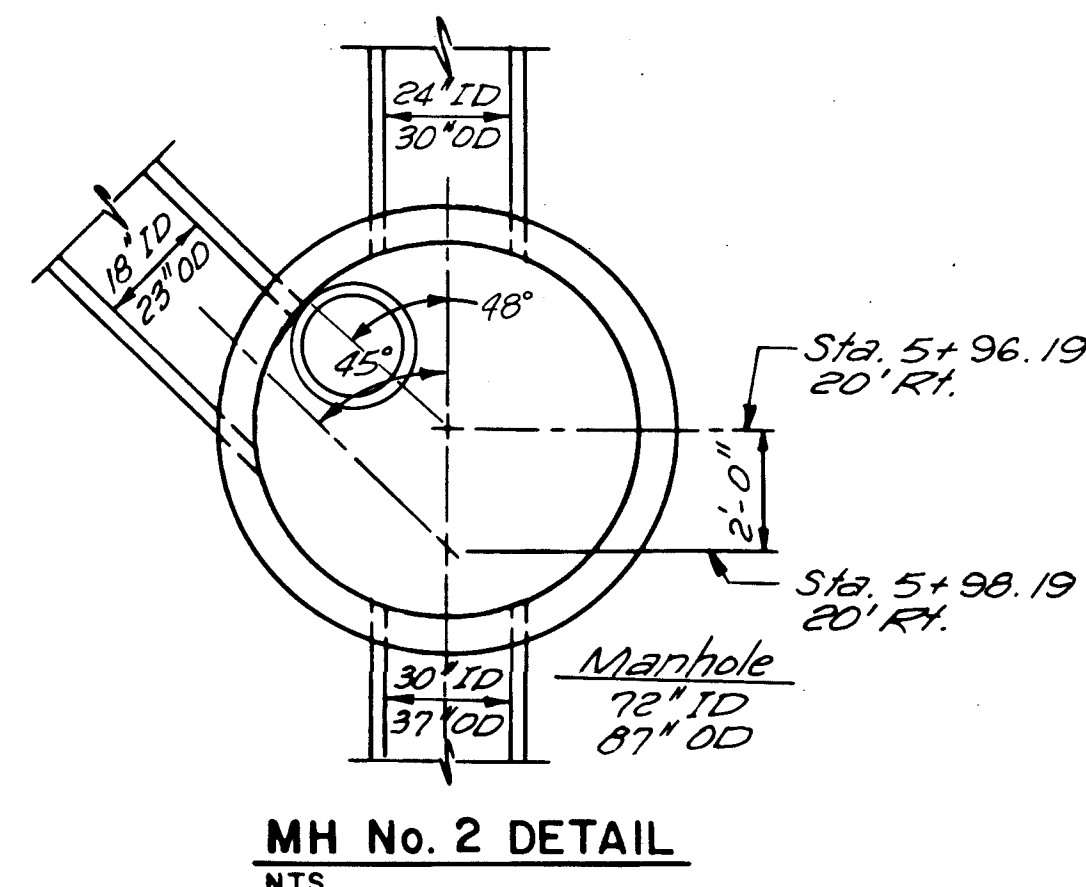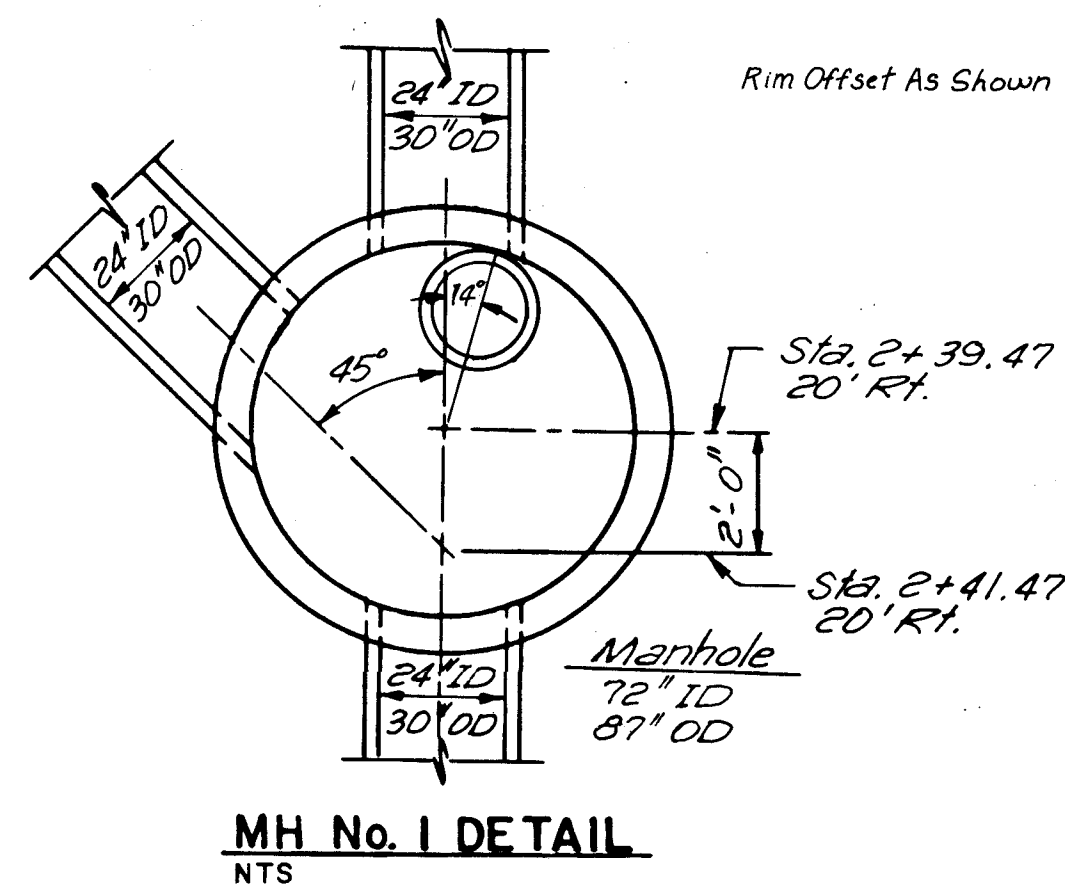

PIPE INTERSECTIONS OFFSETS



MANHOLE	1	2	3	4	5	6	7	8
POND	D	E	F	G				
RIM EL.	80.10	68.00	57.10	53.22	51.20	45.30	42.38	36.50
EL. A	80.33	68.14	57.23	53.90	51.99	44.68	42.80	36.47
EL. B	80.10	68.04	57.15	53.84	51.96	44.26	42.75	36.47
EL. C	79.10	66.72	55.92	52.65	50.02	45.93	42.35	36.47
EL. D	79.10	66.72	55.92	52.59	50.02	45.51	42.30	36.47
EL. E	80.10	67.72	56.92	--	51.02	--	--	--
EL. F	79.52	67.14	56.34	--	50.44	--	--	--

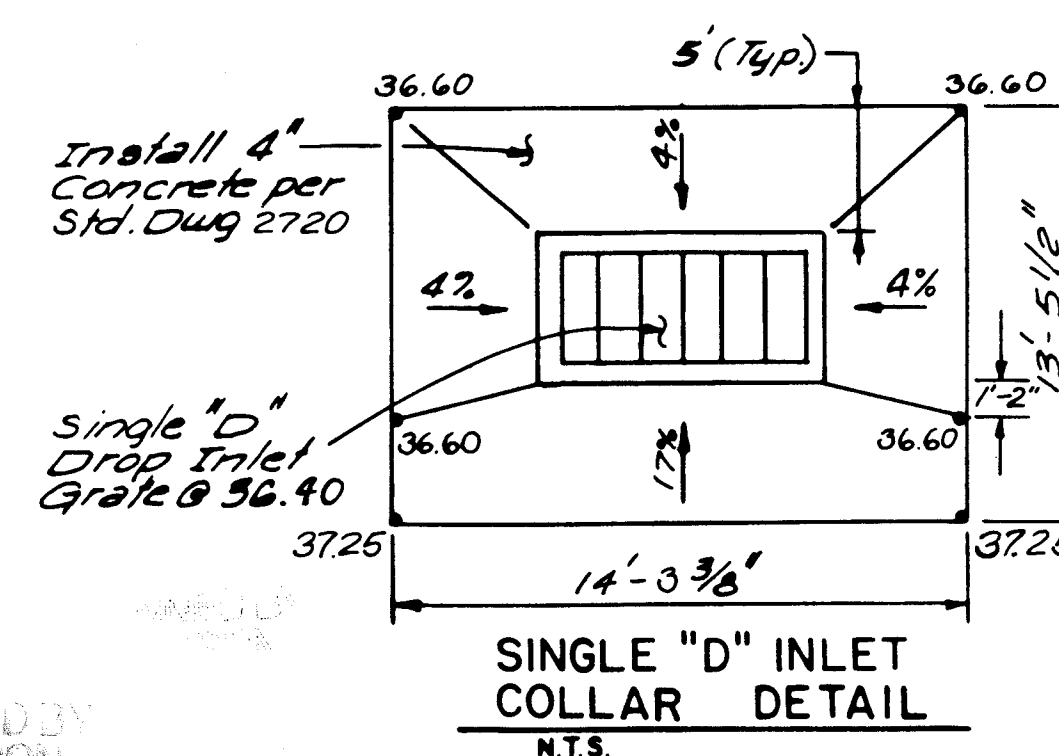

		<i>ENGINEERS SEAL</i>		<i>SURVEY INFORMATION</i>		<i>BENCH MARKS</i>		<i>AS BUILT INFORMATION</i>	
				FIELD NOTES				CONTRACTOR <i>CCM</i>	
				NO.		BY		WORK STOPPED BY SUSPECTED BY ACCEPTANCE BY	
								STATION MARK IS A STANDARD USC&GS BRASS TABLET, STAMPED "HUGHES, 1954", SET IN TOP OF A CONCRETE POST PROJECTING 0.3 FT. ABOVE THE GROUND. TO REACH THE STATION FROM THE INTERSECTION OF CENTRAL AVE. AND STATE RD. 448, GO NORTH ON STATE RD. 448, 6.1 MILES. THE STATION IS 450' WEST OF STATE RD. 448 IN	
				REMARKS				DATE <i>ALS</i>	
				BY				DATE <i>ALS</i>	
				DESIGNED BY		DATE		DATE <i>ALS</i>	
				DRAWN BY		DATE		DATE <i>ALS</i>	
				DESIGN				RECORDED BY	
				DATE 10/92				DATE	
				DATE 10/92				DATE	

QUERQUE DEPARTMENT GROUP		
DIVISION DETAILS TRAIL		
ROVALS	ENGINEER	DATE
	NIA RWK	7-20-
WATER	NIA RWK	7-20-
FCA	John Kelly	11Aug99

PROJECT NO.	4569.91	MAP NO.	D-12	SHEET	8	OF	18
-------------	---------	---------	------	-------	---	----	----

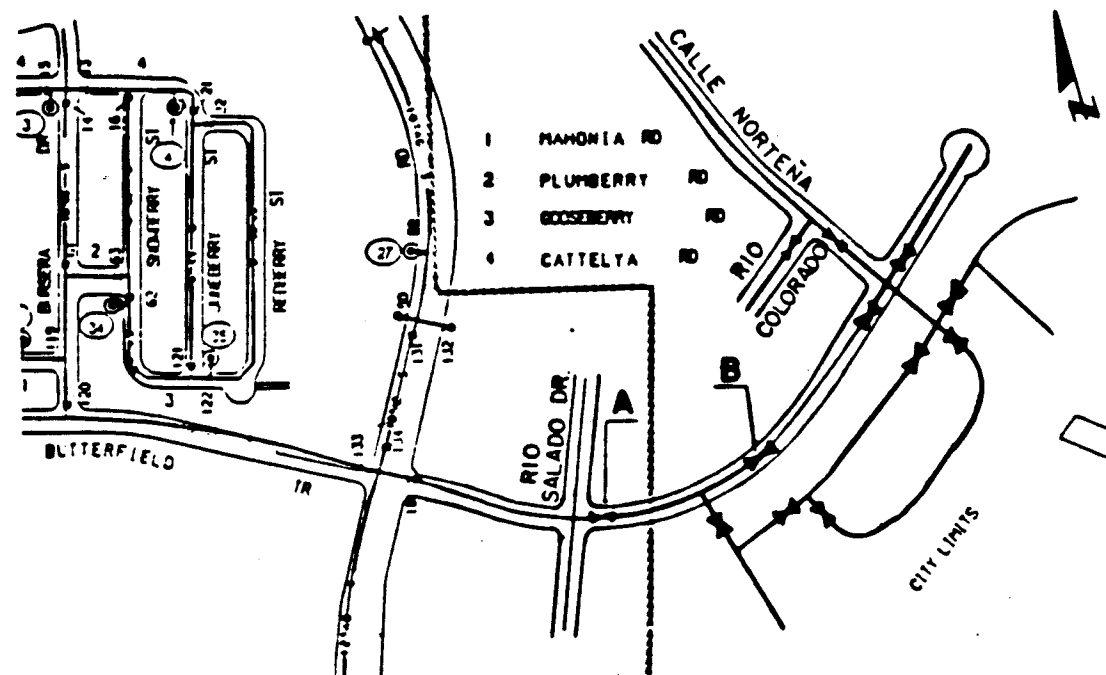
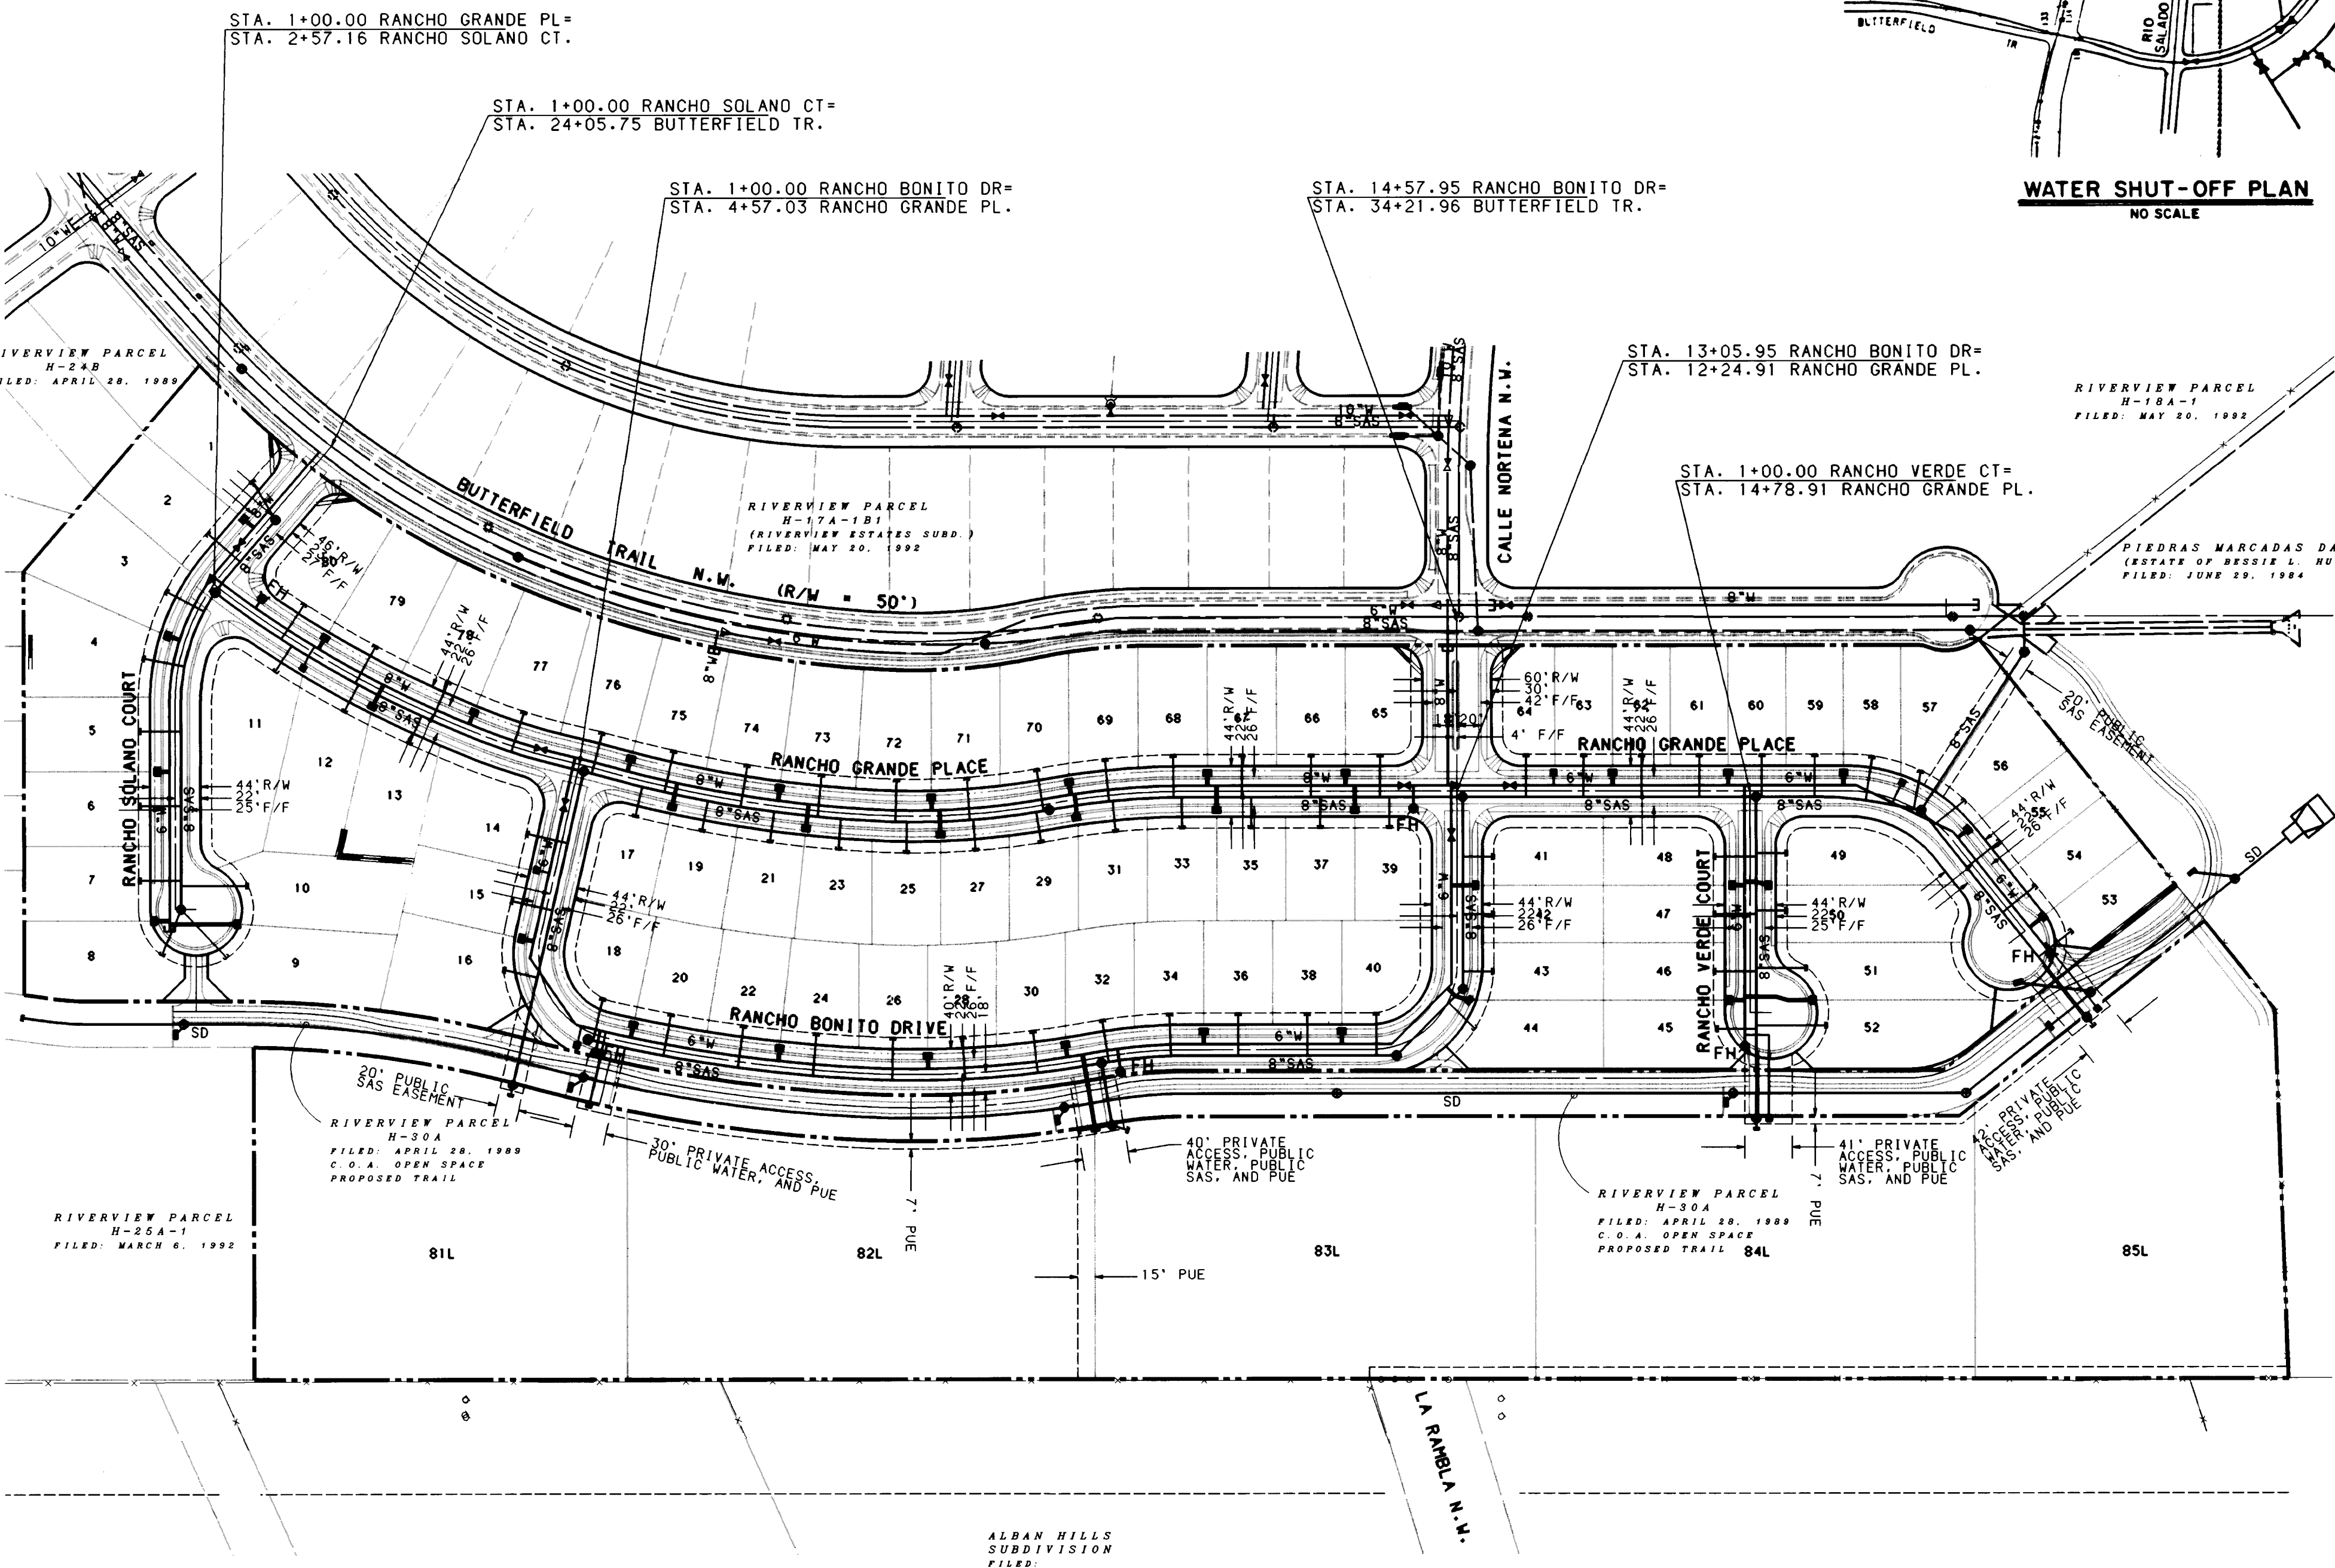


APPROVAL OF A LICENSE AGREEMENT BY AMAFCA IS REQUIRED PRIOR TO CONSTRUCTION WITHIN THE PIEDRAS MARCADAS DAM RIGHT-OF-WAY.

NOTE: THIS SHEET INCLUDED FOR INFORMATION ONLY.

LEGEND

PROJECT BOUNDARY	---
PROPOSED CURB & GUTTER	=====
EXISTING CURB & GUTTER	-----
FUTURE SIDEWALK	
PROPOSED SANITARY SEWER MANHOLE	●
EXISTING SANITARY SEWER MANHOLE	○
PROPOSED FIRE HYDRANT	▼ FH
EXISTING FIRE HYDRANT	⋈
PROPOSED GATE VALVE	⋈
EXISTING GATE VALVE	⋈
EXISTING STORM DRAIN MANHOLE	⊙
PROPOSED SANITARY SEWER LINE	— SAS —
EXISTING SANITARY SEWER LINE	— SAS —
PROPOSED SANITARY SEWER SERVICE	— S —
PROPOSED WATER LINE	— W —
EXISTING WATER LINE	— W —
PROPOSED WATER METER SERVICE	— M —
EXISTING STORM DRAIN LINE	— SD —

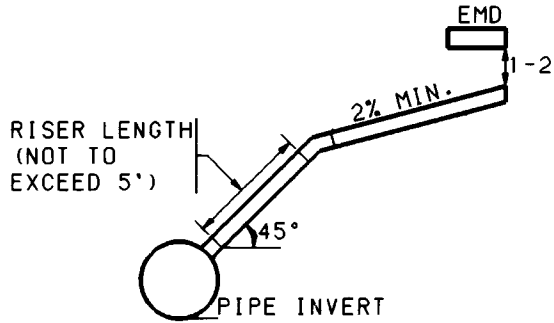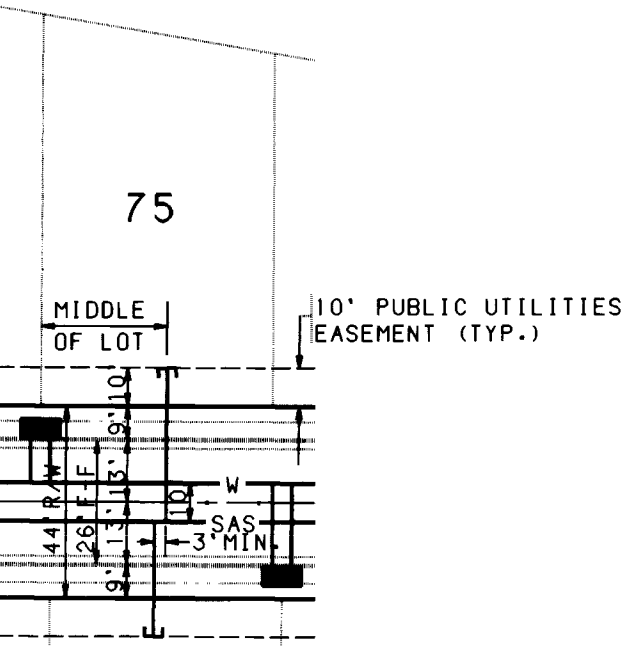

SERVICE RISER DETAIL
(SERVICE CONNECTION & INSTALLATION TO CONFORM TO COA STD. DWG. 2134, USE CI SOIL PIPE ONLY)

SCANNED BY LASON

- NOTES**
1. THE CONTRACTOR SHALL FIELD VERIFY ALL EXISTING UTILITY LOCATIONS AND NOTIFY THE ENGINEER IMMEDIATELY OF ANY DISCREPANCIES.
 2. ALL CURB RETURN RADII SHALL BE 25' TO FACE OF CURB UNLESS OTHERWISE SPECIFIED.
 3. ALL CURVE DATA AND DIMENSIONS REFER TO FACE OF CURB UNLESS OTHERWISE SPECIFIED.
 4. GRADE ELEVATIONS, WHERE NOTED, ARE FOR TOP OF STANDARD CURB UNLESS OTHERWISE SPECIFIED.
 5. CONTRACTOR IS TO INSTALL A 4"x4"x5' POST AND EMD AT THE END OF EACH SANITARY SEWER SERVICE.
 6. CONTRACTOR IS RESPONSIBLE FOR REPAIR AND/OR REPLACEMENT OF ALL UTILITY CONDUITS AND EXISTING LINES.
 7. ANY ADDITIONAL GRADING REQUIRED TO MATCH PROPOSED STREET GRADES SHALL BE INCIDENTAL TO PAVING ITEMS.
 8. CONTRACTOR SHALL PROVIDE THE INSPECTORS (CITY AND PRIVATE) WITH THE PROPOSED HYDROSTATIC TESTING PLAN. THE PLAN MUST BE APPROVED BEFORE TESTING OPERATIONS BEGIN.
 9. CONTRACTOR SHALL PARK EQUIPMENT AND VEHICLES AS NOT TO INTERFERE WITH NORMAL ACTIVITIES OF RESIDENTS OR OTHER CONTRACTORS ON SITE.
 10. ANY DAMAGE TO THE EXISTING FACILITIES (CURB AND GUTTER, PAVEMENT, CONDUITS, LANDSCAPING, UTILITY LINES, ETC.) DURING CONSTRUCTION SHALL BE REPLACED AT THE CONTRACTORS EXPENSE.
 11. REMOVAL OF THE EXISTING CURB AND GUTTER SHALL BE AS PER COA STD. DWG. 2415 (SAWCUT ONLY).
 12. WHEEL CHAIR RAMPS SHALL BE CONSTRUCTED PRIOR TO ACCEPTANCE OF CURB AND GUTTER.
 13. THE FOLLOWING PERSONS SHALL BE NOTIFIED AT LEAST TWO BUSINESS DAYS PRIOR TO INSTALLING UTILITY CONDUIT CROSSINGS:

COMPANY	PHONE	CONTACT
PNM	848-3374	TOM BACA
US WEST	245-6694	BECKY OLSEN
GAS CO.	761-7770	LEO APODACA
JONES	761-6200	YVETTE SUAZO

WATER SHUT-OFF REQUIREMENTS

CONTRACTOR WILL BE RESPONSIBLE FOR THE TIMING AND COORDINATION OF THE WATER SHUT-OFF REQUIREMENTS IN CONJUNCTION WITH THE COMPLETION OF THIS PROJECT.

AT LEAST THREE (3) WORKING DAYS PRIOR TO CONSTRUCTION, THE CONTRACTOR SHALL CONTACT PWD/WATER SYSTEMS DIVISION (857-8200) TO INITIATE IMPLEMENTATION OF THIS WATER SHUT-OFF PLAN.

WATER SHUT-OFF PLAN

CLOSE VALVES

- A. RANCHO SOLANO COURT - A, B
NON-PRESSURE CONNECTION

1 2 3 4 5 6 7 8 9 10 11 12 13 14 15
2 4 4 5 6 9 9 10 9 9 4 1




CITY OF ALBUQUERQUE
PUBLIC WORKS DEPARTMENT
ENGINEERING GROUP



TITLE: RANCHO SERENO SUBDIVISION
OVERALL UTILITY PLAN

APPROVALS	ENGINEER	DATE	APPROVALS	ENGINEER	DATE
DRC CHAIRMAN	R. W. Kane	9-07-93	WATER	R. W. Kane	7-28-93
TRANS. DEV.	R. W. Kane	8-18-93	WASTE WATER	R. W. Kane	7-28-93
HYDROLOGY	R. W. Kane	8-23-93			

PROJECT NO.	4569.91	MAP NO.	D-12	SHEET	9	OF	18
-------------	---------	---------	------	-------	---	----	----

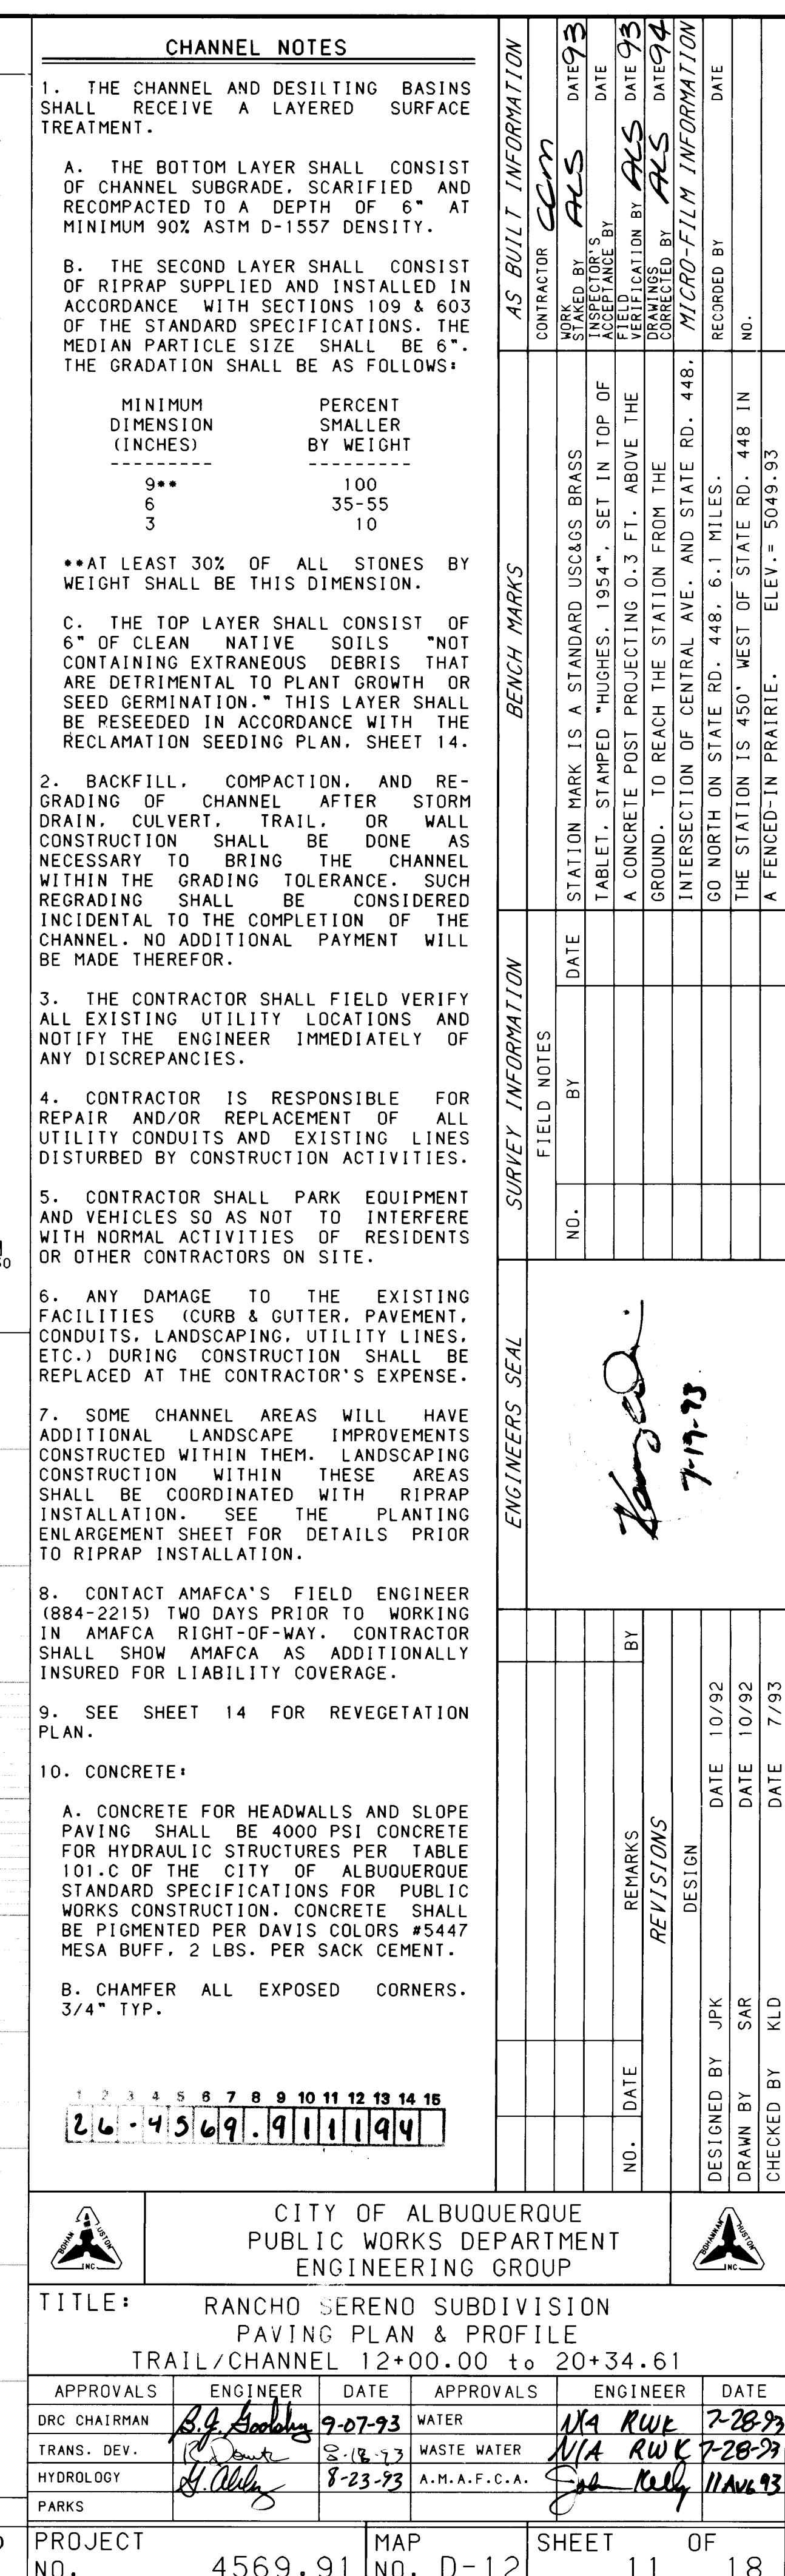

GENERAL NOTES

- * ALL QUANTITIES SHOWN IN PLANT LIST AND IRRIGATION PARTS LIST ARE FOR CONVENIENCE. CONTRACTOR SHALL BE RESPONSIBLE FOR HIS/HER QUANTITY TAKE OFFS. IN SITUATIONS WHERE PLANS CONFLICT WITH QUANTITIES SHOWN IN PLANT LIST OR IRRIGATION PARTS LIST THE QUANTITIES IN THE PLANS SHALL GOVERN.
- * ALL SHRUBS AND GROUND COVERS SHALL MAINTAIN A 5' HORIZONTAL SETBACK FROM THE EDGE OF THE BIKE PATH. ALL TREES, A 10' HORIZONTAL SETBACK FROM THE BIKE PATH. A 10' VERTICAL CLEARANCE SHALL BE MAINTAINED WITHIN THE HORIZONTAL SETBACK.
- * CONTRACTOR SHALL COORDINATE ALL WORK WITH OTHER CONTRACTORS.

PLANTING NOTES

GENERAL

- * SCOPE: WORK COVERED IN THESE NOTES CONSISTS OF THE PLANTING OF SEEDING, TREES, SHRUBS AND GROUNDCOVERS, GRADING AND MULCHING, INCLUDING THE FURNISHING OF ALL LABOR, EQUIPMENT, MATERIALS AND PERFORMING ALL WORK IN CONNECTION WITH THE DRAWINGS AND SPECIFICATIONS.
- * CONTRACTOR SHALL BE FAMILIAR WITH PLANS, DETAILS AND SPECIFICATIONS AS THEY PERTAIN TO THE SITE. IT SHALL BE THE CONTRACTORS RESPONSIBILITY TO NOTIFY THE OWNER'S REPRESENTATIVE IF ANY ITEMS CONTAINED WITHIN THE SCOPE OF WORK DEFINED HEREIN, ARE IN CONFLICT WITH PROPOSED CONTRACT.
- * EXISTING UTILITY LINES ARE TO BE BLUE STAKED PRIOR TO EXCAVATION FOR PLANT MATERIALS. CHECK AND FIELD VERIFY ALL SITE CONDITIONS, UTILITIES AND SERVICES PRIOR TO EXCAVATION. CALL N.M. ONE CALL AT 260-1990 FOR BLUE STAKING.

PROTECTION

- * PROTECTION OF PERSONS AND PROPERTY: CONTRACTOR IS TO BARRICADE OPEN EXCAVATIONS OCCURRING AS PART OF THIS WORK AND POST WITH WARNING LIGHTS OR OTHER WARNING MEASURES AS NECESSARY. PROTECTION OF SHRUBS, TREES AND OTHER PLANT MATERIALS ARE ALSO TO BE INCLUDED.
- * PROTECT STRUCTURES, UTILITIES, SIDEWALKS, PAVEMENTS AND OTHER FACILITIES FROM DAMAGE CAUSED BY SETTLEMENT, LATERAL MOVEMENT, UNDERMINING, WASHOUT AND OTHER HAZARDS CREATED BY EARTHWORK OPERATIONS.ALL DAMAGES THAT MAY OCCUR DURING THIS PHASE OF WORK SHALL BE THE CONTRACTORS FINANCIAL RESPONSIBILITY.

GRADING

- * PERFORM GRADING AND EXCAVATION WORK IN COMPLIANCE WITH APPLICABLE SPECIFICATIONS, REQUIREMENTS, CODES AND ORDINANCES OF THE CITY OF ALBUQUERQUE AND OTHER GOVERNING BODIES HAVING JURISDICTION.
- * ROUGH GRADING: ROUGH GRADING SHALL BE PERFORMED TO SPECIFICATIONS BY GENERAL CONTRACTOR.
- * ALL EARTHWORK SHALL BE DONE SO THAT ALL WATER DRAINS AWAY FROM ALL BUILDINGS.
- * FINE GRADING: SURFACE SHALL BE RAKED FREE OF STONES AND EXTRANEIOUS MATERIALS AND DEBRIS TO A SMOOTH AND EVEN TEXTURE. ALL EXTRANEIOUS MATTER WILL BE DISPOSED OF BY CONTRACTOR.

PLANTINGS

- * PLANT MATERIAL SUBSTITUTIONS SHALL NOT BE MADE WITHOUT THE WRITTEN PERMISSION OF THE OWNER'S REPRESENTATIVE. THE USE OF MATERIALS DIFFERING IN KIND, QUALITY OR SIZE FROM THAT SPECIFIED WILL BE ALLOWED ONLY AFTER THE OWNER'S REPRESENTATIVE IS CONVINCED THAT ALL MEANS OF OBTAINING THE SPECIFIED MATERIALS HAVE BEEN EXHAUSTED. AT THE TIME BIDS ARE SUBMITTED, THE CONTRACTOR IS ASSUMED TO HAVE LOCATED THE MATERIALS NECESSARY TO COMPLETE THE JOB AS SPECIFIED. ALL REQUESTS FOR SUBSTITUTIONS MUST BE SUBMITTED NO LATER THAN 2 WEEKS PRIOR TO THE INITIATION OF WORK.
- * PLANT MATERIAL QUALITY, SIZE AND CONDITION SHALL BE IN ACCORDANCE WITH AMERICAN STANDARD FOR NURSERY STOCK, 1980 EDITION, AS PUBLISHED BY THE COMMITTEE ON HORTICULTURAL STANDARDS OF THE AMERICAN ASSOCIATION OF NURSERYMEN, INC.

MULCHING

WARRANTY

SEEDING NOTES

GENERAL

- * ALL PLANTS SHALL BY TYPICAL OF THEIR SPECIES OR VARIETY. ALL PLANTS SHALL HAVE NORMAL, WELL DEVELOPED BRANCHES AND VIGOROUS ROOT SYSTEMS. THEY SHALL BE SOUND, HEALTHY, VIGOROUS, FREE FROM DEFECTS, DISFIGURING KNOTS, ABRASIONS OF THE BARK, SUNSCALD INJURIES, PLANT DISEASES, INSECT EGGS, BORES AND ALL OTHER FORMS OF INFECTIONS.
- * UNLESS OTHERWISE STATED ON THE DRAWINGS OR APPROVED BY OWNER'S REPRESENTATIVE, ALL PLANTS SHALL BE NURSERY GROWN AND SHALL BE TAGGED WITH NURSERY LABELS INDICATING SPECIES AND VARIETY.
- * CONTAINER GROWN PLANT MATERIAL SHALL HAVE BEEN ESTABLISHED IN ITS DELIVERY CONTAINER FOR NOT LESS THAN SIX MONTHS, BUT FOR NOT MORE THAN TWO YEARS. ANY ROOTBOUND MATERIAL WILL NOT BE ACCEPTED.
- * BALLED AND BURLAPPED PLANT MATERIAL SHALL HAVE A SOLID BALL OF EARTH OF MINIMUM SPECIFIED SIZE AND HELD IN PLACE SECURELY BY BURLAP AND A STOUT TWINE OR ROPE. BROKEN OR LOOSE BALLS WILL BE REJECTED.
- * UNLESS SPECIFICALLY NOTED ON THE DRAWINGS, ALL TREES SHALL HAVE A SINGLE TRUNK THAT IS STRAIGHT AND FREE OF "DOG-LEGS", "CROOKS", "Y-CROTCHES", OR OTHER DISFIGURING SHAPES. THE CENTRAL LEADER OF ALL TREES SHALL NOT HAVE BEEN PRUNED. TREES WITH DOUBLE LEADERS ARE NOT ACCEPTABLE, UNLESS SPECIFIED AS MULTI-TRUNKED.
- * ALL PLANT MATERIAL SHALL HAVE A UNIFORM SHAPE AROUND ITS COMPLETE CIRCUMFERENCE. PLANT MATERIAL WITH IRREGULAR BRANCHING PATTERNS OR WITH BRANCHING PATTERNS MORE HIGHLY DEVELOPED ON ONE SIDE THAN ON OTHER SIDES SHALL NOT BE ACCEPTABLE.
- * THE OWNER'S REPRESENTATIVE SHALL INSPECT ALL PLANT MATERIAL AT THE CONTRACTOR'S YARD PRIOR TO DELIVERY, DURING PLANTING AND AFTER PLANTING AT THE JOB SITE.
- * AT THE OPTION OF THE CONTRACTOR, THE OWNER'S REPRESENTATIVE WILL INSPECT PLANT MATERIAL AT A WHOLESALE NURSERY OF THE CONTRACTOR'S CHOICE PRIOR TO DELIVERY OF MATERIALS TO THE CONTRACTOR'S YARD. HOWEVER, AT NO ADDITIONAL EXPENSE TO THE OWNER, THE CONTRACTOR SHALL BE RESPONSIBLE FOR ALL TRAVEL EXPENSES INCURRED BY THE OWNER'S REPRESENTATIVE FOR ANY TRAVEL OUTSIDE OF THE ALBUQUERQUE METROPOLITAN AREA.
- * THE OWNER'S REPRESENTATIVE SHALL BE THE JUDGE OF THE QUALITY AND ACCEPTABILITY OF ALL PLANT MATERIALS. ALL REJECTED MATERIAL SHALL BE IMMEDIATELY REMOVED FROM THE SITE AND REPLACED WITH ACCEPTABLE MATERIAL AT NO ADDITIONAL COST TO OWNER.
- * ALL PLANTING BEDS SHOWN ON PLANS SHALL BE MULCHED. NO BEDS WILL BE LEFT UNCOVERED OR NOT TOP DRESSED, UNLESS OTHERWISE SPECIFIED.
- * ALL TREES, SHRUBS AND GROUNDCOVERS SHALL BE GUARANTEED FOR THE PERIOD OF ONE FULL YEAR BEGINNING ON THE DATE OF FINAL CONTRACT ACCEPTANCE.
- * ALL AREAS DISTURBED OR DENUED OF VEGETATION SHALL BE RESEEDED WITH THE RECLAMATION SEED MIX AS DESCRIBED IN THE PLANS.
- * ALL AREAS SHOWN AS RECLAMATION SEEDING AND SWALE SEEDING ON THE PLANS SHALL BE PAID BASED ON PER ACRE. ALL DISTURBED OR DENUED AREAS BEYOND THE LIMITS OF CONSTRUCTION SHALL BE RESEEDED AS PER THE RECLAMATION SEED MIX AND AS PER THE OWNER'S DIRECTION.
- * ALL RECLAMAION SEEDING OUTSIDE THE LIMITS OF CONSTRUCTION SHALL BE CONSIDERED INCIDENTAL TO CONTRACT.

IRRIGATION NOTES

GENERAL

- * WORK UNDER THIS SECTION CONSISTS OF INSTALLING A COMPLETE UNDERGROUND IRRIGATION SYSTEM AS SHOWN ON THESE PLANS, DETAILS AND SPECIFICATIONS. THE CONTRACTOR PERFORMING THIS WORK SHALL FURNISH ALL LABOR, EQUIPMENT, MATERIALS AND PERMITS NECESSARY FOR THE COMPLETION OF THE IRRIGATION SYSTEM, EXCEPT FOR THOSE COMPONENTS SPECIFIED TO BE FURNISHED BY OTHERS.
- * THE CONTRACTOR SHALL BE FAMILIAR WITH THESE PLANS, DETAILS AND SPECIFICATIONS AS THEY PERTAIN TO THE SITE. IT SHALL BE THE CONTRACTOR'S RESPONSIBILITY TO NOTIFY THE OWNER'S REPRESENTATIVE OF ANY ITEMS THAT ARE IN CONFLICT WITH THE PROPOSED CONTRACT.
- * EXISTING UTILITY LINES ARE TO BE BLUE STAKED PRIOR TO EXCAVATION FOR IRRIGATION LINES AND EQUIPMENT. CHECK AND FIELD VERIFY ALL SITE CONDITIONS, UTILITIES AND SERVICES PRIOR TO TRENCHING. CALL N.M. ONE CALL AT 260-1990 FOR BLUE STAKING.
- * ALL PLANT MATERIALS SHALL BE IRRIGATED WITH AUTOMATIC IRRIGATION SYSTEMS AS PER PLANS, DETAILS AND SPECIFICATIONS UNLESS OTHERWISE INDICATED ON THE DRAWING.
- * WHERE TREES, LIGHT STANDARDS, ETC. ARE AN OBSTRUCTION OF PIPING AND DRIP EMITTERS, THEY SHALL BE ADJUSTED AND/OR RELOCATED AS NECESSARY TO OBTAIN FULL COVERAGE WITHOUT EXCESSIVE OVERFLOW.
- * CONTRACTOR SHALL FLUSH ALL LINES PRIOR TO INSTALLING HEADS AND EMITTERS.
- * PLANS ARE DIAGRAMMATIC AND APPROXIMATE DUE TO SCALE OF DRAWINGS. ALL VALVES SHALL BE LOCATED IN PLANTING AREAS OR SODDED AREAS WHERE SHOWN AND ALL PIPING SHALL BE INSTALLED PRIOR TO LANDSCAPING OR PAVING WORK. NO TEES, ELLS OR OTHER TURNS IN PIPING SHALL BE LOCATED UNDER PAVING. CAP ALL ENDS HAND TIGHT, PRIOR TO BACKFILL.
- * COMPLY WITH REQUIREMENTS OF THE UNIFORM PLUMBING CODE AND CITY OF ALBUQUERQUE STANDARD SPECIFICATIONS FOR PUBLIC WORKS CONSTRUCTION (LATEST EDITION) AND ANY OTHER GOVERNMENTAL BODIES HAVING JURISDICTION.
- * REFER TO IRRIGATION DETAILS, SPECIFICATIONS AND MANUFACTURERS RECOMMENDATIONS FOR ALL INSTALLATION PROCEDURES NOT FULLY DESCRIBED ON THE IRRIGATION PLANS.
- * ALL BACKFILLING SHALL BE CLEAN MATERIAL FROM EXCAVATION. BACKFILLED TRENCH IS TO BE EVEN WITH EXISTING GRADES AFTER COMPACTION.
- * TRENCH BACKFILL MATERIAL SHALL BE COMPACTED TO 85% PROCTOR DENSITY.
- * ALL VALVES TO BE IN APPROVED VALVE BOXES. LOCATE VALVE BOXES IN GROUPS OF TWO OR THREE AND NEAR WALKWAYS WHEREVER POSSIBLE.
- * COORDINATE PROGRAMS TO AVOID STATION OVERLAP.



COMPONENTS AND PRODUCTS

- * ALL COMPONENTS INSTALLED AS THE UNDERGROUND IRRIGATION SYSTEM ARE TO BE NEW AND IN GOOD WORKING ORDER AND WITHOUT FLAWS UNLESS OTHERWISE INDICATED ON THE PLANS, DETAILS AND SPECIFICATIONS.
- * IF THE CONTRACT DRAWINGS AND/OR SPECIFICATIONS DO NOT THOROUGHLY DESCRIBE THE METHOD OR TECHNIQUES TO BE USED FOR INSTALLATION, THEN THE CONTRACTOR SHALL FOLLOW THE INSTALLATION METHODS RECOMMENDED BY THE MANUFACTURER.
- * ALL PLANT MATERIALS INSTALLED SHALL HAVE THE AUTOMATIC IRRIGATION SYSTEM FULLY OPERABLE AT THE TIME OF PLANT INSTALLATION.
- * THE CONTRACTOR SHALL FURNISH A CERTIFICATE OF WARRANTY AND A GUARANTEE OF WORK AND MATERIALS FOR A ONE-YEAR PERIOD FROM DATE OF FINAL ACCEPTANCE. FINAL PAYMENT FOR THE SYSTEM SHALL NOT BE MADE UNLESS THIS CERTIFICATE IS PRESENTED TO THE OWNER.
- * THE CONTRACTOR SHALL MAINTAIN THE IRRIGATION SYSTEM, IN SATISFACTORY WORKING ORDER, DURING THE TIME OF CONTRACT WORK.
- * THE CONTRACTOR SHALL BE LIABLE FOR ANY LOSS OR DAMAGE TO ANY WORK OR MATERIALS, SUPPLIES AND EQUIPMENT ON THE JOB SITE CAUSED BY THE CONTRACTOR, ITS EMPLOYEES OR ANY OTHER UNFORESEEN CAUSE UNTIL FINAL ACCEPTANCE OF PROJECT WITH THE OWNER'S REPRESENTATIVE AND THE CITY OF ALBUQUERQUE.

SCANNED BY
BY LASON

1 2 3 4 5 6 7 8 9 10 11 12 13 14 15
26-45691-911394

			CITY OF ALBUQUERQUE PUBLIC WORKS DEPARTMENT ENGINEERING GROUP					
TITLE: RANCHO SERENO SUBDIVISION GENERAL NOTES								
APPROVALS	ENGINEER	DATE	APPROVALS	ENGINEER	DATE			
DRC CHAIRMAN	<i>[Signature]</i>	9-07-93	WATER	<i>[Signature]</i>	7-28-93			
TRANSPORTATION	<i>[Signature]</i>	8-18-93	WASTE WATER	<i>[Signature]</i>	7-28-93			
HYDROLOGY	<i>[Signature]</i>	8-23-93						
PARKS	<i>[Signature]</i>	8/19/93						
DRAWING NO.	4569.91		MAP NO.	D-12		SHEET	OF 13 18	

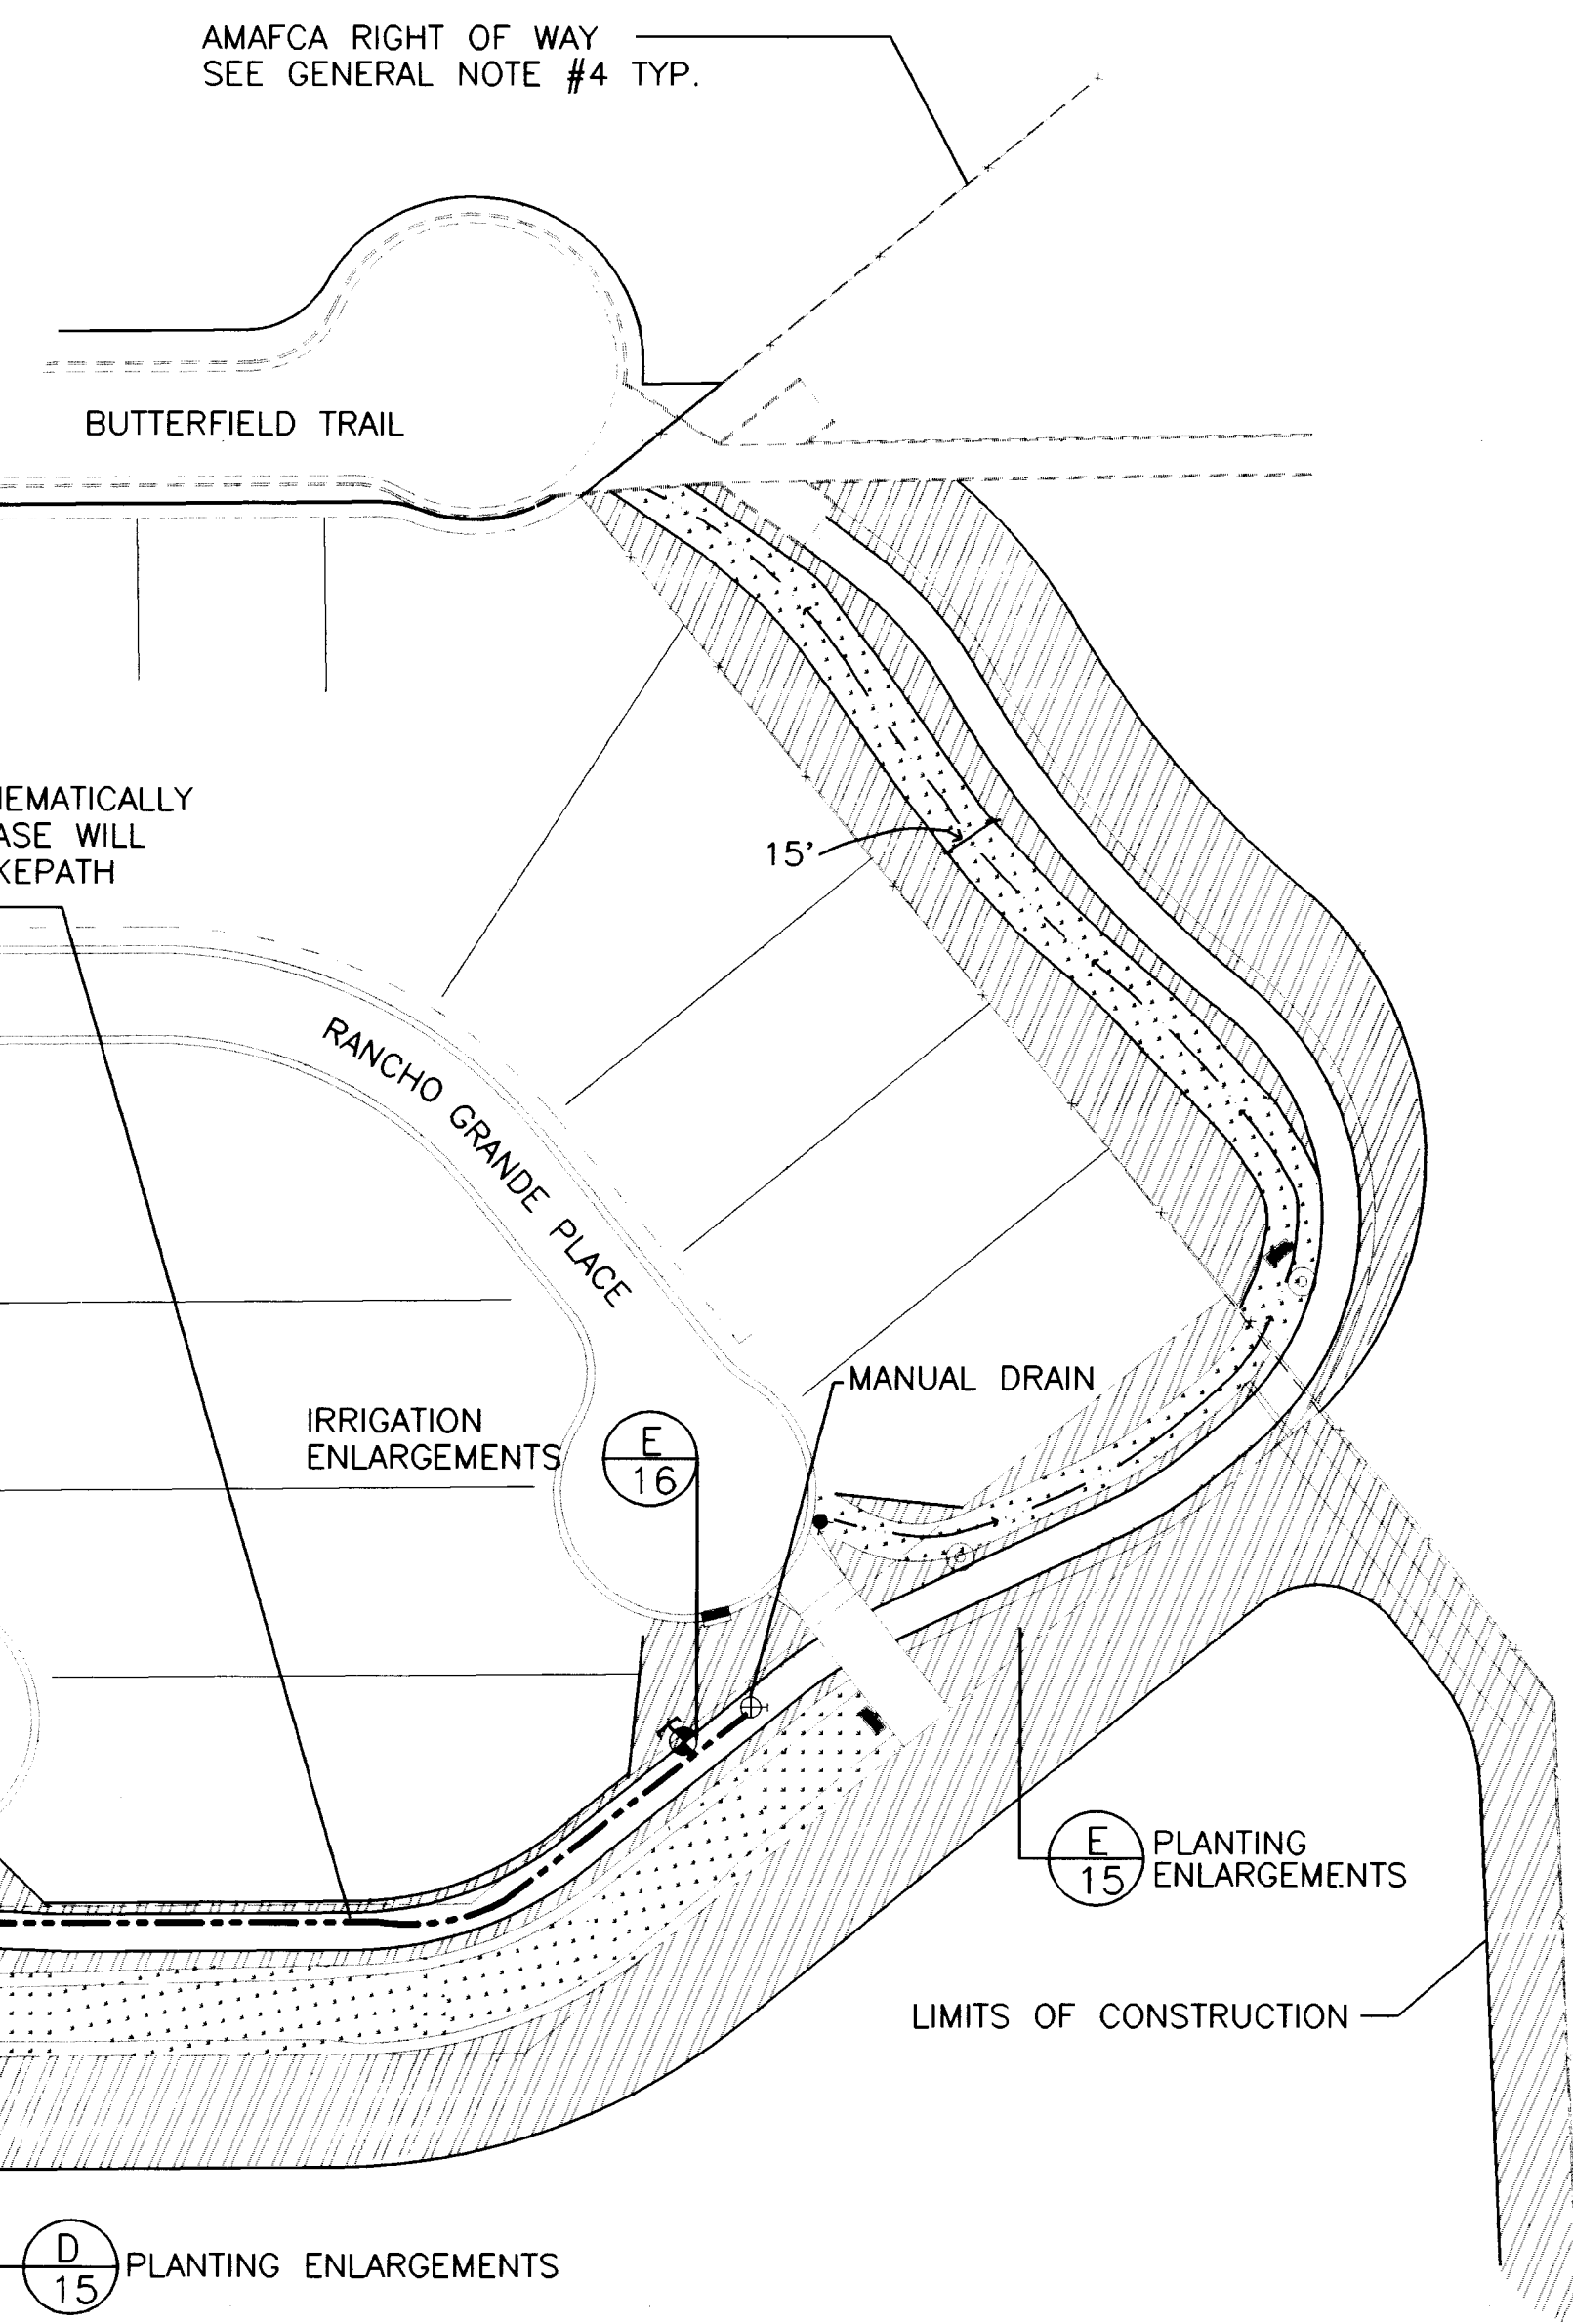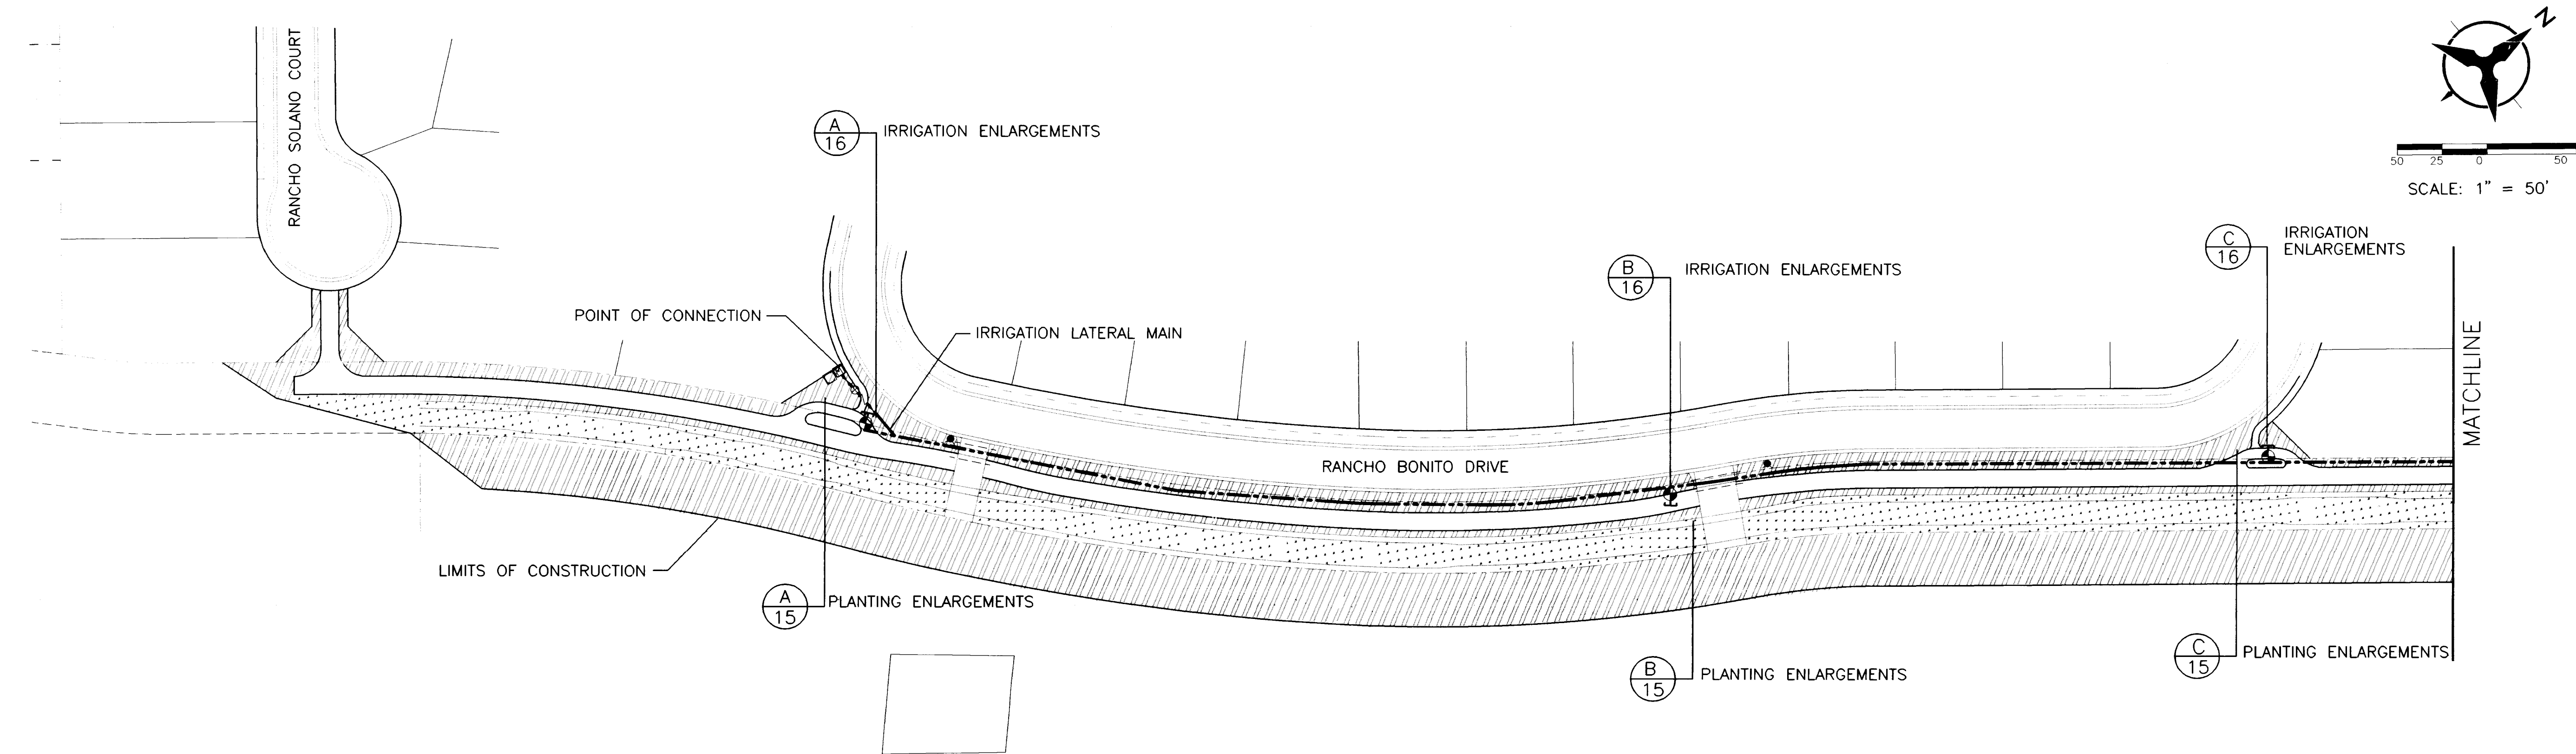

GENERAL SEEDING NOTES

ALL SEEDING SHALL CONFORM TO THE CITY OF ALBUQUERQUE STANDARD CONSTRUCTION DETAILS AND SPECIFICATIONS, DESIGN AND DEVELOPMENT DIVISION, PARKS AND GENERAL SERVICES DEPARTMENT, SECTION 1012 NATIVE GRASS SEEDING.

SEEDING LIST

SYMBOL	BOTANICAL NAME	COMMON NAME	LBS PLS/ACRE
	Hilaria jamesii	Galleta Grass	4 LBS PLS/ACRE
	Bouteloua gracilis	Blue Grama Grass 'Hachita'	9 LBS PLS/ACRE
	Oryzopsis hymenoides	Indian Rice Grass 'Paloma'	2 LBS PLS/ACRE
	Bouteloua curtipendula	Sideoats Grama Grass 'Vaughn'	4.5 LBS PLS/ACRE
	Sporobolus cryptandrus	Sand Dropseed	1 LBS PLS/ACRE
	Aster bigelovii	Purple Aster	.5 LBS PLS/ACRE
	Chrysopsis villosa	Golden Aster	1 LBS PLS/ACRE
	Linum perenne lewisii	Blue Flax	1 LBS PLS/ACRE
	Agropyron smithii	Western Wheatgrass	1 LBS PLS/ACRE
	Hilaria jamesii	Galleta Grass	4 LBS PLS/ACRE
	Bouteloua gracilis	Blue Grama Grass 'Hachita'	9 LBS PLS/ACRE
	Oryzopsis hymenoides	Indian Rice Grass 'Paloma'	2 LBS PLS/ACRE
	Bouteloua curtipendula	Sideoats Grama Grass 'Vaughn'	4.5 LBS PLS/ACRE
	Sporobolus cryptandrus	Sand Dropseed	1 LBS PLS/ACRE
	Aster bigelovii	Purple Aster	.5 LBS PLS/ACRE
	Chrysopsis villosa	Golden Aster	1 LBS PLS/ACRE

LEGEND

SYMBOL	NAME	REMARKS
	IRRIGATION LATERAL MAIN AND VALVE	SEE IRRIGATION ENLARGEMENT SHEET FOR MORE DETAILED INFORMATION
	ENLARGEMENT FLAG	SYMBOLS DENOTE PLANTING NODE LOCATIONS AND REFER TO APPLICABLE ENLARGEMENT SHEETS

SCANNED BY
BY LASON

1 2 3 4 5 6 7 8 9 10 11 12 13 14 15
26-4569.911494

						CITY OF ALBUQUERQUE PUBLIC WORKS DEPARTMENT ENGINEERING GROUP											
TITLE: RANCHO SERENO SUBDIVISION RECLAMATION SEEDING AND SITE LAYOUT PLAN																	
APPROVALS		ENGINEER		DATE		APPROVALS		ENGINEER		DATE		APPROVALS		ENGINEER		DATE	
DRC CHAIRMAN		N/A		7-28-93		WATER		N/A		RWK		7-28-93		WASTE WATER		N/A	
TRANSPORTATION		N/A		8-15-93				N/A		RWK		7-28-93					
HYDROLOGY		N/A		8-23-93				N/A		RWK		7-28-93					
PARKS		N/A		7/94				N/A		RWK		7-28-93					
DRAWING NO.		4569.91				MAP NO.		D-12				SHEET OF		14 OF 18			




ENLARGEMENT 'B'

ENLARGEMENT 'C'


ENLARGEMENT 'D'

ENLARGEMENT 'E'


BHI JOB NO. 92236 46

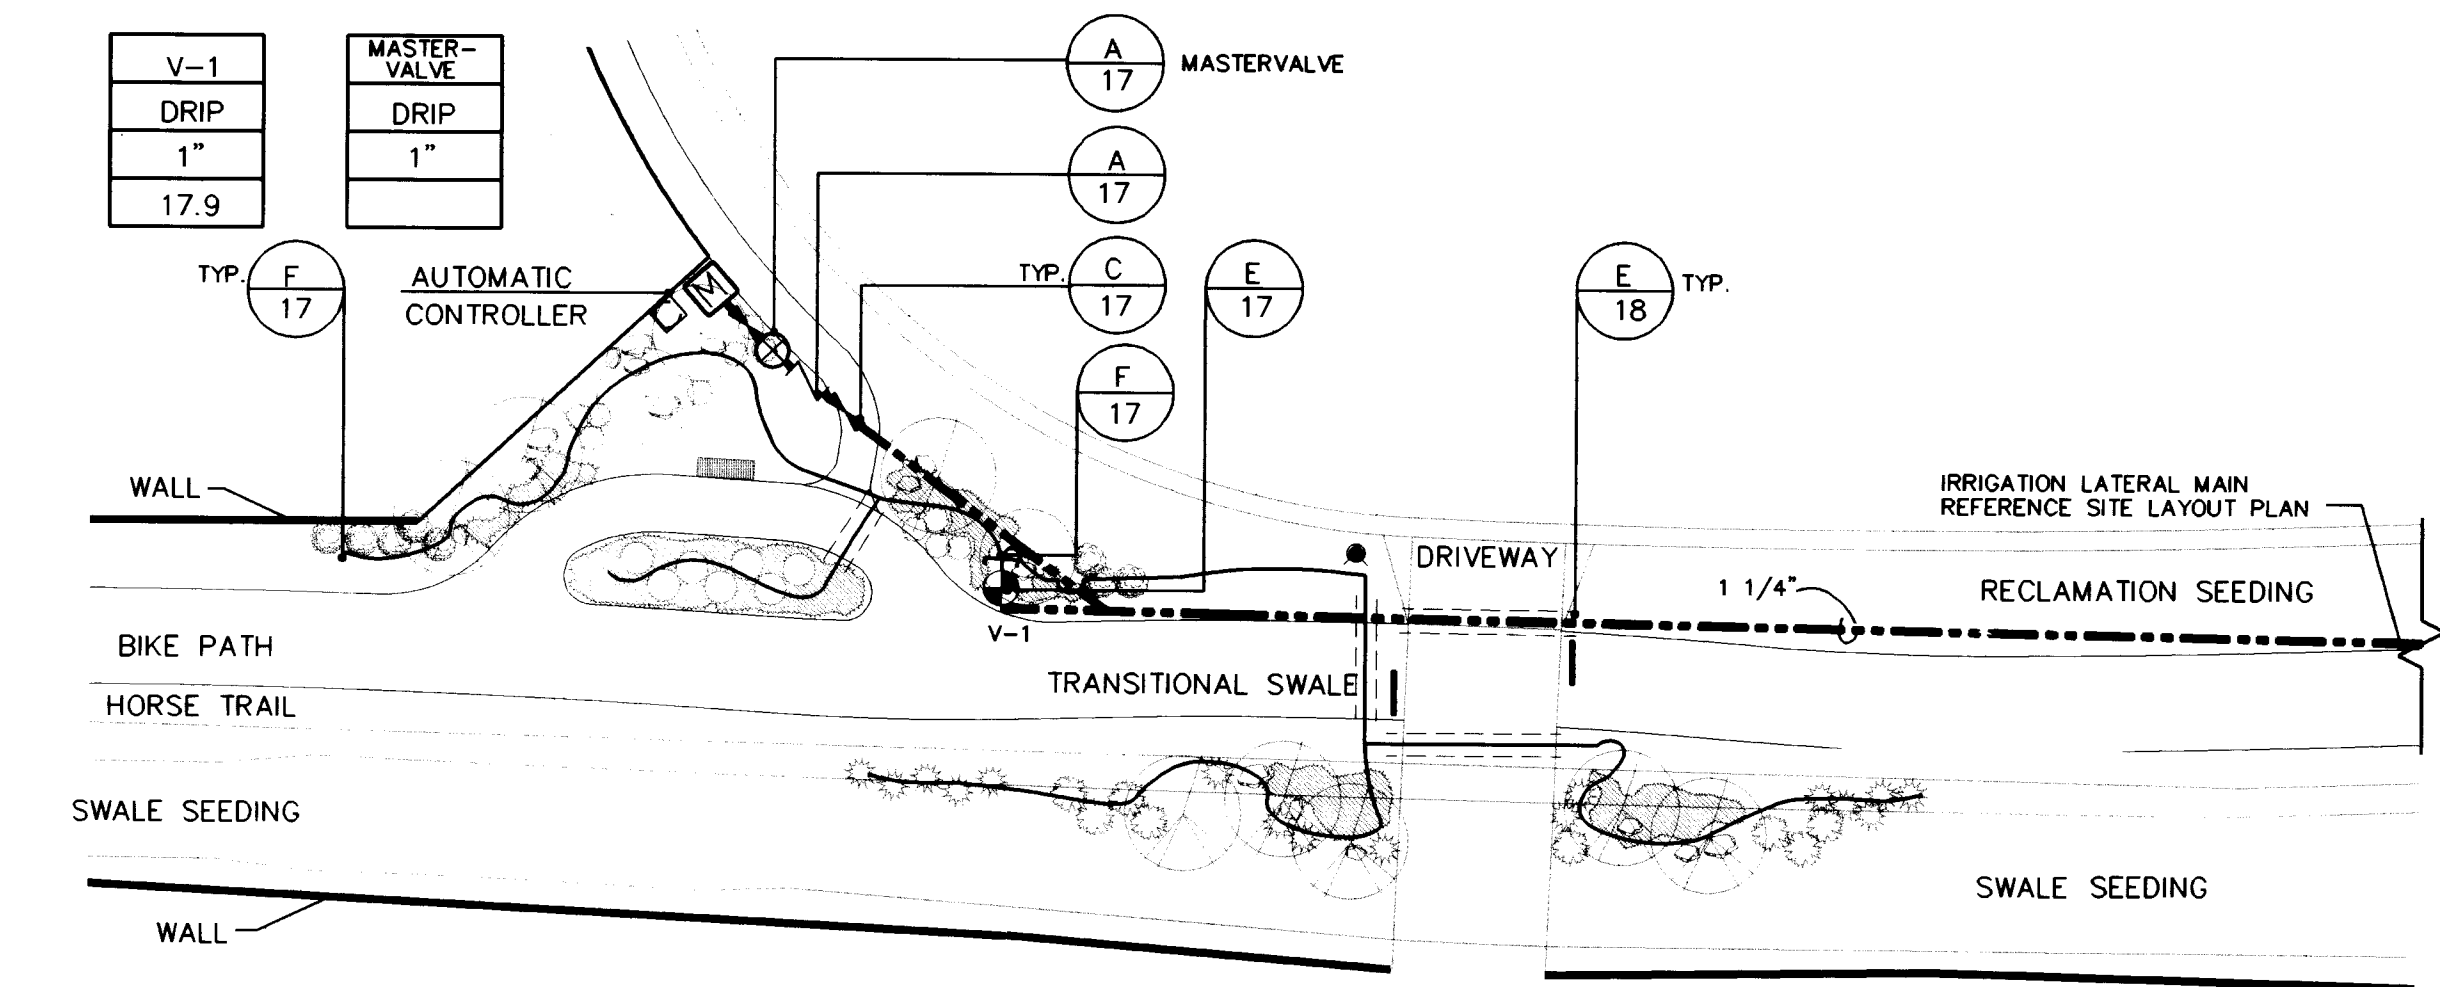

A ENLARGEMENT 'A'
SCALE: 1"=20'

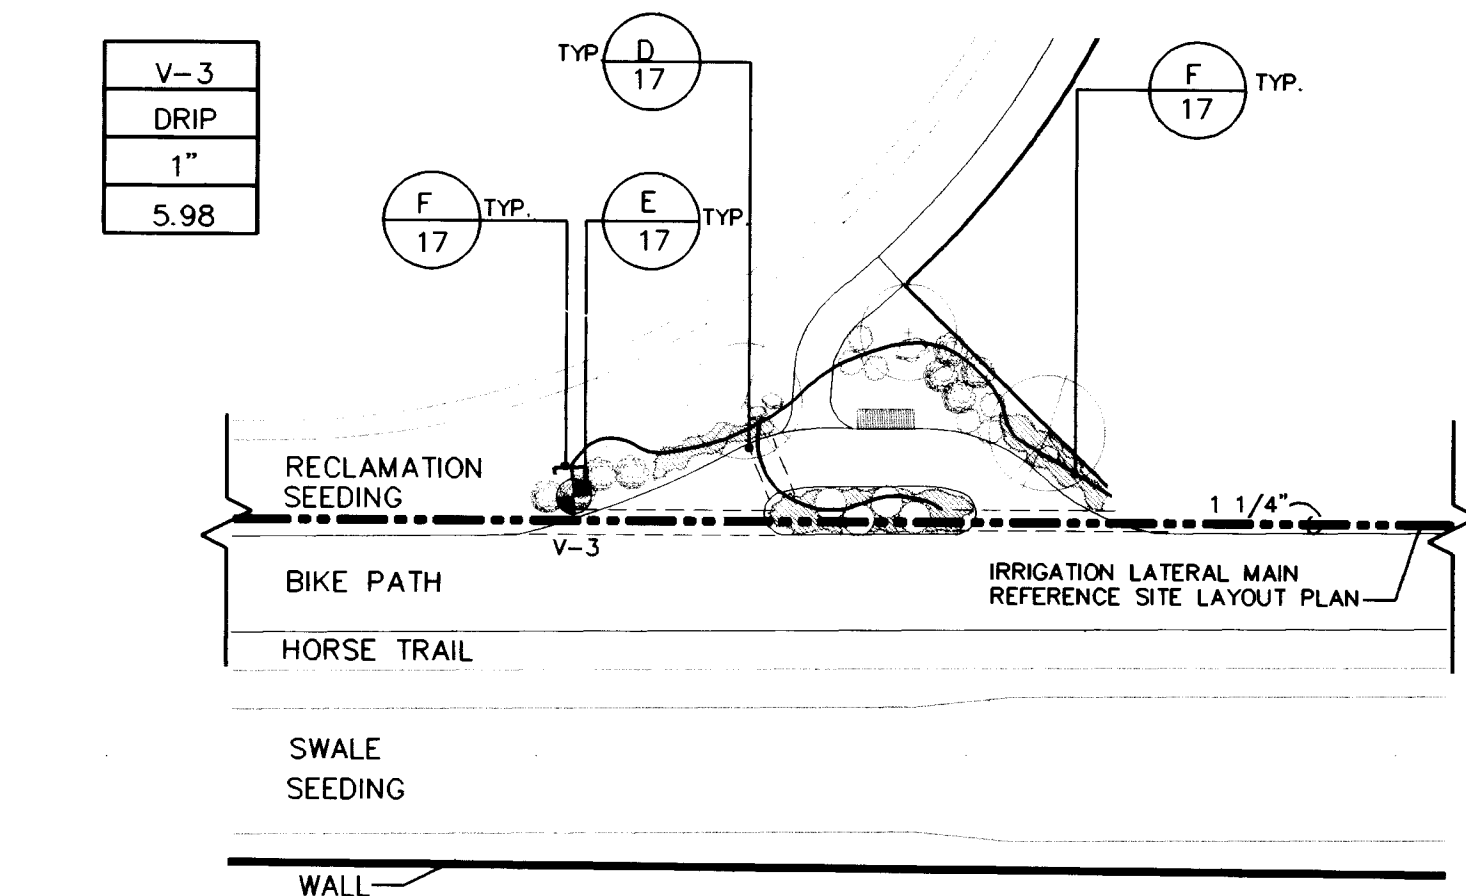


B ENLARGEMENT 'B'
SCALE: 1"=20'

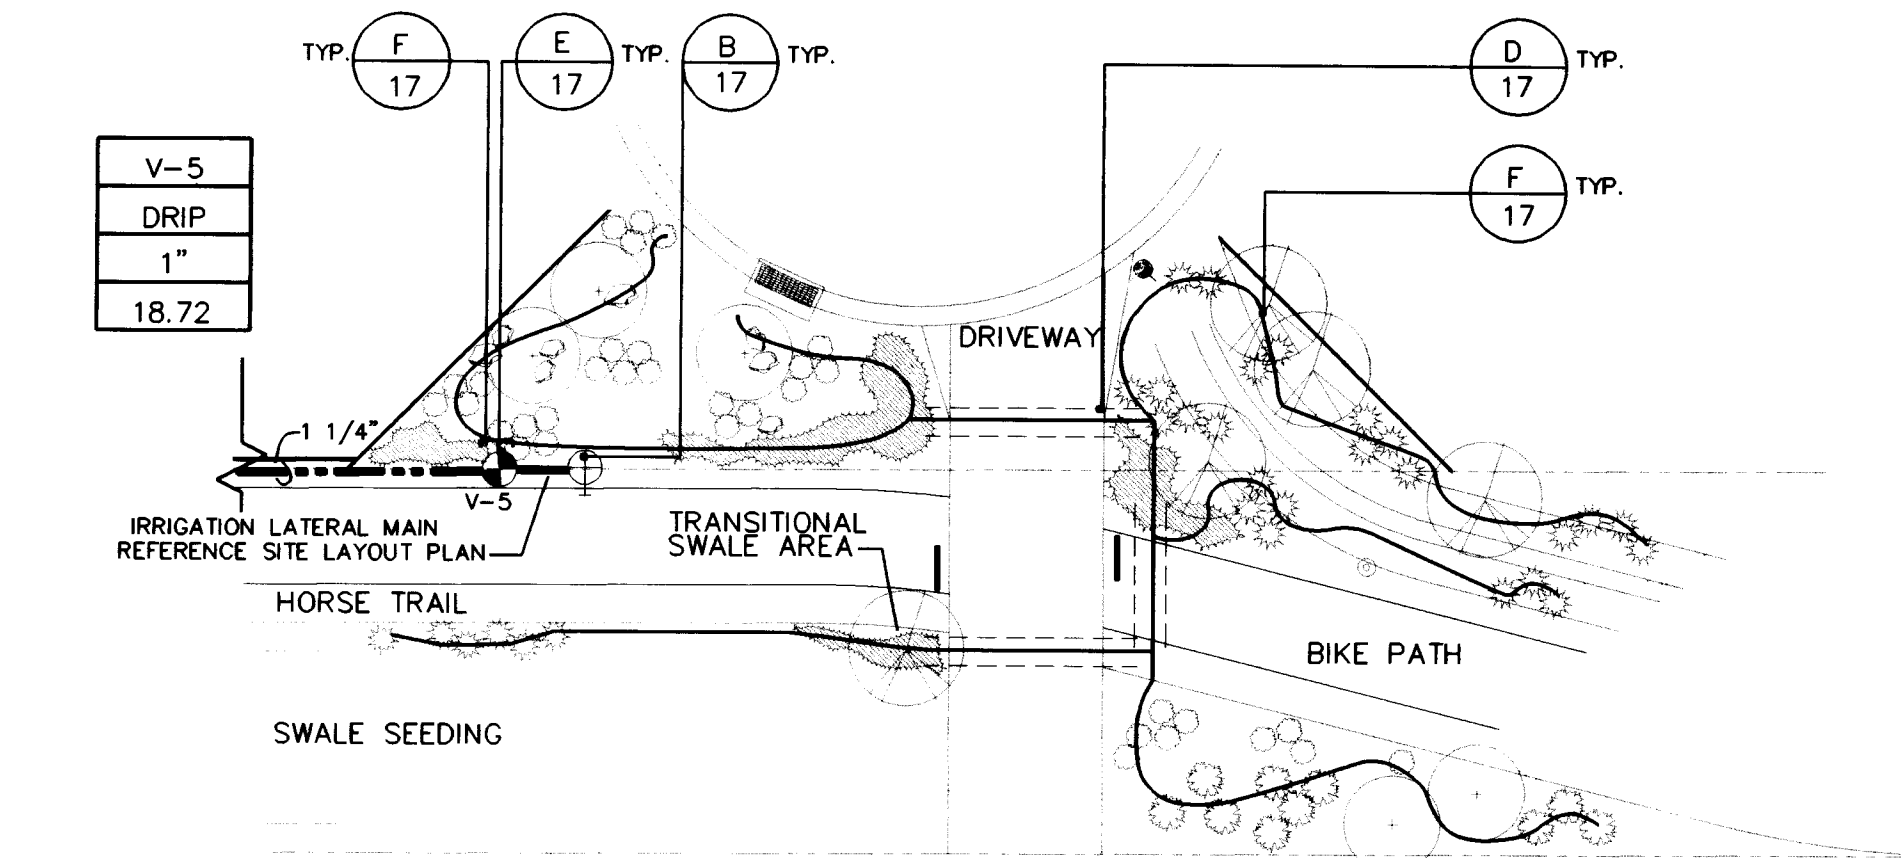


C ENLARGEMENT 'C'
SCALE: 1"=20'

E ENLARGEMENT 'E'
SCALE: 1"=20'

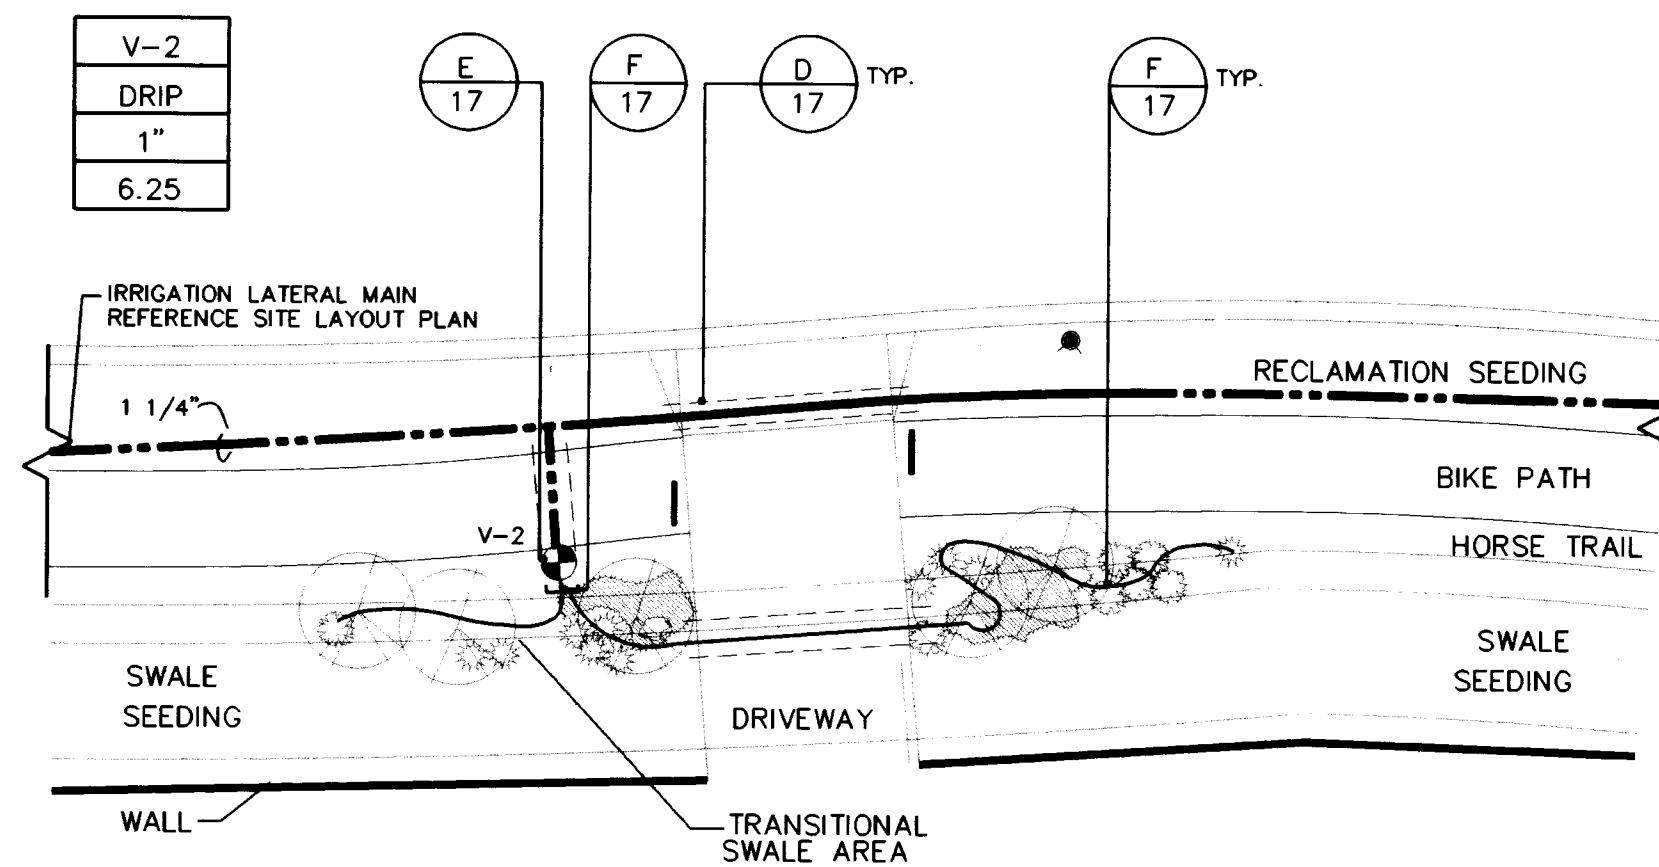

D ENLARGEMENT 'D'
SCALE: 1"=20'

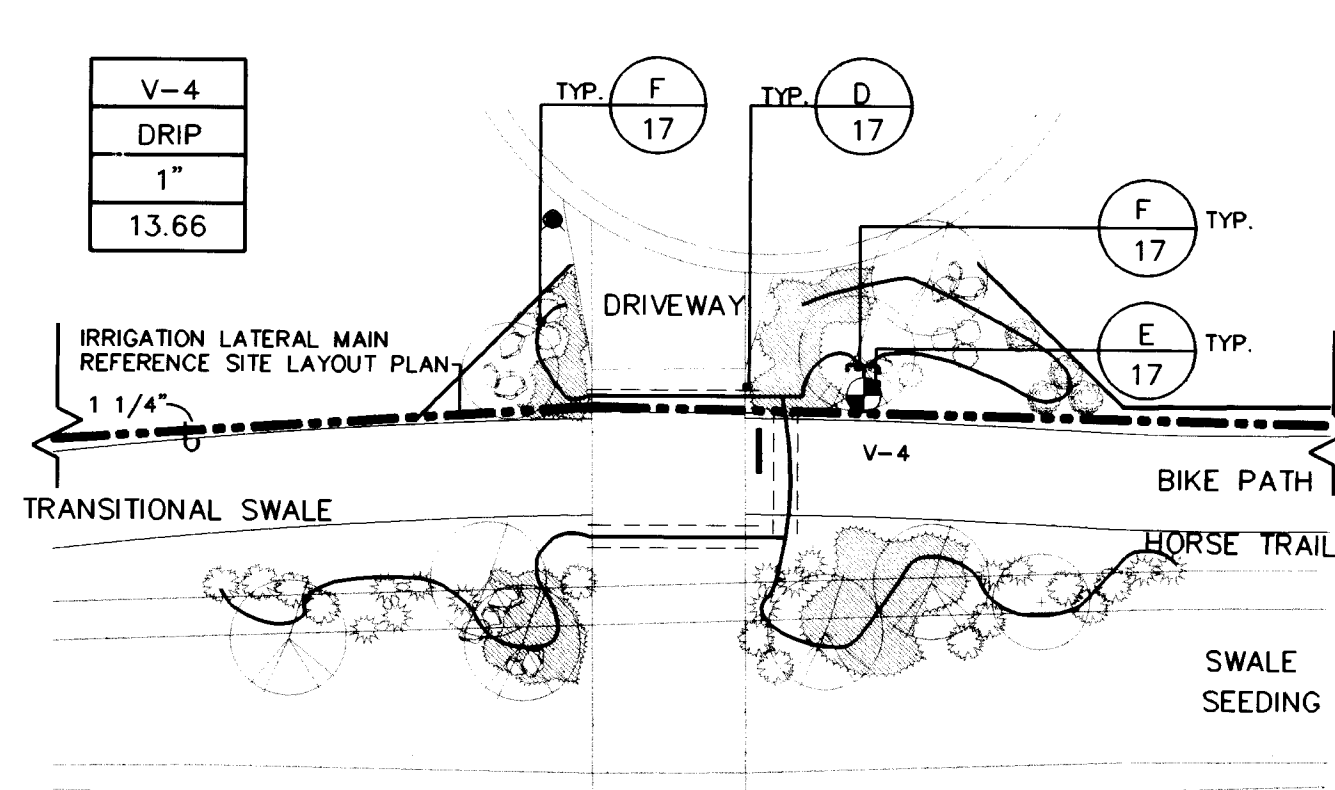

E ENLARGEMENT 'E'
SCALE: 1"=20'

VALVING LEGEND

VALVE NO.	VALVE SIZE	GPM	DESIGN PSI	PSI @	ZONE TYPE
V-1	1 1/2"	17.9	15	80	MAINLINE
V-2	1"	6.25	15	85.14	DRIP
V-3	1 1/2"	5.98	15	70.53	DRIP
V-4	1"	13.66	15	83.44	DRIP
V-5	1"	18.72	15	78.8	DRIP
V-6					
V-7					
V-8	1 1/2"	18.72 MAXIMUM DEMAND		80	MASTERVAlVE

ALL CALCULATIONS BASED ON 1 1/4" LATERAL MAIN.

IRRIGATION LEGEND

SYM.	DESCRIPTION	MODEL	UNIT	QTY	PSI	NOTES
☐	CONTROLLER	SOLARTROL LEIT 8000 EA.	1	-	-	SEE PLAN FOR LOCATION
☐	INSTALL AS PER MANUFACTURER'S RECOMMENDATIONS.					
⊕	METER	3/4"	EA.	1	-	INSTALLATION COMPLETE INC. UEC.
⊕	MASTERVAlVE	HARDIE CENTURY 100 SERIES	EA.	1	-	SIZE AND PSI AS PER PLAN
⊕	CONTROL VALVE	HARDIE CENTURY 100 SERIES	EA.	5	-	SIZE AND PSI AS PER PLAN
⌌	P.V.B. BACKFLOW PREVENTER	FEBCO 765	EA.	1	-	1"
⌌	ISOLATION VALVE	CHAMPION 4100	EA.	2	-	1"
⊕	MANUAL DRAIN	CHAMPION 100-100	EA.	1	-	1"
⊕	"Y" FILTER	RAINBIRD RBY-100	EA.	5	-	1"
⊕	BALL VALVE	SPEARS TRUE UNION	EA.	5	-	SEE PLAN FOR SIZE
⊕	SCH 80 PVC	RAINBIRD PC-05	EA.	748	-	SEE NOTE THIS SHEET 5 GPH
---	LATERAL MAIN	SCH 40 PVC	L.F.	80	-	1 1/4" CONTINUOUS
---	LATERAL	FLEXIBLE POLY PIPE	L.F.	20	-	3/4" CONTINUOUS
---	SLEEVE	SCH 40 PVC	L.F.		-	SEE SPECIFICATIONS

IRRIGATION NOTES

- 1) DRIP EMITTERS AT TREES SHALL BE EQUALLY SPACED AROUND THE TREE, WITHIN THE WATER RETENTION BASIN, (3) THREE EMITTERS PER TREE.
- 2) DRIP EMITTERS AT SHRUBS SHALL BE EQUALLY SPACED AROUND THE SHRUB, WITHIN THE WATER RETENTION BASIN, (2) EMITTERS PER SHRUB.
- 3) DRIP EMITTERS AT PERENNIALS SHALL BE CENTRALLY LOCATED, (1) EMITTER PER (3) PERENNIALS.
- 4) CONTRACTOR SHALL INSTALL LEMA 152 ACTUATOR, ONE (1) PER VALVE. INSTALL SOLARTROL AMT 2035 MOUNTING COLUMN, AND PROVIDE SOLARTROL TKIT-3000. COLUMN SHALL BE INSTALLED IN CONCRETE FOOTING.
- 5) ALL IRRIGATION WIRES SHALL UTILIZE SOLARTROL CABLE, ONE (1) RUN PER AUTOMATIC VALVE. ALL SPLICING SHALL UTILIZE SOLARTROL SPLICE 2201.

LEGEND

VALVE AND STATION NO.	V-4
HEAD TYPE	DRIP
VALVE SIZE	1"
TOTAL GPM	5.8

SCANNED BY
BY LASON

24-4569.911694


CITY OF ALBUQUERQUE PUBLIC WORKS DEPARTMENT ENGINEERING GROUP					
TITLE: RANCHO SERENO SUBDIVISION IRRIGATION ENLARGEMENTS					
APPROVALS	ENGINEER	DATE	APPROVALS	ENGINEER	DATE
DRC CHAIRMAN	<i>[Signature]</i>	7-27-93	WATER	<i>[Signature]</i>	7-28-93
TRANSPORTATION	<i>[Signature]</i>	7-28-93	WASTE WATER	<i>[Signature]</i>	7-28-93
HYDROLOGY	<i>[Signature]</i>	8-23-93			
PARKS	<i>[Signature]</i>	8/9/93			
DRAWING NO.	4569.91	MAP NO. D-12	SHEET 16	OF 18	

- GENERAL NOTES
- PVB'S UNAPPROVED FOR CONTAINMENT PROTECTION, EXCEPT FOR LAWN IRRIGATION SYSTEMS.
 - DO NOT INSTALL PVB'S IN FLOOD PRONE AREAS.
 - DO NOT INSTALL PVB'S 5' ABOVE GROUND LEVEL.
 - METALLIC RISER PIPING REOD.
 - JOINTS TO BE ADEQUATELY RESTRAINED.
 - HORIZONTAL INSTALLATION REOD, AS SHOWN.

CONSTRUCTION NOTES


- CURB STOP AND BOX.
- METER.
- SERVICE LINE, NO OUTLETS ALLOWED.
- FINISH GRADE.
- BROOK'S PRODUCTS INC, 1730 PB-18 BODY (ABS) VALVE BOX WITH 1730 BOLT DOWN COVER (ABS) AND TWO 8" EXTENSIONS.
- ELECTRIC OR MANUAL VALVE- SEE IRRIGATION PLAN.
- 24" WIRE EXPANSION COIL.
- 3M SKOTCHLOK.

- SCHEDULE 80 PVC CLOSE NIPPLE.
- ELECTRIC OR MANUAL VALVE (SEE PLAN).
- SPEARS SCH 80 PVC UNION.
- SCH 80 PVC NIPPLE.
- 1 CUBIC FOOT 1" DIAMETER WASHED ROCK.
- 8" X 8" X 16" SOLID CMU BLOCK.
- GALVANIZED ELL.
- GALVANIZED NIPPLE.
- GALVANIZED UNION, 4" ABOVE GRADE, MIN.
- GALVANIZED TEE.
- BALL DRAIN, CHAMPION DV050 1/2" PRESSURE VACUUM BREAKER BACKFLOW PREVENTER (SEE PLAN).
- PVC MIP ADAPTER.
- MAINLINE/LATERAL MAINLINE.
- ISOLATION VALVE (SEE PLAN).
- SPRINKLER.
- 12" MIN. ABOVE HIGHEST POINT OF ALL DOWNSTREAM PIPING AND OUTLETS.
- 4000 PSI CONCRETE EDGER.
- FINISH GRADE.
- 6 mm BLACK POLYETHYLENE TAPE TO ALL INLET AND OUTLET LINES.

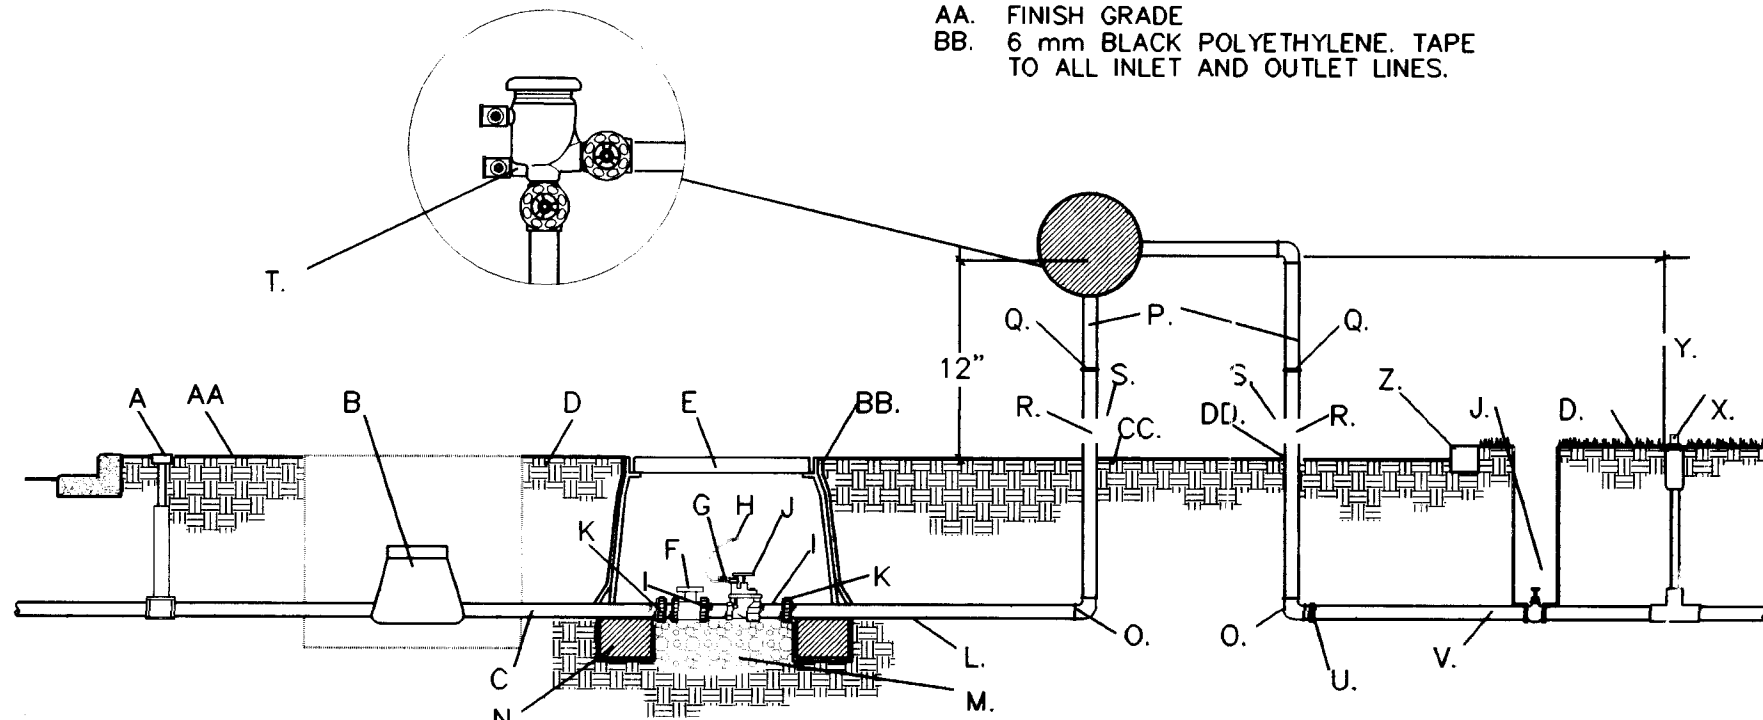


A IRRIGATION MASTER VALVE WITH PRESSURE VACUUM BREAKER

NOT TO SCALE

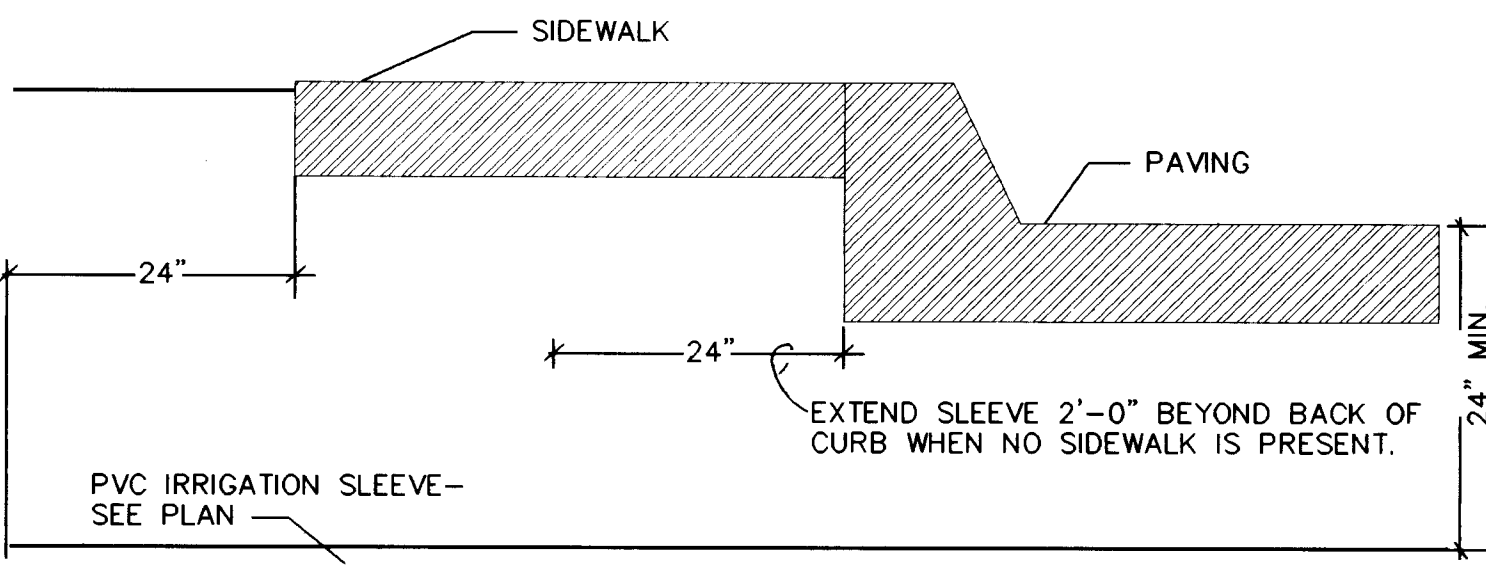


D IRRIGATION SLEEVES UNDER PAVING AND SIDEWALKS

NOT TO SCALE

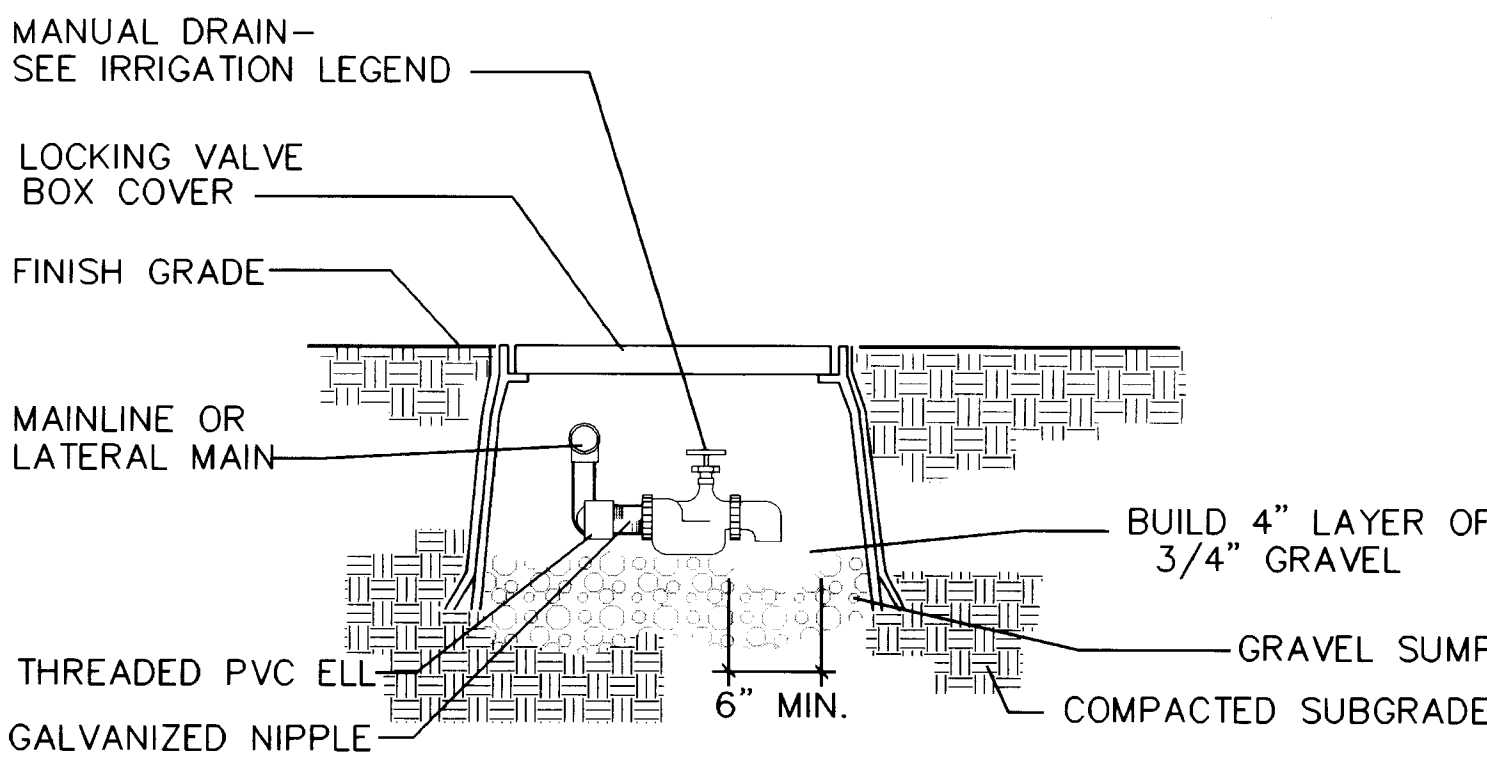


B MANUAL DRAIN

NOT TO SCALE

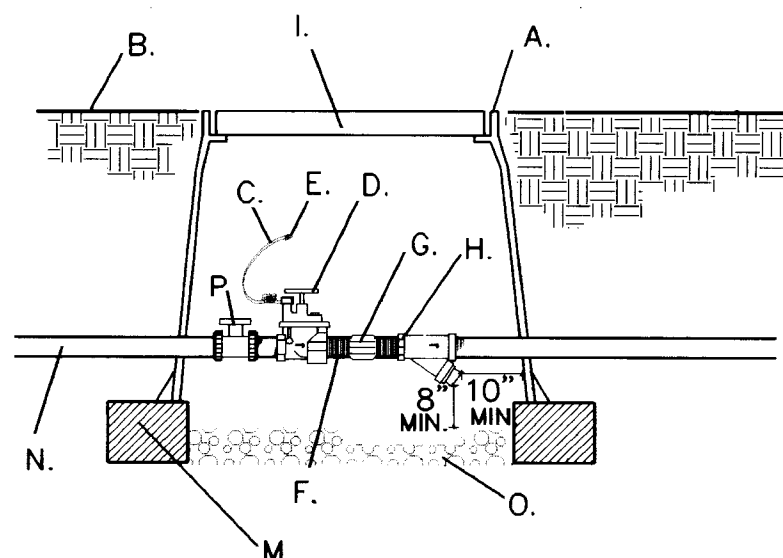


E DRIP VALVE/FILTER ASSEMBLY

NOT TO SCALE

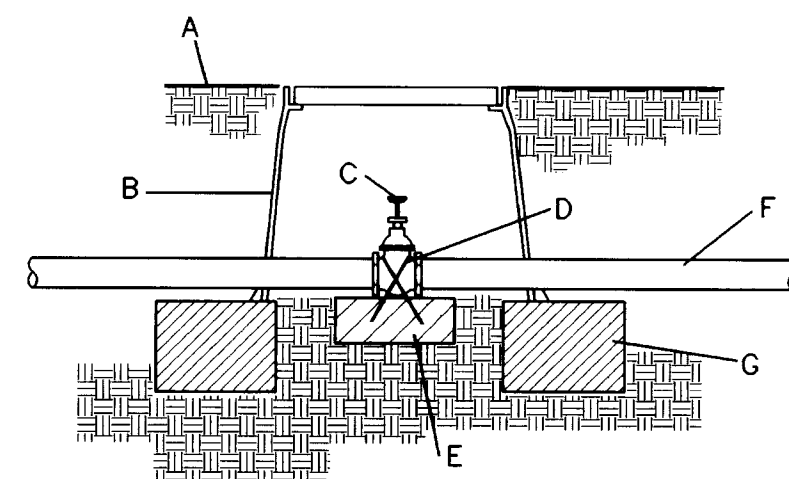

C ISOLATION VALVE

NOT TO SCALE

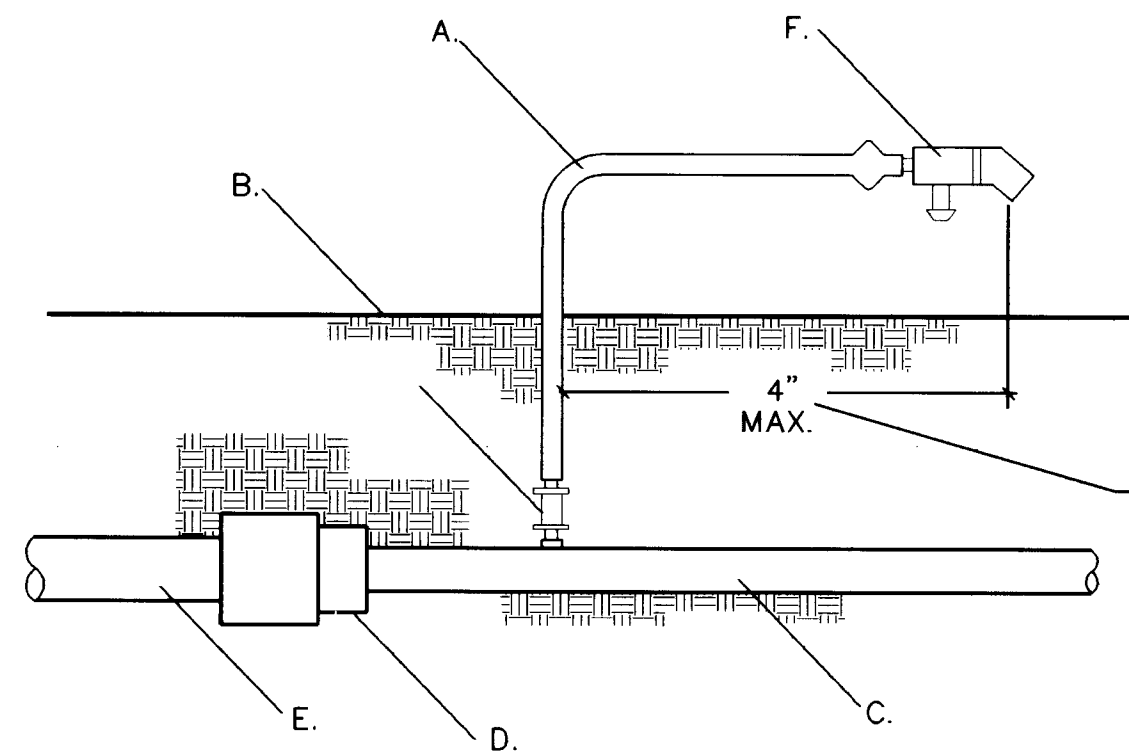

F PVC/POLY PIPE CONNECTION

NOT TO SCALE


GENERAL NOTES:

- INSTALL AN 8" X 8" X 16" SOLID CMU BLOCK AT EACH CORNER OF THE VALVE BOX

CONSTRUCTION NOTES:

- FINISH GRADE.
- BROOK'S PRODUCTS INC, 1730 PB-18 BODY (ABS) VALVE BOX WITH 1730 BOLT DOWN COVER (ABS) AND TWO 8" EXTENSIONS.
- MANUAL VALVE- SEE PLAN.
- NO. 4 REBAR.
- THRUST BLOCK-4000 PSI CONCRETE PLACED AGAINST UNDISTURBED SOIL.
- IRRIGATION MAINLINE.
- 8" X 8" X 16" SOLID CMU BLOCK.


AS BUILT INFORMATION			BENCH MARK			SURVEY INFORMATION			FIELD NOTES			PROFESSIONAL SEAL			REVISIONS			DESIGN		
CONTRACTOR	DATE	WORK STATED BY	DATE	INSPECTOR'S APPROVAL	DATE	NO.	BY	DATE	NO.	BY	DATE	NO.	BY	DATE	NO.	DATE	REMARKS	NO.	DATE	REVISIONS
ALS	9/3	ALS	9/3	ALS	9/3															
DRAWING CORRECTED BY			MICRO-FILM INFORMATION			DESIGNED BY: KCP			DRAWN BY: PA			CHECKED BY: GR			DATE: 6/93			DATE: 6/93		
RECORDED BY			NO.			DATE: 6/93			DATE: 6/93			DATE: 6/93			DATE: 6/93			DATE: 6/93		

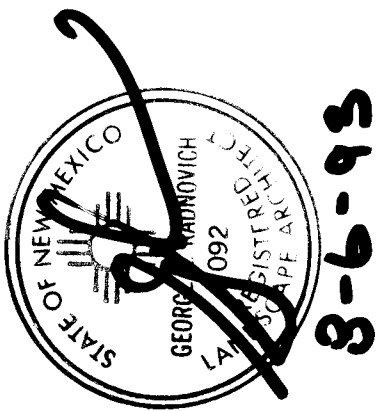

24-4569.911/284

CITY OF ALBUQUERQUE PUBLIC WORKS DEPARTMENT ENGINEERING GROUP					
TITLE: RANCHO SERENO SUBDIVISION IRRIGATION DETAILS					
APPROVALS	ENGINEER	DATE	APPROVALS	ENGINEER	DATE
DRG CHAIRMAN	A. A. B. B.	9-07-93	WATER	N/A RUK	7-28-93
TRANSPORTATION	N/A	8-18-93	WASTE WATER	N/A RUK	7-28-93
HYDROLOGY	N/A	8-23-93			
PARKS	N/A	8/24/93			
DRAWING NO.	4569.91		MAP NO.	D-12	
			SHEET	17	OF 18


SCANNED BY LASON

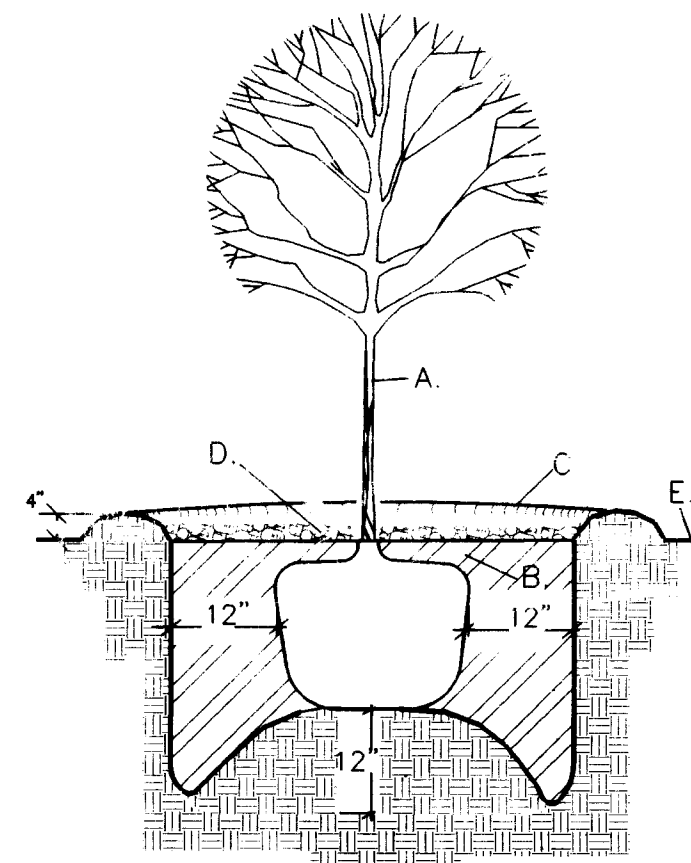

- GENERAL NOTES:
1. STABILIZE SOIL BELOW ROOT BALL PRIOR TO PLANTING TO PREVENT TREE FROM SETTLING.
 2. TOP OF ROOTBALL INDICATES LEVEL AT WHICH TREE WAS GROWN AND DUG; THIS REPRESENTS THE LEVEL AT WHICH THE TREE SHOULD BE INSTALLED; THAT LEVEL MAY ONLY BE EXCEEDED BY A ONE INCH LAYER OF SOIL.
 3. PRIOR TO BACKFILLING TREE, ALL WIRE, ROPE AND SYNTHETIC MATERIALS SHALL BE REMOVED FROM THE TREE AND THE PLANTING PIT.
 4. PRIOR TO BACKFILLING, ALL BURLAP SHALL BE CUT AWAY FROM THE ROOTBALL.
- CONSTRUCTION NOTES:
- A. TREE.
 - B. PLANTING SOIL MIXTURE. (REF SPECIFICATIONS)
 - C. WATER RETENTION BASIN.
 - D. 4" DEPTH OF BARK MULCH.
 - E. FINISH GRADE.

A ISOLATED TREE PLANTING


NOT TO SCALE

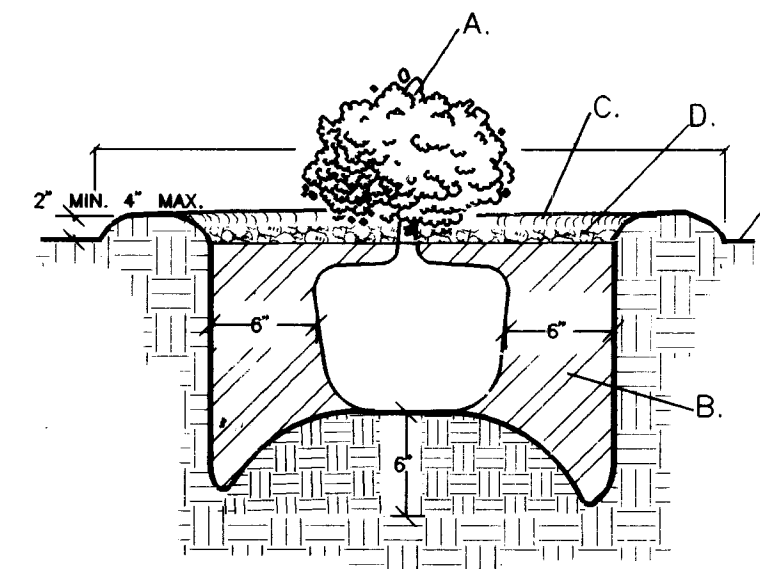

- GENERAL NOTES:
1. THE OUTSIDE DIAMETER OF THE WATER RETENTION BASIN SHALL BE TWICE THE DIAMETER OF THE SHRUB PLANTING PIT.
- CONSTRUCTION NOTES:
- A. SHRUB.
 - B. PLANTING SOIL MIXTURE (UNAMENDED LOOSENED NATIVE SOIL)
 - C. WATER RETENTION BASIN.
 - D. 2" DEPTH OF BARK MULCH.
 - E. FINISH GRADE.

B ISOLATED SHRUB PLANTING


NOT TO SCALE

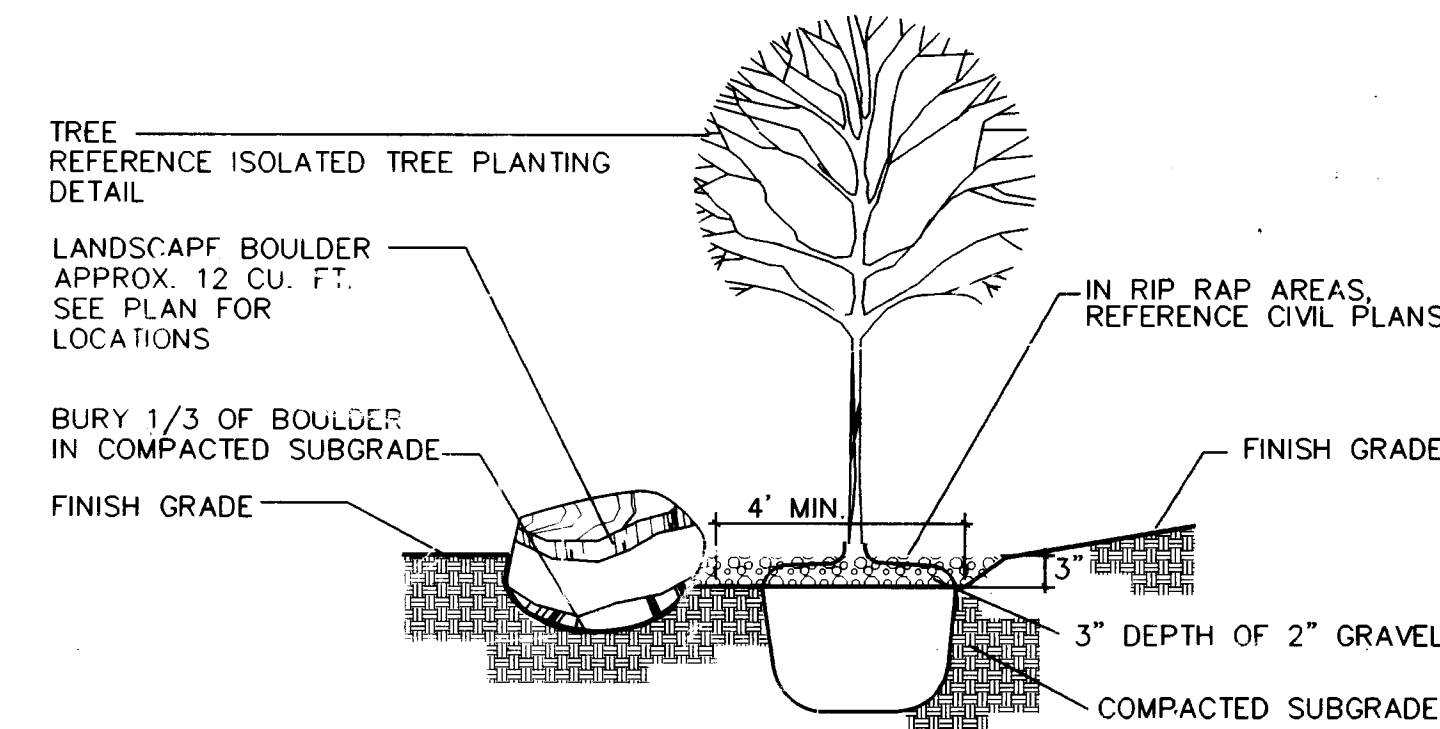

NOTE:
BOULDER SHALL BE OMITTED IN SWALE TRANSITION AREAS.
BOULDER SHALL BE LOCATED ON THE DOWNHILL SIDE OF THE TREE.


C PLANTING AND BOULDER DETAIL

NOT TO SCALE

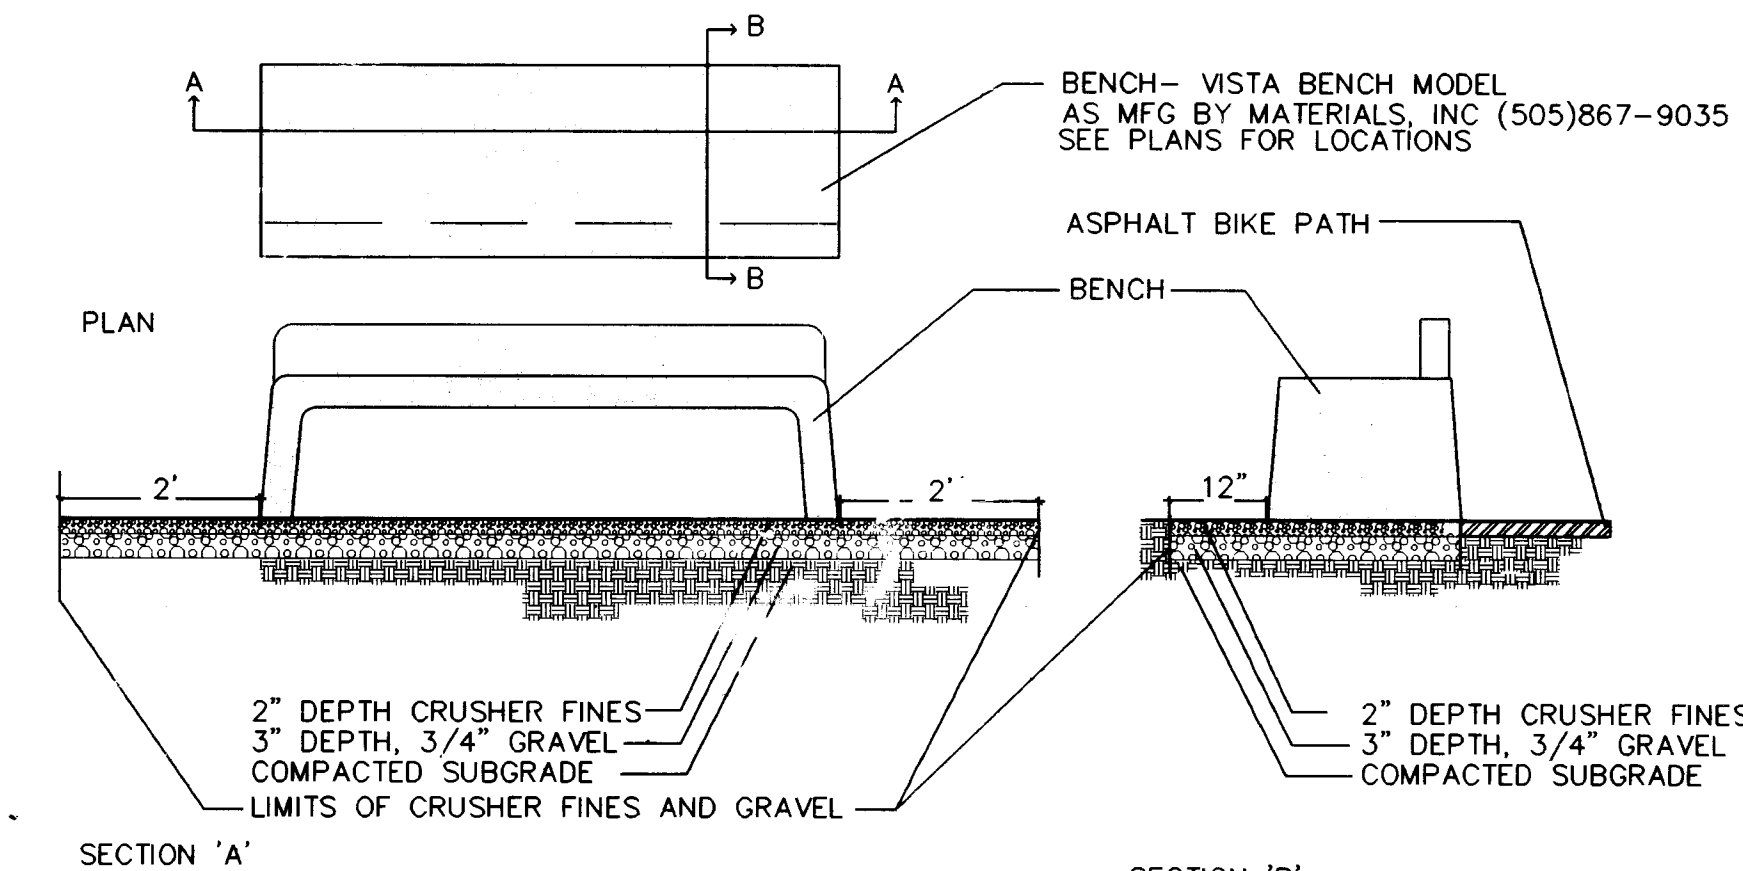

D BENCH INSTALLATION


NOT TO SCALE

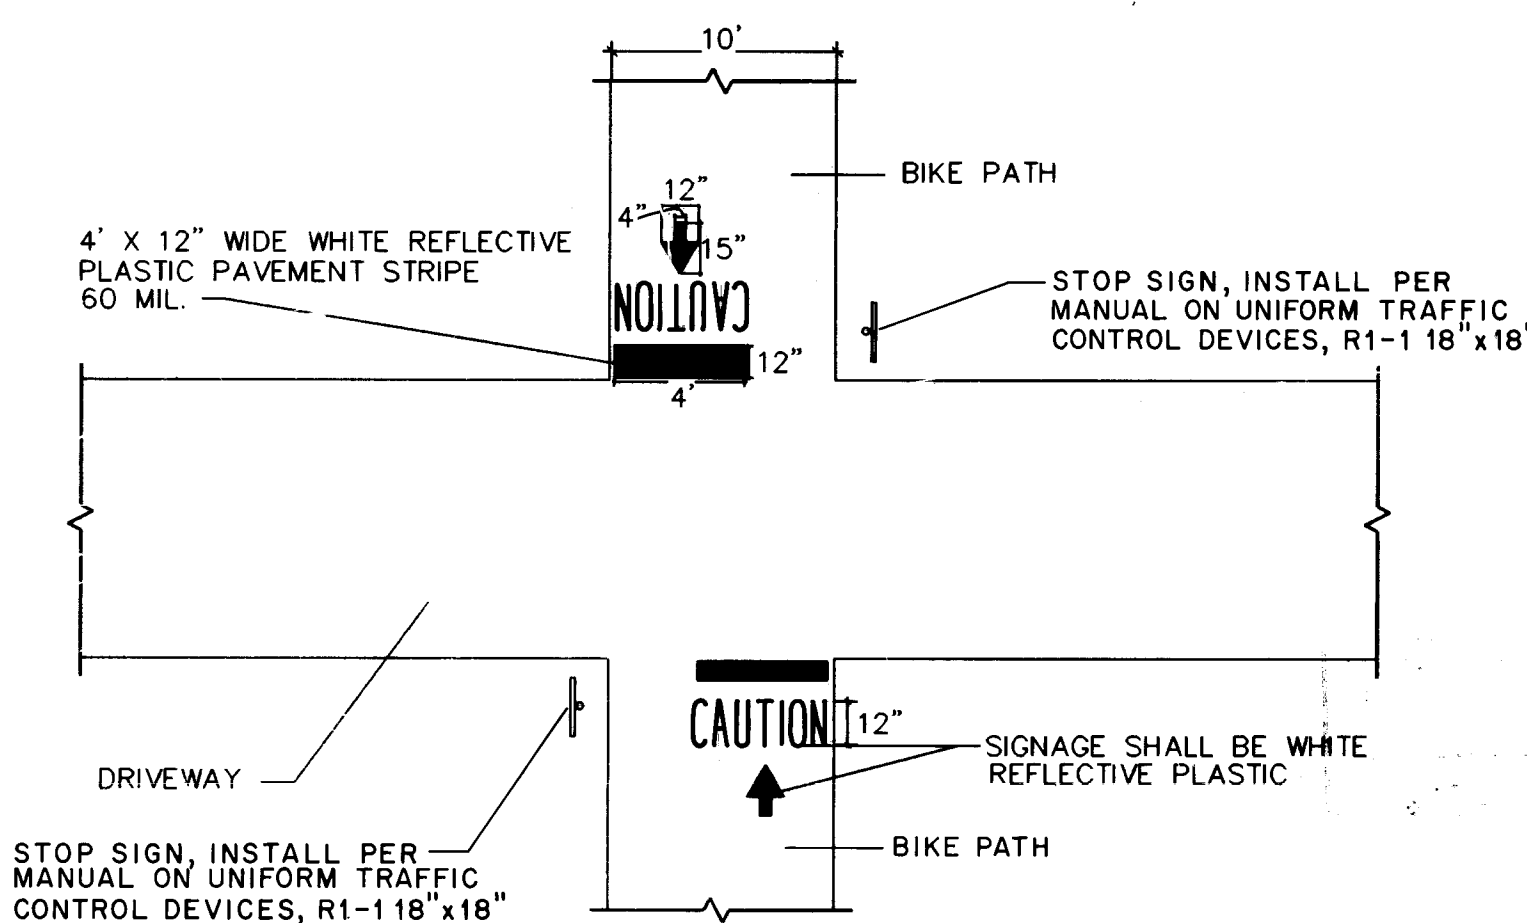

E BIKE PATH CROSSINGS

NOT TO SCALE

AS BUILT INFORMATION		BENCH MARK		SURVEY INFORMATION		FIELD NOTES		PROFESSIONAL SEAL	
CONTRACTOR	DATE	NO.	DATE	NO.	DATE	NO.	DATE	NO.	DATE
CLM	6/93								
WORK STAKED BY	DATE								
INSPECTOR'S APPROVAL	DATE								
FIELD VERIFICATION BY	DATE								
DRAWING CORRECTED BY	DATE								
MICRO-FILM INFORMATION	DATE								
RECORDED BY	NO.								

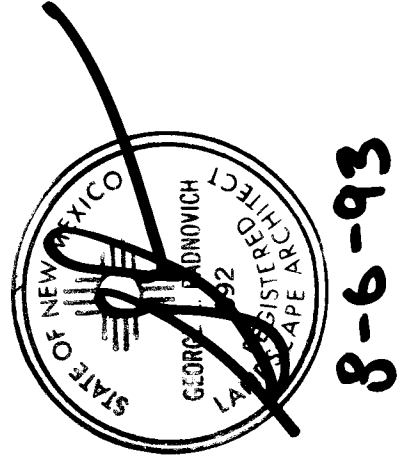

1 2 3 4 5 6 7 8 9 10 11 12 13 14 15
26-4569.91110894


CITY OF ALBUQUERQUE PUBLIC WORKS DEPARTMENT ENGINEERING GROUP					
TITLE: RANCHO SERENO SUBDIVISION PLANTING AND CONSTRUCTION DETAILS					
APPROVALS	ENGINEER	DATE	APPROVALS	ENGINEER	DATE
DRG CHAIRMAN	<i>B. B. B. B.</i>	7-27-93	WATER	<i>U/A RUC</i>	7-28-93
TRANSPORTATION	<i>W. B. B. B.</i>	7-18-93	WASTE WATER	<i>U/A RUC</i>	7-28-93
HYDROLOGY	<i>B. B. B. B.</i>	8-23-93			
PARKS	<i>B. B. B. B.</i>	8-23-93			
DRAWING NO.	4569.91	MAP NO. D-12	SHEET 18	OF 18	

SCANNED BY
BY LASON



BUTTERFIELD WELL SITE PARK

Shade Structure Installation

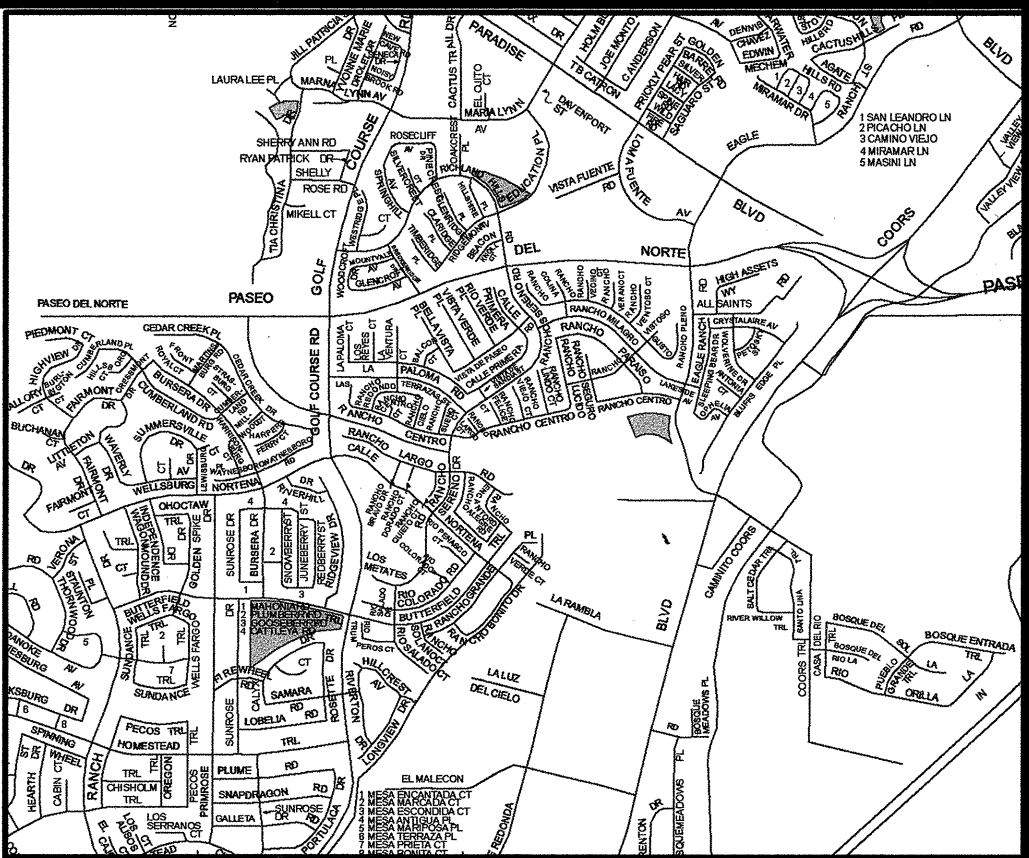

VICINITY MAP: Zone Map D-12

CITY OF ALBUQUERQUE
DEPARTMENT OF MUNICIPAL DEVELOPMENT – Managing Department
Park Design & Construction Division

SEPTEMBER 22, 2008
Parks & Recreation Department-Owner

Property Information

Property Address: 4100 Rancho Alegre Rd. NW
Zone : R-IT
Shade Structure Installation

Legal Description

A certain tract of land situate within
Sections 13 and 24, township 11 North,
Range 2 East, New Mexico Principal
Meridian, City of Abuquerque,
Bernalillo County, NM.

Index of Drawings

- 1. Cover Sheet
- 2. General Notes
- 3. Demolition & Construction Plan
- 4. Project Information Form

**UTILITY COMPANY
CONTACTS**

**CITY OF ALBUQUERQUE
UTILITY DEVELOPMENT**
P.O. Box 1293
Albuquerque, New Mexico 87103
(505) 768-2719

PNM-ELECTRIC
4201 Edith Boulevard NE
Albuquerque, New Mexico 87107
(505)-241-0525

PNM-GAS
4625 Edith Boulevard NE
Albuquerque, New Mexico 87107
(505)-241-7745

**CALL BEFORE
YOU DIG!**

**STATEWIDE
1-800-321-ALERT
ALBUQUERQUE
260-1990**

QWEST
201 Third Street NW Suite 700
Albuquerque, New Mexico 87103
(505) 245-8706

QWEST
201 Third Street NW Suite 700
Albuquerque, New Mexico 87103
(505) 245-8706

REV.	SHEETS	CITY ENGINEER	DATE	USER DEPARTMENT	DATE	USER DEPARTMENT	DATE
ENGINEERS STAMP & SIGNATURE		APPROVED	ENGINEER	DATE			
DATE:		PROJECT # 456991				SHEET 1 OF 5	

RECORD DRAWINGS
THIS RECORD DRAWING HAS BEEN PREPARED, BASED
UPON INFORMATION FURNISHED BY THE CONTRACTOR.
THE DESIGN PROFESSIONAL HAS NOT INDEPENDENTLY
REVIEWED THE ACCURACY OF THE INFORMATION
PROVIDED. THESE RECORD DRAWINGS ACCURATLY
DEPICT THE FIELD CHANGES WHICH WERE REPORTED
BY THE CONTRACTOR.

FINAL FOR CONSTRUCTION

BUTTERFIELD WELL SITE PARK
SHADE STRUCTURE INSTALLATION

RECORD DRAWINGS X
SEPTEMBER 22, 2008

- 1 FIVE (5) WORKING DAYS PRIOR TO BEGINNING CONSTRUCTION, THE CONTRACTOR WILL SUBMIT A DETAILED CONSTRUCTION SCHEDULE TO THE CITY CONSTRUCTION COORDINATION DIVISION. TWO (2) DAYS PRIOR TO CONSTRUCTION, THE CONTRACTOR WILL OBTAIN A BARRICADING PERMIT FROM THE CONSTRUCTION COORDINATION DIVISION. CONTRACTOR SHALL NOTIFY BARRICADE ENGINEER (924-3400) PRIOR TO OCCUPYING AN INTERSECTION. REFER TO SECTION 19 OF SPECIFICATIONS.
- 2 THE CONTRACTOR WILL NOTIFY THE FIELD ENGINEER NOT LESS THAN SEVEN (7) DAYS PRIOR TO STARTING WORK, IN ORDER THAT THE CITY SURVEY SECTION MAY TAKE NECESSARY MEASURES TO INSURE THE PRESERVATION OF SURVEY MONUMENTS. THE CONTRACTOR WILL NOTIFY THE ENGINEER IF A MONUMENT IS DISTURBED. REPLACEMENT WILL BE DONE ONLY BY THE CITY OF ALBUQUERQUE SURVEY SECTION AT THE CONTRACTOR'S EXPENSE. WHEN A CHANGE IS MADE IN THE FINISHED ELEV. OF THE PAVEMENT OF ANY ROADWAY IN WHICH A PERMANENT SURVEY MONUMENT IS LOCATED, CONTRACTOR WILL, AT HIS OWN EXPENSE, HAVE THE CITY SURVEY SECTION ADJUST THE MONUMENT COVER TO THE NEW GRADE UNLESS OTHERWISE SPECIFIED. REFER TO SECTION 4 OF SPECIFICATIONS.
- 3 THE SPECIFICATIONS USED FOR THIS PROJECT ARE THE CITY OF ALBUQUERQUE STANDARD SPECIFICATIONS FOR PUBLIC WORKS CONSTRUCTION, 1986 EDITION, UPDATE NO. 7.
- 4 ALL NEW MANHOLES SHALL BE TYPE "E" (COA DWG. 2102) UNLESS OTHERWISE NOTED ON THE PLANS.
- 5 THE CONTRACTOR WILL BE RESPONSIBLE FOR DISPOSING OF ALL DEBRIS, INCLUDING, BUT NOT LIMITED TO HAZARDOUS WASTE AT DISPOSAL SITES APPROVED BY GOVERNMENTAL AGENCIES REGULATING THE DISPOSAL OF SUCH MATERIALS.
- 6 ALL WATER VALVE BOXES AND MANHOLES IN THE STREET CONSTRUCTION ARE TO BE ADJUSTED TO FINISH GRADE AND WILL BE MEASURED AND PAID PER EACH.
- 7 SUBGRADE PREPARATION UNDER SIDEWALKS AND DRIVE PADS, AND SUBGRADE AND SUBBASE PREPARATION UNDER CURB AND GUTTER IS CONSIDERED INCIDENTAL TO THE CONSTRUCTION OF SUCH, AND NO DIRECT PAYMENT SHALL BE MADE FOR THOSE ITEMS OF WORK.
- 8 THE CONTRACTOR WILL REPLACE ANY STRIPPING THAT HAS BEEN RUINED OR REMOVED IN THE COURSE OF CONSTRUCTION.
- 9 ALL EXCAVATION WILL BE GOVERNED BY FEDERAL, STATE AND LOCAL LAWS, RULES, AND REGULATIONS CONCERNING CONSTRUCTION SAFETY AND HEALTH.
- 10 ALL SIGNS AND CODING WILL BE IN ACCORDANCE WITH THE "MANUAL OF UNIFORM TRAFFIC CONTROL DEVICES FOR STREETS AND HIGHWAYS" CURRENT EDITION PUBLISHED BY THE U.S. DEPARTMENT OF TRANSPORTATION.
- 11 THE CONTRACTOR IS TO EXERCISE CARE TO AVOID DISTURBING ANY EXISTING UNDERGROUND UTILITIES. IT WILL BE HIS RESPONSIBILITY TO COORDINATE WITH THE UTILITY COMPANIES IN ORDER TO PREVENT ANY SERVICE DISRUPTION. SEE SECTION 18 "UTILITIES", CITY OF ALBUQUERQUE, STANDARD SPECIFICATIONS FOR CONTRACTOR REQUIREMENTS.
- 12 WHEN ABUTTING NEW PAVEMENT TO EXISTING INTERSECTING STREETS, SAW CUT EXISTING PAVEMENT TO A STRAIGHT LINE AND AT RIGHT ANGLES AND REMOVE ANY
- 13 ALL GAS VALVES, GAS MANHOLES, ELECTRICAL MANHOLES, TELEPHONE MANHOLES, AND UTILITY POLES WILL BE ADJUSTED TO GRADE BY EACH UTILITY COMPANY.CONTRACTOR WILL COORDINATE THROUGH CITY UTILITY COORDINATOR.
- 14 WHEN REMOVAL OF EXISTING CURB AND GUTTER OR SIDEWALK IS REQUIRED, REMOVE BACK TO NEAREST SUITABLE JOINT UNLESS OTHERWISE DIRECTED BY THE CITY FIELD ENGINEER.
- 15 THE CONTRACTOR WILL NOTIFY THE NEW MEXICO ONE CALL SYSTEM 260-1990 TWO (2) WORKING DAYS PRIOR TO COMMENCING WORK IN NEW AREAS.
- 16 CONTRACTOR WILL MAKE ALL WATER VALVES AND MANHOLES ACCESSIBLE TO THE CITY AT ALL TIMES.
- 17 CONTRACTOR WILL PLACE BITUMINOUS MATERIAL WITH THE USE OF A LAYDOWN MACHINE WHERE PAVEMENT IS 8 FEET IN WIDTH OR WIDER.
- 18 ALL SUBGRADE AND SUBBASE MATERIAL ENCOUNTERED IN PAVEMENT REMOVAL AND REPLACEMENT THAT IS DETERMINED BY THE FIELD ENGINEER TO MEET THE SPECIFICATIONS, CAN BE REUSED. HOWEVER, THE MATERIAL WILL BE PROCESSED AND COMPACTED TO MEET MOISTURE CONTENT AND PERCENT COMPACTION REQUIRED BY THE SPECIFICATIONS.
- 19 CONTRACTOR WILL NOT PAVE OVER ANY SURFACE FEATURE, I.E., GAS VALVE, MANHOLE COVER, ETC. WITHOUT PRIOR APPROVAL FROM THE CITY FIELD ENGINEER.
- 20 CONTRACTOR WILL CONFINE HIS WORK WITHIN THE CONSTRUCTION EASEMENT LIMITS AND/OR RIGHT-OF-WAY, OR PROVIDE COPIES OF AGREEMENTS WITH ADJACENT LANDOWNERS TO THE CITY OF ALBUQUERQUE.
- 21 ALL WATER VALVES AND FIRE HYDRANTS REMOVED TO BE SALVAGED AND RETURNED TO THE C.O.A.
- 22 MINIMUM BOTTOM WIDTH OF TRENCHES FOR RIGID PIPE SHALL BE EQUAL TO THE OUTSIDE DIAMETER PLUS 16 INCHES. BEDDING MATERIAL SHALL BE CLASS II, III, OR IV UNLESS OTHERWISE SPECIFICALLY NOTED ON THE PLANS.
- 23 MINIMUM BOTTOM WIDTH OF TRENCHES FOR NON-RIGID PIPE SHALL BE EQUAL TO THE OUTSIDE DIAMETER PLUS 12 INCHES. BEDDING MATERIAL SHALL BE CLASS I, II, OR III.
- 24 THE CONTRACTOR AGREES TO TAKE NECESSARY SAFETY PRECAUTIONS AS REQUIRED BY FEDERAL, STATE AND LOCAL AUTHORITIES TO PROTECT PEDESTRIAN AND VEHICULAR TRAFFIC IN THE CONSTRUCTION AREA, WHICH INCLUDE BUT ARE NOT LIMITED TO: MAINTAINING ADEQUATE WARNING SIGNS, BARRICADES, LIGHTS, GUARD FENCES, WALKS AND BRIDGES.
- 25 ALL STRUCTURAL CONCRETE WILL BE 3000 PSI UNLESS OTHERWISE NOTED ON PLANS.
- 26 ALL REINFORCING STEEL WILL BE GRADE 60.

- 27 ALL EXPOSED EDGES ON CAST-IN-PLACE CONCRETE STRUCTURES WILL HAVE A 1" CHAMFER UNLESS OTHERWISE NOTED.
- 28 ALL SPLICES IN REINFORCING STEEL TO BE 2-FOOT 6-INCH MINIMUM UNLESS OTHERWISE NOTED.
- 29 PRIOR TO CONSTRUCTION, THE CONTRACTOR WILL EXCAVATE AND VERIFY THE HORIZONTAL AND VERTICAL LOCATIONS OF ALL POTENTIAL CONFLICTING UTILITIES. SHOULD A CONFLICT EXIST BETWEEN THE FIELD INFORMATION AND THE PLANS, THE CONTRACTOR WILL NOTIFY THE FIELD ENGINEER SO THE CONFLICT CAN BE RESOLVED WITH MINIMUM AMOUNT OF DELAY.
- 30 THE REPLACEMENT OF THE EXISTING UTILITIES AND THE INSTALLATION OF NEW UTILITY LINES WILL BE COMPLETED IN ADVANCE OF STARTING THE PAVEMENT WORK. TEMPORARY PAVEMENT WILL BE PLACED IN ALL TRENCHES REQUIRED FOR THE UTILITY REPLACEMENTS IN THOSE AREAS THAT MUST MAINTAIN TRAFFIC UNTIL THE FINAL PAVEMENT WORK STARTS IN EACH AREA. TEMPORARY STRIPING SHALL BE THE CONTRACTOR'S RESPONSIBILITY. MAINTENANCE OF THE TEMPORARY PAVING AND STRIPING WILL BE AT THE CONTRACTOR'S EXPENSE.
- 31 TACK COAT FOR SURFACE COURSE REQUIREMENTS WILL BE DETERMINED BY THE FIELD ENGINEER.
- 32 THE CONTRACTOR WILL CONTACT THE CITY OF ALBUQUERQUE TRAFFIC DIVISION 857-8025, ONE (1) WEEK IN ADVANCE OF ANY CHANGES REQUIRED IN THE TRAFFIC SIGNALIZATION OF THIS PROJECT. ALL WORK ASSOCIATED WITH NEW TRAFFIC SIGNALIZATION SHALL BE THE RESPONSIBILITY OF THE CONTRACTOR.
- 33 ALL NEW STREET PAVING, DRIVEWAYS, SIDEWALKS, AND CURB AND GUTTERS, ABUTTING EXISTING AREAS SHALL MATCH THE ELEVATION OF THOSE AREAS.
- 34 PERMANENT PAVEMENT STRIPING AND MARKINGS WILL BE PLACED BY THE CONTRACTOR. ROAD SHALL NOT BE OPENED TO TRAFFIC UNTIL IT IS STRIPED. ALL STRIPING, PAVEMENT MARKINGS INCLUDING CROSSWALKS, ARROWS AND LINE MARKINGS ARE TO BE CONSTRUCTED OF HOT PLASTIC OR COLD PLASTIC IN ACCORDANCE WITH THE MANUAL OF UNIFORM TRAFFIC CONTROL DEVICES.
- 35 ALL EXCAVATED MATERIAL THAT IS NOT REQUIRED TO BE REUSED MUST BE REMOVED FROM THE PROJECT AREA WITHIN FOUR DAYS OF EXCAVATION. SPOIL PILES WILL BE ALLOWED ONLY AS DIRECTED BY THE CITY FIELD ENGINEER.
- 36 THE CONTRACTOR WILL COORDINATE THE CONSTRUCTION ACTIVITIES WITH ALL OTHER CONTRACTORS AND UTILITY COMPANIES WORKING IN THE SAME AREA. THE CONTRACTOR MAY BE REQUIRED TO RESCHEDULE THEIR ACTIVITIES TO ALLOW UTILITY CREWS TO PERFORM THEIR REQUIRED WORK. NO ADDITIONAL COMPENSATION WILL BE ALLOWED FOR DELAYS OR INCONVENIENCE CAUSED BY UTILITY COMPANY WORK CREWS. A CONTRACT EXTENSION MAY BE ALLOWED AS DELINEATED IN CITY OF ALBUQUERQUE STANDARD SPECIFICATIONS.
- 37 ALL CONSTRUCTION EASEMENTS ON PRIVATE PROPERTY WILL BE OBTAINED BY THE CITY OF ALBUQUERQUE PRIOR TO THE BEGINNING OF CONSTRUCTION.
- 38 EXISTING MEDIAN CURB AND GUTTER AND STANDARD CURB AND GUTTER, NOT DISTURBED BY CONTRACTOR, BUT OUT OF ALIGNMENT, DISPLACED VERTICALLY, BADLY
- 39 ALL TRAFFIC CONTROL DEVICES REQUIRED FOR DRIVEWAY CLOSURES, UTILITY CONSTRUCTION OR FOR OTHER REASONS AND NOT SHOWN ON THE SIGNING PLANS WILL BE FURNISHED BY THE CONTRACTOR AND WILL BE PAID AS SPECIFIED IN THE TECHNICAL SPECIFICATIONS AND BID PROPOSAL. PRIOR TO PLACING THE TRAFFIC CONTROL DEVICES, THE CONTRACTOR WILL NOTIFY THE AFFECTED OWNERS IN ACCORDANCE WITH THE SPECIFICATIONS. CONTRACTOR MUST MAKE PROVISIONS TO PROVIDE ACCESS TO PROPERTIES. REFER TO SECTION 19 OF THE SPECIFICATIONS.
- 40 ALL UTILITY LINES WHICH ARE NOT SPECIFICALLY DESIGNATED TO BE REMOVED AND REPLACED ON THE PLANS, WILL BE MAINTAINED IN SERVICE. SHORING, SHEETING AND OTHER MEANS OF SUPPORT SHALL BE EMPLOYED BY THE CONTRACTOR TO PREVENT DAMAGE OR LOSS OF THESE EXISTING UTILITIES AND THESE SHORING, SHEETING, AND SUPPORTS ARE CONSIDERED INCIDENTAL TO THIS PROJECT. BEAM AND CABLE OR OTHER ADEQUATE SUPPORTS WILL BE USED FOR TEMPORARY SUPPORT OF ALL UTILITY LINES WHICH CROSS THE TRENCH. ANY DAMAGE TO EXISTING UTILITIES WILL PROMPTLY BE REPAIRED AT THE CONTRACTOR'S EXPENSE. THE CONTRACTOR WILL NOTIFY THE ENGINEER IMMEDIATELY OF ANY SIGNIFICANT DEVIATION OF EXPOSED UTILITIES FROM THE LOCATIONS SHOWN ON THE PLANS SO THAT CONFLICTS CAN BE RESOLVED IN A TIMELY MANNER.
- 41 THE CONTRACTOR WILL ASSUME RESPONSIBILITY FOR ANY DAMAGE TO EXISTING COA INFRASTRUCTURE (C & G, PAVING, ETC.) DURING CONSTRUCTION, APART FROM THOSE SECTIONS INDICATED FOR REMOVAL ON THE PLANS, AND WILL REPAIR OR REPLACE SAME AT HIS OWN EXPENSE. HE WILL SUITABLY PROTECT THE CURB AND GUTTER FROM INCIDENTAL SPLASHING DURING THE TACK COAT APPLICATION AND WILL BE RESPONSIBLE FOR CLEANING SAME AT HIS OWN COST SHOULD SPLASHING OCCUR.
- 42 ALL INTERFERING PORTIONS OF ABANDONED UTILITY LINES WHICH ARE EXPOSED AS A RESULT OF CONSTRUCTION WILL BE REMOVED AND DISPOSED OF BY THE CONTRACTOR.
- 43 STATIONS OF STORM DRAIN INLETS ARE TO THE CENTER OF GRATE. ALL STORM DRAIN INLETS WILL BE TYPE "A" UNLESS OTHERWISE NOTED ON THE PLANS.
- 44 SHORING COSTS WILL BE CONSIDERED INCIDENTAL TO THE TRENCH AND BACKFILL COSTS.
- 45 THE CONTRACTOR WILL BE RESPONSIBLE FOR SECURING NPDES PERMITS REQUIRED BY APPLICABLE CITY, STATE, AND FEDERAL REGULATIONS.
- 46 ALL STORM DRAIN AND CONNECTOR PIPE WILL BE CLASS IV REINFORCED CONCRETE PIPE UNLESS OTHERWISE NOTED ON THE PLANS.
- 47 THE TERM REMOVE USED IN THIS PLAN SET INCLUDES THE DISPOSAL OF SAID MATERIAL IN ACCORDANCE WITH CITY OF ALBUQUERQUE SPECIFICATIONS, LATEST EDITION.
- 48 CONTRACTOR WILL SURVEY AND LOG EXISTING ELEVATIONS OF CURB-AND-GUTTER, SIDEWALK, AND PAVEMENT WHICH WILL BE REMOVED FOR CONSTRUCTION OF IMPROVEMENTS. CONTRACTOR WILL REPLACE REMOVED CURB-AND-GUTTER, SIDEWALK, DRIVE PADS, AND PAVEMENT TO ELEVATIONS PRIOR TO REMOVAL UNLESS OTHERWISE INDICATED ON THE PLANS.

- 49 CONTRACTOR WILL CONSTRUCT TEMPORARY ASPHALT PAVEMENT AS DIRECTED BY THE FIELD ENGINEER TO PROVIDE ACCESS TO LOCAL BUSINESS, ETC. TEMPORARY PAVEMENT SHALL BE REMOVED AND DISPOSED OF PRIOR TO PLACEMENT OF FULL WIDTH PAVEMENT SECTION. TEMPORARY PAVING SHALL BE PER COA STD. DWG. 2415 AND PAID FOR PER COA STD. SPECIFICATIONS.
- 50 ALL CLASSES OF SEEDING SHALL BE DRY LAND MIX PLACED AT 1.5 LBS/1000 S.F. WITH FERTILIZER 21-12-12 PLACED AT 5 LBS/1000 S.F.
- 51 ALL ASPHALTIC CONCRETE SHALL BE MINIMUM 1800 LB. STABILITY AND COMPACTED TO 95% MODIFIED MARSHALL DENSITY UNLESS OTHERWISE NOTED ON THE PLANS.
- 52 ANY WORK OCCURRING WITHIN AN ARTERIAL ROADWAY REQUIRES TWENTY-FOUR (24) HOUR CONSTRUCTION.
- 53 ALL EXCAVATION, TRENCHING AND SHORING ACTIVITIES MUST BE CARRIED-OUT IN ACCORDANCE WITH OSHA 29 CFR 1926.650 SUBPART P.
- 54 THE CONTRACTOR SHALL BE RESPONSIBLE FOR TIMING AND COORDINATION OF WATER SHUTOFF AT LEAST SEVEN (7) WORKING DAYS PRIOR TO CONSTRUCTION. CONTRACTOR SHALL CONTACT THE WATER SYSTEMS DIVISION, 857-8200, TO INITIATE IMPLEMENTATION OF THE NON-PRESSURIZED CONNECTION PLAN.
- 55 FOR STORM DRAIN CONSTRUCTION, RCP PIPE JOINTS SHALL NOT BE GROUTED PRIOR TO FINAL INSPECTION. FINAL INSPECTION WILL DETERMINE JOINTS TO BE GROUTED FOR FINAL ACCEPTANCE OF THE CONSTRUCTION.
- 56 CONTRACTOR SHALL MAINTAIN A GRAFFITI-FREE WORK SITE. CONTRACTOR SHALL PROMPTLY REMOVE ANY AND ALL GRAFFITI FROM EQUIPMENT, WHETHER PERMANENT OR TEMPORARY.
- 57 CONTRACTOR SHALL ERECT TEMPORARY CHAIN LINK CONSTRUCTION FENCE. SUCH FENCE SHALL BE MAINTAINED THROUGHOUT THE DURATION OF THE CONSTRUCTION PERIOD AND REMOVED ONLY UPON FINAL ACCEPTANCE OF THE PROJECT BY THE CITY.
- 58 QUANTITIES PROVIDED ON THE PLANS ARE FOR THE CONTRACTOR'S CONVENIENCE ONLY. PLANS SHALL TAKE PRECEDENCE IN ALL CASES.


EXISTING FEATURES LEGEND:


- X----- EXISTING T-POST/WIRE FENCE
- 5" 180° 3/4" EXISTING GAS LINE W/ VALVE
- 5" W-3/4" EXISTING WATERLINE W/ VALVE
- @ EXISTING WATERLINE METER
- U EXISTING FIRE HYDRANT
- 5" SAG 3/4" EXISTING SANITARY SEWER LINE W/ MANHOLE
- 3/4" EXISTING STORM DRAIN
- GHE EXISTING OVERHEAD ELECTRIC W/POLE
- UE--- EXISTING UNDERGROUND ELECTRIC
- H--- EXISTING 1' CONTOUR
- 40AS--- EXISTING 5' CONTOUR
- ===== EXISTING CURB & GUTTER
- ===== EXISTING CONCRETE
- EXISTING BUILDING LINE
- -- EXISTING EASEMENT LINE

RECORD DRAWINGS

THIS RECORD DRAWING HAS BEEN PREPARED, BASED UPON INFORMATION FURNISHED BY THE CONTRACTOR. THE DESIGN PROFESSIONAL HAS NOT INDEPENDENTLY REVIEWED THE ACCURACY OF THE INFORMATION PROVIDED. THESE RECORD DRAWINGS ACCURATELY DEPICT THE FIELD CHANGES WHICH WERE REPORTED BY THE CONTRACTOR.

CITY OF ALBUQUERQUE DEPARTMENT OF MUNICIPAL DEVELOPMENT Park Design & Construction Division			
TITLE: BUTTERFIELD WELL SITE PARK SHADE STRUCTURE INSTALLATION GENERAL NOTES			
Design Review Committee	City Engineer Approval	LAST DESIGN UPDATE	
		Mo./Day/Yr.	Mo./Day/Yr.
Project #	456991	Zone Map	D-20
			Sheet 2 of 5

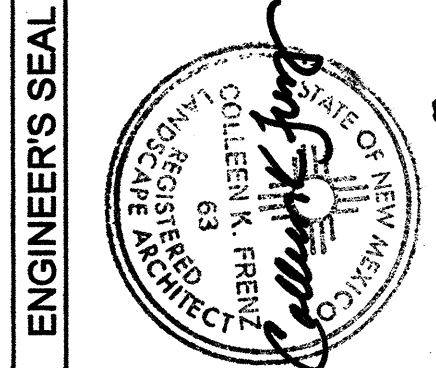

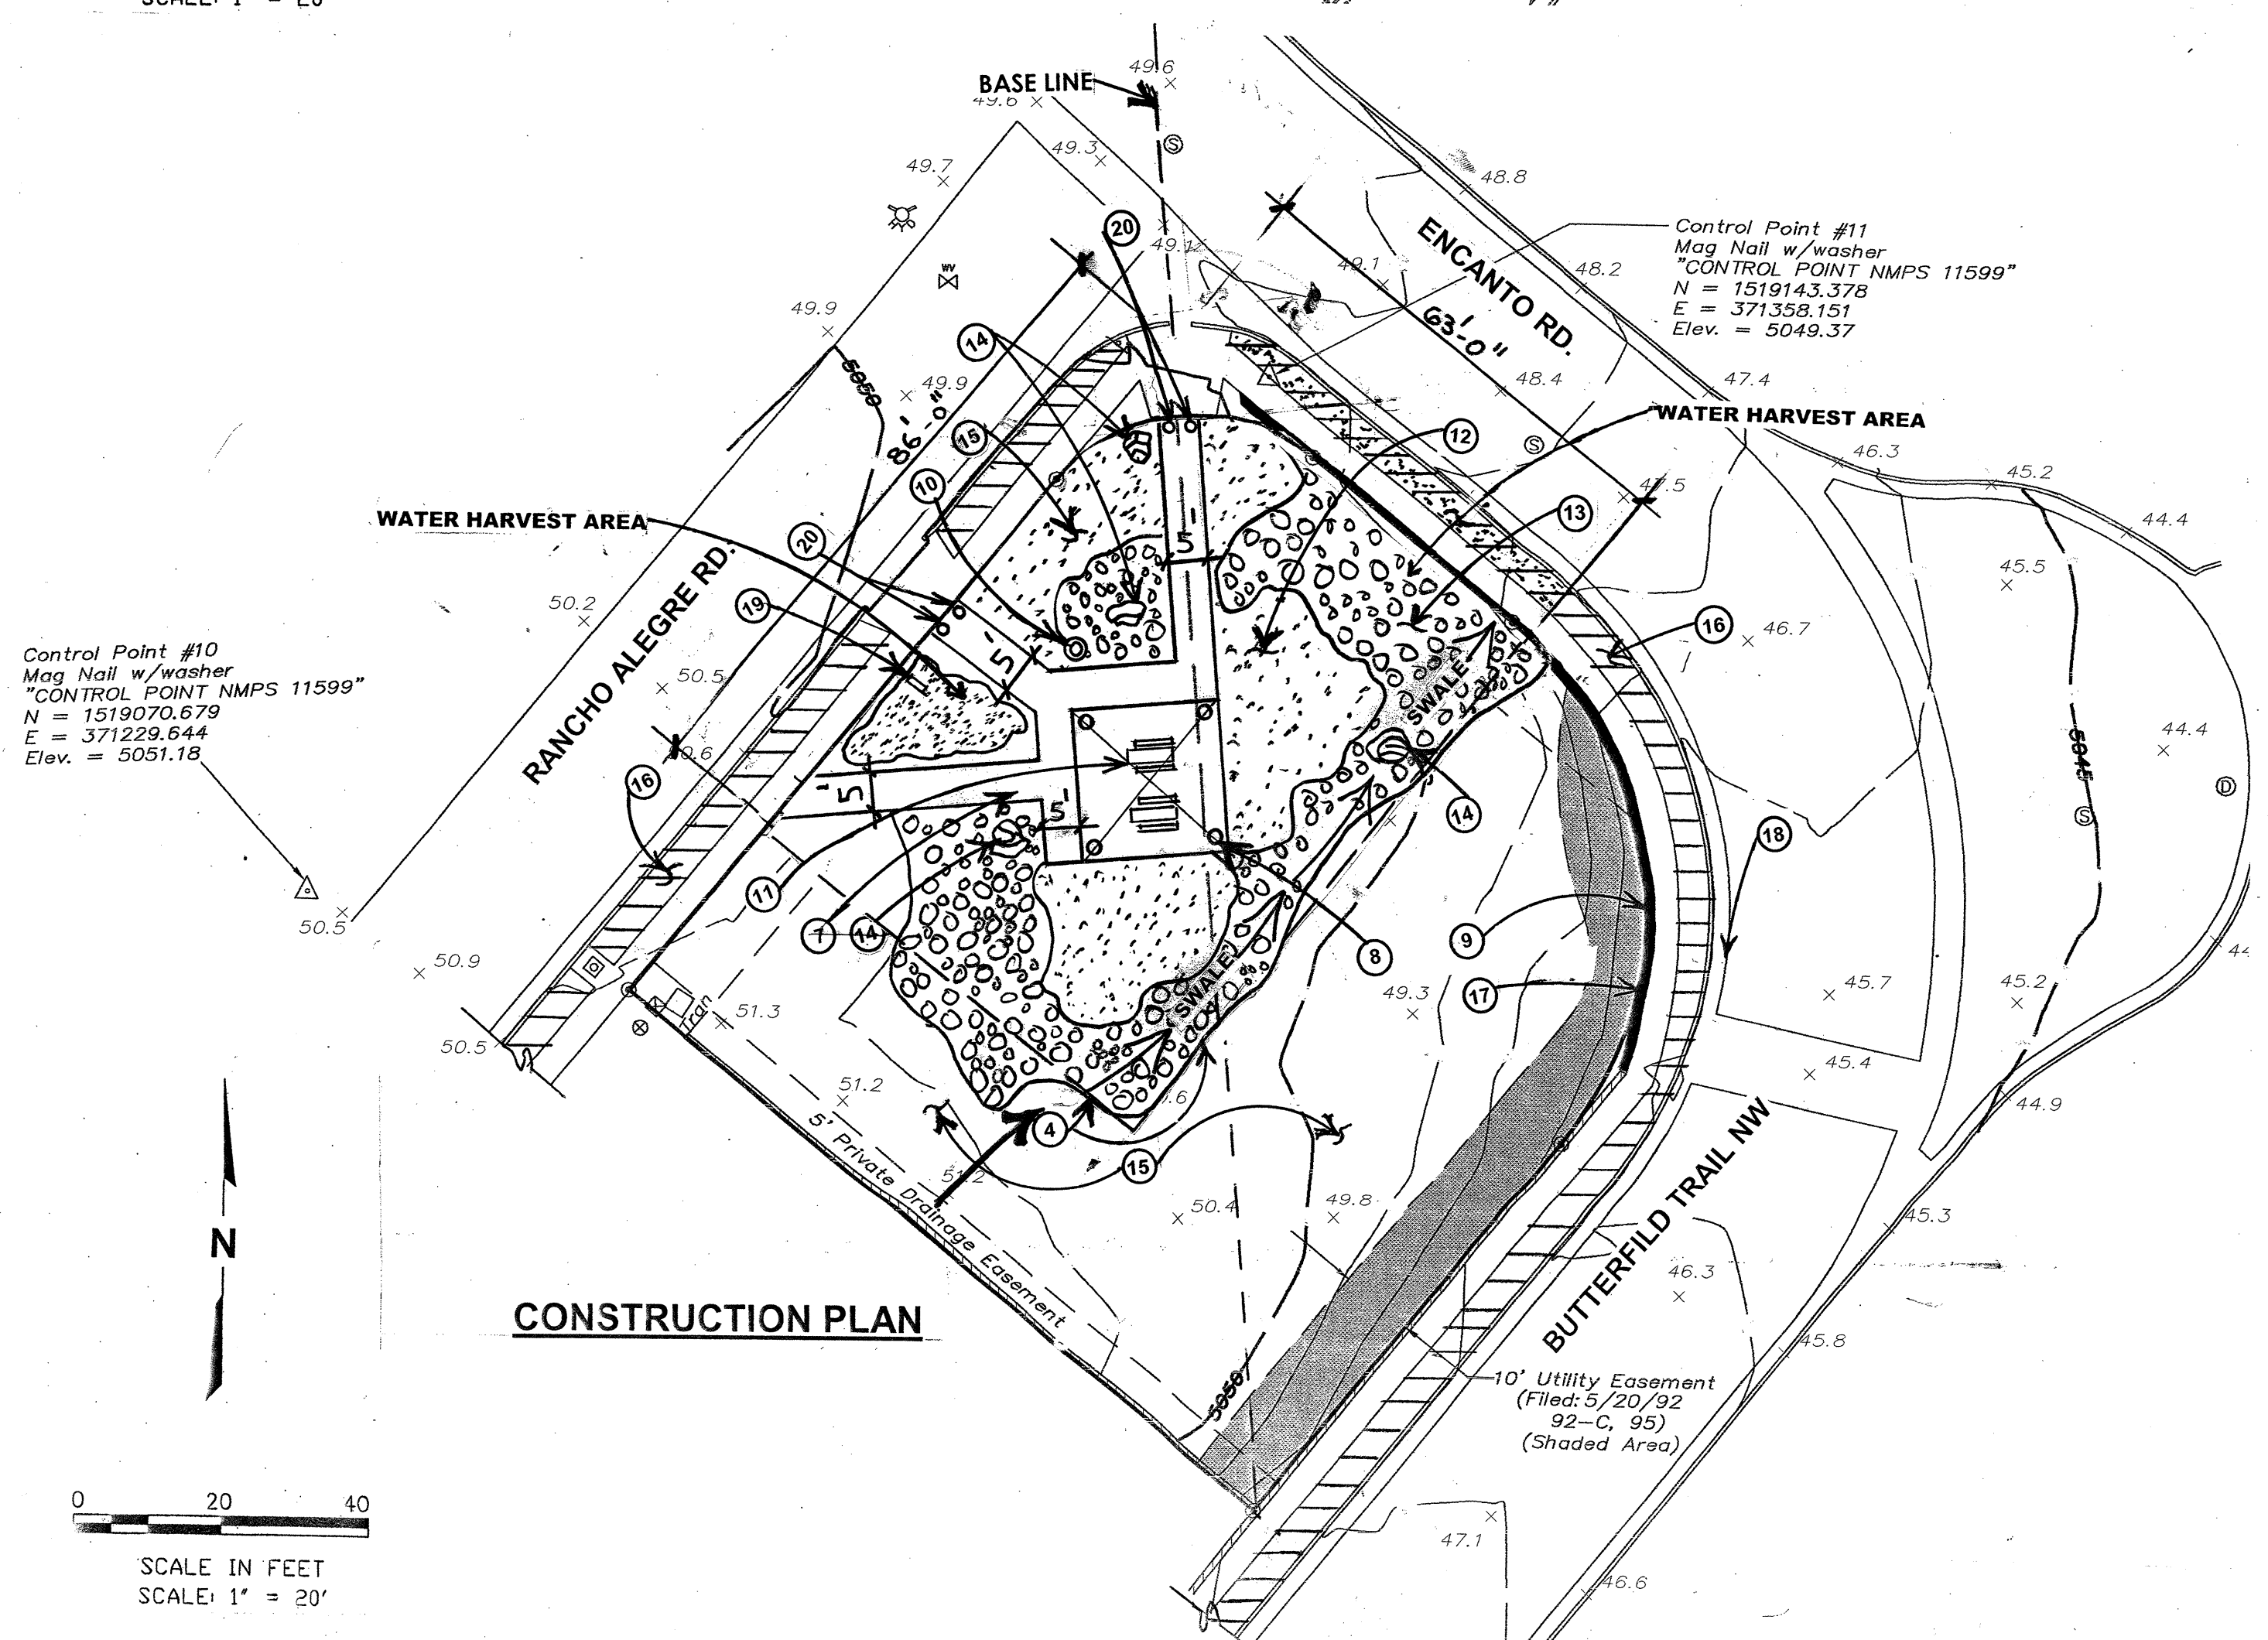

- ① GRADE AREA WHERE THE CONCRETE SLAB WILL BE
INSTALLED PER CITY STANDARD SPECIFICATIONS DWG. 2720.
- ② EXISTING SIDEWALK.
- ③ EXISTING VEGETATION TO REMAIN UNDISTURBED.
- ④ EXTENT OF WORK.
- ⑤ PROPOSED WELL SITE LOCATION.
- ⑥ EXISTING WHEEL CHAIR CURB ACCESS RAMP.

- ① NEW CONCRETE PAD TO BE INSTALLED PER CITY STANDARD SPECIFICATIONS DWG. 2720.
- ② CONCRETE TO MATCH EXISTING SIDEWALK AND EXISTING WHEELCHAIR RAMP ELEVATION AND BRUSH FINISH.
- ③ INSTALL NEW 20' X 20' LITCHFIELD SHADE STRUCTURE # 8120 PITTSBURGH MODEL, PER MANUFACTURERS SPECIFICATIONS. PLACE ON RAISED PEDESTAL FOOTINGS, AVAILABLE THRU TRIPLE M RECREATION PHONE 899-6892. COLOR: BLACK FRAME AND BLUE ROOF PANELS.
- ④ INSTALL A NEW CMU RETAINING WALL PER DETAIL LOCATED ON THIS SHEET. 6' TO 2' VARY IN HEIGHT SMOOTH FACE/SPILT FACE, COMPLETE WITH FOOTING, WEEP HOLES PLASTERS AND TOP CAP. COLOR: CORAL TO MATCH EXISTING CMU SPLIT-FACE WALL.
- ⑤ MCCLINTOCK RSO 25, 32 GAL TRASH RECEPTACLE INSTALL ON A CONCRETE PAD PER MANUFACTURERS SPECIFICATIONS.
- ⑥ INSTALL DUMOR 8' ACCESSIBLE TABLE, MODEL 77-68-1PL, INGROUND MOUNT PROVIDED BY COA. TOTAL OF 2.
- ⑦ FINE GRADE LOW SPOTS AND INSTALL 2" OF BRONZE CRUSHED GRAVEL OVER HYDROSEED (WESTSIDE SEED MIX).
- ⑧ INSTALL 4" TO 8" SANTA ANA TAN RIVER ROCK COBBLE OVER BRONZE CRUSHED GRAVEL OVER HYDRO-SEED.
- ⑨ INSTALL (4) 3X3 MOSS ROCK BOULDERS.
- ⑩ PRESERVE/PROTECT EXISTING VEGETATION.
- ⑪ CLEAN BETWEEN SIDEWALK AND CURB, INSTALL 4" OF SANTA ANA TAN CRUSHED GRAVEL OVER WEED BARRIER.
- ⑫ BACKFILL EXCESS SOIL TO CMU WALL.
- ⑬ MOVE STREET SIGN POST SOUTH.
- ⑭ INSTALL PARK SIGN.
- ⑮ INSTALL STATIONARY/REMOVABLE BOLLARDS PER CITY STANDARD SPECIFICATIONS DWG. 2250.
- ⑯ SAW CUT CONTROL JOINTS.
- ⑰ EXPANSION JOINTS. — — — — —


THIS RECORD DRAWING HAS BEEN PREPARED, BASED UPON INFORMATION FURNISHED BY THE CONTRACTOR. THE DESIGN PROFESSIONAL HAS NOT INDEPENDENTLY REVIEWED THE ACCURACY OF THE INFORMATION PROVIDED. THESE RECORD DRAWINGS ACCURATELY DEPICT THE FIELD CHANGES WHICH WERE REPORTED BY THE CONTRACTOR.

	CITY OF ALBUQUERQUE DEPARTMENT OF MUNICIPAL DEVELOPMENT Park Design & Construction Division
	TITLE: BUTTERFIELD WELL SITE PARK SHADE STRUCTURE INSTALLATION GRADING & CONSTRUCTION PLAN

Design Review Committee	City Ebgineer Approval	DATE	Mo./Day/Yr.	Mo./Day/Yr.

Project #	Zone Map	D-12	Sheet 3 of 5
456391			

NO.	REMARKS	BY:	DATE	ENGINEER'S SEAL	SURVEY INFORMATION FIELD NOTES		BENCH MARKS	AS BUILT INFORMATION		
				 <i>Coleen K. Frenz</i>	NO.	BY:		CONTRACTOR	DATE	
									STAMPED BY	DATE
									ACCEPTANCE BY	DATE
									FIELD RECORD BY	DATE
									DRAWINGS	DATE
								CORRECTED BY	DATE	
	DESIGNED BY:							MICRO-FILM INFORMATION		
	DRAWN BY/DAV							RECORDED BY	DATE	
	CHECKED BY: OKF									

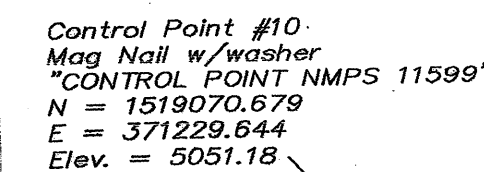

0 20 40
SCALE IN FEET
SCALE: 1" = 20'

RECORD DRAWINGS


THIS RECORD DRAWING HAS BEEN PREPARED, BASED UPON INFORMATION FURNISHED BY THE CONTRACTOR. THE DESIGN PROFESSIONAL HAS NOT INDEPENDENTLY REVIEWED THE ACCURACY OF THE INFORMATION PROVIDED. THESE RECORD DRAWINGS ACCURATELY DEPICT THE FIELD CHANGES WHICH WERE REPORTED BY THE CONTRACTOR.

WELL SITE GRADING PLAN

- ① GRADE AREA WHERE THE CONCRETE SLAB WILL BE INSTALLED PER CITY STANDARD SPECIFICATIONS DWG. 2720.
- ② EXISTING SIDEWALK.
- ③ EXISTING VEGETATION TO REMAIN UNDISTURBED.
- ④ EXTENT OF WORK.
- ⑤ PROPOSED WHEEL CHAIR LOCATION.
- ⑥ EXISTING WHEEL CHAIR CURB ACCESS RAMP.

CONSTRUCTION PLAN

- 7) NEW CONCRETE PAD TO BE INSTALLED PER CITY STANDARD SPECIFICATIONS DWG. 27.20.
CONCRETE TO MATCH EXISTING SIDEWALK AND EXISTING WHEELCHAIR RAMP ELEVATION AND BRUSH FINISH.
- 8) INSTALL NEW 20' X 20' LITCHFIELD SHADE STRUCTURE #8120 PITTSBURGH MODEL. PER MANUFACTURERS SPECIFICATIONS. PLACE ON RAISED PEDESTAL FOOTINGS, AVAILABLE THRU TRIPLE M RECREATION PHONE 899-6892. COLOR: BLACK FRAME AND BLUE ROOF PANELS.
- 9) INSTALL A NEW CMU RETAINING WALL PER DETAIL LOCATED ON THIS SHEET. 6 TO 2' VARY IN HEIGHT SMOOTH FACE/SPLIT FACE. COMPLETE WITH FOOTING. WEEP HOLES PILASTERS AND TOP CAP. COLOR: CORAL TO MATCH EXISTING CMU SPLIT-FACE WALL.
- 10) MCCLINTOCK RSO 25, 32 GAL TRASH RECEPTACLE INSTALL ON A CONCRETE PAD PER MANUFACTURERS SPECIFICATIONS.
- 11) INSTALL DUMOR 8' ACCESSIBLE TABLE, MODEL 77-68-1PL, INGROUND MOUNT PROVIDED BY COA. TOTAL OF 2.
- 12) FINE GRADE LOW SPOTS AND INSTALL 2" OF BRONZE CRUSHED GRAVEL OVER HYDROSEED (WESTSIDE SEED MIX).
- 13) INSTALL 4" TO 6" SANTA ANA TAN RIVER ROCK COBBLE OVER BRONZE CRUSHED GRAVEL OVER HYDRO-SEED.
- 14) INSTALL (4) 3X3 MOSS ROCK BOULDERS.
- 15) PRESERVE/PROTECT EXISTING VEGETATION.
- 16) CLEAN BETWEEN SIDEWALK AND CURB, INSTALL 4" OF SANTA ANA TAN CRUSHED ROCK OVER WEED BARRIER.
- 17) BACKFILL EXCESS SOIL TO CMU WALL.
- 18) MOVE STREET SIGN POST SOUTH.
- 19) INSTALL PARK SIGN.
- 20) INSTALL STATIONARY/REMOVABLE BOLLARDS PER CITY STANDARD SPECIFICATIONS DWG. 2250.
- 21) SAW CUT CONTROL JOINTS. _____
- 22) EXPANSION JOINTS. _____

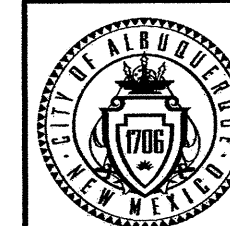[illegible]

CITY OF ALBUQUERQUE
DEPARTMENT OF MUNICIPAL DEVELOPMENT
Park Design & Construction Division

TITLE: BUTTERFIELD WELL SITE PARK
SHADE STRUCTURE INSTALLATION
PICNIC TABLE CONCRETE EXPANSION/CONTROL JOINT PLAN

Design Review Committee	City Engineer Approval	LAST DESIGN UPDATE	Mo./Day/Yr.	Mo./Day/Yr.
Project #	456991	Zone Map	D-12	Sheet 4 of 5

FINAL FOR CONSTRUCTION

BUTTERFIELD WELL SITE PARK SHADE STRUCTURE INSTALLATION

Project # 456991

	X
--	---

RECORD DRAWINGS
SEPTEMBER 22, 2008



Date: 7/10/08
To: Jeff Hart, Superintendent, Park Management, Parks & Recreation Department (PRD)
From: John Casados, Construction Manager, Park Design & Construction, DMD
Subject: Butterfield Well/Park - Substantial Completion - 07/10/08
PRD, Park Management Division Accepts Maintenance Responsibility

As of (date): 07/10/08

Project ID#: 456691

Name of Facility: Butterfield Wolf Park

Address: 4100 Rancho Alegre NW
Albuquerque, NM

CD: 5

Park Zoning: RL-T

... is officially assigned to the Park Management Division, Parks & Recreation Department, City of Albuquerque for maintenance. Outlined below is a description of work completed:

❑ Renovation ► Developed

Detailed Park Summary Information:

Total Park Acreage: 0.124

Acres Developed: 0.124

Description of Project:

Acres of Irrigated Turf	cool / warm season
Turf Removal:	square foot
Landscape Area Trees & Shrubs:	
Tree Count:	cool / warm
Recycled Construction Materials:	truckload
Recycled Benches	
Recycled Tables	2
Engineered Wood Fibers	square feet

Park property renovated; per FINAL FOR CONSTRUCTION DOCUMENTS DATED 03/06/08 and COA specifications.
New:

1. Site Furnishings:
 - (1) 20'x20' Litchfield Shade Structure.
 - (2) 8ft ADA Picnic Table
 - (1) Trash Receptacle
 - (2) Concrete sidewalks entering towards shade structure and a 20ft x 20ft concrete pad under shade structure.
 - (3) 4'-6" Santa Ana Tan river rock cobble over Bronze crushed gravel.
 - (4) stationery bollards.
 - (5) 4"x3"x3" moss boulders.
 - (6) (119ft) CMU block wall along northeast corner, added to existing wall, height varied from 5ft to 18inches
 - (7) West side native seed planted under new gravel not irrigated.
 - (8) Electrical and water biline was not applicable.

Effective date: 07/10/08
NO MORE CHARGES for new water, electric and gas

...will be accepted by the contractor:	City of Albuquerque; Class II Crews and Valley Fence
...are to occur against activity numbers:	7294150

Contacts:

Project Manager, City of Albuquerque, Park Design & Construction, DMD

Project Manager: David Flores
Phone: (505) 768-3815
Email: dflores@cabq.gov
Fax: (505) 768-2310

Consultant: AE# n/a

Landscape Architect of Record: Colleen K. Frenz
Address: CABQ, P.O. Box 1293, Alb., NM, 87103
Contact Name: Colleen K. Frenz, RLA, ASLA
Phone: (505) 768-3826
Email: cfrenz@cabq.gov

Contactor Information:

Contractor: City of Albuquerque, DMD, Class II Crews
Contact Name: Manuel Avila
Phone: (505) 857-8655
Scope of Work: Install all hardscape, irrigation and landscape.
Warranty: One (1) year labor and materials
Warranty Start Date: - Expiration Date: 07/10/08 - 07/10/09

Contractor: Valley Fence Company - PO# 684531
Contact Name: David Garcia
Phone: (505) 304-3891
Scope of Work: Install of new CMU block wall.
Warranty: One (1) year labor and materials
Warranty Start Date: 07/10/08- Finish Date: 07/10/08

Warranty and Vendor Information:

Warranty and Vendor Information: The following is a listing of all labor, vendors and product warranties pertaining to project: Butterfield Well/Park

During the first year all calls regarding warranty information will go to the contractor. After one year calls regarding warranty go directly to the vendor.

Vendor: Triple M Recreation
Phone: (480) 315-9103
Application: Litchfield Shade Structure
Product: 20ftx20ft Pittsburgh Square Shelter
Model#: 8120, Black frame and blue roof
Manufacture structural warranty: 20 yrs.

Vendor: Exerplay, Inc.
Phone: (505) 281-0151
Application: Dumor Site Furnishings
Product: (2) 8' Picnic Tables, recycled plastic
Model#: 100-80PL, surface mount
Manufacture structural warranty:

Vendor: Utility Block (Purchased by Valley Fence)
Phone: (505) 344-2368
Application: CMU Block Wall Materials
Product: Size: 6"x6"x16"
Model#: Color: Coral
Manufacture structural warranty: n/a

Vendor: BearSaver
Phone: (800) 350-3588
Application: Site Furnishings
Product: (1) Trash receptacles
Model#: RSO-25, color: Black
Manufacture structural warranty: 1 yr.

Audit Information for Play Equipment, Irrigation System and Backflow Preventor

Auditor:
Phone:
Inspector Name:
Inspection Date:
Products Inspected: Backflow Prevention Assembly

Auditor:
Phone:
Inspector Name:
Inspection Date:
Products Inspected: Landscape Irrigation Water Audit

Water Meter:

Reading: _____
Address: _____
Serial Number: _____
Type: _____
Final billing date: _____
New Service JV: _____

Electric Meter:

Reading: _____
Number: _____
Serial Number: _____
Type: _____

- Maintenance Documents
 - Keys (trash receptacles)
 - Benches
 - Tables
 - Play Structures
 - Shade Structures (engineered drawings and footing details)
 - Lights
 - Booster Pump
 - Irrigation Controller
- Permits (date approved)
 - Electrical ()
 - SWPPP/NOI ()
 - Building (Shade Structure/04/08/08)
 - Dust Control ()
 - Water Meter Tap ()
 - Concrete Tests
- Punch list complete date: 07/25/08
- Record drawings per General Conditions section 6.10
 - Reproducible as built Record Drawings for entire park project completed by a certified draftsman
 - same scale as plans.
 - Legible, reduced laminate layout drawings of irrigation system for each controller.
 - color coded by each valve front of copy.
 - irrigation legend and scheduled batch of copy.
 - irrigation schedule batch of copies.
 - 11"x17" format.

Email copies to:
jayhart@cabq.gov, szuschlag@cabq.gov, amgarcia@cabq.gov, cfrenz@cabq.gov, jcasados@cabq.gov, rlofstrom@cabq.gov,
jeffnhart@cabq.gov, Rgabaldon@cabq.gov, Idunn@cabq.gov, DFlores@cabq.gov, cmsandoval@cabq.gov

[illegible]

Auditor: _____ Phone: _____ Inspector Name: _____ Inspection Date: _____ Products Inspected: Backflow Prevention Assembly	
Auditor: _____ Phone: _____ Inspector Name: _____ Inspection Date: _____ Products Inspected: Landscape Irrigation Water Audit	
Water Meter: Reading: _____ Address: _____ Serial Number: _____ Type: _____ Final billing date: _____ New Service JV: _____	Electric Meter: Reading: _____ Number: _____ Serial Number: _____ Type: _____

NO.	REMARKS	BY:	DATE	ENGINEER'S SEAL	SURVEY INFORMATION FIELD NOTES NO. BY:	BENCH MARKS	AS BUILT INFORMATION
							CONTRACTOR DATE
							STAKED BY DATE
							INSPECTOR'S ACCEPTANCE BY DATE
							TESTING VERIFICATION BY DATE
							DRAWINGS CONNECTED BY DATE
DESIGNED BY:							MICRO-FILM INFORMATION
DRAWN BY: DAV							RECORDED BY DATE
CHECKED BY: OKF							

CITY OF ALBUQUERQUE DEPARTMENT OF MUNICIPAL DEVELOPMENT Park Design & Construction Division				
TITLE: BUTTERFIELD WELL SITE PARK SHADE STRUCTURE INSTALLATION FINAL ACCEPTANCE FORM				
Design Review Committee	City Engineer Approval	LAST DESIGN UPDATE	Mo./Day/Yr.	Mo./Day/Yr.
Project #	Zone Map		Sheet 5 of 5	
456991		D-12		

**RECORD DRAWINGS
SEPTEMBER 22, 2008**

BUTTERFIELD WELL SITE PARK SHADE STRUCTURE INSTALLATION

FINAL FOR CONSTRUCTION