

CONSTRUCTION PLANS
FOR
RANCHO SERENO SUBDIVISION
UNIT II
ALBUQUERQUE, NEW MEXICO

INDEX	
SHEET NUMBER	DESCRIPTION
1	TITLE SHEET
2-3	PLAT
4-5	FINAL GRADING AND DRAINAGE PLAN
6-7	PIEDRAS MARCADAS DAM BASIN GRADING PLAN
8	GRADING AND DRAINAGE DETAILS
9	OVERALL PAVING PLAN
	PAVING PLAN AND PROFILE
10-12	RANCHO LARGO & STORM DRAIN
13	RANCHO SERENO & STORM DRAIN
14	RANCHO ALEGRE
15	RANCHO ENCANTO
16	RANCHO QUIETO CT. RANCHO DORADO CT. & RANCHO BRAVO
17	OVERALL UTILITY PLAN
	UTILITY PLAN AND PROFILE
18-20	RANCHO LARGO
21	RANCHO SERENO
22	RANCHO ALEGRE
23	RANCHO ENCANTO
24	RANCHO QUIETO CT. RANCHO DORADO CT. & RANCHO BRAVO
25	ENERGY DISSIPATOR DETAILS
26-27	RETAINING WALL PROFILES
28	RETAINING WALL DETAILS


I, A. E. Schumacher, Registered Professional Engineer and Land Surveyor in the State of New Mexico, do hereby certify that this "as-built" information was obtained by me or under my supervision and represents the "as-built" conditions of this project, and is true and correct to the best of my knowledge and belief. All vertical and horizontal dimensions should be field verified prior to use on future projects.

A. E. Schumacher
A. E. Schumacher
NMPE/LS No. 2360

APPROVAL OF AS BUILT DRAWINGS
CHIEF CONSTRUCTION ENGINEER
F. J. B. L. L.
DATE 7-28-94

SCANNED BY
BY LASON

BHI JOB NO. 92287.01

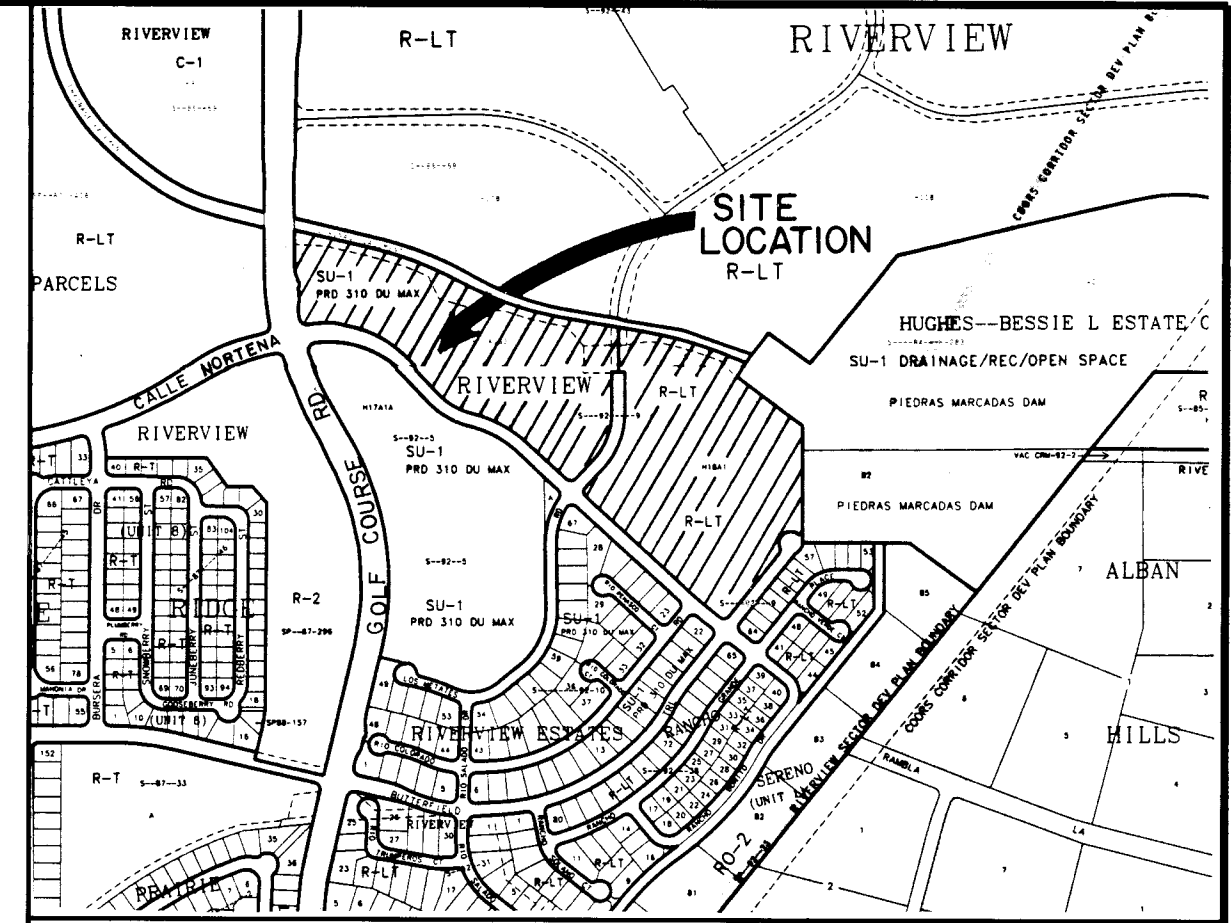

VICINITY MAP
NOT TO SCALE
C-12 & D-12


NOTICE TO CONTRACTORS

1. ALL WORK DETAILED ON THESE PLANS TO BE PERFORMED UNDER CONTRACT SHALL, EXCEPT AS OTHERWISE STATED OR PROVIDED FOR HEREON, BE CONSTRUCTED IN ACCORDANCE WITH THE CITY OF ALBUQUERQUE STANDARD SPECIFICATIONS FOR PUBLIC WORKS CONSTRUCTION, 1986 EDITION AND SHALL INCLUDE UPDATE NO. 4 REVISIONS, DELETIONS, AND ADDITIONS DATED JAN. 28, 1993.
2. TWO WORKING DAYS PRIOR TO ANY EXCAVATION, THE CONTRACTOR MUST CONTACT NEW MEXICO ONE CALL SYSTEM (260-1990) FOR LOCATION OF EXISTING UTILITIES.
3. PRIOR TO CONSTRUCTION, THE CONTRACTOR SHALL EXCAVATE AND VERIFY THE HORIZONTAL AND VERTICAL LOCATIONS OF ALL OBSTRUCTIONS. SHOULD A CONFLICT EXIST, THE CONTRACTOR SHALL NOTIFY THE ENGINEER OR SURVEYOR IMMEDIATELY SO THAT THE CONFLICT CAN BE RESOLVED WITH A MINIMUM AMOUNT OF DELAY.
4. THREE (3) WORKING DAYS PRIOR TO BEGINNING CONSTRUCTION, THE CONTRACTOR SHALL SUBMIT TO CONSTRUCTION COORDINATION DIVISION A DETAILED CONSTRUCTION SCHEDULE. TWO (2) WORKING DAYS PRIOR TO CONSTRUCTION, THE CONTRACTOR SHALL OBTAIN A BARRICADING PERMIT FROM THE CONST. COORDINATION DIVISION. CONTRACTOR SHALL NOTIFY BARRICADE ENGINEER (768-2551) PRIOR TO OCCUPYING AN INTERSECTION. REFER TO SECTION 1.9 OF THE GENERAL CONDITIONS OF THE STANDARD SPECIFICATIONS.
5. ALL STREET STRIPING ALTERED OR DESTROYED SHALL BE REPLACED IN KIND BY CONTRACTOR TO LOCATION AND IN KIND AS EXISTING OR AS INDICATED BY THIS PLAN SET.
6. CONTRACTOR SHALL NOTIFY THE ENGINEER NOT LESS THAN SEVEN (7) DAYS PRIOR TO STARTING WORK IN ORDER THAT THE ENGINEER MAY TAKE NECESSARY MEASURES TO INSURE THE PRESERVATION OF SURVEY MONUMENTS. CONTRACTOR SHALL NOT DISTURB PERMANENT SURVEY MONUMENTS WITHOUT THE CONSENT OF THE ENGINEER AND SHALL NOTIFY THE ENGINEER AND BEAR THE EXPENSE OF REPLACING ANY THAT MAY BE DISTURBED WITHOUT PERMISSION. REPLACEMENT SHALL BE DONE ON REQUEST BY THE ENGINEER. WHEN A CHANGE IS MADE IN THE FINISHED ELEVATIONS OF THE PAVEMENT OF ANY ROADWAY IN WHICH A PERMANENT SURVEY MONUMENT IS LOCATED, CONTRACTOR SHALL, AT HIS OWN EXPENSE, ADJUST THE MONUMENT COVER TO THE NEW GRADE UNLESS OTHERWISE SPECIFIED. REFER TO SECTION 4.4 OF THE GENERAL CONDITIONS OF THE STANDARD SPECIFICATIONS.

THE FOLLOWING NOTES ALSO APPLY WHEN CHECKED

- ☒ ALL UTILITIES AND UTILITY SERVICE LINES SHALL BE INSTALLED PRIOR TO PAVING.
- ☐ BACKFILL COMPACTION SHALL BE ACCORDING TO SPECIFIED STREET USE.
- ☐ TACK COAT REQUIREMENTS SHALL BE DETERMINED BY THE CITY ENGINEER.
- ☒ SIDEWALKS AND WHEELCHAIR RAMPS WITHIN THE CURB RETURNS SHALL BE CONSTRUCTED WHEREVER A NEW CURB RETURN IS CONSTRUCTED.
- ☒ IF CURB IS DEEPRESSED FOR A DRIVEPAD, THE DRIVEPAD SHALL BE CONSTRUCTED PRIOR TO ACCEPTANCE OF CURB AND GUTTER.
- ☒ ALL STORM DRAINAGE FACILITIES SHALL BE COMPLETED PRIOR TO FINAL ACCEPTANCE.
- ☒ THE REQUESTOR OR DEVELOPER SHALL BE RESPONSIBLE FOR REPAIR OR REPLACEMENT OF ALL CURB AND GUTTER OR SIDEWALK DAMAGED AFTER APPROVAL BY THE CITY ENGINEER OF WORK COMPLETED BY THE CONTRACTOR.

REV		SHEETS		CITY ENGINEER		DATE		USER DEPARTMENT		DATE		USER DEPARTMENT		DATE	
APPROVAL OF REVISIONS															

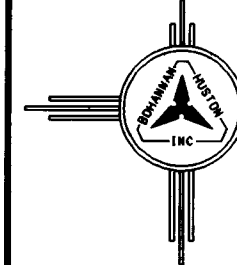[illegible]

BOHANNAN HUSTON INC.
ALBUQUERQUE, NEW MEXICO
ENGINEERS PLANNERS PHOTOGRAMMETRISTS

APPROVED FOR
CONSTRUCTION

Ricard B. T. 10 11	
Oct 7, 1993	C.E.


PROJECT NUMBER

4569.93

SHEET OF

28 |

930913130303

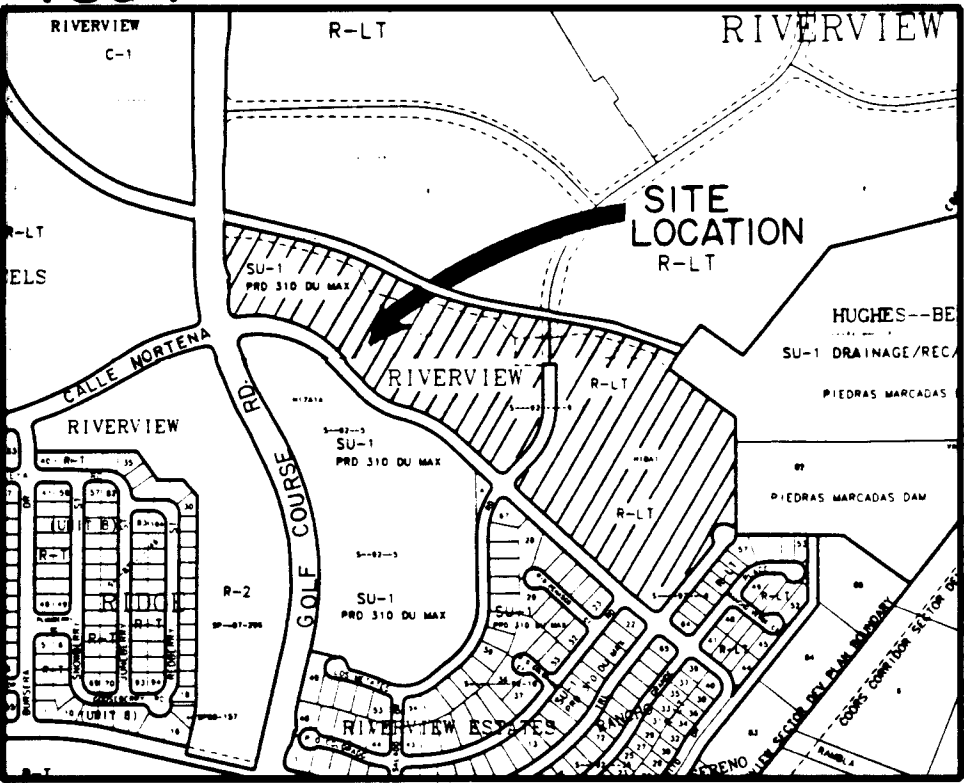

ZONE ATLAS INDEX MAP No. C-12 and D-12
NOT TO SCALE

SUBDIVISION DATA

1. DRB No. 92-440.
2. Zone Atlas Index Map No. C-12 and D-12
3. Gross Subdivision Acreage: 25.9766 Acres.
4. Date of Survey: September, 1993
5. Total number of Lots created: 112 Lots and 5 Tracts
6. This Plat shows existing easements.

NOTES

1. Bearings are New Mexico State Plane Grid Bearings (Central Zone).
2. Distances are ground distances.
3. City of Albuquerque Water and Sanitary Sewer Services to Lots 86-197 must be verified and coordinated with Public Works Department, City of Albuquerque.
4. This site is located within Sections 13 and 24, T11N, R2E, N.M.P.M. Public street right-of-way dedicated by this Plat: S-1361 Ave.
5. Lots 86 thru 197 inclusive are designated as "P" Lots and shall conform to Item 1, Intermittent Parking Criteria. This requires four off street parking spaces per lot for homes containing four bedrooms or less, which can be provided by a two-car garage with driveway. Homes containing five bedrooms will require three-car garages.
6. Tract D is dedicated to the City of Albuquerque as a future Well Site.
7. Tracts B, C, and E are dedicated to the City of Albuquerque as Permanent Trails and Open Space Easements and are reserved for construction and maintenance of trails, open spaces, landscaping, recreational uses, utilities, access and service roads.
8. Centerline (in lieu of R/W) monumentation to be installed at all centerline, P.O.'s, P.I.'s, angle points and street intersections prior to acceptance of subdivision street improvements and will consist of a standard four (4) inch (1.27 cm) aluminum alloy cap stamped "City of Albuquerque", "Centerline Monumentation", "Survey Marker", "Do Not Disturb", "PLS 5978".
9. Tract A is to be acquired by AMAFCA for inclusion into the Piedras Mercedes Dam, in accordance with the agreement dated _____.

DISCLOSURE STATEMENT

The purpose of this Replat is to subdivide Parcel H-17A-1B2 and Parcel H-18A-1, dedicate public street right-of-way, grant easements, to vacate easements, and to vacate the blanket drainage easements upon Parcel H-17A-1B2 and Parcel H-18A-1, vacated by Outclaim Deeds from the AMAFCA Board of Directors, filed _____, 1993 as Document Nos. _____ and _____, respectively, and approved by the DRB as V-93-30.

PUBLIC UTILITY EASEMENTS

PUBLIC UTILITY EASEMENTS shown on this plat are ten (10) feet wide and are for the common joint use of:

- A. The Public Service Company of New Mexico for the installation, maintenance, and service of overhead and underground electrical lines, structures and related facilities reasonably necessary to provide electrical service.
- B. The Gas Company of New Mexico for installation, maintenance, and service of natural gas lines, valves and other equipment and facilities reasonably necessary to provide natural gas.
- C. U.S. West for the installation, maintenance and service of all buried and aerial communication lines and other related equipment and facilities reasonably necessary to provide communication services, including but not limited to above ground pedestals and closures.
- D. Jones Interchange for the installation, maintenance, and service of such lines, cable, and other related equipment and facilities reasonably necessary to provide Cable TV service.

Included is the right to build, rebuild, construct, reconstruct, locate, relocate, change, remove, modify, renew, operate, and maintain facilities for the purposes described above, together with free access to, from, and over said easements, including sufficient working area space for electric transformers, with the right and privilege to trim and remove trees, shrubs or bushes which interfere with the purposes set forth herein. No building, sign, pool (above ground or subsurface), hot tub, concrete or wood pool decking, or other structure shall be erected or constructed on said easements, nor shall any well be drilled or operated thereon. Property owners shall be solely responsible for correcting any violations of National Electric Safety Code caused by construction of pools, decking, or any structures adjacent to or near easements shown on this plat.

DESCRIPTION

A certain tract of land situate within Sections 13 and 24, Township 11 North, Range 2 East, New Mexico Principal Meridian, City of Albuquerque, Bernalillo County, New Mexico, being and comprising all of Parcel H-17A-1B2 and Parcel H-18A-1 of Plat of RIVERVIEW PARCELS H-17A-1B1, H-17A-1B2, H-18A-1 and H-24C-1, as the same is shown and designated on the plat thereof, filed in the office of the County Clerk of Bernalillo County, New Mexico on May 20, 1992 in Volume 92C, Folio 95 and being more particularly described by New Mexico State Plane Grid Bearings (Central Zone) and ground distances as follows:

BEGINNING at the northeast corner of said Parcel H-18A-1, a point on the westerly boundary line of the Piedras Mercedes Dam, whence the ACS monument "R. Alameda B. No. 2" a standard Corps of Engineers brass tablet and iron concrete base, New Mexico State Plane Grid Coordinates for Central Zone: X=373,513.20 and Y=1,520,142.81) bears N70°15'41"E, a distance of 2509.21 feet and from said point of beginning running thence along the easterly boundary line of said Parcel H-18A-1 and also along said Piedras Mercedes Dam boundary line:
S36°53'05"W, a distance of 46.46 feet to a point; thence,
S53°06'08"E, a distance of 319.96 feet to a point; thence,
S00°00'40"E, a distance of 409.93 feet to a point on the westerly right-of-way line of Butterfield Trails, N.W., thence running along the easterly boundary line of said Parcel H-18A-1 and also along said right-of-way line:
S38°33'11"W, a distance of 20.98 feet to a point of curvature (non-tangent); thence,
123.15 feet along the arc of a curve to the left having a radius of 45.00 feet and a chord which bears S56°46'28"W, a distance of 88.16 feet to a point of reverse curvature; thence,
26.26 feet along the arc of a curve to the right having a radius of 25.00 feet and a chord which bears S08°27'48"W, a distance of 25.07 feet to a point of tangency; thence,
S38°33'11"W, a distance of 312.15 feet to a point of curvature; thence,
39.27 feet along the arc of a curve to the right having a radius of 25.00 feet and a chord which bears S83°33'11"W, a distance of 35.36 feet to a point of tangency on the southerly boundary line of said Parcel H-18A-1 and also being a point on the northerly right-of-way line of Calle Nortena N.W., thence running along the southerly boundary line of said Parcel H-18A-1 and also along said right-of-way line:
N51°26'49"W, a distance of 81.64 feet to a point of curvature; thence,
75.18 feet along the arc of a curve to the right having a radius of 975.00 feet and a chord which bears N49°14'17"W, a distance of 75.16 feet to a point of tangency; thence,
N47°01'45"W, a distance of 543.28 feet to a point of curvature; thence,
39.27 feet along the arc of a curve to the right having a radius of 25.00 feet and a chord which bears N02°01'45"W, a distance of 35.36 feet to a point of tangency on the westerly boundary line of said Parcel H-18A-1 and also being a point on the easterly right-of-way line of Rancho Sereno Drive, thence running along the westerly boundary line of said Parcel H-18A-1 and also along said right-of-way line:
N42°58'15"E, a distance of 94.26 feet to a point of curvature; thence,
244.58 feet along the arc of a curve to the left having a radius of 325.00 feet and a chord which bears N21°24'42"E, a distance of 238.85 feet to a point of tangency; thence,
N00°08'52"W, a distance of 157.21 feet to a point of tangency; thence,
S89°51'08"W, a distance of 50.00 feet to a point on the easterly boundary line of said Parcel H-17A-1B2 and also being a point on the westerly right-of-way line of said Rancho Sereno Drive, thence running along the easterly boundary line of said Parcel H-17A-1B2 and also along said right-of-way line:
S00°08'52"E, a distance of 157.21 feet to a point of curvature; thence,
206.95 feet along the arc of a curve to the right having a radius of 275.00 feet and a chord which bears S21°24'42"E, a distance of 202.11 feet to a point of tangency; thence,
S42°58'15"W, a distance of 94.26 feet to a point of curvature; thence,
39.27 feet along the arc of a curve to the right having a radius of 25.00 feet and a chord which bears S87°58'15"W, a distance of 35.36 feet to a point of tangency on the southerly boundary line of said Parcel H-17A-1B2 and also being a point on the northerly right-of-way line of Calle Nortena N.W., thence running along the southerly boundary line of said Parcel H-17A-1B2 and also along said right-of-way line:
N47°01'45"W, a distance of 208.79 feet to a point of curvature; thence,
236.40 feet along the arc of a curve to the left having a radius of 470.00 feet and a chord which bears N61°26'18"W, a distance of 233.92 feet to a point of reverse curvature; thence,
159.75 feet along the arc of a curve to the right having a radius of 280.00 feet and a chord which bears N50°30'10"W, a distance of 157.60 feet to a point of tangency; thence,
N43°09'28"W, a distance of 178.51 feet to a point of curvature; thence,
260.72 feet along the arc of a curve to the left having a radius of 425.00 feet and a chord which bears N60°43'55"W, a distance of 256.65 feet to a point of reverse curvature; thence,
29.14 feet along the arc of a curve to the right having a radius of 291.00 feet and a chord which bears N75°26'16"W, a distance of 29.13 feet to a point of reverse curvature; thence,
42.34 feet along the arc of a curve to the left having a radius of 159.00 feet and a chord which bears N10°28'47"W, a distance of 52.36 feet to a point of tangency; thence,
88.39 feet along the arc of a curve to the left having a radius of 431.00 feet and a chord which bears S86°17'56"W, a distance of 88.23 feet to a point of reverse curvature; thence,
46.35 feet along the arc of a curve to the right having a radius of 30.00 feet and a chord which bears N55°18'41"W, a distance of 41.88 feet to a point of compound curvature on the westerly boundary line of said Parcel H-17A-1B2 and also being a point on the easterly right-of-way line of Golf Course Road, N.W., thence running along the westerly boundary line of said Parcel H-17A-1B2 and also along said right-of-way line:
11.73 feet along the arc of a curve to the right having a radius of 1047.00 feet and a chord which bears N10°43'32"W, a distance of 11.73 feet to a point of compound curvature; thence,
53.76 feet along the arc of a curve to the right having a radius of 140.00 feet and a chord which bears N00°35'49"E, a distance of 53.43 feet to a point of reverse curvature; thence,
18.93 feet along the arc of a curve to the left having a radius of 60.00 feet and a chord which bears N02°33'32"E, a distance of 18.85 feet to a point of reverse curvature; thence,
40.00 feet along the arc of a curve to the right having a radius of 1035.00 feet and a chord which bears N05°22'24"W, a distance of 40.00 feet to a point of tangency; thence,
N85°44'01"E, a distance of 5.00 feet to a point; thence,
N83°42'36"W, a distance of 20.00 feet to a point; thence,
S86°50'47"W, a distance of 5.00 feet to a point of curvature (non-tangent); thence,
108.96 feet along the arc of a curve to the left having a radius of 60.00 feet and a chord which bears N12°12'19"W, a distance of 18.88 feet to a point of reverse curvature; thence,
52.67 feet along the arc of a curve to the right having a radius of 140.00 feet and a chord which bears N10°28'47"W, a distance of 52.36 feet to a point of tangency; thence,
N00°17°50"E, a distance of 125.69 feet to the northwest corner of said Parcel H-17A-1B2, a point on the southerly right-of-way line of the Piedras Mercedes Arroyo, thence running along the northerly boundary line of said Parcel H-17A-1B2 and also along said southerly right-of-way line:
S75°57'43"E, a distance of 282.36 feet to a point of curvature; thence,
117.91 feet along the arc of a curve to the right having a radius of 2233.30 feet and a chord which bears S74°26'59"E, a distance of 117.90 feet to a point of compound curvature; thence,
152.39 feet along the arc of a curve to the right having a radius of 1101.65 feet and a chord which bears S68°58'28"E, a distance of 152.27 feet to a point of compound curvature; thence,
117.91 feet along the arc of a curve to the right having a radius of 2233.30 feet and a chord which bears S63°29'56"E, a distance of 117.90 feet to a point of reverse curvature; thence,
127.33 feet along the arc of a curve to the left having a radius of 2030.00 feet and a chord which bears S63°47'00"E, a distance of 127.31 feet to a point of compound curvature; thence,
194.37 feet along the arc of a curve to the left having a radius of 1030.00 feet and a chord which bears S70°59'11"E, a distance of 194.08 feet to a point of compound curvature; thence,
127.33 feet along the arc of a curve to the left having a radius of 2030.00 feet and a chord which bears S78°11'22"E, a distance of 127.31 feet to a point of tangency; thence,
S79°59'11"E, a distance of 255.62 feet to a point of curvature; thence,
125.29 feet along the arc of a curve to the right having a radius of 2956.10 feet and a chord which bears S78°46'20"E, a distance of 125.28 feet to a point of compound curvature; thence,
259.01 feet along the arc of a curve to the right having a radius of 1463.05 feet and a chord which bears S72°29'11"E, a distance of 258.67 feet to a point of compound curvature; thence,
60.72 feet along the arc of a curve to the right having a radius of 2956.10 feet and a chord which bears S66°49'35"E, a distance of 60.72 feet to the point and place of beginning.

Tract contains 25.9766 acres, more or less.

PLAT OF
RANCHO SERENO SUBDIVISION
UNIT 2
ALBUQUERQUE, NEW MEXICO
SEPTEMBER, 1993

APPROVALS

PLAT NUMBER _____

PLANNING DIRECTOR _____ DATE _____

CITY ENGINEER _____ DATE _____

A.M.A.C. _____ DATE _____

TRAFFIC ENGINEER _____ DATE _____

CITY SURVEYOR _____ DATE _____

PROPERTY MANAGEMENT _____ DATE _____

UTILITY DEVELOPMENT DEPARTMENT _____ DATE _____

PARKS AND RECREATION DEPARTMENT _____ DATE _____

PUBLIC SERVICE COMPANY OF NEW MEXICO _____ DATE _____

U.S. WEST COMMUNICATIONS _____ DATE _____

GAS COMPANY OF NEW MEXICO _____ DATE _____

THIS IS TO CERTIFY THAT TAXES ARE CURRENT AND PAID

ON UPON _____

PROPERTY OWNER OF RECORD _____

BERNALILLO COUNTY TREASURER'S OFFICE _____ DATE _____

FREE CONSENT AND DEDICATION

The foregoing Replat of those certain tracts of land situate within Sections 13 and 24, Township 11 North, Range 2 East, New Mexico Principal Meridian, City of Albuquerque, Bernalillo County, New Mexico, being and comprising all of Parcel H-17A-1B2 and Parcel H-18A-1 of Plat of RIVERVIEW PARCELS H-17A-1B1, H-17A-1B2, H-18A-1 and H-24C-1, as the same is shown and designated on the plat thereof, filed in the office of the County Clerk of Bernalillo County, New Mexico on May 20, 1992 in Volume 92C, Folio 95 and now heron comprising RANCHO SERENO SUBDIVISION, UNIT 2 is with free consent and in accordance with the desires of the undersigned owner(s) and/or proprietor(s) thereof, and said owner(s) and/or proprietor(s) do hereby dedicate additional public street and public access right-of-way to the City of Albuquerque in fee simple with warranty covenants and do hereby grant all access, utility and drainage easements shown hereon including the right to construct, operate, inspect, and maintain facilities therein and all public utility easements shown hereon for the common and joint use of gas, electrical power and communication services for buried distribution lines, conduits, and pipes for underground utilities where shown or indicated, and including the right to trim interfering trees and shrubs. Said owner(s) and/or proprietor(s) do hereby consent to all of the foregoing and do hereby certify that this subdivision is their free act and deed.

Richard Mallett
Richard Mallett, President
CENTEX REAL ESTATE CORPORATION

State of New Mexico)
County of Bernalillo)

This instrument was acknowledged before me on 10th day of Sept., 1993 by Richard Mallett, President of CENTEX REAL ESTATE CORPORATION.

My Commission Expires 6/24/96 Frederic J. Valdez
Notary Public

SURVEYOR'S CERTIFICATION

I, Thomas G. Klingenhagen, a registered Professional New Mexico Surveyor, certify that this plat was prepared by me or under my supervision, shows all easements of record, meets the minimum requirements for monumentation and surveys contained in the Albuquerque Subdivision Ordinance, and is true and accurate to the best of my knowledge and belief.

Thomas G. Klingenhagen
Thomas G. Klingenhagen
New Mexico Surveyor 5978

Date: 9-13-93

Bohannon-Huston Inc.
Courtney J.
1500 Jefferson Street, N.E.
Albuquerque, New Mexico 87109


JOB NO. 92287.B3



SHEET 1 OF 3 SHEETS

PLAT OF
RANCHO SERENO SUBDIVISION
UNIT 2
ALBUQUERQUE, NEW MEXICO
SEPTEMBER, 1993

CURVE DATA									
NUMBER	ARC	RADIUS	DELTA	CHORD	CHORD BEARING	TANGENT	NUMBER	ARC	RADIUS
C1	123.15	45.00	156°48'08"	88.16	S56°46'29"W	219.25	C113	44.20	25.00
C2	26.26	25.00	60°10'46"	25.07	S08°27'48"W	14.49	C114	110.52	280.00
C3	59.27	25.00	120°00'00"	50.00	S00°00'00"W	25.00	C115	44.20	25.00
C4	75.18	975.00	4°25'04"	75.16	N49°14'17"W	37.61	C116	95.61	525.00
C5	39.27	25.00	90°00'00"	35.36	N02°01'45"W	25.00	C117	5.30	345.00
C6	244.58	325.00	43°07'07"	238.85	N21°24'42"E	128.41	C118	50.23	2936.10
C7	206.95	325.00	43°07'07"	203.17	N21°24'42"E	108.65	C119	22.52	1443.05
C8	39.27	25.00	90°00'00"	35.36	S07°58'15"W	25.00	C120	45.33	345.00
C9	236.40	470.00	28°49'07"	233.92	N61°26'18"W	120.76	C121	53.31	1443.05
C10	159.75	480.00	32°41'32"	157.60	N59°30'15"W	82.12	C122	49.30	345.00
C11	260.72	425.00	35°08'55"	256.65	N60°43'55"W	134.61	C123	53.31	1443.05
C12	29.14	291.00	5°44'14"	29.13	N75°26'16"W	14.58	C124	6.72	343.00
C13	42.34	159.00	15°15'25"	42.21	N80°11'51"W	21.30	C125	5.01	345.00
C14	98.38	44.00	11°45'00"	98.23	S06°17'56"W	44.35	C126	65.73	1443.05
C15	46.35	30.00	88°31'46"	41.88	N55°18'41"W	29.24	C127	46.65	343.00
C16	11.73	1047.00	0°38'32"	11.73	N10°43'32"W	5.87	C128	12.46	1443.05
C17	53.76	140.00	22°00'10"	53.76	N77°39'46"W	27.30	C129	46.65	343.00
C18	18.93	60.00	18°04'44"	18.85	N03°33'32"E	9.55	C130	11.70	343.00
C19	40.00	1035.00	2°12'52"	40.00	N05°22'24"W	20.00	C131	115.70	40.00
C20	18.96	60.00	18°06'11"	18.88	N12°12'19"W	9.56	C132	57.96	297.00
C21	52.67	140.00	21°33'14"	52.36	N10°28'47"W	26.85	C133	6.12	343.00
C22	117.91	2233.30	3°01'30"	117.90	S74°26'59"E	58.97	C134	44.29	40.00
C23	152.39	1101.65	7°55'33"	152.27	S68°58'28"E	76.32	C135	47.65	343.00
C24	117.91	2233.30	3°01'30"	117.90	S74°26'59"E	58.97	C136	29.21	370.00
C25	127.33	2030.00	3°35'38"	127.31	S63°47'00"E	63.69	C137	88.75	45.00
C26	194.37	1030.00	10°48'44"	194.08	S70°59'11"E	97.47	C138	30.41	98.00
C27	127.33	2030.00	3°35'38"	127.31	S78°11'22"E	63.69	C139	46.29	98.00
C28	259.01	1463.05	10°08'36"	258.67	S72°29'11"E	129.84	C140	47.74	98.00
C29	60.72	2956.10	1°10'37"	60.72	S66°49'35"E	30.36	C141	19.11	98.00
C30	109.86	458.00	33°32'05"	109.86	S05°03'56"E	55.03	C142	67.69	297.00
C31	268.08	458.00	33°32'05"	264.25	S16°37'10"W	137.99	C143	33.73	481.00
C32	52.63	75.00	40°12'29"	51.56	S31°16'58"W	27.45	C144	34.00	481.00
C33	52.63	75.00	40°12'29"	51.56	S26°55'30"E	27.45	C145	48.02	481.00
C34	61.80	75.00	47°12'32"	60.06	S70°38'00"E	32.97	C146	48.02	481.00
C35	61.80	75.00	47°12'32"	60.06	N62°09'27"E	32.77	C147	48.02	481.00
C36	244.54	1053.52	13°17'58"	243.99	S79°42'21"E	122.82	C148	48.02	481.00
C37	158.58	285.00	31°28'43"	154.62	S57°19'00"E	80.32	C149	7.68	481.00
C38	143.18	285.00	31°28'43"	141.68	S55°58'10"E	73.13	C150	4.23	98.00
C39	86.83	285.00	17°27'24"	86.50	S79°05'23"E	43.76	C151	4.02	98.00
C40	11.59	285.00	2°19'47"	11.59	S88°58'59"E	5.79	C152	18.36	98.00
C41	20.65	320.00	4°40'18"	20.64	S87°45'43"E	13.33	C153	40.83	45.00
C42	70.69	320.00	12°39'25"	70.55	S79°02'52"E	35.49	C154	47.40	45.00
C43	109.56	320.00	19°37'01"	109.03	S62°54'39"E	55.32	C155	33.26	45.00
C44	159.04	320.00	28°28'34"	157.41	S67°20'25"E	81.20	C156	14.85	25.00
C45	91.05	320.00	10°07'07"	90.83	N24°51'20"E	45.65	C157	36.49	45.00
C46	111.38	148.00	43°07'07"	108.77	S21°24'42"E	58.48	C158	38.11	98.00
C47	30.45	297.00	5°52'26"	30.44	N56°02'21"E	15.24	C159	4.92	25.00
C48	70.69	320.00	12°39'25"	70.55	S79°02'52"E	35.49	C160	20.56	45.00
C49	109.56	320.00	19°37'01"	109.03	S62°54'39"E	55.32	C161	40.83	45.00
C50	159.04	320.00	28°28'34"	157.41	S67°20'25"E	81.20	C162	37.43	45.00
C51	91.05	320.00	10°07'07"	90.83	N24°51'20"E	45.65	C163	0.72	325.00
C52	146.26	1463.05	5°43'40"	146.19	S74°41'39"E	73.19	C164	5.63	98.00
C53	207.33	1443.05	8°13'56"	207.16	N73°26'31"E	103.85	C165	29.19	45.00
C54	50.23	2936.10	1°10'37"	50.23	N78°02'53"E	25.12	C166	49.85	325.00
C55	146.63	1081.65	7°55'33"	146.51	N68°58'28"E	74.93	C167	58.94	435.00
C56	116.85	2213.30	3°01'30"	116.84	N74°26'59"E	58.94	C168	5.09	98.00
C57	116.85	2213.30	3°01'30"	116.84	N74°26'59"E	58.94	C169	47.56	345.00
C58	39.27	25.00	90°00'00"	35.36	S45°38'52"E	25.00	C170	64.03	435.00
C59	46.22	25.00	105°55'20"	39.91	N52°48'48"E	33.13	C171	47.84	325.00
C60	7.81	297.00	1°30'22"	7.81	S73°28'23"E	3.90	C172	47.84	325.00
C61	109.56	297.00	19°37'01"	109.03	S62°54'39"E	55.35	C173	47.84	325.00
C62	39.27	25.00	90°00'00"	35.36	S08°06'08"E	25.00	C174	64.03	435.00
C63	143.55	98.00	83°55'33"	131.06	S05°03'56"E	88.13	C175	47.84	325.00
C64	84.41	98.00	10°37'58"	84.41	N24°51'20"E	45.65	C176	3.57	325.00
C65	18.64	25.00	42°42'32"	18.21	N72°48'05"E	9.77	C177	2.67	325.00
C66	76.17	52.00	83°55'33"	69.54	N05°03'56"E	46.76	C178	47.84	325.00
C67	25.00	25.00	90°00'00"	25.00	N45°08'52"E	25.00	C179	47.84	325.00
C68	142.98	343.00	23°53'02"	141.95	S69°38'11"E	72.54	C180	94.54	275.00
C69	164.73	40.00	23°57'32"	164.73	N19°33'28"E	75.29	C181	58.16	170.00
C70	29.40	25.00	67°22'48"	27.74	S76°09'10"W	16.67	C182	64.80	275.00
C71	88.41	297.00	17°03'18"	88.08	N61°37'47"W	44.53	C183	12.81	40.00
C72	117.44	343.00	19°37'01"	116.86	N62°54'39"E	59.30	C184	40.06	170.00
C73	104.94	345.00	17°25'43"	104.54	N81°26'01"E	52.88	C185	80.53	40.00
C74	19.27	25.00	90°00'00"	35.36	N45°08'52"E	25.00	C186	58.46	40.00
C75	37.34	25.00	85°34'56"	33.97	S04°14'17"E	23.14	C187	31.61	40.00
C76	85.69	52.00	94°25'04"	76.32	S85°45'43"W	56.17	C188	50.20	126.00
C77	72.98	52.00	84°20'57"	67.14	N06°49'16"W	43.96	C189	34.87	40.00
C78	281.52	481.00	33°32'05"	277.52	N16°37'10"E	144.92	C190	44.52	126.00
C79	254.60	435.00	33°32'05"	250.98	S16°37'10"W	131.06	C191	16.58	40.00
C80	10.72	98.00	6°15'57"	10.71	S03°15'55"W	5.36	C192	112.64	470.00
C81	19.58	25.00	44°54'15"	19.10	S49°34'21"W	10.33	C193	76.76	40.00
C82	123.85	45.00	15°41'33"	123.80	S06°49'16"E	228.33	C194	47.75	40.00
C83	19.58	25.00	44°54'15"	19.10	S63°12'55"E	10.33	C195	92.16	470.00
C84	10.72	98.00	6°15'57"	10.71	S43°53'47"E	5.36	C196	22.54	280.00
C85	19.58	25.00	44°54'15"	19.10	S49°34'21"W	10.33	C197	48.03	197.00
C86	19.77	25.00	45°19'15"	19.26	S37°34'23"E	10.44	C198	16.58	40.00
C87	124.60	45.00	15°41'33"	124.55	N85°45'43"E	238.73	C199	47.57	525.00
C88	19.77	25.00	45°19'15"	19.26	N29°05'50"E	10.44	C200	26.69	280.00
C89	22.59	98.00	13°12'16"	22.54	S21°37'55"E	11.34	C201	19.00	40.00
C90	39.27	25.00	90°00'00"	35.36	S44°51'08"W	25.00	C202	61.14	308.00
C91	89.79	260.00	19°47'10"	89.34	N80°15'17"W	45.35	C203	61.14	308.00
C92	15.98	25.00	45°19'15"	15.98	N29°05'50"E	10.44	C204	26.69	280.00
C93	169.22	308.00	31°28'43"	167.10	N57°19'00"W	86.80	C205	71.14	262.00
C94	193.24	1076.52	10°17'05"	192.98	N78°11'54"W	96.88	C206	13.46	262.00
C95	28.19	25.00	60°01'07"	28.01	N53°19'53"W	14.44	C207	54.97	425.00
C96	169.67	40.00	24°52'08"	168.20	S30°09'41"E	10.22	C208	68.20	262.00
C97	239.20	1030.52	13°17'58"	238.67	S79°42'21"E	120.14	C209	72.80	262.00
C98	143.94	262.00	31°28'43"	142.14	S57°19'00"W	73.84	C210	50.12	425.00
C99	154.73	108.00	13°12'16"	154.68	N21°37'55"E	79.04	C211	1030.52	3°58'42"E
C100	47.00	310.00	8°41'12"	46.95	S74°42'17"E	23.54	C212	61.83	425.00
C101	34.43	25.00	78°54'01"	31.77	S39°35'53"E	20.78	C213	70.86	1030.52
C102	94.82	126.00	43°07'07"	92.60	S21°24'42"E	49.57	C214	8.01	425.00
C103	10.06	25.00	43°41'22"	10.06	N45°08'52"E	10.02	C215	24.95	150.00
C104	186.67	40.00	26°22'54"	186.61	N47°01'45"E	41.87	C216	79.93	1030.52
C105	19.06	25.00	43°41'22"	18.61	N21°07'32"E	10.02	C217	17.39	159.00
C106	127.94	40.00	51°07'38"	127.94	N12°42'42"E	67.17	C218	39.70	40.00
C107	39.27	25.00	90°00'00"	35.36	S25°21'42"E	25.00	C219	41.77	40.00
C108	19.06	25.00	43°41'22"	18.61	S41°29'02"W	10.02	C220	48.69	431.00
C109	186.67	40.00	26°22'54"	186.61	S70°21'42"E	38.95	C221	65.80	40.00
C110	19.06	25.00	43°41'22"	18.61	N02°12'55"E	10.02	C222	13.95	40.00
C111	39.27	25.00	90°00'00"	35.36	N64°38'18"E	25.00	C223	62.10	40.00
C112	86.50	475.00	10°26'03"	86.38	S24°51'20"W	43.37	C224	52.10	1076.52

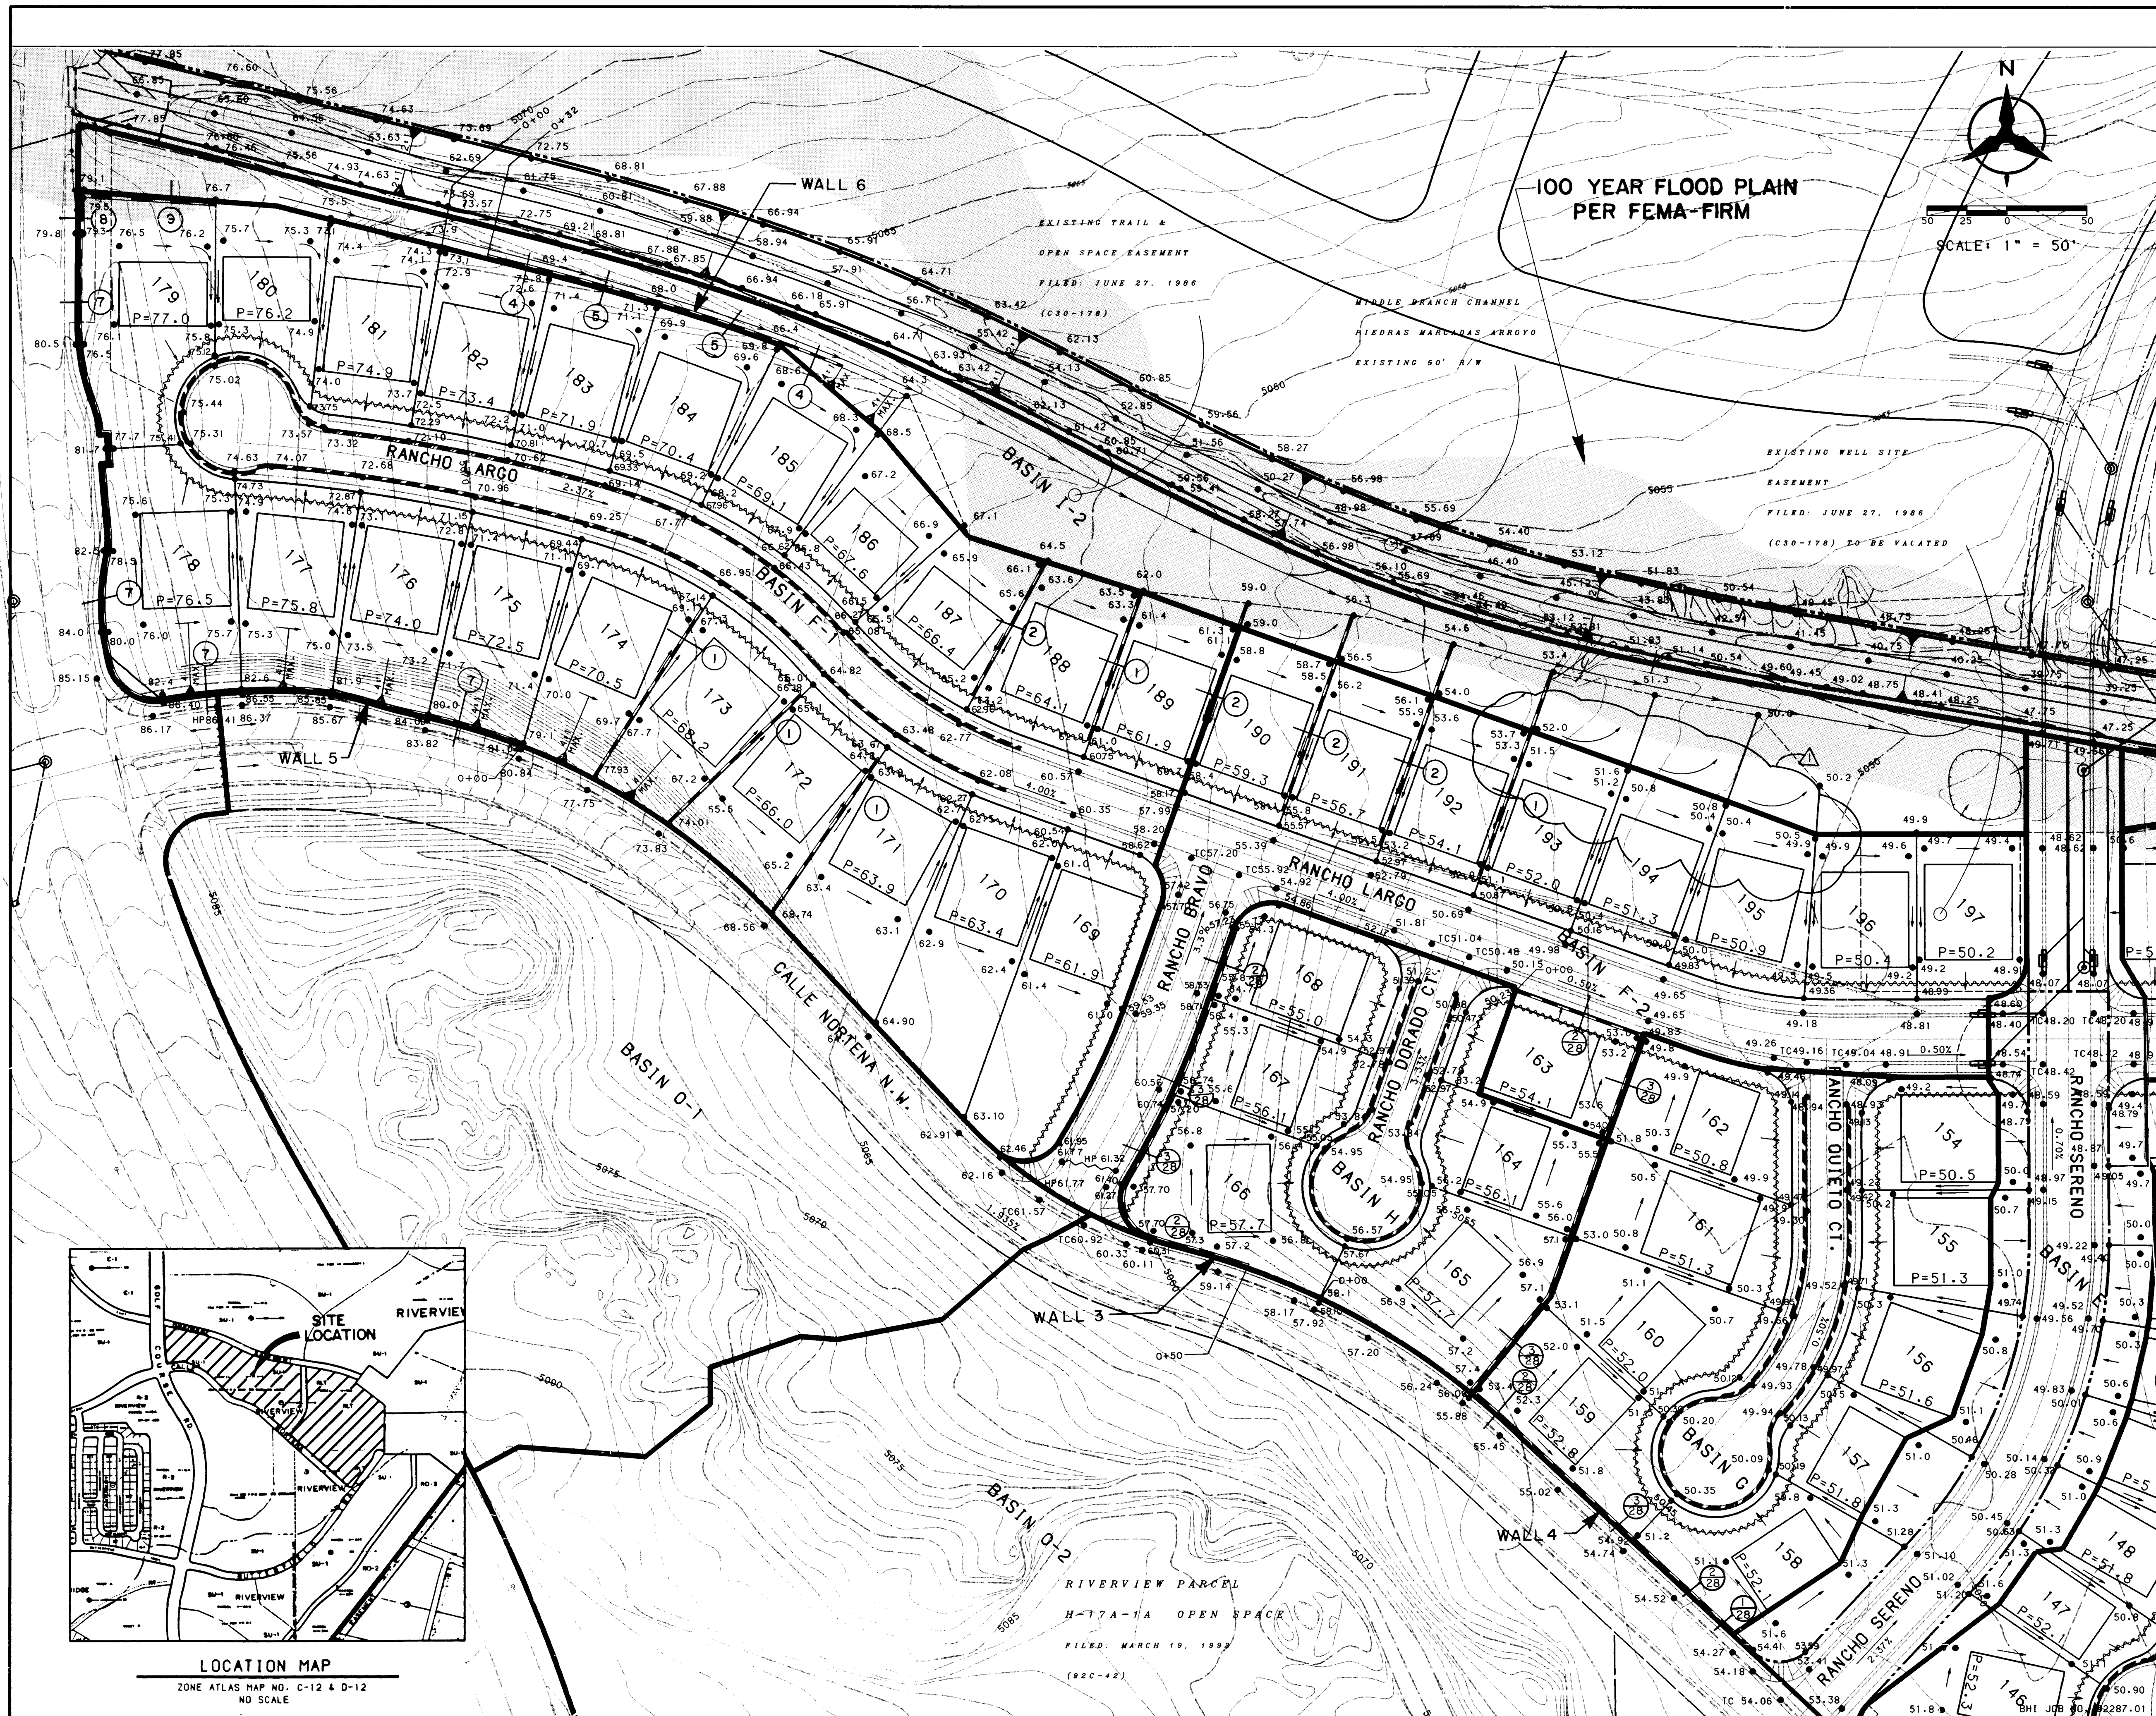

LEGEND

PROJECT BOUNDARY
EXISTING CONTOUR
EXISTING SPOT ELEVATION
PROPOSED SPOT ELEVATION
DIRECTION OF FLOW
BASIN BOUNDARY
EROSION CONTROL BERM
PROPOSED RETAINING WALL
EXISTING STORM DRAIN LINE
EXISTING STORM DRAIN MANHOLE
PROPOSED STORM DRAIN LINE
PROPOSED STORM DRAIN MANHOLE
STANDARD CURB & GUTTER
ROLL CURB & GUTTER
STREET FLOW
PIPE FLOW
SHEET FLOW

ALL FLOWS SHOWN ARE 100 YEAR EVENT

EROSION CONTROL PLAN

THE CONTRACTOR SHALL ENSURE THAT NO SOIL ERODES FROM THE LOTS INTO PUBLIC RIGHT-OF-WAY. THIS CAN BE ACHIEVED BY CONSTRUCTING TEMPORARY EROSION CONTROL BERMS AS PER DETAIL THIS SHEET AND WETTING THE SOIL REGULARLY TO KEEP IT FROM BLOWING.

LEGAL DESCRIPTION

RIVERVIEW TRACT H-18A-1
RIVERVIEW TRACT H-17A-1B2

EROSION CONTROL BERM

NO SCALE

A BERM WITH THE DIMENSIONS SHOWN SHALL BE MAINTAINED DURING CONSTRUCTION UNTIL COMPLETION OF INDIVIDUAL HOMES WITHIN THE PROJECT.

GENERAL GRADING NOTES:

- THE CONTRACTOR MUST OBTAIN A TOPSOIL DISTURBANCE PERMIT FROM THE CITY OF ALBUQUERQUE, ENVIRONMENTAL HEALTH DIV., PRIOR TO CONSTRUCTION.
- THE CONTRACTOR IS TO REFER TO THE EARTHWORK SPECIFICATIONS NOTED IN THE GEOTECHNICAL INVESTIGATION REPORT PREPARED BY VINEYARD AND ASSOCIATES, DATED JUNE 16, 1993 AND SUPPLIED BY THE OWNER.
- THE CONTRACTOR SHALL CONFORM TO ALL CITY, COUNTY, STATE AND FEDERAL DUST CONTROL MEASURES AND REQUIREMENTS AND WILL BE RESPONSIBLE FOR PREPARING AND OBTAINING ALL NECESSARY APPLICATIONS, PERMITS AND APPROVALS.

APPROVED FOR ROUGH GRADING (± 1')

C. E. Allen 7/3/93
A.M.A.F.C.A. DATE

APPROVED FOR ROUGH GRADING (± 1')


William Allen 07-07-93
HYDROLOGY ENGINEER DATE


**CITY OF ALBUQUERQUE
PUBLIC WORKS DEPARTMENT
ENGINEERING GROUP**


**TITLE: RANCHO SERENO SUBDIVISION
UNIT II
FINAL GRADING & DRAINAGE PLAN**


APPROVALS	ENGINEER	DATE	APPROVALS	ENGINEER	DATE
DRG CHAIRMAN	Billy Smith	10-07-93	WATER	N/A RWK	9-9-93
TRANS. DEV.	N/A RWK	9-09-93	WASTE WATER	N/A RWK	9-09-93
HYDROLOGY	W. Allen	07/07/93	A.M.A.F.C.A.	C. E. Allen	7/3/93

PROJECT NO.	4569.93	MAP C-12 NO. D-12	SHEET 4 OF 28
-------------	---------	-------------------	---------------

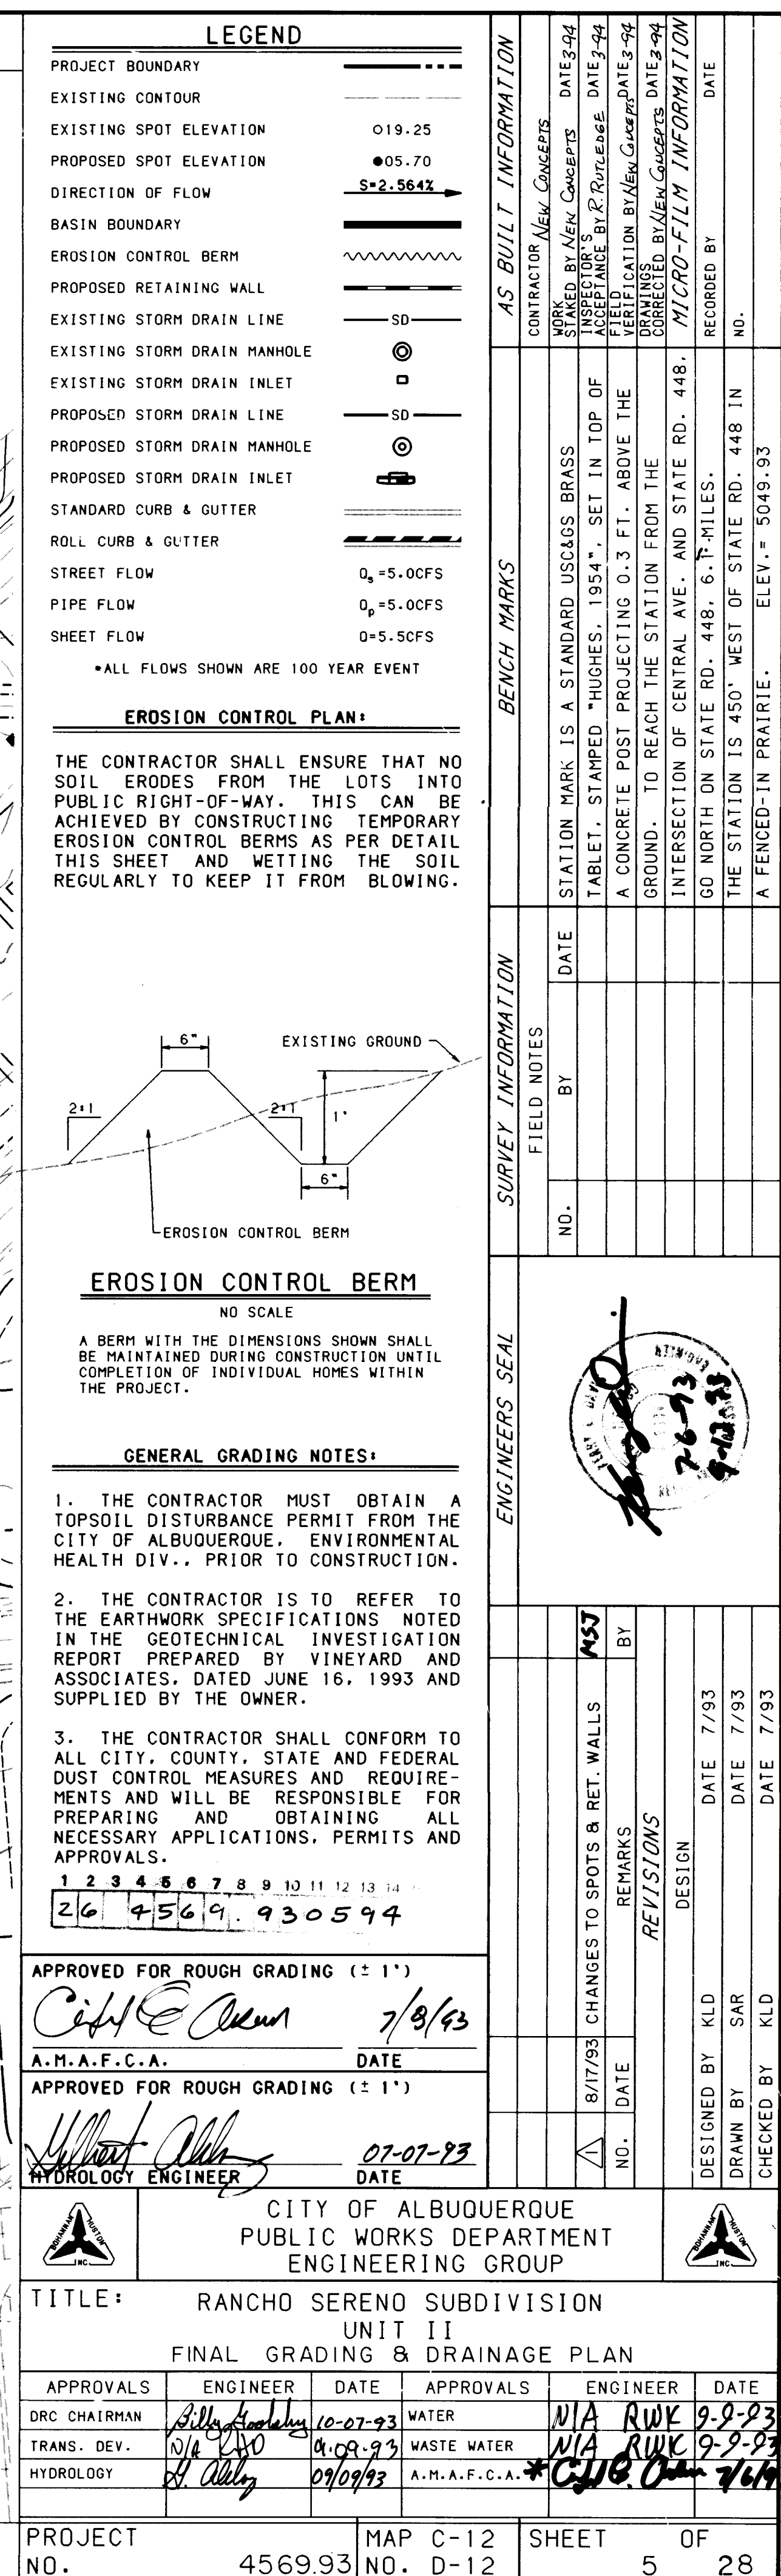


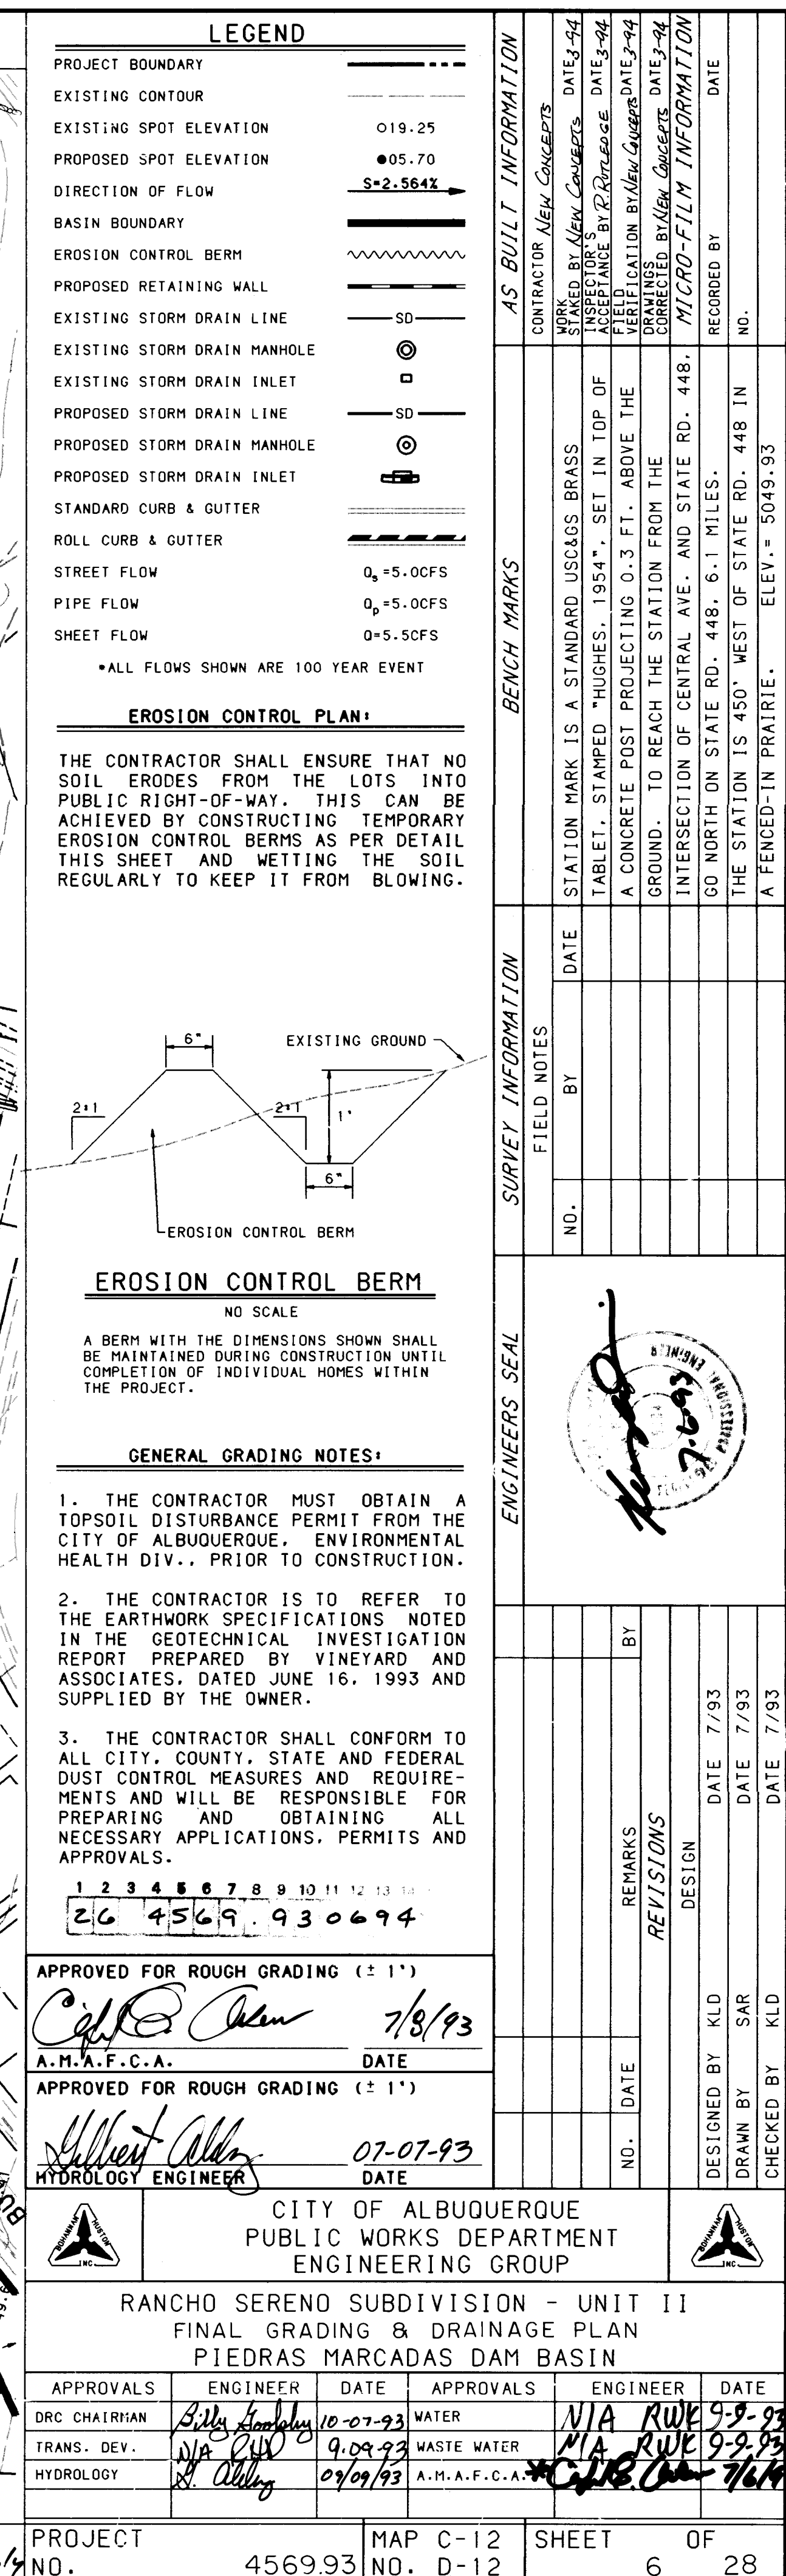

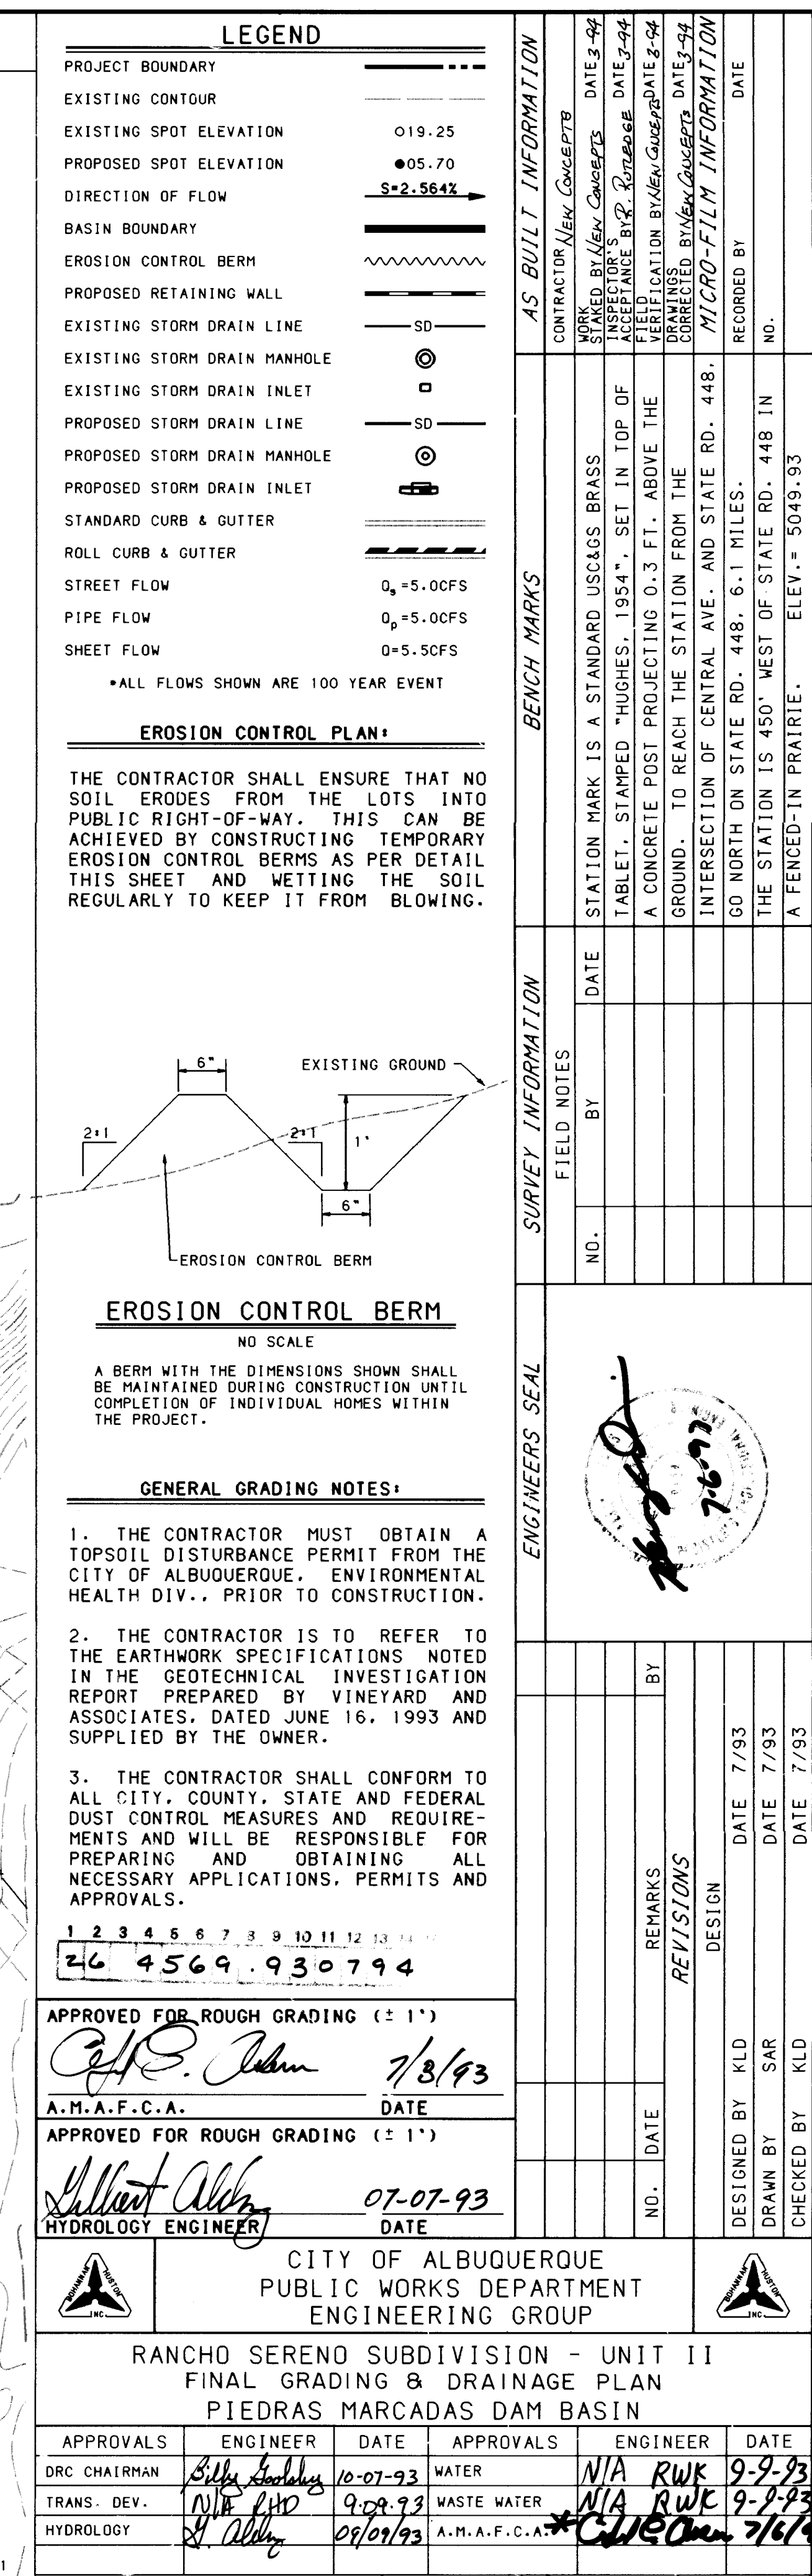


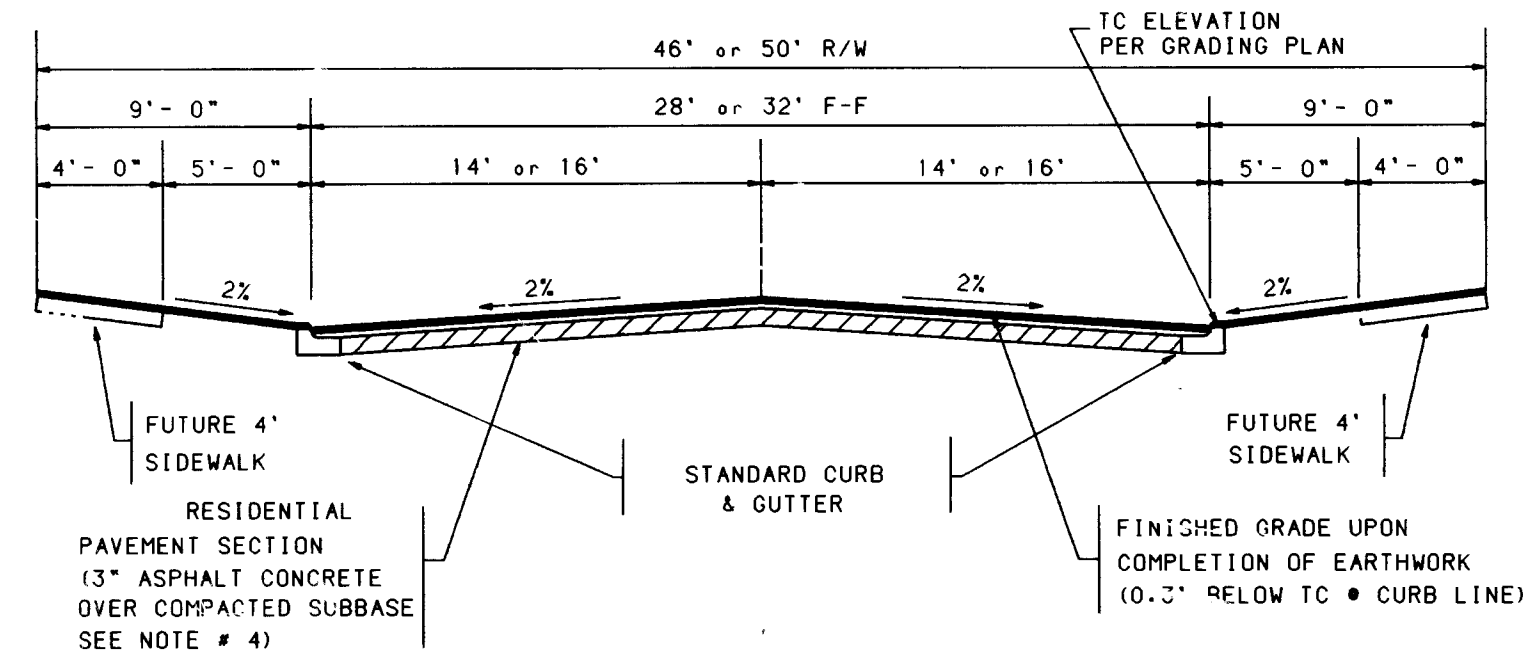


TYPICAL STREET SECTION #1 (STD CURB)
NO SCALE

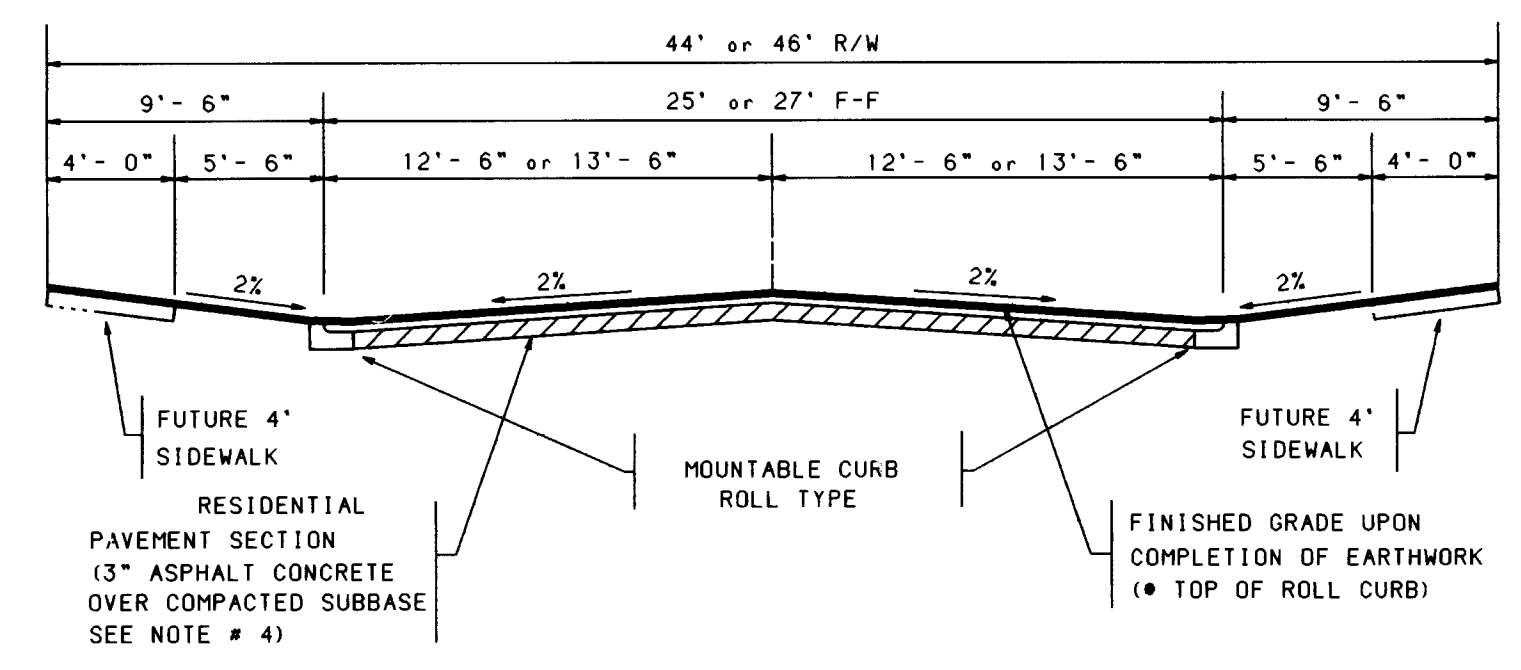


TYPICAL STREET SECTION #2 (ROLL CURB)
NO SCALE

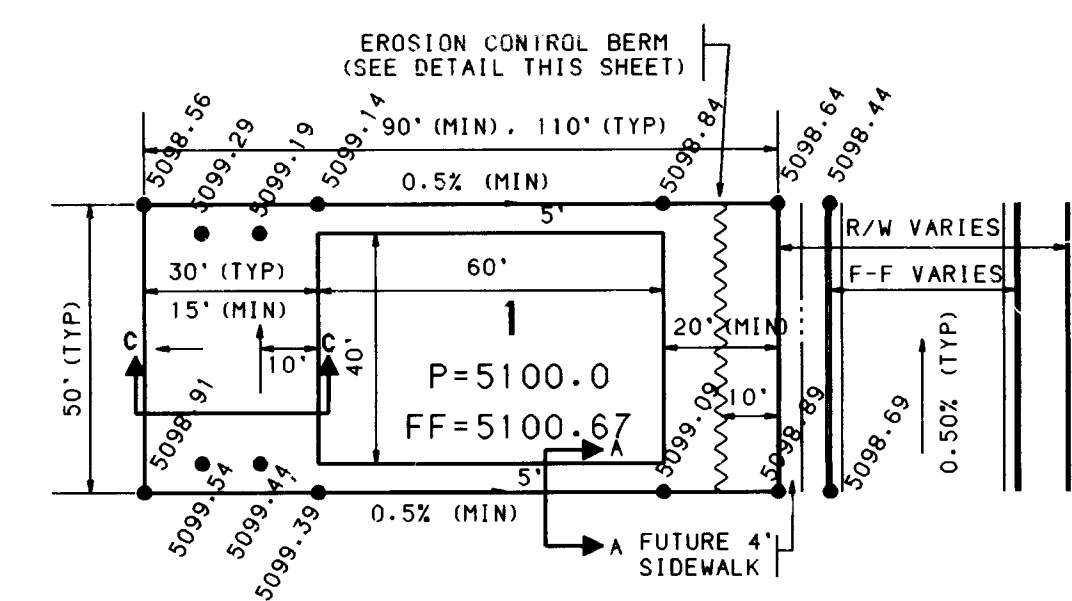


TYPICAL LOT GRADING PLAN
NO SCALE
(TYPICAL FOR SPLIT DRAINED LOTS 86-153)

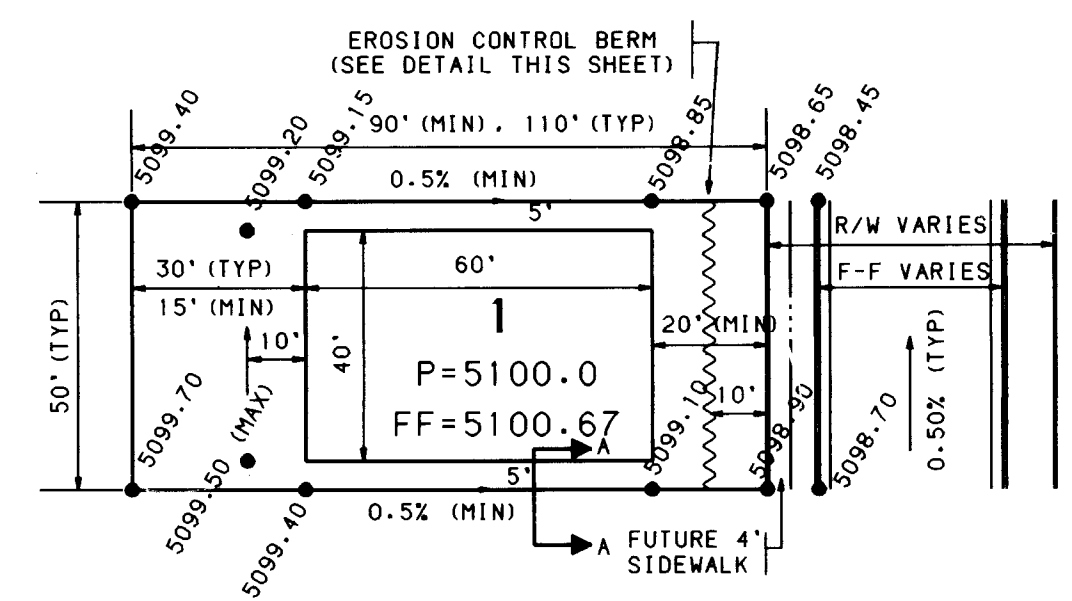


TYPICAL LOT GRADING PLAN
NO SCALE
(TYPICAL FOR FRONT DRAINED LOTS 86-153)

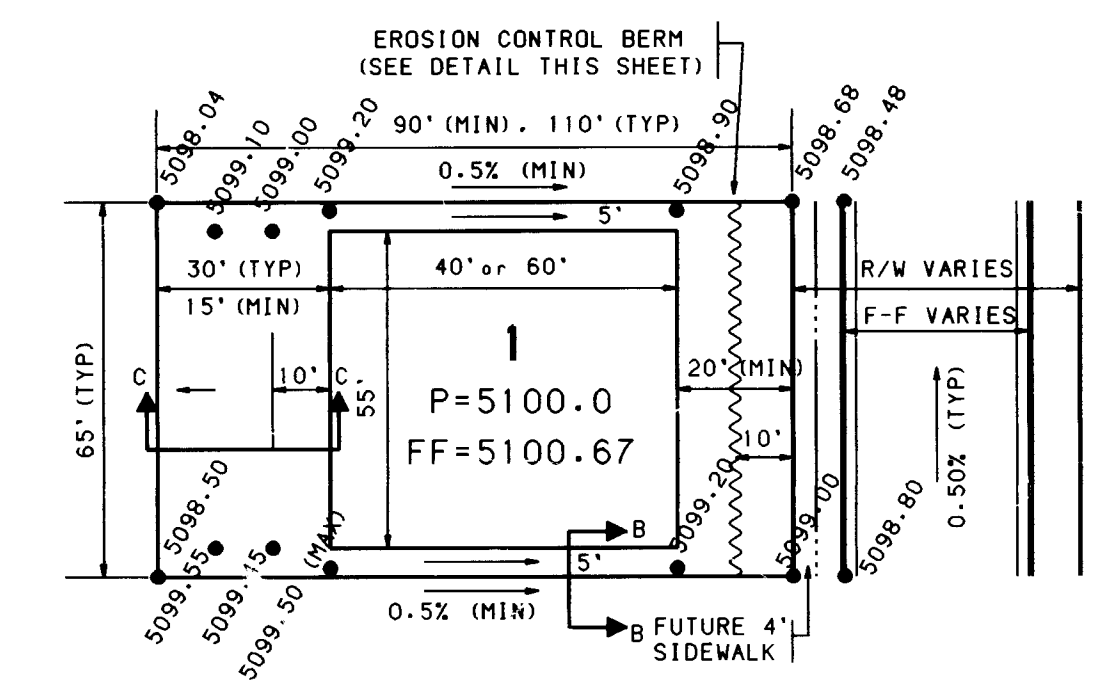


TYPICAL LOT GRADING PLAN
NO SCALE
(TYPICAL FOR SPLIT DRAINED LOTS 154-197)

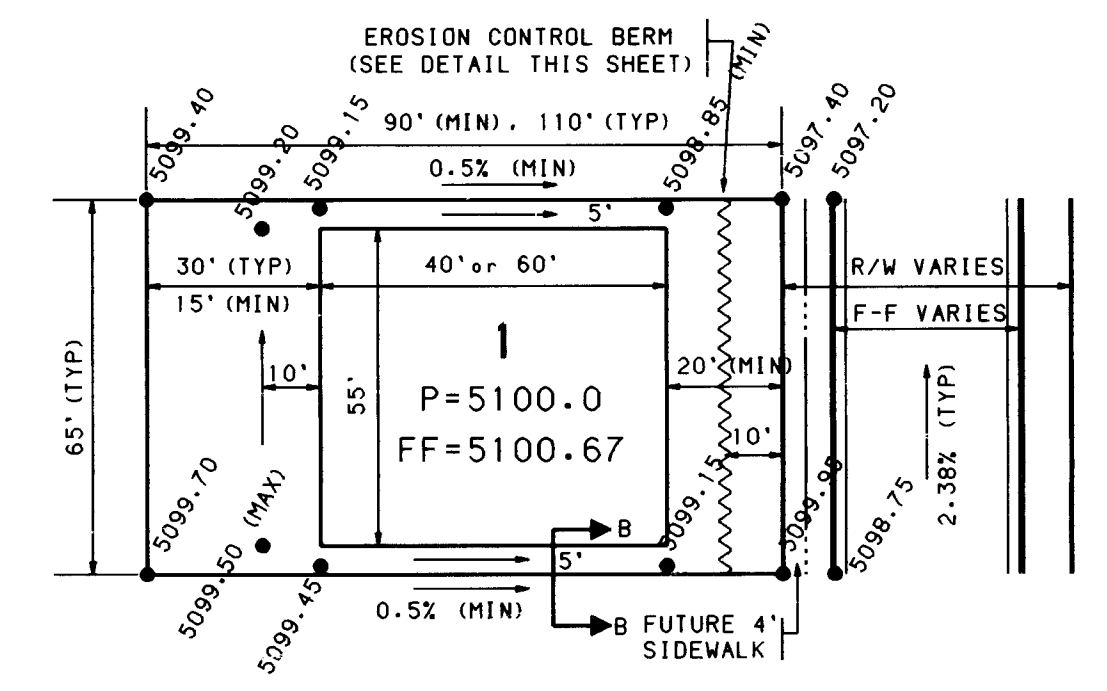


TYPICAL LOT GRADING PLAN
NO SCALE
(TYPICAL FOR FRONT DRAINED LOTS 154-197)

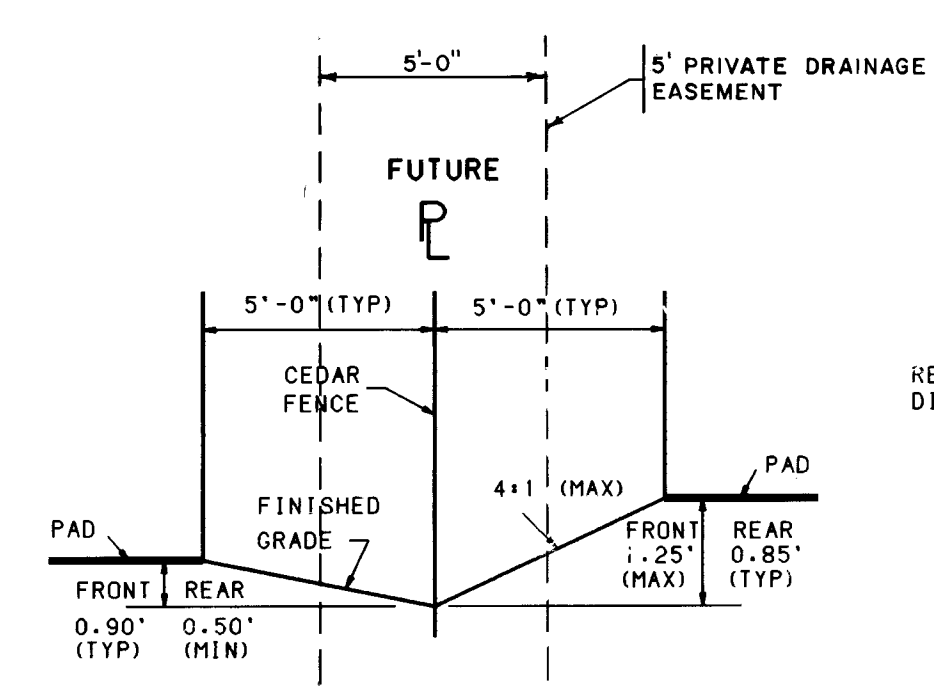


**SECTION A-A
TYPICAL SIDELOT GRADING PLAN**
NO SCALE
(TYPICAL FOR LOTS 86-153 EXCEPT WHERE NOTED OTHERWISE. SEE SECTION B-B FOR LOT DIFFERENCE > 0.5')

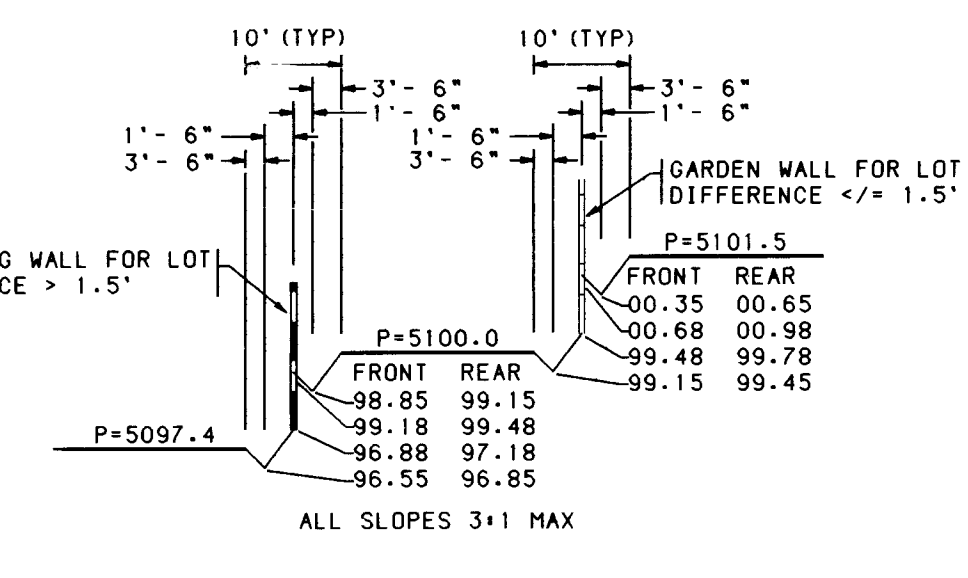


**SECTION B-B
TYPICAL SIDELOT GRADING PLAN**
NO SCALE
(TYPICAL FOR LOTS 154-197 AND LOTS 86-153, WHERE SPECIFICALLY NOTED)

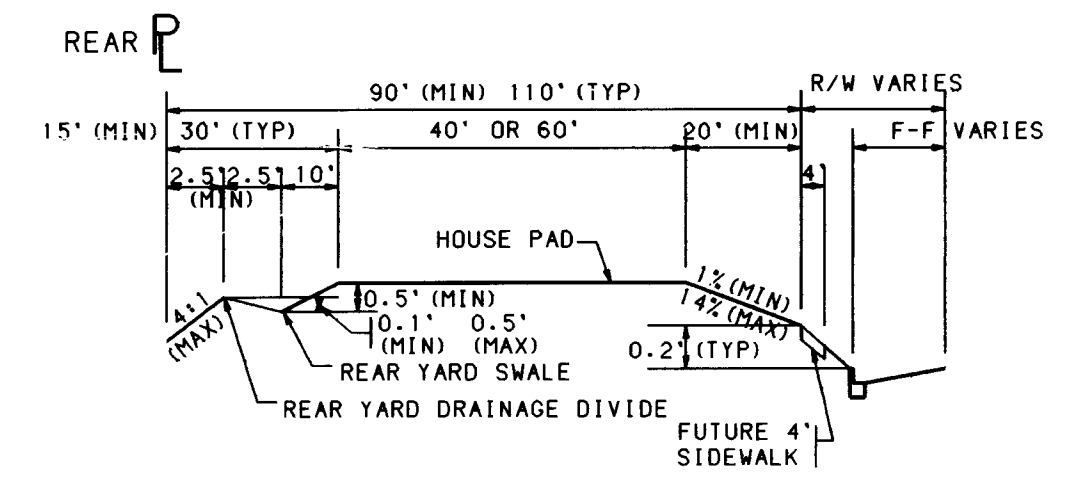

**SECTION C-C
TYPICAL LOT GRADING PROFILE**
NO SCALE
(TYPICAL FOR ALL SPLIT DRAINED LOTS (SPLIT DRAINAGE))

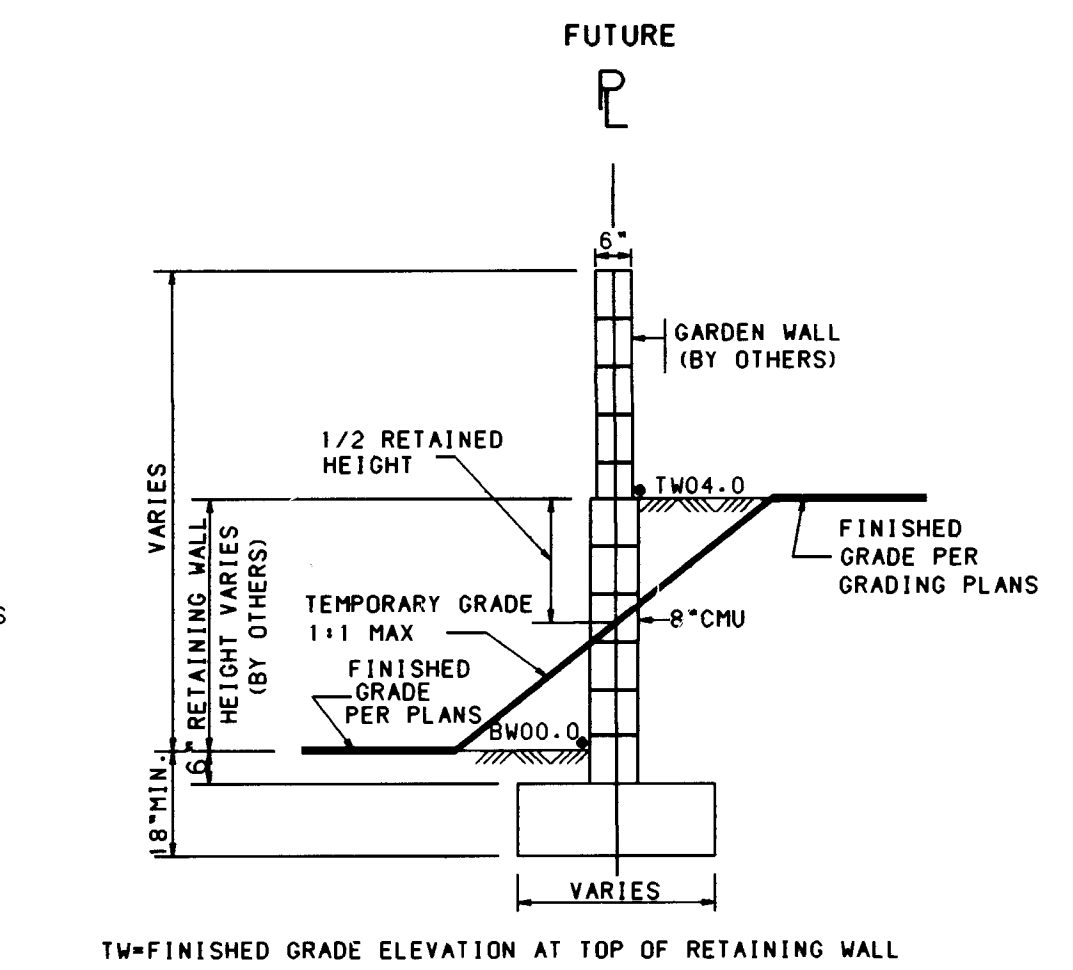

TYPICAL RETAINING WALL GRADING DETAIL
NO SCALE
(RETAINING HEIGHT IS TAKEN TO BE DIFFERENCE IN FINISHED GRADES ON LEFT AND RIGHT SIDE OF WALL)

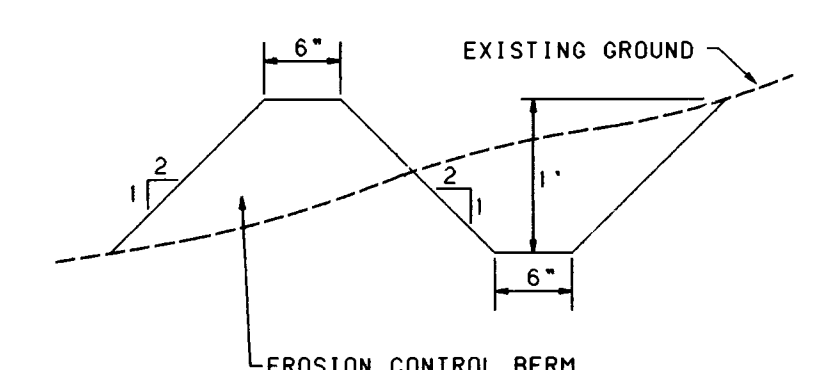

EROSION CONTROL BERM
NO SCALE
A BERM WITH THE DIMENSIONS SHOWN SHALL BE MAINTAINED DURING CONSTRUCTION UNTIL COMPLETION OF INDIVIDUAL HOMES WITHIN THE PROJECT.




- GENERAL GRADING NOTES:**
1. THE CONTRACTOR MUST OBTAIN A TOPSOIL DISTURBANCE PERMIT FROM THE CITY OF ALBUQUERQUE, ENVIRONMENTAL HEALTH DIV., PRIOR TO CONSTRUCTION.
 2. THE CONTRACTOR IS TO REFER TO THE EARTHWORK SPECIFICATIONS NOTED IN THE GEOTECHNICAL INVESTIGATION REPORT PREPARED BY VINEYARD AND ASSOCIATES, DATED JUNE 16, 1993 AND SUPPLIED BY THE OWNER.
 3. THE CONTRACTOR SHALL CONFORM TO ALL CITY, COUNTY, STATE AND FEDERAL DUST CONTROL MEASURES AND REQUIREMENTS AND WILL BE RESPONSIBLE FOR PREPARING AND OBTAINING ALL NECESSARY APPLICATIONS, PERMITS AND APPROVALS.
 4. FINISHED GRADE IN ROADWAY SECTIONS IS BASED UPON MATERIAL IMPORTED DURING EARTHWORK BEING ACCEPTABLE FOR ROADWAY SUBBASE.

- EROSION CONTROL PLAN:**
- THE CONTRACTOR SHALL ENSURE THAT NO SOIL ERODES FROM THE LOTS INTO PUBLIC RIGHT-OF-WAY. THIS CAN BE ACHIEVED BY CONSTRUCTING TEMPORARY EROSION CONTROL BERM AS PER DETAIL THIS SHEET AND WETTING THE SOIL REGULARLY TO KEEP IT FROM BLOWING.

- GENERAL GRADING NOTES:**
1. THE CONTRACTOR MUST OBTAIN A TOPSOIL DISTURBANCE PERMIT FROM THE CITY OF ALBUQUERQUE, ENVIRONMENTAL HEALTH DIV., PRIOR TO CONSTRUCTION.
 2. THE CONTRACTOR IS TO REFER TO THE EARTHWORK SPECIFICATIONS NOTED IN THE GEOTECHNICAL INVESTIGATION REPORT PREPARED BY VINEYARD AND ASSOCIATES, DATED JUNE 16, 1993 AND SUPPLIED BY THE OWNER.
 3. THE CONTRACTOR SHALL CONFORM TO ALL CITY, COUNTY, STATE AND FEDERAL DUST CONTROL MEASURES AND REQUIREMENTS AND WILL BE RESPONSIBLE FOR PREPARING AND OBTAINING ALL NECESSARY APPLICATIONS, PERMITS AND APPROVALS.

APPROVED FOR ROUGH GRADING (± 1")
[Signature] 7/8/93
A.M.A.F.C.A. DATE
APPROVED FOR ROUGH GRADING (± 1")
[Signature] 07-07-93
HYDROLOGY ENGINEER DATE

CITY OF ALBUQUERQUE PUBLIC WORKS DEPARTMENT ENGINEERING GROUP			
TITLE: RANCHO SERENO SUBDIVISION UNIT II GRADING & DRAINAGE DETAILS			
APPROVALS	ENGINEER	DATE	APPROVALS
DRC CHAIRMAN	<i>[Signature]</i>	10-27-93	WATER
TRANS. DEV.	<i>[Signature]</i>	9-08-93	WASTE WATER
HYDROLOGY	<i>[Signature]</i>	07/09/93	A.M.A.F.C.A.
DESIGNED BY	KLD	DATE	7/93
DRAWN BY	MSJ	DATE	7/93
CHECKED BY	KLD	DATE	7/93
PROJECT NO.	4569.93	MAP C-12	SHEET 8 OF 28
		NO. D-12	

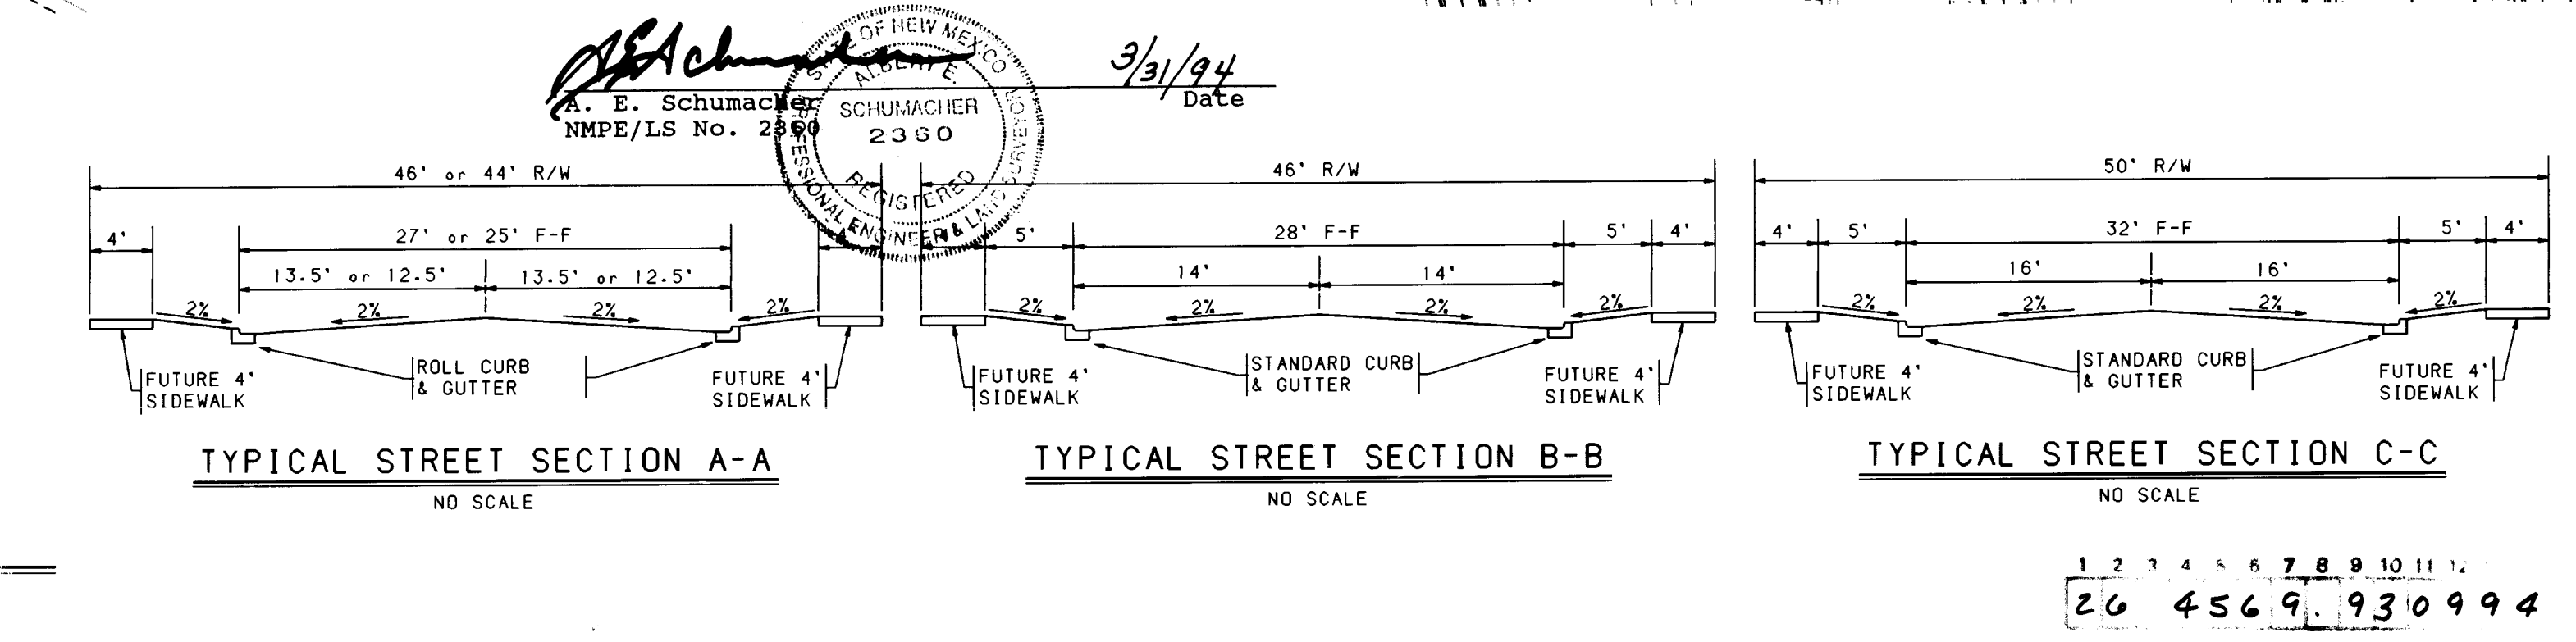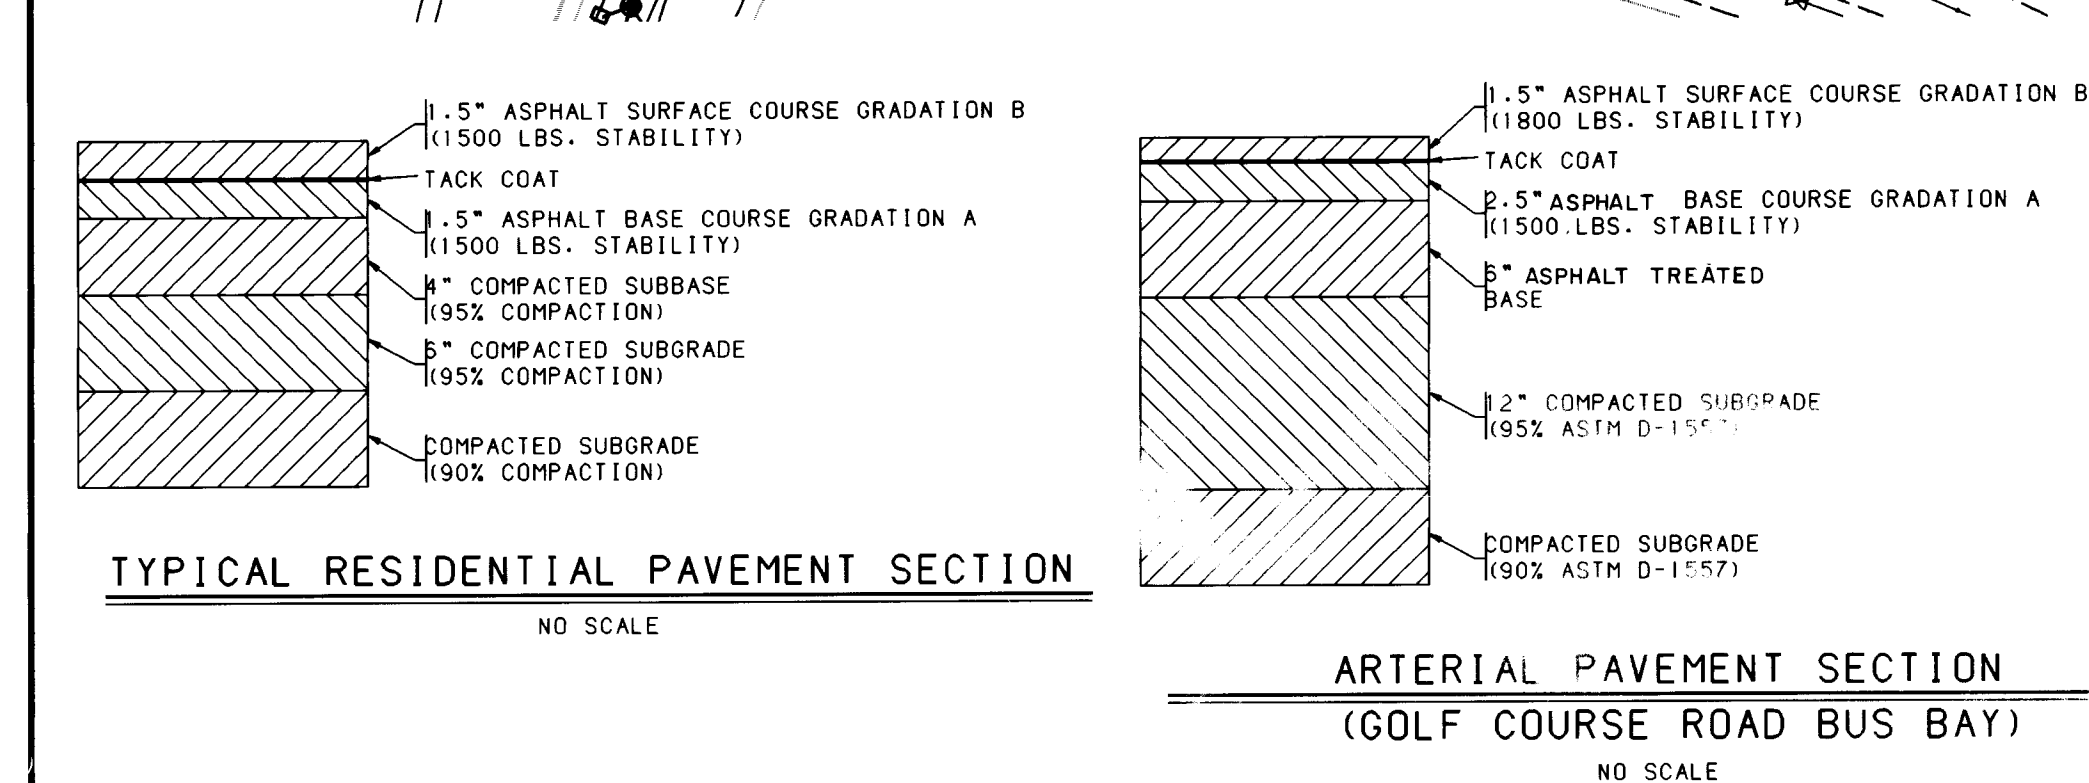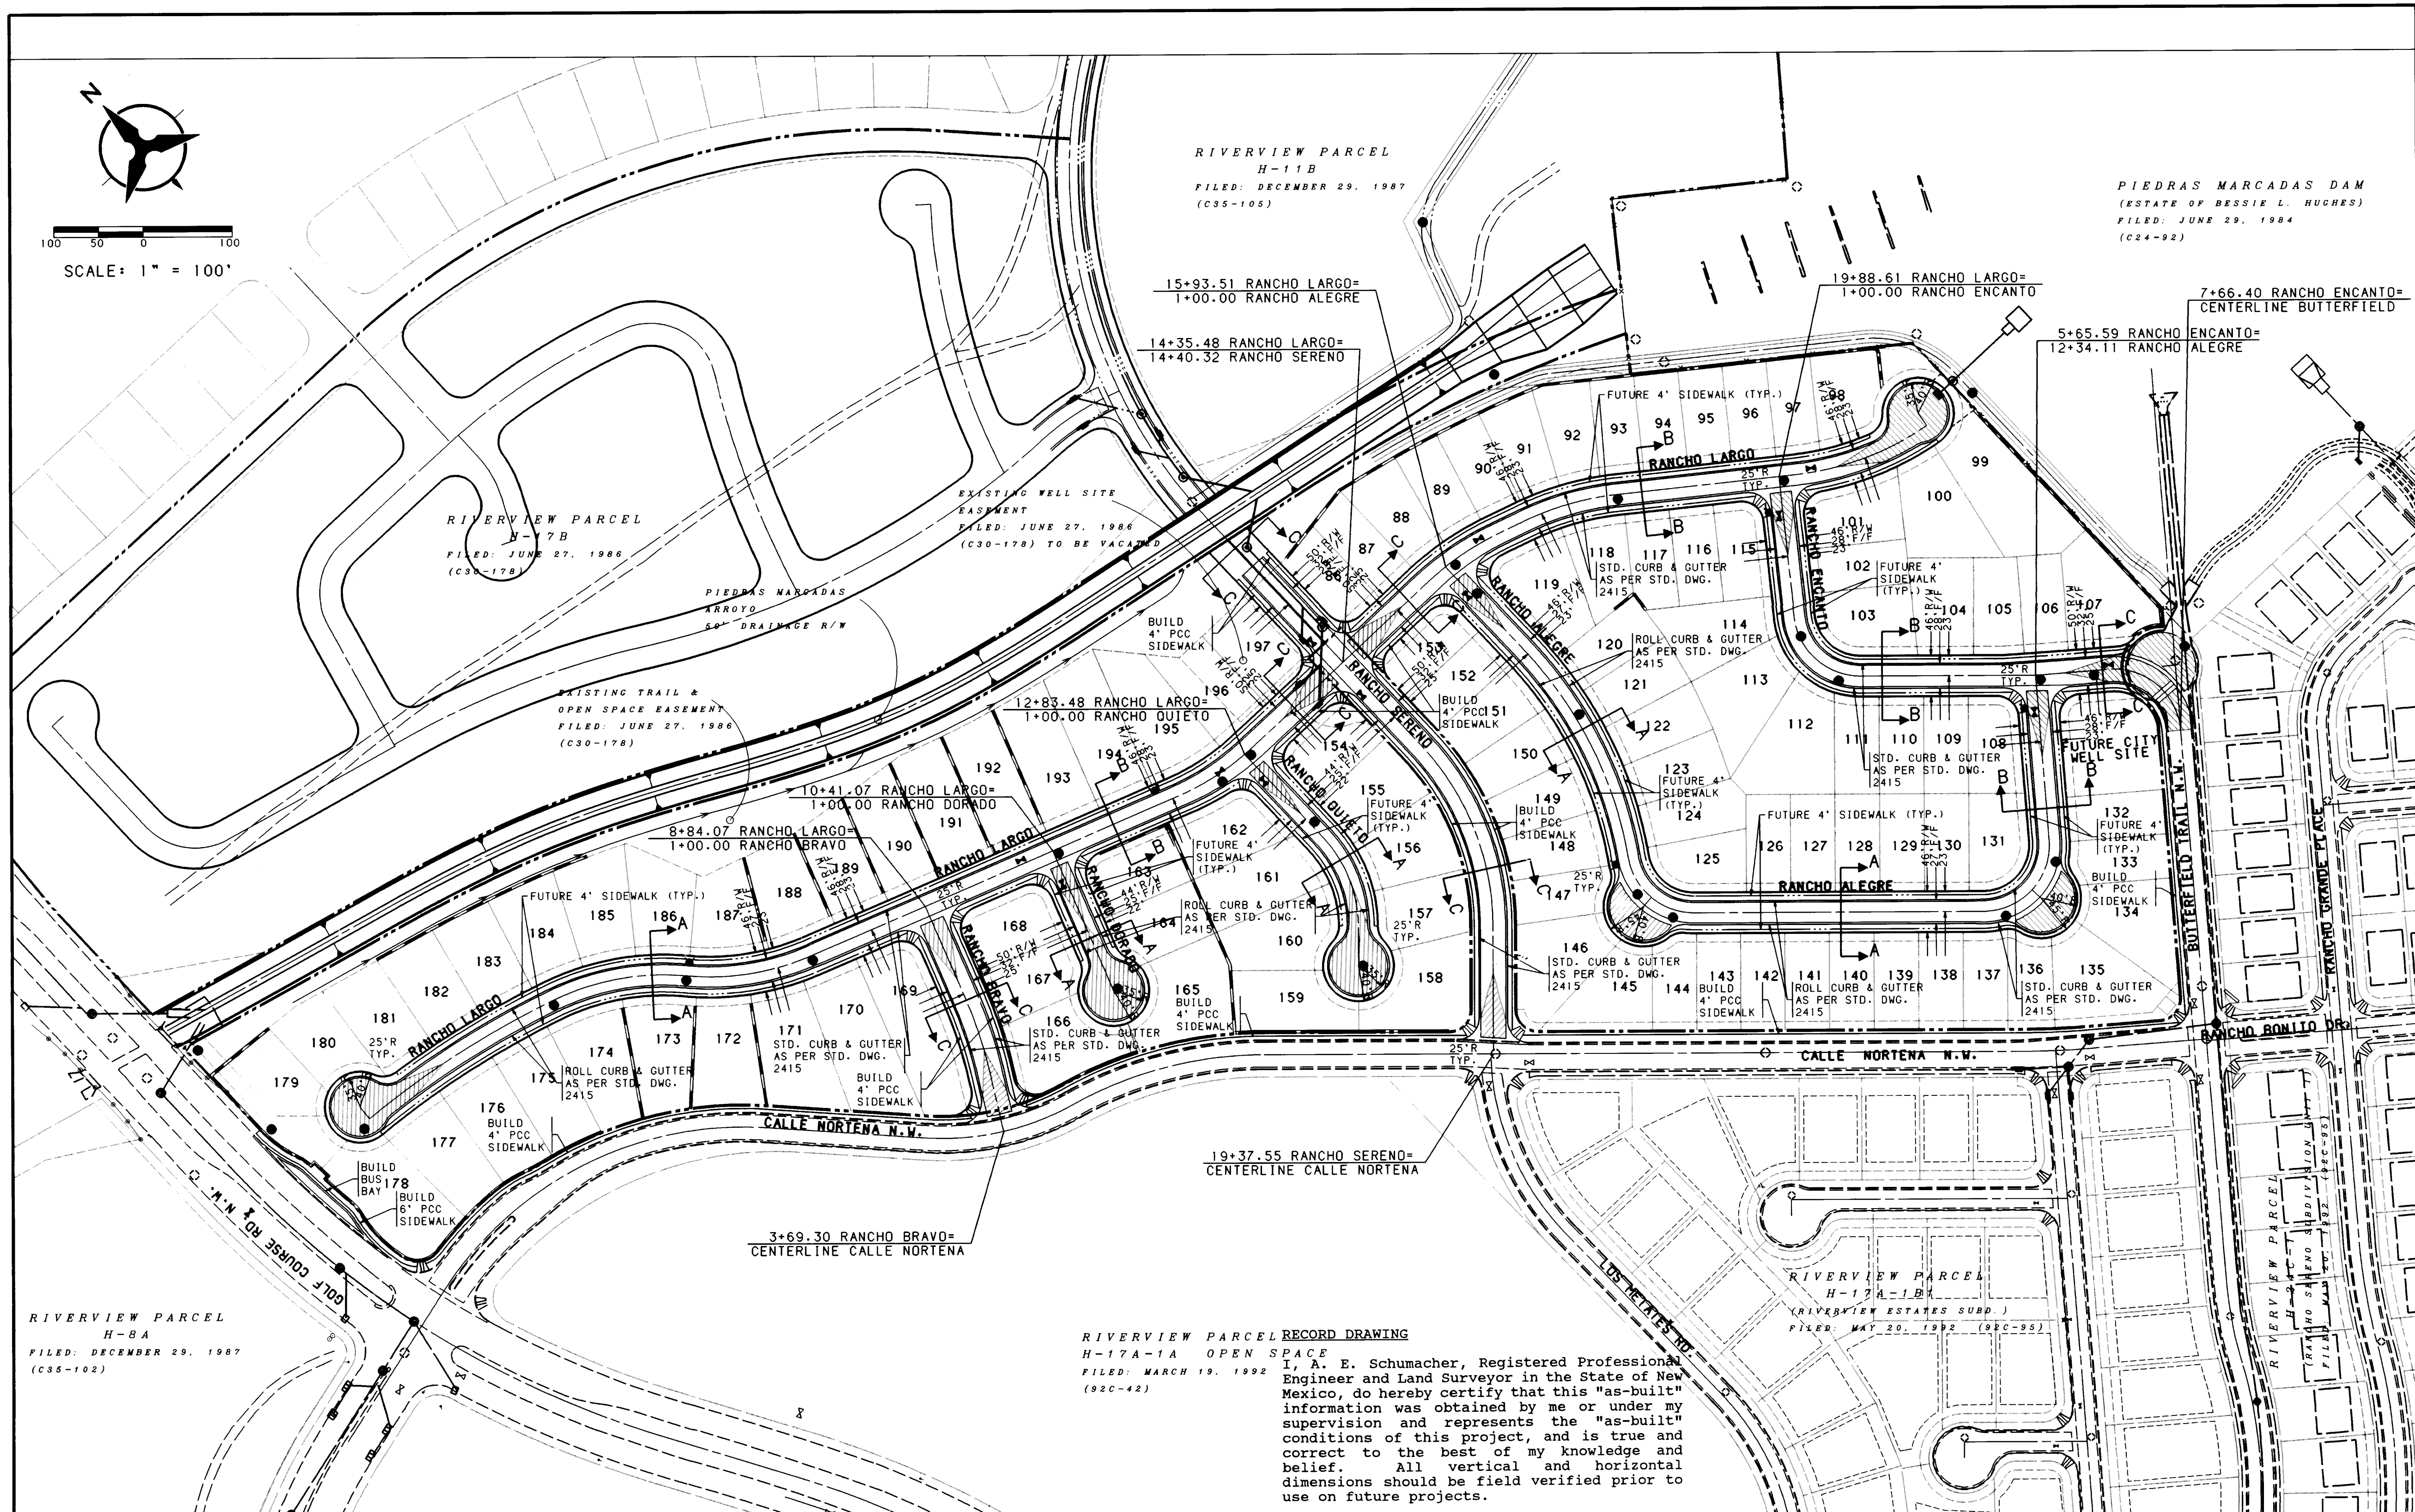

NOTES

- THE CONTRACTOR SHALL FIELD VERIFY ALL EXISTING UTILITY LOCATIONS AND NOTIFY THE ENGINEER IMMEDIATELY OF ANY DISCREPANCIES.
- ALL CURB RETURN RADII SHALL BE 25' TO FACE OF CURB UNLESS OTHERWISE SPECIFIED.
- ALL CURVE DATA AND DIMENSIONS REFER TO FACE OF CURB UNLESS OTHERWISE SPECIFIED.
- GRADE ELEVATIONS, WHERE NOTED, ARE FOR TOP OF STANDARD CURB UNLESS OTHERWISE SPECIFIED.
- CONTRACTOR IS TO INSTALL A 4"x4"x5" POST AND END AT THE END OF EACH SANITARY SEWER SERVICE.
- CONTRACTOR IS RESPONSIBLE FOR REPAIR AND/OR REPLACEMENT OF ALL UTILITY CONDUITS AND EXISTING LINES.
- ANY ADDITIONAL GRADING REQUIRED TO MATCH PROPOSED STREET GRADES SHALL BE INCIDENTAL TO PAVING ITEMS.
- CONTRACTOR SHALL PROVIDE THE INSPECTORS, (CITY AND PRIVATE) WITH THE PROPOSED HYDROSTATIC TESTING PLAN. THE PLAN MUST BE APPROVED BEFORE TESTING OPERATIONS BEGIN.
- CONTRACTOR SHALL PARK EQUIPMENT AND VEHICLES AS NOT TO INTERFERE WITH NORMAL ACTIVITIES OF RESIDENTS OR OTHER CONTRACTORS ON SITE.
- ANY DAMAGE TO THE EXISTING FACILITIES (CURB AND GUTTER, PAVEMENT, CONDUITS, LANDSCAPING, UTILITY LINES, ETC.) DURING CONSTRUCTION SHALL BE REPLACED AT THE CONTRACTORS EXPENSE.
- REMOVAL OF THE EXISTING CURB AND GUTTER SHALL BE AS PER COA STD. DWG. 2415 (SAWCUT ONLY).
- WHEEL CHAIR RAMPS SHALL BE CONSTRUCTED PRIOR TO ACCEPTANCE OF CURB AND GUTTER.
- THE FOLLOWING PERSONS SHALL BE NOTIFIED AT LEAST TWO BUSINESS DAYS PRIOR TO INSTALLING UTILITY CONDUIT CROSSINGS:

COMPANY	PHONE	CONTACT
PNM	848-3374	TOM BACA
US WEST	245-6694	BECKY OLESEN
GAS CO.	761-7770	LEO APADACA
JONES	761-6200	YVETTE SUAZO

LEGEND

PROJECT BOUNDARY	PROPOSED CURB & GUTTER	EXISTING CURB & GUTTER	FUTURE SIDEWALK	PROPOSED SANITARY SEWER MANHOLE	EXISTING SANITARY SEWER MANHOLE	PROPOSED FIRE HYDRANT	EXISTING FIRE HYDRANT	PROPOSED GATE VALVE	EXISTING GATE VALVE	PROPOSED STORM DRAIN LINE	PROPOSED STORM DRAIN MANHOLE	PROPOSED STORM DRAIN INLET	EXISTING STORM DRAIN LINE	EXISTING STORM DRAIN MANHOLE	EXISTING STORM DRAIN INLET	CROWN FLATTENING	PROPOSED CONDUIT PIPE	EXISTING CONDUIT PIPE	PROPOSED STREET LIGHT	EXISTING STREET LIGHT
---	---	---	---	●	●	●	●	⊕	⊕	SD	⊙	■	SD	⊙	□	▨	---	---	---	---

AS BUILT INFORMATION

CONTRACTOR	DATE	INSPECTOR	DATE	FIELD	DATE	REVISIONS
...	...	...	...	...	...	...

ENGINEERS SEAL

REVISIONS

NO.	DATE	REMARKS
...	...	...

CITY OF ALBUQUERQUE PUBLIC WORKS DEPARTMENT ENGINEERING GROUP

TITLE: RANCHO SERENO SUBDIVISION UNIT II OVERALL PAVING PLAN

APPROVALS	ENGINEER	DATE	APPROVALS	ENGINEER	DATE
...	...	...	...	...	...


PROJECT NO. 4569.93 MAP C-12 NO. D-12 SHEET 9 OF 28

USERNAME: CDP2\CDP228701.PAD
FILENAME: PAVING.GRF

SCANNED BY LASON

BHI JOB NO. 92287.01

Copyright Bohannon-Huston, Inc. 1993

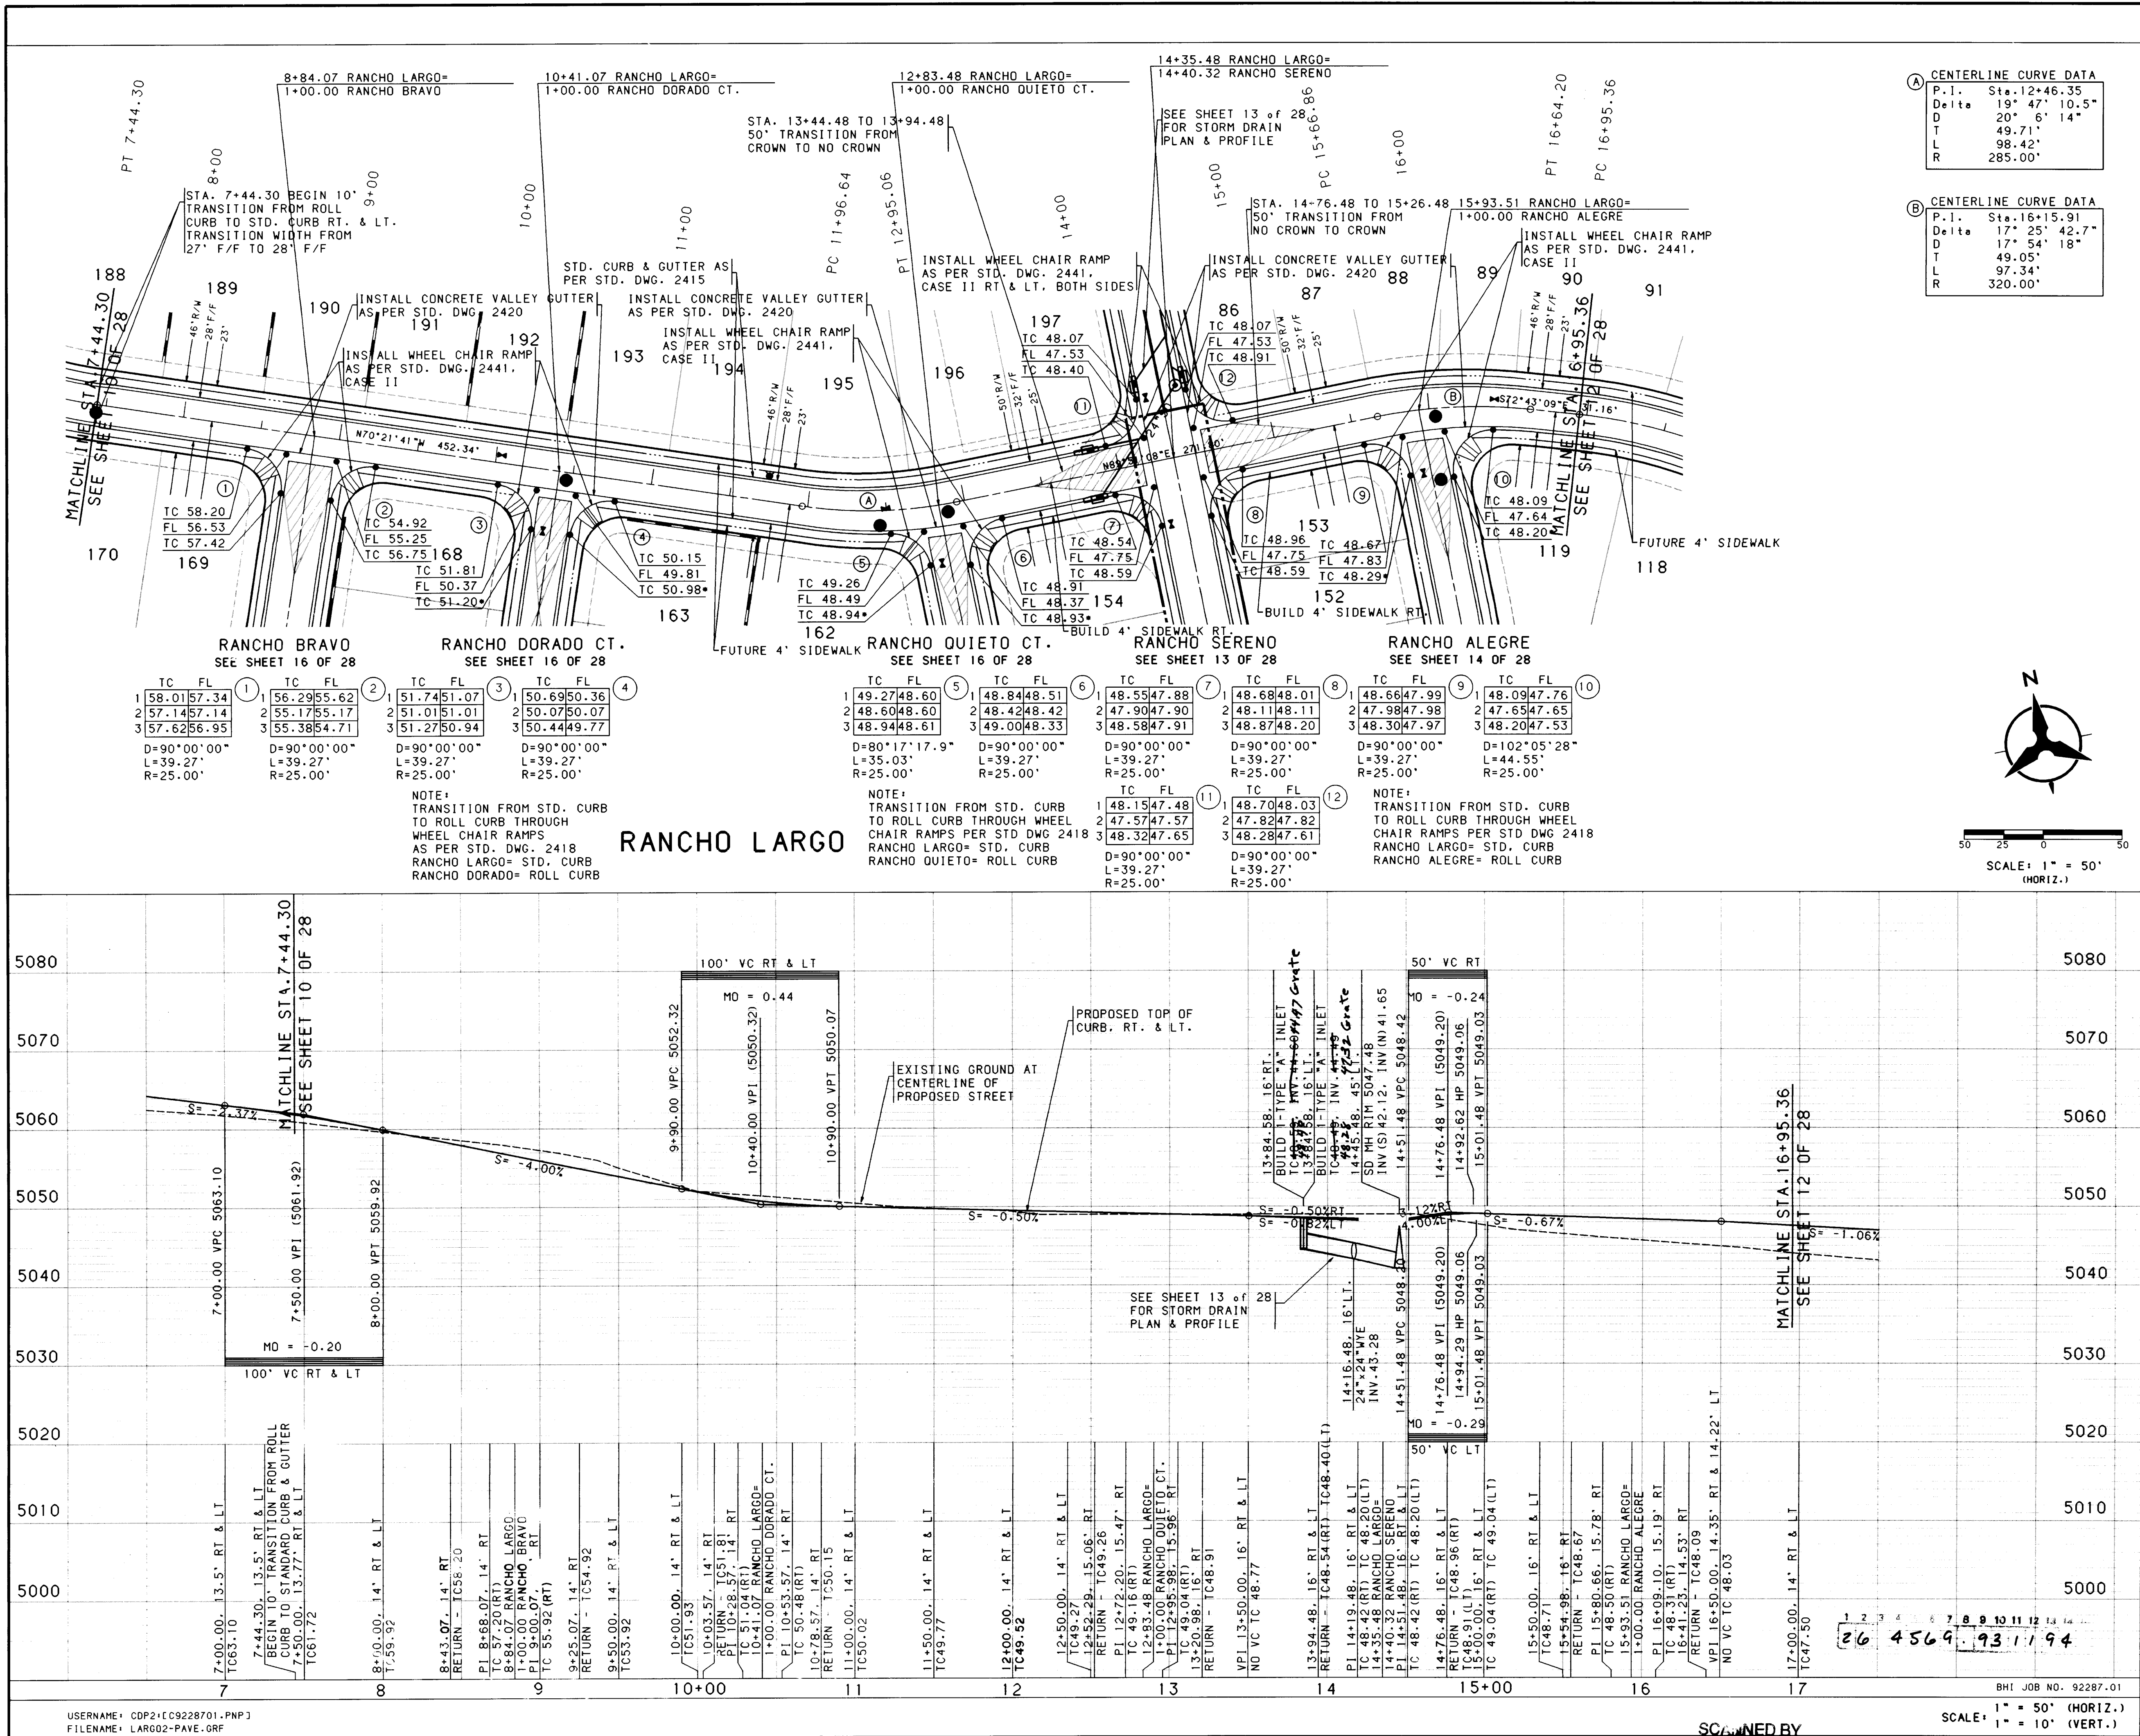


NOTES

- THE CONTRACTOR SHALL FIELD VERIFY ALL EXISTING UTILITY LOCATIONS AND NOTIFY THE ENGINEER IMMEDIATELY OF ANY DISCREPANCIES.
- ALL CURB RETURN RADII SHALL BE 25' TO FACE OF CURB UNLESS OTHERWISE SPECIFIED.
- ALL CURVE DATA AND DIMENSIONS REFER TO FACE OF CURB UNLESS OTHERWISE SPECIFIED.
- GRADE ELEVATIONS, WHERE NOTED, ARE FOR TOP OF STANDARD CURB UNLESS OTHERWISE SPECIFIED.
- CONTRACTOR IS TO INSTALL A 4"x4"x5' POST AND END AT THE END OF EACH SANITARY SEWER SERVICE.
- CONTRACTOR IS RESPONSIBLE FOR REPAIR AND/OR REPLACEMENT OF ALL UTILITY CONDUITS AND EXISTING LINES.
- ANY ADDITIONAL GRADING REQUIRED TO MATCH PROPOSED STREET GRADES SHALL BE INCIDENTAL TO PAVING ITEMS.
- CONTRACTOR SHALL PROVIDE THE INSPECTORS, (CITY AND PRIVATE) WITH THE PROPOSED HYDROSTATIC TESTING PLAN. THE PLAN MUST BE APPROVED BEFORE TESTING OPERATIONS BEGIN.
- CONTRACTOR SHALL PARK EQUIPMENT AND VEHICLES AS NOT TO INTERFERE WITH NORMAL ACTIVITIES OF RESIDENTS OR OTHER CONTRACTORS ON SITE.
- ANY DAMAGE TO THE EXISTING FACILITIES (CURB AND GUTTER, PAVEMENT, CONDUITS, LANDSCAPING, UTILITY LINES, ETC.) DURING CONSTRUCTION SHALL BE REPLACED AT THE CONTRACTORS EXPENSE.
- REMOVAL OF THE EXISTING CURB AND GUTTER SHALL BE AS PER COA STD. DWG. 2415 (SAWCUT ONLY).
- WHEEL CHAIR RAMPS SHALL BE CONSTRUCTED PRIOR TO ACCEPTANCE OF CURB AND GUTTER.
- THE FOLLOWING PERSONS SHALL BE NOTIFIED AT LEAST TWO BUSINESS DAYS PRIOR TO INSTALLING UTILITY CONDUIT CROSSINGS:

COMPANY	PHONE	CONTACT
PNM	848-3374	TOM BACA
US WEST	245-6694	BECKY OLESEN
GAS CO.	761-7770	LED APDACA
JONES	761-6200	YVETTE SUAZO

RECORD DRAWING

I, A. E. Schumacher, Registered Professional Engineer and Land Surveyor in the State of New Mexico, do hereby certify that this "as-built" information was obtained by me or under my supervision and represents the "as-built" conditions of this project, and is true and correct to the best of my knowledge and belief. All vertical and horizontal dimensions should be field verified prior to use on future projects.

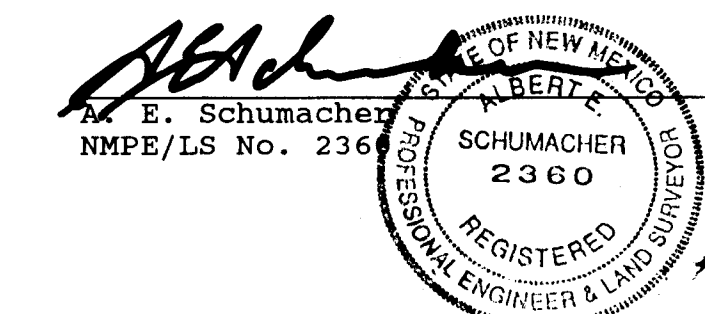


CITY OF ALBUQUERQUE
PUBLIC WORKS DEPARTMENT
ENGINEERING GROUP

TITLE: RANCHO SERENO SUBDIVISION - UNIT II
PAVING PLAN & PROFILE
RANCHO LARGO 7+44.30 to 16+95.36

APPROVALS	ENGINEER	DATE	APPROVALS	ENGINEER	DATE
DR. CHAIRMAN	10-07-93	WATER	N/A RWK	9-2-93	
TRANS. DEV.	9-9-93	WASTE WATER	N/A RWK	9-2-93	
HYDROLOGY	9/9/93				

PROJECT NO. 4569.93
MAP C-12 NO. D-12
SHEET 11 OF 28

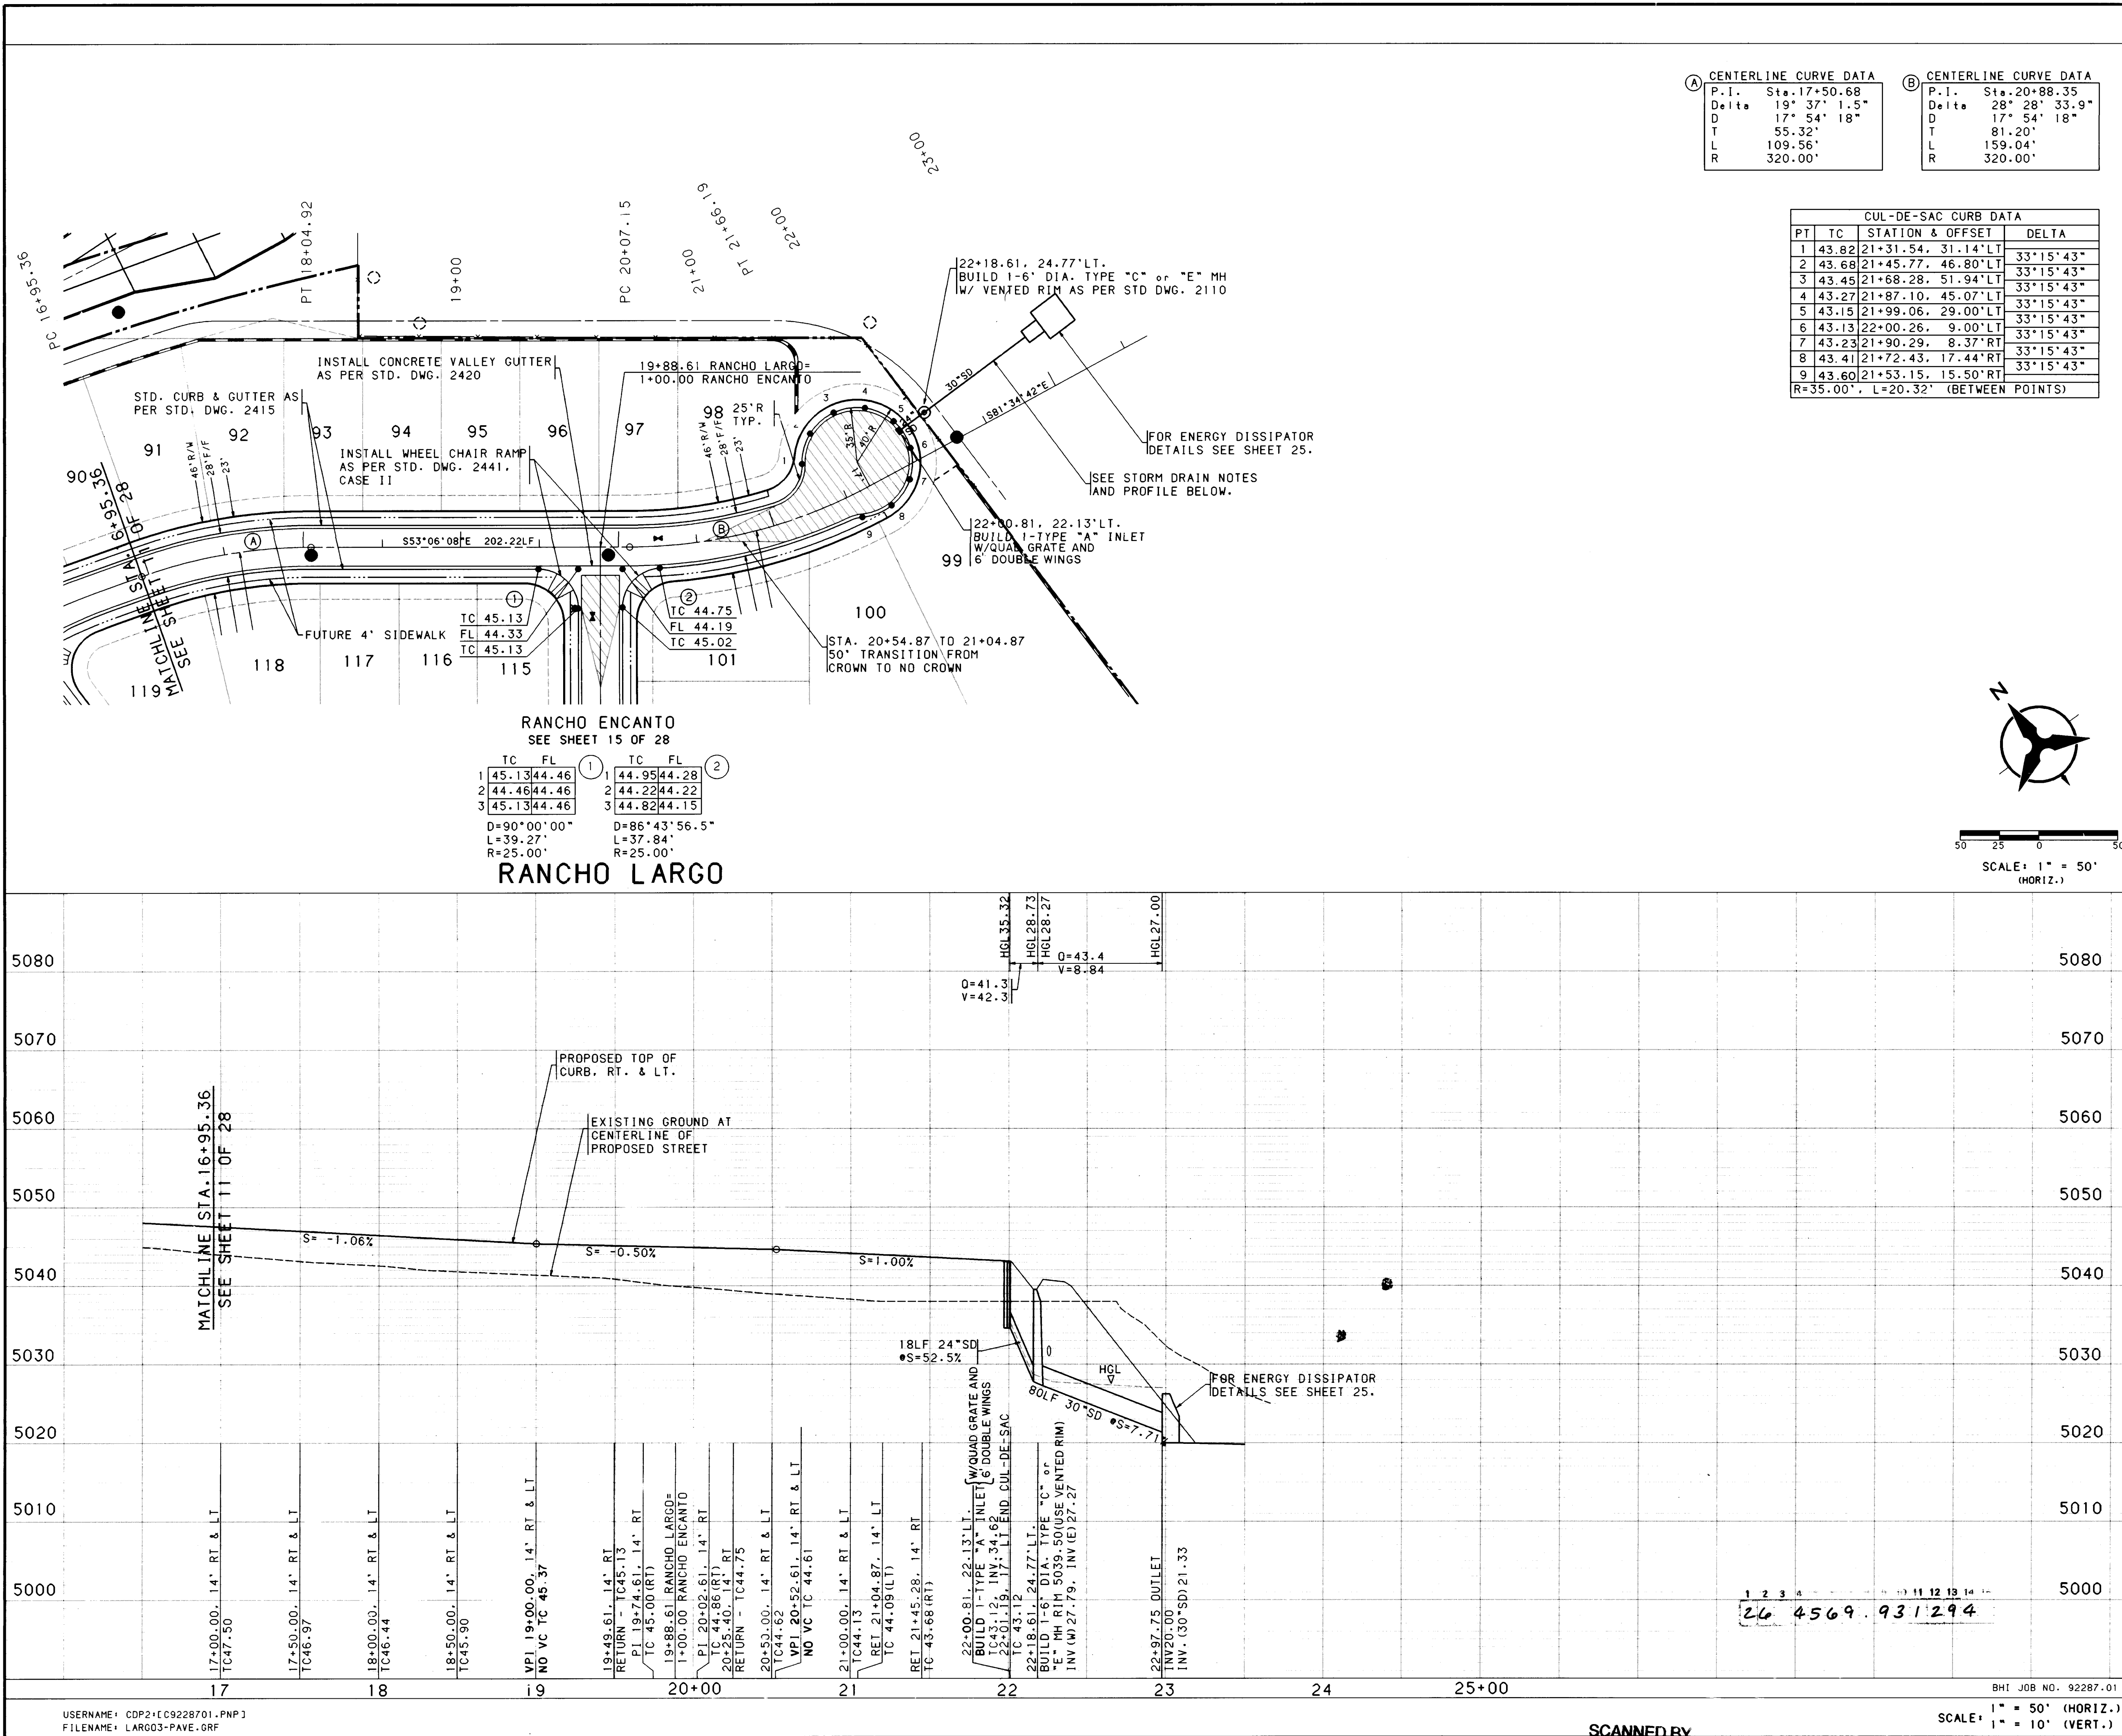

A CENTERLINE CURVE DATA				B CENTERLINE CURVE DATA			
P.I.	Sta.	17+50.68		P.I.	Sta.	20+88.35	
Delta		19° 37' 1.5"		Delta		28° 28' 33.9"	
D		17' 54" 18"		D		17' 54" 18"	
T		55.32'		T		81.20'	
L		109.56'		L		159.04'	
R		320.00'		R		320.00'	

CUL-DE-SAC CURB DATA			
PT	TC	STATION & OFFSET	DELTA
1	43.82	21+31.54, 31.14'LT	33°15'43"
2	43.68	21+45.77, 46.80'LT	33°15'43"
3	43.45	21+68.28, 51.94'LT	33°15'43"
4	43.27	21+87.10, 45.07'LT	33°15'43"
5	43.15	21+99.06, 29.00'LT	33°15'43"
6	43.13	22+00.26, 9.00'LT	33°15'43"
7	43.23	21+90.29, 8.37'RT	33°15'43"
8	43.41	21+72.43, 17.44'RT	33°15'43"
9	43.60	21+53.15, 15.50'RT	33°15'43"
R=35.00', L=20.32' (BETWEEN POINTS)			

NOTES

- THE CONTRACTOR SHALL FIELD VERIFY ALL EXISTING UTILITY LOCATIONS AND NOTIFY THE ENGINEER IMMEDIATELY OF ANY DISCREPANCIES.
- ALL CURB RETURN RADII SHALL BE 25' TO FACE OF CURB UNLESS OTHERWISE SPECIFIED.
- ALL CURVE DATA AND DIMENSIONS REFER TO FACE OF CURB UNLESS OTHERWISE SPECIFIED.
- GRADE ELEVATIONS, WHERE NOTED, ARE FOR TOP OF STANDARD CURB UNLESS OTHERWISE SPECIFIED.
- CONTRACTOR IS TO INSTALL A 4"x4"x5' POST AND END AT THE END OF EACH SANITARY SEWER SERVICE.
- CONTRACTOR IS RESPONSIBLE FOR REPAIR AND/OR REPLACEMENT OF ALL UTILITY CONDUITS AND EXISTING LINES.
- ANY ADDITIONAL GRADING REQUIRED TO MATCH PROPOSED STREET GRADES SHALL BE INCIDENTAL TO PAVING ITEMS.
- CONTRACTOR SHALL PROVIDE THE INSPECTORS, (CITY AND PRIVATE) WITH THE PROPOSED HYDROSTATIC TESTING PLAN. THE PLAN MUST BE APPROVED BEFORE TESTING OPERATIONS BEGIN.
- CONTRACTOR SHALL PARK EQUIPMENT AND VEHICLES AS NOT TO INTERFERE WITH NORMAL ACTIVITIES OF RESIDENTS OR OTHER CONTRACTORS ON SITE.
- ANY DAMAGE TO THE EXISTING FACILITIES (CURB AND GUTTER, PAVEMENT, CONDUITS, LANDSCAPING, UTILITY LINES, ETC.) DURING CONSTRUCTION SHALL BE REPLACED AT THE CONTRACTORS EXPENSE.
- REMOVAL OF THE EXISTING CURB AND GUTTER SHALL BE AS PER COA STD. DWG. 2415 (SAWCUT ONLY).
- WHEEL CHAIR RAMP SHALL BE CONSTRUCTED PRIOR TO ACCEPTANCE OF CURB AND GUTTER.
- THE FOLLOWING PERSONS SHALL BE NOTIFIED AT LEAST TWO BUSINESS DAYS PRIOR TO INSTALLING UTILITY CONDUIT CROSSINGS:

COMPANY	PHONE	CONTACT
PNM	848-3374	TOM BACA
US WEST	245-6694	BECKY OLESEN
GAS CO.	761-7770	LED APODACA
JONES	761-6200	YVETTE SUAZO
- NOTIFY AMAFCA 2 DAYS PRIOR TO WORK ON STORM DRAIN OUTFALL.
- AMAFCA SHALL BE NOTIFIED AND GIVEN OPPORTUNITY TO INSPECT ENERGY DISSIPATOR STEEL PLACEMENT PRIOR TO POURING CONCRETE.

RECORD DRAWING

I, A. E. Schumacher, Registered Professional Engineer and Land Surveyor in the State of New Mexico, do hereby certify that this "as-built" information was obtained by me or under my supervision and represents the "as-built" conditions of this project, and is true and correct to the best of my knowledge and belief. All vertical and horizontal dimensions should be field verified prior to use on future projects.


E. Schumacher
NMPE/LS No. 2360


SEAL
STATE OF NEW MEXICO
REGISTERED PROFESSIONAL ENGINEER & LAND SURVEYOR
E. SCHUMACHER
2360
3/21/93

AS BUILT INFORMATION				BENCH MARKS				SURVEY INFORMATION				ENGINEERS SEAL			
CONTRACTOR	DATE	INSPECTOR	DATE	STATION MARK IS A STANDARD USCSGS BRASS	DATE	TABLET, STAMPED "HUGHES, 1954", SET IN TOP OF A CONCRETE POST PROJECTING 0.3 FT. ABOVE THE GROUND. TO REACH THE STATION FROM THE INTERSECTION OF CENTRAL AVE. AND STATE RD. 448.	DATE	NO.	BY	NO.	BY	REMARKS	DESIGN	DATE	8/93
APPROVALS	ENGINEER	DATE	APPROVALS	ENGINEER	DATE
DRC CHAIRMAN	<i>[Signature]</i>	10-07-93	WATER	N/A RWK	9-2-93
TRANS. DEV.	<i>[Signature]</i>	9-02-93	WASTE WATER	N/A RWK	9-2-93
HYDROLOGY	<i>[Signature]</i>	07/04/93			

PROJECT NO.	4569.93	MAP C-12 NO. D-12	SHEET 12 OF 28
-------------	---------	-------------------	----------------

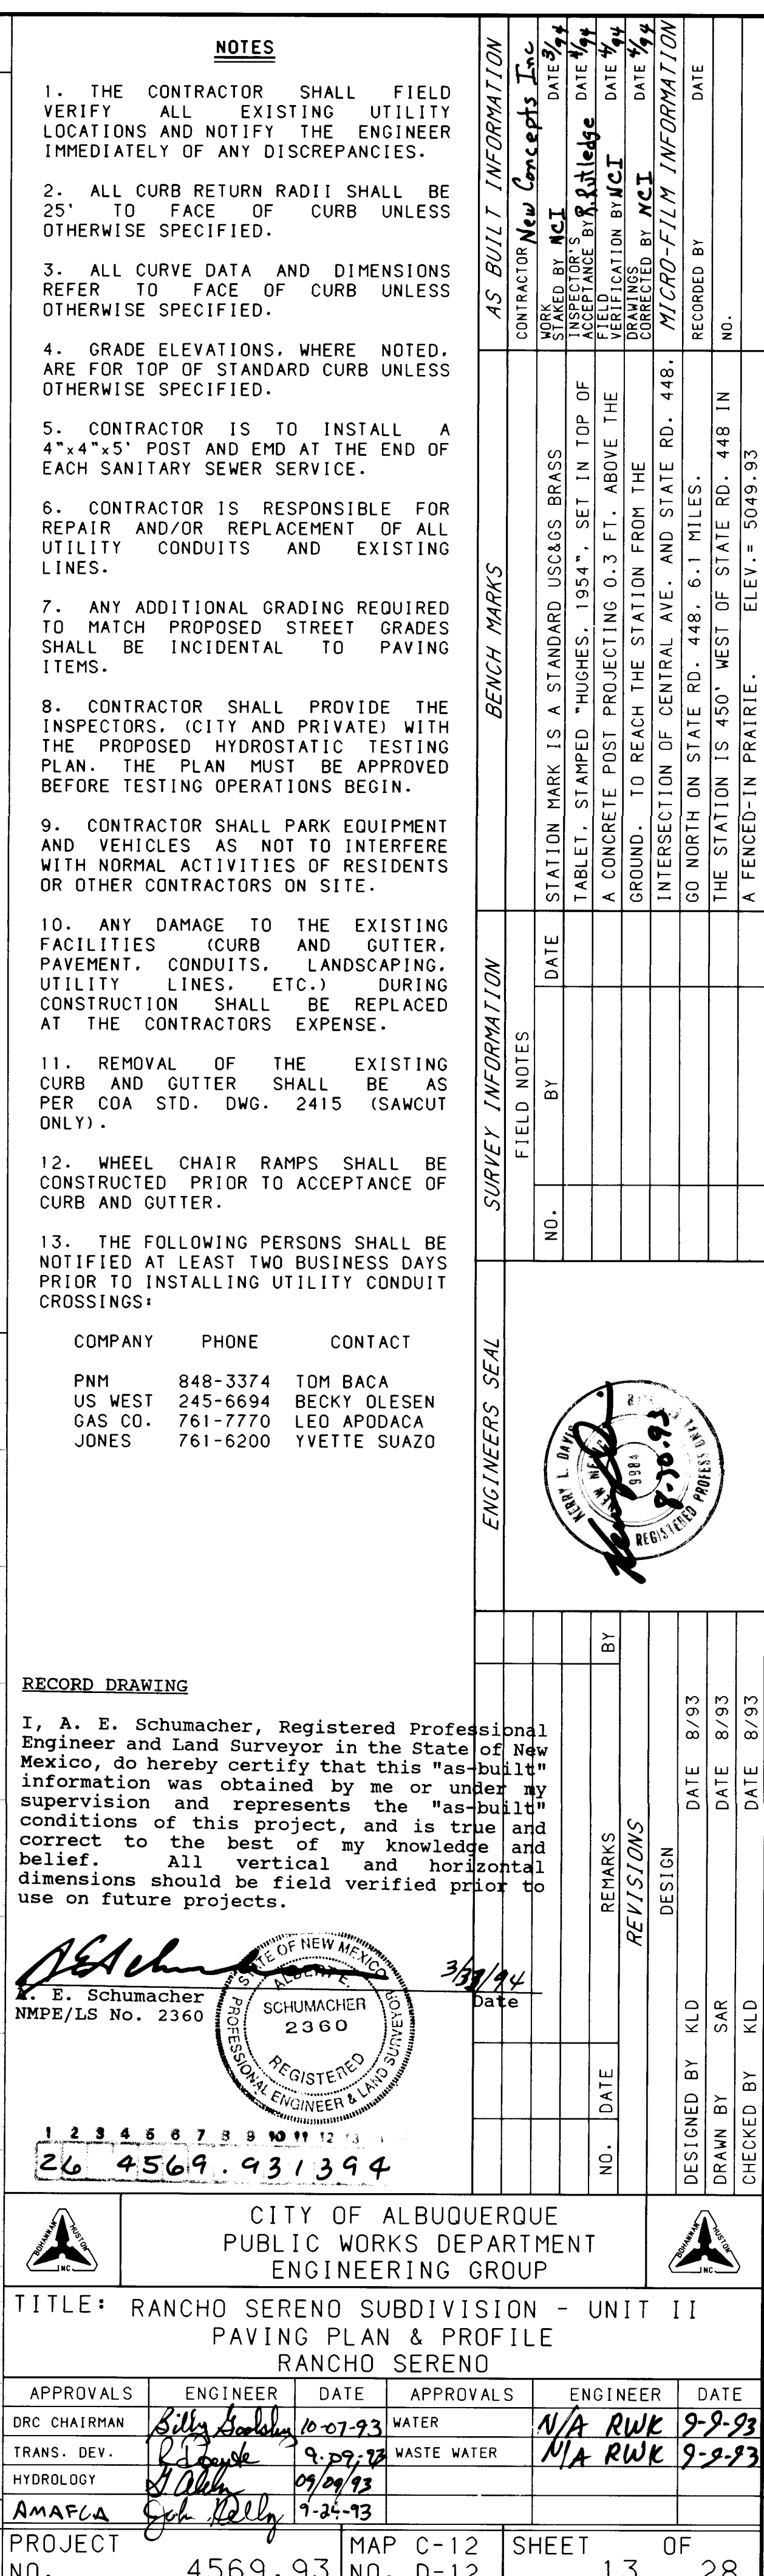

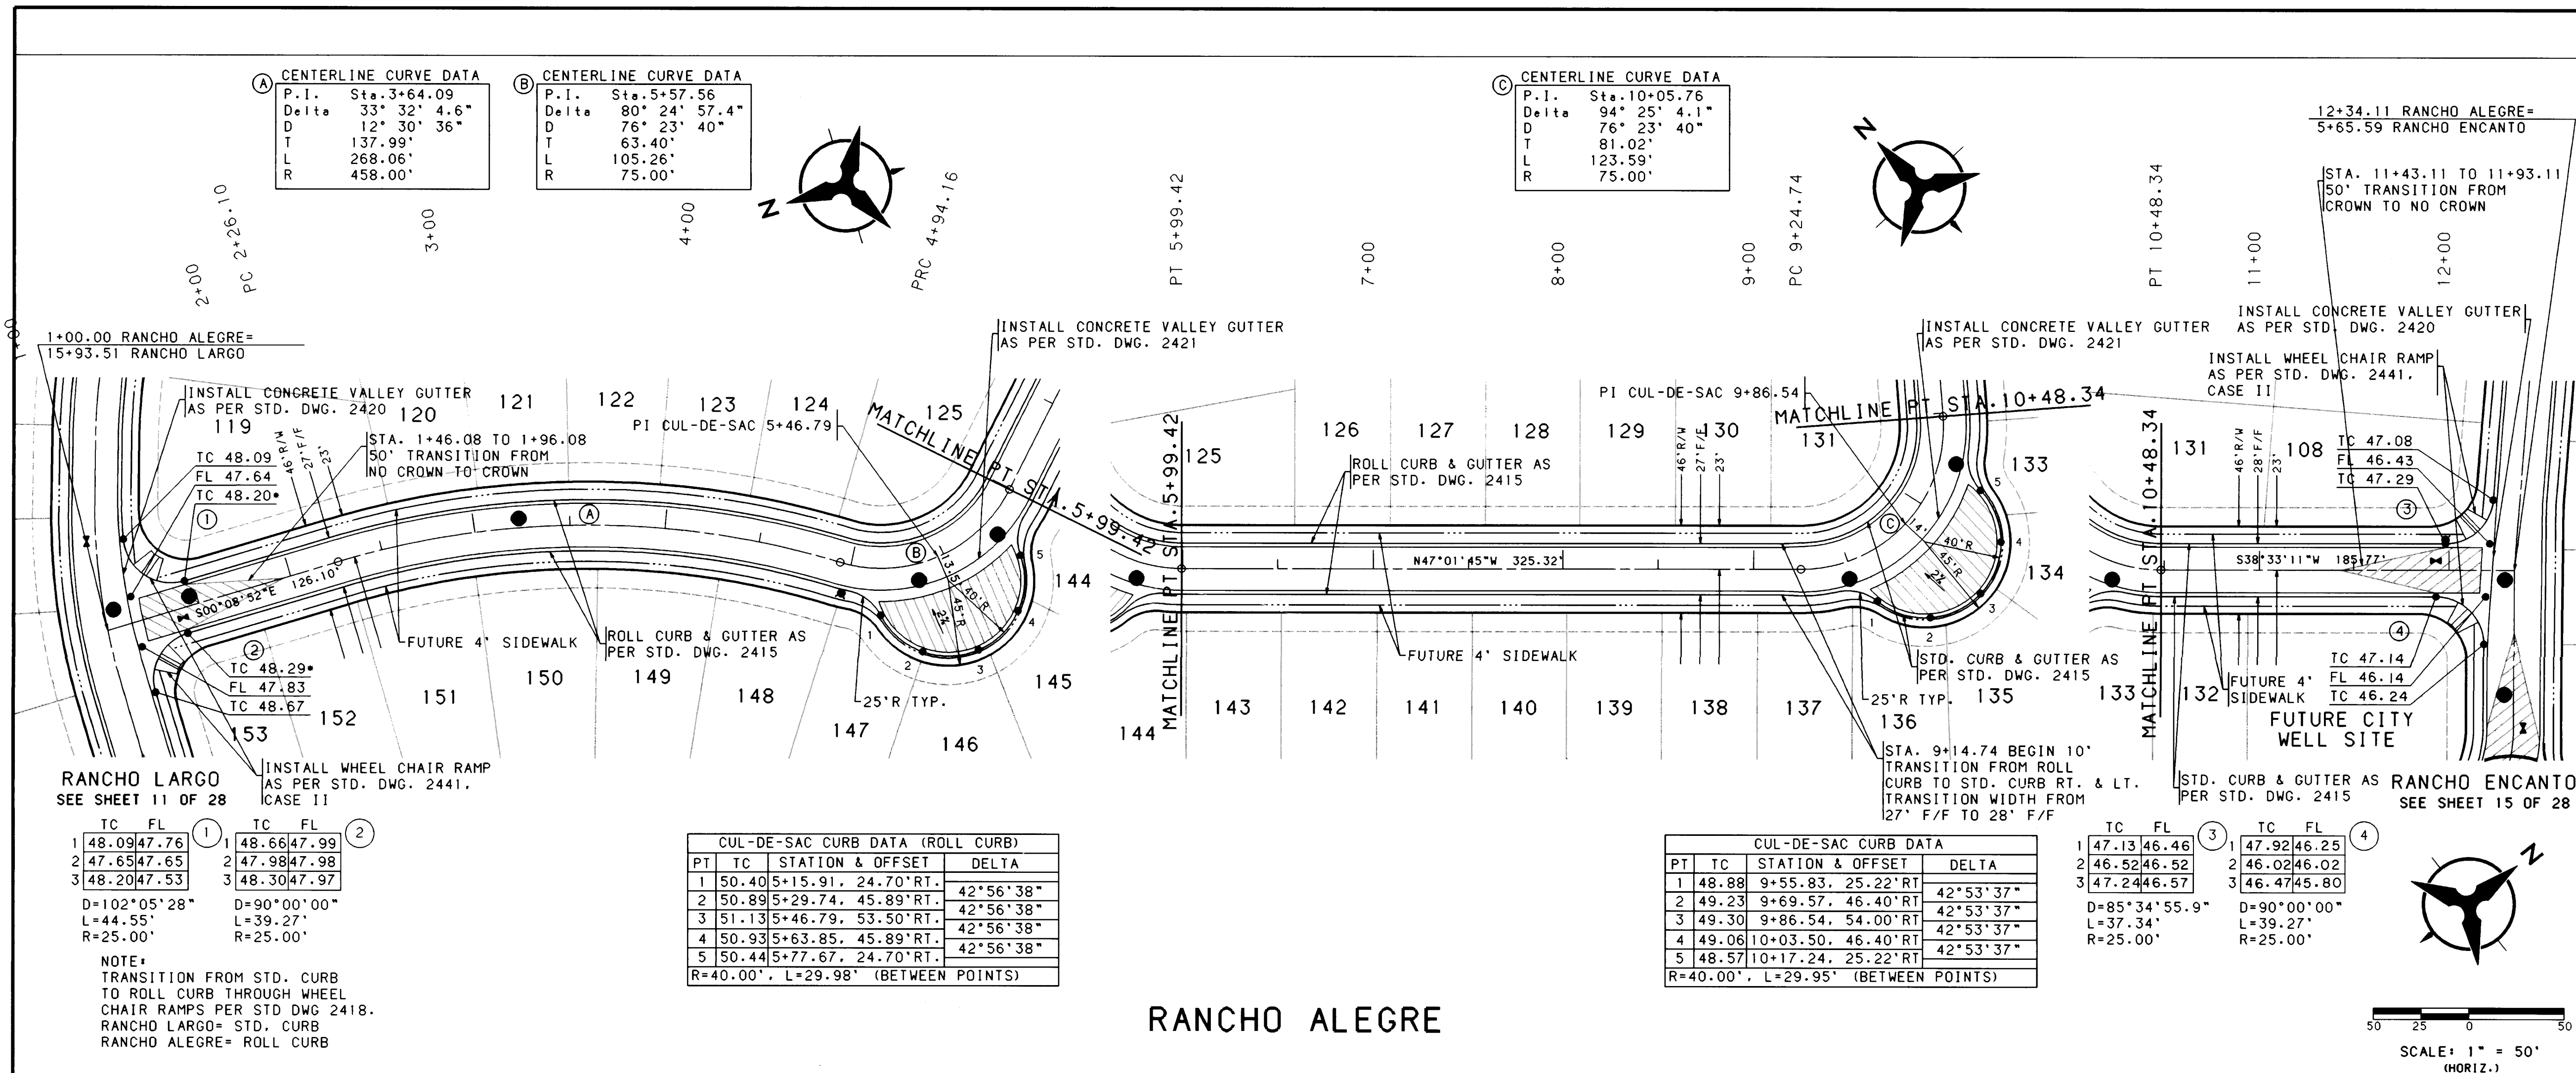

- NOTES**
- THE CONTRACTOR SHALL FIELD VERIFY ALL EXISTING UTILITY LOCATIONS AND NOTIFY THE ENGINEER IMMEDIATELY OF ANY DISCREPANCIES.
 - ALL CURB RETURN RADIUS SHALL BE 25' TO FACE OF CURB UNLESS OTHERWISE SPECIFIED.
 - ALL CURVE DATA AND DIMENSIONS REFER TO FACE OF CURB UNLESS OTHERWISE SPECIFIED.
 - GRADE ELEVATIONS, WHERE NOTED, ARE FOR TOP OF STANDARD CURB UNLESS OTHERWISE SPECIFIED.
 - CONTRACTOR IS TO INSTALL A 4"x4"x5' POST AND END AT THE END OF EACH SANITARY SEWER SERVICE.
 - CONTRACTOR IS RESPONSIBLE FOR REPAIR AND/OR REPLACEMENT OF ALL UTILITY CONDUITS AND EXISTING LINES.
 - ANY ADDITIONAL GRADING REQUIRED TO MATCH PROPOSED STREET GRADES SHALL BE INCIDENTAL TO PAVING ITEMS.
 - CONTRACTOR SHALL PROVIDE THE INSPECTORS, (CITY AND PRIVATE) WITH THE PROPOSED HYDROSTATIC TESTING PLAN. THE PLAN MUST BE APPROVED BEFORE TESTING OPERATIONS BEGIN.
 - CONTRACTOR SHALL PARK EQUIPMENT AND VEHICLES AS NOT TO INTERFERE WITH NORMAL ACTIVITIES OF RESIDENTS OR OTHER CONTRACTORS ON SITE.
 - ANY DAMAGE TO THE EXISTING FACILITIES (CURB AND GUTTER, PAVEMENT, CONDUITS, LANDSCAPING, UTILITY LINES, ETC.) DURING CONSTRUCTION SHALL BE REPLACED AT THE CONTRACTORS EXPENSE.
 - REMOVAL OF THE EXISTING CURB AND GUTTER SHALL BE AS PER COA STD. DWG. 2415 (SAWCUT ONLY).
 - WHEEL CHAIR RAMPS SHALL BE CONSTRUCTED PRIOR TO ACCEPTANCE OF CURB AND GUTTER.
 - THE FOLLOWING PERSONS SHALL BE NOTIFIED AT LEAST TWO BUSINESS DAYS PRIOR TO INSTALLING UTILITY CONDUIT CROSSINGS:

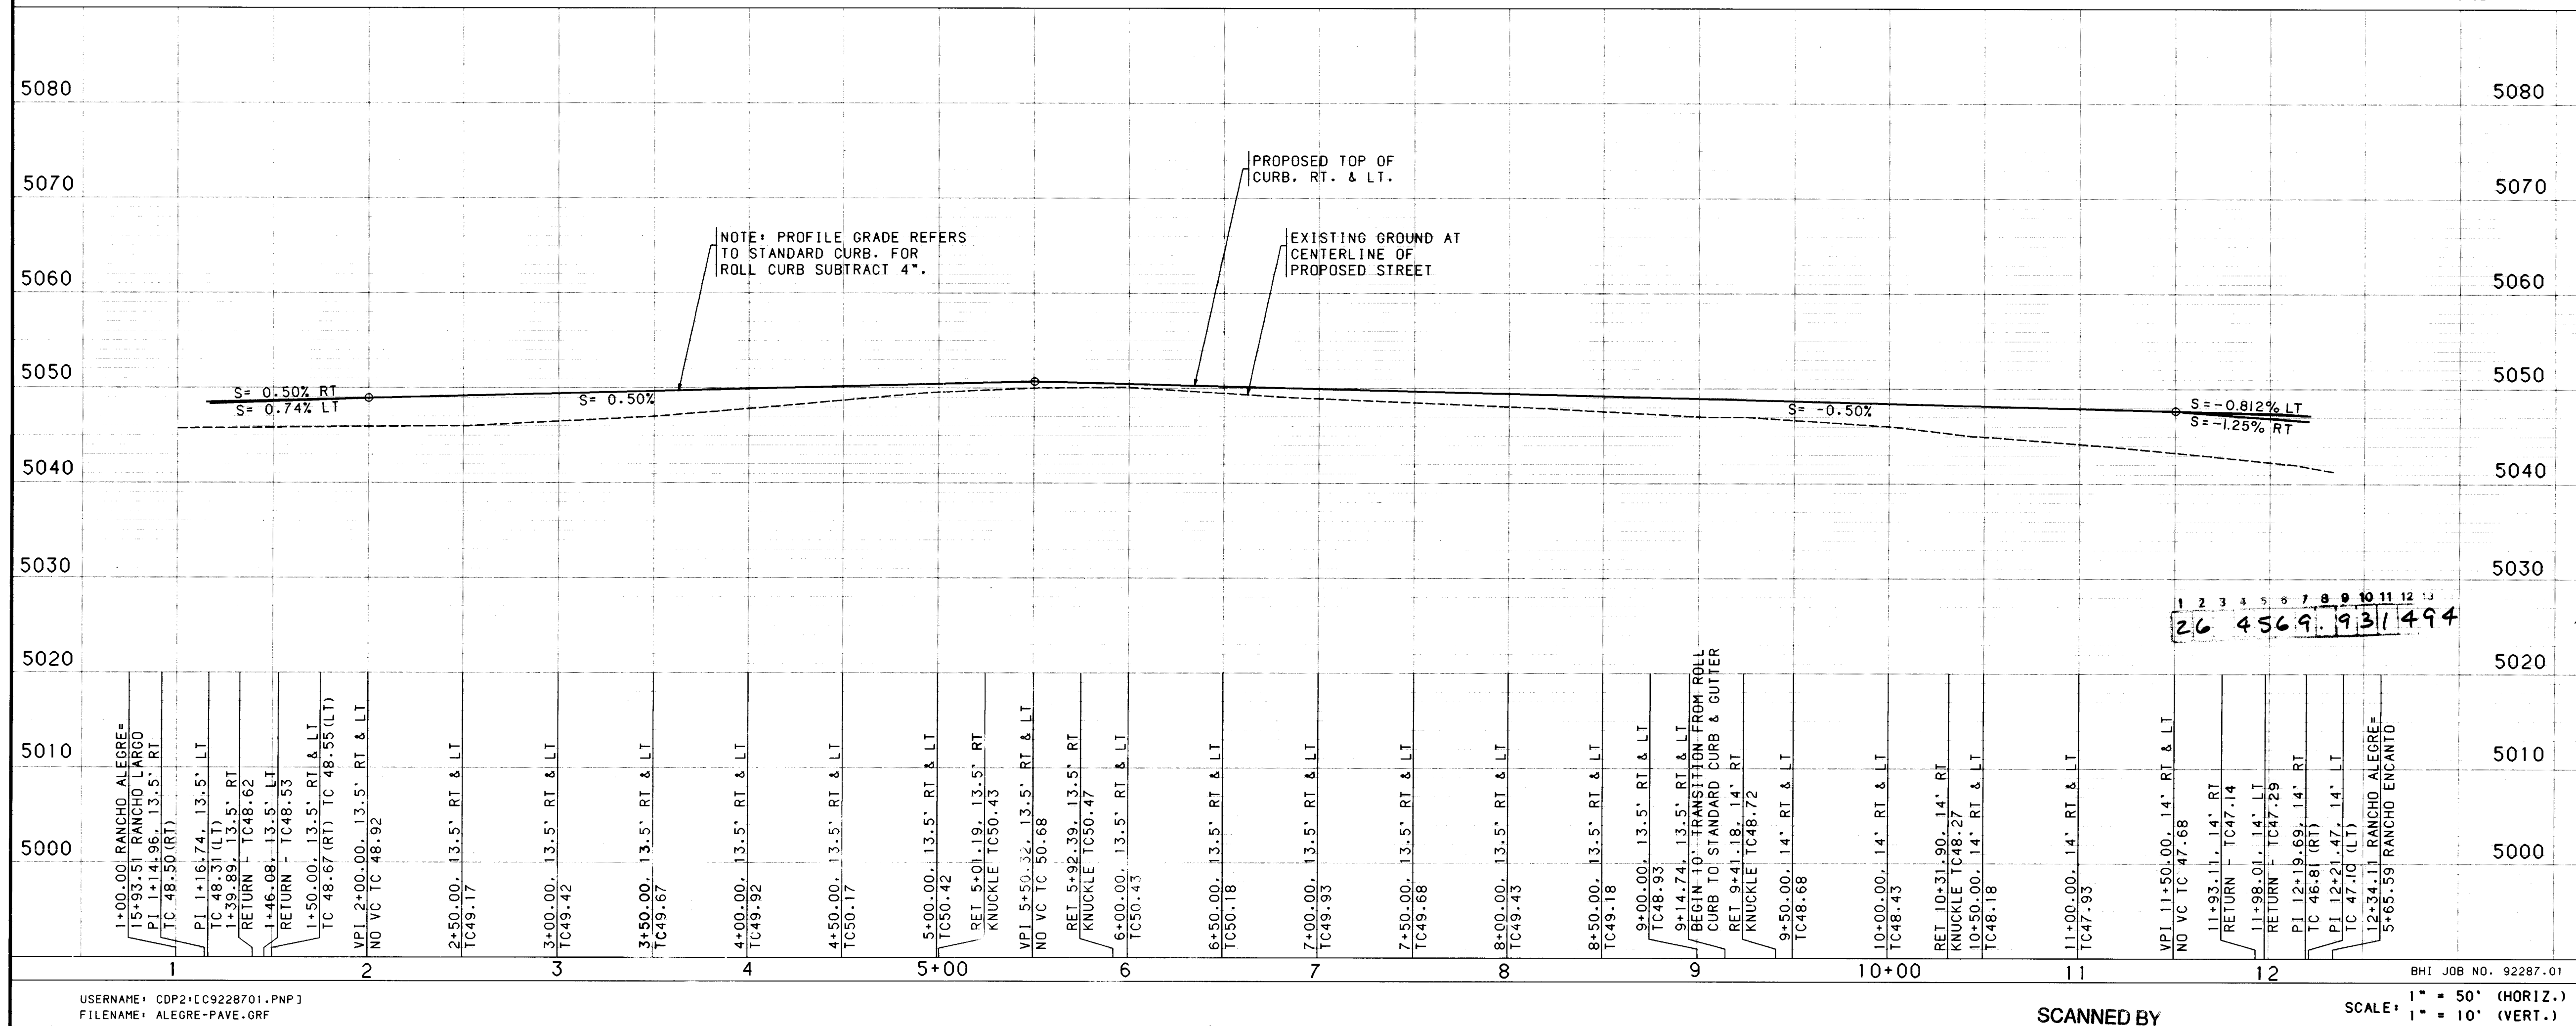

ENGINEERS SEAL

COMPANY PHONE CONTACT

PNM 848-3374 TOM BACA

US WEST 245-6694 BECKY OLESEN

GAS CO. 761-7770 LED APODACA

JONES 761-6200 YVETTE SUAZO

RECORD DRAWING

I, A. E. Schumacher, Registered Professional Engineer and Land Surveyor in the State of New Mexico, do hereby certify that this "as-built" information was obtained by me or under my supervision and represents the "as-built" conditions of this project, and is true and correct to the best of my knowledge and belief. All vertical and horizontal dimensions should be field verified prior to use on future projects.

REVISIONS

NO.	DATE	REMARKS
1	8/93	DESIGN
2	8/93	SAR
3	8/93	KLD

DESIGNED BY KLD DATE 8/93

DRAWN BY SAR DATE 8/93

CHECKED BY KLD DATE 8/93


CITY OF ALBUQUERQUE PUBLIC WORKS DEPARTMENT ENGINEERING GROUP

TITLE: RANCHO SERENO SUBDIVISION - UNIT II PAVING PLAN & PROFILE RANCHO ALEGRE

APPROVALS	ENGINEER	DATE	APPROVALS	ENGINEER	DATE
DRC CHAIRMAN	Billy Schumacher	10-07-93	WATER	NIA RWK	9-9-93
TRANS. DEV.	Billy Schumacher	9-09-93	WASTE WATER	NIA RWK	9-9-93
HYDROLOGY	Billy Schumacher	9/09/93			

PROJECT NO. 4569.93 MAP C-12 SHEET 14 OF 28

NO. D-12

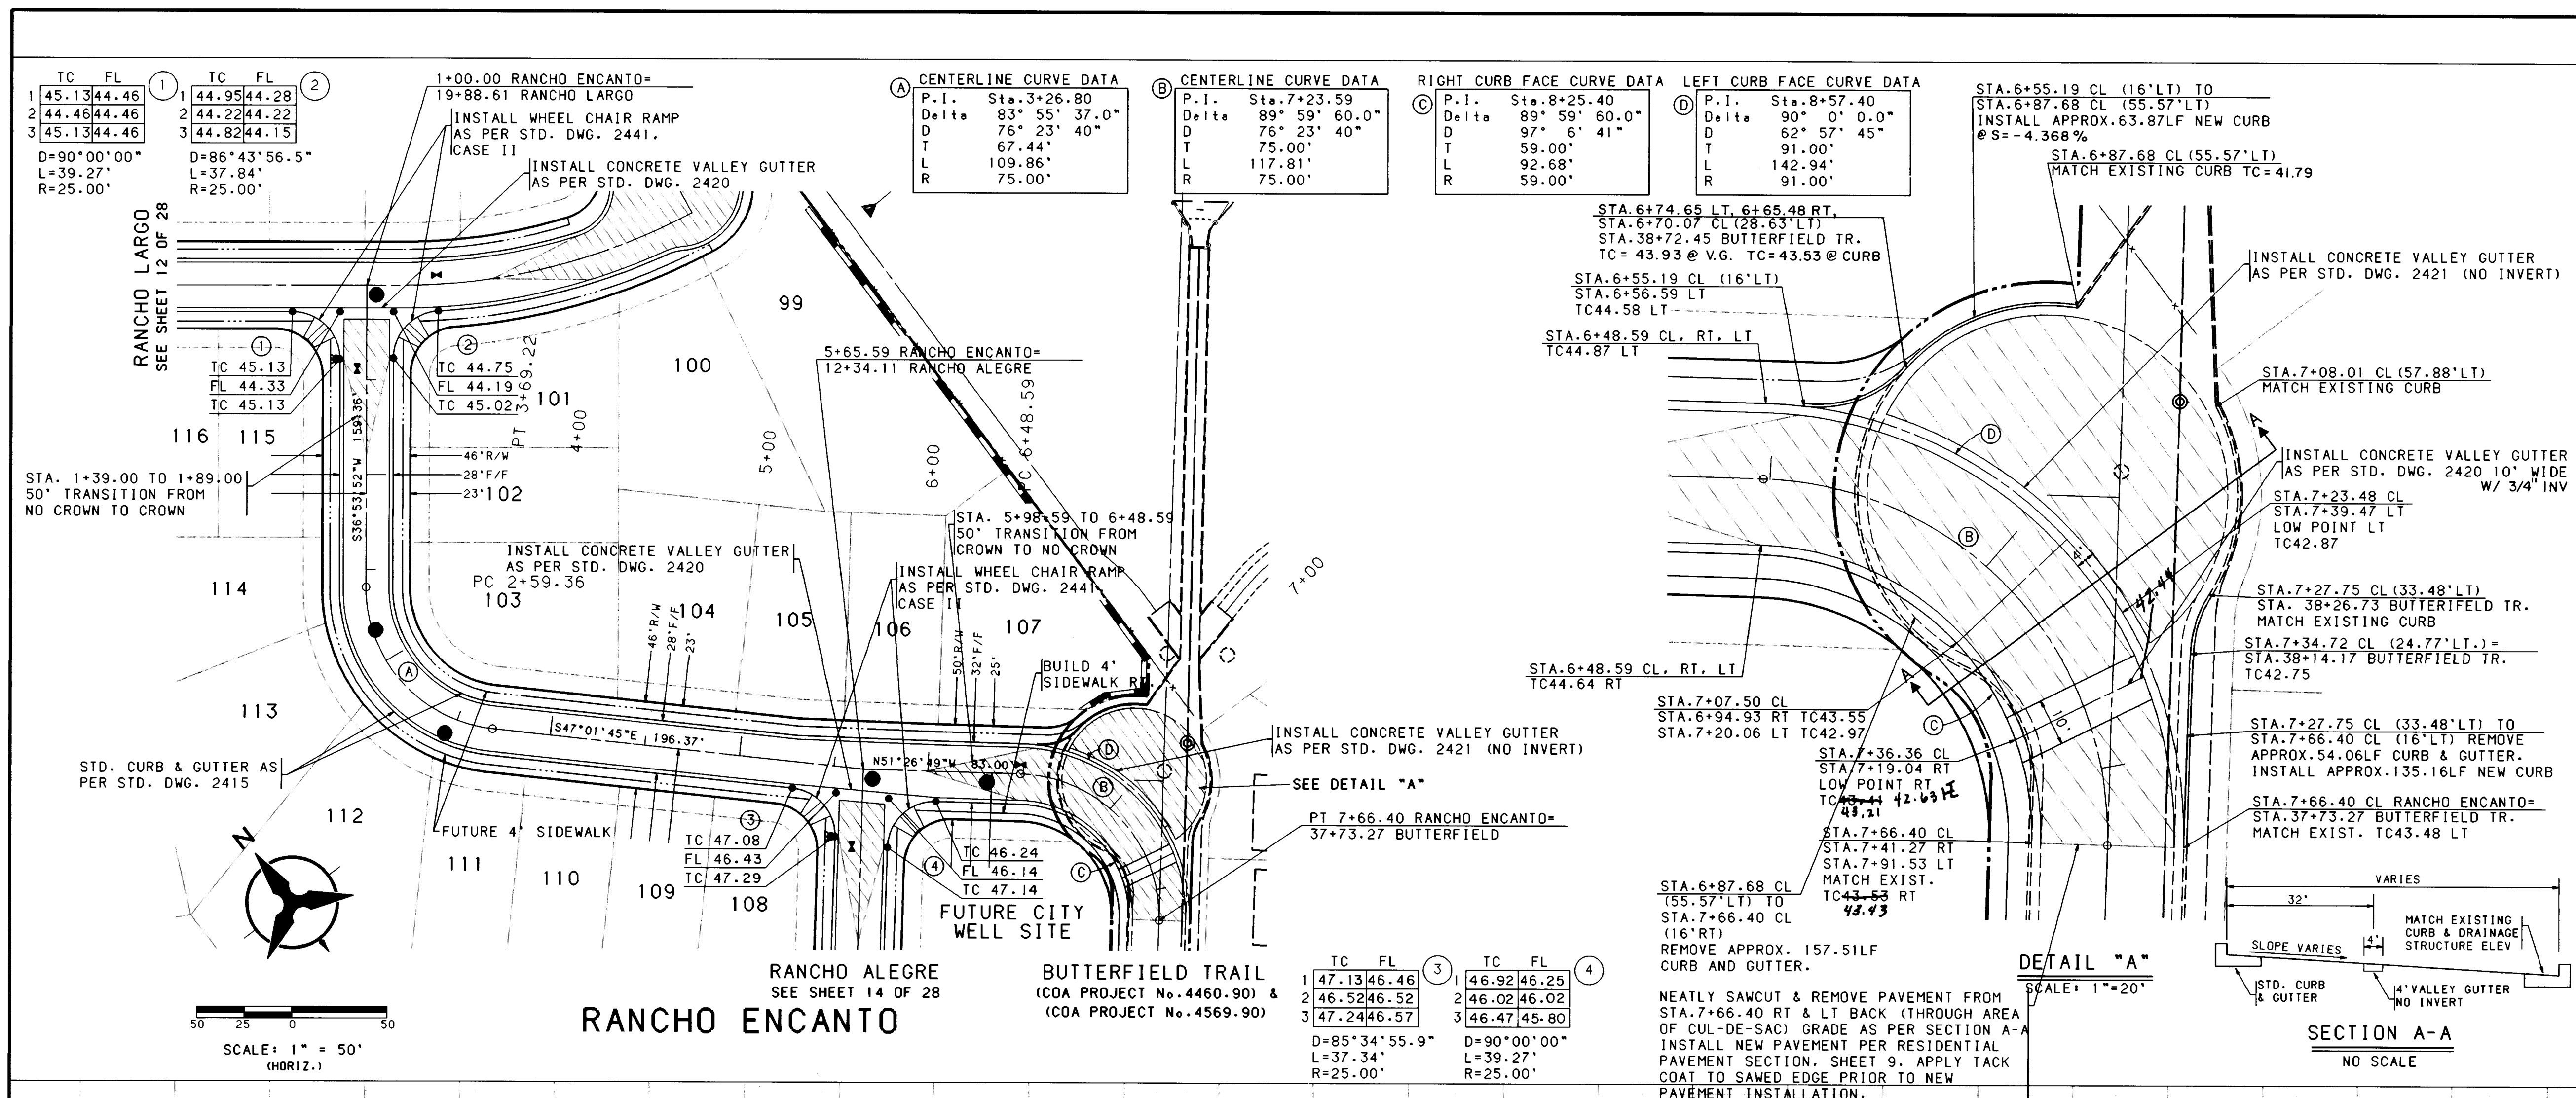


NOTES

1. THE CONTRACTOR SHALL FIELD VERIFY ALL EXISTING UTILITY LOCATIONS AND NOTIFY THE ENGINEER IMMEDIATELY OF ANY DISCREPANCIES.
2. ALL CURB RETURN RADII SHALL BE 25' TO FACE OF CURB UNLESS OTHERWISE SPECIFIED.
3. ALL CURVE DATA AND DIMENSIONS REFER TO FACE OF CURB UNLESS OTHERWISE SPECIFIED.
4. GRADE ELEVATIONS, WHERE NOTED, ARE FOR TOP OF STANDARD CURB UNLESS OTHERWISE SPECIFIED.
5. CONTRACTOR IS TO INSTALL A 4"x5" POST AND END AT THE END OF EACH SANITARY SEWER SERVICE.
6. CONTRACTOR IS RESPONSIBLE FOR REPAIR AND/OR REPLACEMENT OF ALL UTILITY CONDUITS AND EXISTING LINES.
7. ANY ADDITIONAL GRADING REQUIRED TO MATCH PROPOSED STREET GRADES SHALL BE INCIDENTAL TO PAVING ITEMS.
8. CONTRACTOR SHALL PROVIDE THE INSPECTORS, (CITY AND PRIVATE) WITH THE PROPOSED HYDROSTATIC TESTING PLAN. THE PLAN MUST BE APPROVED BEFORE TESTING OPERATIONS BEGIN.
9. CONTRACTOR SHALL PARK EQUIPMENT AND VEHICLES AS NOT TO INTERFERE WITH NORMAL ACTIVITIES OF RESIDENTS OR OTHER CONTRACTORS ON SITE.
10. ANY DAMAGE TO THE EXISTING FACILITIES (CURB AND GUTTER, PAVEMENT, CONDUITS, LANDSCAPING, UTILITY LINES, ETC.) DURING CONSTRUCTION SHALL BE REPLACED AT THE CONTRACTORS EXPENSE.
11. REMOVAL OF THE EXISTING CURB AND GUTTER SHALL BE AS PER COA STD. DWG. 2415 (SAWCUT ONLY).
12. WHEEL CHAIR RAMP SHALL BE CONSTRUCTED PRIOR TO ACCEPTANCE OF CURB AND GUTTER.
13. THE FOLLOWING PERSONS SHALL BE NOTIFIED AT LEAST TWO BUSINESS DAYS PRIOR TO INSTALLING UTILITY CONDUIT CROSSINGS:


COMPANY	PHONE	CONTACT
PNM	848-3374	TOM BACA
US WEST	245-6694	BECKY OLESEN
GAS CO.	761-7770	LED APODACA
JONES	761-6200	YVETTE SUAZO

RECORD DRAWING

I, A. E. Schumacher, Registered Professional Engineer and Land Surveyor in the State of New Mexico, do hereby certify that this "as-built" information was obtained by me or under my supervision and represents the "as-built" conditions of this project, and is true and correct to the best of my knowledge and belief. All vertical and horizontal dimensions should be field verified prior to use on future projects.

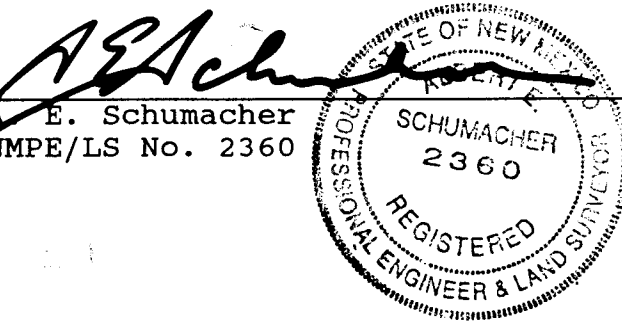

CITY OF ALBUQUERQUE PUBLIC WORKS DEPARTMENT ENGINEERING GROUP			
TITLE: RANCHO SERENO SUBDIVISION - UNIT II PAVING PLAN & PROFILE RANCHO ENCANTO			
APPROVALS	ENGINEER	DATE	APPROVALS
DRG CHAIRMAN	3/10/93	10-07-93	WATER
TRANS. DEV.	3/10/93	9-09-93	WASTE WATER
HYDROLOGY	3/10/93	01/02/93	
PROJECT NO. 4569.93		MAP C-12 NO. D-12	
SHEET 15		OF 28	

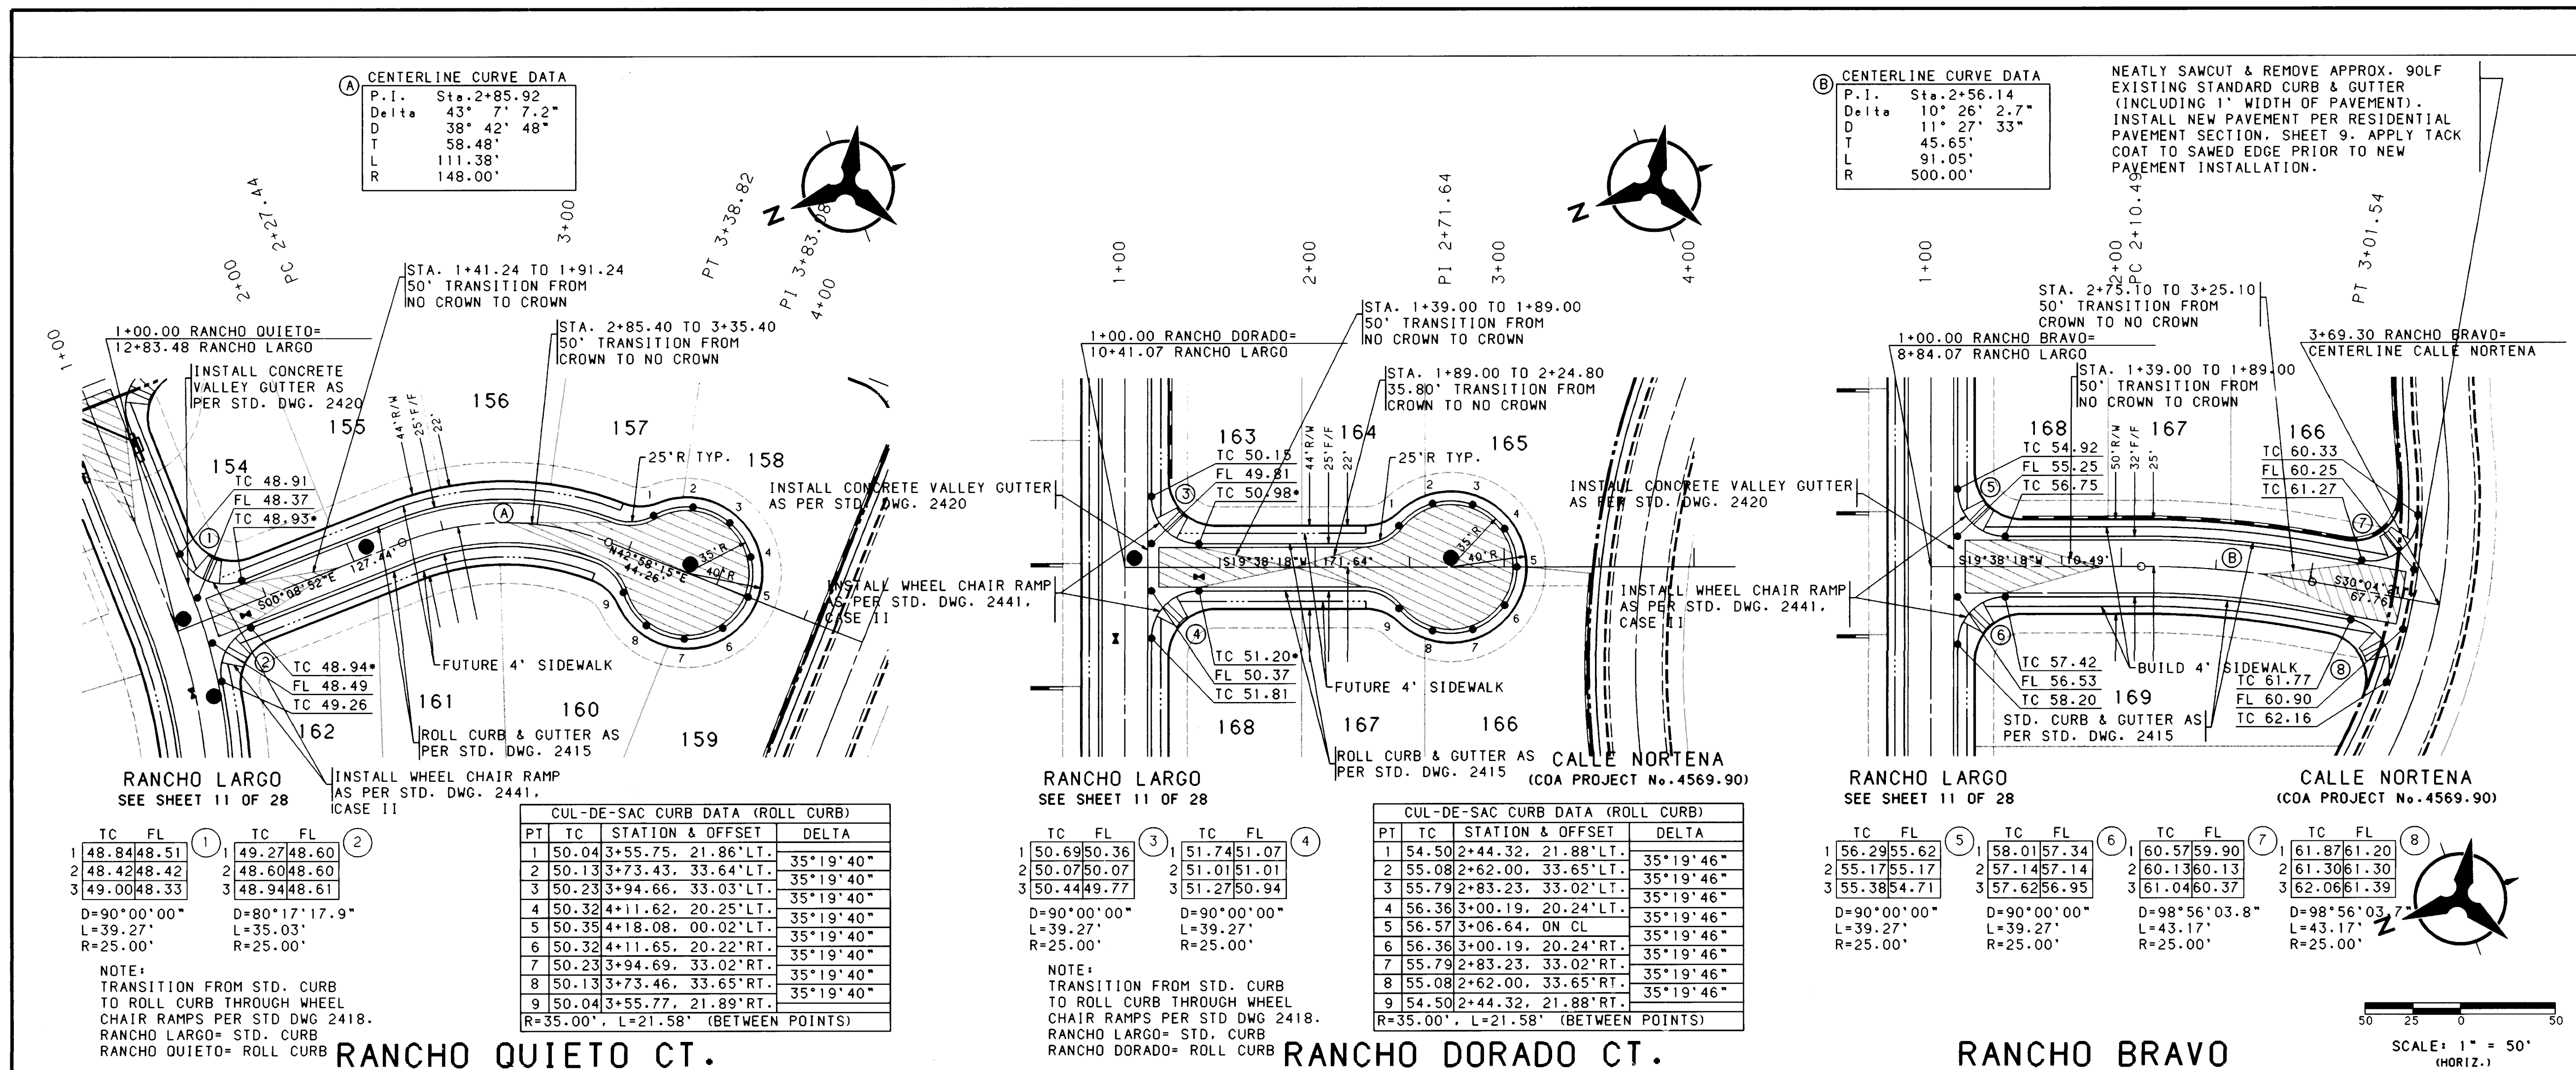

NOTES: 1. THE CONTRACTOR SHALL FIELD VERIFY ALL EXISTING UTILITY LOCATIONS AND NOTIFY THE ENGINEER IMMEDIATELY OF ANY DISCREPANCIES. 2. ALL CURB RETURN RADII SHALL BE 25' TO FACE OF CURB UNLESS OTHERWISE SPECIFIED. 3. ALL CURVE DATA AND DIMENSIONS REFER TO FACE OF CURB UNLESS OTHERWISE SPECIFIED. 4. GRADE ELEVATIONS, WHERE NOTED, ARE FOR TOP OF STANDARD CURB UNLESS OTHERWISE SPECIFIED. 5. CONTRACTOR IS TO INSTALL A 4"x4"x5' POST AND END AT THE END OF EACH SANITARY SEWER SERVICE. 6. CONTRACTOR IS RESPONSIBLE FOR REPAIR AND/OR REPLACEMENT OF ALL UTILITY CONDUITS AND EXISTING LINES. 7. ANY ADDITIONAL GRADING REQUIRED TO MATCH PROPOSED STREET GRADES SHALL BE INCIDENTAL TO PAVING ITEMS. 8. CONTRACTOR SHALL PROVIDE THE INSPECTORS, (CITY AND PRIVATE) WITH THE PROPOSED HYDROSTATIC TESTING PLAN. THE PLAN MUST BE APPROVED BEFORE TESTING OPERATIONS BEGIN. 9. CONTRACTOR SHALL PARK EQUIPMENT AND VEHICLES AS NOT TO INTERFERE WITH NORMAL ACTIVITIES OF RESIDENTS OR OTHER CONTRACTORS ON SITE. 10. ANY DAMAGE TO THE EXISTING FACILITIES (CURB AND GUTTER, PAVEMENT, CONDUITS, LANDSCAPING, UTILITY LINES, ETC.) DURING CONSTRUCTION SHALL BE REPLACED AT THE CONTRACTORS EXPENSE. 11. REMOVAL OF THE EXISTING CURB AND GUTTER SHALL BE AS PER COA STD. DWG. 2415 (SAWCUT ONLY). 12. WHEEL CHAIR RAMPS SHALL BE CONSTRUCTED PRIOR TO ACCEPTANCE OF CURB AND GUTTER. 13. THE FOLLOWING PERSONS SHALL BE NOTIFIED AT LEAST TWO BUSINESS DAYS PRIOR TO INSTALLING UTILITY CONDUIT CROSSINGS:

COMPANY	PHONE	CONTACT
PNM	848-3374	TOM BACA
US WEST	245-6694	BECKY OLESEN
GAS CO.	761-7770	LED APDADCA
JONES	761-6200	YVETTE SUAZO

RECORD DRAWING: I, A. E. Schumacher, Registered Professional Engineer and Land Surveyor in the State of New Mexico, do hereby certify that this "as-built" information was obtained by me or under my supervision and represents the "as-built" conditions of this project and is true and correct to the best of my knowledge and belief. All vertical and horizontal dimensions should be field verified prior to use on future projects.


DESIGNED BY: KLD DATE: 8/93
DRAWN BY: SAR DATE: 8/93
CHECKED BY: KLD DATE: 8/93

CITY OF ALBUQUERQUE PUBLIC WORKS DEPARTMENT ENGINEERING GROUP

TITLE: RANCHO SERENO SUBDIVISION - UNIT II PAVING PLAN & PROFILE RANCHO QUIETO CT., RANCHO DORADO CT., & RANCHO BRAVO

APPROVALS	ENGINEER	DATE	APPROVALS	ENGINEER	DATE
DRC CHAIRMAN	Billy B. B. 12-07-93	12-07-93	WATER	NIA RWK	9-9-93
TRANS. DEV.	9-9-93	9-9-93	WASTE WATER	NIA RWK	9-9-93
HYDROLOGY	9-9-93	9-9-93			

PROJECT NO. 4569.93 MAP C-12 SHEET 16 OF 28 NO. D-12

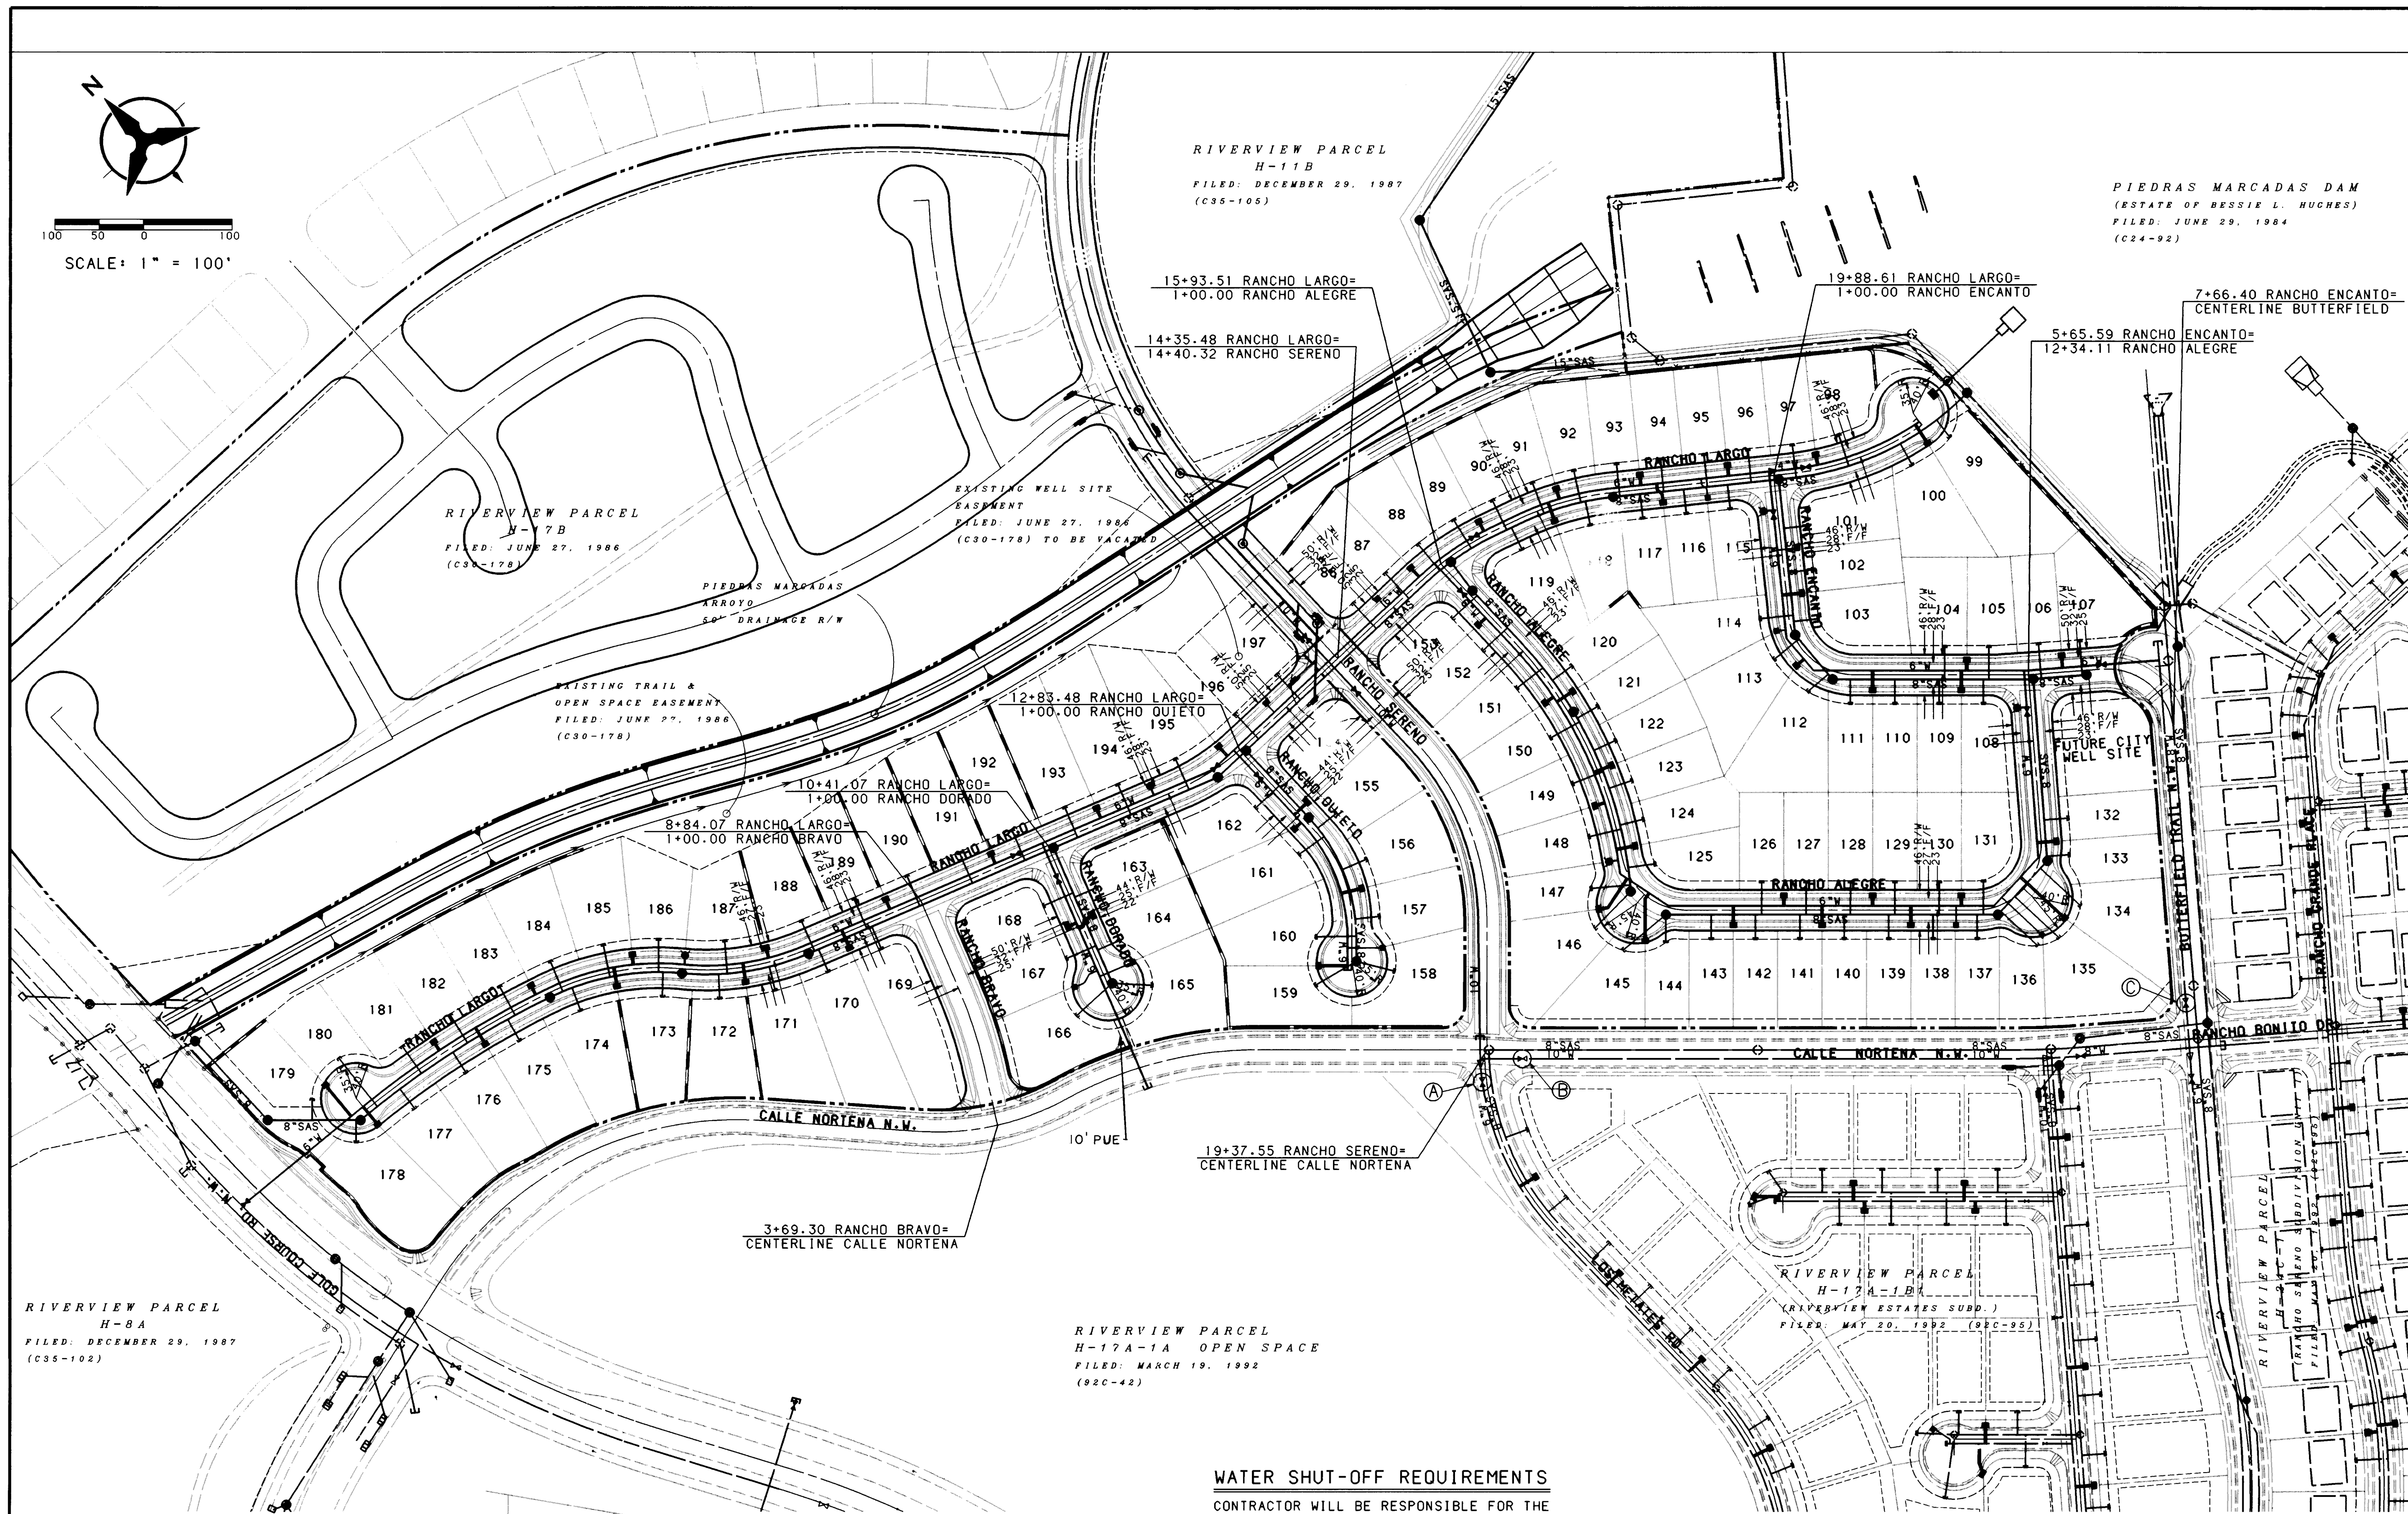

NOTES

- THE CONTRACTOR SHALL FIELD VERIFY ALL EXISTING UTILITY LOCATIONS AND NOTIFY THE ENGINEER IMMEDIATELY OF ANY DISCREPANCIES.
- ALL CURB RETURN RADIUS SHALL BE 25' TO FACE OF CURB UNLESS OTHERWISE SPECIFIED.
- ALL CURVE DATA AND DIMENSIONS REFER TO FACE OF CURB UNLESS OTHERWISE SPECIFIED.
- GRADE ELEVATIONS, WHERE NOTED, ARE FOR TOP OF STANDARD CURB UNLESS OTHERWISE SPECIFIED.
- CONTRACTOR IS TO INSTALL A 4" 4'x5' POST AND END AT THE END OF EACH SANITARY SEWER SERVICE.
- CONTRACTOR IS RESPONSIBLE FOR REPAIR AND/OR REPLACEMENT OF ALL UTILITY CONDUITS AND EXISTING LINES.
- ANY ADDITIONAL GRADING REQUIRED TO MATCH PROPOSED STREET GRADES SHALL BE INCIDENTAL TO PAVING ITEMS.
- CONTRACTOR SHALL PROVIDE THE INSPECTORS, (CITY AND PRIVATE) WITH THE PROPOSED HYDROSTATIC TESTING PLAN. THE PLAN MUST BE APPROVED BEFORE TESTING OPERATIONS BEGIN.
- CONTRACTOR SHALL PARK EQUIPMENT AND VEHICLES AS NOT TO INTERFERE WITH NORMAL ACTIVITIES OF RESIDENTS OR OTHER CONTRACTORS ON SITE.
- ANY DAMAGE TO THE EXISTING FACILITIES (CURB AND GUTTER, PAVEMENT, CONDUITS, LANDSCAPING, UTILITY LINES, ETC.) DURING CONSTRUCTION SHALL BE REPLACED AT THE CONTRACTORS EXPENSE.
- REMOVAL OF THE EXISTING CURB AND GUTTER SHALL BE AS PER COA STD. DWG. 2415 (SAWCUT ONLY).
- WHEEL CHAIR RAMPS SHALL BE CONSTRUCTED PRIOR TO ACCEPTANCE OF CURB AND GUTTER.
- THE FOLLOWING PERSONS SHALL BE NOTIFIED AT LEAST TWO BUSINESS DAYS PRIOR TO INSTALLING UTILITY CONDUIT CROSSINGS:

LEGEND

PROJECT BOUNDARY	---
PROPOSED CURB & GUTTER	---
EXISTING CURB & GUTTER	---
FUTURE SIDEWALK	---
PROPOSED SANITARY SEWER MANHOLE	●
EXISTING SANITARY SEWER MANHOLE	○
PROPOSED FIRE HYDRANT	●
EXISTING FIRE HYDRANT	○
PROPOSED GATE VALVE	+
EXISTING GATE VALVE	+
PROPOSED STORM DRAIN LINE	---
PROPOSED STORM DRAIN MANHOLE	⊙
PROPOSED STORM DRAIN INLET	■
EXISTING STORM DRAIN LINE	---
EXISTING STORM DRAIN MANHOLE	⊙
EXISTING STORM DRAIN INLET	■
PROPOSED SANITARY SEWER LINE	---
EXISTING SANITARY SEWER LINE	---
PROPOSED WATER LINE	---
EXISTING WATER LINE	---
PROPOSED SANITARY SEWER SERVICE	---
PROPOSED WATER METER SERVICE	---

ENGINEERS SEAL

COMPANY PHONE CONTACT

PNM 848-3374 TOM BACA

US WEST 245-6694 BECKY OLESEN

GAS CO. 761-7770 LEO APODACA

JONES 761-6200 YVETTE SUAZO

REVISIONS

NO.	DATE	REMARKS

CITY OF ALBUQUERQUE
PUBLIC WORKS DEPARTMENT
ENGINEERING GROUP

TITLE: RANCHO SERENO SUBDIVISION
UNIT II
OVERALL UTILITY PLAN

APPROVALS	ENGINEER	DATE	APPROVALS	ENGINEER	DATE
DRC CHAIRMAN	Allen S. Schumacher	10-07-93	WATER	R.W. Kane	9-9-97
TRANS. DEV.	W.A. RHO	9-09-93	WASTE WATER	R.W. Kane	9-9-97
HYDROLOGY	A. Schumacher	09/01/93			

DESIGNED BY KLD DATE 8/93
DRAWN BY SAR DATE 8/93
CHECKED BY KLD DATE 8/93

PROJECT NO. 4569.93 MAP C-12 SHEET 17 OF 28
NO. D-12

WATER SHUT-OFF REQUIREMENTS

CONTRACTOR WILL BE RESPONSIBLE FOR THE TIMING AND COORDINATION OF THE WATER SHUT-OFF REQUIREMENTS IN CONJUNCTION WITH THE COMPLETION OF THIS PROJECT.

AT LEAST THREE WORKING DAYS PRIOR TO CONSTRUCTION THE CONTRACTOR SHALL CONTACT PWD/WATER SYSTEMS DIVISION (857-8200) TO INITIATE IMPLEMENTATION OF THIS WATER SHUT-OFF PLAN.

TO CONNECT

10" LINE AT RANCHO SERENO

6" LINE AT BUTTERFIELD TRAIL

6" LINE AT GOLF COURSE ROAD

RECORD DRAWING

I, A. E. Schumacher, Registered Professional Engineer and Land Surveyor in the State of New Mexico, do hereby certify that this "as-built" information was obtained by me or under my supervision and represents the "as-built" conditions of this project, and is true and correct to the best of my knowledge and belief. All vertical and horizontal dimensions should be field verified prior to use on future projects.

A & B
LOS METATES & dimensions should be field verified prior to use on future projects.

C
BUTTERFIELD TR. & CALLE NORTENA

NONE
(PRESSURE CONNECTION)

A. E. Schumacher
NMPE/LS No. 2360

3/31/94
Date

SCANNED BY BY LASON

SERVICE RISER DETAIL

(SERVICE CONNECTION & INSTALLATION TO CONFORM TO COA STD. DWG. 2134. USE CI SOIL PIPE ONLY)

2" MIN. 45°

PIPE INVERT

BHI JOB NO. 92287.01

TYPICAL UTILITY SERVICE LOCATION


NO SCALE

94

MIDDLE OF LOT

10' PUBLIC UTILITIES EASEMENT (TYP.)




USERNAME: CDP21C9228701.PAD1
FILENAME: UTILITY.GRF

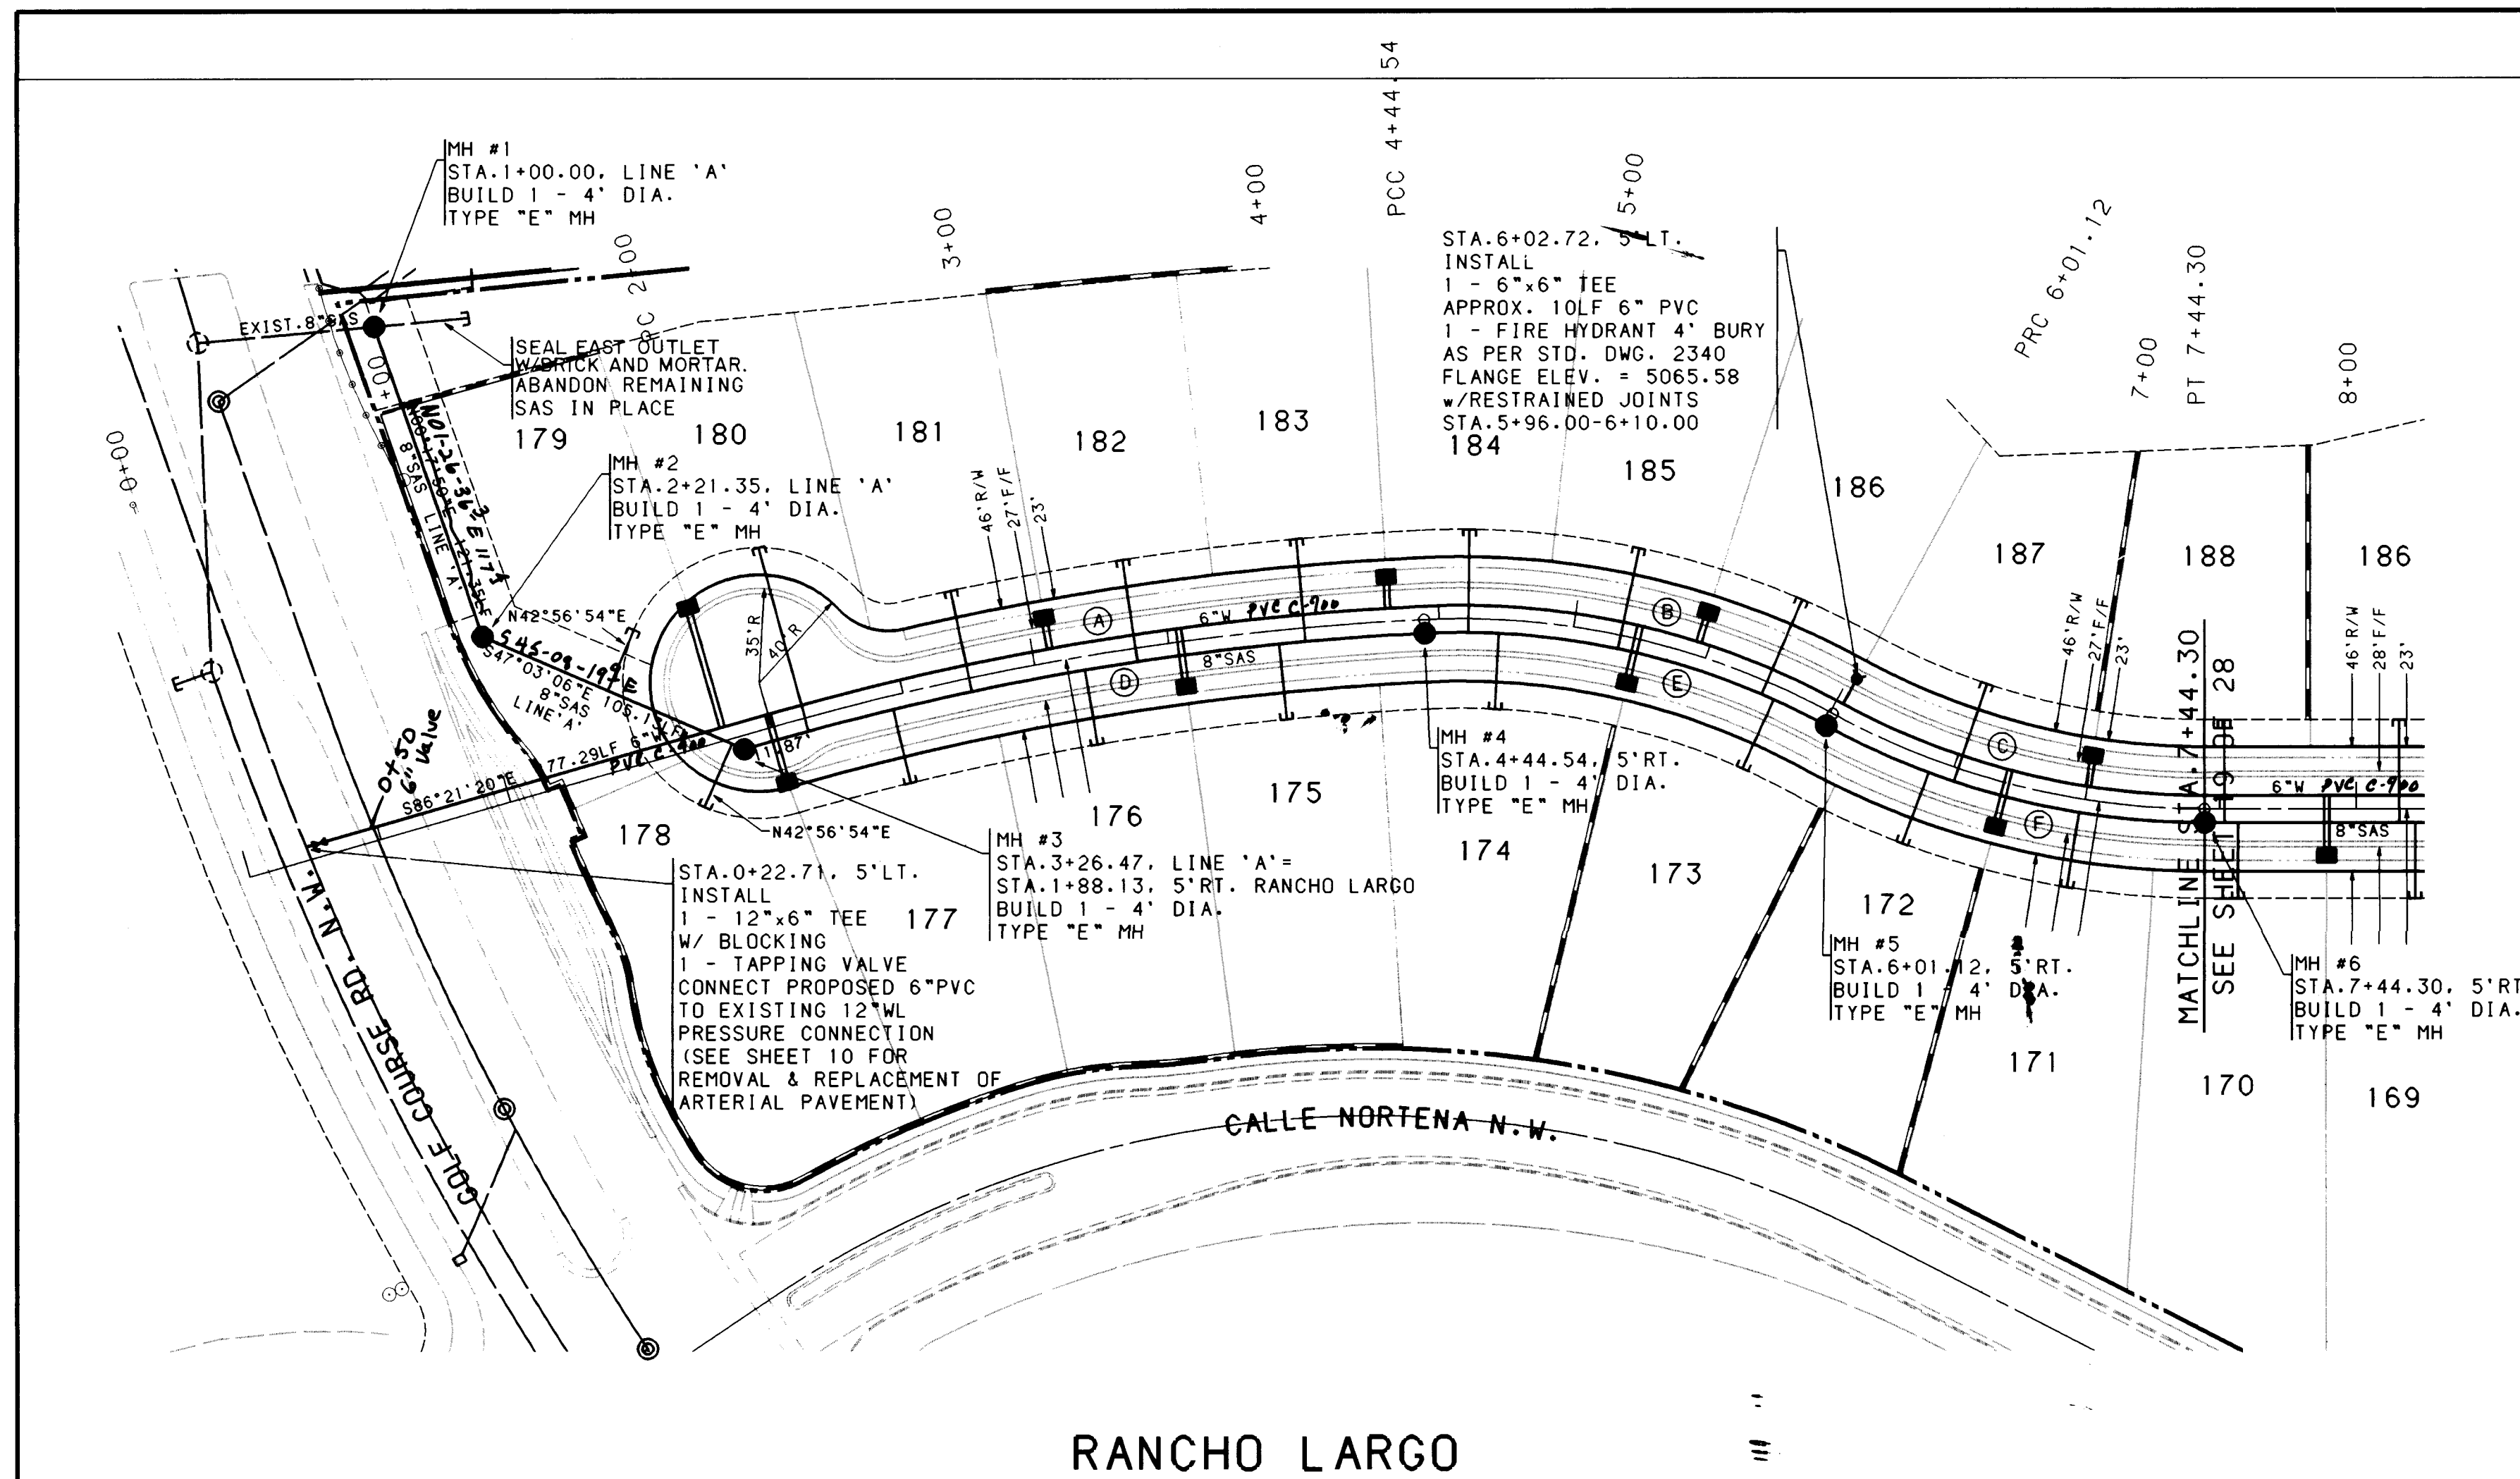

WATERLINE CURVE DATA			WATERLINE CURVE DATA			WATERLINE CURVE DATA		
P.I.	Sta. 3+23.41		P.I.	Sta. 5+26.27		P.I.	Sta. 6+72.97	
Delta	13° 17' 57.9"		Delta	31° 28' 43.0"		Delta	28° 47' 2.8"	
D	5° 24' 46"		D	19° 45' 26"		D	20° 27' 46"	
T	123.41'		T	81.73'		T	71.85'	
L	245.70'		L	159.33'		L	140.67'	
R	1058.52'		R	290.00'		R	280.00'	

SAS CURVE DATA			SAS CURVE DATA			SAS CURVE DATA		
P.I.	Sta. 3+22.24		P.I.	Sta. 5+23.45		P.I.	Sta. 6+75.54	
Delta	13° 17' 57.9"		Delta	31° 28' 43.0"		Delta	28° 47' 2.8"	
D	5° 27' 52"		D	20° 27' 46"		D	19° 45' 26"	
T	122.24'		T	78.91'		T	74.42'	
L	243.38'		L	153.83'		L	145.69'	
R	1048.52'		R	280.00'		R	290.00'	

WATER & SANITARY SEWER SERVICES						
LOT NUMBER	STATION	WL TYPE	STATION & OFFSET	SAS LENGTH	TOP OF PIPE AT PLUG	
179	1+82.51	5.00' LT.	2+71.73, LINE 'A'	24.39'	69.00	
180			2+12.67, 5.00' RT.	70.24'	69.76	
181	3+06.42	5.00' LT.	2+74.99, 5.00' RT.	38.00'	67.92	
182			3+37.65, 5.00' RT.	38.00'	66.44	
183	4+31.34	5.00' LT.	4+00.11, 5.00' RT.	38.00'	64.96	
184			4+60.88, 5.00' RT.	38.00'	63.53	
185	5+45.73	5.00' LT.	5+17.45, 5.00' RT.	38.00'	62.19	
186			5+74.02, 5.00' RT.	38.00'	60.85	
187	7+00.38	5.00' LT.	6+51.55, 5.00' RT.	38.00'	59.30	
188						
178	1+89.51	5.00' LT.	3+21.47, LINE 'A'	25.45'	68.50	
177			2+45.04, 5.00' RT.	28.00'	68.70	
176	3+54.16	5.00' LT.	3+17.94, 5.00' RT.	28.00'	67.05	
175			3+90.38, 5.00' RT.	28.00'	65.48	
174	5+23.74	5.00' LT.	4+72.24, 5.00' RT.	28.00'	63.54	
173			5+79.11, 5.00' RT.	28.00'	60.87	
172	6+70.15	5.00' LT.	6+41.86, 5.00' RT.	28.00'	59.39	
171			6+98.43, 5.00' RT.	28.00'	58.05	

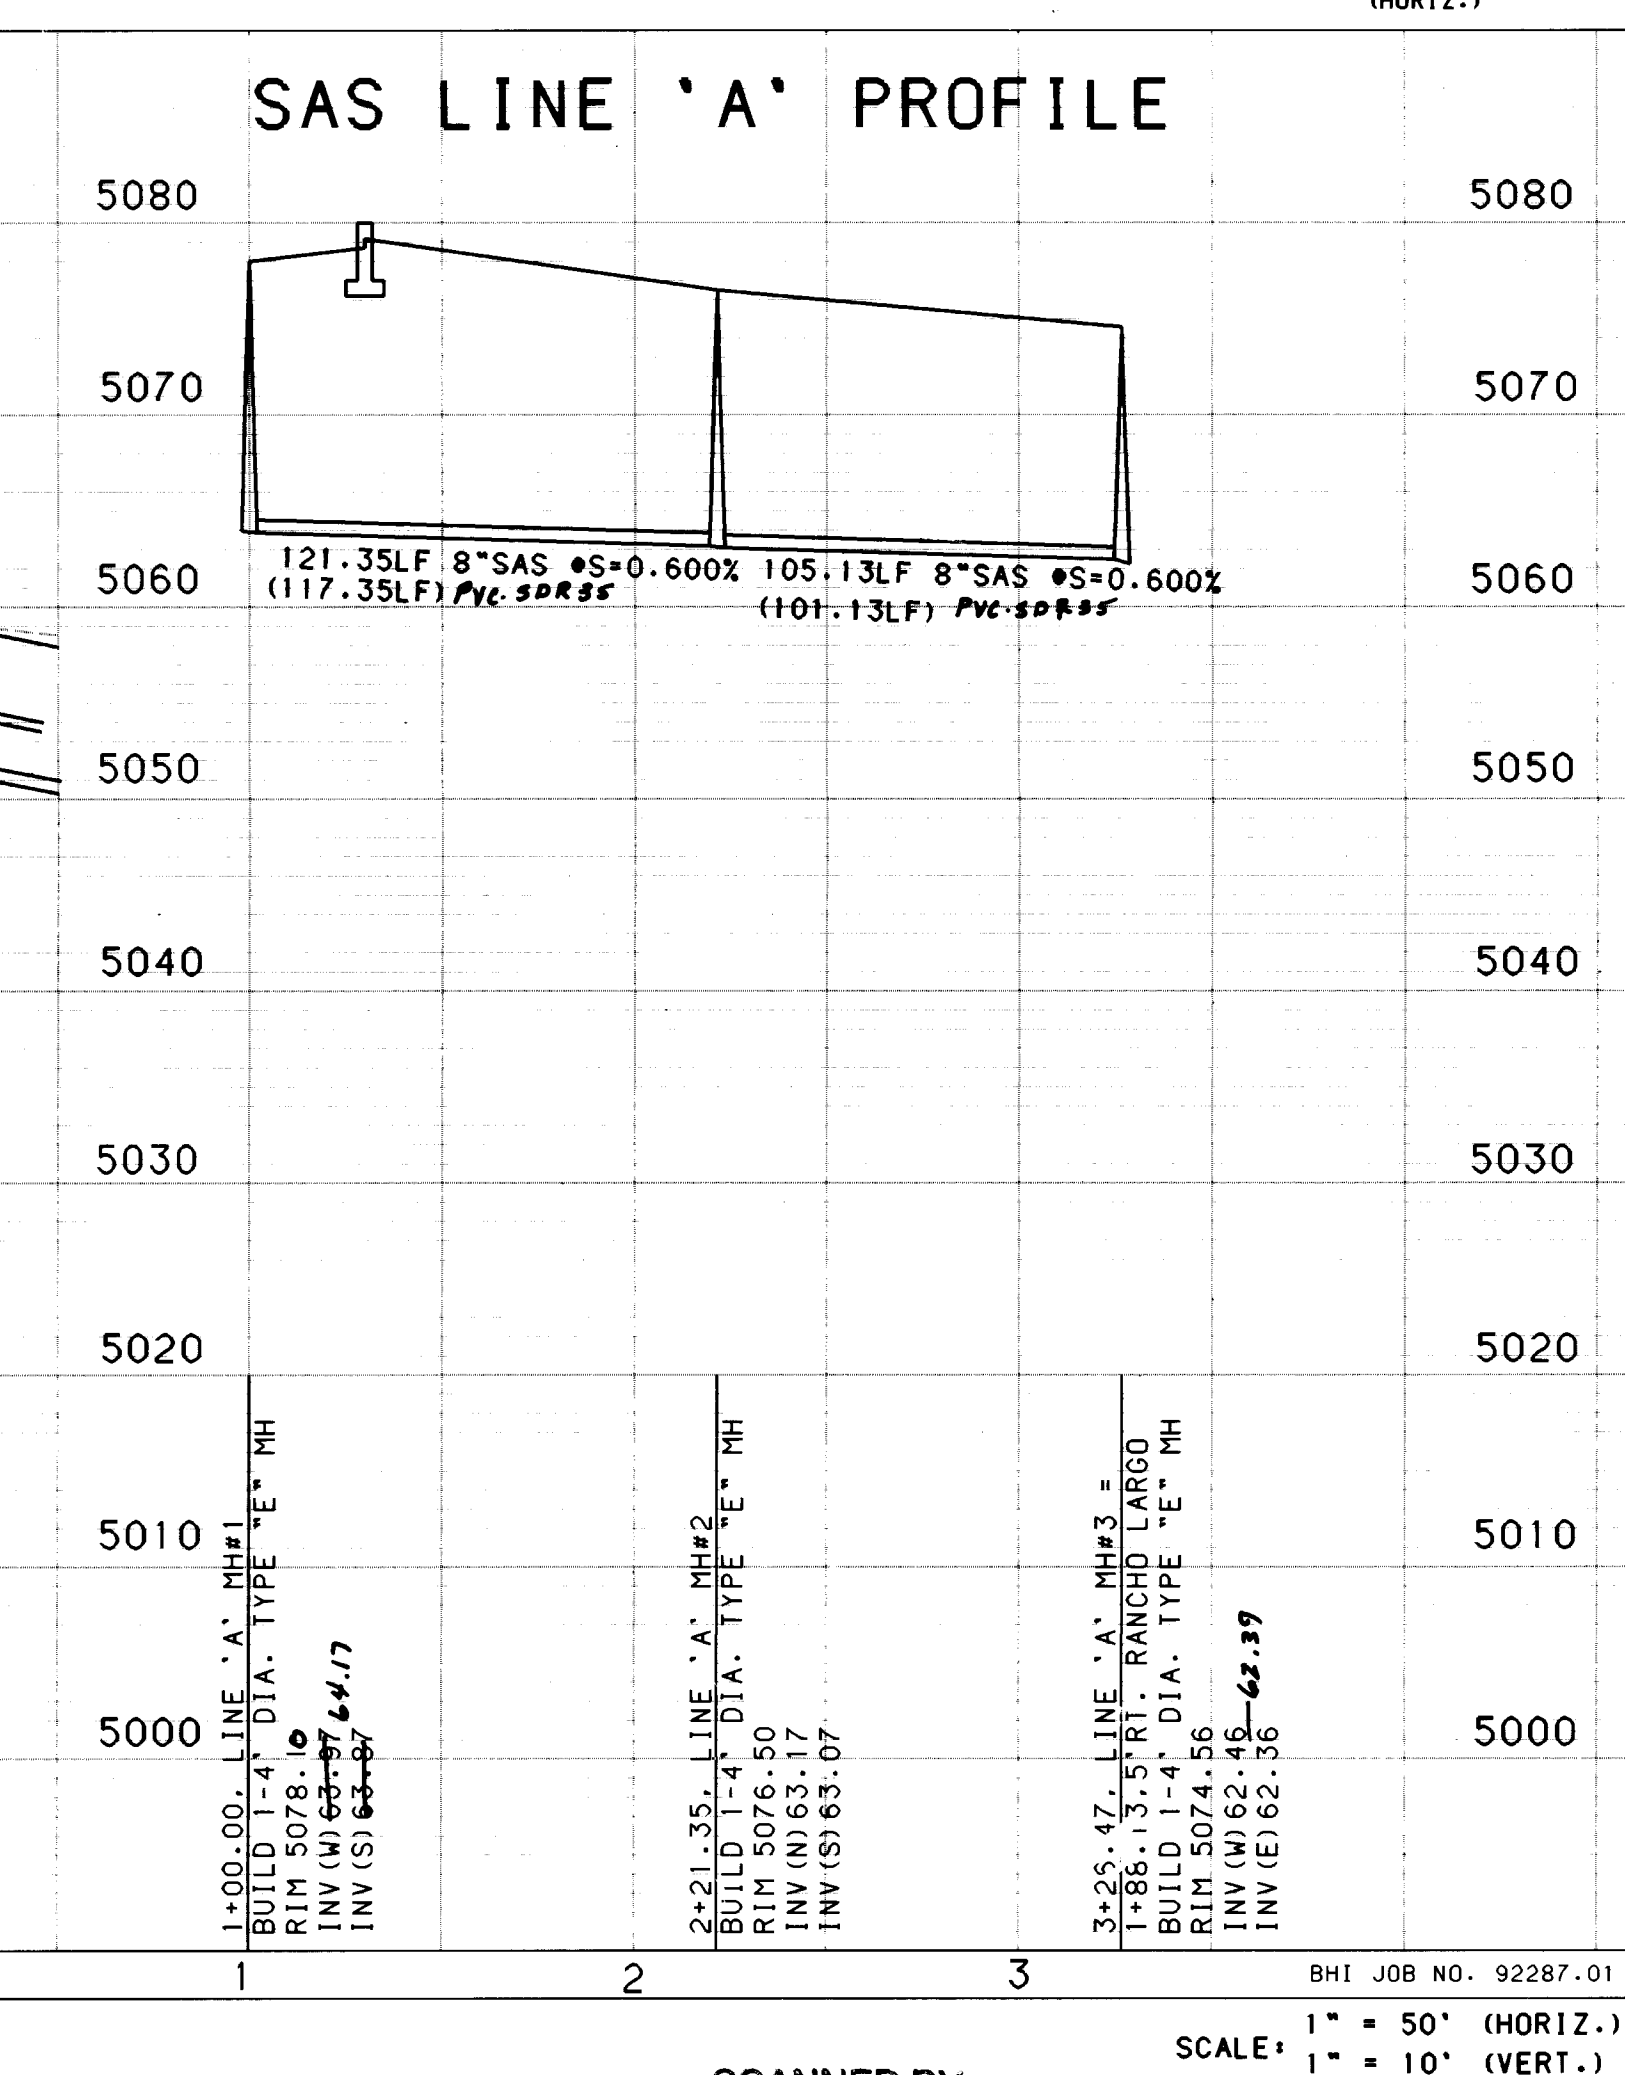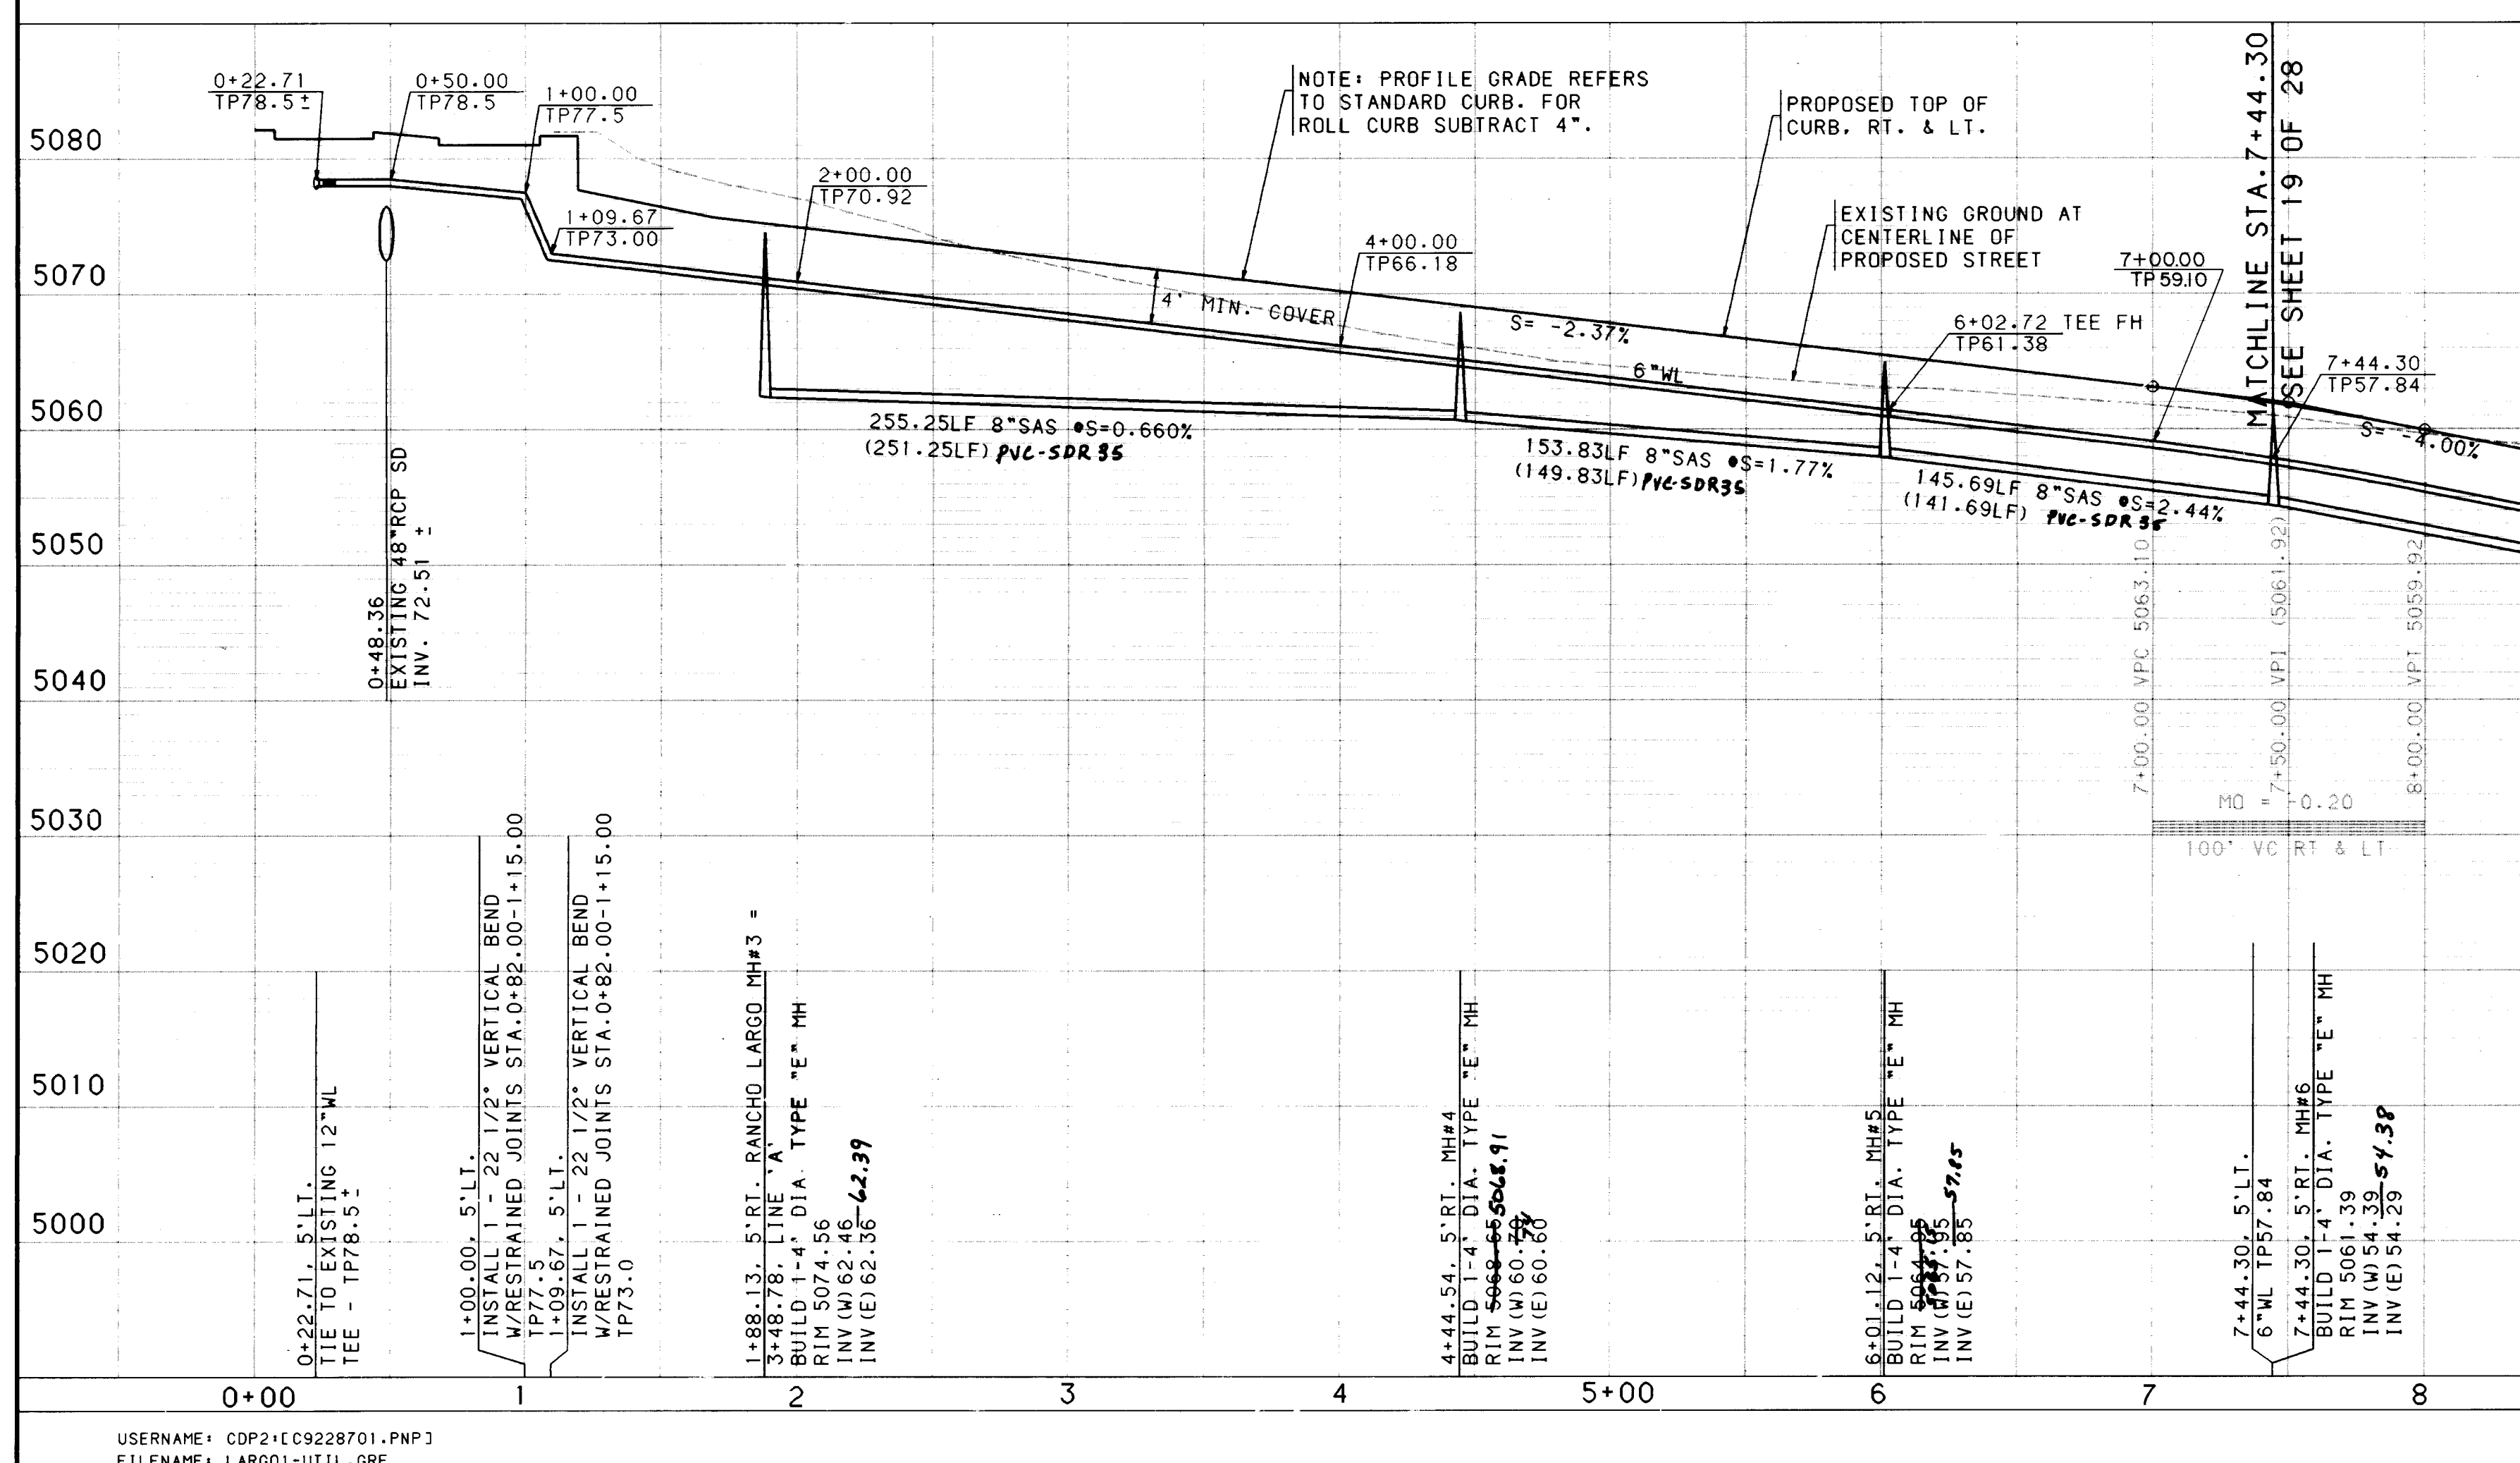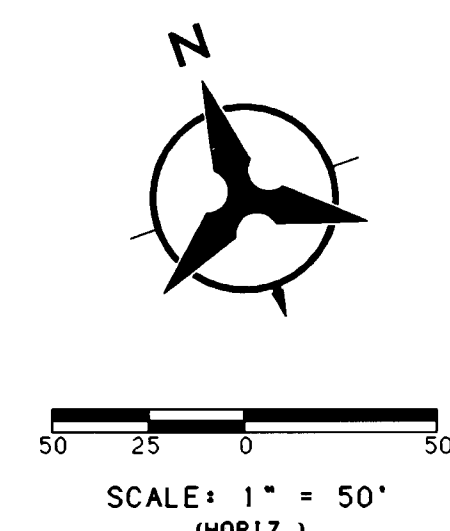

NOTES

- THE CONTRACTOR SHALL FIELD VERIFY ALL EXISTING UTILITY LOCATIONS AND NOTIFY THE ENGINEER IMMEDIATELY OF ANY DISCREPANCIES.
- ALL CURB RETURN RADII SHALL BE 25' TO FACE OF CURB UNLESS OTHERWISE SPECIFIED.
- ALL CURVE DATA AND DIMENSIONS REFER TO FACE OF CURB UNLESS OTHERWISE SPECIFIED.
- GRADE ELEVATIONS, WHERE NOTED, ARE FOR TOP OF STANDARD CURB UNLESS OTHERWISE SPECIFIED.
- CONTRACTOR IS TO INSTALL A 4"x4"x5" POST AND END AT THE END OF EACH SANITARY SEWER SERVICE.
- CONTRACTOR IS RESPONSIBLE FOR REPAIR AND/OR REPLACEMENT OF ALL UTILITY CONDUITS AND EXISTING LINES.
- ANY ADDITIONAL GRADING REQUIRED TO MATCH PROPOSED STREET GRADES SHALL BE INCIDENTAL TO PAVING ITEMS.
- CONTRACTOR SHALL PROVIDE THE INSPECTORS, (CITY AND PRIVATE) WITH THE PROPOSED HYDROSTATIC TESTING PLAN. THE PLAN MUST BE APPROVED BEFORE TESTING OPERATIONS BEGIN.
- CONTRACTOR SHALL PARK EQUIPMENT AND VEHICLES AS NOT TO INTERFERE WITH NORMAL ACTIVITIES OF RESIDENTS OR OTHER CONTRACTORS ON SITE.
- ANY DAMAGE TO THE EXISTING FACILITIES (CURB AND GUTTER, PAVEMENT, CONDUITS, LANDSCAPING, UTILITY LINES, ETC.) DURING CONSTRUCTION SHALL BE REPLACED AT THE CONTRACTORS EXPENSE.
- REMOVAL OF THE EXISTING CURB AND GUTTER SHALL BE AS PER COA STD. DWG. 2415 (SAWCUT ONLY).
- WHEEL CHAIR RAMPS SHALL BE CONSTRUCTED PRIOR TO ACCEPTANCE OF CURB AND GUTTER.
- THE FOLLOWING PERSONS SHALL BE NOTIFIED AT LEAST TWO BUSINESS DAYS PRIOR TO INSTALLING UTILITY CONDUIT CROSSINGS:

COMPANY	PHONE	CONTACT
PNM	848-3374	TOM BACA
US WEST	245-6694	BECKY OLESEN
GAS CO.	761-7770	LED APODACA
JONES	761-6200	YVETTE SUAZO

RECORD DRAWING

I, A. E. Schumacher, Registered Professional Engineer and Land Surveyor in the State of New Mexico, do hereby certify that this "as-built" information was obtained by me or under my supervision and represents the "as-built" conditions of this project, and is true and correct to the best of my knowledge and belief. All vertical and horizontal dimensions should be field verified prior to use on future projects.

A. E. Schumacher
RMP/LS No. 2360

SEAL
A. E. SCHUMACHER
REGISTERED PROFESSIONAL ENGINEER & LAND SURVEYOR
NEW MEXICO
2360

3/31/94
Date

NO.	DATE	REVISIONS
1	2/6	4569.93
2	4/5	69.93
3	4/5	69.93
CITY OF ALBUQUERQUE
PUBLIC WORKS DEPARTMENT
ENGINEERING GROUP


TITLE: RANCHO SERENO SUBDIVISION - UNIT II
UTILITY PLAN & PROFILE
RANCHO LARGO 0+00.00 to 7+44.30

APPROVALS	ENGINEER	DATE	APPROVALS	ENGINEER	DATE
DRC CHAIRMAN	<i>Billie J. Jolly</i>	10-07-93	WATER	<i>R.W. Kane</i>	9-9-93
TRANS. DEV.	<i>N/A</i>	9-27-93	WASTE WATER	<i>R.W. Kane</i>	9-9-93
HYDROLOGY	<i>N/A</i>	09-09-93			

PROJECT NO. 4569.93


MAP C-12 NO. D-12

SHEET 18 OF 28

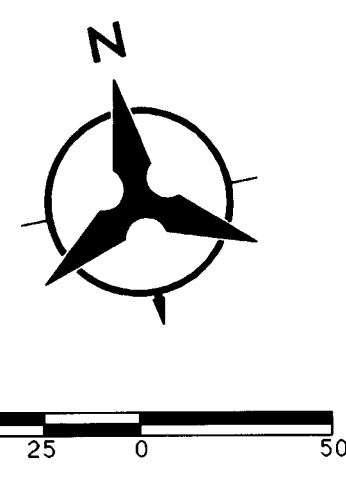

WATER & SANITARY SEWER SERVICES						
LOT NUMBER	STATION & OFFSET	WL TYPE	SAS STATION & OFFSET	SAS LENGTH	TOP OF PIPE AT PLUG	
86	15+15.48, 5.00' LT.	SINGLE	14+90.48, 5.00' RT.	40.00'	43.17	
87	15+65.48, 5.00' LT.	DOUBLE	15+40.48, 5.00' RT.	40.00'	42.74	
88			15+87.59, 5.00' RT.	39.51'	42.40	
89	16+53.57, 5.00' LT.	DOUBLE	16+31.59, 5.00' RT.	38.60'	42.18	
90			16+77.18, 5.00' RT.	38.00'	41.84	
170	7+89.07, 5.00' LT.	DOUBLE	7+56.57, 5.00' RT.	28.00'	56.54	
169			8+21.57, 5.00' RT.	28.00'	54.09	
119	-----	-----	16+82.96, 5.00' RT.	28.00'	42.58	

RANCHO LARGO

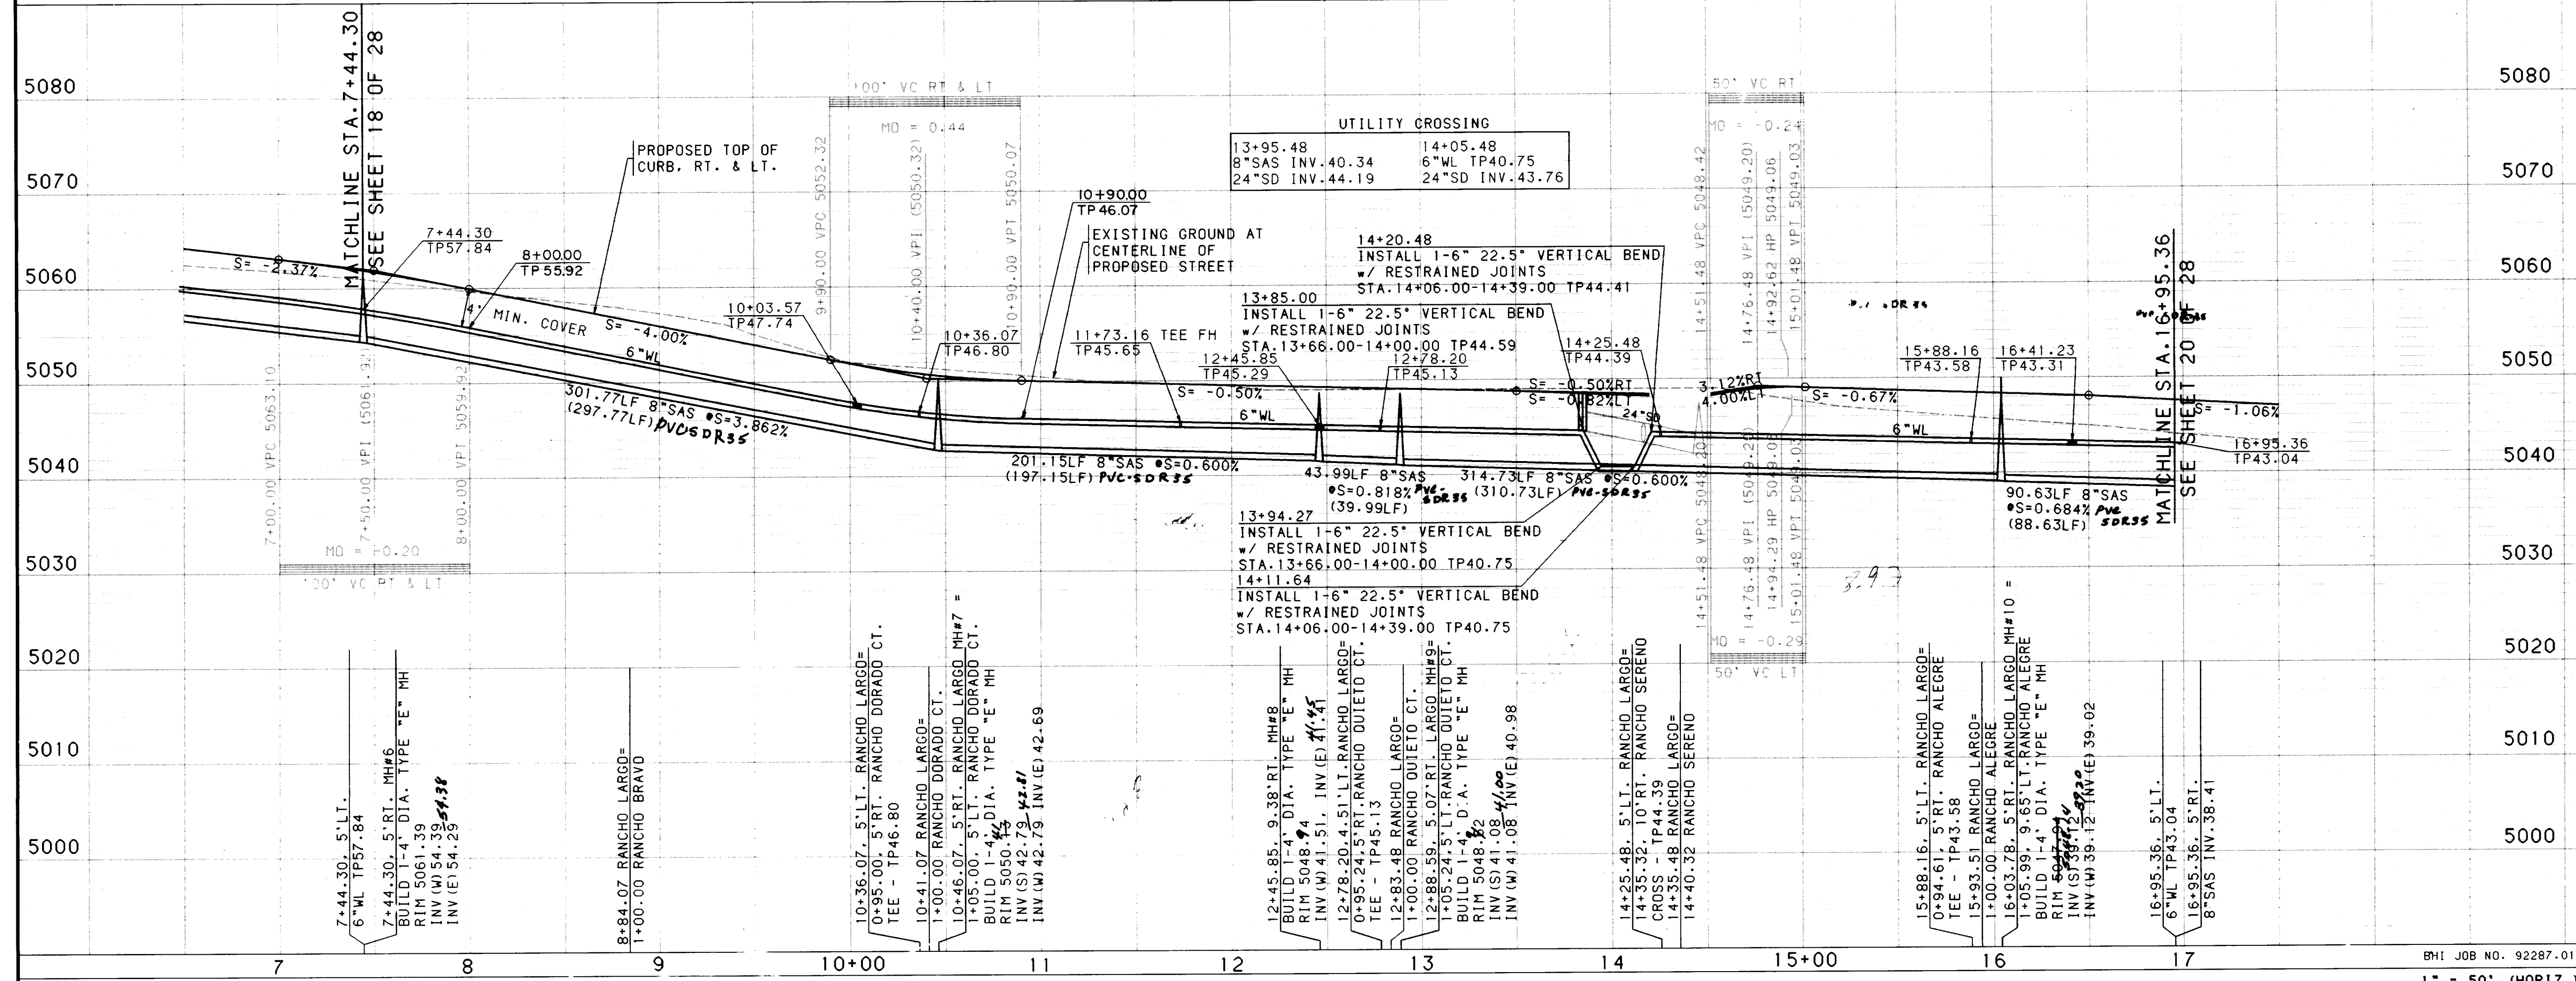


NOTES

1. THE CONTRACTOR SHALL FIELD VERIFY ALL EXISTING UTILITY LOCATIONS AND NOTIFY THE ENGINEER IMMEDIATELY OF ANY DISCREPANCIES.
2. ALL CURB RETURN RADIi SHALL BE 25' TO FACE OF CURB UNLESS OTHERWISE SPECIFIED.
3. ALL CURVE DATA AND DIMENSIONS REFER TO FACE OF CURB UNLESS OTHERWISE SPECIFIED.
4. GRADE ELEVATIONS, WHERE NOTED, ARE FOR TOP OF STANDARD CURB UNLESS OTHERWISE SPECIFIED.
5. CONTRACTOR IS TO INSTALL A 4"x4"x5' POST AND END AT THE END OF EACH SANITARY SEWER SERVICE.
6. CONTRACTOR IS RESPONSIBLE FOR REPAIR AND/OR REPLACEMENT OF ALL UTILITY CONDUITS AND EXISTING LINES.
7. ANY ADDITIONAL GRADING REQUIRED TO MATCH PROPOSED STREET GRADES SHALL BE INCIDENTAL TO PAVING ITEMS.
8. CONTRACTOR SHALL PROVIDE THE INSPECTORS, (CITY AND PRIVATE) WITH THE PROPOSED HYDROSTATIC TESTING PLAN. THE PLAN MUST BE APPROVED BEFORE TESTING OPERATIONS BEGIN.
9. CONTRACTOR SHALL PARK EQUIPMENT AND VEHICLES AS NOT TO INTERFERE WITH NORMAL ACTIVITIES OF RESIDENTS OR OTHER CONTRACTORS ON SITE.
10. ANY DAMAGE TO THE EXISTING FACILITIES (CURB AND GUTTER, PAVEMENT, CONDUITS, LANDSCAPING, UTILITY LINES, ETC.) DURING CONSTRUCTION SHALL BE REPLACED AT THE CONTRACTORS EXPENSE.
11. REMOVAL OF THE EXISTING CURB AND GUTTER SHALL BE AS PER COA STD. DWG. 2415 (SAWCUT ONLY).
12. WHEEL CHAIR RAMPS SHALL BE CONSTRUCTED PRIOR TO ACCEPTANCE OF CURB AND GUTTER.
13. THE FOLLOWING PERSONS SHALL BE NOTIFIED AT LEAST TWO BUSINESS DAYS PRIOR TO INSTALLING UTILITY CONDUIT CROSSINGS:


SURVEY INFORMATION		BENCH MARKS	AS BUILT INFORMATION	
NO.	FIELD NOTES		CONTRACTOR	NEW CONCEPTS INC
	BY DATE		WORKED BY <i>ACI</i>	DATE <i>3/94</i>
		STATION MARK IS A STANDARD USC&GS BRASS	INSPECTOR'S	DATE <i>4/94</i>
		TABLET, STAMPED "HUGHES, 1954". SET IN TOP OF	ACCEPTANCE BY <i>ACI</i>	DATE <i>4/94</i>
		A CONCRETE POST PROJECTING 0.3 FT. ABOVE THE	VERIFICATION BY <i>ACI</i>	DATE <i>4/94</i>
		GROUND. TO REACH THE STATION FROM THE	DRAWINGS	DATE <i>4/94</i>
		INTERSECTION OF CENTRAL AVE. AND STATE RD. 448.	CORRECTED BY <i>ACI</i>	
		GO NORTH ON STATE RD. 448, 6.1 MILES.	<i>MICRO-FILM INFORMATION</i>	
		THE STATION IS 450' WEST OF STATE RD. 448 IN	RECORDED BY	DATE
		A FENCED-IN PRAIRIE. ELEV. = 5049.93	NO.	

COMPANY	PHONE	CONTACT
PNM	848-3374	TOM BACA
US WEST	245-6694	BECKY OLESEN
GAS CO.	761-7770	LEO APODACA
JONES	761-6200	YVETTE SUAZO

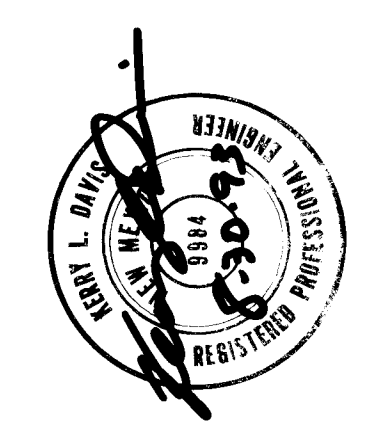

RECORD DRAWING

I, A. E. Schunacher, Registered Professional Engineer and Land Surveyor in the State of New Mexico, do hereby certify that this "as-built" information was obtained by me or under my supervision and represents the "as-built" conditions of this project, and is true and correct to the best of my knowledge and belief. All vertical and horizontal dimensions should be field verified prior to use on future projects.

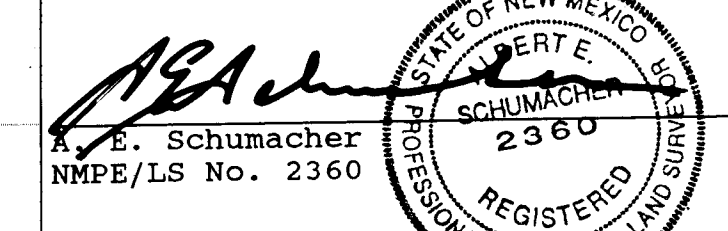


1	2	3	4	5	6	7	8	9	10	11	12	13	14	15
26	45	69	93	19	94									

	CITY OF ALBUQUERQUE PUBLIC WORKS DEPARTMENT ENGINEERING GROUP	
---	---	---

TITLE: RANCHO SERENO SUBDIVISION - UNIT II
UTILITY PLAN & PROFILE
RANCHO LARGO 7+44.30 to 16+95.36

APPROVALS	ENGINEER	DATE	APPROVALS	ENGINEER	DATE
DRC CHAIRMAN	<i>Billy Goodley</i>	10-07-93	WATER	<i>R.W. Kame</i>	9-9-93
TRANS. DEV.	<i>W. H. H.</i>	9-9-93	WASTE WATER	<i>R.W. Kame</i>	9-9-93
HYDROLOGY	<i>A. Allen</i>	09/09/93			



PROJECT NO.	4569.93	MAP C-12 NO. D-12	SHEET 19 OF 28
-------------	---------	-------------------	----------------

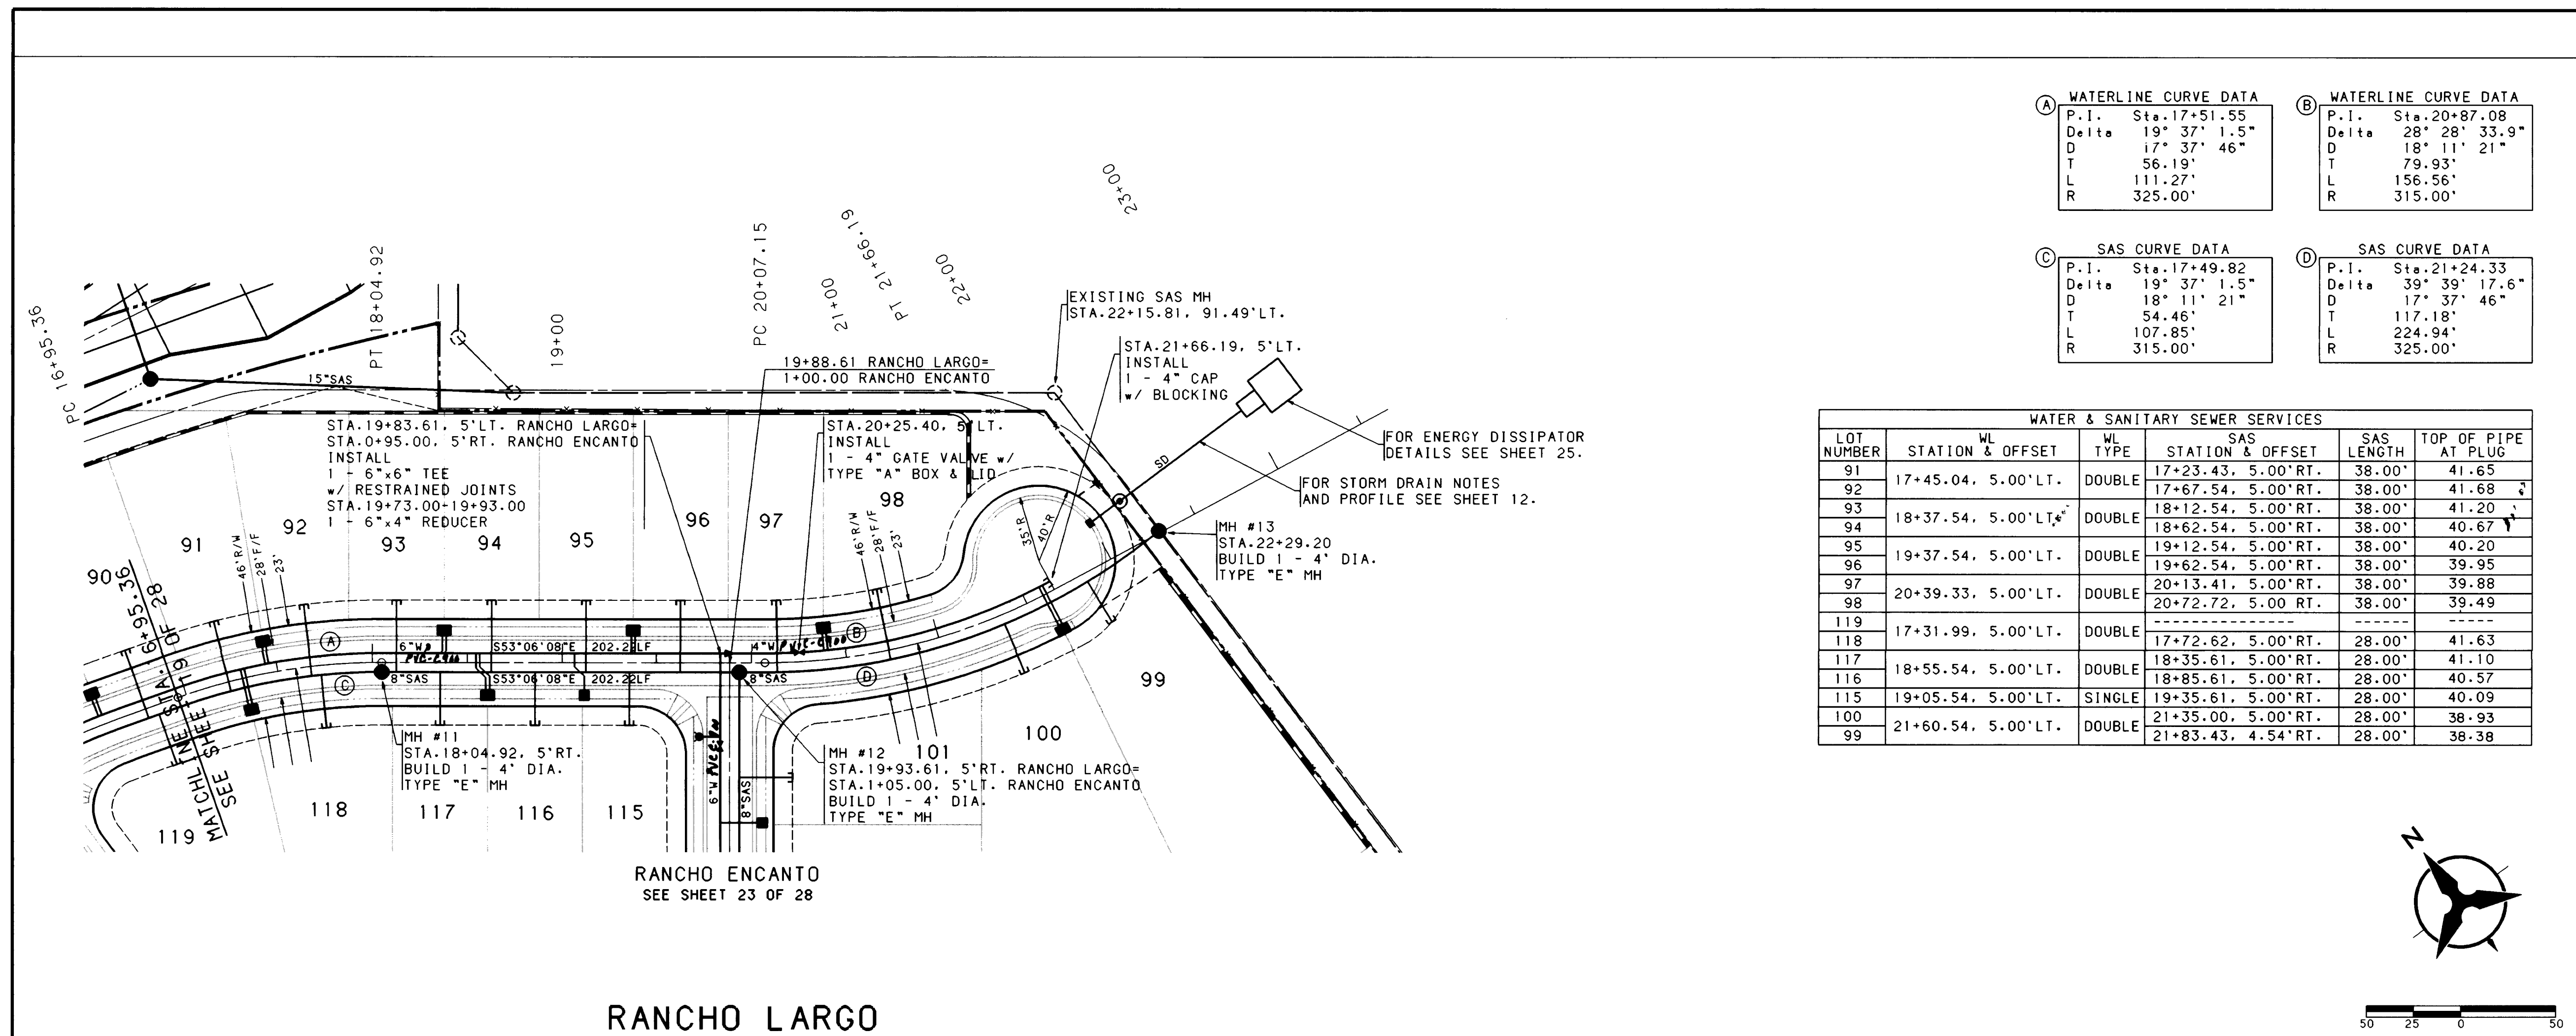

A WATERLINE CURVE DATA		B WATERLINE CURVE DATA	
P.I.	Sta. 17+51.55	P.I.	Sta. 20+87.08
Delta	19° 37' 1.5"	Delta	28° 28' 33.9"
D	17' 37' 46"	D	18' 11' 21"
T	56.19'	T	79.33'
L	111.27'	L	156.56'
R	325.00'	R	315.00'

C SAS CURVE DATA		D SAS CURVE DATA	
P.I.	Sta. 17+49.82	P.I.	Sta. 21+24.33
Delta	19° 37' 1.5"	Delta	39° 39' 17.6"
D	18' 11' 21"	D	17' 37' 46"
T	54.46'	T	117.18'
L	107.85'	L	224.94'
R	315.00'	R	325.00'

WATER & SANITARY SEWER SERVICES					
LOT NUMBER	STATION & OFFSET	WL TYPE	SAS STATION & OFFSET	SAS LENGTH	TOP OF PIPE AT PLUG
91	17+45.04, 5.00' LT.	DOUBLE	17+23.43, 5.00' RT.	38.00'	41.65
92	17+45.04, 5.00' LT.	DOUBLE	17+67.54, 5.00' RT.	38.00'	41.68
93	18+37.54, 5.00' LT.	DOUBLE	18+12.54, 5.00' RT.	38.00'	41.20
94	18+37.54, 5.00' LT.	DOUBLE	18+62.54, 5.00' RT.	38.00'	40.67
95	19+37.54, 5.00' LT.	DOUBLE	19+12.54, 5.00' RT.	38.00'	40.20
96	19+37.54, 5.00' LT.	DOUBLE	19+62.54, 5.00' RT.	38.00'	39.95
97	20+39.33, 5.00' LT.	DOUBLE	20+13.41, 5.00' RT.	38.00'	39.88
98	20+39.33, 5.00' LT.	DOUBLE	20+72.72, 5.00' RT.	38.00'	39.49
119	17+31.99, 5.00' LT.	DOUBLE	17+72.62, 5.00' RT.	28.00'	41.63
118	17+31.99, 5.00' LT.	DOUBLE	18+35.61, 5.00' RT.	28.00'	41.10
117	18+55.54, 5.00' LT.	DOUBLE	18+85.61, 5.00' RT.	28.00'	40.57
116	19+05.54, 5.00' LT.	SINGLE	19+35.61, 5.00' RT.	28.00'	40.09
100	21+60.54, 5.00' LT.	DOUBLE	21+35.00, 5.00' RT.	28.00'	38.93
99	21+60.54, 5.00' LT.	DOUBLE	21+83.43, 4.54' RT.	28.00'	38.38

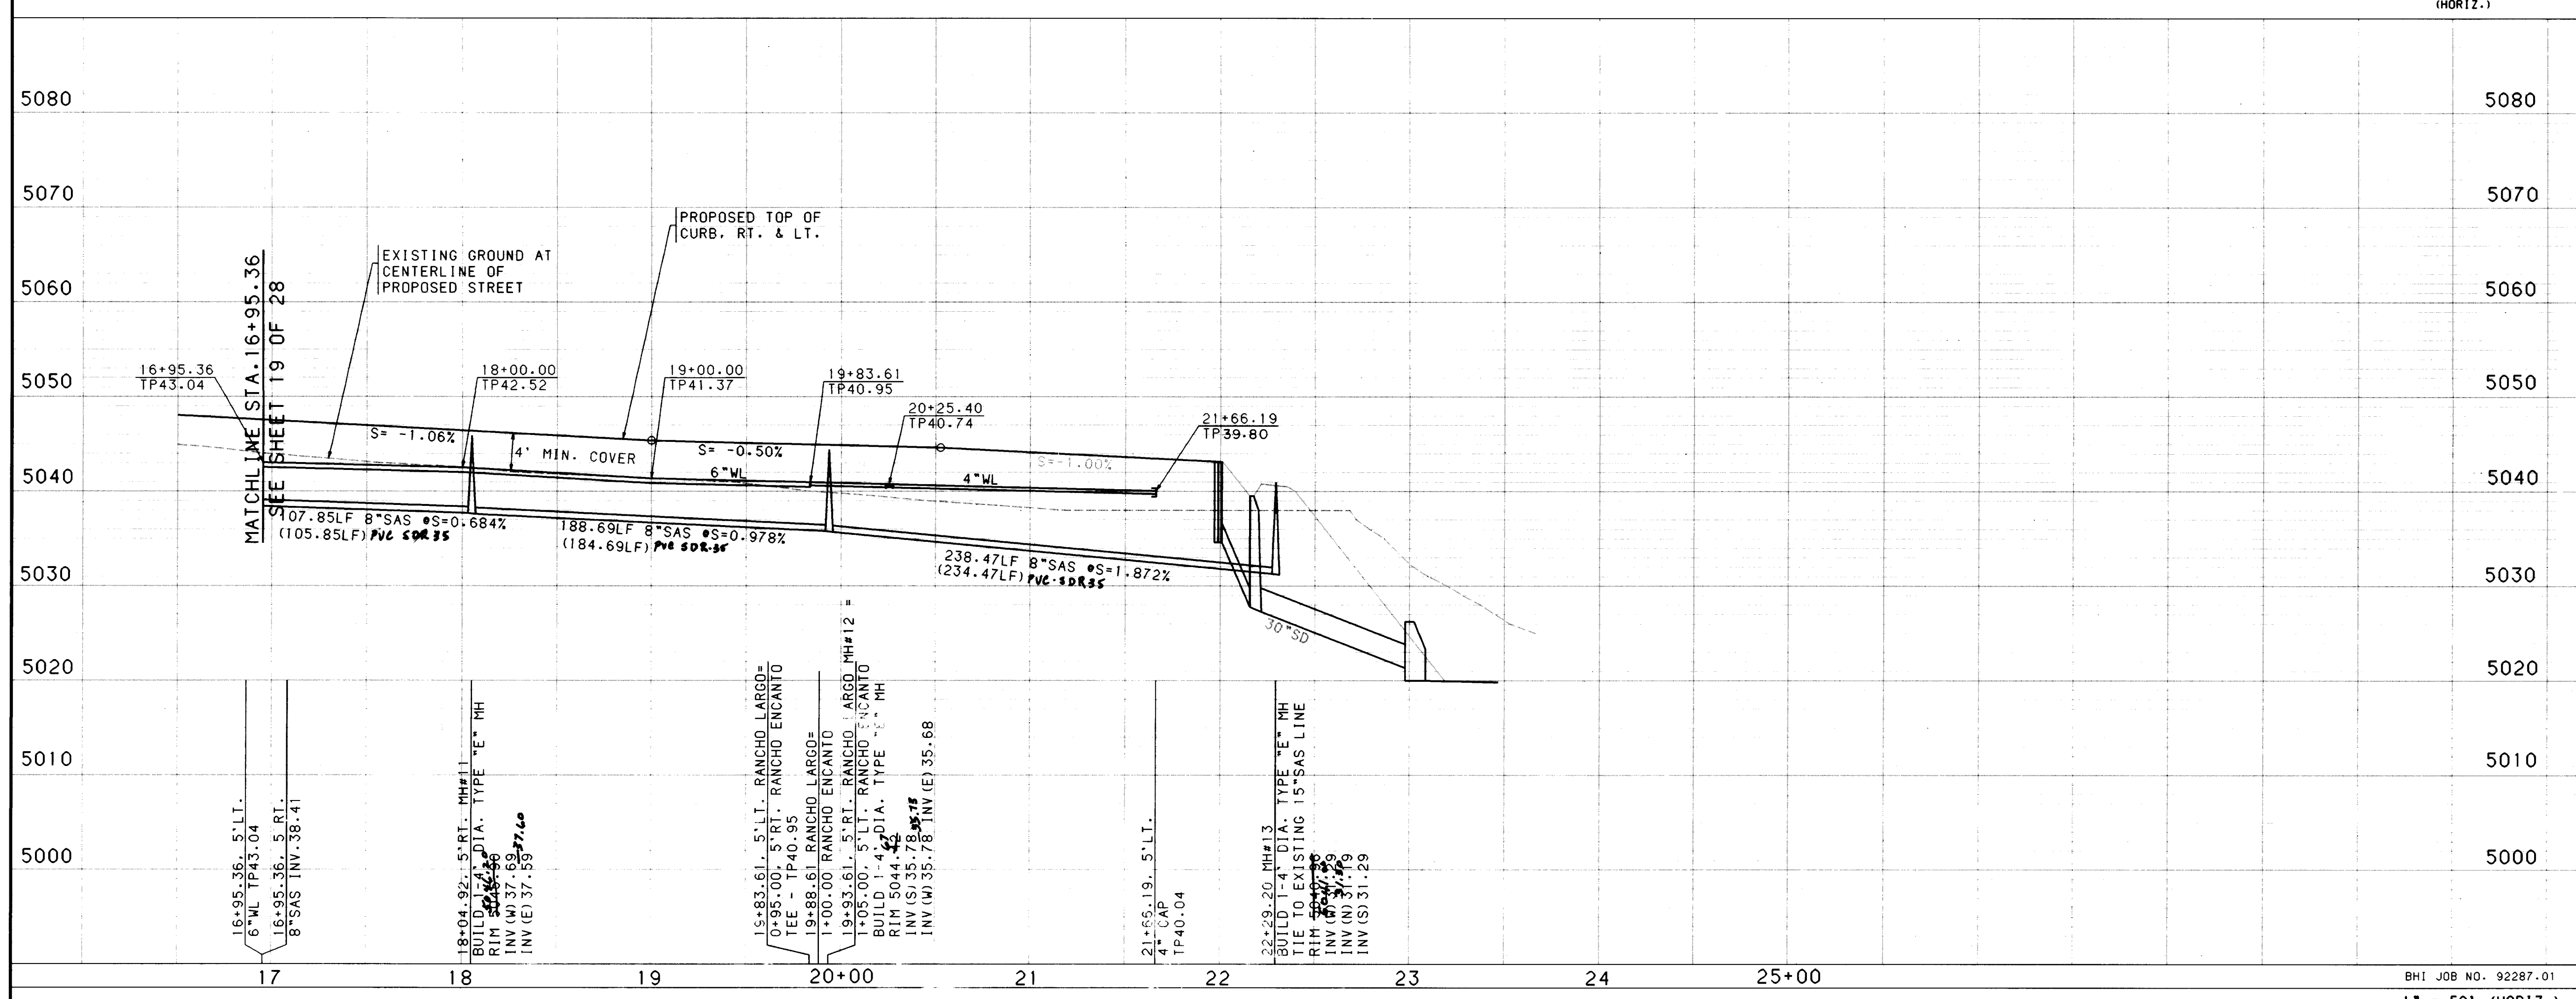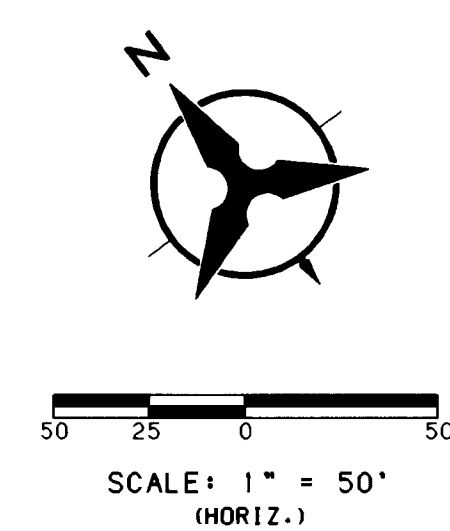

NOTES

- THE CONTRACTOR SHALL FIELD VERIFY ALL EXISTING UTILITY LOCATIONS AND NOTIFY THE ENGINEER IMMEDIATELY OF ANY DISCREPANCIES.
- ALL CURB RETURN RADII SHALL BE 25' TO FACE OF CURB UNLESS OTHERWISE SPECIFIED.
- ALL CURVE DATA AND DIMENSIONS REFER TO FACE OF CURB UNLESS OTHERWISE SPECIFIED.
- GRADE ELEVATIONS, WHERE NOTED, ARE FOR TOP OF STANDARD CURB UNLESS OTHERWISE SPECIFIED.
- CONTRACTOR IS TO INSTALL A 4"x4"x5' POST AND END AT THE END OF EACH SANITARY SEWER SERVICE.
- CONTRACTOR IS RESPONSIBLE FOR REPAIR AND/OR REPLACEMENT OF ALL UTILITY CONDUITS AND EXISTING LINES.
- ANY ADDITIONAL GRADING REQUIRED TO MATCH PROPOSED STREET GRADES SHALL BE INCIDENTAL TO PAVING ITEMS.
- CONTRACTOR SHALL PROVIDE THE INSPECTORS (CITY AND PRIVATE) WITH THE PROPOSED HYDROSTATIC TESTING PLAN. THE PLAN MUST BE APPROVED BEFORE TESTING OPERATIONS BEGIN.
- CONTRACTOR SHALL PARK EQUIPMENT AND VEHICLES AS NOT TO INTERFERE WITH NORMAL ACTIVITIES OF RESIDENTS OR OTHER CONTRACTORS ON SITE.
- REMOVAL OF THE EXISTING CURB AND GUTTER SHALL BE AS PER COA STD. DWG. 2415 (SAWCUT ONLY).
- WHEEL CHAIR RAMPS SHALL BE CONSTRUCTED PRIOR TO ACCEPTANCE OF CURB AND GUTTER.
- THE FOLLOWING PERSONS SHALL BE NOTIFIED AT LEAST TWO BUSINESS DAYS PRIOR TO INSTALLING UTILITY CONDUIT CROSSINGS:

COMPANY	PHONE	CONTACT
PNM	848-3374	TOM BACA
US WEST	245-6694	BECKY OLESEN
GAS CO.	761-7770	LEO APODACA
JONES	761-6200	YVETTE SUAZO

RECORD DRAWING

I, A. E. Schumacher, Registered Professional Engineer and Land Surveyor in the State of New Mexico, do hereby certify that this "as-built" information was obtained by me or under my supervision and represents the "as-built" conditions of this project, and is true and correct to the best of my knowledge and belief. All vertical and horizontal dimensions should be field verified prior to use on future projects.

A. E. Schumacher
NMPE/LS No. 2360

REVISIONS

NO.	DATE	REMARKS
1	26	4569.932094

**CITY OF ALBUQUERQUE
PUBLIC WORKS DEPARTMENT
ENGINEERING GROUP**

**TITLE: RANCHO SERENO SUBDIVISION - UNIT II
UTILITY PLAN & PROFILE
RANCHO LARGO 16+95.36 to 25+00.00**

APPROVALS	ENGINEER	DATE	APPROVALS	ENGINEER	DATE
DRC CHAIRMAN	<i>Billy Schumacher</i>	10-07-93	WATER	<i>R.W. Kane</i>	9-9-93
TRANS. DEV.	<i>W. L. Kane</i>	9-09-93	WASTE WATER	<i>R.W. Kane</i>	9-9-93
HYDROLOGY	<i>A. E. Schumacher</i>	09-09-93			

PROJECT NO. 4569.93 MAP C-12 NO. D-12 SHEET 20 OF 28

AS BUILT INFORMATION

CONTRACTOR	DATE	INSPECTOR'S	DATE	VERIFICATION BY	DATE	DRAGMAN	DATE	RECORDED BY	DATE
New Concepts Inc.	10-07-93	R. E. Rutledge	10-07-93	BY					


ENGINEERS SEAL

A. E. Schumacher
REGISTERED PROFESSIONAL ENGINEER & LAND SURVEYOR
STATE OF NEW MEXICO
NO. 2360

REVISIONS

NO.	DATE	REMARKS
1	26	4569.932094


DESIGNED BY KLD DATE 8/93
DRAWN BY SAR DATE 8/93
CHECKED BY KLD DATE 8/93

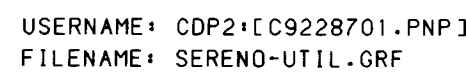

SCANNED BY
BY LASON

SCALE: 1" = 50' (HORIZ.)
1" = 10' (VERT.)

Copyright Bohannon-Huston, Inc. 1993

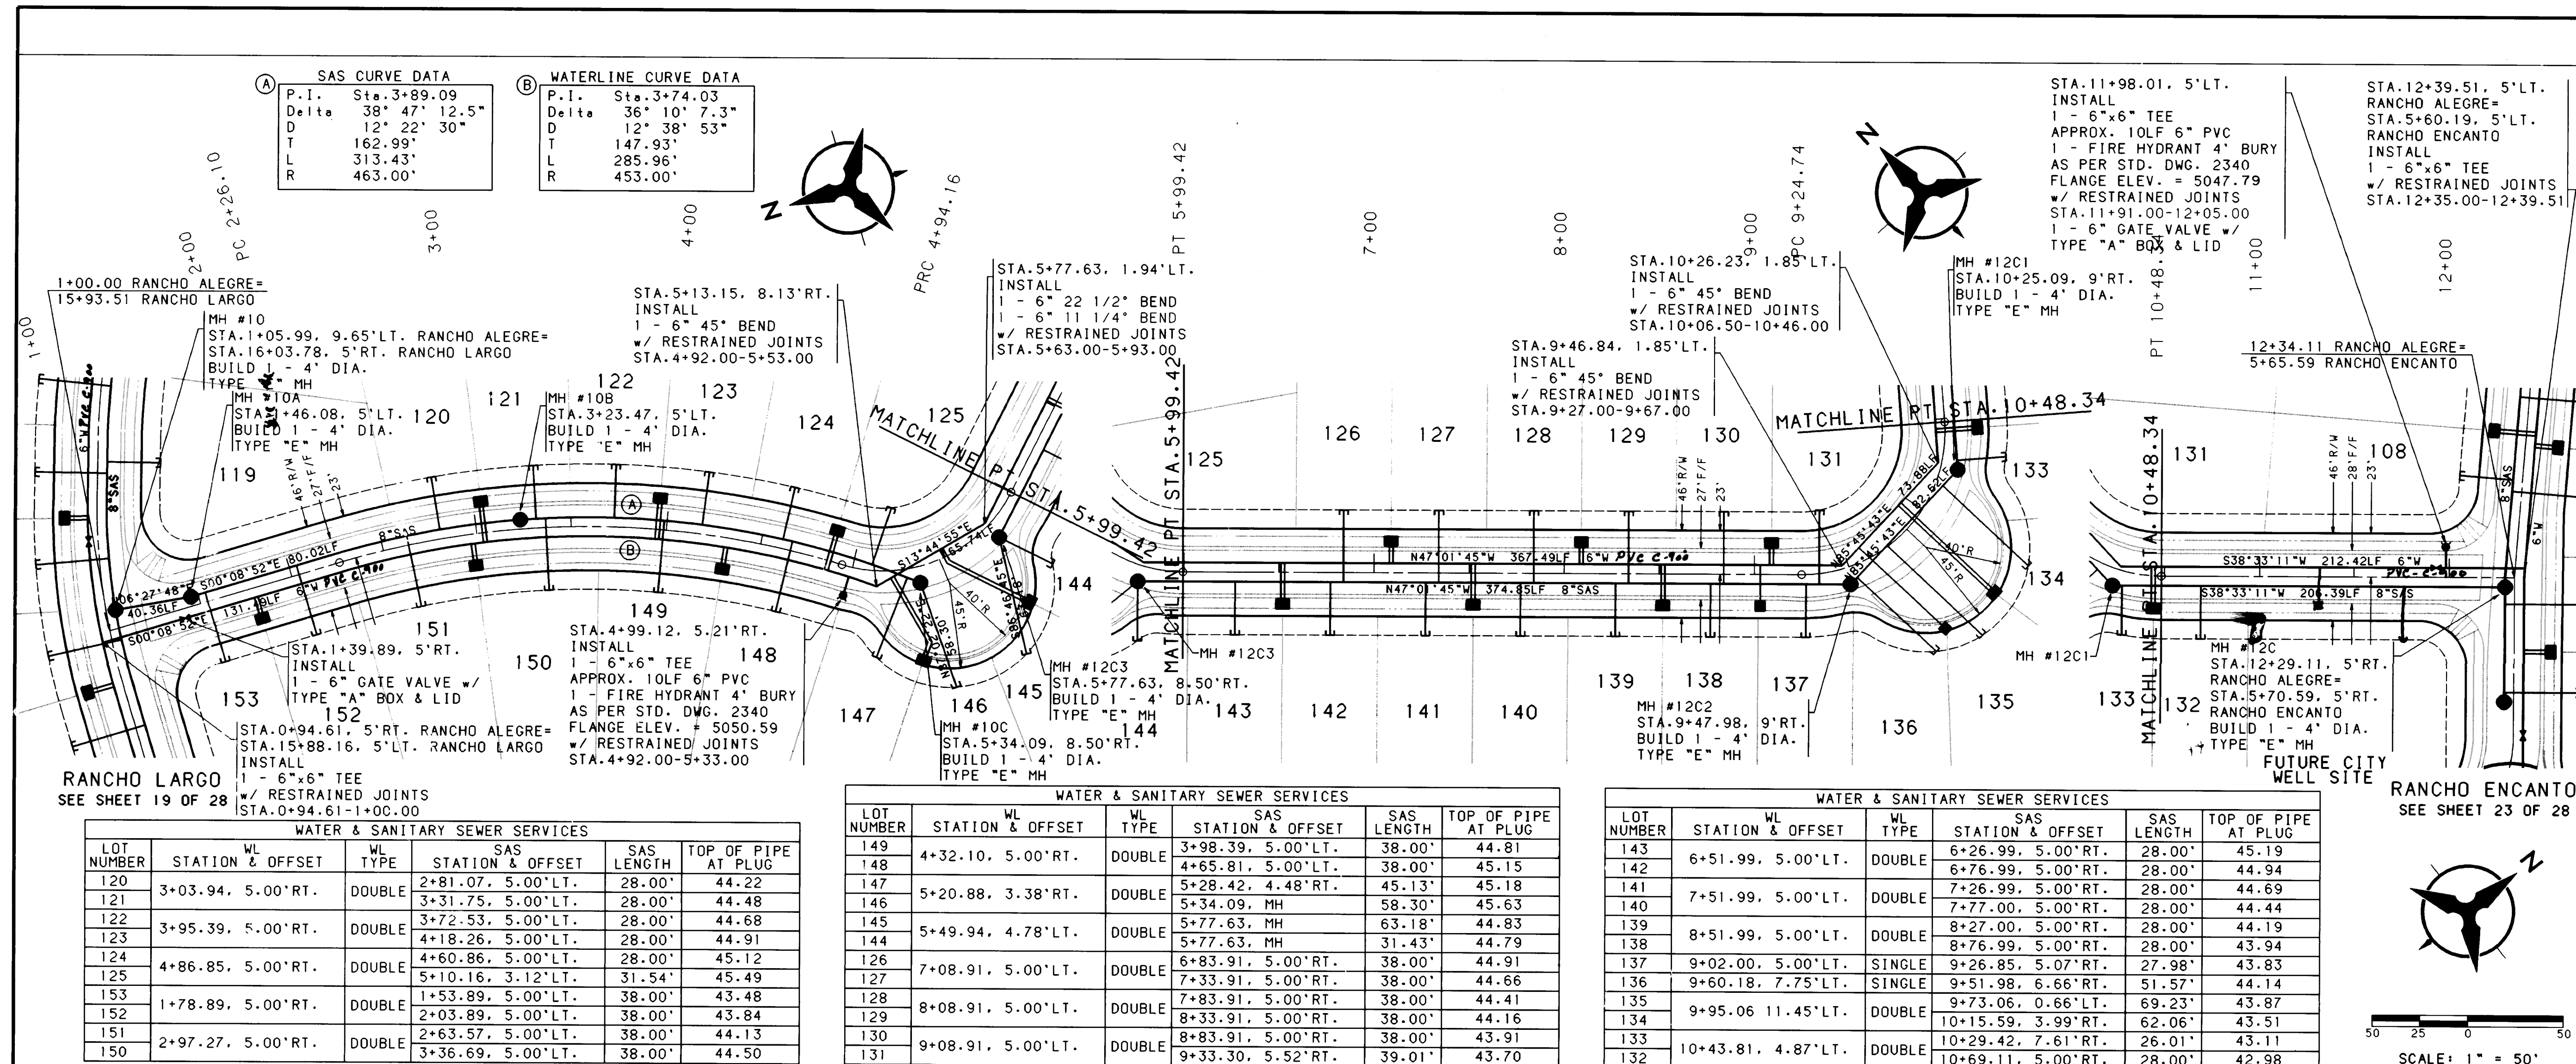

NOTES

- THE CONTRACTOR SHALL FIELD VERIFY ALL EXISTING UTILITY LOCATIONS AND NOTIFY THE ENGINEER IMMEDIATELY OF ANY DISCREPANCIES.
- ALL CURB RETURN RADII SHALL BE 25' TO FACE OF CURB UNLESS OTHERWISE SPECIFIED.
- ALL CURVE DATA AND DIMENSIONS REFER TO FACE OF CURB UNLESS OTHERWISE SPECIFIED.
- GRADE ELEVATIONS, WHERE NOTED, ARE FOR TOP OF STANDARD CURB UNLESS OTHERWISE SPECIFIED.
- CONTRACTOR IS TO INSTALL A 4"x4"x5' POST AND END AT THE END OF EACH SANITARY SEWER SERVICE.
- CONTRACTOR IS RESPONSIBLE FOR REPAIR AND/OR REPLACEMENT OF ALL UTILITY CONDUITS AND EXISTING LINES.
- ANY ADDITIONAL GRADING REQUIRED TO MATCH PROPOSED STREET GRADES SHALL BE INCIDENTAL TO PAVING ITEMS.
- CONTRACTOR SHALL PROVIDE THE INSPECTORS, (CITY AND PRIVATE) WITH THE PROPOSED HYDROSTATIC TESTING PLAN. THE PLAN MUST BE APPROVED BEFORE TESTING OPERATIONS BEGIN.
- CONTRACTOR SHALL PARK EQUIPMENT AND VEHICLES AS NOT TO INTERFERE WITH NORMAL ACTIVITIES OF RESIDENTS OR OTHER CONTRACTORS ON SITE.
- ANY DAMAGE TO THE EXISTING FACILITIES (CURB AND GUTTER, PAVEMENT, CONDUITS, LANDSCAPING, UTILITY LINES, ETC.) DURING CONSTRUCTION SHALL BE REPLACED AT THE CONTRACTORS EXPENSE.
- REMOVAL OF THE EXISTING CURB AND GUTTER SHALL BE AS PER COA STD. DWG. 2415 (SAWCUT ONLY).
- WHEEL CHAIR RAMPS SHALL BE CONSTRUCTED PRIOR TO ACCEPTANCE OF CURB AND GUTTER.
- THE FOLLOWING PERSONS SHALL BE NOTIFIED AT LEAST TWO BUSINESS DAYS PRIOR TO INSTALLING UTILITY CONDUIT CROSSINGS:

COMPANY PHONE CONTACT

COMPANY	PHONE	CONTACT
PNM	848-3374	TOM BACA
US WEST	245-6694	BECKY OLSEN
GAS CO.	761-7770	LEO APODACA
JONES	761-6200	YVETTE SUAZO

RECORD DRAWING

I, A. E. Schumacher, Registered Professional Engineer and Land Surveyor in the State of New Mexico, do hereby certify that this "as-built" information was obtained by me or under my supervision and represents the "as-built" conditions of this project, and is true and correct to the best of my knowledge and belief. All vertical and horizontal dimensions should be field verified prior to use on future projects.

APPROVALS

APPROVALS	ENGINEER	DATE	APPROVALS	ENGINEER	DATE
DRC CHAIRMAN	Billy Schumacher	10/27/93	WATER	R.W. Kane	9-9-93
TRANS. DEV.	W. R. Kane	9-9-93	WASTE WATER	R.W. Kane	9-9-93
HYDROLOGY	W. R. Kane	9-9-93			


CITY OF ALBUQUERQUE PUBLIC WORKS DEPARTMENT ENGINEERING GROUP


TITLE: RANCHO SERENO SUBDIVISION - UNIT II UTILITY PLAN & PROFILE RANCHO ALEGRE

APPROVALS

APPROVALS	ENGINEER	DATE	APPROVALS	ENGINEER	DATE
DRC CHAIRMAN	Billy Schumacher	10/27/93	WATER	R.W. Kane	9-9-93
TRANS. DEV.	W. R. Kane	9-9-93	WASTE WATER	R.W. Kane	9-9-93
HYDROLOGY	W. R. Kane	9-9-93			

PROJECT NO. 4569.93 MAP C-12 SHEET 22 OF 28

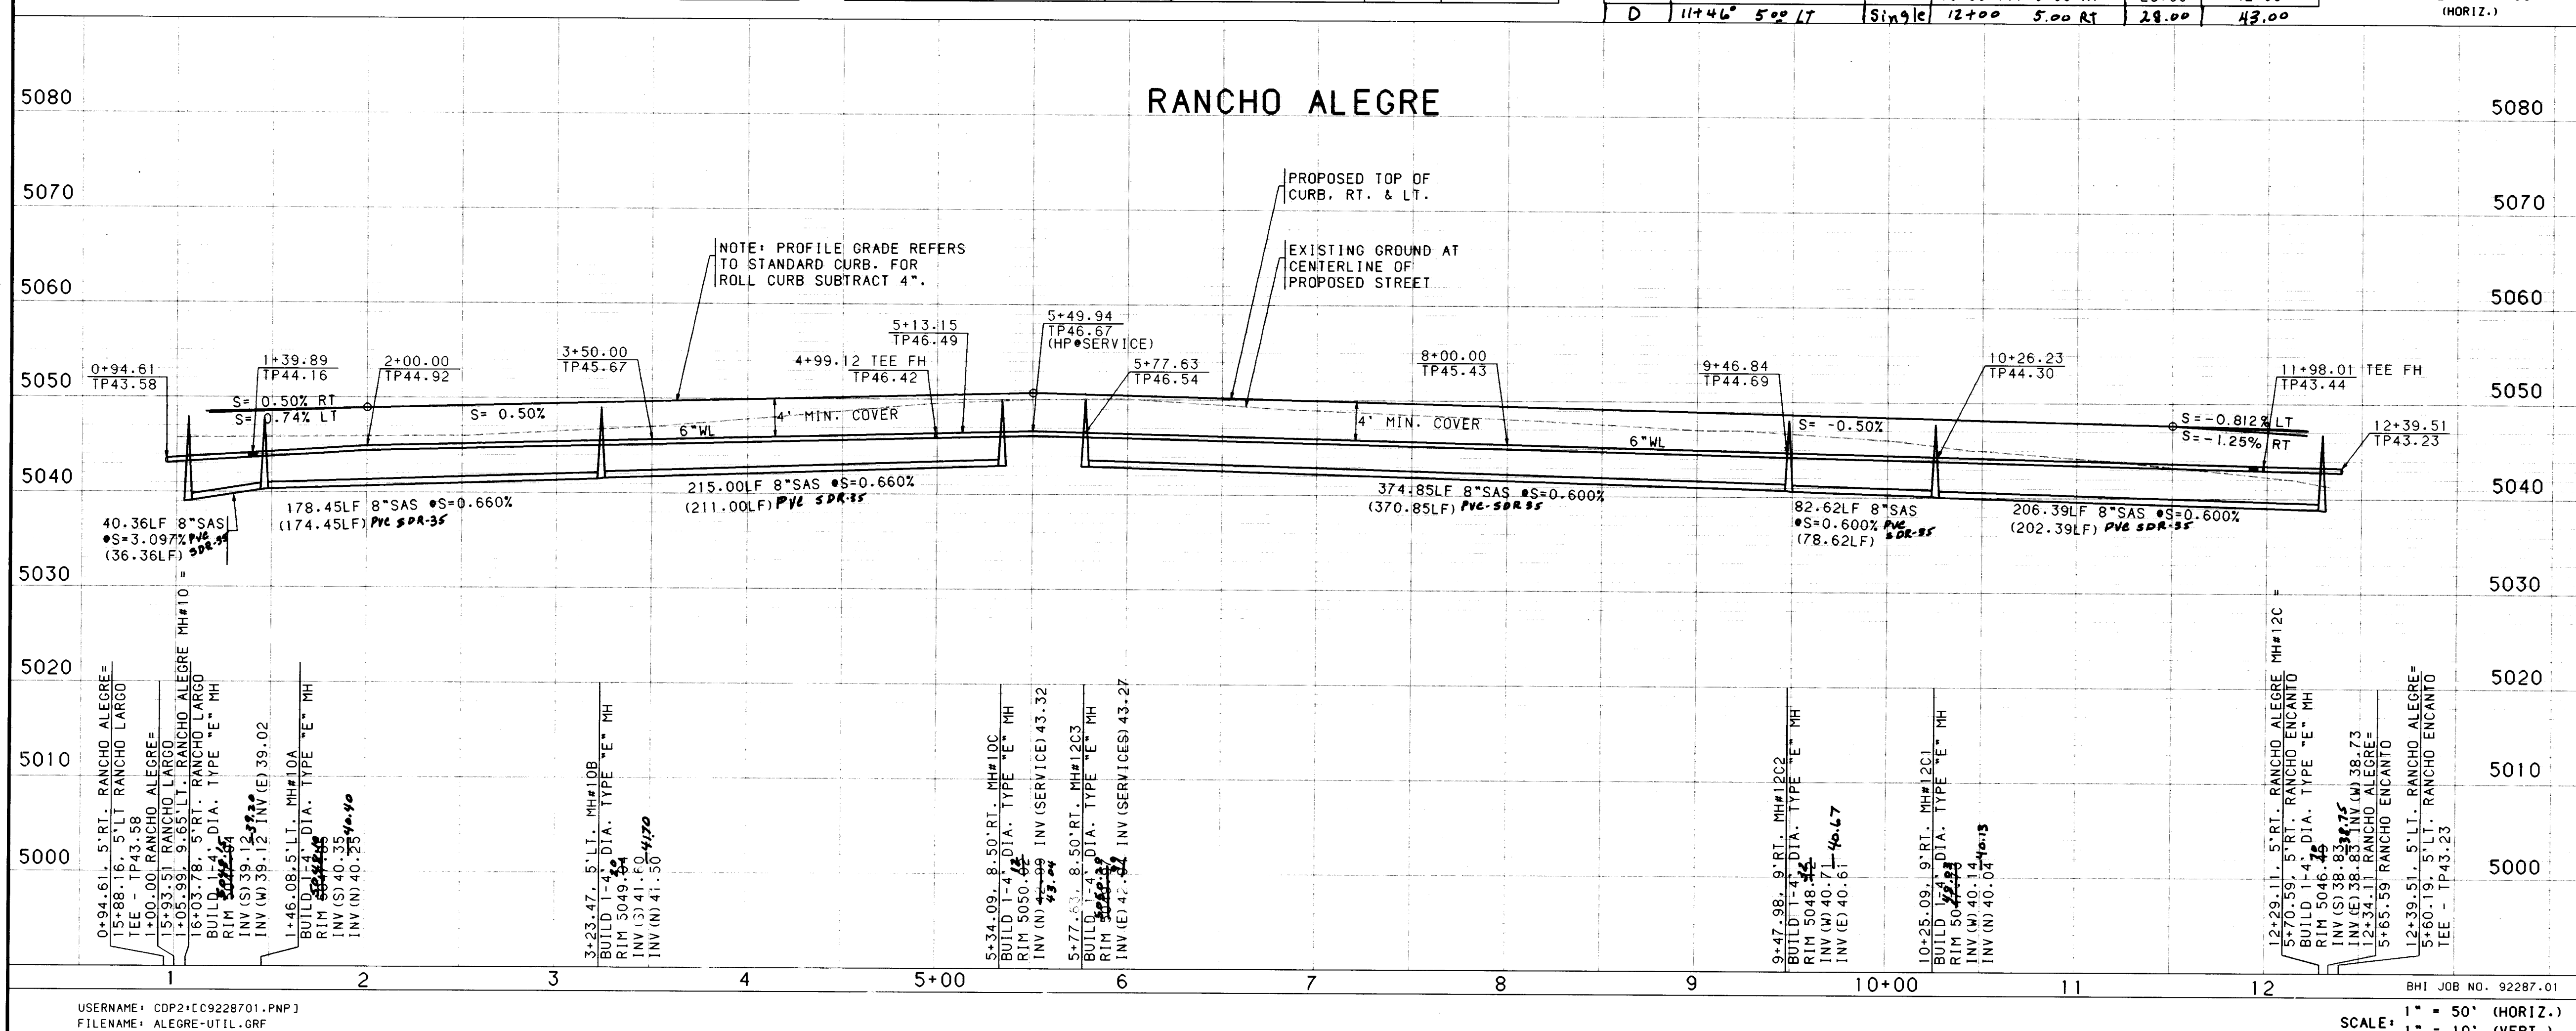

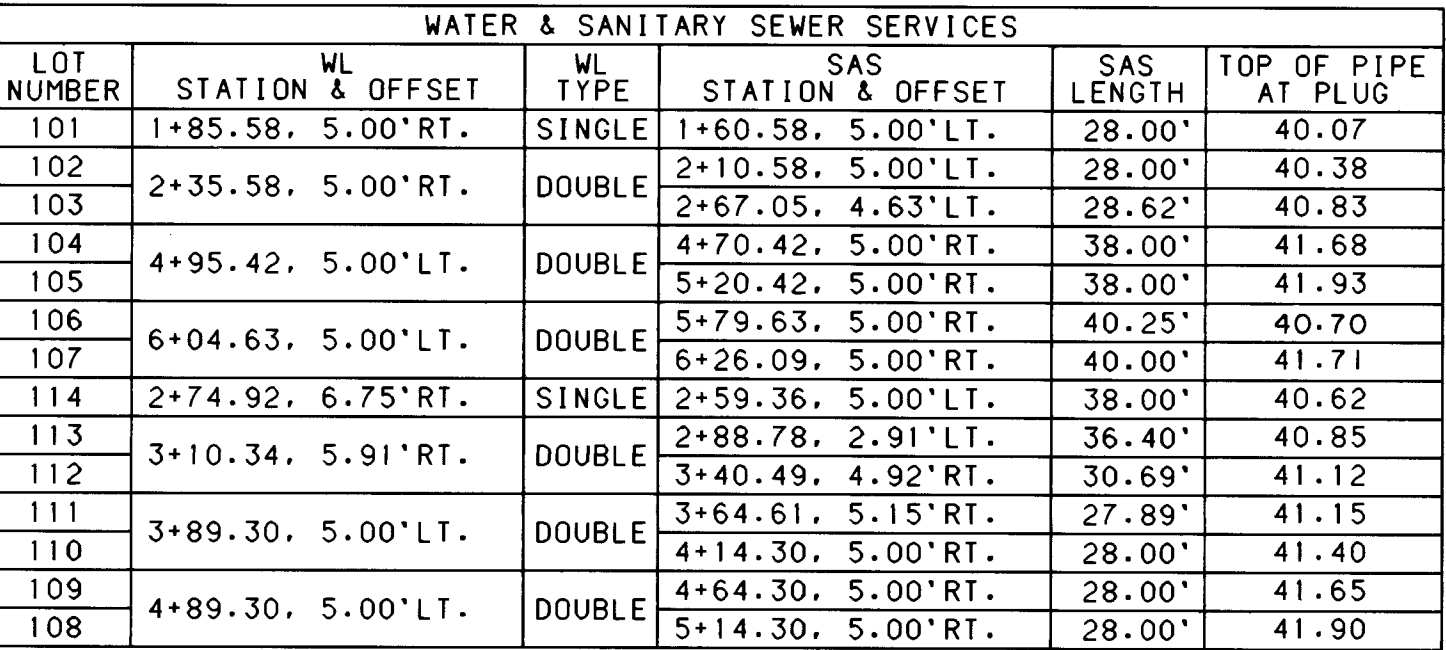

COMPANY	PHONE	CONTACT
PNM	848-3374	TOM BACA
US WEST	245-6694	BECKY OLES
GAS CO.	761-7770	LEO APODAC
JONES	761-6200	YVETTE SUA

I, A. E. Schumacher, Registered Professional Engineer and Land Surveyor in the State of New Mexico, do hereby certify that this "as-built" information was obtained by me or under my supervision and represents the "as-built" conditions of this project, and is true and correct to the best of my knowledge and belief. All vertical and horizontal dimensions should be field verified prior to use on future projects.

E. Schumacher
E. E. Schumacher
NMPE/LS No. 2360




CITY OF ALBUQUERQUE
PUBLIC WORKS DEPARTMENT
ENGINEERING GROUP

TITLE: RANCHO SERENO SUBDIVISION - UNIT II
UTILITY PLAN & PROFILE
RANCHO ENCANTO

APPROVALS	ENGINEER	DATE	APPROVALS	ENGINEER	DATE
CHAIRMAN	<i>Billy Gooding</i>	10-07-93	WATER	<i>R.W. Kane</i>	9-9-93
ANS. DEV.	<i>W.B. Ho</i>	9-09-93	WASTE WATER	<i>R.W. Kane</i>	9-9-93
APPROX					

PROJECT	MAP C-12	SHEET	OF
4569.93	NO. D-12	23	28

Copyright Bohannon-Huston, Inc. 1993

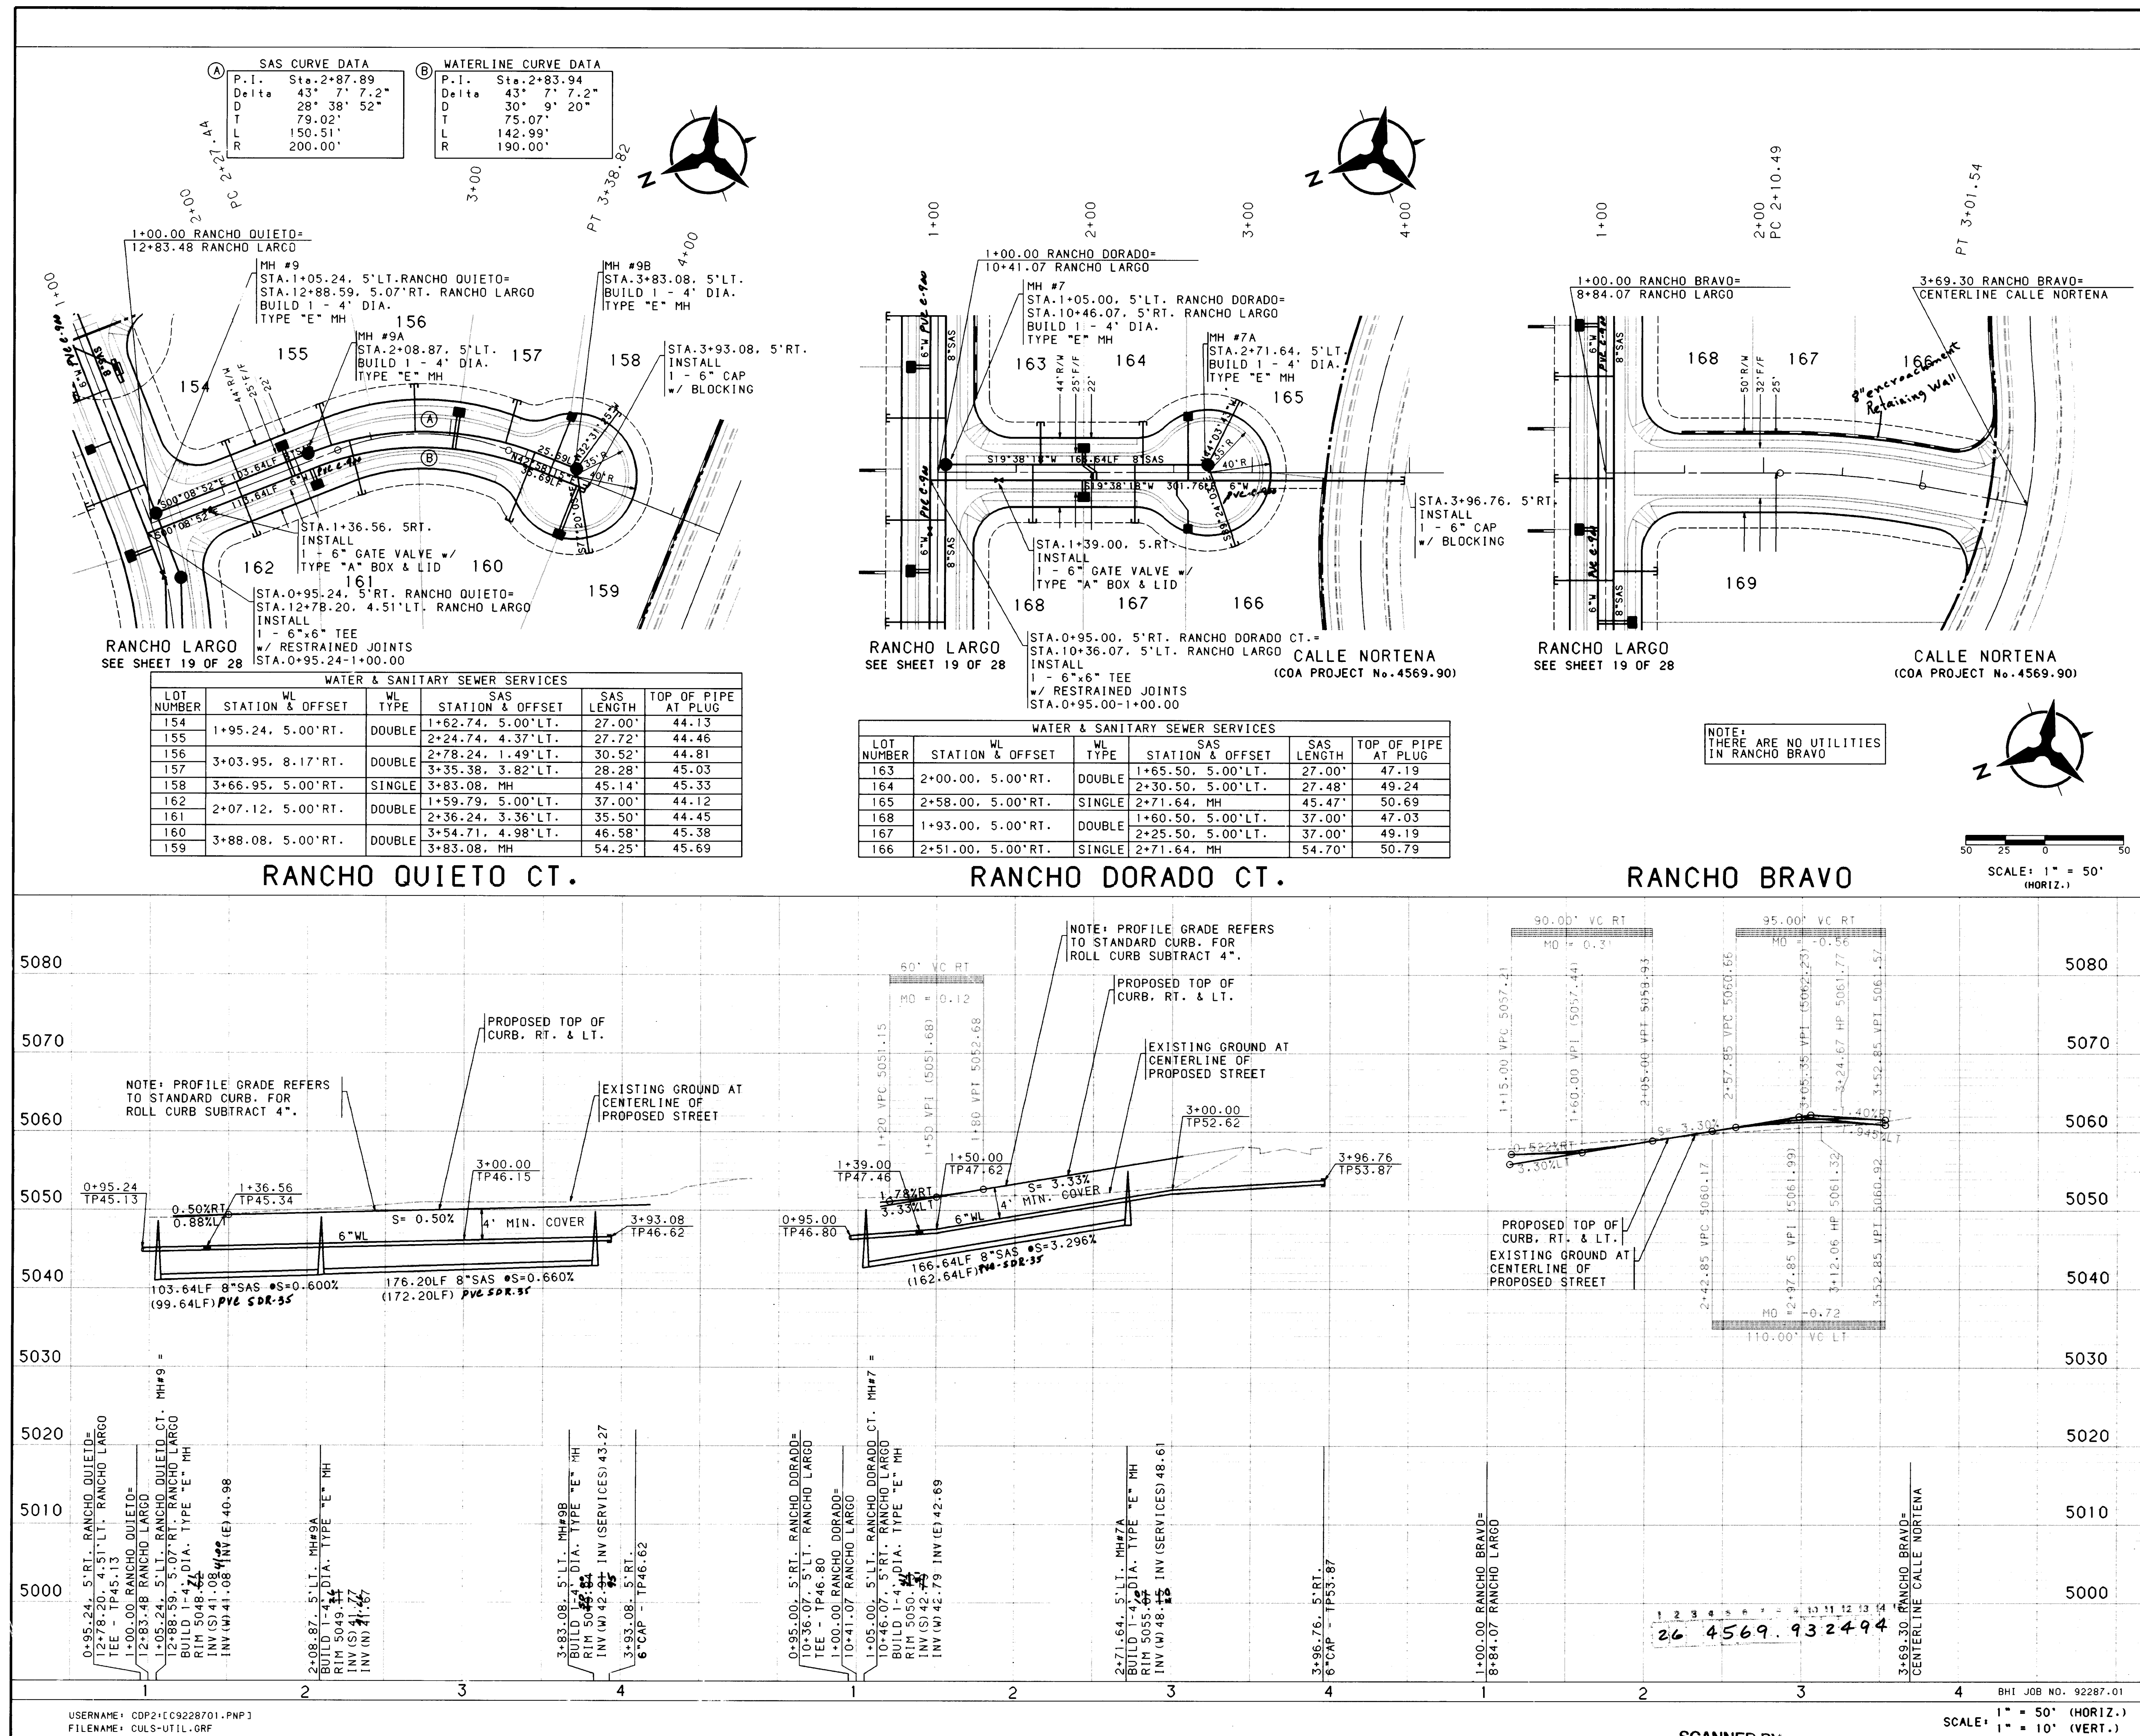

NOTES

1. THE CONTRACTOR SHALL FIELD VERIFY ALL EXISTING UTILITY LOCATIONS AND NOTIFY THE ENGINEER IMMEDIATELY OF ANY DISCREPANCIES.
2. ALL CURB RETURN RADII SHALL BE 25' TO FACE OF CURB UNLESS OTHERWISE SPECIFIED.
3. ALL CURVE DATA AND DIMENSIONS REFER TO FACE OF CURB UNLESS OTHERWISE SPECIFIED.
4. GRADE ELEVATIONS, WHERE NOTED, ARE FOR TOP OF STANDARD CURB UNLESS OTHERWISE SPECIFIED.
5. CONTRACTOR IS TO INSTALL A 4"x4"x5' POST AND END AT THE END OF EACH SANITARY SEWER SERVICE.
6. CONTRACTOR IS RESPONSIBLE FOR REPAIR AND/OR REPLACEMENT OF ALL UTILITY CONDUITS AND EXISTING LINES.
7. ANY ADDITIONAL GRADING REQUIRED TO MATCH PROPOSED STREET GRADES SHALL BE INCIDENTAL TO PAVING ITEMS.
8. CONTRACTOR SHALL PROVIDE THE INSPECTORS, (CITY AND PRIVATE) WITH THE PROPOSED HYDROSTATIC TESTING PLAN. THE PLAN MUST BE APPROVED BEFORE TESTING OPERATIONS BEGIN.
9. CONTRACTOR SHALL PARK EQUIPMENT AND VEHICLES AS NOT TO INTERFERE WITH NORMAL ACTIVITIES OF RESIDENTS OR OTHER CONTRACTORS ON SITE.
10. ANY DAMAGE TO THE EXISTING FACILITIES (CURB AND GUTTER, PAVEMENT, CONDUITS, LANDSCAPING, UTILITY LINES, ETC.) DURING CONSTRUCTION SHALL BE REPLACED AT THE CONTRACTORS EXPENSE.
11. REMOVAL OF THE EXISTING CURB AND GUTTER SHALL BE AS PER COA STD. DWG. 2415 (SAWCUT ONLY).
12. WHEEL CHAIR RAMPS SHALL BE CONSTRUCTED PRIOR TO ACCEPTANCE OF CURB AND GUTTER.
13. THE FOLLOWING PERSONS SHALL BE NOTIFIED AT LEAST TWO BUSINESS DAYS PRIOR TO INSTALLING UTILITY CONDUIT CROSSINGS:

COMPANY	PHONE	CONTACT
---------	-------	---------

PNM	848-3374	TOM BACA
US WEST	245-6694	BECKY OLESEN
GAS CO.	761-7770	LEO APODACA
JONES	761-6200	YVETTE SUAZO

RECORD DRAWING

I, A. E. Schumacher, Registered Professional Engineer and Land Surveyor in the State of New Mexico, do hereby certify that this "as-built" information was obtained by me or under my supervision and represents the "as-built" conditions of this project, and is true and correct to the best of my knowledge and belief. All vertical and horizontal dimensions should be field verified prior to use on future projects.

A. E. Schumacher
A. E. Schumacher
NMPE/LS No. 2360

STATE OF NEW MEXICO
COUNTY OF BERNILLO
SHERIFF
SCHUMACHER
2360

3/31/94
Date



CITY OF ALBUQUERQUE
PUBLIC WORKS DEPARTMENT
ENGINEERING GROUP

TITLE: RANCHO SERENO SUBDIVISION
UTILITY PLAN & PROFILE
RANCHO QUIETO CT. RANCHO DORADO CT.

APPROVALS	ENGINEER	DATE	APPROVALS
-----------	----------	------	-----------

DRG CHAIRMAN	<i>[Signature]</i>	10-01-93	WATER
TRANS. DEV.	<i>[Signature]</i>	2:38	WASTE WATER

HYDROLOGY	<i>[Signature]</i>	09/09/93	
-----------	--------------------	----------	--

	0	1		
--	---	---	--	--

PROJECT	MAP C-12	SH
---------	----------	----

NO.	4509.95	NO.	D-12
-----	---------	-----	------

Copyright Bohanna

ENGINEERS SEAL						SURVEY INFORMATION		BENCH MARKS		AS BUILT INFORMATION	
		FIELD NOTES									
NO.		BY		DATE		STATION MARK IS A STANDARD USC&GS BRASS		CONTRACTOR		New Concepts, Inc.	
						TABLET, STAMPED "HUGHES, 1954". SET IN TOP OF		WORK BY		KCI	
						A CONCRETE POST PROJECTING 0.3 FT. ABOVE THE		INSPECTOR'S		DATE 3/94	
						GROUND. TO REACH THE STATION FROM THE		ACCEPTANCE BY		DATE 4/94	
						INTERSECTION OF CENTRAL AVE. AND STATE RD. 448.		VERIFICATION BY		DATE 4/94	
						GO NORTH ON STATE RD. 448. 6.1 MILES.		DRAWINGS		DATE 4/94	
						THE STATION IS 450' WEST OF STATE RD. 448 IN		CORRECTED BY		MICRO-FILM INFORMATION	
						A FENCED-IN PRAIRIE. ELEV.= 5049.93'		RECORDED BY		DATE	
								NO.			

L. DWYER
STATE OF NEW MEXICO
REGISTERED PROFESSIONAL ENGINEER
NO. 394



DESIGNED BY KLD		DATE 8/93	
DRAWN BY SAR		DATE 8/93	
CHECKED BY KLD		DATE 8/93	

BUREAU OF RECLAMATION
U.S. DEPARTMENT OF THE INTERIOR

VALUATIONS - UNIT II PROFILE		
CT. & RANCHO BRAVO	ENGINEER	DATE
	<i>R.W. Kane</i>	<i>9-8-93</i>
	<i>R.W. Kane</i>	<i>9-9-93</i>

SHEET 24
OF 28

Copyright Bohannon-Huston, Inc. 1993

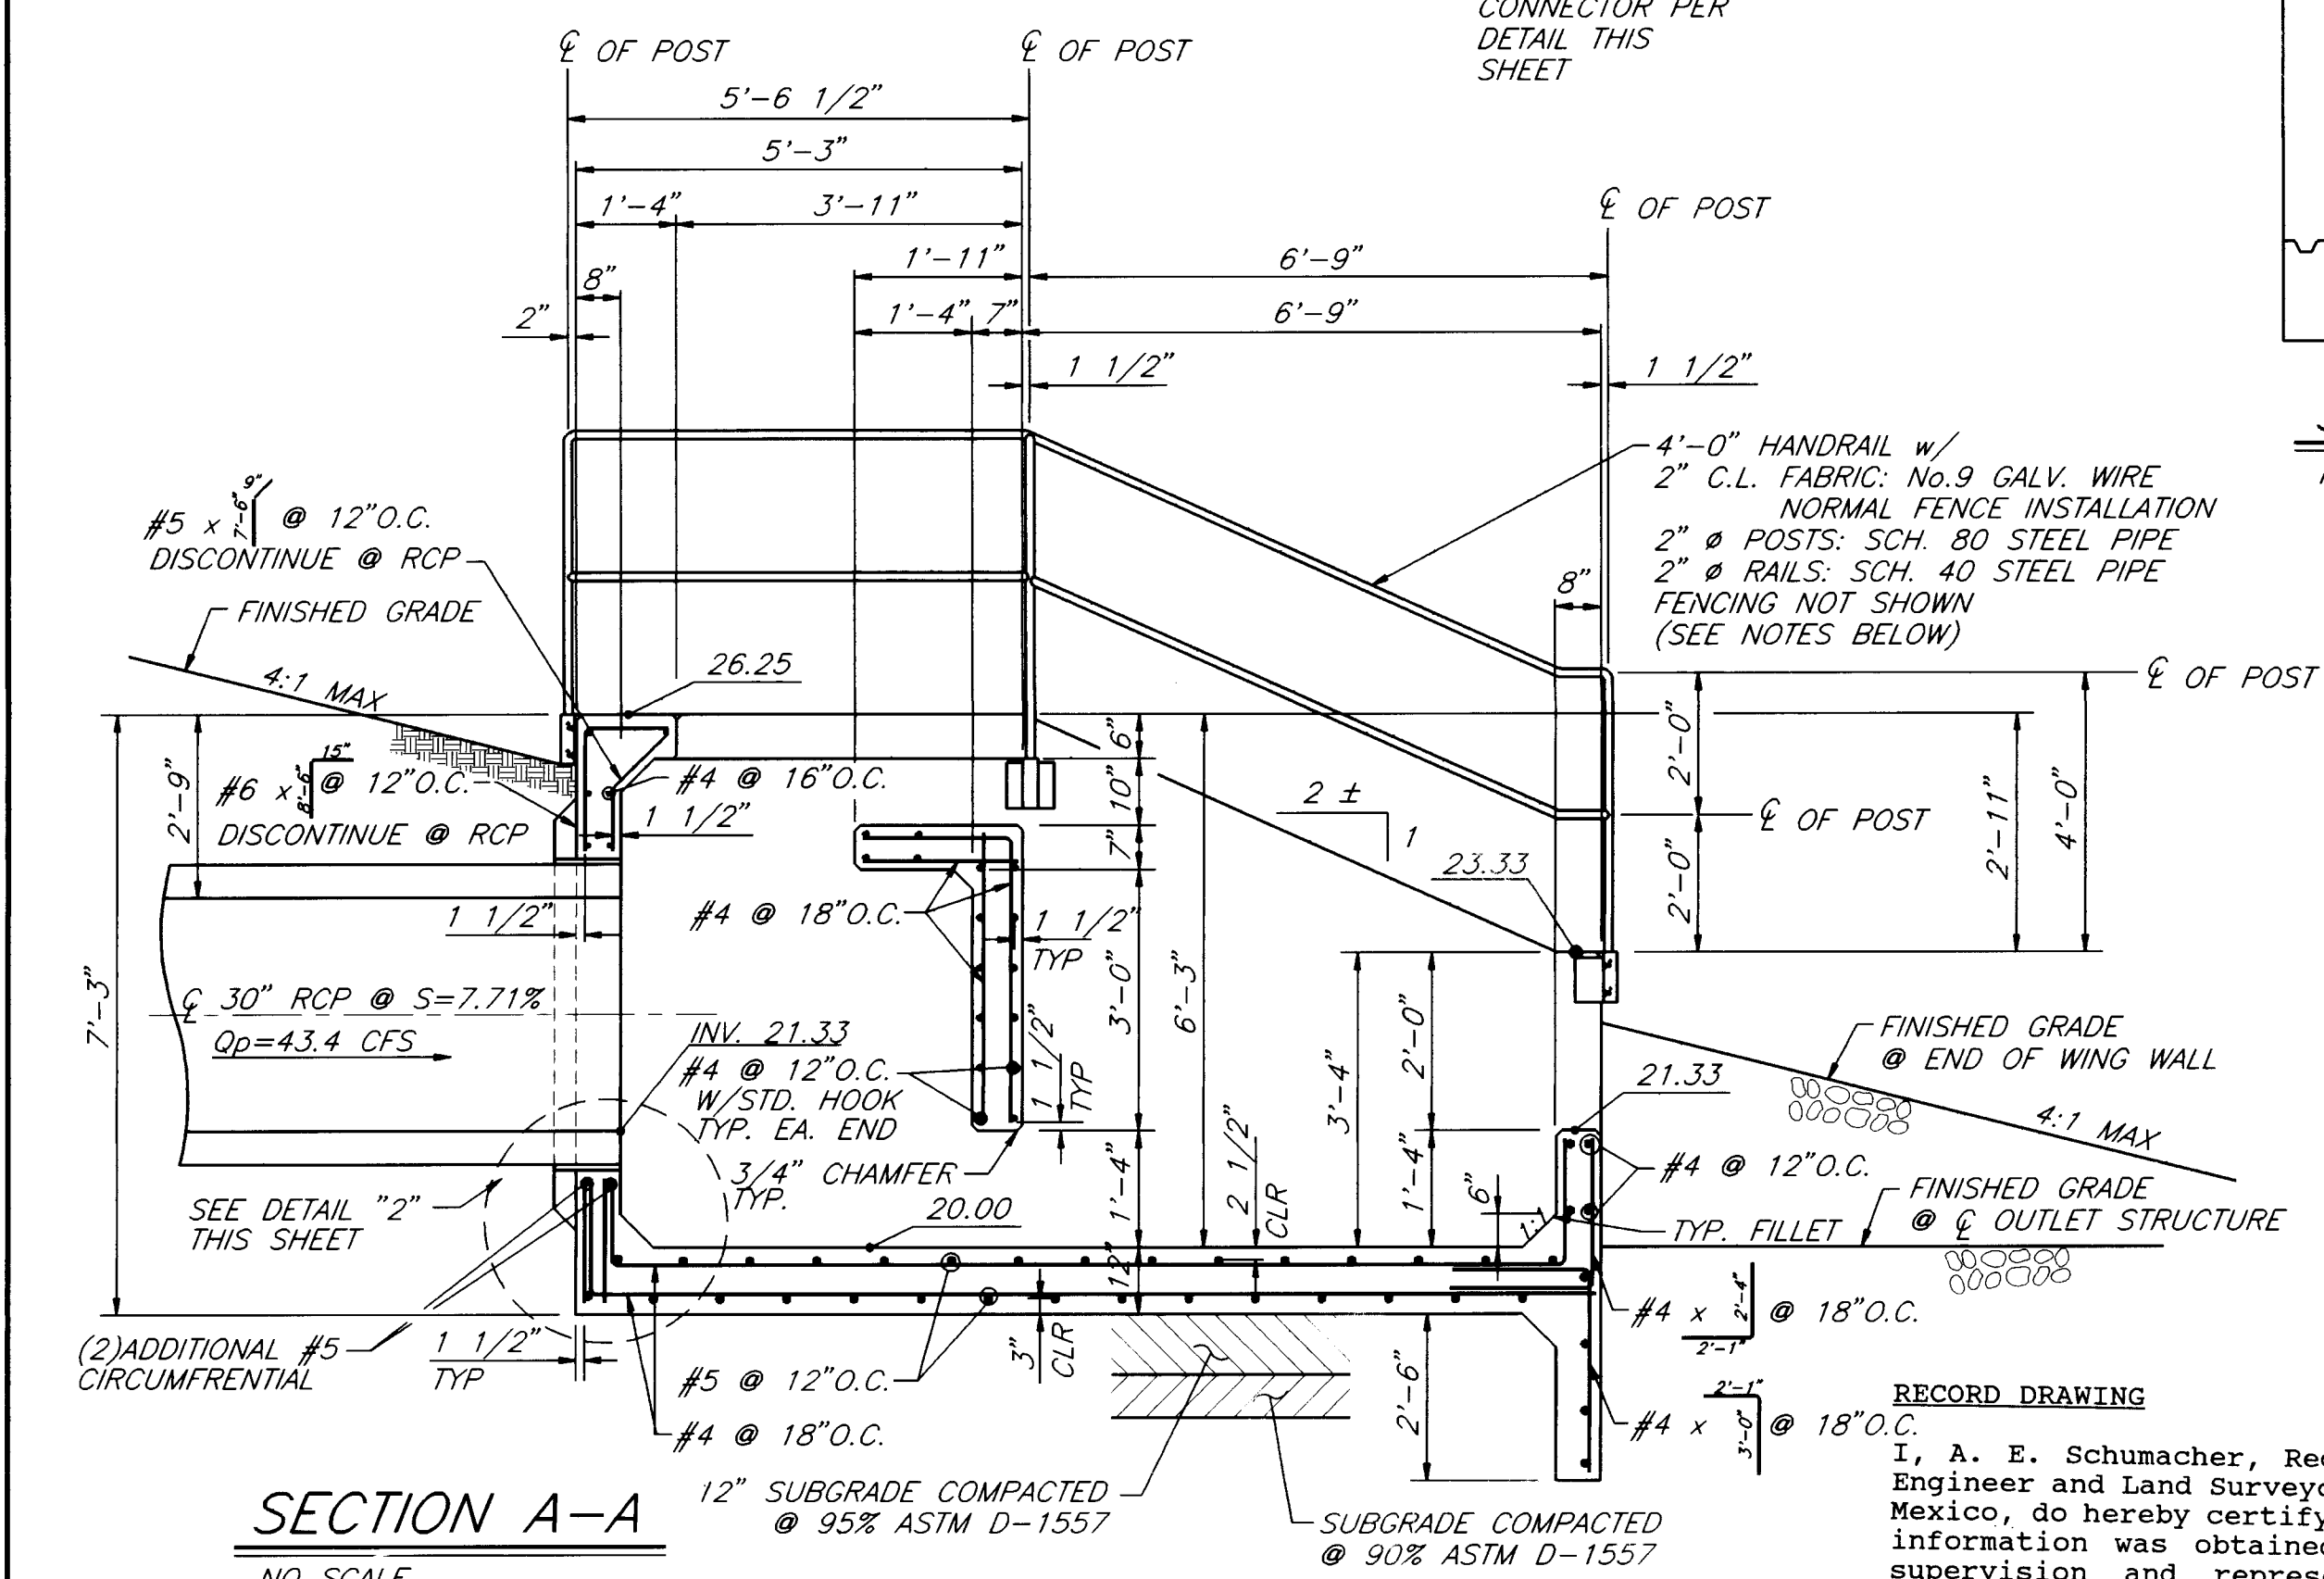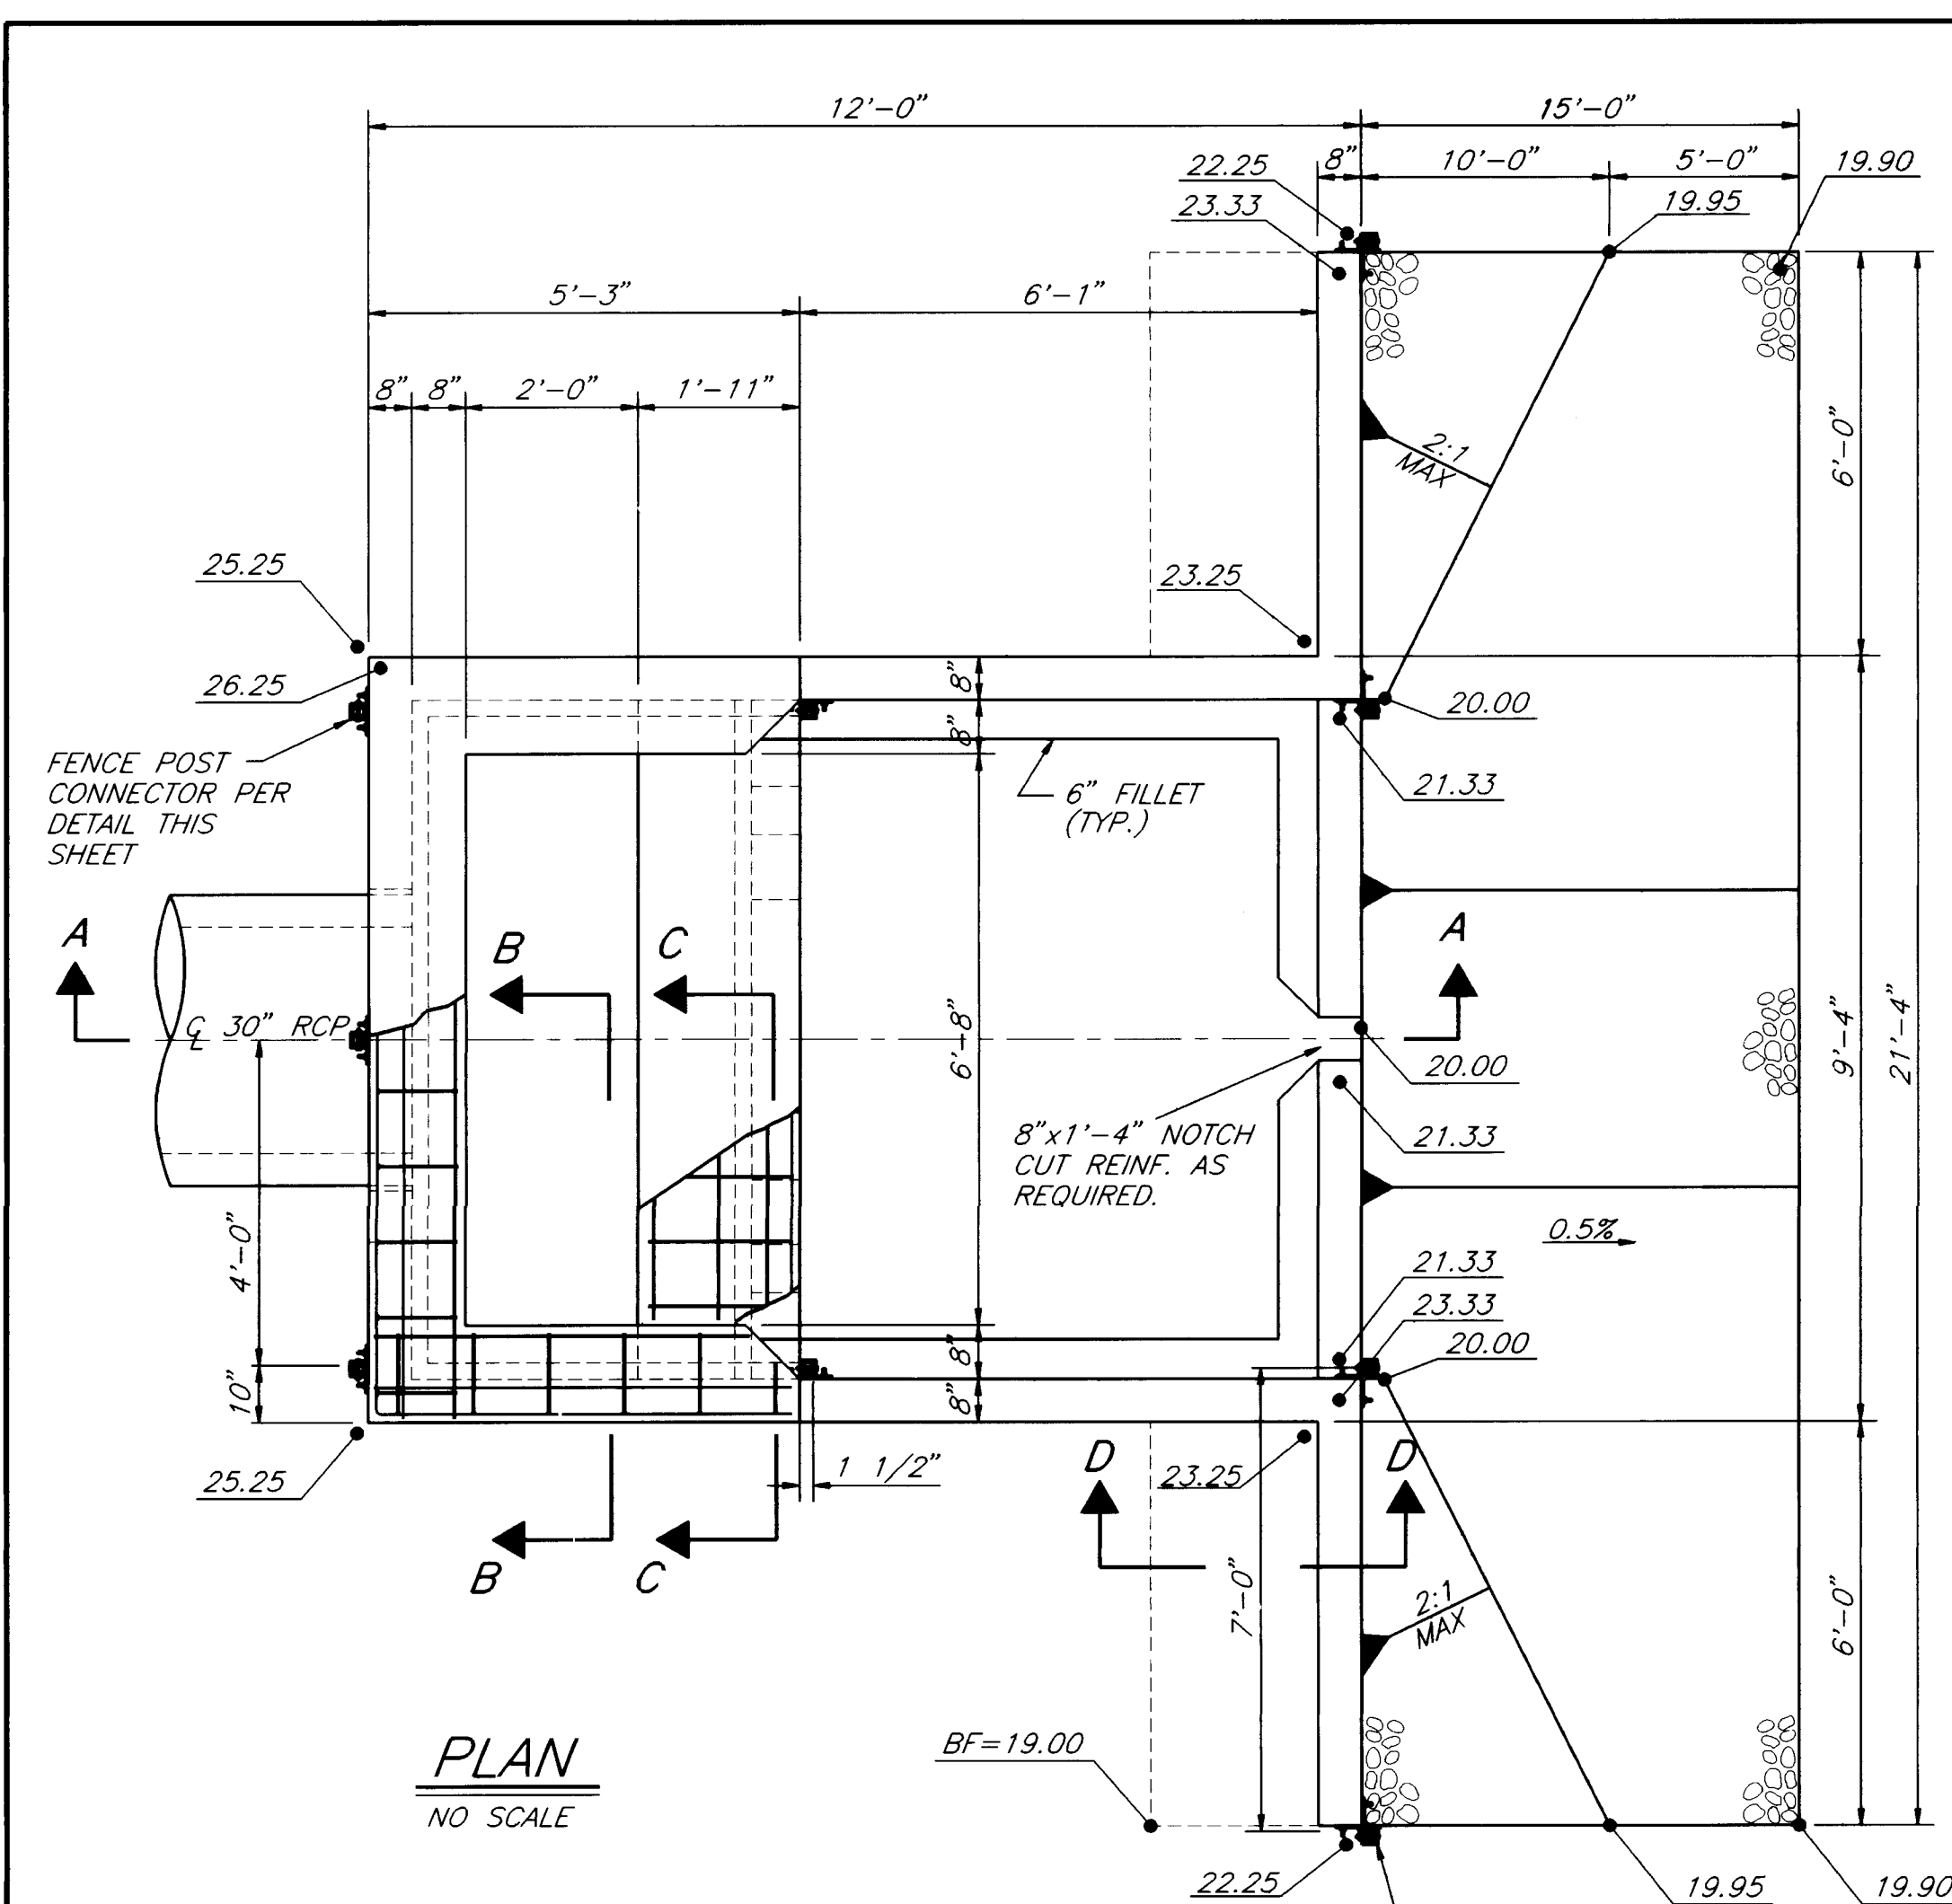

HANDRAIL NOTES

1. All posts, rails, plates, angles, bolts, etc... Shall be of structural steel and galvanized per C.O.A. standards.
2. Install chain link fabric on outside of pipe rail.
3. Tension wire shall be 7 ga. spring steel w/ 11 ga. wire ties @ 24"± c.c.


4. Tension bars and three (3) clamps at each corner post.
5. Tack weld chain link fabric @ 3 points along each frame member.
6. Paint all field welds with galvanizing coating.

A. E. Schumacher, Registered Professional Engineer and Land Surveyor in the State of New Mexico, do hereby certify that this "as-built" information was obtained by me or under my supervision and represents the "as-built" conditions of this project, and is true and correct to the best of my knowledge and belief. All vertical and horizontal dimensions should be field verified prior to use on future projects.

3/31/94
Date
A. E. Schumacher
REGISTERED PROFESSIONAL ENGINEER AND LAND SURVEYOR
No. 2360


FENCE POST CONNECTOR DETAIL

NO SCALE

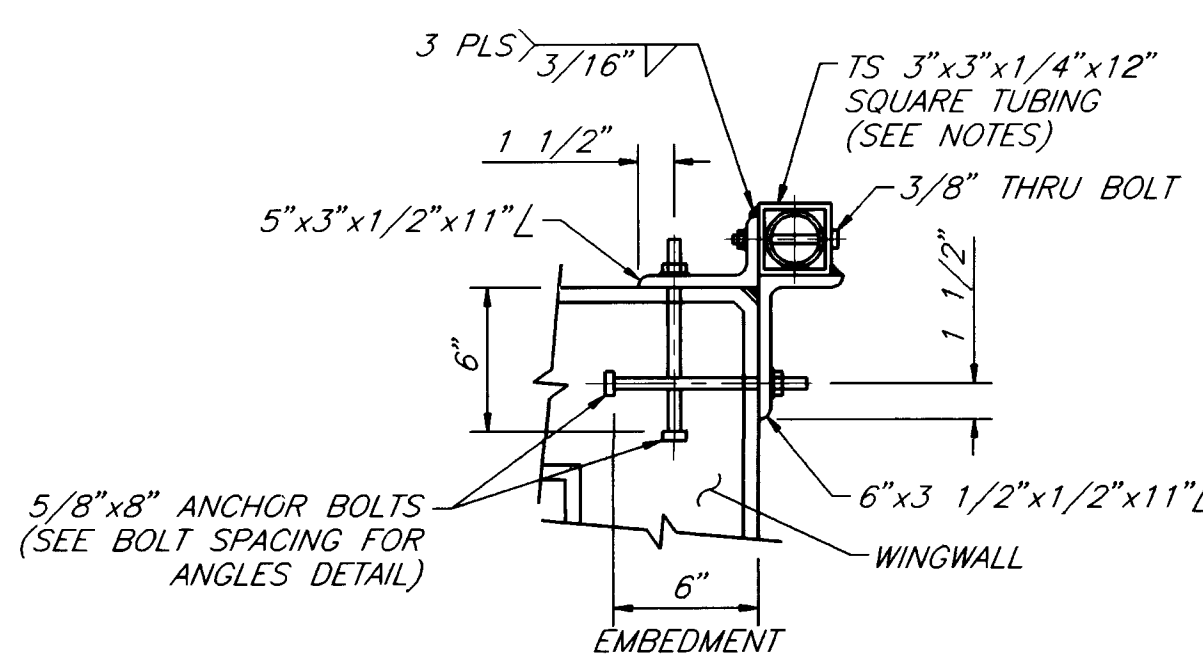


CORNER POST CONNECTOR DETAIL

NO SCALE

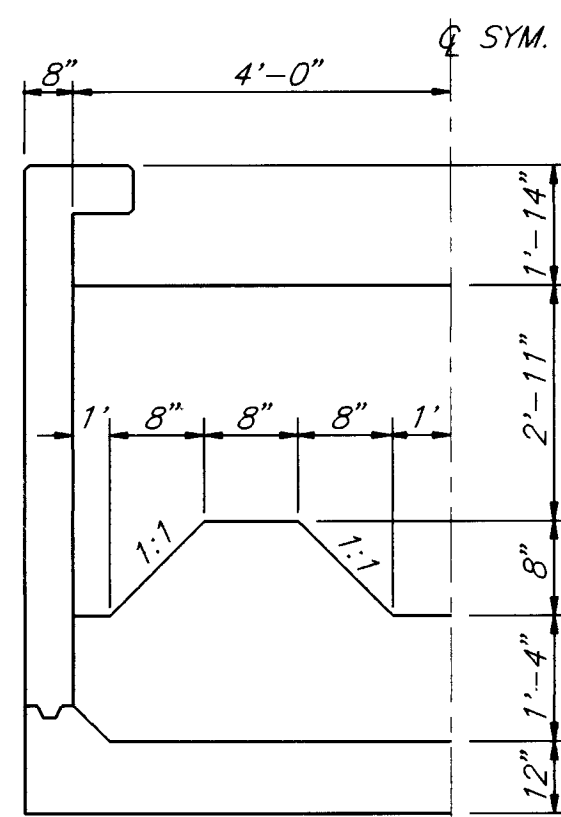

SECTION C-C


NO SCALE

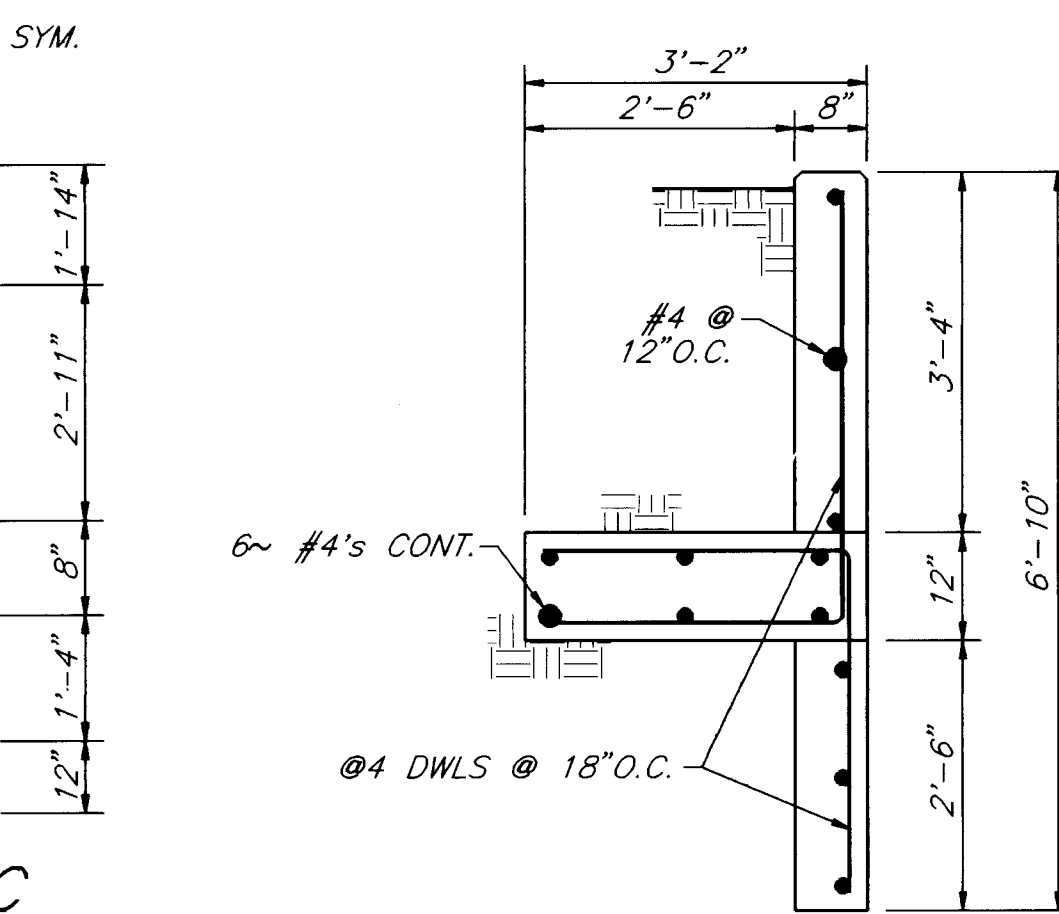

SECTION D-D


DISSIPATOR WINGWALL DETAIL

NO SCALE

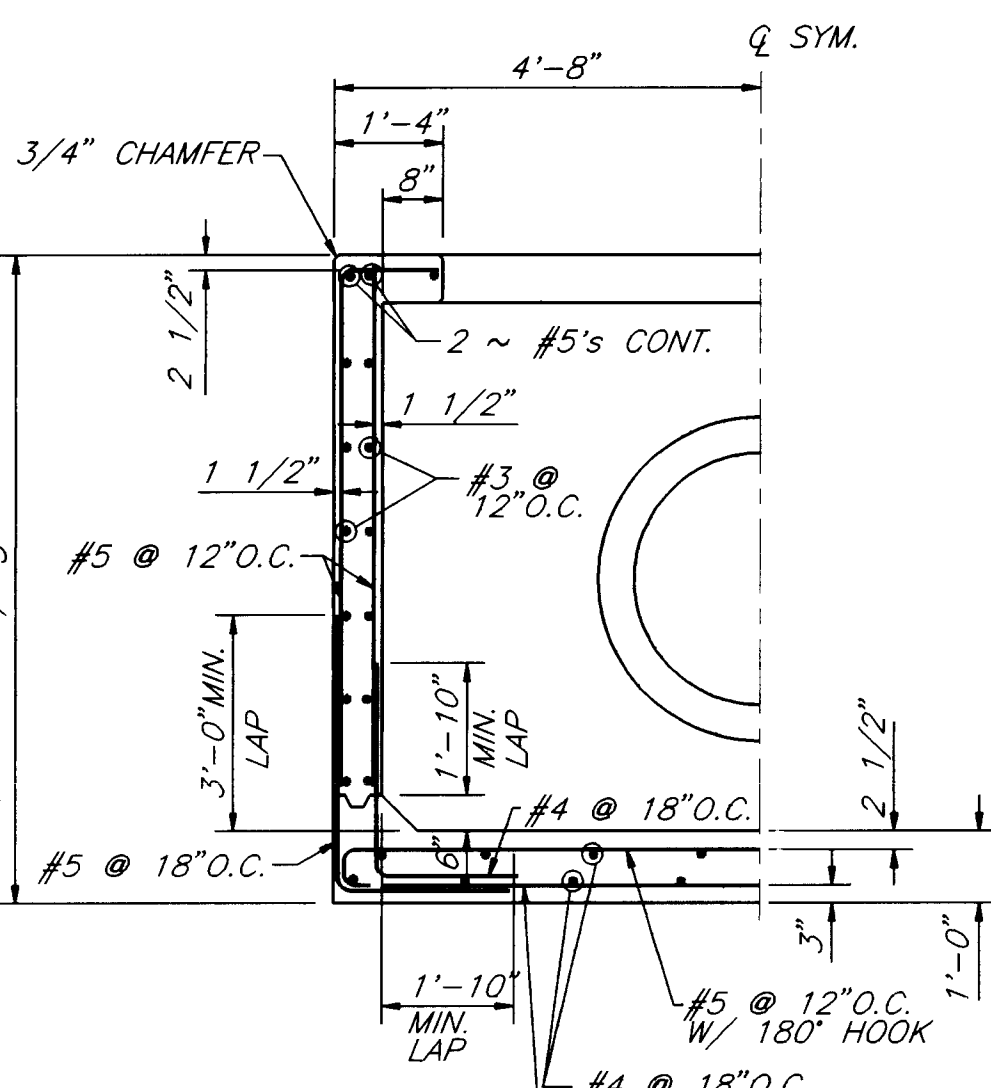


SECTION B-B

NO SCALE

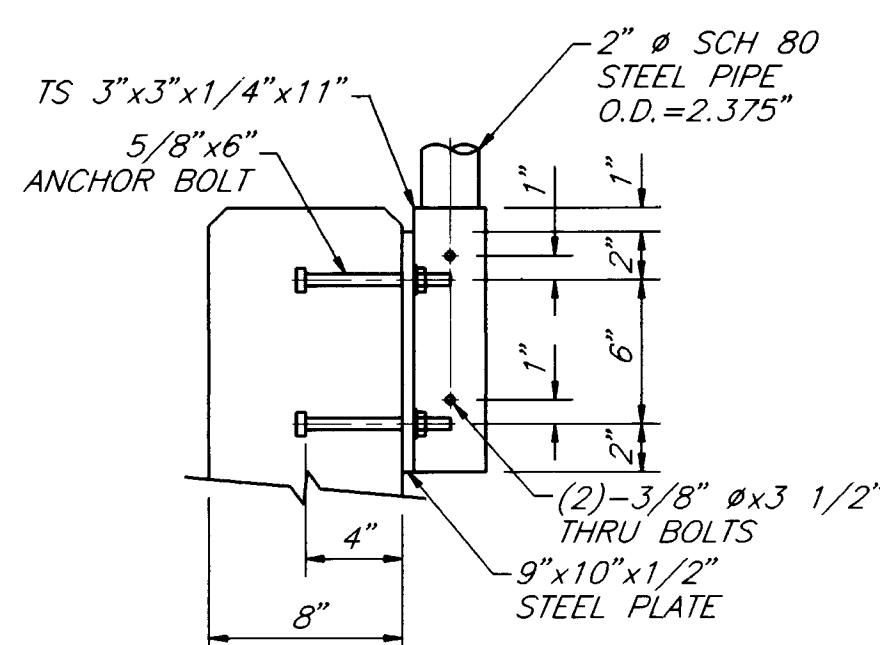


SECTION E-E

NO SCALE

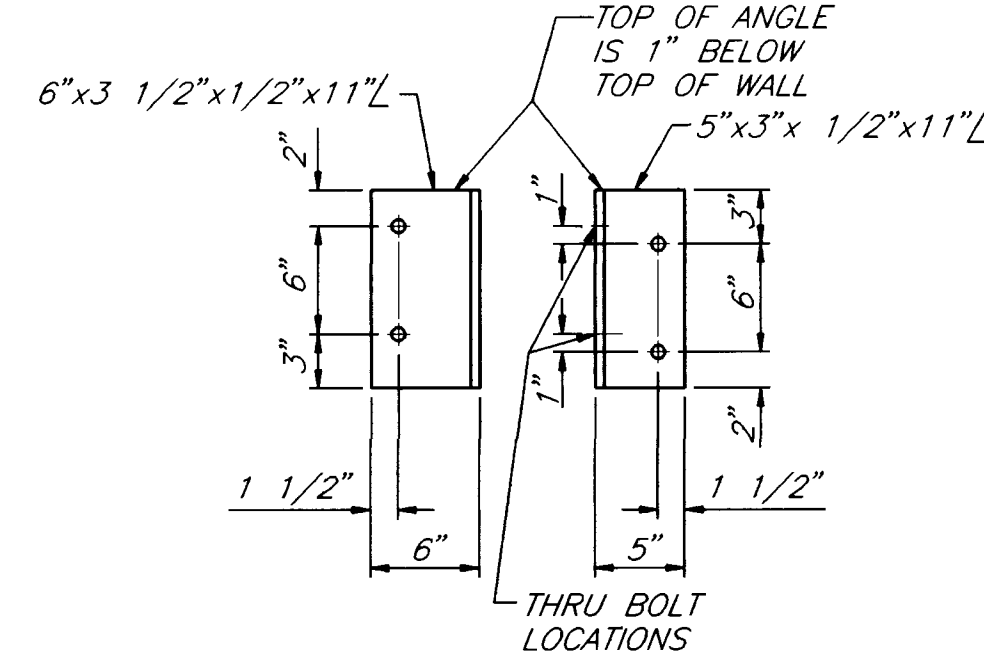


BOLT SPACING FOR ANGLES OF CORNER POST CONNECTOR

NO SCALE

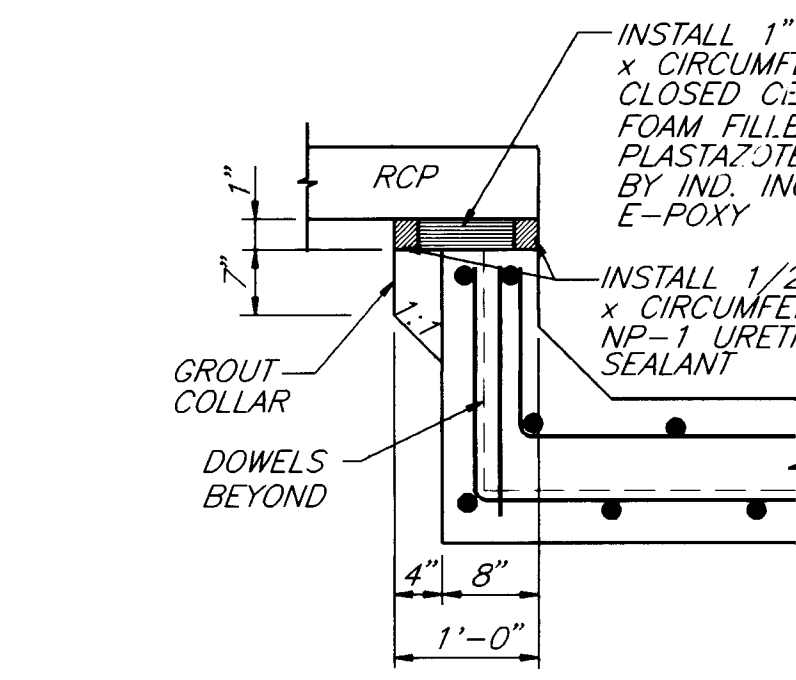

DETAIL "2"

NO SCALE

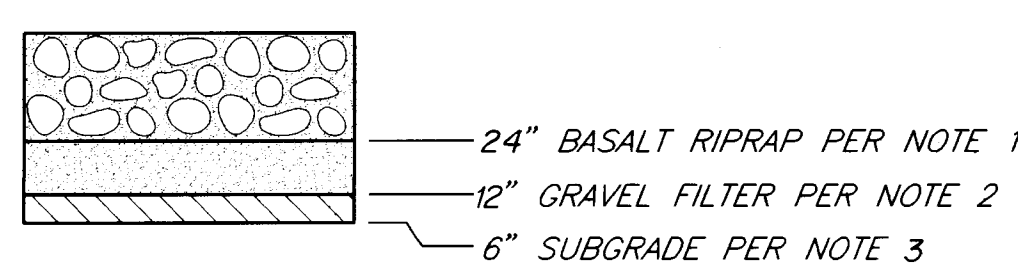

BASALT RIPRAP SECTION

NO SCALE

RIPRAP NOTES

1. Riprap shall consist of locally-obtainable basalt supplied and installed in accordance with section 603 of the standard specifications. Riprap shall be type M per section 109. On site rock will have to be sorted to meet gradation.
 2. Riprap shall be placed on gravel filter material. Gravel filter material shall be supplied and installed per section 603.10 of the standard specifications, and the gradation shall be as follows:
- | SIEVE SIZE | % PASSING |
|------------|-----------|
| 3" | 90-100 |
| 3/4" | 20-90 |
| #4 | 0-20 |
| #200 | 0-3 |
3. Riprap subgrade scarified and compacted to a depth of 6" at minimum 90% ASTM D-1557 Density.


GENERAL STRUCTURAL NOTES


1. CODES AND MANUALS:
Uniform Building Code, 1991 Edition
ACI 318, Latest Edition, Building Code Requirements for Reinforced Concrete.
2. DESIGN LOADS:
A. Live Loads:
Soil Weight = 120 pcf
Equiv lateral = 40 pcf
Maximum Allowable soil bearing pressure: 2000psf+
Allowable 1/3 stress increase for gravity and/or lateral loading.
3. GENERAL:
A. The Contractor shall verify all dimensions in the field.
B. Shop drawings shall be furnished for review before any fabrication and erection is started. Poorly executed shop drawings shall be rejected and re submitted.
C. The Contractor shall be responsible for providing safe and adequate shoring for all parts of the wall and adjacent structures during construction, as well as worker safety and compliance with OSHA or other agency safety guidelines.
D. The Contractor shall field all existing utility locations and notify the Engineer immediately of any discrepancies.
E. Grade elevations, where noted, are for top of curb, unless otherwise noted.
F. The Contractor is responsible for repair and/or replacement of all utility conduits and existing lines.
G. Any additional grading required to match proposed street grades shall be incidental to paving items.
H. The contractor shall park equipment and vehicles as not to interfere with normal activities of residents or other Contractors on site.
I. Any damage to existing facilities (curb and gutter, pavement, conduits, landscaping, utilities, ect.) during construction shall be replaced at the Contractors expense.
J. Removal of the existing curb and gutter shall be as per COA standard drawing 2415 (sawcut only).
K. Chamfer all exposed corners 3/4" TYP.
4. MATERIALS:
A. Cast-in-Place Concrete:
(1) All concrete shall conform to the City of Albuquerque specifications for Structural Concrete, Section 101 and Table 101.C Concrete for Hydraulic Structures.
B. Reinforcing Steel:
(1) All reinforcing steel shall conform to ASTM A615 Grade 60; except stirrups, ties, may conform to ASTM A615 Grade 40.
(2) Reinforcing shall be stored in such a manner as to inhibit rusting or the deposit of oils or other bond inhibiting deposits.
(3) Reinforcing steel shall be fabricated and placed in accordance with the Building Code Requirements for Reinforced Concrete (ACI 318) and the CRSI Standard Manual.
(4) Bar supports and spacers for rebar shall be provided in accordance with ACI and CRSI.
(5) All lap splices shall be class B.
(6) Concrete cover for reinforcing shall be as follows:
a. Concrete poured against earth 3 inches.
b. Concrete poured in forms but exposed to weather or earth:
1. If bars are larger than No. 5 2 inches
2. If bars are No. 5 or smaller 1-1/2 inches
(7) The Contractor shall be responsible to see that all rebar is properly aligned and tied in place before placing concrete. All column, wall dowels and vertical steel shall be accurately located and secured in place so that it remains in the position shown during the concrete placing operation. Any rebar found to be improperly installed shall be removed at no additional cost to the Owner.
(8) Form ties shall be either of the threaded or snap-off type or other approved equal so that no metal will be left within 1 inch of the surface of the wall. Following removal of form ties, recesses are to be carefully filled and pointed with mortar.


NOTIFY AMAFCA 2 DAYS PRIOR TO WORK IN R.O.W. AMAFCA MUST INSPECT STEEL & FORMWORK PRIOR TO CASTING CONCRETE

APPROVAL OF A LICENSE AGREE-MENT BY AMAFCA IS REQUIRED PRIOR TO CONSTRUCTION WITHIN THE PIEDRAS MARCADAS DAM RIGHT-OF-WAY



CITY OF ALBUQUERQUE PUBLIC WORKS DEPARTMENT ENGINEERING GROUP				
TITLE: RANCHO SERENO SUBDIVISION - UNIT II ENERGY DISSIPATOR PLAN & SECTIONS RANCHO SERENO				
APPROVALS	ENGINEER	DATE	APPROVALS	ENGINEER
D.R.C. CHAIR	<i>[Signature]</i>	10/27/93	WATER	N/A RWK 9-9-93
TRANS. DEV.	<i>[Signature]</i>	9-27-93	WASTE WATER	N/A RWK 9-9-93
HYDROLOGY	<i>[Signature]</i>	09/09/93	NMUI	
AMAFCA PROJECT NO.	4569.93	MAP NO. C-12 & D-12	SHEET 25	OF 28

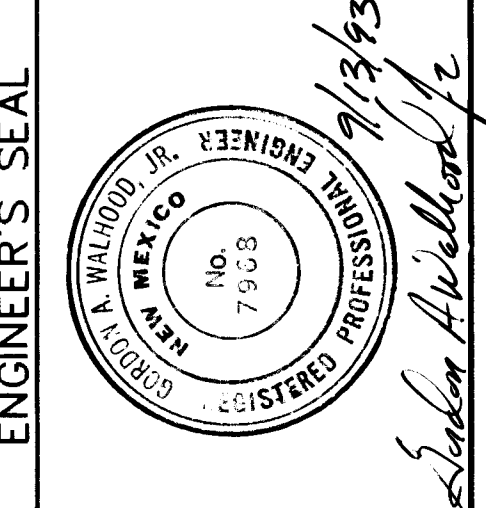

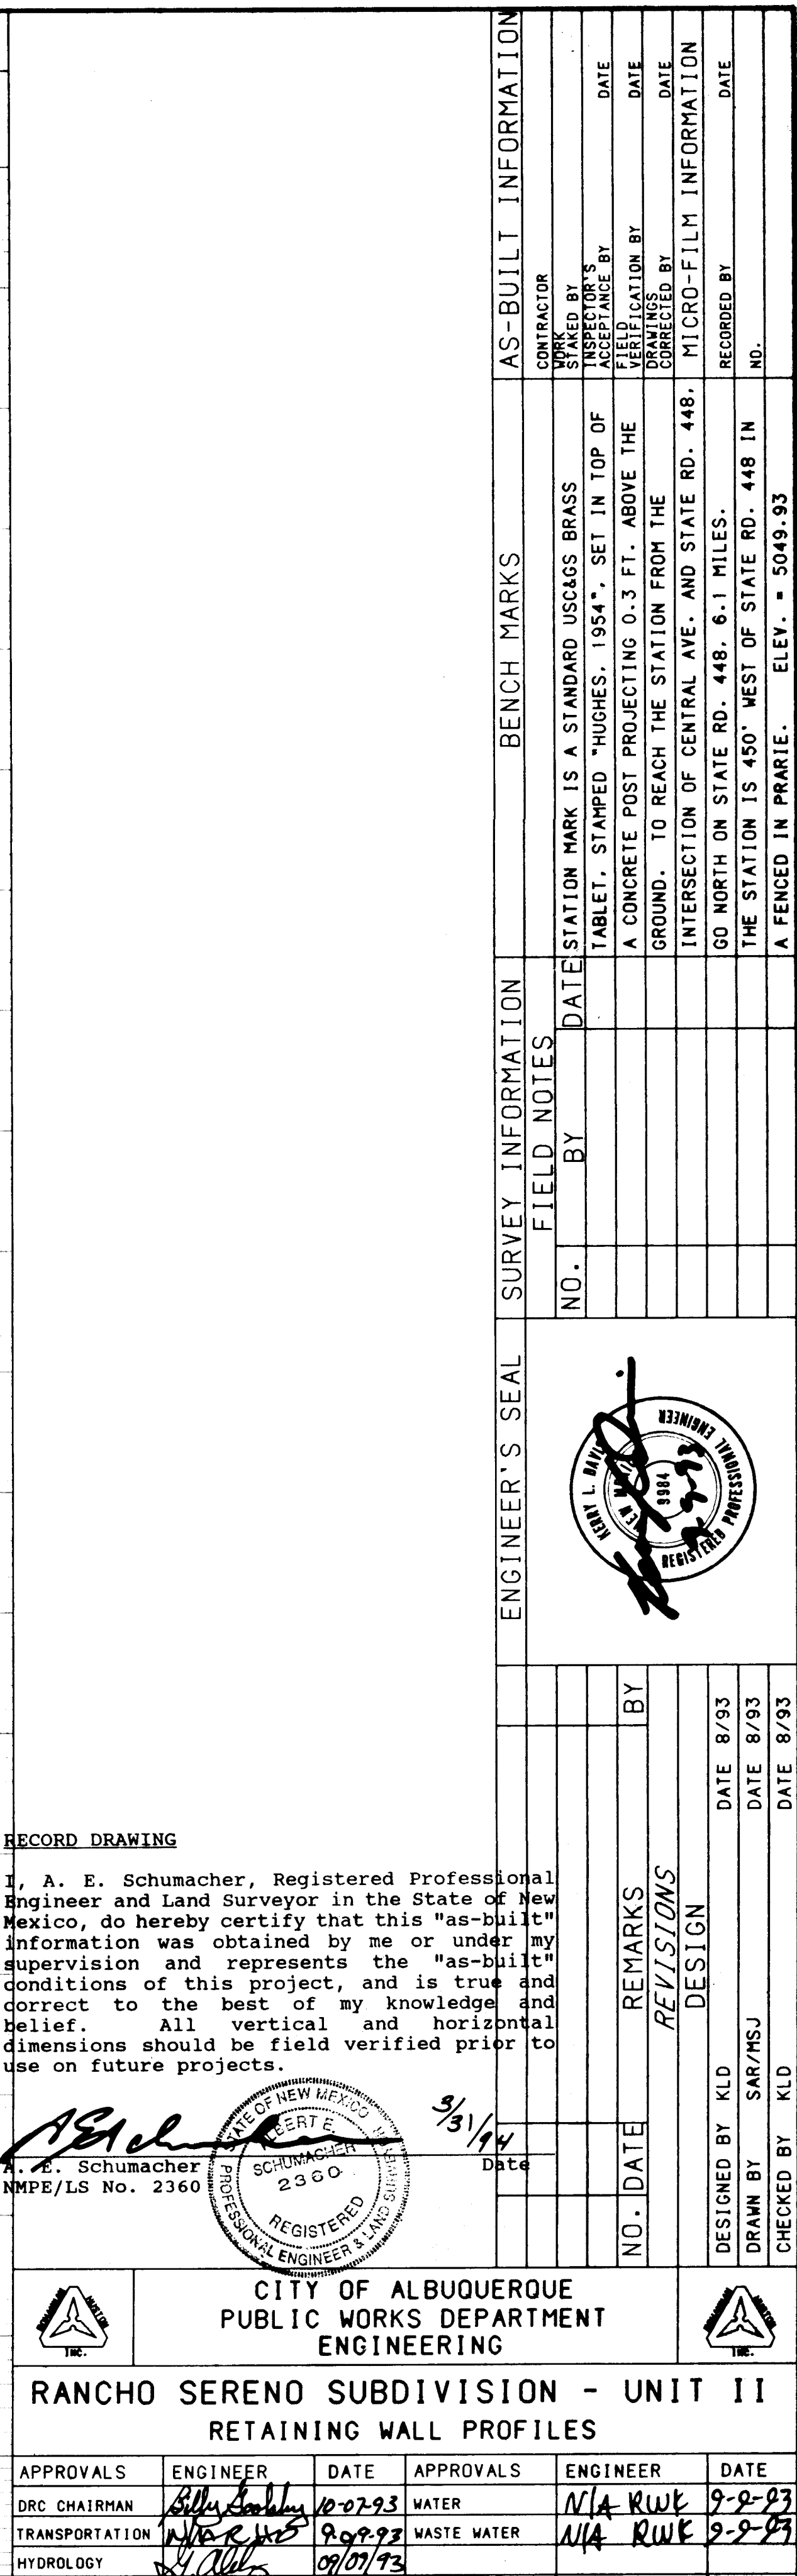

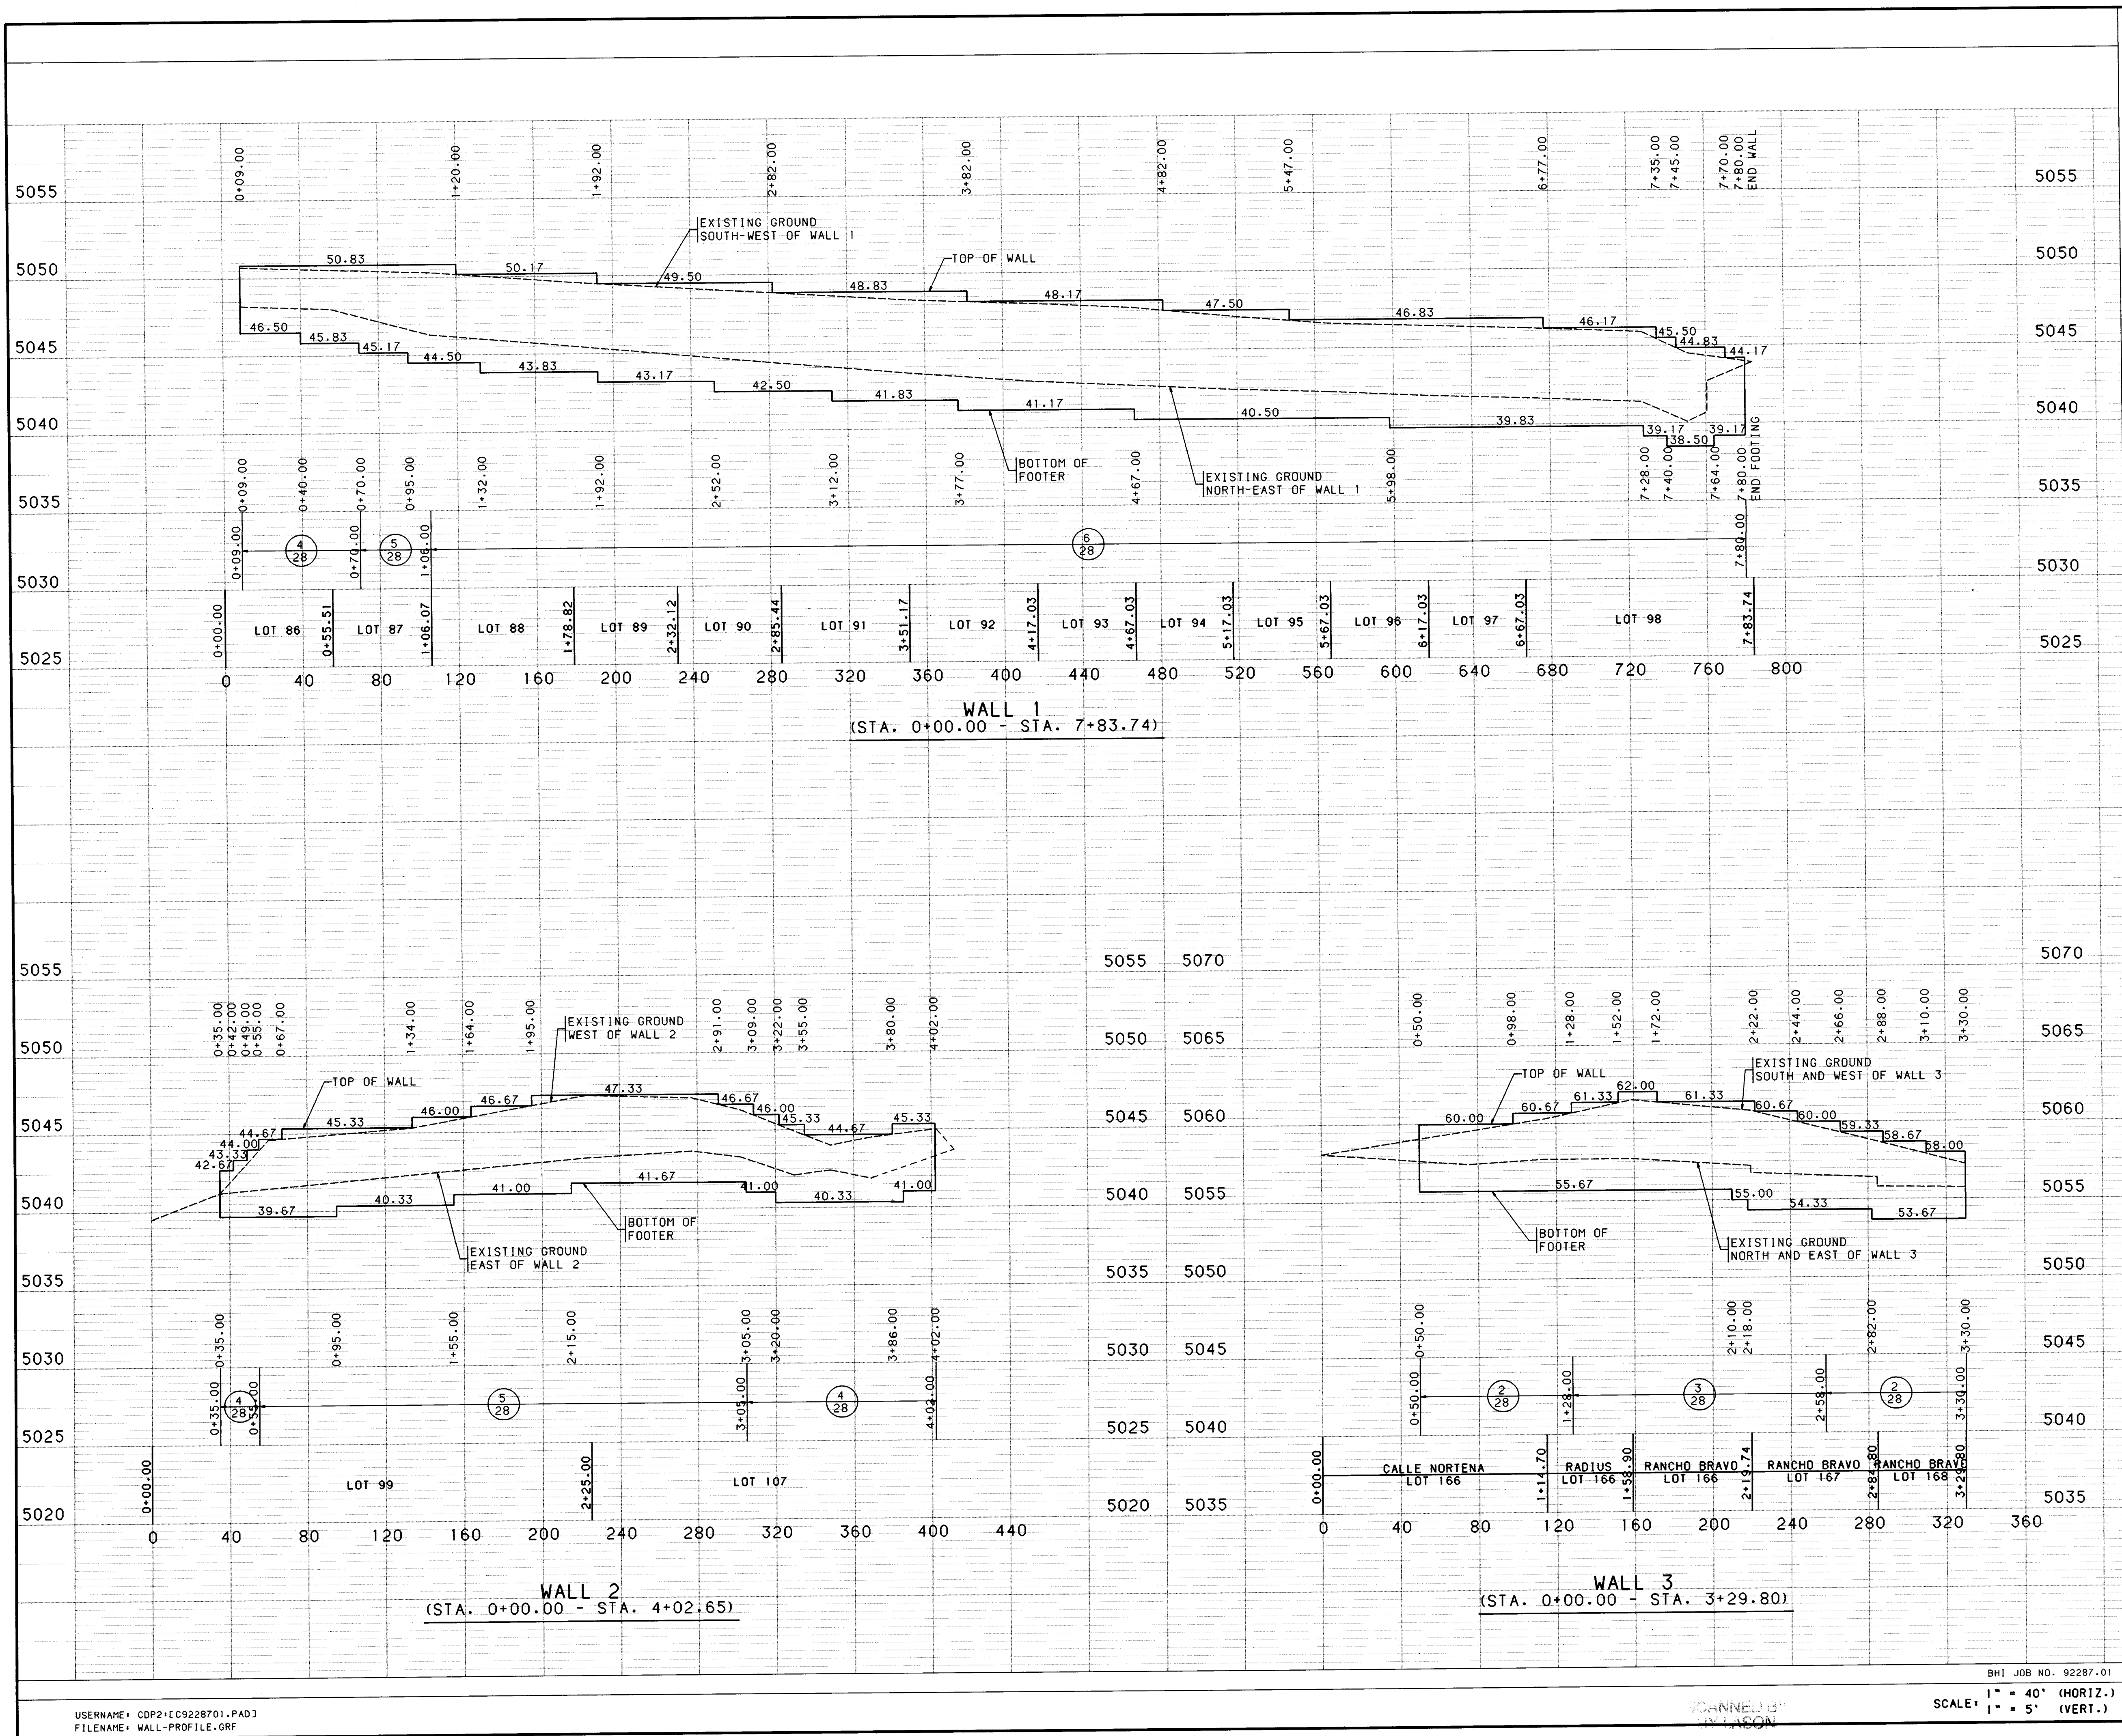

ENGINEER'S SEAL		SURVEY INFORMATION		BENCH MARKS		AS-BUILT INFORMATION																									
BY		FIELD NOTES		STATION MARK IS A STANDARD USGCS BRASS TABLET, STAMPED "HUGHES, 1954", SET IN TOP OF A CONCRETE POST PROJECTING 0.3 FT. ABOVE THE GROUND. TO REACH THE STATION FROM THE INTERSECTION OF CENTRAL AVE. AND STATE RD. 448, GO NORTH ON STATE RD. 448, 6.1 MILES. THE STATION IS 450' WEST OF STATE RD. 448 IN A FENCED IN PRAIRIE.		CONTRACTOR																									
REVISIONS		NO. DATE		NO. DATE		NO. DATE																									
DESIGNED BY KLD		DATE 8/93		NO. DATE		NO. DATE																									
DRAWN BY SAR/MSJ		DATE 8/93		NO. DATE		NO. DATE																									
CHECKED BY KLD		DATE 8/93		NO. DATE		NO. DATE																									
1 2 3 4 5 6 7 8 9 10 11 12 13 216 4569.93 2694A CITY OF ALBUQUERQUE PUBLIC WORKS DEPARTMENT ENGINEERING RANCHO SERENO SUBDIVISION - UNIT II RETAINING WALL PROFILES <table border="1"><thead><tr><th>APPROVALS</th><th>ENGINEER</th><th>DATE</th><th>APPROVALS</th><th>ENGINEER</th><th>DATE</th></tr></thead><tbody><tr><td>DRC CHAIRMAN</td><td>Billy Bobley</td><td>10-2-93</td><td>WATER</td><td>N/A RWK</td><td>9-2-93</td></tr><tr><td>TRANSPORTATION</td><td>N/A RWK</td><td>9-2-93</td><td>WASTE WATER</td><td>N/A RWK</td><td>9-2-93</td></tr><tr><td>HYDROLOGY</td><td>N/A RWK</td><td>09/07/93</td><td></td><td></td><td></td></tr></tbody></table> PROJECT NO. 4569.93 MAP C-12 NO. D-12 SHEET 26 OF 28								APPROVALS	ENGINEER	DATE	APPROVALS	ENGINEER	DATE	DRC CHAIRMAN	Billy Bobley	10-2-93	WATER	N/A RWK	9-2-93	TRANSPORTATION	N/A RWK	9-2-93	WASTE WATER	N/A RWK	9-2-93	HYDROLOGY	N/A RWK	09/07/93			
APPROVALS	ENGINEER	DATE	APPROVALS	ENGINEER	DATE																										
DRC CHAIRMAN	Billy Bobley	10-2-93	WATER	N/A RWK	9-2-93																										
TRANSPORTATION	N/A RWK	9-2-93	WASTE WATER	N/A RWK	9-2-93																										
HYDROLOGY	N/A RWK	09/07/93																													

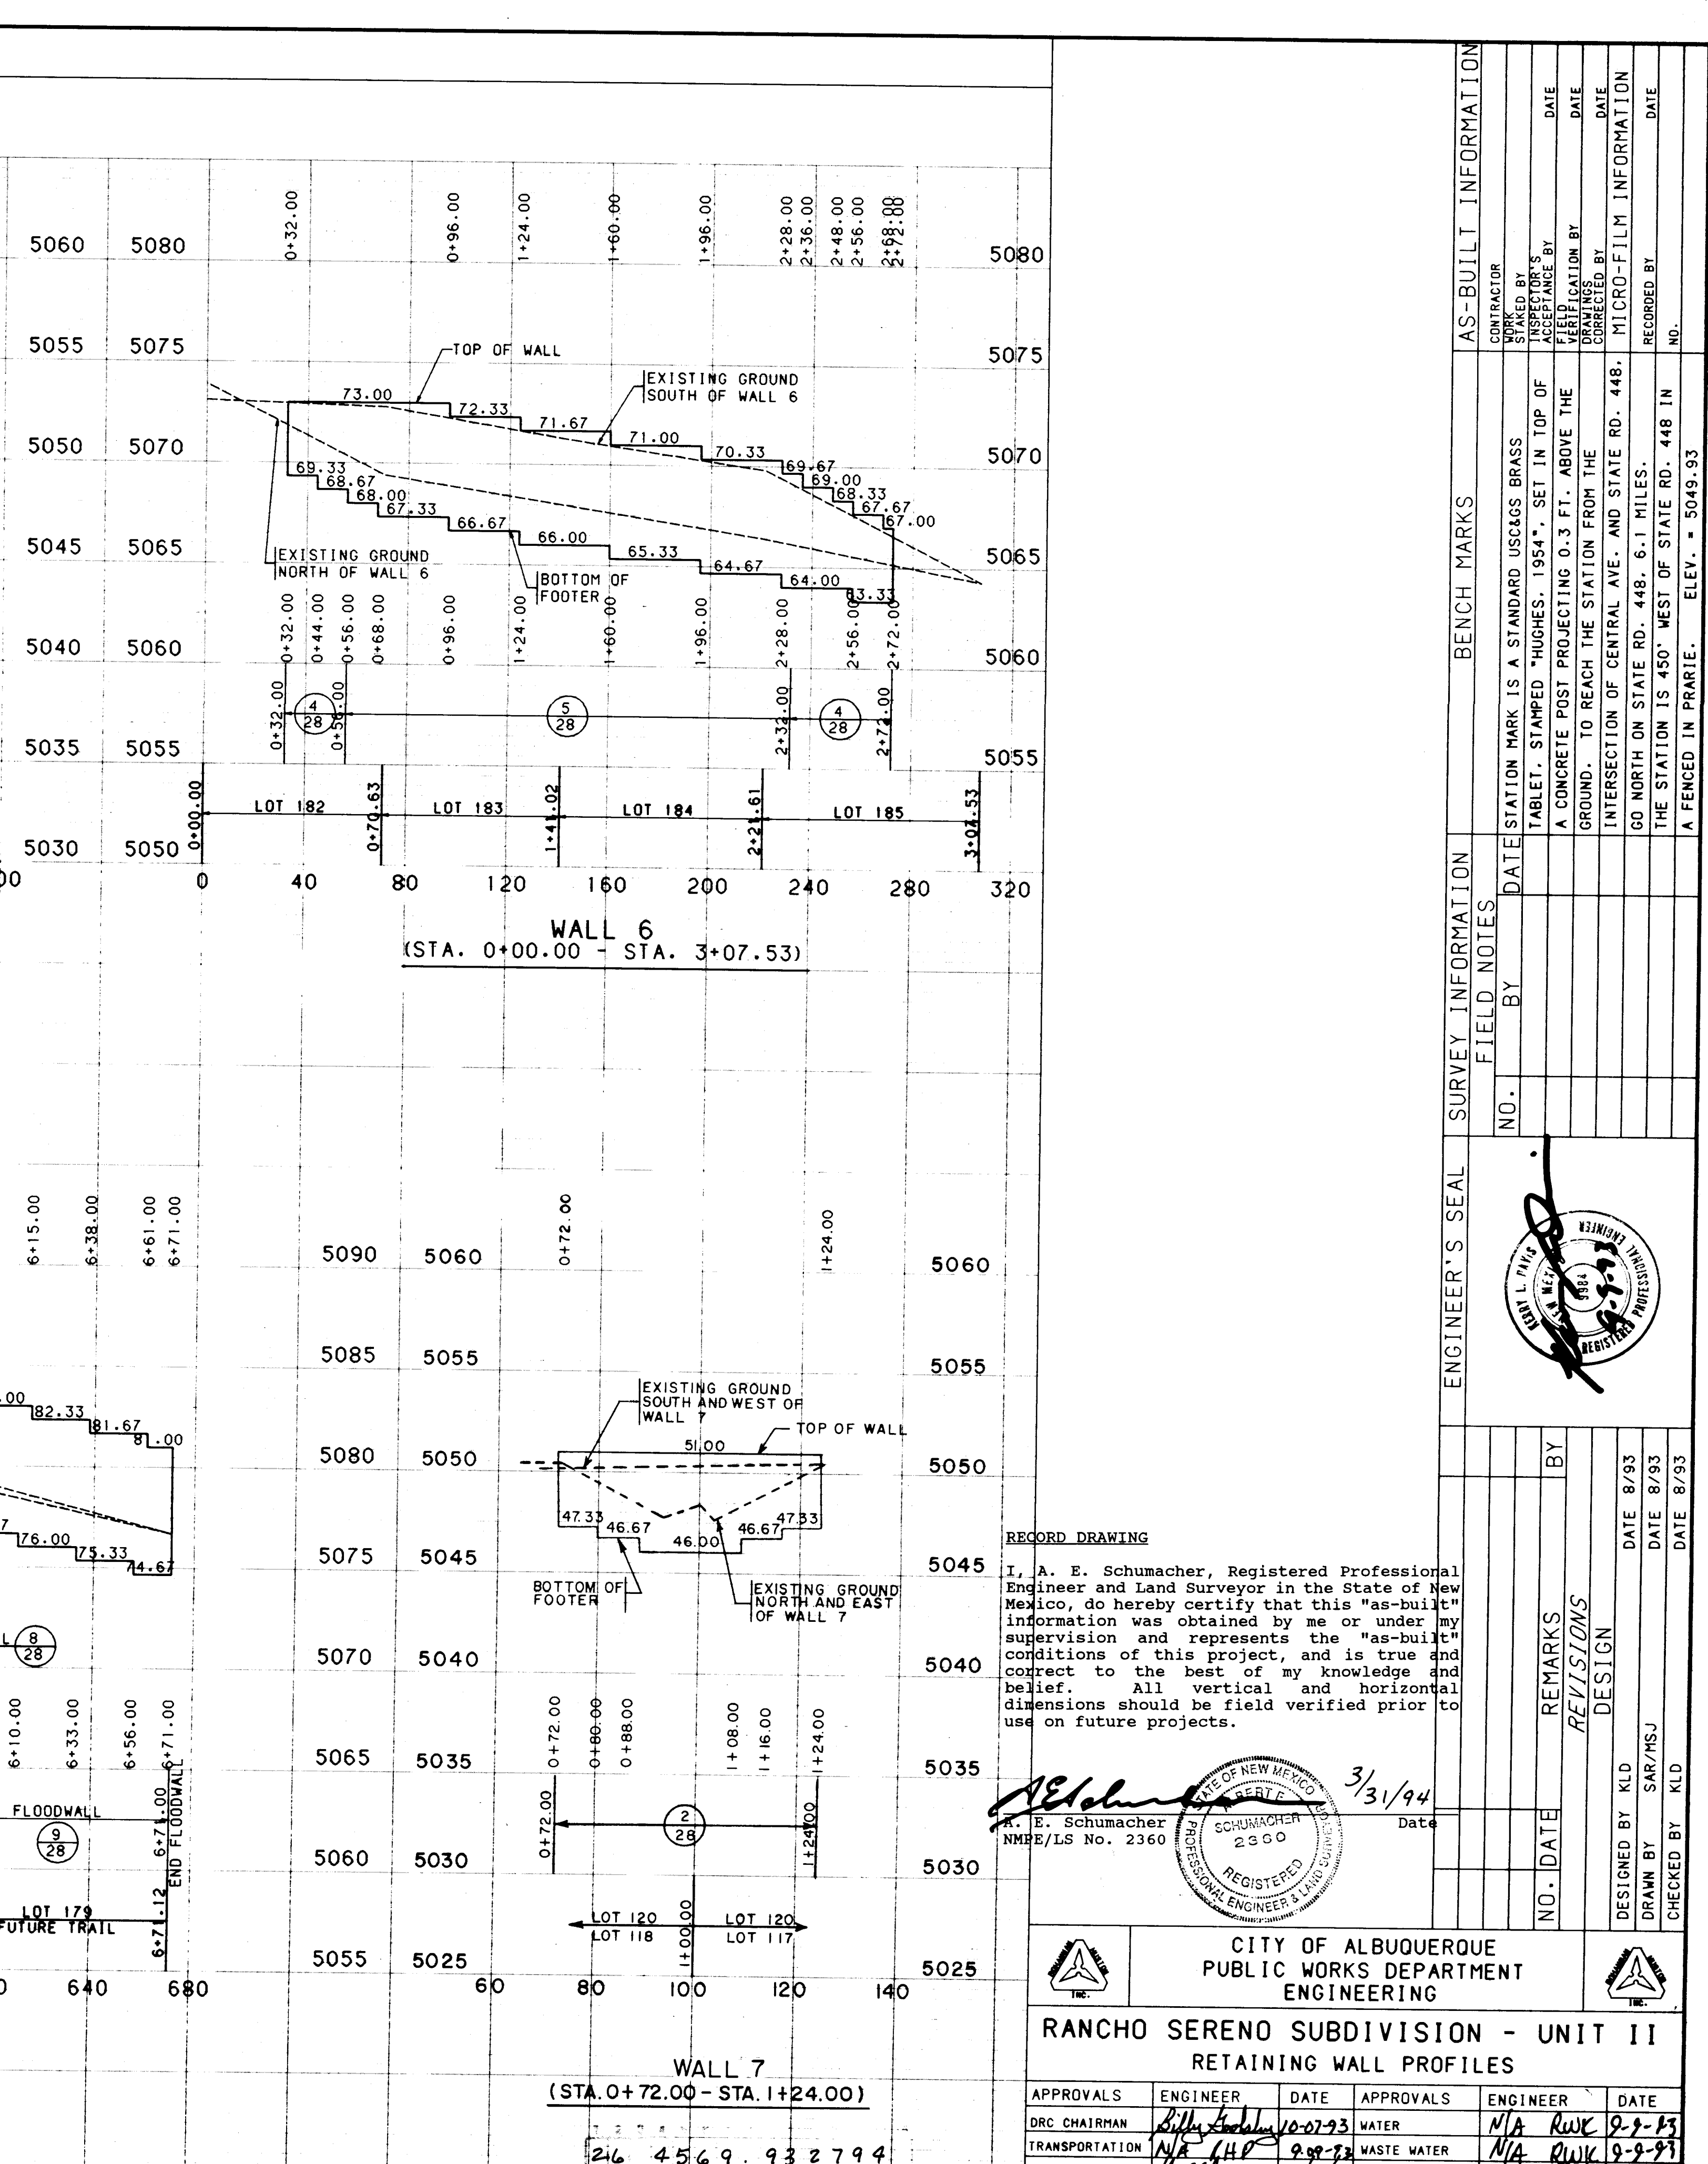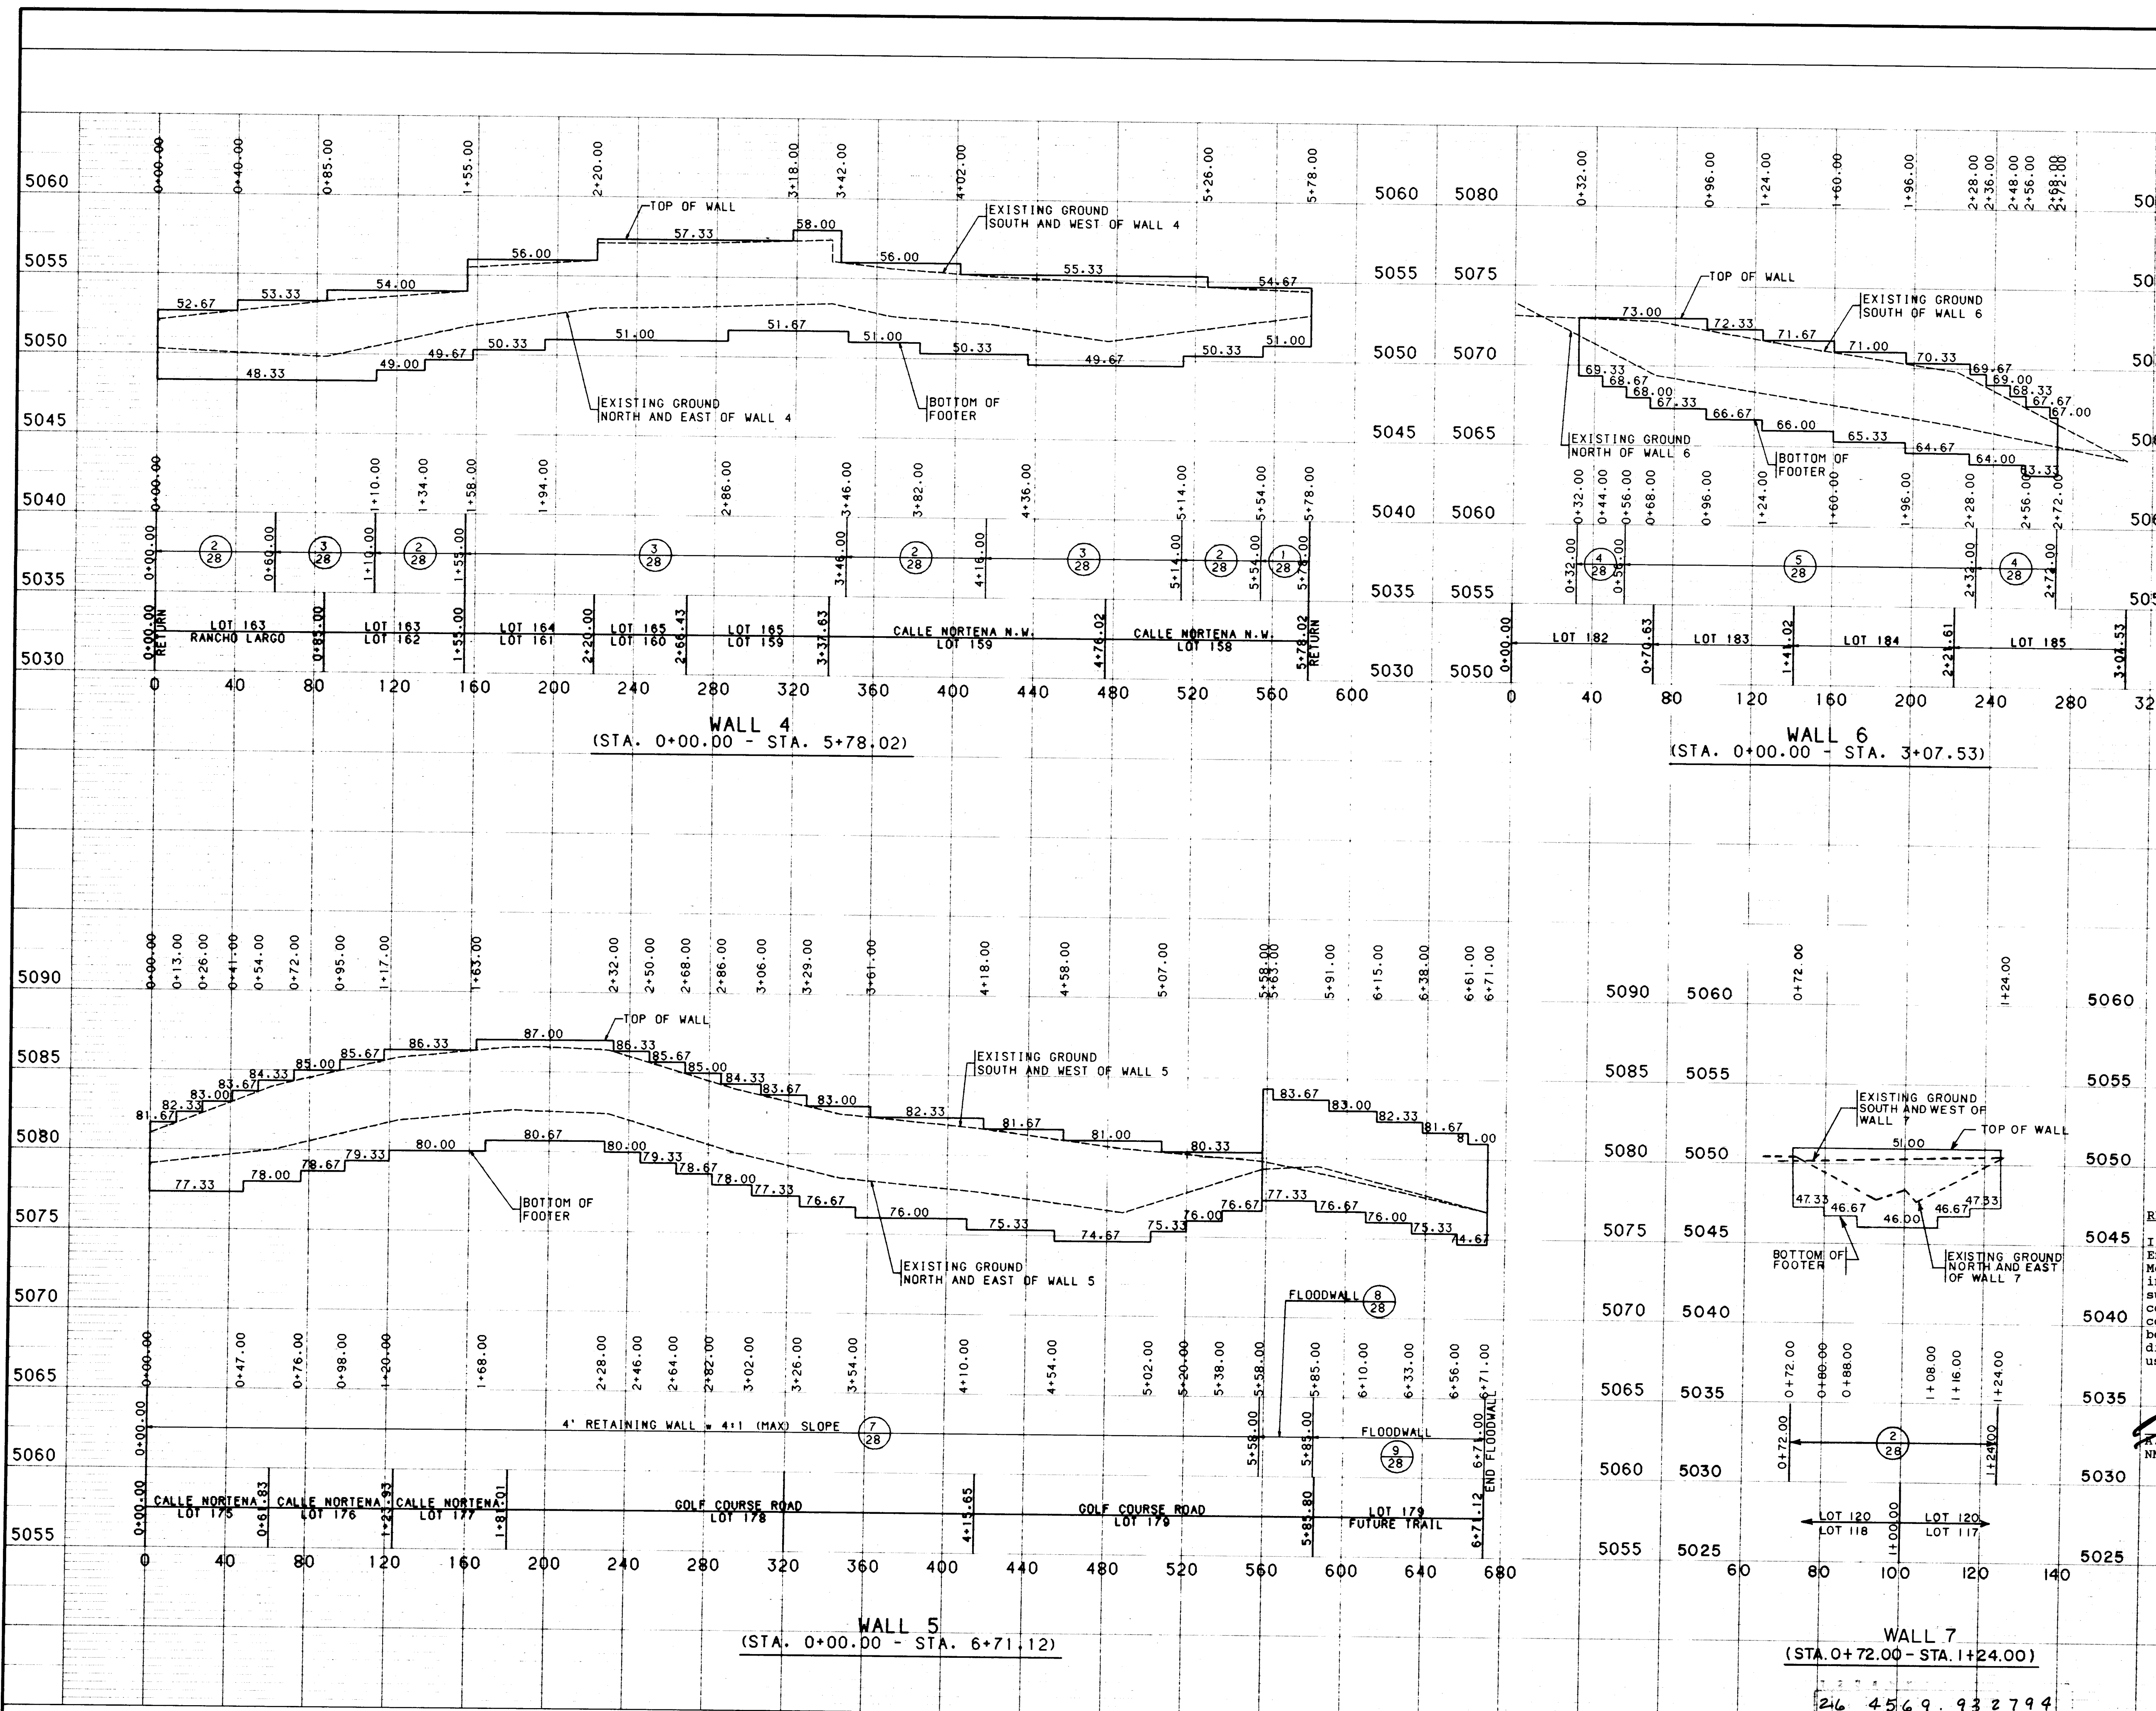


RECORD DRAWING
I, A. E. Schumacher, Registered Professional Engineer and Land Surveyor in the State of New Mexico, do hereby certify that this "as-built" information was obtained by me or under my supervision and represents the "as-built" conditions of this project, and is true and correct to the best of my knowledge and belief. All vertical and horizontal dimensions should be field verified prior to use on future projects.

A. E. Schumacher
A. E. Schumacher
NMBE/LS No. 2360
3/31/94
Date


CITY OF ALBUQUERQUE PUBLIC WORKS DEPARTMENT ENGINEERING					
RANCHO SERENO SUBDIVISION - UNIT II RETAINING WALL PROFILES					
APPROVALS	ENGINEER	DATE	APPROVALS	ENGINEER	DATE
DRG CHAIRMAN	<i>Billy Schumacher</i>	10-07-93	WATER	N/A	RWK 9-9-93
TRANSPORTATION	N/A	140	WASTE WATER	N/A	RWK 9-9-93
HYDROLOGY	<i>S. M. M.</i>	07/07/93			
PROJECT NO. 4569.93			MAP C-12 NO. D-12		
SHEET 27			OF 28		

AS-BUILT INFORMATION	
CONTRACTOR	STATION MARK IS A STANDARD USGCS BRASS
DATE	TABLET, STAMPED "HUGHES, 1954", SET IN TOP OF
DATE	A CONCRETE POST PROJECTING 0.3 FT. ABOVE THE
DATE	GROUND. TO REACH THE STATION FROM THE
DATE	INTERSECTION OF CENTRAL AVE. AND STATE RD. 448.
DATE	GO NORTH ON STATE RD. 448. 6.1 MILES.
DATE	THE STATION IS 450' WEST OF STATE RD. 448 IN
DATE	A FENCED IN PRAIRIE. ELEV. = 5049.83

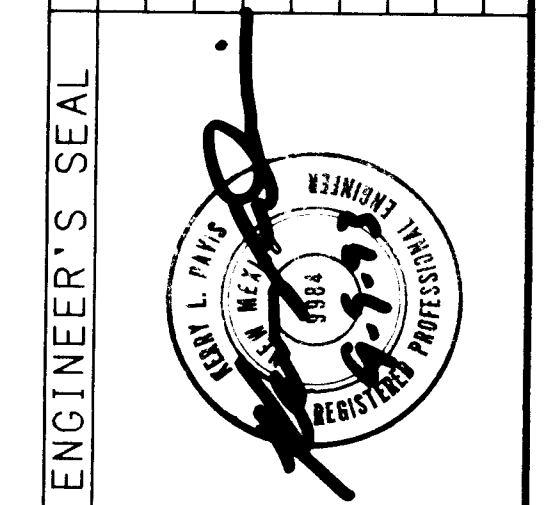

USERNAME: CDP21C9228701.PAD3
FILENAME: WALL-PROFILE2.GRF

SCANNED BY BY LASON
SCALE: 1" = 40' (HORIZ.)
1" = 5' (VERT.)

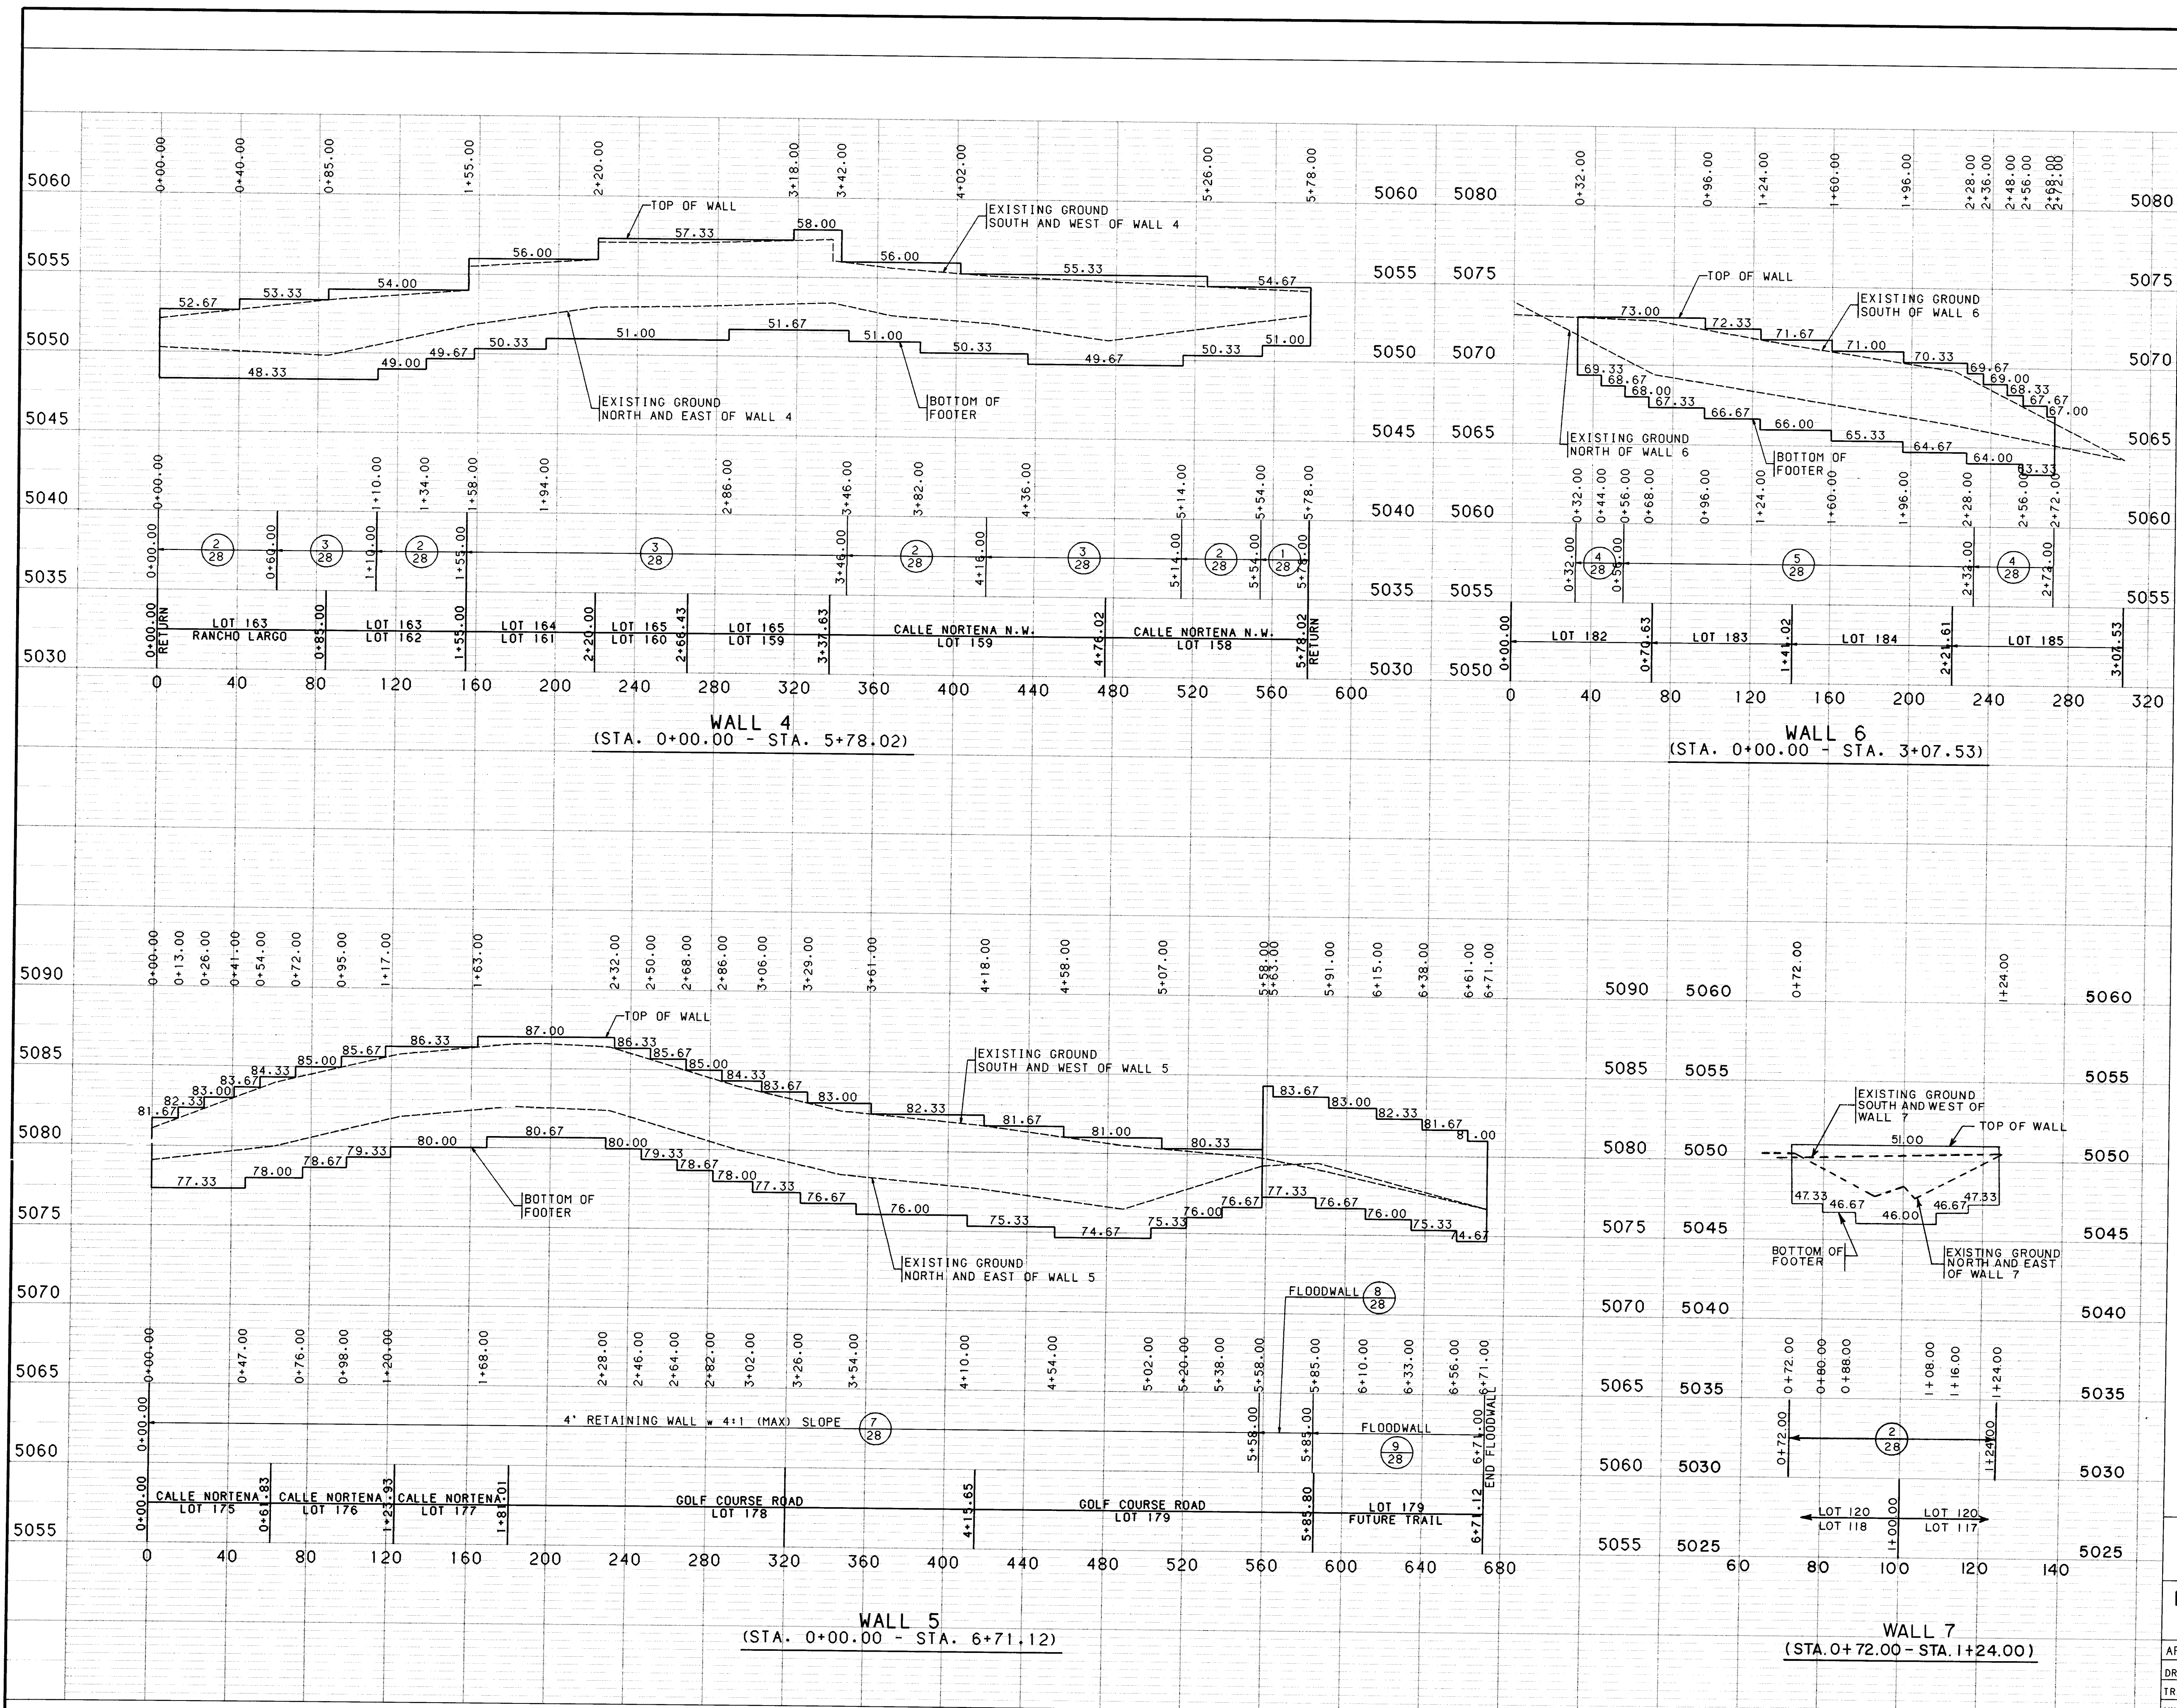

ENGINEER'S SEAL		SURVEY INFORMATION		BENCH MARKS		AS-BUILT INFORMATION	
		FIELD NOTES					
		NO.	BY	DATE	CONTRACTOR	MARKED BY	DATE
					STATION MARK IS A STANDARD USCGS BRASS		
					TABLET, STAMPED "HUGHES, 1954", SET IN TOP OF		
					A CONCRETE POST PROJECTING 0.3 FT. ABOVE THE		
					GROUND. TO REACH THE STATION FROM THE		
					INTERSECTION OF CENTRAL AVE. AND STATE RD. 448.		
					GO NORTH ON STATE RD. 448. 6.1 MILES.		
					THE STATION IS 450' WEST OF STATE RD. 448 IN		
					A FENCED IN PRATIE. ELEV. = 5049.93		

REVISIONS			
NO.	DATE	REMARKS	BY
DESIGN			
DESIGNED BY KLD			
DRAWN BY SAR/MSJ			
CHECKED BY KLD			
DATE 8/93			
DATE 8/93			
DATE 8/93			

CITY OF ALBUQUERQUE PUBLIC WORKS DEPARTMENT ENGINEERING			
RANCHO SERENO SUBDIVISION - UNIT II RETAINING WALL PROFILES			
APPROVALS	ENGINEER	DATE	APPROVALS
DRG CHAIRMAN	Billy B. B. 10-07-93	10-07-93	WATER
TRANSPORTATION	N/A	09-07-93	WASTE WATER
HYDROLOGY	N/A	07-07-93	

PROJECT NO.		MAP NO.		SHEET	
4569.93		C-12 D-12		27 OF 28	

SCANNED BY: BHI JOB NO. 92287.01
SCALE: 1" = 40' (HORIZ.)
1" = 5' (VERT.)



Copyright Bohannon-Huston, Inc. 1993







SIDE YARD RETAINING WALL LISTING												
LOT	DIMENSION (FEET)				ELEVATION							
	A	B	C	D	E	F	G	H	J	K	M	N
171/172	10	60	36.77	63.67	64.24	64.8	65.2	68.74	68.74	63.4	63.9	N.A
172/173	10	60	35.86	65.01	65.91	66.8	67.2	71.91	74.01	65.5	65.1	N.A
173/174	10	40	37.06	67.14	68.12	69.1	69.7	77.93	77.93	67.7	67.3	N.A
187/188	10	40	37.06	62.96	64.08	65.2	65.6	66.1	64.5	63.6	63.2	N.A
	10	60	17.06	(NOTE: Pad 187 is 55'x40', Pad 188 is 55'x60')								
188/189	10	60	21.22	60.75	61.83	62.9	63.3	63.5	62.0	61.4	61.0	N.A
189/190	10	60	35.91	58.17	59.44	60.7	61.1	61.3	59.0	58.8	58.4	59.0
190/191	10	60	50.93	55.57	56.84	58.1	58.5	58.7	56.5	56.2	55.8	56.3
191/192	10	60	55.04	52.97	54.24	55.5	55.9	56.1	54.0	53.6	53.2	54.6
192/193	10	60	59.65	50.87	51.89	52.9	53.3	53.7	52.0	51.5	51.1	53.4

STEPS IN BOTTOM OF FOOTING							
LOT	TYPE						
171/172	1/28	Sta. 0+60,	El.62.00;	Sta. 0+76,	El.61.33;	Sta. 0+96,	El.61.33
172/173	1/28	Sta. 0+10,	El.63.33;	Sta. 0+90,	El.64.00;	Sta. 0+96,	El.64.00
173/174	1/28	Sta. 0+10,	El.65.33;	Sta. 0+58,	El.66.00;	Sta. 0+94,	El.66.67;
		Sta. 1+02,	El.66.67				
187/188	2/28	Sta. 0+10,	El.61.33;	Sta. 0+74,	El.62.00;	Sta. 1+02,	El.62.67;
		Sta. 1+07.06	El.62.67				
188/189	1/28	Sta. 0+10,	El.59.33;	Sta. 0+94,	El.60.00;	Sta. 1+11.22	El.60.00
189/190	2/28	Sta. 0+10,	El.56.67;	Sta. 0+94,	El.57.33;	Sta. 1+25.91	El.57.33
190/191	1/28	Sta. 0+10,	El.54.00;	Sta. 0+86,	El.54.67;	Sta. 1+20,	El.54.67
191/192	2/28	Sta. 0+10,	El.51.33;	Sta. 0+74,	El.52.00;	Sta. 1+20,	El.52.00
192/193	1/28	Sta. 0+10,	El.49.33;	Sta. 0+90,	El.50.00;	Sta. 1+24,	El.50.00

STEPS IN TOP OF WALL						
LOT	TYPE					
171/172	1/28	Sta. 0+60,	Ei 65.67;	Sta. 0+94,	Ei 66.33;	Sta. 0+96, Ei 66.33
172/173	1/28	Sta. 0+10,	Ei 66.33;	Sta. 0+14,	Ei 67.00;	Sta. 0+40, Ei 67.67
		Sta. 0+92,	Ei 68.33;	Sta. 0+96,	Ei 68.33	
173/174	1/28	Sta. 0+10,	Ei 69.00;	Sta. 0+18,	Ei 69.67;	Sta. 0+86, Ei 70.33
		Sta. 0+93,	Ei 71.00;	Sta. 0+97,	Ei 71.67;	Sta. 1+02, Ei 71.67
187/188	2/28	Sta. 0+10,	Ei 64.00;	Sta. 0+12,	Ei 65.00	Sta. 0+18, Ei 65.67
		Sta. 0+74,	Ei 66.33;	Sta. 1+07.06,	Ei 66.33;	
188/189	1/28	Sta. 0+10,	Ei 62.33;	Sta. 0+14,	Ei 63.00;	Sta. 0+20, Ei 63.67
		Sta. 1+11.22,	Ei 63.67			
189/190	2/28	Sta. 0+10,	Ei 60.33;	Sta. 0+17,	Ei 61.00;	Sta. 0+70, Ei 61.67
		Sta. 1+13,	Ei 61.00;	Sta. 1+18,	Ei 60.33;	Sta. 1+22, Ei 59.67
		Sta. 1+25.91,	Ei 59.67			
190/191	2/28	Sta. 0+10,	Ei 57.67;	Sta. 0+16,	Ei 58.33;	Sta. 0+60, Ei 59.00
		Sta. 1+16,	Ei 58.33;	Sta. 1+20,	Ei 58.33	
191/192	2/28	Sta. 0+10,	Ei 55.67;	Sta. 0+16,	Ei 55.67;	Sta. 0+50, Ei 56.33
		Sta. 1+40,	Ei 56.33			
192/193	1/28	Sta. 0+10,	Ei 52.33;	Sta. 0+14,	Ei 53.00	Sta. 0+36, Ei 53.67
		Sta. 1+24,	Ei 53.67			

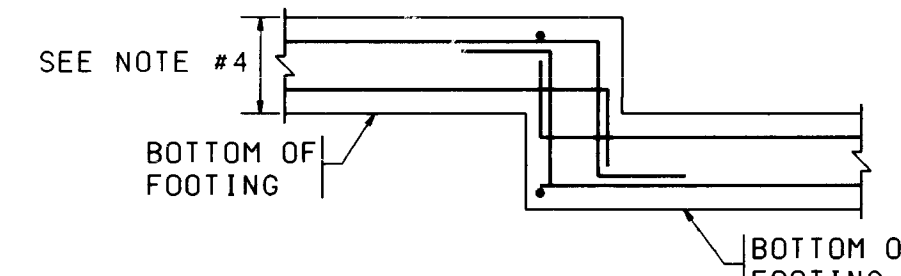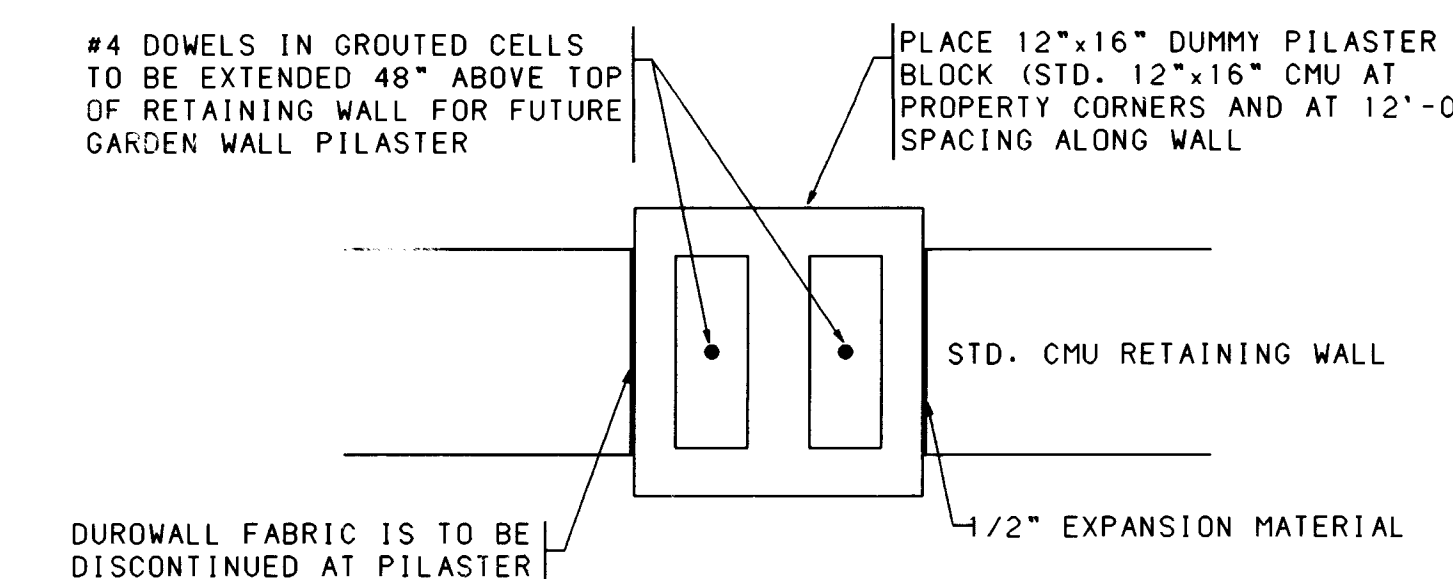

TYPICAL STEPPED FOOTING DETAIL

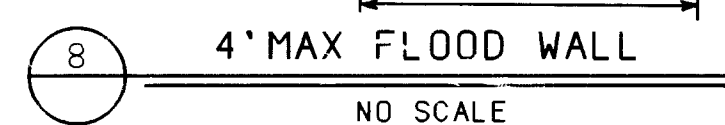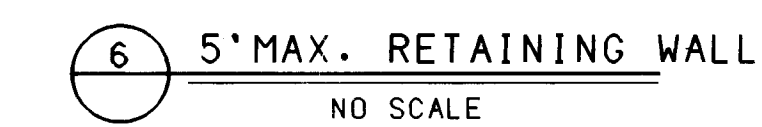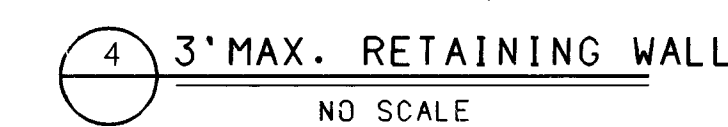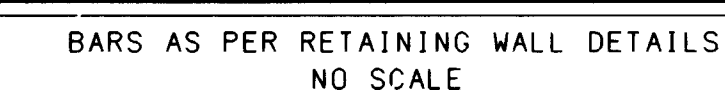

Copyright Bohannon-Huston, Inc. 1993

1	2	3	4	5	6	7	8	9	10	11	12		
2	6		4	5	6	9	.	9	3	2	8	9	4

ERQUE ARTMENT GROUP			
IVISION			
DETAILS			
ALS	ENGINEER	DATE	
	N/A RWE	9-9-93	
ER	N/A RWE	9-9-93	
SHEET		OF	
28		28	

PROJECT NO.	4569.93	MAP C-12 NO. D-12	SHEET 28 OF 28
-------------	---------	-------------------	----------------