

CONSTRUCTION PLANS FOR RANCHO SERENO SUBDIVISION UNIT V ALBUQUERQUE, NEW MEXICO

INDEX


SHEET NUMBER	DESCRIPTION
1	TITLE SHEET
2A-2B	PLAT
3-7	FINAL GRADING AND DRAINAGE PLAN
8	OVERALL PAVING PLAN
	PAVING PLAN AND PROFILE SHEETS
9	RANCHO LUCIDO STA. 27+00.00 - 36+50.00
10	RANCHO PARAISO STA. 36+50.00 - 47+95.12
10a	RANCHO PARAISO STORM DRAIN
11	RANCHO SEGURO STA. 1+00.00 - 7+00.00
12	RANCHO CENTRO STA. 7+00.00 - 14+59.58
12a	RANCHO CENTRO STORM DRAIN
13	RANCHO VISTOSO STA. 1+00.00 - 7+00.00
14	RANCHO VISTOSO STA. 7+00.00 - 12+95.76
15	OVERALL UTILITY PLAN
	UTILITY PLAN AND PROFILE SHEETS
16	RANCHO LUCIDO STA. 27+00.00 - 36+50.00
17	RANCHO PARAISO STA. 36+50.00 - 47+95.12
18	RANCHO SEGURO STA. 1+00.00 - 7+00.00
19	RANCHO CENTRO STA. 7+00.00 - 14+59.58
20	RANCHO VISTOSO STA. 1+00.00 - 7+00.00
21	RANCHO VISTOSO STA. 7+00.00 - 12+95.76
22	CMU RETAINING WALL DETAILS

26-45697-971-2197

Record Drawing


I, Rhonda L. Hice, Registered Professional Land Surveyor in the State of New Mexico, do hereby certify that this "as-built" information was obtained by me or under my supervision and represents that "as-built" conditions of this project, and is true and correct to the best of my knowledge and belief. All vertical and horizontal dimensions should be field verified prior to use on future projects.

Rhonda L. Hice
PS NO. 11953
Date 1/21/97

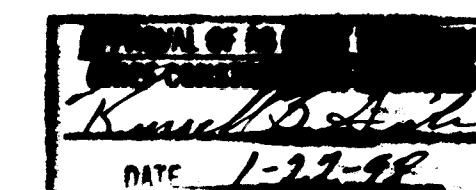

DRB #95-389 BHI JOB NO. 96436A2400

BOHANNAN-HUSTON INC.
ENGINEERS • PLANNERS • PHOTOGRAMMETRISTS • SURVEYORS • LANDSCAPE ARCHITECTS
ALBUQUERQUE LAS CRUCES SANTA FE

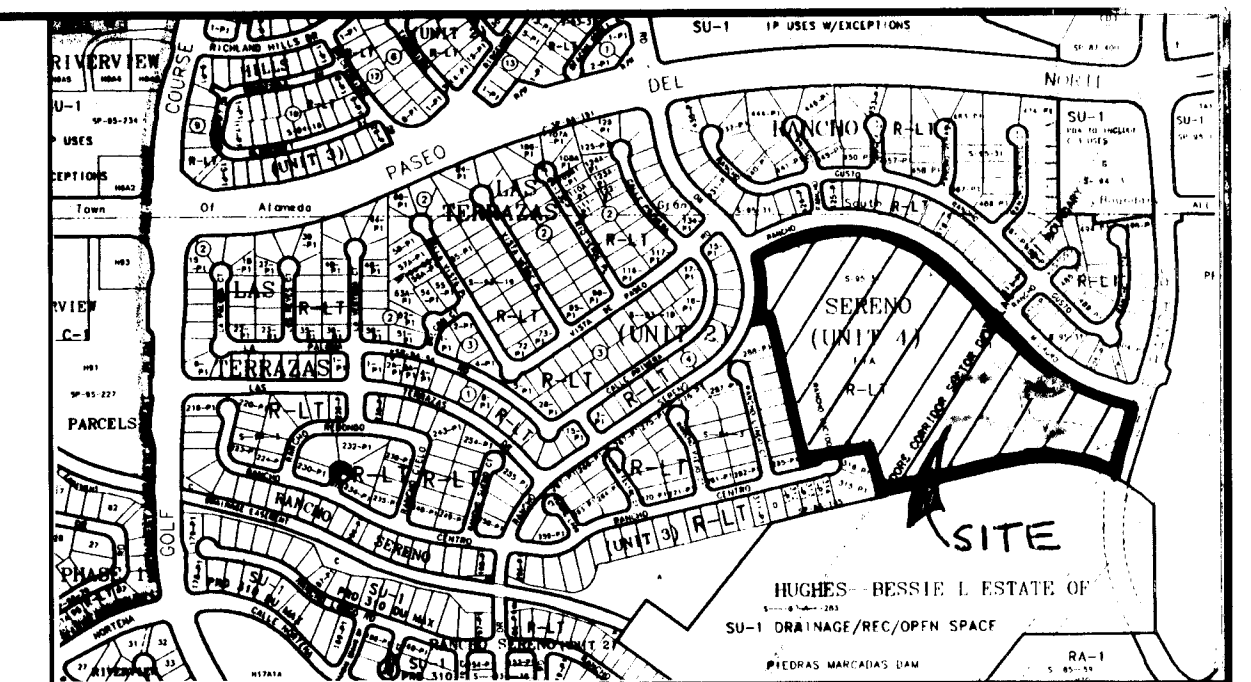

VICINITY MAP

NTS: ZONE ATLAS MAP NO. C-12

NOTICE TO CONTRACTORS

- ALL WORK DETAILED ON THESE PLANS TO BE PERFORMED UNDER CONTRACT SHALL, EXCEPT AS OTHERWISE STATED OR PROVIDED FOR HEREON, BE CONSTRUCTED IN ACCORDANCE WITH THE CITY OF ALBUQUERQUE STANDARD SPECIFICATIONS FOR PUBLIC WORKS CONSTRUCTION, 1986 EDITION AND SHALL INCLUDE UPDATE No. 6.
- TWO WORKING DAYS PRIOR TO ANY EXCAVATION, THE CONTRACTOR MUST CONTACT NEW MEXICO ONE CALL SYSTEM (260-1990) FOR LOCATION OF EXISTING UTILITIES.
- PRIOR TO CONSTRUCTION, THE CONTRACTOR SHALL EXCAVATE AND VERIFY THE HORIZONTAL AND VERTICAL LOCATIONS OF ALL OBSTRUCTIONS. SHOULD A CONFLICT EXIST, THE CONTRACTOR SHALL NOTIFY THE ENGINEER OR SURVEYOR IMMEDIATELY SO THAT THE CONFLICT CAN BE RESOLVED WITH A MINIMUM AMOUNT OF DELAY.
- THREE (3) WORKING DAYS PRIOR TO BEGINNING CONSTRUCTION, THE CONTRACTOR SHALL SUBMIT TO CONSTRUCTION COORDINATION DIVISION A DETAILED CONSTRUCTION SCHEDULE. TWO (2) WORKING DAYS PRIOR TO CONSTRUCTION, THE CONTRACTOR SHALL OBTAIN A BARRICADE PERMIT FROM THE CONST. COORDINATION DIVISION. CONTRACTOR SHALL NOTIFY BARRICADE ENGINEER (768-2551) PRIOR TO OCCUPYING AN INTERSECTION. REFER TO SECTION 19 OF THE GENERAL CONDITIONS OF THE STANDARD SPECIFICATIONS.
- ALL STREET STRIPING ALTERED OR DESTROYED SHALL BE REPLACED W/ PLASTIC REFLECTORIZED PAVEMENT MARKING BY CONTRACTOR TO LOCATION AS EXISTING OR AS INDICATED BY THIS PLAN SET.
- CONTRACTOR SHALL NOTIFY THE ENGINEER NOT LESS THAN SEVEN (7) DAYS PRIOR TO STARTING WORK IN ORDER THAT THE CITY SURVEYOR MAY TAKE NECESSARY MEASURES TO INSURE THE PRESERVATION OF SURVEY MONUMENTS. CONTRACTOR SHALL NOT DISTURB PERMANENT SURVEY MONUMENTS WITHOUT THE CONSENT OF THE CITY SURVEYOR AND SHALL NOTIFY THE CITY SURVEYOR AND BEAR THE EXPENSE OF REPLACING ANY THAT MAY BE DISTURBED WITHOUT PERMISSION. REPLACEMENT SHALL BE DONE ONLY BY THE CITY SURVEYOR. WHEN A CHANGE IS MADE IN THE FINISHED ELEVATIONS OF THE PAVEMENT OF ANY ROADWAY IN WHICH A PERMANENT SURVEY MONUMENT IS LOCATED, CONTRACTOR SHALL, AT HIS OWN EXPENSE, ADJUST THE MONUMENT COVER TO THE NEW GRADE UNLESS OTHERWISE SPECIFIED. REFER TO SECTION 4.4 OF THE GENERAL CONDITIONS OF THE STANDARD SPECIFICATIONS. ANY PERMANENT SURVEY MONUMENT LOCATED WITHIN 50' OF THE PROJECT LIMITS NOT SHOWN ON THE PLANS THAT IS DESTROYED DURING CONSTRUCTION WILL BE REPLACED AT DESIGNER'S EXPENSE.
- ANY WORK WITHIN AN ARTERIAL ROADWAY REQUIRES TWENTY-FOUR HOUR CONSTRUCTION.

THE FOLLOWING NOTES ALSO APPLY WHEN CHECKED

- ☒ ALL UTILITIES AND UTILITY SERVICE LINES SHALL BE INSTALLED PRIOR TO PAVING.
- ☐ BACKFILL COMPACTION SHALL BE ACCORDING TO SPECIFIED STREET USE.
- ☐ TACK COAT REQUIREMENTS SHALL BE DETERMINED BY THE CITY ENGINEER.
- ☒ SIDEWALKS AND WHEELCHAIR RAMPS WITHIN THE CURB RETURNS SHALL BE CONSTRUCTED WHEREVER A NEW CURB RETURN IS CONSTRUCTED.
- ☒ IF CURB IS DEPRESSIONED FOR A DRIVEPAD, THE DRIVEPAD SHALL BE CONSTRUCTED PRIOR TO ACCEPTANCE OF CURB AND GUTTER.
- ☒ ALL STORM DRAINAGE FACILITIES SHALL BE COMPLETED PRIOR TO FINAL ACCEPTANCE.
- ☒ THE REQUESTOR OR DEVELOPER SHALL BE RESPONSIBLE FOR REPAIR OR REPLACEMENT OF ALL CURB AND GUTTER OR SIDEWALK DAMAGED AFTER APPROVAL BY THE CITY ENGINEER OF WORK COMPLETED BY THE CONTRACTOR.

REV.	SHEETS	CITY ENGINEER	DATE	USER DEPARTMENT	DATE	USER DEPARTMENT	DATE
ENGINEERS STAMP & APPROVAL		APPROVALS		ENGINEER	DATE	APPROVED FOR CONSTRUCTION	
		DRC Chairman		Gilley J. Galarza	2-7-97	APPROVED FOR CONSTRUCTION 11/2/97 City Engineer 3/4/97 Date	
		Transportation		Gilley J. Galarza	1-16-96		
		Water/Wastewater		Gilley J. Galarza	1-8-96		
		Hydrology		Gilley J. Galarza	1-9-97		
		Constr. Mngmt.		Gilley J. Galarza	1-16-97		
CITY PROJECT NO.		456997		SHEET 1 OF 22			

SP 000000000000

PLAT OF RANCHO SERENO SUBDIVISION UNIT V

ALBUQUERQUE, NEW MEXICO
DECEMBER, 1996

APPROVALS

PLAT NUMBER	
PLANNING DIRECTOR	DATE
CITY ENGINEER	DATE
A.M.A.F.C.A.	DATE
TRAFFIC ENGINEER	DATE
CITY SURVEYOR	DATE
PROPERTY MANAGEMENT	DATE
UTILITY DEVELOPMENT DEPARTMENT	DATE
DESIGN & DEVELOPMENT, CIP	DATE
U.S. WEST COMMUNICATIONS	DATE
PNM ELECTRIC SERVICES	DATE
PNM GAS SERVICES	DATE
NEW MEXICO UTILITIES, INC.	DATE
THIS IS TO CERTIFY THAT TAXES ARE CURRENT AND PAID ON UPC#	
PROPERTY OWNER OF RECORD:	
BERNALILLO COUNTY TREASURER'S OFFICE	DATE

LOCATION MAP ZONE ATLAS INDEX MAP No. C-12-Z NOT TO SCALE

SUBDIVISION DATA

- D.R.B. No.
- Gross subdivision area: 22.2106 acres
- Total number of lots created: ninety-four (94) lots
- 4.8317 acres of public street right-of-way dedicated with the filing of this plat.
- This plat shows existing easements.
- Date of survey: May 1994
- This site is located within Section 13, T11N, R2E, N.M.P.M.

NOTES

- Bearings are New Mexico State Plane grid Bearings (Central Zone).
- Distances are ground distances.
- Centerline (in lieu of 1/4") monumentation to be installed, as shown on Sheet 2, prior to acceptance of subdivision improvements and will consist of a standard four-inch (4") aluminum alloy cap stamped "City of Albuquerque, Centerline Monumentation, Survey Marker, Do Not Disturb, PLS 5978".
- City of Albuquerque Water and Sanitary Sewer Service to RANCHO SERENO SUBDIVISION, UNIT V must be verified and coordinated with the Public Works Department, City of Albuquerque.
- Lots 317 thru 410, inclusive, are designated as "P-1" lots and shall conform to item 1, Intermittent Parking Criteria. This requires four (4) off street parking spaces per lot for homes containing four (4) bedrooms or less, which can be provided by a two-car garage with driveway. Homes containing five (5) bedrooms will require three-car garages.
- The 1200 square feet of open space required by the R-1-L zone will be met on site for each lot.

DISCLOSURE STATEMENT

The purpose of this report is to subdivide TRACT F-1-A, dedicate public street right-of-way, grant easements, and to vacate easements.

PUBLIC UTILITY EASEMENTS

PUBLIC UTILITY EASEMENTS shown on this plat are ten (10) feet wide and are for the common joint use of:

- PNM Electric Services for the installation, maintenance, and service of overhead and underground electrical lines, transformers, and other equipment, fixtures, structures and related facilities reasonably necessary to provide electrical service.
- PNM Gas Services for installation, maintenance, and service of natural gas lines, valves and other equipment and facilities reasonably necessary to provide natural gas.
- U.S. West for the installation, maintenance and service of all buried and aerial communication lines and other related equipment and facilities reasonably necessary to provide communication services, including but not limited to above ground pedestals and closures.
- Jones Interchange for the installation, maintenance, and service of such lines, cable, and other related equipment and facilities reasonably necessary to provide Cable TV service.
- New Mexico Utilities, Inc. for the installation, maintenance and service of underground water and sanitary sewer lines across the easement (But not parallel within).

Included is the right to build, rebuild, construct, reconstruct, locate, relocate, change, remove, modify, renew, operate, and maintain facilities for the purposes described above, together with free access to, from, and over said easements, including sufficient working area space for electric transformers, with the right and privilege to trim and remove trees, shrubs or bushes which interfere with the purposes set forth herein. No building, sign, pool (above ground or subsurface), hot tub, concrete or wood pool decking, or other structure shall be erected or constructed on said easements, nor shall any well be drilled or operated thereon. Property owners shall be solely responsible for correcting any violations of National Electric Safety Code caused by construction of poles, decking, or any structures adjacent to or near easements shown on this plat.

FREE CONSENT AND DEDICATION

The foregoing recital of that certain tract of land situate within Section 13, Township 11 North, Range 2 East, New Mexico Principal Meridian, City of Albuquerque, Bernalillo County, New Mexico, being TRACT F-1-A, RANCHO SERENO SUBDIVISION, UNIT IV, as the same is shown and designated on the plat recorded in the office of the County Clerk of Bernalillo County, New Mexico on January 4, 1996 in Volume 96C, Folio 3, and now hereon shown and comprising RANCHO SERENO, UNIT V is with the free consent and in accordance with the desired of the undersigned owner(s) and/or proprietor(s) thereof. Said owner(s) and/or proprietor(s) do hereby dedicate 4.8317 acres of public street right-of-way to the City of Albuquerque in Fee Simple with Warranty Covenants and do hereby grant all easements shown on this plat. Electrical power and communication easements are reserved for buried distribution lines, conduits, and pipes for underground utilities and other related equipment where shown or indicated, including the right of ingress and egress, and the right to trim trees and shrubs.

CENTEX REAL ESTATE CORPORATION

Tom Houser, President

State of New Mexico)

County of New Mexico)

This instrument was acknowledged before me on _____ day of _____, 199____ by Tom Houser, President of CENTEX REAL ESTATE CORPORATION, a Nevada Corporation, on behalf of said Corporation.

My commission expires: _____

Notary Public

SURVEYOR'S CERTIFICATION

I, Thomas G. Klingenhagen, a registered Professional New Mexico Surveyor, certify that I am responsible for this survey and that this plat was prepared by me or under my supervision, shows all easements of record, and conforms to the Minimum Requirements of the Board of Registration for Professional Engineers and Professional Surveyors in February 1994 and meets the minimum requirements for monumentation and surveys contained in the Albuquerque Subdivision Ordinance, and is true and accurate to the best of my knowledge and belief.

Bohannon-Huston Inc.
Courtyard I
7500 Jefferson Street, N.E.
Albuquerque, New Mexico 87109

Thomas G. Klingenhagen
New Mexico Professional Surveyor 5978
Date: _____

SHEET 1 OF 3



BOHANNAN-HUSTON INC.
ENGINEERS • PLANNERS • PHOTOGRAMMETRISTS • SURVEYORS • LANDSCAPE ARCHITECTS
ALBUQUERQUE LAS CRUCES SANTA FE

JOB NO. 96-436A-3212

PLAT OF RANCHO SERENO SUBDIVISION UNIT V

ALBUQUERQUE, NEW MEXICO
DECEMBER, 1996SOUTH BOUNDARY TOWN OF
ALAMEDA GRANTRANCHO SERENO SUBDIVISION
PHASE IV
FILED: JANUARY 4, 1996
(96C-3)

SCALE: 1" = 100'

LEGEND	
—	SUBDIVISION BOUNDARY LINE
—	NEW LOT LINE
—	ADJOINING PROPERTY LINE
—	MONUMENT TIE LINE
---	EXISTING EASEMENT LINE
---	NEW EASEMENT LINE
●	CENTERLINE MONUMENT TO BE INSTALLED
▲	FOUND 5/8" REBAR W/ 1-1/4" YELLOW PLASTIC SURVEY CAP STAMPED "WEAVER LS 6544"
△	CITY OF ALBUQUERQUE SURVEY CONTROL MONUMENT
⊙	SET 5/8" REBAR W/ 1-1/4" RED PLASTIC SURVEY CAP STAMPED "KLINGENHAGEN LS 5978"

Corps of Engineers Metal Tablet
stamped "R. ALAMEDA B. NO. 2"
Geographic Position (NAD 1927)
N.M. State Plane Coordinates (Central Zone)
X= 373,513.20 Y= 1,520,142.81
Ground-to-Grid Factor = 0.99967638
ΔG = -00'15"15"
Elevation = 5252.00 (TRIG.)

EXISTING 30' TEMPORARY PUBLIC STORM
DRAINAGE EASEMENT GRANTED TO THE CITY OF
ALBUQUERQUE BY PLAT FILED: JANUARY 4, 1996 (96C-3)
VACATED BY VACATION ACTION

TRACT E
RANCHO SERENO SUBDIVISION
PHASE III
FILED: SEPTEMBER 27, 1994
(94C-327)

TRACT "A-2"
ESTATE OF BESSIE L. HUGHES
FILED: JUNE 29, 1984 (C24-92)
PIEDRAS MARCADAS DAM

CORRECTED
RANCHO SERENO SUBDIVISION
PHASE III
FILED: OCTOBER 4, 1996
(96C-359)

26-7-96
#456977

DETAIL "A"
SCALE: NTS

SHEET 2 OF 3



BOHANNAN-HUSTON INC.
ENGINEERS • PLANNERS • PHOTOGRAMMETRISTS • SURVEYORS • LANDSCAPE ARCHITECTS
ALBUQUERQUE LAS CRUCES SANTA FE

JOB NO. 96-436A-3212


C:\ADDCAD\CIVIL\PI\S96436A\SHEET2.DWG 12/09/1996

PLAT OF
RANCHO SERENO SUBDIVISION
UNIT V
ALBUQUERQUE, NEW MEXICO
DECEMBER, 1996

LOT	ACREAGE
LOT 317	0.1652
LOT 318	0.1641
LOT 319	0.1737
LOT 320	0.1737
LOT 321	0.1641
LOT 322	0.1652
LOT 323	0.2517
LOT 324	0.4288
LOT 325	0.1966
LOT 326	0.1940
LOT 327	0.1940
LOT 328	0.1940
LOT 329	0.1940
LOT 330	0.1500
LOT 331	0.1543
LOT 332	0.1542
LOT 333	0.1544
LOT 334	0.1541
LOT 335	0.1539
LOT 336	0.2006
LOT 337	0.1728
LOT 338	0.1433
LOT 339	0.1511
LOT 340	0.1696
LOT 341	0.1785
LOT 342	0.1512
LOT 343	0.1429
LOT 344	0.2721
LOT 345	0.1744
LOT 346	0.1716
LOT 347	0.1786
LOT 348	0.1505
LOT 349	0.1263
LOT 350	0.1263
LOT 351	0.1728
LOT 352	0.1562
LOT 353	0.1969
LOT 354	0.1837
LOT 355	0.1701
LOT 356	0.1701
LOT 357	0.1572
LOT 358	0.1813
LOT 359	0.1582
LOT 360	0.1586
LOT 361	0.2103
LOT 362	0.2444
LOT 363	0.2013
LOT 364	0.2844
LOT 365	0.2917
LOT 366	0.1680
LOT 367	0.1671
LOT 368	0.1671
LOT 369	0.1769
LOT 370	0.3564
LOT 371	0.2115
LOT 372	0.1809
LOT 373	0.1836
LOT 374	0.1836
LOT 375	0.1836
LOT 376	0.1836
LOT 377	0.2295
LOT 378	0.1850
LOT 379	0.1641
LOT 380	0.1641
LOT 381	0.1641
LOT 382	0.1641
LOT 383	0.1612
LOT 384	0.1737
LOT 385	0.1637
LOT 386	0.1812
LOT 387	0.1812
LOT 388	0.1612
LOT 389	0.1612
LOT 390	0.1612
LOT 391	0.1612
LOT 392	0.1612
LOT 393	0.1612
LOT 394	0.1612
LOT 395	0.1952
LOT 396	0.2250
LOT 397	0.2758
LOT 398	0.1911
LOT 399	0.1844
LOT 400	0.1844
LOT 401	0.1844
LOT 402	0.1844
LOT 403	0.1844
LOT 404	0.1844
LOT 405	0.1844
LOT 406	0.1844
LOT 407	0.1794
LOT 408	0.1716
LOT 409	0.1716
LOT 410	0.1786

CURVE	RADIUS	LENGTH	TANGENT	CHORD	CHORD BEARING	DELTA
C1	600.00	202.19	102.06	201.23	S88°26'27"W	19°19'23"
C2	50.00	63.32	36.70	59.17	S40°43'17"W	72°33'41"
C3	405.00	271.40	141.01	266.35	N03°08'56"E	38°23'40"
C4	30.00	42.69	25.87	39.18	N24°43'17"E	81°32'22"
C5	618.00	751.09	430.21	705.42	S79°34'42"E	69°51'39"
C6	684.00	334.33	170.57	331.01	S58°39'02"E	28°00'18"
C7	30.00	47.12	30.00	42.43	S27°39'11"E	90°00'01"
C8	75.00	22.83	11.90	22.74	N04°16'43"W	17°26'19"
C9	75.00	110.61	68.12	100.85	N29°15'06"E	84°29'55"
C10	476.00	530.46	296.58	503.43	S76°34'25"E	63°51'04"
C11	180.00	120.82	62.78	118.56	S25°25'11"E	38°27'24"
C12	300.00	165.72	85.03	163.62	N61°10'38"E	31°39'01"
C13	75.00	117.81	75.00	106.07	S57°59'52"E	90°00'00"
C14	750.00	89.10	44.60	89.04	N80°24'20"E	06°48'28"
C15	748.00	307.29	155.85	305.14	S84°25'20"E	23°32'18"
C16	75.00	51.48	26.80	50.47	N06°39'54"E	39°19'32"
C17	75.00	59.13	31.20	57.61	N48°54'51"E	45°10'24"
C18	75.00	58.90	31.07	57.40	S35°29'52"E	45°00'00"
C19	75.00	58.90	31.07	57.40	S80°29'52"E	45°00'00"
C20	50.00	15.22	7.67	15.16	N04°16'42"W	17°26'19"
C21	100.00	21.21	10.64	21.17	N06°55'21"W	12°09'02"
C22	25.00	14.95	7.71	14.73	N17°58'41"W	34°15'41"
C23	40.00	85.78	73.48	70.26	N26°19'40"E	122°52'21"
C24	25.00	14.95	7.71	14.73	N70°38'00"E	34°15'41"
C25	100.00	31.41	15.84	31.28	N62°30'06"E	17°59'54"
C26	50.00	73.74	45.42	67.24	S29°15'06"W	84°29'55"
C27	100.00	28.38	14.29	28.28	S04°52'03"E	16°15'37"
C28	25.00	2.06	1.03	2.06	S00°54'07"W	04°43'23"
C29	501.00	558.32	312.16	529.87	S76°34'25"E	63°51'04"
C30	205.00	137.60	71.50	135.03	S25°25'11"E	38°27'24"
C31	155.00	104.04	54.06	102.09	N25°25'11"W	38°27'24"
C32	451.00	502.60	281.00	476.99	N76°34'25"E	63°51'04"
C33	25.00	39.27	25.00	35.36	S57°59'52"E	90°00'00"
C34	275.00	151.91	77.95	149.99	N61°10'38"E	31°39'01"
C35	25.00	39.27	25.00	35.36	N00°21'07"E	90°00'00"
C36	25.00	39.27	25.00	35.36	N89°38'53"W	90°00'00"
C37	325.00	179.53	92.12	177.26	S61°10'38"W	31°39'01"
C38	25.00	39.27	25.00	35.36	S32°00'08"E	90°00'00"
C39	25.00	39.27	25.00	35.36	S89°38'53"E	90°00'00"
C40	25.00	39.27	25.00	35.36	N00°21'07"E	90°00'00"
C41	25.00	39.27	25.00	35.36	N89°38'53"W	90°00'00"
C42	25.00	39.27	25.00	35.36	S00°21'07"W	90°00'00"
C43	25.00	39.27	25.00	35.36	S32°00'08"E	90°00'00"
C44	50.00	78.54	50.00	70.71	S57°59'52"E	90°00'00"
C45	775.00	43.60	21.80	43.59	N78°36'50"E	03°13'23"
C46	25.00	37.71	23.48	34.23	N37°01'01"E	86°25'00"
C47	25.00	37.70	23.48	34.23	S49°37'26"E	86°23'55"
C48	771.00	268.28	135.51	266.93	S82°37'17"E	19°56'13"
C49	40.00	8.20	4.11	8.19	N18°37'28"W	11°44'43"
C50	25.00	27.63	15.55	26.41	N44°38'13"W	63°46'19"
C51	725.00	335.00	170.55	332.03	N89°43'37"W	26°28'29"
C52	100.00	28.38	14.29	28.28	S85°07'56"W	16°15'37"
C53	25.00	16.96	8.82	16.64	S73°49'21"W	38°52'48"
C54	40.00	94.42	97.14	73.97	N57°59'52"W	135°14'24"
C55	25.00	16.96	8.82	16.64	N09°49'04"E	38°52'49"
C56	100.00	28.38	14.29	28.28	N21°07'40"W	16°15'37"
C57	25.00	39.27	25.00	35.36	N57°59'52"W	90°00'00"
C58	25.00	39.27	25.00	35.36	N32°00'08"E	90°00'00"
C59	40.00	8.20	4.11	8.19	S74°45'36"W	61°30'55"
C60	25.00	25.52	12.76	25.52	S17°14'24"E	241°30'55"
C61	25.00	39.27	25.00	35.36	S57°59'52"E	90°00'00"
C62	25.00	2.06	1.03	2.06	S26°53'46"E	04°43'25"
C63	25.00	14.95	7.71	14.68	S07°27'22"E	34°09'24"
C64	40.00	22.31	11.16	22.31	S19°31'50"E	38°18'19"
C65	40.00	31.78	15.89	31.78	S87°09'01"E	76°58'04"
C66	725.00	335.00	170.55	332.03	N79°01'06"E	04°01'55"
C67	500.00	592.77	311.04	522.07	S79°50'26"W	02°08'27"
C68	725.00	335.00	170.55	332.03	N83°15'03"E	04°26'00"
C69	600.00	202.19	102.06	201.23	S88°26'27"W	19°19'23"
C70	725.00	335.00	170.55	332.03	N87°41'19"E	04°26'32"
C71	500.00	592.77	311.04	522.07	S87°28'28"W	04°23'36"
C72	725.00	335.00	170.55	332.03	S87°52'12"E	04°26'27"

TANGENT	BEARING	DISTANCE
T1	S78°47'13"W	70.00
T2	N85°33'33"W	50.11
T3	S77°00'08"W	58.00
T4	S77°00'08"W	72.66
T5	S72°39'11"E	65.00
T6	S06°11'29"E	2.00
T7	N77°00'08"E	17.00
T8	S72°39'11"E	8.99
T9	S17°20'49"W	17.00
T10	N63°40'21"W	5.12
T11	S32°00'59"W	9.85
T12	N24°29'47"W	40.00
T13	S77°00'08"W	4.32
T14	N77°00'08"E	4.62
T15	S63°30'13"W	4.61
T16	N20°24'36"E	20.17

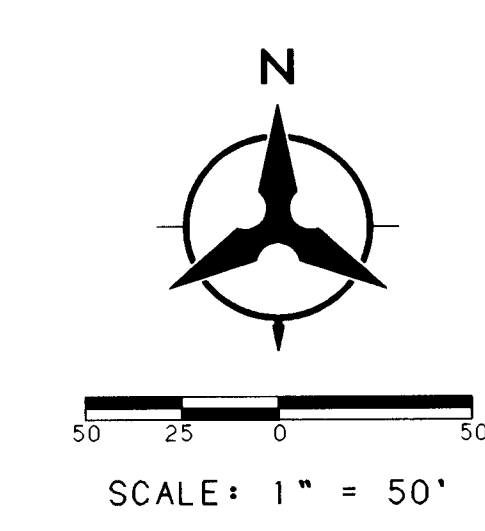

LEGEND	
PROJECT BOUNDARY	---
EXISTING CONTOUR	--- 45.5 ---
EXISTING SPOT ELEVATION	45.5
PROPOSED SPOT ELEVATION	45.5
DIRECTION OF FLOW	S=2.98%
PHASE BOUNDARY	---
EROSION CONTROL BERM	~ ~ ~
PROPOSED RETAINING WALL	=====
EXISTING STORM DRAIN LINE	SD
EXISTING STORM DRAIN MANHOLE	⊙
EXISTING STORM DRAIN INLET	SD
PROPOSED STORM DRAIN LINE	SD
PROPOSED STORM DRAIN MANHOLE	⊙
PROPOSED STORM DRAIN INLET	SD
TURNED BLOCK LOCATION	⊙


NOTE: SPOT ELEVATIONS SHOWN AT CURB DENOTE TOP OF CURB ELEVATIONS

GENERAL GRADING NOTES:

1. THE CONTRACTOR MUST OBTAIN A TOPSOIL DISTURBANCE PERMIT FROM THE CITY OF ALBUQUERQUE, ENVIRONMENTAL HEALTH DIV., PRIOR TO CONSTRUCTION.
2. THE CONTRACTOR IS TO REFER TO THE EARTHWORK SPECIFICATIONS NOTED IN THE GEOTECHNICAL INVESTIGATION REPORT PREPARED BY VINEYARD AND ASSOCIATES, DATED JUNE 16, 1993 AND SUPPLIED BY THE OWNER.
3. THE CONTRACTOR SHALL CONFORM TO ALL CITY, COUNTY, STATE AND FEDERAL DUST CONTROL MEASURES AND REQUIREMENTS AND WILL BE RESPONSIBLE FOR PREPARING AND OBTAINING ALL NECESSARY APPLICATIONS, PERMITS AND APPROVALS.

EROSION CONTROL PLAN:

THE CONTRACTOR SHALL ENSURE THAT NO SOIL ERODES FROM THE LOTS INTO PUBLIC RIGHT-OF-WAY. THIS CAN BE ACHIEVED BY CONSTRUCTING TEMPORARY EROSION CONTROL BERMS AS PER DETAIL THIS SHEET AND WETTING THE SOIL REGULARLY TO KEEP IT FROM BLOWING.

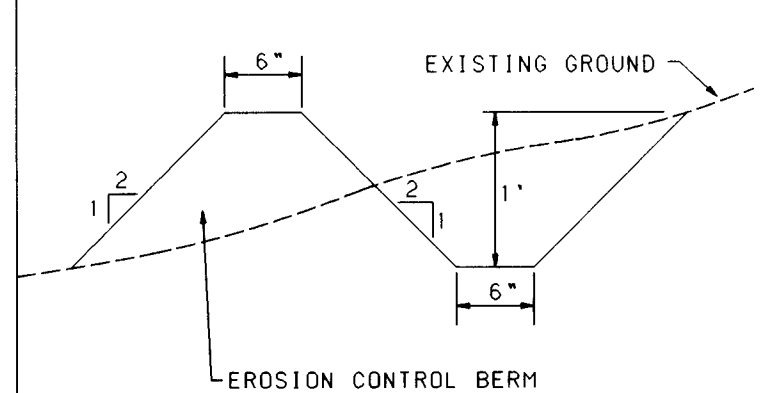

EROSION CONTROL PLAN

NO SCALE
A BERM WITH THE DIMENSIONS SHOWN SHALL BE MAINTAINED DURING CONSTRUCTION UNTIL COMPLETION OF INDIVIDUAL HOMES WITHIN THE PROJECT.

26-4569-97-0397

CITY OF ALBUQUERQUE PUBLIC WORKS DEPARTMENT ENGINEERING GROUP					
RANCHO SERENO SUBDIVISION - UNIT V FINAL GRADING & DRAINAGE PLAN					
APPROVALS	ENGINEER	DATE	APPROVALS	ENGINEER	DATE
DRG CHAIRMAN			WATER		
TRANSPORTATION			WASTE WATER		
HYDROLOGY			A.M.A.F.C.A.		
DRAWING NO. 456997			MAP NO. C-12		
DESIGNED BY MSJ			SHEET 3 OF 22		
DRAWN BY SAR			DATE		
CHECKED BY KLD			DATE		



USERNAME: CDP109520701.PAD
FILENAME: GRADE3.GRF

BHI JOB NO. C95207-01

Copyright Bohannon-Houston, Inc. 1995


FOR INFORMATION ONLY

SCANNED BY
LASON

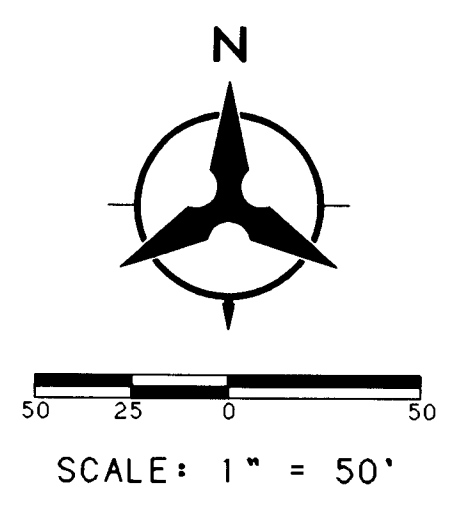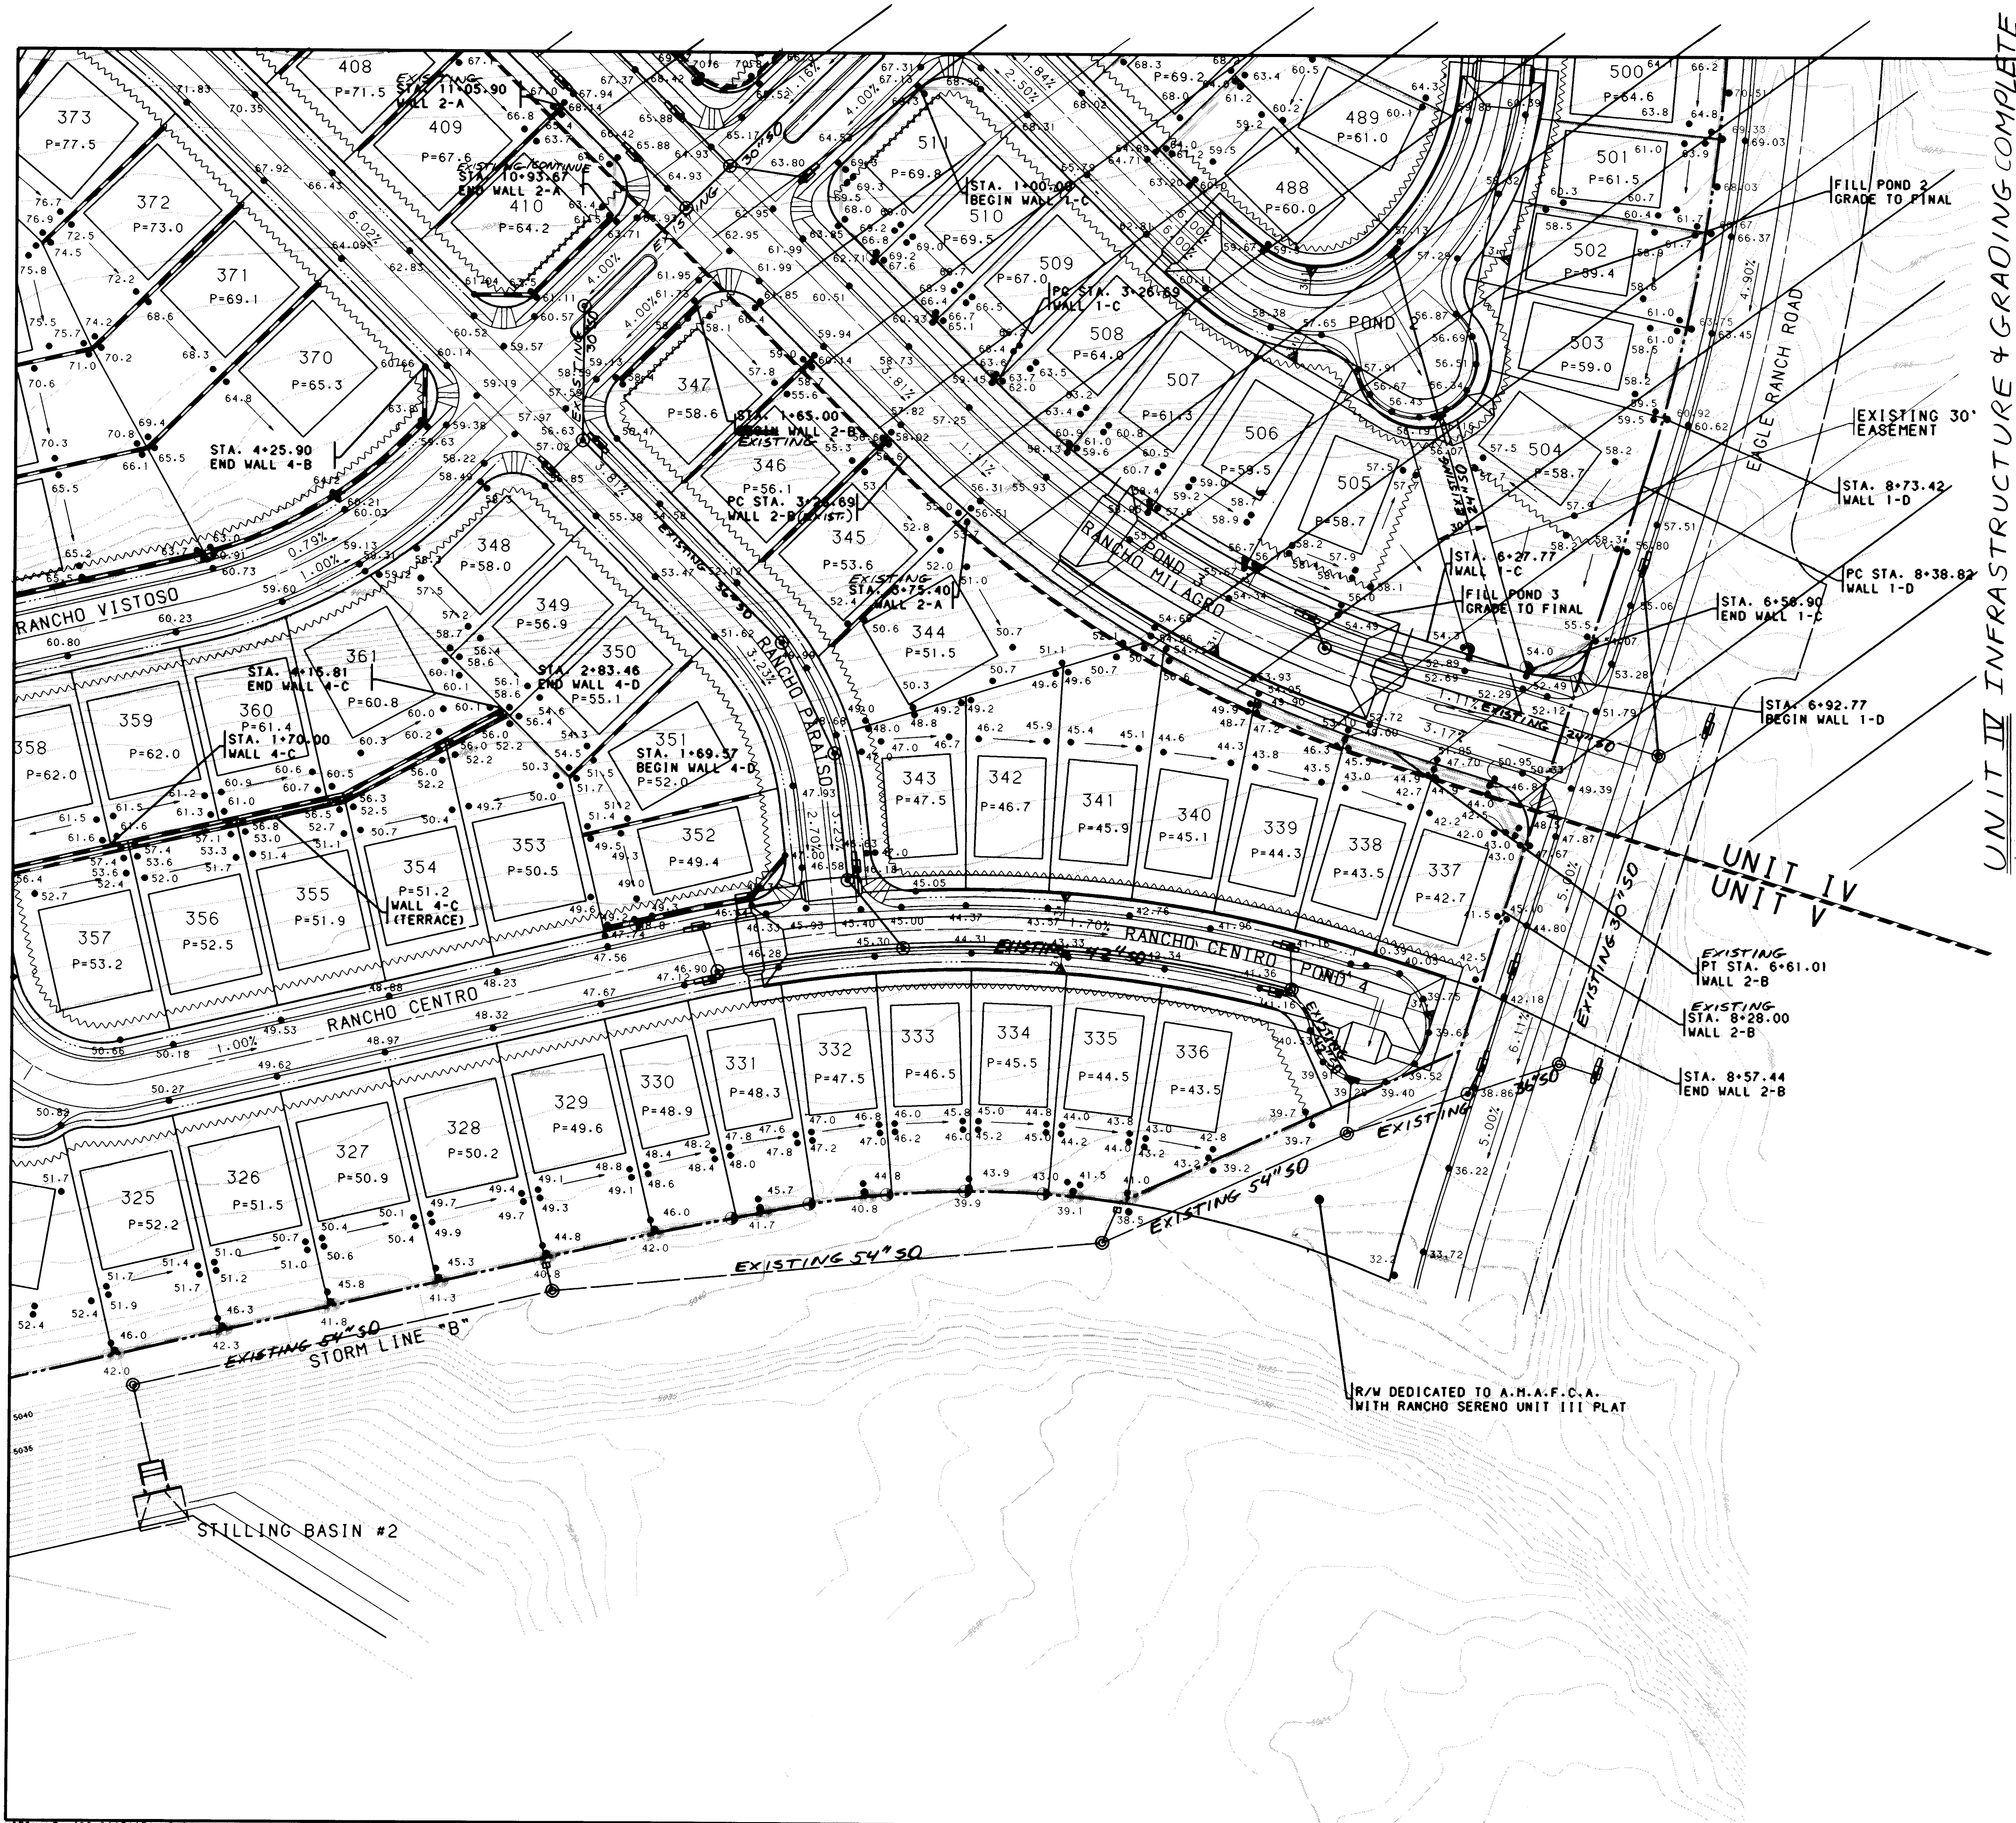

LEGEND	
PROJECT BOUNDARY	---
EXISTING CONTOUR	---
EXISTING SPOT ELEVATION	45.5
PROPOSED SPOT ELEVATION	45.5
DIRECTION OF FLOW	S=2.98%
PHASE BOUNDARY	---
EROSION CONTROL BERM	---
PROPOSED RETAINING WALL	---
EXISTING STORM DRAIN LINE	---
EXISTING STORM DRAIN MANHOLE	---
EXISTING STORM DRAIN INLET	---
PROPOSED STORM DRAIN LINE	---
PROPOSED STORM DRAIN MANHOLE	---
PROPOSED STORM DRAIN INLET	---
TURNED BLOCK LOCATION	---


NOTE: SPOT ELEVATIONS SHOWN AT CURB DENOTE TOP OF CURB ELEVATIONS

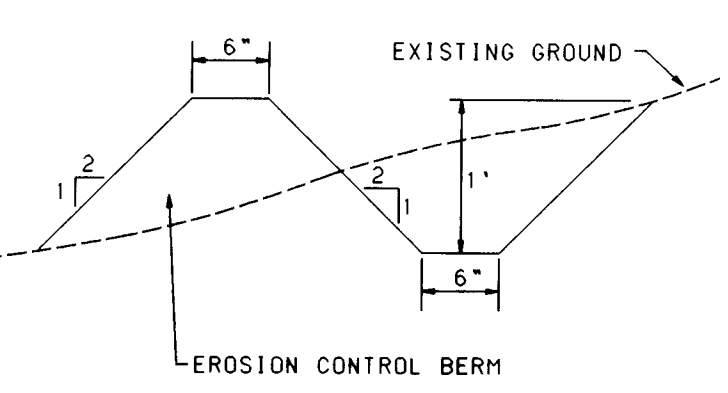

EROSION CONTROL PLAN
NO SCALE
A BERM WITH THE DIMENSIONS SHOWN SHALL BE MAINTAINED DURING CONSTRUCTION UNTIL COMPLETION OF INDIVIDUAL HOMES WITHIN THE PROJECT.

2/2/1995 10/1/97 10/1/97

AS-BUILT INFORMATION	
CONTRACTOR	New Concepts Inc.
INSPECTOR	STANLEY BRASS
DATE	11/29/95
FIELD NOTES	
NO.	BY
1	MSJ
2	MSJ
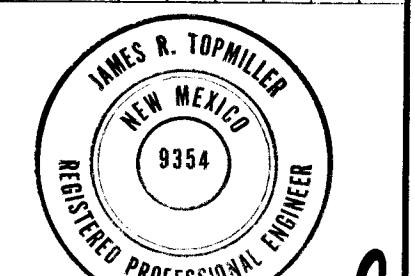


James R. Tompkins
11/1/95

CITY OF ALBUQUERQUE PUBLIC WORKS DEPARTMENT ENGINEERING GROUP					
RANCHO SERENO SUBDIVISION - UNIT V FINAL GRADING & DRAINAGE PLAN					
APPROVALS	ENGINEER	DATE	APPROVALS	ENGINEER	DATE
DRG. CHAIRMAN			WATER		
TRANSPORTATION			WASTE WATER		
HYDROLOGY			A.M.A.F.C.A.		
DRAWING NO.	456997	MAP NO.	C-12	SHEET	4 OF 22
BHI JOB NO. C95207.01					
Copyright Bohannon-Huston, Inc. 1995					

FOR INFORMATION ONLY


SCANNED BY LASON

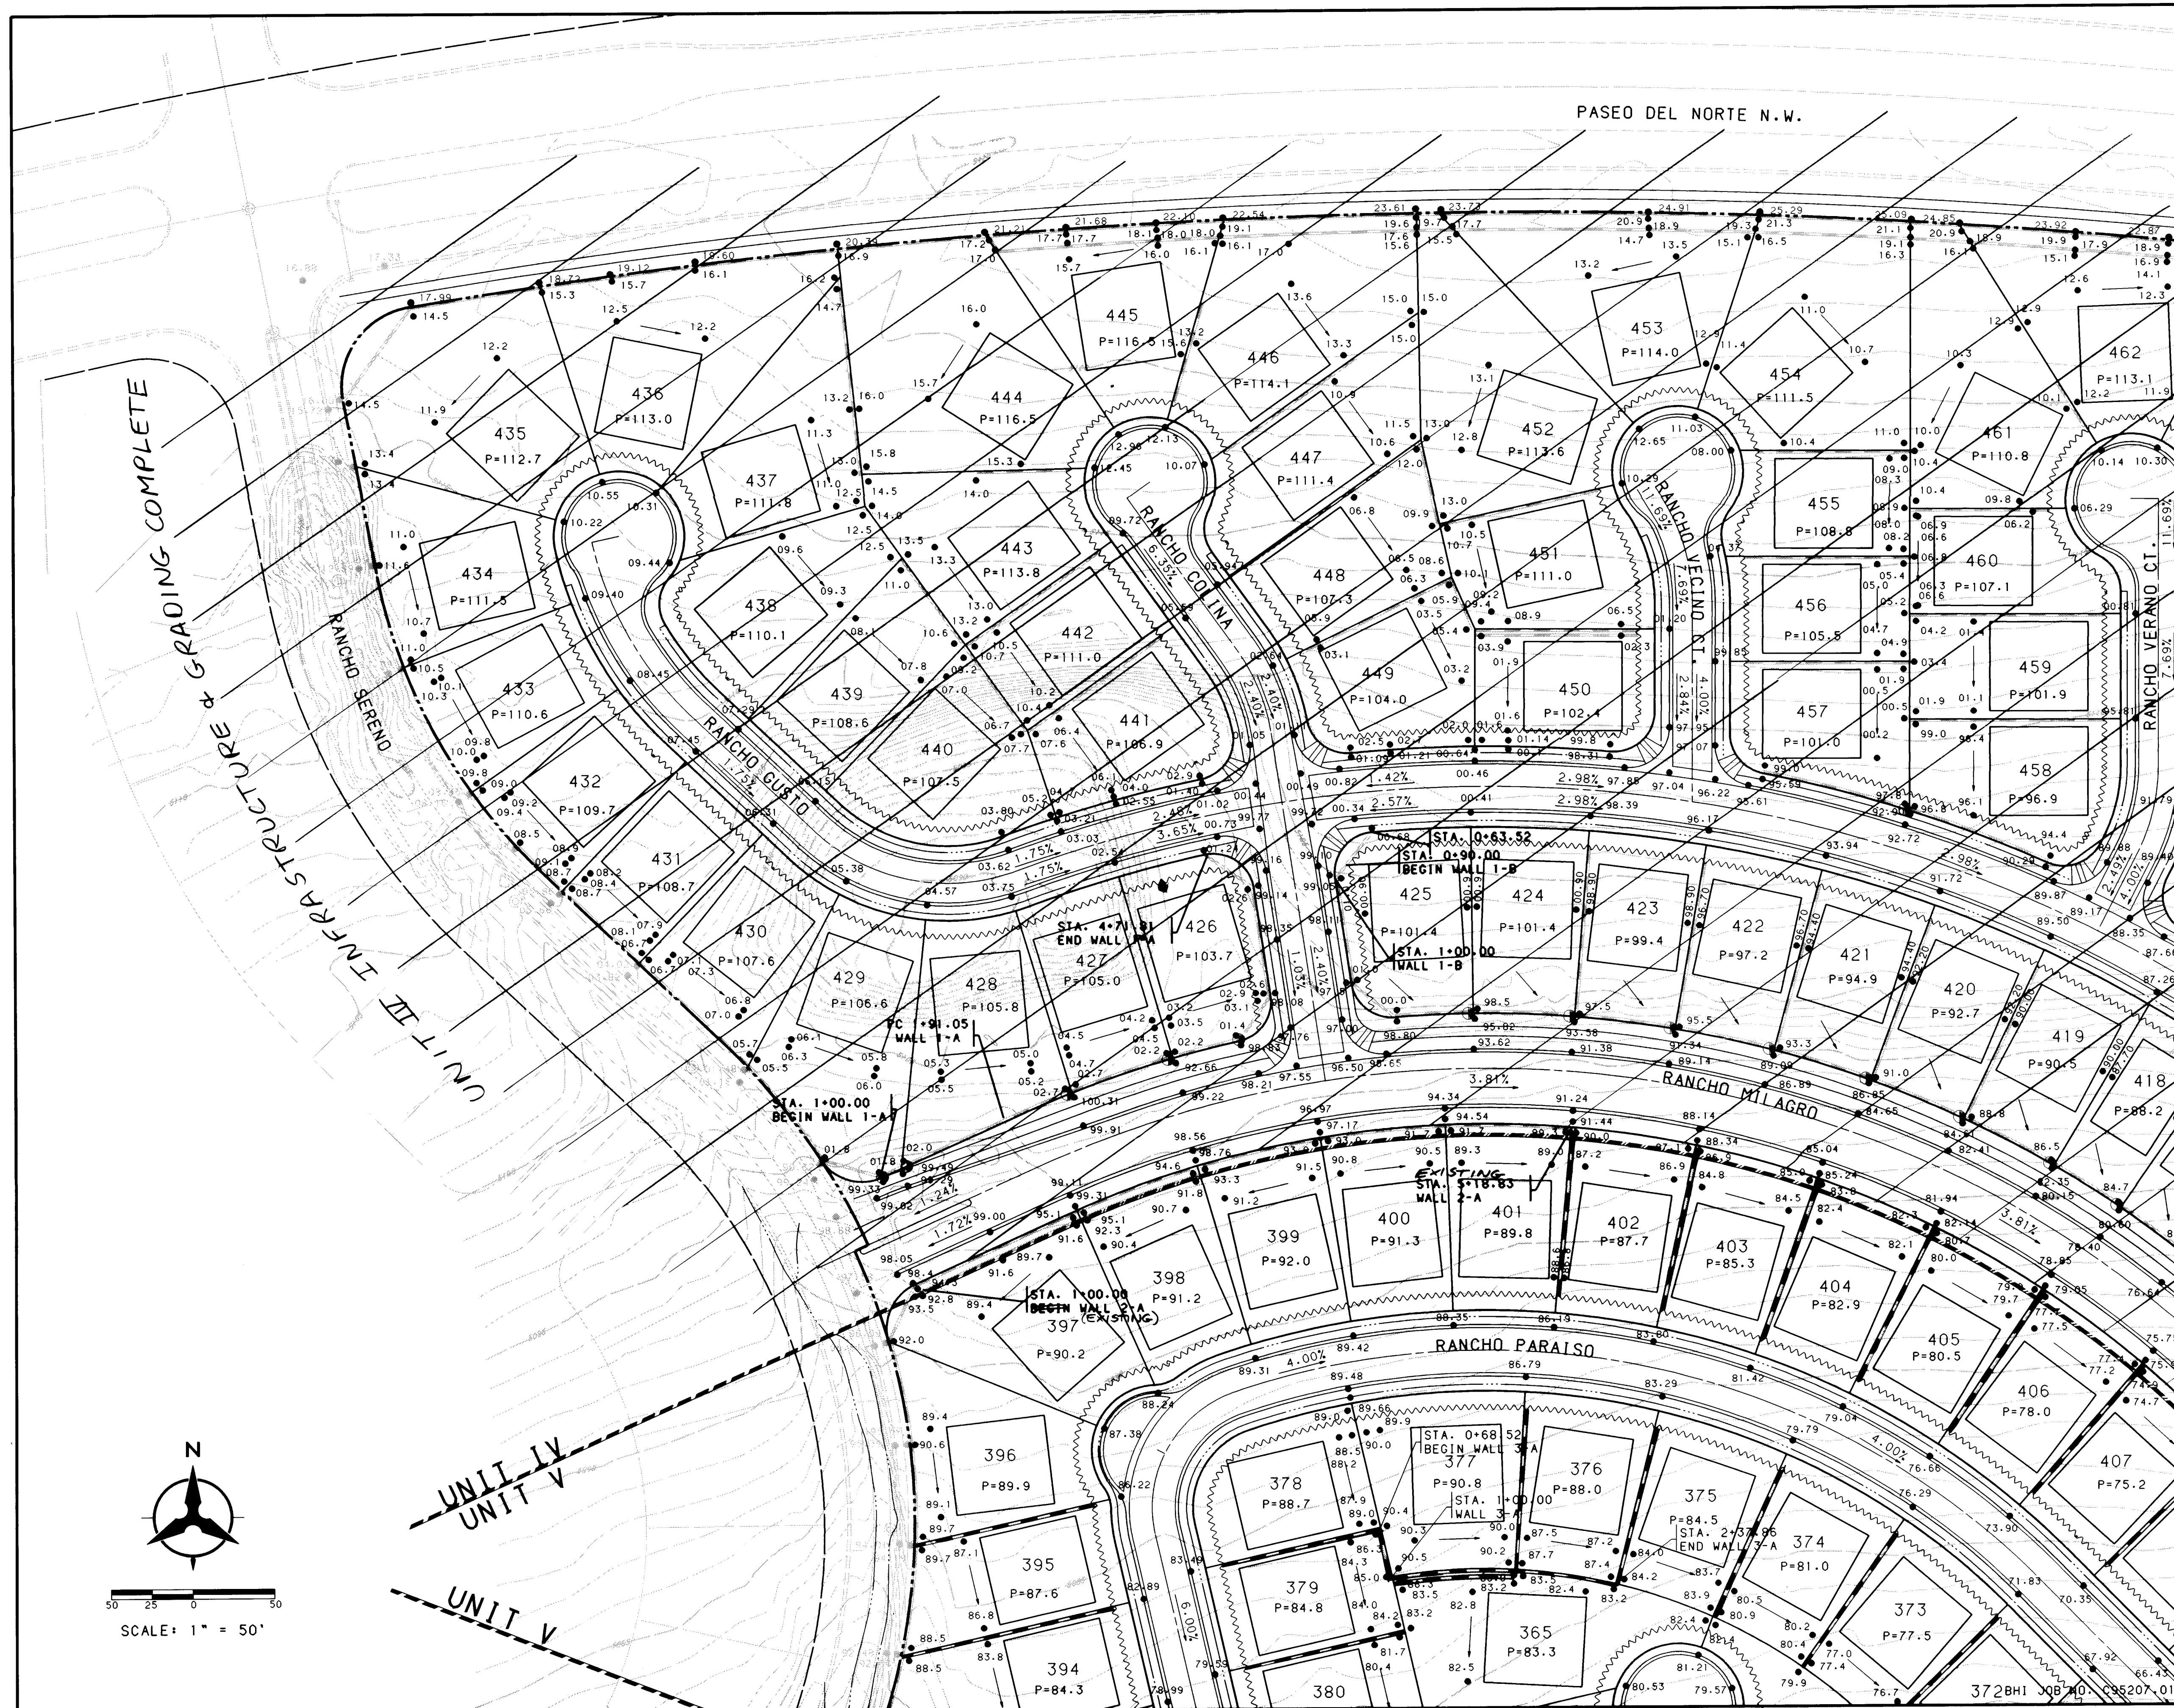

LEGEND

- PROJECT BOUNDARY
- EXISTING CONTOUR
- EXISTING SPOT ELEVATION
- PROPOSED SPOT ELEVATION
- DIRECTION OF FLOW
- PHASE BOUNDARY
- EROSION CONTROL BERM
- PROPOSED RETAINING WALL
- EXISTING STORM DRAIN LINE
- EXISTING STORM DRAIN MANHOLE
- EXISTING STORM DRAIN INLET
- PROPOSED STORM DRAIN LINE
- PROPOSED STORM DRAIN MANHOLE
- PROPOSED STORM DRAIN INLET
- TURNED BLOCK LOCATION

NOTE: SPOT ELEVATIONS SHOWN AT CURB DENOTE TOP OF CURB ELEVATIONS

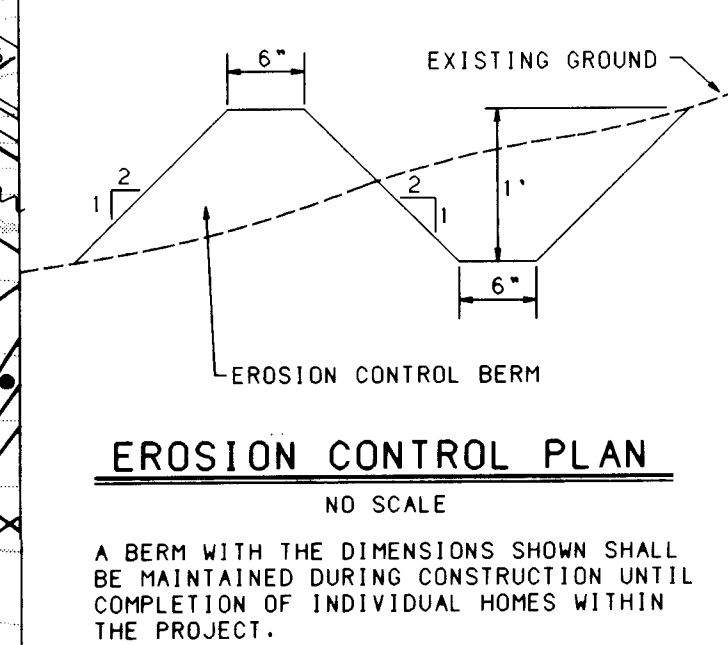

EROSION CONTROL PLAN
NO SCALE
A BERM WITH THE DIMENSIONS SHOWN SHALL BE MAINTAINED DURING CONSTRUCTION UNTIL COMPLETION OF INDIVIDUAL HOMES WITHIN THE PROJECT.

24-19567-77 03/97

CITY OF ALBUQUERQUE
PUBLIC WORKS DEPARTMENT
ENGINEERING GROUP

RANCHO SERENO SUBDIVISION - UNIT V
FINAL GRADING & DRAINAGE PLAN

APPROVALS	ENGINEER	DATE	APPROVALS	ENGINEER	DATE
DRG CHAIRMAN			WATER		
TRANSPORTATION			WASTE WATER		
HYDROLOGY			A.M.A.F.C.A.		

DRAWING NO. 456997 MAP NO. C-12 SHEET 5 OF 22


ENGINEER'S SEAL SURVEY INFORMATION		BENCH MARKS		AS-BUILT INFORMATION	
NO.	BY	DATE	NO.	DATE	NO.
MSJ	MSJ	10/95	MSJ	10/95	MSJ
REMARKS	REVISIONS	DESIGNED BY	DRAWN BY	CHECKED BY	DATE
	DESIGN	MSJ	SAR	KLD	10/95

James R. Topmiller
11/1/95

CONTRACTOR	DATE
James R. Topmiller	11/1/95

DATE	NO.
11/1/95	448

IN A FENCED-IN PRAIRIE. ELEV. = 5049.93

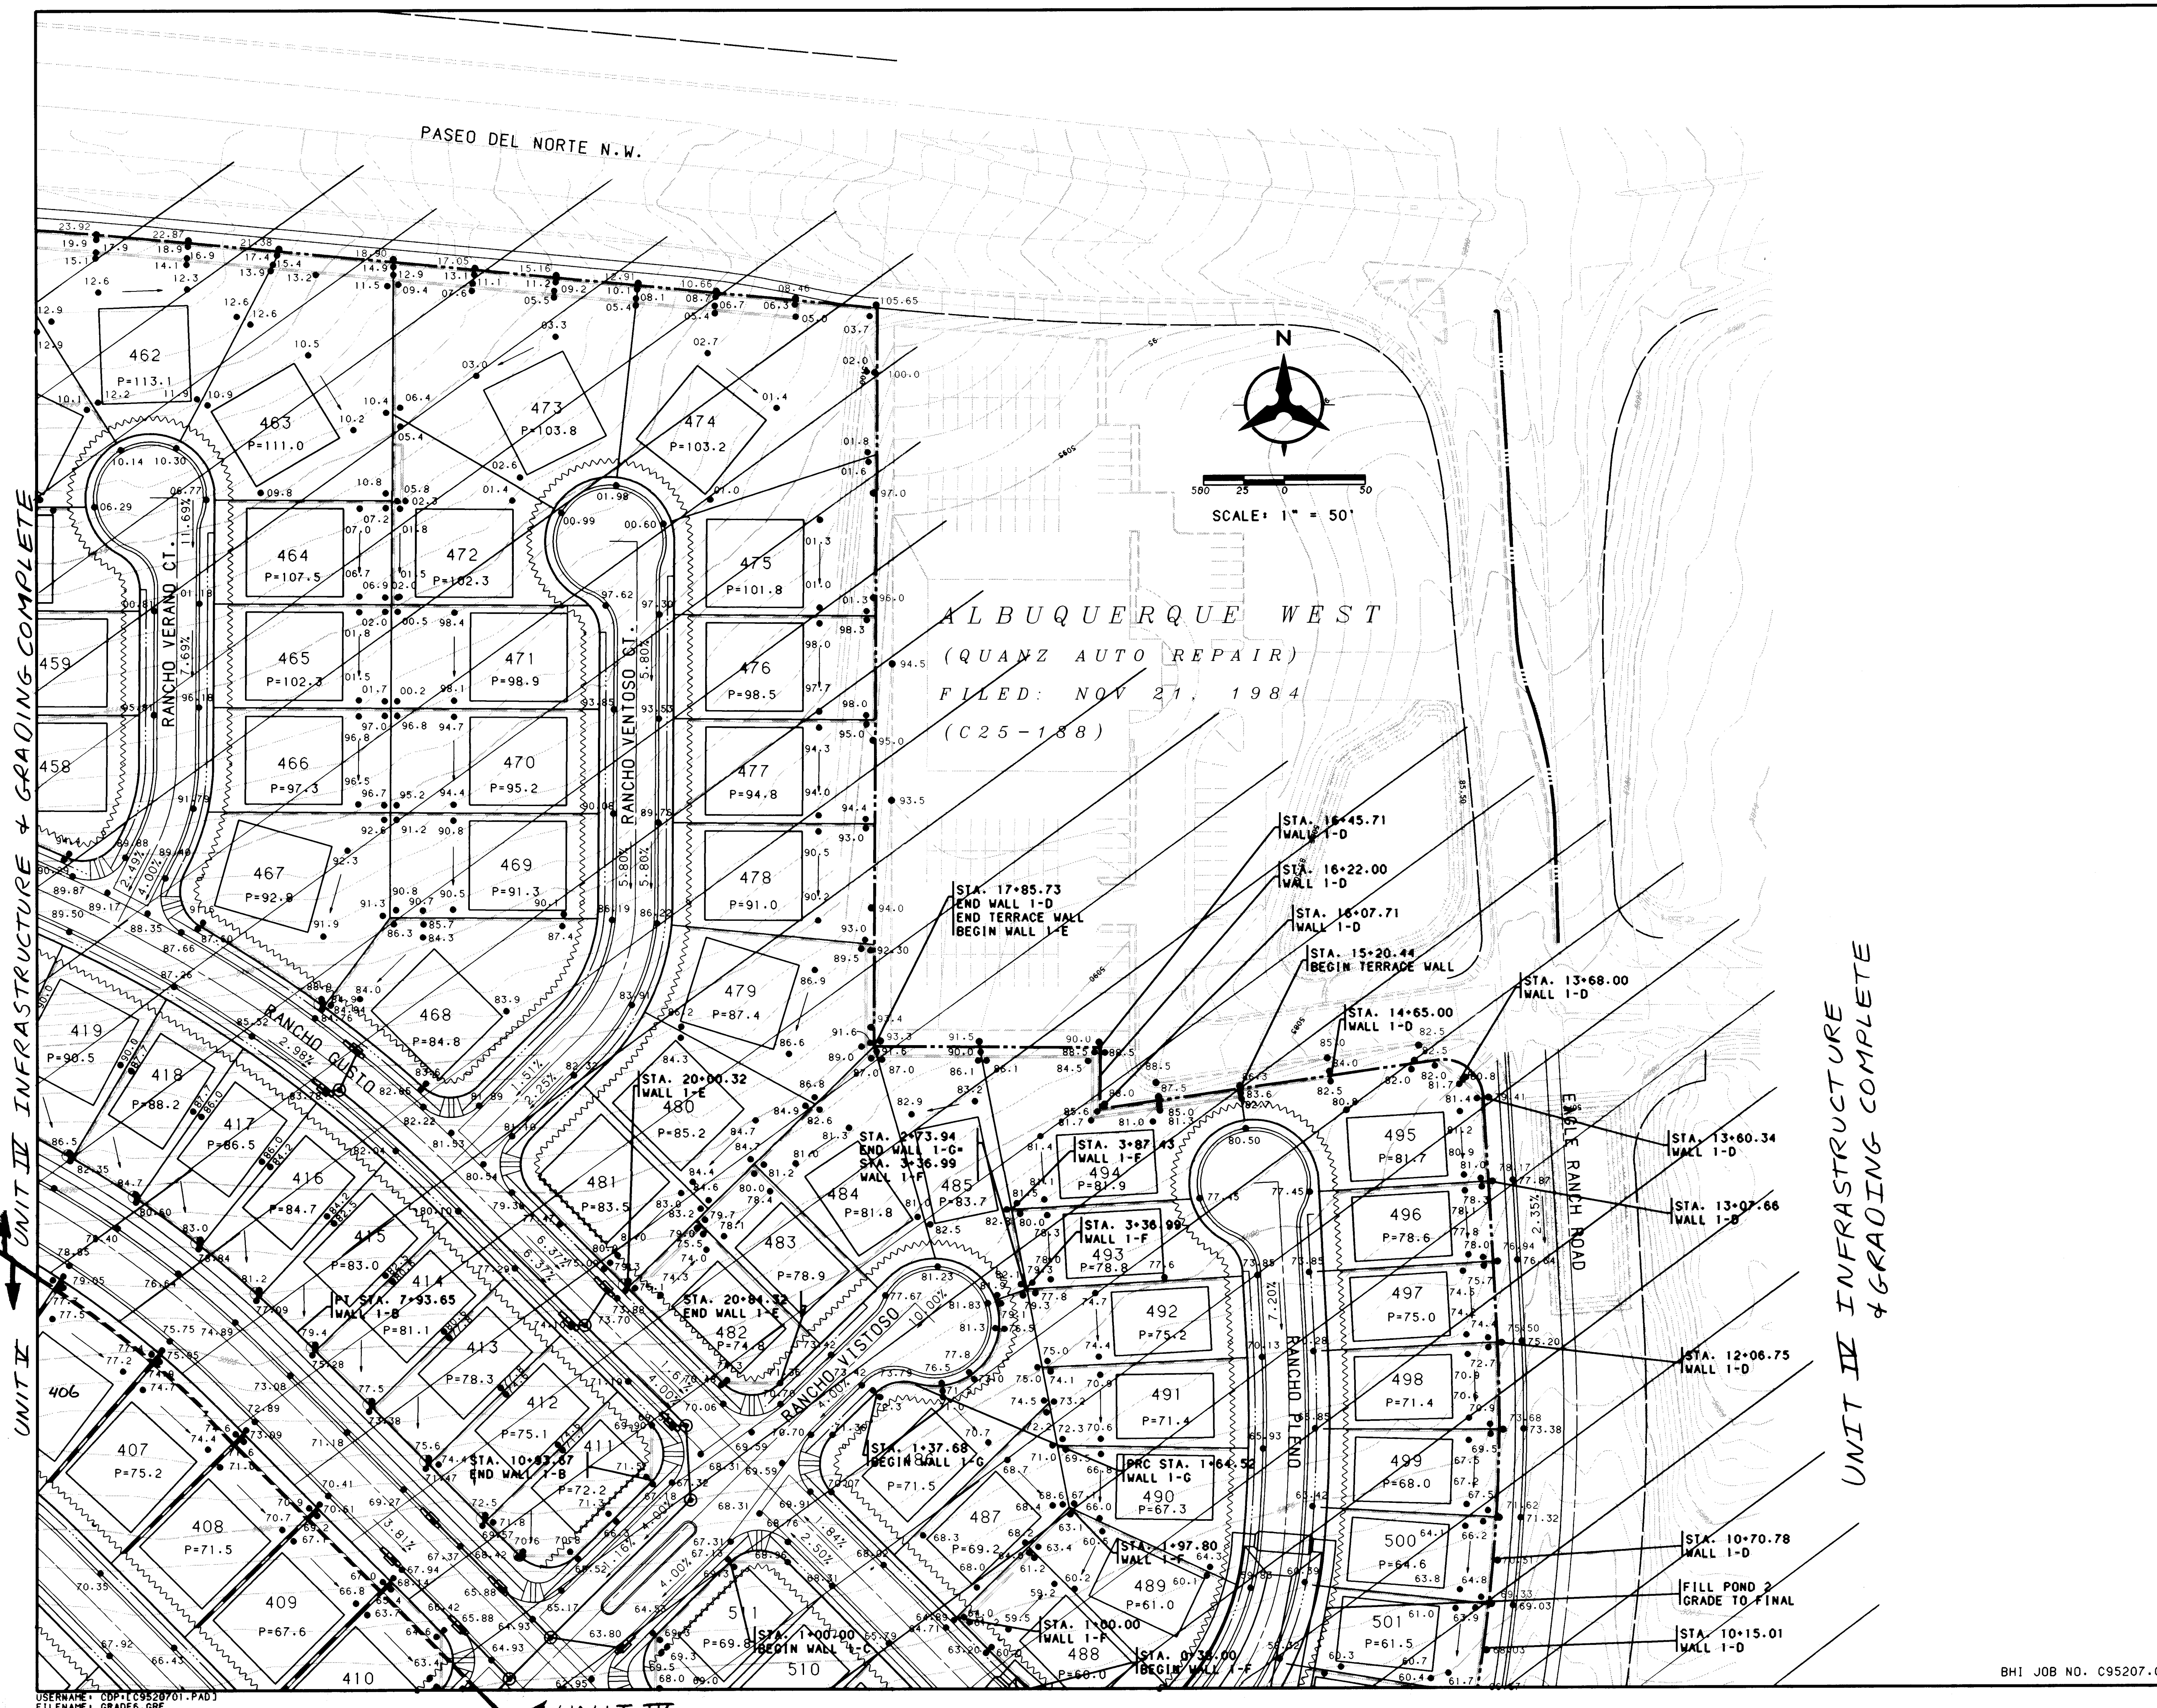

UNIT IV UNIT III INFRASTRUCTURE & GRADING COMPLETE

UNIT IV INFRASTRUCTURE & GRADING COMPLETE

FOR INFORMATION ONLY

LEGEND

PROJECT BOUNDARY	----
EXISTING CONTOUR	
EXISTING SPOT ELEVATION	45.5
PROPOSED SPOT ELEVATION	45.5
DIRECTION OF FLOW	S=2.98%
PHASE BOUNDARY	----
EROSION CONTROL BERM	~~~~~
PROPOSED RETAINING WALL	=====
EXISTING STORM DRAIN LINE	—SD—
EXISTING STORM DRAIN MANHOLE	—○—
EXISTING STORM DRAIN INLET	—□—
PROPOSED STORM DRAIN LINE	—SD—
PROPOSED STORM DRAIN MANHOLE	—○—
PROPOSED STORM DRAIN INLET	—□—
TURNED BLOCK LOCATION	●

NOTE: SPOT ELEVATIONS SHOWN AT CURB
DENOTE TOP OF CURB ELEVATIONS

AS-BUILT INFORMATION

CONTRACTOR	New Greens Inc.
INSPECTOR'S	DATE
STAMPED BY	DATE
STATION MARK IS A STANDARD USC&GS BRASS	DATE
TABLET, STAMPED "HUGHES, 1954", SET IN TOP	DATE
OF A CONCRETE POST PROJECTING 0.3 FT. ABOVE	DATE
THE GROUND. TO REACH THE STATION FROM THE	DATE
ORIENTED BY	DATE
INTERSECTION OF CENTRAL AVE. AND STATE RD.	DATE
448. GO NORTH ON STATE RD. 448. 6.1 MILES.	DATE
THE STATION IS 450' WEST OF STATE RD. 448	DATE
IN A FENCED-IN PRAIRIE.	DATE

EROSION CONTROL PLAN

NO SCALE

A BERM WITH THE DIMENSIONS SHOWN SHALL
BE MAINTAINED DURING CONSTRUCTION UNTIL
COMPLETION OF INDIVIDUAL HOMES WITHIN
THE PROJECT.

ENGINEER'S SEAL

James R. Topmiller
11/1/14

NO.	DATE	BY	REMARKS	DESIGN
12/2/96	REMOVAL OF UNIT IV INFORMATION	MSJ		
1/29/95	DARKENED PROPOSED RETAINING WALLS	MSJ		
NO. DATE				
DESIGNED BY	MSJ	DATE	10/95	
DRAWN BY	SAR	DATE	10/95	
CHECKED BY	KLD	DATE	10/95	

CITY OF ALBUQUERQUE
PUBLIC WORKS DEPARTMENT
ENGINEERING GROUP

RANCHO SERENO SUBDIVISION - UNIT V

FINAL GRADING & DRAINAGE PLAN

APPROVALS	ENGINEER	DATE
DRG CHAIRMAN		
TRANSPORTATION		
HYDROLOGY		












APPROVALS	ENGINEER	DATE
WATER		
WASTE WATER		
A.M.A.F. PLAN		

DRAWING NO. **456997**

MAP NO. **C-12**

SHEET **6** OF **22**

Copyright Bohannon-Huston, Inc. 1995

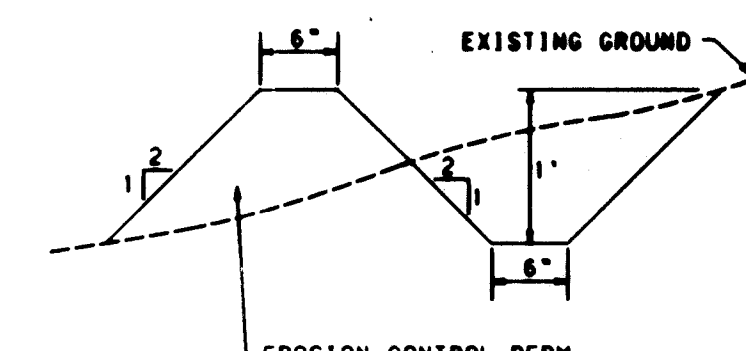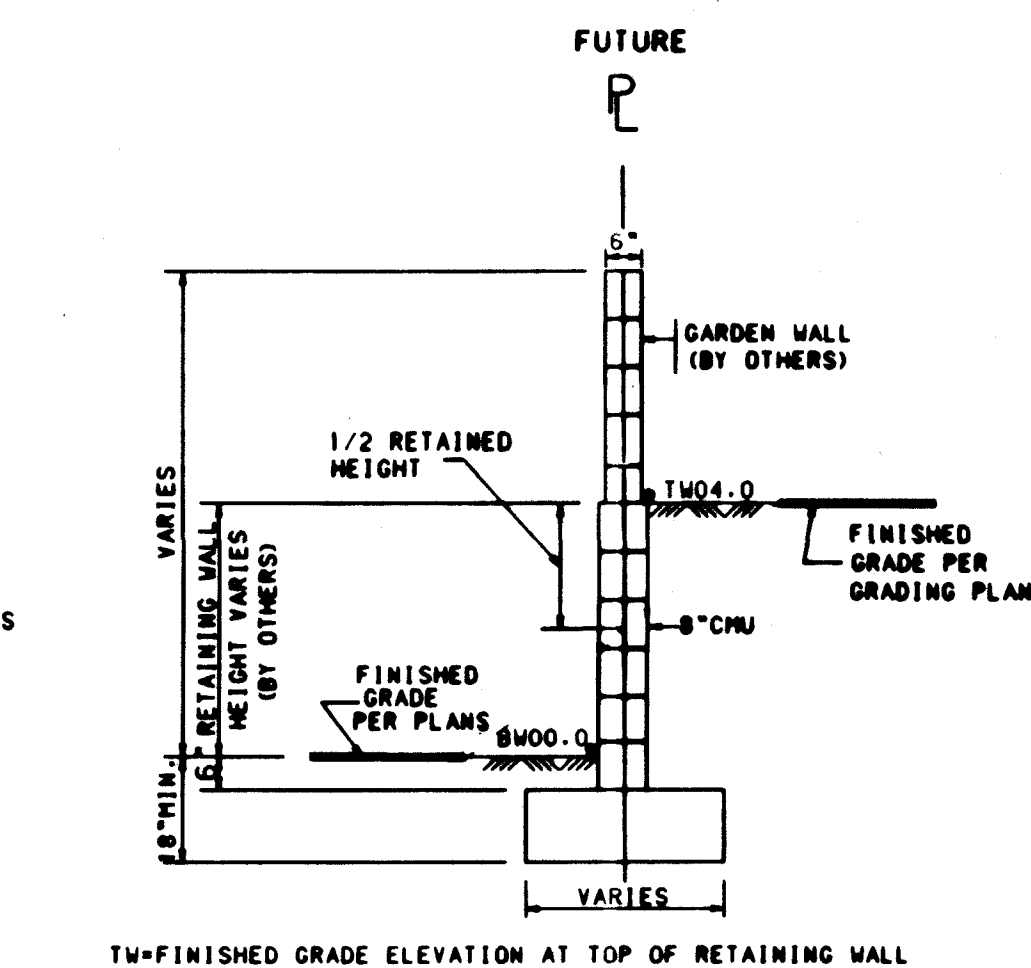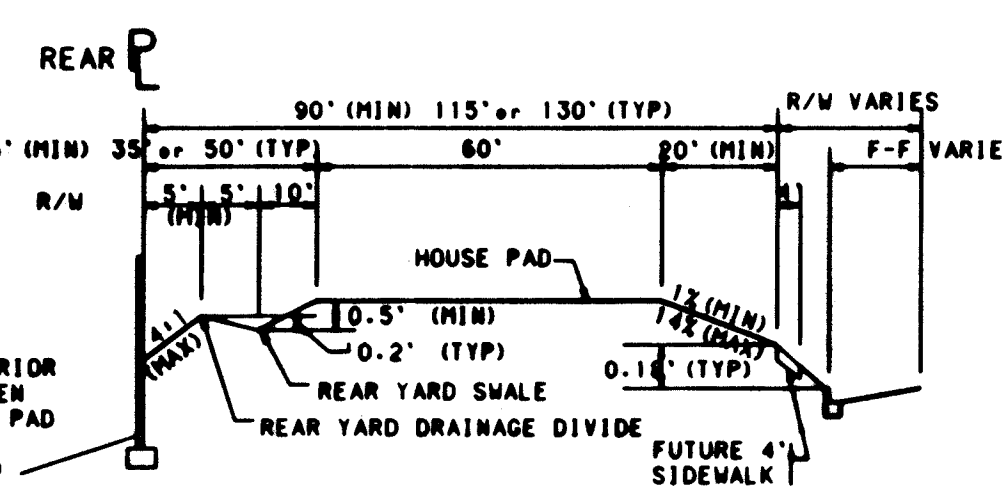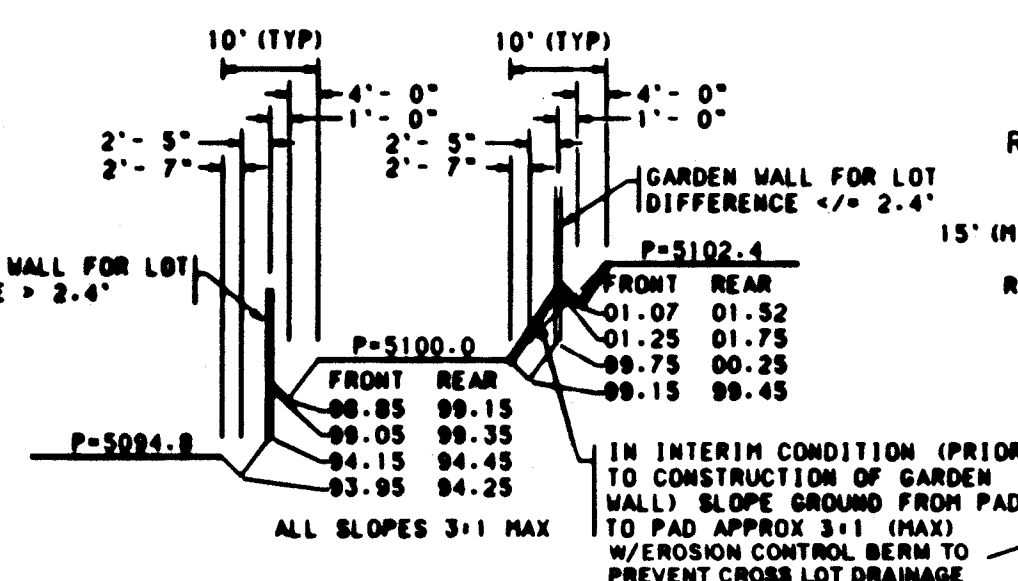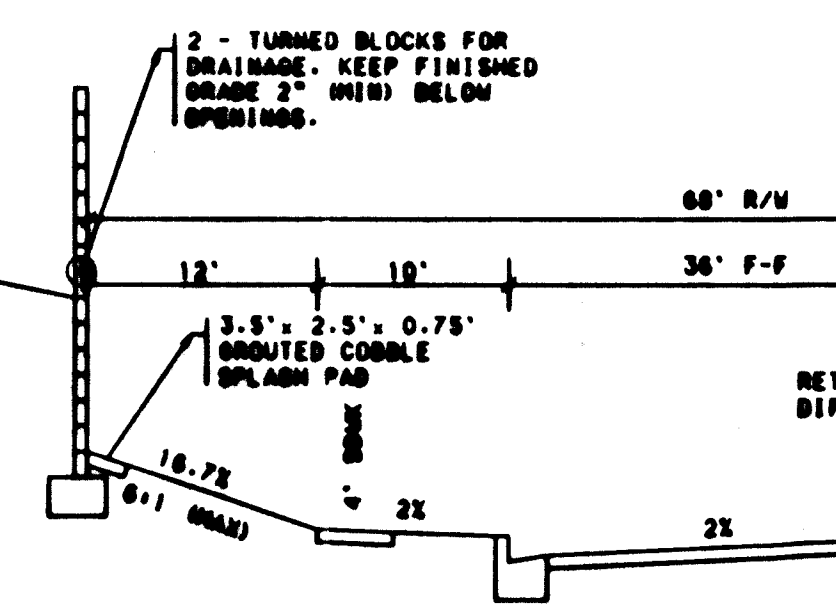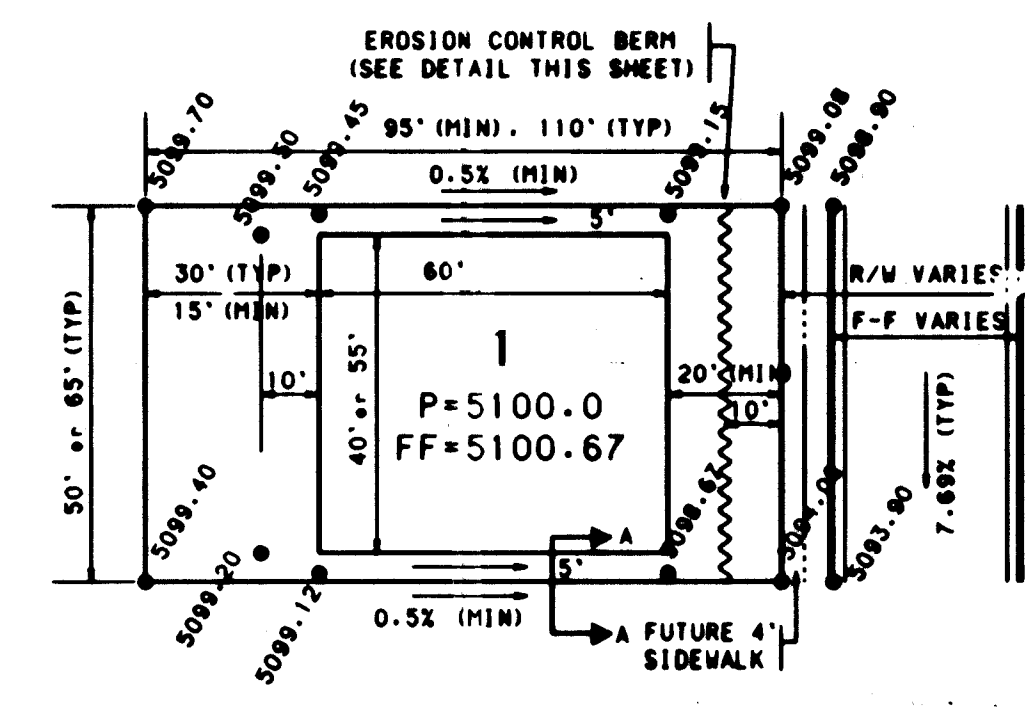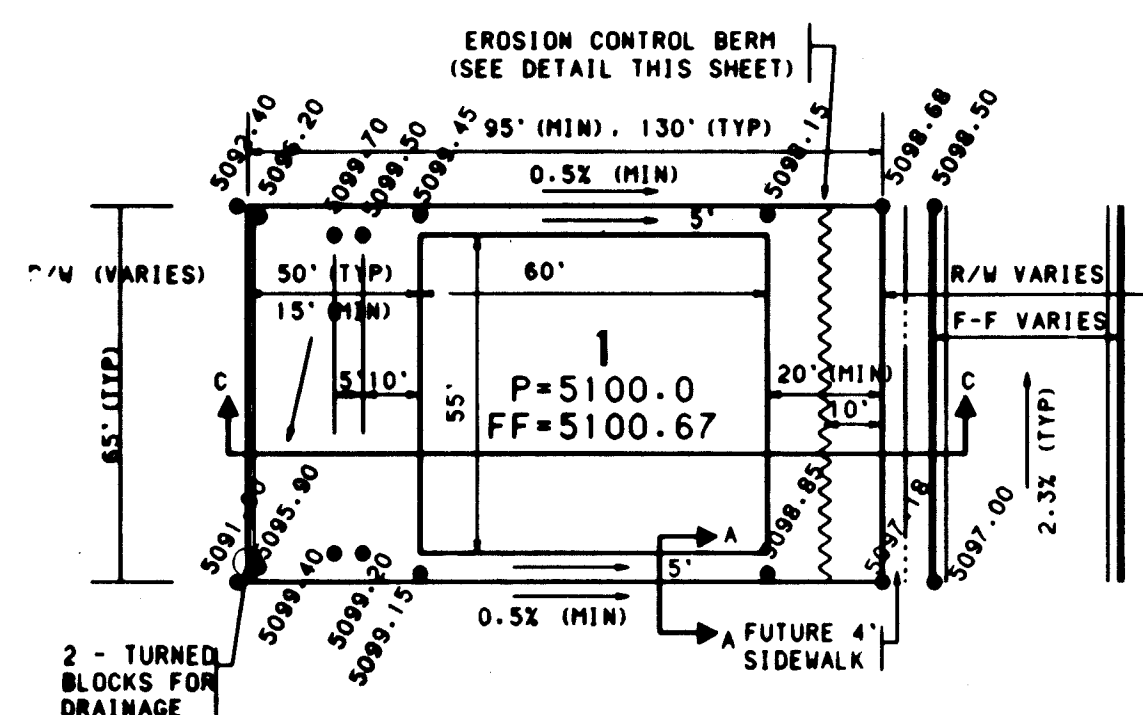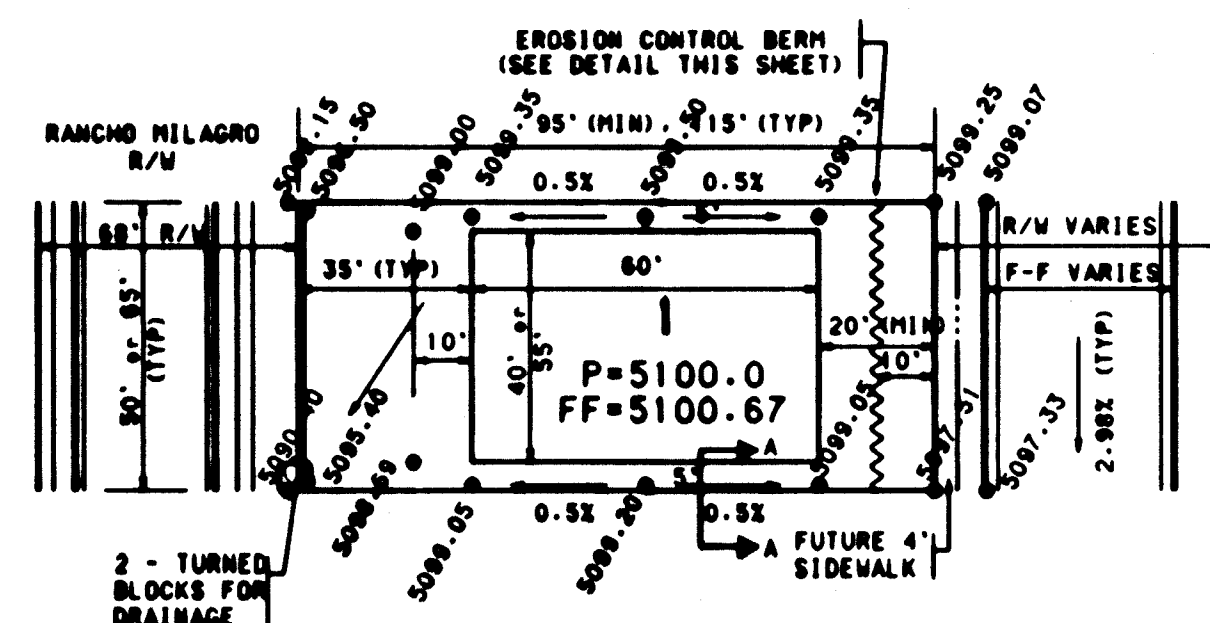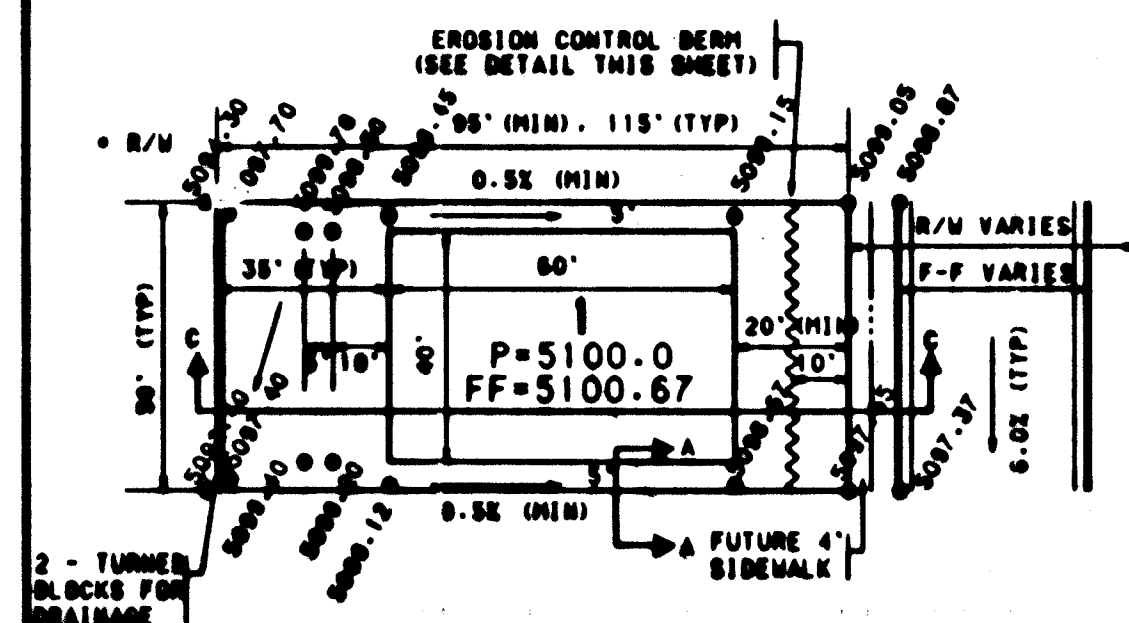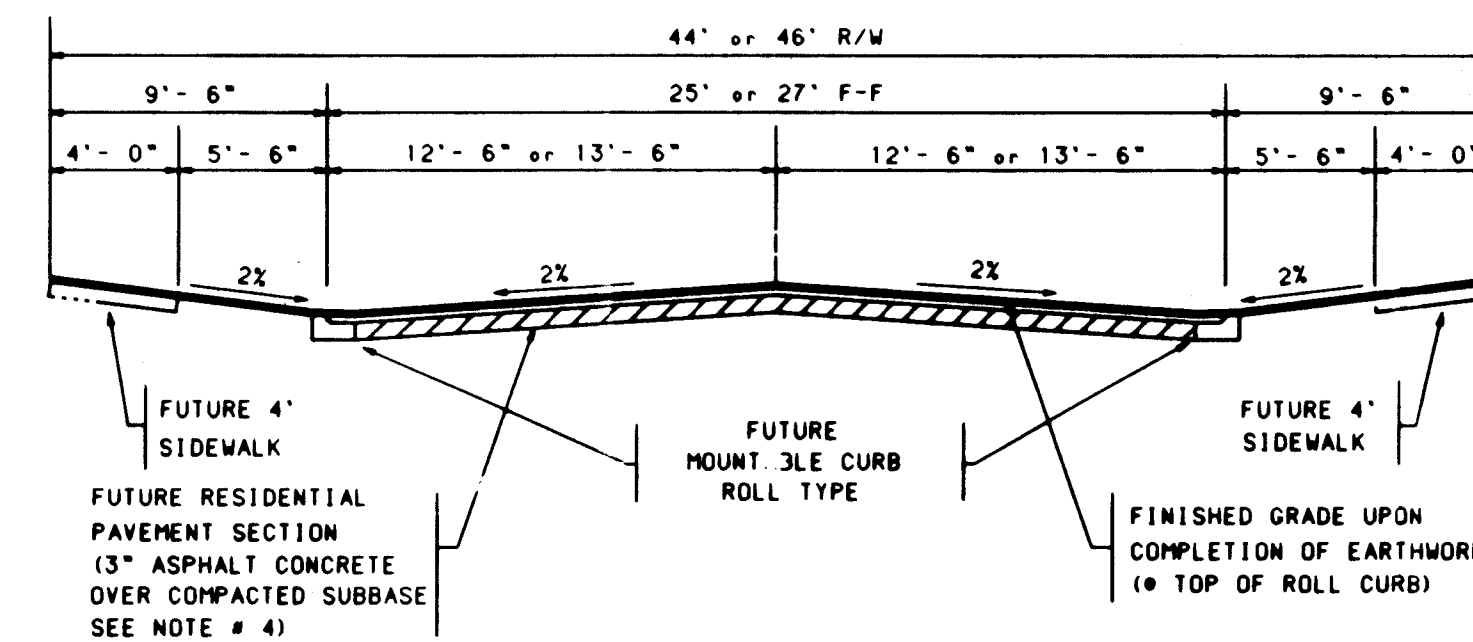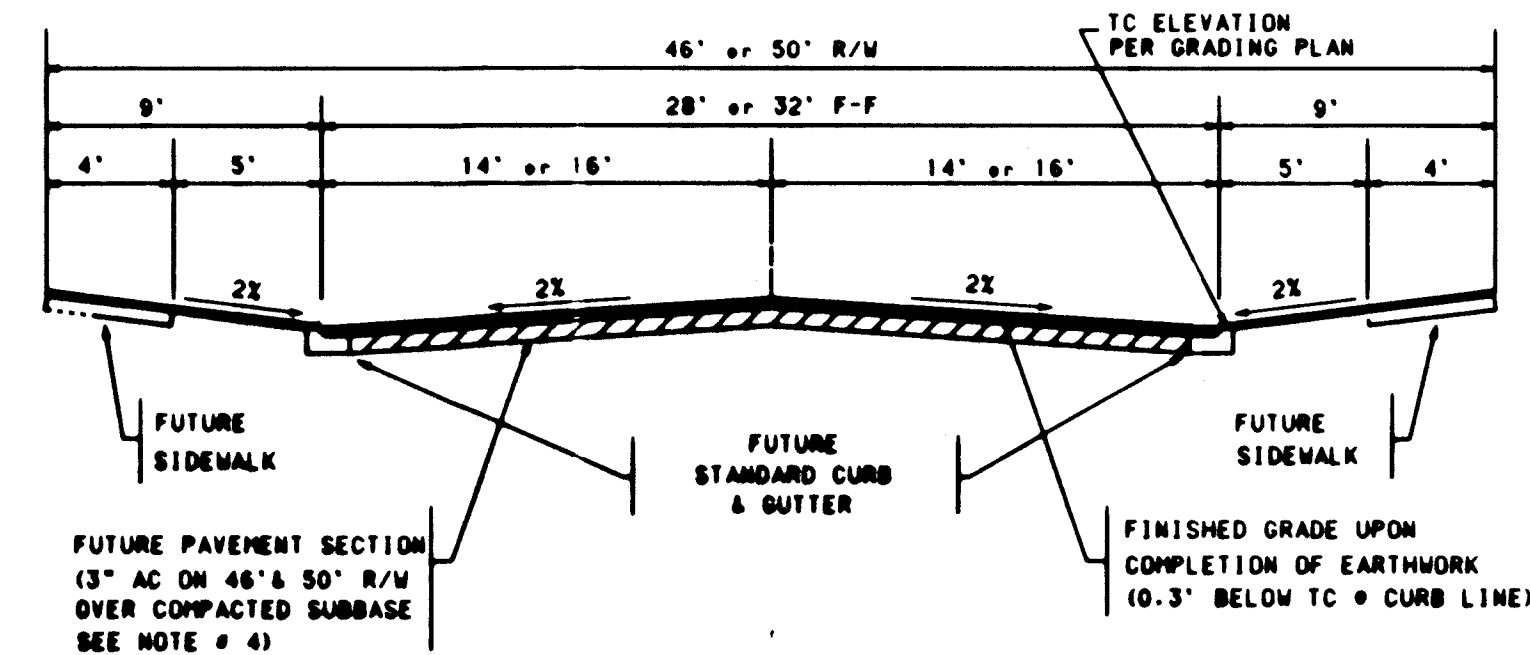


GENERAL GRADING NOTES:


1. THE CONTRACTOR MUST OBTAIN A TOPSOIL DISTURBANCE PERMIT FROM THE CITY OF ALBUQUERQUE, ENVIRONMENTAL HEALTH DIV., PRIOR TO CONSTRUCTION.
2. THE CONTRACTOR IS TO REFER TO THE EARTHWORK SPECIFICATIONS NOTED IN THE GEOTECHNICAL INVESTIGATION REPORT DATED JUNE 16, 1993 AND ASSOCIATES, DATED JUNE 16, 1993 AND SUPPLIED BY THE OWNER.
3. THE CONTRACTOR SHALL CONFORM TO ALL CITY, COUNTY, STATE AND FEDERAL DUST CONTROL MEASURES AND REQUIREMENTS AND WILL BE RESPONSIBLE FOR PREPARING AND OBTAINING ALL NECESSARY APPLICATIONS, PERMITS AND APPROVALS.
4. FINISHED GRADE IN ROADWAY SECTIONS IS BASED UPON MATERIAL IMPORTED DURING EARTHWORK BEING ACCEPTABLE FOR ROADWAY SUBBASE.

EROSION CONTROL PLAN:

THE CONTRACTOR SHALL ENSURE THAT NO SOIL ERODES FROM THE LOTS INTO PUBLIC RIGHT-OF-WAY. THIS CAN BE ACHIEVED BY CONSTRUCTING TEMPORARY EROSION CONTROL BERMS AS PER DETAIL THIS SHEET AND WETTING THE SOIL REGULARLY TO KEEP IT FROM BLOWING. ALL EXCESS DISTURBED AREAS MUST BE SEEDDED PER C.O.A. SPECIFICATION SECTION 1012.

ENGINEER'S SEAL		SURVEY INFORMATION		BENCH MARKS		AS-BUILT INFORMATION	
		FIELD NOTES					
		NO.	BY	DATE	STATION MARK IS A STANDARD USGCS BRASS TABLET, STAMPED "MCHES, 1954". SET IN TOP OF A CONCRETE POST PROJECTING 0.3 FT. ABOVE THE GROUND. TO REACH THE STATION FROM THE INTERSECTION OF CENTRAL AVE. AND STATE RD. 448. GO NORTH ON STATE RD. 448. 6.1 MILES. THE STATION IS 450' WEST OF STATE RD. 448 IN A FENCED-IN PRAIRIE.		
REVISIONS		DESIGN					
DESIGNED BY	MSJ	DATE	10/95				
DRAWN BY	MSJ	DATE	10/95				
CHECKED BY	KLD	DATE	10/95				
							
							
							
							
							
							
							
							
							
							
							
							
							
							
							
							
							
							
							
							
							
							
							
							
							
							
							
							
							
							

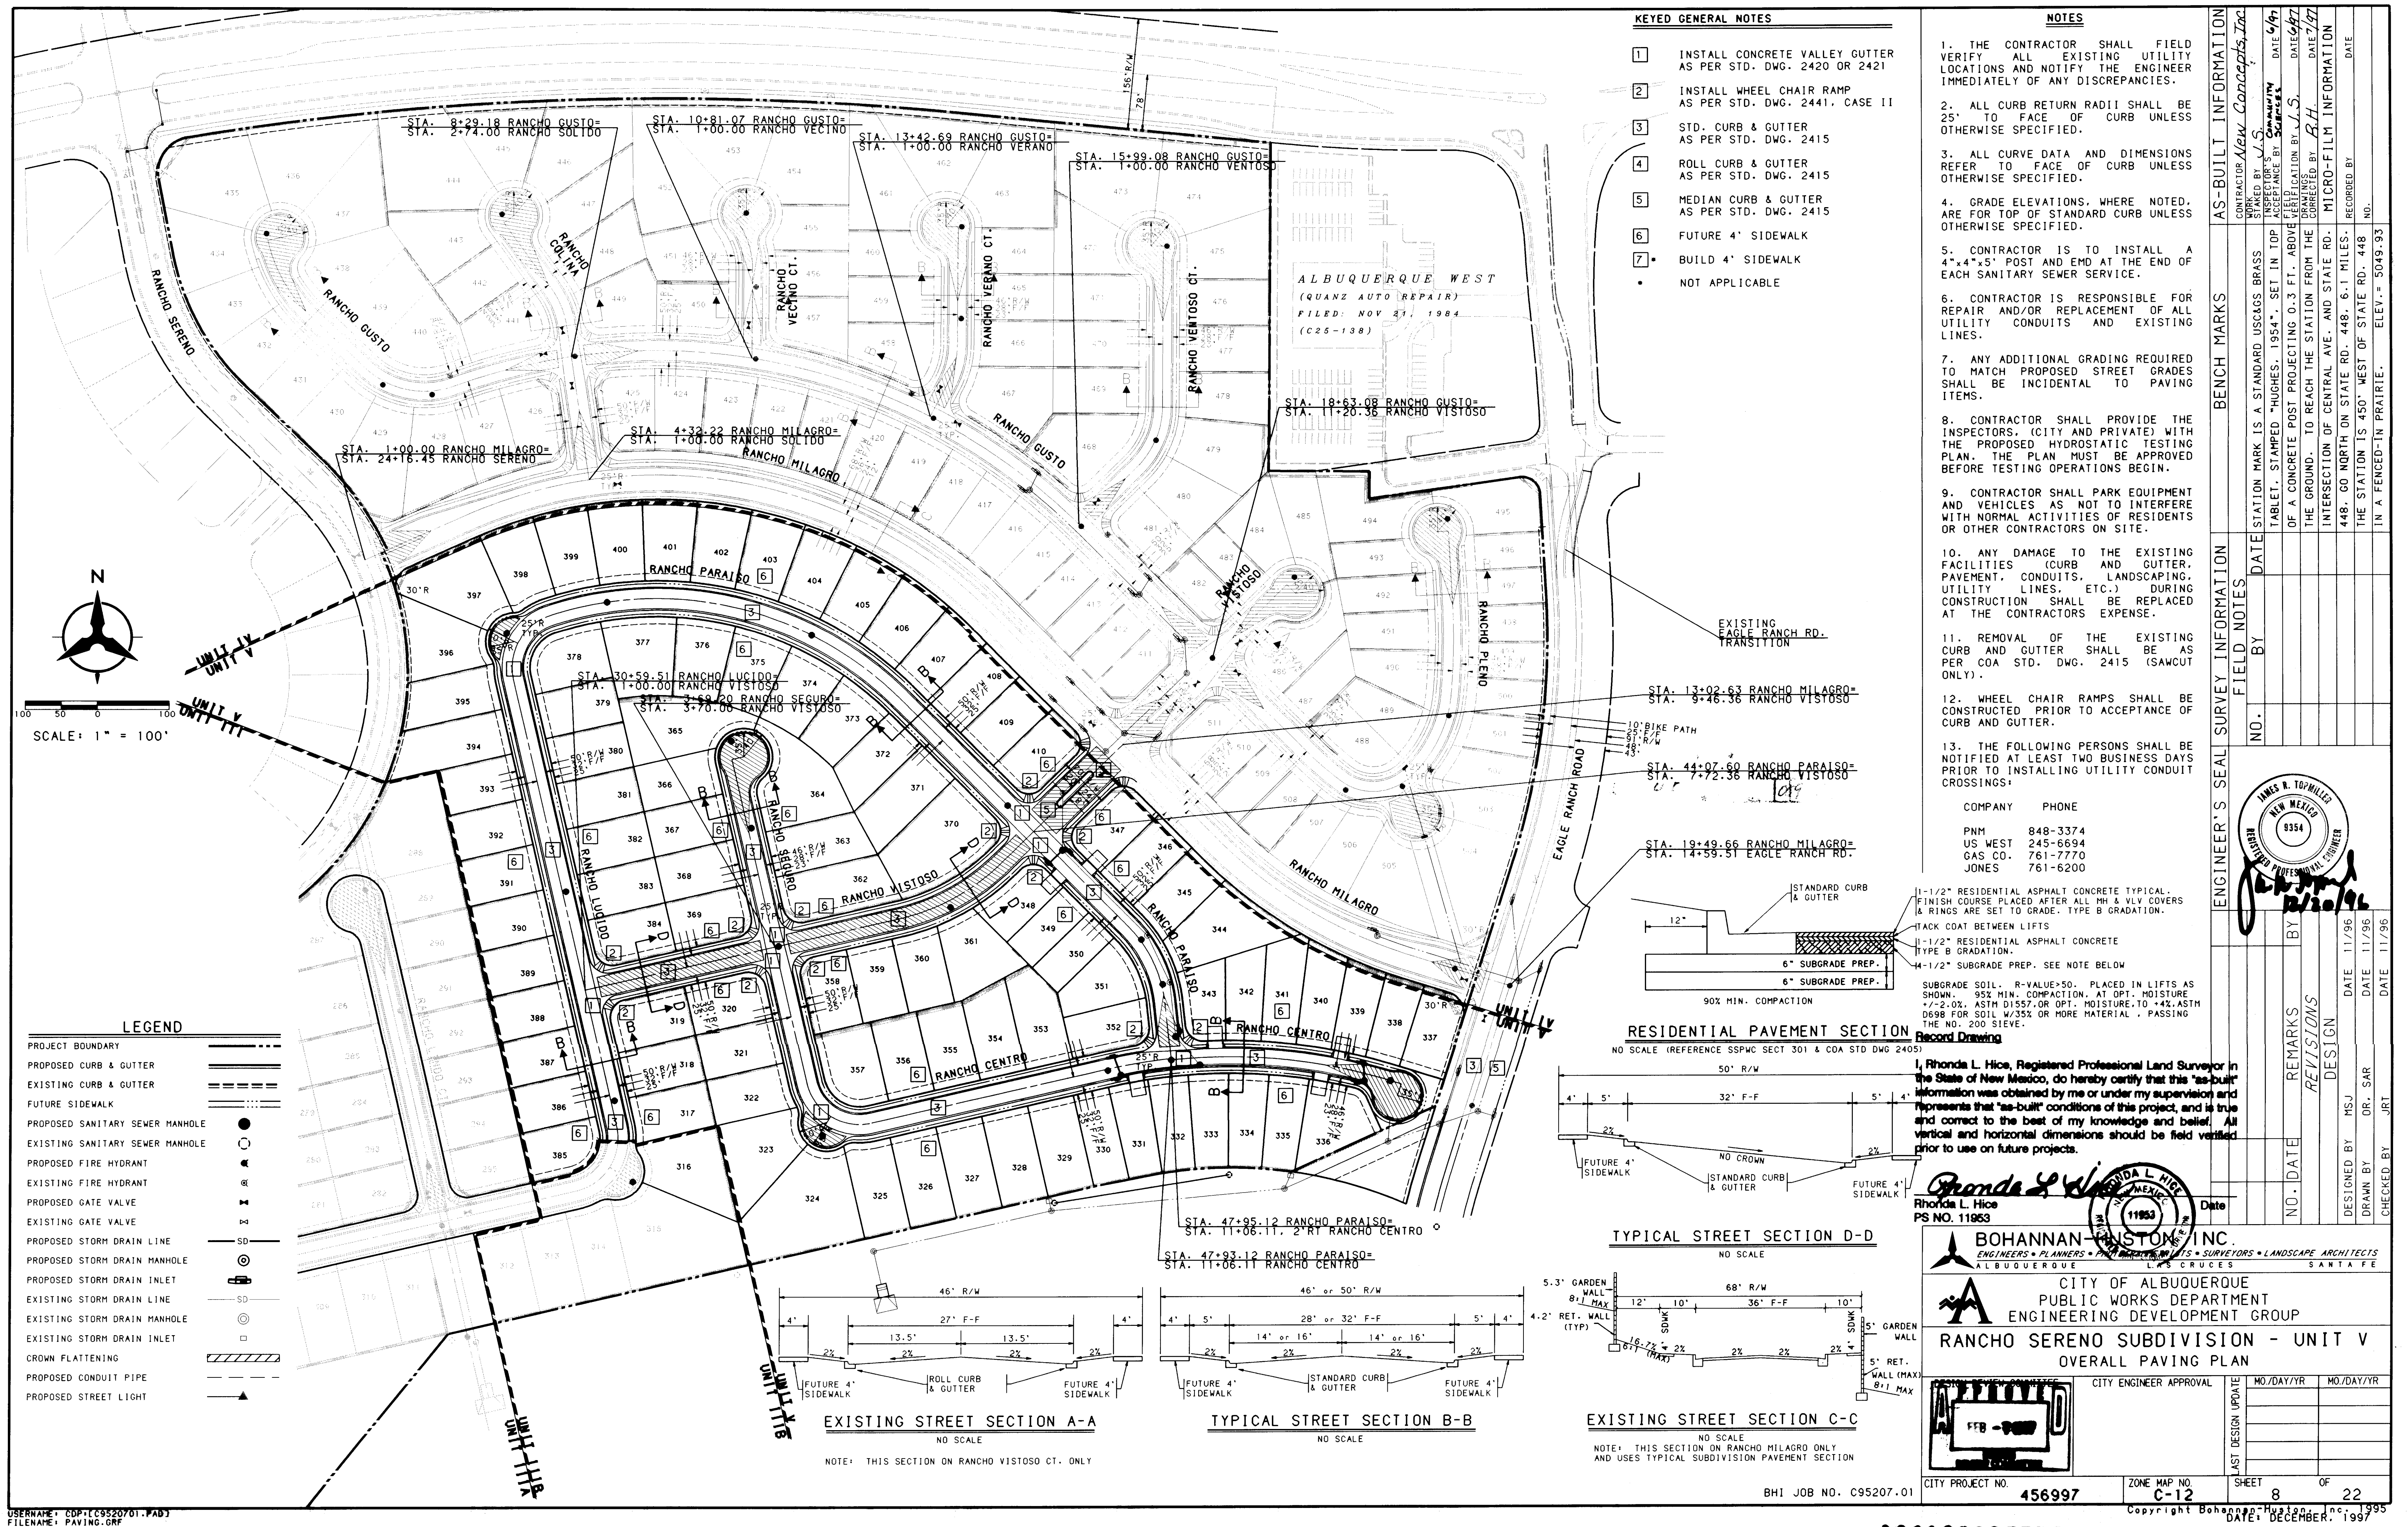

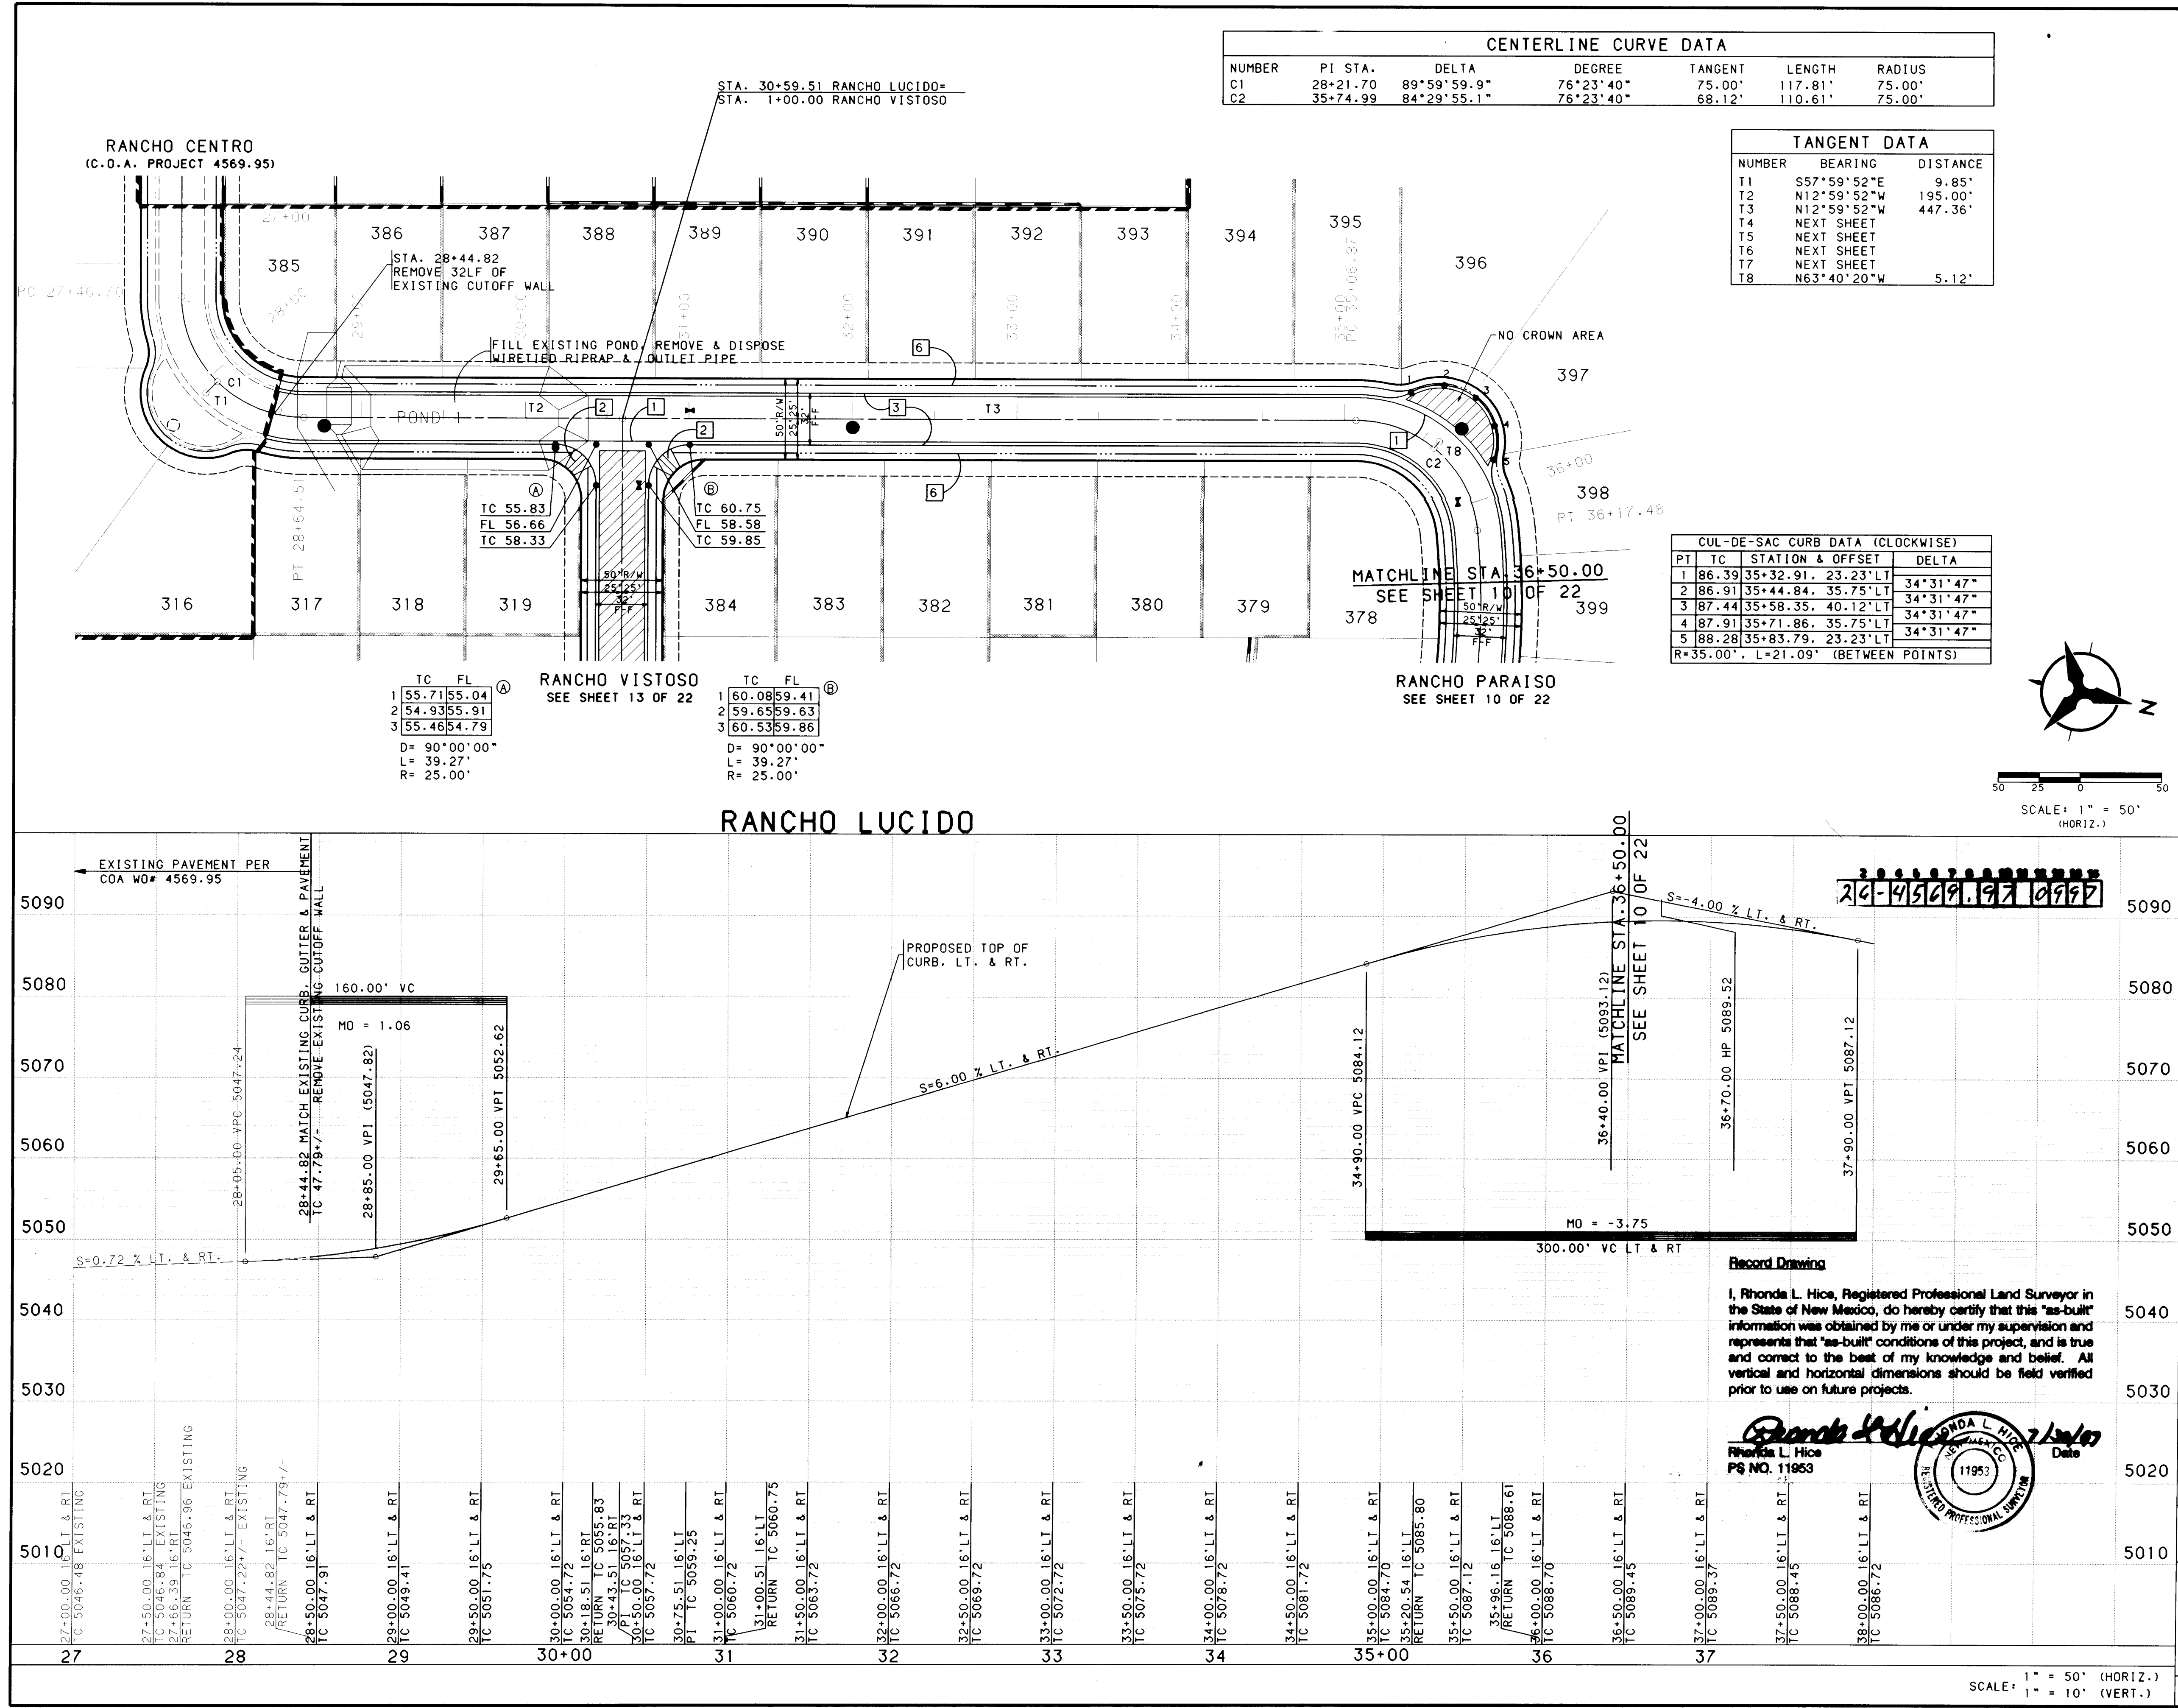

NOTES

- THE CONTRACTOR SHALL FIELD VERIFY ALL EXISTING UTILITY LOCATIONS AND NOTIFY THE ENGINEER IMMEDIATELY OF ANY DISCREPANCIES.
- ALL CURB RETURN RADII SHALL BE 25' TO FACE OF CURB UNLESS OTHERWISE SPECIFIED.
- ALL CURVE DATA AND DIMENSIONS REFER TO FACE OF CURB UNLESS OTHERWISE SPECIFIED.
- GRADE ELEVATIONS, WHERE NOTED, ARE FOR TOP OF STANDARD CURB UNLESS OTHERWISE SPECIFIED.
- CONTRACTOR IS TO INSTALL A 4"x4"x5' POST AND END AT THE END OF EACH SANITARY SEWER SERVICE.
- CONTRACTOR IS RESPONSIBLE FOR REPAIR AND/OR REPLACEMENT OF ALL UTILITY CONDUITS AND EXISTING LINES.
- ANY ADDITIONAL GRADING REQUIRED TO MATCH PROPOSED STREET GRADES SHALL BE INCIDENTAL TO PAVING ITEMS.
- CONTRACTOR SHALL PROVIDE THE INSPECTORS (CITY AND PRIVATE) WITH THE PROPOSED HYDROSTATIC TESTING PLAN. THE PLAN MUST BE APPROVED BEFORE TESTING OPERATIONS BEGIN.
- CONTRACTOR SHALL PARK EQUIPMENT AND VEHICLES AS NOT TO INTERFERE WITH NORMAL ACTIVITIES OF RESIDENTS OR OTHER CONTRACTORS ON SITE.
- ANY DAMAGE TO THE EXISTING FACILITIES (CURB AND GUTTER, PAVEMENT, CONDUITS, LANDSCAPING, UTILITY LINES, ETC.) DURING CONSTRUCTION SHALL BE REPLACED AT THE CONTRACTORS EXPENSE.
- REMOVAL OF THE EXISTING CURB AND GUTTER SHALL BE AS PER COA STD. DWG. 2415 (SAWCUT ONLY).
- WHEEL CHAIR RAMPS SHALL BE CONSTRUCTED PRIOR TO ACCEPTANCE OF CURB AND GUTTER.
- THE FOLLOWING PERSONS SHALL BE NOTIFIED AT LEAST TWO BUSINESS DAYS PRIOR TO INSTALLING UTILITY CONDUIT CROSSINGS:

COMPANY	PHONE
PNM	848-3374
US WEST	245-6694
GAS CO.	761-7770
JONES	761-6200

KEYED GENERAL NOTES

- INSTALL CONCRETE VALLEY GUTTER AS PER STD. DWG. 2420 OR 2421
- INSTALL WHEEL CHAIR RAMP AS PER STD. DWG. 2441, CASE 11
- STD. CURB & GUTTER AS PER STD. DWG. 2415
- ROLL CURB & GUTTER AS PER STD. DWG. 2415
- MEDIAN CURB & GUTTER AS PER STD. DWG. 2415
- FUTURE 4' SIDEWALK
- BUILD 4' SIDEWALK

• NOT APPLICABLE THIS SHEET

BOHANNAN-HUSTON INC.
ENGINEERS • PLANNERS • PHOTOGRAMMETRISTS • SURVEYORS • LANDSCAPE ARCHITECTS
ALBUQUERQUE LAS CRUCES SANTA FE

CITY OF ALBUQUERQUE
PUBLIC WORKS DEPARTMENT
ENGINEERING DEVELOPMENT GROUP

RANCHO SERENO SUBDIVISION - UNIT V
PAVING PLAN & PROFILE
RANCHO LUCIDO STA. 27+00.00 - 36+50.00

APPROVE
DESIGN REVIEW COMMITTEE

REVISIONS

NO.	DATE	REMARKS
1	11/96	DESIGN

DESIGNED BY: MSJ DATE: 11/96
DRAWN BY: BS, OR, SAR DATE: 11/96
CHECKED BY: JRT DATE: 11/96

CITY PROJECT NO. **456997** ZONE MAP NO. **C-12** SHEET **9** OF **22**

DATE: DECEMBER, 1996

CENTERLINE CURVE DATA						
NUMBER	PI STA.	DELTA	DEGREE	TANGENT	LENGTH	RADIUS
C3	39+14.06	63°51' 4.0"	12° 2' 13"	296.58'	530.46'	476.00'
C4	46+56.72	38°27' 24.0"	31°49' 52"	62.78'	120.82'	180.00'

STA. 44+07.60 RANCHO PARAISO=
STA. 7+72.36 RANCHO VISTOSO

STA. 47+95.12 RANCHO PARAISO=
STA. 11+06.11, 2" RT. RANCHO CENTRO
STA. 47+93.12 RANCHO PARAISO=
STA. 11+06.11 RANCHO CENTRO

RANCHO VISTOSO
SEE SHEET 14 OF 22

RANCHO CENTRO
SEE SHEET 12 OF 22


TANGENT DATA		
NUMBER	BEARING	DISTANCE
T4	S44°38'53"E	259.67'
T5	S44°38'53"E	186.32'
T6	S06°11'29"E	78.37'
T7	S06°11'29"E	2.00'

TC	FL
1 60.55	59.89
2 59.90	59.88
3 60.53	59.86
D= 90°00'00"	
L= 39.27'	
R= 25.00'	


TC	FL
1 57.12	56.45
2 56.96	56.94
3 58.10	57.43
D= 90°00'00"	
L= 39.27'	
R= 25.00'	

TC	FL
1 59.95	59.28
2 59.11	59.09
3 59.57	58.90
D= 90°00'00"	
L= 39.27'	
R= 25.00'	

TC	FL
1 57.92	57.25
2 56.97	56.95
3 57.32	56.65
D= 90°00'00"	
L= 39.27'	
R= 25.00'	

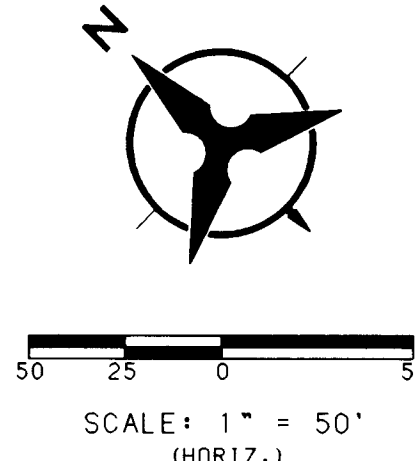


RANCHO PARAISO

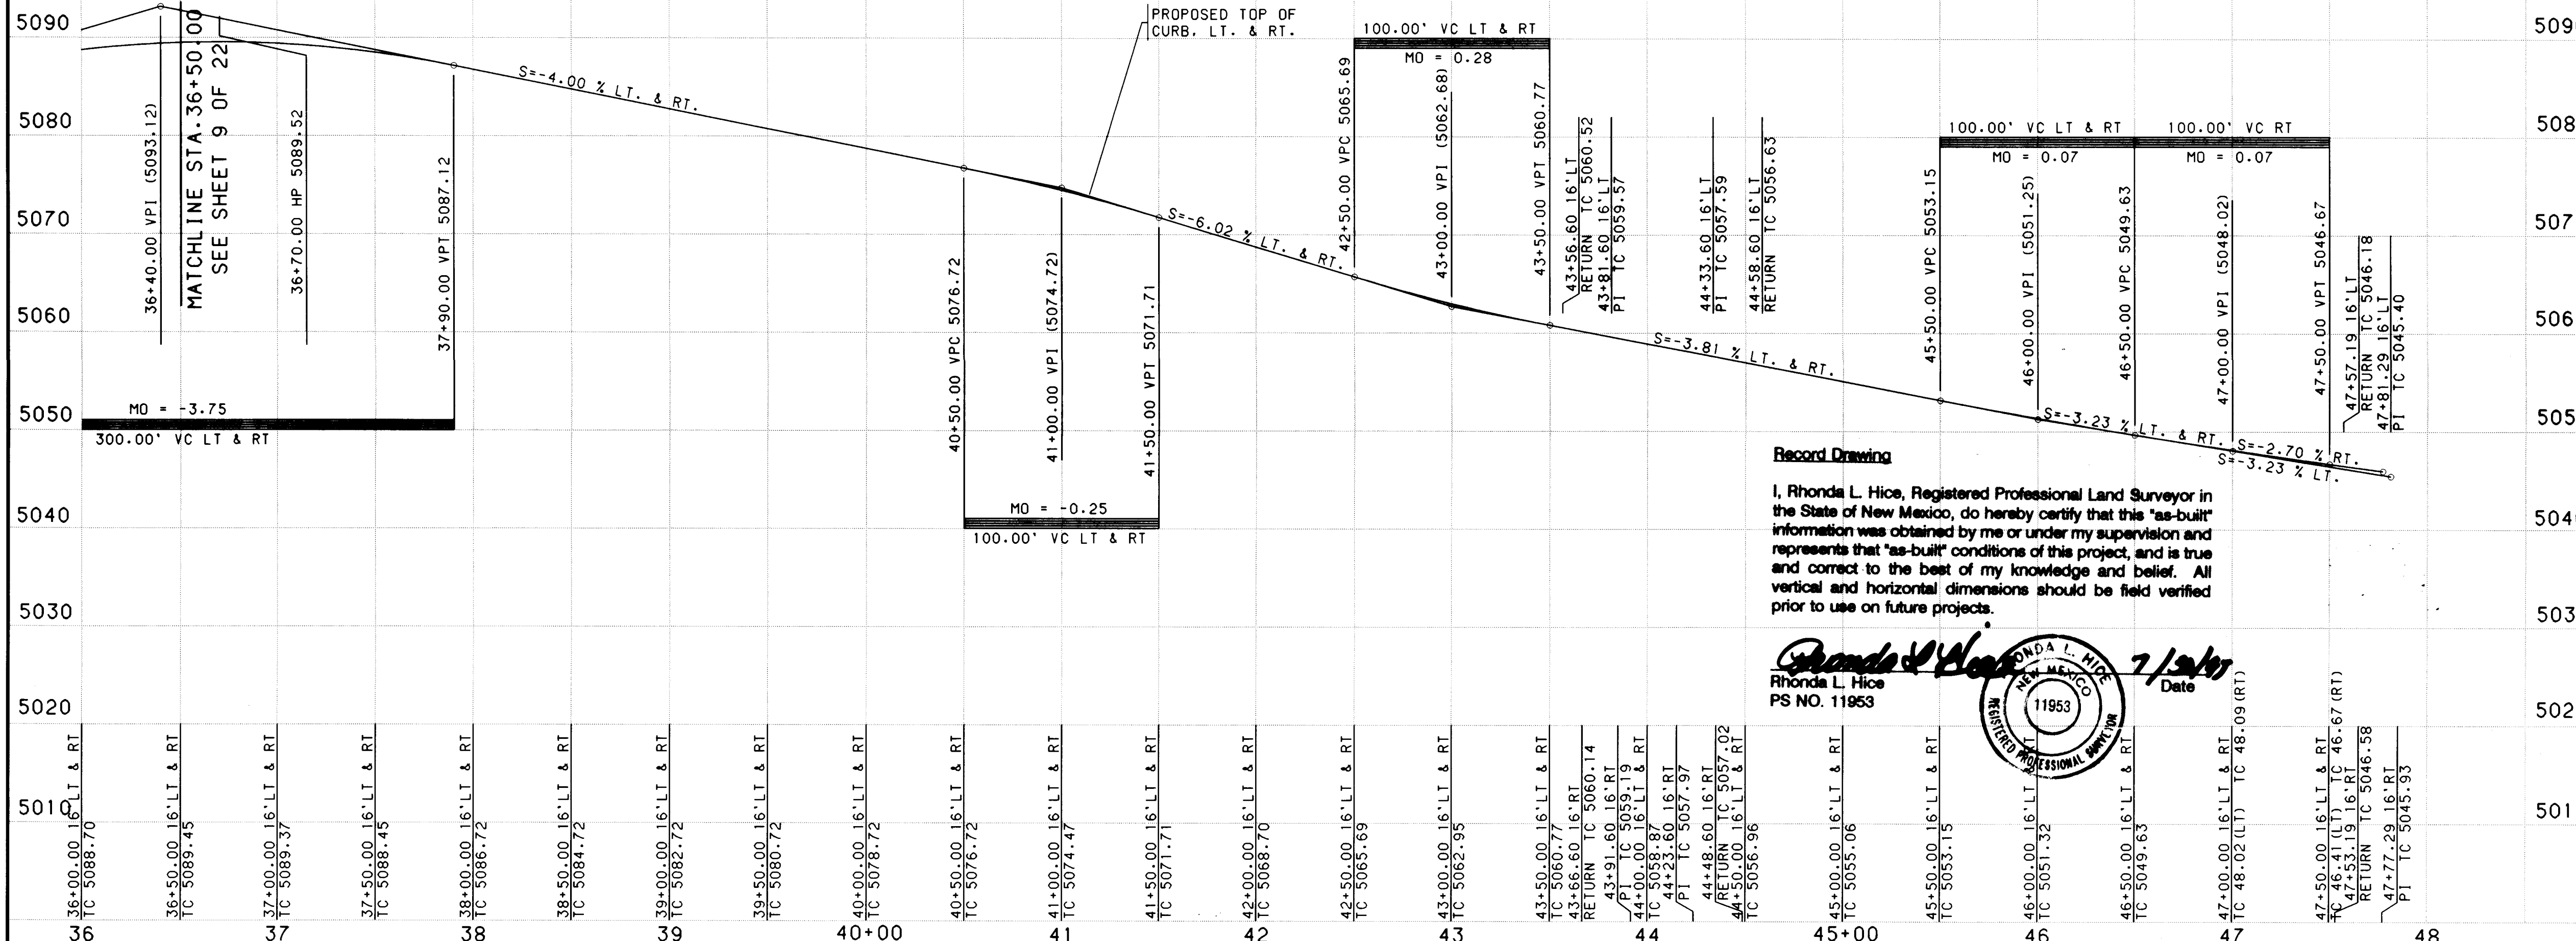

Record Drawing

I, Rhonda L. Hice, Registered Professional Land Surveyor in the State of New Mexico, do hereby certify that this "as-built" information was obtained by me or under my supervision and represents that "as-built" conditions of this project, and is true and correct to the best of my knowledge and belief. All vertical and horizontal dimensions should be field verified prior to use on future projects.

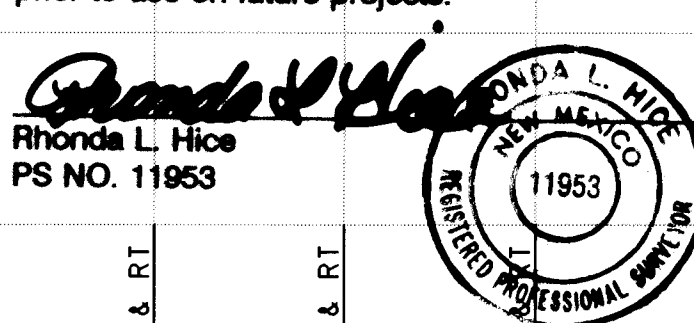

NOTES

1. THE CONTRACTOR SHALL FIELD VERIFY ALL EXISTING UTILITY LOCATIONS AND NOTIFY THE ENGINEER IMMEDIATELY OF ANY DISCREPANCIES.
2. ALL CURB RETURN RADI SHALL BE 25' TO FACE OF CURB UNLESS OTHERWISE SPECIFIED.
3. ALL CURVE DATA AND DIMENSIONS REFER TO FACE OF CURB UNLESS OTHERWISE SPECIFIED.
4. GRADE ELEVATIONS, WHERE NOTED, ARE FOR TOP OF STANDARD CURB UNLESS OTHERWISE SPECIFIED.
5. CONTRACTOR IS TO INSTALL A 4"x4"x5" POST AND EMD AT THE END OF EACH SANITARY SEWER SERVICE.
6. CONTRACTOR IS RESPONSIBLE FOR REPAIR AND/OR REPLACEMENT OF ALL UTILITY CONDUITS AND EXISTING LINES.
7. ANY ADDITIONAL GRADING REQUIRED TO MATCH PROPOSED STREET GRADES SHALL BE INCIDENTAL TO PAVING ITEMS.
8. CONTRACTOR SHALL PROVIDE THE INSPECTORS (CITY AND PRIVATE) WITH THE PROPOSED HYDROSTATIC TESTING PLAN. THE PLAN SHALL BE APPROVED BEFORE TESTING OPERATIONS BEGIN.
9. CONTRACTOR SHALL PARK EQUIPMENT AND VEHICLES AS NOT TO INTERFERE WITH NORMAL ACTIVITIES OF RESIDENTS OR OTHER CONTRACTORS ON SITE.
10. ANY DAMAGE TO THE EXISTING FACILITIES (CURB AND GUTTER, PAVEMENT, CONDUITS, LANDSCAPING, UTILITY LINES, ETC.) DURING CONSTRUCTION SHALL BE REPLACED AT THE CONTRACTORS EXPENSE.
11. REMOVAL OF THE EXISTING CURB AND GUTTER SHALL BE AS PER COA STD. DWG. 2415 (SAWCUT ONLY).
12. WHEEL CHAIR RAMPS SHALL BE CONSTRUCTED PRIOR TO ACCEPTANCE OF CURB AND GUTTER.
13. THE FOLLOWING PERSONS SHALL BE NOTIFIED AT LEAST TWO BUSINESS DAYS PRIOR TO INSTALLING UTILITY CONDUIT CROSSINGS:

COMPANY PHONE
PNM 848-3374
US WEST 245-6694
GAS CO. 761-7770
JONES 761-6200

KEYED GENERAL NOTES

1. INSTALL CONCRETE VALLEY GUTTER AS PER STD. DWG. 2420 OR 2421
 2. INSTALL WHEEL CHAIR RAMP AS PER STD. DWG. 2441, CASE II
 3. STD. CURB & GUTTER AS PER STD. DWG. 2415
 4. ROLL CURB & GUTTER AS PER STD. DWG. 2415
 5. MEDIAN CURB & GUTTER AS PER STD. DWG. 2415
 6. FUTURE 4' SIDEWALK
 7. BUILD 4' SIDEWALK
- NOT APPLICABLE THIS SHEET

BOHANNAN-HUSTON INC.
ENGINEERS • PLANNERS • PHOTOGRAMMETRISTS • SURVEYORS • LANDSCAPE ARCHITECTS
ALBUQUERQUE LAS CRUCES SANTA FE

CITY OF ALBUQUERQUE
PUBLIC WORKS DEPARTMENT
ENGINEERING DEVELOPMENT GROUP

RANCHO SERENO SUBDIVISION - UNIT V
PAVING PLAN & PROFILE
RANCHO PARAISO STA. 36+50.00 - 47+95.12



CITY ENGINEER APPROVAL

DESIGN REVIEW COMMITTEE

DATE: 11/96

DATE: 11/96

DATE: 11/96

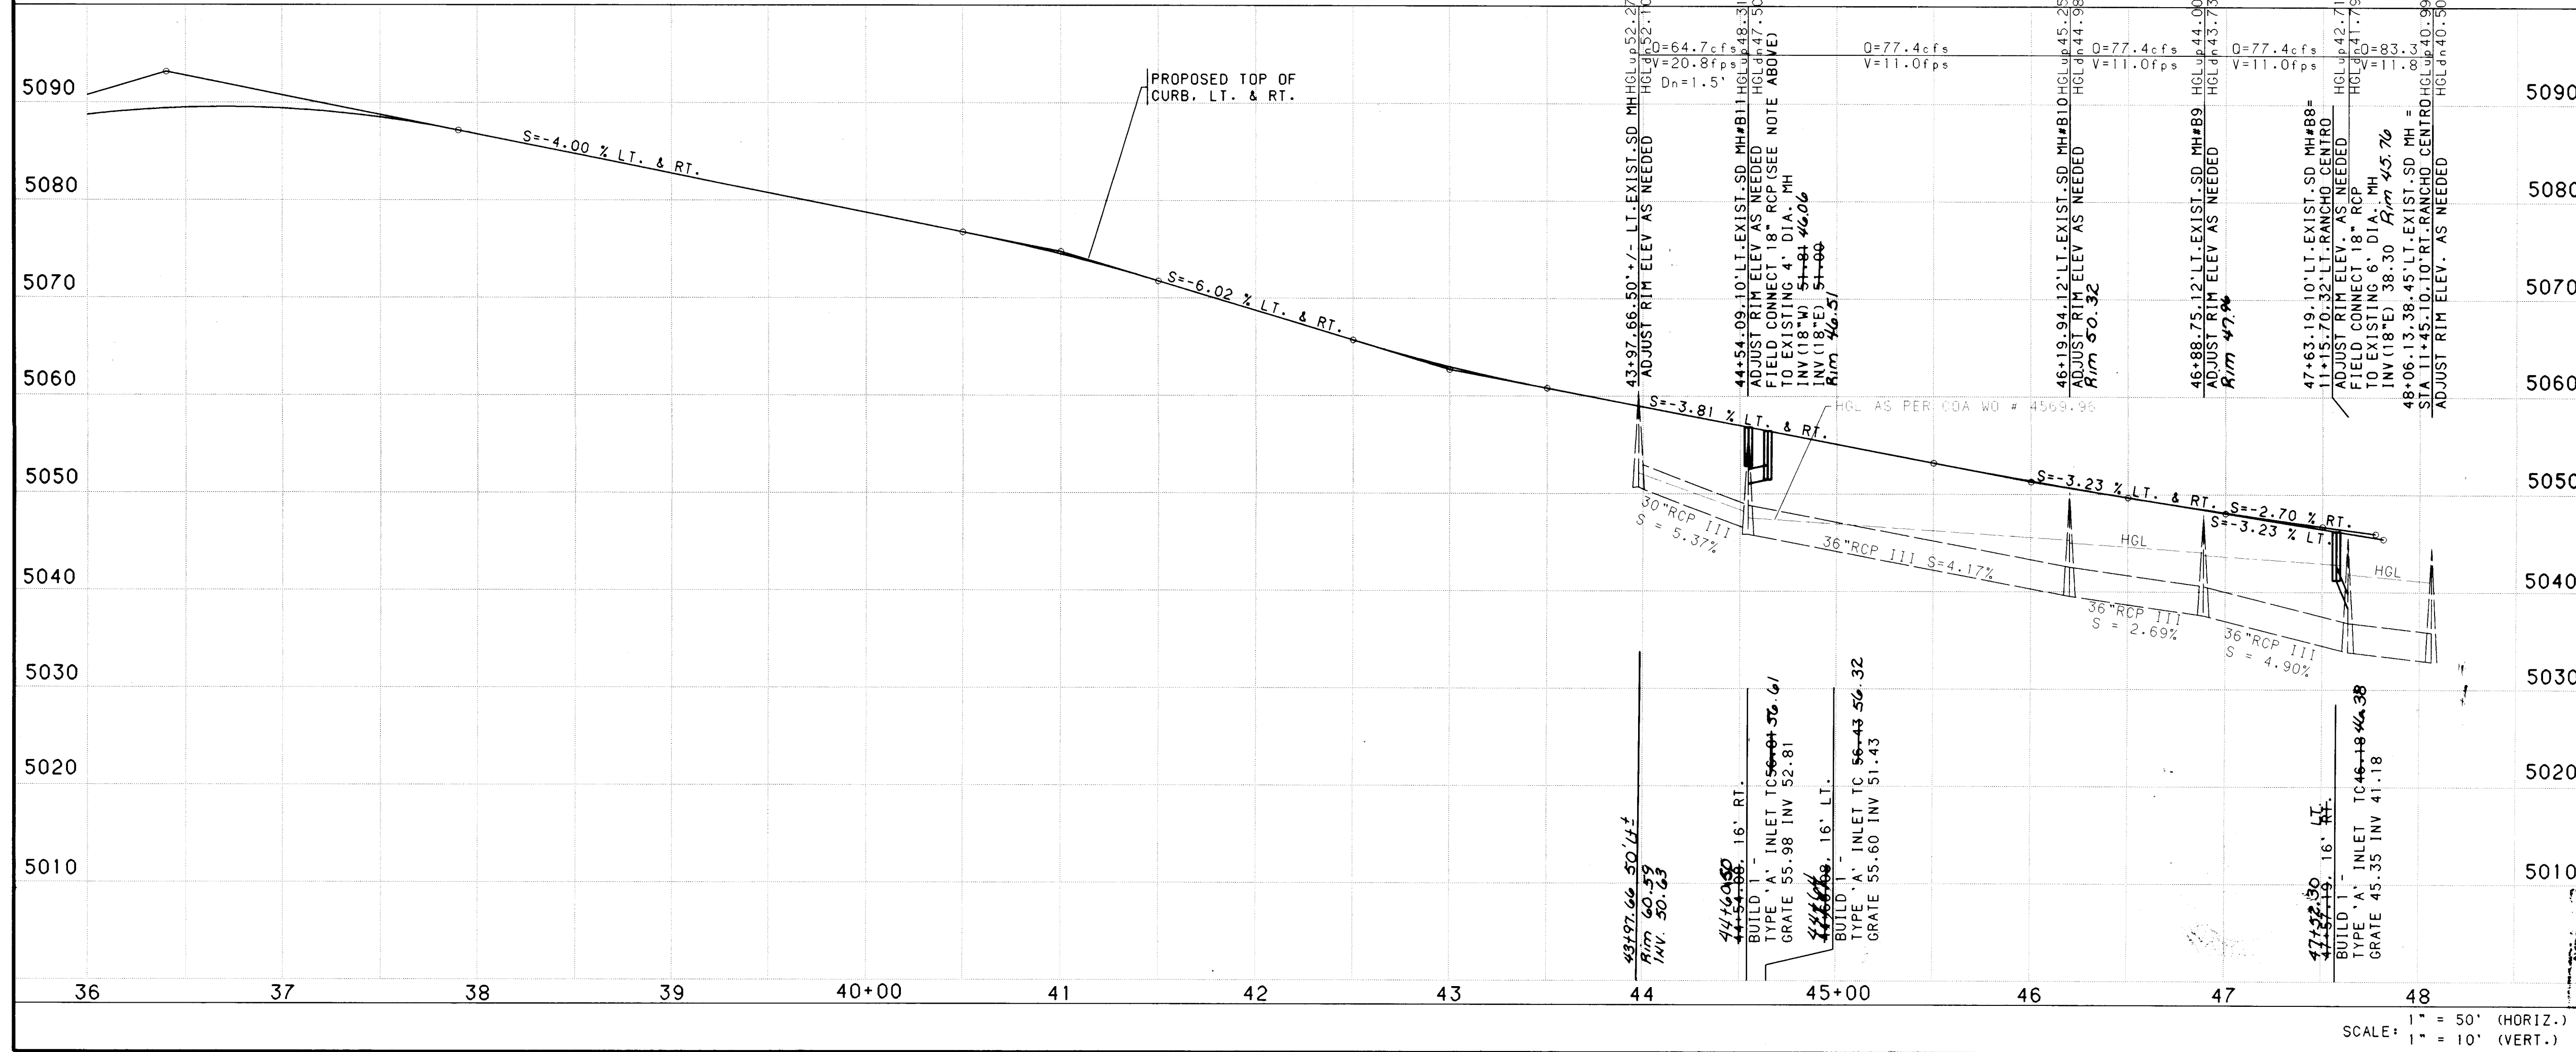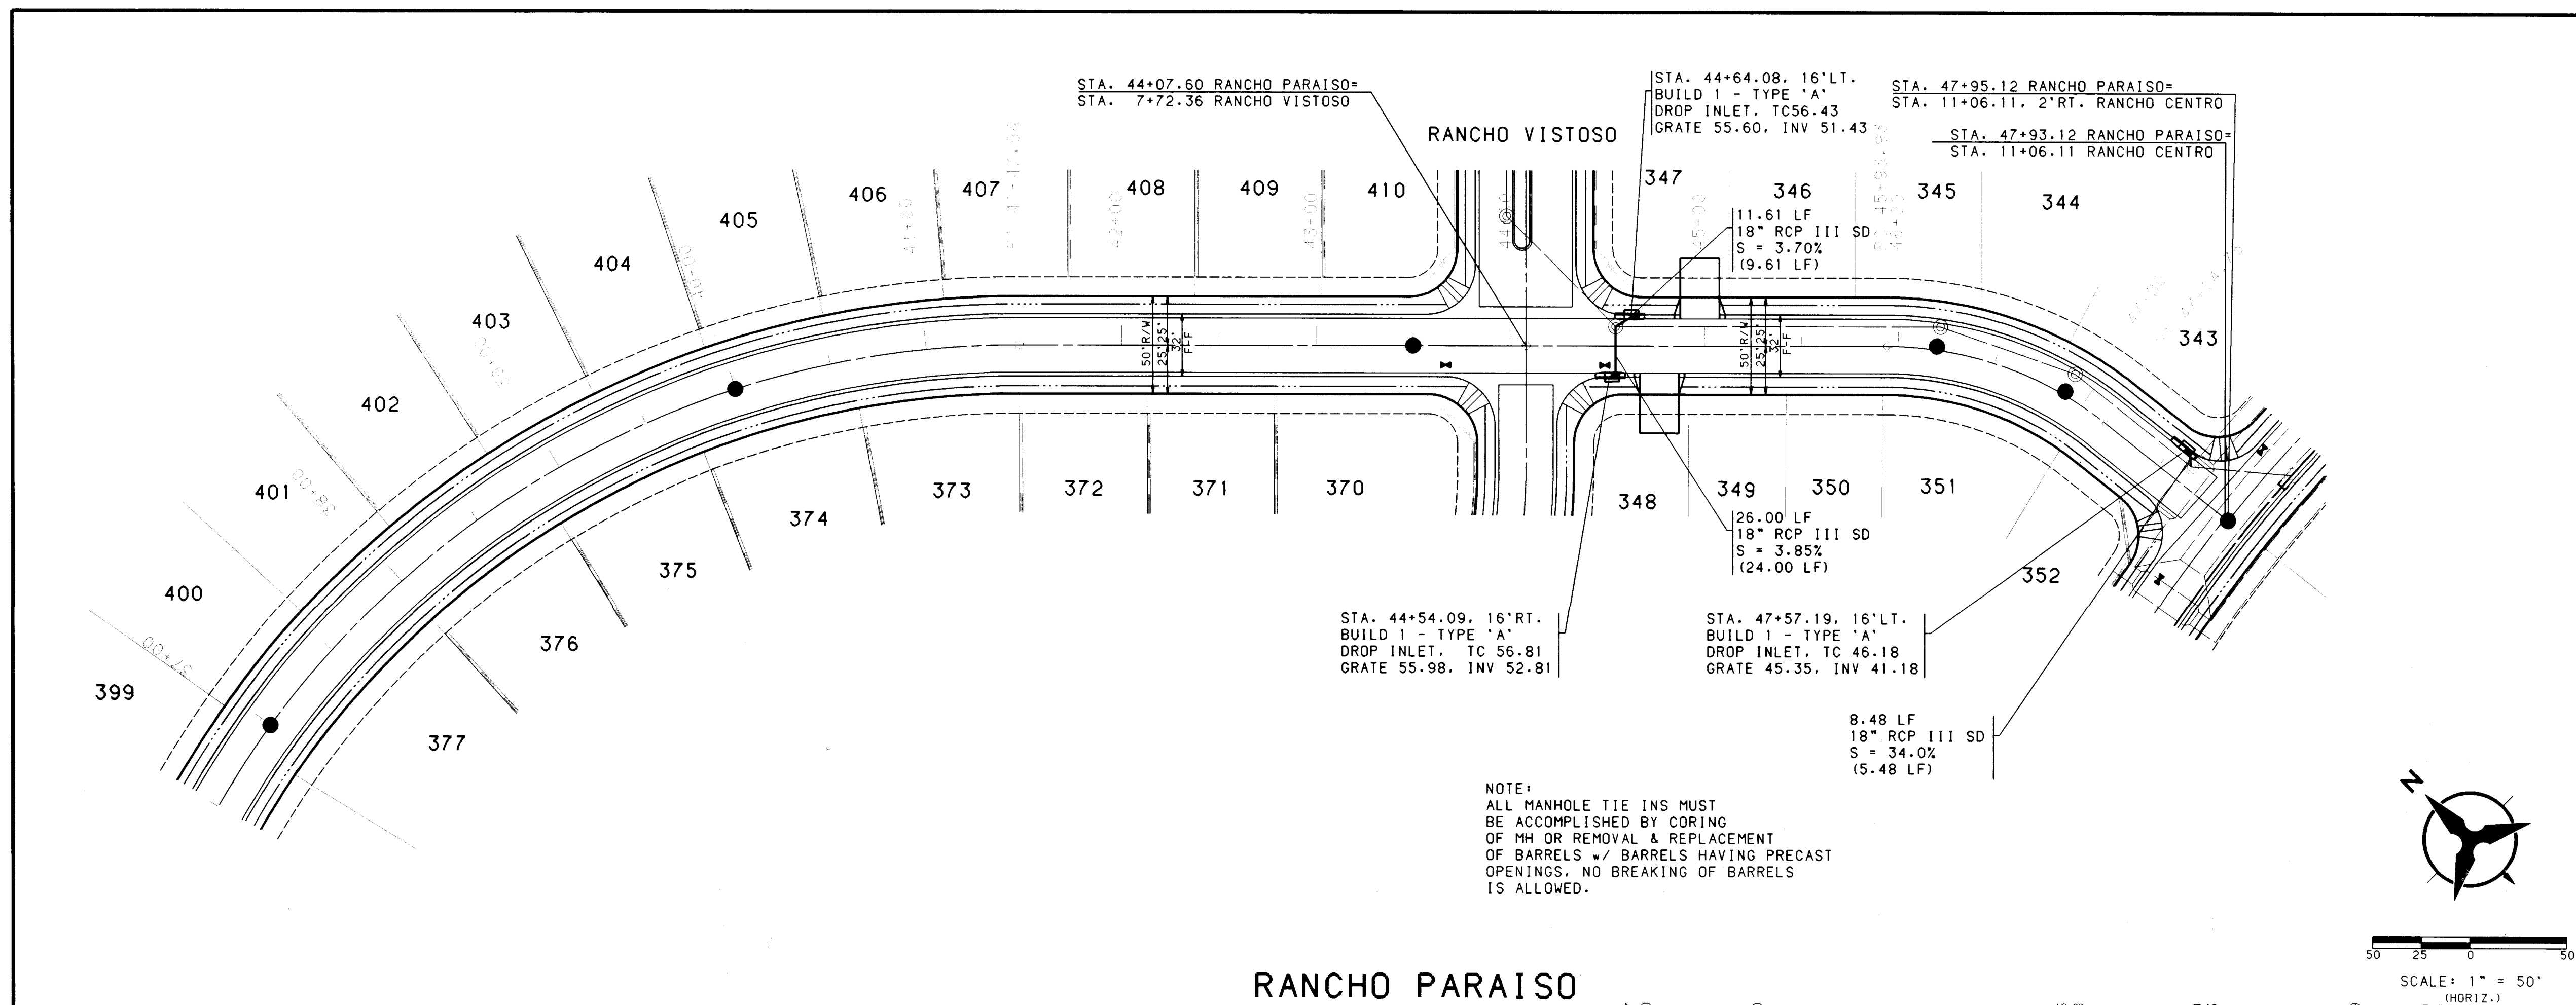

NOTES	
1. THE CONTRACTOR SHALL FIELD VERIFY ALL EXISTING UTILITY LOCATIONS AND NOTIFY THE ENGINEER IMMEDIATELY OF ANY DISCREPANCIES.	
2. ALL CURB RETURN RADII SHALL BE 25' TO FACE OF CURB UNLESS OTHERWISE SPECIFIED.	
3. ALL CURVE DATA AND DIMENSIONS REFER TO FACE OF CURB UNLESS OTHERWISE SPECIFIED.	
4. GRADE ELEVATIONS, WHERE NOTED, ARE FOR TOP OF STANDARD CURB UNLESS OTHERWISE SPECIFIED.	
5. CONTRACTOR IS TO INSTALL A 4"x4"x5" POST AND EMD AT THE END OF EACH SANITARY SEWER SERVICE.	
6. CONTRACTOR IS RESPONSIBLE FOR REPAIR AND/OR REPLACEMENT OF ALL UTILITY CONDUITS AND EXISTING LINES.	
7. ANY ADDITIONAL GRADING REQUIRED TO MATCH PROPOSED STREET GRADES SHALL BE INCIDENTAL TO PAVING ITEMS.	
8. CONTRACTOR SHALL PROVIDE THE INSPECTORS (CITY AND PRIVATE) WITH THE PROPOSED HYDROSTATIC TESTING PLAN. THE PLAN MUST BE APPROVED BEFORE TESTING OPERATIONS BEGIN.	
9. CONTRACTOR SHALL PARK EQUIPMENT AND VEHICLES AS NOT TO INTERFERE WITH NORMAL ACTIVITIES OF RESIDENTS OR OTHER CONTRACTORS ON SITE.	
10. ANY DAMAGE TO THE EXISTING FACILITIES (CURB AND GUTTER, PAVEMENT, CONDUITS, LANDSCAPING, UTILITY LINES, ETC.) DURING CONSTRUCTION SHALL BE REPLACED AT THE CONTRACTORS EXPENSE.	
11. REMOVAL OF THE EXISTING CURB AND GUTTER SHALL BE AS PER COA STD. DWG. 2415 (SAWCUT ONLY).	
12. WHEEL CHAIR RAMPS SHALL BE CONSTRUCTED PRIOR TO ACCEPTANCE OF CURB AND GUTTER.	
13. THE FOLLOWING PERSONS SHALL BE NOTIFIED AT LEAST TWO BUSINESS DAYS PRIOR TO INSTALLING UTILITY CONDUIT CROSSINGS:	
COMPANY PHONE	
PNM 848-3374	
US WEST 245-6694	
GAS CO. 761-7770	
JONES 761-6200	

AS-BUILT INFORMATION	
CONTRACTOR	NEW CONCEPTS, INC.
STATION MARK	STANDARD USCS&S BRASS
TABLET	STAMPED "HUGHES, 1954". SET IN TOP OF A CONCRETE POST PROJECTING 0.3 FT. ABOVE THE GROUND. TO REACH THE STATION FROM THE INTERSECTION OF CENTRAL AVE. AND STATE RD. 448. GO NORTH ON STATE RD. 448. 6.1 MILES. THE STATION IS 450' WEST OF STATE RD. 448. IN A FENCED-IN PRAIRIE.

BENCH MARKS	
STATION MARK	STANDARD USCS&S BRASS
TABLET	STAMPED "HUGHES, 1954". SET IN TOP OF A CONCRETE POST PROJECTING 0.3 FT. ABOVE THE GROUND. TO REACH THE STATION FROM THE INTERSECTION OF CENTRAL AVE. AND STATE RD. 448. GO NORTH ON STATE RD. 448. 6.1 MILES. THE STATION IS 450' WEST OF STATE RD. 448. IN A FENCED-IN PRAIRIE.

FIELD NOTES	
NO.	DATE
1	11/96
2	11/96
3	11/96
REVISIONS	
NO.	DATE
1	11/96
2	11/96
3	11/96
REVISIONS	
NO.	DATE
1	11/96
2	11/96
3	11/96
4	11/96
5	11/96
6	11/96
7	11/96
8	11/96
9	11/96

PT	TC	STATION & OFFSET	DELTA
1	77.86	1+12.57, 15.67' RT.	33°41'28"
2	79.48	0+92.33, 17.15' RT.	33°41'28"
3	80.89	0+74.68, 7.16' RT.	33°41'28"
4	81.63	0+65.53, 10.94' LT.	33°41'28"
5	81.43	0+67.96, 31.08' LT.	33°41'28"
6	80.38	0+81.15, 46.49' LT.	33°41'28"
7	78.81	1+00.68, 51.99' LT.	33°41'28"
8	77.27	1+19.97, 45.74' LT.	33°41'28"
9	76.26	1+32.56, 29.83' LT.	33°41'28"


R=35.00', L=20.58' (BETWEEN POINTS)

NUMBER	PI STA.	DELTA	DEGREE	TANGENT	LENGTH	RADIUS
C1	6+39.20	90° 0' 0.1"	76°23'40"	75.00'	117.81'	75.00'

NUMBER	BEARING	DISTANCE
T1	S77°00'08"W	17.00'
T2	S12°59'52"E	269.20'
T3	S12°59'52"E	195.00'
T4	NEXT SHEET	
T5	NEXT SHEET	
T6	S32°00'08"W	9.85'

PT	TC	STATION & OFFSET	DELTA
1	50.81	6+48.99, 24.87' RT.	37°26'24"
2	50.93	6+37.11, 39.63' RT.	37°26'24"
3	51.11	6+23.11, 44.85' RT.	37°26'24"
4	51.35	6+09.11, 39.63' RT.	37°26'24"
5	51.61	5+97.22, 24.87' RT.	37°26'24"

R=35.00', L=22.87' (BETWEEN POINTS)

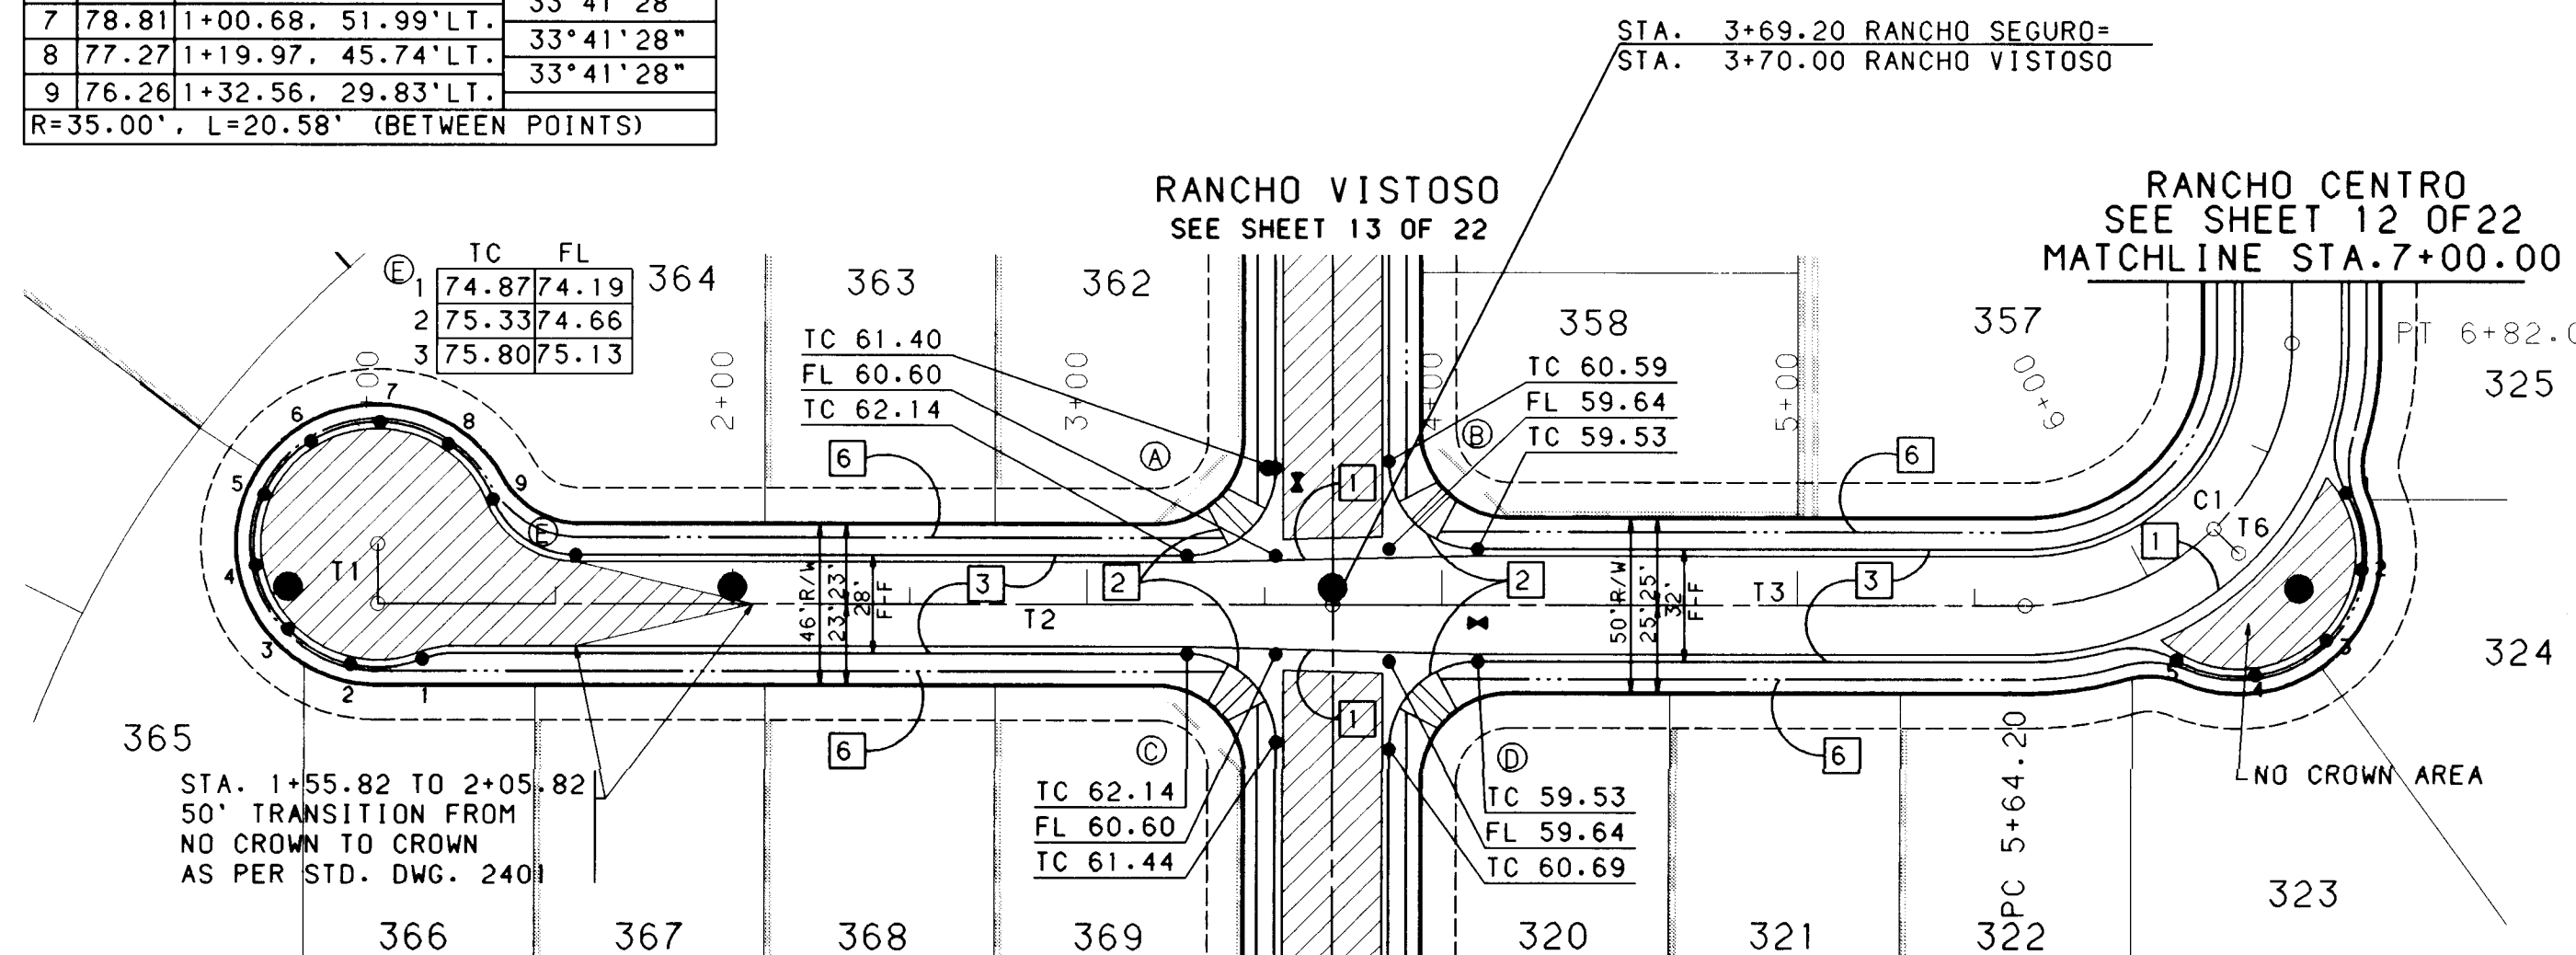

TC	FL
1	61.59 60.92
2	61.12 61.10
3	61.96 61.29

D= 90°00'00"
L= 39.27'
R= 25.00'

TC	FL
1	59.79 59.13
2	59.41 59.39
3	60.32 59.66

D= 90°00'00"
L= 39.27'
R= 25.00'


TC	FL
1	61.96 61.30
2	61.14 61.12
3	61.61 60.95

D= 90°00'00"
L= 39.27'
R= 25.00'

TC	FL
1	60.40 59.73
2	59.46 59.44
3	59.82 59.15

D= 90°00'00"
L= 39.27'
R= 25.00'


RANCHO SEGURO

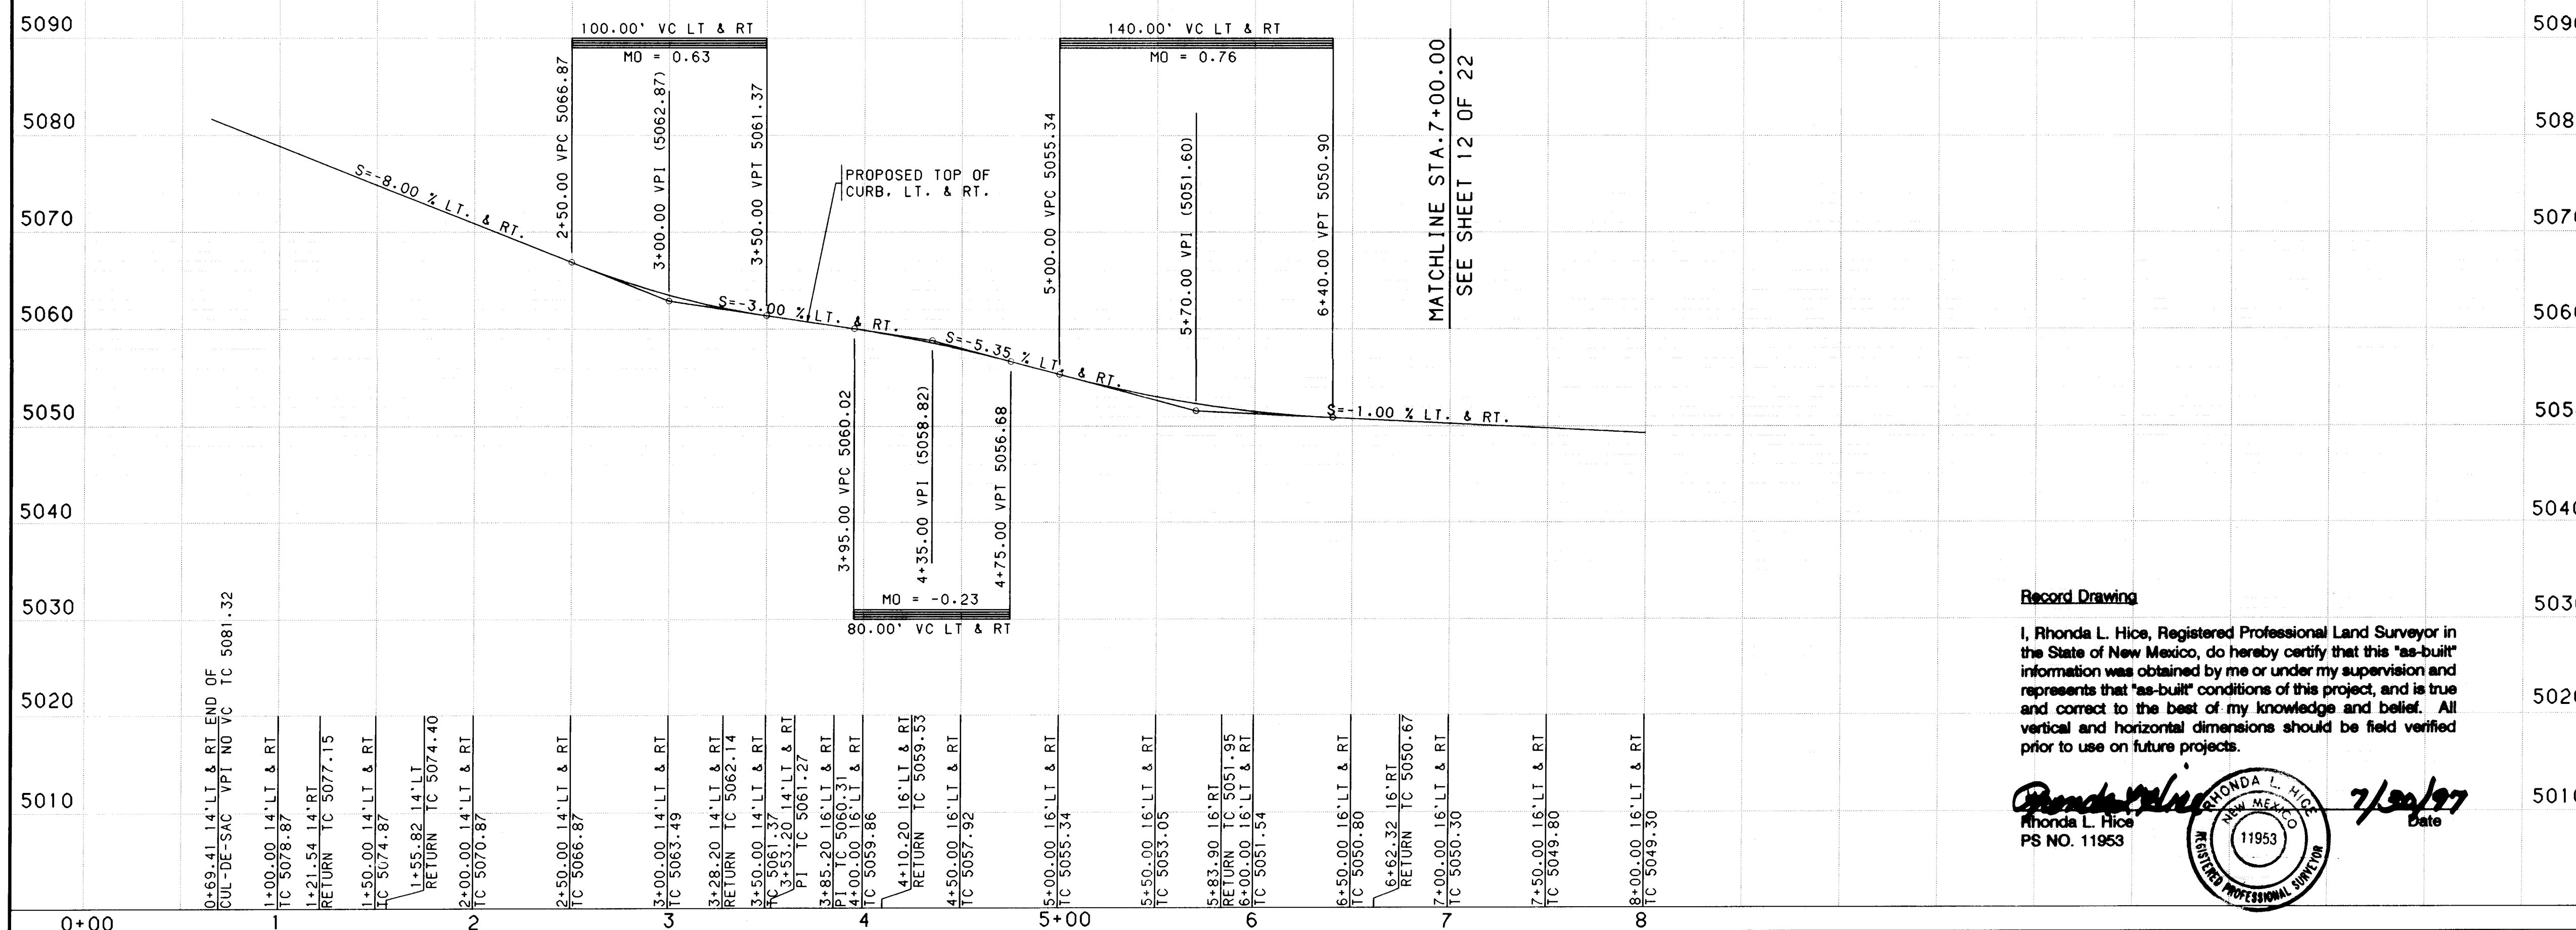

Record Drawing

I, Rhonda L. Hice, Registered Professional Land Surveyor in the State of New Mexico, do hereby certify that this "as-built" information was obtained by me or under my supervision and represents that "as-built" conditions of this project, and is true and correct to the best of my knowledge and belief. All vertical and horizontal dimensions should be field verified prior to use on future projects.

Rhonda L. Hice
PS NO. 11953
7/30/97
Date

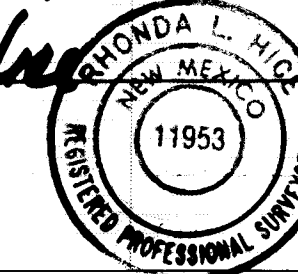

SCALE: 1" = 50' (HORIZ.)
1" = 10' (VERT.)

NOTES

- THE CONTRACTOR SHALL FIELD VERIFY ALL EXISTING UTILITY LOCATIONS AND NOTIFY THE ENGINEER IMMEDIATELY OF ANY DISCREPANCIES.
- ALL CURB RETURN RADIUS SHALL BE 25' TO FACE OF CURB UNLESS OTHERWISE SPECIFIED.
- ALL CURVE DATA AND DIMENSIONS REFER TO FACE OF CURB UNLESS OTHERWISE SPECIFIED.
- GRADE ELEVATIONS, WHERE NOTED, ARE FOR TOP OF STANDARD CURB UNLESS OTHERWISE SPECIFIED.
- CONTRACTOR IS TO INSTALL A 4"x4"x5' POST AND END AT THE END OF EACH SANITARY SEWER SERVICE.
- CONTRACTOR IS RESPONSIBLE FOR REPAIR AND/OR REPLACEMENT OF ALL UTILITY CONDUITS AND EXISTING LINES.
- ANY ADDITIONAL GRADING REQUIRED TO MATCH PROPOSED STREET GRADES SHALL BE INCIDENTAL TO PAVING ITEMS.
- CONTRACTOR SHALL PROVIDE THE INSPECTORS (CITY AND PRIVATE) WITH THE PROPOSED HYDROSTATIC TESTING PLAN. THE PLAN MUST BE APPROVED BEFORE TESTING OPERATIONS BEGIN.
- CONTRACTOR SHALL PARK EQUIPMENT AND VEHICLES AS NOT TO INTERFERE WITH NORMAL ACTIVITIES OF RESIDENTS OR OTHER CONTRACTORS ON SITE.
- ANY DAMAGE TO THE EXISTING FACILITIES (CURB AND GUTTER, PAVEMENT, CONDUITS, LANDSCAPING, UTILITY LINES, ETC.) DURING CONSTRUCTION SHALL BE REPLACED AT THE CONTRACTORS EXPENSE.
- REMOVAL OF THE EXISTING CURB AND GUTTER SHALL BE AS PER COA STD. DWG. 2415 (SAWCUT ONLY).
- WHEEL CHAIR RAMPS SHALL BE CONSTRUCTED PRIOR TO ACCEPTANCE OF CURB AND GUTTER.
- THE FOLLOWING PERSONS SHALL BE NOTIFIED AT LEAST TWO BUSINESS DAYS PRIOR TO INSTALLING UTILITY CONDUIT CROSSINGS:

COMPANY PHONE
PNM 848-3374
US WEST 245-6694
GAS CO. 761-7770
JONES 761-6200

KEYED GENERAL NOTES

- INSTALL CONCRETE VALLEY GUTTER AS PER STD. DWG. 2420 OR 2421
- INSTALL WHEEL CHAIR RAMP AS PER STD. DWG. 2441, CASE II
- STD. CURB & GUTTER AS PER STD. DWG. 2415
- ROLL CURB & GUTTER AS PER STD. DWG. 2415
- MEDIAN CURB & GUTTER AS PER STD. DWG. 2415
- FUTURE 4' SIDEWALK
- BUILD 4' SIDEWALK

BOHANNAN-HUSTON INC.
ENGINEERS • PLANNERS • PHOTOGRAMMETRISTS • SURVEYORS • LANDSCAPE ARCHITECTS
ALBUQUERQUE LAS CRUCES SANTA FE

CITY OF ALBUQUERQUE
PUBLIC WORKS DEPARTMENT
ENGINEERING DEVELOPMENT GROUP

RANCHO SERENO SUBDIVISION - UNIT V
PAYING PLAN & PROFILE
RANCHO SEGURO STA. 1+00.00 - 7+00.00

DESIGN REVIEW COMMITTEE	CITY ENGINEER APPROVAL	MO/DAY/YR	MO/DAY/YR
DATE	DATE	DATE	DATE
DESIGNED BY	OR. SAR	CHECKED BY	JRT
DRAWN BY			

CITY PROJECT NO. 456997 ZONE MAP NO. C-12 SHEET 11 OF 22

BHI JOB NO. C96436A2400 Copyright Bohannon-Huston, Inc. 1996


SCANNED BY
BY LABON

CENTERLINE CURVE DATA						
NUMBER	PI STA.	DELTA	DEGREE	TANGENT	LENGTH	RADIUS
C1	6+39.20	90° 0' 0.1"	76° 23' 40"	75.00'	117.81'	75.00'
C2	10+61.62	6° 48' 23.2"	7° 38' 22"	44.60'	89.10'	750.00'
C3	12+61.96	23° 32' 18.0"	7° 39' 36"	155.85'	307.29'	748.00'

RANCHO SEGURO
SEE SHEET 00 OF 00

RANCHO PARAISO
SEE SHEET 10 OF 22

STA. 11+06.11 RANCHO CENTRO=
STA. 47+93.12 RANCHO PARAISO
STA. 11+06.11, 2° RT RANCHO CENTRO=
STA. 47+95.12 RANCHO PARAISO

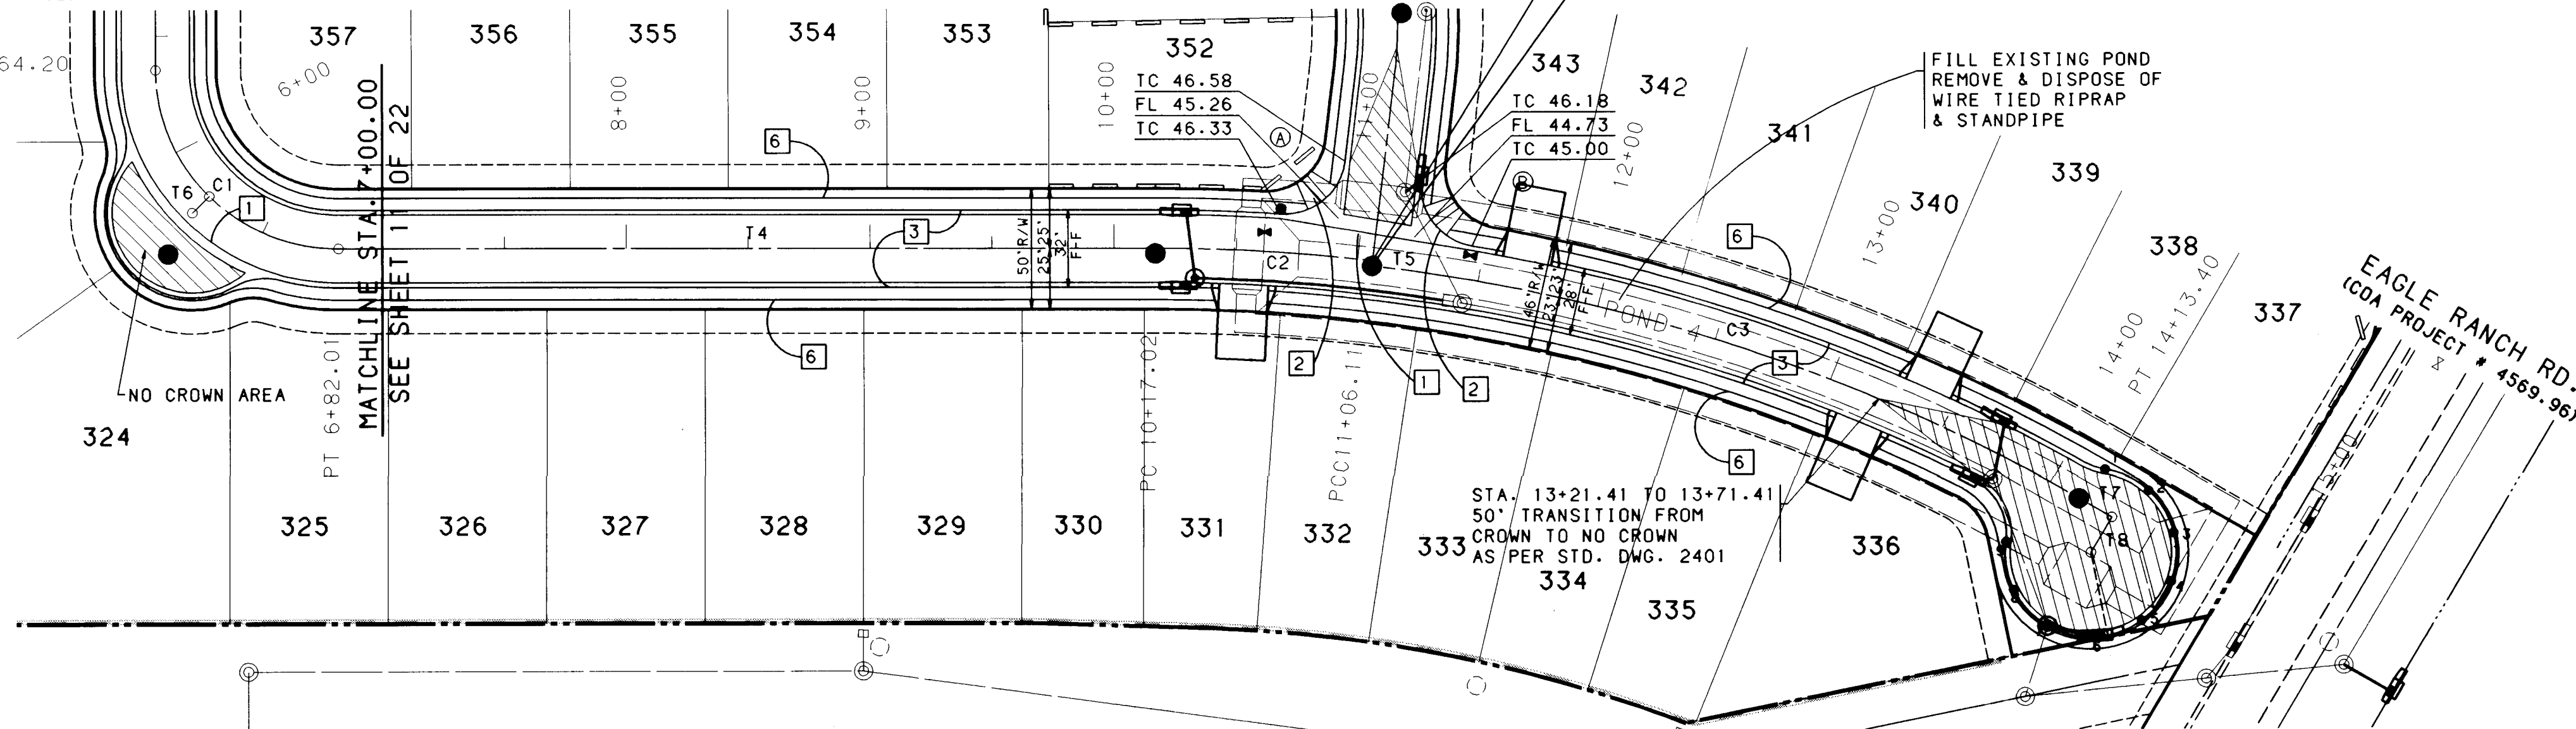

TANGENT DATA		
NUMBER	BEARING	DISTANCE
T4	N77°00'08"E	335.00'
T5	S06°11'29"E	2.00'
T6	S32°00'08"W	9.85'
T7	S72°39'11"E	15.58'
T8	S17°20'49"W	17.00'


TC	FL	TC	FL
1 46.52	45.85	1 45.29	44.63
2 45.81	45.79	2 44.94	44.92
3 46.34	45.73	3 45.88	45.22

D = 87°01'43.9"
L = 37.97'
R = 25.00'


D = 87°00'49.4"
L = 37.97'
R = 25.00'

CUL-DE-SAC CURB DATA (CLOCKWISE)			
PT	TC	STATION & OFFSET	DELTA
1	40.39	14+16.39, 15.65' LT	33°33'18"
2	40.05	14+36.53, 17.18' LT	33°33'18"
3	39.75	14+54.17, 7.31' LT	33°33'18"
4	39.63	14+63.41, 10.66' RT	33°33'18"
5	39.52	14+61.18, 30.74' RT	33°33'18"
6	39.40	14+48.22, 46.24' RT	33°33'18"
7	39.78	14+28.85, 52.00' RT	33°33'18"
8	40.15	14+09.27, 46.08' RT	33°33'18"
9	40.53	13+95.98, 30.29' RT	33°33'18"

R=35.00', L=20.50' (BETWEEN POINTS)

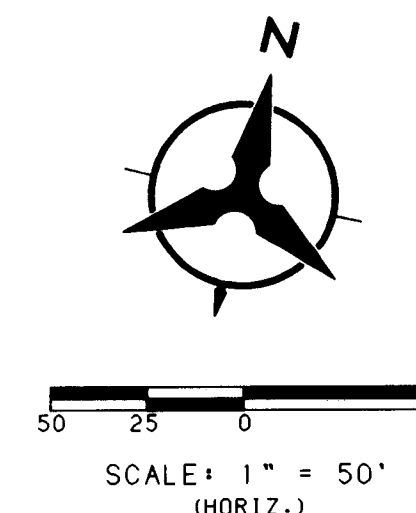

RANCHO CENTRO

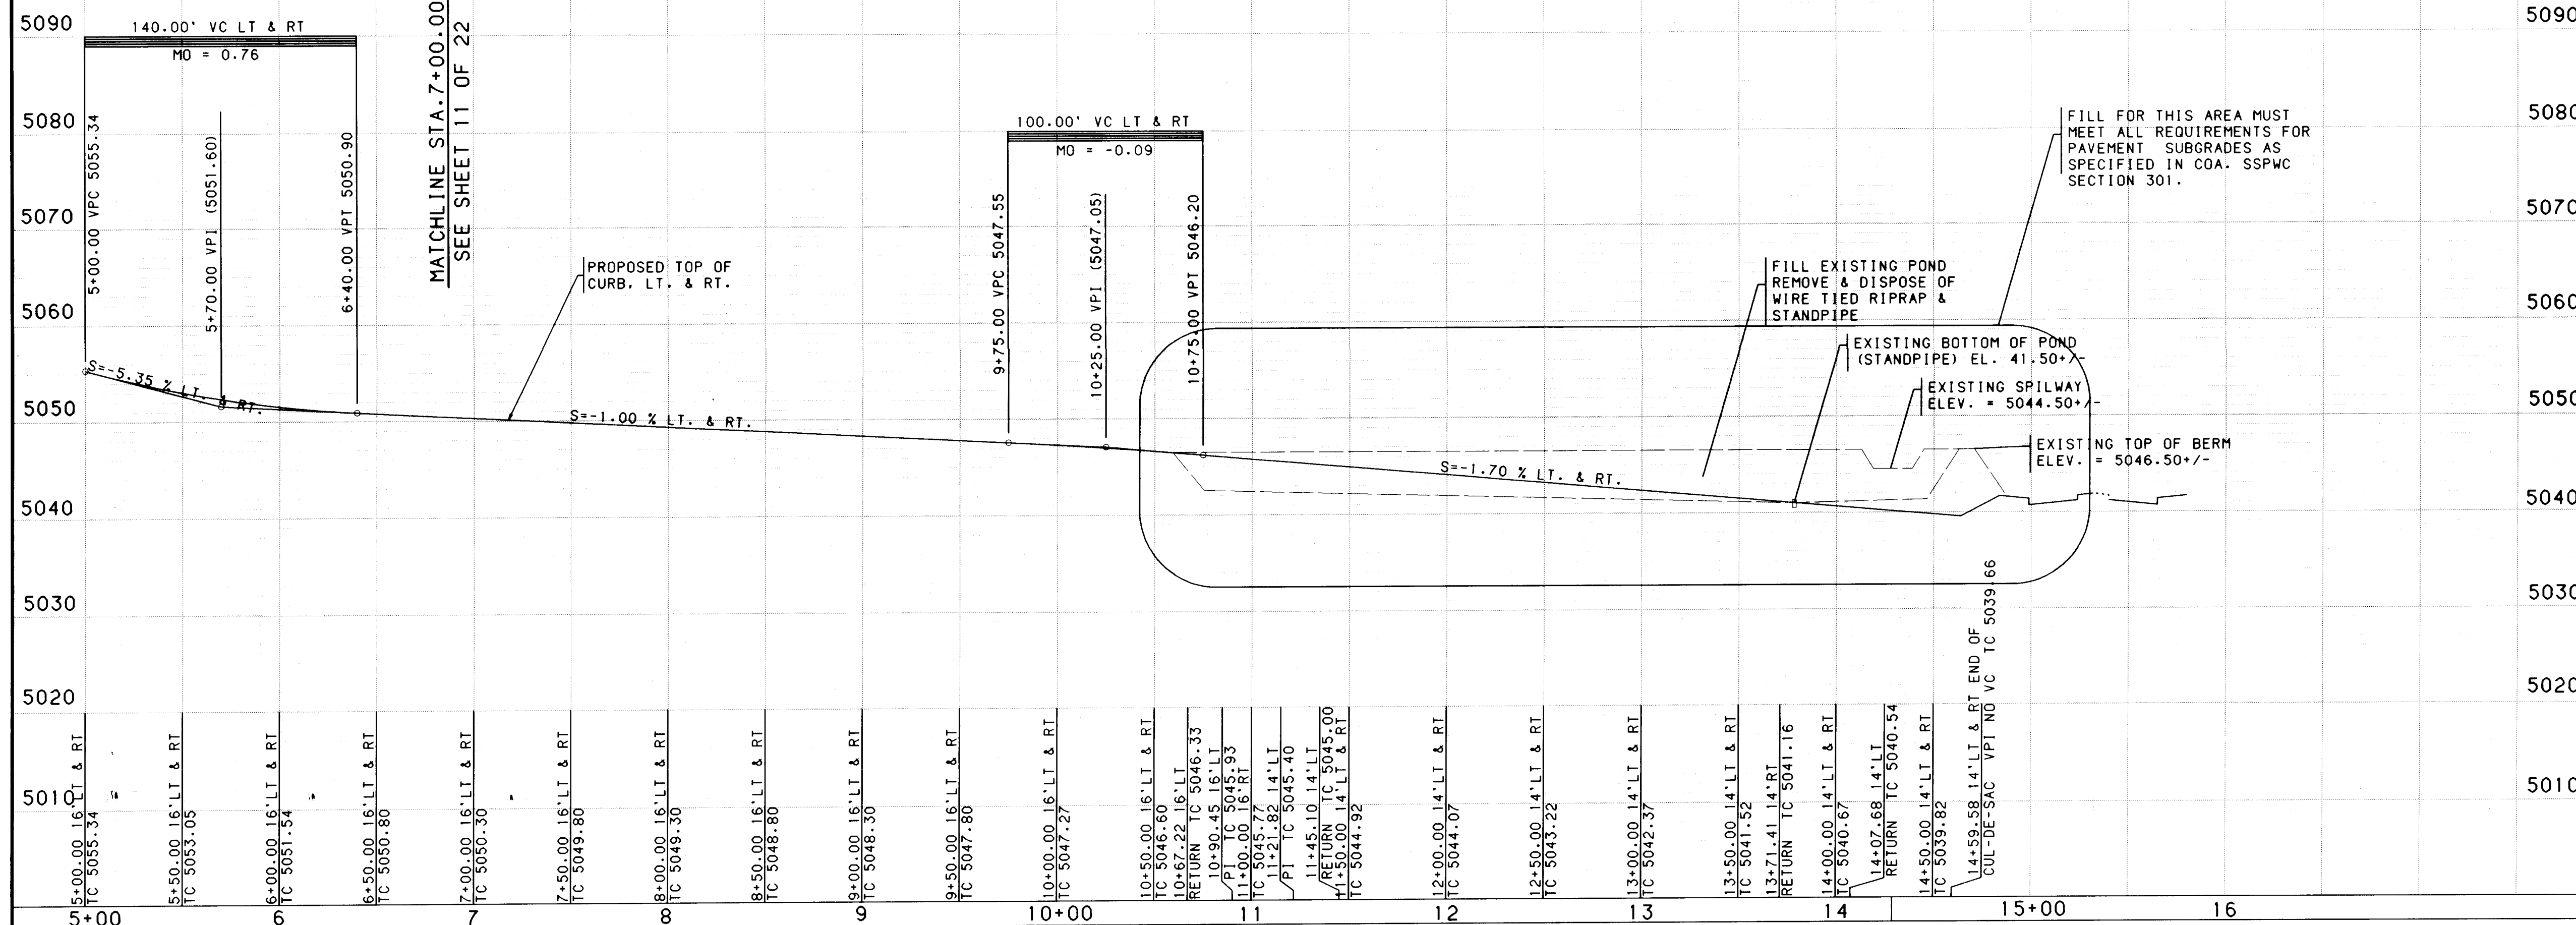

SCALE: 1" = 50' (HORIZ.)
1" = 10' (VERT.)

NOTES

- THE CONTRACTOR SHALL FIELD VERIFY ALL EXISTING UTILITY LOCATIONS AND NOTIFY THE ENGINEER IMMEDIATELY OF ANY DISCREPANCIES.
- ALL CURB RETURN RADIUS SHALL BE 25' TO FACE OF CURB UNLESS OTHERWISE SPECIFIED.
- ALL CURVE DATA AND DIMENSIONS REFER TO FACE OF CURB UNLESS OTHERWISE SPECIFIED.
- GRADE ELEVATIONS, WHERE NOTED, ARE FOR TOP OF STANDARD CURB UNLESS OTHERWISE SPECIFIED.
- CONTRACTOR IS TO INSTALL A 4"x4"x5' POST AND EMD AT THE END OF EACH SANITARY SEWER SERVICE.
- CONTRACTOR IS RESPONSIBLE FOR REPAIR AND/OR REPLACEMENT OF ALL UTILITY CONDUITS AND EXISTING LINES.
- ANY ADDITIONAL GRADING REQUIRED TO MATCH PROPOSED STREET GRADES SHALL BE INCIDENTAL TO PAVING ITEMS.
- CONTRACTOR SHALL PROVIDE THE INSPECTORS (CITY AND PRIVATE) WITH THE PROPOSED HYDROSTATIC TESTING PLAN. THE PLAN MUST BE APPROVED BEFORE TESTING OPERATIONS BEGIN.
- CONTRACTOR SHALL PARK EQUIPMENT AND VEHICLES AS NOT TO INTERFERE WITH NORMAL ACTIVITIES OF RESIDENTS OR OTHER CONTRACTORS ON SITE.
- ANY DAMAGE TO THE EXISTING FACILITIES (CURB AND GUTTER, PAVEMENT, CONDUITS, LANDSCAPING, UTILITY LINES, ETC.) DURING CONSTRUCTION SHALL BE REPLACED AT THE CONTRACTORS EXPENSE.
- REMOVAL OF THE EXISTING CURB AND GUTTER SHALL BE AS PER COA STD. DWG. 2415 (SAWCUT ONLY).
- WHEEL CHAIR RAMPS SHALL BE CONSTRUCTED PRIOR TO ACCEPTANCE OF CURB AND GUTTER.
- THE FOLLOWING PERSONS SHALL BE NOTIFIED AT LEAST TWO BUSINESS DAYS PRIOR TO INSTALLING UTILITY CONDUIT CROSSINGS:

COMPANY PHONE

PNM 848-3374
US WEST 245-6694
GAS CO. 761-7770
JONES 761-6200

KEYED GENERAL NOTES

- INSTALL CONCRETE VALLEY GUTTER AS PER STD. DWG. 2420 OR 2421
- INSTALL WHEEL CHAIR RAMP AS PER STD. DWG. 2441, CASE II
- STD. CURB & GUTTER AS PER STD. DWG. 2415
- ROLL CURB & GUTTER AS PER STD. DWG. 2415
- MEDIAN CURB & GUTTER AS PER STD. DWG. 2415
- FUTURE 4' SIDEWALK
- BUILD 4' SIDEWALK

• NOT APPLICABLE THIS SHEET


ENGINEER'S SEAL		SURVEY INFORMATION		FIELD NOTES		BENCH MARKS		AS-BUILT INFORMATION						
	DATE	NO.	BY	DATE	NO.	DATE	NO.	DATE	NO.					
DESIGNED BY MSJ		REMARKS		REVISIONS		DATE		DATE						
DRAWN BY BS		DESIGN		DATE		DATE		DATE						
CHECKED BY JRT		DATE		DATE		DATE		DATE						
BOHANNAN-HUSTON, INC.		CITY OF ALBUQUERQUE		ENGINEERING DEVELOPMENT GROUP		RANCHO SERENO SUBDIVISION - UNIT V		PAVING PLAN & PROFILE						
ENGINEERS • PLANNERS • PHOTOGRAMMETRISTS • SURVEYORS • LANDSCAPE ARCHITECTS		ALBUQUERQUE LAS CRUCES SANTA FE		14+59.58		MO/DAY/YR		MO/DAY/YR						
APPROVE		CITY ENGINEER APPROVAL		LAST DESIGN UPDATE		12		22						
PROJECT NO. 456997		ZONE MAP NO. C-12		SHEET 12 OF 22		DATE: DECEMBER, 1996		Copyright Bohannon-Huston, Inc. 1996						

TC	FL	①
1	59.95	59.28
2	59.11	59.09
3	59.57	58.90

D = 90°00'00"
L = 39.27'
R = 25.00'
WR = 25.00'

TC	FL	②
1	60.55	59.89
2	59.90	59.88
3	60.53	59.86


D = 90°00'00"
L = 39.27'
R = 25.00'
WR = 25.00'

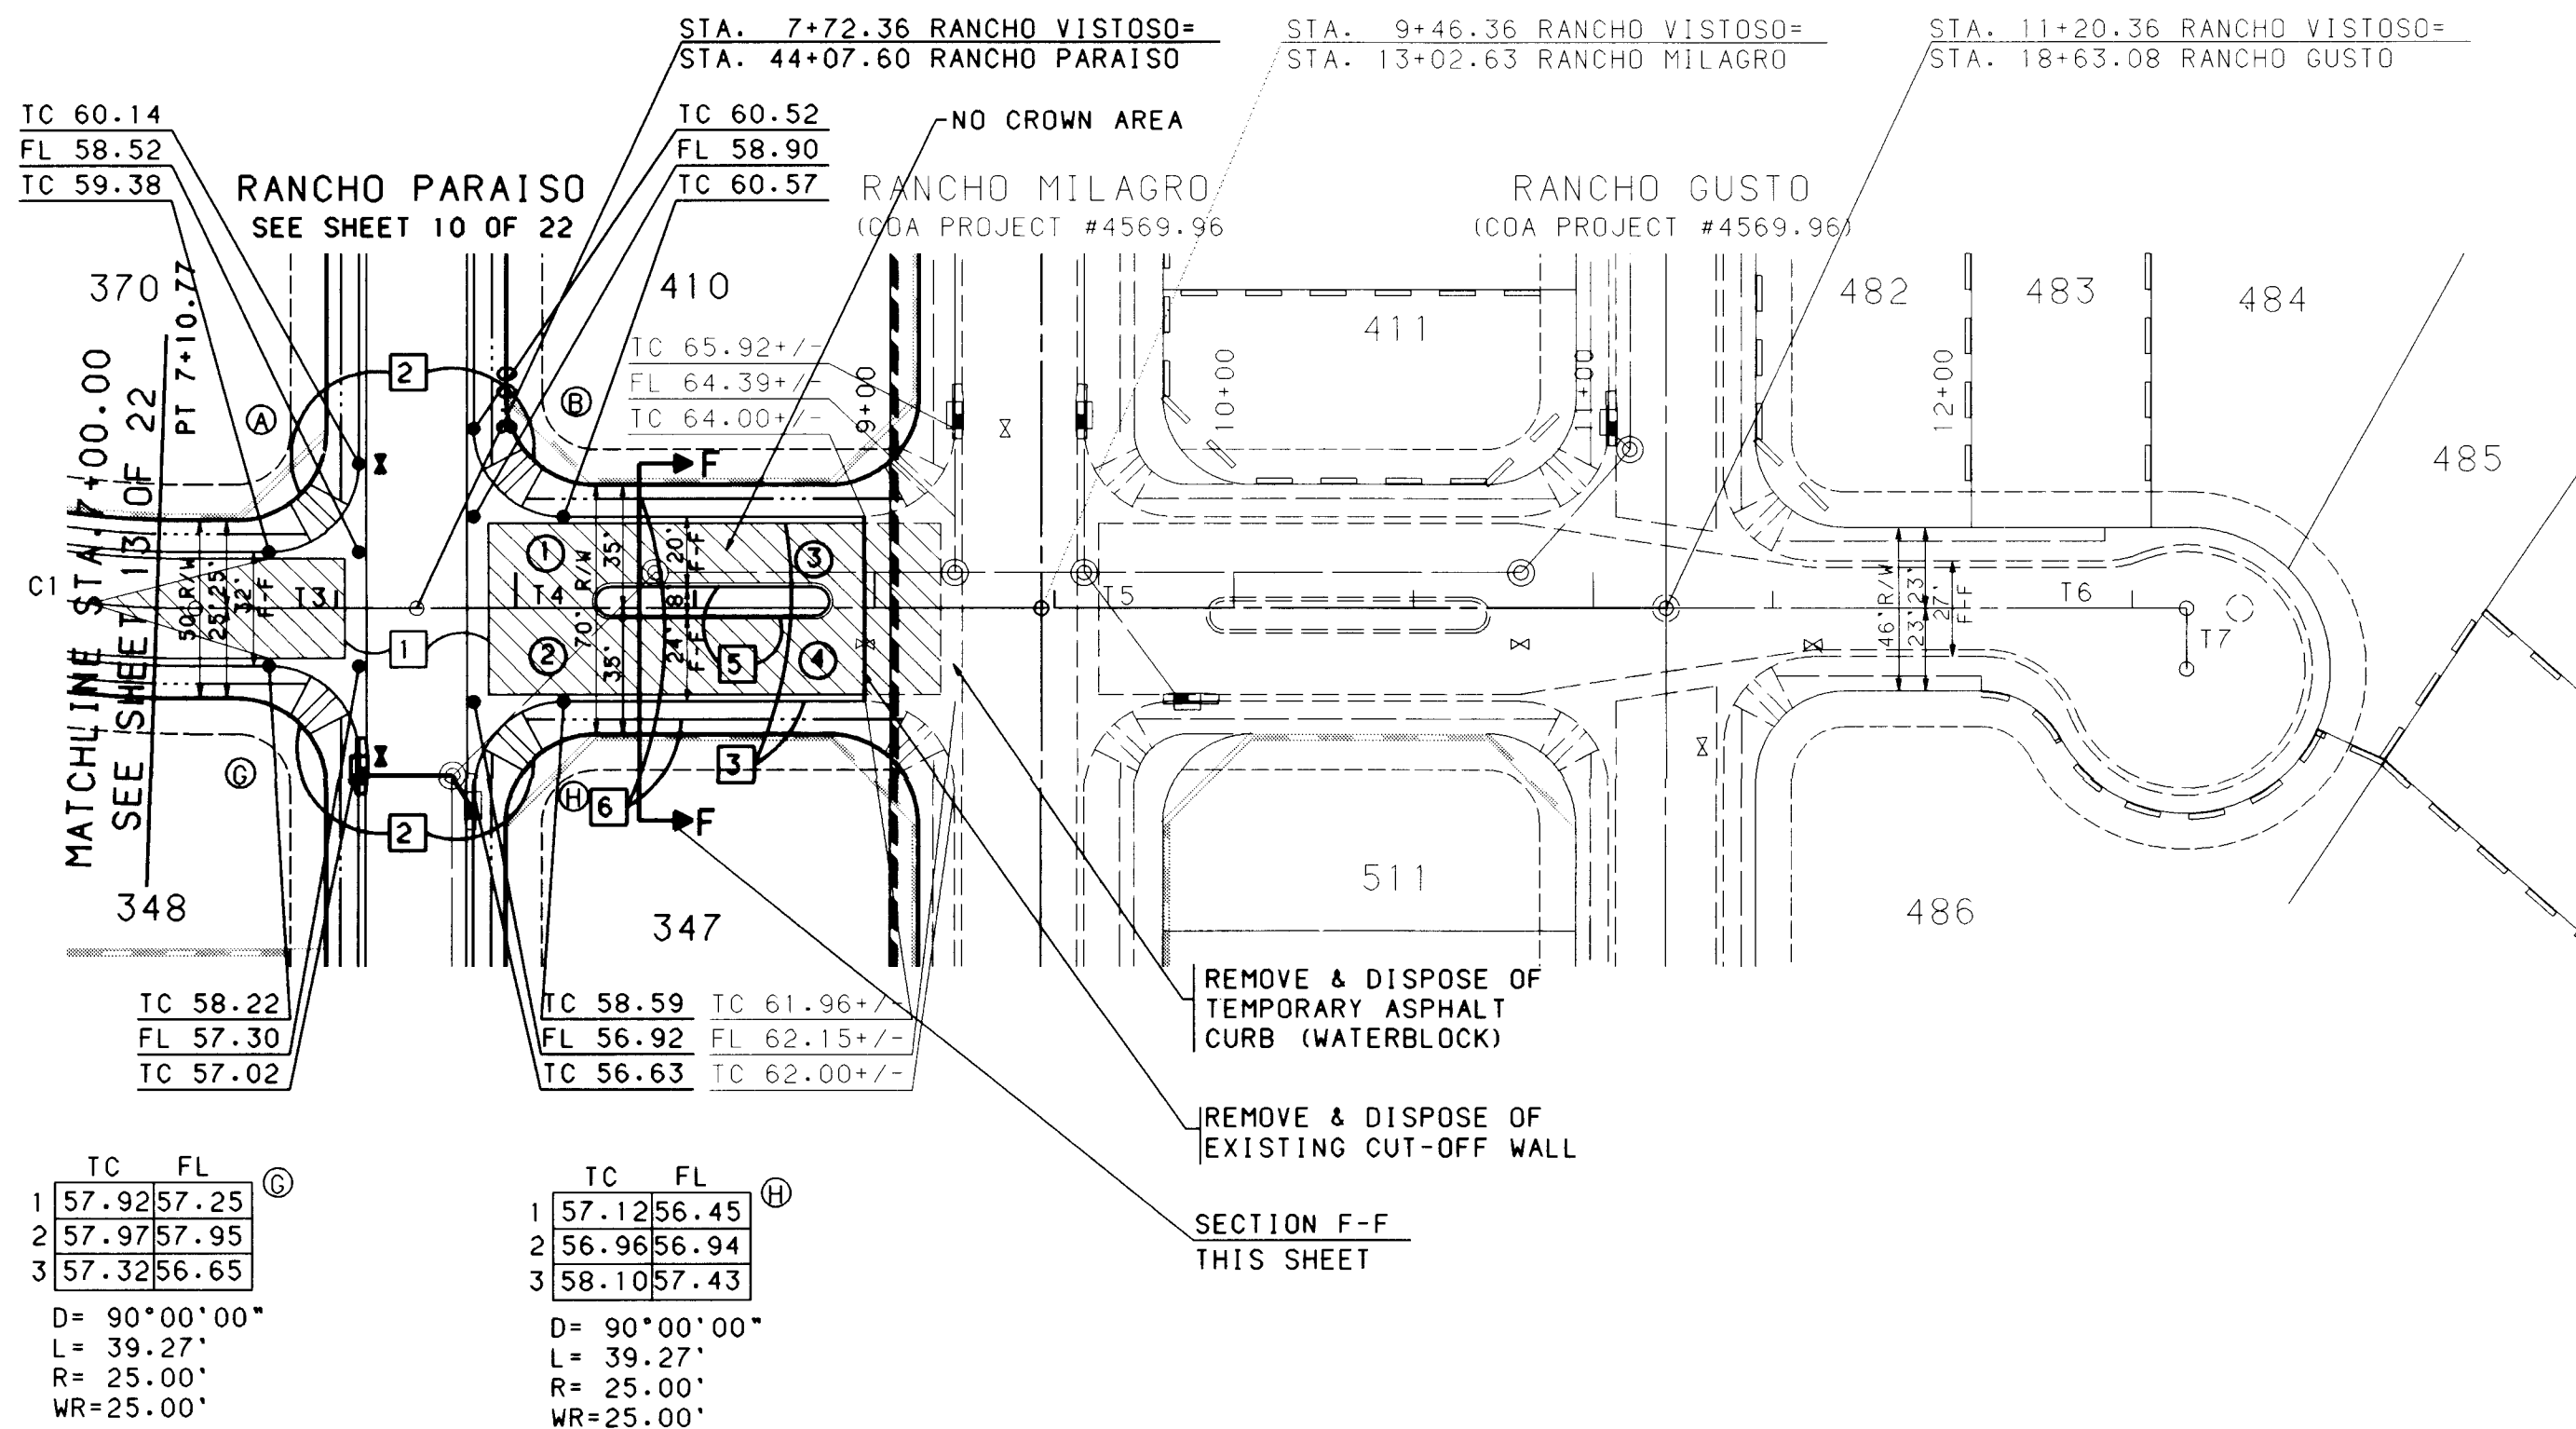

CENTERLINE CURVE DATA					
NUMBER	PI STA.	DELTA	DEGREE	TANGENT	RADIUS
C1	6+30.09	31°39' 0.8"	19° 5'55"	85.03'	165.72'

TANGENT DATA		
NUMBER	BEARING	DISTANCE
T3	N45°21'07"E	61.58'
T4	N45°21'07"E	174.01'
T5	N45°21'07"E	174.00'
T6	N45°21'07"E	144.81'
T7	S44°38'53"E	17.00'

MEDIAN CURB DATA		
PT	TC	STATION & OFFSET
①	60.31	8+26.36, 6' LT.
②	59.98	8+26.36, 2' RT.
③	62.59	8+83.36, 6' LT.
④	62.26	8+83.36, 2' RT.

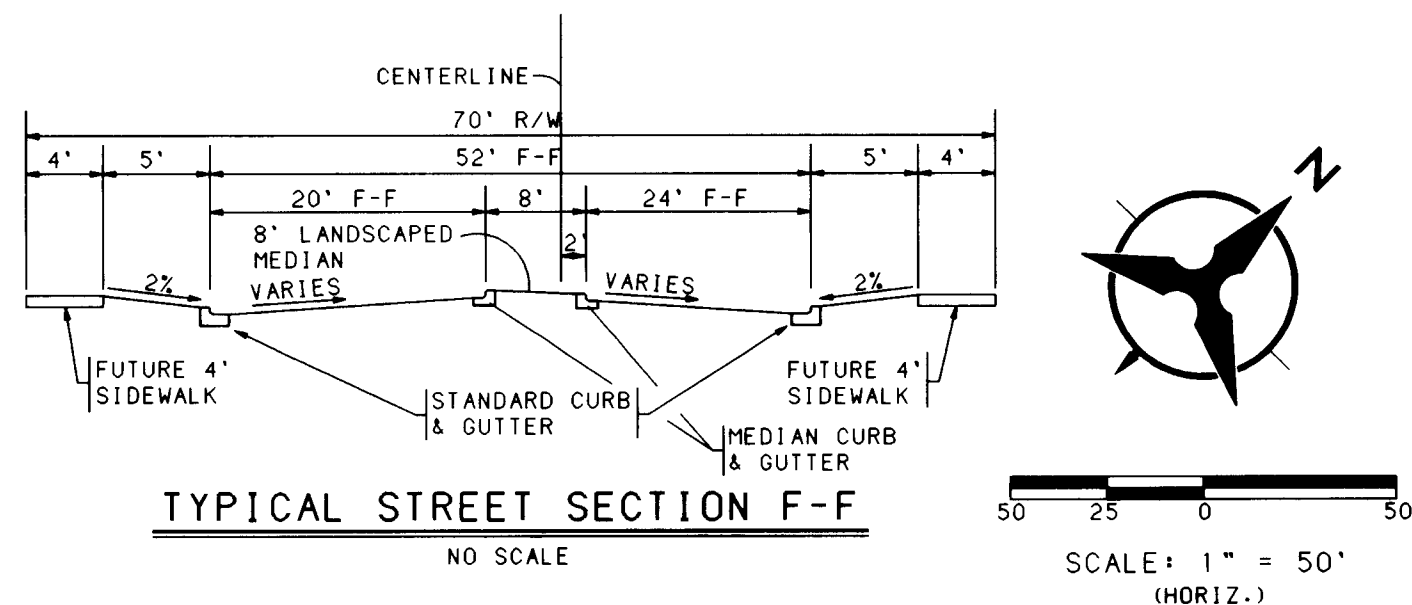

NOTES

1. THE CONTRACTOR SHALL FIELD VERIFY ALL EXISTING UTILITY LOCATIONS AND NOTIFY THE ENGINEER IMMEDIATELY OF ANY DISCREPANCIES.
2. ALL CURB RETURN RADII SHALL BE 25' TO FACE OF CURB UNLESS OTHERWISE SPECIFIED.
3. ALL CURVE DATA AND DIMENSIONS REFER TO FACE OF CURB UNLESS OTHERWISE SPECIFIED.
4. GRADE ELEVATIONS, WHERE NOTED, ARE FOR TOP OF STANDARD CURB UNLESS OTHERWISE SPECIFIED.
5. CONTRACTOR IS TO INSTALL A 4"x4"x5" POST AND EMD AT THE END OF EACH SANITARY SEWER SERVICE.
6. CONTRACTOR IS RESPONSIBLE FOR REPAIR AND/OR REPLACEMENT OF ALL UTILITY CONDUITS AND EXISTING LINES.
7. ANY ADDITIONAL GRADING REQUIRED TO MATCH PROPOSED STREET GRADES SHALL BE INCIDENTAL TO PAVING ITEMS.
8. CONTRACTOR SHALL PROVIDE THE INSPECTORS, (CITY AND PRIVATE) WITH THE PROPOSED HYDROSTATIC TESTING PLAN. THE PLAN MUST BE APPROVED BEFORE TESTING OPERATIONS BEGIN.
9. CONTRACTOR SHALL PARK EQUIPMENT AND VEHICLES AS NOT TO INTERFERE WITH NORMAL ACTIVITIES OF RESIDENTS OR OTHER CONTRACTORS ON SITE.
10. ANY DAMAGE TO THE EXISTING FACILITIES (CURB AND GUTTER, PAVEMENT, CONDUITS, LANDSCAPING, UTILITY LINES, ETC.) DURING CONSTRUCTION SHALL BE REPLACED AT THE CONTRACTORS EXPENSE.
11. REMOVAL OF THE EXISTING CURB AND GUTTER SHALL BE AS PER COA STD. DWG. 2415 (SAWCUT ONLY).
12. WHEEL CHAIR RAMPS SHALL BE CONSTRUCTED PRIOR TO ACCEPTANCE OF CURB AND GUTTER.
13. THE FOLLOWING PERSONS SHALL BE NOTIFIED AT LEAST TWO BUSINESS DAYS PRIOR TO INSTALLING UTILITY CONDUIT CROSSINGS:

COMPANY PHONE
PNM 848-3374
US WEST 245-6694
GAS CO. 761-7770
JONES 761-6200


KEYED GENERAL NOTES

1. INSTALL CONCRETE VALLEY GUTTER AS PER STD. DWG. 2420 OR 2421
 2. INSTALL WHEEL CHAIR RAMP AS PER STD. DWG. 2441, CASE 11
 3. STD. CURB & GUTTER AS PER STD. DWG. 2415
 4. ROLL CURB & GUTTER AS PER STD. DWG. 2415
 5. MEDIAN CURB & GUTTER AS PER STD. DWG. 2415
 6. FUTURE 4' SIDEWALK
 7. BUILD 4' SIDEWALK
- NOT APPLICABLE THIS SHEET

Record Drawing

I, Rhonda L. Hice, Registered Professional Land Surveyor in the State of New Mexico, do hereby certify that this "as-built" information was obtained by me or under my supervision and represents that "as-built" conditions of this project, and is true and correct to the best of my knowledge and belief. All vertical and horizontal dimensions should be field verified prior to use on future projects.

Rhonda L. Hice
PS NO. 11953

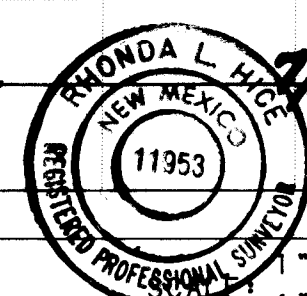

BOHANNAN-HUSTON, INC.
ENGINEERS • PLANNERS • PHOTOGRAMMETRISTS • SURVEYORS • LANDSCAPE ARCHITECTS
ALBUQUERQUE LAS CRUCES SANTA FE

CITY OF ALBUQUERQUE
PUBLIC WORKS DEPARTMENT
ENGINEERING DEVELOPMENT GROUP


RANCHO SERENO SUBDIVISION - UNIT V
PAVING PLAN & PROFILE
RANCHO VISTOSO STA. 7+00.00 - 12+95.76

DESIGN REVIEW COMMITTEE	CITY ENGINEER APPROVAL	MO/DAY/YR	MO/DAY/YR
APPROVED			

CITY PROJECT NO. **456997** ZONE MAP NO. **C-12** SHEET **14** OF **22**



Copyright Bohannon-Huston, Inc. 1996
DATE: DECEMBER, 1997

SCANNED BY
BY LASON

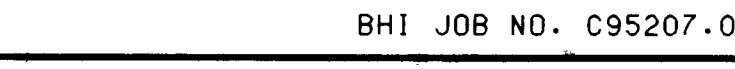

SCANNED BY
BY LASON

SCANNED BY
BY LASON

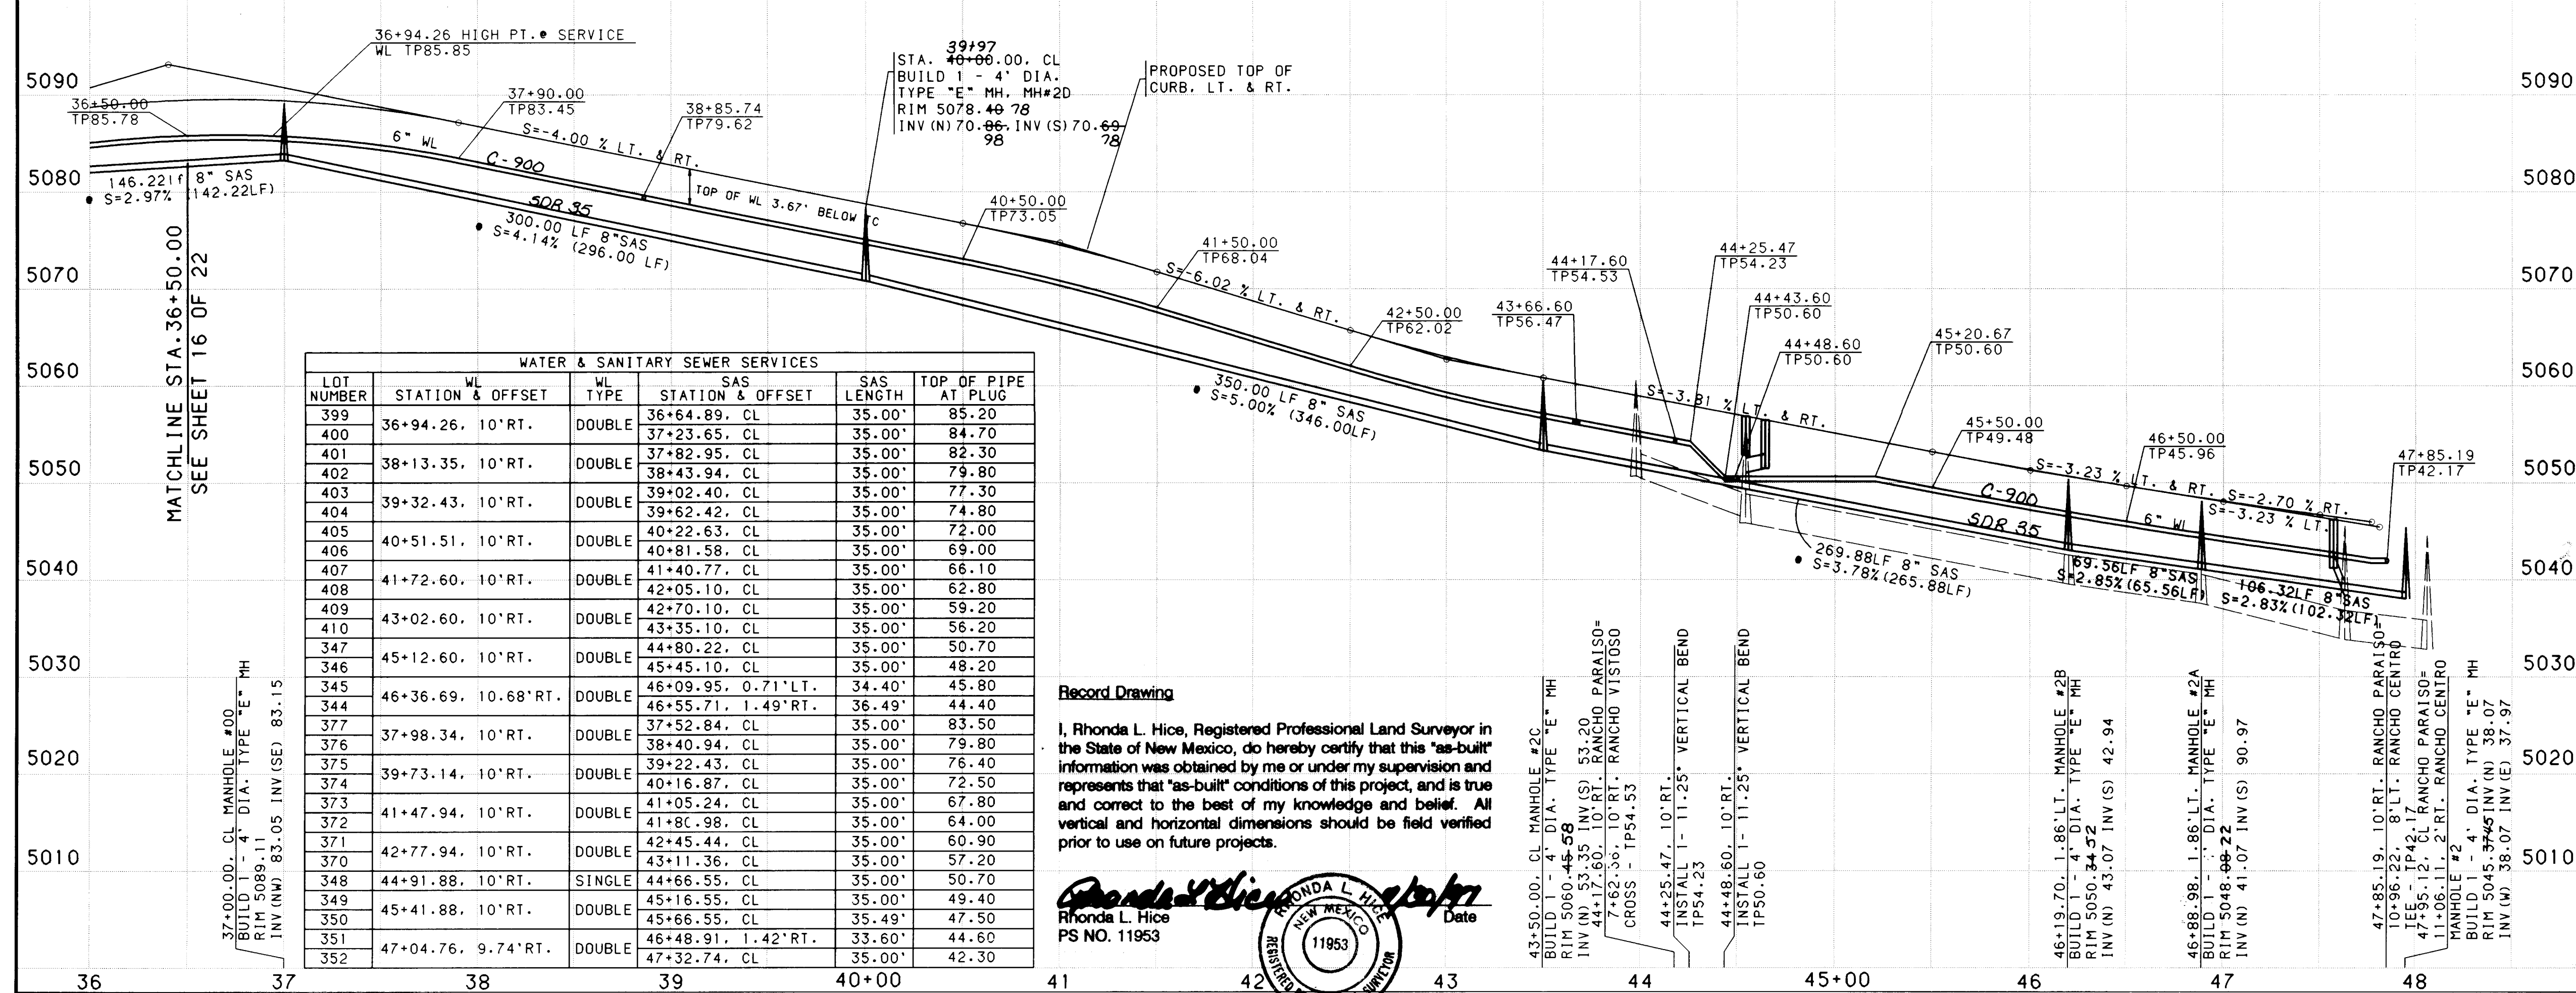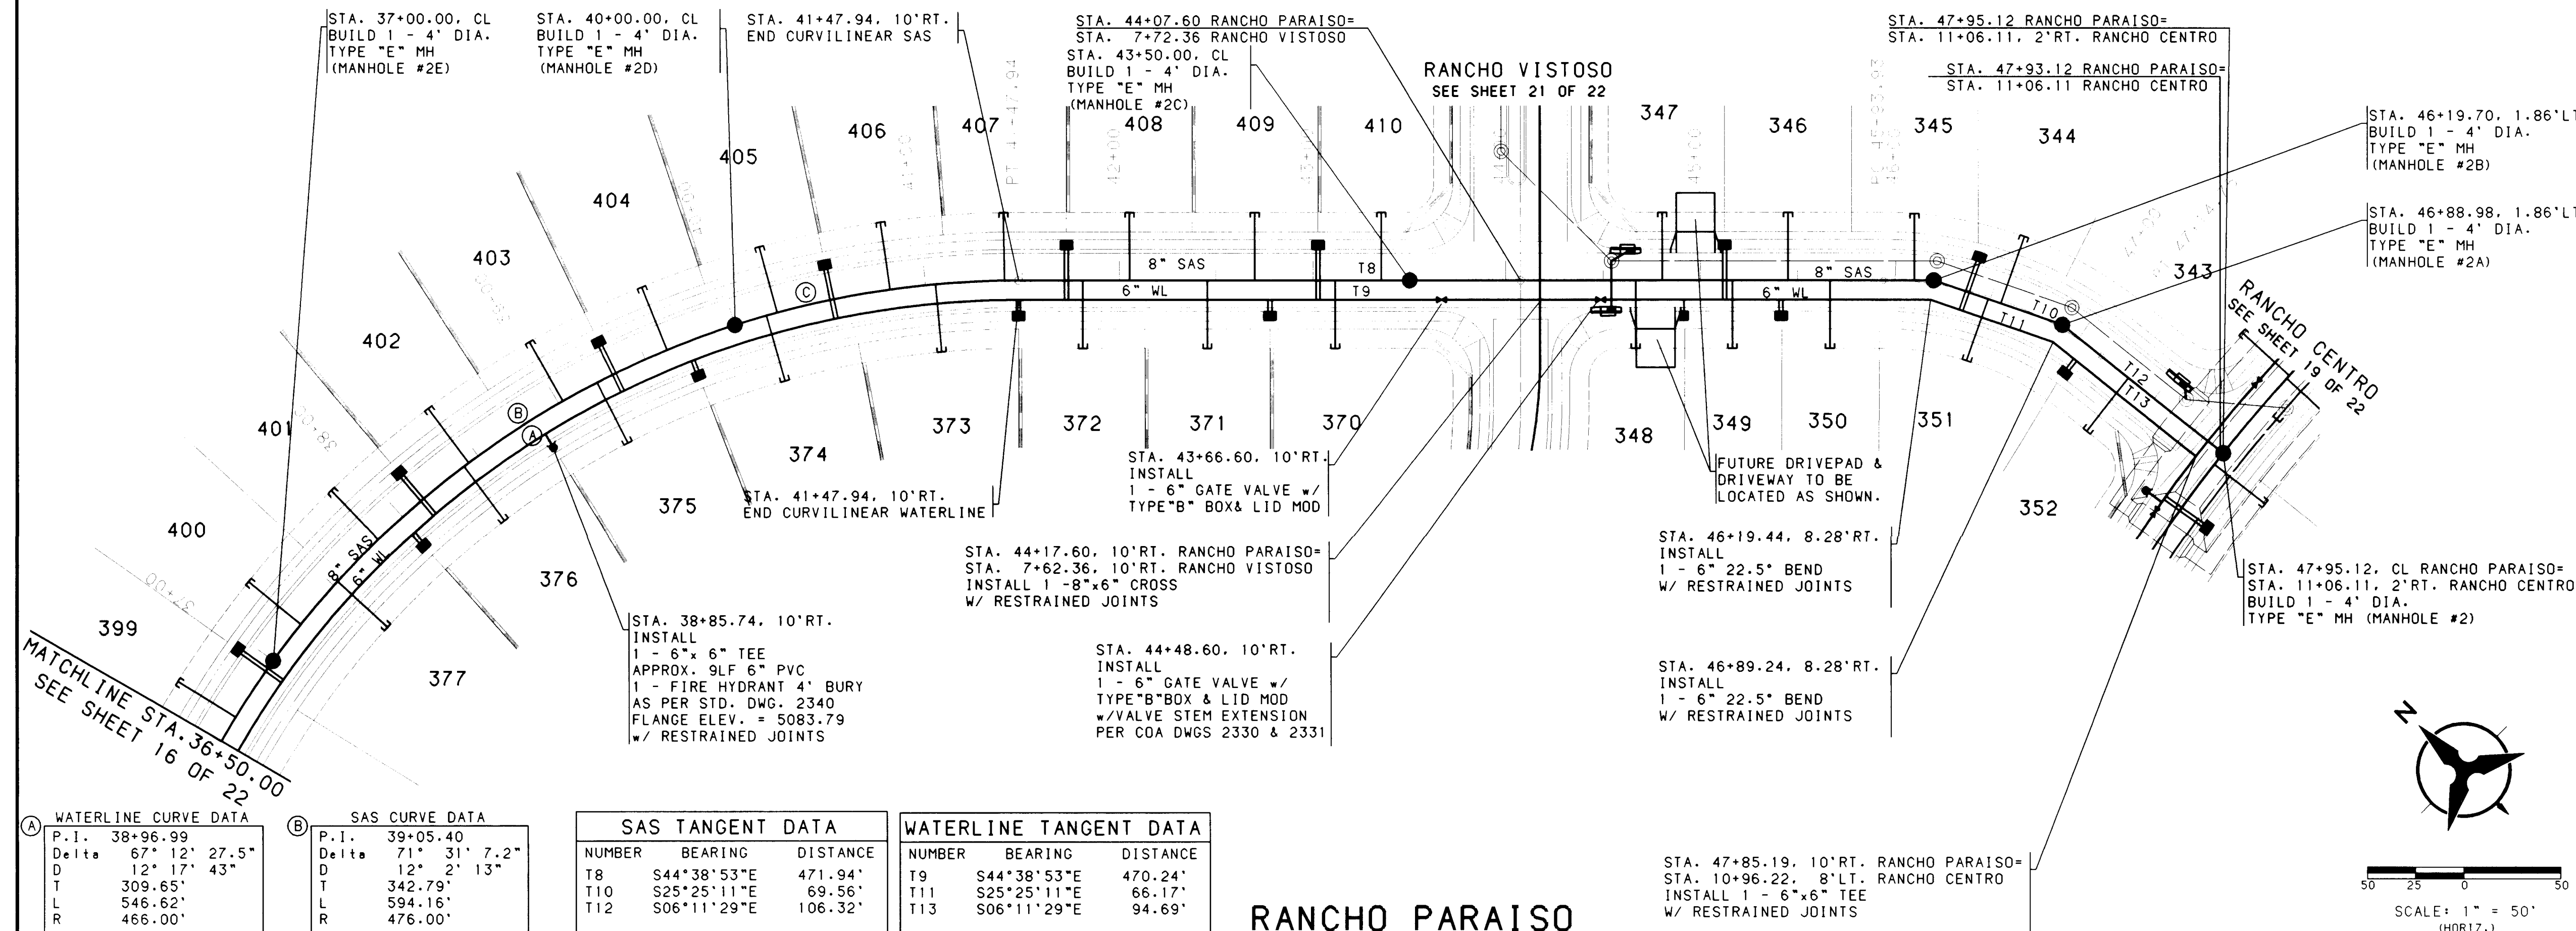


USERNAME: CDP[C96436A2400.PAD]
FILENAME: PARAIISO.GRF

Record Drawing

I, Rhonda L. Hice, Registered Professional Land Surveyor in the State of New Mexico, do hereby certify that this "as-built" information was obtained by me or under my supervision and represents that "as-built" conditions of this project, and is true and correct to the best of my knowledge and belief. All vertical and horizontal dimensions should be field verified prior to use on future projects.

Rhonda L. Hice
PS NO. 11953

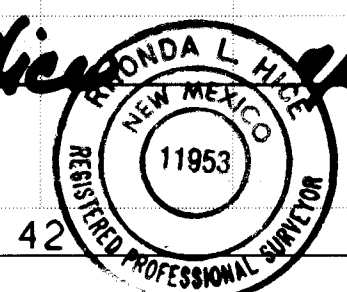

- NOTES**
1. THE CONTRACTOR SHALL FIELD VERIFY ALL EXISTING UTILITY LOCATIONS AND NOTIFY THE ENGINEER IMMEDIATELY OF ANY DISCREPANCIES.
 2. ALL CURB RETURN RADII SHALL BE 25' TO FACE OF CURB UNLESS OTHERWISE SPECIFIED.
 3. ALL CURVE DATA AND DIMENSIONS REFER TO FACE OF CURB UNLESS OTHERWISE SPECIFIED.
 4. GRADE ELEVATIONS, WHERE NOTED, ARE FOR TOP OF STANDARD CURB UNLESS OTHERWISE SPECIFIED.
 5. CONTRACTOR IS TO INSTALL A 4"x4"x5' POST AND END AT THE END OF EACH SANITARY SEWER SERVICE.
 6. CONTRACTOR IS RESPONSIBLE FOR REPAIR AND/OR REPLACEMENT OF ALL UTILITY CONDUITS AND EXISTING LINES.
 7. ANY ADDITIONAL GRADING REQUIRED TO MATCH PROPOSED STREET GRADES SHALL BE INCIDENTAL TO PAVING ITEMS.
 8. CONTRACTOR SHALL PROVIDE THE INSPECTORS, (CITY AND PRIVATE) WITH THE PROPOSED HYDROSTATIC TESTING PLAN. THE PLAN MUST BE APPROVED BEFORE TESTING OPERATIONS BEGIN.
 9. CONTRACTOR SHALL PARK EQUIPMENT AND VEHICLES AS NOT TO INTERFERE WITH NORMAL ACTIVITIES OF RESIDENTS OR OTHER CONTRACTORS ON SITE.
 10. ANY DAMAGE TO THE EXISTING FACILITIES (CURB AND GUTTER, PAVEMENT, CONDUITS, LANDSCAPING, UTILITY LINES, ETC.) DURING CONSTRUCTION SHALL BE REPLACED AT THE CONTRACTORS EXPENSE.
 11. REMOVAL OF THE EXISTING CURB AND GUTTER SHALL BE AS PER COA STD. DWG. 2415 (SAWCUT ONLY).
 12. WHEEL CHAIR RAMPS SHALL BE CONSTRUCTED PRIOR TO ACCEPTANCE OF CURB AND GUTTER.
 13. THE FOLLOWING PERSONS SHALL BE NOTIFIED AT LEAST TWO BUSINESS DAYS PRIOR TO INSTALLING UTILITY CONDUIT CROSSINGS:

COMPANY PHONE
PNM 848-3374
US WEST 245-6694
GAS CO. 761-7770
JONES 761-6200

14. FOR RESTRAINED JOINTS, SEE TABLE - SHEET 15 OF 22 (TYP).
15. FIRE HYDRANTS RESTRAINED FROM DISTRIBUTION LINE TO FLANGE (TYP).
16. MATERIALS FOR UTILITIES SHALL BE THE FOLLOWING:
WATER: C900 PVC
SANITARY: SDR35 PVC
STORM: RCP III
17. ADJUST ALL EXISTING MH RIM ELEVATIONS AS NEEDED.

BOHANNAN-HUSTON INC.
ENGINEERS • PLANNERS • PHOTOGRAMMETRISTS • SURVEYORS • LANDSCAPE ARCHITECTS
ALBUQUERQUE LAS CRUCES SANTA FE

CITY OF ALBUQUERQUE
PUBLIC WORKS DEPARTMENT
ENGINEERING DEVELOPMENT GROUP



RANCHO SERENO SUBDIVISION - UNIT V
UTILITY PLAN & PROFILE
RANCHO PARAIISO STA. 36+50.00 - 47+95.12

DESIGN REVIEW COMMITTEE CITY ENGINEER APPROVAL
DATE: 11/96

LAST DESIGN UPDATE: 11/96
SHEET 17 OF 22

CITY PROJECT NO. 456997 ZONE MAP NO. C-12
Copyright Bohannon-Huston, Inc. 1995
DATE: DECEMBER, 1996

SCANNED BY
BY LASON

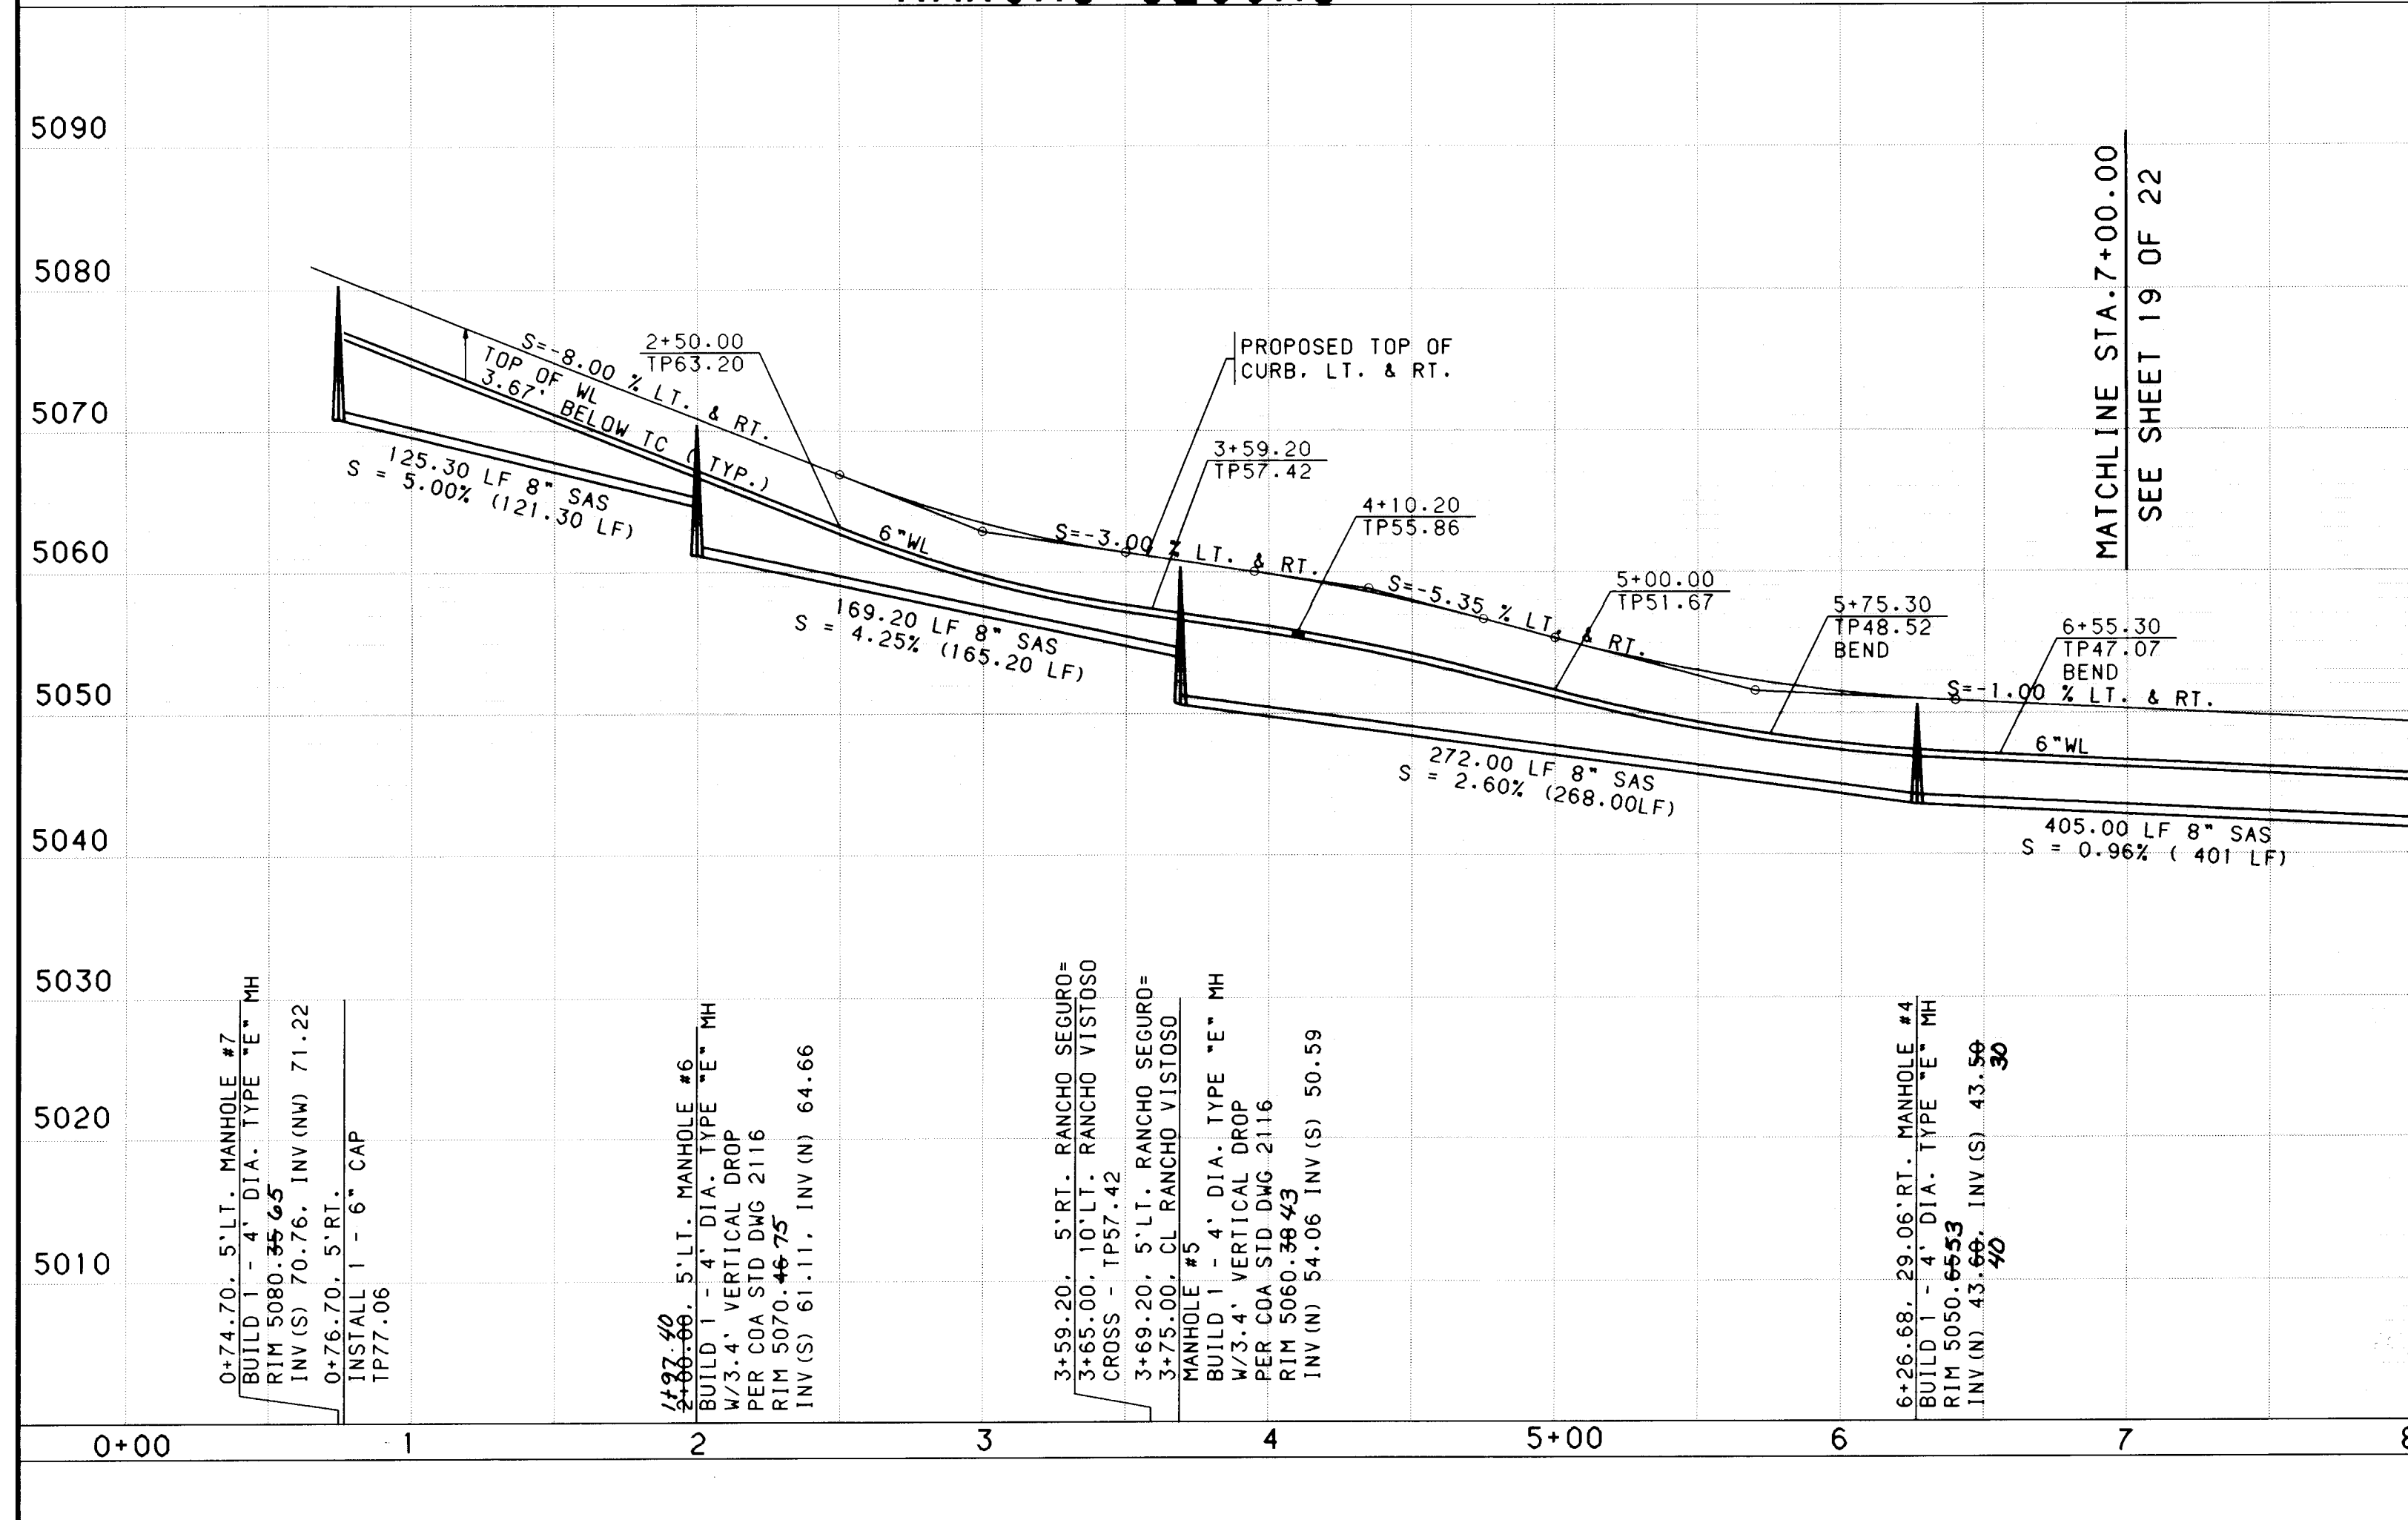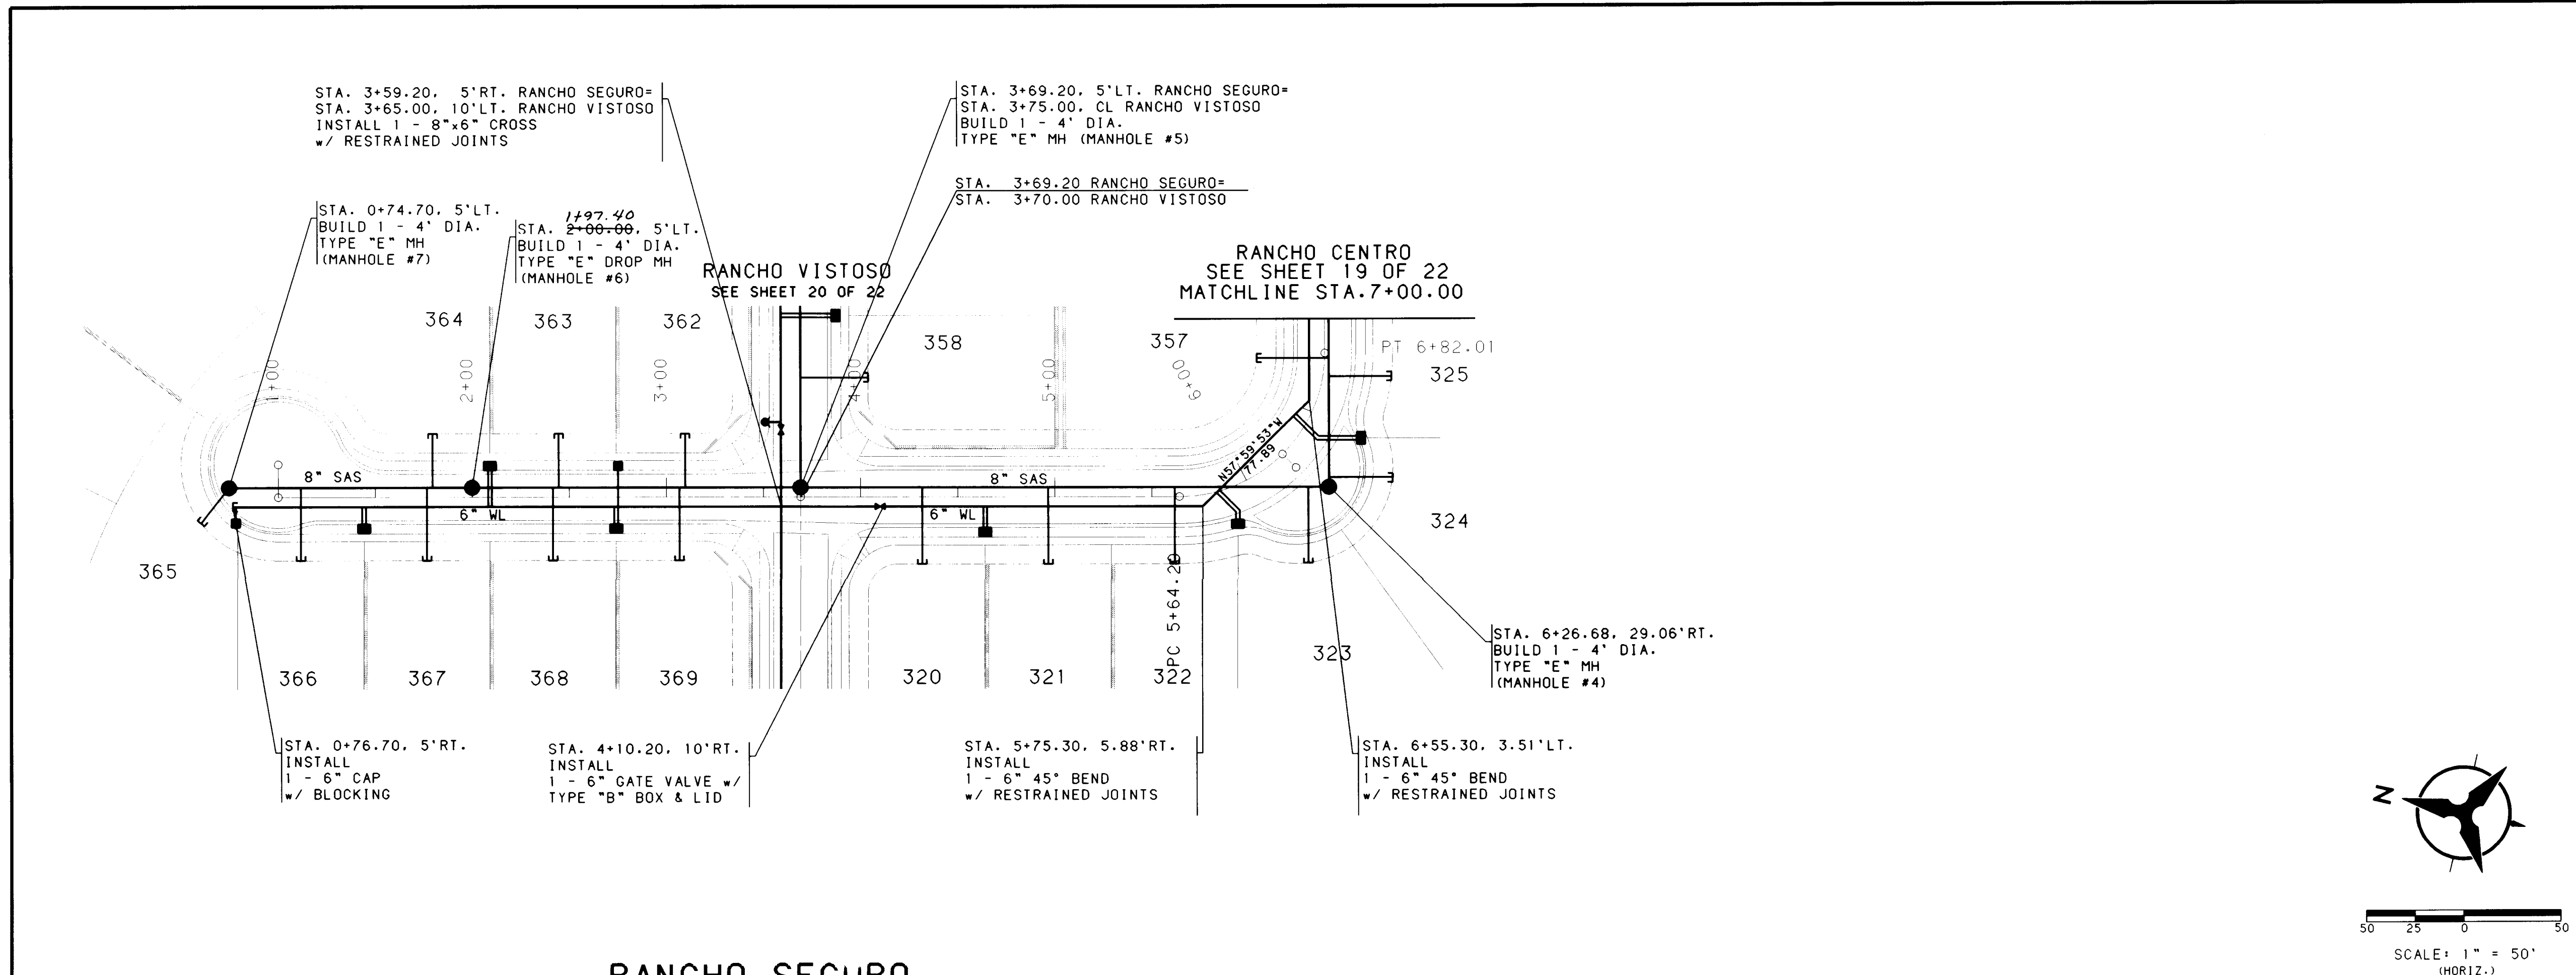

WATER & SANITARY SEWER SERVICES					
LOT NUMBER	STATION & OFFSET	WL TYPE	SAS STATION & OFFSET	SAS LENGTH	TOP OF PIPE AT PLUG
362	2+74.20, 5' RT.	SINGLE	3+09.70, 5' LT.	28.00'	58.20
363	2+09.20, 5' RT.	DOUBLE	2+44.70, 5' LT.	28.00'	61.40
364	0+79.20, 5' RT.	SINGLE	1+79.70, 5' LT.	28.00'	67.50
365	0+79.20, 5' RT.	SINGLE	0+74.70, 5' LT. MH	23.33'	72.50
366	1+44.20, 5' RT.	DOUBLE	1+11.70, 5' LT.	38.00'	71.20
367	2+74.20, 5' RT.	DOUBLE	1+76.70, 5' LT.	38.00'	67.70
368	2+74.20, 5' RT.	DOUBLE	2+41.70, 5' LT.	38.00'	61.60
369	2+74.20, 5' RT.	DOUBLE	3+06.70, 5' LT.	38.00'	58.40
320	4+64.20, 5' RT.	DOUBLE	4+31.70, 5' LT.	40.00'	51.50
321	4+64.20, 5' RT.	DOUBLE	4+96.70, 5' LT.	40.00'	49.70
322	5+84.14, 0.12' LT.	DOUBLE	5+61.70, 5' LT.	40.00'	47.70
323	6+44.36, 7.30' LT.	DOUBLE	6+21.05, 21.38' RT.	39.61'	46.10
324	6+44.36, 7.30' LT.	DOUBLE	6+29.43, 25.77' RT.	32.75'	45.70
325	6+44.36, 7.30' LT.	DOUBLE	6+70.31, 2.95' RT.	32.33'	45.30
365	SEE SHEET 19 OF 22	-----	6+79.58, 2.04' RT.	37.08'	45.50

NOTES

- THE CONTRACTOR SHALL FIELD VERIFY ALL EXISTING UTILITY LOCATIONS AND NOTIFY THE ENGINEER IMMEDIATELY OF ANY DISCREPANCIES.
- ALL CURB RETURN RADII SHALL BE 25' TO FACE OF CURB UNLESS OTHERWISE SPECIFIED.
- ALL CURVE DATA AND DIMENSIONS REFER TO FACE OF CURB UNLESS OTHERWISE SPECIFIED.
- GRADE ELEVATIONS, WHERE NOTED, ARE FOR TOP OF STANDARD CURB UNLESS OTHERWISE SPECIFIED.
- CONTRACTOR IS TO INSTALL A 4"x4"x5' POST AND END AT THE END OF EACH SANITARY SEWER SERVICE.
- CONTRACTOR IS RESPONSIBLE FOR REPAIR AND/OR REPLACEMENT OF ALL UTILITY CONDUITS AND EXISTING LINES.
- ANY ADDITIONAL GRADING REQUIRED TO MATCH PROPOSED STREET GRADES SHALL BE INCIDENTAL TO PAVING ITEMS.
- CONTRACTOR SHALL PROVIDE THE INSPECTORS, (CITY AND PRIVATE) WITH THE PROPOSED HYDROSTATIC TESTING PLAN. THE PLAN MUST BE APPROVED BEFORE TESTING OPERATIONS BEGIN.
- CONTRACTOR SHALL PARK EQUIPMENT AND VEHICLES AS NOT TO INTERFERE WITH NORMAL ACTIVITIES OF RESIDENTS OR OTHER CONTRACTORS ON SITE.
- ANY DAMAGE TO THE EXISTING FACILITIES (CURB AND GUTTER, PAVEMENT, CONDUITS, LANDSCAPING, UTILITY LINES, ETC.) DURING CONSTRUCTION SHALL BE REPLACED AT THE CONTRACTORS EXPENSE.
- REMOVAL OF THE EXISTING CURB AND GUTTER SHALL BE AS PER COA STD. DWG. 2415 (SAWCUT ONLY).
- WHEEL CHAIR RAMPS SHALL BE CONSTRUCTED PRIOR TO ACCEPTANCE OF CURB AND GUTTER.
- THE FOLLOWING PERSONS SHALL BE NOTIFIED AT LEAST TWO BUSINESS DAYS PRIOR TO INSTALLING UTILITY CONDUIT CROSSINGS:

COMPANY	PHONE
PNM	848-3374
US WEST	245-6694
GAS CO.	761-7770
JONES	761-6200
- FOR RESTRAINED JOINTS, SEE TABLE - SHEET 15 OF 22 (TYP).
- FIRE HYDRANTS RESTRAINED FROM DISTRIBUTION LINE TO FLANGE (TYP).
- MATERIALS FOR UTILITIES SHALL BE THE FOLLOWING:
WATER: C900 PVC
SANITARY: SDR35 PVC
STORM: RCP III
- ADJUST ALL EXISTING MH RIM ELEVATIONS AS NEEDED.

AS-BUILT INFORMATION

CONTRACTOR: *New Concepts Inc.*

STATION MARK IS A STANDARD USCS BRASS TABLET, STAMPED "HUGHES, 1954", SET IN TOP OF A CONCRETE POST PROJECTING 0.3 FT. ABOVE THE GROUND. TO REACH THE STATION FROM THE INTERSECTION OF CENTRAL AVE. AND STATE RD. 448, GO NORTH ON STATE RD. 448, 6.1 MILES. THE STATION IS 450' WEST OF STATE RD. 448 IN A FENCED-IN PRAIRIE. ELEV. = 5049.93

FIELD NOTES

NO.	DATE	BY

ENGINEER'S SEAL

JAMES R. TOPMILLER
NEW MEXICO
REGISTERED PROFESSIONAL ENGINEER
9354

James R. Topmiller

NO.	DATE	REMARKS

DESIGNED BY: MSJ
DRAWN BY: DR. SAR
CHECKED BY: JRT

DATE: 11/96
DATE: 11/96
DATE: 11/96

BOHANNAN-HUSTON INC.
ENGINEERS • PLANNERS • PHOTOGRAMMETRISTS • SURVEYORS • LANDSCAPE ARCHITECTS
ALBUQUERQUE LAS CRUCES SANTA FE

CITY OF ALBUQUERQUE
PUBLIC WORKS DEPARTMENT
ENGINEERING DEVELOPMENT GROUP


RANCHO SERENO SUBDIVISION - UNIT V
UTILITY PLAN & PROFILE
RANCHO SEGURO STA. 1+00.00 - 7+00.00

DESIGN REVIEW COMMITTEE
CITY ENGINEER APPROVAL

LAST DESIGN UPDATE
MO/DAY/YR MO/DAY/YR

CITY PROJECT NO. **456997** ZONE MAP NO. **C-12** SHEET **18** OF **22**

DATE: **7/31/97**

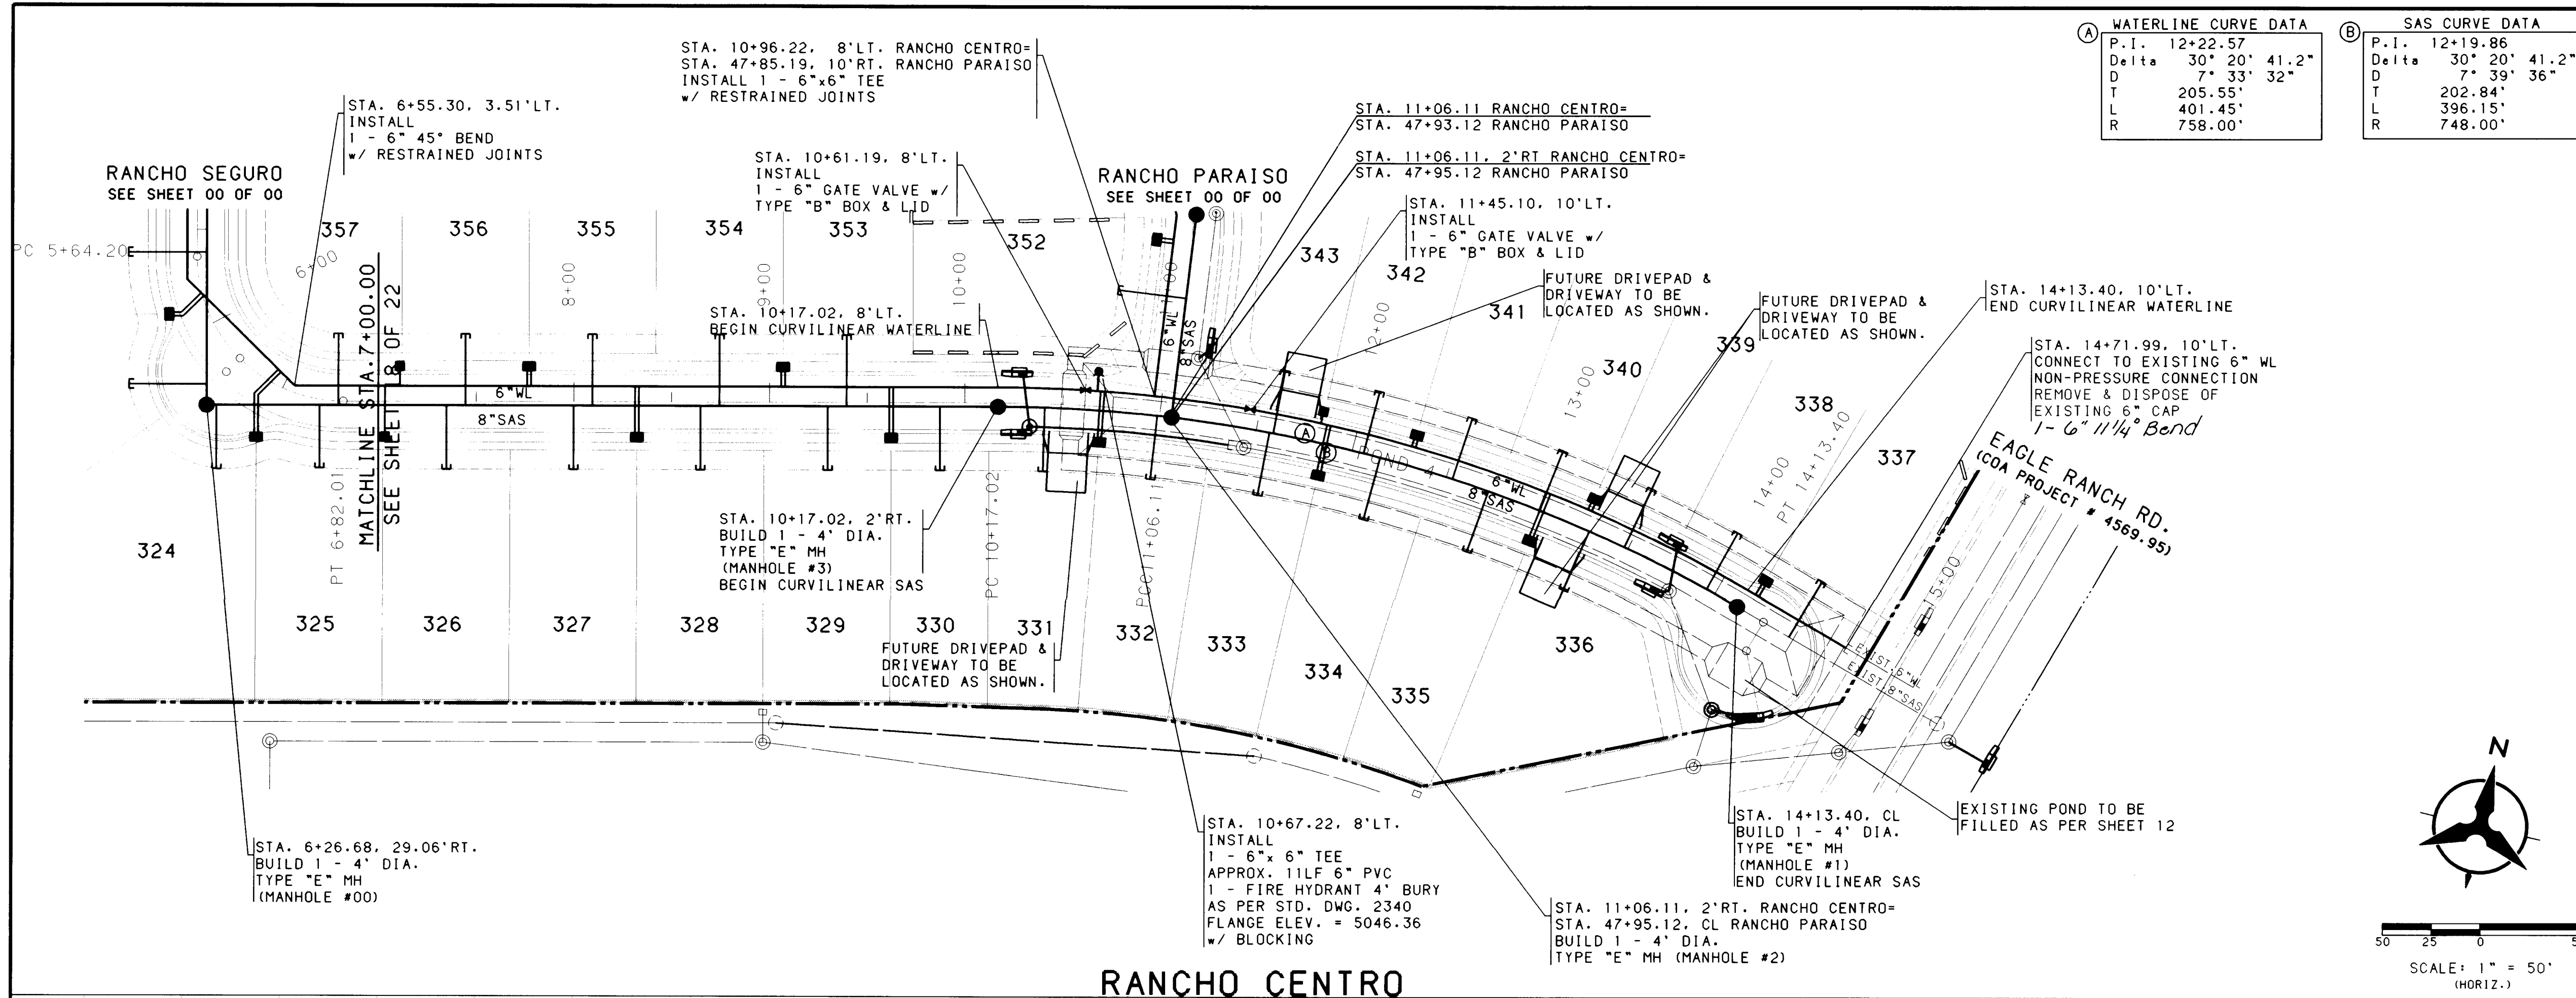

NOTES

- THE CONTRACTOR SHALL FIELD VERIFY ALL EXISTING UTILITY LOCATIONS AND NOTIFY THE ENGINEER IMMEDIATELY OF ANY DISCREPANCIES.
- ALL CURB RETURN RADII SHALL BE 25' TO FACE OF CURB UNLESS OTHERWISE SPECIFIED.
- ALL CURVE DATA AND DIMENSIONS REFER TO FACE OF CURB UNLESS OTHERWISE SPECIFIED.
- GRADE ELEVATIONS, WHERE NOTED, ARE FOR TOP OF STANDARD CURB UNLESS OTHERWISE SPECIFIED.
- CONTRACTOR IS TO INSTALL A 4"x4"x5' POST AND END AT THE END OF EACH SANITARY SEWER SERVICE.
- CONTRACTOR IS RESPONSIBLE FOR REPAIR AND/OR REPLACEMENT OF ALL UTILITY CONDUITS AND EXISTING LINES.
- ANY ADDITIONAL GRADING REQUIRED TO MATCH PROPOSED STREET GRADES SHALL BE INCIDENTAL TO PAVING ITEMS.
- CONTRACTOR SHALL PROVIDE THE INSPECTORS (CITY AND PRIVATE) WITH THE PROPOSED HYDROSTATIC TESTING PLAN. THE PLAN MUST BE APPROVED BEFORE TESTING OPERATIONS BEGIN.
- CONTRACTOR SHALL PARK EQUIPMENT AND VEHICLES AS NOT TO INTERFERE WITH NORMAL ACTIVITIES OF RESIDENTS OR OTHER CONTRACTORS ON SITE.
- ANY DAMAGE TO THE EXISTING FACILITIES (CURB AND GUTTER, PAVEMENT, CONDUITS, LANDSCAPING, UTILITY LINES, ETC.) DURING CONSTRUCTION SHALL BE REPLACED AT THE CONTRACTORS EXPENSE.
- REMOVAL OF THE EXISTING CURB AND GUTTER SHALL BE AS PER COA STD. DWG. 2415 (SAWCUT ONLY).
- WHEEL CHAIR RAMPS SHALL BE CONSTRUCTED PRIOR TO ACCEPTANCE OF CURB AND GUTTER.
- THE FOLLOWING PERSONS SHALL BE NOTIFIED AT LEAST TWO BUSINESS DAYS PRIOR TO INSTALLING UTILITY CONDUIT CROSSINGS:

COMPANY	PHONE
PNM	848-3374
US WEST	245-6694
GAS CO.	761-7770
JONES	761-6200
- FOR RESTRAINED JOINTS, SEE TABLE - SHEET 15 OF 22 (TYP).
- FIRE HYDRANTS RESTRAINED FROM DISTRIBUTION LINE TO FLANGE (TYP).
- MATERIALS FOR UTILITIES SHALL BE THE FOLLOWING:
WATER - C900 PVC
SANITARY SEWER - SDR35 PVC
STORM - RCP III
- ADJUST ALL EXISTING MH RIM ELEVATIONS AS NEEDED.

AS-BUILT INFORMATION

CONTRACTOR: *New Concepts, Inc.*
INSPECTOR: *J.S. [Signature]*
DATE: *11/20/96*

ENGINEER'S SEAL

James R. Topolnick
11/20/96
REGISTERED PROFESSIONAL ENGINEER
NEW MEXICO
9354

REVISIONS

NO.	DATE	REMARKS
1	11/20/96	DESIGN

BOHANNAN-HUSTON INC.
ENGINEERS • PLANNERS • PHOTOGRAMMETRISTS • SURVEYORS • LANDSCAPE ARCHITECTS
ALBUQUERQUE LAS CRUCES SANTA FE


CITY OF ALBUQUERQUE
PUBLIC WORKS DEPARTMENT
ENGINEERING DEVELOPMENT GROUP

RANCHO SERENO SUBDIVISION - UNIT V
UTILITY PLAN & PROFILE
RANCHO CENTRO STA. 7+00.00 - 14+59.58


CITY ENGINEER APPROVAL: [Signature]
DATE: 11/20/96

LAST DESIGN UPDATE: [Signature]
DATE: 11/20/96


CITY PROJECT NO. **456997**
ZONE MAP NO. **C-12**
SHEET **19** OF **22**

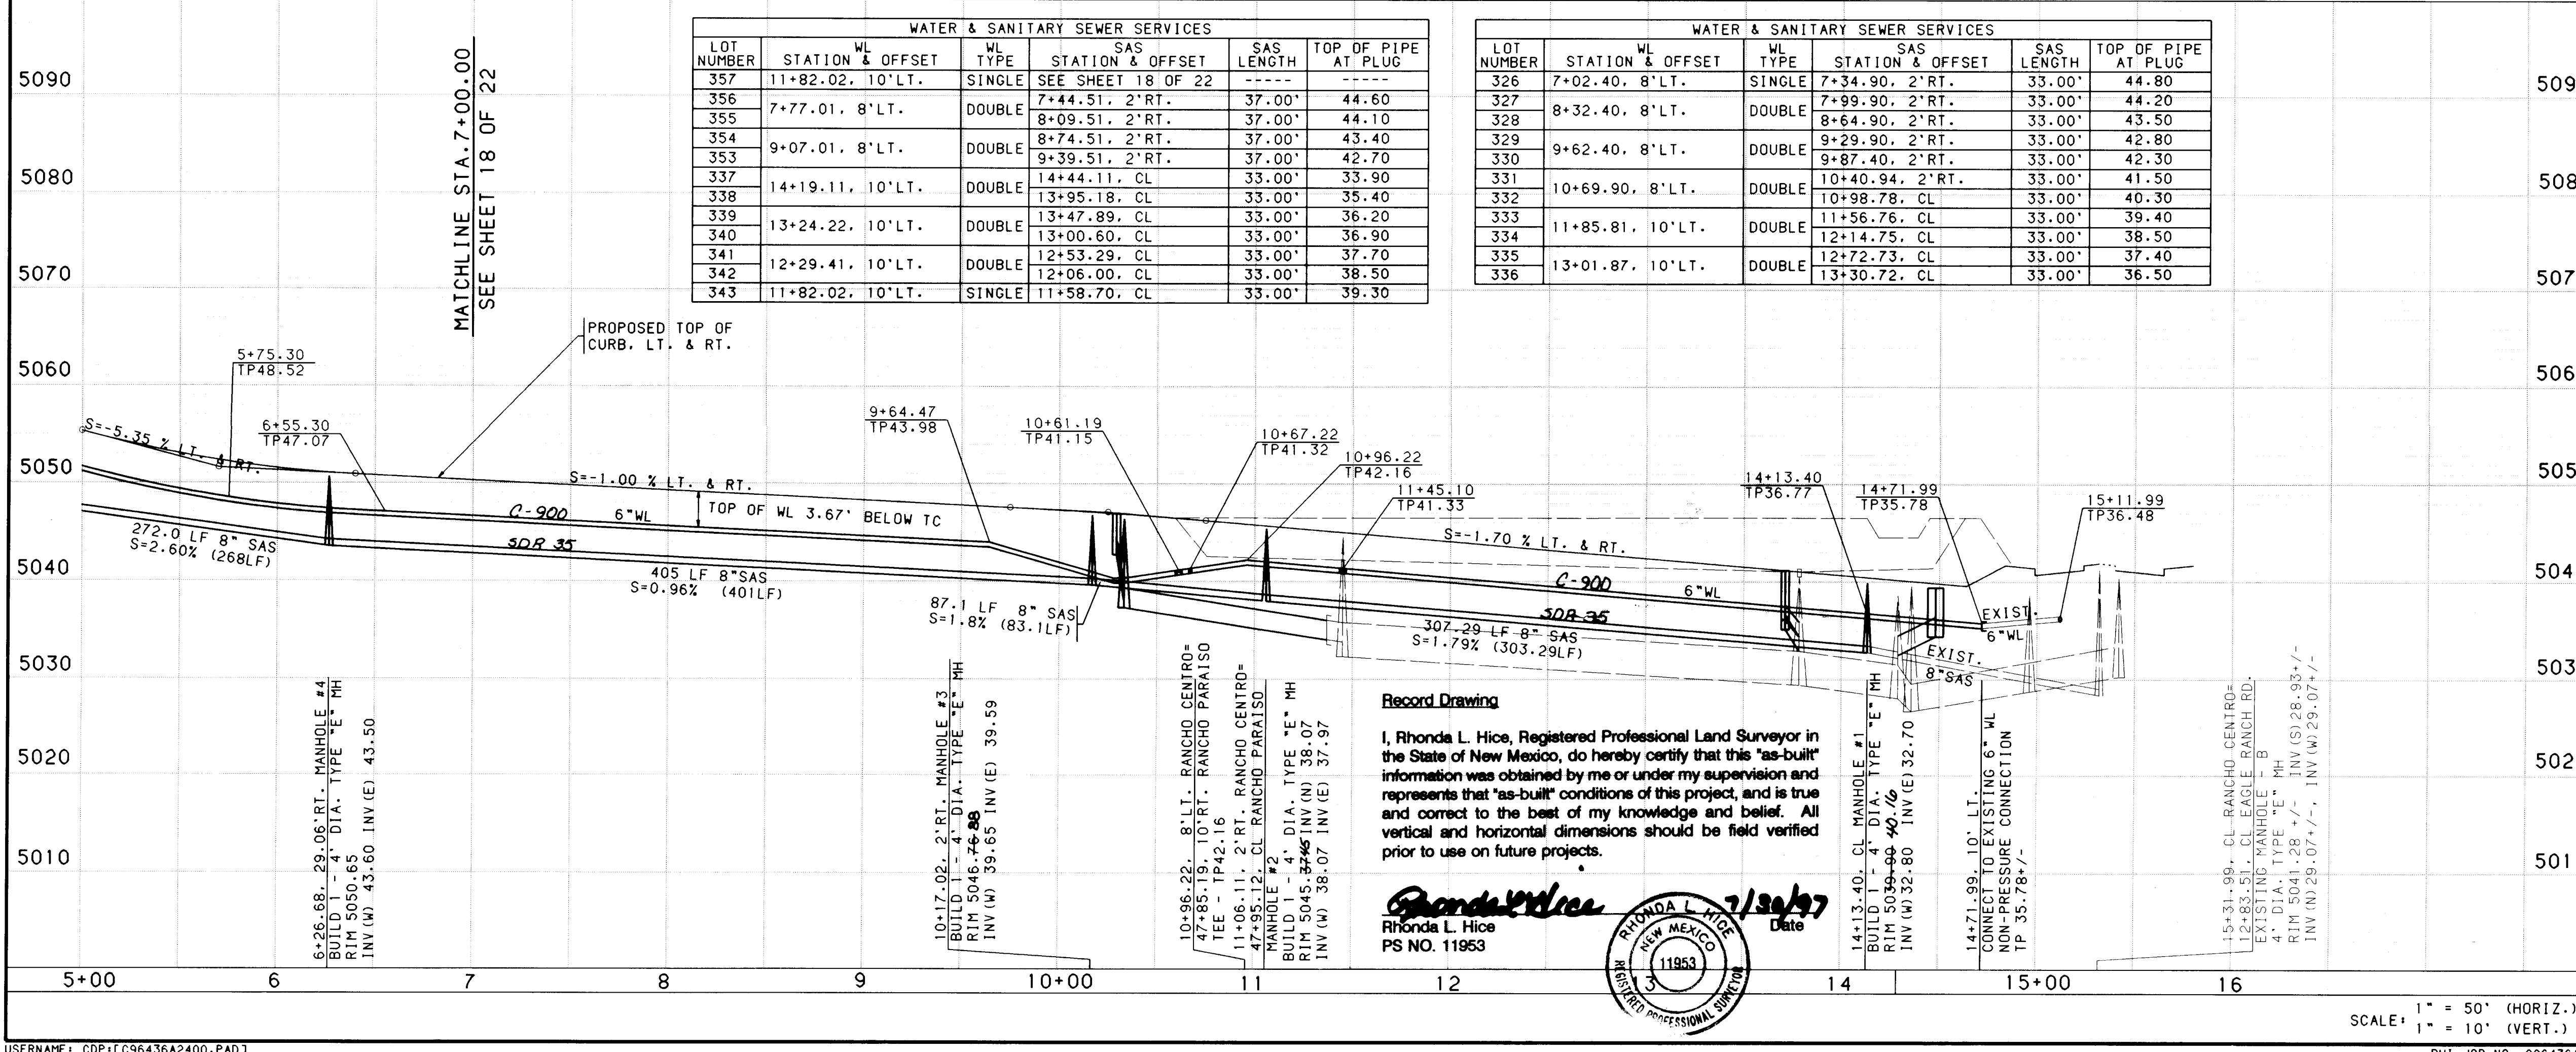


Copyright Bohannon-Huston, Inc. 1990
DATE: DECEMBER, 1997

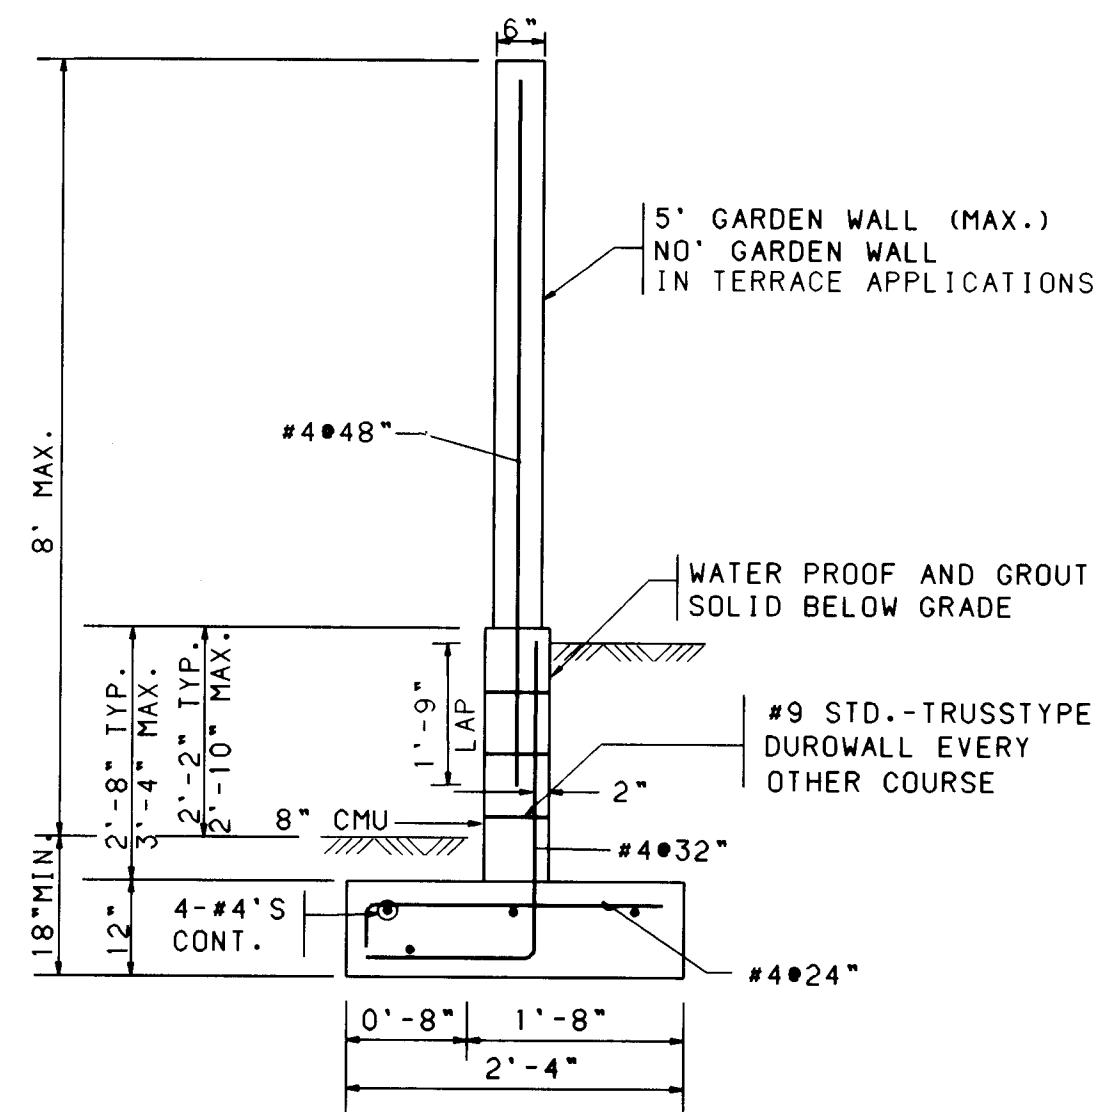


1 2-3' TERRACE/RETAINING WALL
NO SCALE

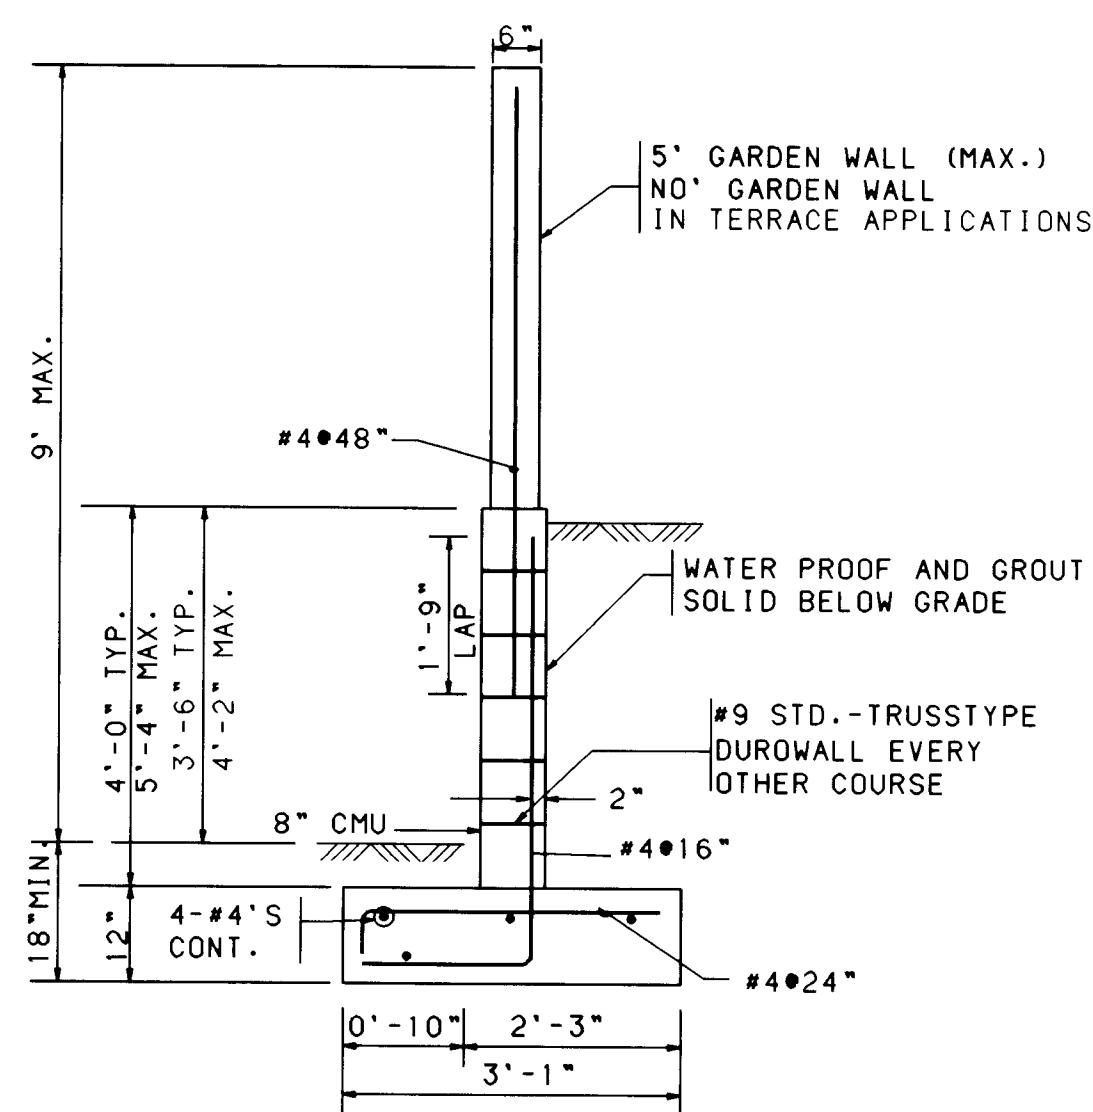


2 3-4' TERRACE/RETAINING WALL
NO SCALE

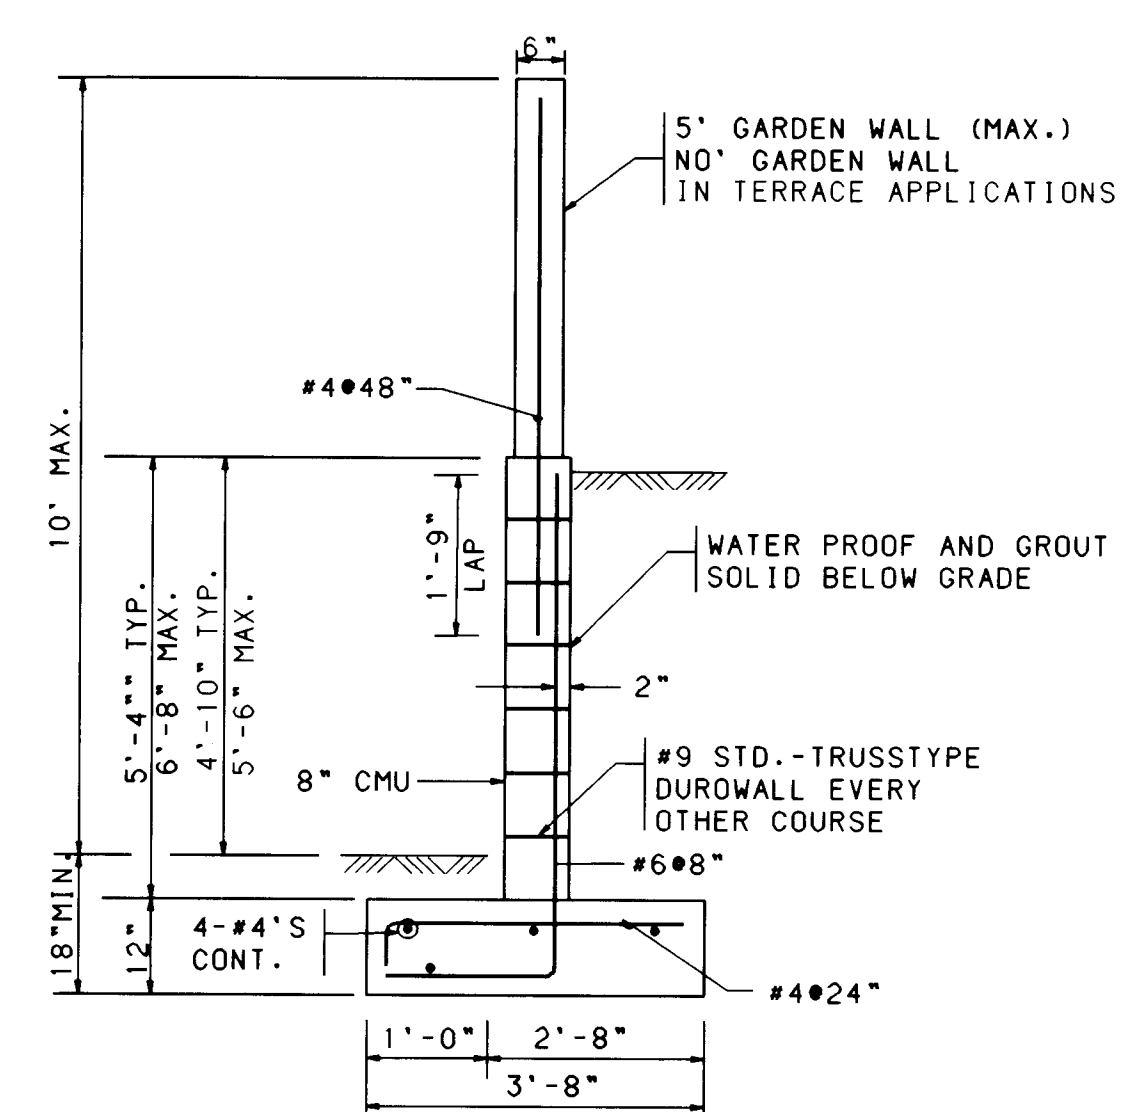


3 5' TERRACE/RETAINING WALL
NO SCALE

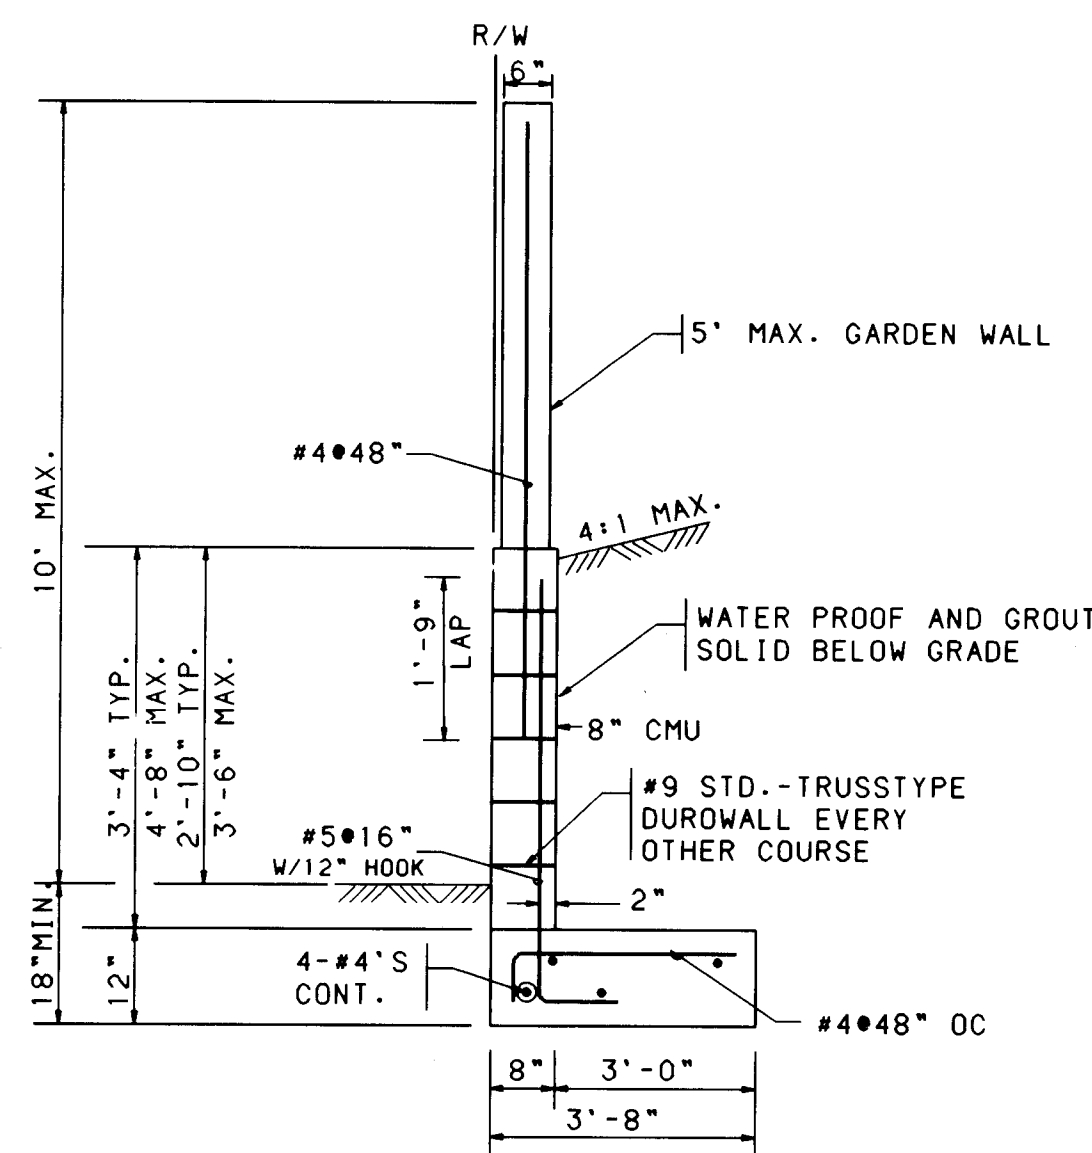


4 3-4' "L" RETAINING WALL
NO SCALE

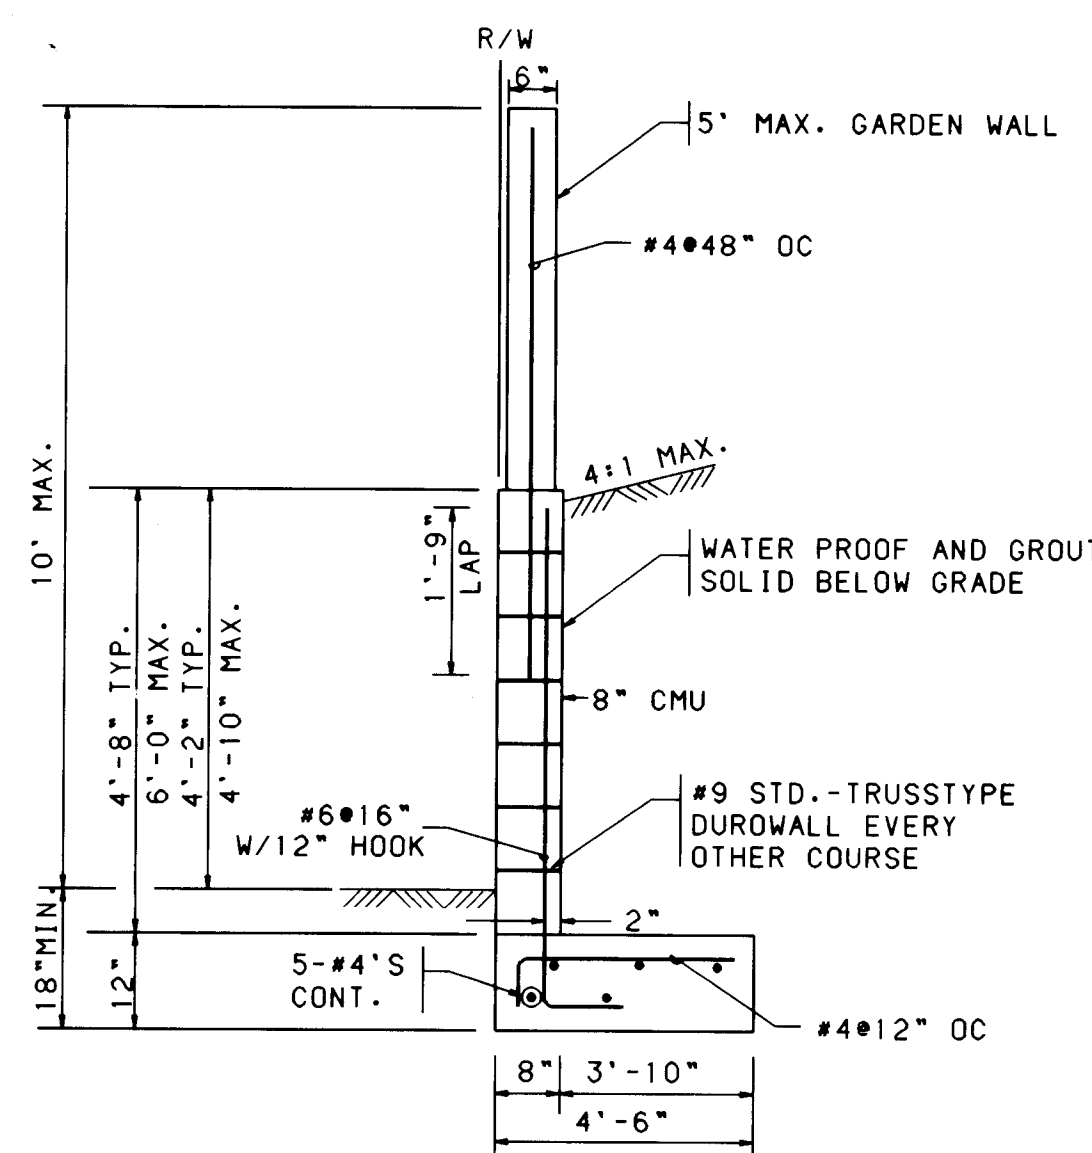


5 4-5' "L" RETAINING WALL
NO SCALE

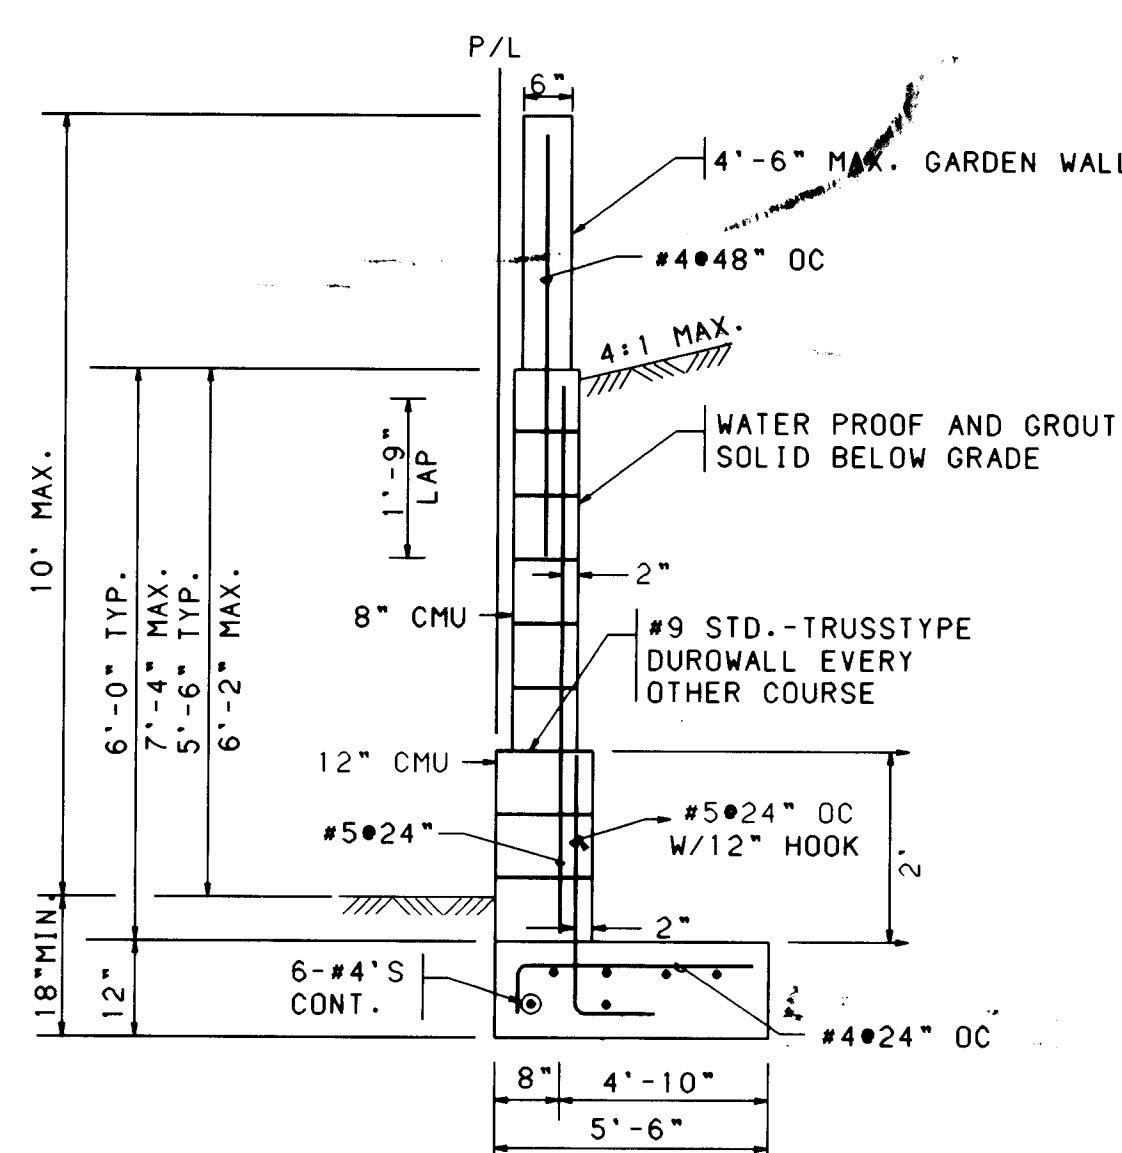


6 5-6' "L" RETAINING WALL
NO SCALE

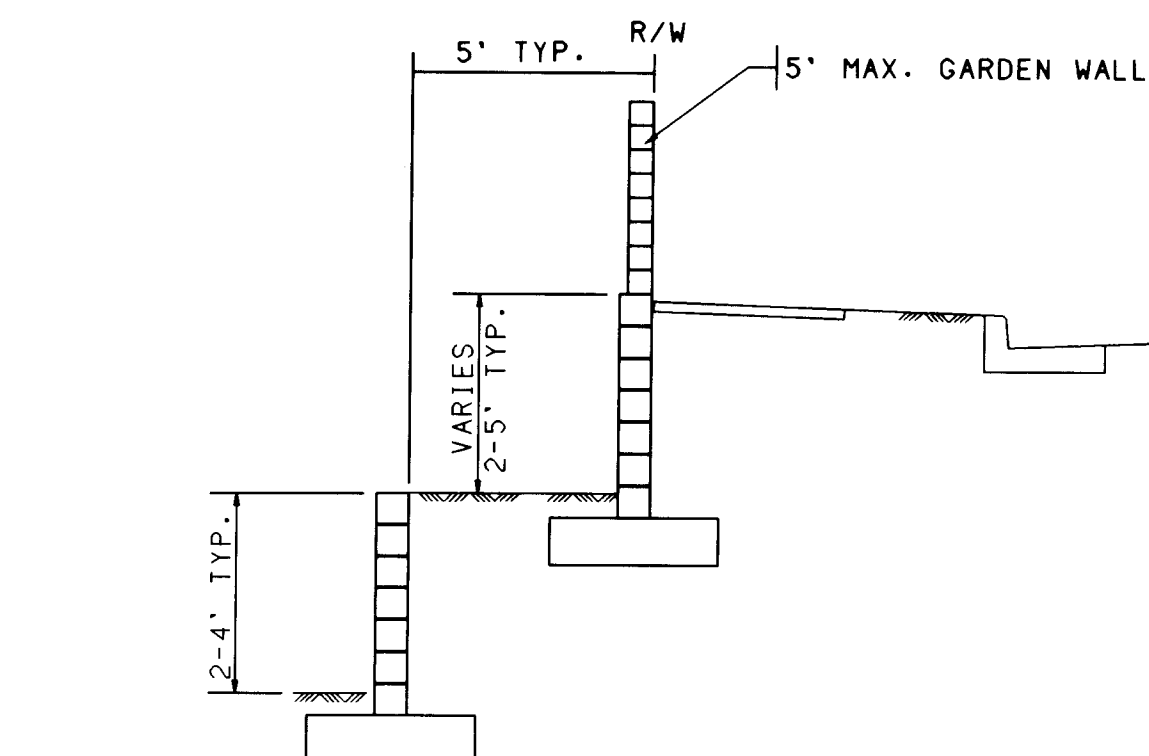

A TERRACE WALL CONDITIONS
NO SCALE

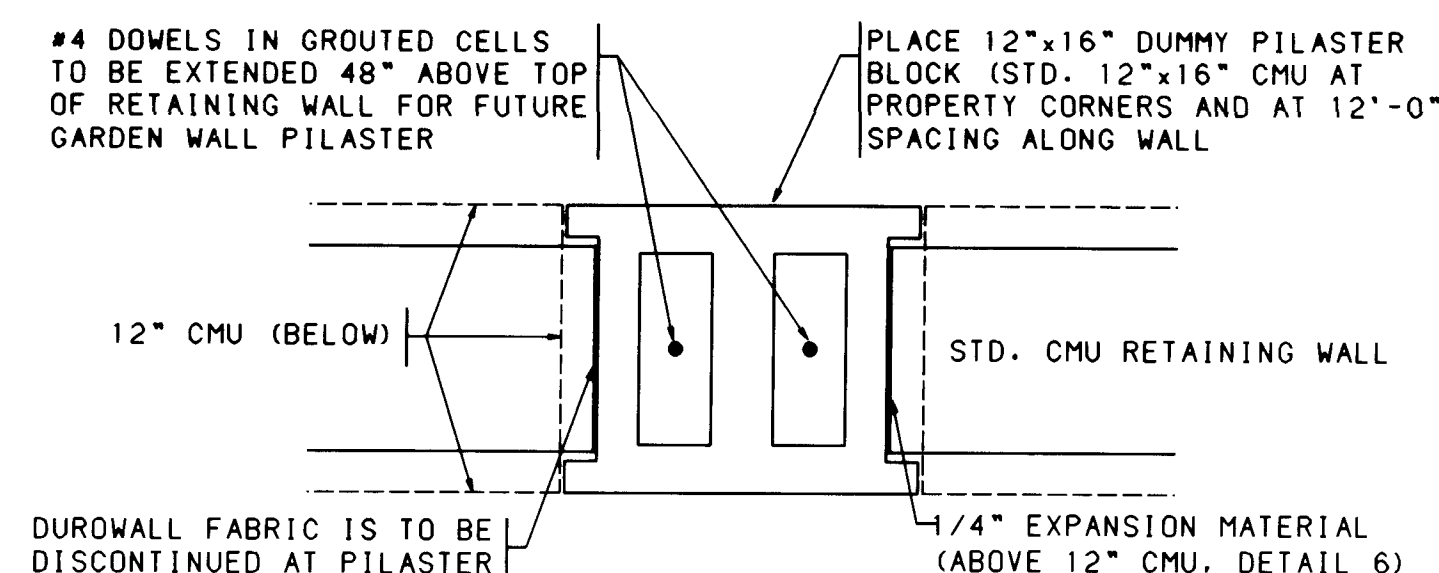

TYPICAL PILASTER DETAIL
NO SCALE

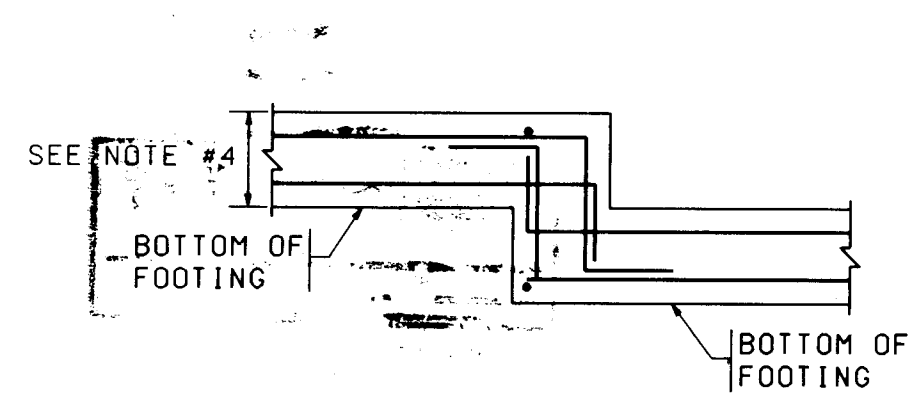

TYPICAL STEPPED FOOTING DETAIL
BARS AS PER RETAINING WALL DETAILS
NO SCALE

GENERAL NOTES (RETAINING WALL CONST.)

- RETAINING WALL FOOTINGS SHOULD BE EMBEDDED A MINIMUM OF EIGHTEEN INCHES BELOW LOWEST ADJACENT GRADE. PRIOR TO PLACING FOOTINGS, THE EXPOSED SOILS SHOULD BE SCARIFIED TO A DEPTH OF EIGHT (8") INCHES. MOISTURE CONDITIONED TO A NEAR OPTIMUM ($\pm 3\%$) MOISTURE CONTENT AND COMPACTED TO A MINIMUM OF 95% OF MAXIMUM DENSITY AS DETERMINED BY ASTM D-1557.
- RETAINING WALL SHALL NOT BE BACK-FILLED UNTIL AT LEAST 7 DAYS AFTER PLACING OF FINAL GROUT LEVEL. WHERE HEAVY EQUIPMENT IS USED IN BACKFILLING, SUCH EQUIPMENT SHOULD NOT APPROACH CLOSER TO THE TOP OF THE WALL THAN A DISTANCE EQUAL TO THE HEIGHT OF THE WALL. CARE SHOULD BE TAKEN TO AVOID EXERTING IMPACT FORCES ON THE WALL AS COULD BE CAUSED BY A LARGE MASS OF MOVING EARTH.
- SLOPES UP AWAY FROM WALLS SHOULD NOT EXCEED 4:1.
- VERTICAL CONTROL JOINTS WITH PVC INSERTS SHALL BE PLACED AT INTERVALS NOT TO EXCEED 30'-0" ON CENTER. PILASTERS MAY BE SUBSTITUTED FOR CONTROL JOINTS WHEN PLACED AT 12'-0" INTERVALS. PILASTERS SHALL BE PLACED AT EVERY SIDE LOT LINE INTERSECTION. DISCONTINUE DUROWALL EACH SIDE OF PILASTERS.
- MINIMUM LAP SPICE ON REINFORCING BARS SHALL BE 30" BAR DIAMETERS OR 1'-4" MINIMUM. REINFORCEMENT OF A SIZE AND SPACING OTHER THAN THAT GIVEN IN THE TABLES MAY BE USED PROVIDING SUCH OTHER REINFORCEMENT FURNISHES AN AREA OF STEEL AREA AT LEAST EQUAL TO THAT GIVEN IN THE TABLE.
- CONSTRUCTION OF RETAINING WALLS SHALL CONFORM TO REQUIREMENTS OF THE UNIFORM BUILDING CODE SECTION 24, LOWLIFT GROUTING METHOD.
- OMISSION OF A VERTICAL MORTAR JOINT ON FIRST COURSE AT 48" O.C. SHALL BE USED FOR WEEP HOLES. WHITE SLUMP BLOCK WITH MINIMUM COMPRESSIVE STRENGTH OF 1500 PSI MAY BE SUBSTITUTED FOR STANDARD CMU GRADE N.
- DESIGN DATA
BLOCK WEIGHT 12" = 130 PSF
BLOCK WEIGHT 8" = 85 PSF
SOIL WEIGHT = 110 PCF
EQUIV. FLUID FRESSURE = 35 PCF
SOIL BEARING PRESSURE = 1500 PCF
(1/3 INCREASE FOR WIND/SEISMIC)
COEFFICIENT OF FRICTION = 0.4
PASSIVE SOIL PRESSURE = 300 PCF
CONCRETE F'C (28 DAYS) = 4000 PSI
GROUT STRENGTH = 2000 PSI
CMU GRADE N = 1500 PSI (GROUTED)
REINFORCEMENT = 60 ASTM A-615
- CONTRACTOR SHALL NOTIFY ENGINEER PRIOR TO CONCRETE FOOTING POUR FOR INSPECTION OF COMPACTION UNDER FOOTING, FOOTING DEPTH AND WIDTH AND WALL STEEL AND SPACING. FINAL INSPECTION OF FOOTING AND WALL WILL BE REQUIRED.
- CONTRACTOR SHALL BE RESPONSIBLE FOR CODE ADMINISTRATION APPROVAL AND FEES ASSOCIATED WITH IT.
- ALL CELLS BELOW GRADE SHALL BE FULLY GROUTED.
- THE CONTRACTOR SHALL BE RESPONSIBLE TO SEE THAT ALL REBAR IS PROPERLY ALIGNED AND TIED IN PLACE BEFORE PLACING CONCRETE. ALL STEEL SHALL BE ACCURATELY LOCATED AND SECURED IN PLACE SO THAT IT REMAIN IN POSITION DURING THE PLACEMENT OF THE CONCRETE. ANY REBAR IMPROPERLY INSTALLED SHALL BE REMOVED AT NO ADDITIONAL COST TO THE OWNER.
- CMU SHALL NOT BE PLACED ON CONCRETE FOOTINGS UNTIL CONCRETE HAS CURED FOR A MINIMUM OF 7 DAYS.

AS BUILT INFORMATION				BENCH MARKS				SURVEY INFORMATION				ENGINEERS SEAL			
CONTRACTOR	DATE	INSPECTOR'S	DATE	STATION MARK	DATE	STATION MARK	DATE	NO.	DATE	BY	DATE	NO.	DATE	BY	DATE
NEW CONSTRUCTION		TABLET, STAMPED "HUGHES, 1954"		A CONCRETE POST PROJECTING 0.3 FT. ABOVE THE GROUND. TO REACH THE STATION FROM THE INTERSECTION OF CENTRAL AVE. AND STATE RD. 448.		GO NORTH ON STATE RD. 448. 6.1 MILES. THE STATION IS 450' WEST OF STATE RD. 448 IN A FENCED-IN PRAIRIE.									
RECORDED BY	NO.	RECORDED BY	NO.	RECORDED BY	NO.	RECORDED BY	NO.	RECORDED BY	NO.	RECORDED BY	NO.	RECORDED BY	NO.	RECORDED BY	NO.



James R. Topmiller
12/20/96

BOHANNAN-HUSTON INC.
ENGINEERS • PLANNERS • PHOTOGRAMMETRISTS • SURVEYORS • LANDSCAPE ARCHITECTS
ALBUQUERQUE LAS CRUCES SANTA FE

CITY OF ALBUQUERQUE
PUBLIC WORKS DEPARTMENT
ENGINEERING DEVELOPMENT GROUP

RANCHO SERENO SUBDIVISION - UNIT V
CMU RETAINING WALL DETAILS

DESIGN REVIEW COMMITTEE	CITY ENGINEER APPROVAL	MO/DAY/YR	MO/DAY/YR
APPROVED			
DESIGN REVIEW COMMITTEE			
CITY PROJECT NO.	ZONE MAP NO.	SHEET	OF
456997	C-12	22	22

Copyright Bohannan-Huston, Inc. 1983