




DRAINAGE, GRADING, PAVING, AND UTILITY IMPROVEMENTS

SHT. NO.	TITLE
1.	TITLE SHEET
2a, b & c	PLAT
3.	OVERALL PAVING PLAN
4.	OVERALL UTILITY PLAN
5.	GRADING PLAN
6.	GRADING PLAN
7.	GRADING PLAN
8.	ARCHES ROAD - PAVING PLAN & PROFILE
9.	CANYONLANDS CT. & CANYONLANDS RD. - PAVING PLAN & PROFILE
10.	JEWEL CAVE ROAD - PAVING PLAN & PROFILE
11.	WIND RIVER STREET - PAVING PLAN & PROFILE
12.	KINGS CANYON ROAD - PAVING PLAN & PROFILE
13.	SALINAS STREET - PAVING PLAN & PROFILE
14.	STEAMBOAT STREET/JEWEL CAVE ROAD - PAVING PLAN & PROFILE
15.	TONY SANCHEZ DRIVE - PAVING PLAN & PROFILE
16.	TONY SANCHEZ DRIVE - PAVING PLAN & PROFILE
17.	TEMPORARY ACCESS ROAD #1 - PAVING PLAN & PROFILE
18.	TEMPORARY ACCESS ROAD #1 & 2 - PAVING PLAN & PROFILE
19.	ARCHES ROAD - UTILITY PLAN & PROFILE
20.	CANYONLANDS CT. & CANYONLANDS RD. - UTILITY PLAN & PROFILE
21.	JEWEL CAVE ROAD - UTILITY PLAN & PROFILE
22.	WIND RIVER STREET - UTILITY PLAN & PROFILE
23.	KINGS CANYON ROAD - UTILITY PLAN & PROFILE
24.	SALINAS STREET - UTILITY PLAN & PROFILE
25.	STEAMBOAT STREET/JEWEL CAVE ROAD - UTILITY PLAN & PROFILE
26.	TONY SANCHEZ DRIVE - UTILITY PLAN & PROFILE
27.	TONY SANCHEZ DRIVE - UTILITY PLAN & PROFILE
28.	ARCHES ROAD - STORM DRAIN PLAN & PROFILE
29.	CANYONLANDS ROAD - STORM DRAIN PLAN & PROFILE
30.	JEWEL CAVE ROAD - STORM DRAIN PLAN & PROFILE
31.	WIND RIVER STREET - STORM DRAIN PLAN & PROFILE
32.	KINGS CANYON ROAD - STORM DRAIN PLAN & PROFILE
33.	SALINAS STREET - STORM DRAIN PLAN & PROFILE
34.	TONY SANCHEZ DRIVE - STORM DRAIN PLAN & PROFILE
35.	OFFSITE STORM DRAIN - PLAN & PROFILE
36.	STREET PAVING SECTIONS
37.	DRAINAGE CHANNEL - PLAN & PROFILE
38.	DRAINAGE CHANNEL - PLAN & PROFILE
39.	GRADING DETAILS
40.	WALL DETAILS


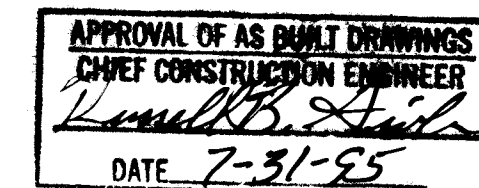



LOCATION MAP
ZONE ATLAS MAP L-21-Z


GENERAL NOTES

1. ALL WORK DETAILED ON THESE PLANS TO BE PERFORMED UNDER CONTRACT, AND UNLESS OTHERWISE ORDERED BY THE PROVIDER FOR HEREON, SHALL BE CONSTRUCTED IN ACCORDANCE WITH THE CITY OF ALBUQUERQUE STANDARD SPECIFICATIONS, PUBLIC WORKS CONSTRUCTION, 1986 EDITION, UPDATE NO. 4.
2. TWO WORKING DAYS PRIOR TO ANY EXCAVATION, THE CONTRACTOR MUST CONTACT NEW MEXICO ONE CALL, 260-1990, FOR LOCATION OF EXISTING UTILITIES.
3. PRIOR TO CONSTRUCTION, THE CONTRACTOR SHALL EXCAVATE AND VERIFY THE HORIZONTAL AND VERTICAL LOCATIONS OF EXISTING UTILITIES BEING CONNECTED TO AND ALL POTENTIAL OBSTRUCTIONS. SHOULD A CONFLICT EXIST, THE CONTRACTOR SHALL NOTIFY THE ENGINEER SO THAT THE CONFLICT CAN BE RESOLVED WITH A MINIMUM AMOUNT OF DELAY.
4. ALL WORK ON THIS PROJECT SHALL BE PERFORMED IN ACCORDANCE WITH APPLICABLE FEDERAL, STATE AND LOCAL LAWS, RULES, AND REGULATIONS CONCERNING SAFETY AND HEALTH.
5. CONTRACTOR SHALL MAINTAIN ACCESS TO ADJACENT PROPERTIES DURING CONSTRUCTION.
6. ALL GAS, ELECTRIC, TELEPHONE LINES, CABLES AND APPURTENANCES ENCOUNTERED DURING CONSTRUCTION THAT REQUIRE RELOCATION SHALL BE DONE BY THE RESPONSIBLE UTILITY. THE CONTRACTOR SHALL BE RESPONSIBLE FOR COORDINATION OF ALL NECESSARY UTILITY ADJUSTMENTS.
7. IT SHALL BE THE CONTRACTOR'S RESPONSIBILITY TO PROTECT AND MAINTAIN IN SERVICE ALL EXISTING UTILITIES.
8. THE CONTRACTOR SHALL BE REQUIRED TO CONFINED HIS WORK WITHIN THE CONSTRUCTION LIMITS AND/OR PUBLIC RIGHT-OF-WAY OR EASEMENTS TO PRESERVE EXISTING VEGETATION AND PRIVATE PROPERTY. OVERNIGHT PARKING OF EQUIPMENT AND/OR STORAGE OF MATERIALS IS NOT ALLOWED EXCEPT BY PERMISSION OF PROPERTY OWNER. RESTORATION OF PRIVATE IMPROVEMENTS WILL BE AT THE CONTRACTOR'S EXPENSE.
9. A DISPOSAL SITE FOR ALL EXCESS EXCAVATION MATERIAL, ASPHALTIC PAVING, CONCRETE CURBS AND SIDEWALKS, ETC. SHALL BE OBTAINED BY THE CONTRACTOR IN COMPLIANCE WITH APPLICABLE ENVIRONMENTAL REGULATIONS AND APPROVED BY THE FIELD ENGINEER. ALL COSTS INCURRED IN OBTAINING A DISPOSAL SITE AND HAUL THERETO SHALL BE CONSIDERED INCIDENTAL TO THE PROJECT AND NO SEPARATE MEASUREMENT OR PAYMENT SHALL BE MADE.
10. WHEN ABUTTING EXISTING PAVEMENT TO NEW, SAWCUT EXISTING PAVEMENT TO A STRAIGHT EDGE AND AT A RIGHT ANGLE, OR AS APPROVED BY THE PROJECT ENGINEER. REMOVAL OF BROKEN OR CRACKED PAVEMENT WILL ALSO BE REQUIRED.
11. THREE (3) WORKING DAYS PRIOR TO BEGINNING CONSTRUCTION, THE CONTRACTOR SHALL SUBMIT TO THE CONSTRUCTION COORDINATION DIVISION A DETAILED CONSTRUCTION SCHEDULE. TWO (2) WORKING DAYS PRIOR TO CONSTRUCTION, THE CONTRACTOR SHALL OBTAIN A BARRICADE PERMIT FROM THE CONSTRUCTION COORDINATION DIVISION. CONTRACTOR SHALL NOTIFY BARRICADE ENGINEER (768-2551) PRIOR TO OCCUPYING AN INTERSECTION. SEE SECTION 19 OF THE SPECIFICATIONS.
12. ALL FINAL BACKFILL FOR TRENCHES SHALL BE COMPACTED TO A MINIMUM 90% MAXIMUM DENSITY PER ASTM D-1557 AND AS DIRECTED BY SECTION 701.14.2 AND STANDARD DRAWING NUMBER 2315.
13. CONTRACTOR SHALL SUBMIT A REVEGETATION PLAN TO ENGINEER FOR PRIOR APPROVAL.
14. CONTRACTOR SHALL NOTIFY THE ENGINEER NOT LESS THAN SEVEN (7) DAYS PRIOR TO STARTING WORK IN ORDER THAT THE ENGINEER MAY TAKE NECESSARY MEASURES TO INSURE THE PRESERVATION OF SURVEY MONUMENTS. CONTRACTOR SHALL NOT DISTURB PERMANENT SURVEY MONUMENTS WITHOUT THE CONSENT OF THE ENGINEER AND SHALL NOTIFY THE ENGINEER AND BEAR THE EXPENSE OF REPLACING ANY THAT MAY BE DISTURBED WITHOUT PERMISSION. REPLACEMENT SHALL BE DONE ONLY BY THE CITY SURVEYOR. WHEN A CHANGE IS MADE IN THE FINISHED ELEVATIONS OF PAVEMENT OF ANY ROADWAY IN WHICH A PERMANENT SURVEY MONUMENT IS LOCATED, CONTRACTOR SHALL, AT HIS OWN EXPENSE, ADJUST THE MONUMENT COVER TO THE NEW GRADE UNLESS OTHERWISE SPECIFIED. REFER TO SECTION 4.4 OF GENERAL CONDITIONS OF THE STANDARD SPECIFICATIONS.

		APPROVAL OF REVISIONS	
PLANS PREPARED UNDER DIRECTION OF:		APPROVED FOR CONSTRUCTION	
DATE: _____		PROJECT NO. 4604.93	
DATE: _____		SHEET 1 OF 40	

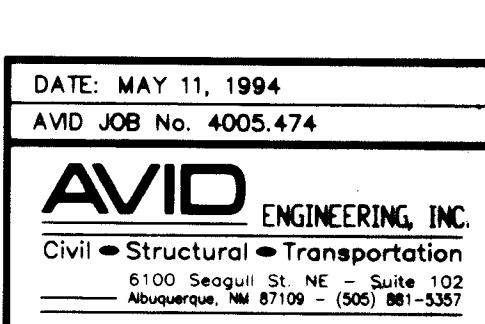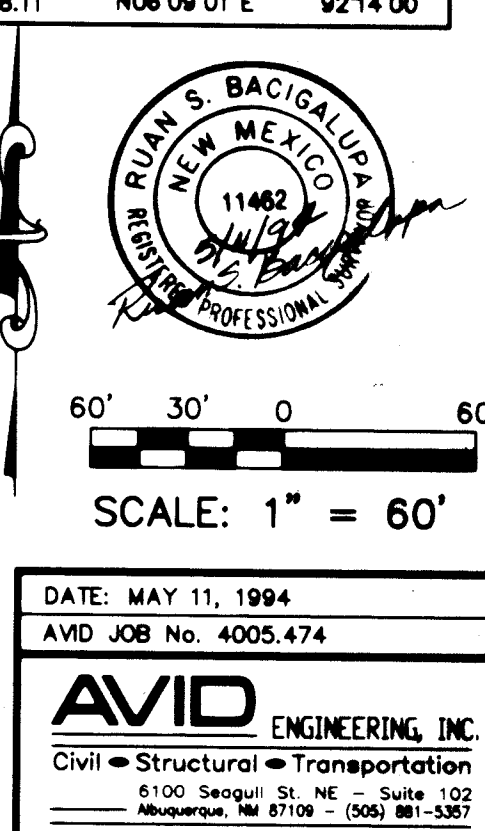

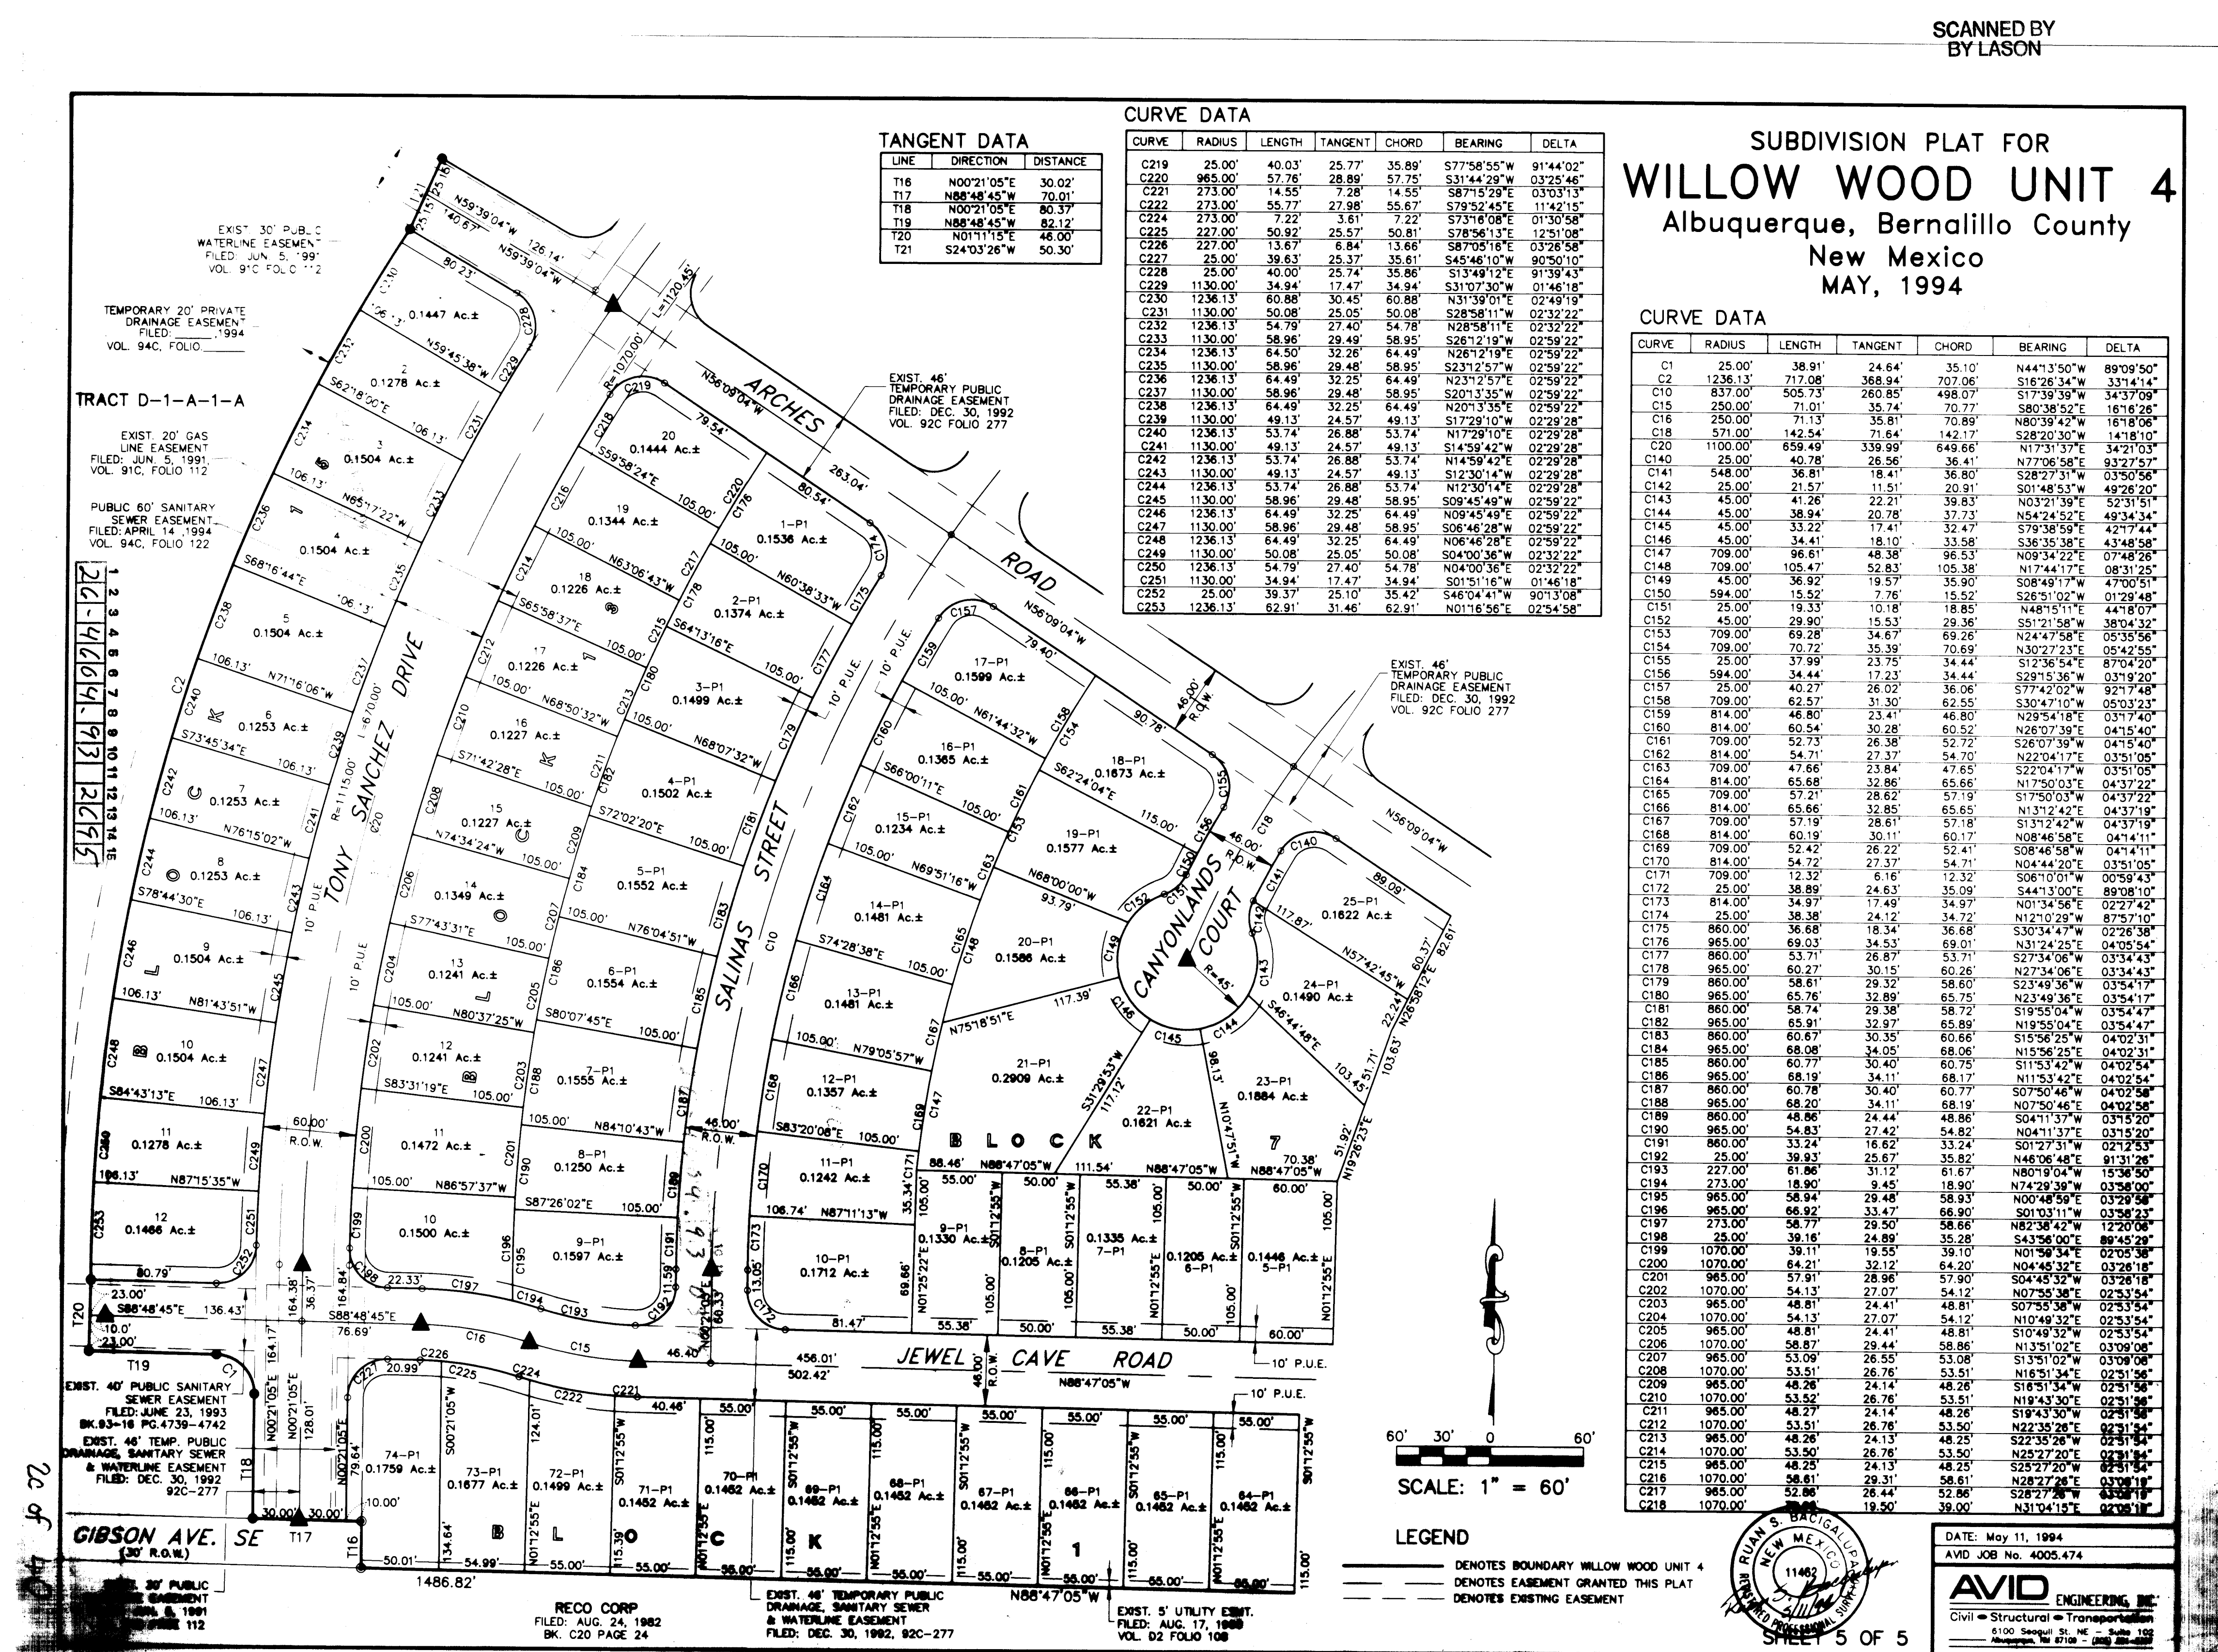

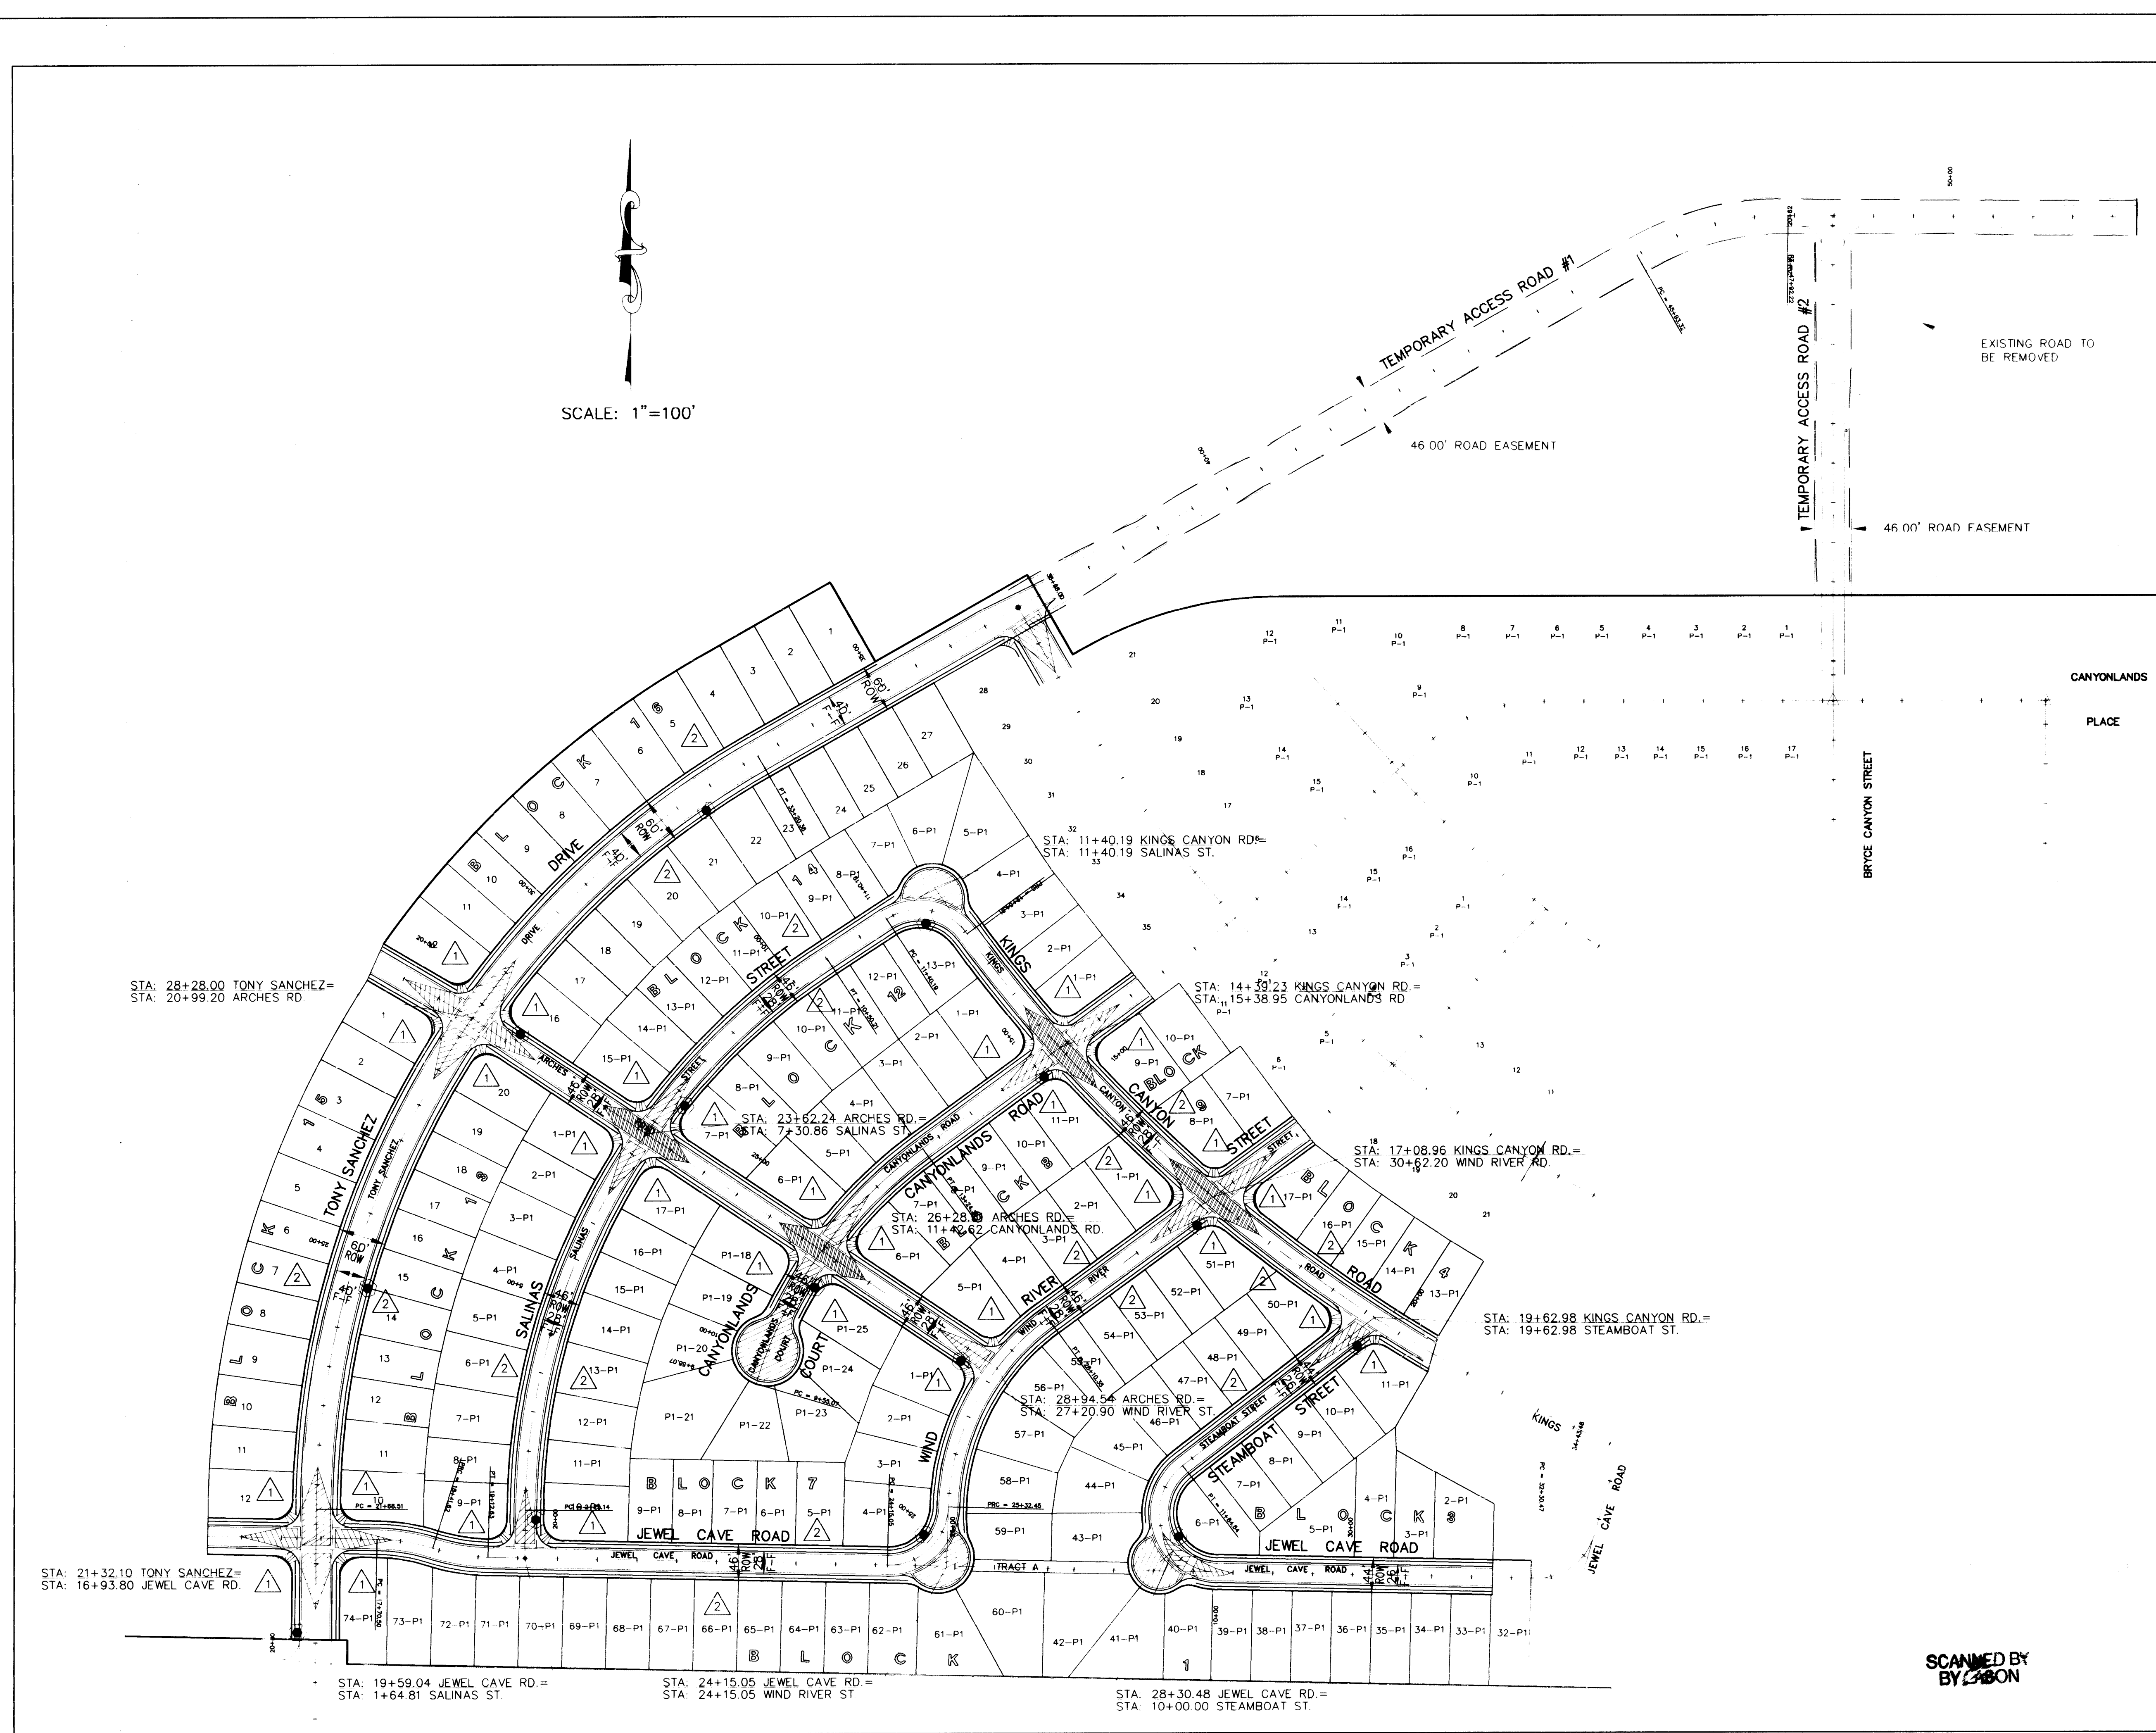

GENERAL NOTES:

1. ALL STATIONING AND OFFSET DIMENSIONS ARE BASED ON CENTERLINE OF RIGHT-OF-WAY.

KEYED NOTES:

1. CONSTRUCT WHEELCHAIR RAMP PER COA DRW 2441, TYPE II

2. FUTURE 4' SIDEWALK, BY OTHERS

LEGEND

CENTERLINE OF STREET

EXISTING CURB & GUTTER

PROPOSED ASPHALT CURB

PROPOSED STANDARD CURB & GUTTER

PROPOSED MOUNTABLE CURB & GUTTER

PROPOSED WHEELCHAIR RAMP

PROPOSED CONCRETE VALLEY GUTTER

TEMPORARY PAVEMENT

TRANSITION SECTION FROM FULL CROWN TO NO CROWN SECTION

TRANSITION SECTION FROM FULL CROWN TO HALF CROWN

PROPOSED SANITARY SEWER MANHOLE

PROPOSED STREET LIGHT LOCATION

EXISTING VALVES

EXISTING MANHOLE

AS BUILT INFORMATION

DATE: 5/94

COA: EAR

DATE: 5/94

COA: COA

DATE: 5/94

MICRO-FILM INFORMATION

DATE: 5/94

COA: COA

DATE: 5/94

COA: COA

DATE: 5/94

BENCH MARKS

THE STATION MARK IS A STANDARD ACS BRASS TABLET, STAMPED "1-L21 RESET '974," LOCATED 7.8 MILES EAST OF DOWNTOWN ALBUQUERQUE, AT THE INTERSECTION OF CENTRAL AVE. AND JUAN TABO BLVD. THE STATION IS ON THE MEDIAN STRIP OF CENTRAL AVE. 81' WEST OF THE CENTERLINE OF JUAN TABO BLVD. AND FLUSH WITH THE TOP OF CURB. SLD ELEV. 5534.63

SURVEY INFORMATION

DATE: 5/94

BY: JVD

NO. 1

ENGINEER'S SEAL

DATE: 5/94

DESIGN: DATE: 5/94

NO. 1

REMARKS

DATE: 5/94

DESIGNED BY: ETS

DRAWN BY: DATE: 5/94

CHECKED BY: JVD

CITY OF ALBUQUERQUE

PUBLIC WORKS DEPARTMENT

ENGINEERING GROUP


TITLE: WILLOW WOOD - UNIT IV OVERALL PAVING PLAN

APPROVALS	ENGINEER	DATE	APPROVALS	ENGINEER	DATE
D.R.C. Chair	7-15-94	Water	N/A RWF	7-8-94	
Transportation	7-1-94	Waste Water	N/A RWF	7-8-94	
Hydrology	7-1-94				

DRAWING NO. 4604.93

MAP NO. L-21-Z

SHEET 3 OF 40

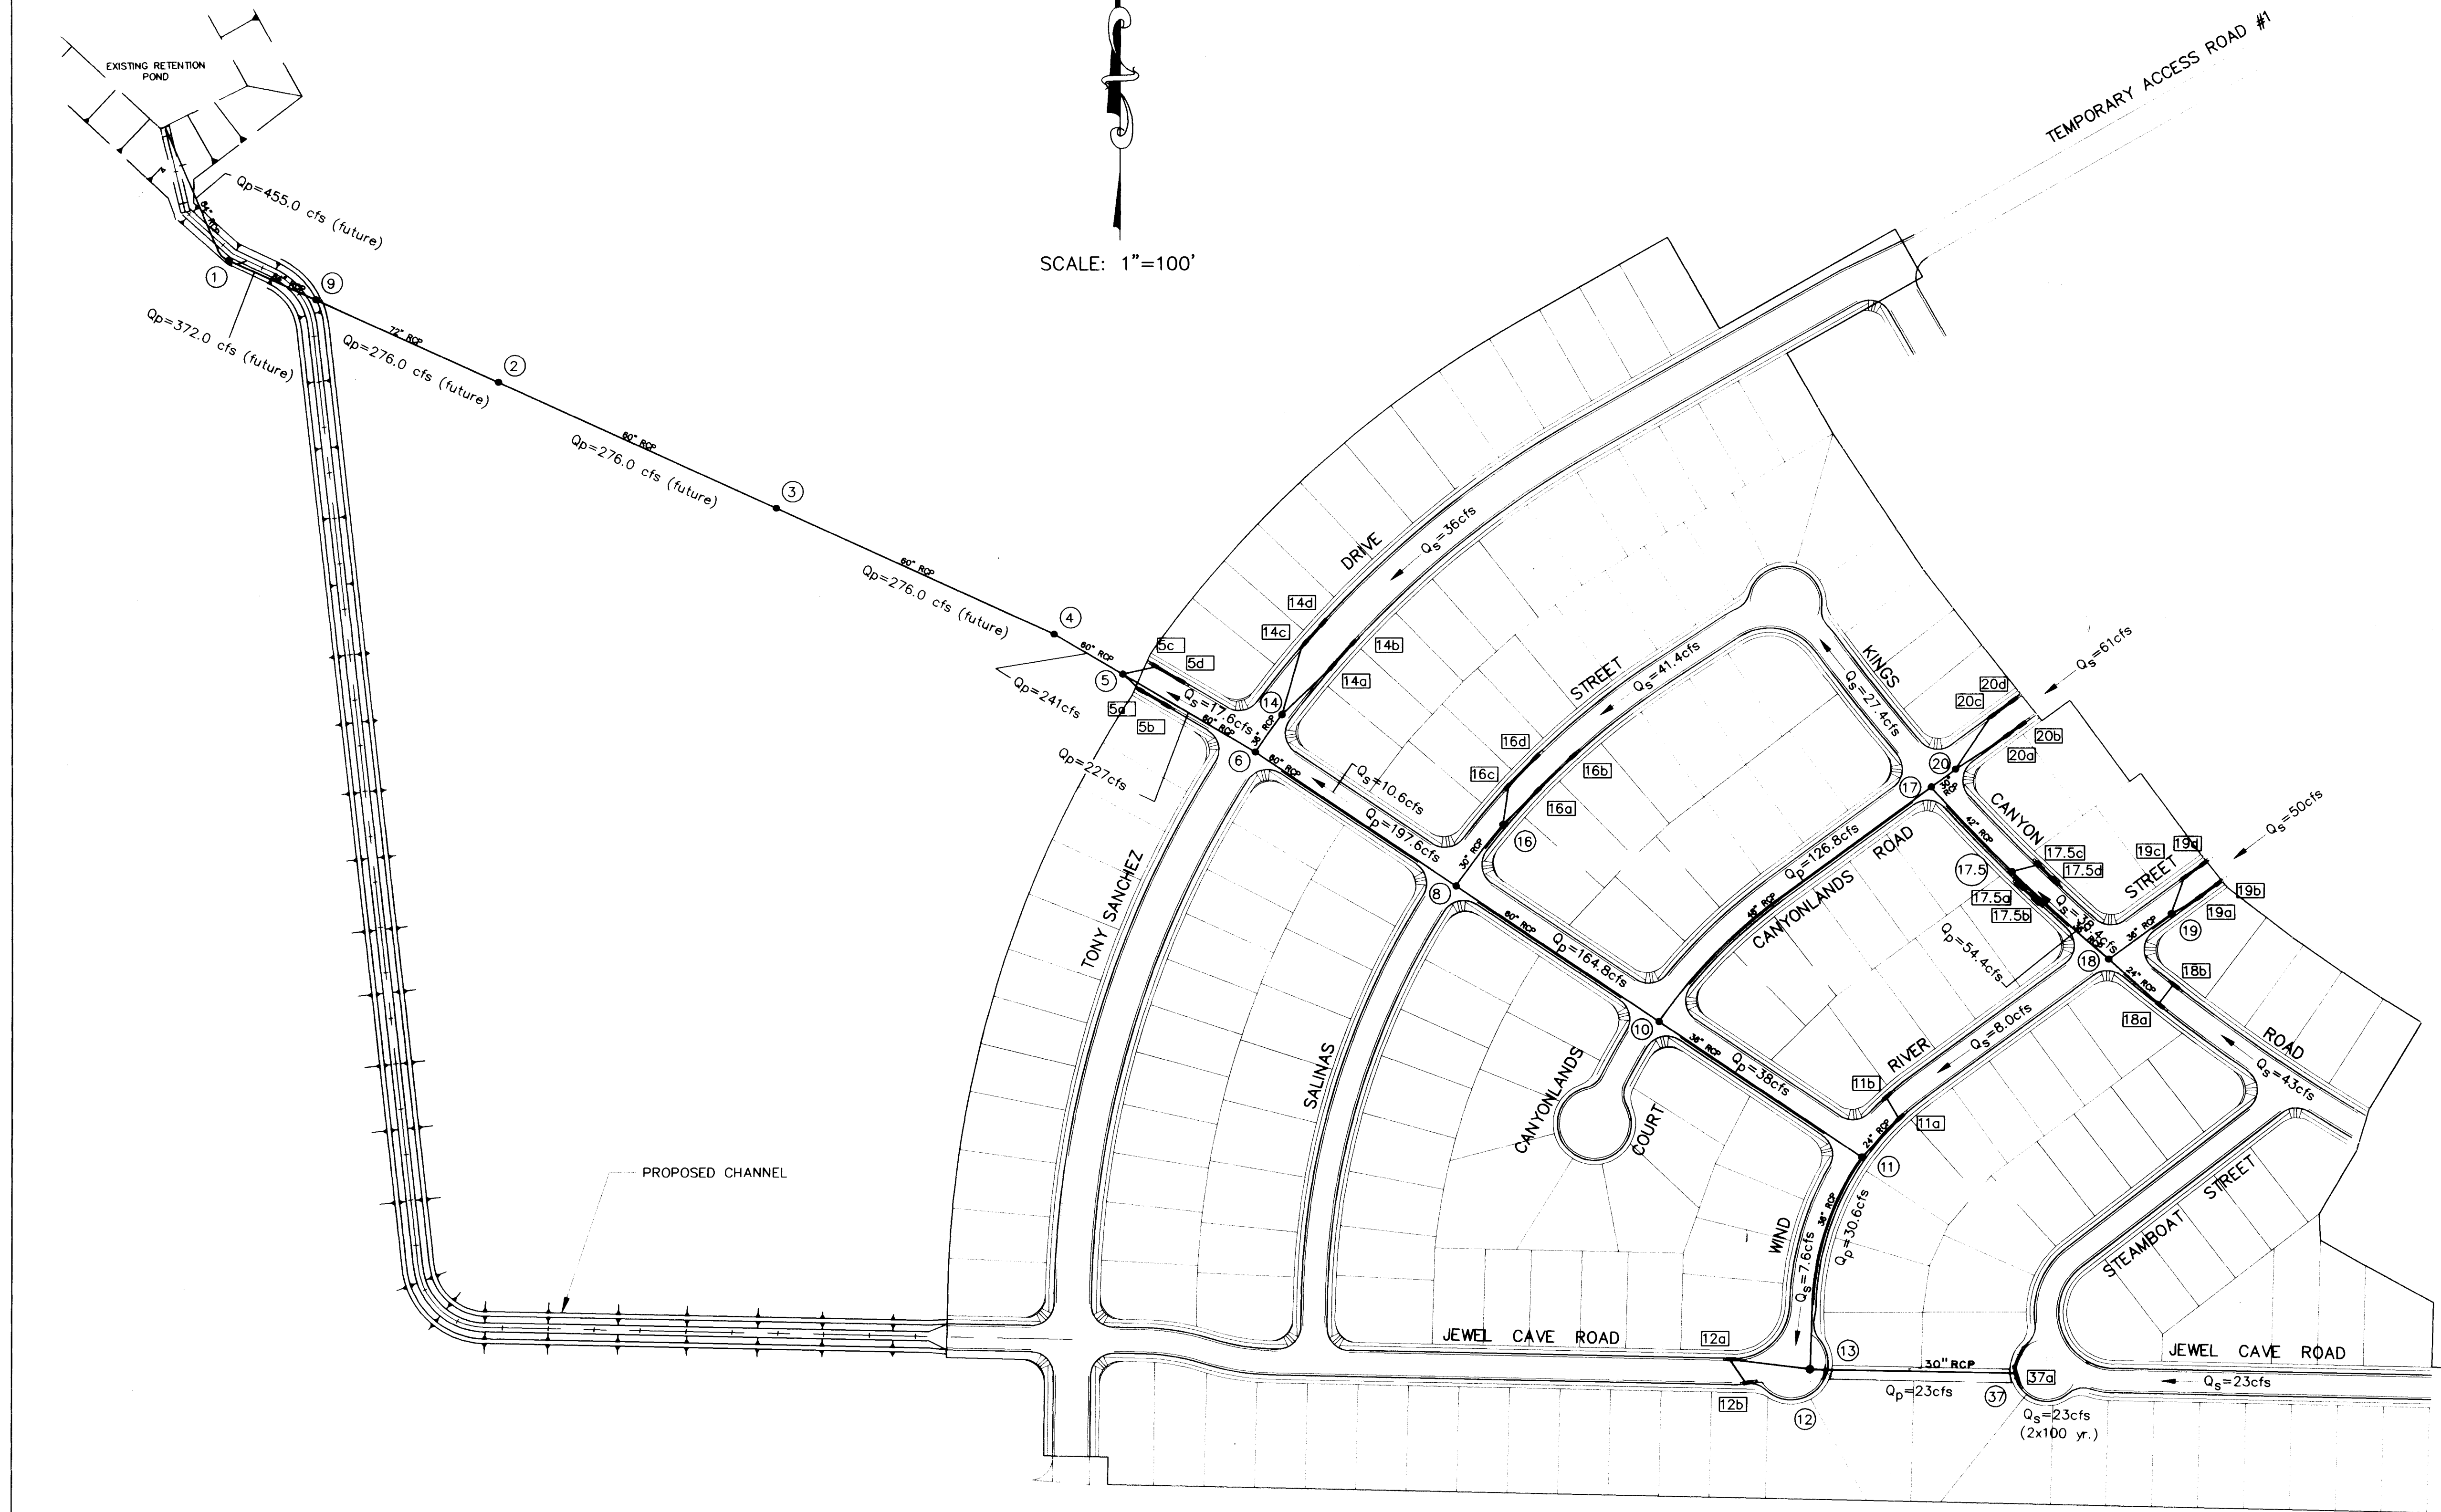

SCANNED BY
BY LASON

LEGEND

- RCP PROPOSED STORM DRAIN
- PROPOSED MANHOLE
- PROPOSED TYPE DOUBLE "A" STORM INLET
- PROPOSED TYPE DOUBLE "C" STORM INLET
- 19c INLET NUMBER
- 18 MANHOLE NUMBER
- Qs STREET FLOW
- Qp PIPE FLOW

AVID ENGINEERING, INC.
Civil • Structural • Transportation
6100 Seagull St. NE Suite 102
Albuquerque, NM 87109 (505) 881-5357

1 2 3 4 5 6 7 8 9 10 11 12 13 14 15
20-144041-93 14895

CITY OF ALBUQUERQUE
PUBLIC WORKS DEPARTMENT
ENGINEERING GROUP




TITLE: WILLOW WOOD - UNIT IV
OVERALL STORM DRAIN PLAN

APPROVALS	ENGINEER	DATE	APPROVALS	ENGINEER	DATE
D.R.C. Chair	<i>[Signature]</i>	7-15-94	Water	NIA RWK	7-8-94
Transportation	<i>[Signature]</i>	7-01-94	Waste Water	NIA RWK	7-8-94
Hydrology	<i>[Signature]</i>	7-1-94			

DRAWING NO.	4604.93	MAP NO. L-21-Z	SHEET 4a OF 40
-------------	---------	----------------	----------------

SURVEY INFORMATION				BENCH MARKS				AS BUILT INFORMATION			
FIELD NOTES				THE STATION MARK IS A STANDARD ACS BRASS TABLET, STAMPED "1-L21 RESET 1974," LOCATED 7.8 MILES EAST OF DOWNTOWN ALBUQUERQUE, AT THE INTERSECTION OF CENTRAL AVE. AND JUAN TABO BLVD. THE STATION IS ON THE MEDIAN STRIP OF CENTRAL AVE., 81' WEST OF THE CENTERLINE OF JUAN TABO BLVD. AND FLUSH WITH THE TOP OF CURB. SLD ELEV. 5534.63				CONTRACTOR: New Concepts Inc.			
NO.	BY	DATE		NO.	BY	DATE		NO.	BY	DATE	

ENGINEER'S SEAL							
							</

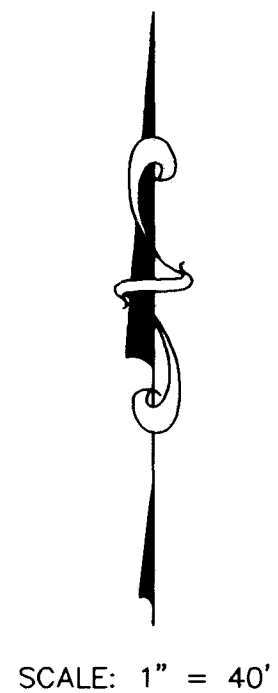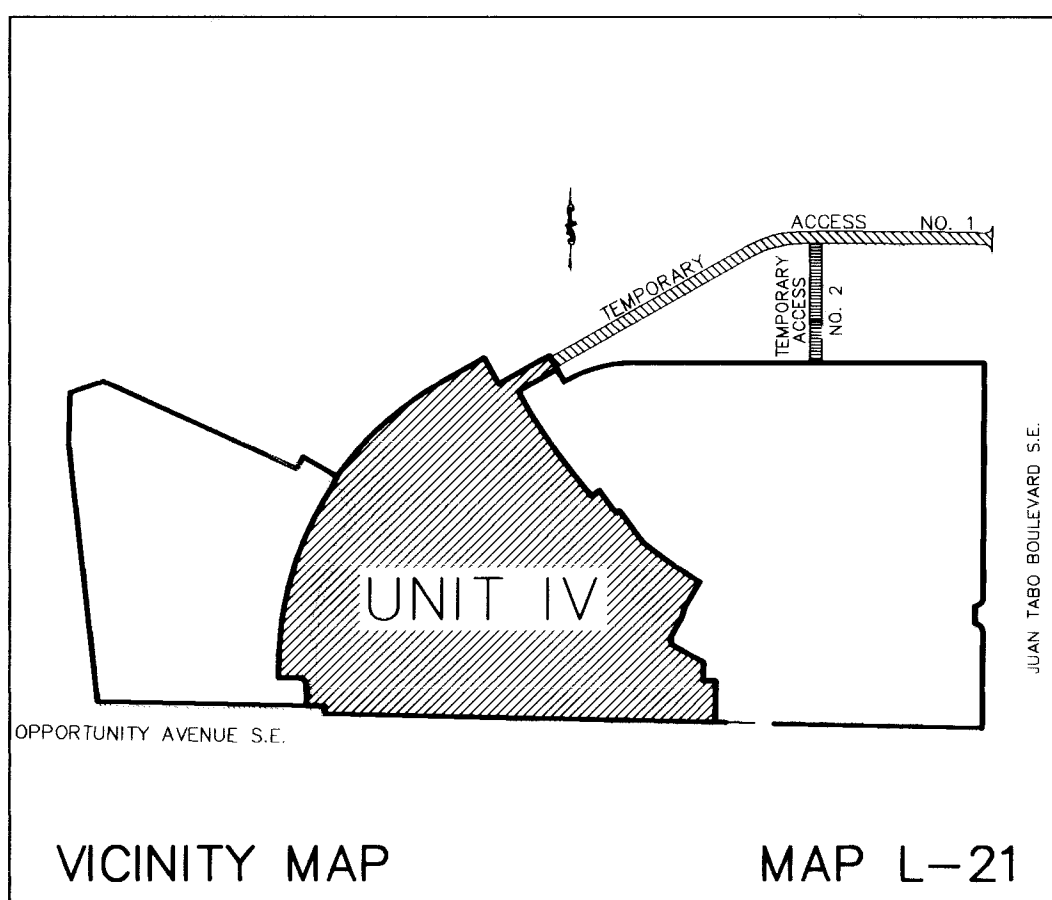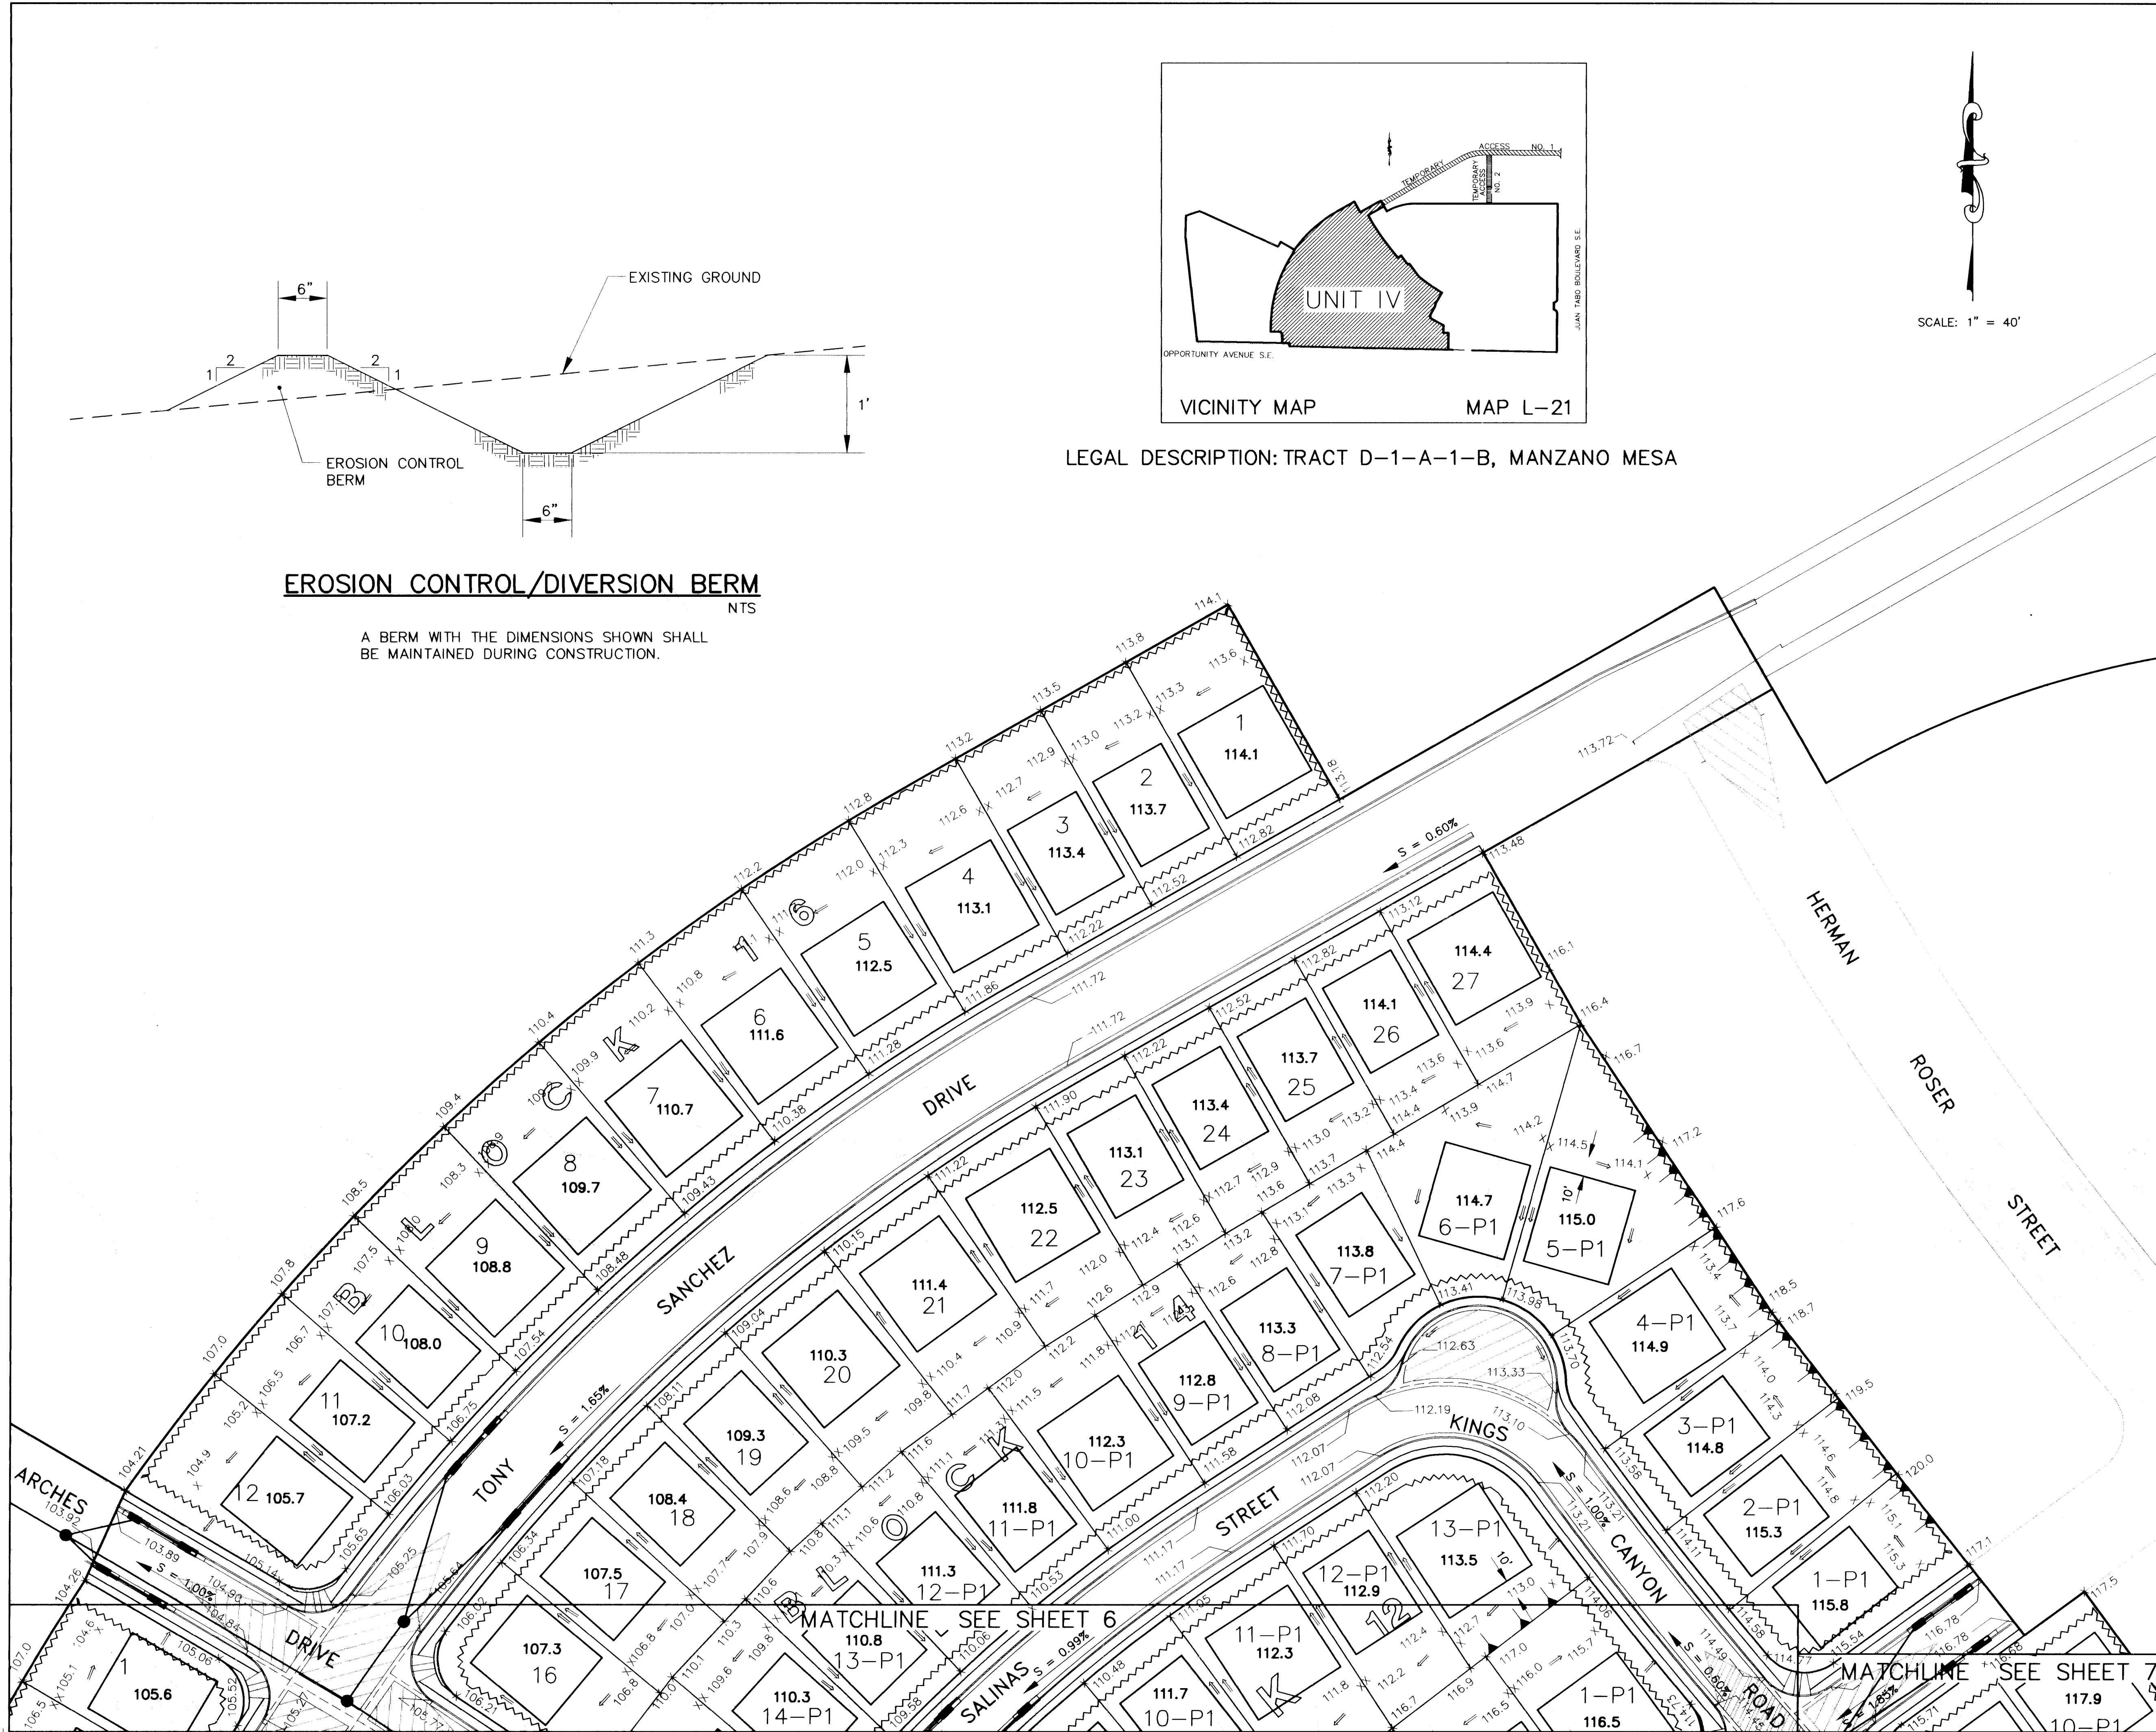

LEGAL DESCRIPTION: TRACT D-1-A-1-B, MANZANO MESA

EROSION CONTROL/DIVERSION BERM

A BERM WITH THE DIMENSIONS SHOWN SHALL BE MAINTAINED DURING CONSTRUCTION.

- GENERAL NOTES
- ALL CURB ELEVATIONS SHOWN ARE TOP OF CURB UNLESS OTHERWISE NOTED.
 - GRADE PADS TO WITHIN 5' OF THE PROPERTY LINE EXCEPT AT SIDESTREETS GRADE PADS TO WITHIN 10' OF PROPERTY LINE.
 - CONTRACTOR TO PROVIDE AS-BUILT INFORMATION NECESSARY FOR CITY GRADING & DRAINAGE CERTIFICATION.
 - SEE TYPICAL LOT GRADING DETAILS
 - CONTRACTOR SHALL OBTAIN A TOP SOIL DISTURBANCE PERMIT PRIOR TO BEGINNING ANY EARTHWORK CONSTRUCTION.
 - CONTRACTOR REQUIRED TO REMOVE SEDIMENT IN STREET WITHIN 24 HOURS.

SCANNED BY LASON

- LEGEND
- EXISTING STANDARD CURB & GUTTER
 - PROPOSED AC CURB
 - PROPOSED STANDARD CURB & GUTTER
 - PROPOSED MOUNTABLE CURB & GUTTER
 - EXISTING GROUND CONTOUR
 - PROPOSED CONCRETE VALLEY GUTTER
 - TRANSITION SECTION FROM FULL CROWN TO NO CROWN SECTION
 - TRANSITION SECTION FROM FULL CROWN TO HALF CROWN
 - TEMPORARY PAVING
 - PROPOSED WHEELCHAIR RAMP
 - PROPOSED SPOT ELEVATION
 - PROPOSED FLOW DIRECTION
 - PROPOSED WATER BLOCK
 - BUILDING PAD & ELEVATION
 - TEMPORARY EROSION CONTROL BERM
 - PROPOSED MANHOLE
 - PROPOSED DROP INLET

A	B	C
50'X50'	45'X50'	40'X50'

PADS

AVID ENGINEERING, INC.
Civil • Structural • Transportation
6100 Seagull St. NE Suite 102
Albuquerque, NM 87109 • (505) 881-5357


20-4004-193 0515

CITY OF ALBUQUERQUE
PUBLIC WORKS DEPARTMENT
ENGINEERING GROUP

TITLE: WILLOW WOOD - UNIT IV
GRADING PLAN
SHEET 1

APPROVALS	ENGINEER	DATE	APPROVALS	ENGINEER	DATE
D.R.C. Chair	89. S. S. S.	7-15-94	Water	N/A RWE	7-8-94
Transportation	M. S. S.	7-01-94	Waste Water	N/A RWE	7-8-94
Hydrology	J. S. S.	7-1-94			
DRAWING NO.	4604.93	MAP NO. L-21-Z	SHEET 5 OF 40		

[illegible]

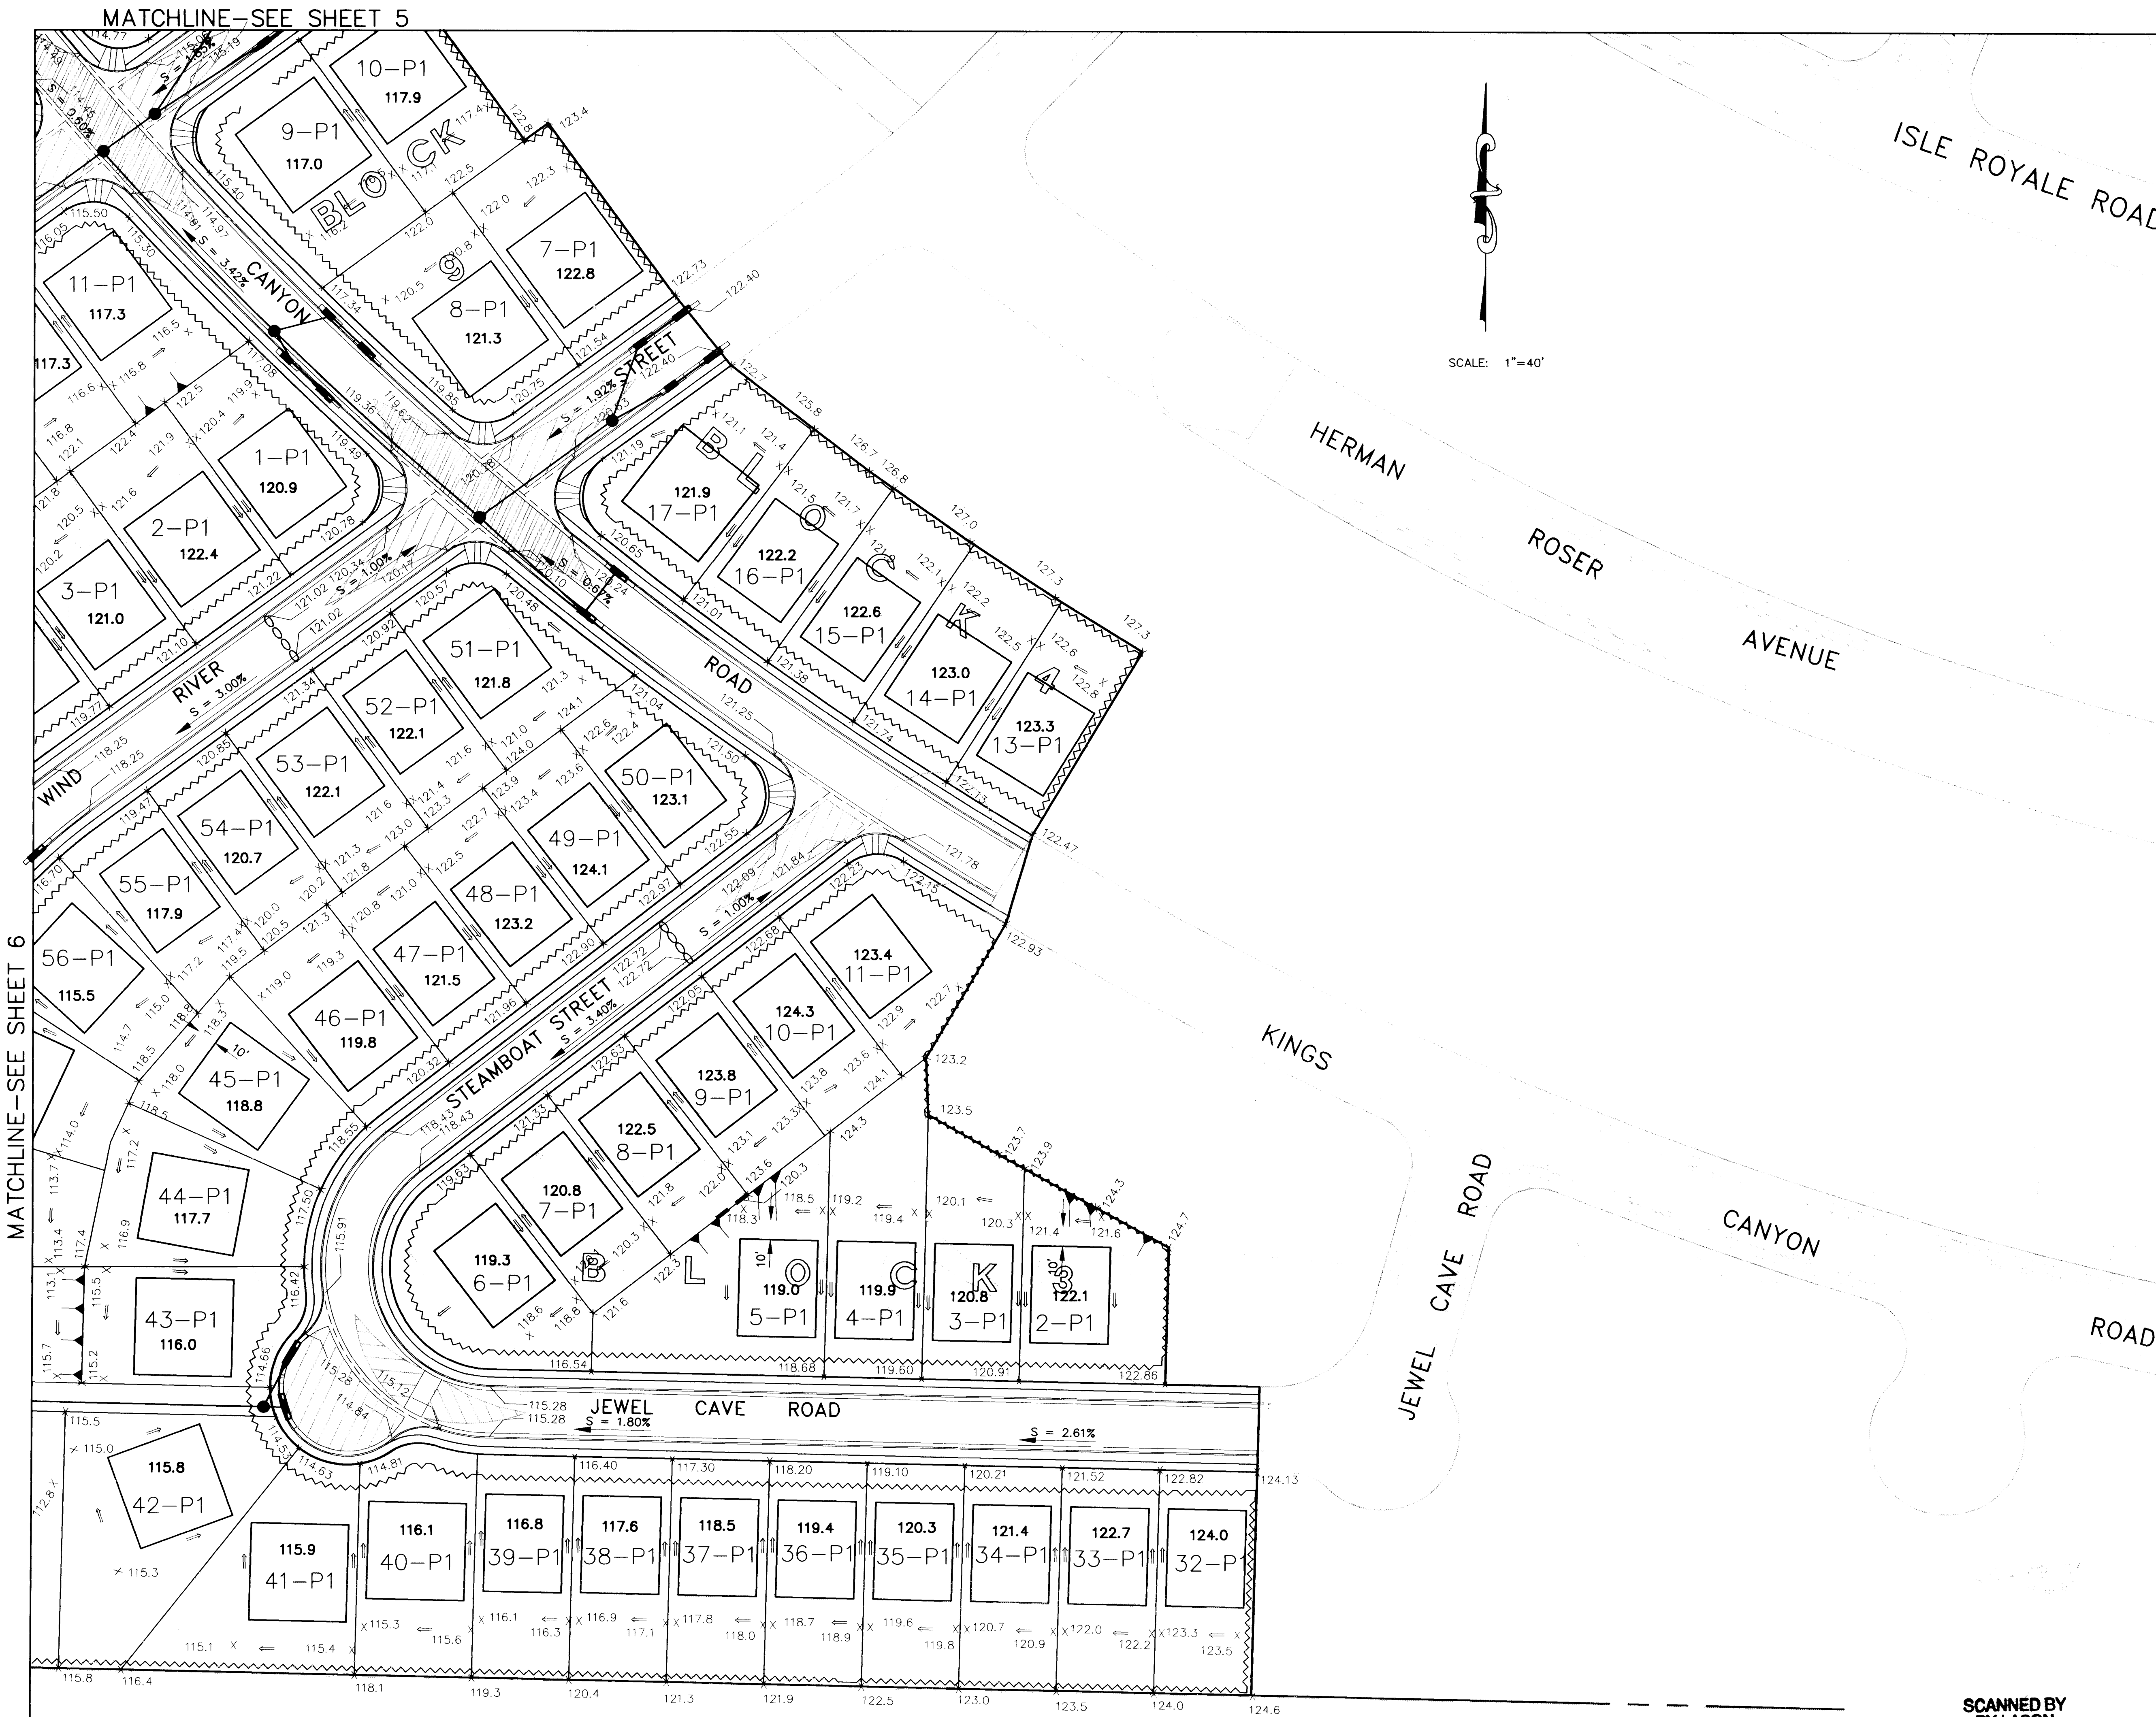

GENERAL NOTES

- ALL CURB ELEVATIONS SHOWN ARE TOP OF CURB UNLESS OTHERWISE NOTED.
- GRADE PADS TO WITHIN 5' OF THE PROPERTY LINE EXCEPT AT SIDESTREETS GRADE PADS TO WITHIN 10' OF PROPERTY LINE.
- CONTRACTOR TO PROVIDE AS-BUILT INFORMATION NECESSARY FOR CITY GRADING & DRAINAGE CERTIFICATION.
- SEE TYPICAL LOT GRADING DETAILS
- CONTRACTOR SHALL OBTAIN A TOP SOIL DISTURBANCE PERMIT PRIOR TO BEGINNING ANY EARTHWORK CONSTRUCTION.
- CONTRACTOR REQUIRED TO REMOVE SEDIMENT IN STREET WITHIN 24 HOURS.

LEGEND

- EXISTING STANDARD CURB & GUTTER
- PROPOSED AC CURB
- PROPOSED STANDARD CURB & GUTTER
- PROPOSED MOUNTABLE CURB & GUTTER
- EXISTING GROUND CONTOUR
- PROPOSED CONCRETE VALLEY GUTTER
- TRANSITION SECTION FROM FULL CROWN TO NO CROWN SECTION
- TRANSITION SECTION FROM FULL CROWN TO HALF CROWN
- TEMPORARY PAVING
- PROPOSED WHEELCHAIR RAMP
- PROPOSED SPOT ELEVATION
- PROPOSED FLOW DIRECTION
- PROPOSED WATER BLOCK
- BUILDING PAD & ELEVATION
- PROPOSED MANHOLE
- PROPOSED DROP INLET

PADS

NO.	DATE	REMARKS	DESIGN	DATE	DRAWN BY	CHECKED BY
A	50'X50'					
B	45'X50'					
C	40'X50'					

AVID ENGINEERING, INC.
Civil • Structural • Transportation
6100 Seagull St. NE - Suite 102
Albuquerque, NM 87109 - (505) 881-5357

24-76014-193 10795



CITY OF ALBUQUERQUE
PUBLIC WORKS DEPARTMENT
ENGINEERING GROUP

TITLE: WILLOW WOOD - UNIT IV
GRADING PLAN
SHEET 3

APPROVALS	ENGINEER	DATE	APPROVALS	ENGINEER	DATE
D.R.C. Chair	B.G. Bockley	7-15-94	Water	N/A RWK	7-8-94
Transportation	M.A. Ebo	7-01-94	Waste Water	N/A RWK	7-8-94
Hydrology	J. Easton	7-1-94			

DRAWING NO. 4604.93 **MAP NO.** L-21-Z **SHEET** 7 **OF** 40

MATCHLINE-SEE SHEET 6

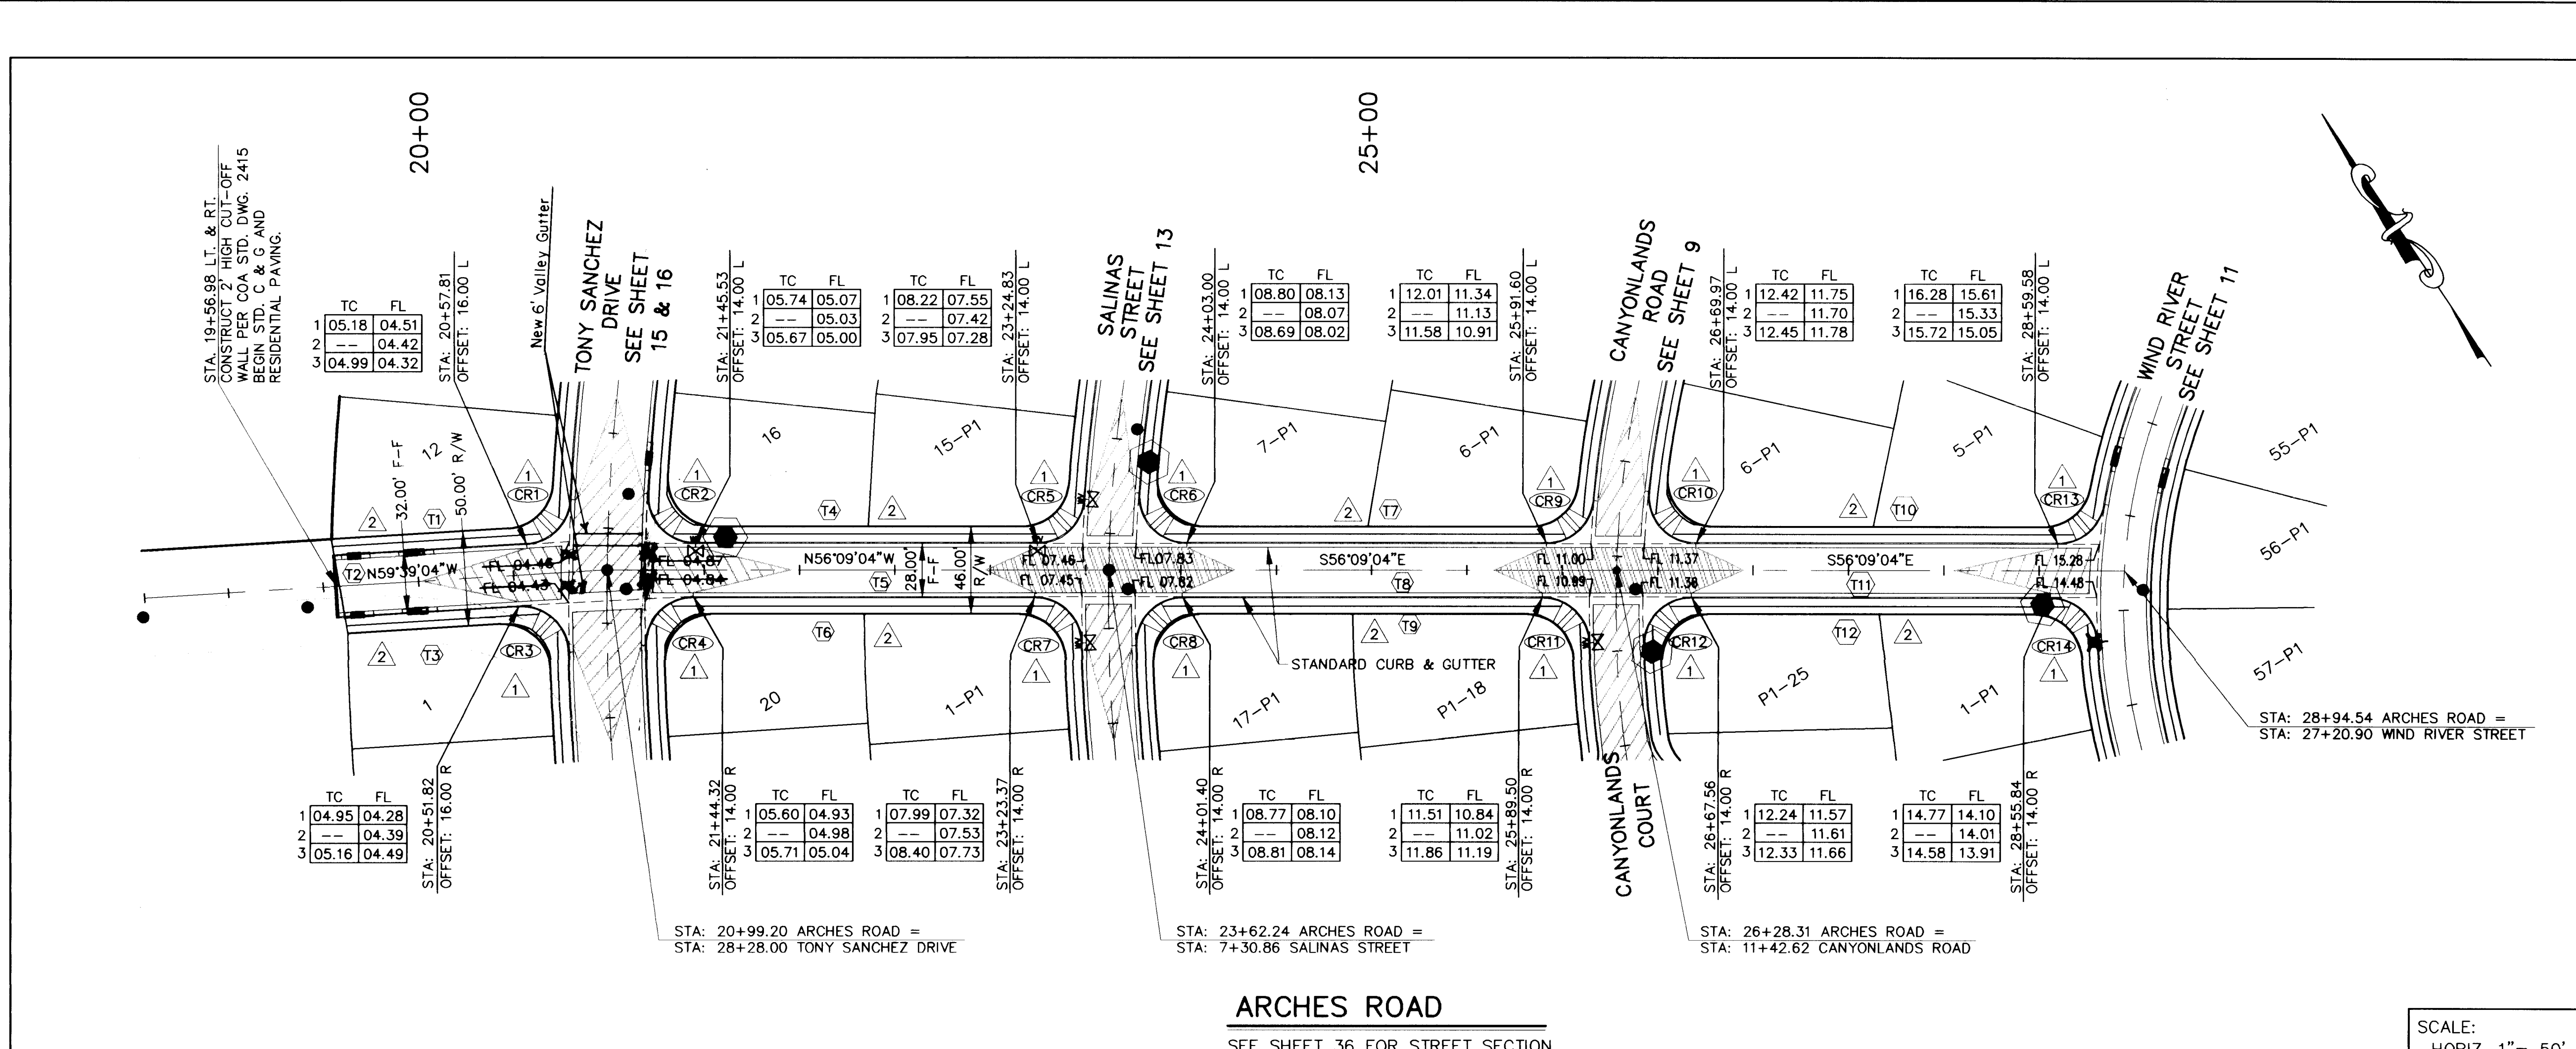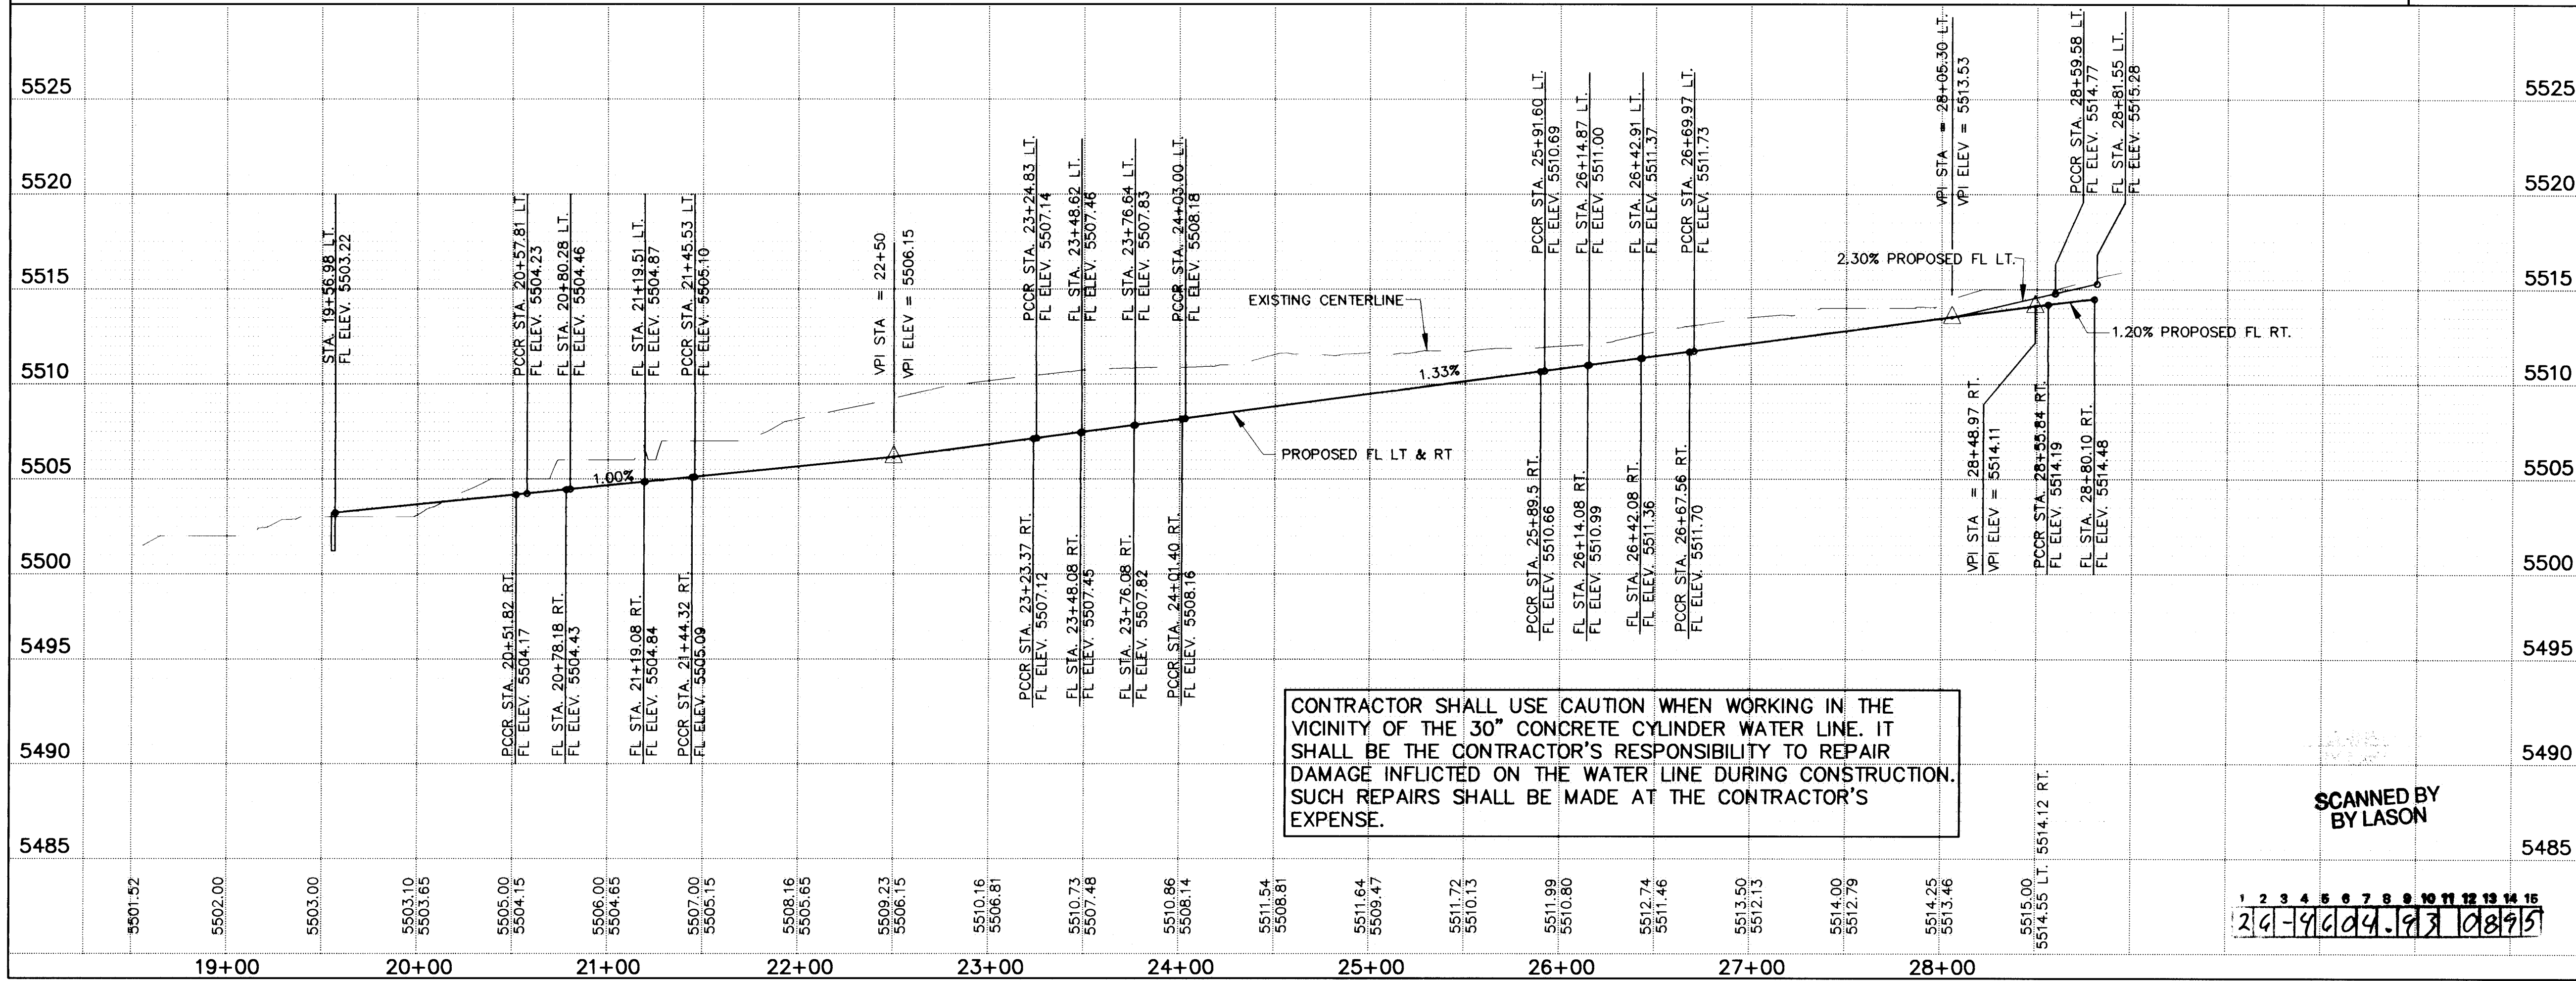

GENERAL NOTES

- ALL STATIONS AND OFFSET DIMENSIONS ARE BASED ON CENTERLINE OF RIGHT-OF-WAY.
- ALL ELEVATIONS ARE FLOWLINE UNLESS OTHERWISE NOTED.

KEYED NOTES

- CONSTRUCT WHEELCHAIR RAMPS PER COA DWG. 2441, TYPE II.
- FUTURE 4' SIDEWALK, BY OTHERS.

ARCHES ROAD

CURB CURVE DATA			
CURVE	DELTA	RADIUS	LENGTH
CR1	83°45'28"	25.00'	36.55'
CR2	93°00'33"	25.00'	40.58'
CR3	92°07'38"	25.00'	40.20'
CR4	91°13'42"	25.00'	39.81'
CR5	86°22'31"	25.00'	37.69'
CR6	93°58'47"	25.00'	41.01'
CR7	88°31'14"	25.00'	38.62'
CR8	91°37'23"	25.00'	39.98'
CR9	84°47'27"	25.00'	37.00'
CR10	95°58'32"	25.00'	41.88'
CR11	87°52'31"	25.00'	38.34'
CR12	92°26'11"	25.00'	40.33'
CR13	80°44'05"	25.00'	35.23'
CR14	86°13'51"	25.00'	37.63'

TANGENT DATA		
TANGENT	BEARING	DISTANCE
(1)	S59°39'04"E	100.83'
(2)	N59°39'04"W	243.43'
(3)	N59°39'04"W	94.83'
(4)	S56°09'04"E	179.30'
(5)	S56°09'04"E	263.04'
(6)	S56°09'04"E	179.05'
(7)	N56°09'04"W	188.60'
(8)	N56°09'04"W	266.07'
(9)	N56°09'04"W	188.10'
(10)	N56°09'04"W	189.62'
(11)	N56°09'04"W	266.22'
(12)	S56°09'04"E	188.28'

LEGEND

- CENTERLINE OF STREET
- EXISTING CURB & GUTTER
- PROPOSED ASPHALT CURB
- PROPOSED STANDARD CURB & GUTTER
- PROPOSED MOUNTABLE CURB & GUTTER
- PROPOSED WHEELCHAIR RAMP
- PROPOSED CONCRETE VALLEY GUTTER
- TRANSITION SECTION FROM FULL CROWN TO NO CROWN SECTION (MINIMUM 50' TRANSITION)
- TRANSITION SECTION FROM FULL CROWN TO HALF CROWN
- PROPOSED MANHOLE
- PROPOSED STREET LIGHT LOCATION
- EXISTING VALVES
- EXISTING MANHOLE
- PROPOSED WATER VALVE
- PROPOSED STORM INLET
- PROPOSED FIRE HYDRANT

ENGINEER'S SEAL

AS BUILT INFORMATION

CONTRACTOR	NEW CONCEPTS INC.
STAMPED BY	COA
DATE	DATE
FIELD BY	DATE
DATE	DATE
CORRECTED BY	DATE
RECORDED BY	DATE

NO. DATE

REMARKS


DESIGN

DATE

CITY OF ALBUQUERQUE
PUBLIC WORKS DEPARTMENT
ENGINEERING GROUP

TITLE: WILLOW WOOD - UNIT IV
ARCHES ROAD
PAVING PLAN AND PROFILE

APPROVALS	ENGINEER	DATE	APPROVALS	ENGINEER	DATE
D.R.C. Chair	7-15-94	Water	7-15-94	7-15-94	7-15-94
Transportation	7-01-94	Waste Water	7-01-94	7-01-94	7-01-94
Hydrology	7-1-94				

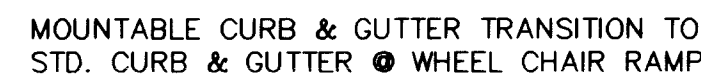

SEE SHEET 36 FOR STREET SECTION

SCALE:
HORIZ. 1" = 50'
VERT. 1" = 5'




1	2	3	4	5	6	7	8	9	10	11	12	13	14	15	
2	6	-	4	4	0	4	.	9	3			0	9	9	5

AVID ENGINEERING, INC.
Civil • Structural • Transportation
6100 Seagull St. NE - Suite 102
Albuquerque, NM 87109 - (505) 881-5357


DRAWING NO. 4604.93	MAP NO. L-21-Z	SHEET 9 OF 40
------------------------	-------------------	---------------


[illegible]

CANYON.DWG

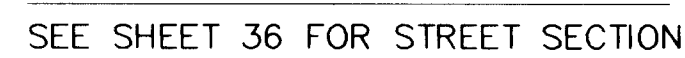

DRAWING NO.	4604.93	MAP NO. L-21-Z	SHEET 10	OF 40
----------------	---------	-------------------	-------------	----------

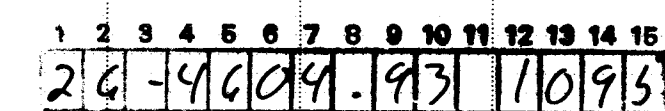


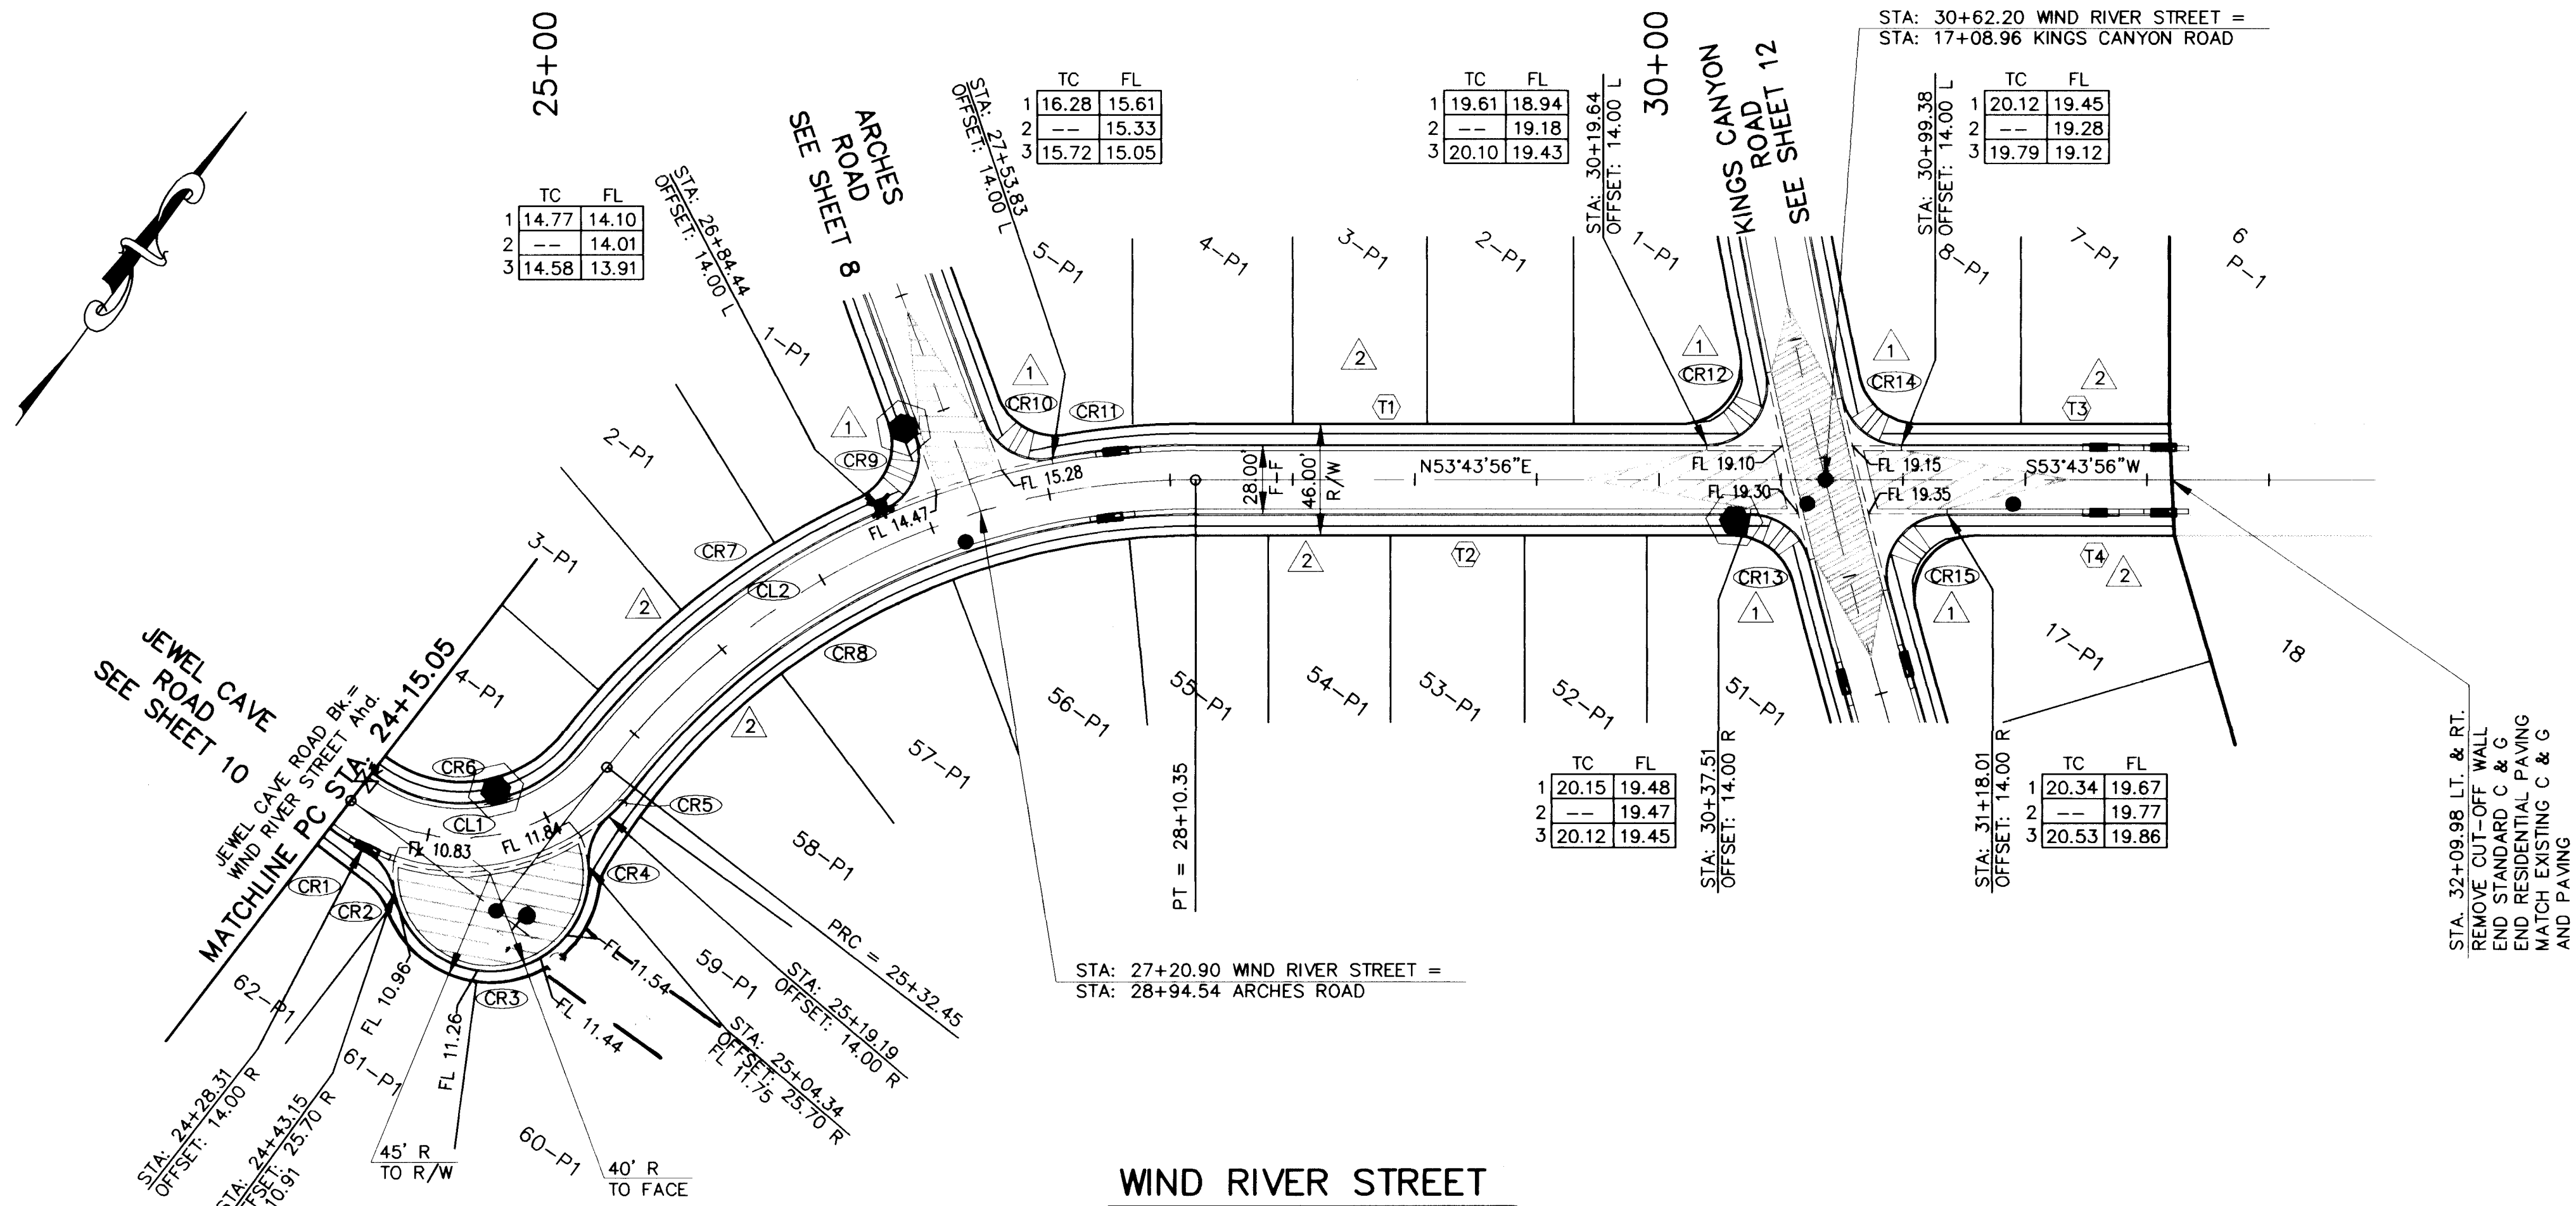

WIND RIVER STREET

SEE SHEET 36 FOR STREET SECTION

SCALE:
HORIZ. 1" = 50'
VERT. 1" = 5'

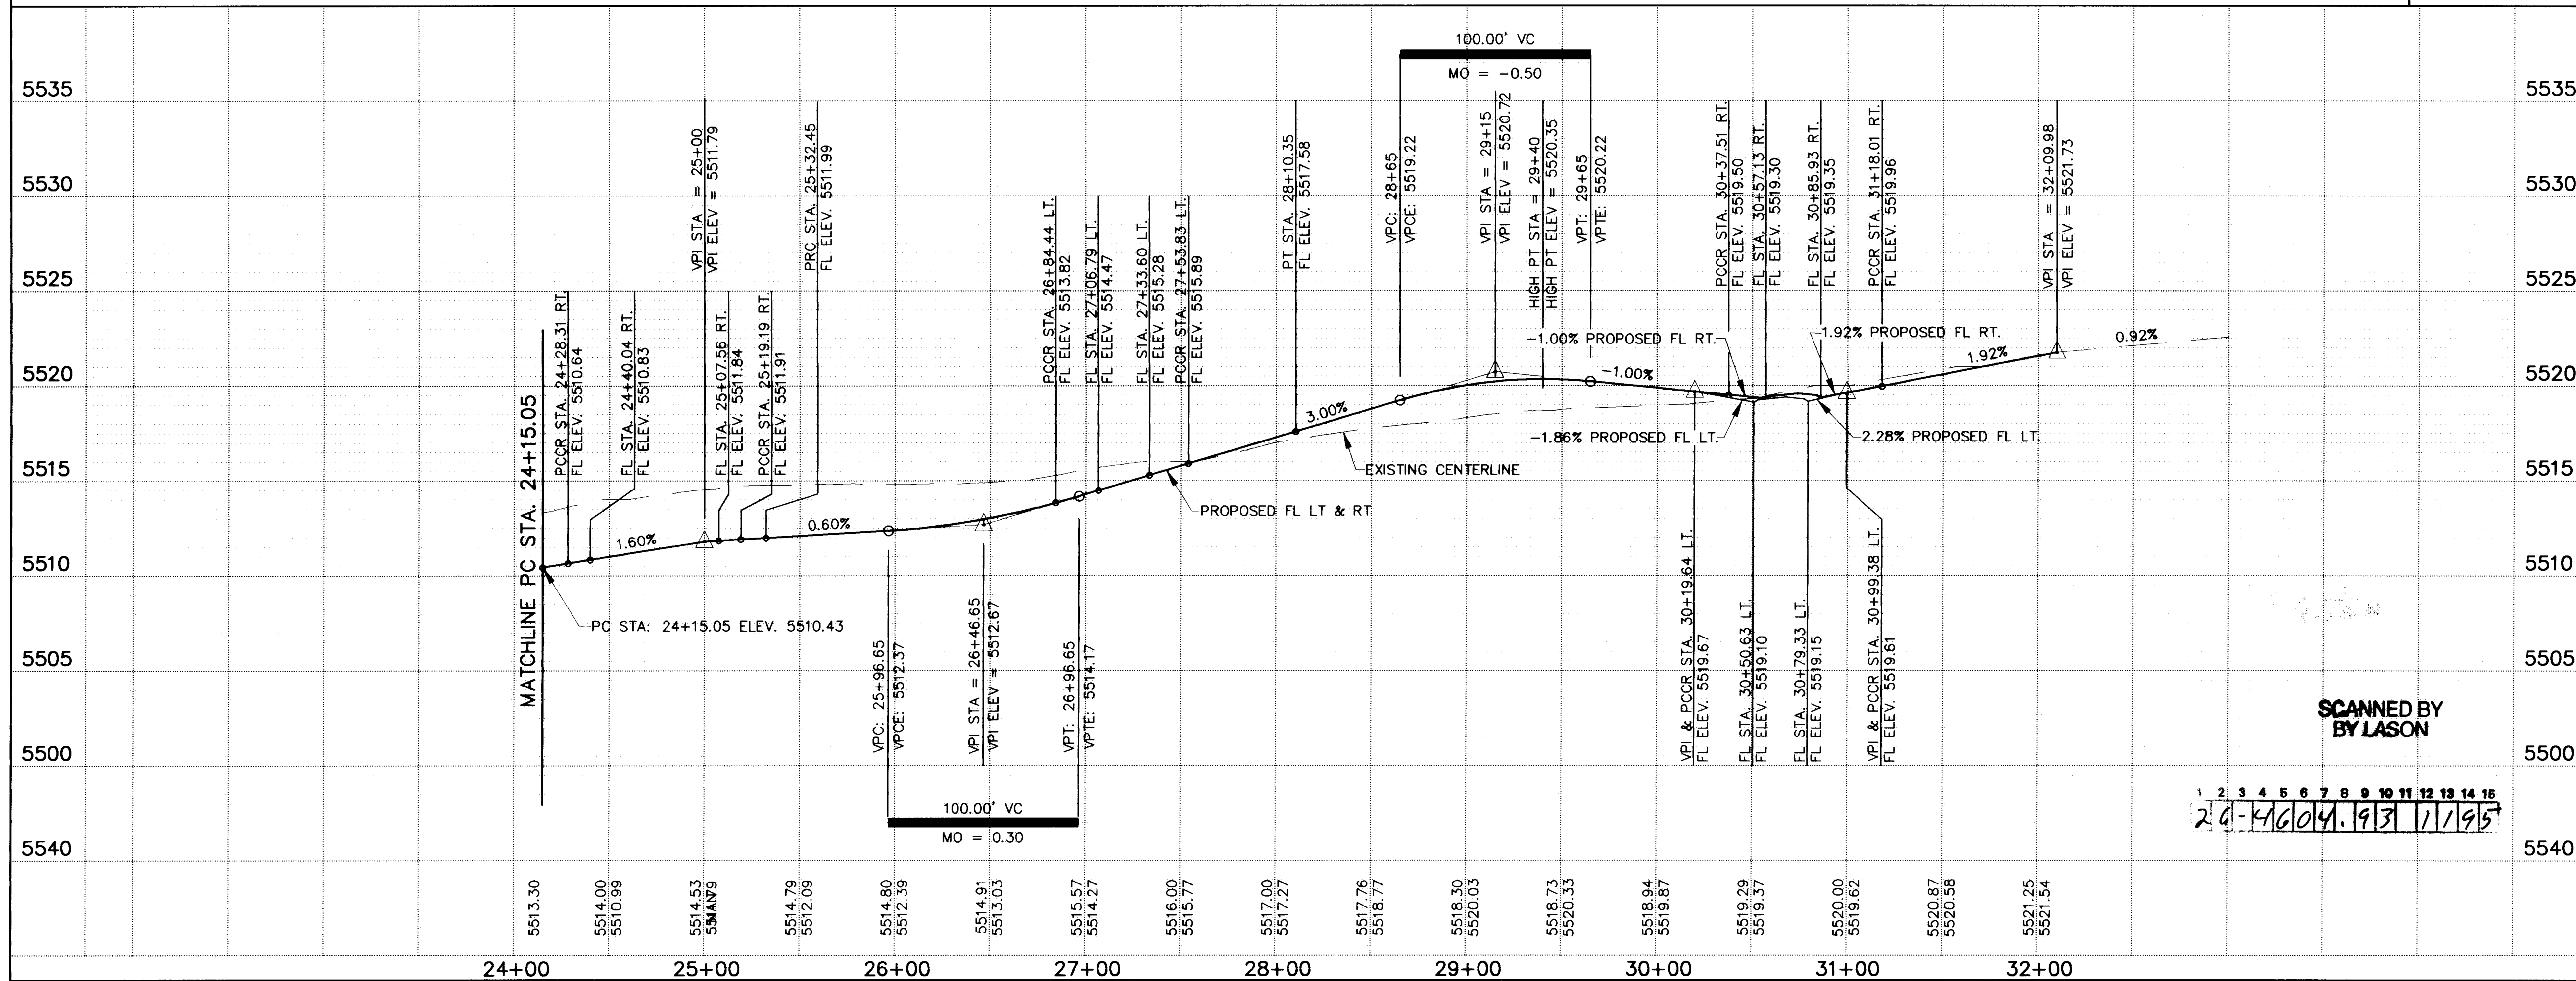

SCANNED BY
BY LASON

24-4604.93 1/1/95

- GENERAL NOTES**
- ALL STATIONS AND OFFSET DIMENSIONS ARE BASED ON CENTERLINE OF RIGHT-OF-WAY.
 - ALL ELEVATIONS ARE FLOWLINE UNLESS OTHERWISE NOTED.
- KEYED NOTES**
- CONSTRUCT WHEELCHAIR RAMPS PER COA DWG. 2441, TYPE II.
 - FUTURE 4' SIDEWALK, BY OTHERS.

WIND RIVER STREET

CURVE	DELTA	RADIUS	LENGTH	TANGENT
CR1	10°08'00"	89.00'	15.74'	7.89'
CR2	52°21'31"	25.00'	22.85'	12.29'
CR3	174°08'18"	40.00'	121.57'	781.28'
CR4	52°21'31"	25.00'	22.85'	12.29'
CR5	10°08'00"	89.00'	15.74'	7.89'
CR6	89°41'16"	61.00'	95.49'	60.67'
CR7	28°33'07"	319.00'	158.97'	81.17'
CR8	52°12'17"	25.00'	265.14'	142.57'
CR9	86°13'51"	25.00'	37.63'	23.41'
CR10	80°44'05"	25.00'	35.23'	21.25'
CR11	10°37'05"	319.00'	59.12'	29.64'
CR12	101°45'49"	25.00'	44.40'	30.74'
CR13	75°57'27"	25.00'	33.14'	19.52'
CR14	77°45'17"	25.00'	33.93'	20.16'
CR15	104°37'16"	25.00'	45.65'	32.36'

CENTERLINE CURVE DATA

CURVE	DELTA	RADIUS	LENGTH	TANGENT
CL1	89°41'16"	75.00'	117.40'	74.59'
CL2	52°12'17"	305.00'	277.90'	149.43'

TANGENT DATA

TANGENT	BEARING	DISTANCE
T1	N53°43'56"E	209.29'
T2	N53°43'56"E	227.16'
T3	N53°43'56"E	110.60'
T4	S53°43'56"W	91.97'

LEGEND

- CENTERLINE OF STREET
- EXISTING CURB & GUTTER
- PROPOSED ASPHALT CURB
- PROPOSED STANDARD CURB & GUTTER
- PROPOSED MOUNTABLE CURB & GUTTER
- PROPOSED WHEELCHAIR RAMP
- PROPOSED CONCRETE VALLEY GUTTER
- TRANSITION SECTION FROM FULL CROWN TO NO CROWN SECTION (MINIMUM 50' TRANSITION)
- TRANSITION SECTION FROM FULL CROWN TO HALF CROWN
- PROPOSED MANHOLE
- PROPOSED STREET LIGHT LOCATION
- EXISTING VALVES
- EXISTING MANHOLE
- PROPOSED WATER VALVE
- PROPOSED STORM INLET
- PROPOSED FIRE HYDRANT



AVID ENGINEERING, INC.
Civil • Structural • Transportation
6100 Seagull St. NE, Suite 102
Albuquerque, NM 87109 • (505) 881-5357

CITY OF ALBUQUERQUE
PUBLIC WORKS DEPARTMENT
ENGINEERING GROUP

TITLE: WILLOW WOOD - UNIT IV
WIND RIVER STREET
PAVING PLAN AND PROFILE

APPROVALS	ENGINEER	DATE	APPROVALS	ENGINEER	DATE
D.R.C. Chair	8/1/94	7-15-94	Water	N/A RWR	7-8-94
Transportation	8/1/94	7-15-94	Waste Water	N/A RWR	7-8-94
Hydrology	8/1/94	7-15-94			

DRAWING NO. 4604.93 **MAP NO.** L-21-Z **SHEET** 11 **OF** 40

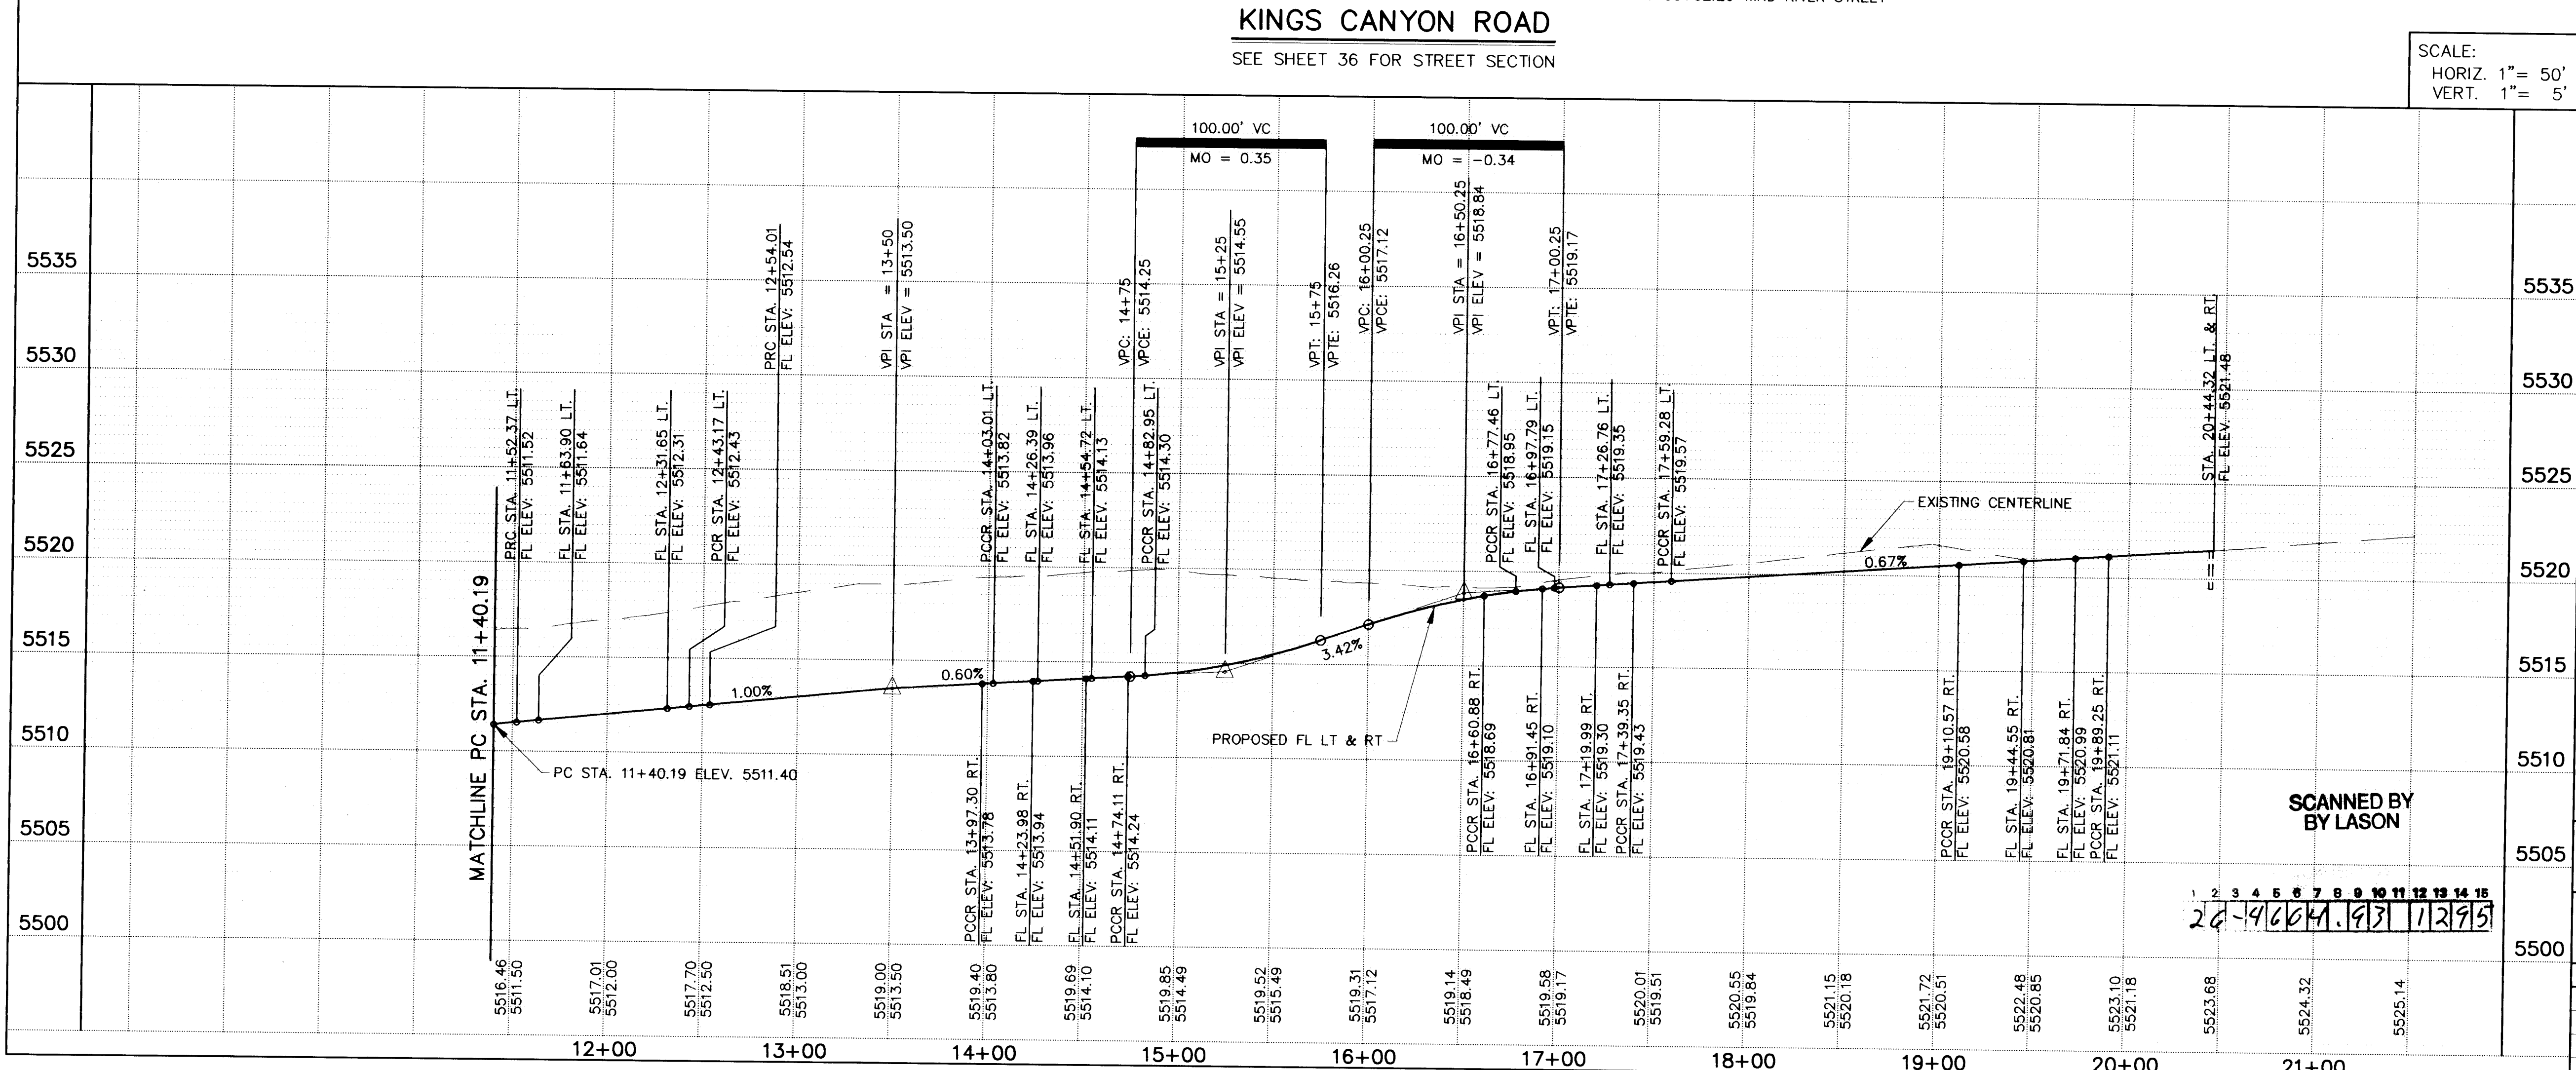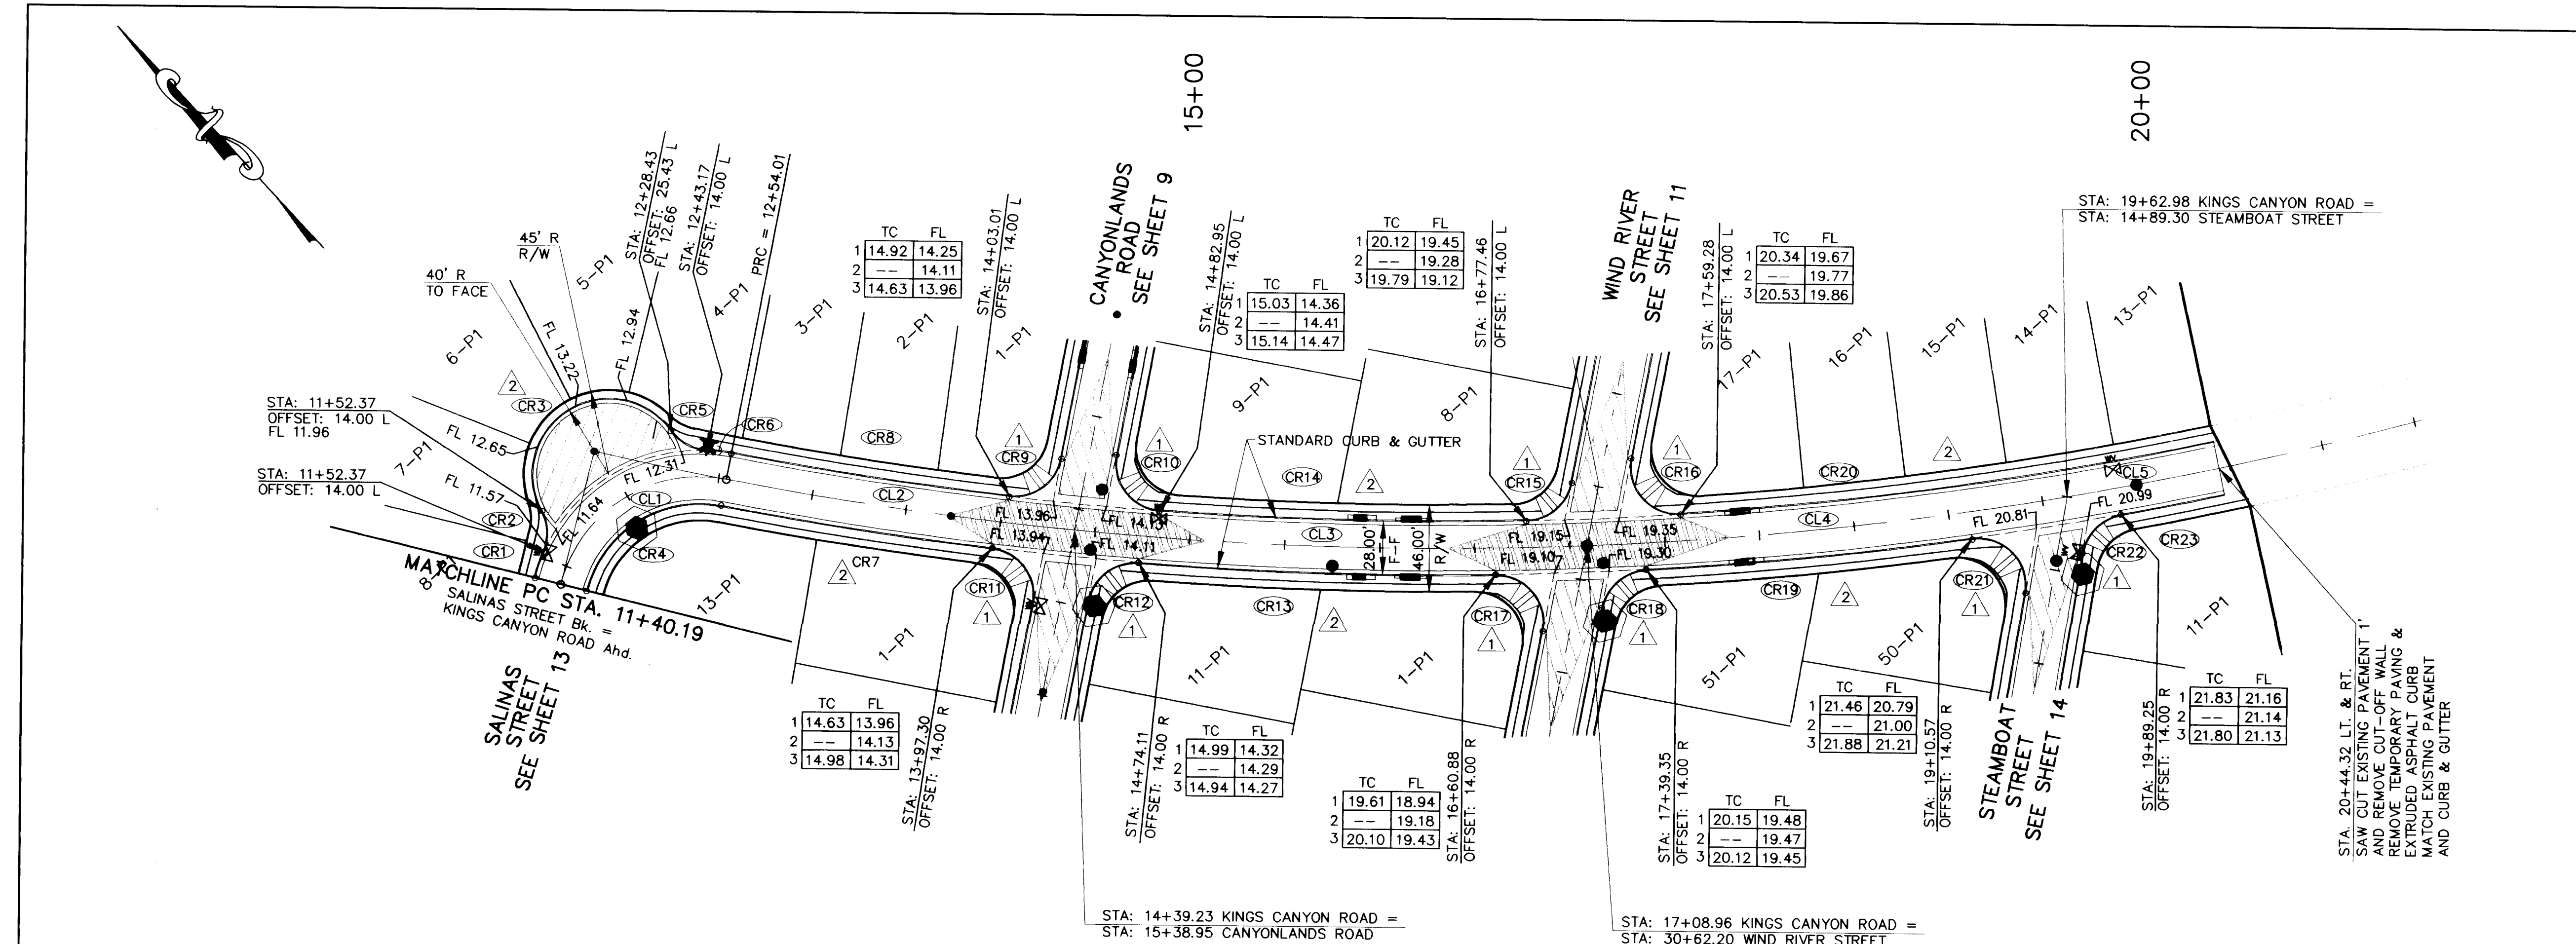

GENERAL NOTES

- ALL STATIONS AND OFFSET DIMENSIONS ARE BASED ON CENTERLINE OF RIGHT-OF-WAY.
- ALL ELEVATIONS ARE FLOWLINE UNLESS OTHERWISE NOTED.

KEYED NOTES

- CONSTRUCT WHEELCHAIR RAMPS PER COA DWG. 2441, TYPE II.
- FUTURE 4' SIDEWALK, BY OTHERS.

KINGS CANYON ROAD

CURB CURVE DATA			
CURVE	DELTA	RADIUS	TANGENT
CR1	09°18'19"	89.00'	14.45'
CR2	51°40'48"	25.00'	22.55'
CR3	172°43'29"	40.00'	120.58'
CR4	86°57'12"	61.00'	92.57'
CR5	51°40'48"	25.00'	22.55'
CR6	08°16'59"	89.00'	12.87'
CR7	04°09'39"	1987.00'	144.30'
CR8	04°19'37"	1959.00'	147.94'
CR9	85°43'29"	25.00'	37.40'
CR10	96°55'48"	25.00'	42.15'
CR11	94°06'33"	25.00'	41.06'
CR12	83°39'36"	25.00'	36.50'
CR13	05°25'25"	1987.00'	188.09'
CR14	05°38'55"	1959.00'	193.13'
CR15	77°45'17"	25.00'	33.93'
CR16	104°37'16"	25.00'	45.65'
CR17	101°45'49"	25.00'	44.40'
CR18	75°57'27"	25.00'	33.14'
CR19	04°58'19"	1987.00'	172.43'
CR20	08°16'45"	1959.00'	283.07'
CR21	107°32'57"	25.00'	46.93'
CR22	70°09'57"	25.00'	30.62'
CR23	01°36'03"	1987.00'	55.52'

CENTERLINE CURVE DATA			
CURVE	DELTA	RADIUS	TANGENT
CL1	86°57'12"	75.00'	113.82'
CL2	05°22'44"	1973.00'	185.22'
CL3	07°49'58"	1973.00'	269.73'
CL4	07°22'36"	1973.00'	254.02'
CL5	02°21'49"	1973.00'	81.40'

LEGEND

- CENTERLINE OF STREET
- EXISTING CURB & GUTTER
- PROPOSED ASPHALT CURB
- PROPOSED STANDARD CURB & GUTTER
- PROPOSED MOUNTABLE CURB & GUTTER
- PROPOSED WHEELCHAIR RAMP
- PROPOSED CONCRETE VALLEY GUTTER
- TRANSITION SECTION FROM FULL CROWN TO NO CROWN SECTION (MINIMUM 50' TRANSITION)
- TRANSITION SECTION FROM FULL CROWN TO HALF CROWN
- PROPOSED MANHOLE
- PROPOSED STREET LIGHT LOCATION
- EXISTING VALVES
- EXISTING MANHOLE
- PROPOSED WATER VALVE
- PROPOSED STORM INLET
- PROPOSED FIRE HYDRANT


AVID ENGINEERING, INC.
Civil • Structural • Transportation
6100 Seagull St. NE - Suite 102
Albuquerque, NM 87109 - (505) 881-5357

CITY OF ALBUQUERQUE
PUBLIC WORKS DEPARTMENT
ENGINEERING GROUP

TITLE: WILLOW WOOD - UNIT IV
KINGS CANYON ROAD
PAVING PLAN AND PROFILE


APPROVALS	ENGINEER	DATE	APPROVALS	ENGINEER	DATE
D.R.C. Chair	7-15-94	Water	N/A RWE	7-8-94	
Transportation	7-01-94	Waste Water	N/A RWE	7-8-94	
Hydrology	7-1-94				

DRAWING NO. 4604.93
MAP NO. L-21-Z
SHEET 12 **OF** 40

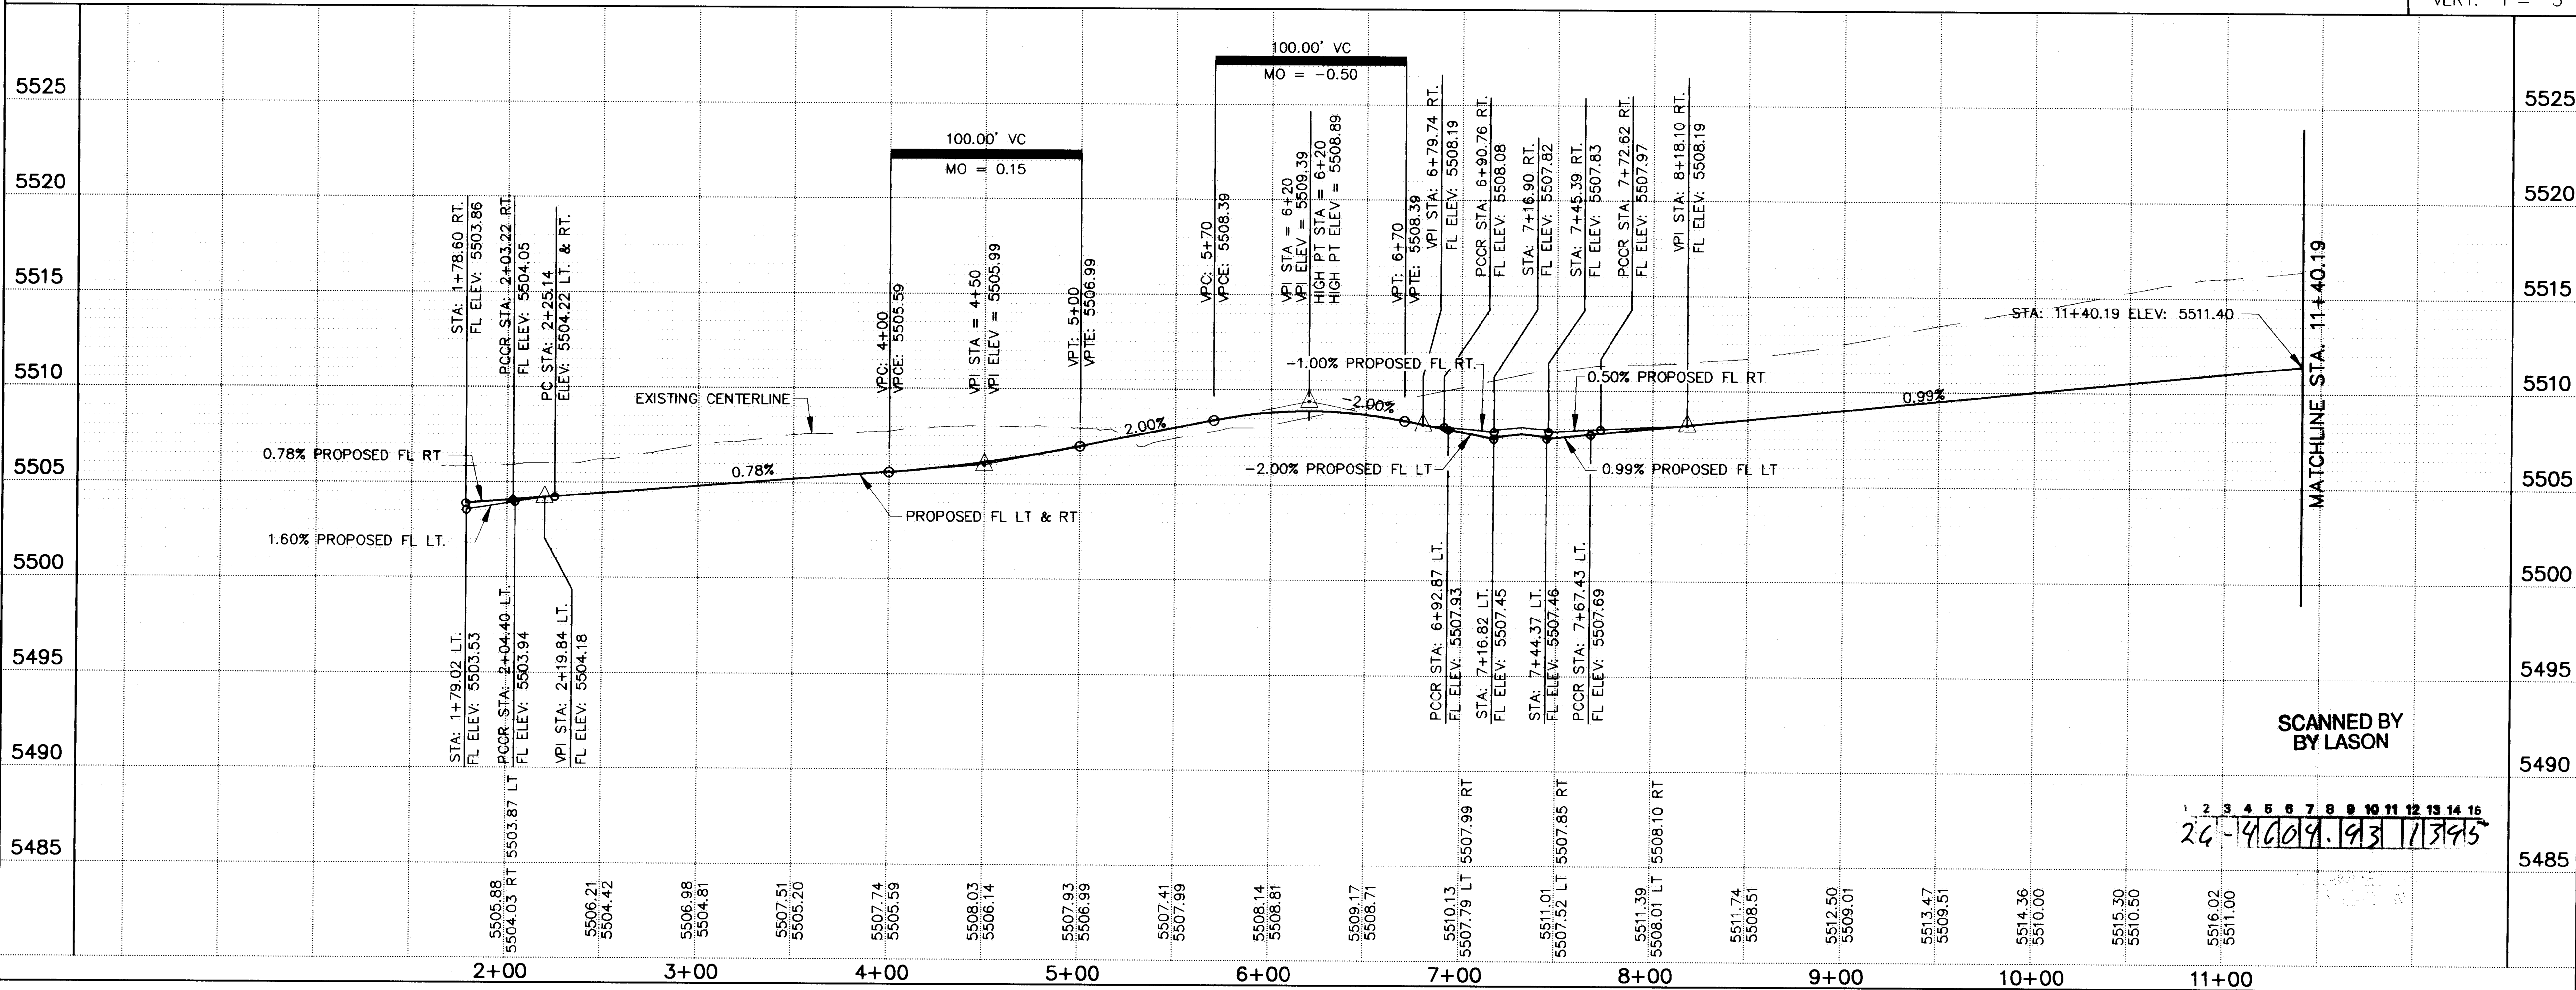

SALINAS STREET

SEE SHEET 36 FOR STREET SECTION

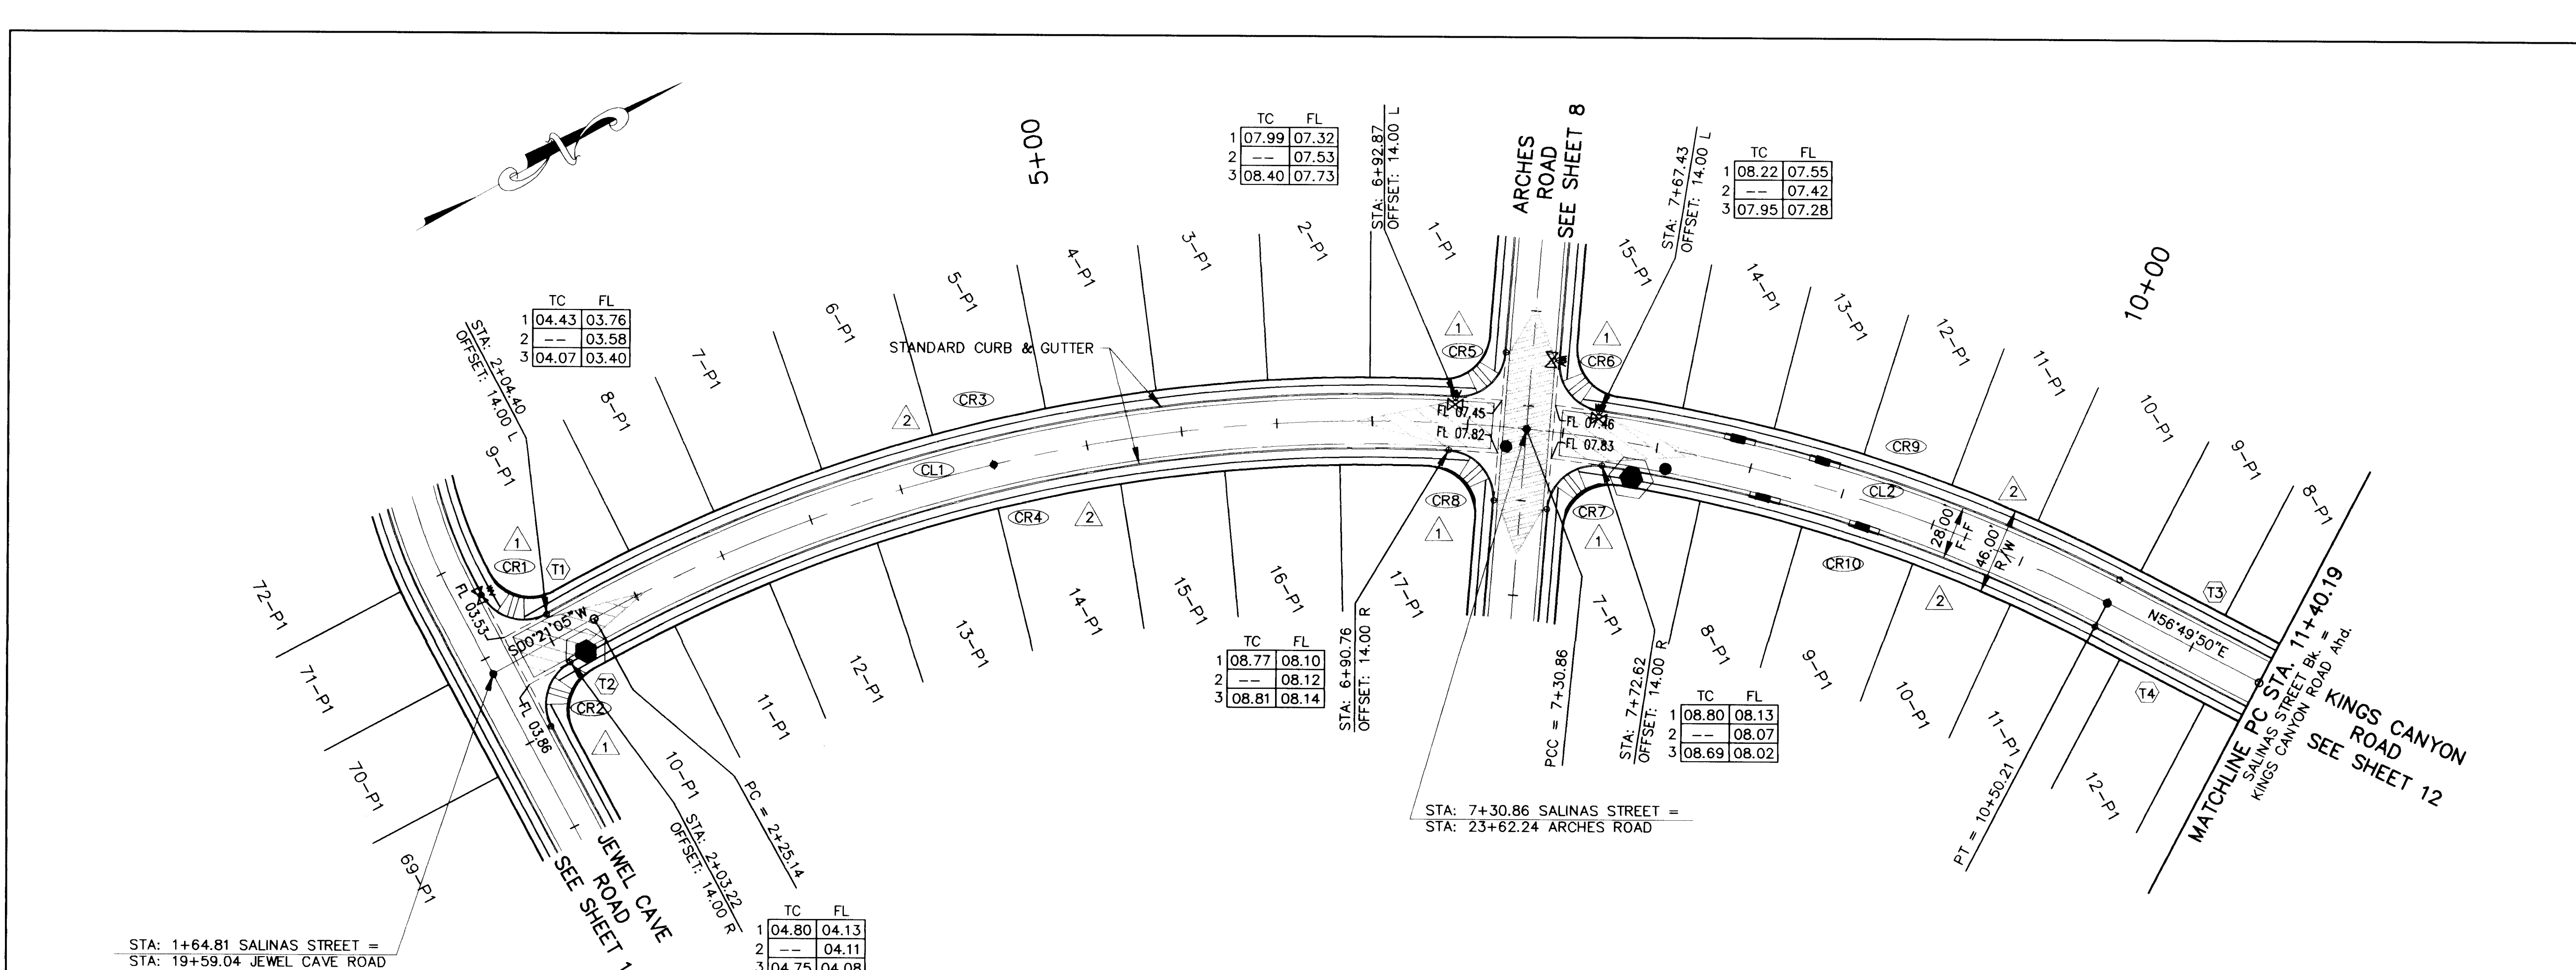

GENERAL NOTES

- ALL STATIONS AND OFFSET DIMENSIONS ARE BASED ON CENTERLINE OF RIGHT-OF-WAY.
- ALL ELEVATIONS ARE FLOWLINE UNLESS OTHERWISE NOTED.

KEYED NOTES

- CONSTRUCT WHEELCHAIR RAMPS PER COA DWG. 2441, TYPE II.
- FUTURE 4' SIDEWALK, BY OTHERS.

SALINAS STREET

CURB CURVE DATA				
CURVE	DELTA	RADIUS	LENGTH	TANGENT
CR1	90°51'50"	25.00'	39.65'	25.38'
CR2	89°08'10"	25.00'	38.89'	24.63'
CR3	32°01'05"	851.00'	475.56'	244.17'
CR4	31°52'24"	823.00'	457.83'	235.01'
CR5	88°31'14"	25.00'	38.62'	24.36'
CR6	86°22'31"	25.00'	37.69'	23.47'
CR7	93°58'47"	25.00'	41.01'	26.80'
CR8	91°37'27"	25.00'	39.98'	25.72'
CR9	19°21'24"	851.00'	287.50'	145.13'
CR10	19°00'07"	823.00'	272.94'	137.74'

CENTERLINE CURVE DATA			
CURVE	DELTA	RADIUS	TANGENT
CL1	34°37'09"	837.00'	260.85'
CL2	21°51'36"	837.00'	161.64'

TANGENT DATA		
TANGENT	BEARING	DISTANCE
T1	N00°21'05"E	20.74'
T2	N00°21'05"E	21.91'
T3	N56°49'50"E	89.98'
T4	N56°49'50"E	89.98'

LEGEND

- CENTERLINE OF STREET
- EXISTING CURB & GUTTER
- PROPOSED ASPHALT CURB
- PROPOSED STANDARD CURB & GUTTER
- PROPOSED MOUNTABLE CURB & GUTTER
- PROPOSED WHEELCHAIR RAMP
- PROPOSED CONCRETE VALLEY GUTTER
- TRANSITION SECTION FROM FULL CROWN TO NO CROWN SECTION (MINIMUM 50' TRANSITION)
- TRANSITION SECTION FROM FULL CROWN TO HALF CROWN
- PROPOSED MANHOLE
- PROPOSED STREET LIGHT LOCATION
- EXISTING VALVES
- EXISTING MANHOLE
- PROPOSED WATER VALVE
- PROPOSED STORM INLET
- PROPOSED FIRE HYDRANT

ENGINEER'S SEAL

NO. DATE		REMARKS		BY	
DESIGNED BY	DATE	CHECKED BY	DATE		

CITY OF ALBUQUERQUE


PUBLIC WORKS DEPARTMENT

ENGINEERING GROUP

TITLE: **WILLOW WOOD - UNIT IV**
SALINAS STREET
PAVING PLAN AND PROFILE


APPROVALS	ENGINEER	DATE	APPROVALS	ENGINEER	DATE
D.R.C. Chair	<i>[Signature]</i>	7-15-94	Water	<i>[Signature]</i>	7-8-94
Transportation	<i>[Signature]</i>	7-01-94	Waste Water	<i>[Signature]</i>	7-8-94
Hydrology	<i>[Signature]</i>	7-1-94			

DRAWING NO.	MAP NO.	SHEET	OF
4604.93	L-21-Z	13	40

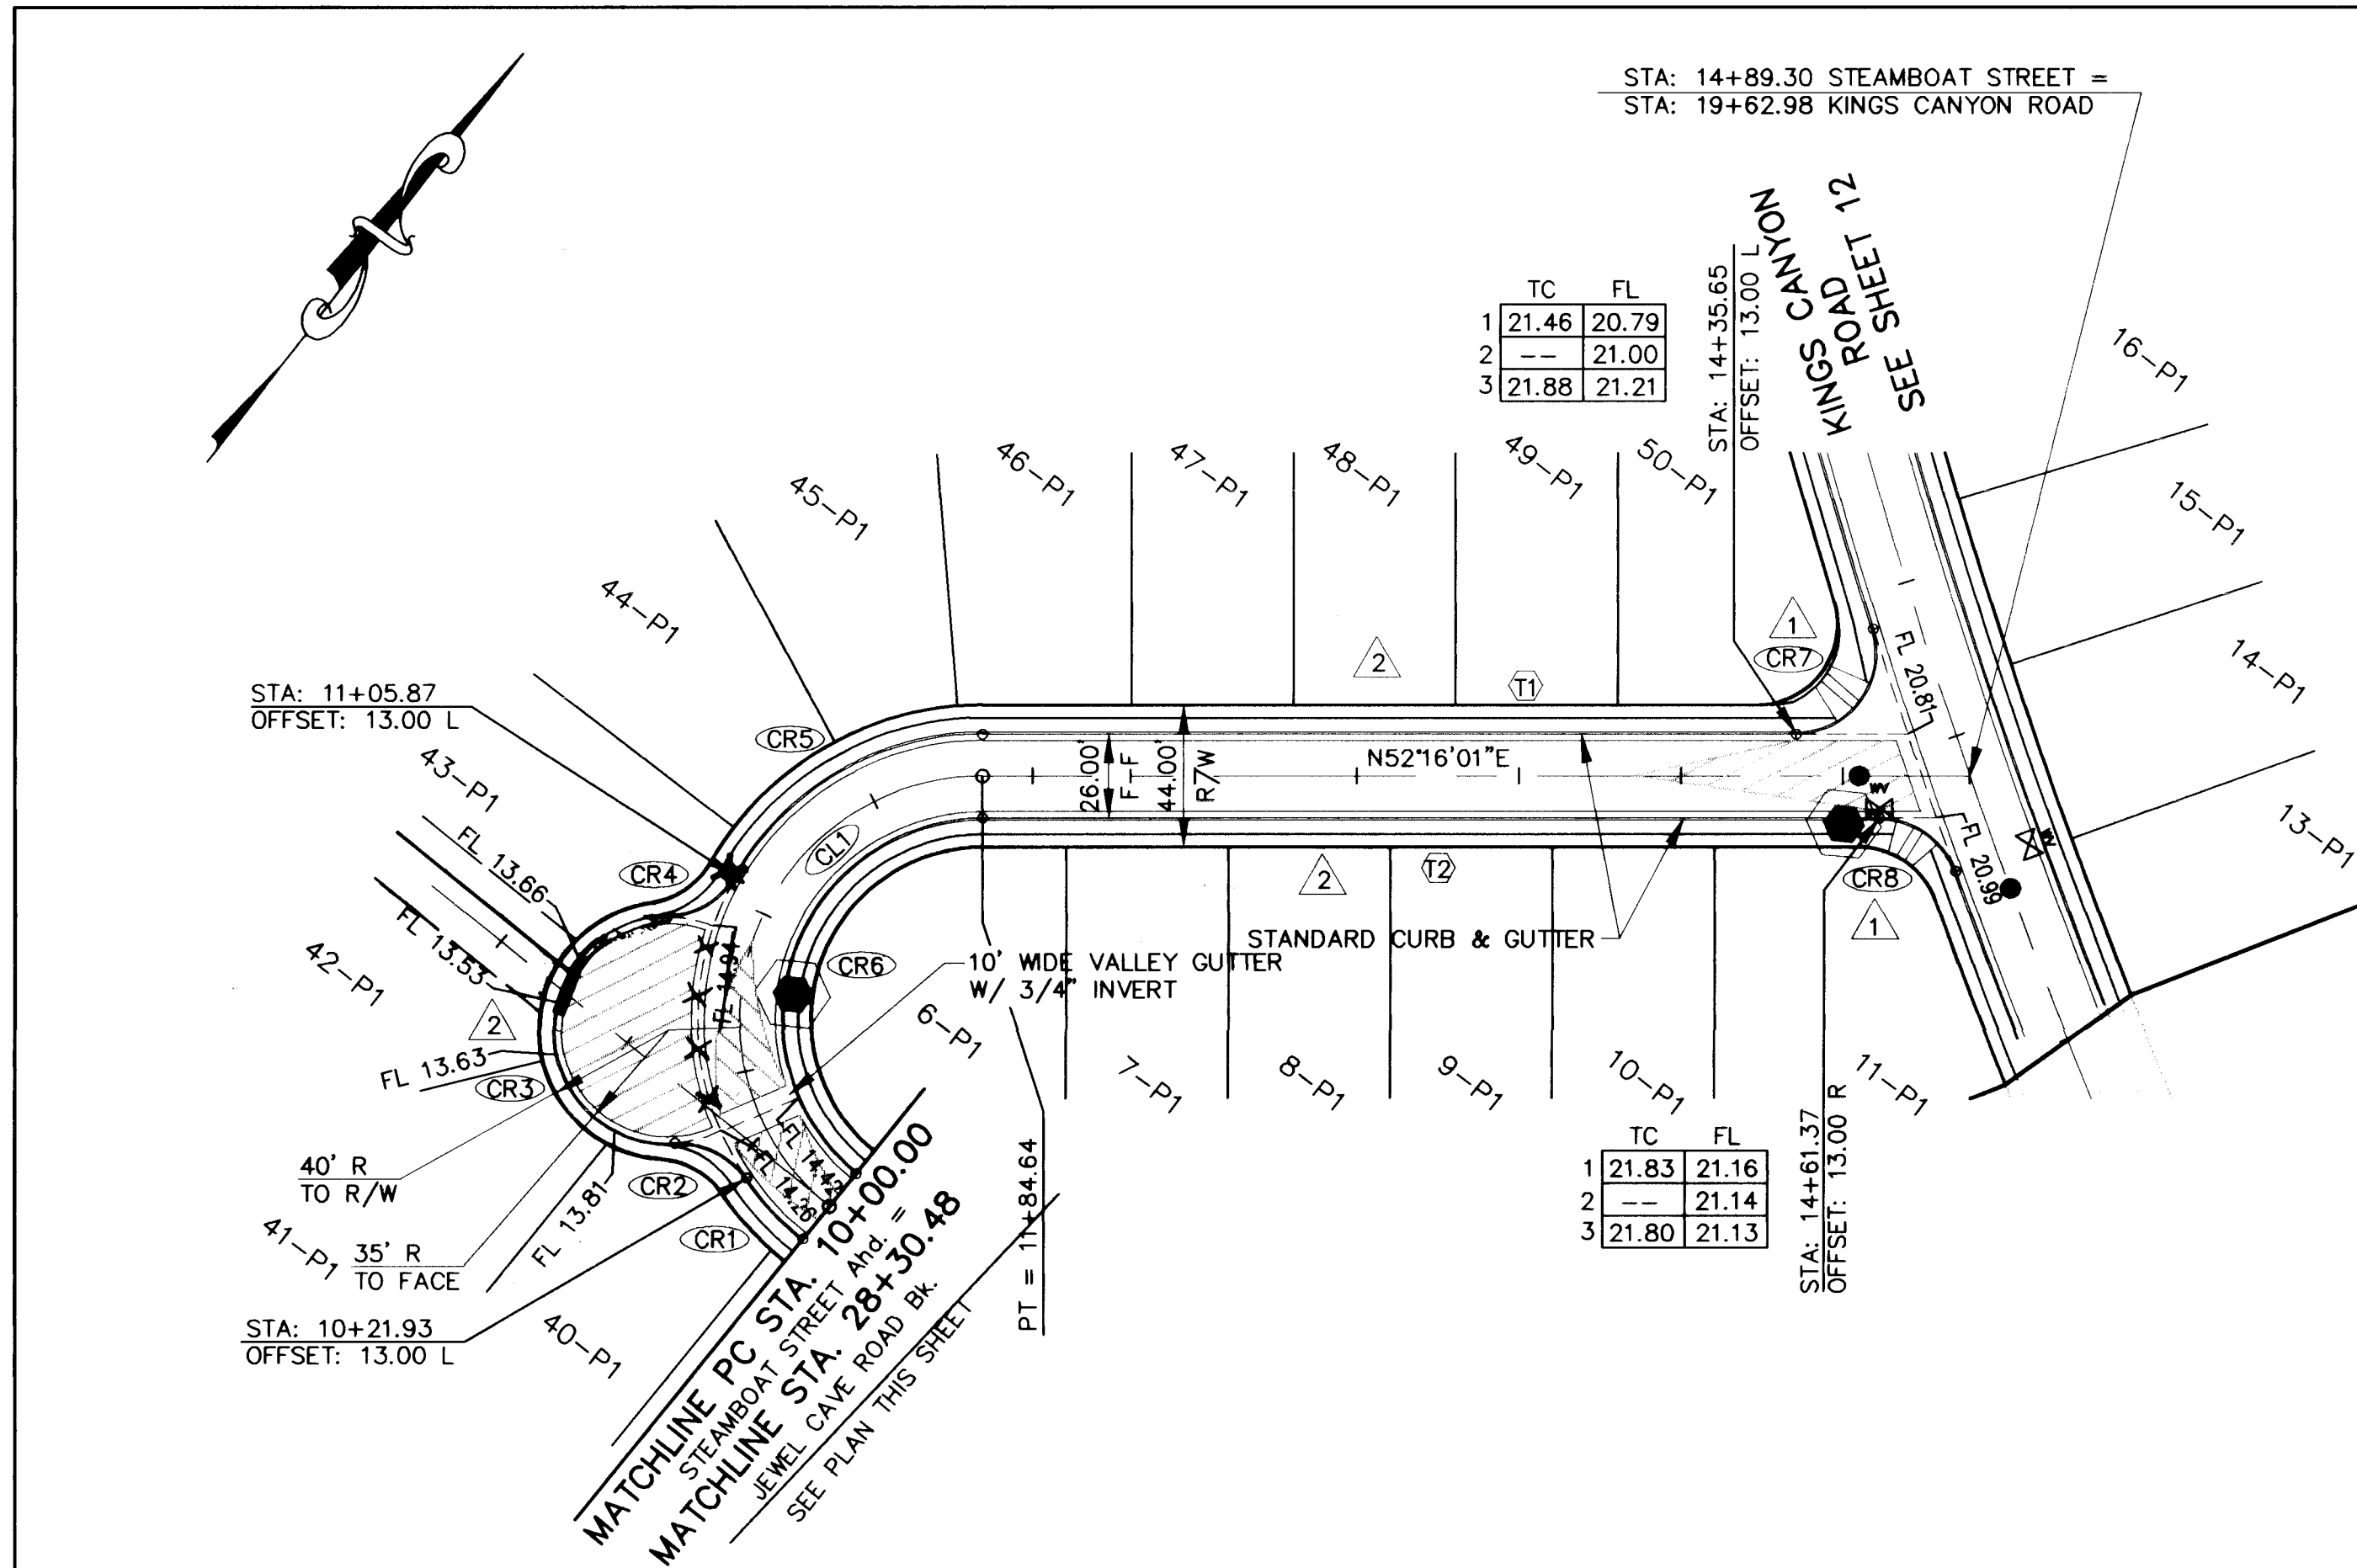

STEAMBOAT STREET



SEE SHEET 36 FOR STREET SECTION

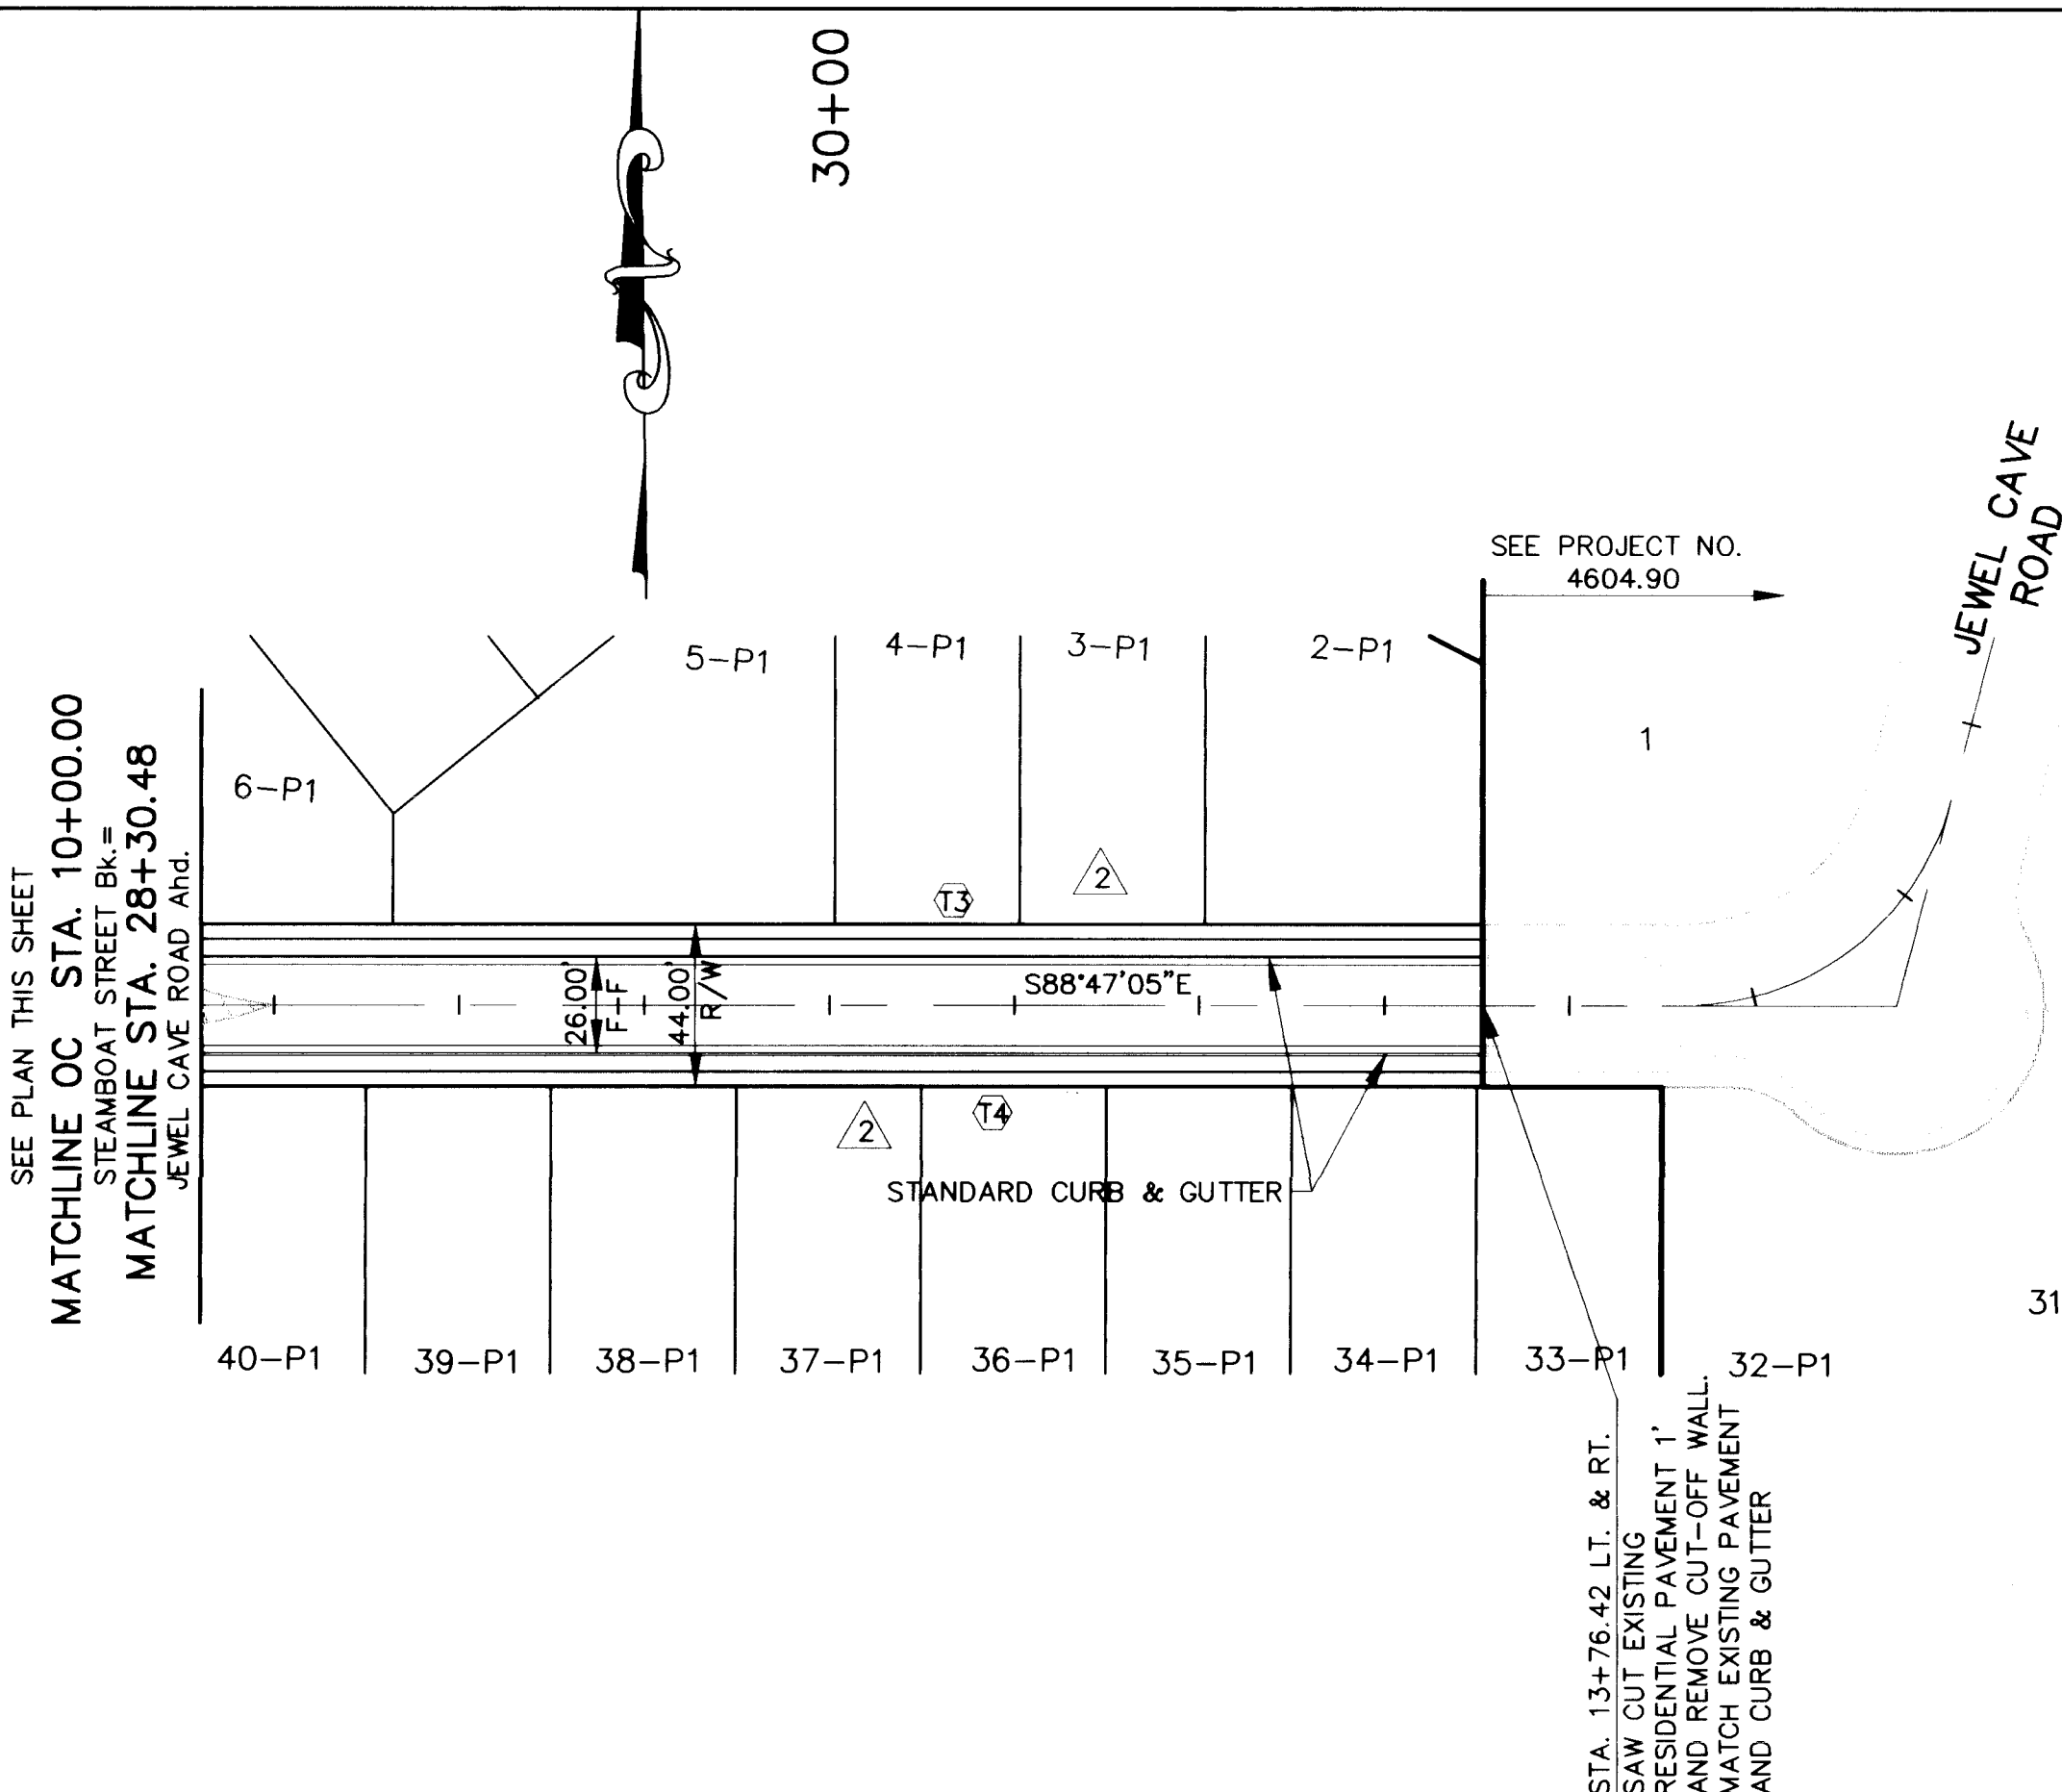

JEWEL CAVE ROAD

SEE SHEET 36 FOR STREET SECTION

SCALE:
HORIZ. 1" = 50'
VERT. 1" = 5'

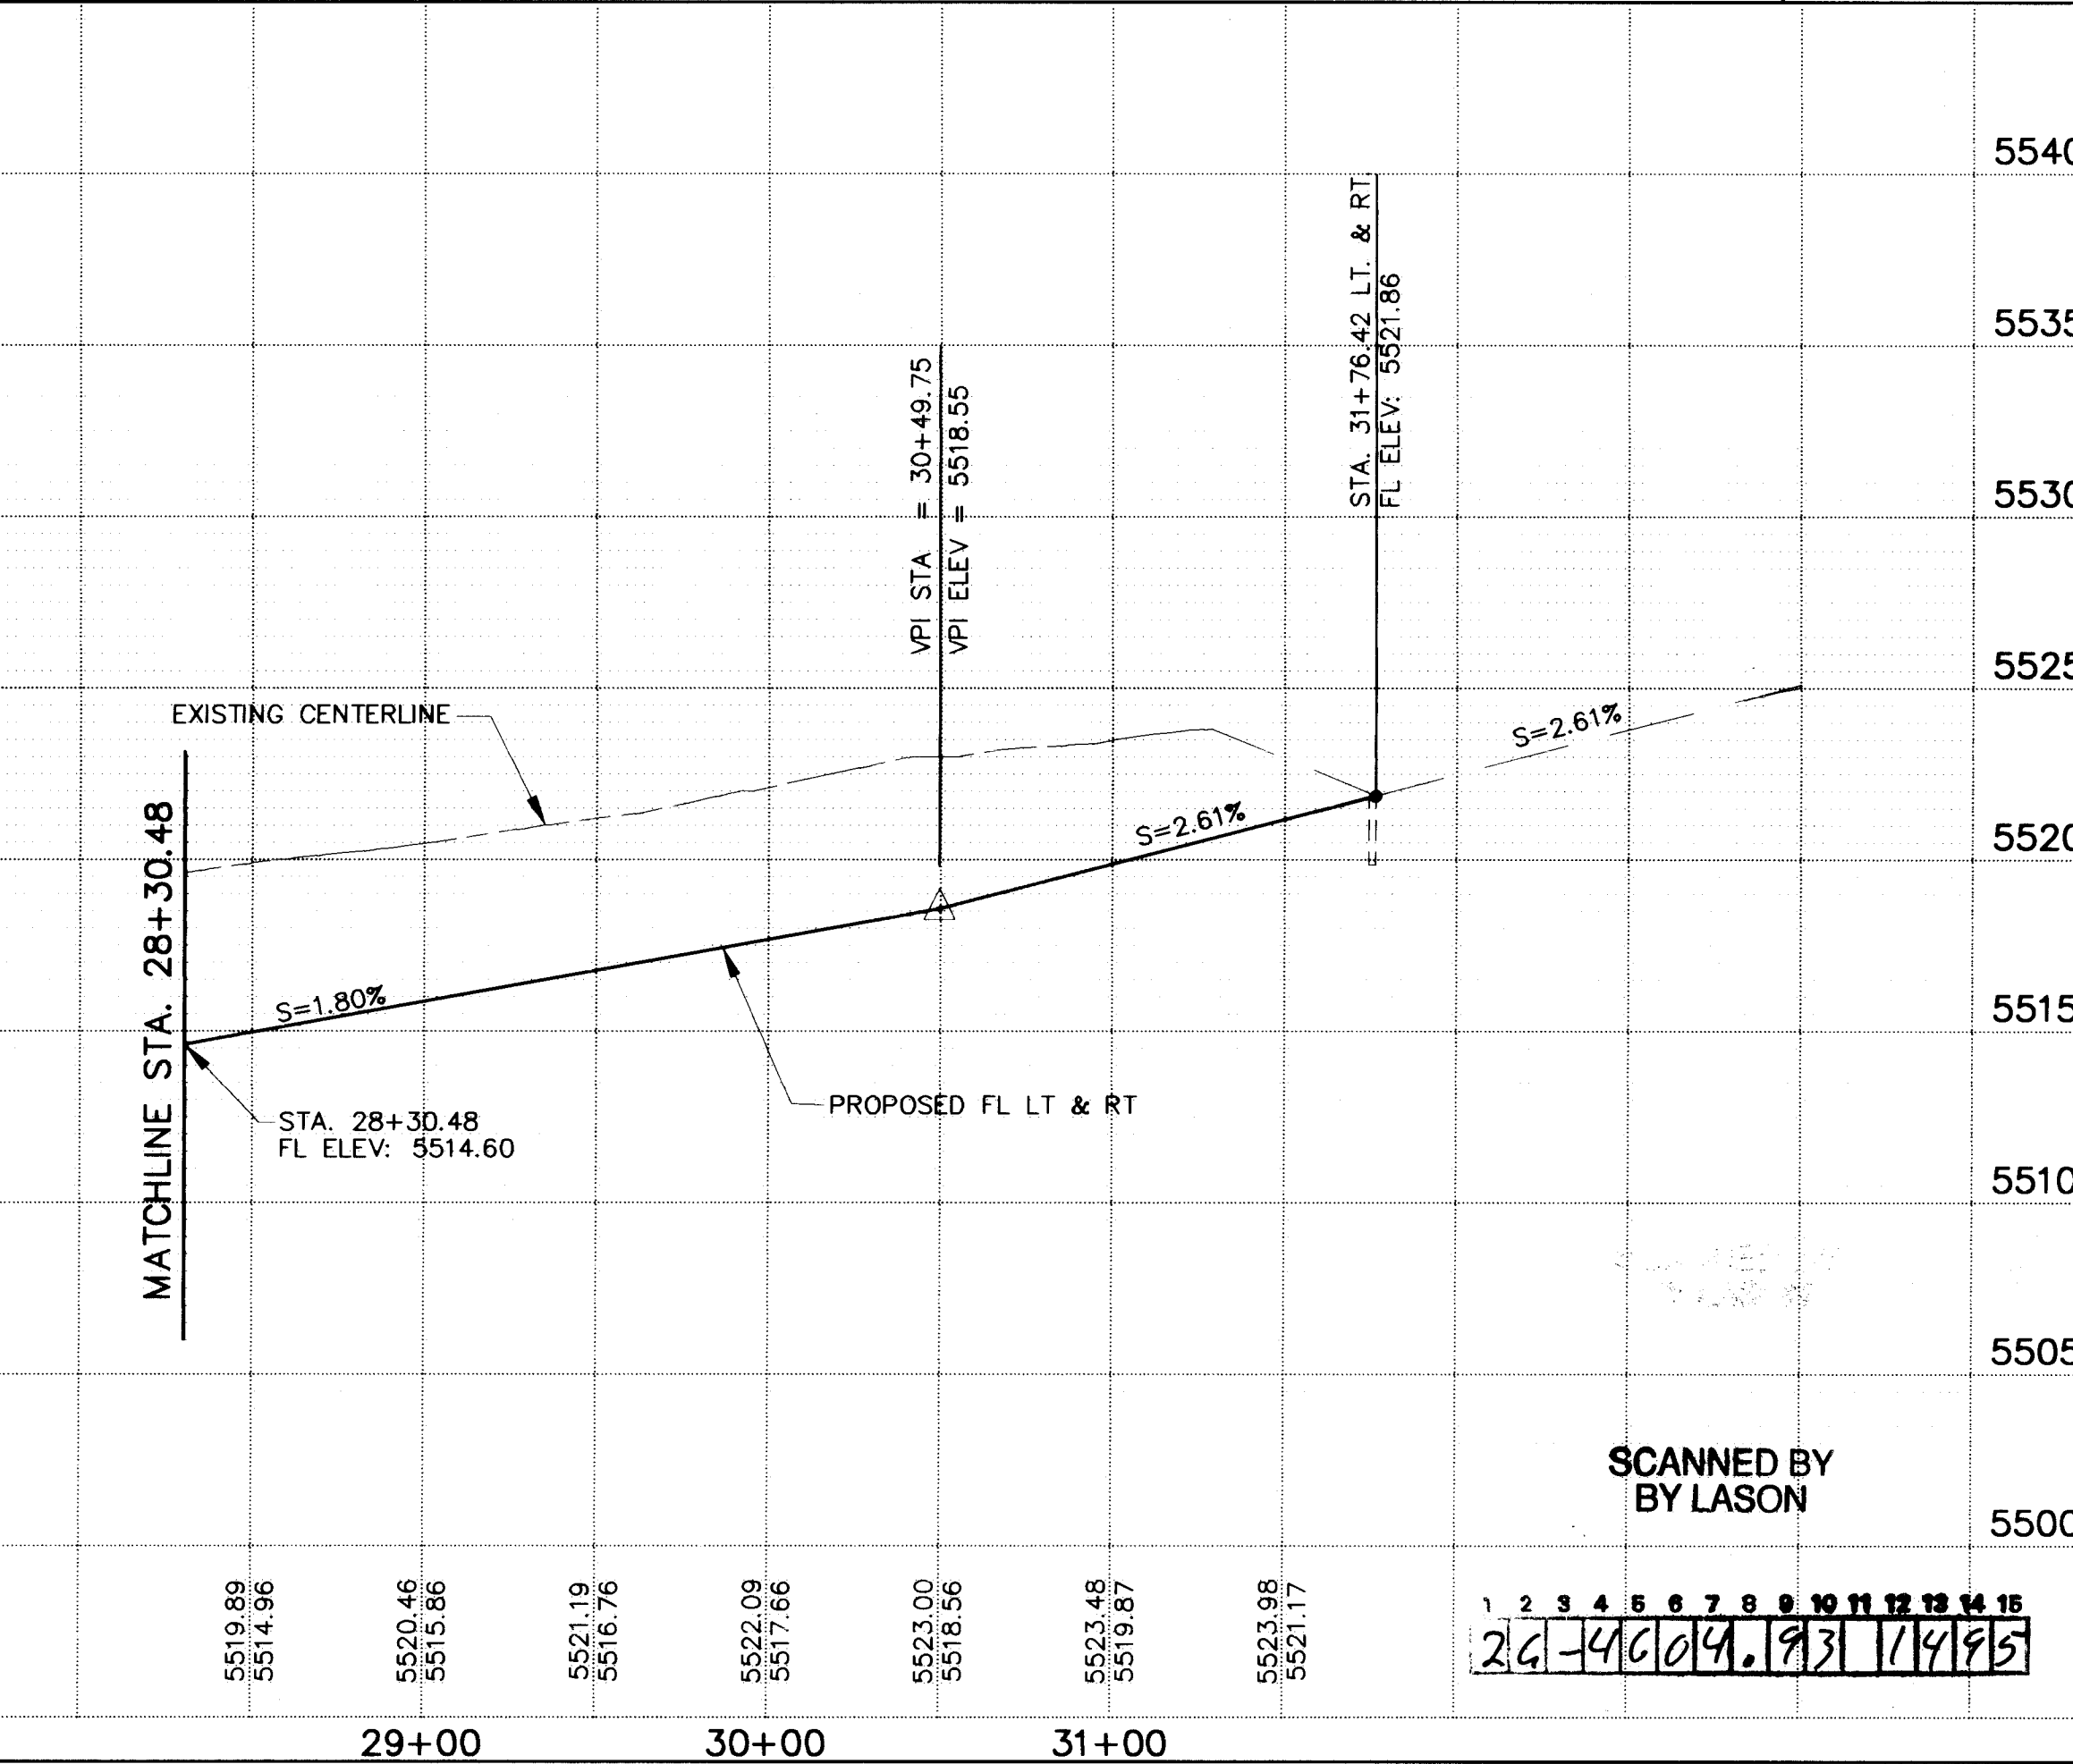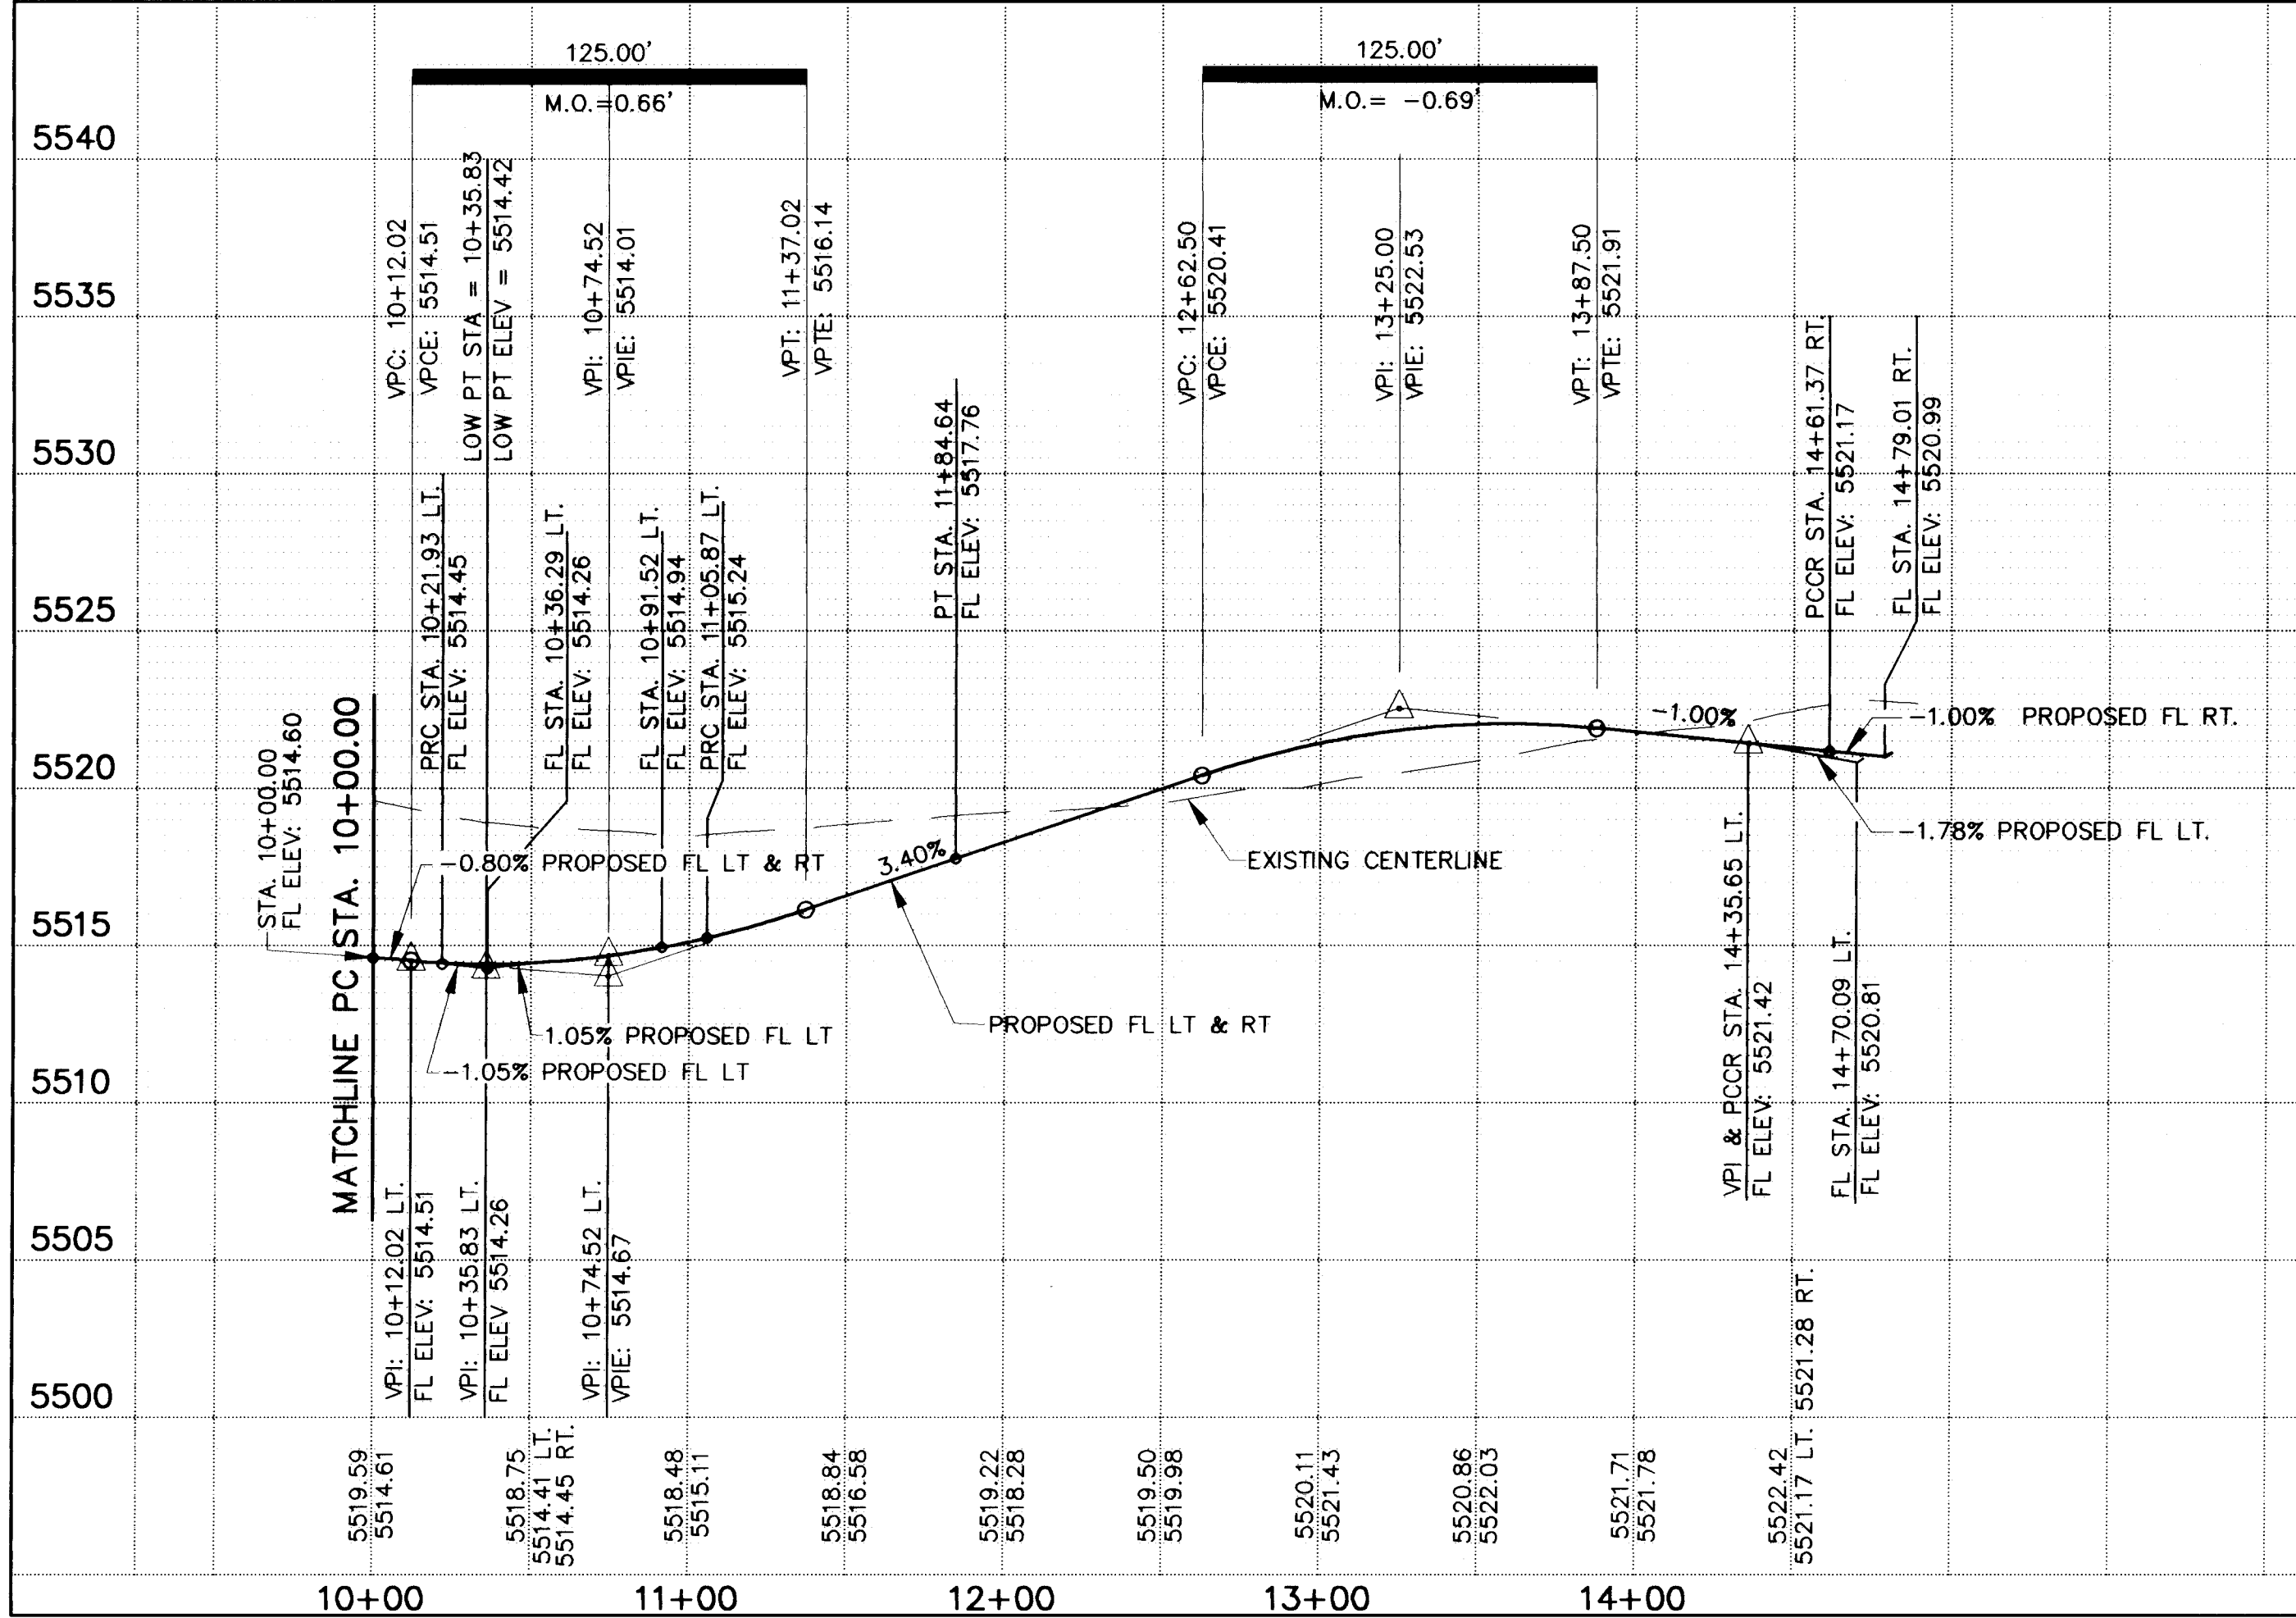

GENERAL NOTES

- ALL STATIONS AND OFFSET DIMENSIONS ARE BASED ON CENTERLINE OF RIGHT-OF-WAY.
- ALL ELEVATIONS ARE FLOWLINE UNLESS OTHERWISE NOTED.

KEYED NOTES

- CONSTRUCT WHEELCHAIR RAMPS PER COA DWG. 2441, TYPE II.
- FUTURE 4' SIDEWALK, BY OTHERS.

STEAMBOAT STREET

CURVE	DELTA	RADIUS	LENGTH	TANGENT
CR1	16°45'17"	88.00'	25.73'	12.96'
CR2	59°07'04"	25.00'	25.80'	14.18'
CR3	182°21'46"	35.00'	111.40'	1697.14'
CR4	59°07'04"	25.00'	25.80'	14.18'
CR5	60°10'11"	88.00'	92.41'	50.98'
CR6	141°03'06"	62.00'	152.63'	175.33'
CR7	107°32'57"	25.00'	46.93'	34.13'
CR8	70°09'57"	25.00'	30.62'	17.56'

CURVE	DELTA	RADIUS	LENGTH	TANGENT
CL1	141°03'06"	75.00'	184.64'	212.10'

TANGENT	BEARING	DISTANCE
T1	S52°16'01"W	251.02'
T2	S52°16'01"W	276.73'

JEWEL CAVE ROAD

TANGENT	BEARING	DISTANCE
T3	S88°47'05"W	345.94'
T4	S88°47'05"W	345.94'

LEGEND

- CENTERLINE OF STREET
- EXISTING CURB & GUTTER
- PROPOSED ASPHALT CURB
- PROPOSED STANDARD CURB & GUTTER
- PROPOSED MOUNTABLE CURB & GUTTER
- PROPOSED WHEELCHAIR RAMP
- PROPOSED CONCRETE VALLEY GUTTER
- TRANSITION SECTION FROM FULL CROWN TO NO CROWN SECTION (MINIMUM 50' TRANSITION)
- TRANSITION SECTION FROM FULL CROWN TO HALF CROWN
- PROPOSED MANHOLE
- PROPOSED STREET LIGHT LOCATION
- EXISTING VALVES
- EXISTING MANHOLE
- PROPOSED WATER VALVE
- PROPOSED STORM INLET
- PROPOSED FIRE HYDRANT

AVID ENGINEERING, INC.
Civil • Structural • Transportation
6100 Seagull St. NE - Suite 102
Albuquerque, NM 87109 - (505) 881-5357

CITY OF ALBUQUERQUE
PUBLIC WORKS DEPARTMENT
ENGINEERING GROUP

TITLE: WILLOW WOOD - UNIT IV
STEAMBOAT STREET & JEWEL CAVE ROAD
PAVING PLAN AND PROFILE

APPROVALS	ENGINEER	DATE	APPROVALS	ENGINEER	DATE
D.R.C. Chair	7-15-94	Water	N/A	RWE	7-8-94
Transportation	7-01-94	Waste Water	N/A	RWE	7-8-94
Hydrology	7-1-94				

DRAWING NO. 4604.93 MAP NO. L-21-Z SHEET 14 OF 40

AS BUILT INFORMATION

CONTRACTOR: New Concepts Inc.

WORK: PAVING PLAN AND PROFILE

STAMPED BY: [Signature]

DATE: 7-15-94

COA: [Signature]

DATE: 7-15-94

FIELD CATCHER BY: [Signature]

DATE: 7-15-94


FIELD CATCHER BY: [Signature]

DATE: 7-15-94

RECORDED BY: [Signature]

DATE: 7-15-94

NO. 14

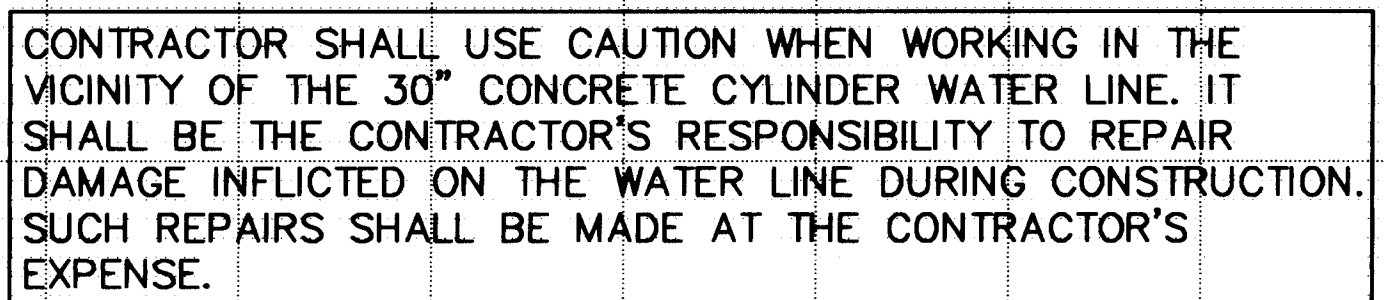

SCANNED BY
BY LASON


DRAWING NO.	4604.93	MAP NO.	L-21-Z	SHEET	15	OF	40
-------------	---------	---------	--------	-------	----	----	----

ENGINEER'S SEAL		SURVEY INFORMATION		BENCH MARKS		AS BUILT INFORMATION	
		FIELD NOTES					
		NO.	BY	DATE		CONTRACTOR	NEW CONCEPTS INC.
						STAKED BY	COA
						INSPECTOR'S	DATE
						FLIGHT DATE	EAR
						VERIFICATION BY	COA
						ORIGINATED BY	DATE
						MICRO-FILM INFORMATION	
						RECORDED BY	DATE
						NO.	


DESIGN		DATE	
DESIGNED BY	DATE	DRAWN BY	DATE

UNIT IV DRIVE PROFILE		ENGINEER		DATE	
Water		N/A	RWF	7-8-00	
		N/A	RWF	7-8-00	

SHEET 15 OF 40

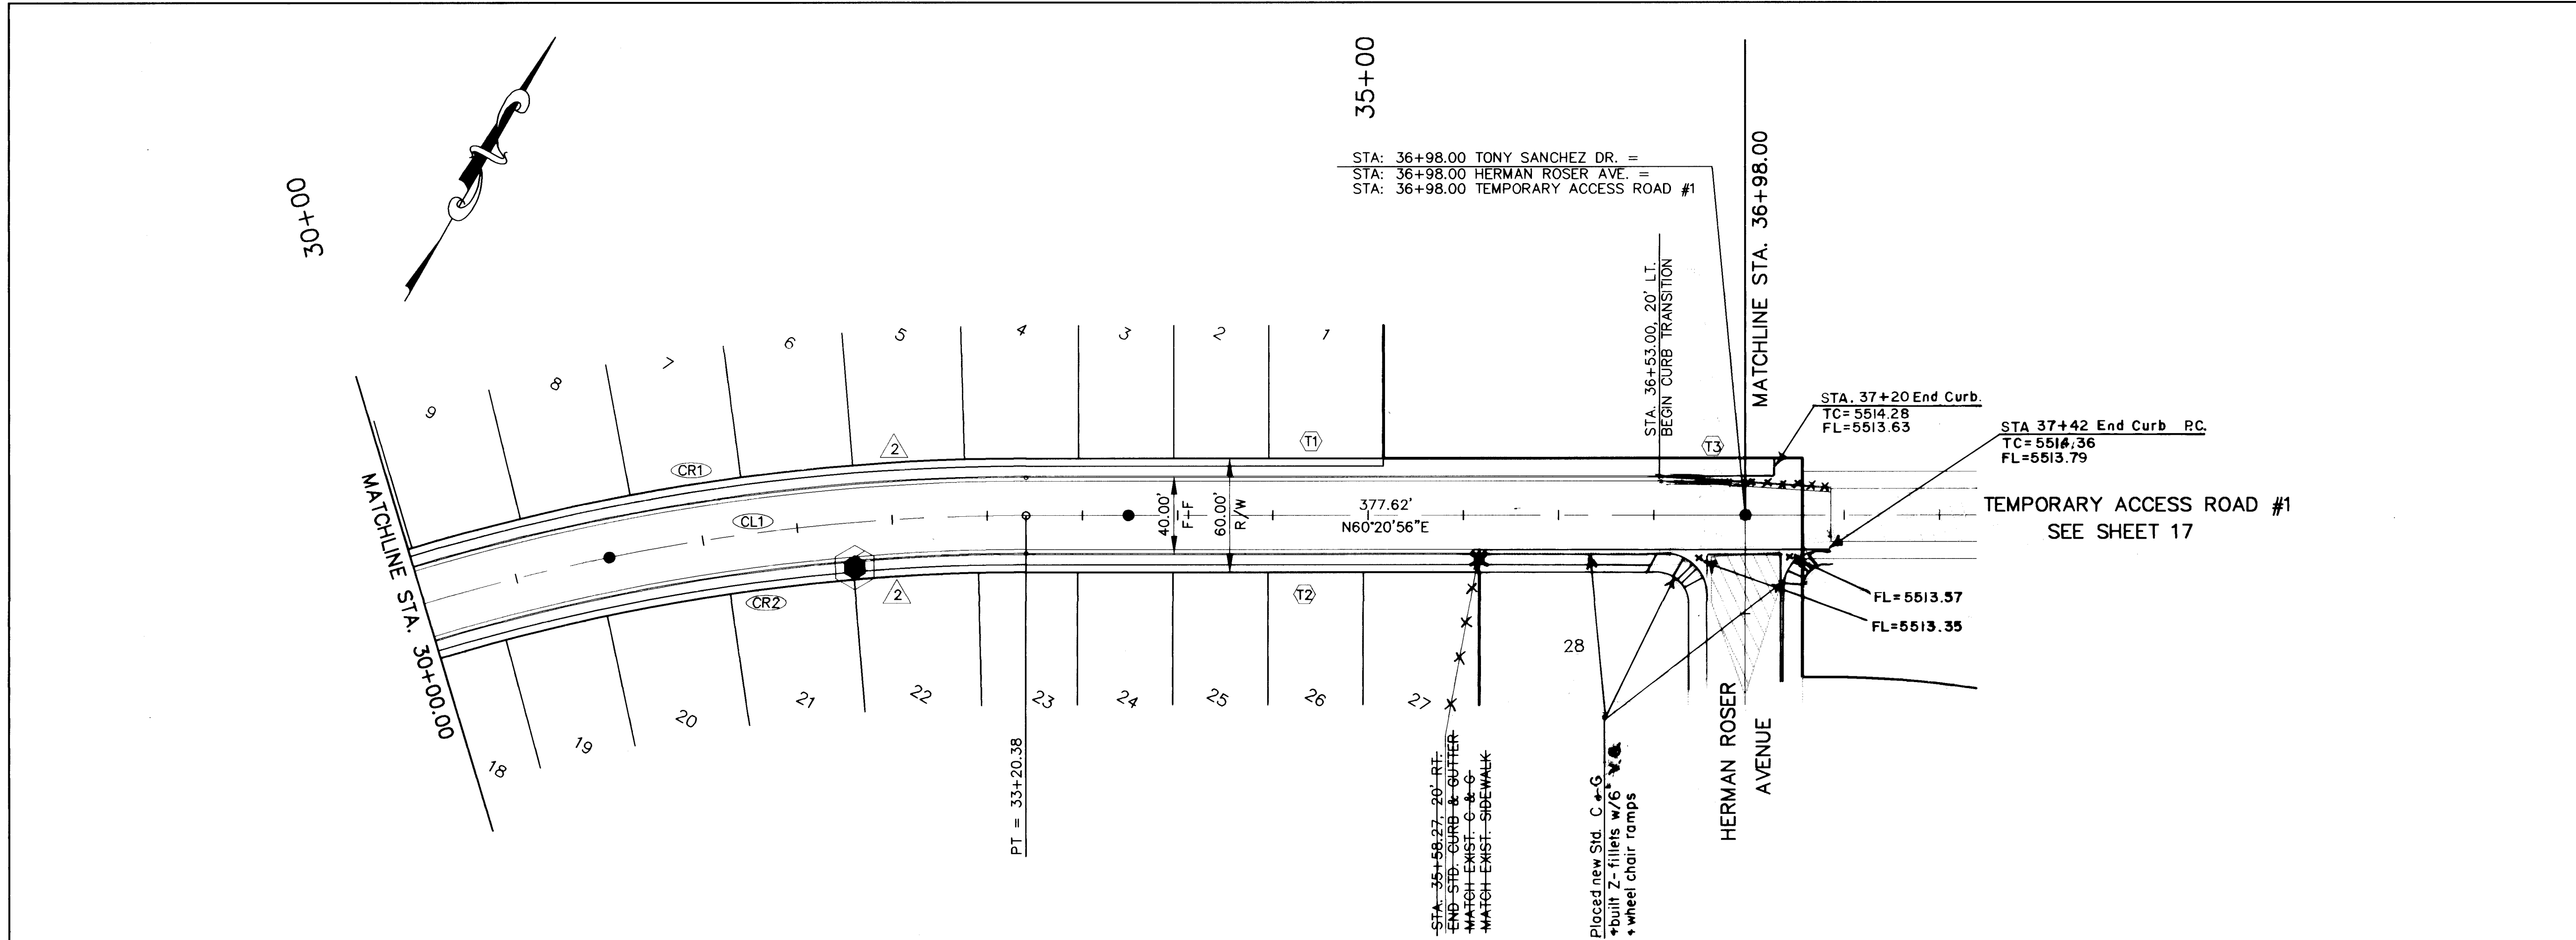

TONY SANCHEZ DRIVE
SEE SHEET 36 FOR STREET SECTION

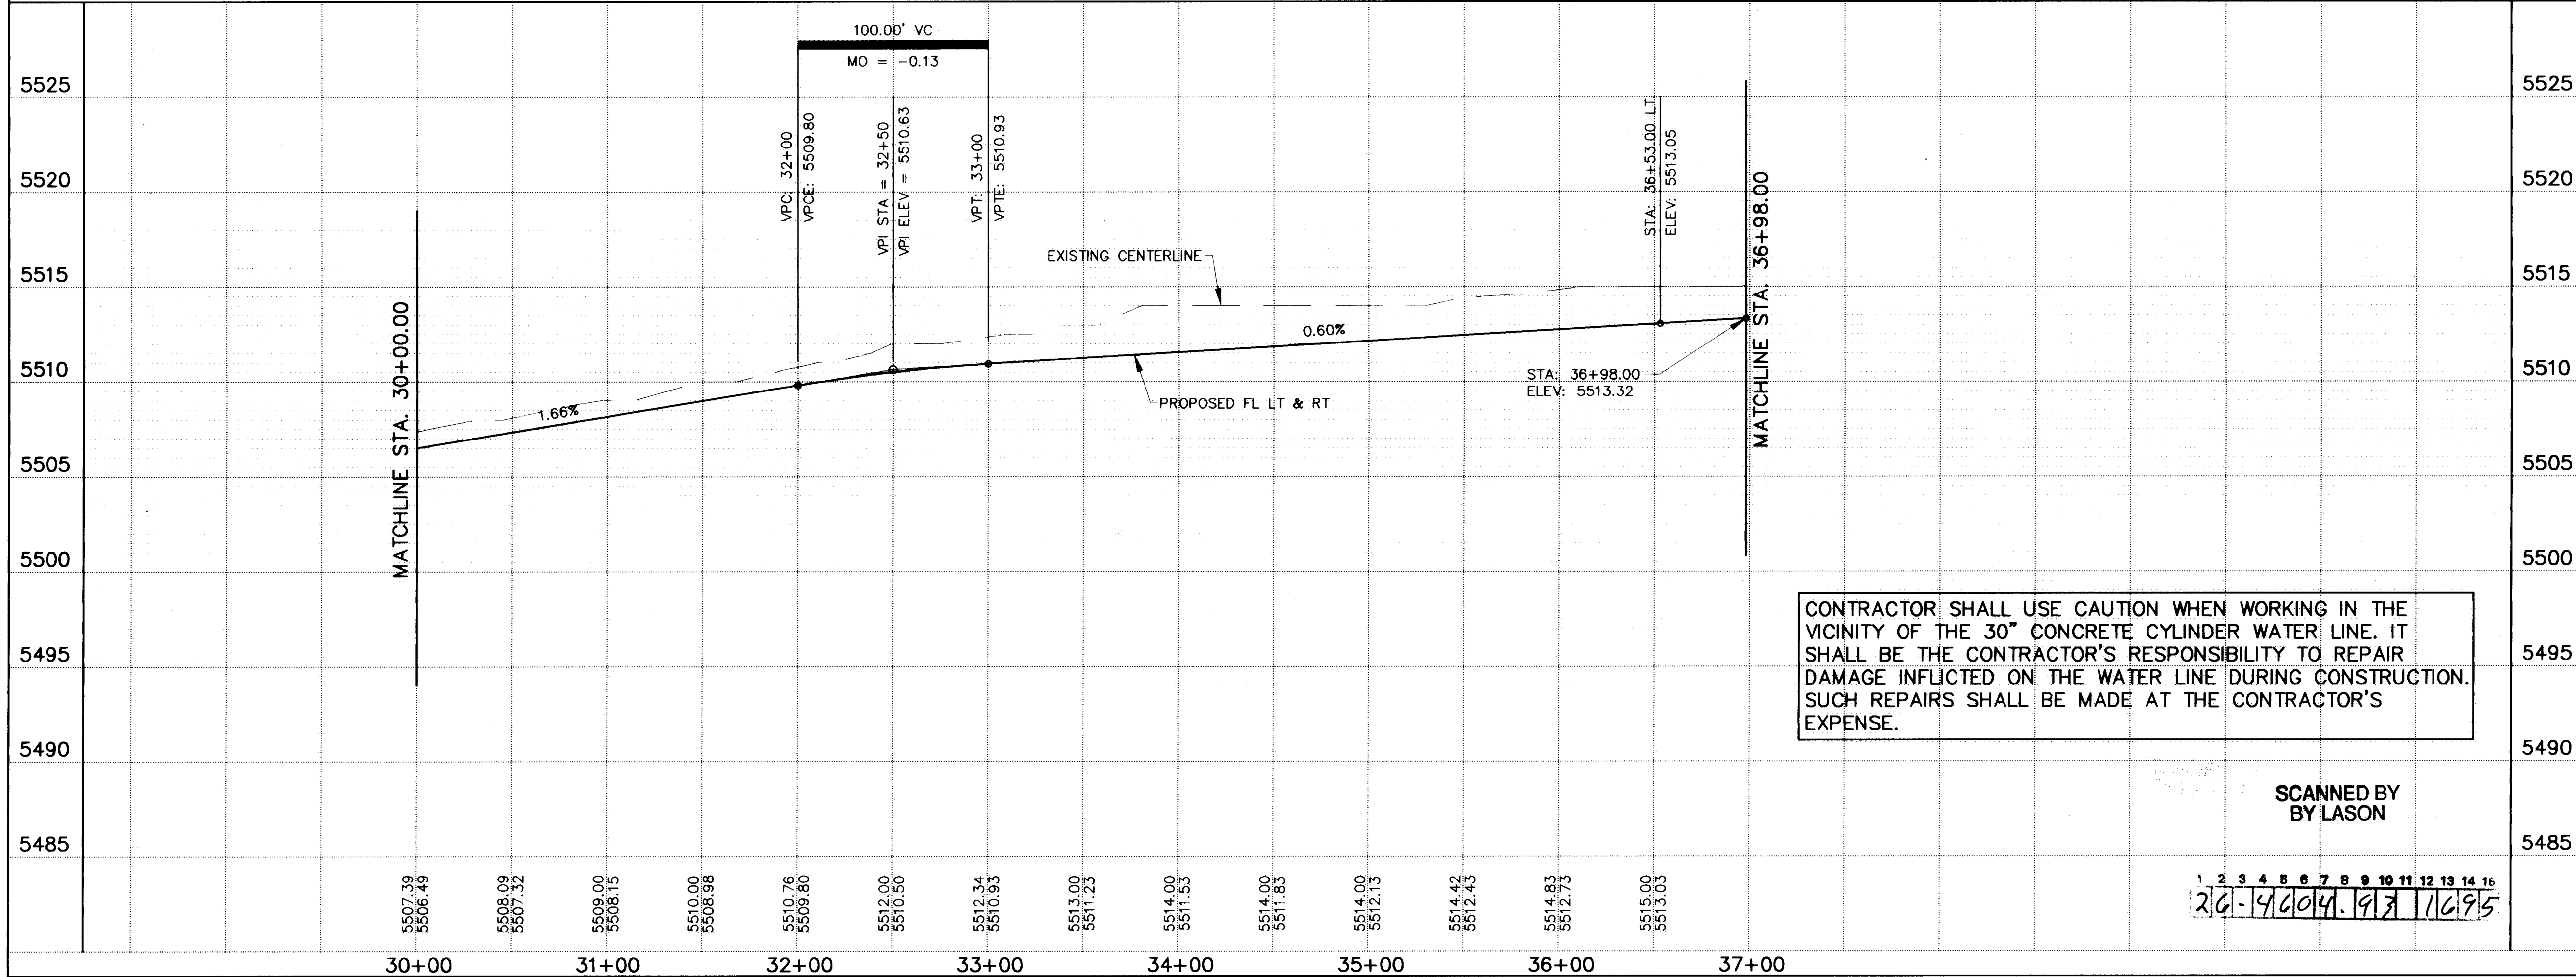

GENERAL NOTES

- ALL STATIONS AND OFFSET DIMENSIONS ARE BASED ON CENTERLINE OF RIGHT-OF-WAY.
- ALL ELEVATIONS ARE FLOWLINE UNLESS OTHERWISE NOTED.

KEYED NOTES

- CONSTRUCT WHEELCHAIR RAMPS PER COA DWG. 2441, TYPE II.
- FUTURE 4' SIDEWALK, BY OTHERS.

TONY SANCHEZ DRIVE

CURB CURVE DATA				
CURVE	DELTA	RADIUS	LENGTH	TANGENT
CR1	23°45'28"	1120.00'	464.41'	235.59'
CR2	23°29'27"	1080.00'	442.79'	224.55'

CENTERLINE CURVE DATA				
CURVE	DELTA	RADIUS	LENGTH	TANGENT
CL1	25°38'48"	1100.00'	492.38'	250.38'

TANGENT DATA		
TANGENT	BEARING	DISTANCE
T1	N60°20'56"E	332.62'
T2	N60°20'56"E	237.89'
T3	N64°09'28"E	90.20'

LEGEND

- CENTERLINE OF STREET
- EXISTING CURB & GUTTER
- PROPOSED ASPHALT CURB
- PROPOSED STANDARD CURB & GUTTER
- PROPOSED MOUNTABLE CURB & GUTTER
- PROPOSED WHEELCHAIR RAMP
- PROPOSED CONCRETE VALLEY GUTTER
- TRANSITION SECTION FROM FULL CROWN TO NO CROWN SECTION (MINIMUM 50' TRANSITION)
- TRANSITION SECTION FROM FULL CROWN TO HALF CROWN
- PROPOSED MANHOLE
- PROPOSED STREET LIGHT LOCATION
- EXISTING VALVES
- EXISTING MANHOLE
- PROPOSED WATER VALVE
- PROPOSED STORM INLET
- PROPOSED FIRE HYDRANT

AVID ENGINEERING, INC.
Civil • Structural • Transportation
6100 Seagull St. NE, Suite 102
Albuquerque, NM 87109 • (505) 881-5357

**CITY OF ALBUQUERQUE
PUBLIC WORKS DEPARTMENT
ENGINEERING GROUP**


**TITLE: WILLOW WOOD - UNIT IV
TONY SANCHEZ DRIVE
PAVING PLAN AND PROFILE**

APPROVALS	ENGINEER	DATE	APPROVALS	ENGINEER	DATE
D.R.C. Chair	By Authority	7-15-94	Water	N/A	RWK 7-8-94
Transportation	By Authority	7-01-94	Waste Water	N/A	RWK 7-8-94
Hydrology	NA	7-1-94			


DRAWING NO. 4604.93

MAP NO. L-21-Z

SHEET 16 OF 40

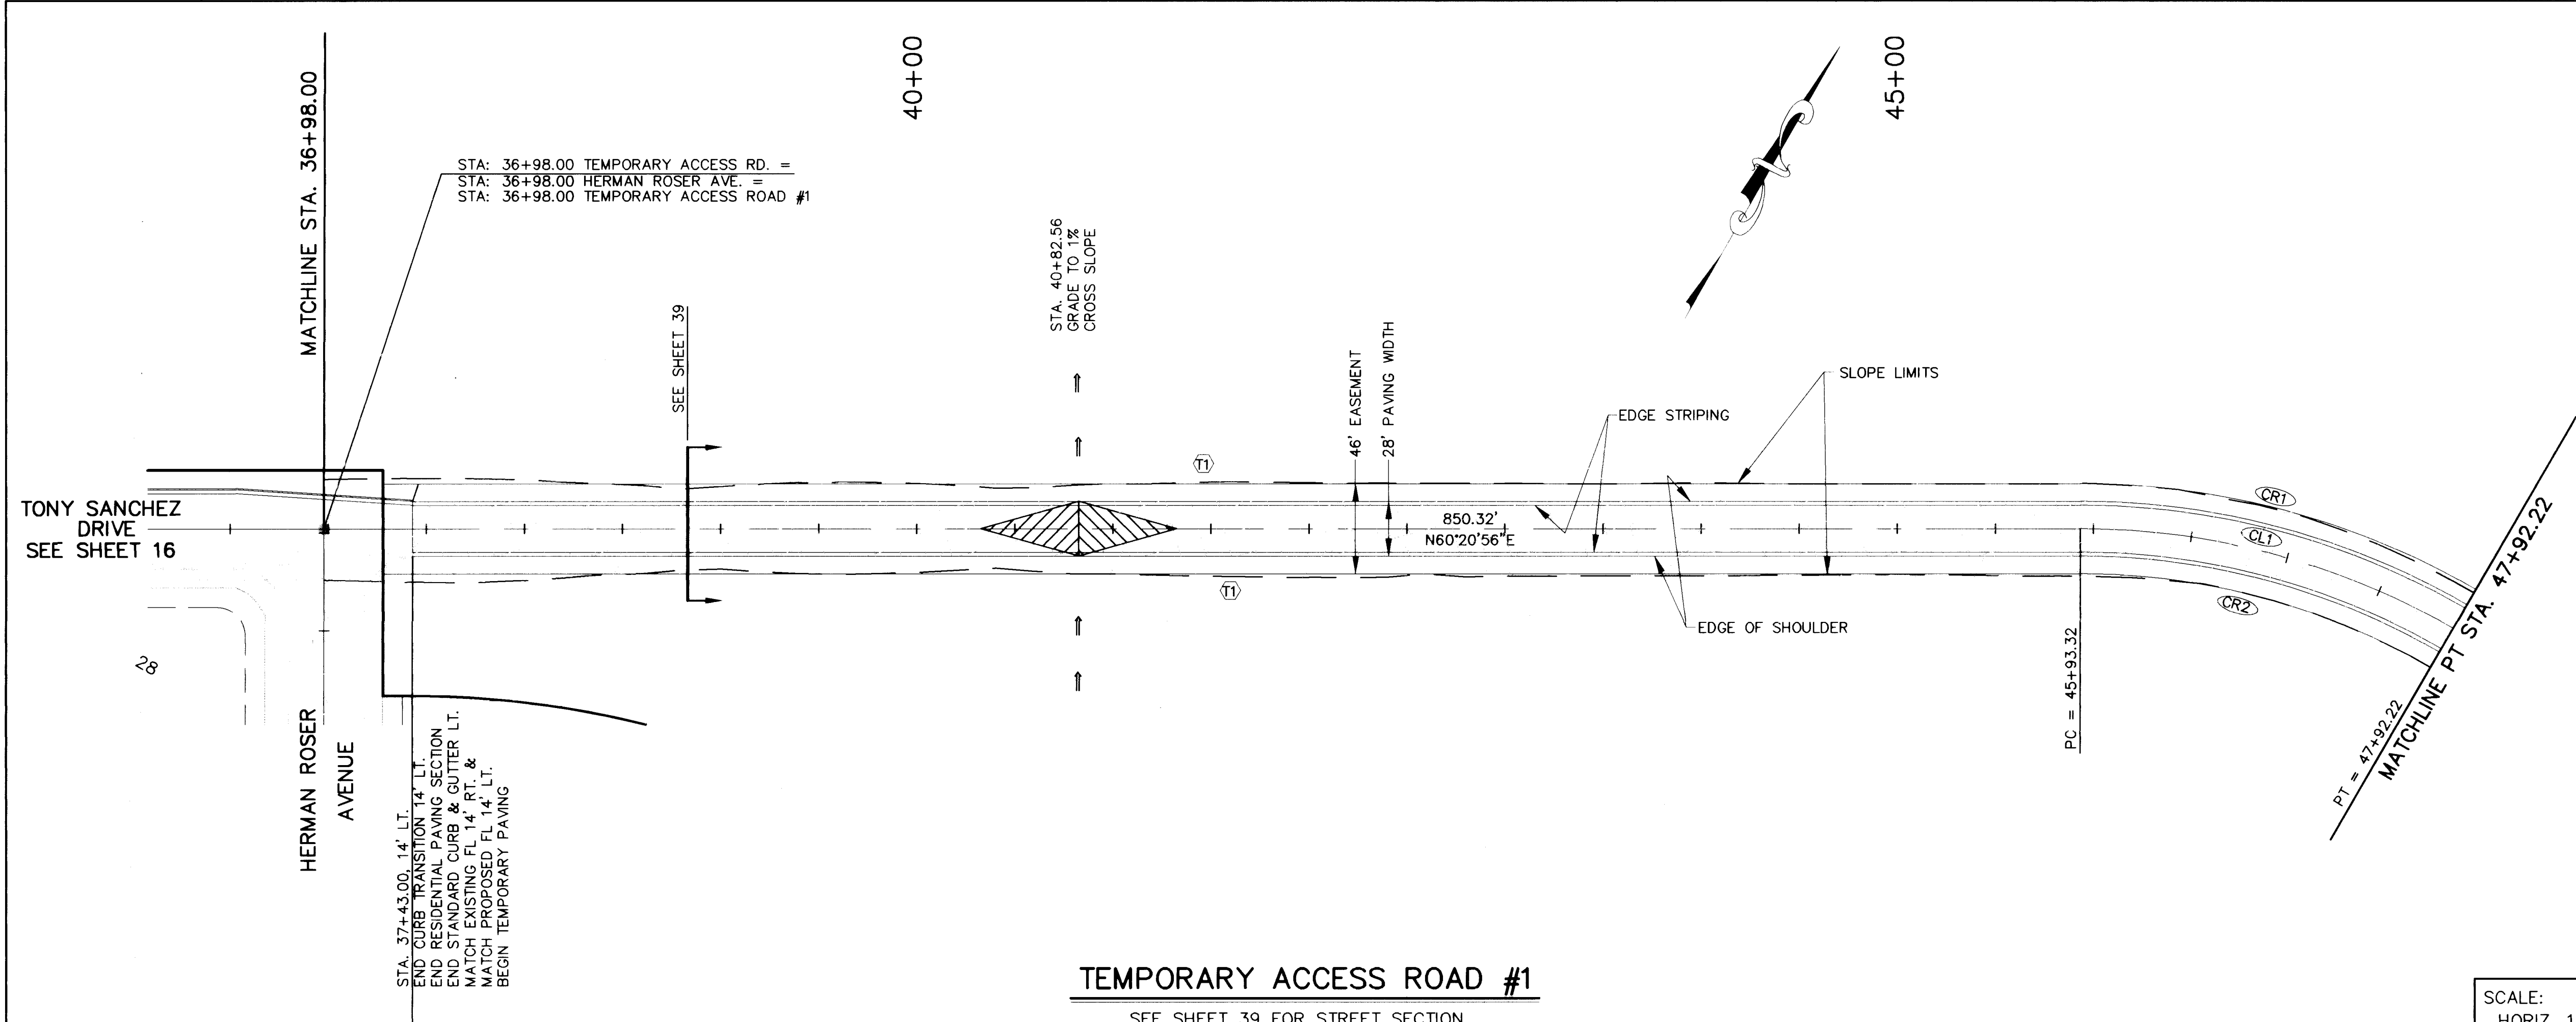

TEMPORARY ACCESS ROAD #1
SEE SHEET 39 FOR STREET SECTION

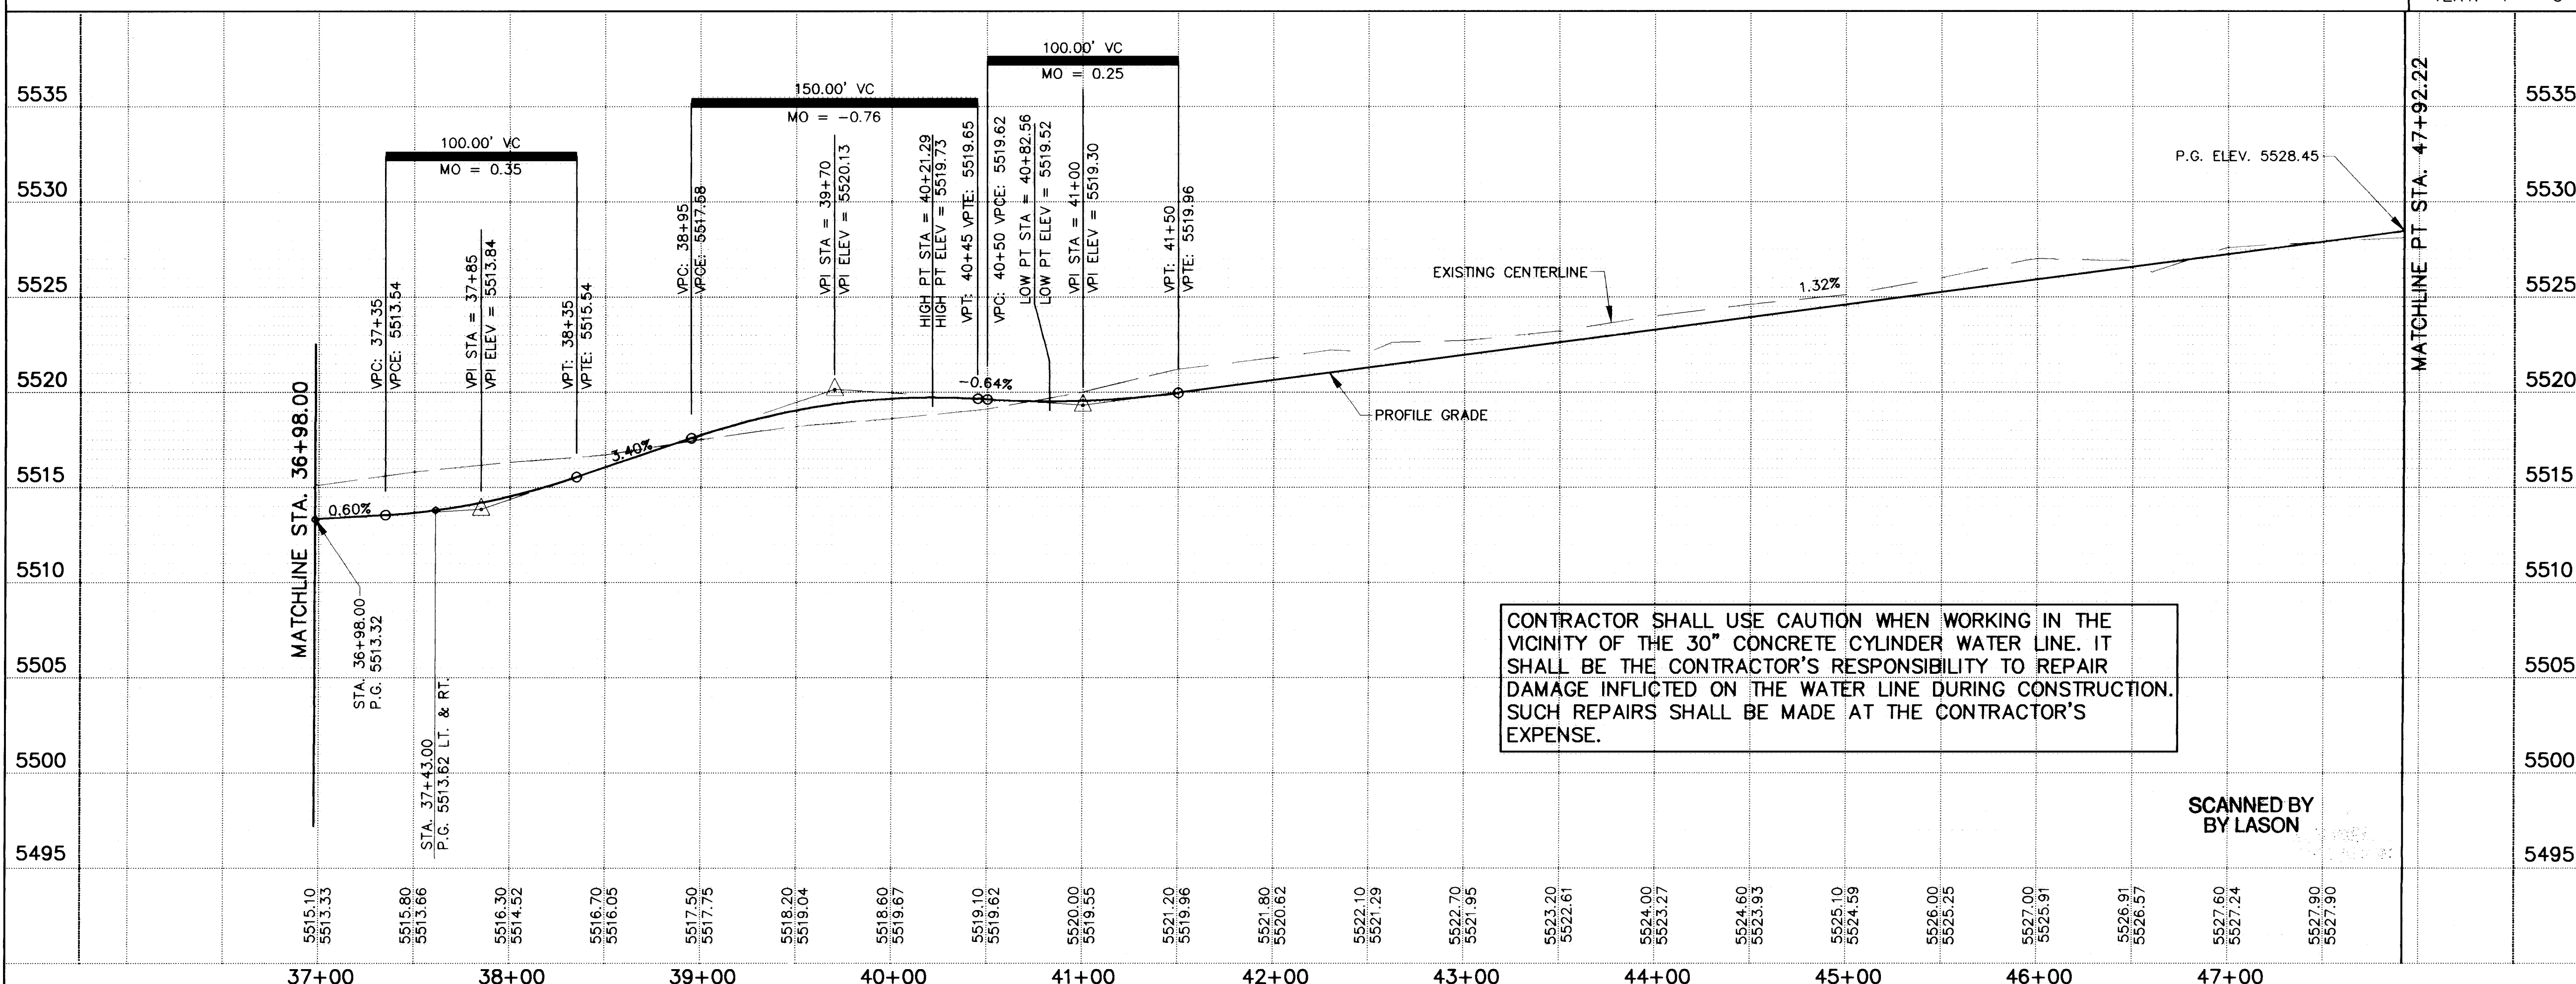

CONTRACTOR SHALL USE CAUTION WHEN WORKING IN THE VICINITY OF THE 30" CONCRETE CYLINDER WATER LINE. IT SHALL BE THE CONTRACTOR'S RESPONSIBILITY TO REPAIR DAMAGE INFLECTED ON THE WATER LINE DURING CONSTRUCTION. SUCH REPAIRS SHALL BE MADE AT THE CONTRACTOR'S EXPENSE.

SCANNED BY
BY LASON

GENERAL NOTES
1. ALL STATIONS AND OFFSET DIMENSIONS ARE BASED ON CENTERLINE OF RIGHT-OF-WAY.
2. ALL ELEVATIONS ARE PROFILE GRADE UNLESS OTHERWISE NOTED.

TEMPORARY ACCESS ROAD #1

CENTERLINE CURVE DATA				
CURVE	DELTA	RADIUS	LENGTH	TANGENT
CL1	29°59'24"	380.00'	198.90'	101.79'

EDGE OF SHOULDER CURVE DATA				
CURVE	DELTA	RADIUS	LENGTH	TANGENT
CR1	29°59'24"	394.00'	206.23'	105.54'
CR2	29°59'24"	366.00'	191.57'	98.04'

TANGENT DATA		
TANGENT	BEARING	DISTANCE
T1	N60°20'56"E	850.32'

LEGEND

- CENTERLINE OF STREET
- EXISTING CURB & GUTTER
- PROPOSED ASPHALT CURB
- PROPOSED STANDARD CURB & GUTTER
- PROPOSED MOUNTABLE CURB & GUTTER
- PROPOSED WHEELCHAIR RAMP
- PROPOSED CONCRETE VALLEY GUTTER
- TRANSITION SECTION FROM FULL CROWN TO NO CROWN SECTION (MINIMUM 50' TRANSITION)
- TRANSITION SECTION FROM FULL CROWN TO HALF CROWN
- TEMPORARY PAVEMENT
- PROPOSED SANITARY SEWER MANHOLE
- PROPOSED STREET LIGHT LOCATION
- EXISTING VALVES
- EXISTING MANHOLE
- PROPOSED WATER VALVE
- PROPOSED STORM INLET
- PROPOSED FIRE HYDRANT

AVID ENGINEERING, INC.
Civil • Structural • Transportation
6100 Seagull St. NE - Suite 102
Albuquerque, NM 87109 - (505) 881-5357



1 2 3 4 5 6 7 8 9 10 11 12 13 14 15
20-19444-193 11795

CITY OF ALBUQUERQUE
PUBLIC WORKS DEPARTMENT
ENGINEERING GROUP
TITLE: WILLOW WOOD - UNIT IV
TEMPORARY ACCESS ROAD #1
PAVING PLAN AND PROFILE


APPROVALS	ENGINEER	DATE	APPROVALS	ENGINEER	DATE
D.R.C. Chair	B.G. Gentry	7-15-94	Water	N/A RWK	7-8-94
Transportation	R. Gentry	7-15-94	Waste Water	N/A RWK	7-8-94
Hydrology	NA	7-1-94			


DRAWING NO. 4604.93 MAP NO. L-21-Z SHEET 17 OF 40

AS BUILT INFORMATION			BENCH MARKS		
CONTRACTOR	NEW CONCEPTS INC.	DATE	STATION	MARK	DATE
STAMPED BY	COA	DATE	OF DOWNTOWN ALBUQUERQUE	AT THE INTERSECTION OF	DATE
FIELD LOCATION BY	EAR	DATE	CENTRAL AVE. AND JUAN TABO BLVD.	THE STATION IS ON	DATE
DRAWINGS	COA	DATE	THE MEDIAN STRIP OF CENTRAL AVE., 81' WEST OF THE	CORRECTED BY	DATE
MICRO-FILM INFORMATION			CENTERLINE OF JUAN TABO BLVD. AND FLUSH WITH THE	RECORDED BY	DATE
			TOP OF CURB. SLD ELEV. 5534.63	NO.	

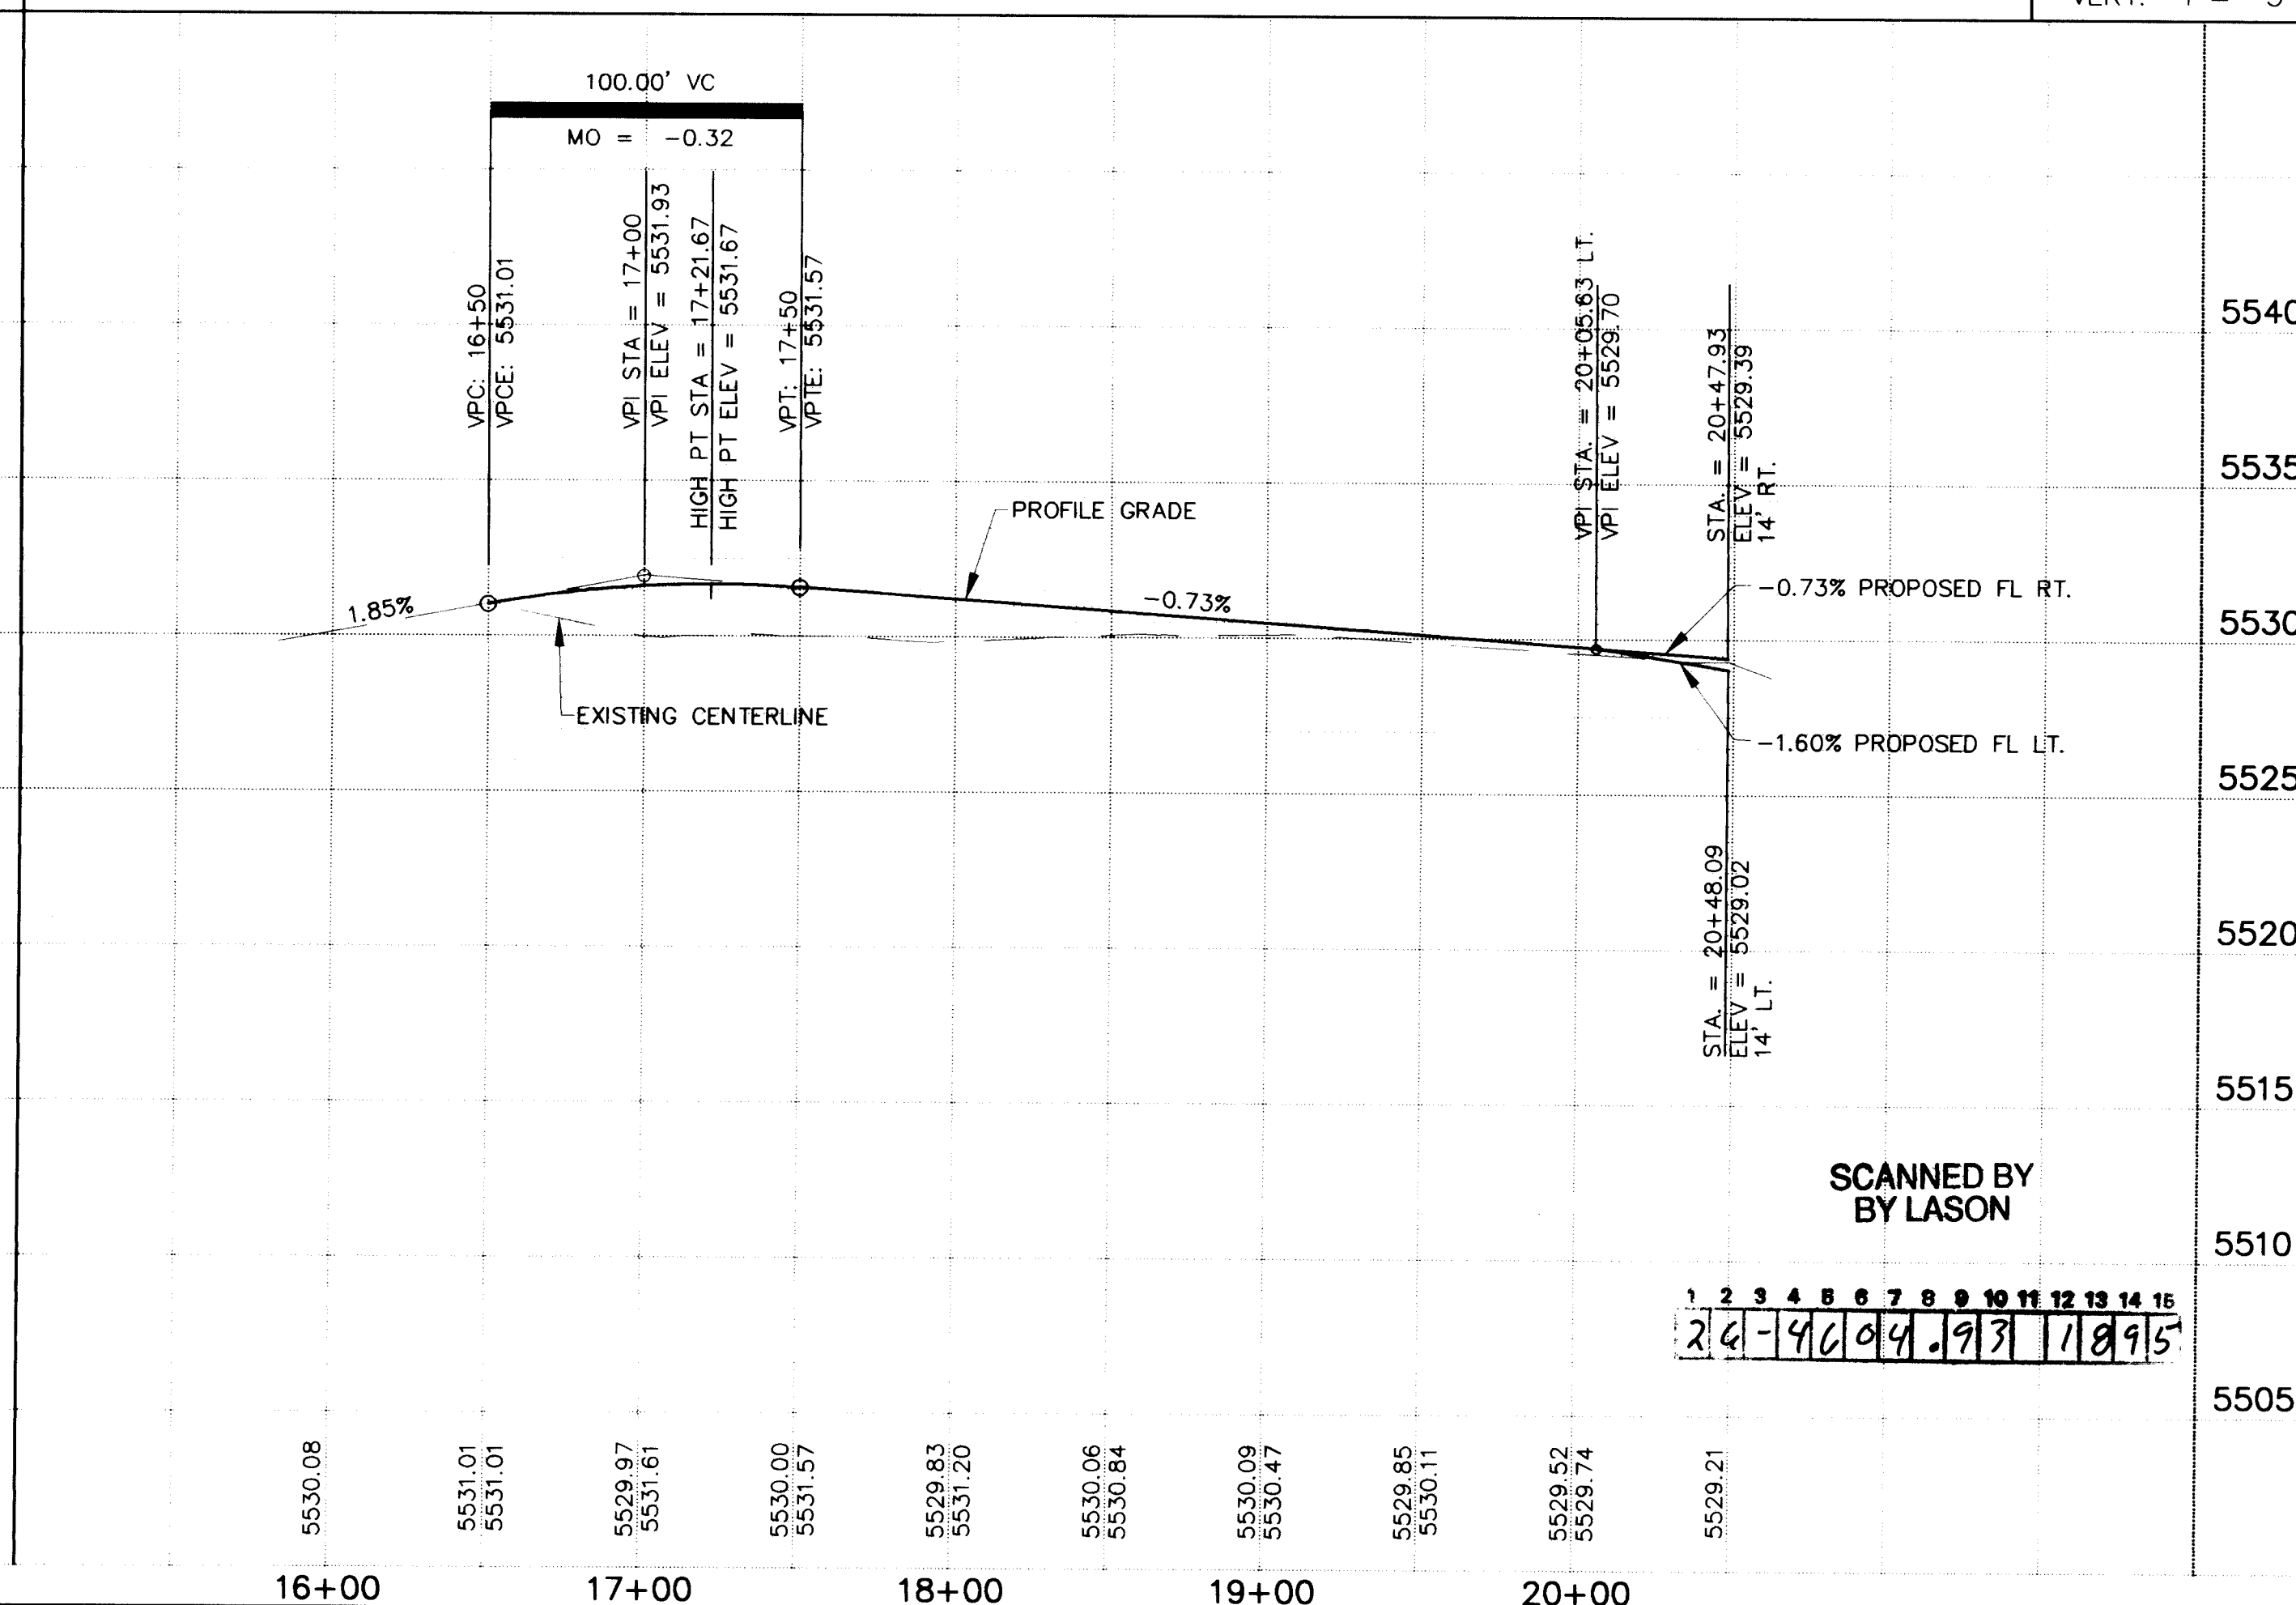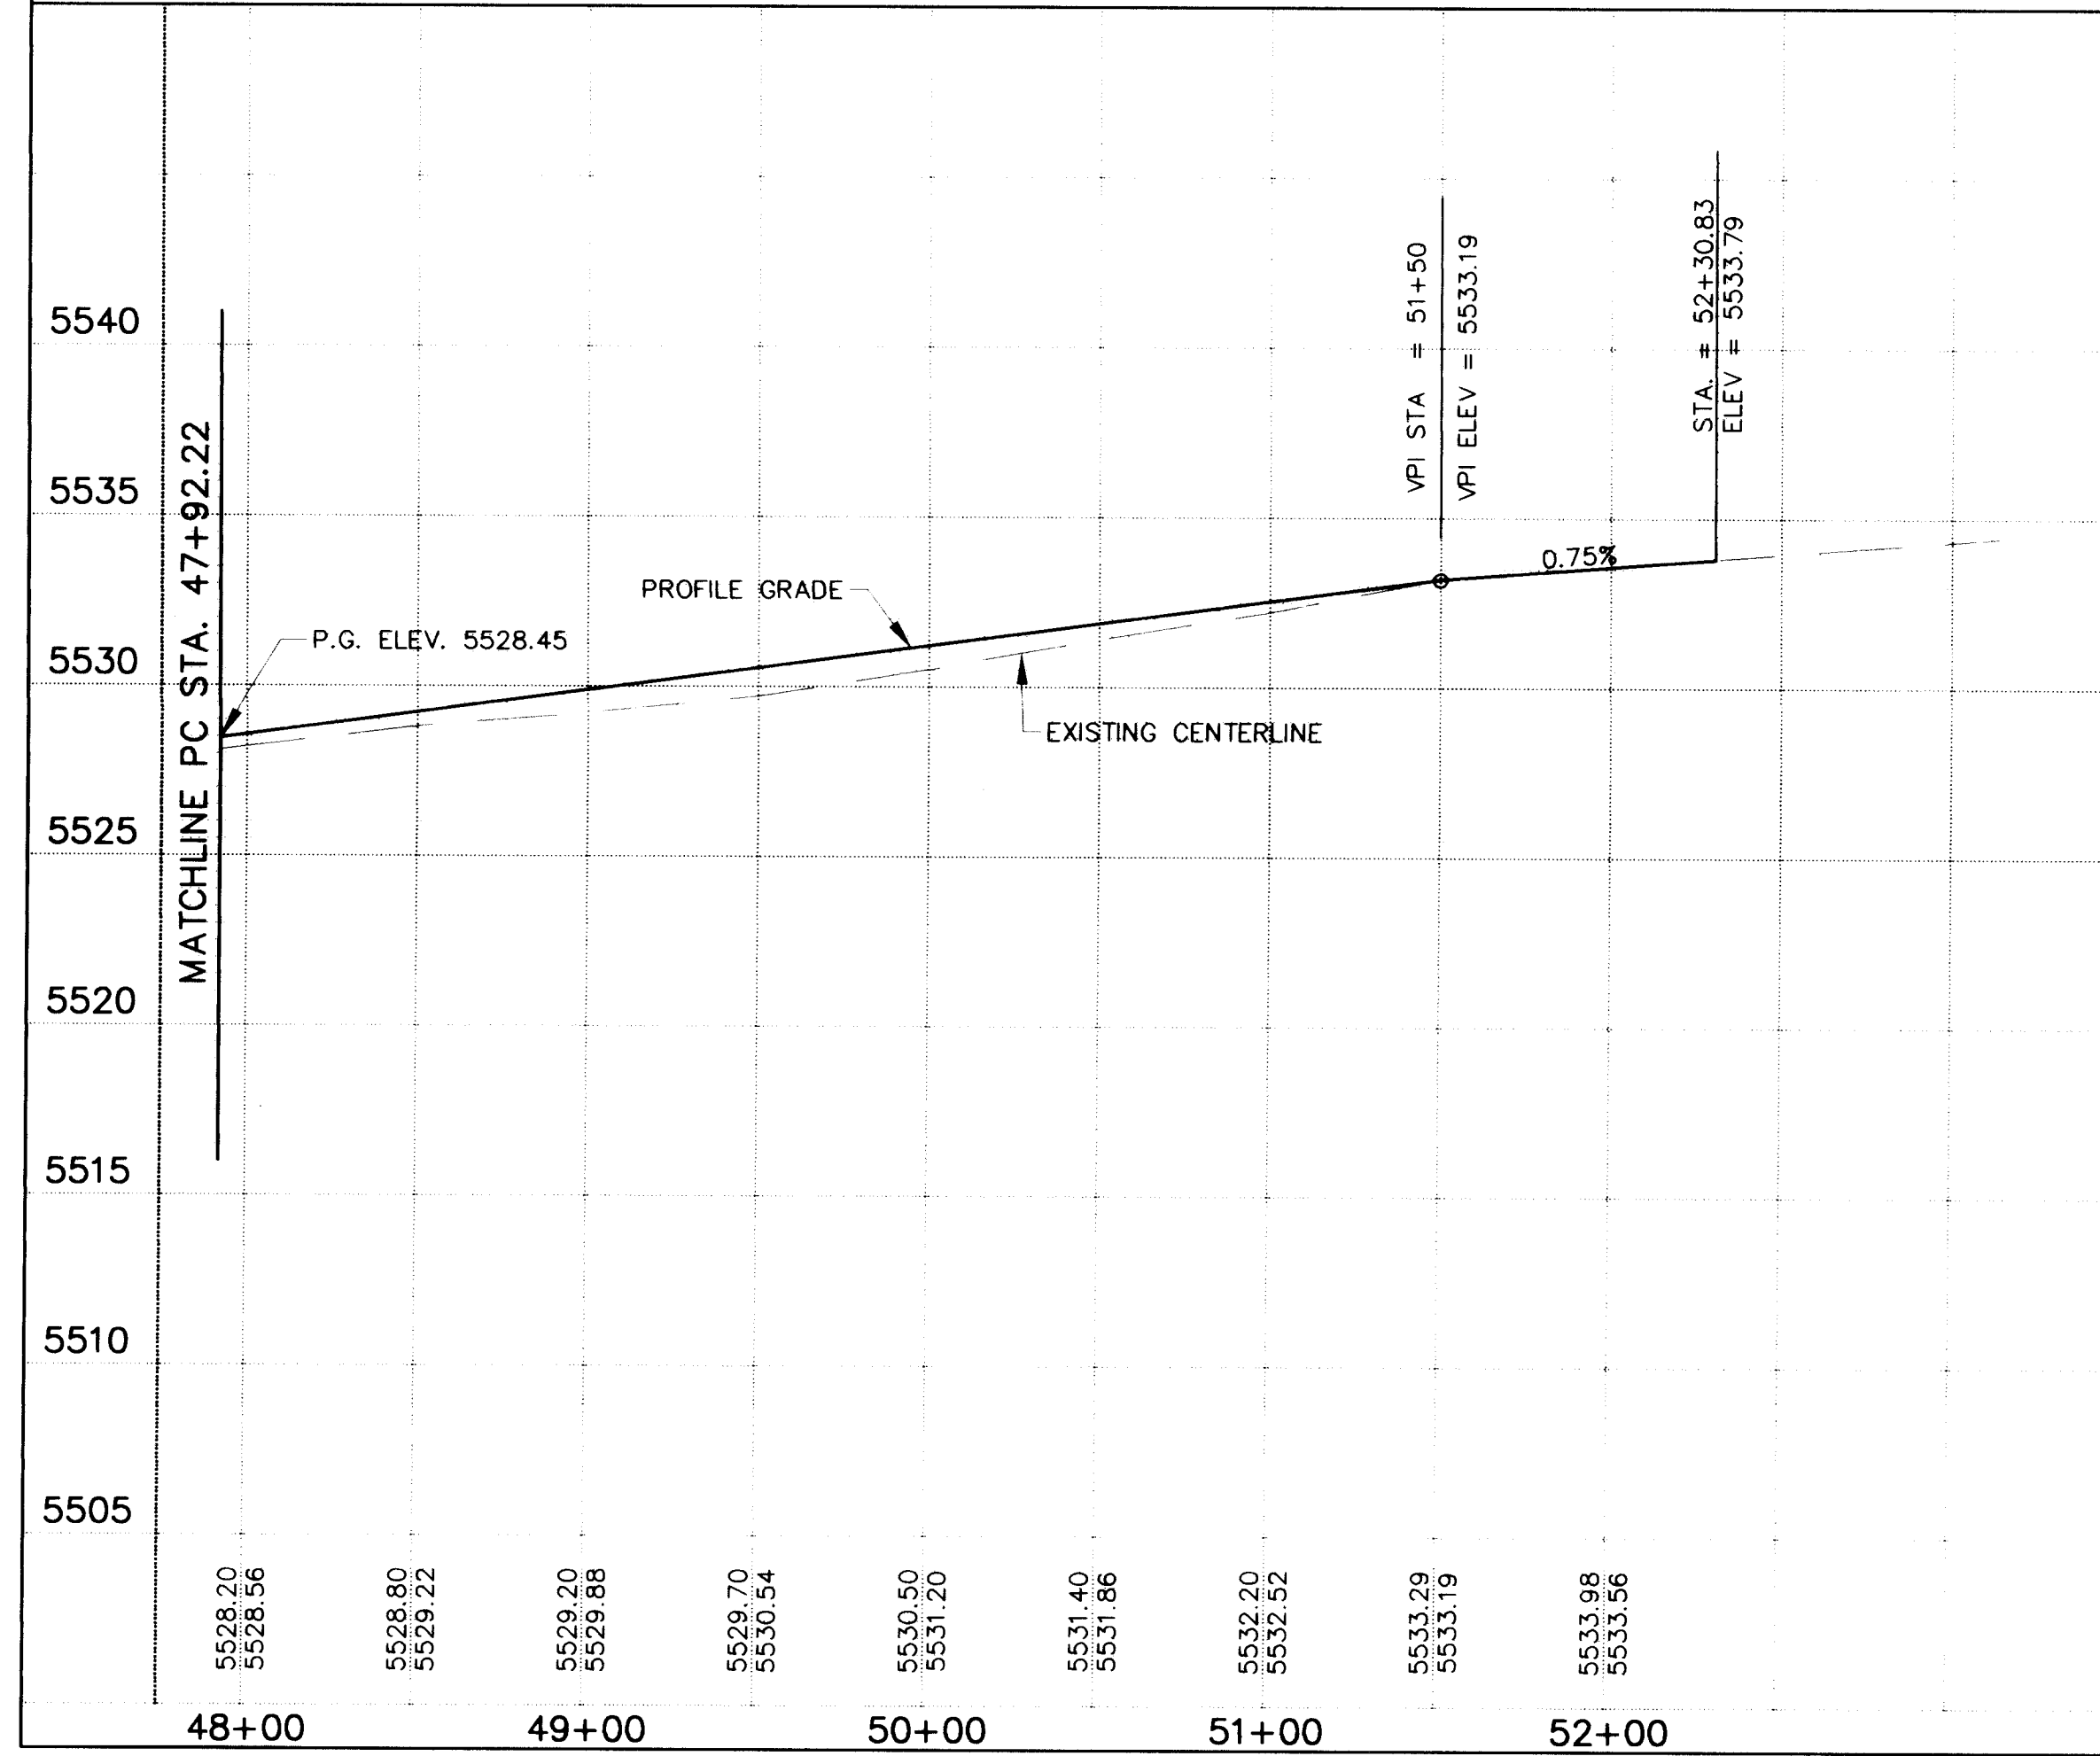

GENERAL NOTES									
1. ALL STATIONS AND OFFSET DIMENSIONS ARE BASED ON CENTERLINE OF RIGHT-OF-WAY. 2. ALL ELEVATIONS ARE PROFILE GRADE UNLESS OTHERWISE NOTED.									
TEMPORARY ACCESS RD. #1									
SHOULDER CURVE DATA									
CURVE	DELTA	RADIUS	LENGTH	TANGENT					
CR1	89°40'07"	25.00'	39.13'	24.86'					
CR2	90°21'09"	25.00'	39.42'	25.15'					
TANGENT DATA									
TANGENT	BEARING	DISTANCE							
T1	S89°39'40"E	438.61'							
T2	S89°39'40"E	17.58'							
T3	S89°39'40"E	343.03'							
TEMPORARY ACCESS RD. #2									
SHOULDER CURVE DATA									
CURVE	DELTA	RADIUS	LENGTH	TANGENT					
CR1	89°40'07"	25.00'	39.13'	24.86'					
CR2	90°21'09"	25.00'	39.42'	25.15'					
TANGENT DATA									
TANGENT	BEARING	DISTANCE							
T1	S00°00'00"E	373.23'							
T2	S00°00'00"E	372.77'							
LEGEND									
CENTERLINE OF STREET									
EXISTING CURB & GUTTER									
PROPOSED ASPHALT CURB									
PROPOSED STANDARD CURB & GUTTER									
PROPOSED MOUNTABLE CURB & GUTTER									
PROPOSED WHEELCHAIR RAMP									
PROPOSED CONCRETE VALLEY GUTTER									
TRANSITION SECTION FROM FULL CROWN TO NO CROWN SECTION (MINIMUM 50' TRANSITION)									
TRANSITION SECTION FROM FULL CROWN TO HALF CROWN									
TEMPORARY PAVEMENT									
PROPOSED SANITARY SEWER MANHOLE									
PROPOSED STREET LIGHT LOCATION									
EXISTING VALVES									
EXISTING MANHOLE									
PROPOSED WATER VALVE									
PROPOSED STORM INLET									
PROPOSED FIRE HYDRANT									
 AVID ENGINEERING, INC. Civil • Structural • Transportation 6100 Seagull St. NE Suite 102 Albuquerque, NM 87109 • (505) 881-5357									
CITY OF ALBUQUERQUE PUBLIC WORKS DEPARTMENT ENGINEERING GROUP									
TITLE: WILLOW WOOD - UNIT IV TEMPORARY ACCESS ROAD #1 & #2 PAYING PLAN AND PROFILE									
APPROVALS	ENGINEER	DATE	APPROVALS	ENGINEER	DATE				
D.R.C. Chair	<i>B.G. Gonzalez</i>	7-15-94	Water	<i>N/A RWK</i>	7-8-94				
Transportation	<i>N. P. Lopez</i>	7-01-94	Waste Water	<i>N/A RWK</i>	7-8-94				
Hydrology	<i>NA fpc</i>	7-1-94							
DRAWING NO.		4604.93		MAP NO.		L-21-Z		SHEET 18 OF 40	

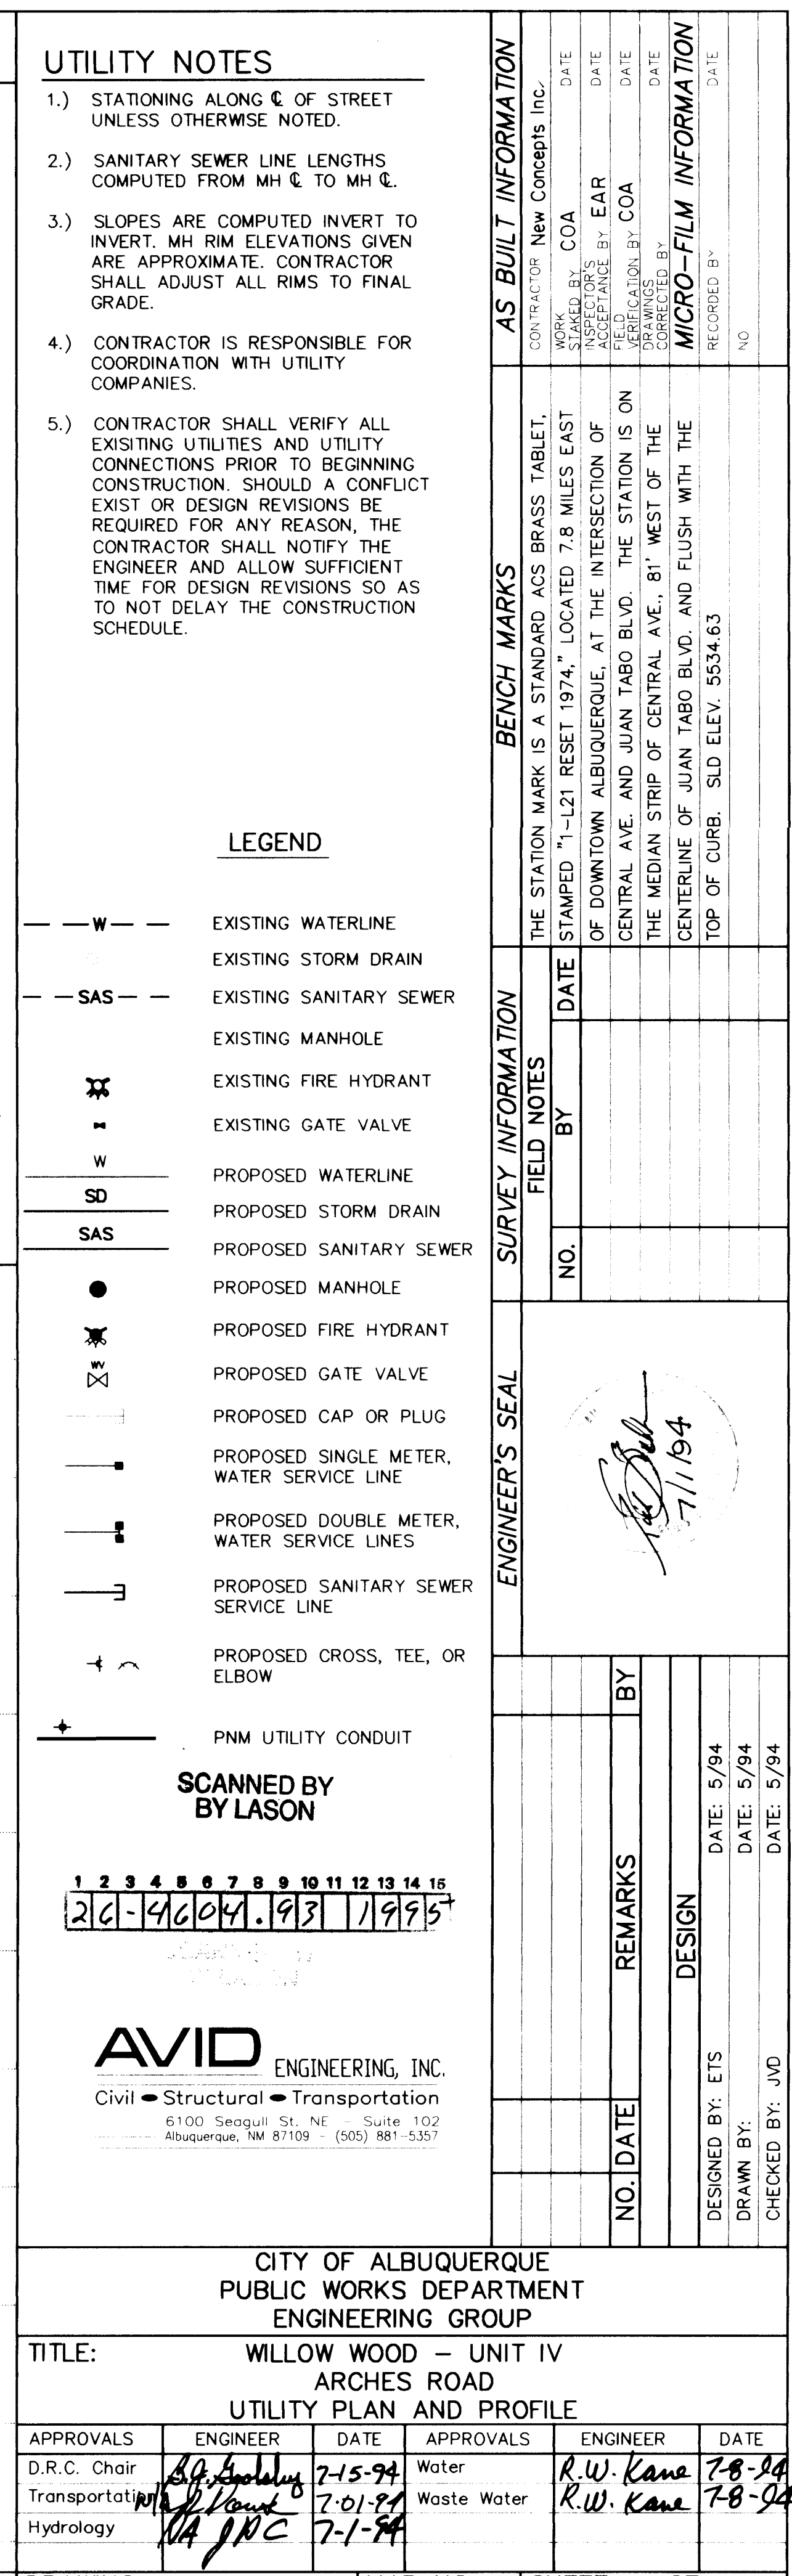

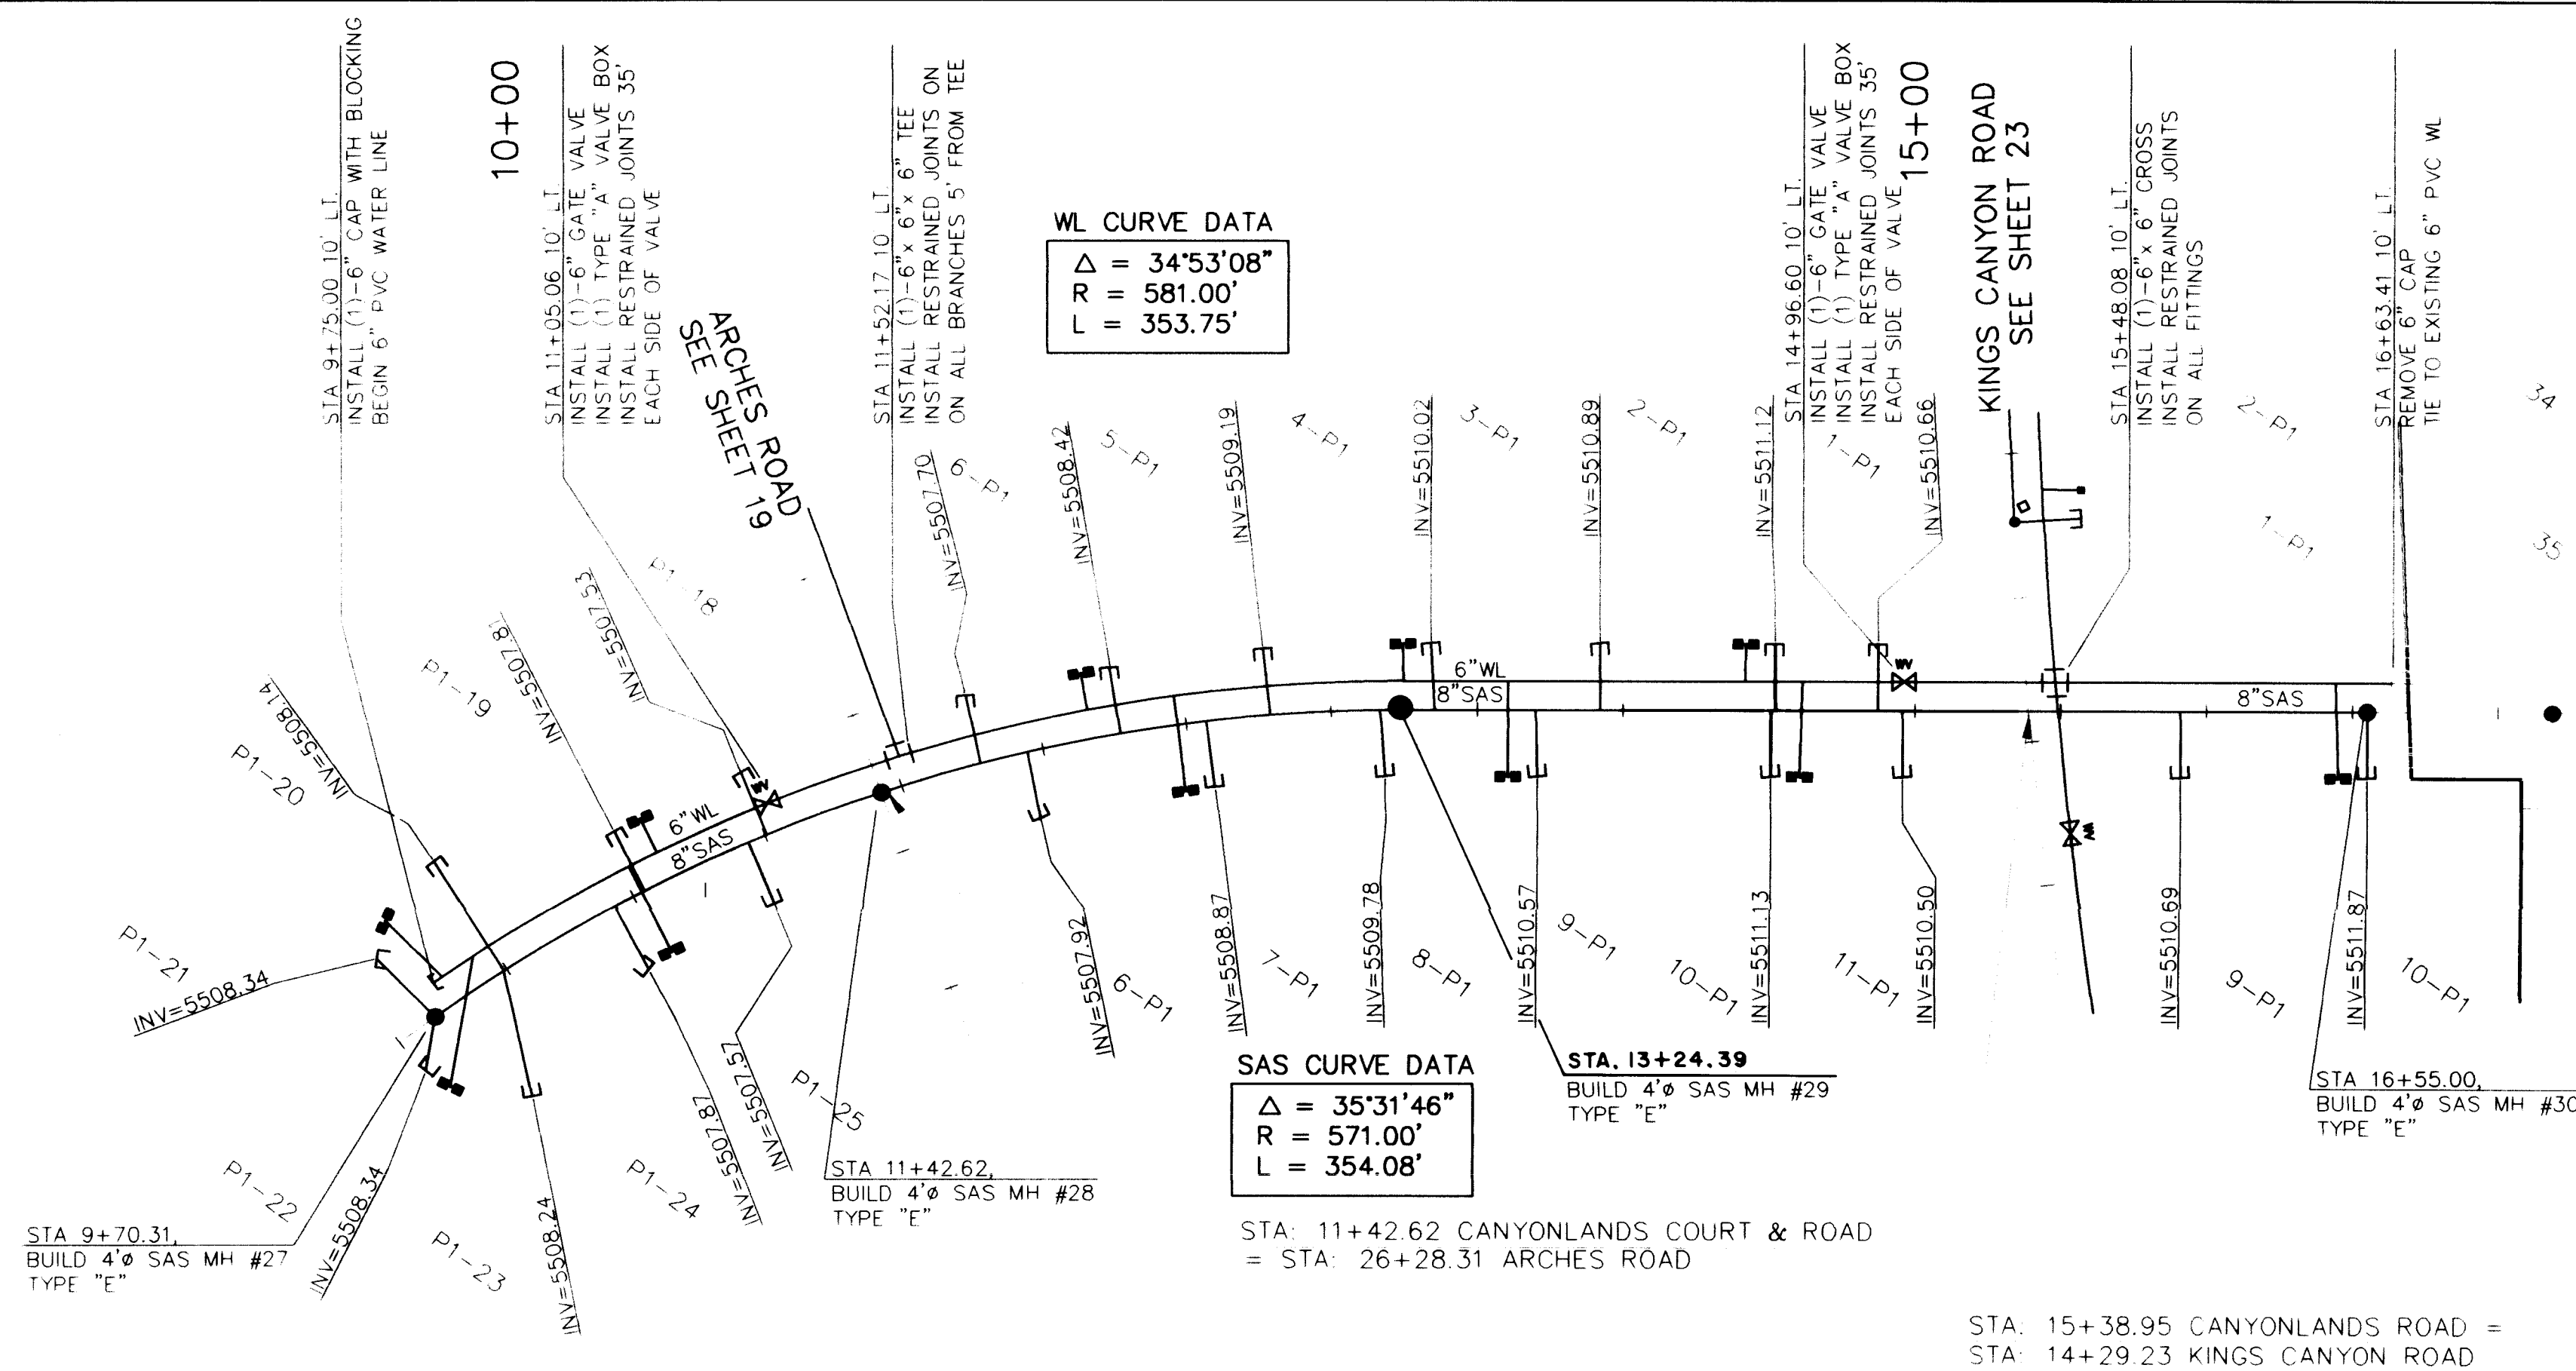

STA: 16+93.80 JEWEL CAVE ROAD =
STA: 21+32.14 TONY SANCHEZ DRIVE

TONY SANCHEZ
ROAD
SEE SHEET 26


JEWEL CAVE ROAD

STA: 19+59.04 JEWEL CAVE ROAD =
STA: 1+64.81 SALINAS STREET

STA: 24+15.05 JEWEL CAVE ROAD =
STA: 24+15.05 WIND RIVER STREET

MATCH LINE STA: 26+50
SEE JEWEL CAVE UTILITY PLAN & PROFILE

SCALE:
HORIZ. 1" = 50'
VERT. 1" = 5'

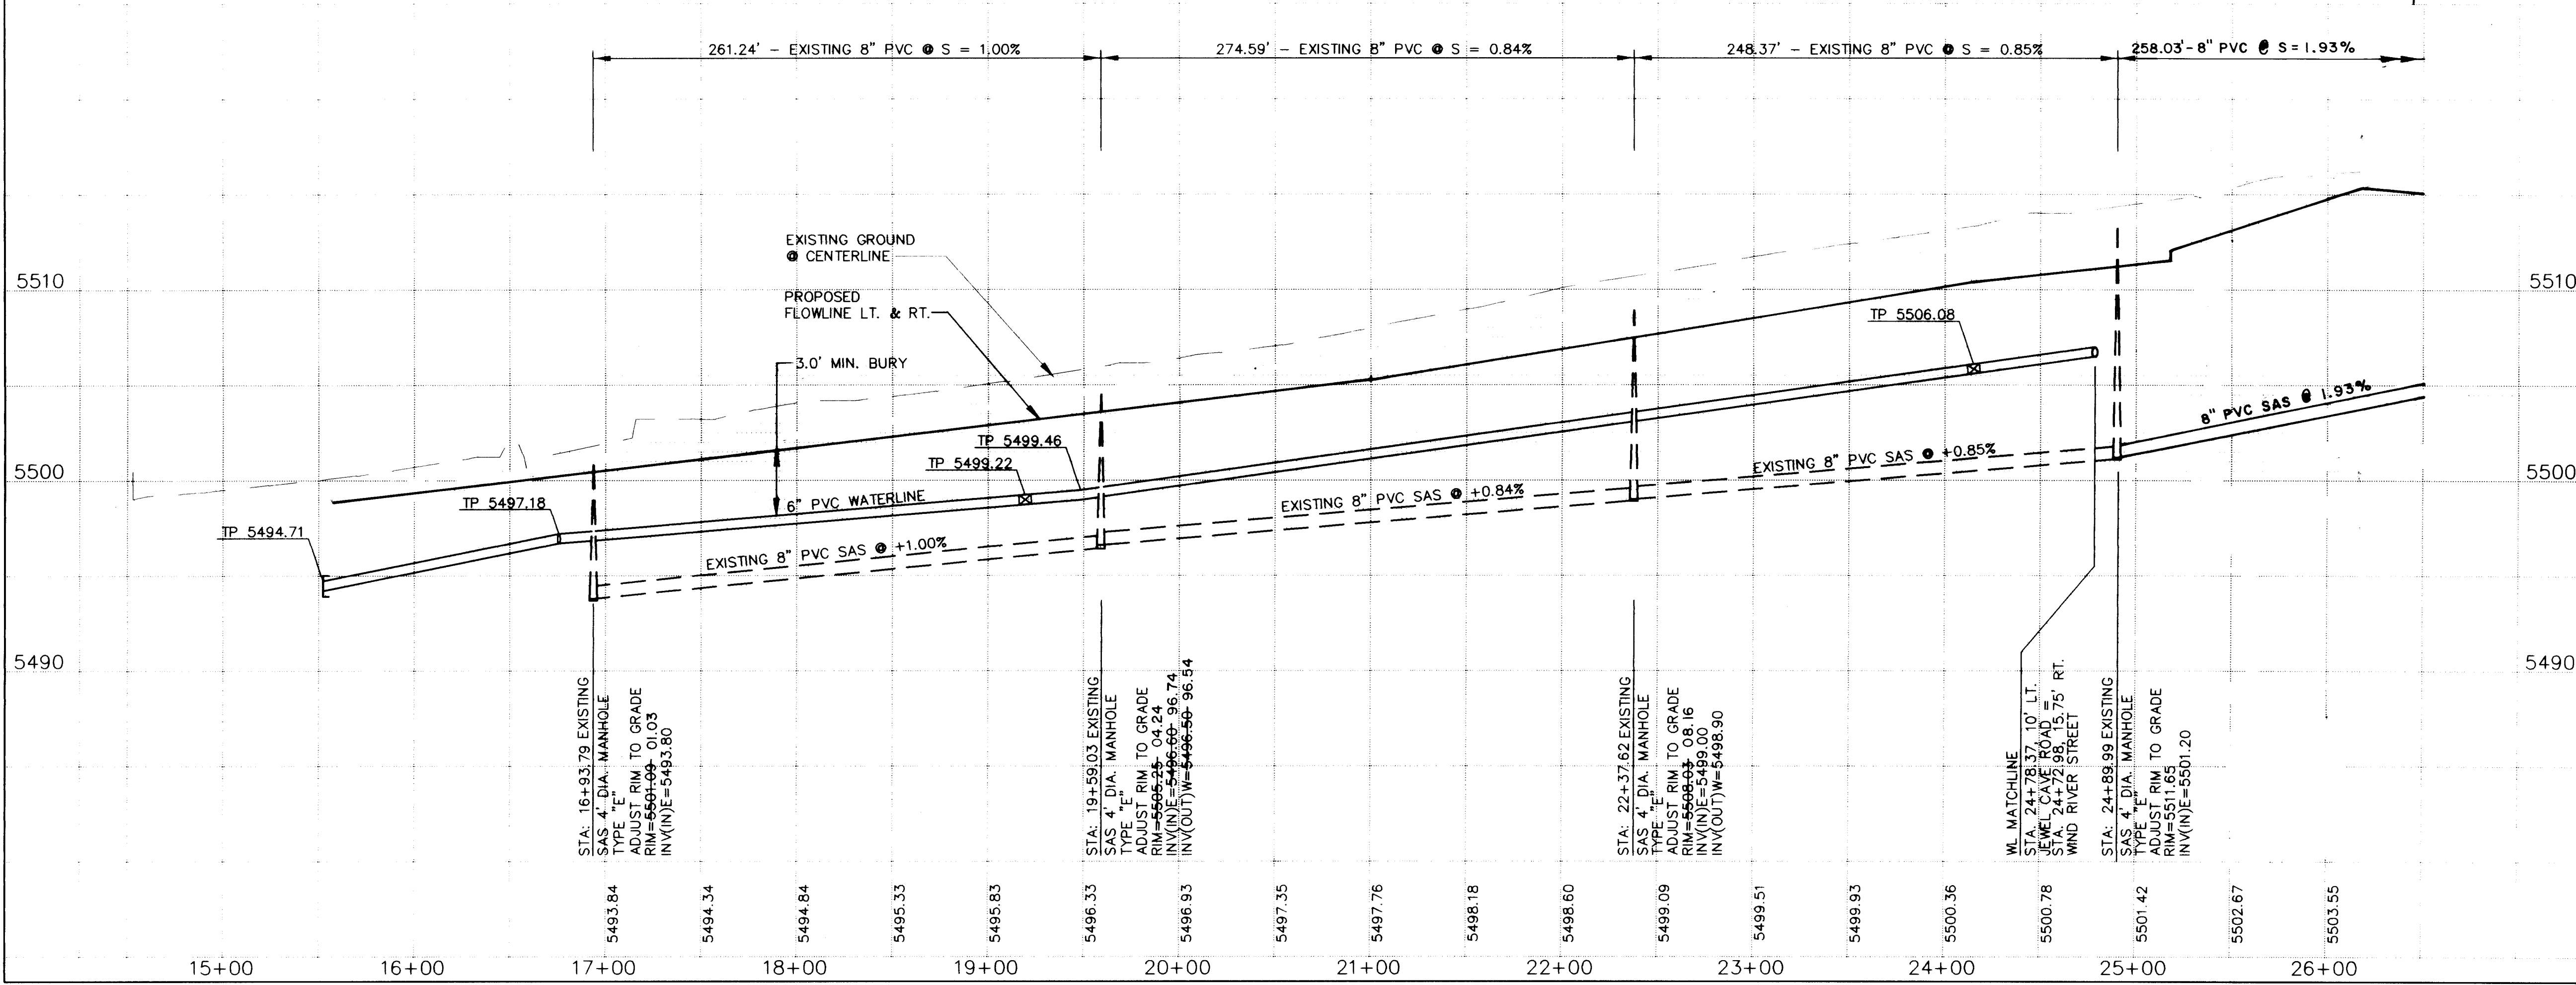

UTILITY NOTES

- STATIONING ALONG C OF STREET UNLESS OTHERWISE NOTED.
- SANITARY SEWER LINE LENGTHS COMPUTED FROM MH C TO MH C.
- SLOPES ARE COMPUTED INVERT TO INVERT. MH RIM ELEVATIONS GIVEN ARE APPROXIMATE. CONTRACTOR SHALL ADJUST ALL RIMS TO FINAL GRADE.
- CONTRACTOR IS RESPONSIBLE FOR COORDINATION WITH UTILITY COMPANIES.
- CONTRACTOR SHALL VERIFY ALL EXISTING UTILITY AND UTILITY CONNECTIONS PRIOR TO BEGINNING CONSTRUCTION. SHOULD A CONFLICT EXIST OR DESIGN REVISIONS BE REQUIRED FOR ANY REASON, THE CONTRACTOR SHALL NOTIFY THE ENGINEER AND ALLOW SUFFICIENT TIME FOR DESIGN REVISIONS SO AS TO NOT DELAY THE CONSTRUCTION SCHEDULE.

LEGEND

- EXISTING WATERLINE
- EXISTING STORM DRAIN
- EXISTING SANITARY SEWER
- EXISTING MANHOLE
- EXISTING FIRE HYDRANT
- EXISTING GATE VALVE
- PROPOSED WATERLINE
- PROPOSED STORM DRAIN
- PROPOSED SANITARY SEWER
- PROPOSED MANHOLE
- PROPOSED FIRE HYDRANT
- PROPOSED GATE VALVE
- PROPOSED CAP OR PLUG
- PROPOSED SINGLE METER, WATER SERVICE LINE
- PROPOSED DOUBLE METER, WATER SERVICE LINES
- PROPOSED SANITARY SEWER SERVICE LINE
- PROPOSED CROSS, TEE, OR ELBOW
- PNM UTILITY CONDUIT

SCANNED BY
BY LASON

AVID ENGINEERING, INC.
Civil • Structural • Transportation
6100 Sequoia St. NE - Suite 102
Albuquerque, NM 87109 (505) 881-5357

CITY OF ALBUQUERQUE
PUBLIC WORKS DEPARTMENT
ENGINEERING GROUP

TITLE: WILLOW WOOD - UNIT IV
JEWEL CAVE ROAD
UTILITY PLAN AND PROFILE

APPROVALS	ENGINEER	DATE	APPROVALS	ENGINEER	DATE
D.R.C. Chair	<i>[Signature]</i>	7-15-94	Water	<i>[Signature]</i>	7-8-94
Transportation	<i>[Signature]</i>	7-15-94	Waste Water	<i>[Signature]</i>	7-8-94
Hydrology	<i>[Signature]</i>	7-1-94			

DRAWING NO.	4604.93	MAP NO.	L-21-Z	SHEET	21	OF	40
-------------	---------	---------	--------	-------	----	----	----

AS BUILT INFORMATION			
CONTRACTOR	New Concepts Inc.	WORK	DATE
DESIGNED BY	COA	INSTALLED BY	EAR
CHECKED BY	COA	FIELD VERIFIED BY	COA
RECORDED BY	COA	DATE	DATE


BENCH MARKS			
THE STATION MARK IS A STANDARD ACS BRASS TABLET, STAMPED "1-L21 RESET 1974," LOCATED 7.8 MILES EAST OF DOWNTOWN ALBUQUERQUE, AT THE INTERSECTION OF CENTRAL AVE. AND JUAN TABO BLVD. THE STATION IS ON THE MEDIAN STRIP OF CENTRAL AVE., 81' WEST OF THE CENTERLINE OF JUAN TABO BLVD. AND FLUSH WITH THE TOP OF CURB. SLD ELEV. 5534.63			

SURVEY INFORMATION			
FIELD NOTES		DATE	BY
NO.			

ENGINEER'S SEAL			


REMARKS			
NO.	DATE	BY	
1			
2			
3			
DESIGN			
DESIGNED BY:	ETS	DATE:	5/94
DRAWN BY:		DATE:	5/94
CHECKED BY:	WVD	DATE:	5/94

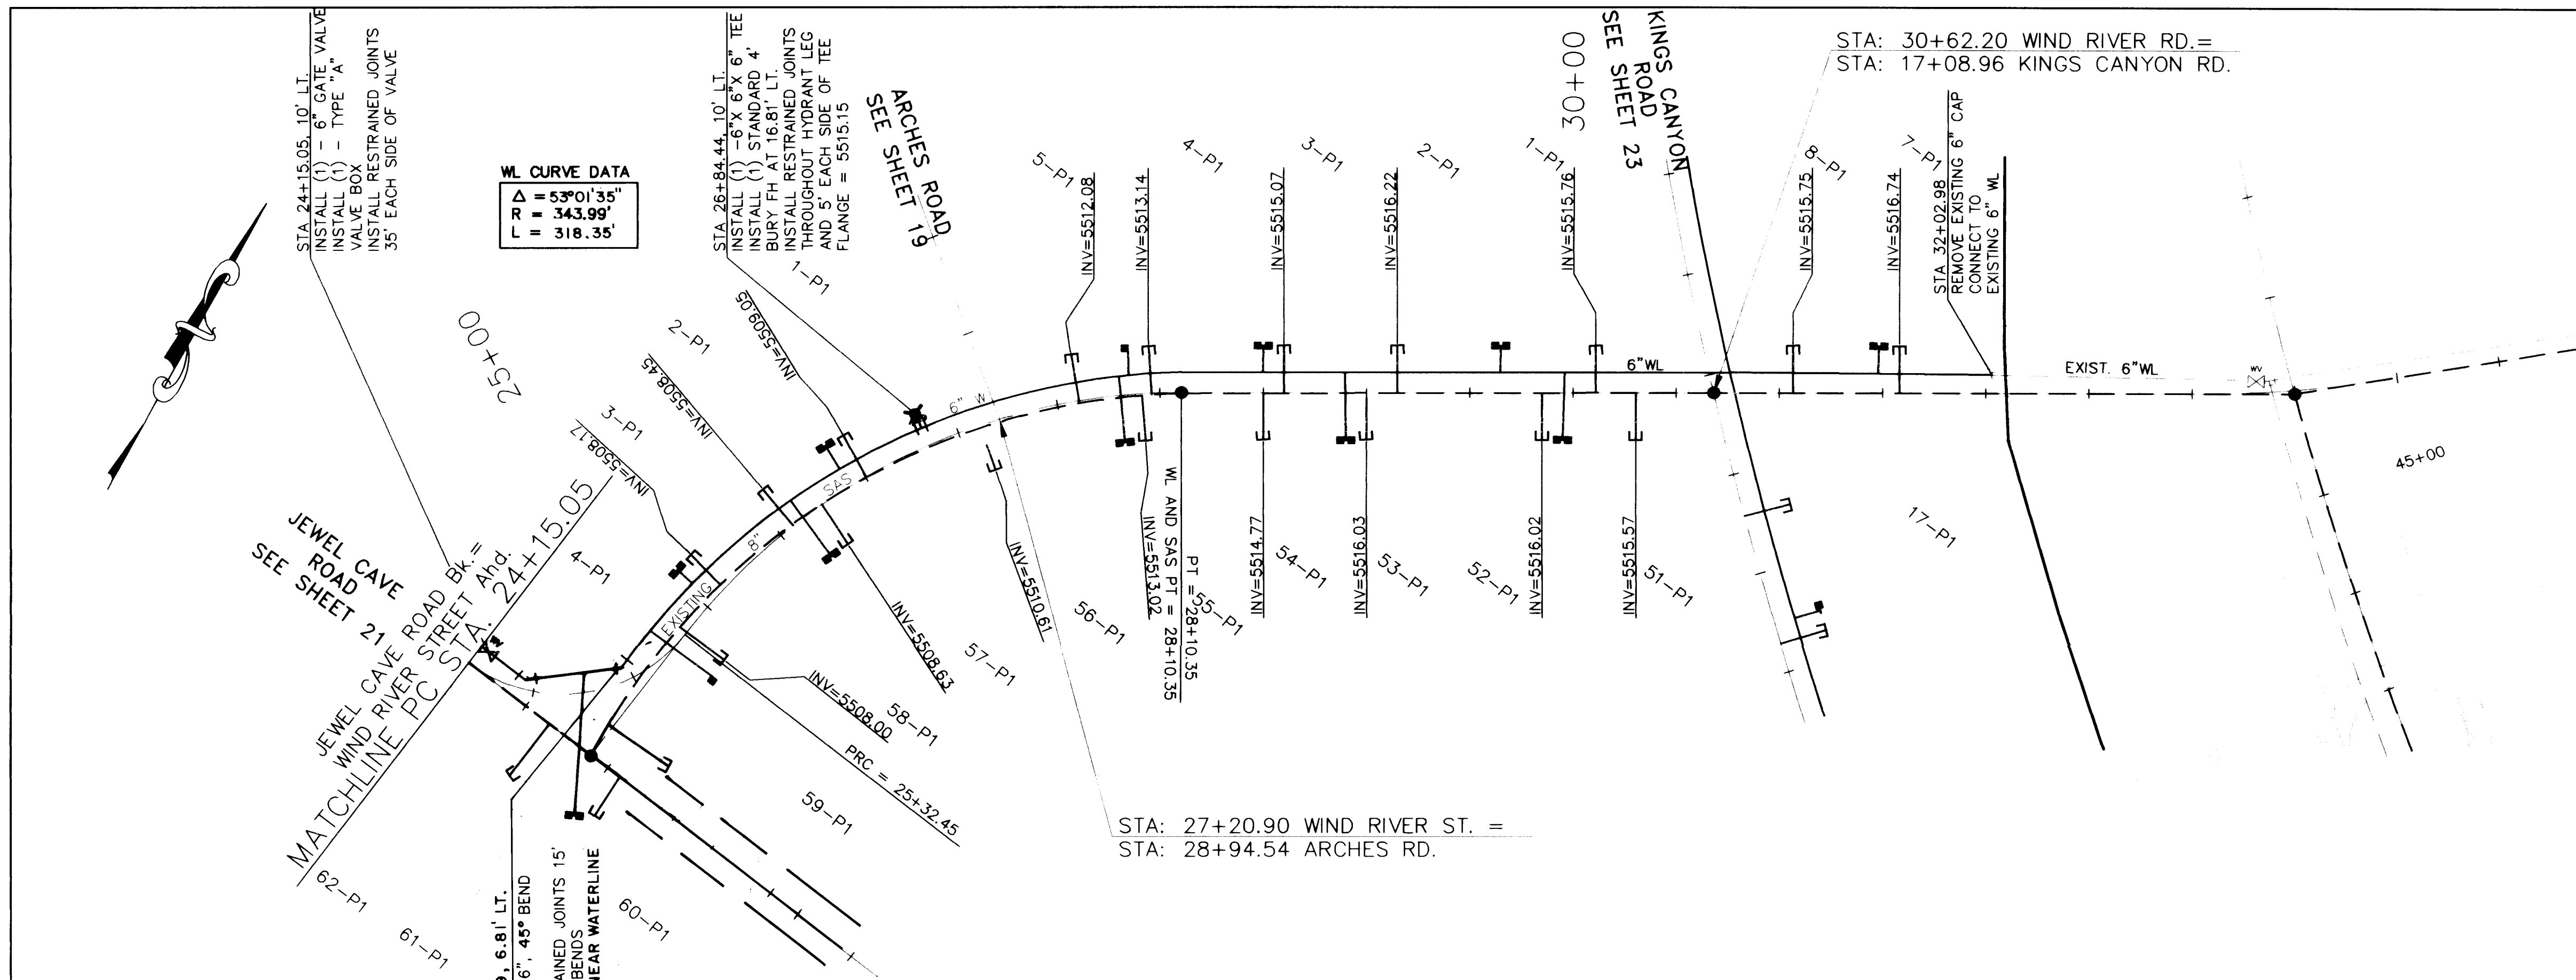

WL CURVE DATA

Δ	53°01'35"
L	343.99'
E	318.35'

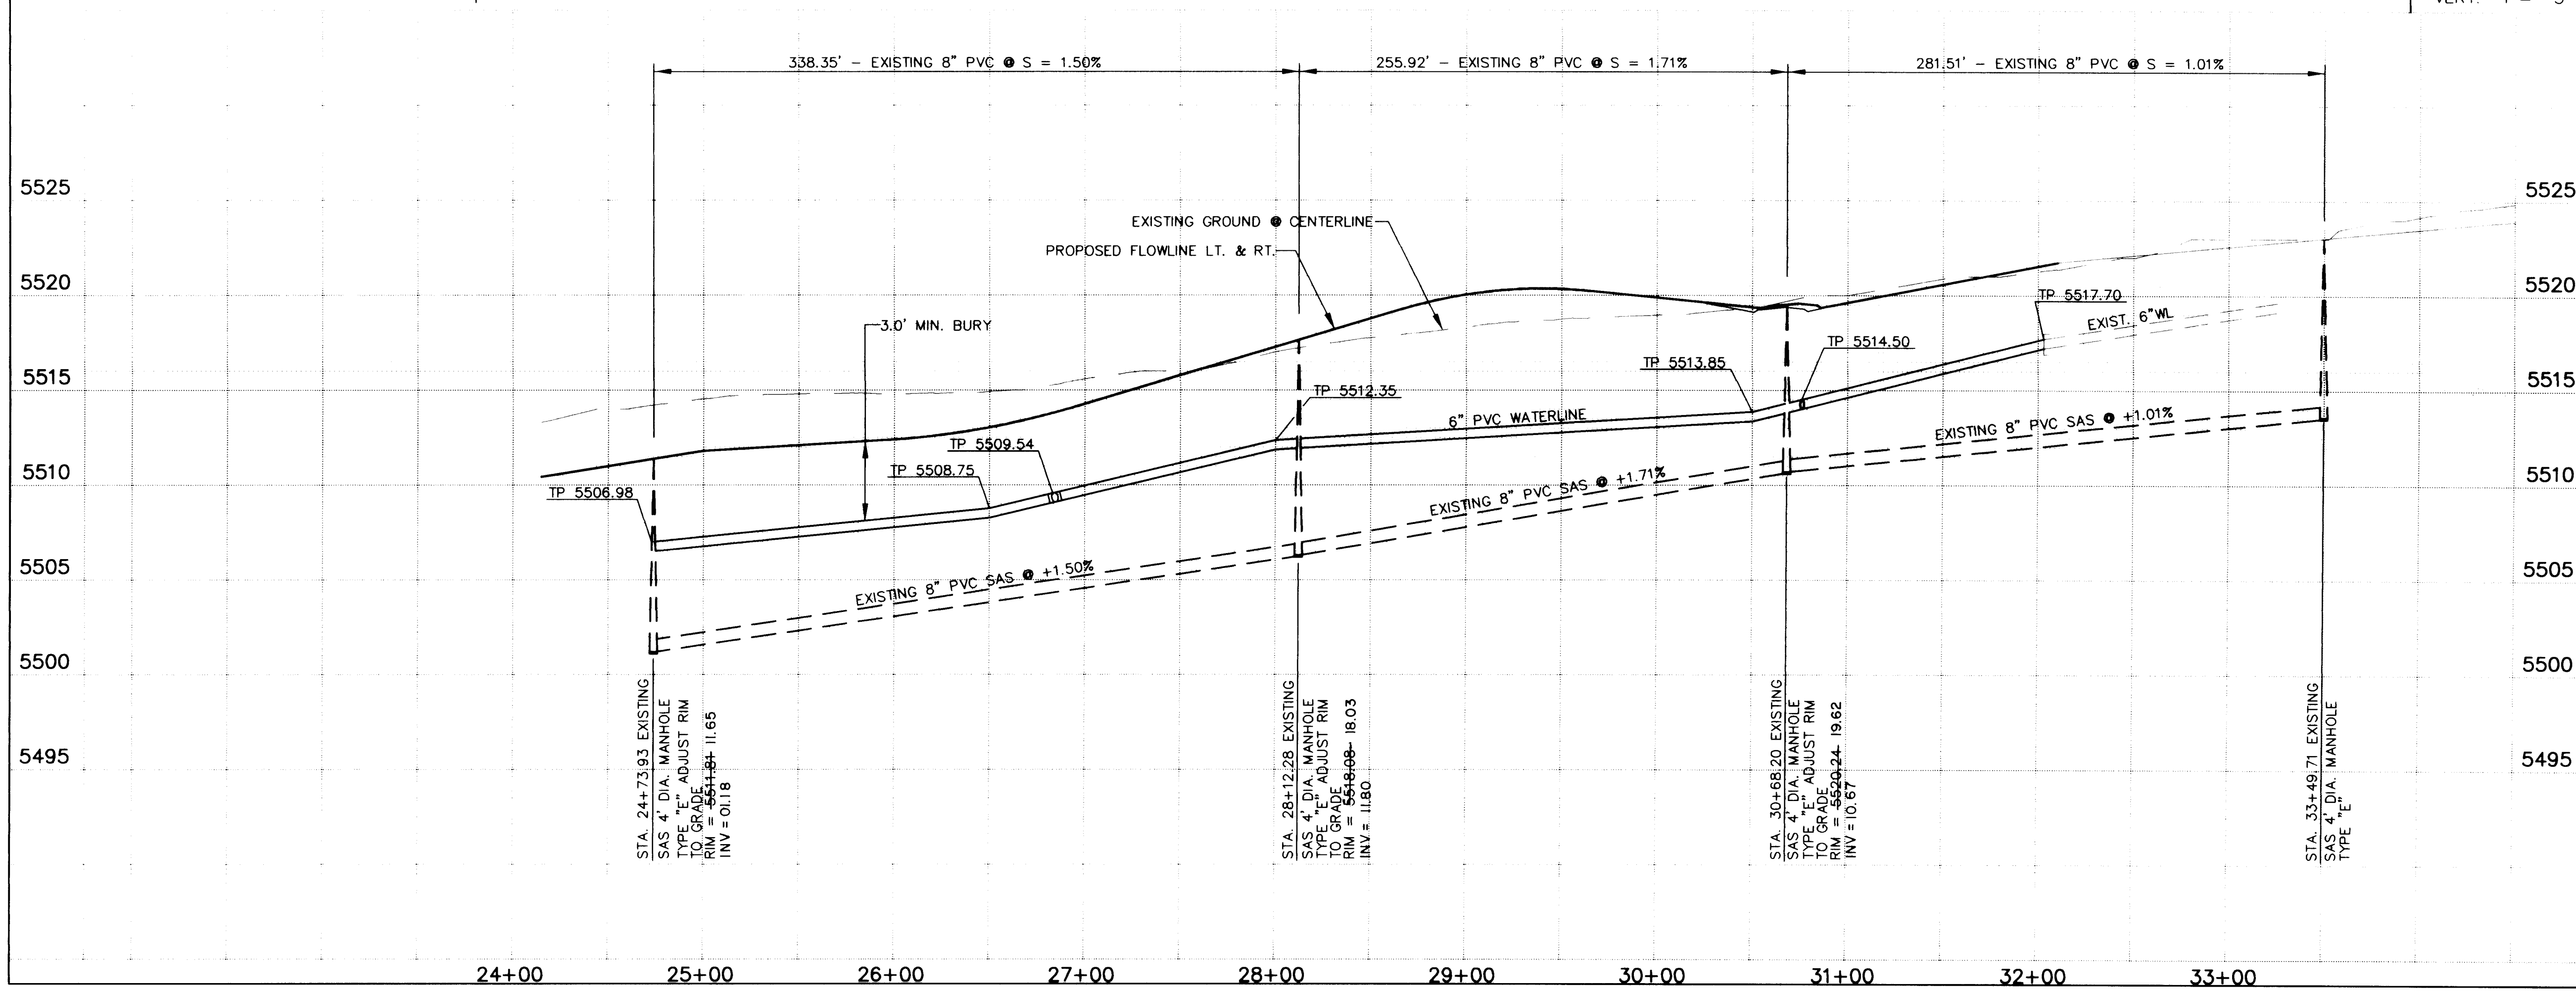

- UTILITY NOTES
- STATIONING ALONG C OF STREET UNLESS OTHERWISE NOTED.
 - SANITARY SEWER LINE LENGTHS COMPUTED FROM MH C TO MH C.
 - SLOPES ARE COMPUTED INVERT TO INVERT. MH RIM ELEVATIONS GIVEN ARE APPROXIMATE. CONTRACTOR SHALL ADJUST ALL RIMS TO FINAL GRADE.
 - CONTRACTOR IS RESPONSIBLE FOR COORDINATION WITH UTILITY COMPANIES.
 - CONTRACTOR SHALL VERIFY ALL EXISTING UTILITIES AND UTILITY CONNECTIONS PRIOR TO BEGINNING CONSTRUCTION. SHOULD A CONFLICT EXIST OR DESIGN REVISIONS BE REQUIRED FOR ANY REASON, THE CONTRACTOR SHALL NOTIFY THE ENGINEER AND ALLOW SUFFICIENT TIME FOR DESIGN REVISIONS SO AS TO NOT DELAY THE CONSTRUCTION SCHEDULE.

LEGEND

- W — EXISTING WATERLINE
- SAS — EXISTING STORM DRAIN
- SAS — EXISTING SANITARY SEWER
- EXISTING MANHOLE
- EXISTING FIRE HYDRANT
- EXISTING GATE VALVE
- W — PROPOSED WATERLINE
- SD — PROPOSED STORM DRAIN
- SAS — PROPOSED SANITARY SEWER
- PROPOSED MANHOLE
- PROPOSED FIRE HYDRANT
- PROPOSED GATE VALVE
- PROPOSED CAP OR PLUG
- PROPOSED SINGLE METER, WATER SERVICE LINE
- PROPOSED DOUBLE METER, WATER SERVICE LINES
- PROPOSED SANITARY SEWER SERVICE LINE
- PROPOSED CROSS, TEE, OR ELBOW
- PNM UTILITY CONDUIT

SCALE:
HORIZ. 1" = 50'
VERT. 1" = 5'



AS BUILT INFORMATION			BENCH MARKS			SURVEY INFORMATION			ENGINEER'S SEAL		
CONTRACTOR	DATE	COA	STATION MARK	DATE	NO.	FIELD NOTES	BY	DATE	NO.	DATE	BY
New Concepts Inc			STAMPED "1-121 RESET 1974" LOCATED 7.8 MILES EAST OF DOWNTOWN ALBUQUERQUE, AT THE INTERSECTION OF CENTRAL AVE. AND JUAN TABO BLVD. THE STATION IS ON THE MEDIAN STRIP OF CENTRAL AVE., 81' WEST OF THE CENTERLINE OF JUAN TABO BLVD. AND FLUSH WITH THE TOP OF CURB. SLD ELEV. 5534.63								
MICRO-FILM INFORMATION			DESIGN			REMARKS			DATE		
RECORDED BY	DATE	NO.	DESIGNED BY	DATE		NO.	DATE		DESIGNED BY	DATE	
			DRAWN BY	DATE					DRAWN BY	DATE	
			CHECKED BY	DATE					CHECKED BY	DATE	

SCANNED BY
BY LASON

20-142041.93 22915

AVID ENGINEERING, INC.
Civil • Structural • Transportation
6100 Seagull St. NE Suite 102
Albuquerque, NM 87109 (505) 881-5357

CITY OF ALBUQUERQUE PUBLIC WORKS DEPARTMENT ENGINEERING GROUP					
TITLE: WILLOW WOOD - UNIT IV WIND RIVER STREET UTILITY PLAN AND PROFILE					
APPROVALS	ENGINEER	DATE	APPROVALS	ENGINEER	DATE
D.R.C. Chair	B.G. Chaplin	7-15-94	Water	R.W. Kano	7-8-94
Transportation	NA	7-1-94	Waste Water	R.W. Kano	7-8-94
Hydrology	NA	7-1-94			
DRAWING NO.	4604.93	MAP NO. L-21-Z	SHEET 22	OF 40	

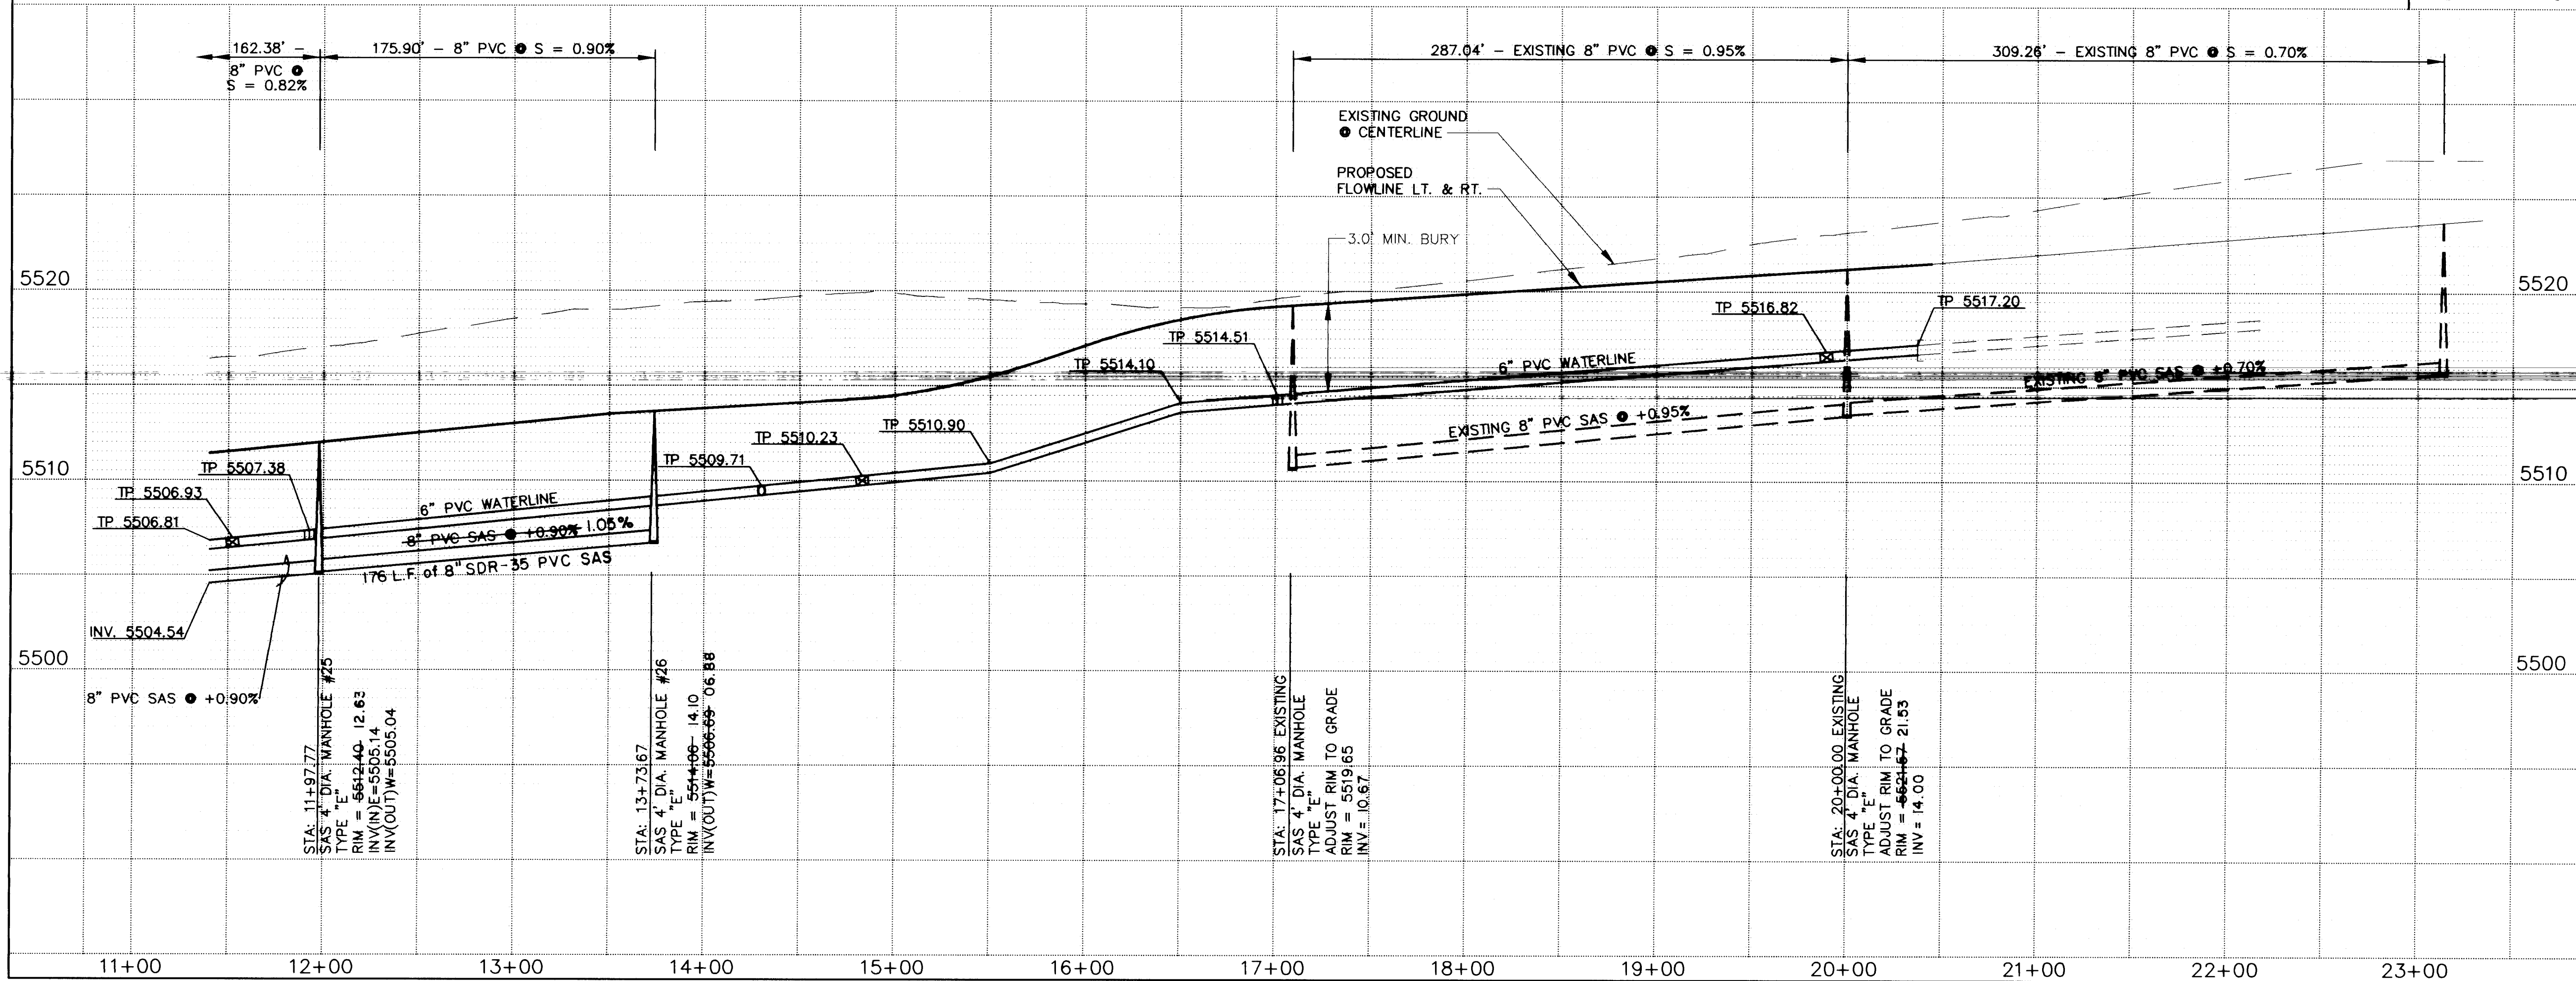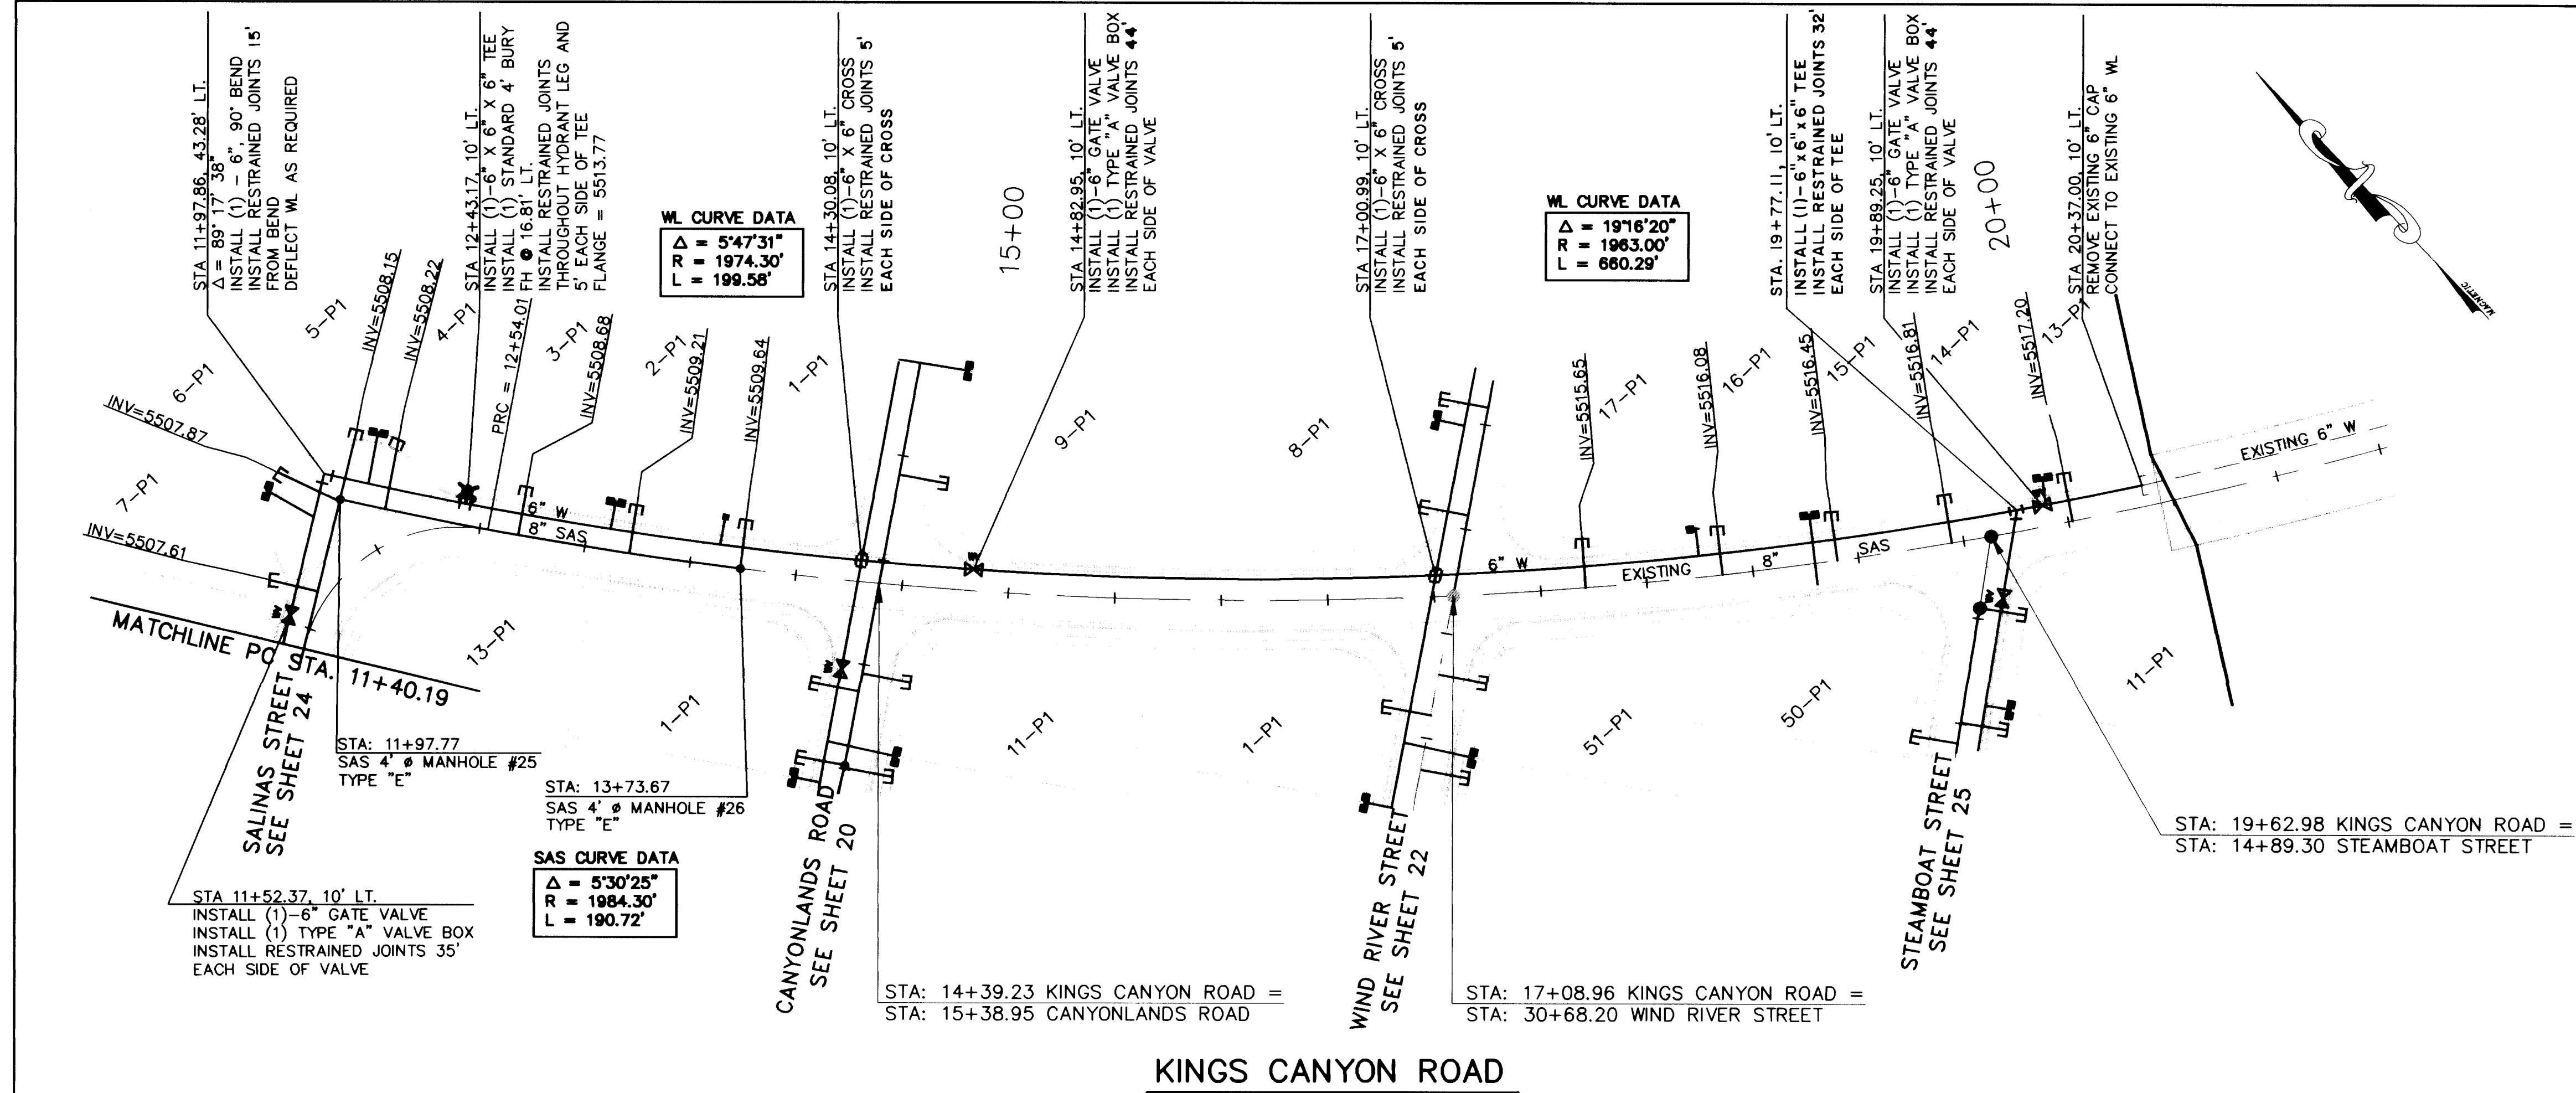

UTILITY NOTES

- STATIONING ALONG C. OF STREET UNLESS OTHERWISE NOTED.
- SANITARY SEWER LINE LENGTHS COMPUTED FROM MH C. TO MH C.
- SLOPES ARE COMPUTED INVERT TO INVERT. MH RIM ELEVATIONS GIVEN ARE APPROXIMATE. CONTRACTOR SHALL ADJUST ALL RIMS TO FINAL GRADE.
- CONTRACTOR IS RESPONSIBLE FOR COORDINATION WITH UTILITY COMPANIES.
- CONTRACTOR SHALL VERIFY ALL EXISTING UTILITIES AND UTILITY CONNECTIONS PRIOR TO BEGINNING CONSTRUCTION. SHOULD A CONFLICT EXIST OR DESIGN REVISIONS BE REQUIRED FOR ANY REASON, THE CONTRACTOR SHALL NOTIFY THE ENGINEER AND ALLOW SUFFICIENT TIME FOR DESIGN REVISIONS SO AS TO NOT DELAY THE CONSTRUCTION SCHEDULE.

LEGEND

W — EXISTING WATERLINE
SD — EXISTING STORM DRAIN
SAS — EXISTING SANITARY SEWER
— EXISTING MANHOLE
— EXISTING FIRE HYDRANT
— EXISTING GATE VALVE
W — PROPOSED WATERLINE
SD — PROPOSED STORM DRAIN
SAS — PROPOSED SANITARY SEWER
— PROPOSED MANHOLE
— PROPOSED FIRE HYDRANT
— PROPOSED GATE VALVE
— PROPOSED CAP OR PLUG
— PROPOSED SINGLE METER, WATER SERVICE LINE
— PROPOSED DOUBLE METER, WATER SERVICE LINES
— PROPOSED SANITARY SEWER SERVICE LINE
+ + — PROPOSED CROSS, TEE, OR ELBOW
— PNM UTILITY CONDUIT

AS BUILT INFORMATION

CONTRACTOR: New Concepts Inc.
STAMPED: 11-121 RESET 1974, LOCATED 7.8 MILES EAST OF DOWNTOWN ALBUQUERQUE, AT THE INTERSECTION OF CENTRAL AVE. AND JUAN TABO BLVD. THE STATION IS ON THE MEDIAN STRIP OF CENTRAL AVE., 81' WEST OF THE CENTERLINE OF JUAN TABO BLVD. AND FLUSH WITH THE TOP OF CURB. SLD ELEV. 5534.63

SURVEY INFORMATION

DATE: 5/94
BY: JVO

ENGINEER'S SEAL

DESIGNED BY: ETS
DRAWN BY: JVO
CHECKED BY: JVO



CITY OF ALBUQUERQUE
PUBLIC WORKS DEPARTMENT
ENGINEERING GROUP

TITLE: WILLOW WOOD — UNIT IV
KINGS CANYON ROAD
UTILITY PLAN AND PROFILE

APPROVALS

ENGINEER	DATE	APPROVALS	ENGINEER	DATE
D.R.C. Chair	7-15-94	Water	R.W. Kane	7-8-94
Transportation	7-8-94	Waste Water	R.W. Kane	7-8-94
Hydrology	7-1-94			

DRAWING NO. 4604.93 **MAP NO.** L-21-Z **SHEET** 23 **OF** 40

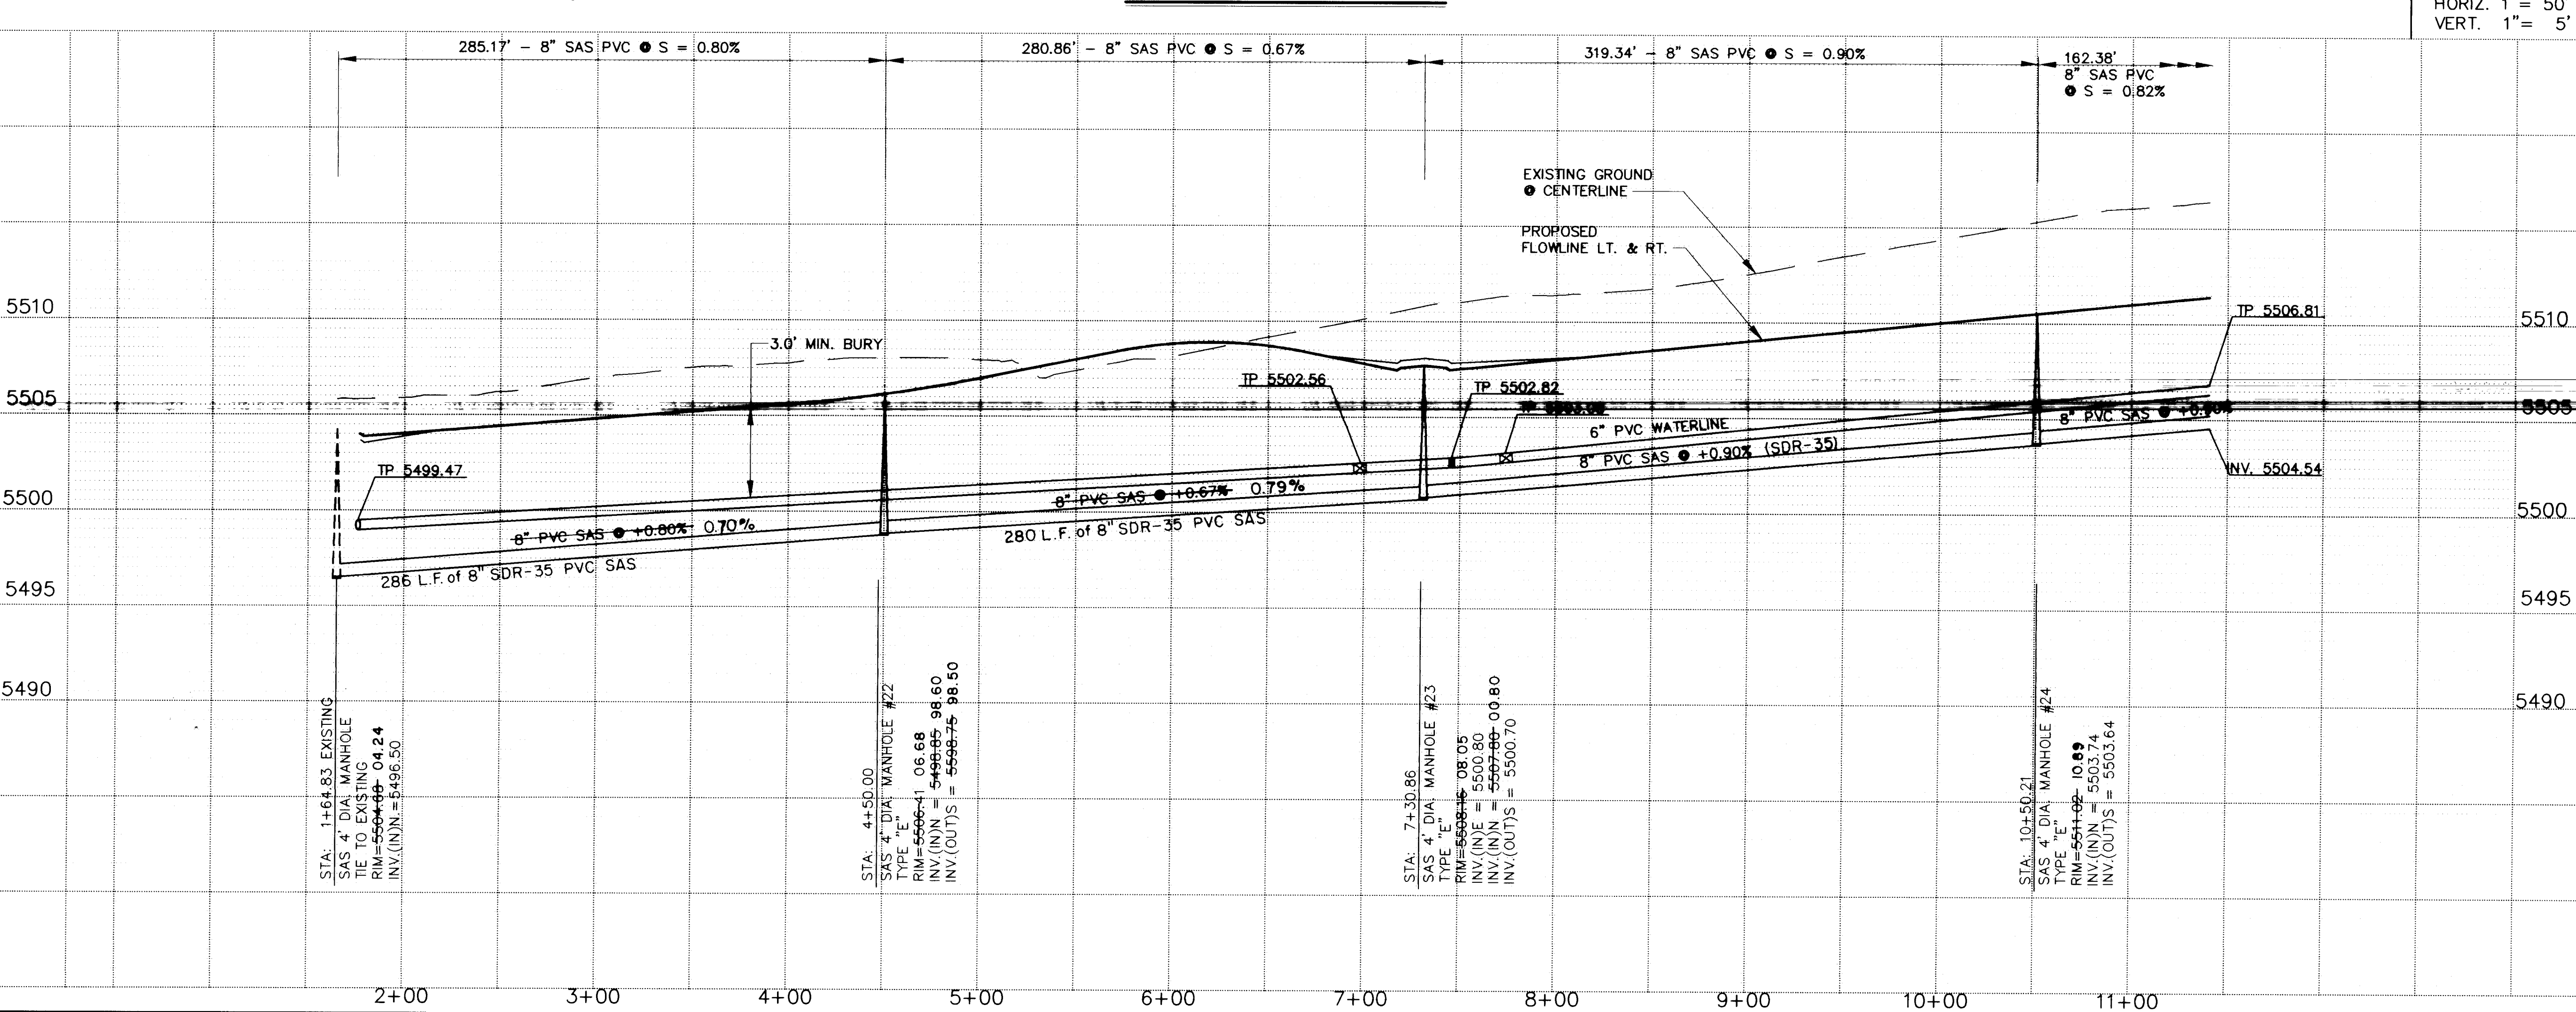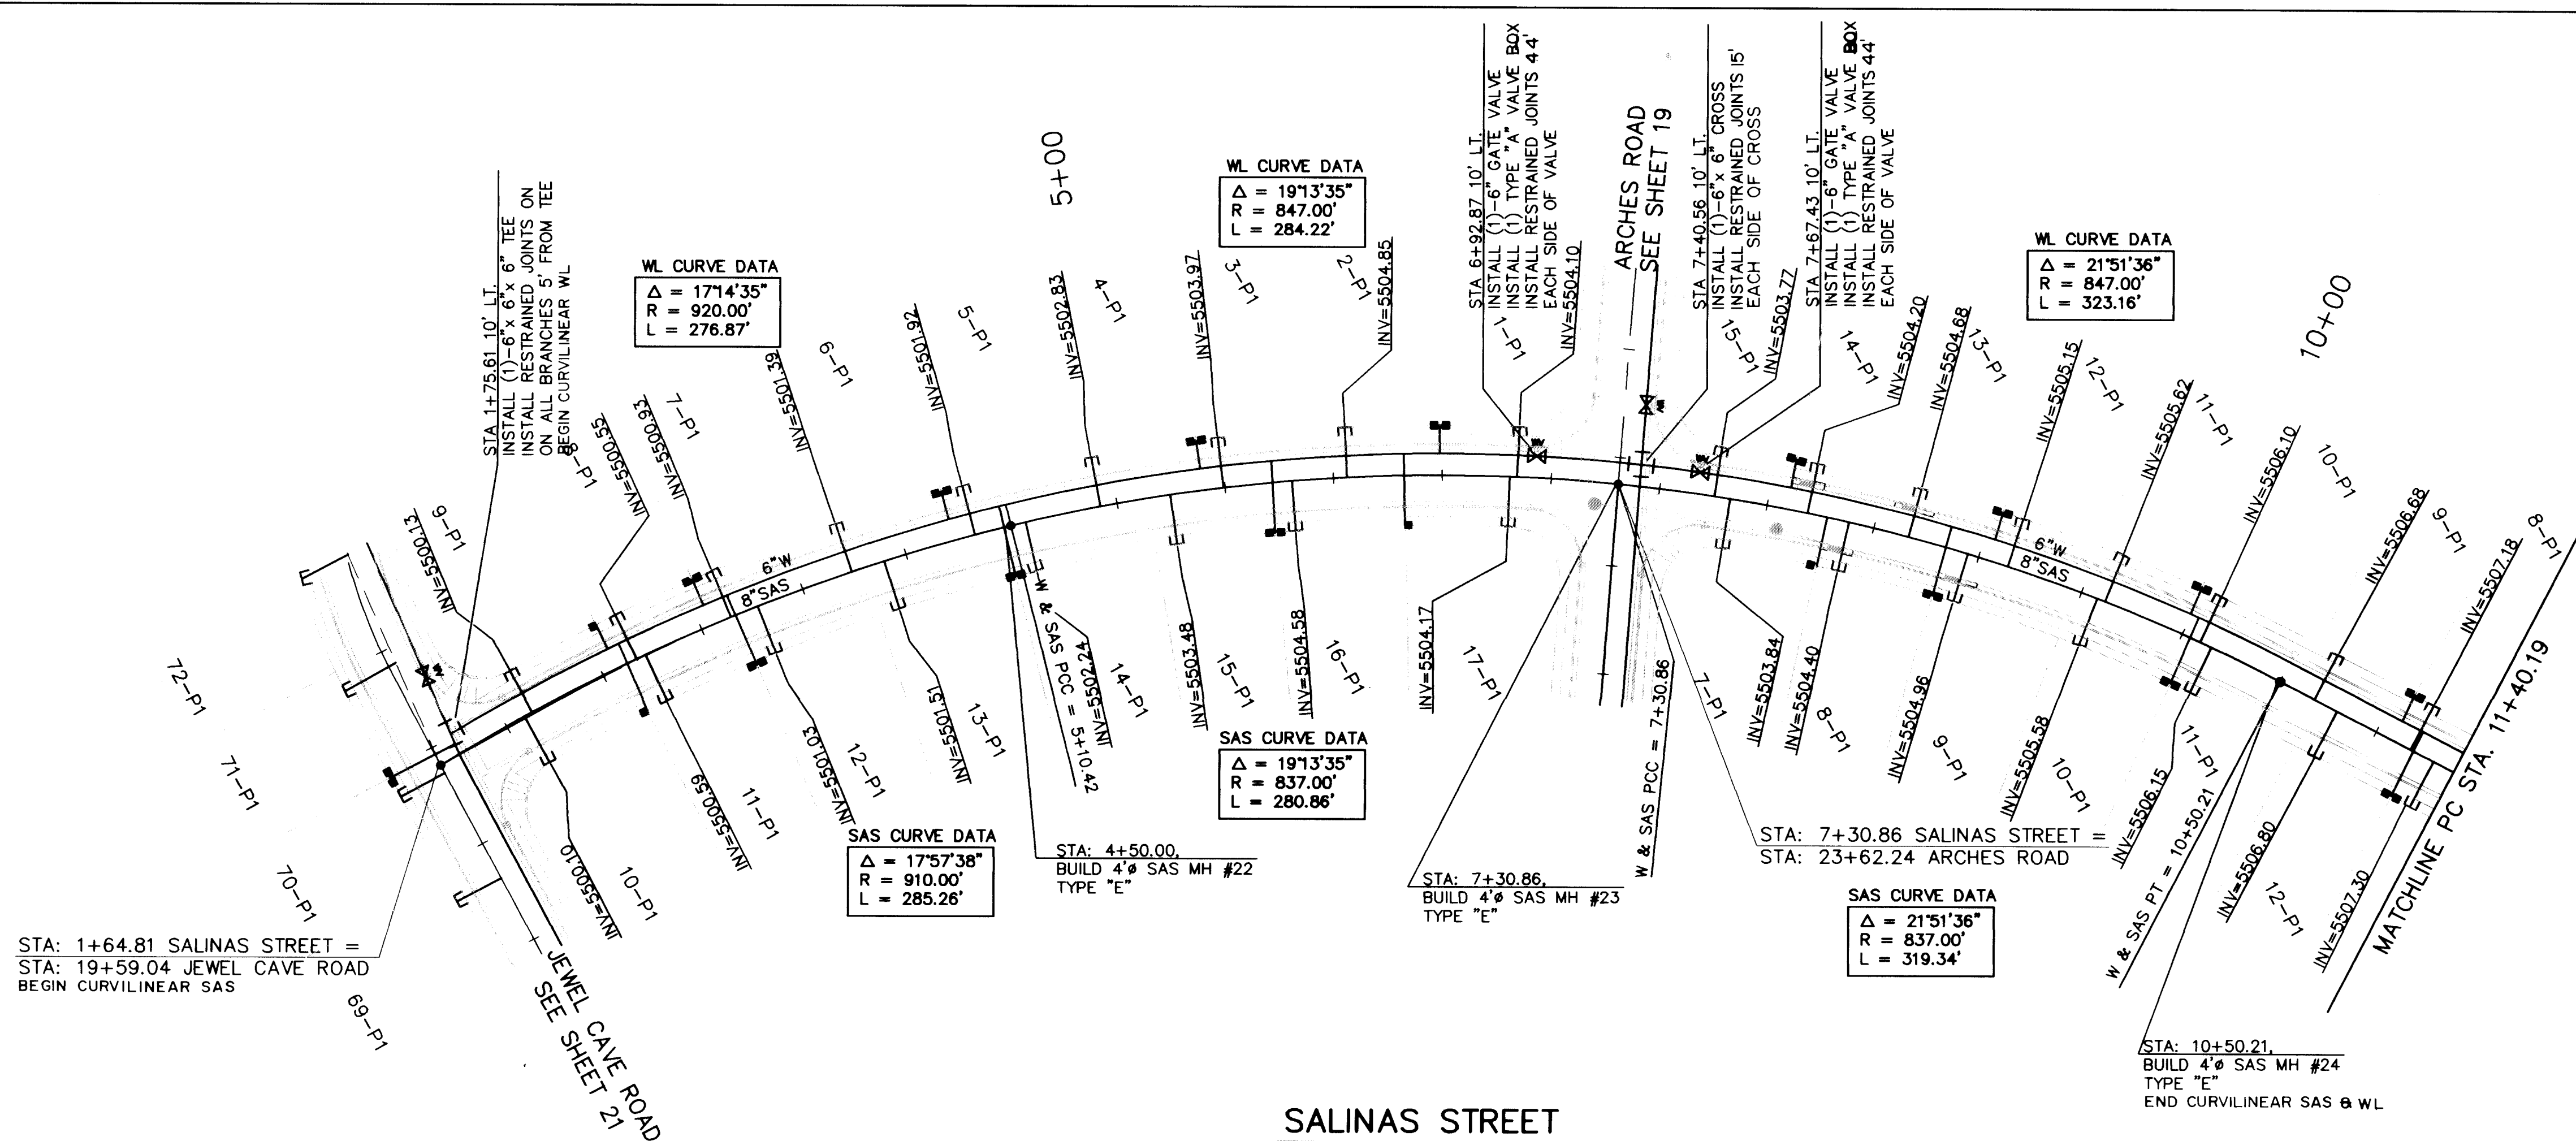

- UTILITY NOTES
- 1.) STATIONING ALONG C OF STREET UNLESS OTHERWISE NOTED.
 - 2.) SANITARY SEWER LINE LENGTHS COMPUTED FROM MH C TO MH C.
 - 3.) SLOPES ARE COMPUTED INVERT TO INVERT. MH RIM ELEVATIONS GIVEN ARE APPROXIMATE. CONTRACTOR SHALL ADJUST ALL RIMS TO FINAL GRADE.
 - 4.) CONTRACTOR IS RESPONSIBLE FOR COORDINATION WITH UTILITY COMPANIES.
 - 5.) CONTRACTOR SHALL VERIFY ALL EXISTING UTILITIES AND UTILITY CONNECTIONS PRIOR TO BEGINNING CONSTRUCTION. SHOULD A CONFLICT EXIST OR DESIGN REVISIONS BE REQUIRED FOR ANY REASON, THE CONTRACTOR SHALL NOTIFY THE ENGINEER AND ALLOW SUFFICIENT TIME FOR DESIGN REVISIONS SO AS TO NOT DELAY THE CONSTRUCTION SCHEDULE.





- LEGEND
- W — EXISTING WATERLINE
 - SD — EXISTING STORM DRAIN
 - SAS — EXISTING SANITARY SEWER
 - — EXISTING MANHOLE
 - — EXISTING FIRE HYDRANT
 - — EXISTING GATE VALVE
 - W — PROPOSED WATERLINE
 - SD — PROPOSED STORM DRAIN
 - SAS — PROPOSED SANITARY SEWER
 - — PROPOSED MANHOLE
 - — PROPOSED FIRE HYDRANT
 - — PROPOSED GATE VALVE
 - — PROPOSED CAP OR PLUG
 - — PROPOSED SINGLE METER, WATER SERVICE LINE
 - — PROPOSED DOUBLE METER, WATER SERVICE LINES
 - — PROPOSED SANITARY SEWER SERVICE LINE
 - — PROPOSED CROSS, TEE, OR ELBOW
 - — PNM UTILITY CONDUIT

SCANNED BY
BY LASON

20-4604-93 2995

AVID ENGINEERING, INC.
Civil • Structural • Transportation
6100 Seagull St. NE - Suite 102
Albuquerque, NM 87109 - (505) 881-5357

CITY OF ALBUQUERQUE PUBLIC WORKS DEPARTMENT ENGINEERING GROUP					
TITLE: WILLOW WOOD - UNIT IV SALANIS STREET UTILITY PLAN AND PROFILE					
APPROVALS	ENGINEER	DATE	APPROVALS	ENGINEER	DATE
D.R.C. Chair	<i>[Signature]</i>	7-15-94	Water	<i>[Signature]</i>	7-8-94
Transportation	<i>[Signature]</i>	7-01-94	Waste Water	<i>[Signature]</i>	7-8-94
Hydrology	<i>[Signature]</i>	7-1-94			
DRAWING NO.	4604.93	MAP NO. L-21-Z	SHEET 24	OF 40	

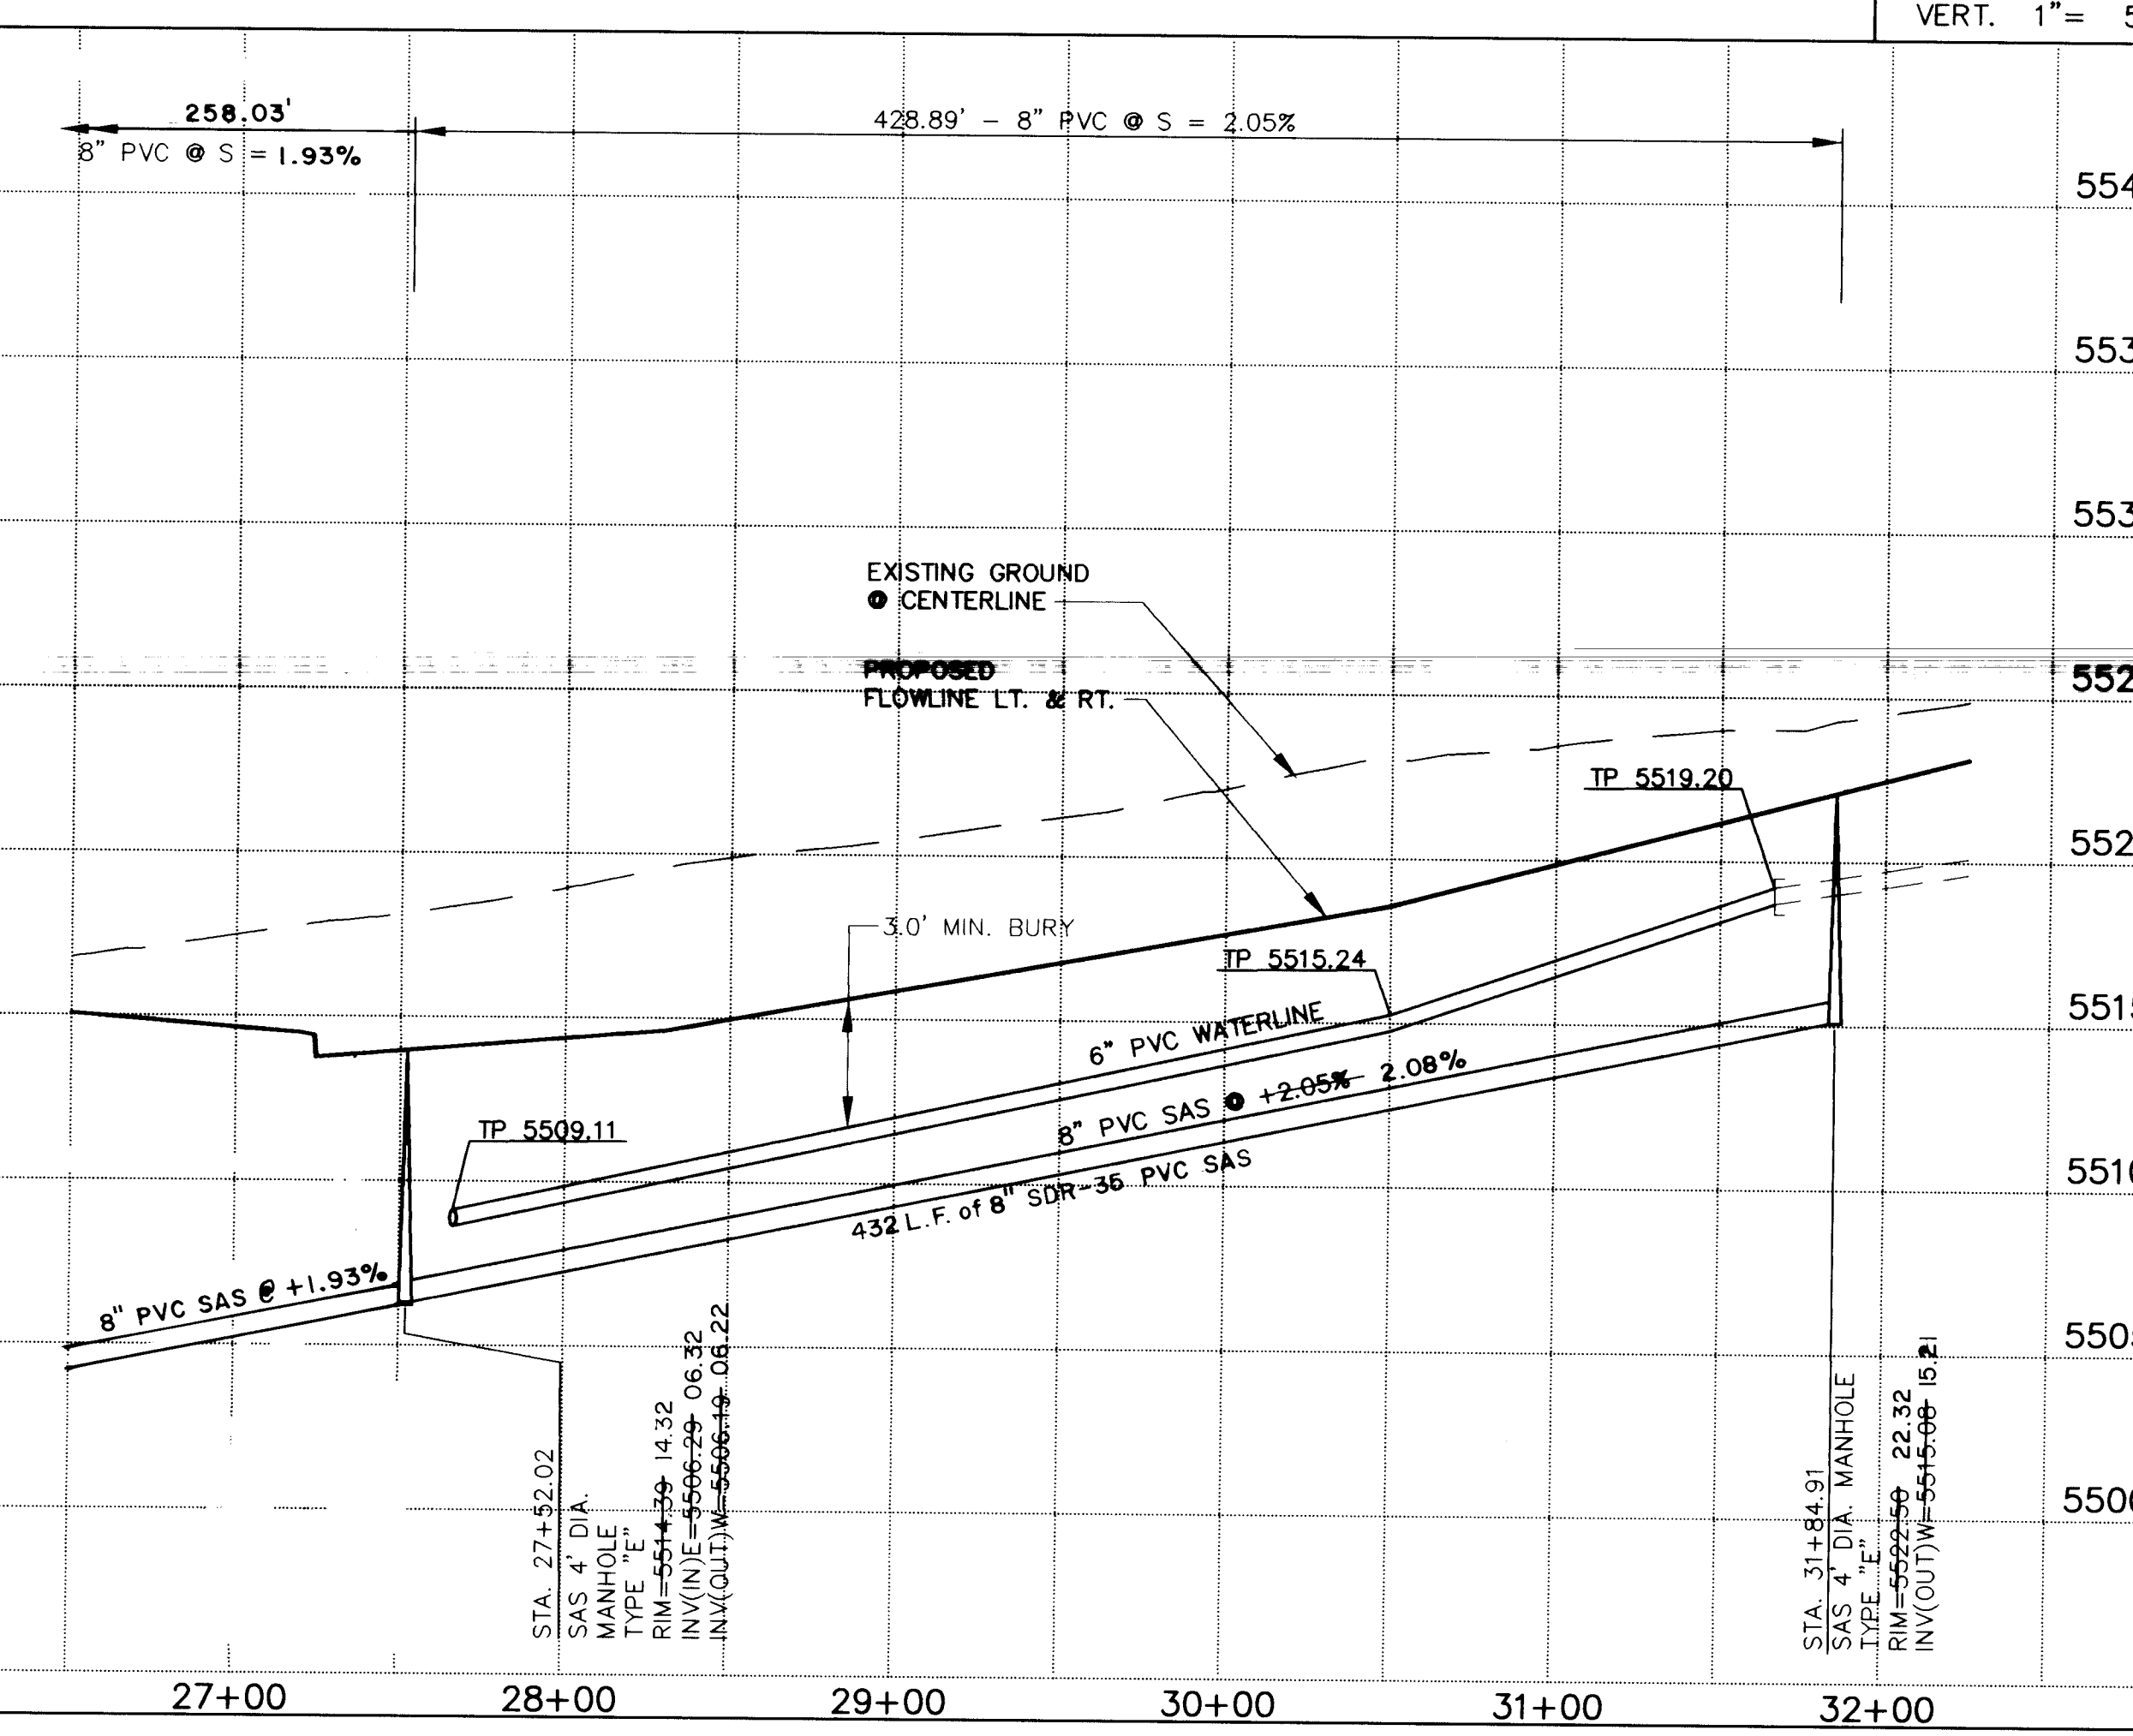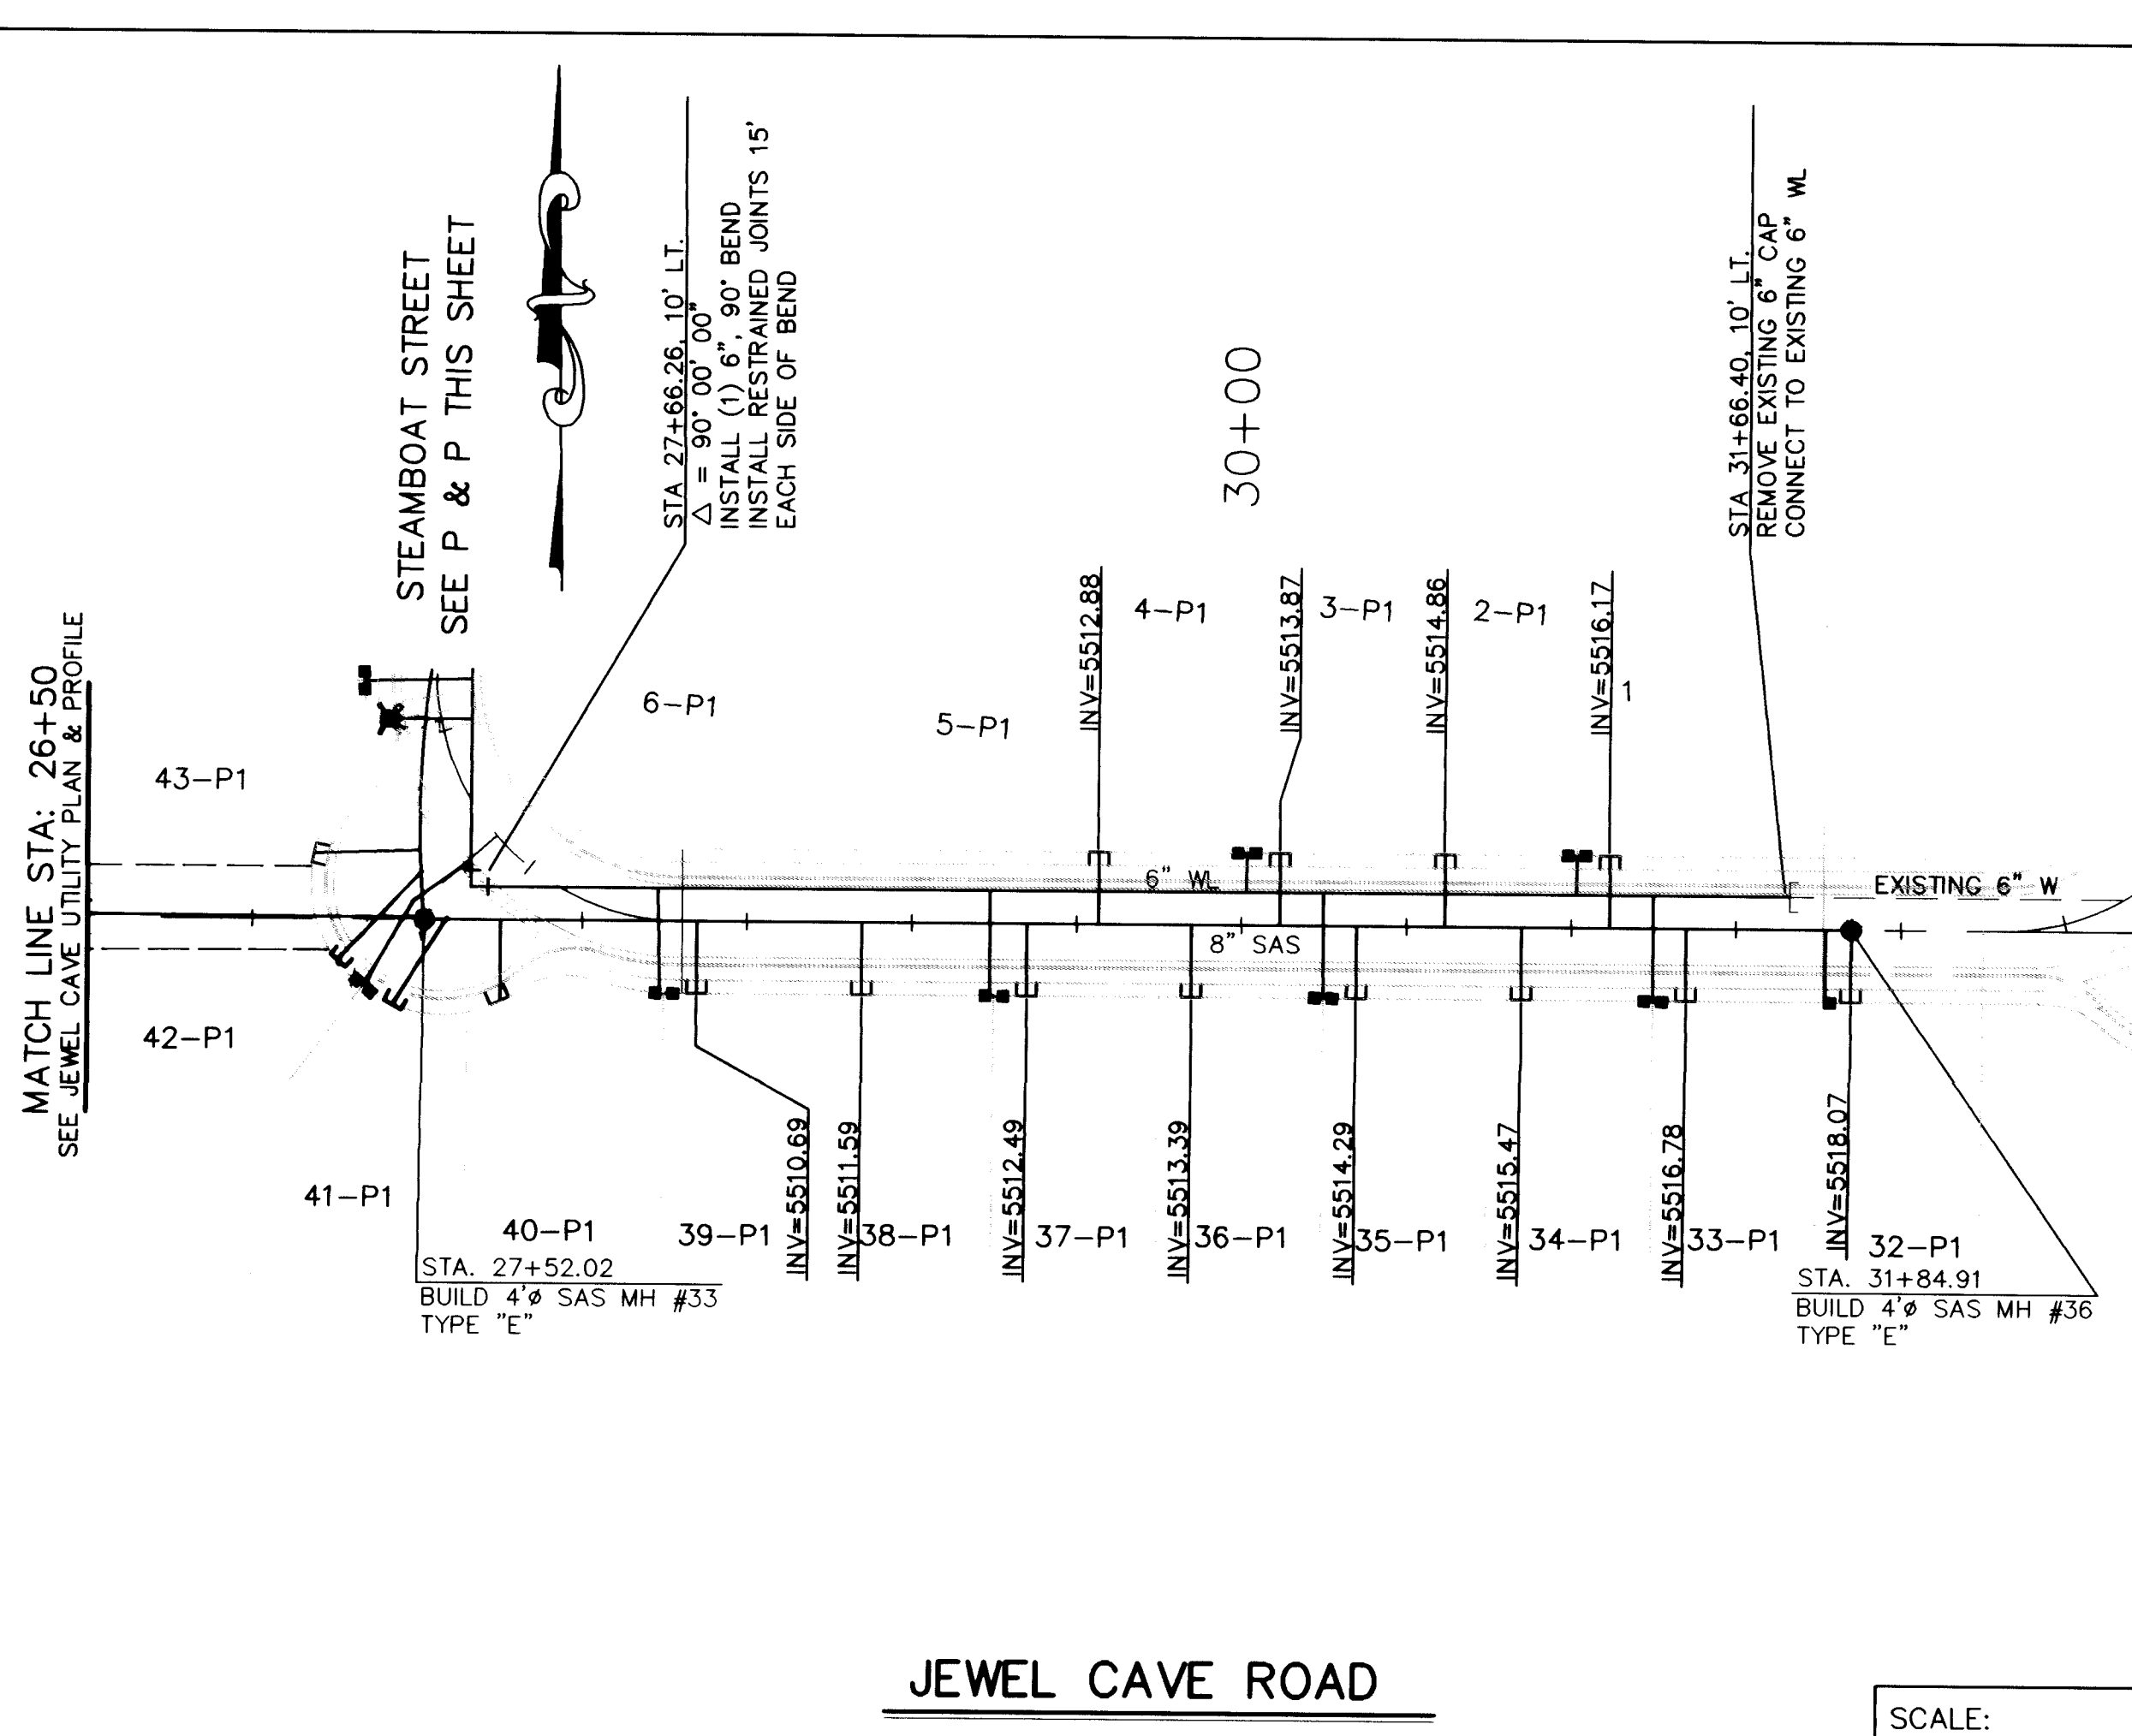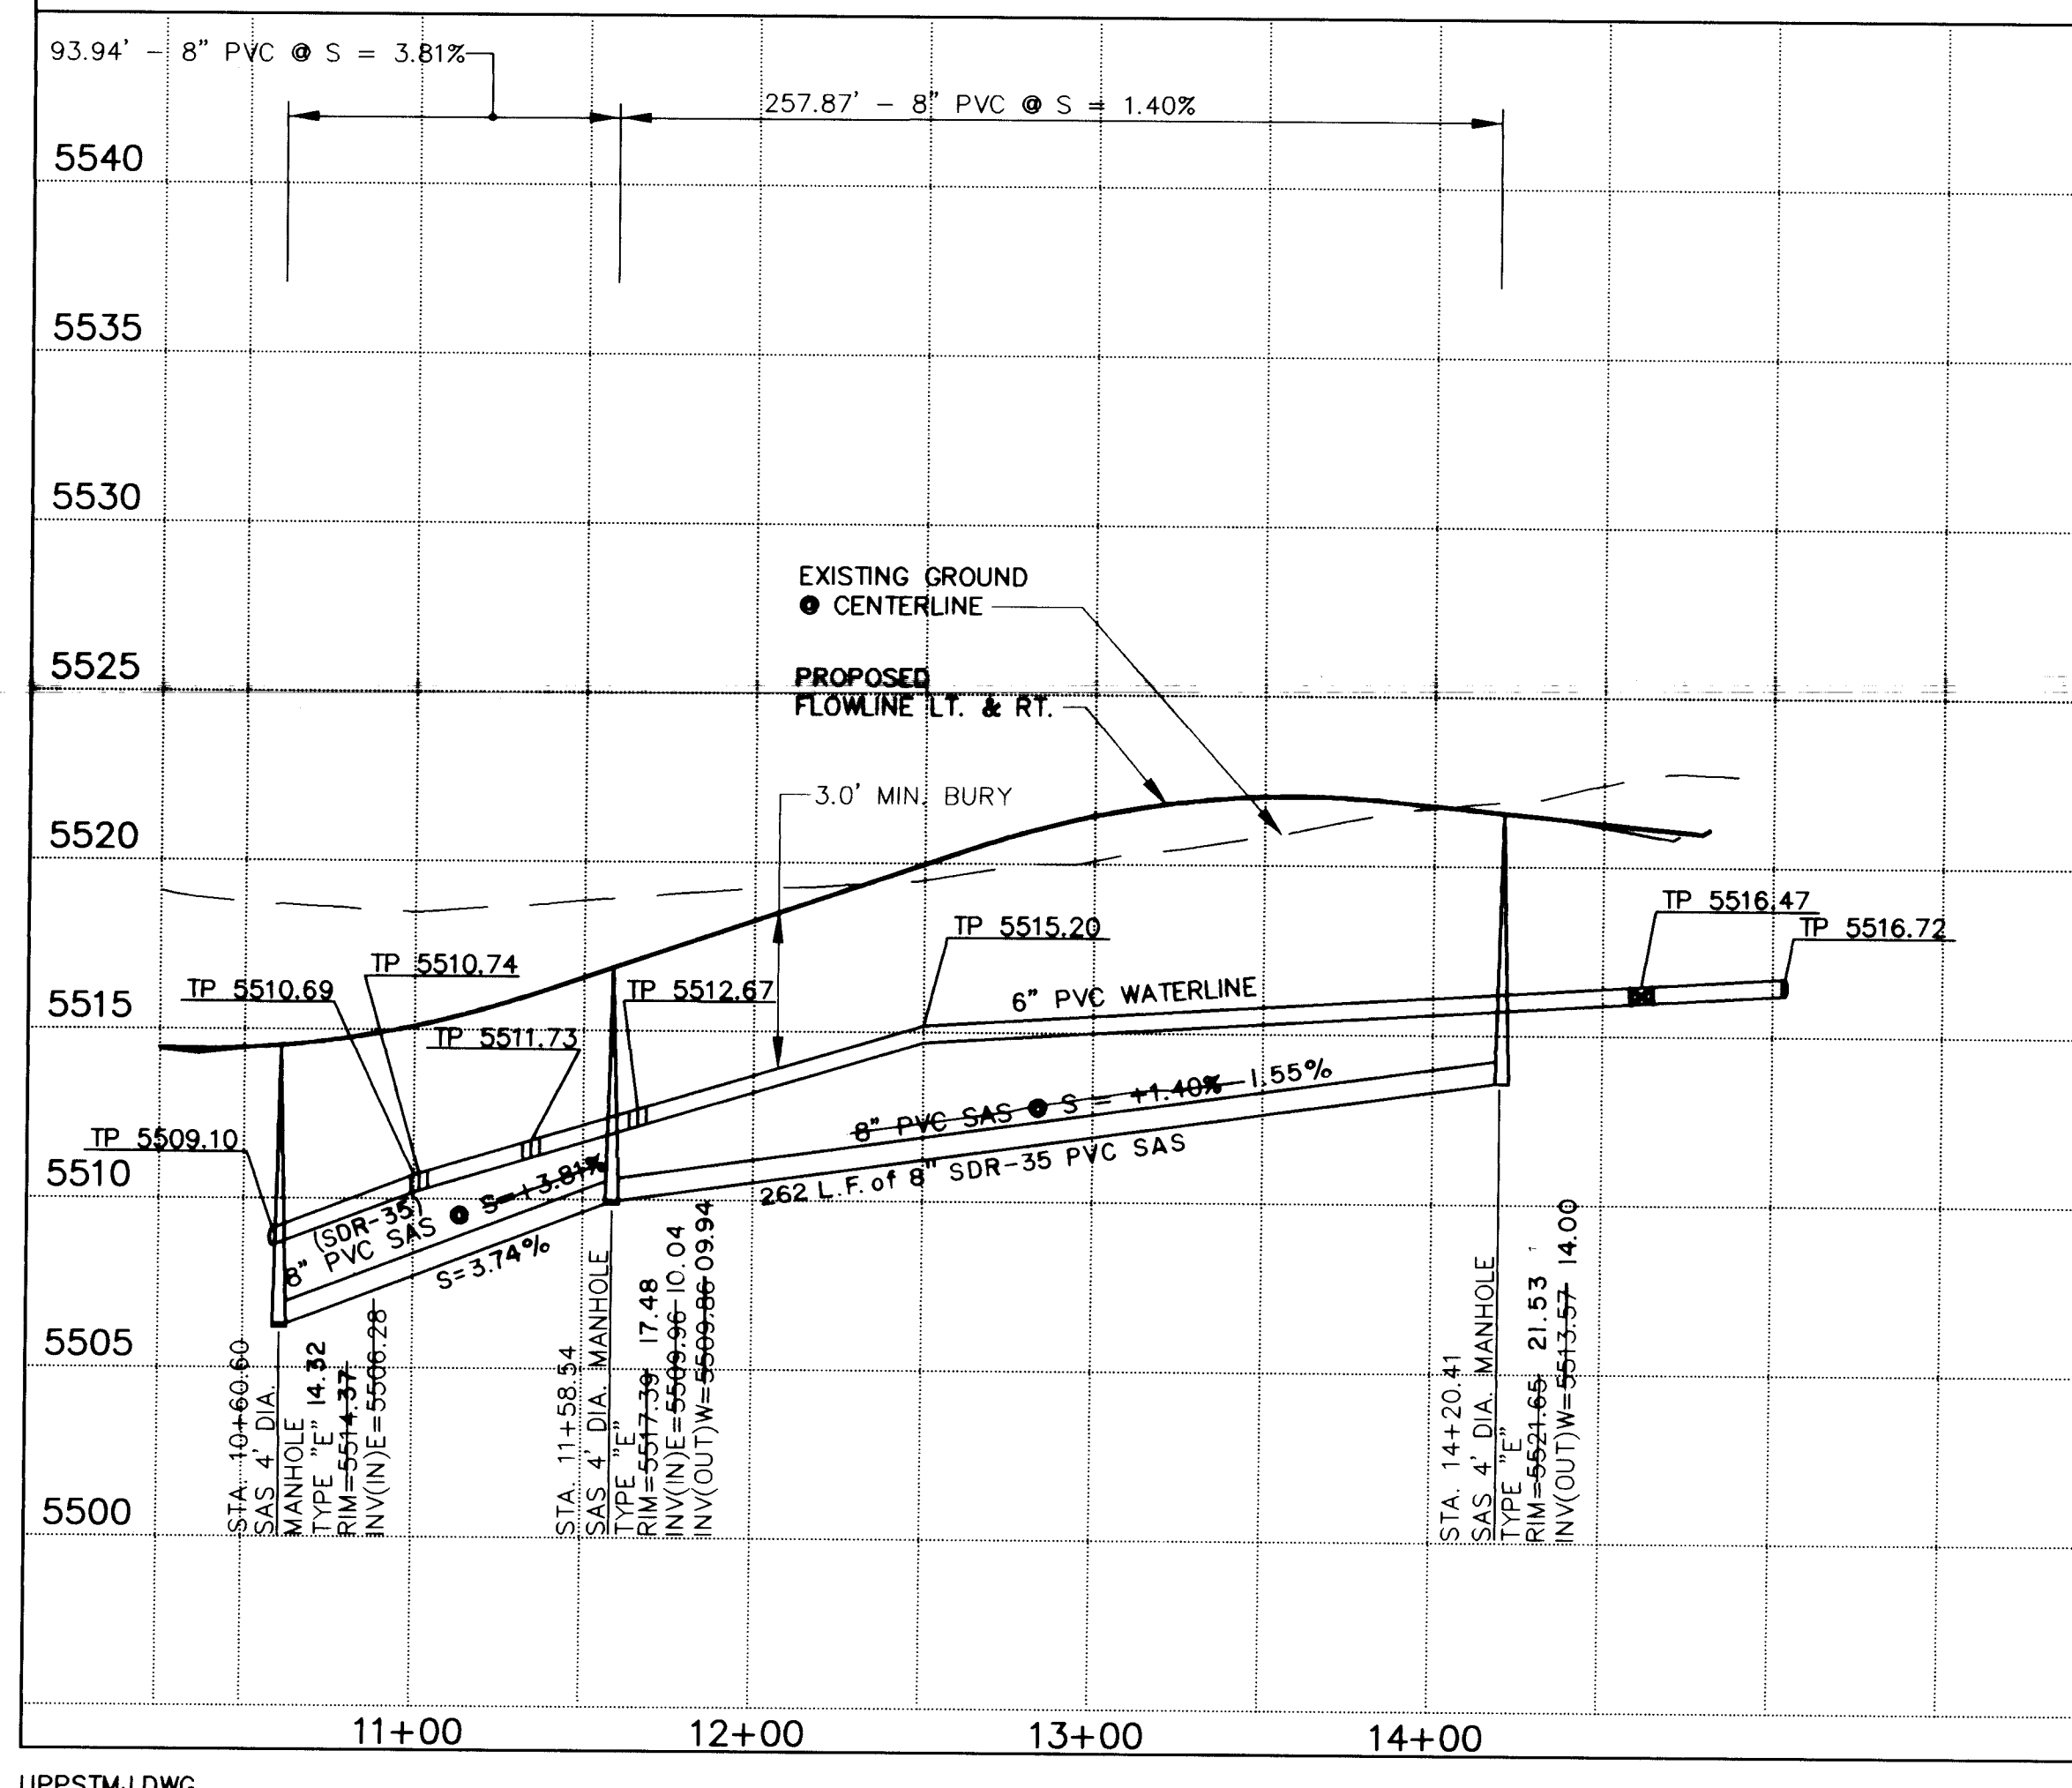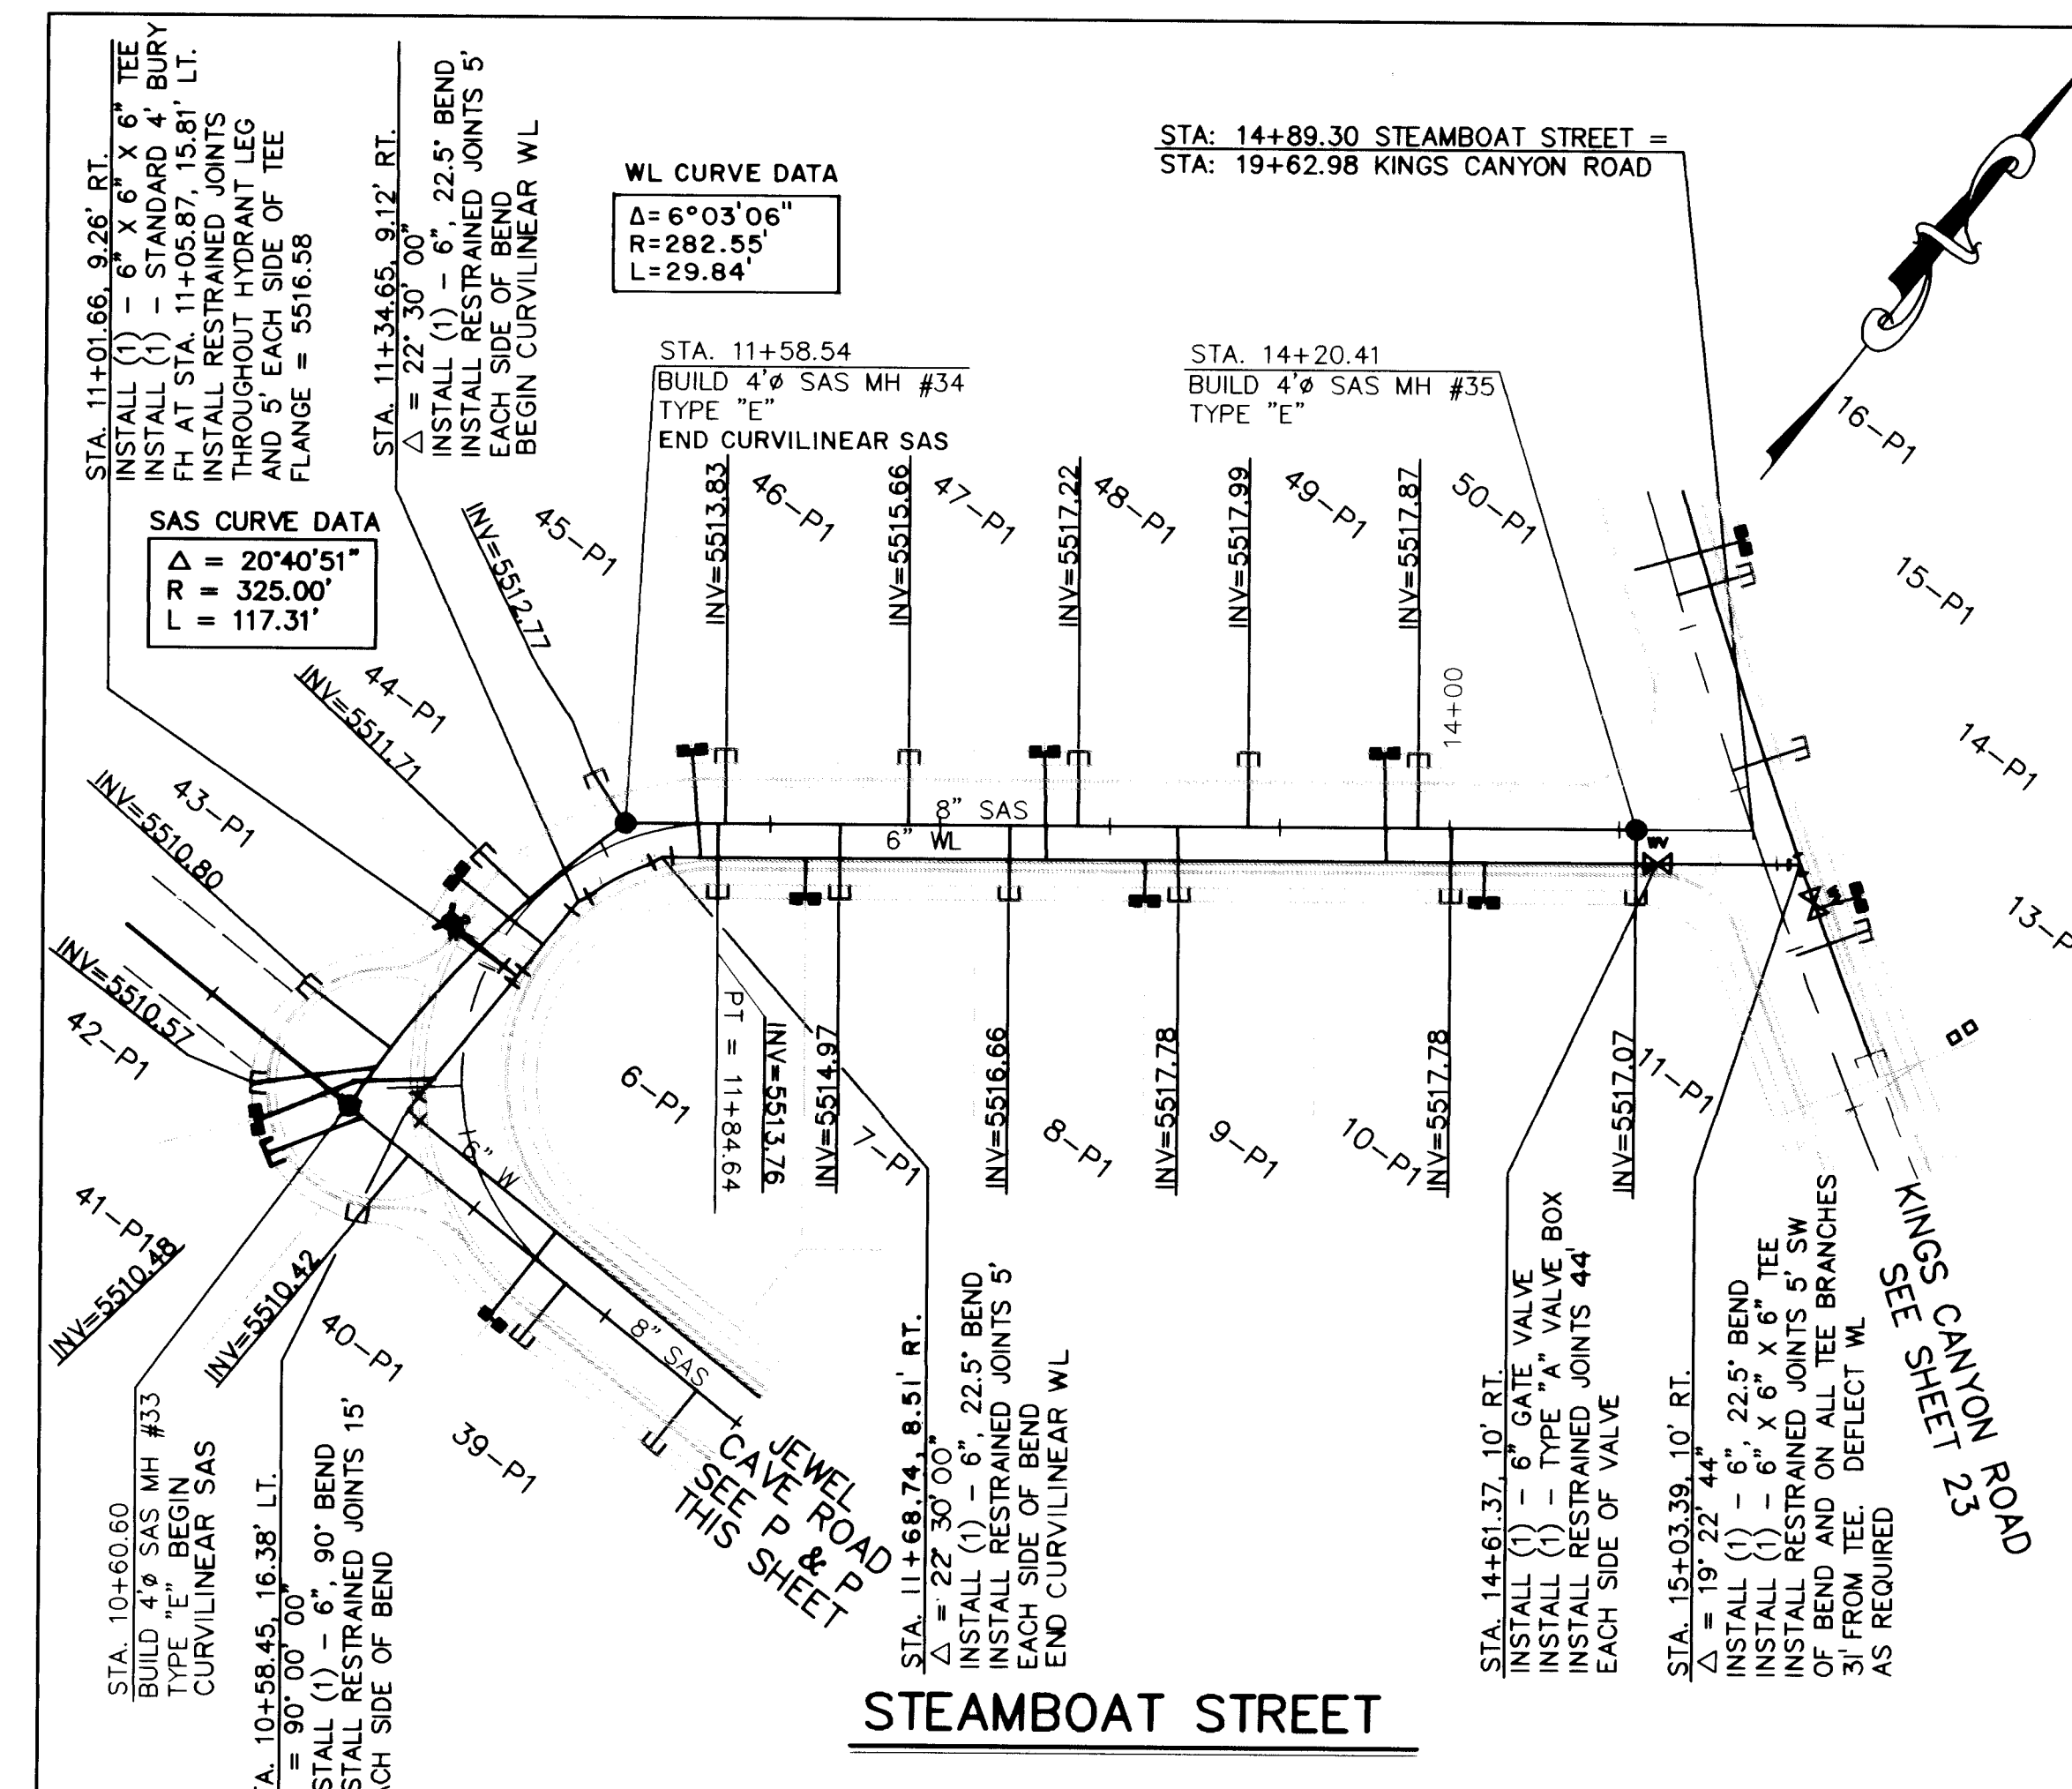

UTILITY NOTES

- STATIONING ALONG C OF STREET UNLESS OTHERWISE NOTED.
- SANITARY SEWER LINE LENGTHS COMPUTED FROM MH C TO MH C.
- SLOPES ARE COMPUTED INVERT TO INVERT. MH RIM ELEVATIONS GIVEN ARE APPROXIMATE. CONTRACTOR SHALL ADJUST ALL RIMS TO FINAL GRADE.
- CONTRACTOR IS RESPONSIBLE FOR COORDINATION WITH UTILITY COMPANIES.
- CONTRACTOR SHALL VERIFY ALL EXISTING UTILITIES AND UTILITY CONNECTIONS PRIOR TO BEGINNING CONSTRUCTION. SHOULD A CONFLICT EXIST OR DESIGN REVISIONS BE REQUIRED FOR ANY REASON, THE CONTRACTOR SHALL NOTIFY THE ENGINEER AND ALLOW SUFFICIENT TIME FOR DESIGN REVISIONS SO AS TO NOT DELAY THE CONSTRUCTION SCHEDULE.

LEGEND

---	EXISTING WATERLINE
---	EXISTING STORM DRAIN
---	EXISTING SANITARY SEWER
---	EXISTING MANHOLE
---	EXISTING FIRE HYDRANT
---	EXISTING GATE VALVE
---	PROPOSED WATERLINE
---	PROPOSED STORM DRAIN
---	PROPOSED SANITARY SEWER
---	PROPOSED MANHOLE
---	PROPOSED FIRE HYDRANT
---	PROPOSED GATE VALVE
---	PROPOSED CAP OR PLUG
---	PROPOSED SINGLE METER, WATER SERVICE LINE
---	PROPOSED DOUBLE METER, WATER SERVICE LINES
---	PROPOSED SANITARY SEWER SERVICE LINE
---	PROPOSED CROSS, TEE, OR ELBOW
---	PNM UTILITY CONDUIT

AS BUILT INFORMATION

CONTRACTOR	Staked By	DATE
INSPECTOR'S	COA	DATE
FIELD TAPE BY	EAR	DATE
VERIFICATION BY	COA	DATE
CORRECTED BY		DATE
MICRO-FILM INFORMATION		
RECORDED BY		DATE
NO.		

SURVEY INFORMATION

THE STATION MARK IS A STANDARD ACS BRASS TABLET, STAMPED "1-121 RESET 1974," LOCATED 7.8 MILES EAST OF DOWNTOWN ALBUQUERQUE, AT THE INTERSECTION OF CENTRAL AVE. AND JUAN TABO BLVD. THE STATION IS ON THE MEDIAN STRIP OF CENTRAL AVE., 81' WEST OF THE CENTERLINE OF JUAN TABO BLVD. AND FLUSH WITH THE TOP OF CURB, SLD ELEV. 5534.63	DATE	BY
NO.		

ENGINEER'S SEAL

NO.	DATE	REMARKS	BY
		DESIGN	
DESIGNED BY	DATE		
DRAWN BY	DATE		
CHECKED BY	DATE		

SCANNED BY
BY LASON

1 2 3 4 5 6 7 8 9 10 11 12 13 14 15
20-146019.193 25795


AVID ENGINEERING, INC.
Civil • Structural • Transportation
6100 Seagull St. NE - Suite 102
Albuquerque, NM 87109 - (505) 881-5357

CITY OF ALBUQUERQUE
PUBLIC WORKS DEPARTMENT
ENGINEERING GROUP

TITLE: WILLOW WOOD - UNIT IV
STEAMBOAT STREET/JEWEL CAVE ROAD
UTILITY PLAN AND PROFILE

APPROVALS	ENGINEER	DATE	APPROVALS	ENGINEER	DATE
D.R.C. Chair	<i>[Signature]</i>	7-15-94	Water	<i>[Signature]</i>	7-8-94
Transportation	<i>[Signature]</i>	7-15-94	Waste Water	<i>[Signature]</i>	7-8-94
Hydrology	<i>[Signature]</i>	7-1-94			

DRAWING NO. 4604.93 MAP NO. L-21-Z SHEET 25 OF 40

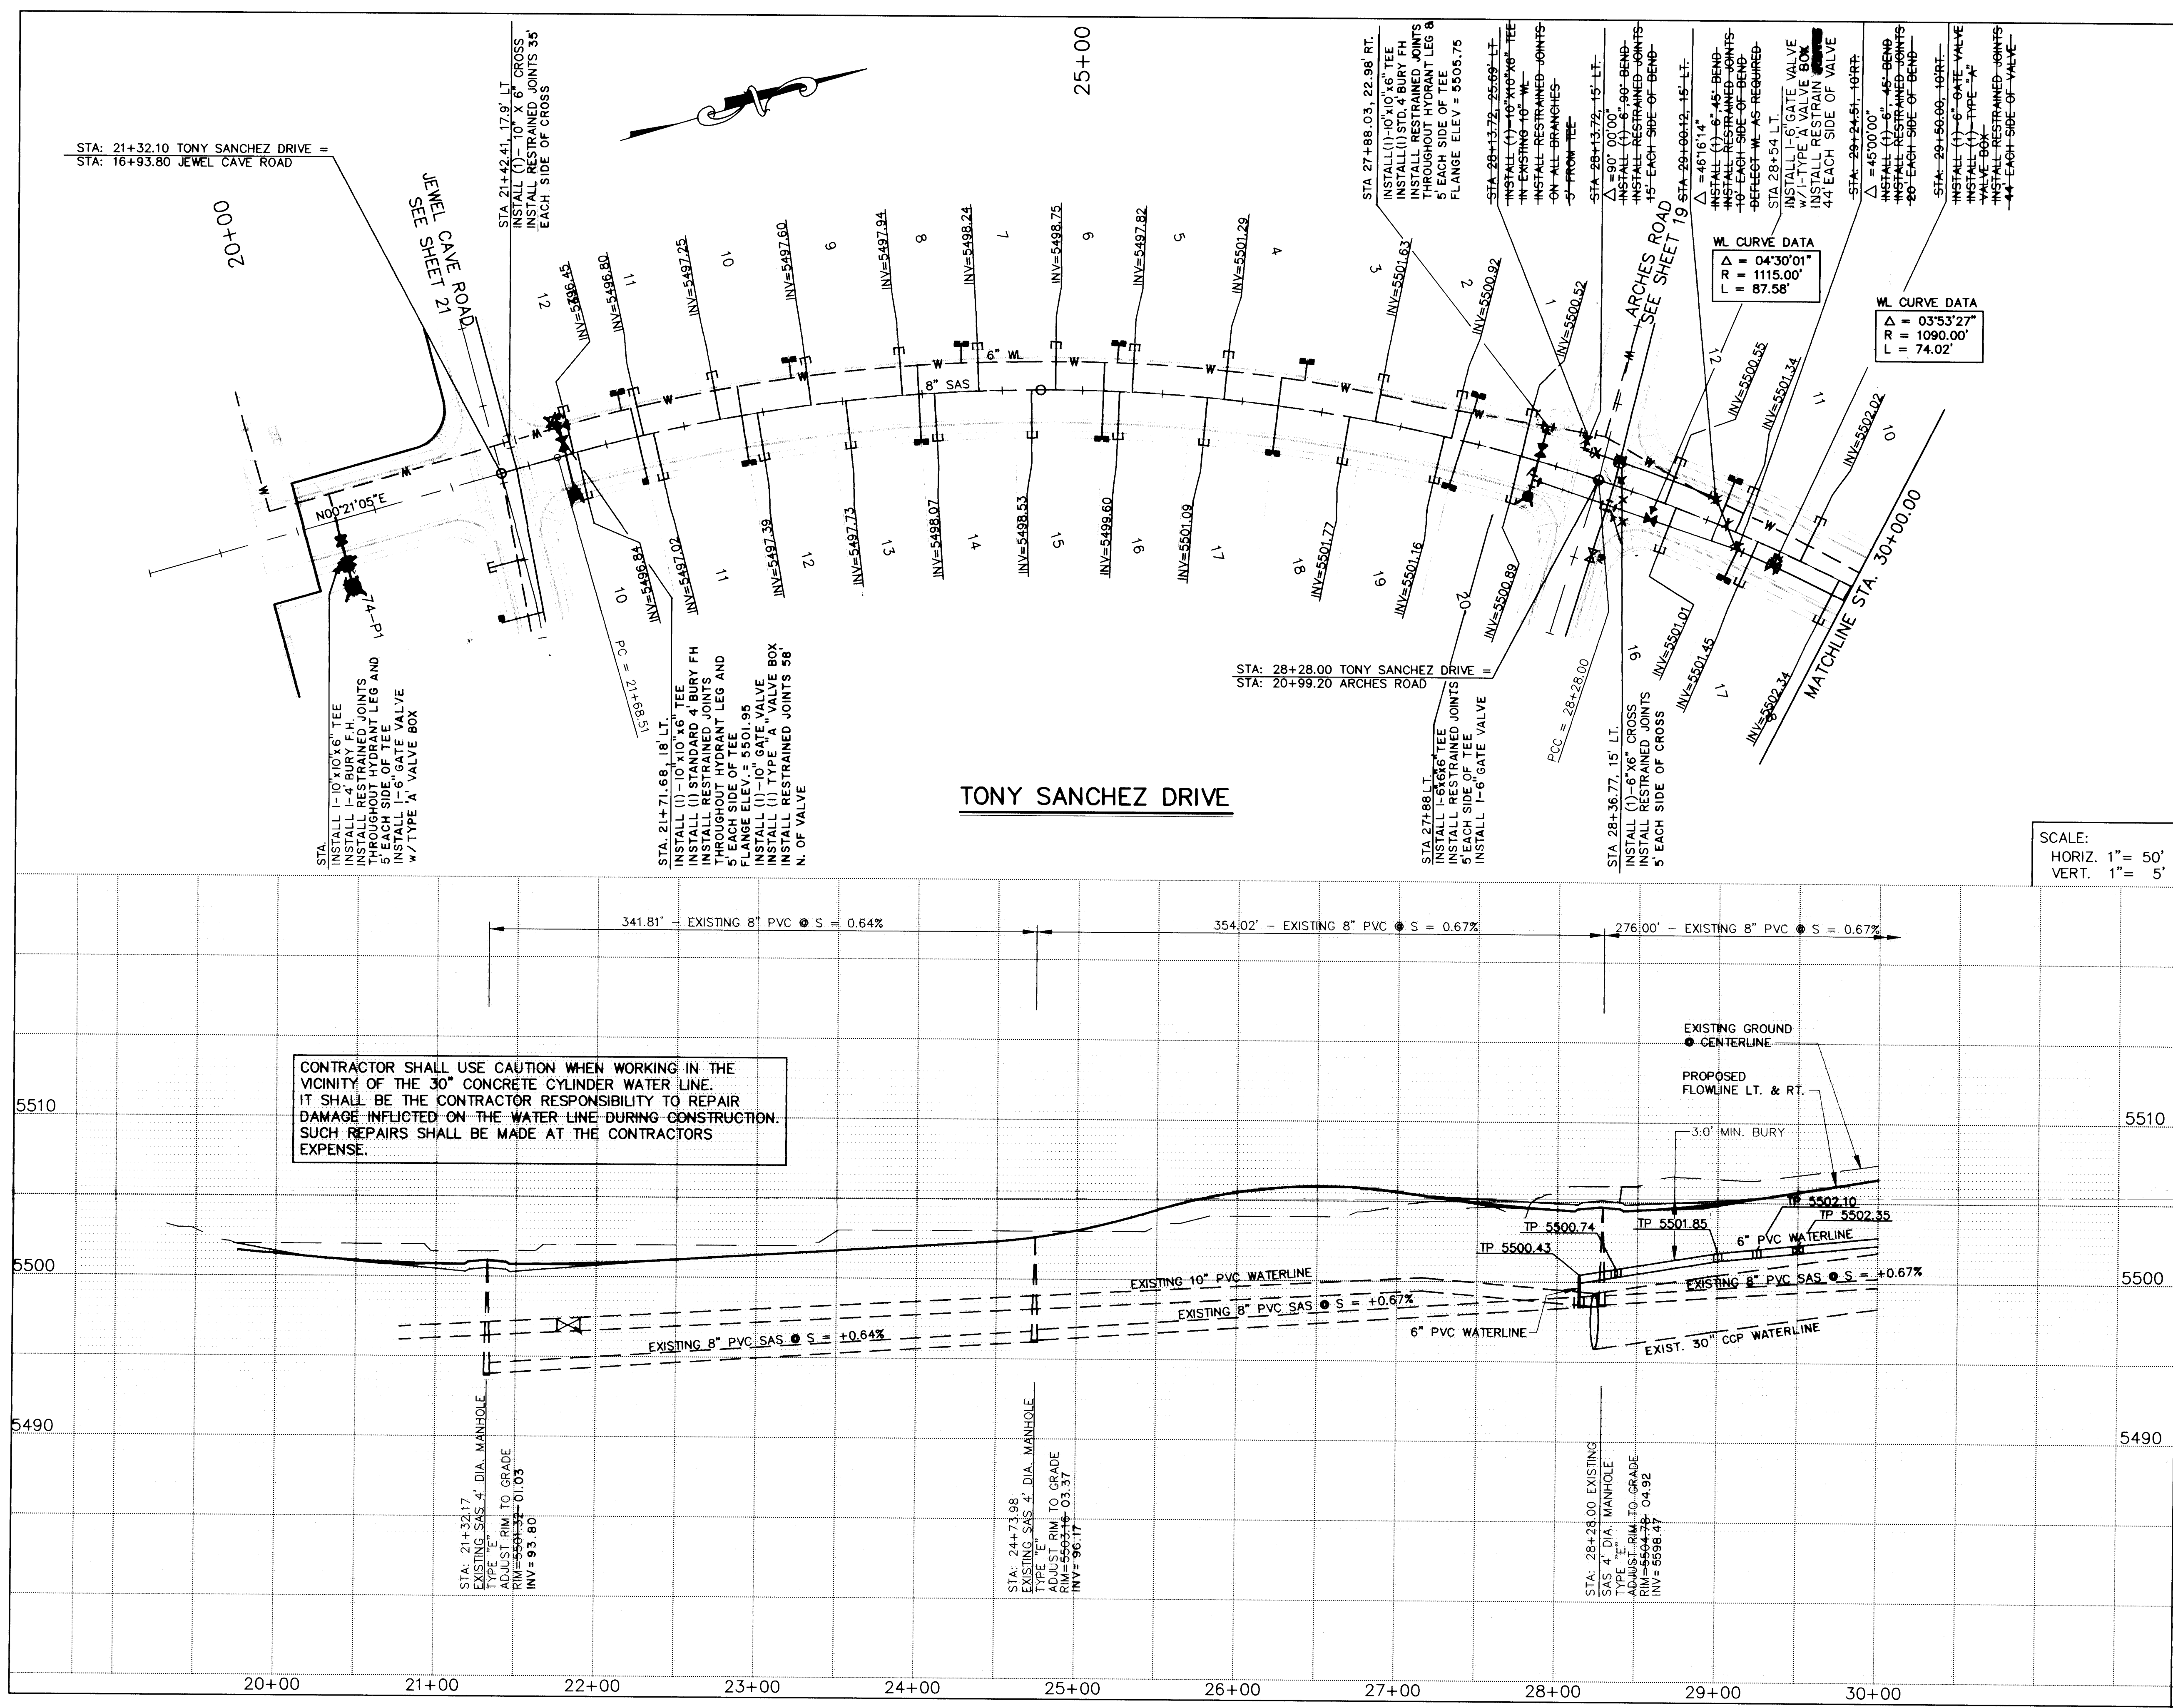

UTILITY NOTES

- STATIONING ALONG C OF STREET UNLESS OTHERWISE NOTED.
- SANITARY SEWER LINE LENGTHS COMPUTED FROM MH C TO MH C.
- SLOPES ARE COMPUTED INVERT TO INVERT. MH RIM ELEVATIONS GIVEN ARE APPROXIMATE. CONTRACTOR SHALL ADJUST ALL RIMS TO FINAL GRADE.
- CONTRACTOR IS RESPONSIBLE FOR COORDINATION WITH UTILITY COMPANIES.
- CONTRACTOR SHALL VERIFY ALL EXISTING UTILITIES AND UTILITY CONNECTIONS PRIOR TO BEGINNING CONSTRUCTION. SHOULD A CONFLICT EXIST OR DESIGN REVISIONS BE REQUIRED FOR ANY REASON, THE CONTRACTOR SHALL NOTIFY THE ENGINEER AND ALLOW SUFFICIENT TIME FOR DESIGN REVISIONS SO AS TO NOT DELAY THE CONSTRUCTION SCHEDULE.

LEGEND

---	EXISTING WATERLINE
---	EXISTING STORM DRAIN
---	EXISTING SANITARY SEWER
---	EXISTING MANHOLE
+	EXISTING FIRE HYDRANT
+	EXISTING GATE VALVE
---	PROPOSED WATERLINE
---	PROPOSED STORM DRAIN
---	PROPOSED SANITARY SEWER
+	PROPOSED MANHOLE
+	PROPOSED FIRE HYDRANT
+	PROPOSED GATE VALVE
---	PROPOSED CAP OR PLUG
---	PROPOSED SINGLE METER, WATER SERVICE LINE
---	PROPOSED DOUBLE METER, WATER SERVICE LINES
---	PROPOSED SANITARY SEWER SERVICE LINE
+	PROPOSED CROSS, TEE, OR ELBOW
---	PNM UTILITY CONDUIT

AS BUILT INFORMATION

CONTRACTOR	DATE
New Concepts Inc. <td></td>	

BENCH MARKS

THE STATION MARK IS A STANDARD ACS BRASS TABLET, STAMPED "1-121 RESET 1974," LOCATED 7.8 MILES EAST OF DOWNTOWN ALBUQUERQUE, AT THE INTERSECTION OF CENTRAL AVE. AND JUAN TABO BLVD. THE STATION IS ON THE MEDIAN STRIP OF CENTRAL AVE., 81' WEST OF THE CENTERLINE OF JUAN TABO BLVD. AND FLUSH WITH THE TOP OF CURB. SLD ELEV. 5534.63

SURVEY INFORMATION

NO.	DATE	BY

ENGINEER'S SEAL

Professional Engineer Seal for AVID Engineering, Inc.

REMARKS

NO.	DATE	BY

DESIGN


DESIGNED BY: ETS	DATE: 5/94
DRAWN BY: JVD	DATE: 5/94
CHECKED BY: JVD	DATE: 5/94

CITY OF ALBUQUERQUE PUBLIC WORKS DEPARTMENT ENGINEERING GROUP

TITLE: WILLOW WOOD - UNIT IV TONY SANCHEZ DRIVE UTILITY PLAN AND PROFILE


APPROVALS	ENGINEER	DATE	APPROVALS	ENGINEER	DATE
D.R.C. Chair	<i>[Signature]</i>	7-15-94	Water	<i>[Signature]</i>	7-8-94
Transportation	<i>[Signature]</i>	7-01-94	Waste Water	<i>[Signature]</i>	7-8-94
Hydrology	<i>[Signature]</i>	7-7-94			

DRAWING NO.	4604.93	MAP NO.	L-21-Z	SHEET	26	OF	40
-------------	---------	---------	--------	-------	----	----	----

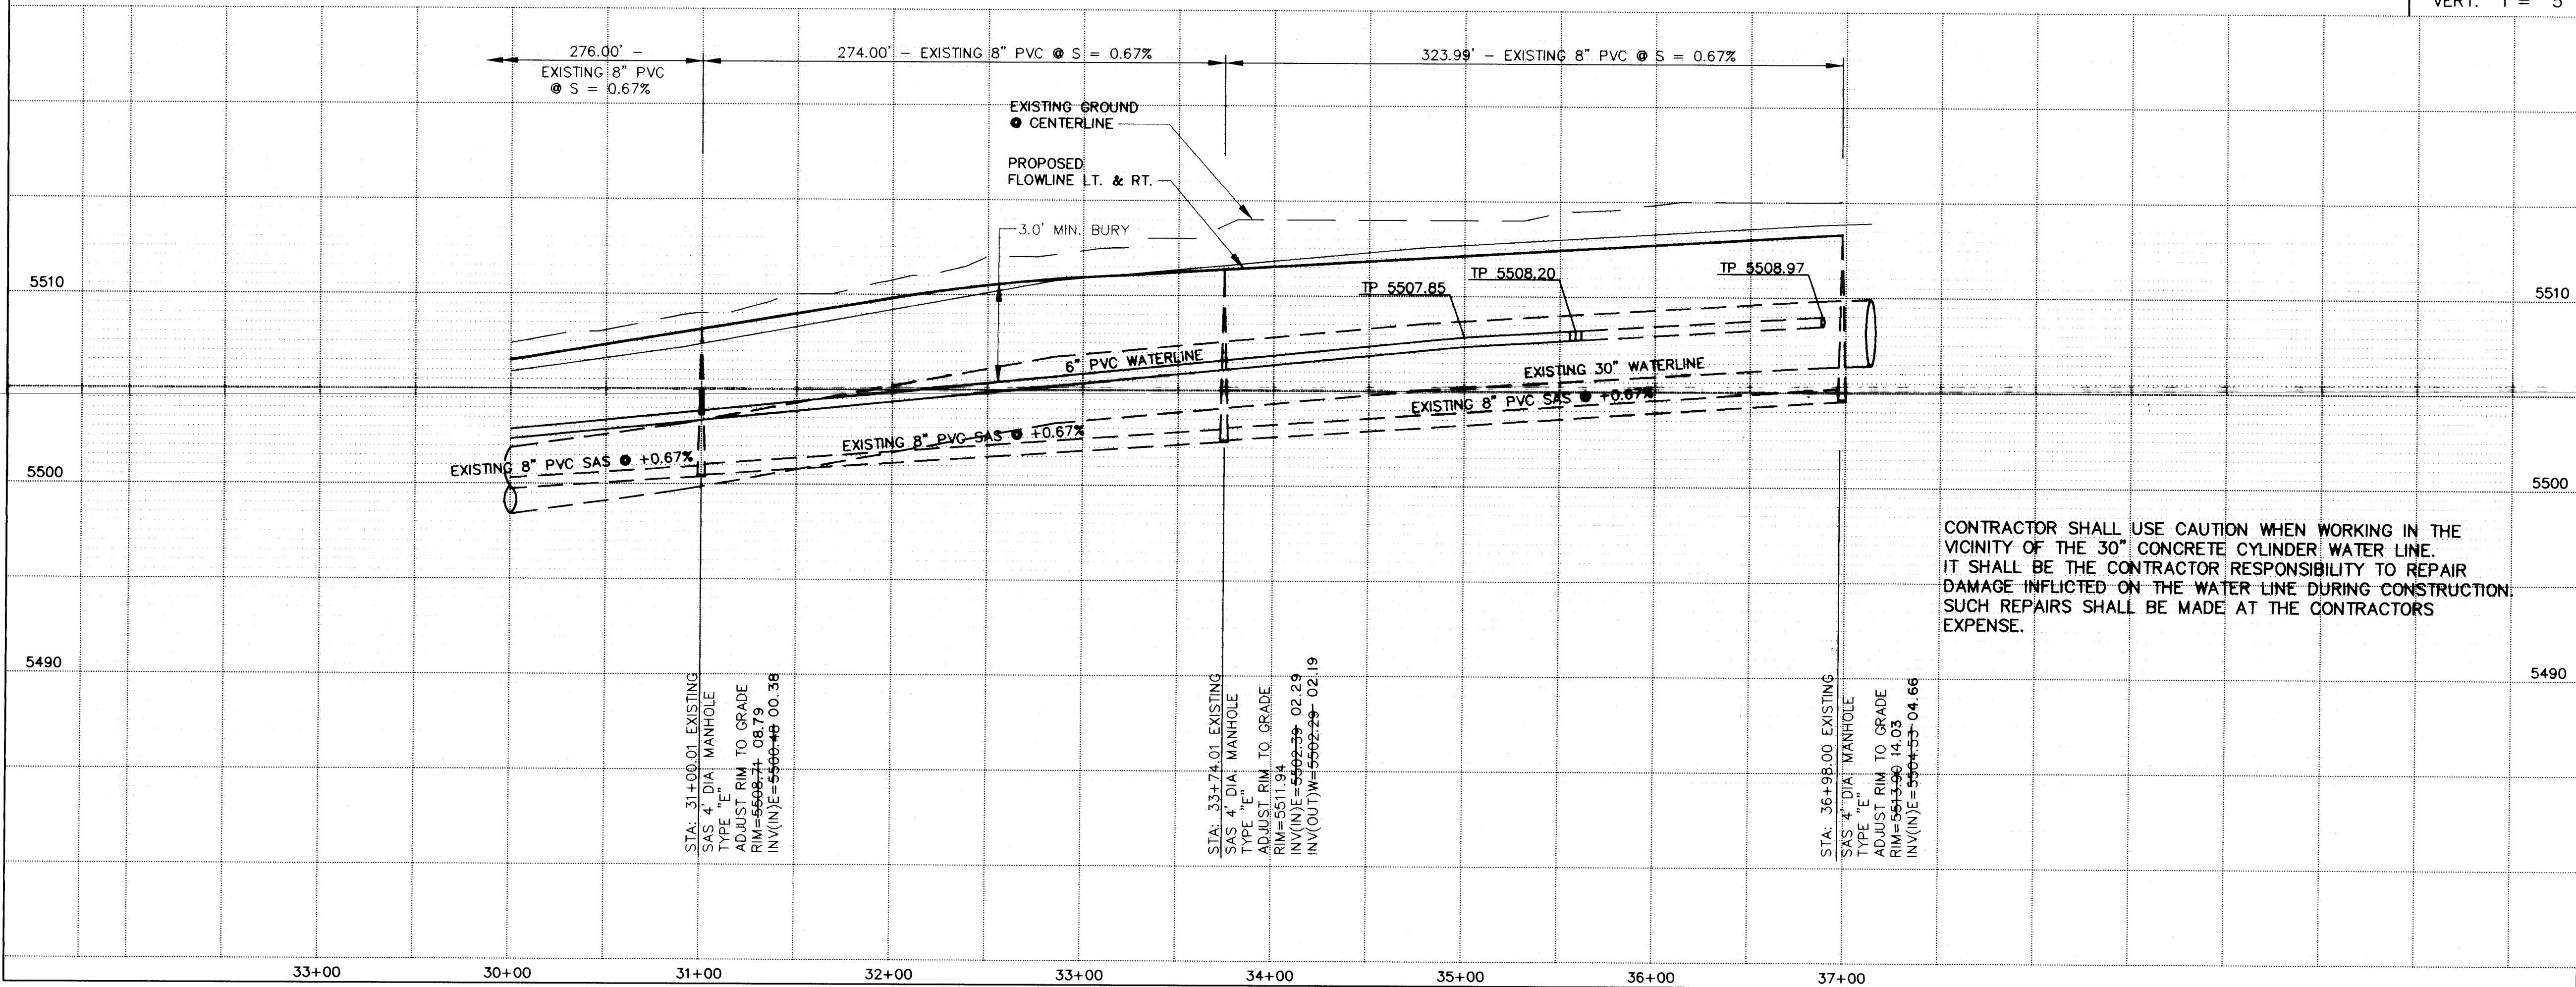

30+00

WL CURVE DATA
Δ = 16°36'14"
R = 1090.00'
L = 315.87'

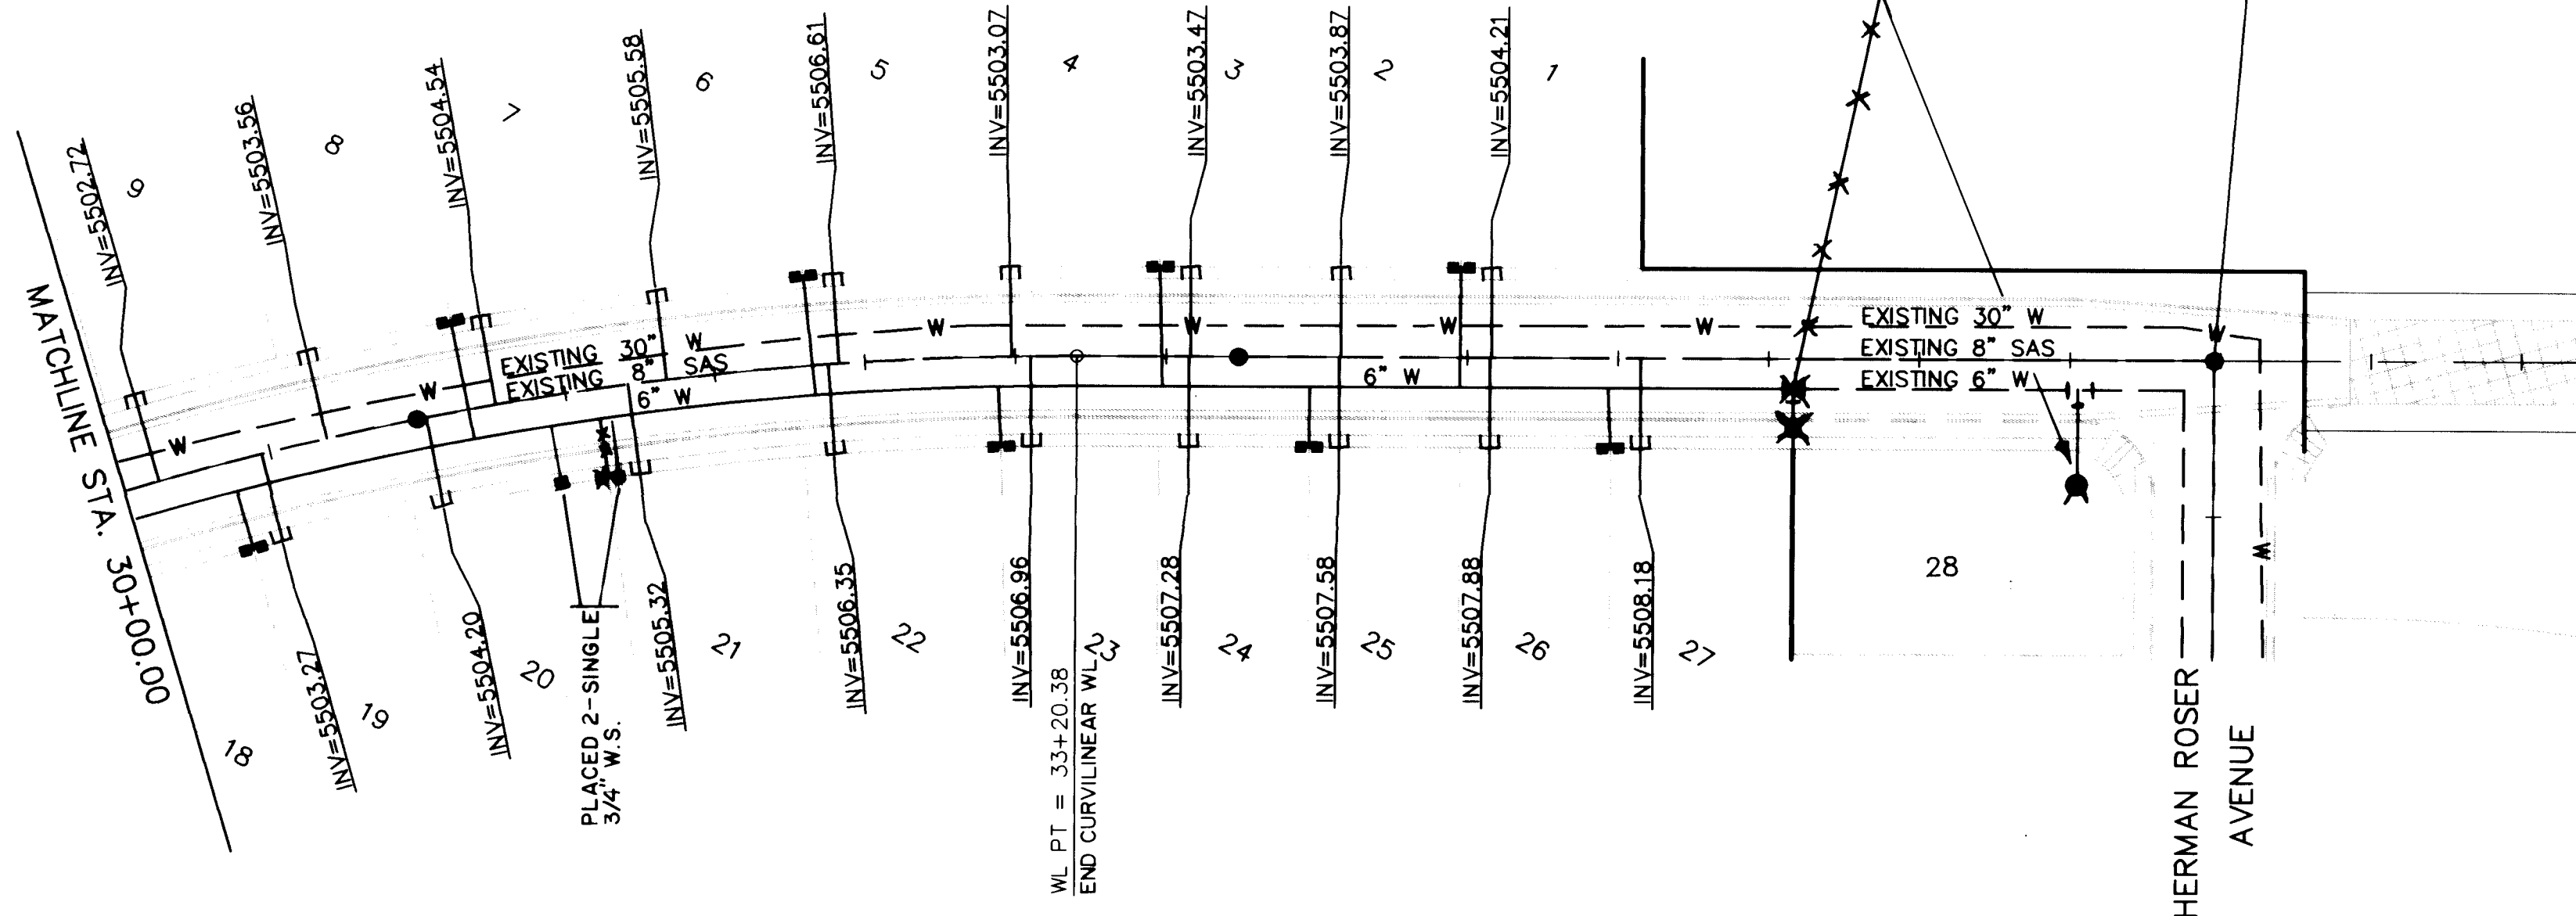

TONY SANCHEZ DRIVE

SCALE:
HORIZ. 1" = 50'
VERT. 1" = 5'

UTILITY NOTES

- 1.) STATIONING ALONG C. OF STREET UNLESS OTHERWISE NOTED.
- 2.) SANITARY SEWER LINE LENGTHS COMPUTED FROM MH C. TO MH C.
- 3.) SLOPES ARE COMPUTED INVERT TO INVERT. MH RIM ELEVATIONS GIVEN ARE APPROXIMATE. CONTRACTOR SHALL ADJUST ALL RIMS TO FINAL GRADE.
- 4.) CONTRACTOR IS RESPONSIBLE FOR COORDINATION WITH UTILITY COMPANIES.
- 5.) CONTRACTOR SHALL VERIFY ALL EXISTING UTILITIES AND UTILITY CONNECTIONS PRIOR TO BEGINNING CONSTRUCTION. SHOULD A CONFLICT EXIST OR DESIGN REVISIONS BE REQUIRED FOR ANY REASON, THE CONTRACTOR SHALL NOTIFY THE ENGINEER AND ALLOW SUFFICIENT TIME FOR DESIGN REVISIONS SO AS TO NOT DELAY THE CONSTRUCTION SCHEDULE.

LEGEND

- W — EXISTING WATERLINE
- SAS — EXISTING SANITARY SEWER
- — EXISTING STORM DRAIN
- — EXISTING MANHOLE
- — EXISTING FIRE HYDRANT
- — EXISTING GATE VALVE
- W — PROPOSED WATERLINE
- SD — PROPOSED STORM DRAIN
- SAS — PROPOSED SANITARY SEWER
- — PROPOSED MANHOLE
- — PROPOSED FIRE HYDRANT
- — PROPOSED GATE VALVE
- — PROPOSED CAP OR PLUG
- — PROPOSED SINGLE METER, WATER SERVICE LINE
- — PROPOSED DOUBLE METER, WATER SERVICE LINES
- — PROPOSED SANITARY SEWER SERVICE LINE
- — PROPOSED CROSS, TEE, OR ELBOW
- — PNM UTILITY CONDUIT

SCANNED BY
BY LABON

1 2 3 4 5 6 7 8 9 10 11 12 13 14 15
24-14604.93 2795

AVID ENGINEERING, INC.
Civil • Structural • Transportation
6100 Saegull St. NE Suite 102
Albuquerque, NM 87109 • (505) 881-5357

CITY OF ALBUQUERQUE
PUBLIC WORKS DEPARTMENT
ENGINEERING GROUP

TITLE: WILLOW WOOD - UNIT IV
TONY SANCHEZ ROAD
UTILITY PLAN AND PROFILE

APPROVALS	ENGINEER	DATE	APPROVALS	ENGINEER	DATE
D.R.C. Chair	R.W. Kana	7-15-94	Water	R.W. Kana	7-15-94
Transportation	NA	7-01-94	Waste Water	R.W. Kana	7-15-94
Hydrology	NA	7-1-94			

DRAWING NO.	MAP NO.	SHEET	OF
4604.93	L-21-Z	27	40


AS BUILT INFORMATION			
CONTRACTOR	NEW CONCEPTS INC.	WORK STAGED BY	COA
DATE		INSPECTED BY	EAR
DATE		FIELD CORRECTION BY	COA
DATE		REVISION BY	COA
DATE		RECORDED BY	
NO.			

BENCH MARKS			
THE STATION MARK IS A STANDARD ACS BRASS TABLET, STAMPED "1-L21 RESET 1974," LOCATED 7.8 MILES EAST OF DOWNTOWN ALBUQUERQUE, AT THE INTERSECTION OF CENTRAL AVE. AND JUAN TABO BLVD. THE STATION IS ON THE MEDIAN STRIP OF CENTRAL AVE., 81' WEST OF THE CENTERLINE OF JUAN TABO BLVD. AND FLUSH WITH THE TOP OF CURB. SLD ELEV. 5534.63			


SURVEY INFORMATION			
FIELD NOTES	DATE	BY	
NO.			

ENGINEER'S SEAL			

REMARKS			
NO.	DATE	BY	
DESIGNED BY: ETS	DATE: 5/94		
DRAWN BY:	DATE: 5/94		
CHECKED BY: JVO	DATE: 5/94		

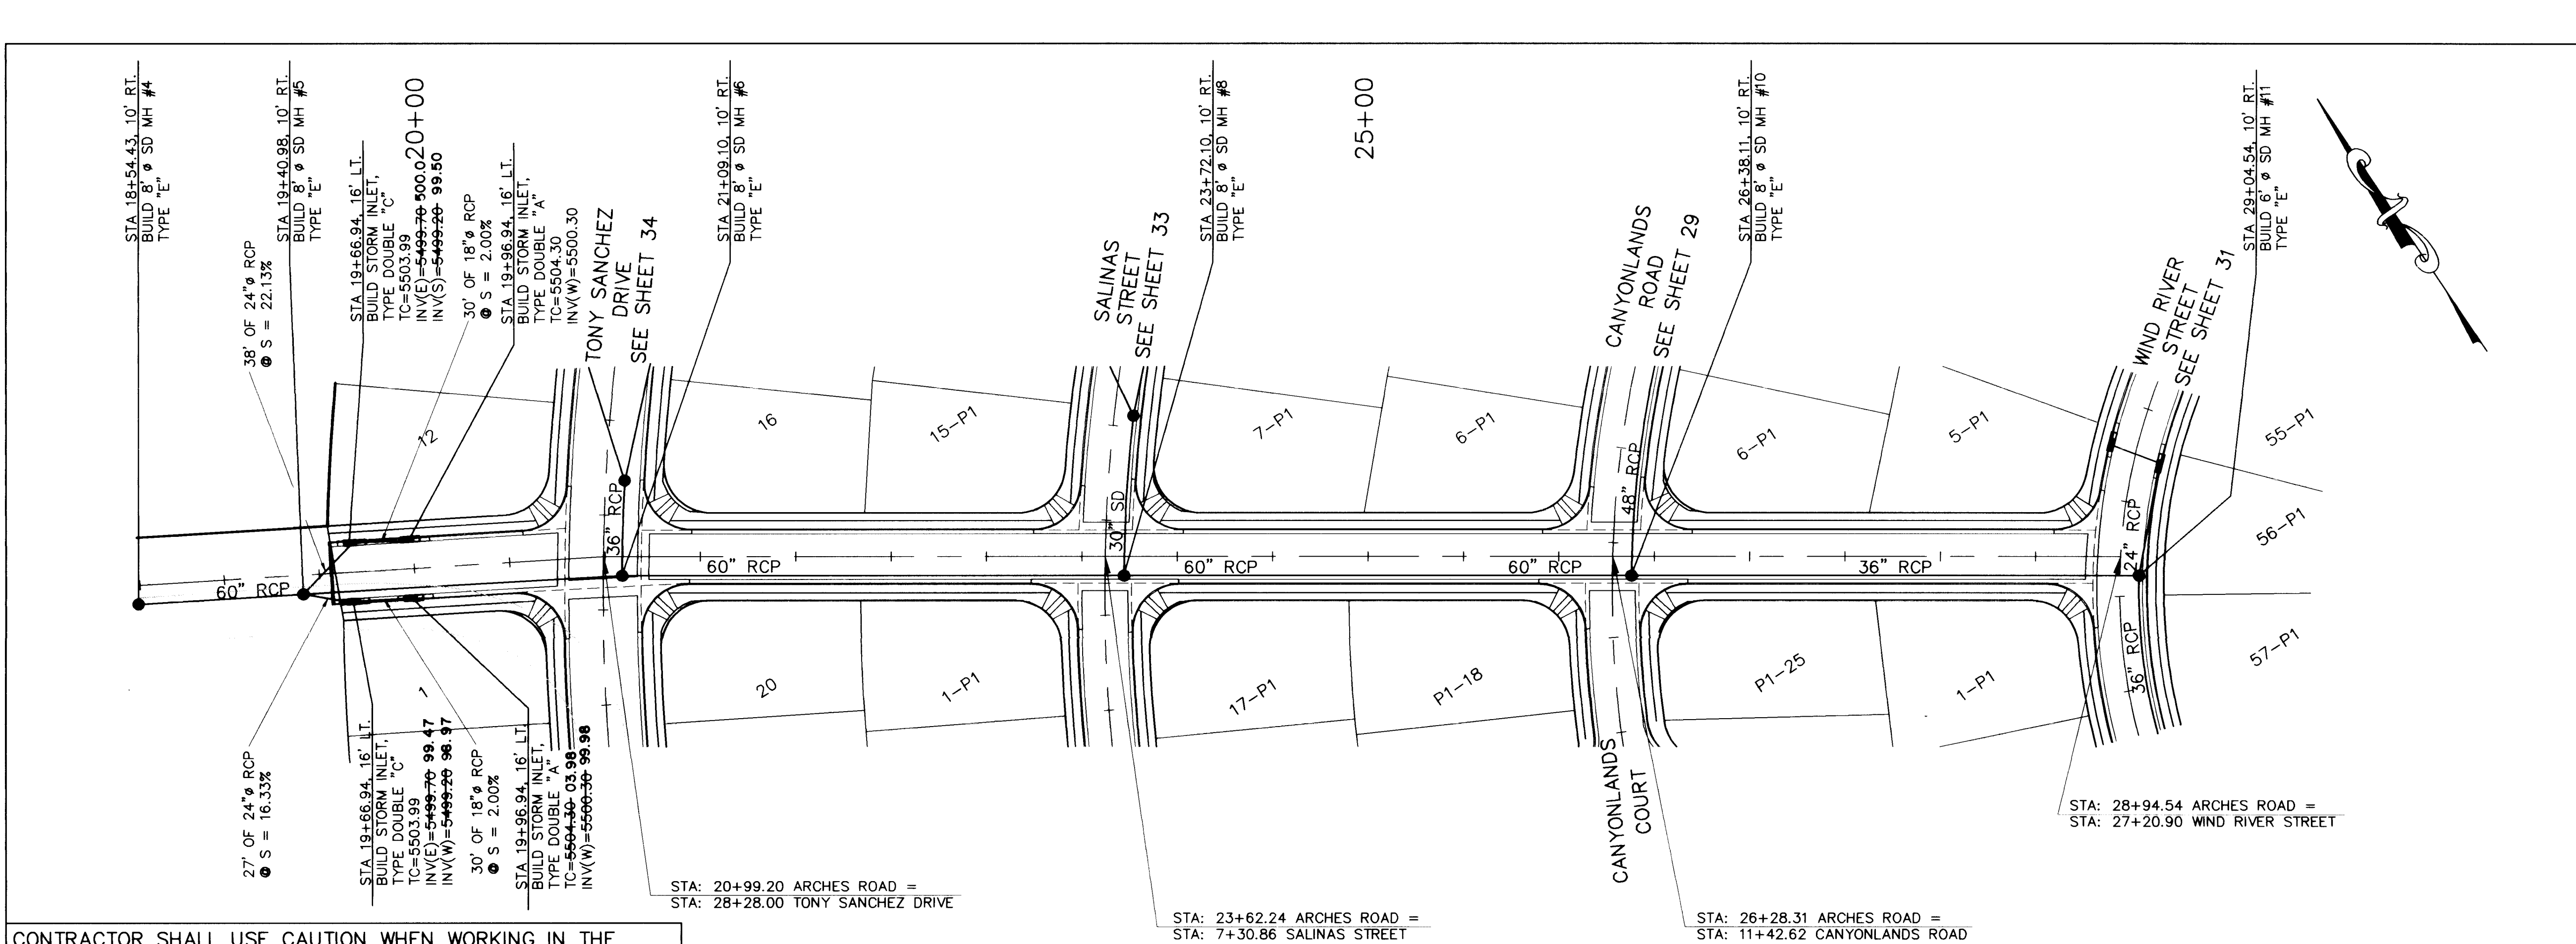

CONTRACTOR SHALL USE CAUTION WHEN WORKING IN THE VICINITY OF THE 30" CONCRETE CYLINDER WATER LINE. IT SHALL BE THE CONTRACTOR'S RESPONSIBILITY TO REPAIR DAMAGE INFLECTED ON THE WATER LINE DURING CONSTRUCTION. SUCH REPAIRS SHALL BE MADE AT THE CONTRACTOR'S EXPENSE.

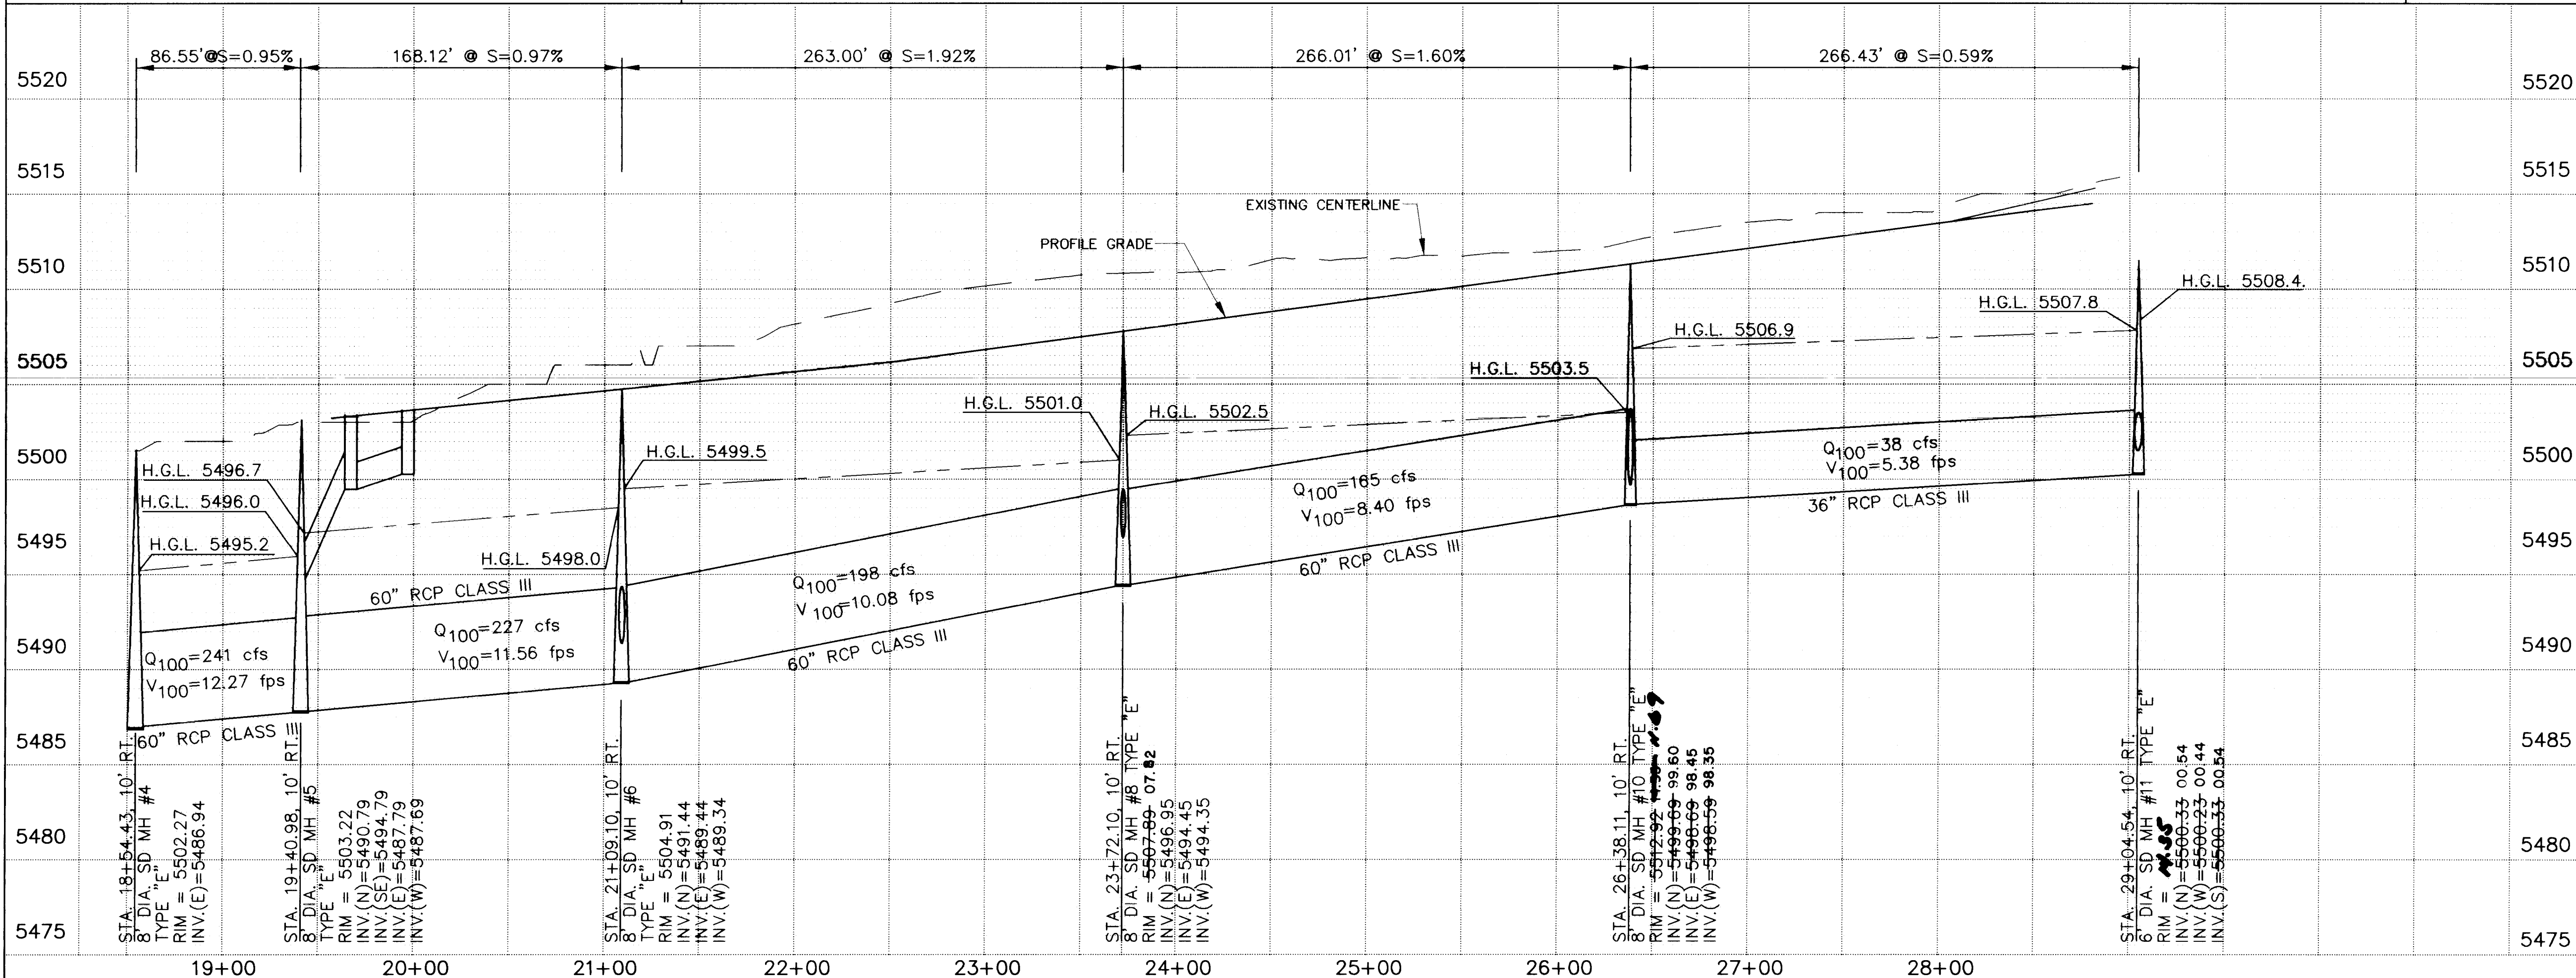

STORM DRAIN NOTES

- 1.) STATIONING ALONG C. OF STREET UNLESS OTHERWISE NOTED.
- 2.) STORM SEWER LINE LENGTHS COMPUTED FROM MH C. TO MH C.
- 3.) SLOPES ARE COMPUTED INVERT TO INVERT. MH RIM ELEVATIONS GIVEN ARE APPROXIMATE. CONTRACTOR SHALL ADJUST ALL RIMS TO FINAL GRADE.
- 4.) CONTRACTOR IS RESPONSIBLE FOR COORDINATION WITH UTILITY COMPANIES.
- 5.) CONTRACTOR SHALL VERIFY ALL EXISTING UTILITIES AND UTILITY CONNECTIONS PRIOR TO BEGINNING CONSTRUCTION. SHOULD A CONFLICT EXIST OR DESIGN REVISIONS BE REQUIRED FOR ANY REASON, THE CONTRACTOR SHALL NOTIFY THE ENGINEER AND ALLOW SUFFICIENT TIME FOR DESIGN REVISIONS SO AS TO NOT DELAY THE CONSTRUCTION SCHEDULE.
- 6.) INLET INVERTS AND CONNECTOR PIPE SLOPES AND LENGTHS ARE COMPUTED FROM STA./OFFSET TO STA./OFFSET SHOWN ON PLANS.

TYPICAL INLET LOCATION DETAIL

LEGEND

- SD PROPOSED STORM DRAIN
- PROPOSED MANHOLE
- ▬ PROPOSED TYPE DOUBLE "A" STORM INLET
- ▬ PROPOSED TYPE DOUBLE "C" STORM INLET

AS BUILT INFORMATION

CONTRACTOR	WORK	DATE
New Concepts Inc. <td>STAMPED "1-L21 RESET 1974," LOCATED 7.8 MILES EAST OF DOWNTOWN ALBUQUERQUE, AT THE INTERSECTION OF CENTRAL AVE. AND JUAN TABO BLVD. THE STATION IS ON THE MEDIAN STRIP OF CENTRAL AVE., 81' WEST OF THE CENTERLINE OF JUAN TABO BLVD. AND FLUSH WITH THE TOP OF CURB. SLD ELEV 5534.63</td> <td></td>	STAMPED "1-L21 RESET 1974," LOCATED 7.8 MILES EAST OF DOWNTOWN ALBUQUERQUE, AT THE INTERSECTION OF CENTRAL AVE. AND JUAN TABO BLVD. THE STATION IS ON THE MEDIAN STRIP OF CENTRAL AVE., 81' WEST OF THE CENTERLINE OF JUAN TABO BLVD. AND FLUSH WITH THE TOP OF CURB. SLD ELEV 5534.63	

SURVEY INFORMATION

DATE	BY

ENGINEER'S SEAL


APPROVALS

APPROVALS	ENGINEER	DATE	APPROVALS	ENGINEER	DATE
D.R.C. Chair	84.6.6.6	7-1-94	Water	N/A RWK 7-8-94	
Transportation	N/A RWK	7-1-94	Waste Water	N/A RWK 7-8-94	
Hydrology	7-1-94				

CITY OF ALBUQUERQUE PUBLIC WORKS DEPARTMENT ENGINEERING GROUP


TITLE: WILLOW WOOD - UNIT IV
ARCHES ROAD
STORM DRAIN PLAN & PROFILE

DRAWING NO.	4604.93	MAP NO.	L-21-Z	SHEET	28	OF	40
-------------	---------	---------	--------	-------	----	----	----

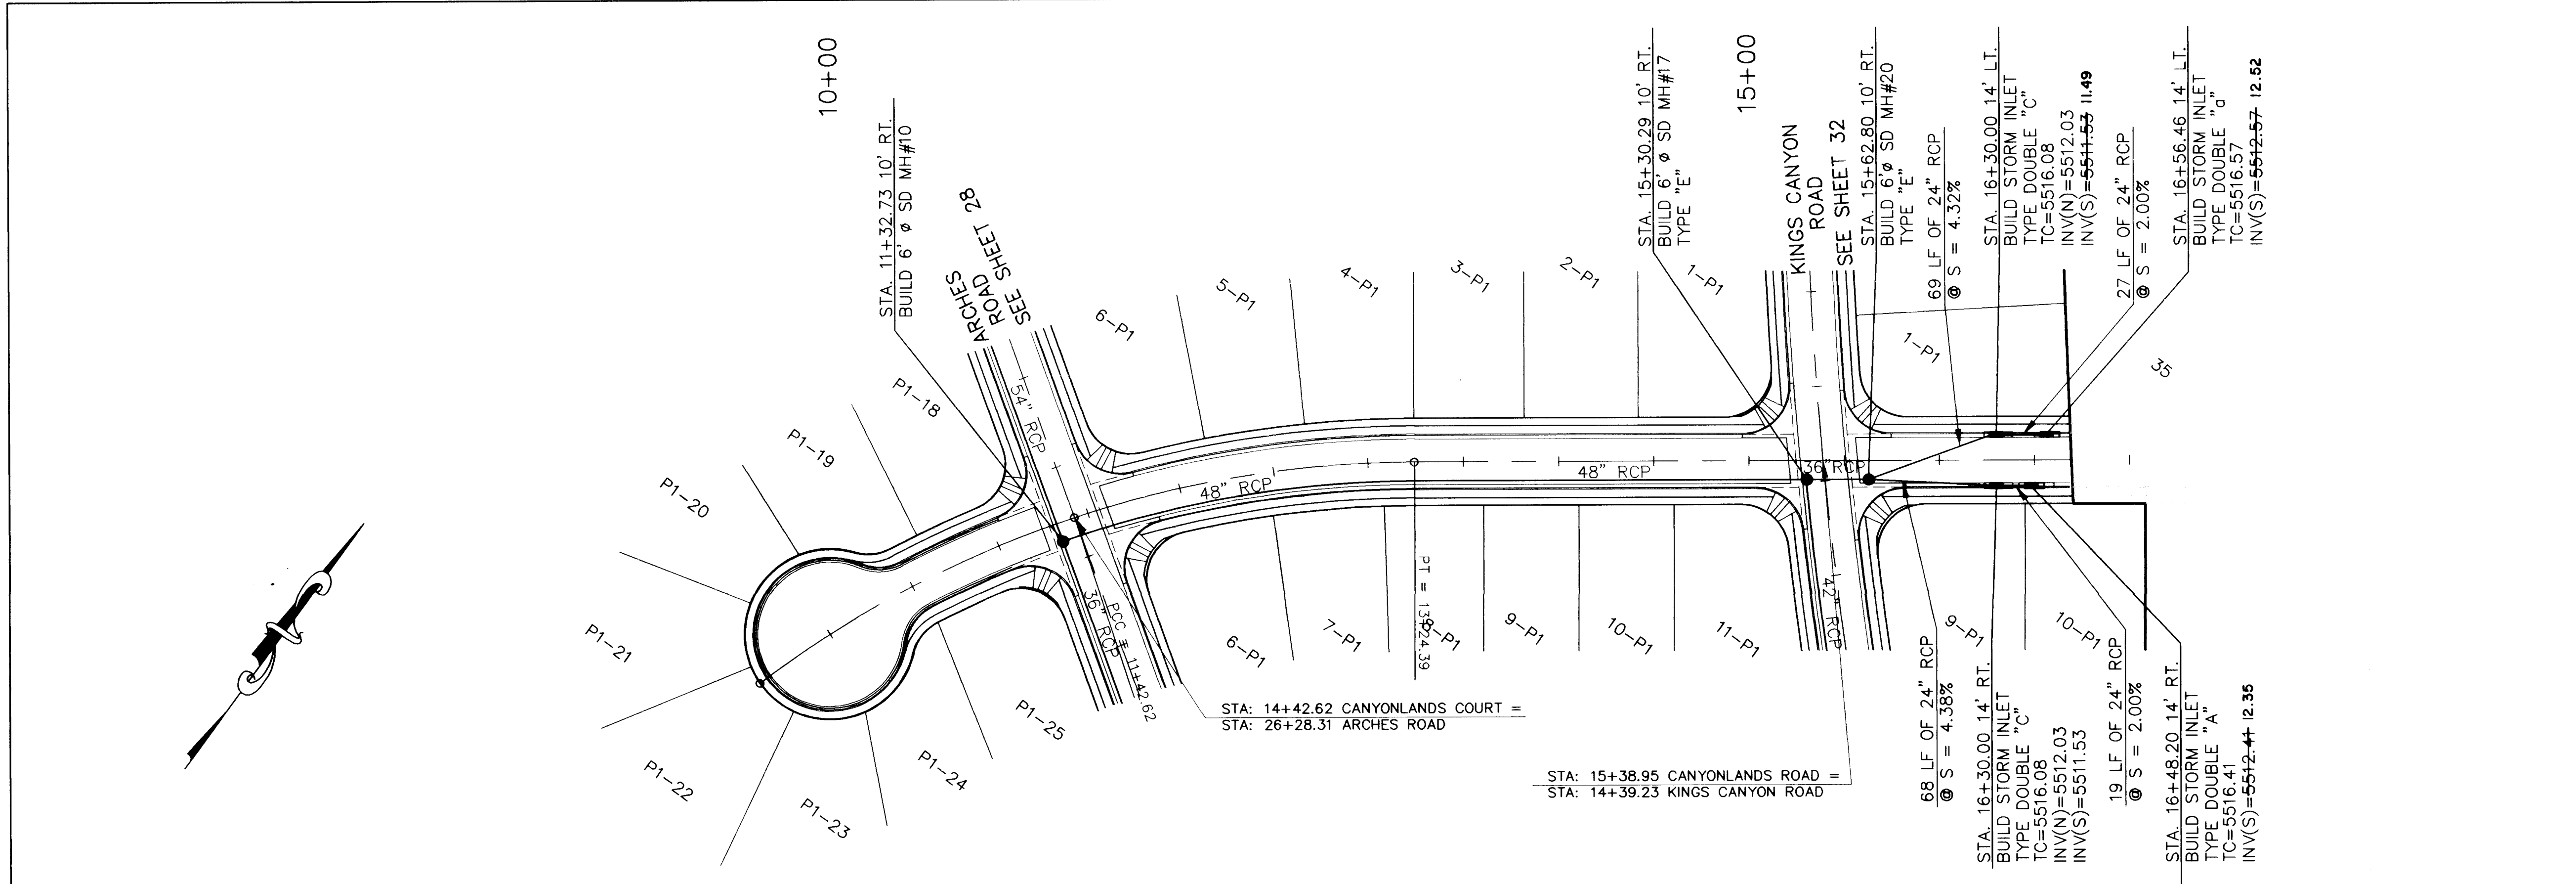


CANYONLANDS COURT & CANYONLANDS ROAD

SCALE:
HORIZ. 1" = 50'
VERT. 1" = 5'

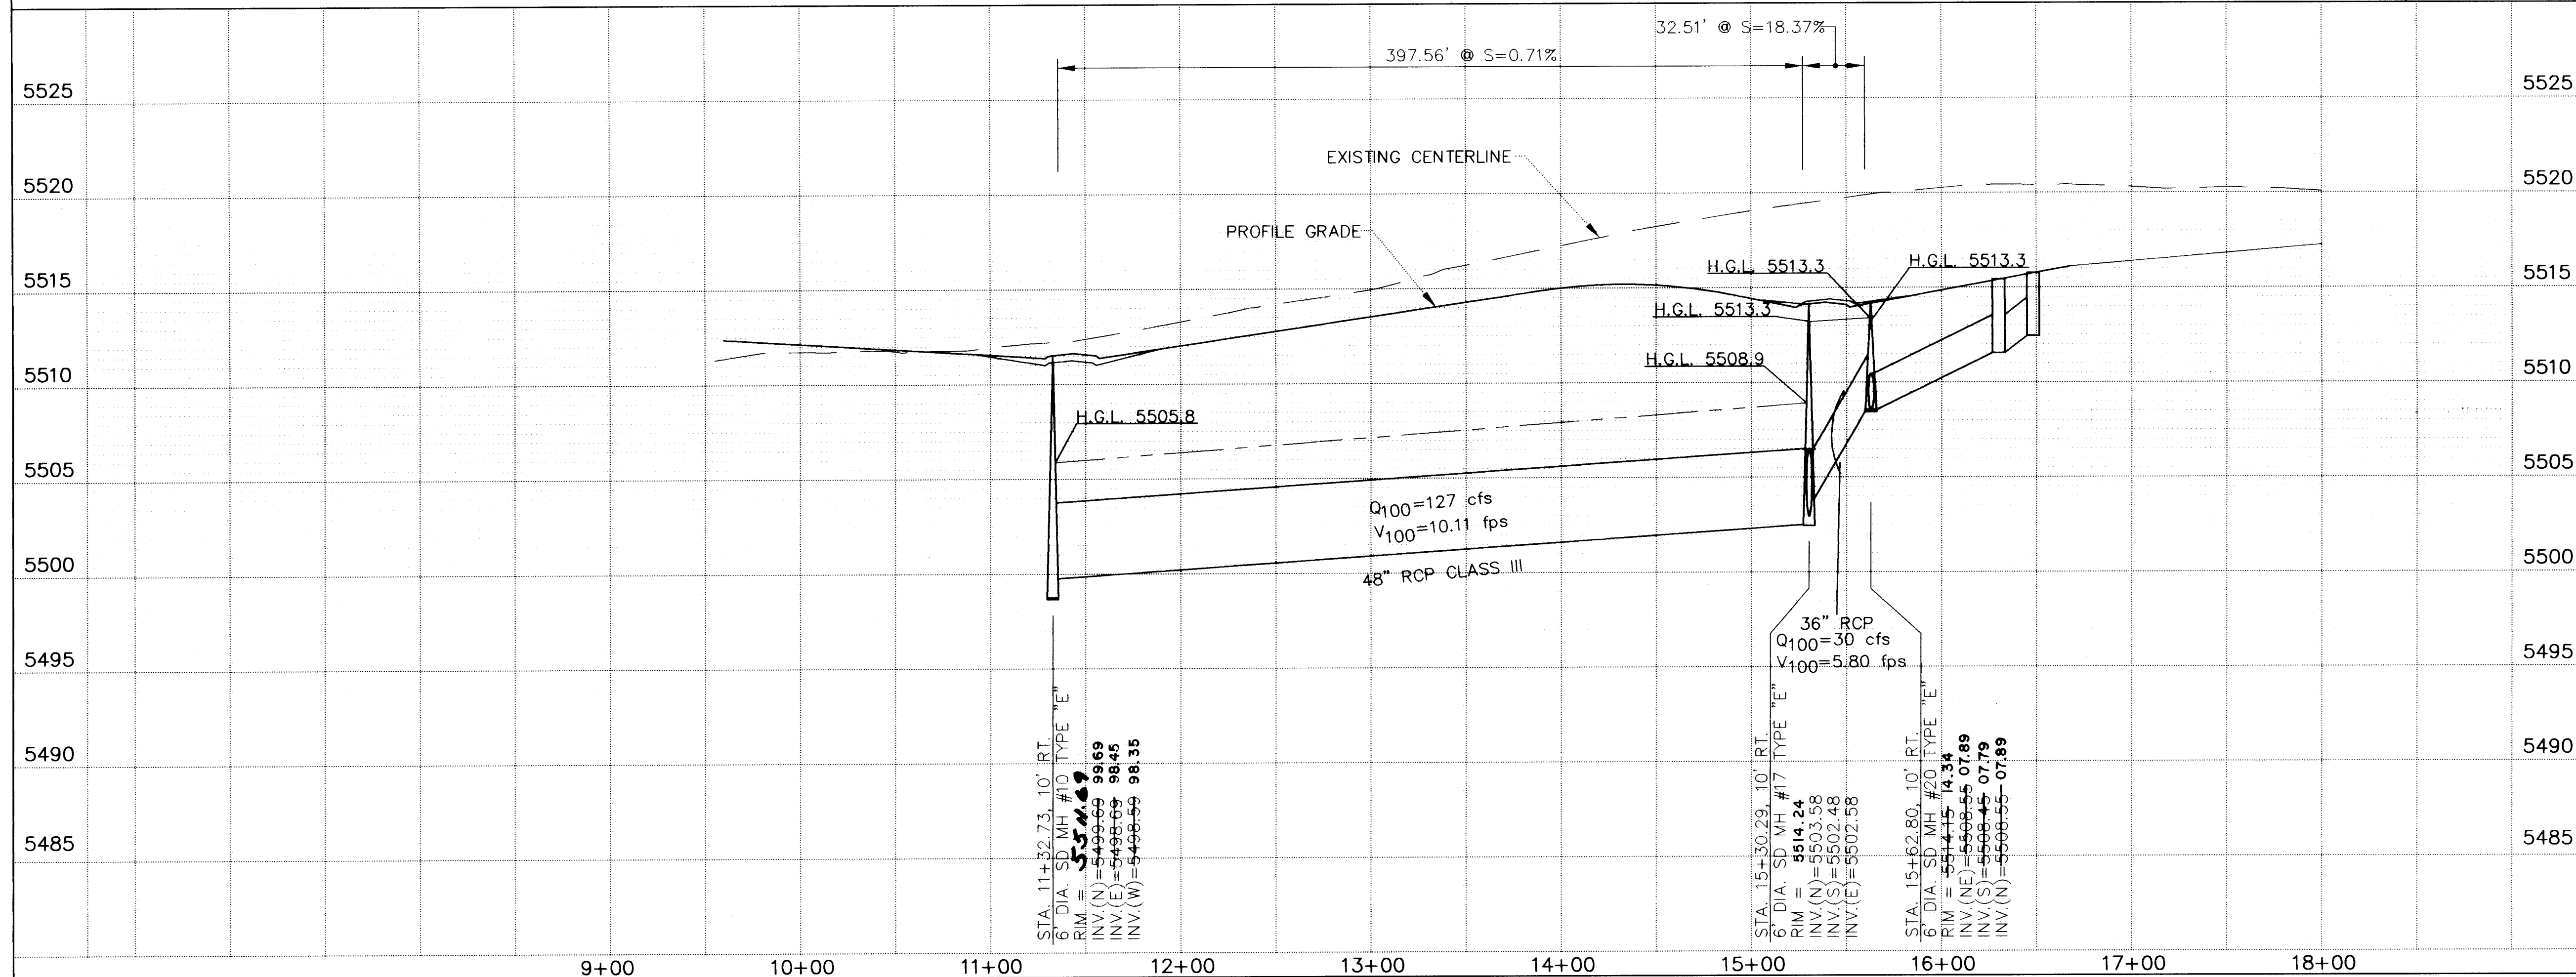

STORM DRAIN NOTES

- 1.) STATIONING ALONG C. OF STREET UNLESS OTHERWISE NOTED.
- 2.) STORM SEWER LINE LENGTHS COMPUTED FROM MH C. TO MH C.
- 3.) SLOPES ARE COMPUTED INVERT TO INVERT. MH RIM ELEVATIONS GIVEN ARE APPROXIMATE. CONTRACTOR SHALL ADJUST ALL RIMS TO FINAL GRADE.
- 4.) CONTRACTOR IS RESPONSIBLE FOR COORDINATION WITH UTILITY COMPANIES.
- 5.) CONTRACTOR SHALL VERIFY ALL EXISTING UTILITIES AND UTILITY CONNECTIONS PRIOR TO BEGINNING CONSTRUCTION. SHOULD A CONFLICT EXIST OR DESIGN REVISIONS BE REQUIRED FOR ANY REASON, THE CONTRACTOR SHALL NOTIFY THE ENGINEER AND ALLOW SUFFICIENT TIME FOR DESIGN REVISIONS SO AS TO NOT DELAY THE CONSTRUCTION SCHEDULE.
- 6.) INLET INVERTS AND CONNECTOR PIPE SLOPES AND LENGTHS ARE COMPUTED FROM STA./OFFSET TO STA./OFFSET SHOWN ON PLANS.

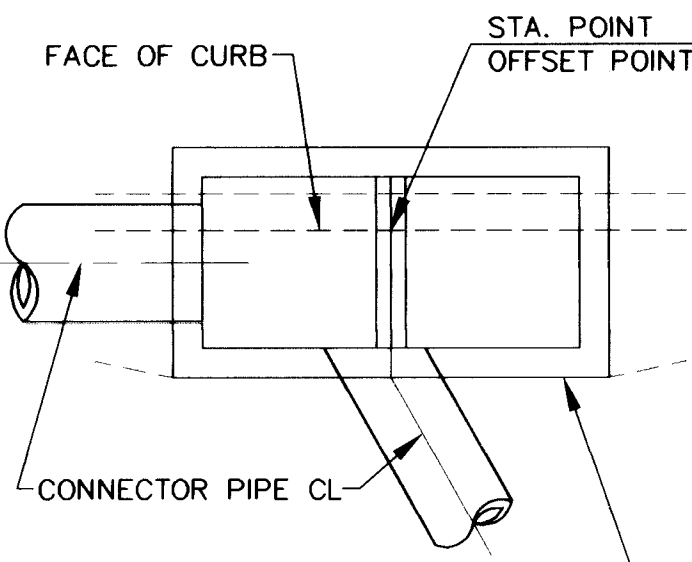

TYPICAL INLET LOCATION DETAIL

LEGEND

- SD PROPOSED STORM DRAIN
- PROPOSED MANHOLE
- PROPOSED TYPE DOUBLE "A" STORM INLET
- PROPOSED TYPE DOUBLE "C" STORM INLET

SCANNED BY
BY LASON

1 2 3 4 5 6 7 8 9 10 11 12 13 14 15
20-14004.93 12915



AVID ENGINEERING, INC.
Civil • Structural • Transportation
6100 Seagull St. NE - Suite 102
Albuquerque, NM 87109 - (505) 881-5357

CITY OF ALBUQUERQUE
PUBLIC WORKS DEPARTMENT
ENGINEERING GROUP

TITLE: WILLOW WOOD - UNIT IV
CANYONLANDS ROAD
STORM DRAIN PLAN AND PROFILE

APPROVALS	ENGINEER	DATE	APPROVALS	ENGINEER	DATE
D.R.C. Chair	<i>[Signature]</i>	7-15-94	Water	N/A R/WK 7-8-94	
Transportation	<i>[Signature]</i>	7-15-94	Waste Water	N/A R/WK 7-8-94	
Hydrology	<i>[Signature]</i>	7-15-94			

DRAWING NO. 4604.93 MAP NO. L-21-Z SHEET 29 OF 40

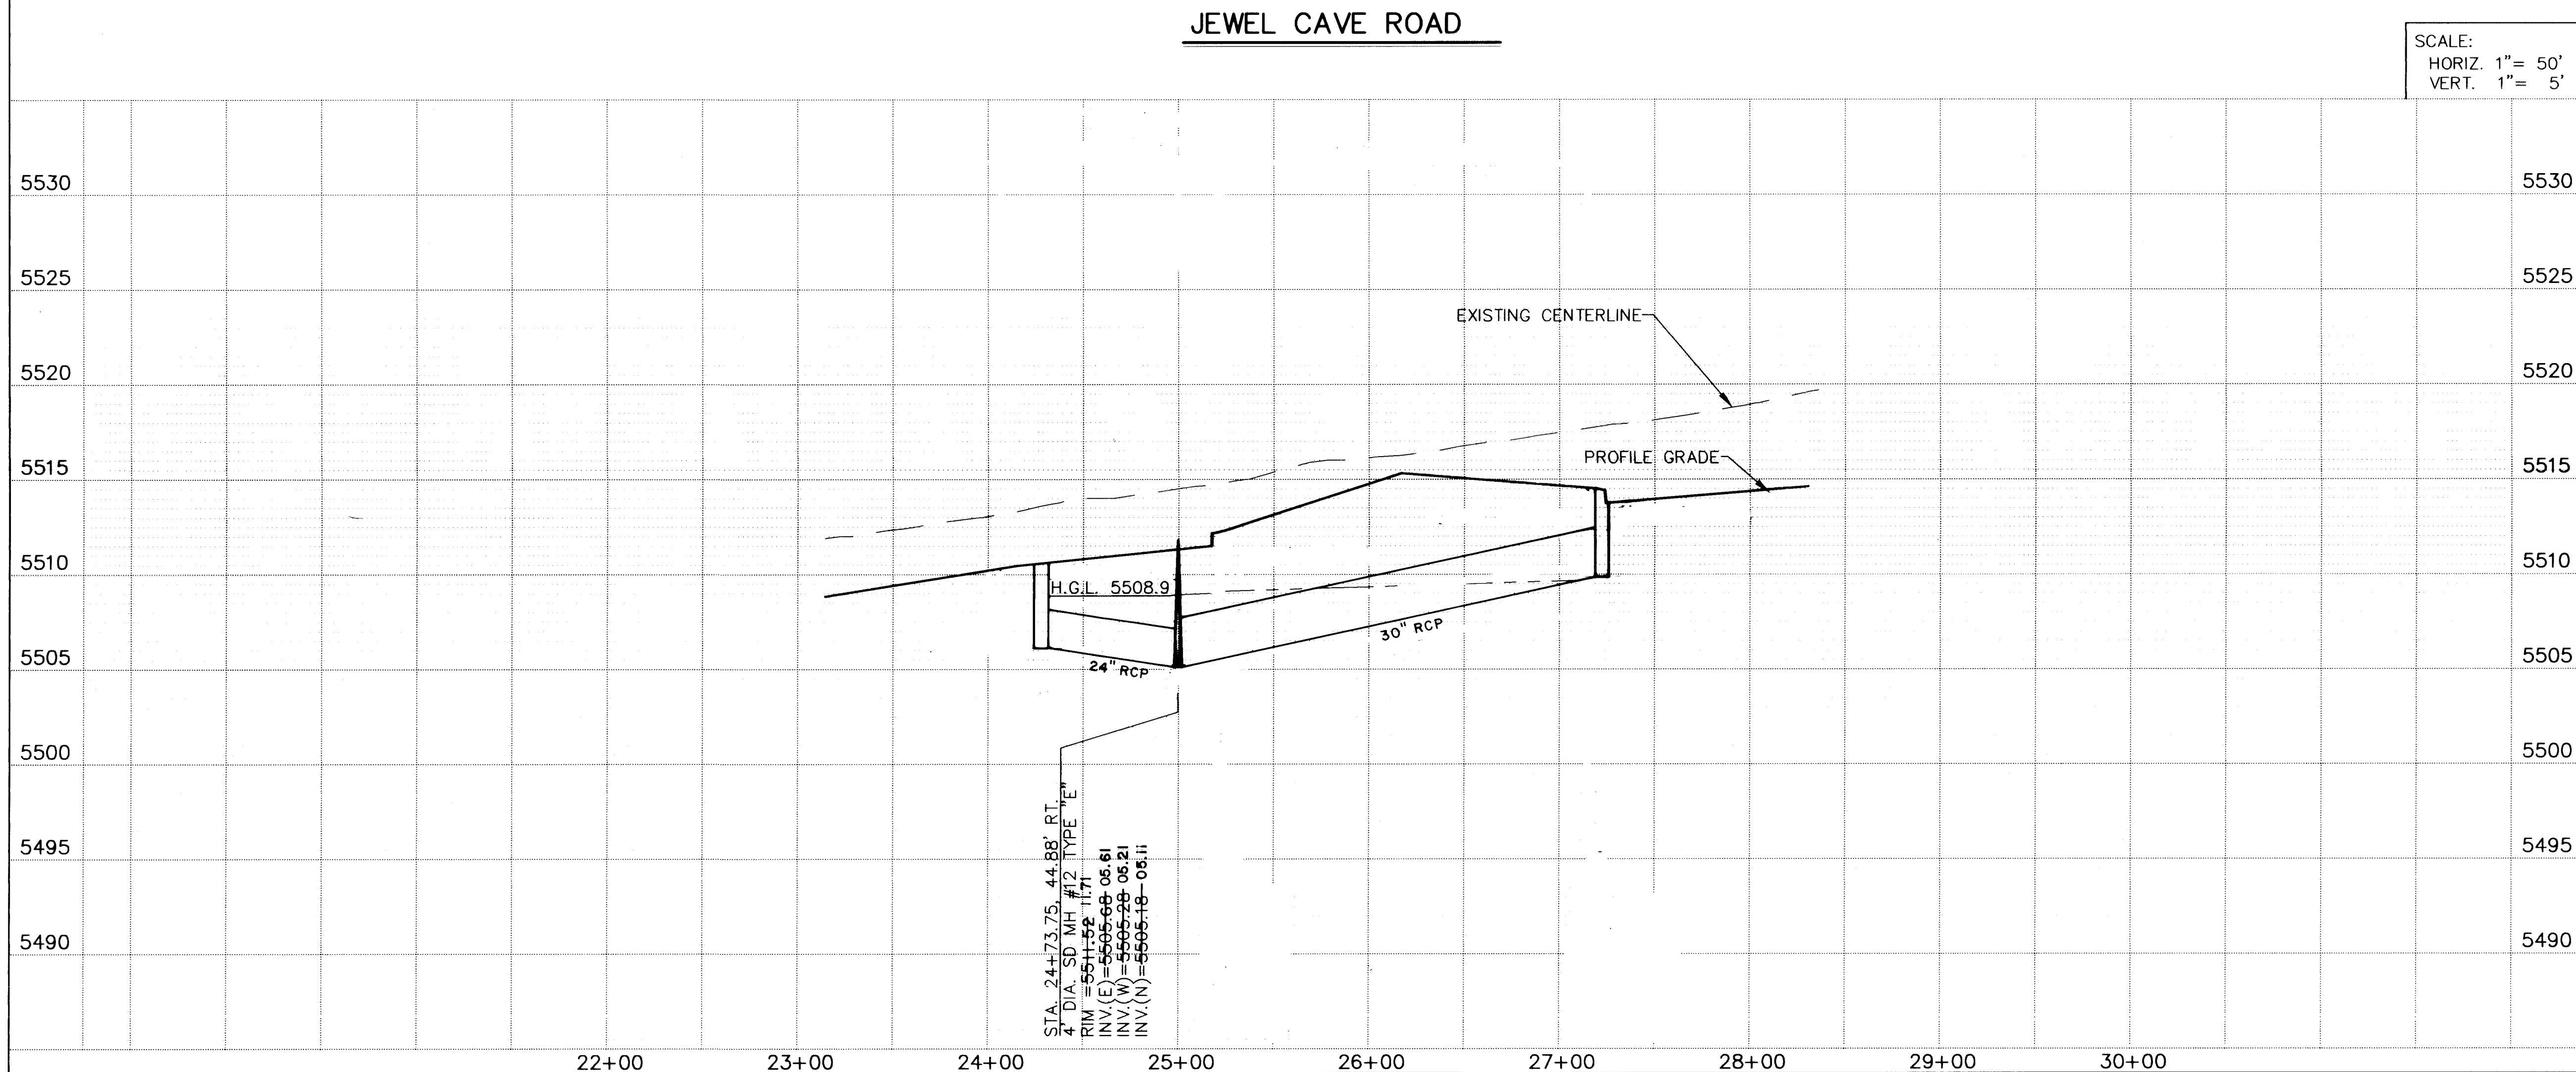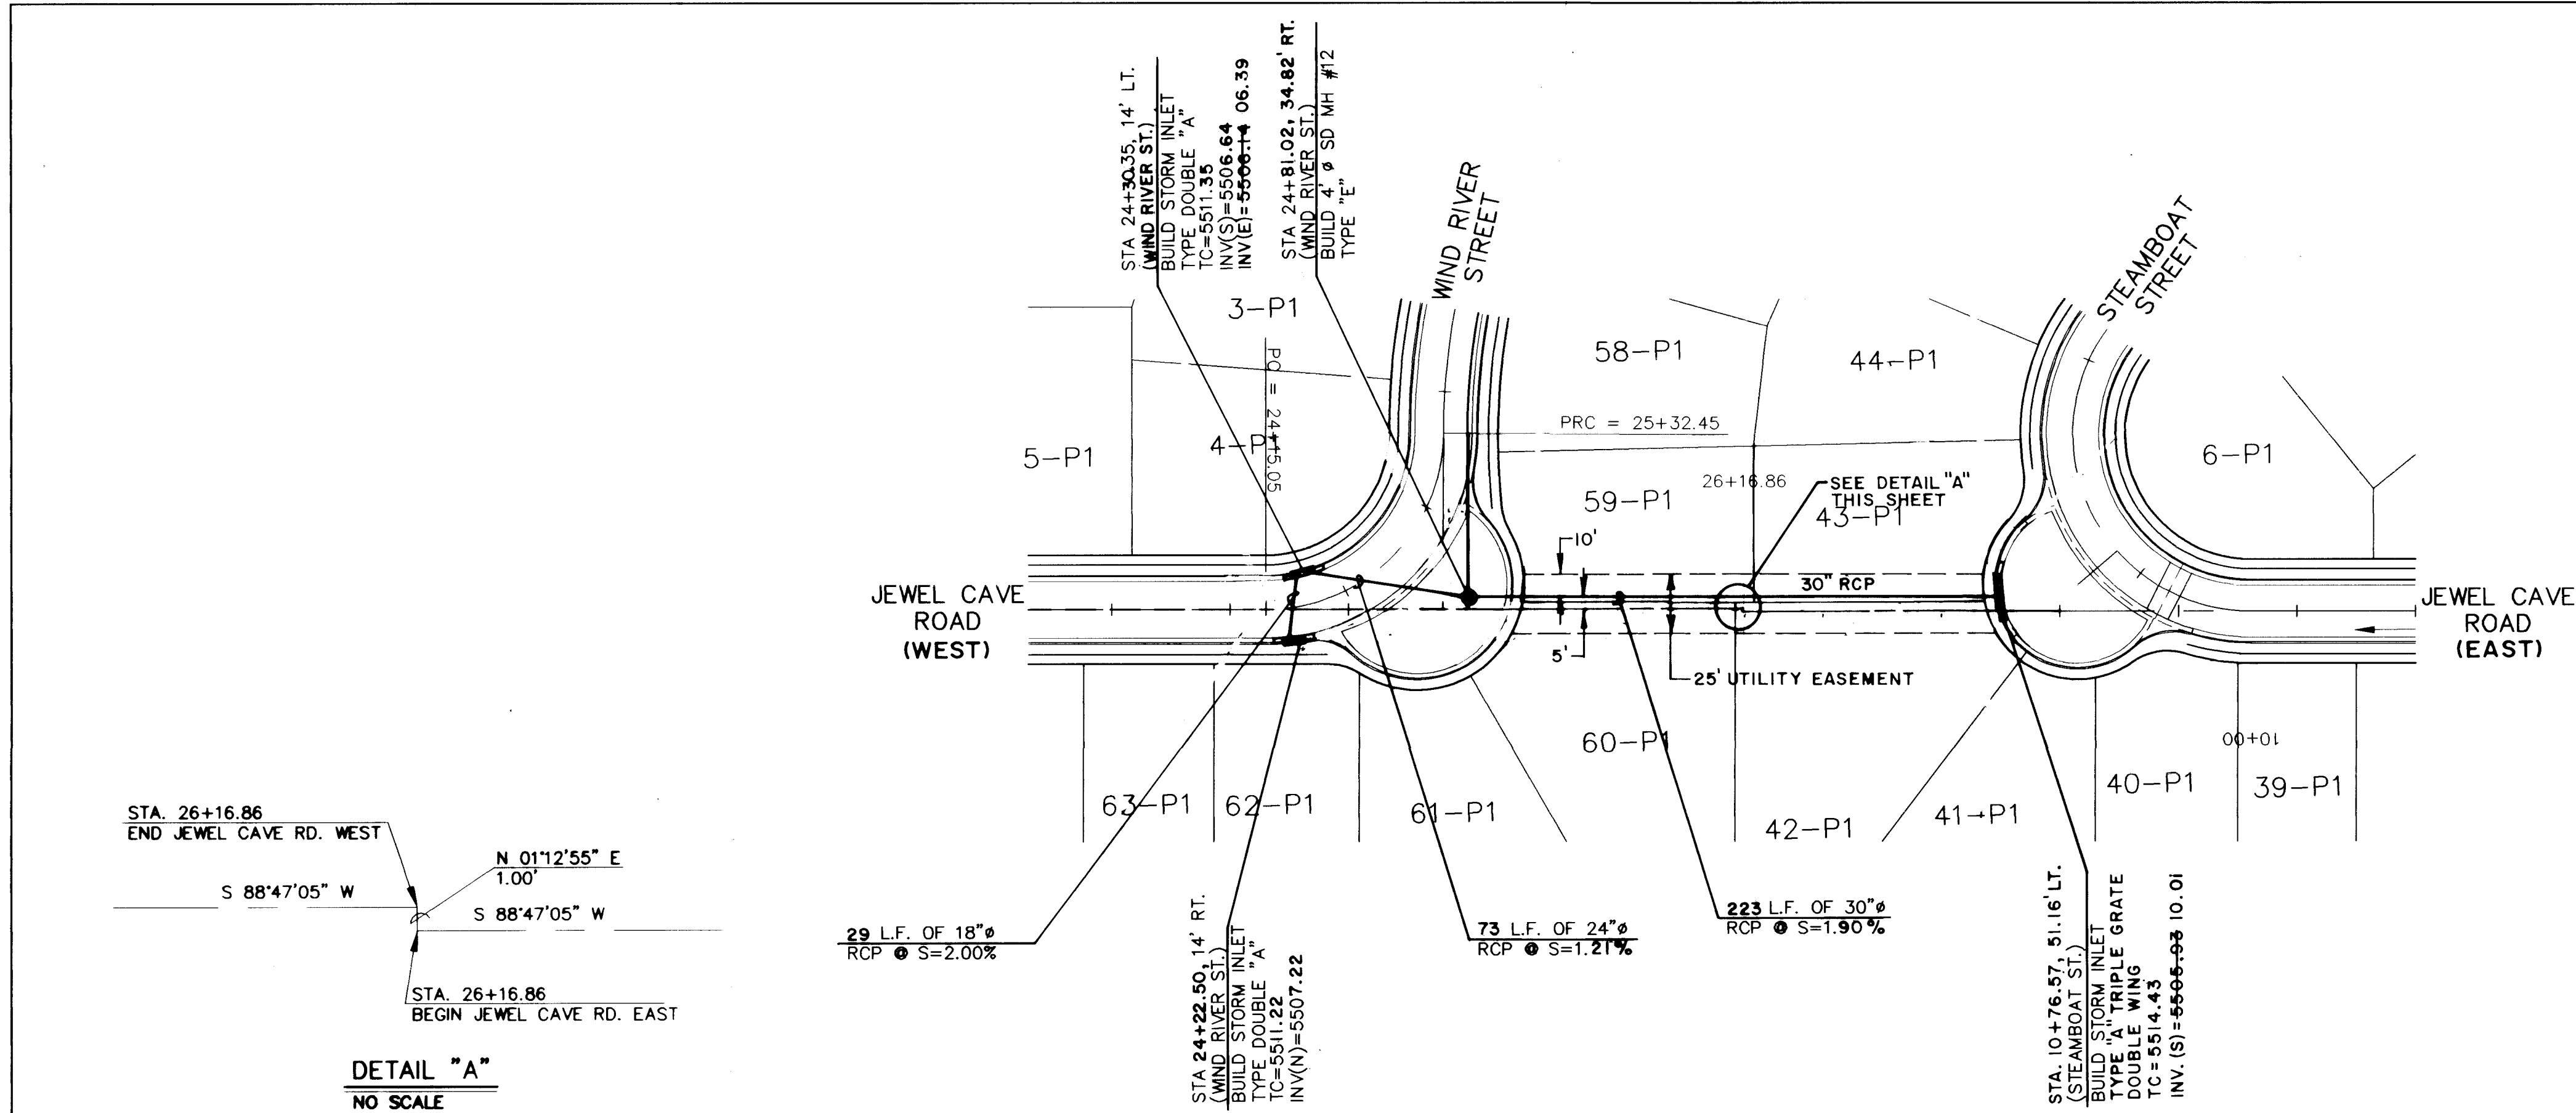


22+00 23+00 24+00 25+00 26+00 27+00 28+00 29+00 30+00

STM-JEW.DWG

STORM DRAIN NOTES

- 1.) STATIONING ALONG C OF STREET UNLESS OTHERWISE NOTED.
- 2.) STORM SEWER LINE LENGTHS COMPUTED FROM MH C TO MH C.
- 3.) SLOPES ARE COMPUTED INVERT TO INVERT. MH RIM ELEVATIONS GIVEN ARE APPROXIMATE. CONTRACTOR SHALL ADJUST ALL RIMS TO FINAL GRADE.
- 4.) CONTRACTOR IS RESPONSIBLE FOR COORDINATION WITH UTILITY COMPANIES.
- 5.) CONTRACTOR SHALL VERIFY ALL EXISTING UTILITIES AND UTILITY CONNECTIONS PRIOR TO BEGINNING CONSTRUCTION. SHOULD A CONFLICT EXIST OR DESIGN REVISIONS BE REQUIRED FOR ANY REASON, THE CONTRACTOR SHALL NOTIFY THE ENGINEER AND ALLOW SUFFICIENT TIME FOR DESIGN REVISIONS SO AS TO NOT DELAY THE CONSTRUCTION SCHEDULE.
- 6.) INLET INVERTS AND CONNECTOR PIPE SLOPES AND LENGTHS ARE COMPUTED FROM STA./OFFSET TO STA./OFFSET SHOWN ON PLANS.

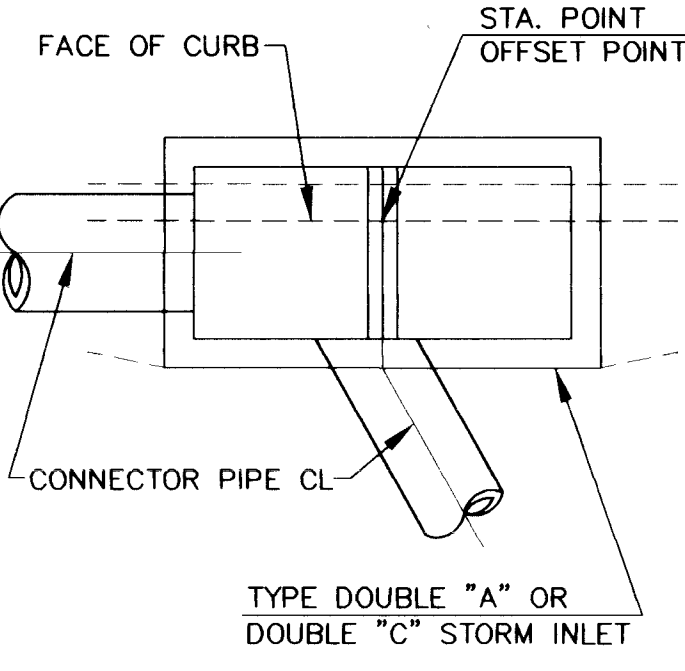

TYPICAL INLET LOCATION DETAIL

- LEGEND
- SD PROPOSED STORM DRAIN
 - PROPOSED MANHOLE
 - ▬ PROPOSED TYPE DOUBLE "A" STORM INLET
 - ▬ PROPOSED TYPE DOUBLE "C" STORM INLET

SCANNED BY LASON

1 2 3 4 5 6 7 8 9 10 11 12 13 14 15

20-14009.93 3096



AVID ENGINEERING, INC.
Civil • Structural • Transportation
6100 Seagull St. NE - Suite 102
Albuquerque, NM 87109 - (505) 881-5357

CITY OF ALBUQUERQUE PUBLIC WORKS DEPARTMENT ENGINEERING GROUP			
TITLE: WILLOW WOOD - UNIT IV JEWEL CAVE ROAD STORM DRAIN PLAN & PROFILE			
APPROVALS	ENGINEER	DATE	APPROVALS
D.R.C. Chair	<i>[Signature]</i>	7-15-94	Water
Transportation	<i>[Signature]</i>	7-15-94	Waste Water
Hydrology	<i>[Signature]</i>	7-15-94	
DESIGNED BY: ETS		DATE: 5/94	
DRAWN BY:		DATE: 5/94	
CHECKED BY: JVD		DATE: 5/94	
DRAWING NO.	4604.93	MAP NO.	L-21-Z
SHEET 30		OF 40	

AS BUILT INFORMATION			
CONTRACTOR	New Concepts Inc.	WORK	DATE
STATIONED BY	COA	ACCEPTED BY	EAR
FIELD LOCATION BY	COA	DATE	DATE
MICRO-FILM INFORMATION			
RECORDED BY		NO.	


BENCH MARKS			
THE STATION MARK IS A STANDARD ACS BRASS TABLET.	DATE	BY	NO.
STAMPED "1-1-21 RESET 1974," LOCATED 7.8 MILES EAST OF DOWNTOWN ALBUQUERQUE, AT THE INTERSECTION OF CENTRAL AVE. AND JUAN TABO BLVD. THE STATION IS ON THE MEDIAN STRIP OF CENTRAL AVE., 81' WEST OF THE CENTERLINE OF JUAN TABO BLVD. AND FLUSH WITH THE TOP OF CURB. SLD ELEV. 5534.63			

ENGINEER'S SEAL			
NO.	DATE	REMARKS	BY
		DESIGN	

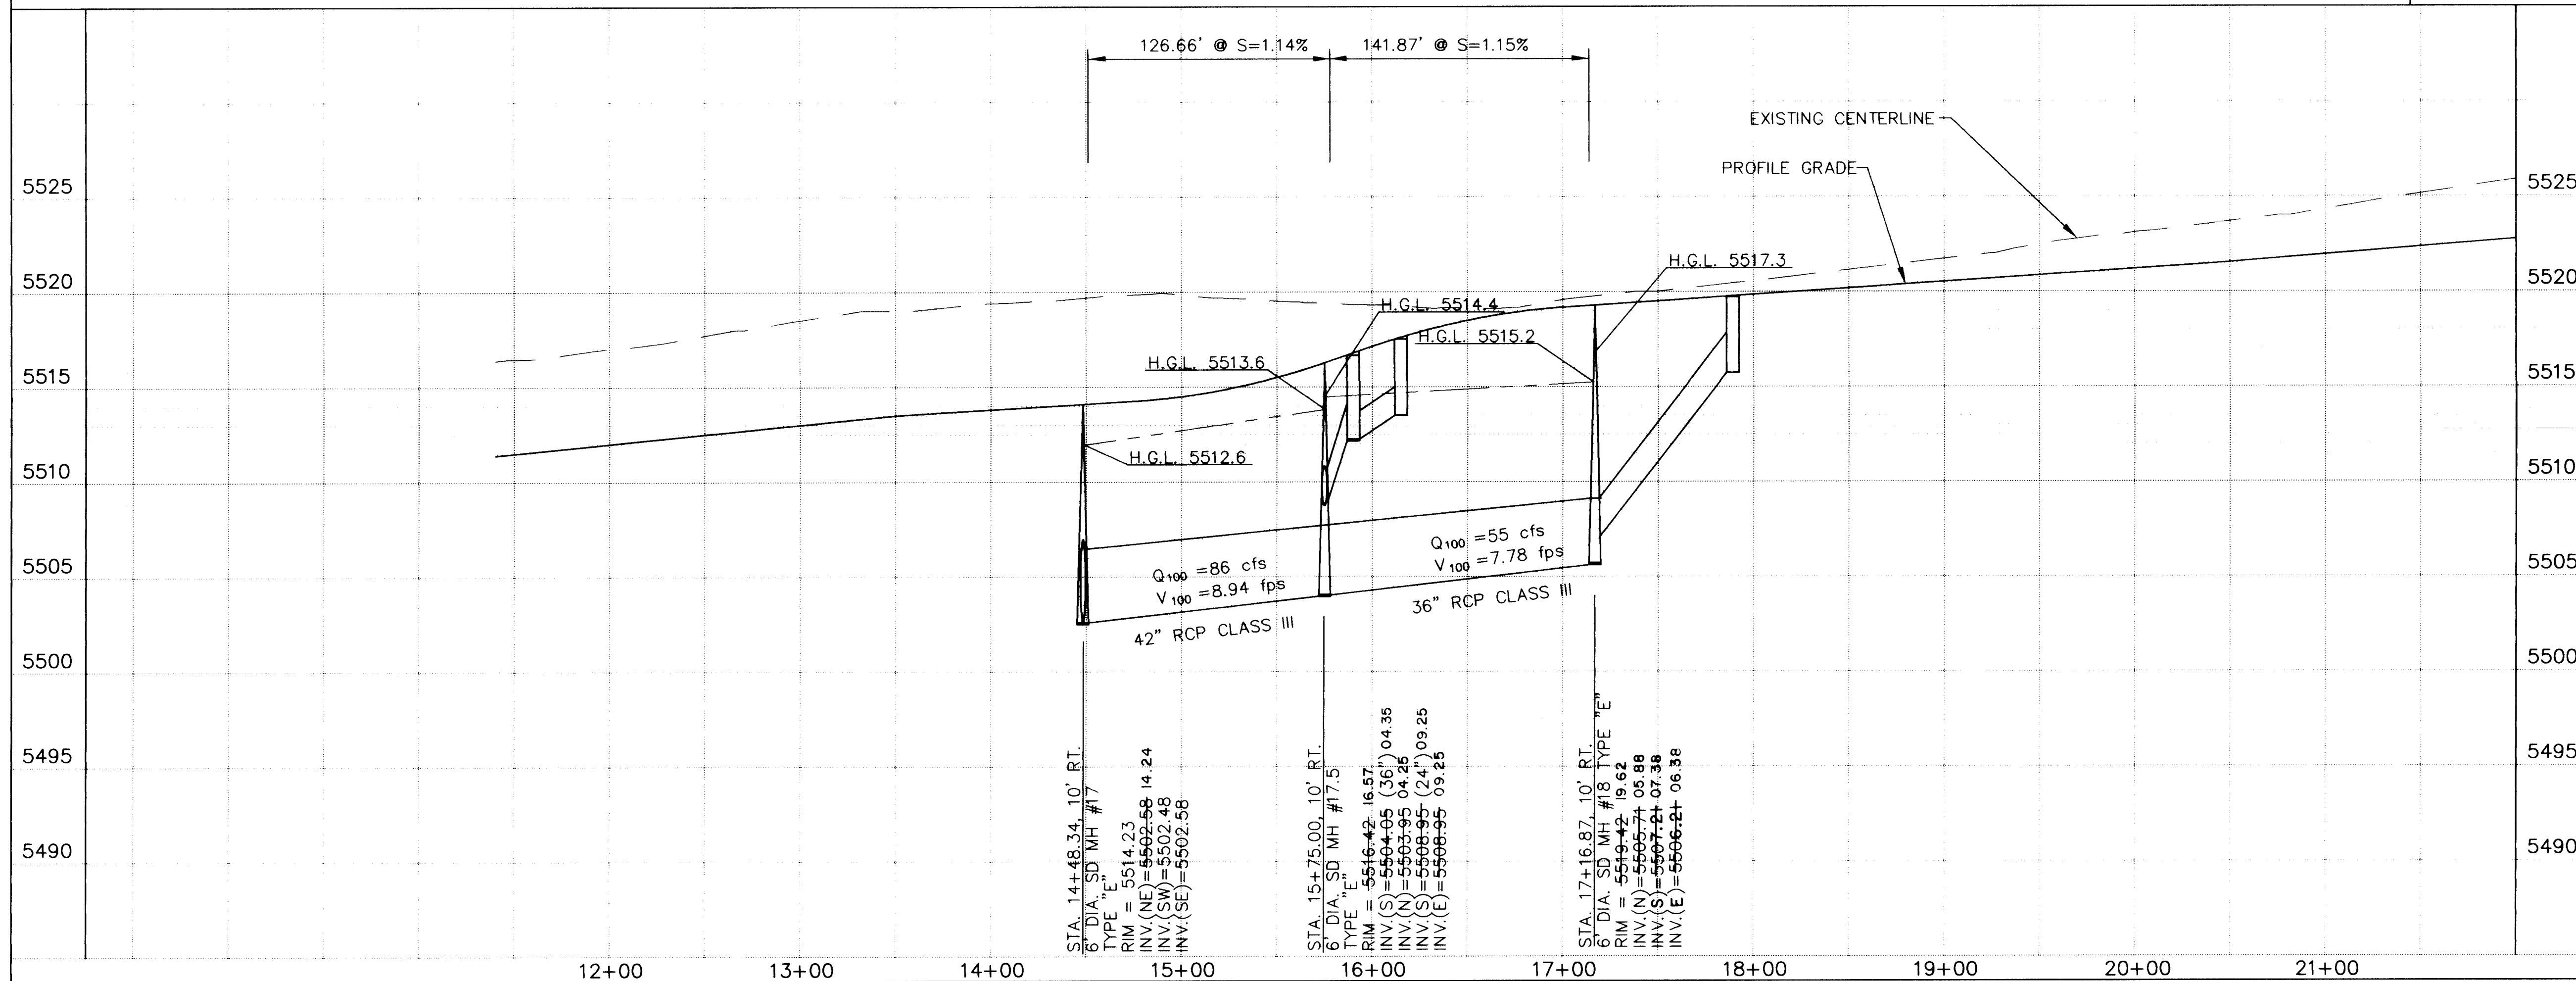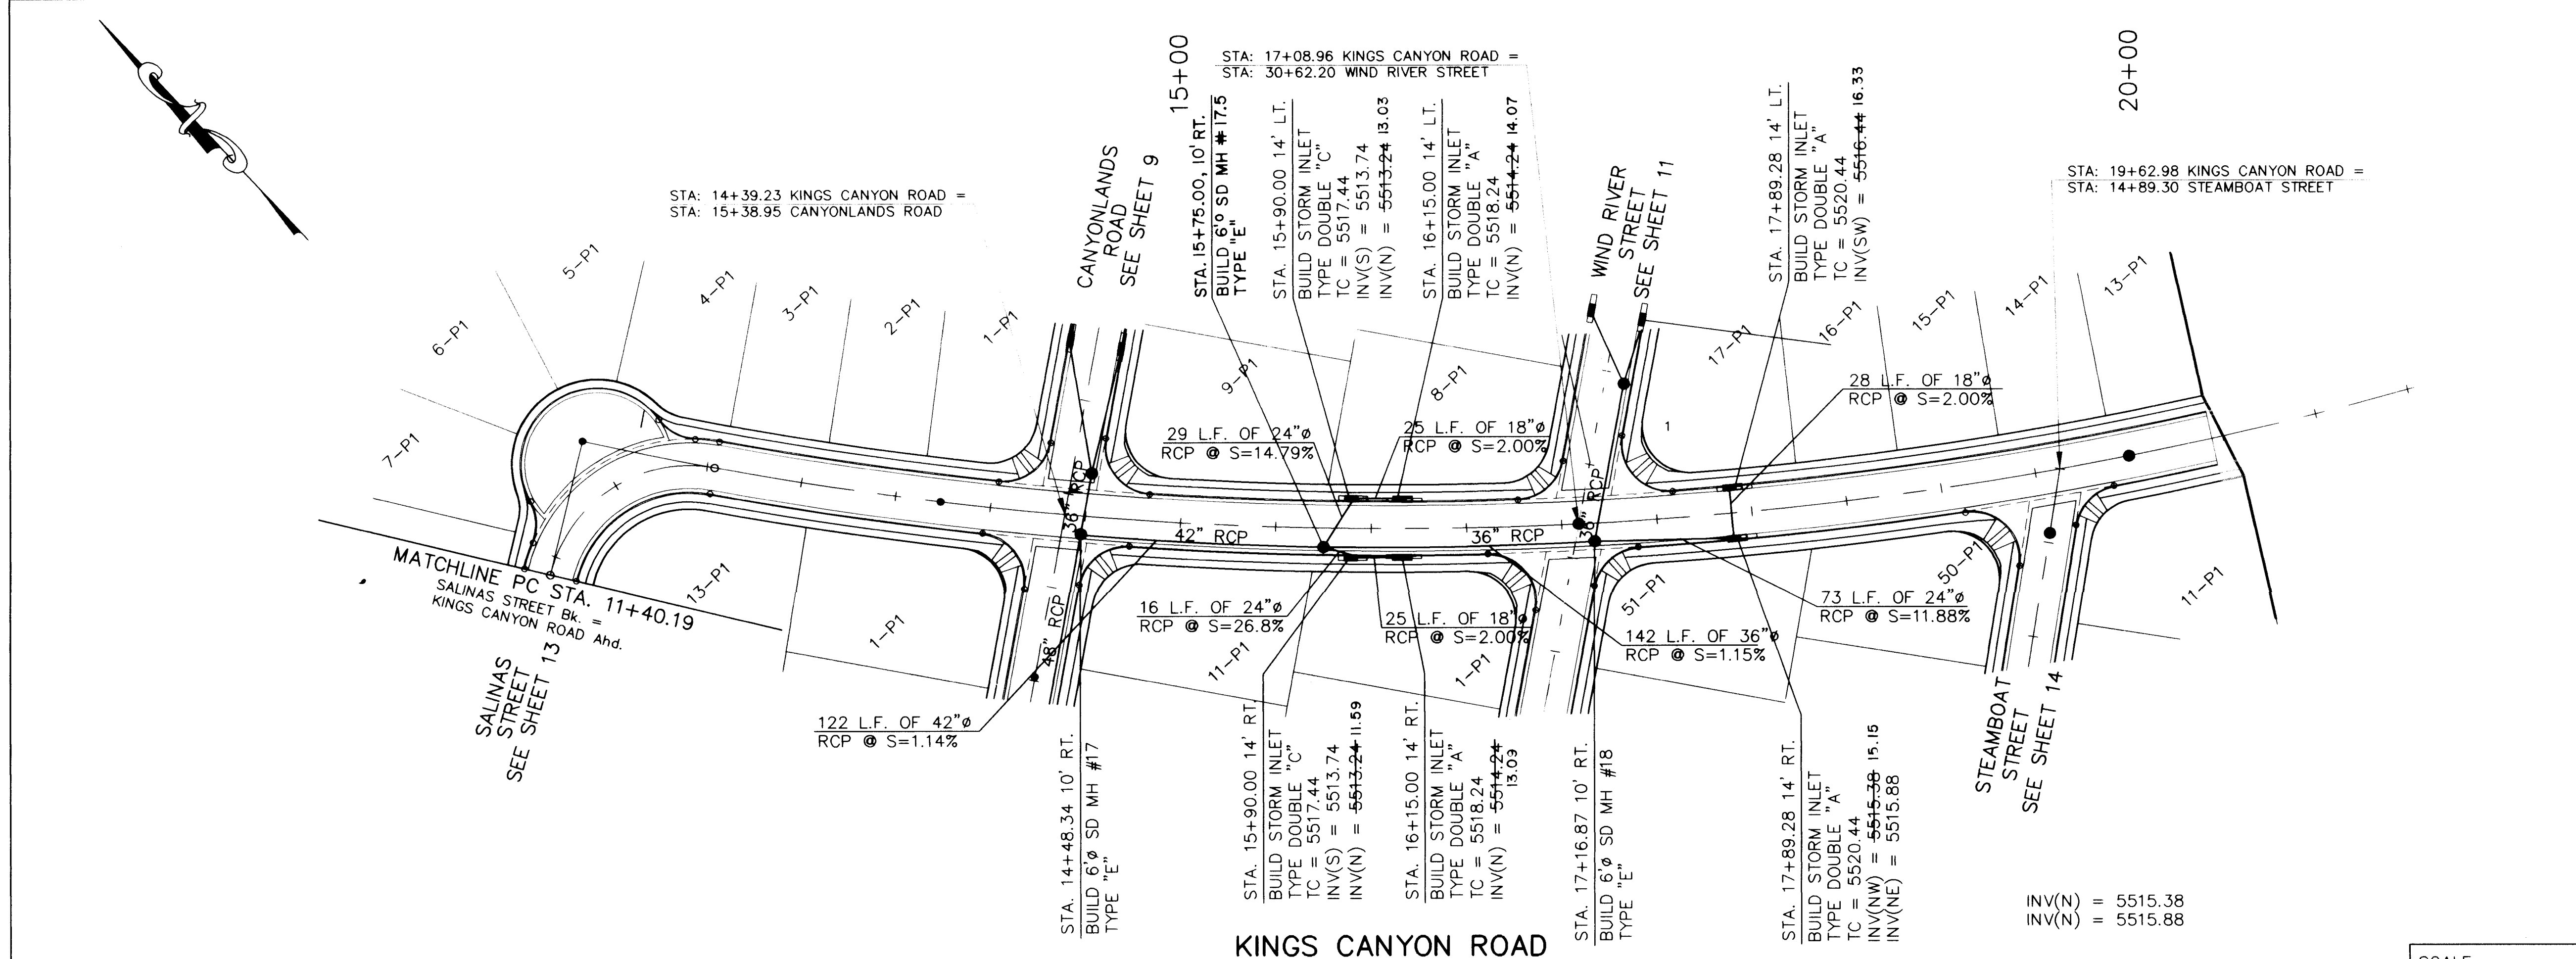

STORM DRAIN NOTES

- 1.) STATIONING ALONG C. OF STREET UNLESS OTHERWISE NOTED.
- 2.) STORM SEWER LINE LENGTHS COMPUTED FROM MH C. TO MH C.
- 3.) SLOPES ARE COMPUTED INVERT TO INVERT. MH RIM ELEVATIONS GIVEN ARE APPROXIMATE. CONTRACTOR SHALL ADJUST ALL RIMS TO FINAL GRADE.
- 4.) CONTRACTOR IS RESPONSIBLE FOR COORDINATION WITH UTILITY COMPANIES.
- 5.) CONTRACTOR SHALL VERIFY ALL EXISTING UTILITIES AND UTILITY CONNECTIONS PRIOR TO BEGINNING CONSTRUCTION. SHOULD A CONFLICT EXIST OR DESIGN REVISIONS BE REQUIRED FOR ANY REASON, THE CONTRACTOR SHALL NOTIFY THE ENGINEER AND ALLOW SUFFICIENT TIME FOR DESIGN REVISIONS SO AS TO NOT DELAY THE CONSTRUCTION SCHEDULE.
- 6.) INLET INVERTS AND CONNECTOR PIPE SLOPES AND LENGTHS ARE COMPUTED FROM STA./OFFSET TO STA./OFFSET SHOWN ON PLANS.

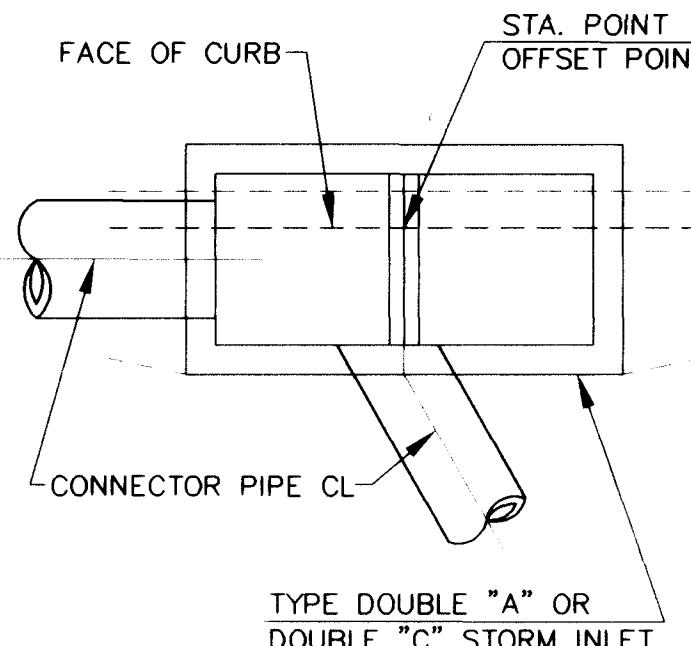

TYPICAL INLET LOCATION DETAIL

- LEGEND
- SD PROPOSED STORM DRAIN
 - PROPOSED MANHOLE
 - ▬ PROPOSED TYPE DOUBLE "A" STORM INLET
 - ▬ PROPOSED TYPE DOUBLE "C" STORM INLET

SCANNED BY
BY LASON

20-1404-1933395


AVID ENGINEERING, INC.
Civil • Structural • Transportation
6100 Seagull St. NE Suite 102
Albuquerque, NM 87109 (505) 881-5357

CITY OF ALBUQUERQUE
PUBLIC WORKS DEPARTMENT
ENGINEERING GROUP


TITLE: WILLOW WOOD - UNIT IV
KINGS CANYON ROAD
STORM DRAIN PLAN AND PROFILE

APPROVALS	ENGINEER	DATE	APPROVALS	ENGINEER	DATE
D.R.C. Chair	<i>[Signature]</i>	7-15-94	Water	N/A RWE	7-8-94
Transportation	<i>[Signature]</i>	7-01-94	Waste Water	N/A RWE	7-8-94
Hydrology	<i>[Signature]</i>	7-1-94			


AS BUILT INFORMATION			BENCH MARKS			SURVEY INFORMATION			ENGINEER'S SEAL				
CONTRACTOR	New Concepts Inc.		STATION MARK	IS A STANDARD ACS BRASS TABLET.		DATE	BY			REMARKS	BY		
STAKED BY	COA	DATE	STATION MARK	OF DOWNTOWN ALBUQUERQUE, AT THE INTERSECTION OF CENTRAL AVE. AND JUAN TABO BLVD. THE STATION IS ON THE MEDIAN STRIP OF CENTRAL AVE., 81' WEST OF THE CENTERLINE OF JUAN TABO BLVD. AND FLUSH WITH THE TOP OF CURB. SLD ELEV. 5534.63									
FIELD CHECKED BY	COA	DATE	STATION MARK										
DESIGNED BY	COA	DATE	STATION MARK										
MICRO-FILM INFORMATION			RECORDING BY			DESIGNED BY			DRAWN BY				

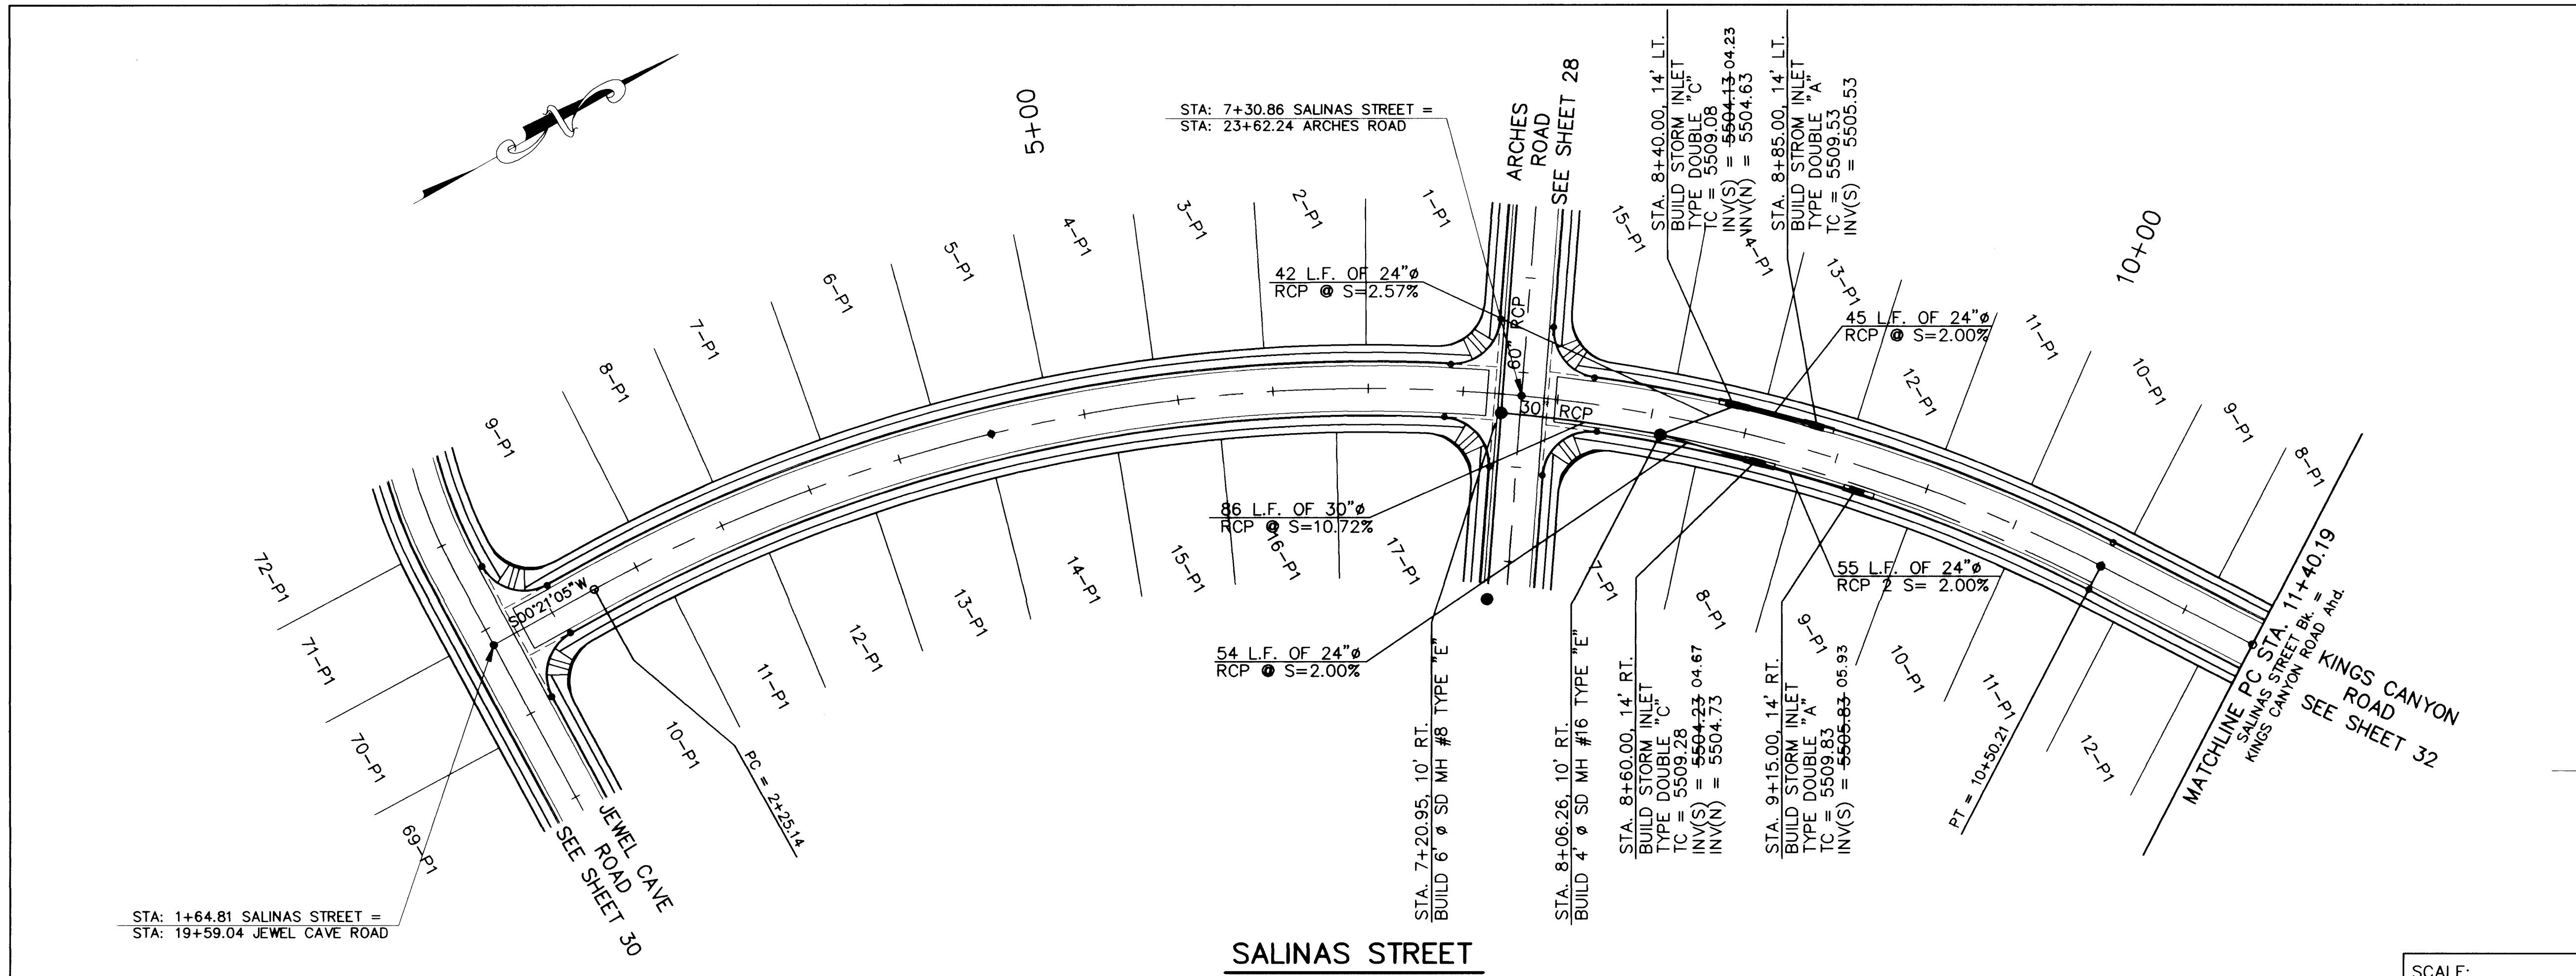

- STORM DRAIN NOTES**
- 1.) STATIONING ALONG C OF STREET UNLESS OTHERWISE NOTED.
 - 2.) STORM SEWER LINE LENGTHS COMPUTED FROM MH C TO MH C.
 - 3.) SLOPES ARE COMPUTED INVERT TO INVERT. MH RIM ELEVATIONS GIVEN ARE APPROXIMATE. CONTRACTOR SHALL ADJUST ALL RIMS TO FINAL GRADE.
 - 4.) CONTRACTOR IS RESPONSIBLE FOR COORDINATION WITH UTILITY COMPANIES.
 - 5.) CONTRACTOR SHALL VERIFY ALL EXISTING UTILITIES AND UTILITY CONNECTIONS PRIOR TO BEGINNING CONSTRUCTION. SHOULD A CONFLICT EXIST OR DESIGN REVISIONS BE REQUIRED FOR ANY REASON, THE CONTRACTOR SHALL NOTIFY THE ENGINEER AND ALLOW SUFFICIENT TIME FOR DESIGN REVISIONS SO AS TO NOT DELAY THE CONSTRUCTION SCHEDULE.
 - 6.) INLET INVERTS AND CONNECTOR PIPE SLOPES AND LENGTHS ARE COMPUTED FROM STA./OFFSET TO STA./OFFSET SHOWN ON PLANS.

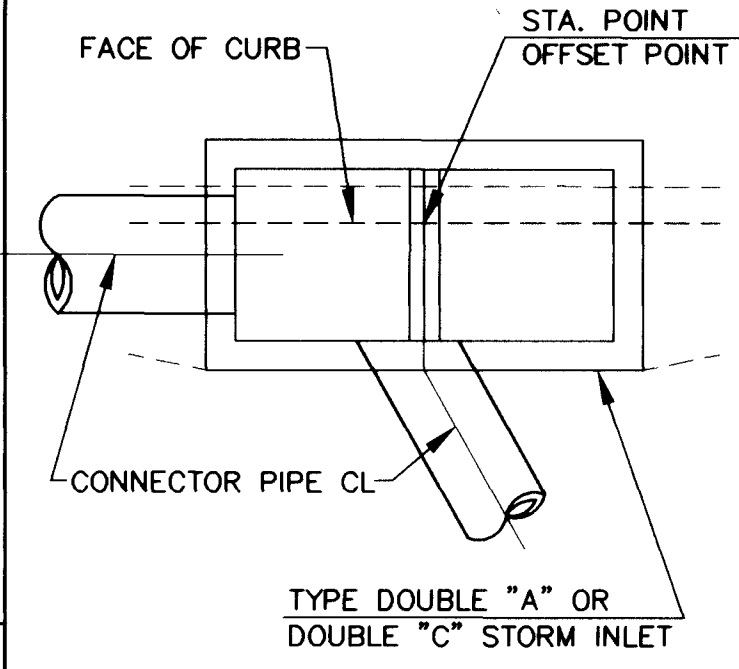

SCALE:
HORIZ. 1" = 50'
VERT. 1" = 5'

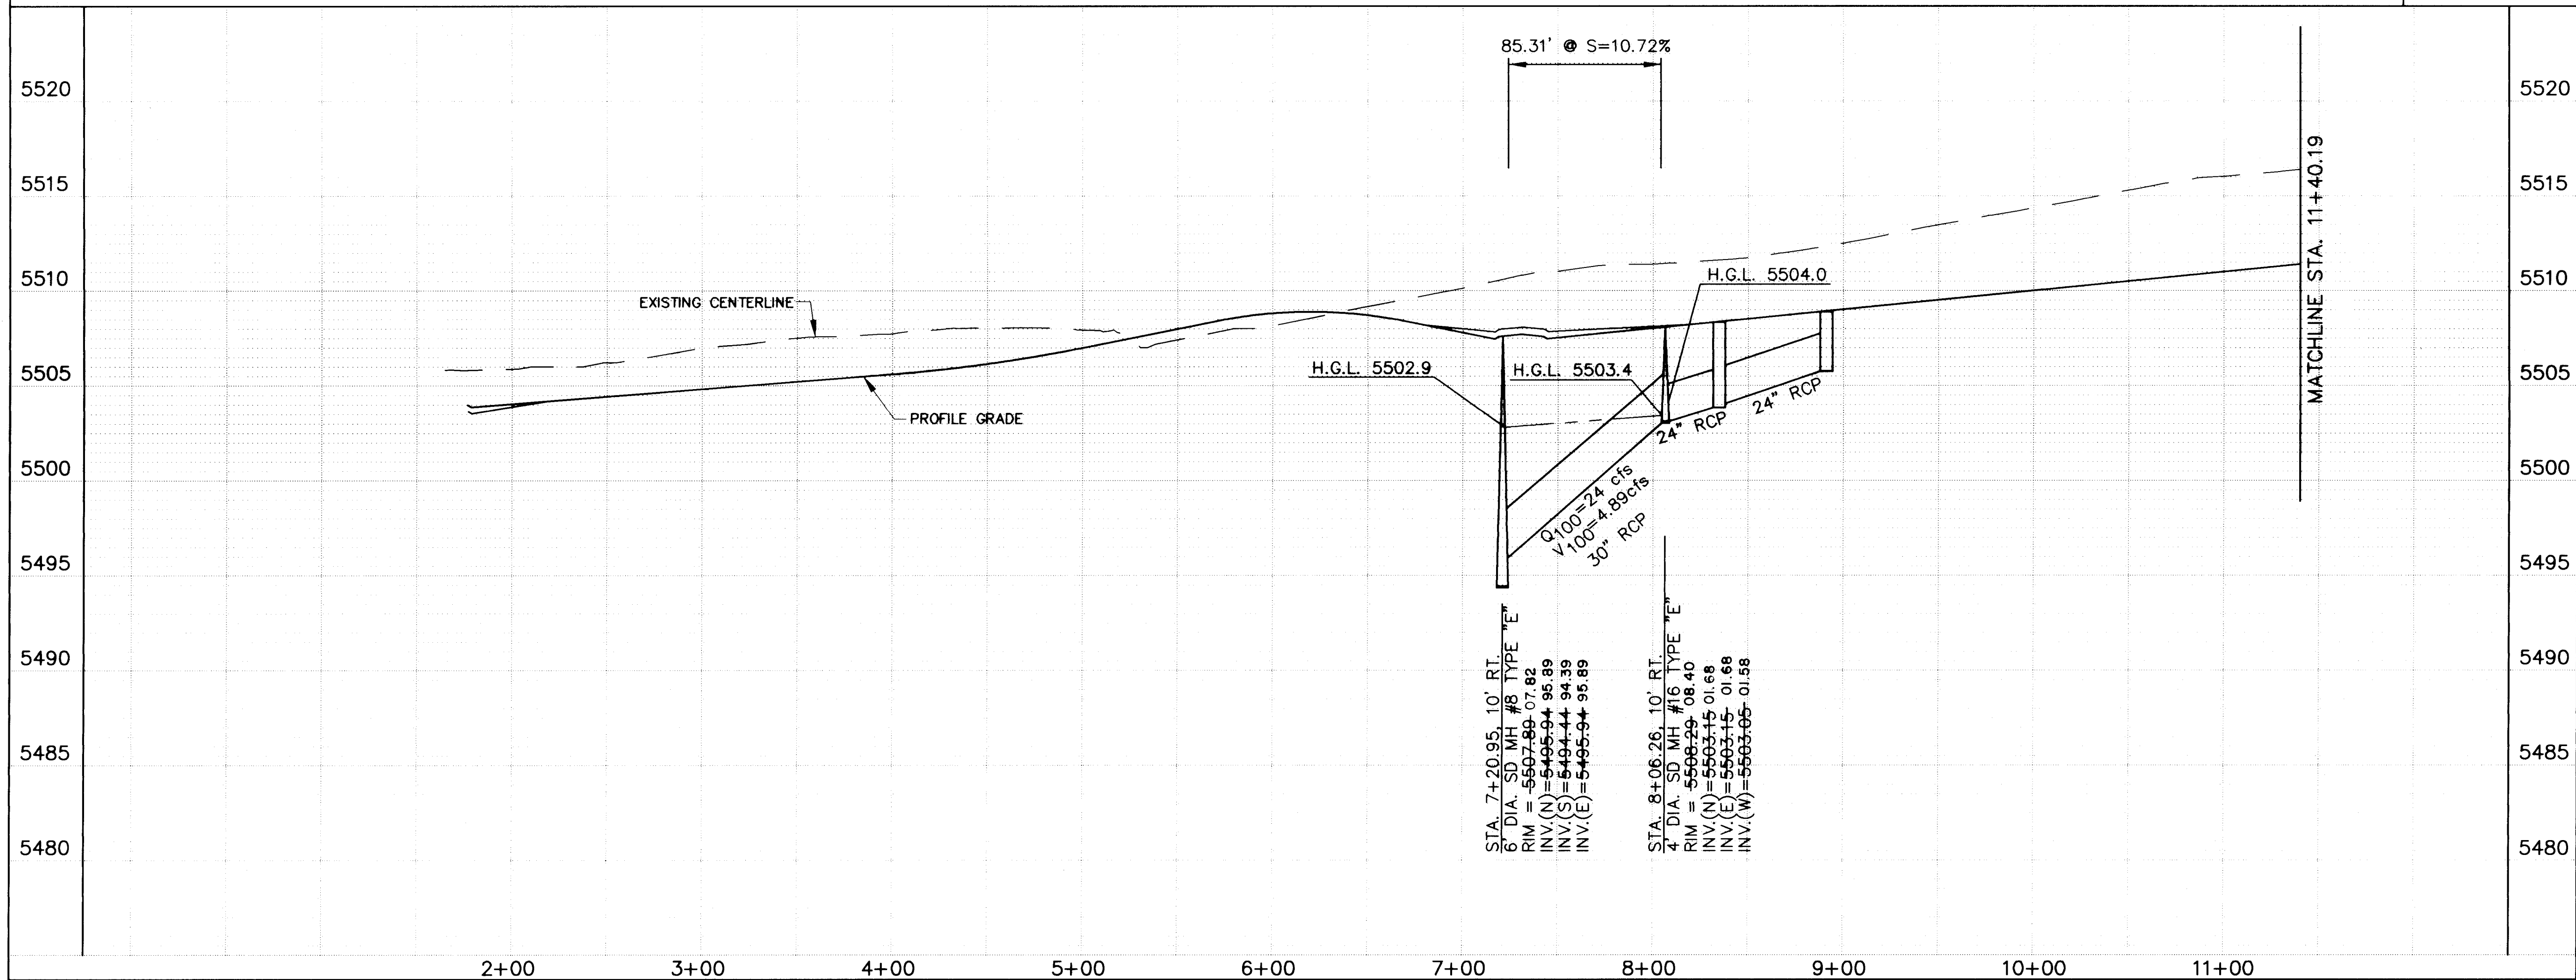


- LEGEND**
- SD PROPOSED STORM DRAIN
 - PROPOSED MANHOLE
 - ▬ PROPOSED TYPE DOUBLE "A" STORM INLET
 - ▬ PROPOSED TYPE DOUBLE "C" STORM INLET

SCANNED BY
BY LASON

20-14604-93 13395

AVID ENGINEERING, INC.
Civil • Structural • Transportation
6100 Seagull St. NE - Suite 102
Albuquerque, NM 87109 - (505) 881-5357

CITY OF ALBUQUERQUE PUBLIC WORKS DEPARTMENT ENGINEERING GROUP					
TITLE: WILLOW WOOD - UNIT IV SALINAS STREET STORM DRAIN PLAN AND PROFILE					
APPROVALS	ENGINEER	DATE	APPROVALS	ENGINEER	DATE
D.R.C. Chair	<i>[Signature]</i>	7-15-94	Water	N/A RWK	7-8-94
Transportation	<i>[Signature]</i>	7-01-94	Waste Water	N/A RWK	7-8-94
Hydrology	<i>[Signature]</i>	7-1-94			
DRAWING NO.	4604.93	MAP NO. L-21-Z	SHEET 33	OF 40	

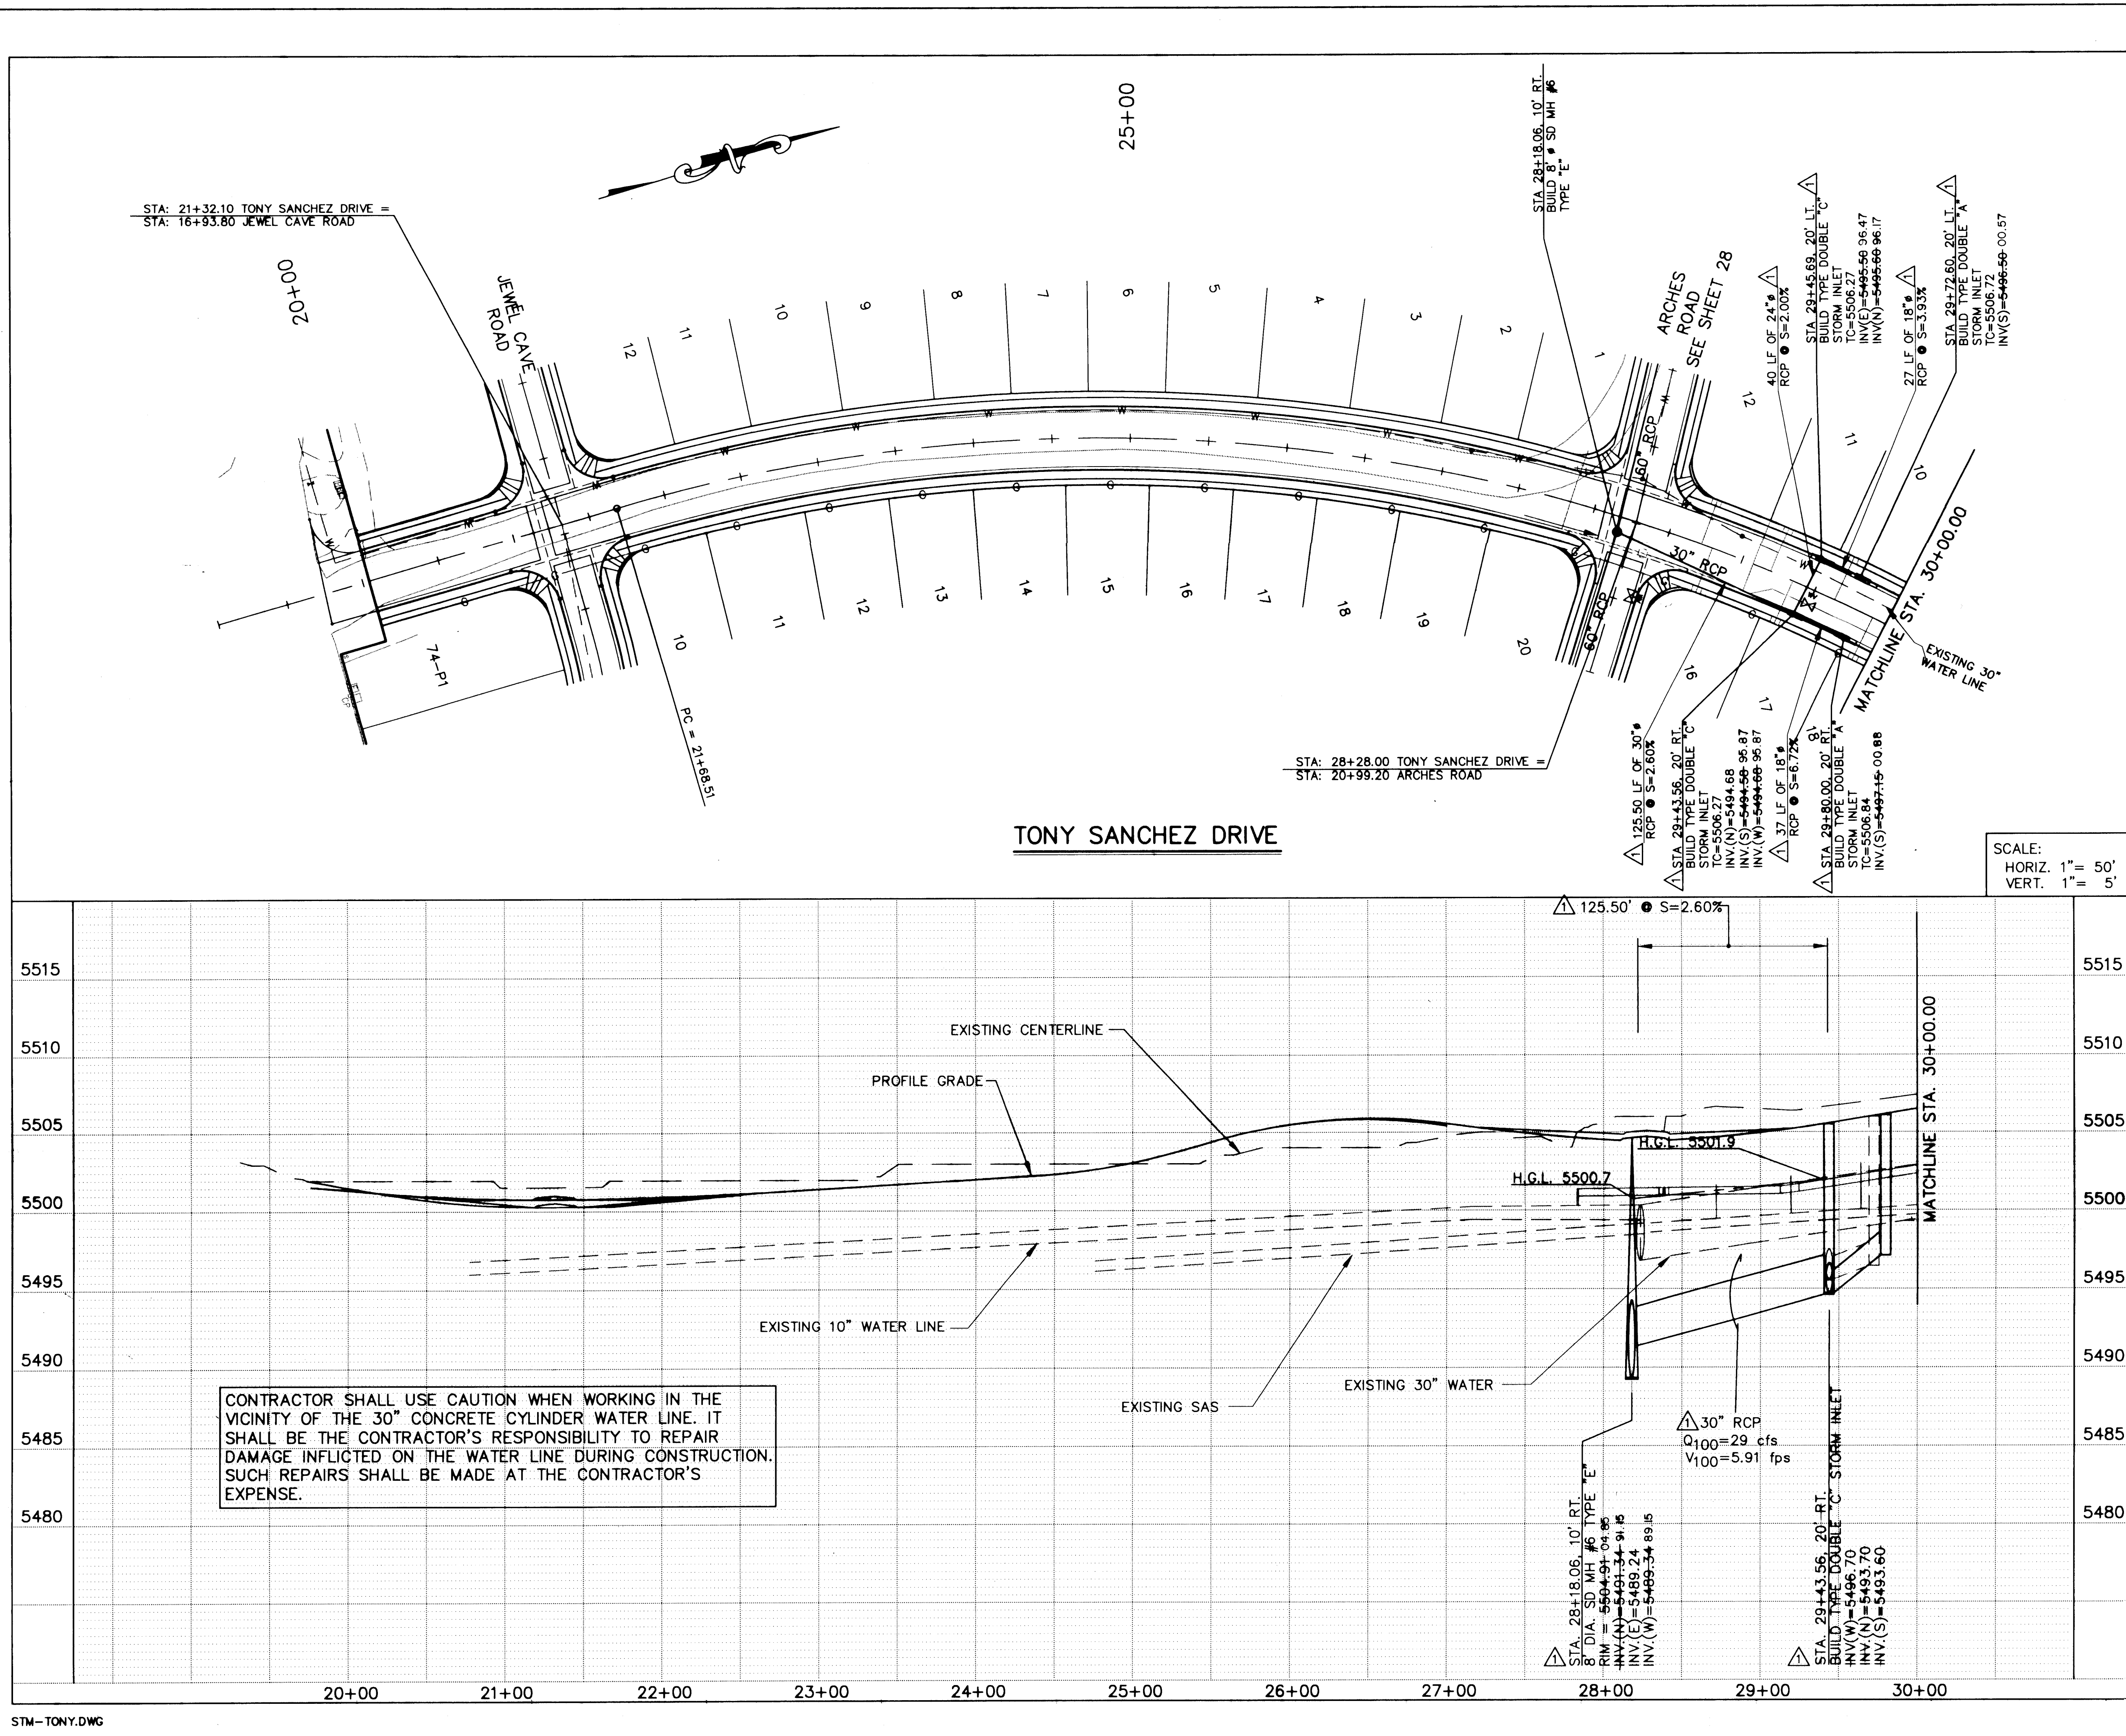

STORM DRAIN NOTES

- STATIONING ALONG C OF STREET UNLESS OTHERWISE NOTED.
- STORM SEWER LINE LENGTHS COMPUTED FROM MH C TO MH C.
- SLOPES ARE COMPUTED INVERT TO INVERT. MH RIM ELEVATIONS GIVEN ARE APPROXIMATE. CONTRACTOR SHALL ADJUST ALL RIMS TO FINAL GRADE.
- CONTRACTOR IS RESPONSIBLE FOR COORDINATION WITH UTILITY COMPANIES.
- CONTRACTOR SHALL VERIFY ALL EXISTING UTILITIES AND UTILITY CONNECTIONS PRIOR TO BEGINNING CONSTRUCTION. SHOULD A CONFLICT EXIST OR DESIGN REVISIONS BE REQUIRED FOR ANY REASON, THE CONTRACTOR SHALL NOTIFY THE ENGINEER AND ALLOW SUFFICIENT TIME FOR DESIGN REVISIONS SO AS TO NOT DELAY THE CONSTRUCTION SCHEDULE.
- INLET INVERTS AND CONNECTOR PIPE SLOPES AND LENGTHS ARE COMPUTED FROM STA./OFFSET TO STA./OFFSET SHOWN ON PLANS.

TYPICAL INLET LOCATION DETAIL

LEGEND

- SD PROPOSED STORM DRAIN
- PROPOSED MANHOLE
- PROPOSED TYPE DOUBLE 'A' STORM INLET
- PROPOSED TYPE DOUBLE 'C' STORM INLET

SCANNED BY BY LASON

20-01-2019 19:11:39

AVID ENGINEERING, INC.
Civil • Structural • Transportation
6100 Seagull St. NE - Suite 102
Albuquerque, NM 87109 - (505) 881-5357


CITY OF ALBUQUERQUE
PUBLIC WORKS DEPARTMENT
ENGINEERING GROUP

TITLE: WILLOW WOOD - UNIT IV
TONY SANCHEZ DRIVE
STORM DRAIN PLAN AND PROFILE

APPROVALS	ENGINEER	DATE	APPROVALS	ENGINEER	DATE
D.R.C. Chair	7-15-94	7-15-94	Water	N/A RUC	7-8-94
Transportation	7-15-94	7-15-94	Waste Water	N/A RUC	7-8-94
Hydrology	7-15-94	7-15-94			

DESIGNED BY	DRAWN BY	CHECKED BY

AS BUILT INFORMATION	BENCH MARKS	SURVEY INFORMATION	ENGINEER'S SEAL
CONTRACTOR: New Concepts Inc. WORK: STORM DRAIN DATE: 7-15-94 INSPECTOR: [Signature] ACCEPTANCE BY: [Signature] DATE: 7-15-94 DRAWINGS: [Signature] DATE: 7-15-94 RECORDED BY: [Signature] DATE: 7-15-94	THE STATION MARK IS A STANDARD ACS BRASS TABLET, STAMPED "1-L21 RESET 1974" LOCATED 7.8 MILES EAST OF DOWNTOWN ALBUQUERQUE, AT THE INTERSECTION OF CENTRAL AVE. AND JUAN TABO BLVD. THE STATION IS ON THE MEDIAN STRIP OF CENTRAL AVE., 81' WEST OF THE CENTERLINE OF JUAN TABO BLVD. AND FLUSH WITH THE TOP OF CURB, SLD ELEV. 5534.63	DATE: 7-15-94 BY: [Signature] NO. 10/13/94	ENGINEER'S SEAL [Signature] [Stamp]

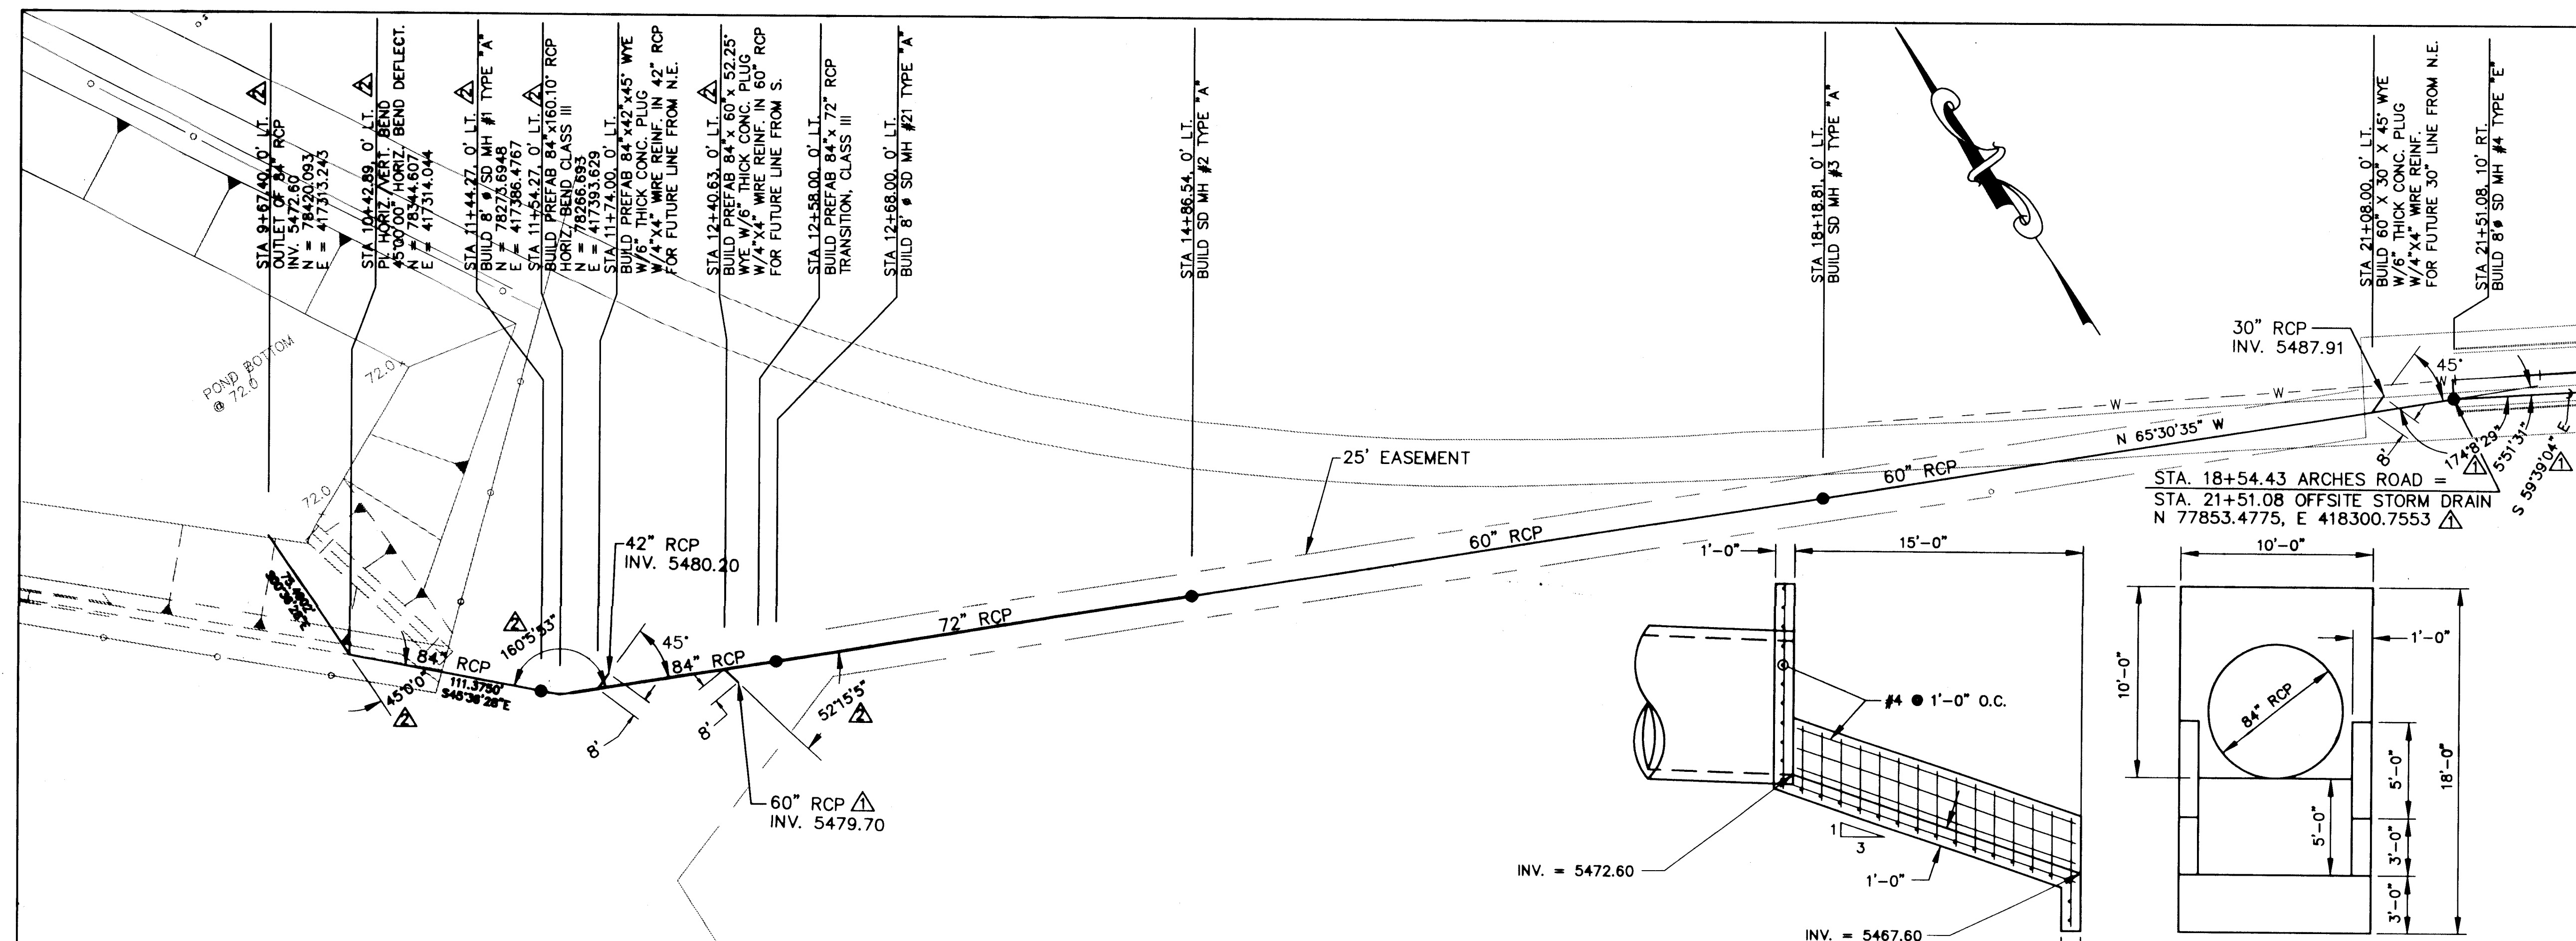


OFFSITE STORM DRAIN

STORM DRAIN CUT-OFF WALL

NO SCALE

SCALE:
HORIZ. 1" = 50'
VERT. 1" = 5'

- LEGEND**
- SD PROPOSED STORM DRAIN
 - PROPOSED MANHOLE
 - PROPOSED TYPE DOUBLE "A" STORM INLET
 - PROPOSED TYPE DOUBLE "C" STORM INLET

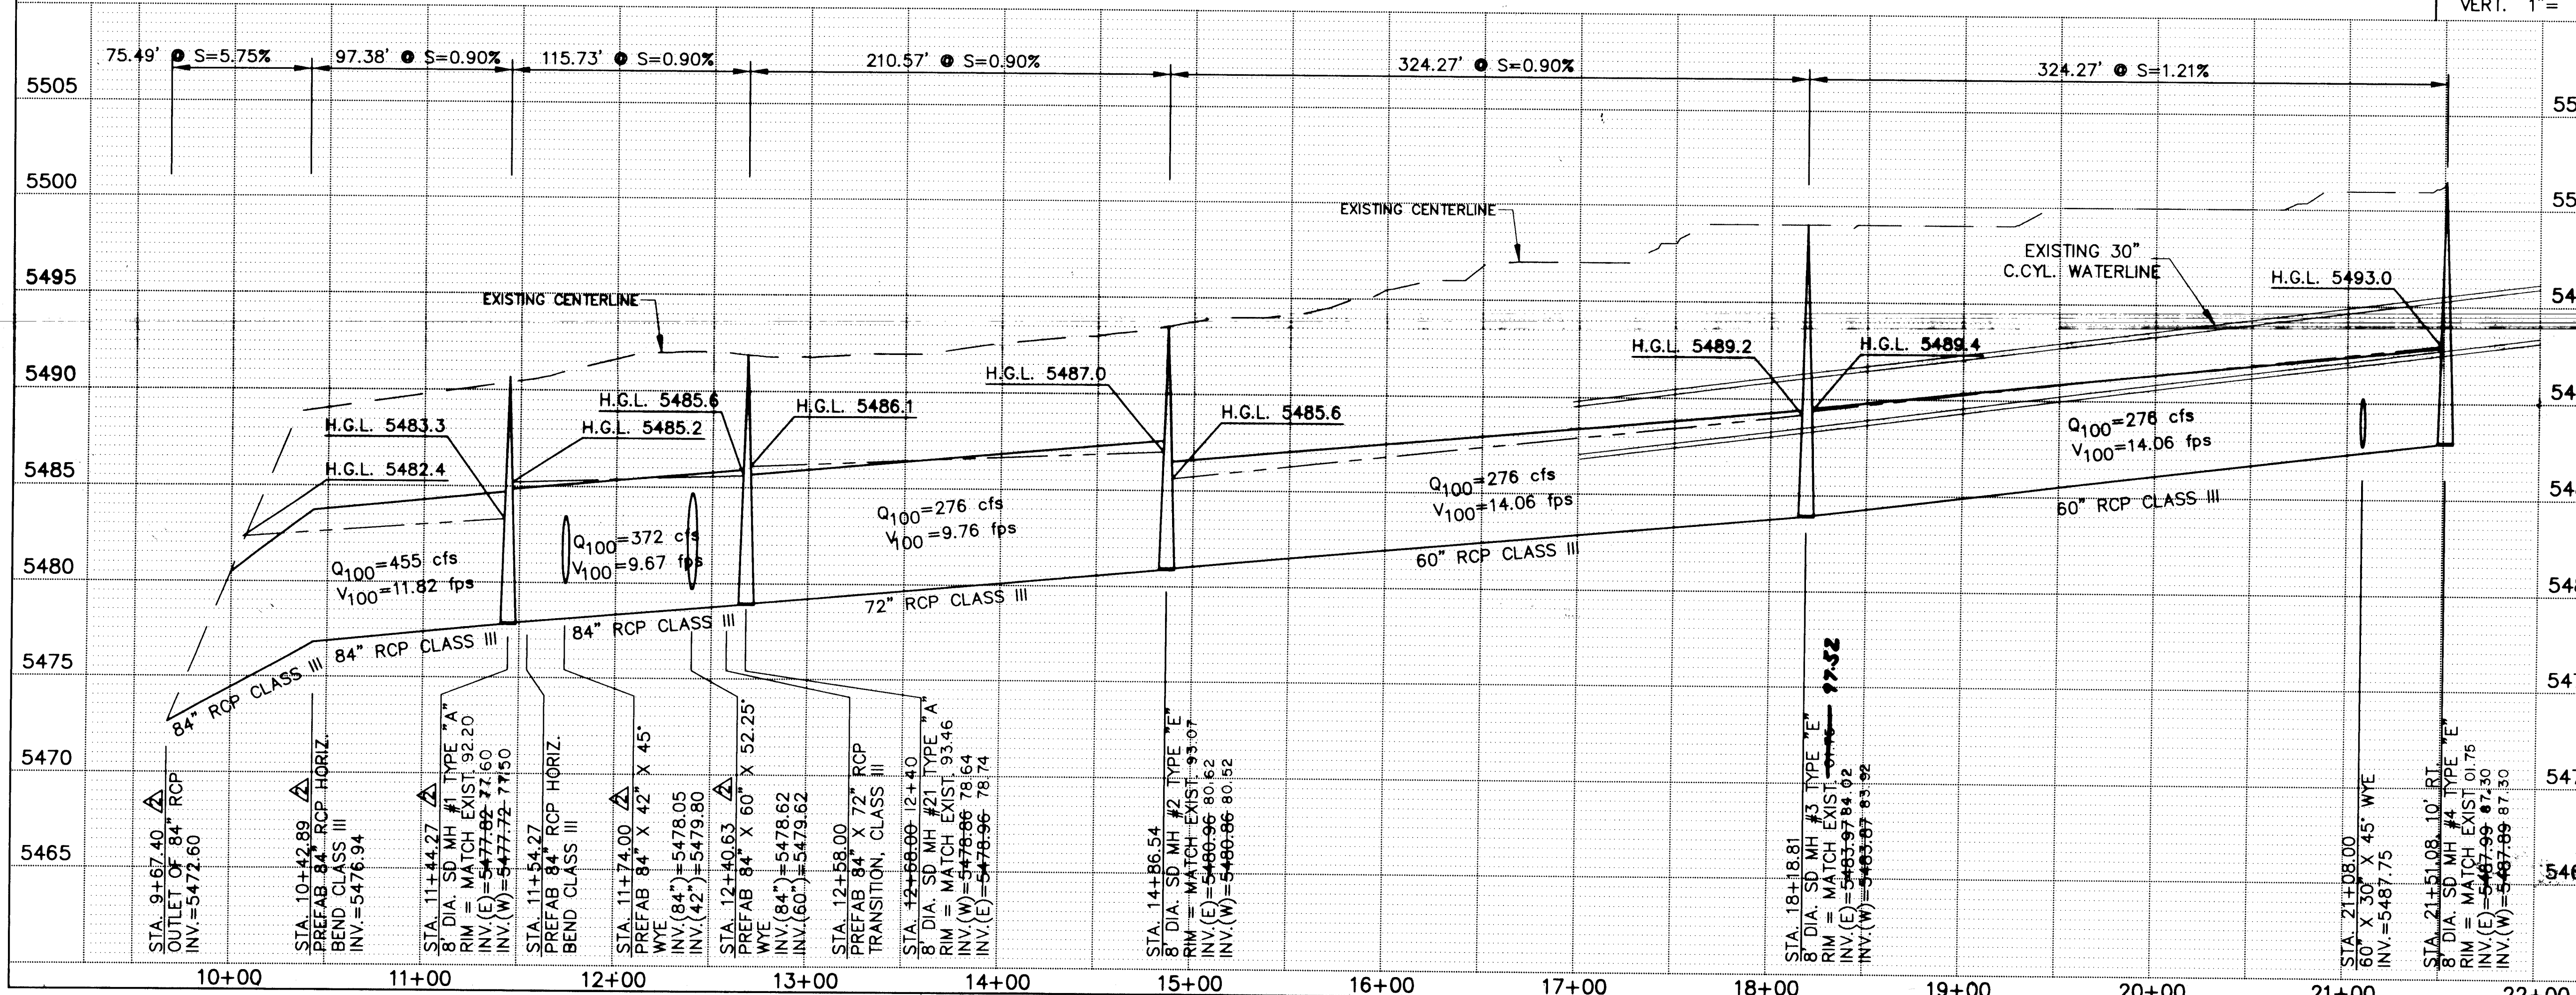

- ### STORM DRAIN NOTES
- STATIONING ALONG C. OF STREET UNLESS OTHERWISE NOTED.
 - STORM SEWER LINE LENGTHS COMPUTED FROM MH C. TO MH C.
 - SLOPES ARE COMPUTED INVERT TO INVERT. MH RIM ELEVATIONS GIVEN ARE APPROXIMATE. CONTRACTOR SHALL ADJUST ALL RIMS TO FINAL GRADE.
 - CONTRACTOR IS RESPONSIBLE FOR COORDINATION WITH UTILITY COMPANIES.
 - CONTRACTOR SHALL VERIFY ALL EXISTING UTILITIES AND UTILITY CONNECTIONS PRIOR TO BEGINNING CONSTRUCTION. SHOULD A CONFLICT EXIST OR DESIGN REVISIONS BE REQUIRED FOR ANY REASON, THE CONTRACTOR SHALL NOTIFY THE ENGINEER AND ALLOW SUFFICIENT TIME FOR DESIGN REVISIONS SO AS TO NOT DELAY THE CONSTRUCTION SCHEDULE.
 - INLET INVERTS AND CONNECTOR PIPE SLOPES AND LENGTHS ARE COMPUTED FROM STA./OFFSET TO STA./OFFSET SHOWN ON PLANS.

AS BUILT INFORMATION			
CONTRACTOR	DATE	COA	DATE
New Concepts Inc.			


BENCH MARKS			
STATION	MARK	DATE	COA
11-121	RESET 1974		

SURVEY INFORMATION			
FIELD NOTES		DATE	
NO.	BY	DATE	BY

ENGINEER'S SEAL			
DATE	BY	REMARKS	DESIGN
10/94	STORM OUTLET ALIGNMENT & DISCHARGE		
8/94	ADDED BRG. & DEF. ANGLES		
NO. DATE			
DESIGNED BY: ETS	DATE: 5/94		
DRAWN BY:	DATE: 5/94		
CHECKED BY: JVD	DATE: 5/94		

CITY OF ALBUQUERQUE PUBLIC WORKS DEPARTMENT ENGINEERING GROUP			
TITLE: WILLOW WOOD - UNIT IV OFFSITE STORM DRAIN STORM DRAIN PLAN & PROFILE			
APPROVALS	ENGINEER	DATE	APPROVALS
D.R.C. Chair	7-15-99	Water	
Transportation	7-01-99	Waste Water	
Hydrology	7-19-99		
ENGINEER	DATE		
N/A RUC	7-8-99		
N/A RUC	7-8-99		


DRAWING NO.	MAP NO.	SHEET OF
4604.93	L-21-Z	35 40

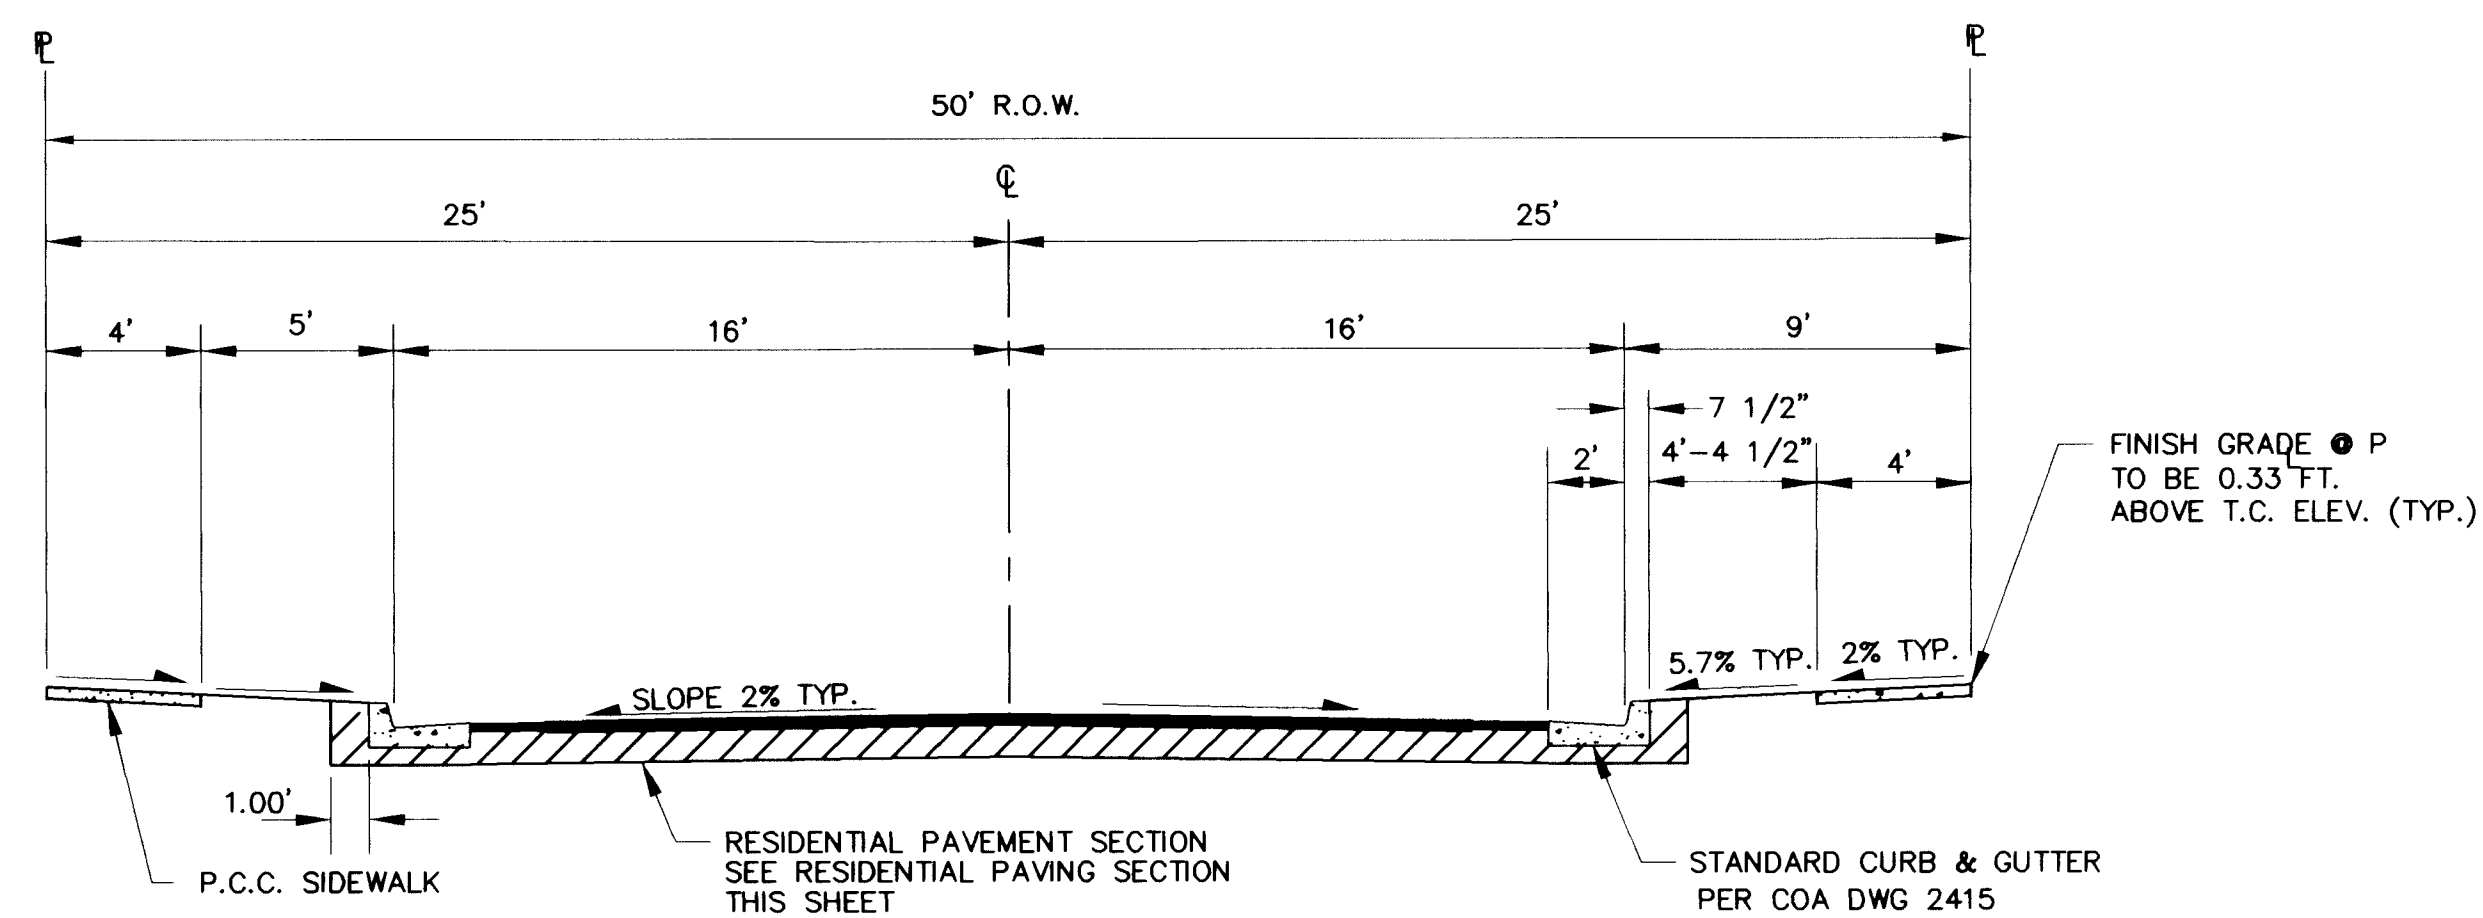

TYPICAL RESIDENTIAL STREET SECTION - 50' ROW


ARCHES ROAD

SCALE: 1"=5'

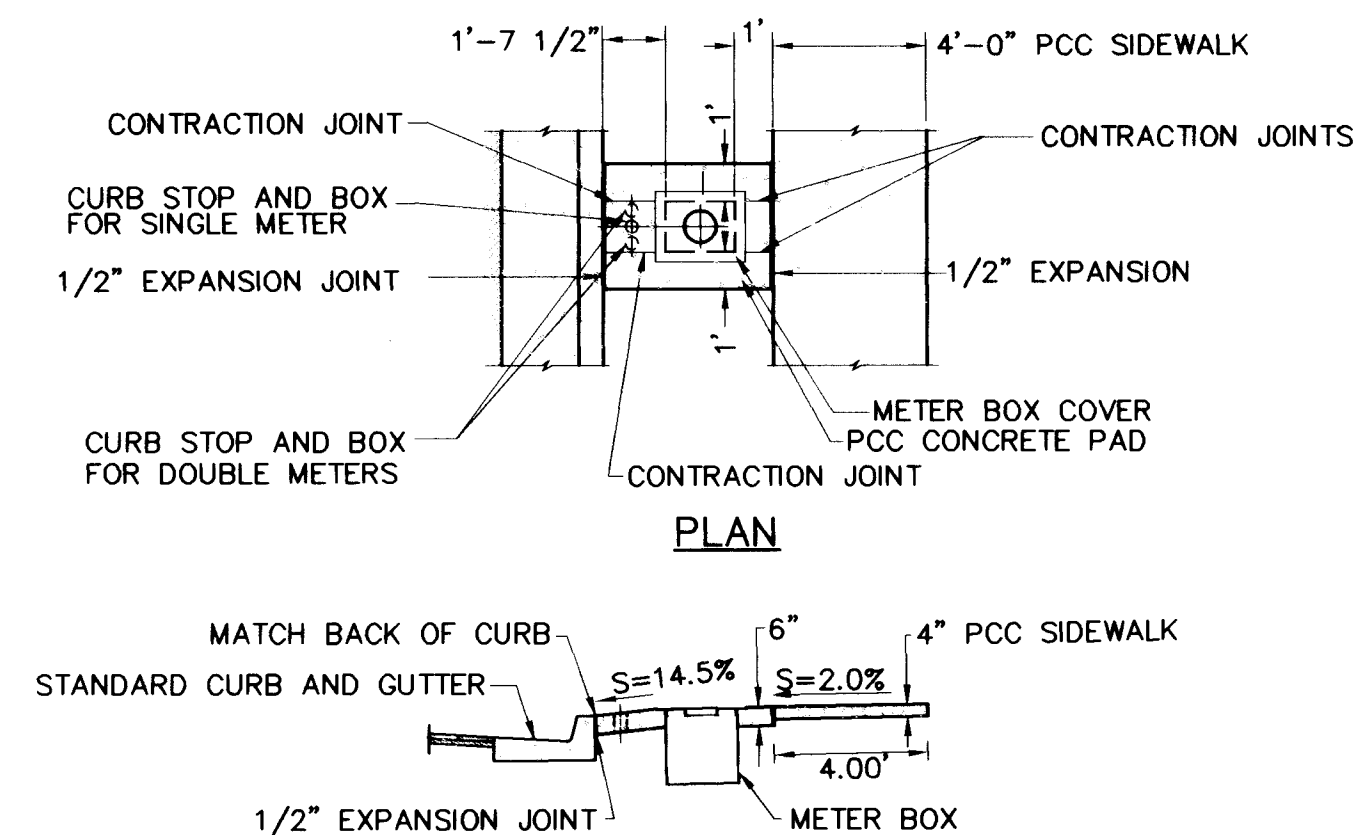


WATER METER INSTALLATION DETAIL - 9' FROM ROW

1"=5'

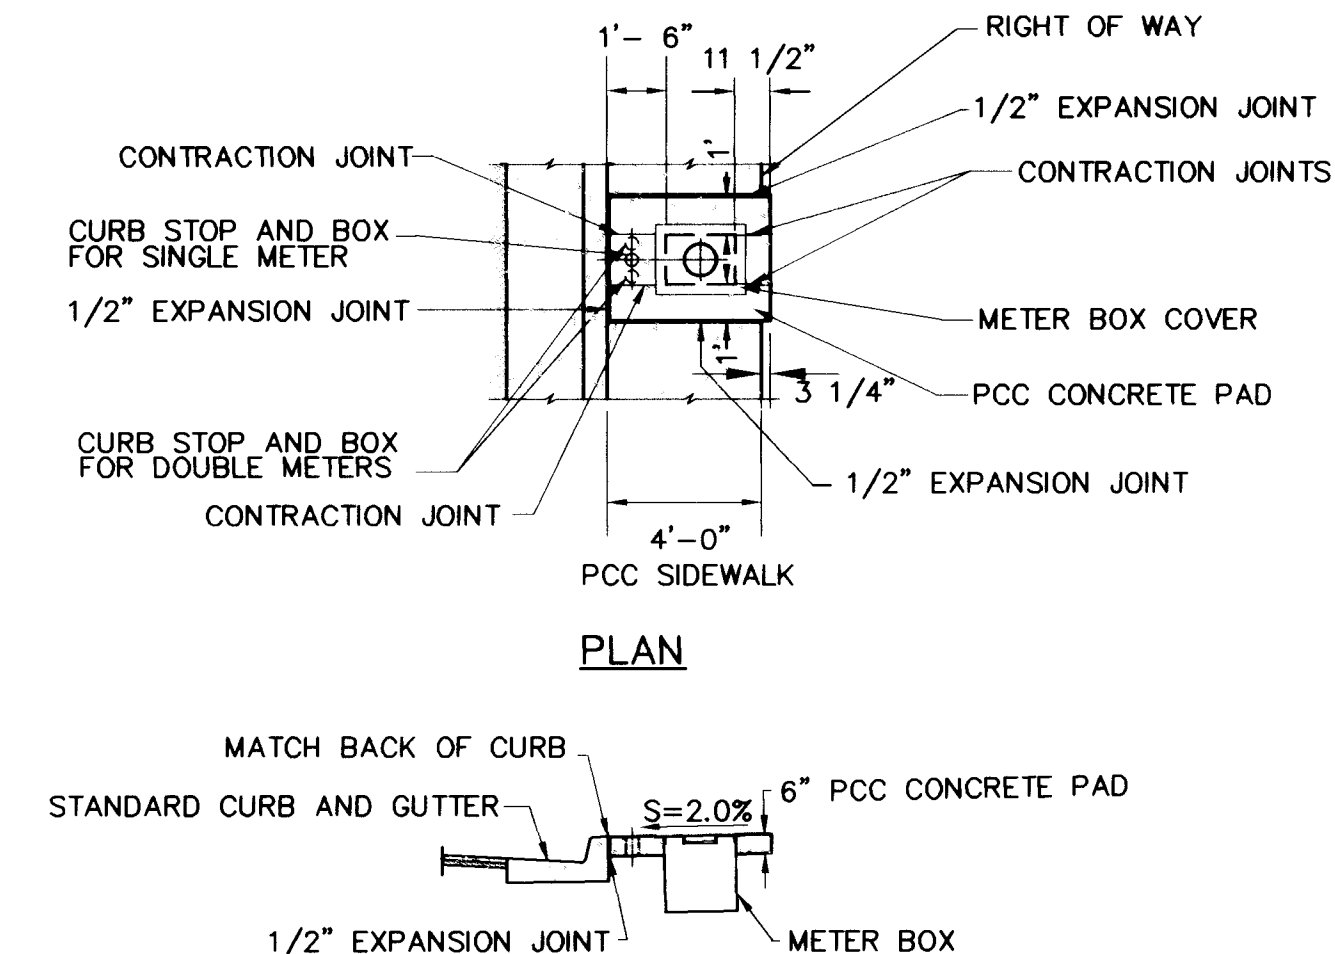

WATER METER INSTALLATION DETAIL - 4'-7 1/2' FROM ROW


1"=5'

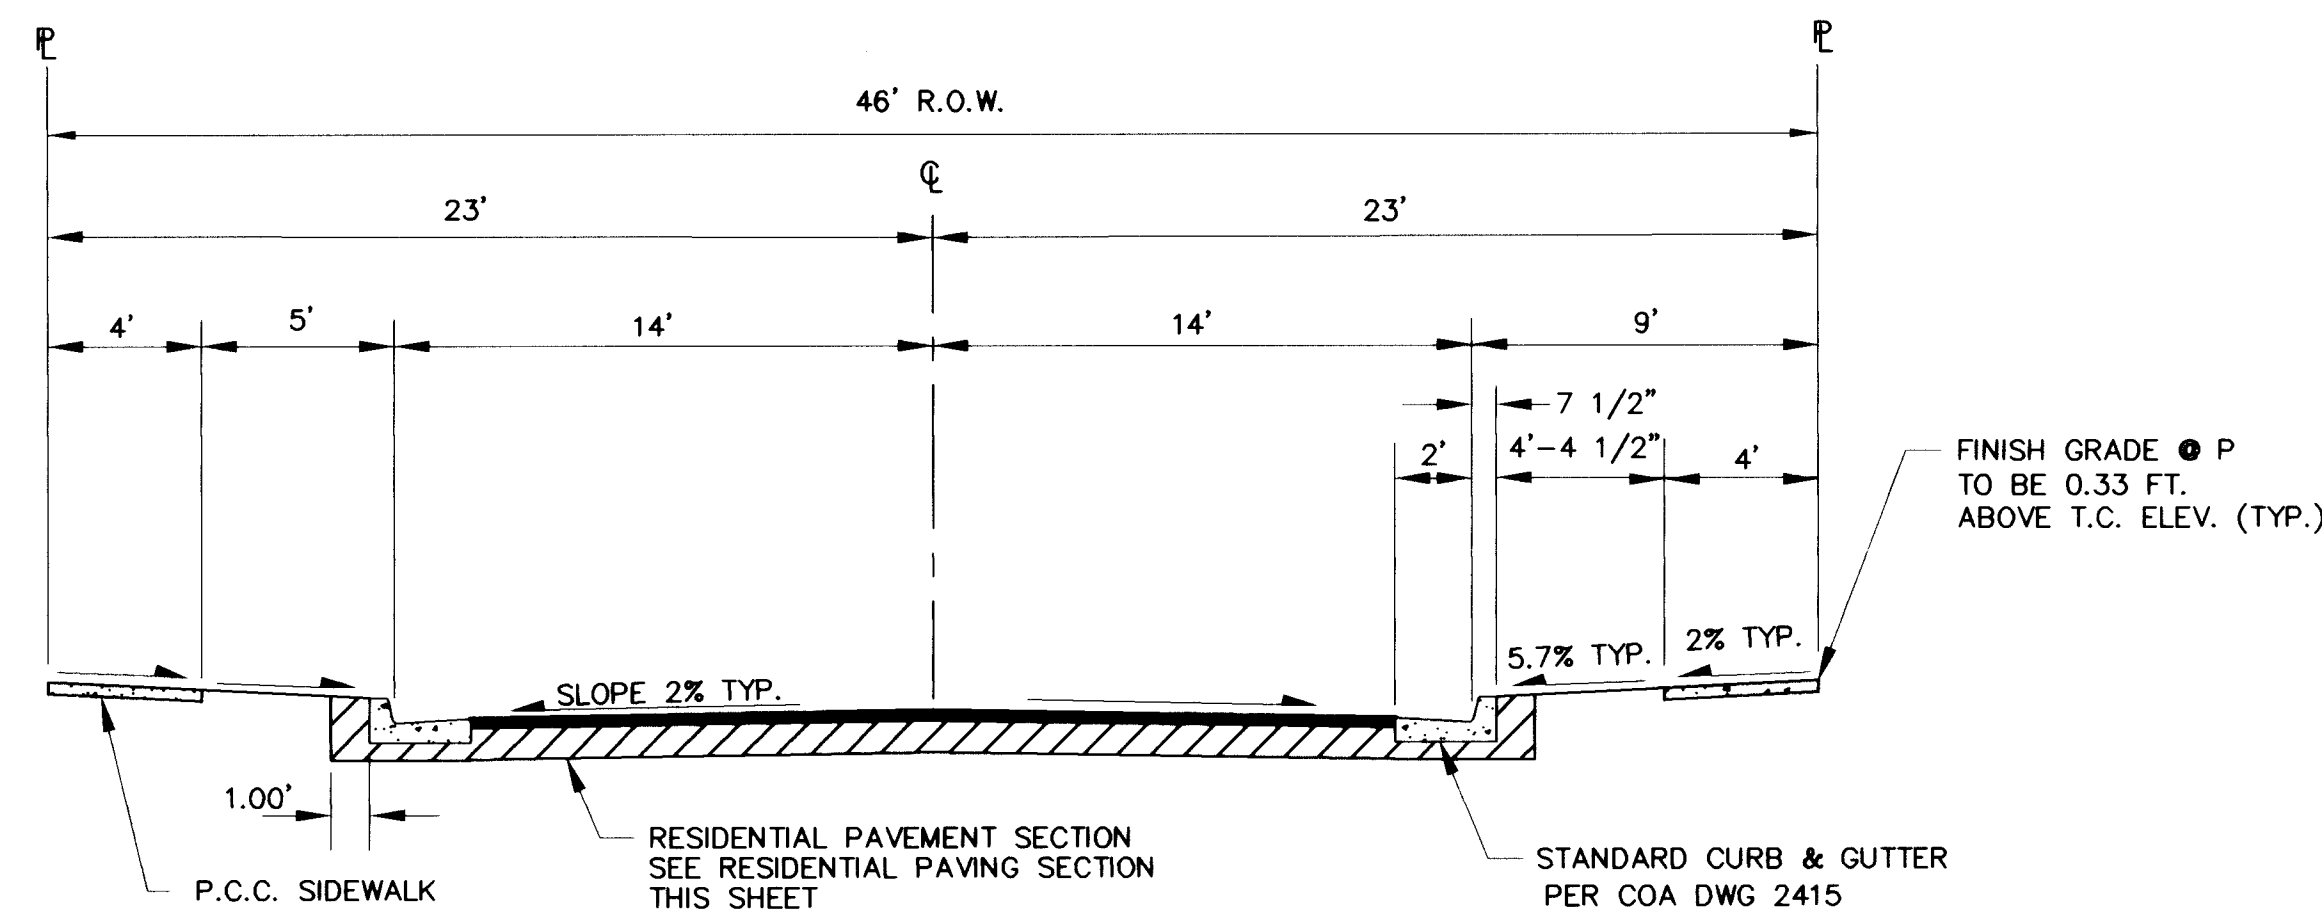

TYPICAL RESIDENTIAL STREET SECTION - 46' ROW

ARCHES ROAD
SALINAS STREET
JEWEL CAVE ROAD
WIND RIVER STREET
KINGS CANYON ROAD
CANYONLANDS ROAD


SCALE: 1"=5'

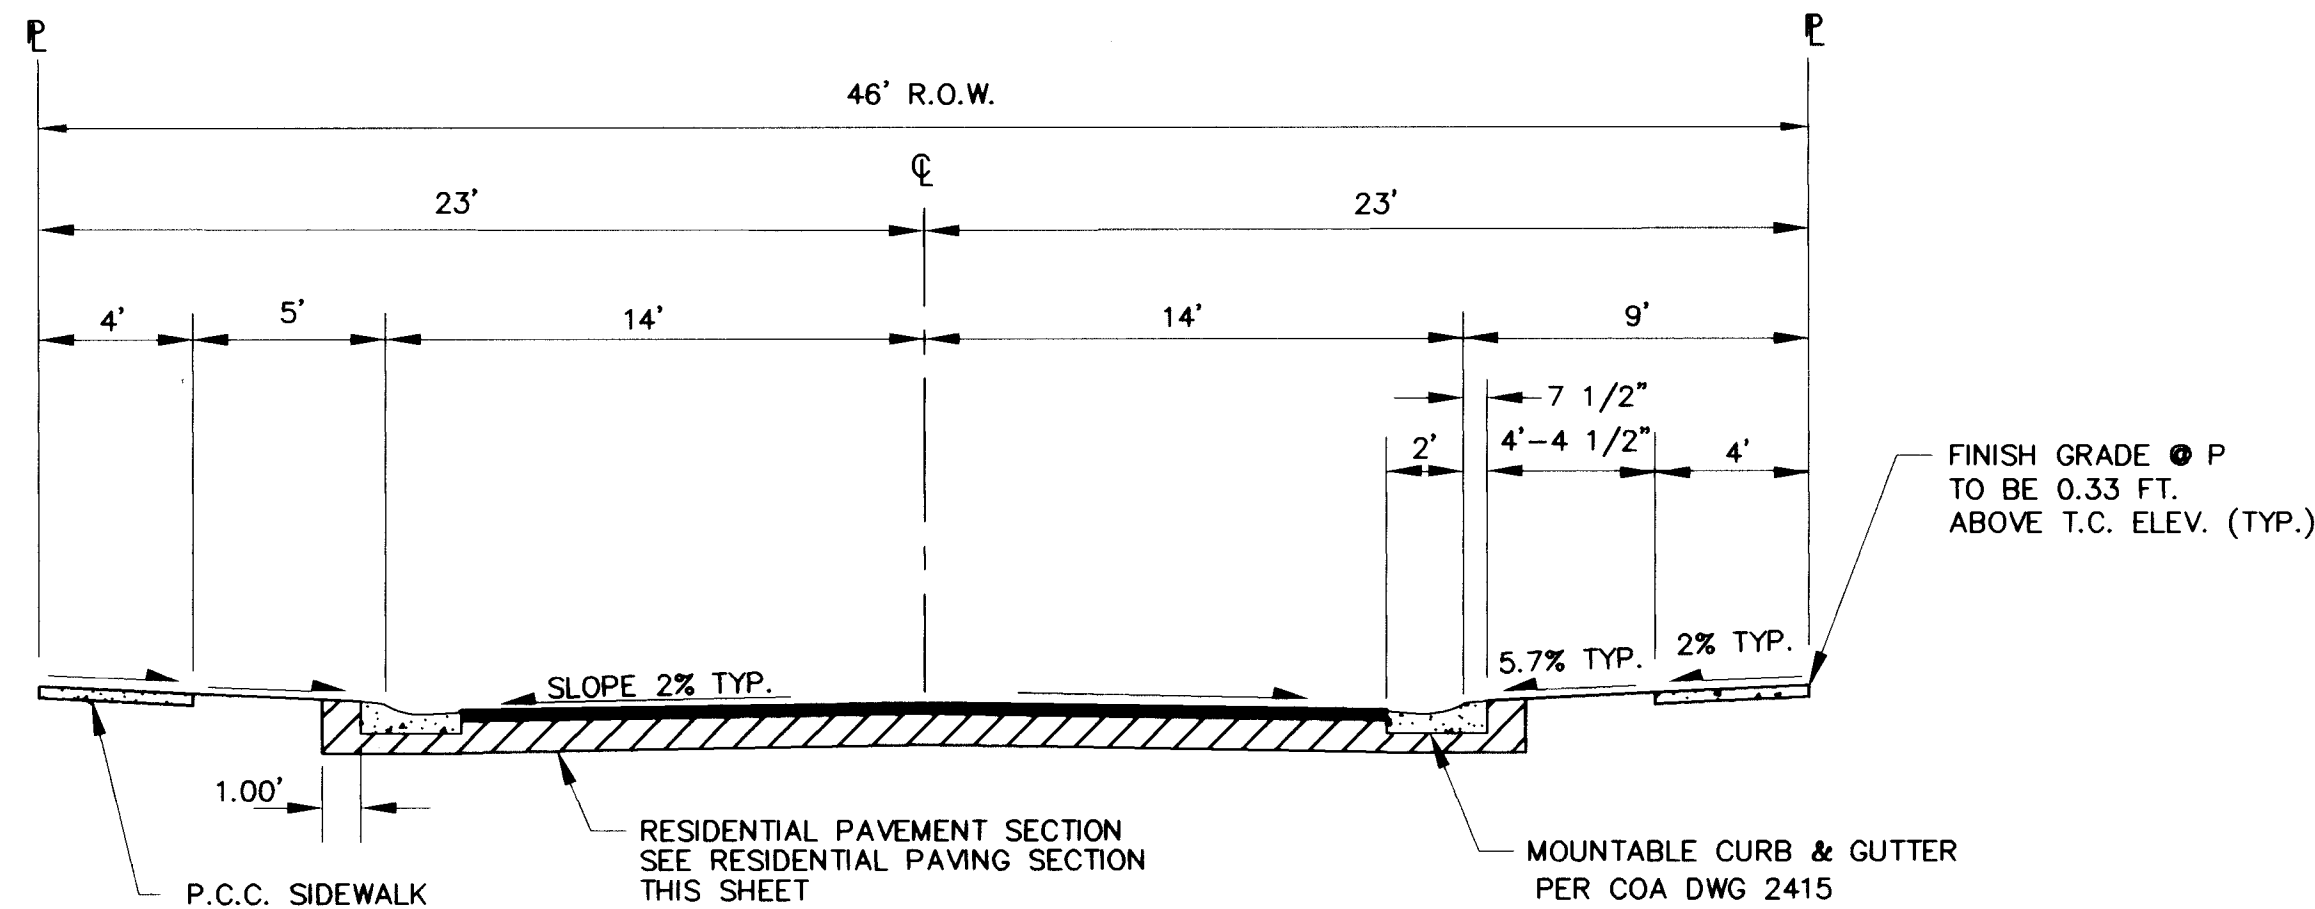

TYPICAL RESIDENTIAL STREET SECTION - 46' ROW

CANYONLANDS COURT


SCALE: 1"=5'

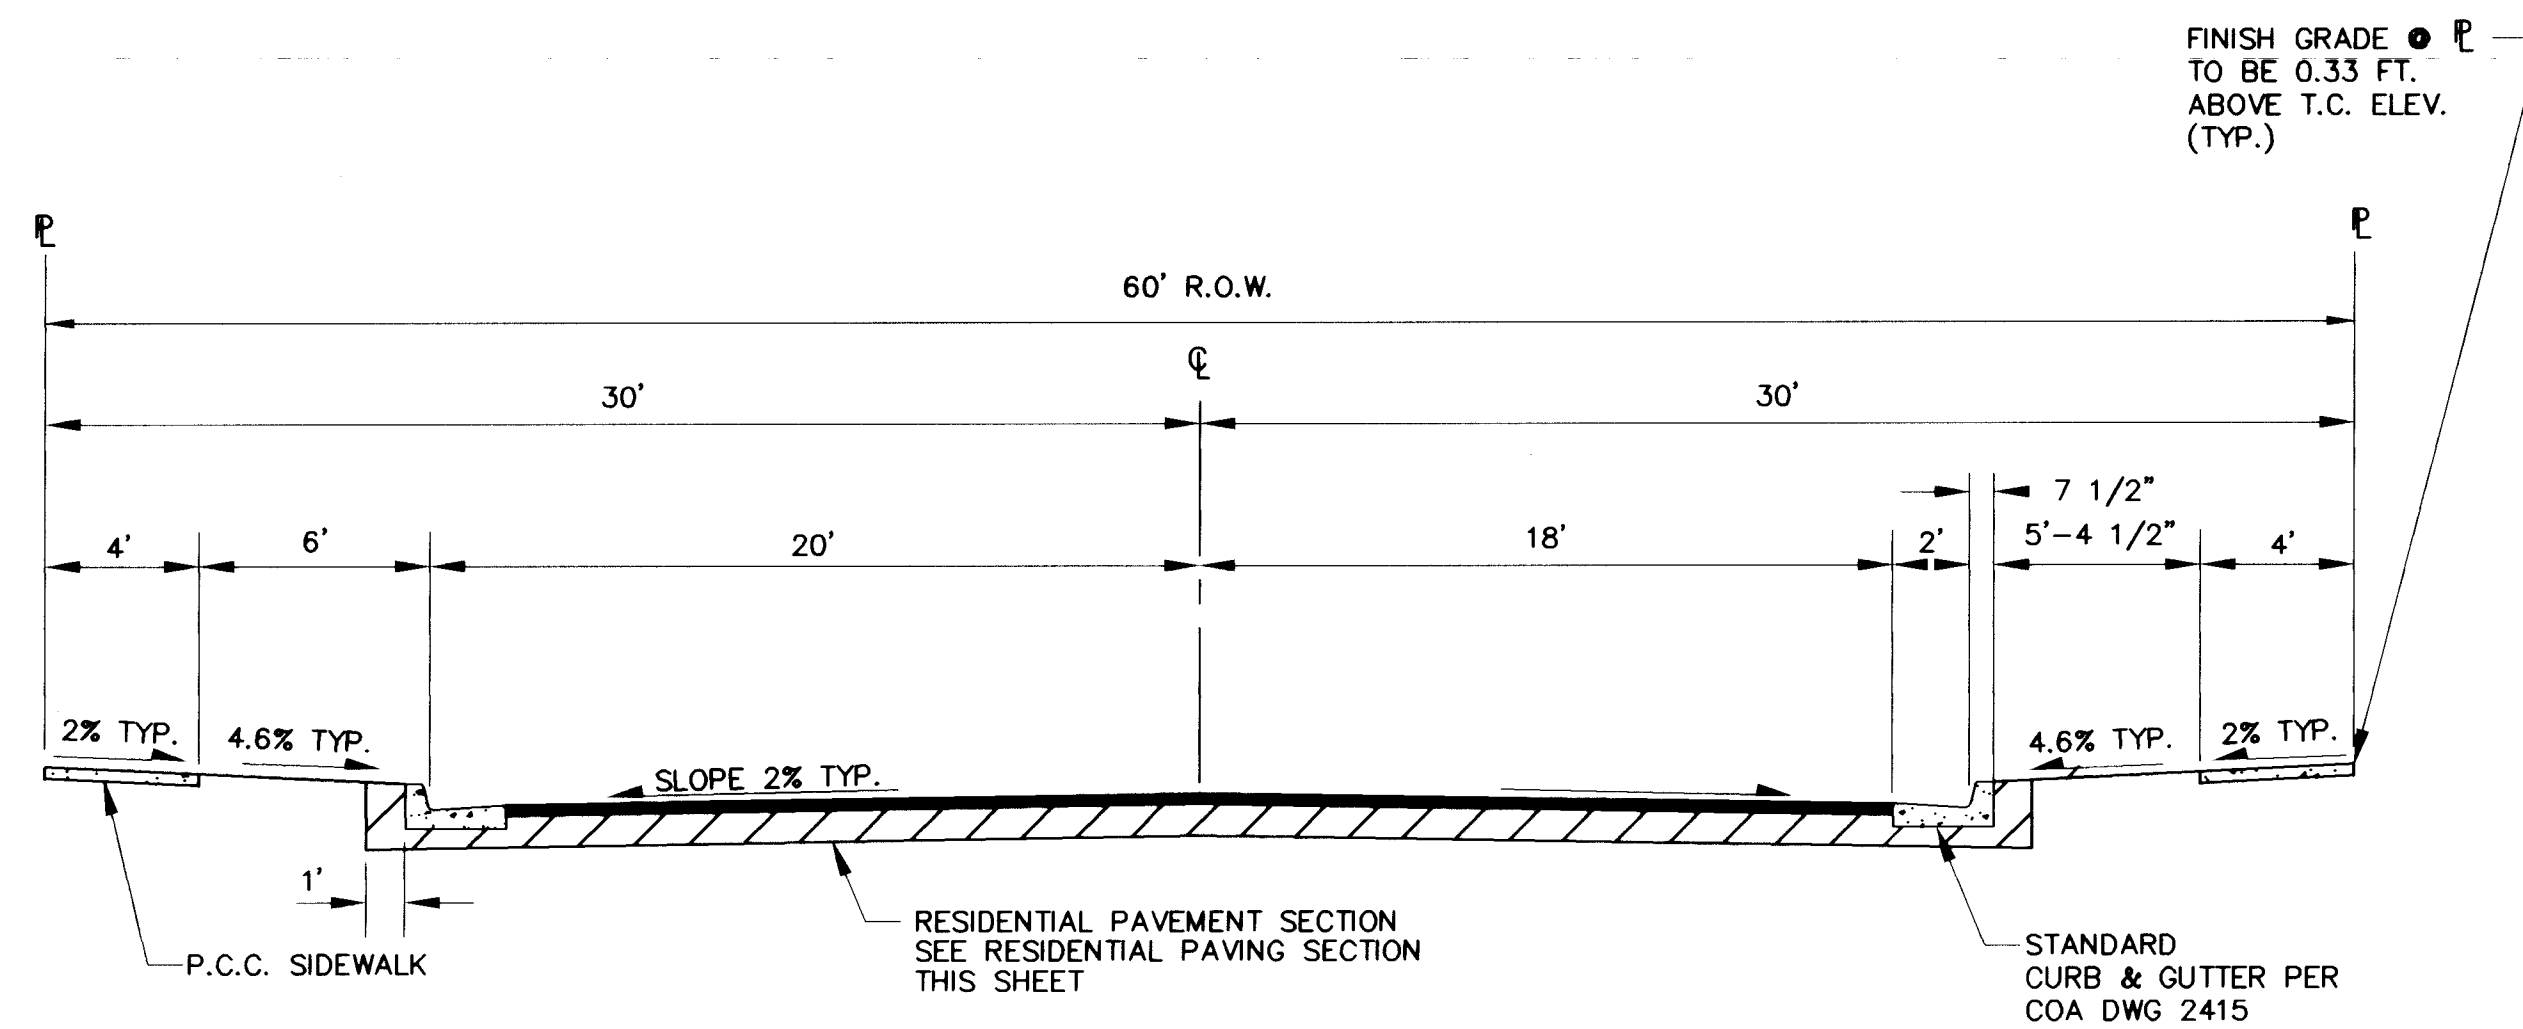

RESIDENTIAL STREET SECTION D-D

TONY SANCHEZ DRIVE


1"=5'

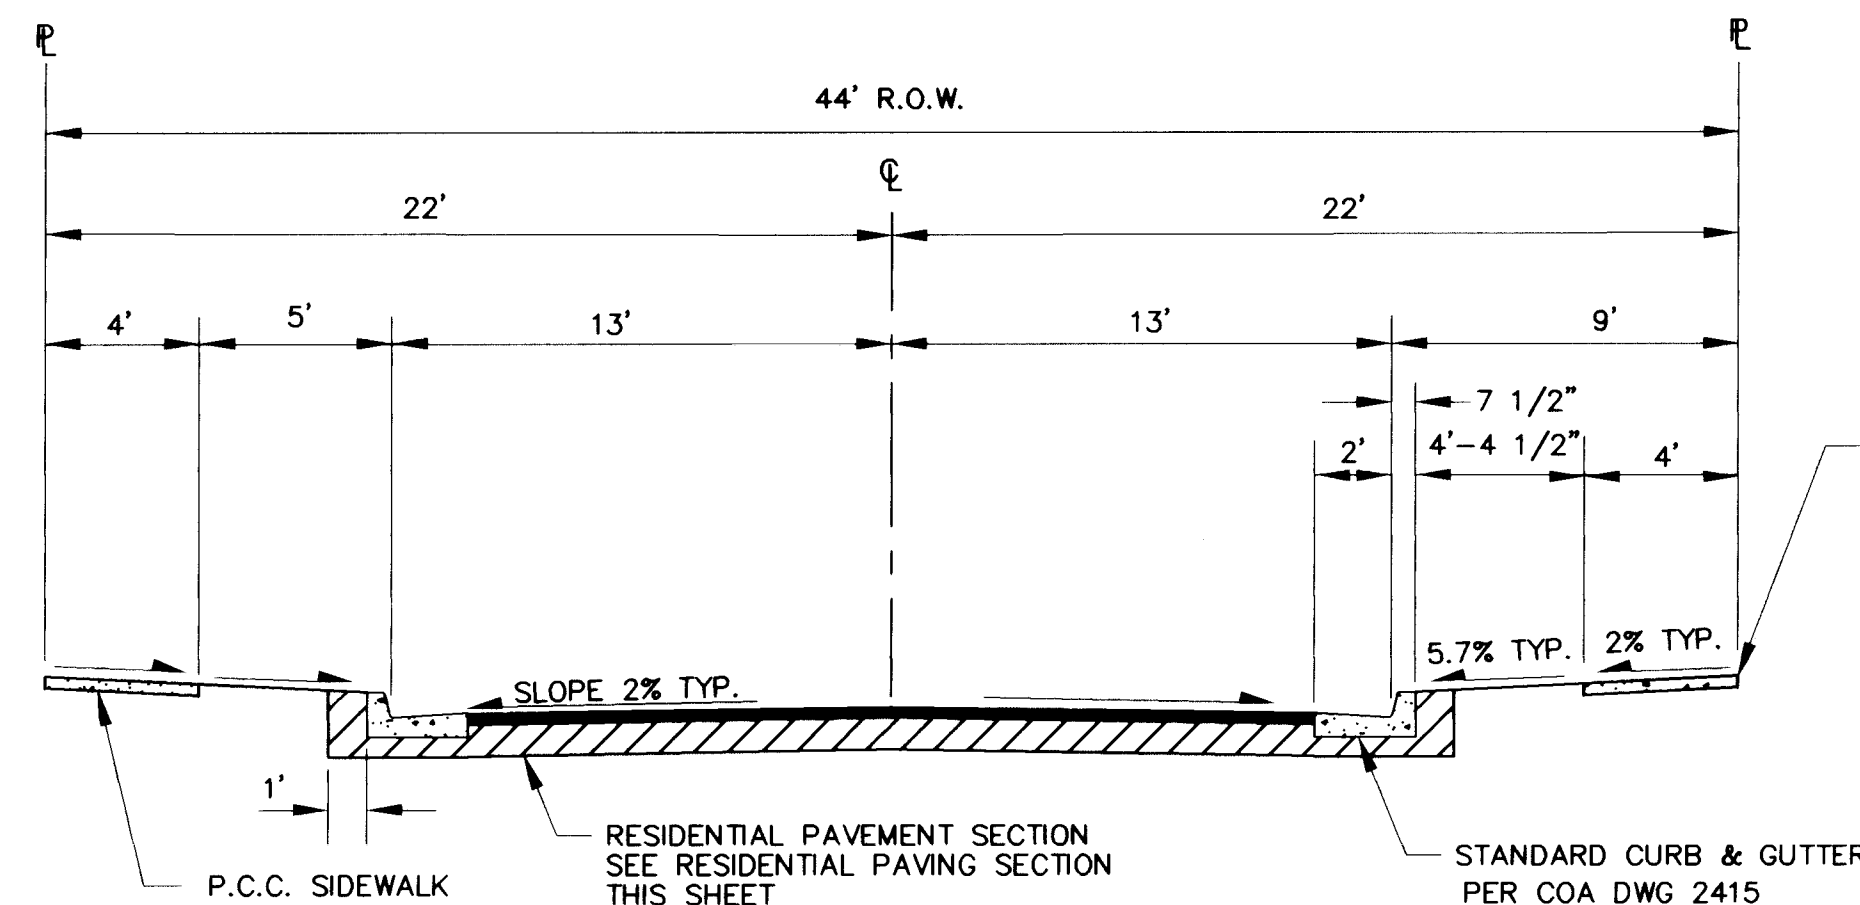

RESIDENTIAL STREET SECTION - 44' ROW

JEWEL CAVE ROAD
STEAMBOAT STREET

SCALE: 1"=5'

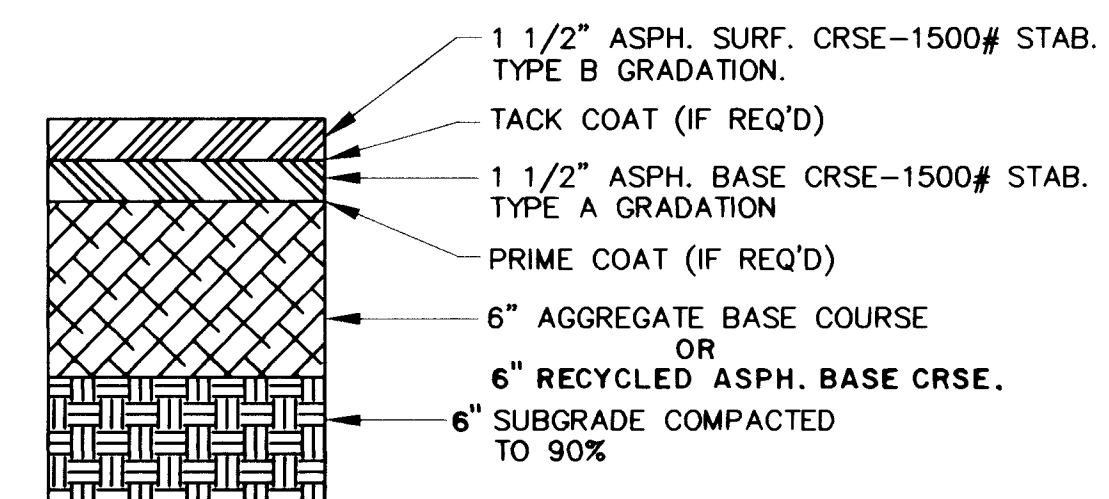

RESIDENTIAL PAVING SECTION




NTS


1 2 3 4 5 6 7 8 9 10 11 12 13 14 15
20-1416149.93131915



AVID ENGINEERING, INC.
Civil • Structural • Transportation
6100 Seagull SE - Suite 102
Albuquerque, NM 87109 - (505) 881-5357

CITY OF ALBUQUERQUE PUBLIC WORKS DEPARTMENT ENGINEERING GROUP					
TITLE: WILLOW WOOD - UNIT IV STREET PAVING SECTIONS AND DETAILS					
APPROVALS	ENGINEER	DATE	APPROVALS	ENGINEER	DATE
D.R.C. Chair	<i>[Signature]</i>	7-15-94	Water	N/A RWK	7-8-94
Transportation	<i>[Signature]</i>	7-21-94	Waste Water	N/A RWK	7-8-94
Hydrology	<i>[Signature]</i>	7-1-94			
DRAWING NO.	4604.93	MAP NO. L-21-Z	SHEET 36	OF 40	


SCANNED BY LASON

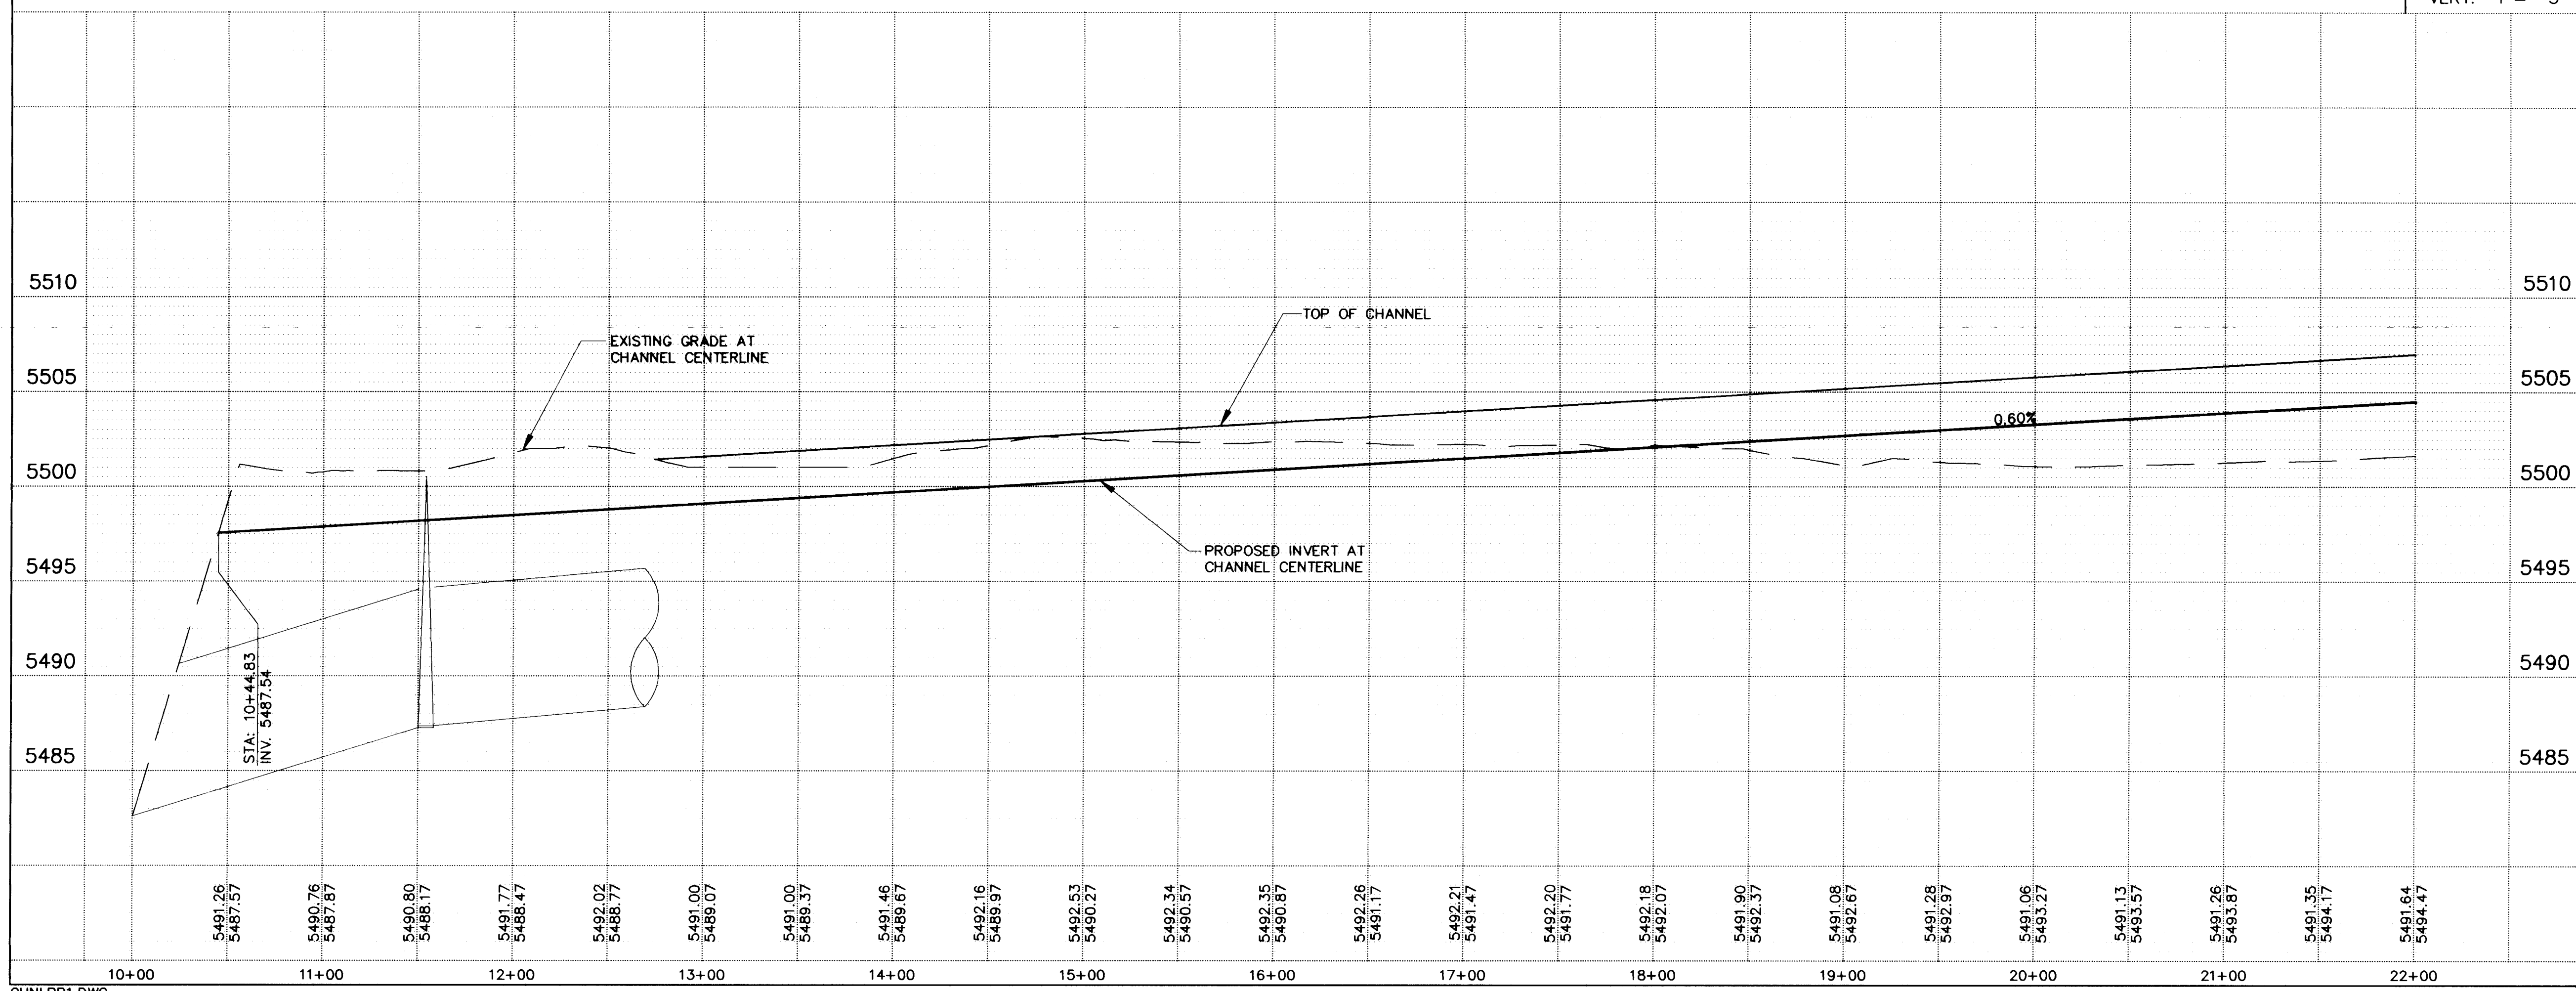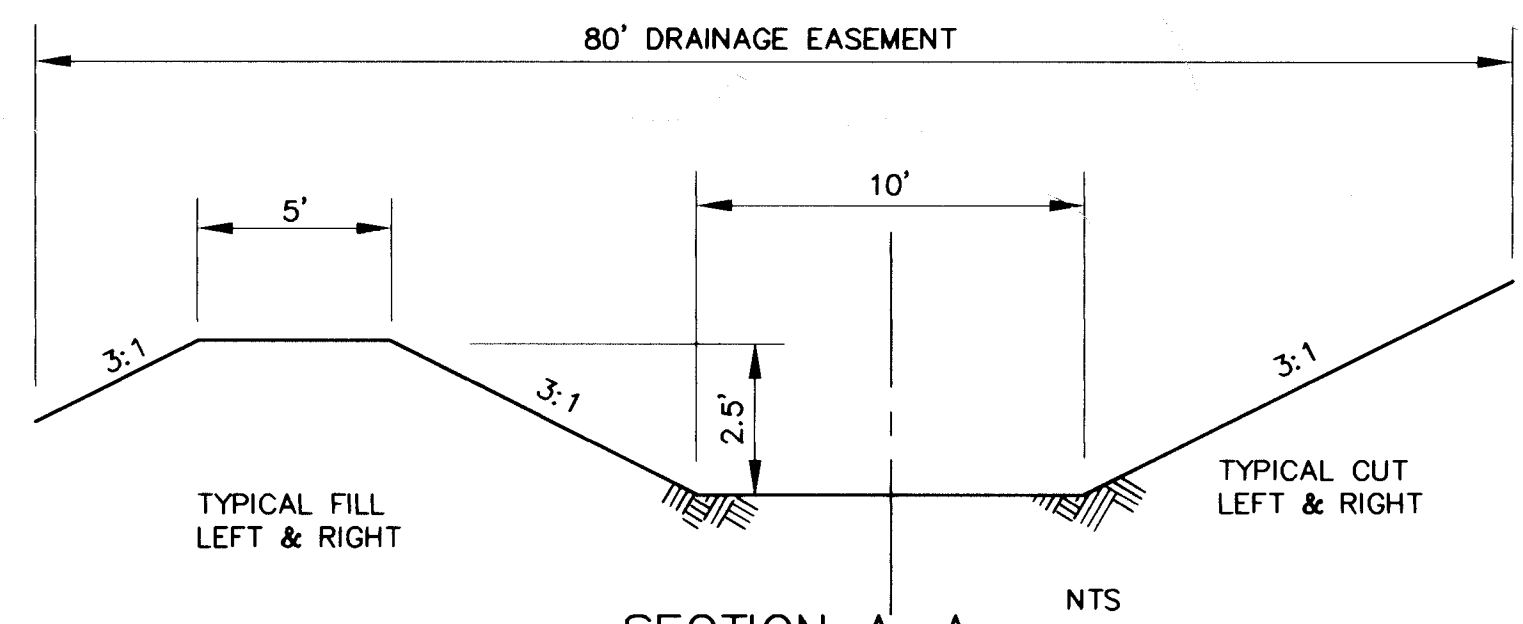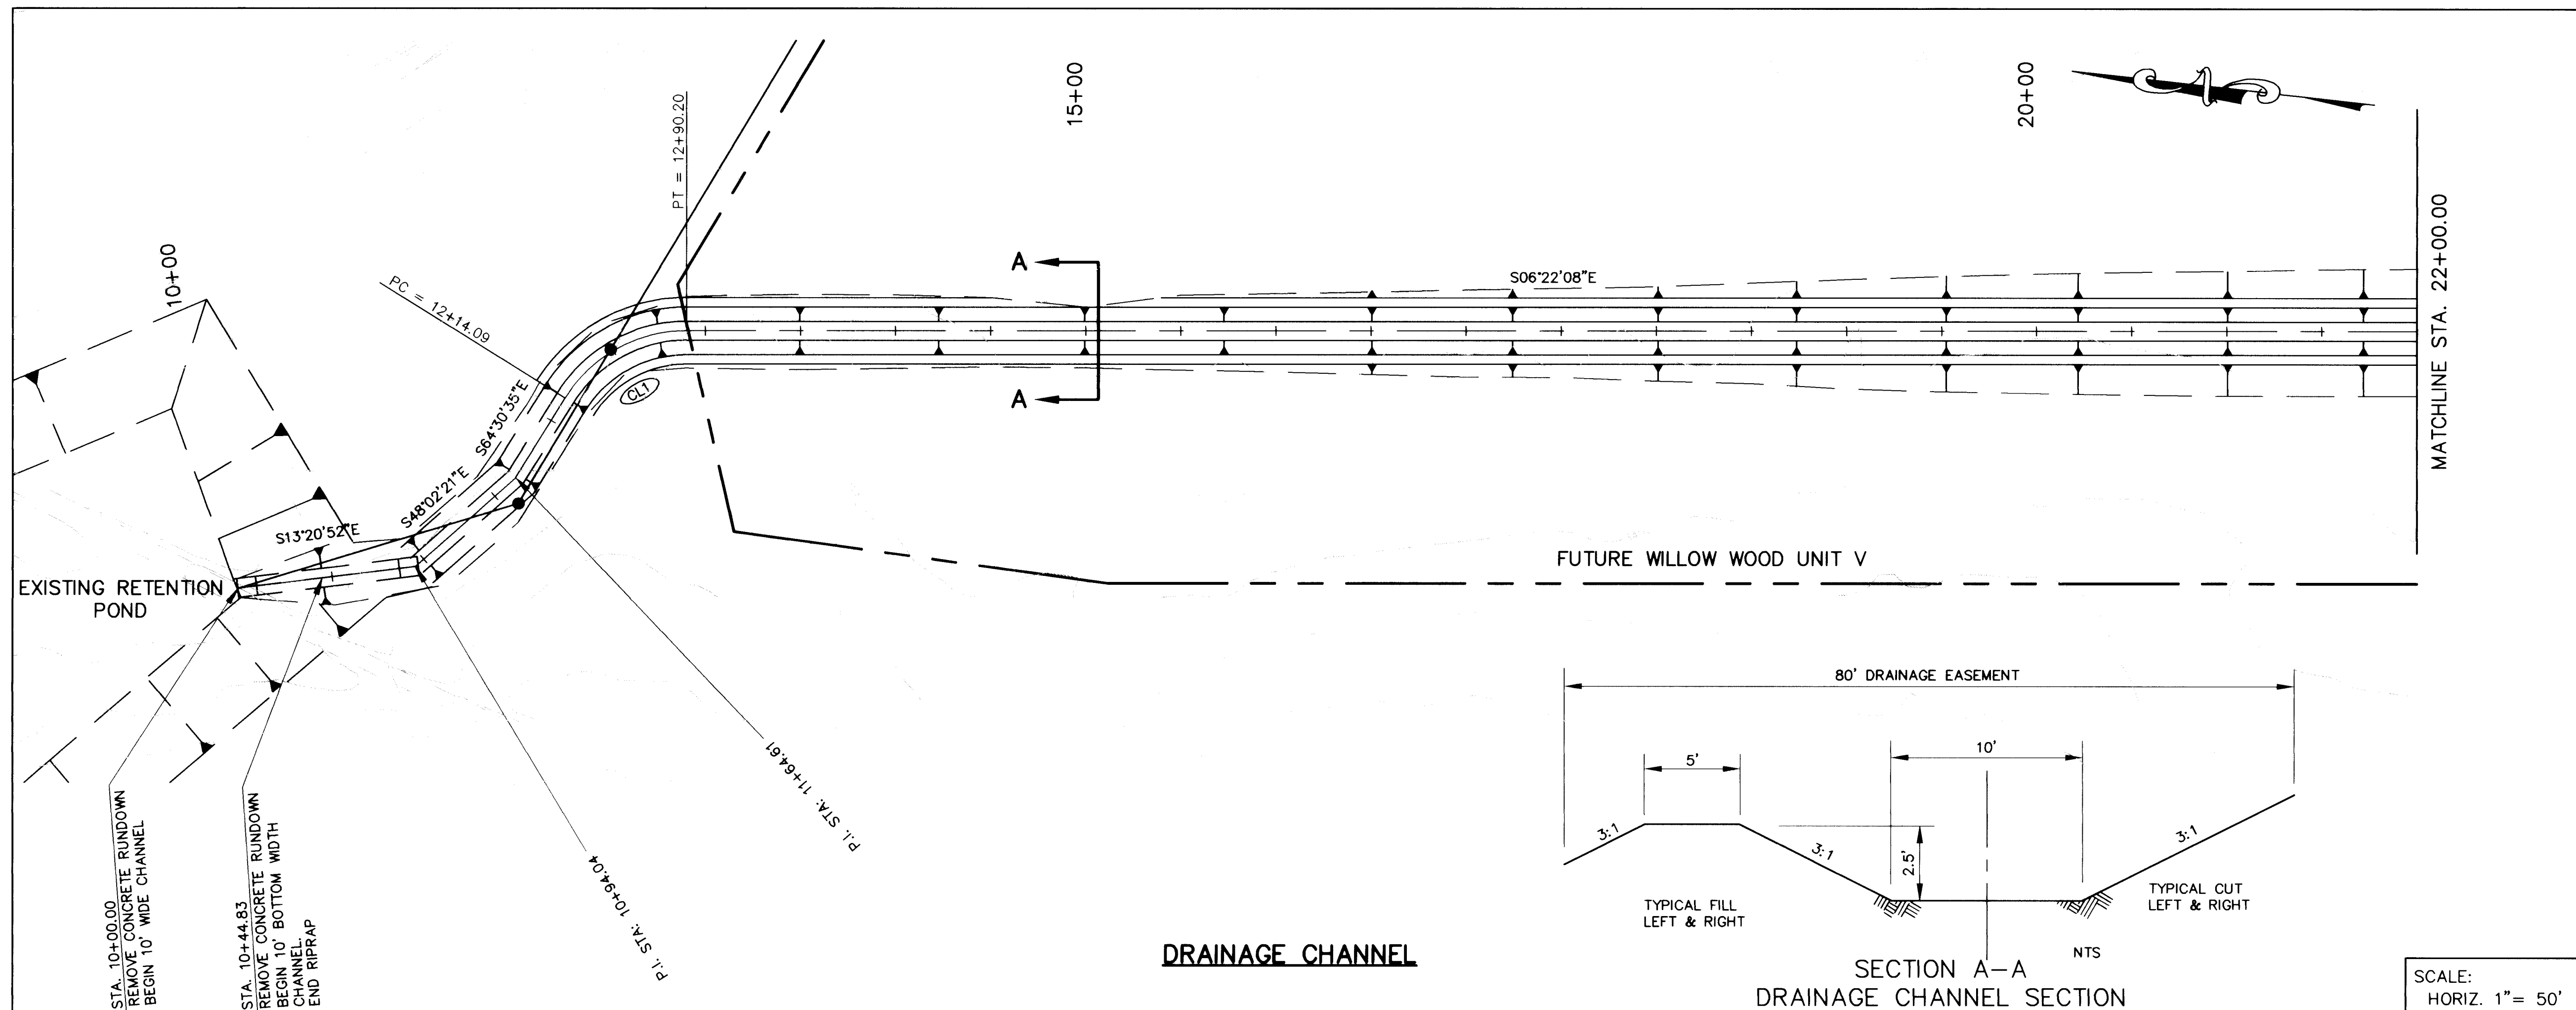

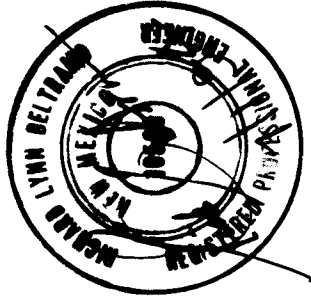
GENERAL NOTES 1. ALL STATIONING AND OFFSET DIMENSIONS ARE BASED ON CENTERLINE OF EASEMENT 2. ALL ELEVATIONS ARE AT CHANNEL INVERT																										
TEMPORARY CHANNEL CENTERLINE CURVE DATA CURVE RADIUS LENGTH TANGENT DELTA (CL) 75.00' 76.11' 41.69' 58'08"27"																										
ENGINEER'S SEAL 																										
SCANNED BY LASON 20-46049-193 3795																										
AVID ENGINEERING, INC. Civil • Structural • Transportation 6100 Seagull St. NE - Suite 102 Albuquerque, NM 87109 - (505) 881-5357																										
CITY OF ALBUQUERQUE PUBLIC WORKS DEPARTMENT ENGINEERING GROUP																										
TITLE: WILLOW WOOD - UNIT IV DRAINAGE CHANNEL PLAN AND PROFILE																										
<table><tr><td>APPROVALS</td><td>ENGINEER</td><td>DATE</td><td>APPROVALS</td><td>ENGINEER</td><td>DATE</td></tr><tr><td>D.R.C. Chair</td><td><i>[Signature]</i></td><td>7-15-94</td><td>Water</td><td><i>[Signature]</i></td><td>7-8-94</td></tr><tr><td>Transportation</td><td><i>[Signature]</i></td><td>7-01-94</td><td>Waste Water</td><td><i>[Signature]</i></td><td>7-8-94</td></tr><tr><td>Hydrology</td><td><i>[Signature]</i></td><td>7-1-94</td><td></td><td></td><td></td></tr></table>			APPROVALS	ENGINEER	DATE	APPROVALS	ENGINEER	DATE	D.R.C. Chair	<i>[Signature]</i>	7-15-94	Water	<i>[Signature]</i>	7-8-94	Transportation	<i>[Signature]</i>	7-01-94	Waste Water	<i>[Signature]</i>	7-8-94	Hydrology	<i>[Signature]</i>	7-1-94			
APPROVALS	ENGINEER	DATE	APPROVALS	ENGINEER	DATE																					
D.R.C. Chair	<i>[Signature]</i>	7-15-94	Water	<i>[Signature]</i>	7-8-94																					
Transportation	<i>[Signature]</i>	7-01-94	Waste Water	<i>[Signature]</i>	7-8-94																					
Hydrology	<i>[Signature]</i>	7-1-94																								
<table><tr><td>DRAWING NO.</td><td>4604.93</td><td>MAP NO.</td><td>L-21-Z</td><td>SHEET</td><td>37</td><td>OF</td><td>40</td></tr></table>			DRAWING NO.	4604.93	MAP NO.	L-21-Z	SHEET	37	OF	40																
DRAWING NO.	4604.93	MAP NO.	L-21-Z	SHEET	37	OF	40																			

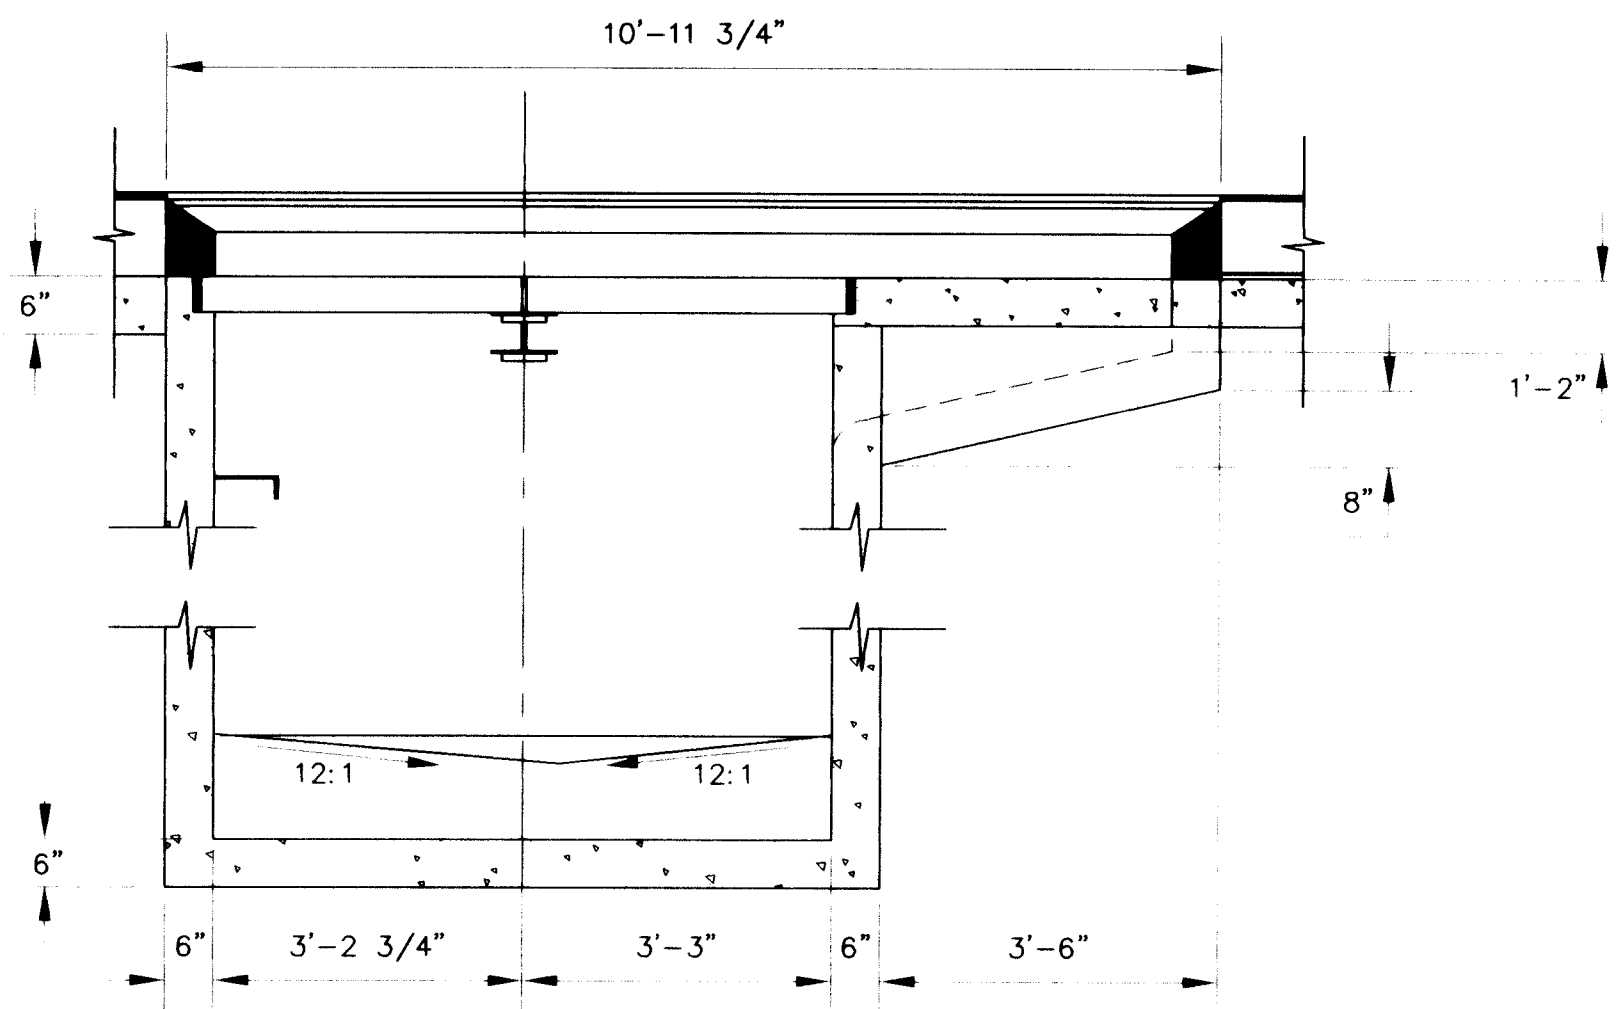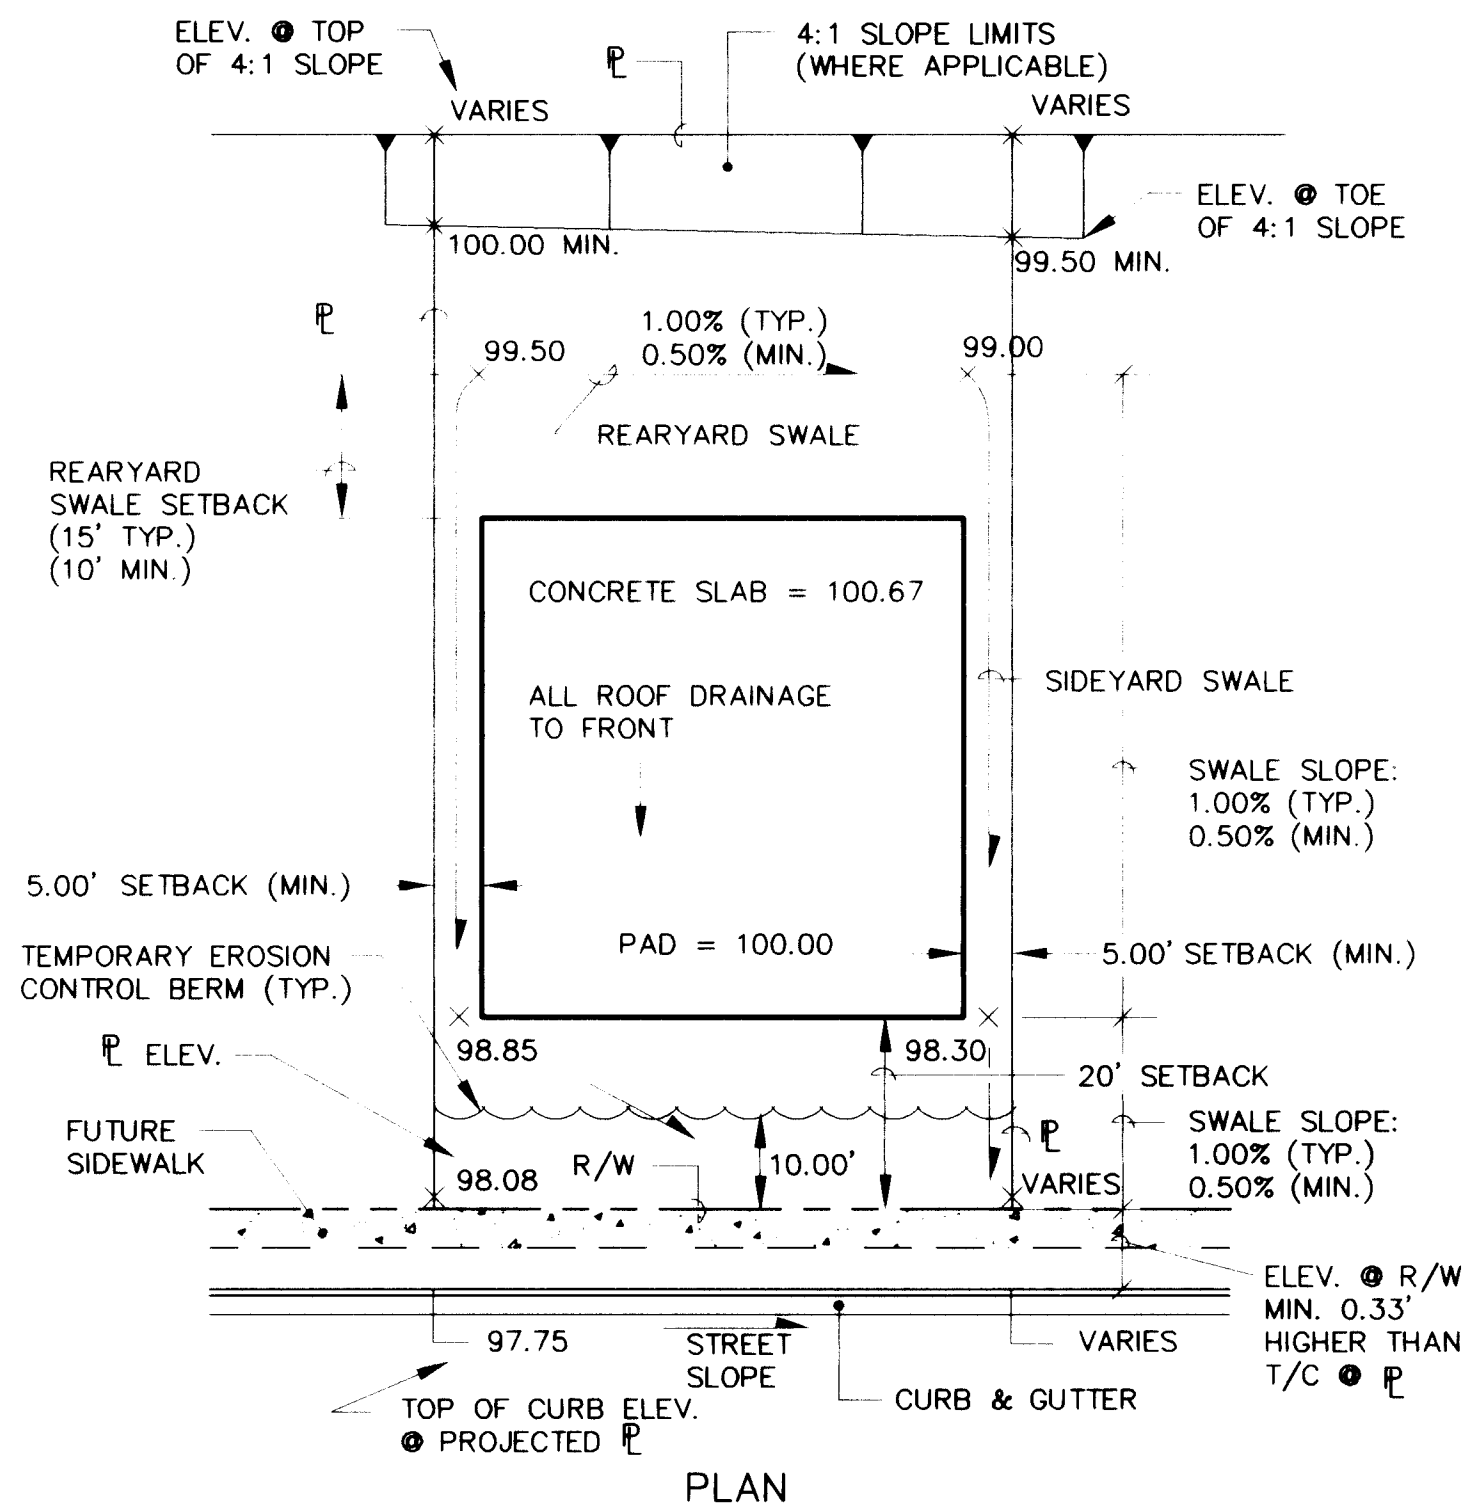

STORM INLET DOUBLE "A"

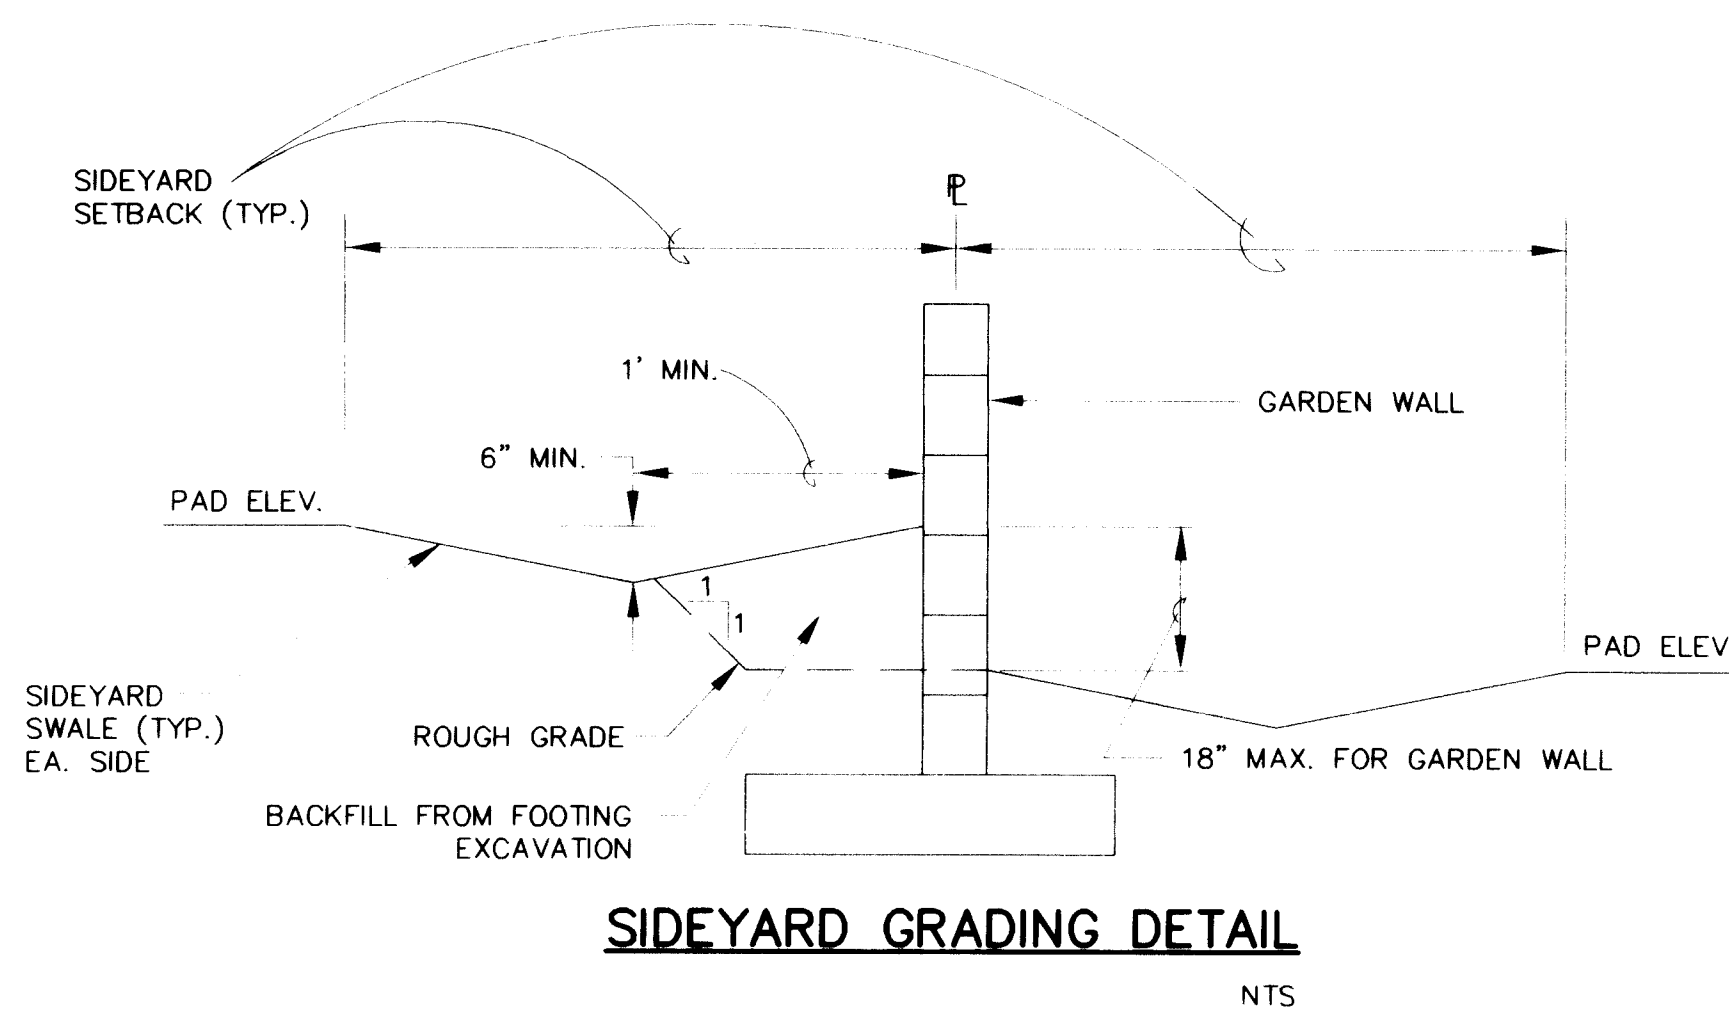


SIDEYARD GRADING DETAIL

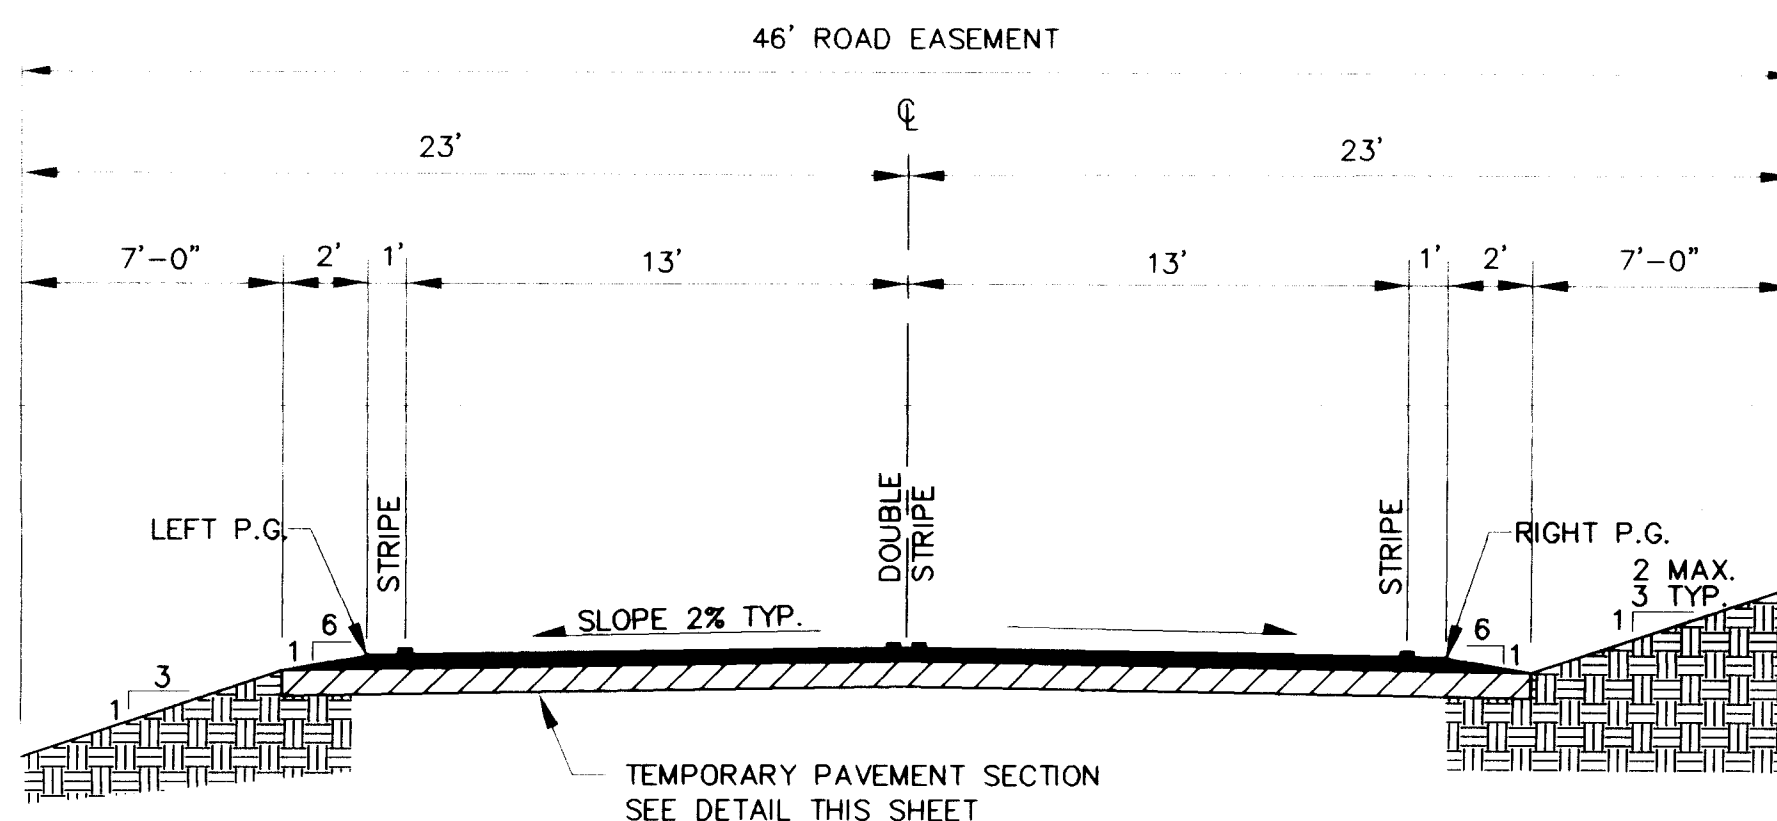

TEMPORARY ACCESS STREET SECTION - 46' ROW


TEMPORARY ACCESS ROADS

SCALE: 1"=5'

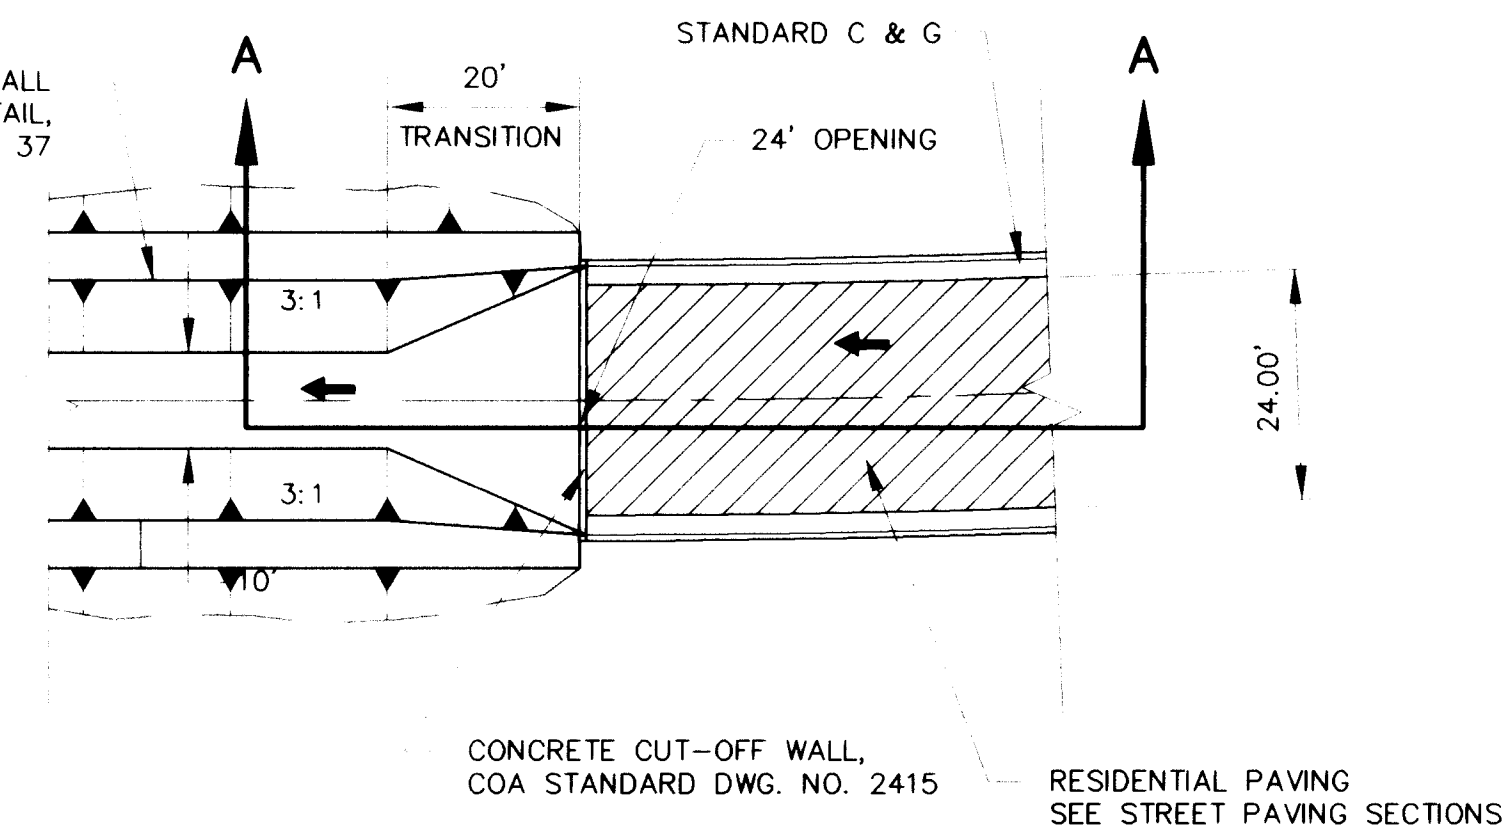


TEMPORARY CHANNEL INLET DETAIL

SCALE: 1"=20'

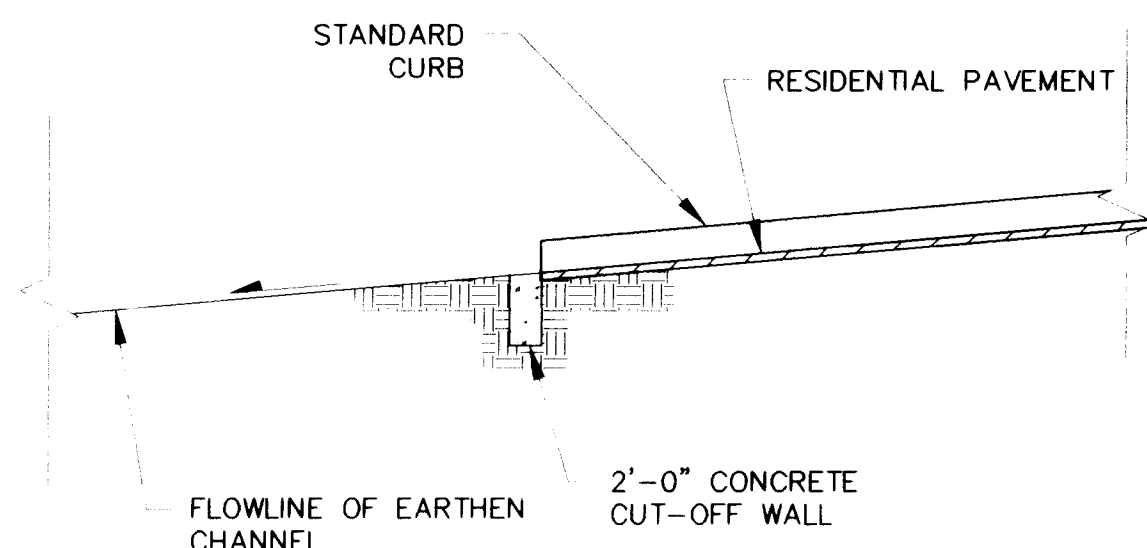


SECTION A-A (TYP.)

NTS

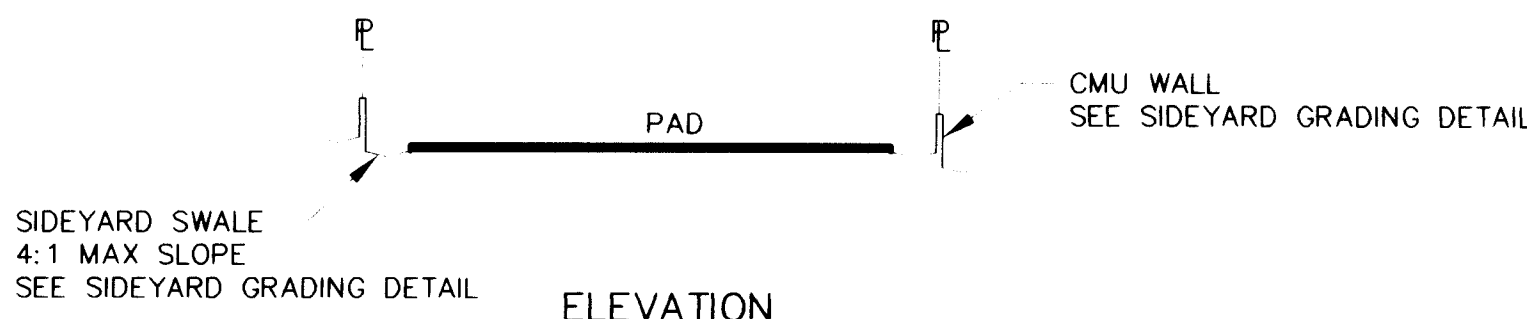

TYPICAL LOT GRADING DETAIL

SCALE: 1"=20'

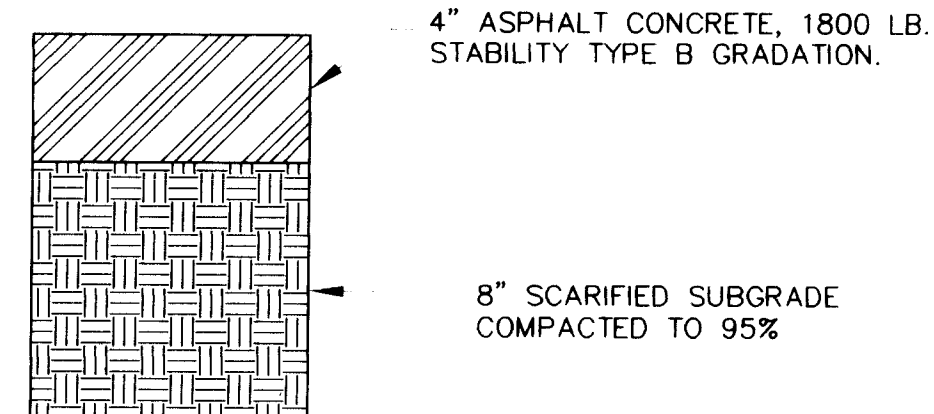

TEMPORARY PAVING SECTION

NTS

LOT GRADING GENERAL NOTES:

- LOT GRADING SHALL MEET THE SITE GRADING AND DRAINAGE CRITERIA FOR PROPOSED CONSTRUCTION AS SET FORTH BY THE DEPARTMENT OF HOUSING AND URBAN DEVELOPMENT - FEDERAL HOUSING ADMINISTRATION IN CIRCULAR LETTER NO. 91-1, OFFICE OF THE MANAGER, ALBUQUERQUE, NEW MEXICO, DATED 1/25/91.
- ELEVATION OF HIGHPOINT OF REARYARD SWALE SHALL BE MIN. OF 6" BELOW PAD ELEVATION.
- FINISHED FLOOR ELEVATIONS (NOT SHOWN) SHALL BE 8" ABOVE PAD ELEVATIONS (SHOWN).
- FRONT YARD SIDEWALK SLOPE SHALL NOT EXCEED 10%.
- DRIVEWAY SLOPE SHALL NOT EXCEED 14%. IF DRIVEWAY IS USED AS SIDEWALK, MAX-SLOPE SHALL NOT EXCEED 10%.
- SLOPES SHALL NOT EXCEED 4:1.
- THE CONTRACTOR MUST OBTAIN A TOPSOIL DISTURBANCE PERMIT FROM THE ENVIRONMENTAL HEALTH DIVISION PRIOR TO COMMENCING CONSTRUCTION.
- THE CONTRACTOR IS TO REFER TO EARTHWORK SPECIFICATIONS AS NOTED IN THE SOILS REPORT SUPPLIED BY CURB INC.
- THE CONTRACTOR SHALL CONFORM TO ALL CITY, COUNTY, STATE AND FEDERAL DUST CONTROL MEASURES AND REQUIREMENTS AND WILL BE RESPONSIBLE FOR PREPARING AND OBTAINING ALL NECESSARY APPLICATIONS AND APPROVALS.
- THE CONTRACTOR SHALL ENSURE THAT NO SOIL ERODES FROM THE CONSTRUCTION SITE. EROSION CONTROL MEASURES ARE INTENDED TO CONTROL MINOR FLOWS AND PROHIBIT THE RELEASE OF SEDIMENT INTO ADJACENT STREETS AND PROPERTY. EROSION CONTROL AND DIVERSION BERMS SHALL BE CONSTRUCTED IN ACCORDANCE WITH THE DETAIL SHOWN ON THIS SHEET, AT LOCATIONS SHOWN ON THE GRADING PLAN.
- THE CONTRACTOR IS RESPONSIBLE FOR MAINTAINING TEMPORARY BERMS THROUGHOUT THE CONSTRUCTION PHASE. THE OWNER WILL MAINTAIN BERMS AFTER COMPLETION AND ACCEPTANCE OF CONSTRUCTION.
- TEMPORARY EROSION CONTROL BERMS LOCATED ON INDIVIDUAL LOTS SHALL REMAIN IN PLACE UNTIL THE CONSTRUCTION OF EACH RESPECTIVE BUILDING IS COMPLETE, ON A LOT BY LOT BASIS.
- THE TOLERANCES FOR ROUGH GRADING SHALL CONFORM TO THE FOLLOWING:
PAD SUBGRADE: +/- 0.2'
STREET SUBGRADE: +/- 0.2'
ALL OTHER AREAS: +/- 0.5'
- BACKYARD DRAINS TO BE PROVIDED AS DESIGNATED.

- THE CONTRACTOR IS FULLY RESPONSIBLE FOR FIELD VERIFYING ALL EXISTING UTILITIES AND NOTIFYING THE ENGINEER IMMEDIATELY OF ANY DISCREPANCIES. CAUTION SHALL BE EXERCISED WHEN WORKING IN THE VICINITY OF EXISTING UTILITIES. ANY DAMAGE TO EXISTING UTILITIES RESULTING FROM CONSTRUCTION ACTIVITIES WILL BE REPAIRED BY THE CONTRACTOR AT THE CONTRACTOR'S EXPENSE.
- GRADE ELEVATIONS, WHERE NOTED, ARE FOR TOP OF STANDARD CURB UNLESS OTHERWISE SPECIFIED.
- CONTRACTOR IS RESPONSIBLE FOR REPAIR AND/OR REPLACEMENT OF ALL UTILITY CONDUITS AND EXISTING LINES.
- ANY DAMAGE TO THE EXISTING FACILITIES (CURB AND GUTTER, PAVEMENT, CONDUITS, LANDSCAPING, UTILITY LINES, ETC.) DURING CONSTRUCTION SHALL BE REPLACED AT THE CONTRACTOR'S EXPENSE.
- THE CONTRACTOR SHALL REVEGETATE AND RE-ESTABLISH ALL AREAS WHICH ARE DISTURBED BY SITE GRADING AND ARE NOT TO RECEIVE PERMANENT SURFACE TREATMENTS. SPECIFICATIONS FOR SEEDING SHALL BE PER CITY OF ALBUQUERQUE STANDARD SPECIFICATIONS FOR PUBLIC WORKS CONSTRUCTION, LATEST EDITION, SECTION 1011, NATIVE SEEDING CLASS A. OPERATION SHALL CONSIST OF PROTECTION OF SITE, PREPARATION OF SEEDBED, MULCHING, FERTILIZATION, AND THE PROVISION OF MATERIALS, LABOR, AND EQUIPMENT NECESSARY TO PERFORM THE OPERATION. THE SEED MIX SHALL BE AS DENOTED IN THE LIST BELOW.


SEED TYPE	LBS. PLS PER ACRE
GRASSES	
INDIAN RICE(10%) GRASS	15 LBS.
GALLET GRASS(30%) 'VIVA'	3.5 LBS.
SIDE OATS(20%) GRAMA	2 LBS.
SAND(10%) DROPSEED	1 LB.
BLUE GRAMA(30%) 'HACHITA'	2 LBS.
WILD FLOWERS	
TAHOKA DAISY	1 LB.
YELLOW CONEFLOWER	1 LB.
GALLARDIA	1 LB.

SCANNED BY
BY LASON

AVID ENGINEERING, INC.
Civil • Structural • Transportation
6100 Seagull St. NE Suite 102
Albuquerque, NM 87109 • (505) 881-5357


CITY OF ALBUQUERQUE PUBLIC WORKS DEPARTMENT ENGINEERING GROUP					
TITLE: WILLOW WOOD UNIT IV GRADING DETAILS					
APPROVALS	ENGINEER	DATE	APPROVALS	ENGINEER	DATE
D.R.C. Chair	<i>[Signature]</i>	7-15-94	Water	N/A	RWK 7-8-94
Transportation	<i>[Signature]</i>	7-15-94	Waste Water	N/A	RWK 7-8-94
Hydrology	<i>[Signature]</i>	7-1-94			
DRAWING NO.	4604.93	MAP NO.	L-21-Z	SHEET	39 OF 40

LEGAL DESCRIPTION: TRACT D-1-A-1-B, MANZANO MESA

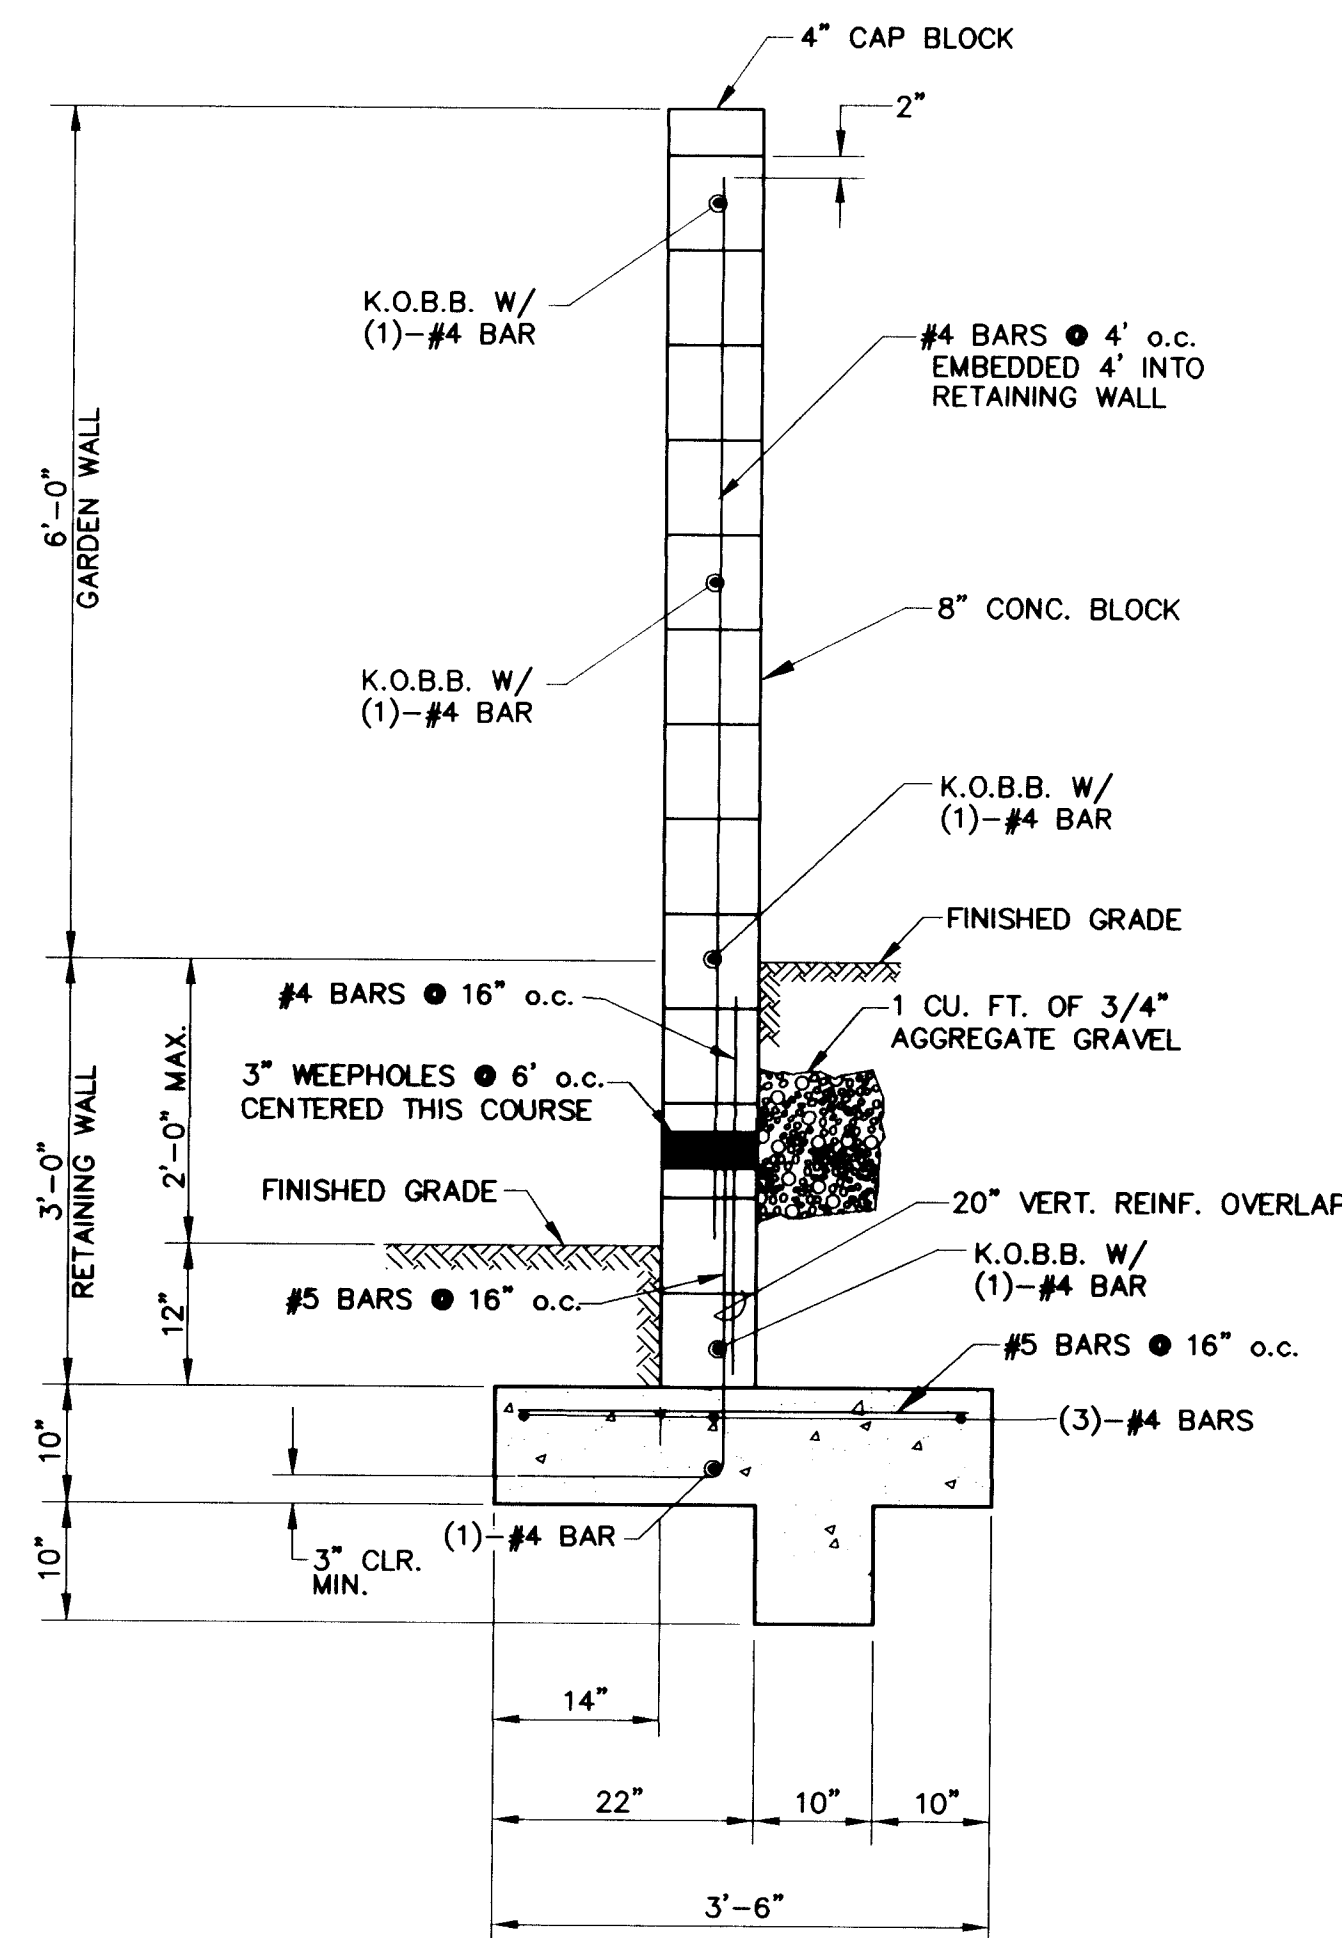


1'-6" TO 2'-0" RETAINING WALL
W/GARDEN WALL EXTENSION

SCALE: 3/4" = 1'-0"

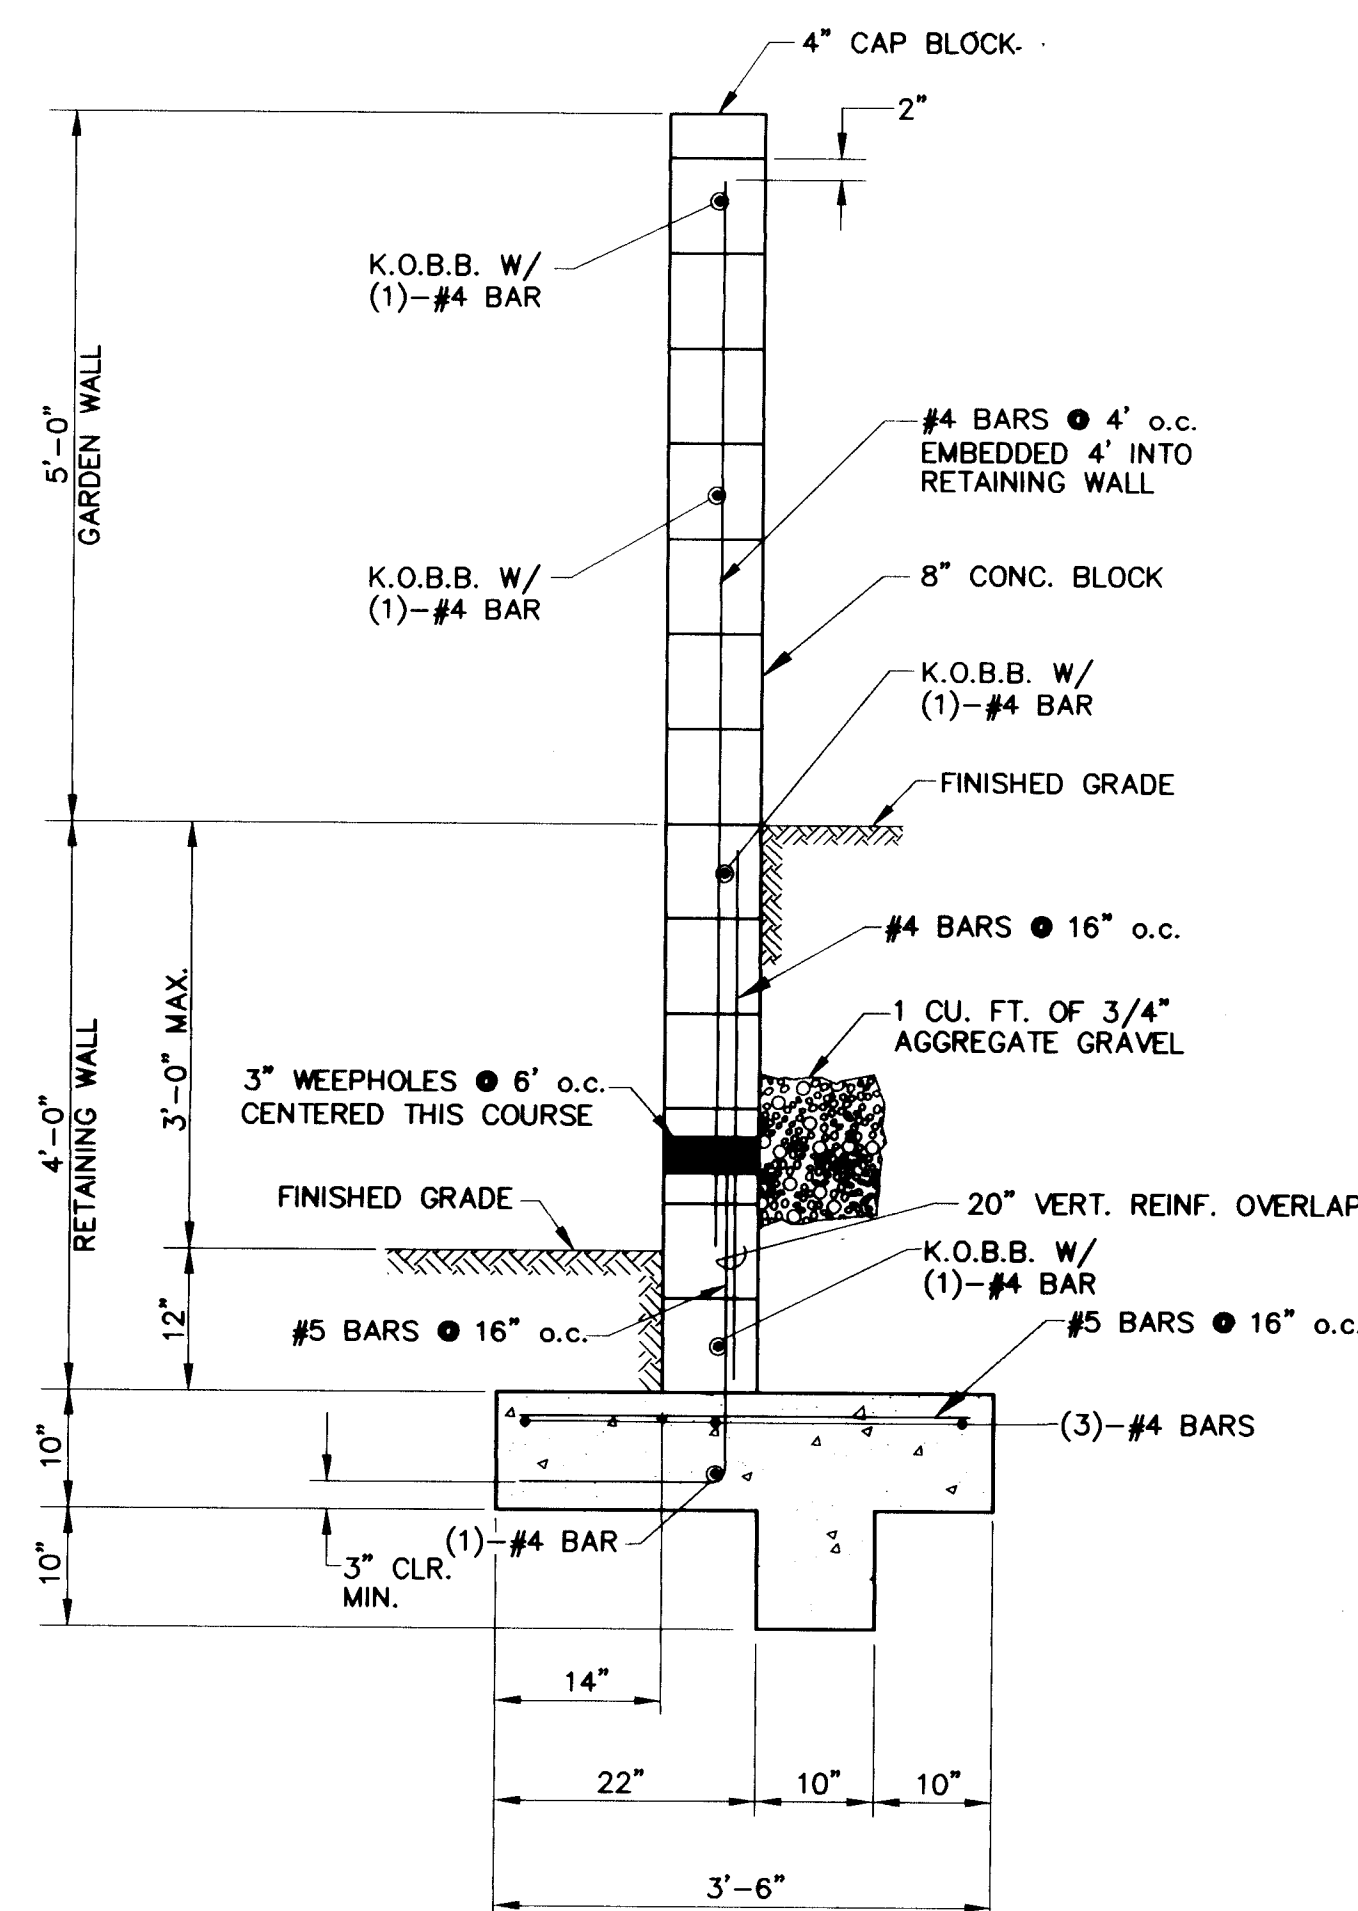


2'-0" TO 3'-0" RETAINING WALL
W/GARDEN WALL EXTENSION

SCALE: 3/4" = 1'-0"

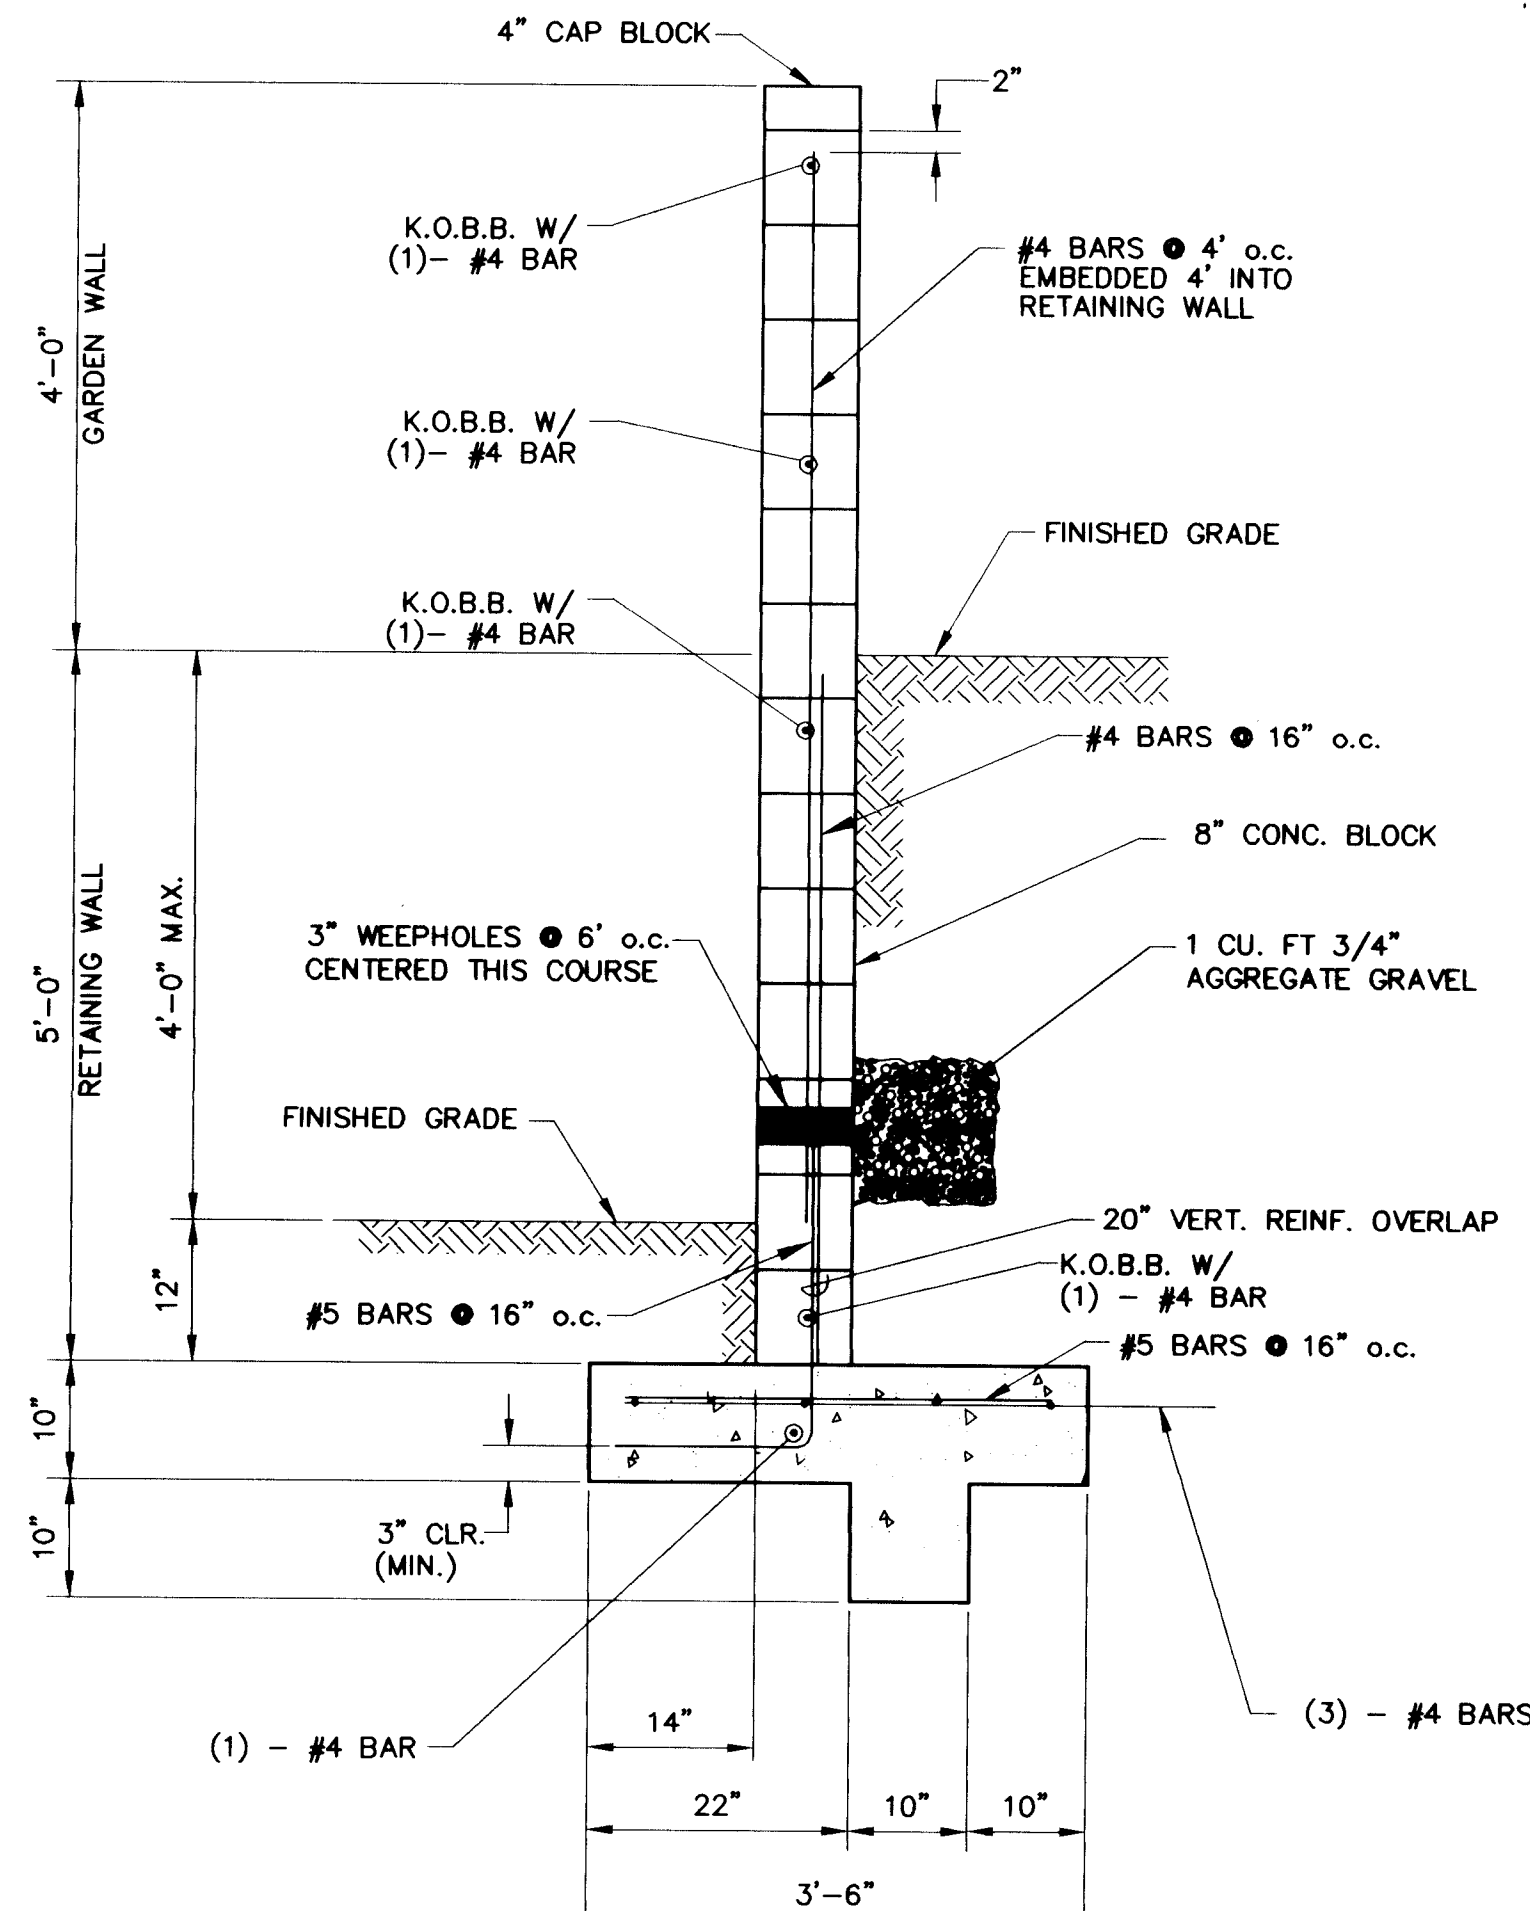


3'-0" TO 4'-0" RETAINING WALL
W/GARDEN WALL EXTENSION

SCALE: 3/4" = 1'-0"

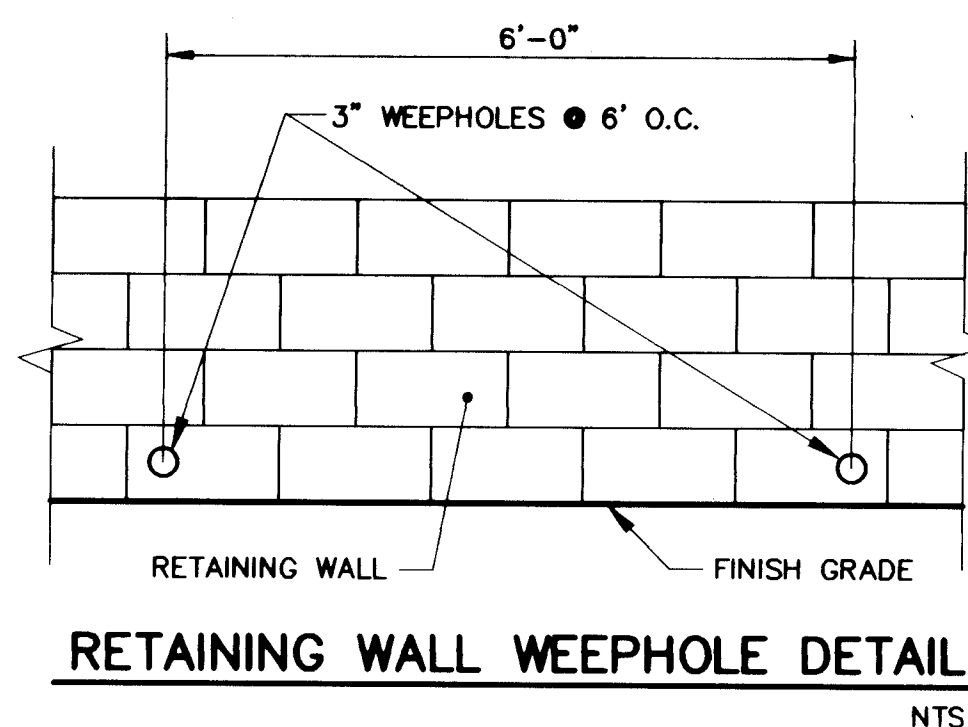


RETAINING WALL WEEPHOLE DETAIL

NTS

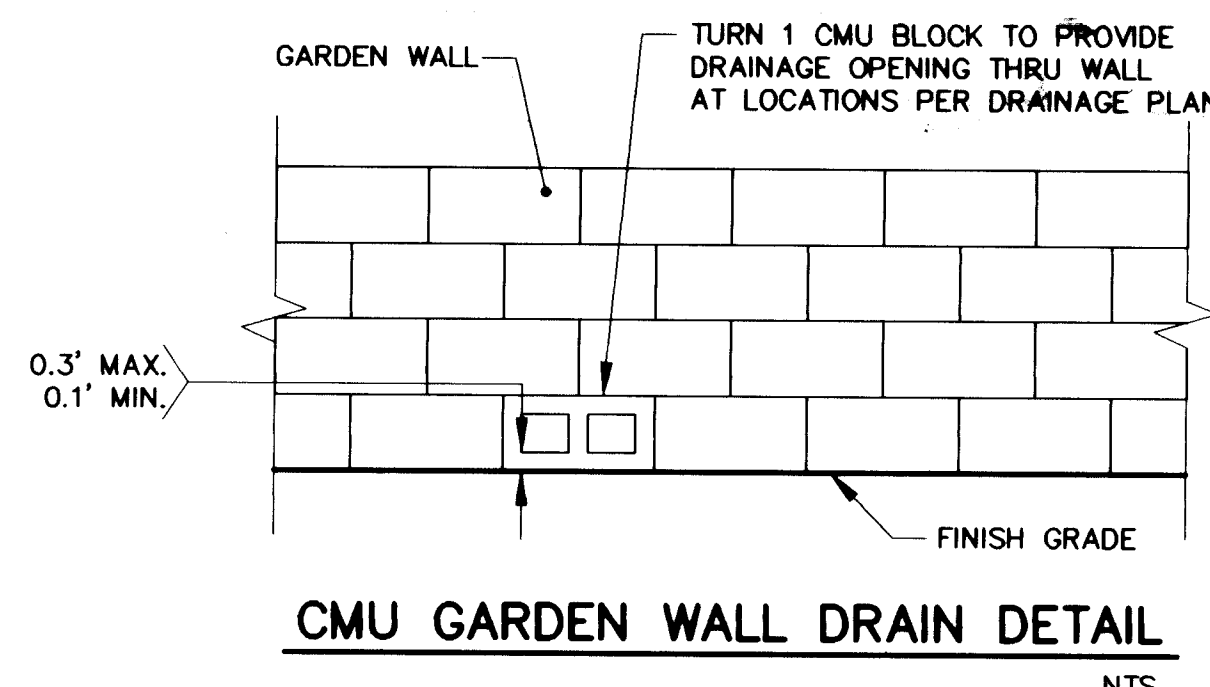


CMU GARDEN WALL DRAIN DETAIL

NTS

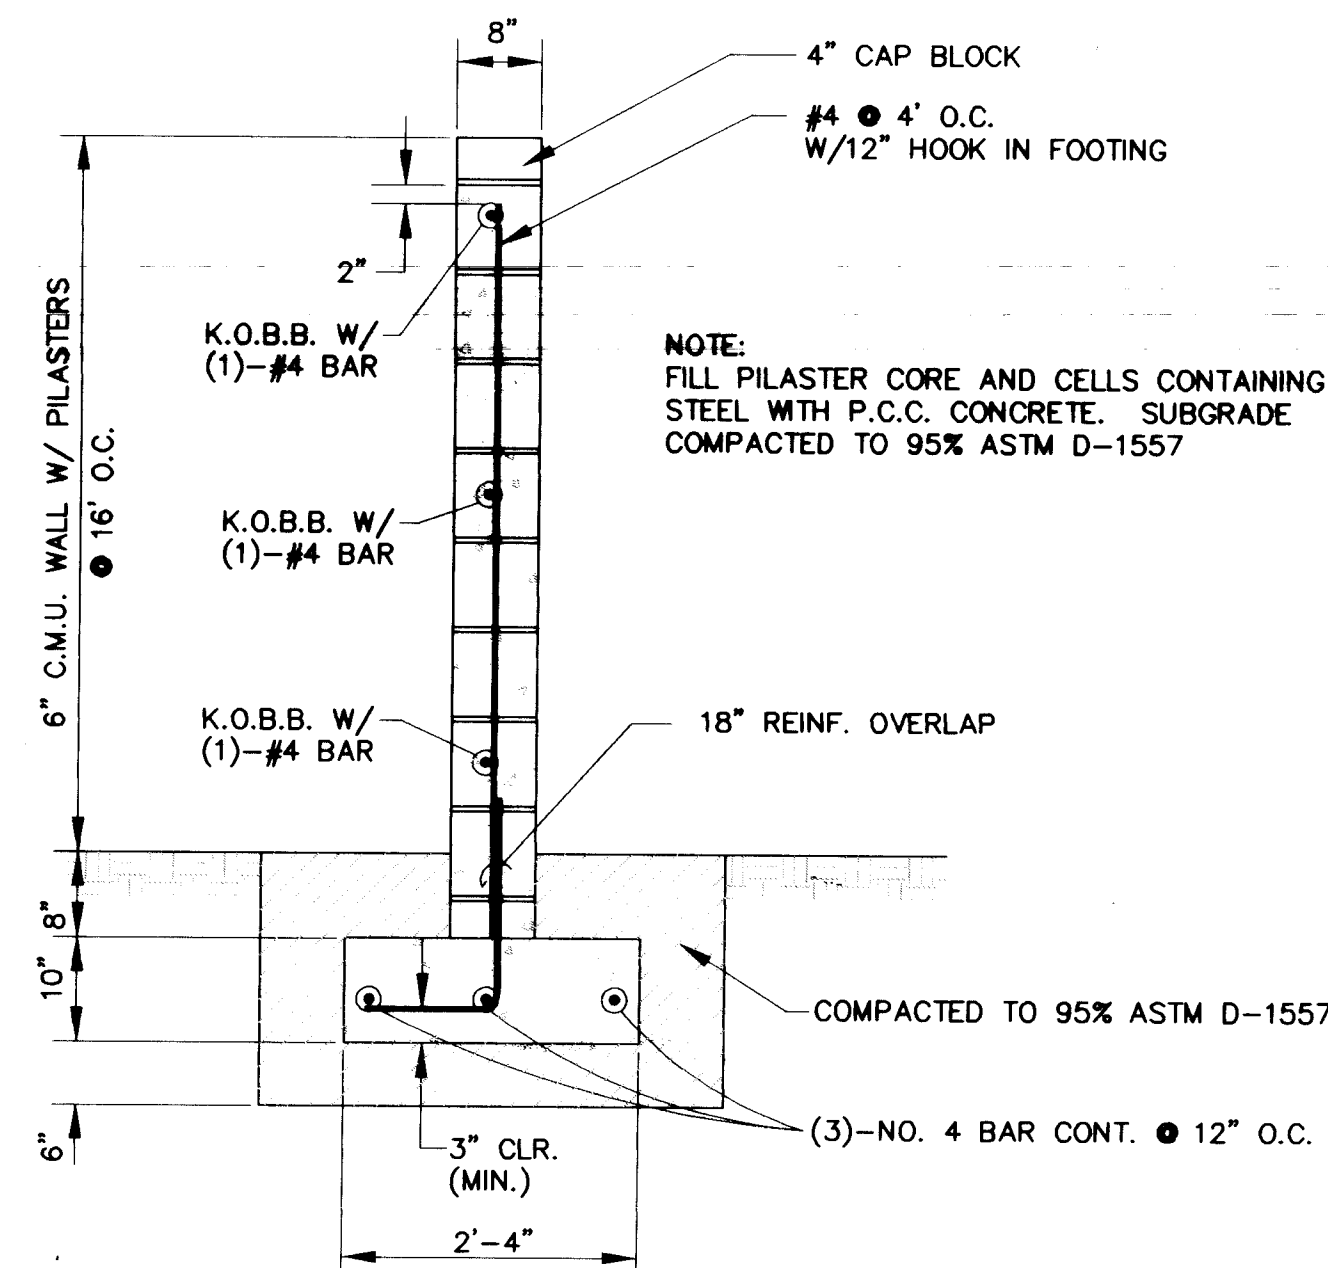

CMU GARDEN WALL DETAIL

NTS

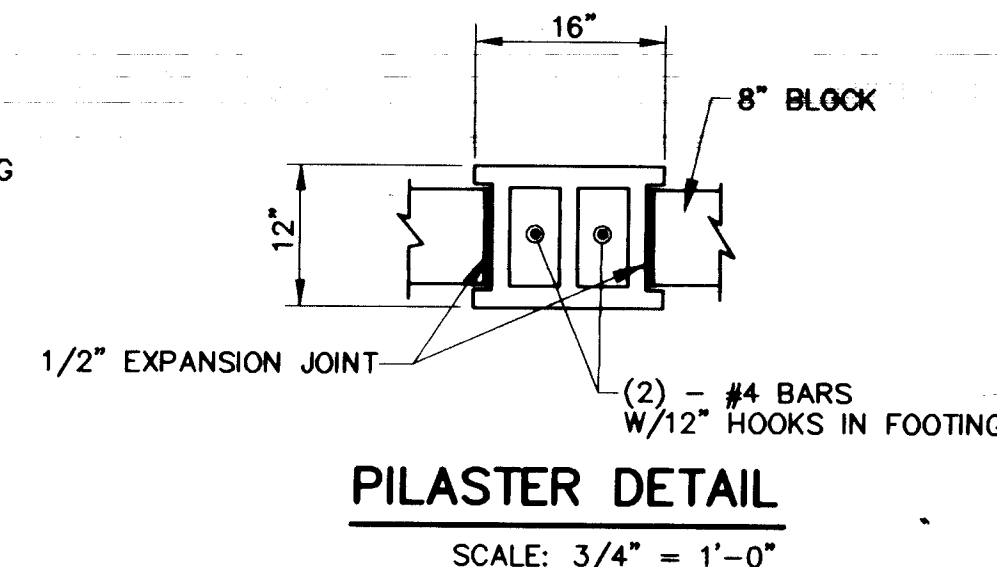

PILASTER DETAIL

SCALE: 3/4" = 1'-0"

GENERAL NOTES FOR RETAINING WALL

1. REINFORCEMENT CLEARANCE IN ALL CMU = 2-3/4" MAX.
2. REINFORCEMENT CLEARANCE IN ALL CONCRETE = 2" MIN., UNLESS OTHERWISE NOTED.
3. 1/2" FELT EXPANSION JOINT TO BE PROVIDED EVERY 16 FT. IN CMU AND CONCRETE AND AT TRANSITIONS IN SECTIONS.
4. ALL CMU RETAINING WALL CELLS CONTAINING REINFORCEMENT SHALL BE FILLED WITH CONCRETE.
5. ALL FOOTING COMPACTION SHALL BE 95% MODIFIED PROCTOR PER ASTM D-1557.
6. TWO (2) WORKING DAYS BEFORE CONSTRUCTION, CONTRACTOR SHALL NOTIFY LINE LOCATING SERVICE 765-1234, FOR UTILITY LOCATIONS. CONTRACTOR SHALL COORDINATE ANY ADJUSTMENTS TO UTILITIES WITH THE UTILITIES COMPANIES.
7. DUR-O-WALL 9 GA. DIAG. EVERY OTHER COURSE MAY BE USED AS AN ALTERNATIVE TO BOND BEAMS.
8. MOISTURE BARRIER COATING SHALL BE APPLIED TO ALL BURIED CMU SURFACES.
9. BACK FILLING AGAINST REINFORCED CONCRETE MASONRY RETAINING WALL SHOULD NOT BE PERMITTED UNTIL AT LEAST 7 DAYS AFTER PLACING THE CORE FILL GROUT. WHERE HEAVY EQUIPMENT IS USED IN BACK FILLING WALLS DESIGNED TO RESIST EARTH PRESSURE ONLY, SUCH EQUIPMENT SHOULD NOT APPROACH CLOSER TO THE TOP OF THE WALL THAN A DISTANCE EQUAL TO THE HEIGHT OF THE WALL. CARE SHOULD ALSO BE TAKEN TO AVOID EXERTING LARGE IMPACT FORCES ON THE WALL AS COULD BE CAUSED BY A LARGE MASS OF MOVING EARTH.
10. INSPECTION OF WALLS DURING CONSTRUCTION BY THE ENGINEER IS REQUIRED FOR ACCEPTANCE.

MATERIALS

CONCRETE: $f_c = 3000$ PSI
GROUT: $f_c = 2500$ PSI
MORTAR: 1800 PSI (TYPE S)
MASONRY: $f_m = 1500$ PSI
REINFORCING: GRADE 60

SCANNED BY
BY LASON

1 2 3 4 5 6 7 8 9 10 11 12 13 14 15
20-41019.173 140915

AVID ENGINEERING, INC.
Civil • Structural • Transportation
6100 Seagull St. NE - Suite 102
Albuquerque, NM 87109 - (505) 881-5357

CITY OF ALBUQUERQUE
PUBLIC WORKS DEPARTMENT
ENGINEERING GROUP

TITLE: WILLOW WOOD - UNIT IV
WALL DETAILS

APPROVALS	ENGINEER	DATE	APPROVALS	ENGINEER	DATE
D.R.C. Chair	<i>[Signature]</i>	7-15-94	Water	<i>[Signature]</i>	7-8-94
Transportation	<i>[Signature]</i>	7-20-94	Waste Water	<i>[Signature]</i>	7-8-94
Hydrology	<i>[Signature]</i>	7-1-94			

DRAWING NO.	4604.93	MAP NO.	L-21-Z	SHEET	40	OF	40
-------------	---------	---------	--------	-------	----	----	----