


CONSTRUCTION PLANS FOR WILLOW WOOD UNIT 6 SUBDIVISION

1. TITLE SHEET
2. PLAT
3. OVERALL PAVING PLAN
4. OVERALL UTILITY PLAN
5. GRADING AND DRAINAGE PLAN
- 6.a LOS PADRES PLACE – PAVING PLAN & PROFILE
- 7.a,b LOS PADRES PLACE – UTILITY PLAN & PROFILE
- 8.a,b ELIZABETH STREET– PAVING & UTILITY PLAN & PROFILE
- 9.b,a ARCHES ROAD & TONY SANCHEZ DR. –PAVING & UTILITY PLAN PROFILE
10. DETAILS
11. WALL DETAILS
12. TRAFFIC CONTROL
13. TRAFFIC CONTROL

AVID ENGINEERING, INC.
Civil • Structural • Transportation
5801 Osuna Rd. NE - Suite 200
Albuquerque, NM 87109 - (505) 881-5351



DRB NO. 97-393

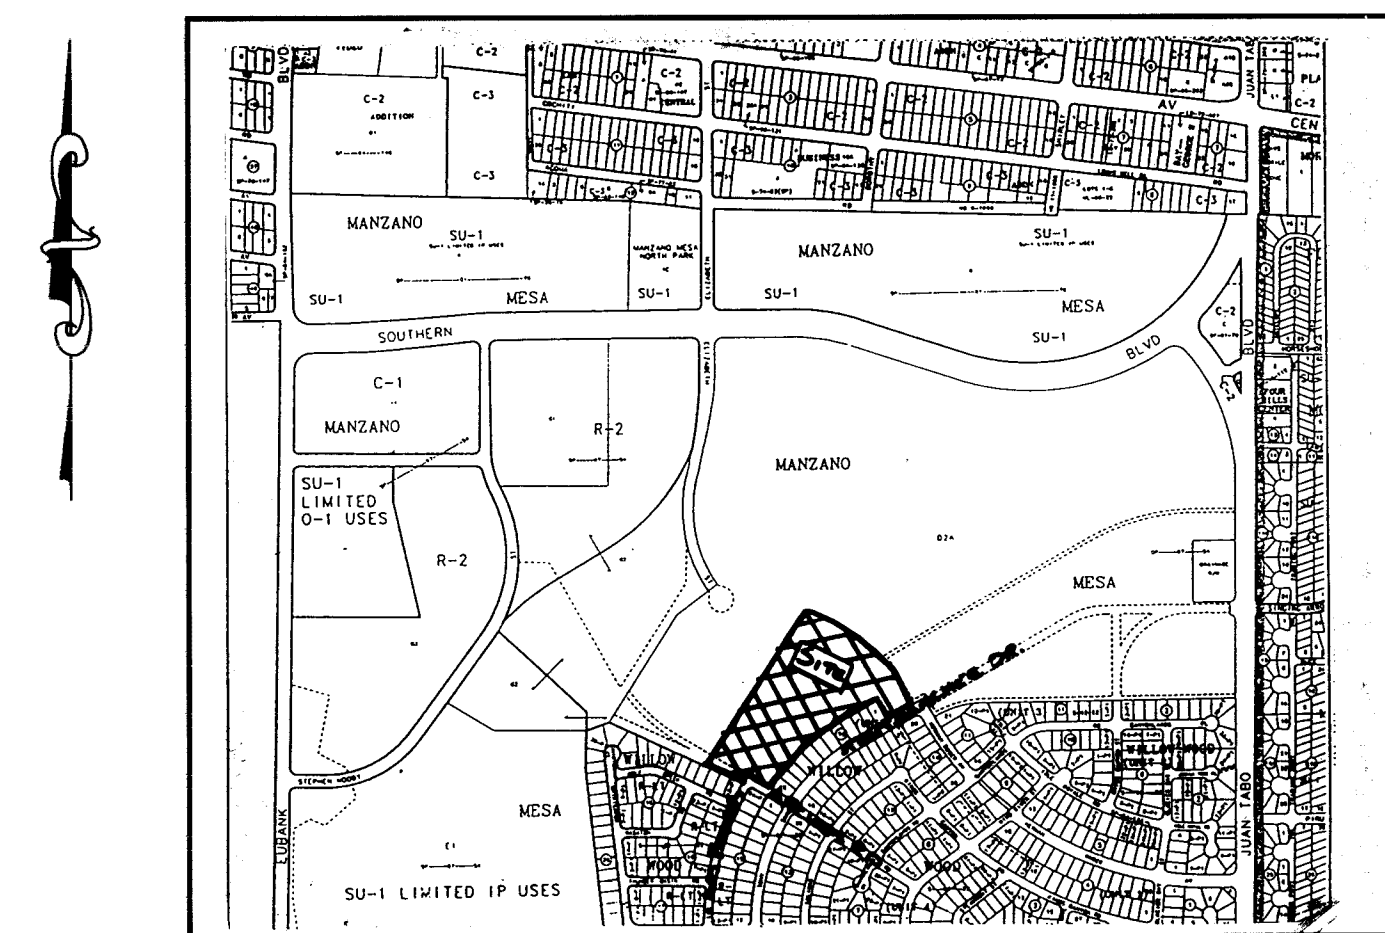


LOCATION MAP
ZONE ATLAS MAP L-21-Z

NTS

1. ALL WORK DETAILED IN THESE PLANS TO BE PERFORMED UNDER CONTRACT, AND UNLESS STATED OTHERWISE PROVIDED FOR HEREON, SHALL BE CONSTRUCTED IN ACCORDANCE WITH THE CITY OF ALBUQUERQUE STANDARD SPECIFICATIONS, PUBLIC WORKS CONSTRUCTION, 1986 EDITION, UPDATE NO. 6.
2. TWO WORKING DAYS PRIOR TO ANY EXCAVATION, THE CONTRACTOR MUST CONTACT NEW MEXICO ONE CALL, 260-1990, FOR LOCATION OF EXISTING UTILITIES.
3. PRIOR TO CONSTRUCTION, THE CONTRACTOR SHALL EXCAVATE AND VERIFY THE HORIZONTAL AND VERTICAL LOCATIONS OF EXISTING UTILITIES BEING CONNECTED TO AND ALL POTENTIAL OBSTRUCTIONS. SHOULD A CONFLICT EXIST, THE CONTRACTOR SHALL NOTIFY THE ENGINEER SO THAT THE CONFLICT CAN BE RESOLVED WITH A MINIMUM AMOUNT OF ~~DELAY~~.
4. ALL WORK ON THIS PROJECT SHALL BE PERFORMED IN ACCORDANCE WITH APPLICABLE FEDERAL, STATE AND LOCAL LAWS, RULES, AND REGULATIONS CONCERNING SAFETY AND HEALTH.
5. CONTRACTOR SHALL MAINTAIN ACCESS TO ADJACENT PROPERTIES DURING CONSTRUCTION.
6. ALL GAS, ELECTRIC, TELEPHONE LINES, CABLES AND APPURTENANCES ENCOUNTERED DURING CONSTRUCTION THAT REQUIRE RELOCATION SHALL BE DONE BY THE RESPONSIBLE UTILITY. THE CONTRACTOR SHALL BE RESPONSIBLE FOR COORDINATION OF ALL NECESSARY UTILITY ADJUSTMENTS.
7. IT SHALL BE THE CONTRACTOR'S RESPONSIBILITY TO PROTECT AND MAINTAIN IN SERVICE ALL EXISTING UTILITIES.
8. THE CONTRACTOR SHALL BE REQUIRED TO CONFINE HIS WORK WITHIN THE CONSTRUCTION LIMITS AND/OR PUBLIC RIGHT-OF-WAY OR EASEMENTS TO PRESERVE EXISTING VEGETATION AND PRIVATE PROPERTY. OVERNIGHT PARKING OF EQUIPMENT AND/OR STORAGE OF MATERIALS IS NOT ALLOWED EXCEPT BY PERMISSION OF PROPERTY OWNER. RESTORATION OF PRIVATE IMPROVEMENTS WILL BE AT THE CONTRACTOR'S EXPENSE.
9. A DISPOSAL SITE FOR ALL EXCESS EXCAVATION MATERIAL, ASPHALTIC PAVING, CONCRETE CURBS AND SIDEWALKS, ETC. SHALL BE OBTAINED BY THE CONTRACTOR IN COMPLIANCE WITH APPLICABLE ENVIRONMENTAL REGULATIONS AND APPROVED BY THE FIELD ENGINEER. ALL COSTS INCURRED IN OBTAINING A DISPOSAL SITE AND HAUL THERE TO SHALL BE CONSIDERED INCIDENTAL TO THE PROJECT AND NO SEPARATE MEASUREMENT OR PAYMENT SHALL BE MADE.
10. WHEN ABUTTING EXISTING PAVEMENT TO NEW, SAWCUT EXISTING PAVEMENT TO A STRAIGHT EDGE AND AT A RIGHT ANGLE, OR AS APPROVED BY THE PROJECT ENGINEER. REMOVAL OF BROKEN OR CRACKED PAVEMENT WILL ALSO BE REQUIRED.
11. FIVE (5) WORKING DAYS PRIOR TO BEGINNING CONSTRUCTION, THE CONTRACTOR SHALL SUBMIT TO THE CONSTRUCTION COORDINATION DIVISION A DETAILED CONSTRUCTION SCHEDULE. TWO (2) WORKING DAYS PRIOR TO CONSTRUCTION, THE CONTRACTOR SHALL OBTAIN A BARRICADE PERMIT FROM THE CONSTRUCTION COORDINATION DIVISION. CONTRACTOR SHALL NOTIFY BARRICADE ENGINEER (768-2551) PRIOR TO OCCUPYING AN INTERSECTION. SEE SECTION 19 OF THE SPECIFICATIONS.
12. ALL FINAL BACKFILL FOR TRENCHES SHALL BE COMPACTED TO A MINIMUM 90% MAXIMUM DENSITY PER ASTM D-1557 AND AS DIRECTED BY SECTION 701.14.2 AND STANDARD DRAWING NUMBER 2315.
13. CONTRACTOR SHALL SUBMIT A REVEGETATION PLAN TO ENGINEER FOR PRIOR APPROVAL.
14. CONTRACTOR SHALL NOTIFY THE ENGINEER NOT LESS THEN SEVEN (7) DAYS PRIOR TO STARTING WORK IN ORDER THAT THE ENGINEER MAY TAKE NECESSARY MEASURES TO INSURE THE PRESERVATION OF SURVEY MONUMENTS. CONTRACTOR SHALL NOT DISTURB PERMANENT SURVEY MONUMENTS WITHOUT THE CONSENT OF THE ENGINEER AND SHALL NOTIFY THE ENGINEER AND BEAR THE EXPENSE OF REPLACING ANY THAT MAY BE DISTURBED WITHOUT PERMISSION. REPLACEMENT SHALL BE DONE ONLY BY THE CITY SURVEYOR. WHEN A CHANGE IS MADE IN THE FINISHED ELEVATIONS OF PAVEMENT OF ANY ROADWAY IN WHICH A PERMANENT SURVEY MONUMENT IS LOCATED, CONTRACTOR SHALL, AT HIS OWN EXPENSE, ADJUST THE MONUMENT COVER TO THE NEW GRADE UNLESS OTHERWISE SPECIFIED. REFER TO SECTION 4.4 OF GENERAL CONDITIONS OF THE STANDARD SPECIFICATIONS.
15. ANY WORK OCCURRING WITHIN AN ARTERIAL ROADWAY REQUIRES TWENTY-FOUR (24) HOURS CONSTRUCTION.
16. ALL STREET STRIPING ALTERED OR DESTROYED SHALL BE REPLACED WITH PLASTIC REFLECTORIZED PAVEMENT MARKINGS BY CONTRACTOR TO LOCATION AS EXISTING OR AS INDICATED BY THIS PLAN SET.

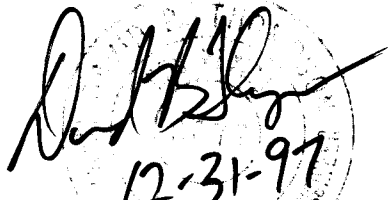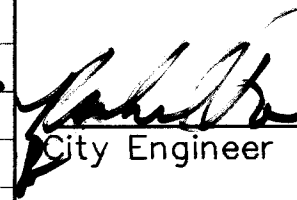PAYMENT MARKINGS BY CONTRACTOR TO LOCATIONS EXISTING OR AS INDICATED BY THIS PLAN SET.						
▲	Co. 7a, 7b	6/1/98	Billy G. Gorbach	6-17-98	6/1/98	6/1/98
▲	Co. 8a, 8b, 87b	6/3/98	R.W. Kane	6-17-98	6/1/98	6/1/98
REV.	SHEETS	CITY ENGINEER	DATE	USER DEPARTMENT	DATE	DATE
ENGINEERS STAMP & SIGNATURE		APPROVALS	ENGINEER	DATE	*****	
 12-31-97 1-20-98 2-5-98		DRC Chairman	Billy G. Gorbach	3-26-98	APPROVED FOR CONSTRUCTION	
		Transportation	Exp. 8/1/98	2-27-98		
		Water/Wastewater	R.W. Kane	1-13-98		
		Hydrology	Glenn Hunsaker	1-13-98		
		Parks				
		Constr. Mngmt.	John Luch	3-17-98		
PROJECT NO.		4604.96		SHEET OF		
				1 13		
				 City Engineer Date 5-01-98		

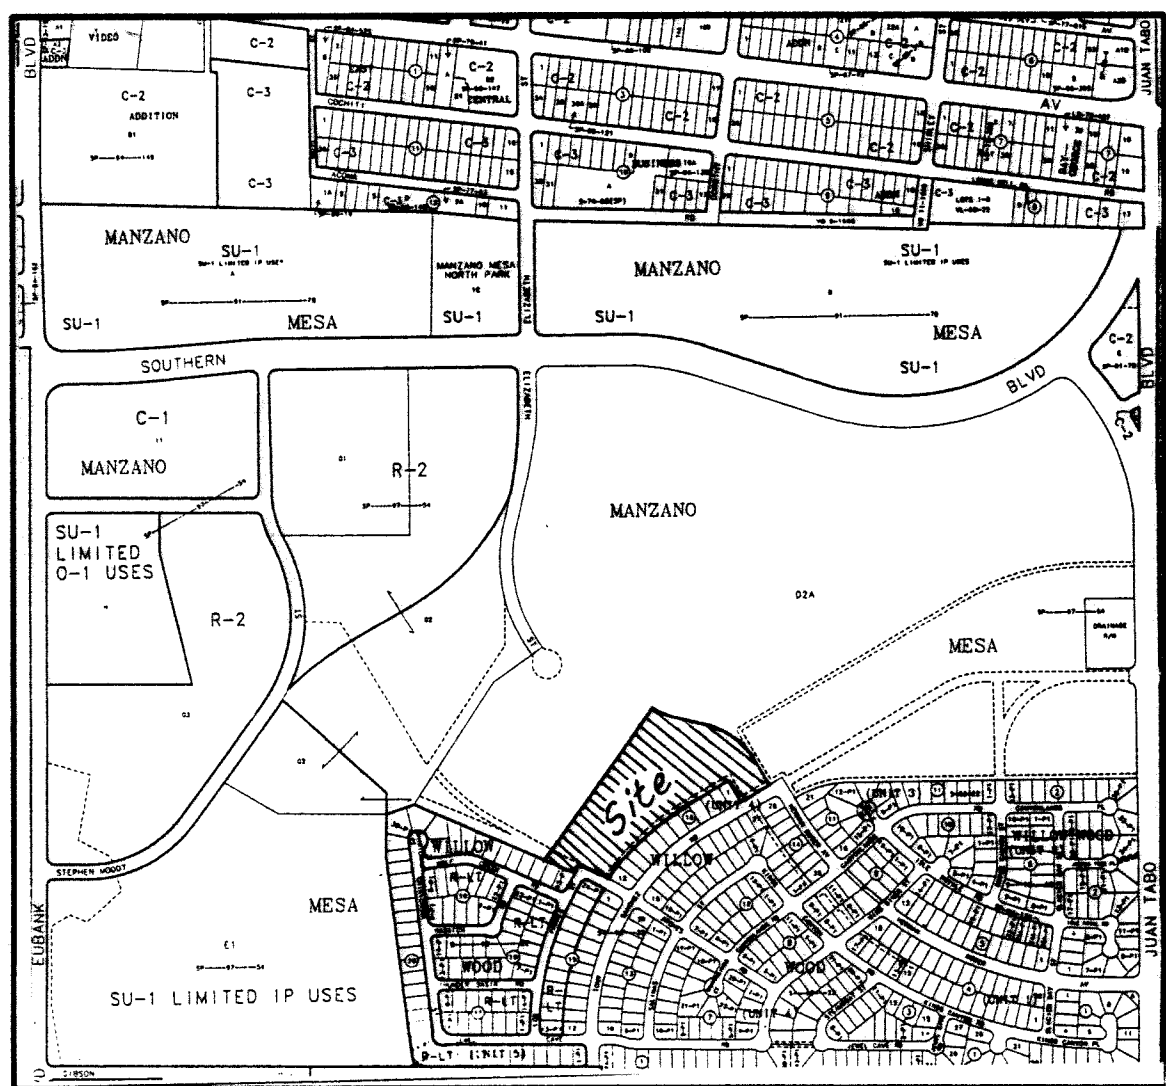

VICINITY MAP
ZONE ATLAS MAP NO. L-21-Z

REPLAT DATA

- DRB Case No. _____
- Zone Atlas Index No. L-21-Z
- Gross Replat Acreage: 6.9533 Ac.±.
- Total Mileage of Full Width Streets Created: 0.170 Miles.
- Date of Survey: August 1997.

NOTES

- Bearings are New Mexico State Plane Grid Bearings (CENTRAL ZONE).
Basis of Bearing: S82°28'20"E Between ACS Monuments "6-L21" and "1-L21(R)".
- Distances are ground distances.
- Centerline (in lieu of R/W) monumentation to be installed at all centerline PC's, PT's, angle points and street intersections as shown hereon, and will consist of a standard four inch (4") aluminum alloy cap stamped "City of Albuquerque, Centerline Monument, Do Not Disturb, NMPS 11462", shown hereon by ▲
- ▲ Denotes found City of Albuquerque Control Survey Monument.
- Denotes found property corner, see Sheet 2 of 2 for description.
- ⊙ Denotes rebar w/ cap "AVID ENG. INC. NMPS 11462" set.
- All Lots marked "P1" shall meet the Off-Street Parking criteria of the City of Albuquerque Comprehensive Zoning Code.

PURPOSE OF REPLAT

- SUBDIVIDE TRACT D-2-A-2, MANZANO MESA INTO WILLOW WOOD UNIT 6 SUBDIVISION CONTAINING 37 LOTS.
- DEDICATE PUBLIC ROADWAY RIGHT-OF-WAY.
- GRANT ALL PUBLIC EASEMENTS SHOWN HEREON.
- VACATE PRIVATE DRAINAGE EASEMENTS SHOWN HEREON, VACATION ACTION No. V-97-101.

DOCUMENTS USED TO DETERMINE BOUNDARY

- PLAT ENTITLED "PLAT OF TRACTS D-2-A-1 & D-2-A-2, MANZANO MESA" FILED: _____ VOL. _____, FOLIO _____.

DESCRIPTION

A certain tract of land situate within Section 28, Township 10 North, Range 4 East, New Mexico Principal Meridian, Bernalillo County, New Mexico, being Tract D-2-A-2, Manzano Mesa, as the same is shown and designated on the plat entitled "PLAT OF TRACTS D-2-A-1 AND D-2-A-2, MANZANO MESA" as filed for record in the Office of the County Clerk of Bernalillo County on 199 , in Volume C, Folio _____, and being more particularly described by New Mexico State Plane Grid bearings and ground distances as follows:

Beginning at a point being the northeast corner of said Tract D-2-A-2, whence the City of Albuquerque Control Survey Monument "1-L21(R)" bears N29°02'04"E a distance of 3558.67 feet,
thence S60°20'56"W along the boundary line between said Tract D-2-A-2 and the northerly right-of-way line of Tony Sanchez Drive S.E., a distance of 160.00 feet to a point;
thence N29°39'04" W along the boundary line between said Tract D-2-A-2 and Willow Wood Unit 4, filed August 16, 1994, in Volume 94C, Folio 268, a distance of 115.00 feet to a point;
thence S60°20'56"W continuing along said boundary line, a distance of 187.60 feet to a point of curvature;
thence continuing along said boundary line 543.26 feet along the arc of a curve to the left, radius = 1245.00 feet, delta = 25°00'04", chord = S47°50'54"W a distance of 538.96 feet to a point being the southeast corner of said Tract D-2-A-2;
thence N59°39'04"W along the boundary line between said Tract D-2-A-2 and the northerly right-of-way line of Arches Road S.E., a distance of 148.00 feet to a point;
thence S30°20'56"W continuing along said boundary line, a distance of 52.36 feet to a point;
thence N65°30'35"W along the boundary line between said Tract D-2-A-2 and Willow Wood Unit 5, filed July 18, 1996, in Volume 96C, Folio 317, a distance of 139.87 feet to a point being the southwest corner of said Tract D-2-A-2;
thence N40°57'47"E along the boundary line between said Tract D-2-A-2 and Tract D-2-A-1, Manzano Mesa, filed _____, 199 , in Volume C, Folio _____, a distance of 839.88 feet to a point being the northwest corner of said Tract D-2-A-2;
thence continuing along said boundary line 104.75 feet along the arc of a curve to the left, radius = 869.84 feet, delta = 06°54'00", chord = S87°46'45"E a distance of 104.69 feet to a point of reverse curvature;
thence continuing along said boundary 397.65 feet along the arc of a curve to the right, radius = 370.00 feet, delta = 61°34'41", chord = S60°26'24"E a distance of 378.79 to a point of tangency;
thence S29°39'04"E continuing along said boundary line, a distance of 111.79 feet to the point and place of beginning, containing 6.9533 acres more or less.

OWNER'S FREE CONSENT

THE SUBDIVISION SHOWN HEREON IS WITH THE FREE CONSENT AND IN ACCORDANCE WITH THE DESIRES OF THE UNDERSIGNED OWNER(S) AND/OR PROPRIETOR(S) THEREOF AND SAID OWNER(S) AND/OR PROPRIETOR(S) DO HEREBY DEDICATE ALL ROADWAY RIGHT-OF-WAY SHOWN HEREON TO THE CITY OF ALBUQUERQUE IN FEE SIMPLE AND DO HEREBY GRANT ALL PUBLIC EASEMENTS SHOWN HEREON INCLUDING THE RIGHT TO CONSTRUCT, OPERATE, INSPECT AND MAINTAIN FACILITIES THEREIN; AND ALL PUBLIC UTILITY EASEMENTS SHOWN HEREON FOR THE COMMON AND JOINT USE OF GAS, ELECTRICAL, POWER AND COMMUNICATION SERVICES FOR BURIED DISTRIBUTION LINES, CONDUITS, AND PIPES FOR UNDERGROUND UTILITIES WHERE SHOWN OR INDICATED, AND INCLUDING THE RIGHT OF INGRESS AND EGRESS FOR CONSTRUCTION AND MAINTENANCE OF, AND THE RIGHT TO TRIM INTERFERING TREES AND SHRUBS (SEE P.U.E. NOTE). SAID OWNER(S) AND/OR PROPRIETOR(S) DO HEREBY CONSENT TO ALL THE FOREGOING AND DO HEREBY CERTIFY THAT THIS SUBDIVISION IS THEIR FREE ACT AND DEED.

Charles A. Haegelin, President, Curb Inc., General Partner _____ Date _____

STATE OF NEW MEXICO }
COUNTY OF BERNALILLO } SS

This Instrument was Acknowledged before me on _____, 1997.

Notary Public _____

SUBDIVISION PLAT FOR WILLOW WOOD UNIT 6

Bernalillo County
Albuquerque, New Mexico
November 1997

APPROVED AND ACCEPTED BY

Subdivision Case No. _____	_____
Planning Director, City of Albuquerque, N.M.	_____ Date _____
City Engineer, City of Albuquerque, N.M.	_____ Date _____
Albuquerque Metropolitan Arroyo Flood Control Authority	_____ Date _____
Traffic Div., City of Albuquerque, N.M.	_____ Date _____
Water Utilities Dept., City of Albuquerque, N.M.	_____ Date _____
Parks and General Services, City of Albuquerque, N.M.	_____ Date _____
City Surveyor, City of Albuquerque, N.M.	_____ Date _____
Property Management, City of Albuquerque, N.M.	_____ Date _____
County Treasurer, Bernalillo County, N.M.	_____ Date _____
PNM Gas Services Division	_____ Date _____
PNM Electric Services Division	_____ Date _____
U.S. West Telecommunications	_____ Date _____
Jones Intercable, Inc.	_____ Date _____

SURVEYOR'S CERTIFICATION

I, Ruan S. Bacigalupa, a duly qualified Registered Professional Land Surveyor under the laws of the State of New Mexico, do hereby certify that this plat was prepared by me or under my supervision, from an actual field survey performed under my direction, and meets the minimum requirements for monumentation and surveys of the Albuquerque Subdivision Ordinance, and further meets the Minimum Standards for Land Surveying in the State of New Mexico (Effective February 2, 1994), and that interior lot corners will be set in accordance with said minimum standards.

Ruan S. Bacigalupa, N.M.P.S. 11462 _____ Date _____
AVID Engineering, Inc.
5801 Osuna Rd. NE - Suite 200
Albuquerque, New Mexico, 87109

INDEXING INFORMATION FOR COUNTY CLERK

OWNER:	MANZANO MESA LIMITED PARTNERSHIP
SECTION:	Sec. 28, T.10N., R.4E.
SUBDIVISION:	WILLOW WOOD

DATE: NOVEMBER 1997
AVID JOB No. 6076.1.473

AVID ENGINEERING, INC.
Civil • Structural • Transportation
5801 Osuna Rd. NE - Suite 200
Albuquerque, NM 87109 - (505) 881-5357

SHEET 1 OF 2


CURVE	DELTA	LENGTH	RADIUS	CHORD BRG.	CHORD
C1	25°00'04"	543.26	1245.00	S47°50'54"W	538.96
C2	06°54'00"	104.75	869.84	S87°46'45"E	104.69
C3	61°34'41"	397.65	370.00	S60°26'24"E	378.79
C4	27°14'32"	780.75	1600.00	N48°20'41"E	753.60
C5	95°28'12"	41.64	25.00	N11°58'58"W	36.99
C6	01°32'18"	42.34	1577.00	N36°33'17"E	42.34
C7	02°37'17"	56.96	1245.00	S36°39'30"W	56.95
C8	01°56'50"	53.59	1577.00	N38°17'52"E	53.59
C9	02°18'02"	49.99	1245.00	S39°07'10"W	49.99
C10	01°56'11"	53.30	1577.00	N40°14'22"E	53.30
C11	02°17'41"	49.86	1245.00	S41°25'01"W	49.86
C12	01°57'04"	53.71	1577.00	N42°11'00"E	53.70
C13	02°17'41"	49.86	1245.00	S43°42'43"W	49.86
C14	01°57'01"	53.68	1577.00	N44°08'03"E	53.68
C15	02°17'59"	49.97	1245.00	S46°00'33"W	49.97
C16	01°57'18"	53.81	1577.00	N46°05'12"E	53.80
C17	02°18'11"	50.04	1245.00	S48°18'38"W	50.04
C18	01°56'56"	53.64	1577.00	N48°02'19"E	53.64
C19	02°17'35"	49.83	1245.00	S50°36'31"W	49.83
C20	01°56'48"	53.58	1577.00	N49°59'11"E	53.58
C21	02°17'15"	49.70	1245.00	S52°53'56"W	49.70
C22	01°57'47"	54.03	1577.00	N51°56'22"E	54.03
C23	02°18'11"	50.05	1245.00	S55°13'59"W	50.04
C24	01°56'45"	53.56	1577.00	N55°35'45"E	53.56
C25	02°16'45"	49.52	1245.00	S57°29'07"W	49.52
C26	01°56'33"	53.47	1577.00	N55°50'24"E	53.46
C27	01°43'27"	37.46	1245.00	S59°29'13"W	37.46
C28	01°56'57"	53.65	1577.00	N57°47'09"E	53.65
C29	01°30'43"	42.60	1577.00	S58°20'04"E	42.60
C30	21°16'25"	9.28	25.00	N70°56'42"E	9.23
C31	54°53'07"	43.11	45.00	N74°27'00"E	41.48
C32	20°18'39"	8.86	25.00	N88°15'46"W	8.82
C33	32°54'32"	25.85	45.00	N30°33'10"E	25.49
C34	90°00'00"	39.27	25.00	S15°20'56"W	35.36
C35	29°51'55"	23.46	45.00	N00°30'05"W	23.19
C36	18°03'43"	116.64	370.00	S38°40'56"E	116.16
C37	41°12'14"	32.36	45.00	N36°22'07"W	31.67
C38	19°17'05"	124.53	370.00	S57°21'19"E	123.95
C39	42°34'48"	33.44	45.00	N78°15'38"W	32.68
C40	22°01'51"	142.27	370.00	S78°00'47"E	141.39
C41	59°02'16"	46.37	45.00	S50°55'50"W	44.34

NOTE: MANY OF THE SIDE LOT LINES SHOWN HEREON ARE NOT RADIAL TO THE R.O.W. CURVES ALONG LOS PADRES PLACE OR TO THE CURVES ALONG THE SUBDIVISION BOUNDARY.

LEGEND

- DENOTES EXISTING 20' DRAINAGE EASEMENTS TO BE VACATED BY VAC. ACT. NO. V-97-101.
- DENOTES EXISTING EASEMENT
- DENOTES EASEMENT GRANTED BY THIS PLAT.

ACS MONUMENT
6-L21
Y= 1,481,220.09
X= 417,975.01
Grid-Grid= 0.99964527
ΔOC= -00°09'27"
CENTRAL ZONE
(NAD 1927)

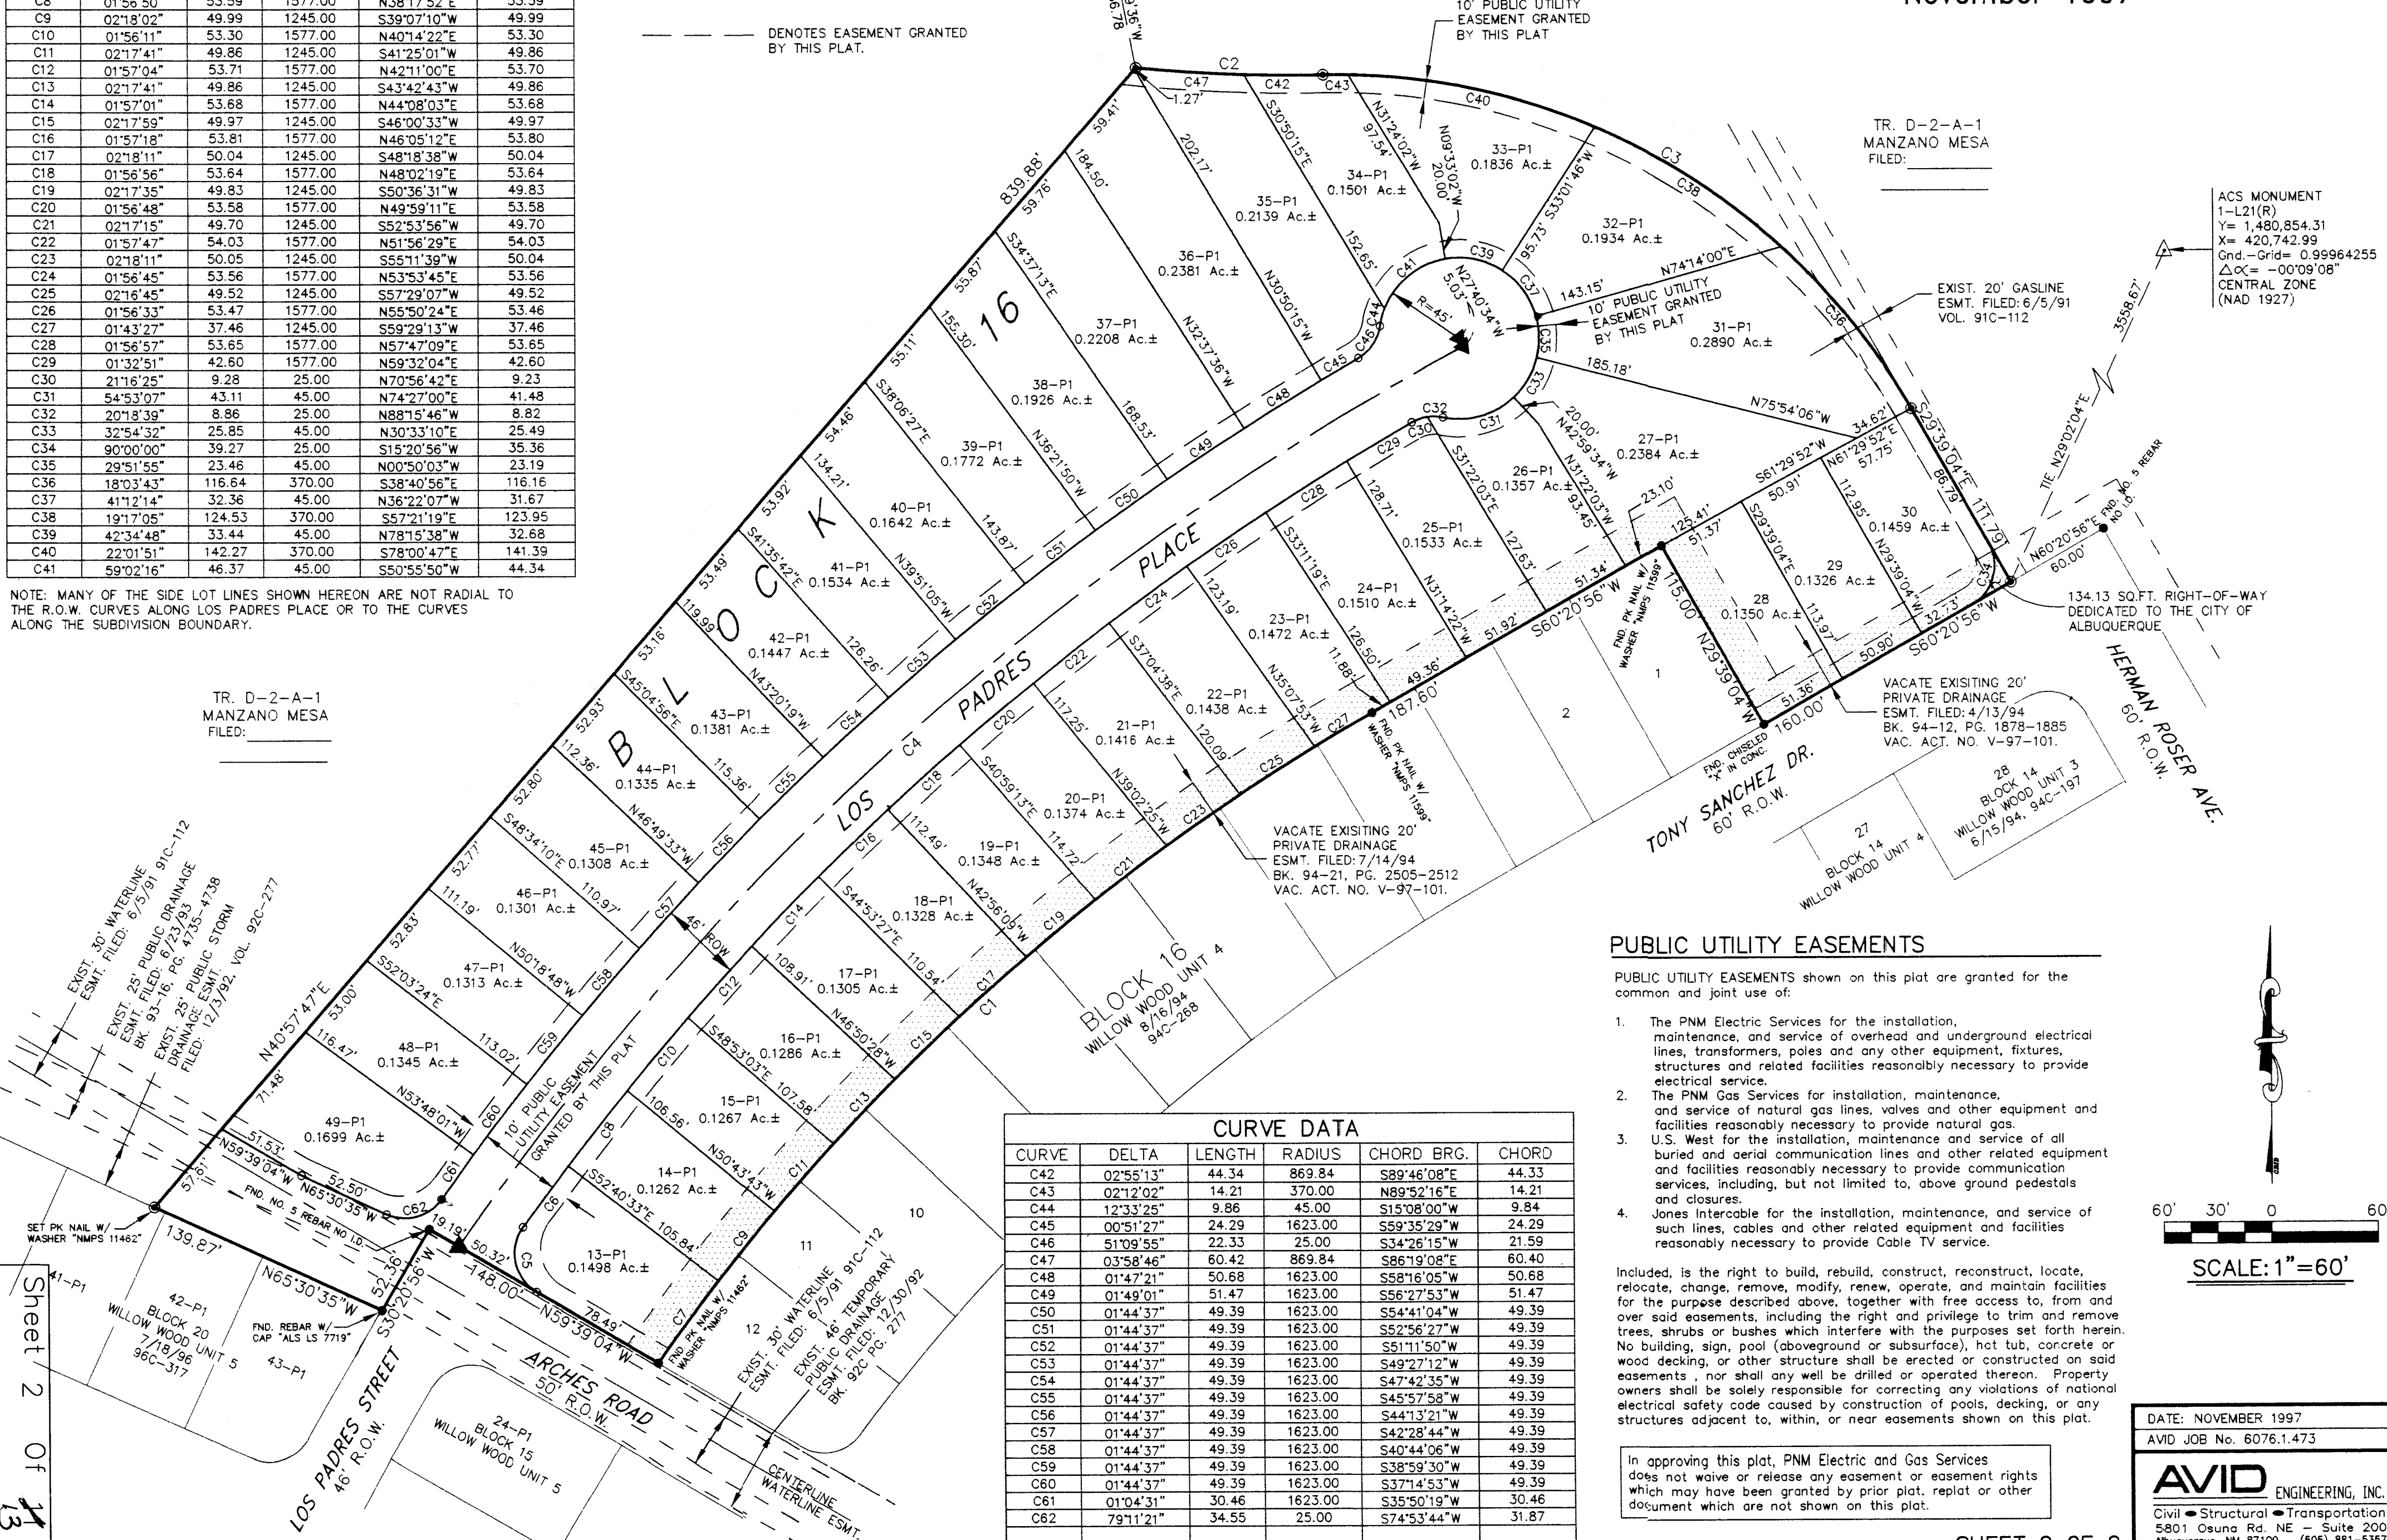

CURVE	DELTA	LENGTH	RADIUS	CHORD BRG.	CHORD
C42	02°58'13"	44.34	869.84	S89°46'08"E	44.33
C43	02°12'02"	14.21	370.00	N89°52'16"E	14.21
C44	12°33'28"	9.86	45.00	S15°08'00"W	9.84
C45	00°51'27"	24.29	1623.00	S59°35'29"W	24.29
C46	51°09'55"	22.33	25.00	S34°26'15"W	21.59
C47	03°58'46"	60.42	869.84	S86°19'08"E	60.40
C48	01°47'21"	50.68	1623.00	S58°16'05"W	50.68
C49	01°48'01"	51.47	1623.00	S56°27'53"W	51.47
C50	01°44'37"	49.39	1623.00	S54°41'04"W	49.39
C51	01°44'37"	49.39	1623.00	S52°56'27"W	49.39
C52	01°44'37"	49.39	1623.00	S51°11'50"W	49.39
C53	01°44'37"	49.39	1623.00	S49°27'12"W	49.39
C54	01°44'37"	49.39	1623.00	S47°42'35"W	49.39
C55	01°44'37"	49.39	1623.00	S45°57'58"W	49.39
C56	01°44'37"	49.39	1623.00	S44°13'21"W	49.39
C57	01°44'37"	49.39	1623.00	S42°28'44"W	49.39
C58	01°44'37"	49.39	1623.00	S40°44'06"W	49.39
C59	01°44'37"	49.39	1623.00	S38°59'30"W	49.39
C60	01°44'37"	49.39	1623.00	S37°14'53"W	49.39
C61	01°04'31"	30.46	1623.00	S35°50'19"W	30.46
C62	79°11'21"	34.55	25.00	S74°53'44"W	31.87

PUBLIC UTILITY EASEMENTS

PUBLIC UTILITY EASEMENTS shown on this plat are granted for the common and joint use of:

- The PNM Electric Services for the installation, maintenance, and service of overhead and underground electrical lines, transformers, poles and any other equipment, fixtures, structures and related facilities reasonably necessary to provide electrical service.
- The PNM Gas Services for installation, maintenance, and service of natural gas lines, valves and other equipment and facilities reasonably necessary to provide natural gas.
- U.S. West for the installation, maintenance and service of all buried and aerial communication lines and other related equipment and facilities reasonably necessary to provide communication services, including, but not limited to, above ground pedestals and closures.
- Jones Intercable for the installation, maintenance, and service of such lines, cables and other related equipment and facilities reasonably necessary to provide Cable TV service.

Included, is the right to build, rebuild, construct, reconstruct, locate, relocate, change, remove, modify, renew, operate, and maintain facilities for the purpose described above, together with free access to, from and over said easements, including the right and privilege to trim and remove trees, shrubs or bushes which interfere with the purposes set forth herein. No building, sign, pool (aboveground or subsurface), hot tub, concrete or wood decking, or other structure shall be erected or constructed on said easements, nor shall any well be drilled or operated thereon. Property owners shall be solely responsible for correcting any violations of national electrical safety code caused by construction of pools, decking, or any structures adjacent to, within, or near easements shown on this plat.

In approving this plat, PNM Electric and Gas Services does not waive or release any easement or easement rights which may have been granted by prior plat, replat or other document which are not shown on this plat.


DATE: NOVEMBER 1997
AVID JOB No. 6076.1.473

AVID ENGINEERING, INC.
Civil • Structural • Transportation
5801 Osuna Rd. NE - Suite 200
Albuquerque, NM 87109 - (505) 881-5357

SHEET 2 OF 2



SCALE: 1" = 50'

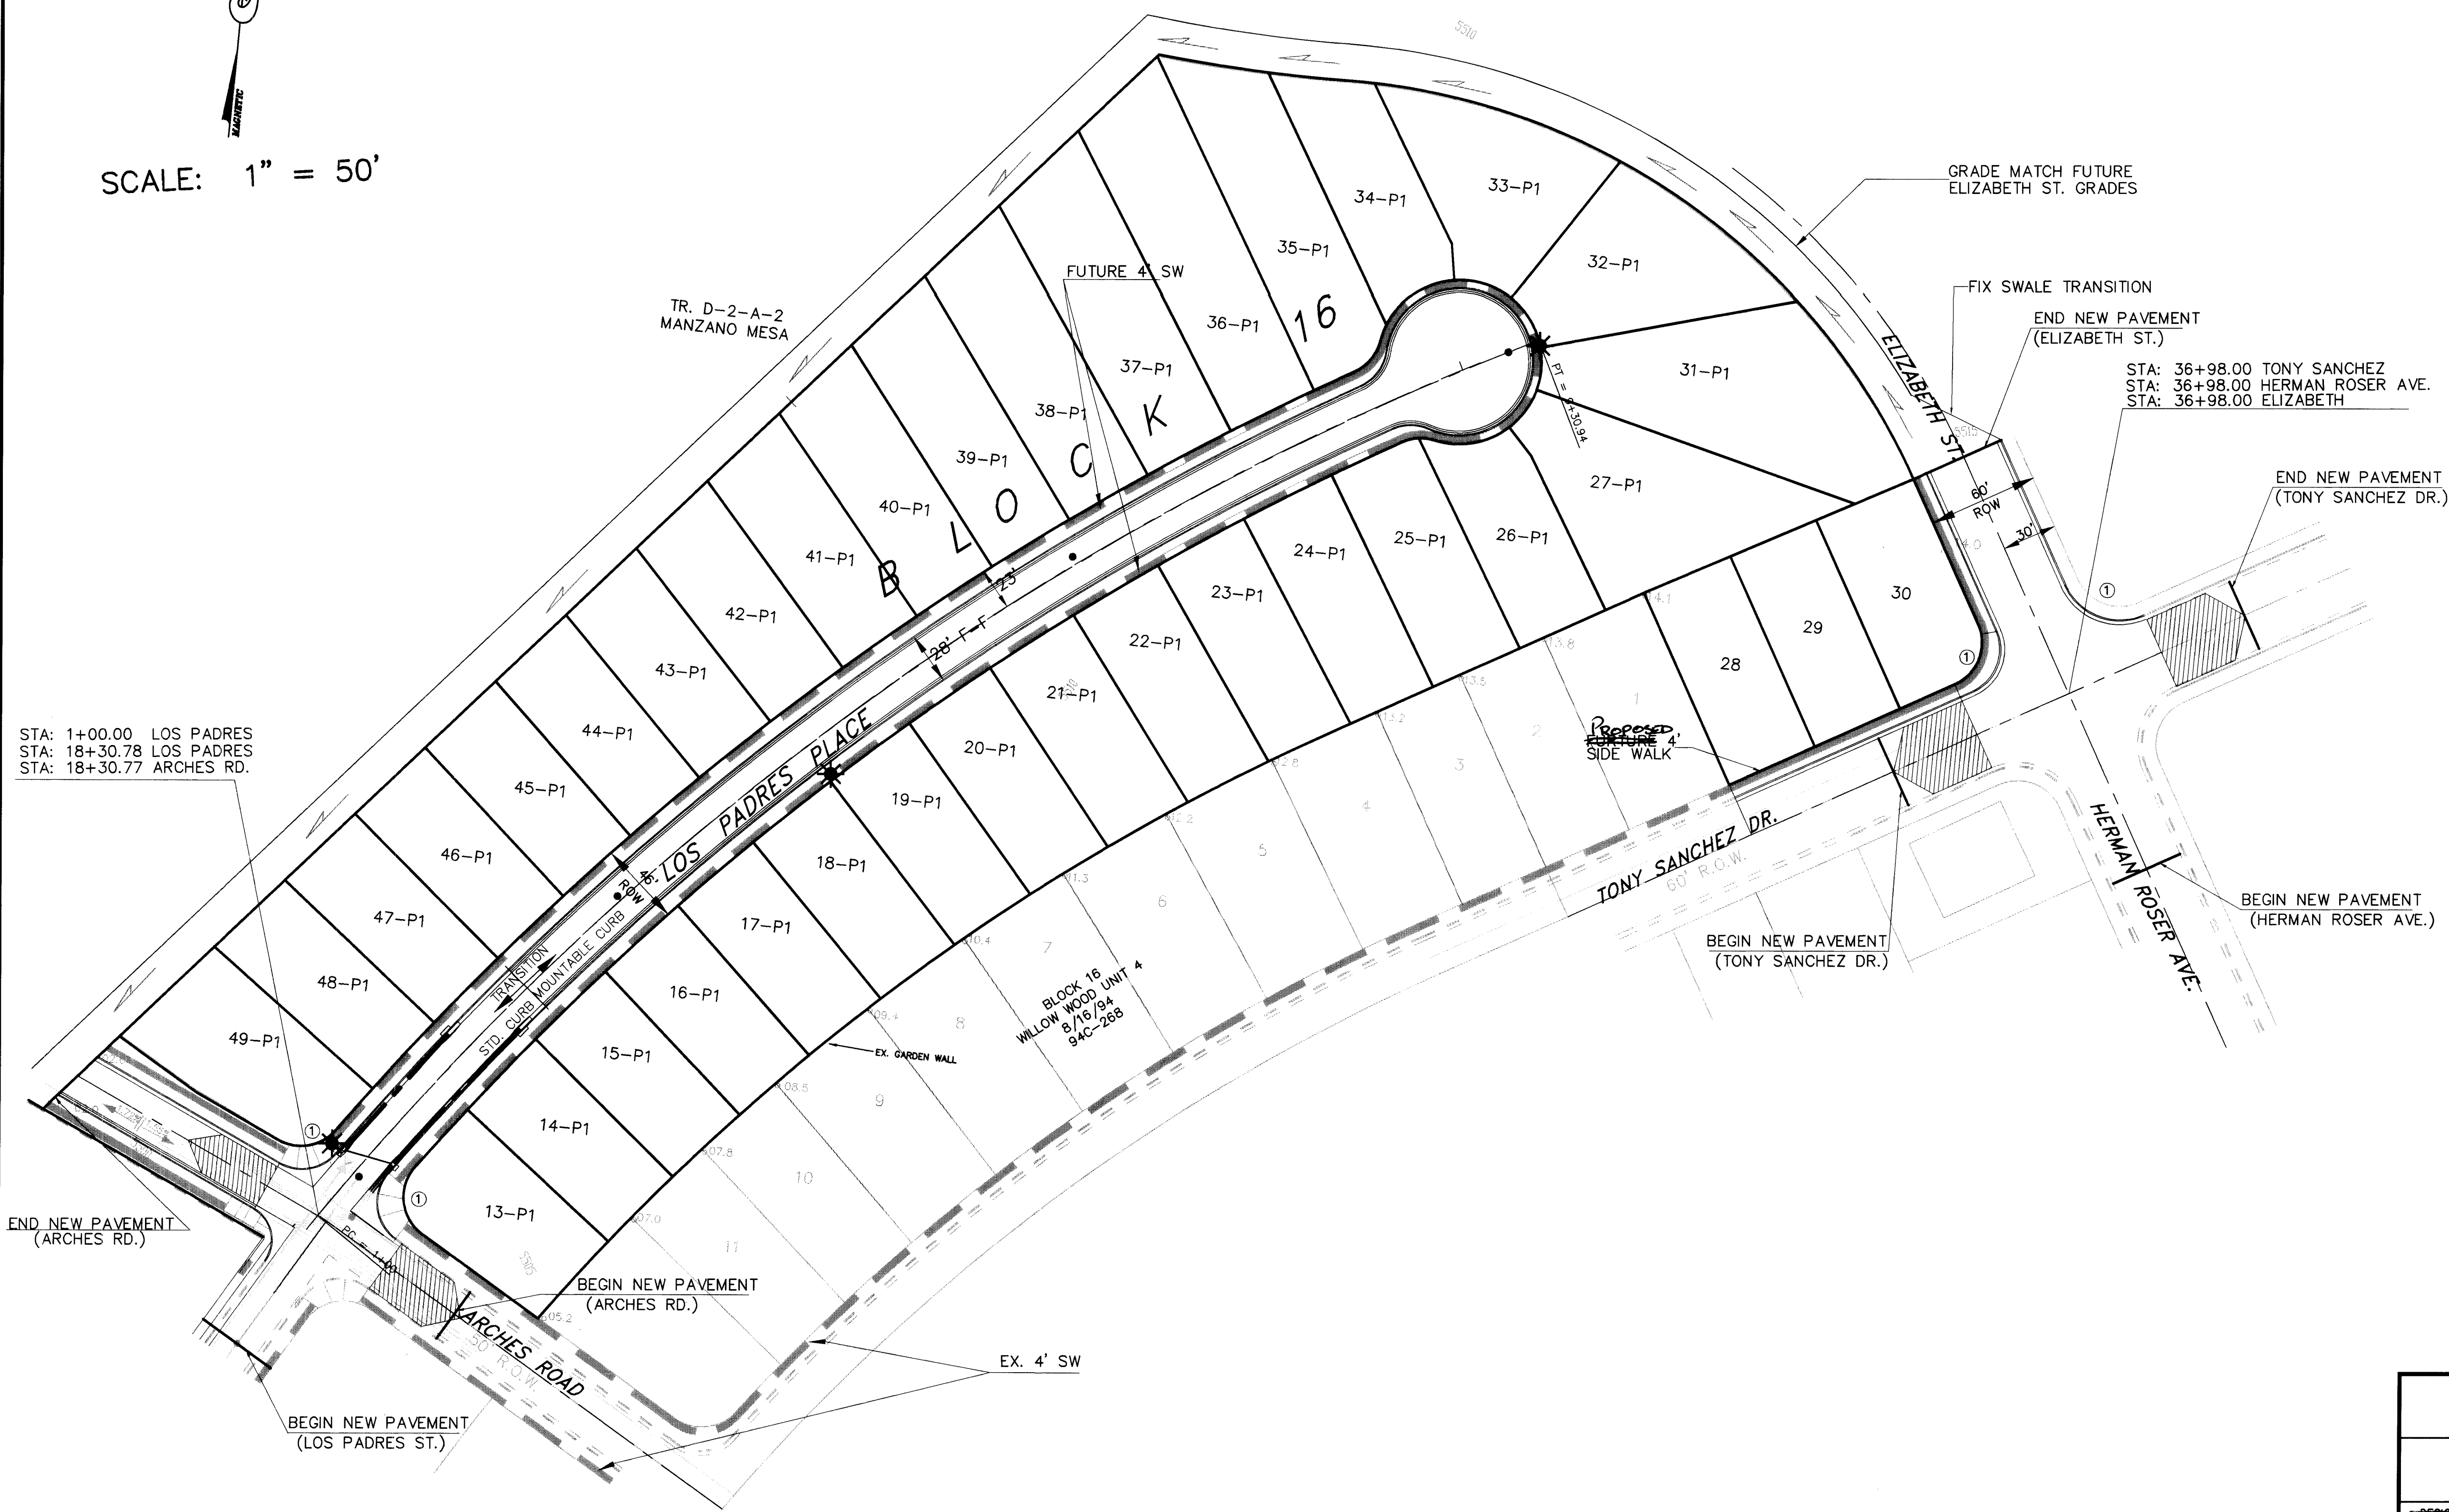

- GENERAL NOTES:**
- ALL STATION AND OFFSET DIMENSIONS ARE BASED ON CENTERLINE OF RIGHT-OF-WAY.
 - ALL ELEVATIONS ARE FLOWLINE UNLESS OTHERWISE NOTED.
 - ALL SIDEWALKS TO BE CONSTRUCTED IN THIS PROJECT ARE SHOWN AS SOLID DILUTED LINES.
 - ALL SIDEWALKS TO BE CONSTRUCTED BY OTHERS ARE SHOWN AS DASHED DILUTED LINES.

- KEYED NOTES**
- CONSTRUCT WHEELCHAIR RAMPS PER COA DWG. 2441, TYPE II.

LOS PADRES PLACE

CURB CURVE DATA				
CURVE	DELTA	RADIUS	LENGTH	TANGENT
CR1	79°31'14"	25.00'	34.70'	20.80'
CR2	25°52'28"	1614.00'	728.87'	370.78'
CR3	37°41'49"	25.00'	16.45'	8.53'
CR4	285°40'08"	40.00'	209.41'	-
CR5	68°44'52"	25.00'	30.00'	17.10'
CR6	24°38'48"	1586.00'	682.24'	346.48'
CR7	95°04'22"	25.00'	41.48'	27.32'
CR8	95°51'31"	25.00'	41.83'	27.70'

CENTERLINE CURVE DATA				
CURVE	DELTA	RADIUS	LENGTH	TANGENT
CL1	28°30'50"	1600.00'	796.26'	406.56'

TANGENT DATA		
TANGENT	BEARING	DISTANCE
T1	S65°30'35"E	119.11'
T2	S65°30'35"E	115.66'

- LEGEND**
- CENTERLINE OF STREET
 - EXISTING CURB & GUTTER
 - FUTURE CURB & GUTTER
 - PROPOSED STANDARD CURB & GUTTER
 - PROPOSED MOUNTABLE CURB & GUTTER
 - PROPOSED WHEELCHAIR RAMP
 - PROPOSED CONCRETE VALLEY GUTTER
 - TRANSITION SECTION FROM FULL CROWN TO NO CROWN SECTION (MINIMUM 50' TRANSITION) SEE CITY STD. DWG. 2401
 - PROPOSED MANHOLE
 - PROPOSED STREET LIGHT LOCATION
 - EXISTING WATER VALVES
 - EXISTING MANHOLE
 - PROPOSED WATER VALVE
 - PROPOSED STORM INLET
 - PROPOSED FIRE HYDRANT
 - PROPOSED DEFERRED 4' SIDEWALK
 - PROPOSED 4' SIDEWALK

AS BUILT INFORMATION		BENCH MARKS		SURVEY INFORMATION		ENGINEER'S SEAL	
CONTRACTOR	DATE	STATION MARK IS A STANDARD ACS BRASS TABLET STAMPED "1-L21 RESET 1974" LOCATED 7.8 MILES EAST OF DOWNTOWN ALBUQUERQUE, AT THE INTERSECTION OF CENTRAL AVE. AND JUAN TABO BLVD. THE STATION IS ON THE MEDIAN STRIP OF CENTRAL AVE., 81' WEST OF THE CENTERLINE OF JUAN TABO BLVD. AND FLUSH WITH THE CURB. SLD ELEV. 5534.63	DATE	NO.	BY	NO.	DATE
WORK BY	DATE		DATE				
INSPECTOR'S ACCEPTANCE BY	DATE		DATE				
VERIFICATION BY	DATE		DATE				
DRAWINGS PREPARED BY	DATE		DATE				
MICRO-FILM INFORMATION							
RECORDED BY	DATE						
NO.							

CITY OF ALBUQUERQUE
PUBLIC WORKS DEPARTMENT
TRANSPORTATION DEVELOPMENT

OVERALL PAVING PLAN
WILLOW WOOD UNIT 6 SUBDIVISION


DESIGN REVIEW COMMITTEE
MAR 26 1998

APPROVED
CITY ENGINEER

City Project No.
4604.96

Zone Map No.
L-21-Z

Sheet 3 Of 11
13

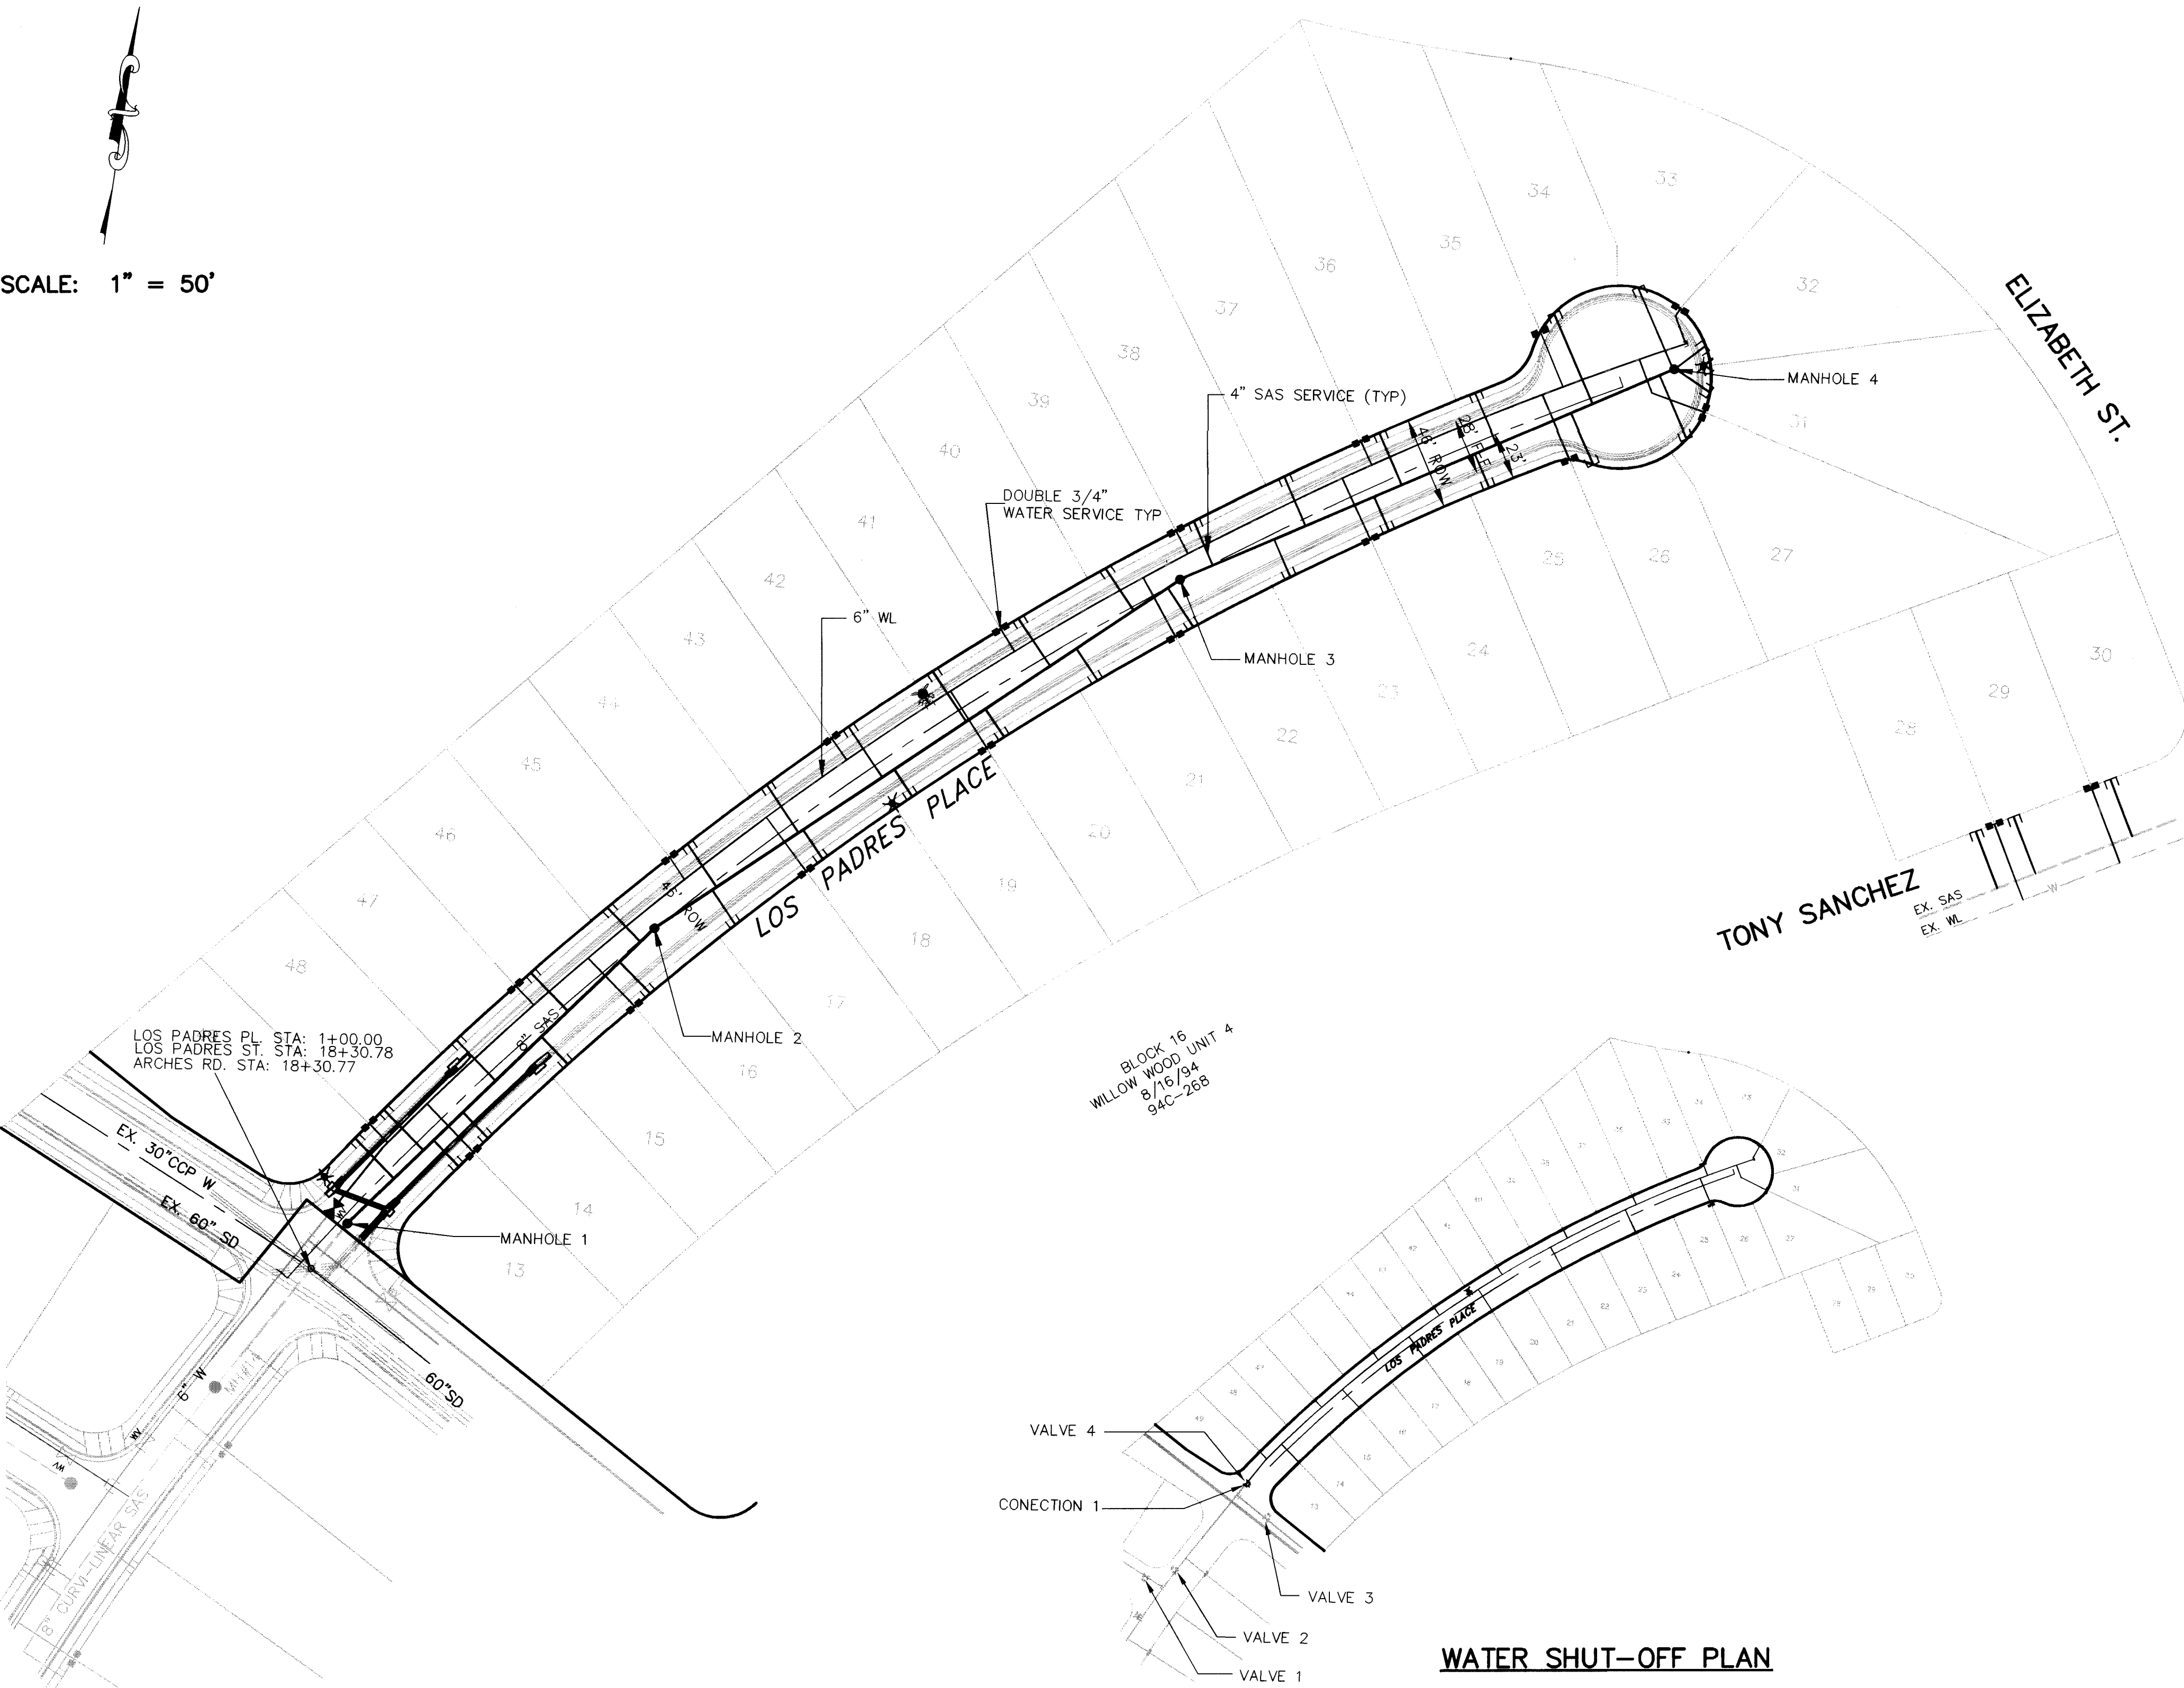

SCALE: 1" = 50'

- UTILITY NOTES**
- STATIONING ALONG C. OF STREET UNLESS OTHERWISE NOTED.
 - SANITARY SEWER LINE LENGTHS COMPUTED FROM MH C. TO MH C.
 - SLOPES ARE COMPUTED INVERT TO INVERT. MH RIM ELEVATIONS GIVEN ARE APPROXIMATE. CONTRACTOR SHALL ADJUST ALL RIMS TO FINAL GRADE.
 - CONTRACTOR IS RESPONSIBLE FOR COORDINATION WITH UTILITY COMPANIES.
 - CONTRACTOR SHALL VERIFY ALL EXISTING UTILITIES AND UTILITY CONNECTIONS PRIOR TO BEGINNING CONSTRUCTION. SHOULD A CONFLICT EXIST OR DESIGN REVISIONS BE REQUIRED FOR ANY REASON, THE CONTRACTOR SHALL NOTIFY THE ENGINEER AND ALLOW SUFFICIENT TIME FOR DESIGN REVISIONS SO AS TO NOT DELAY THE CONSTRUCTION SCHEDULE.
 - REFER TO CITY OF ABO. STANDARD DRAWINGS FOR WATER & SANITARY SEWER CONSTRUCTION.

WATER SHUT-OFF PLAN REQUIREMENTS

CONTRACTOR WILL BE RESPONSIBLE FOR THE TIMING AND COORDINATION OF THE WATER SHUT-OFF REQUIREMENTS IN CONJUNCTION WITH THE COMPLETION OF THIS PROJECT.

AT LEAST FIVE (5) WORKING DAYS PRIOR TO CONSTRUCTION, THE CONTRACTOR SHALL CONTACT PWD/WATER SYSTEMS DIVISION (857-8200) TO INITIATE IMPLEMENTATION OF THIS WATER SHUT-OFF PLAN.

ALL NEW WATERLINE/FIRE HYDRANT INSTALLATIONS MUST BE FLUSHED PRIOR TO BACKFILLING OF LINES.

WATER SHUT-OFF PLAN

CONNECTION CLOSE VALVES

LOS PADRES PL. 2, 3
NON-PRESSURE (SEE DETAIL, THIS SHEET)
CONNECTION

- LEGEND**
- EXISTING WATERLINE
 - EXISTING STORM DRAIN
 - EXISTING SANITARY SEWER
 - EXISTING MANHOLE
 - EXISTING FIRE HYDRANT
 - EXISTING GATE VALVE
 - PROPOSED WATERLINE
 - PROPOSED STORM DRAIN
 - PROPOSED SANITARY SEWER
 - PROPOSED MANHOLE
 - PROPOSED FIRE HYDRANT
 - PROPOSED GATE VALVE
 - PROPOSED CAP OR PLUG
 - PROPOSED SINGLE METER, WATER SERVICE LINE
 - PROPOSED DOUBLE METER, WATER SERVICE LINES
 - PROPOSED SANITARY SEWER SERVICE LINE
 - PROPOSED CROSS, TEE, OR ELBOW
 - STORM INLETS
 - STREET LIGHT

CITY OF ALBUQUERQUE PUBLIC WORKS DEPARTMENT TRANSPORTATION DEVELOPMENT			
OVERALL UTILITY PLAN WILLOW WOOD UNIT 6 SUBDIVISION			
DESIGN REVIEW COMMITTEE MAR 26 1998	CITY ENGINEER MAR 8 1998	MO./DAY/YR.	MO./DAY/YR.
City Project No. 4604.96	Zone Map No. L-21-Z	Sheet 4	Of 11



20" DRAINAGE EASEMENT—
FOR DIVERSION BERM/SWALE



(IN FEET)
1 inch = 40 ft



NTS

PROPOSED BUILDING
PAD ELEVATION

15-P1
06.1


- 1) ALL ELEVATIONS SHOWN ARE MEAN SEA LEVEL (MSL)
- 2) TRUNCATED ELEVATIONS:
ADD 5500.00 MSL
- 3) ALL BACKYARD SLOPES ARE 4:1 UNLESS OTHERWISE NOTED

AVID ENGINEERING, INC.
Civil • Structural • Transportation
5801 Osuna Rd. NE - Suite 200
Albuquerque, NM 87109 - (505) 881-5357

CITY OF ALBUQUERQUE PUBLIC WORKS DEPARTMENT TRANSPORTATION DEVELOPMENT	
TITLE:	WILLOW WOOD UNIT 6 GRADING AND DRAINAGE PLAN

DESIGN REVIEW COMMITTEE	CITY ENGINEER APPROVAL	MO./DAY/YR.	NO./DAY/YR.
			
City Project No.	Zone Map No. L-21-Z	Sheet 5	Of 113

SCANNED BY
BY LASON

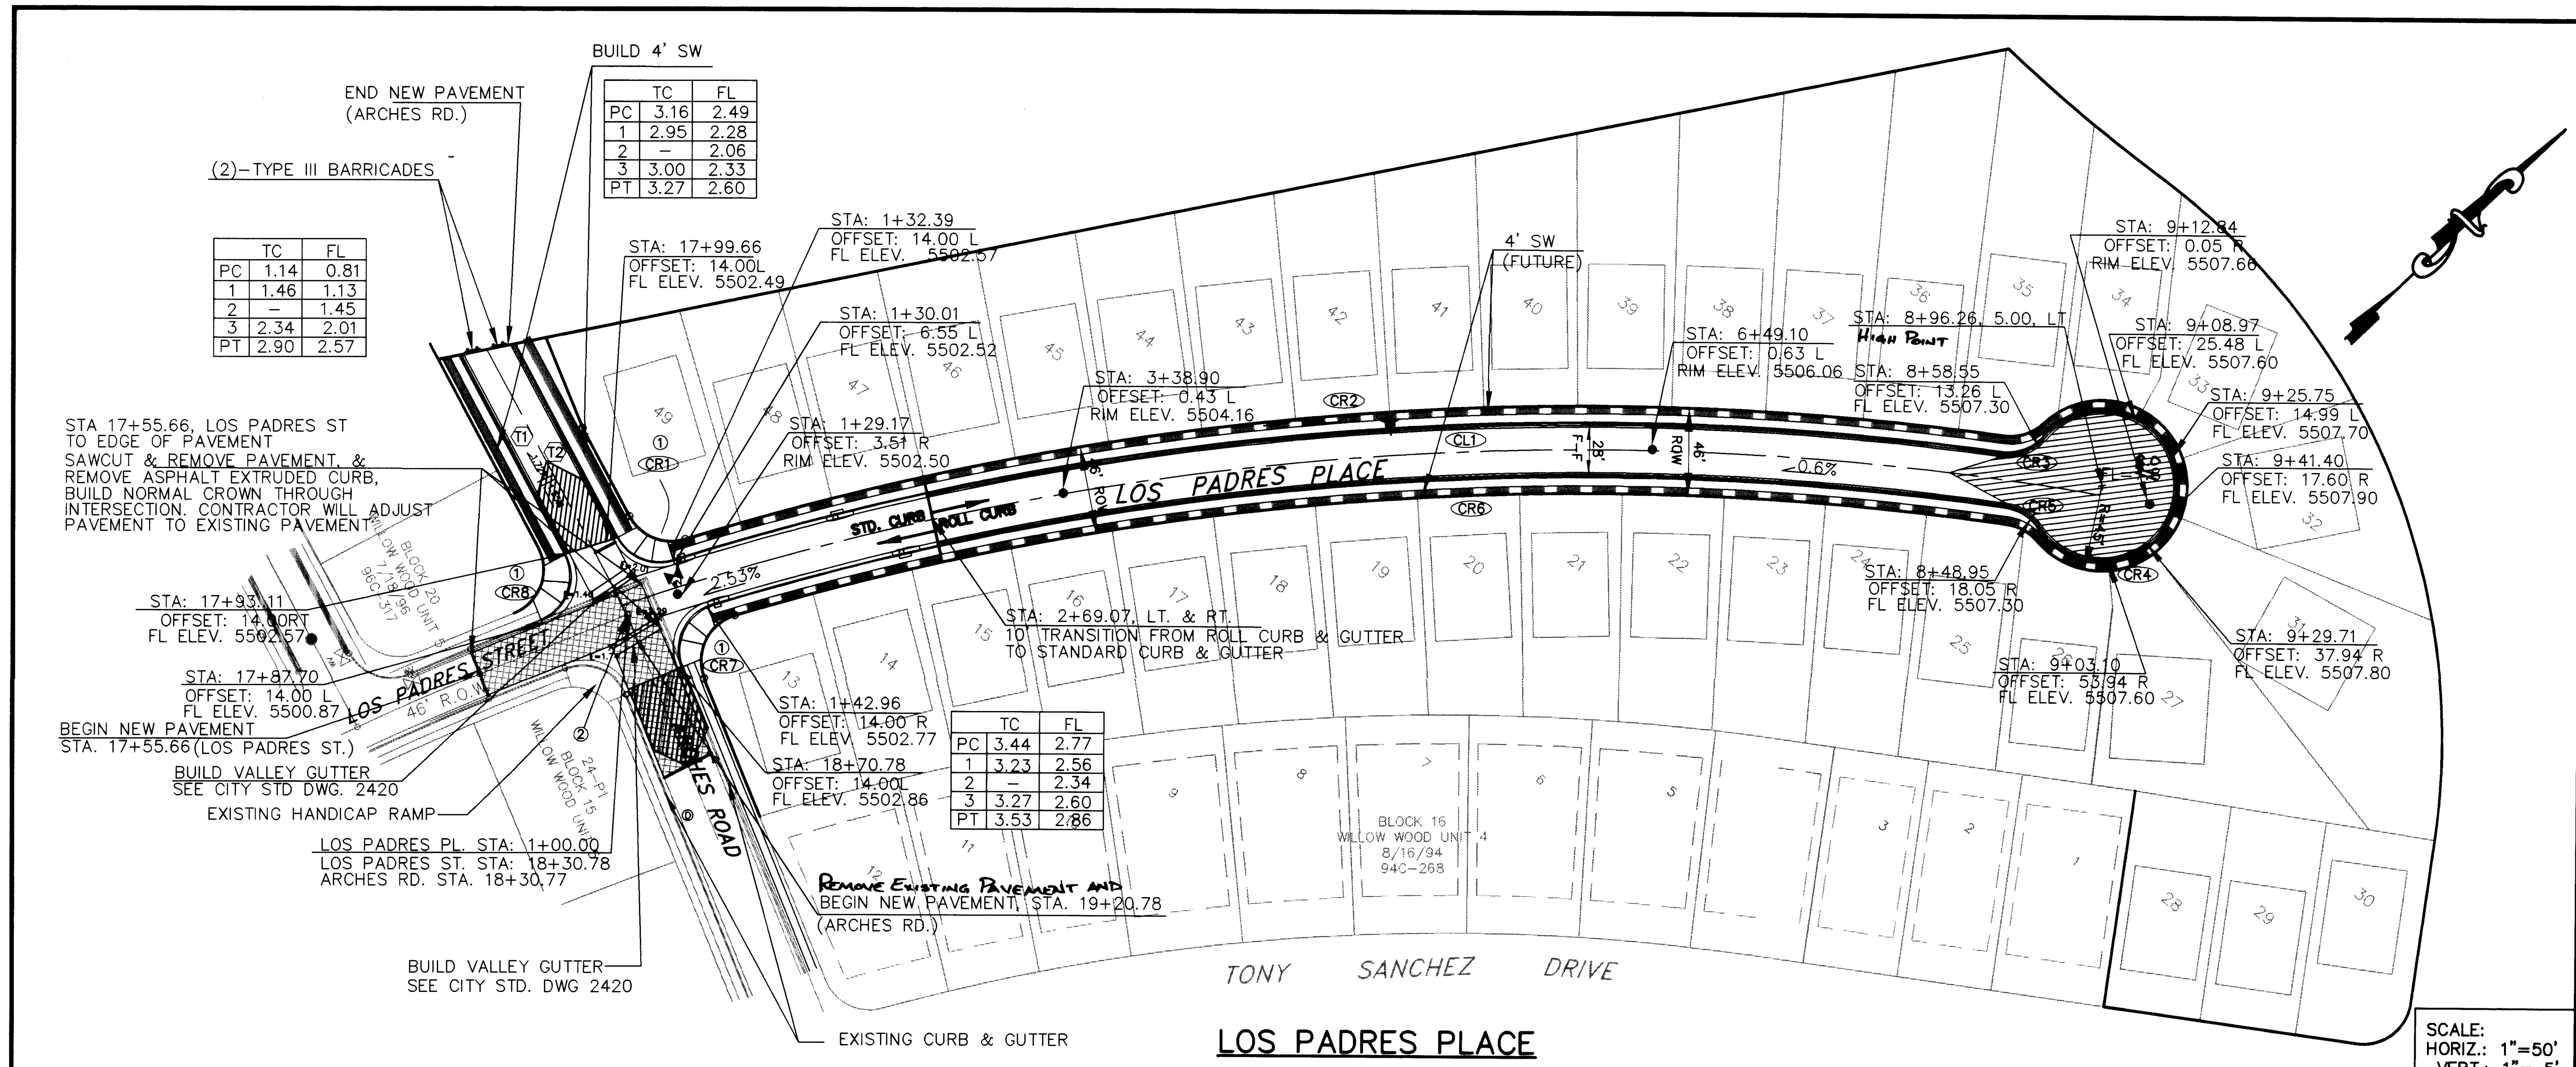

GENERAL NOTES:

- ALL STATION AND OFFSET DIMENSIONS ARE BASED ON CENTERLINE OF RIGHT-OF-WAY.
- ALL ELEVATIONS ARE FLOWLINE UNLESS OTHERWISE NOTED.
- ALL SIDEWALKS TO BE CONSTRUCTED IN THIS PROJECT ARE SHOWN AS SOLID DILUTED LINES.
- ALL SIDEWALKS TO BE CONSTRUCTED BY OTHERS ARE SHOWN AS DASHED DILUTED LINES.

KEYED NOTES

- CONSTRUCT WHEELCHAIR RAMPS PER COA DWG. 2441, TYPE II.
- TRANSITION THE CENTER LINES OF LOS PADRES ST. & LOS PADRES PL. LINEARLY THROUGH THE INTERSECTION. THE NORMAL CROWN SHALL CONTINUE THROUGH THE INTERSECTION ALONG THE CENTERLINE TRANSITION.

LOS PADRES PLACE

CURB CURVE DATA

CURVE	DELTA	RADIUS	LENGTH	TANGENT
CR1	79°31'14"	25.00'	34.70'	20.80'
CR2	25°52'28"	1614.00'	728.87'	370.76'
CR3	37°41'49"	25.00'	16.45'	8.53'
CR4	285°40'08"	40.00'	209.41'	-
CR5	68°44'52"	25.00'	30.00'	17.10'
CR6	24°38'48"	1586.00'	682.24'	346.48'
CR7	95°04'22"	25.00'	41.48'	27.32'
CR8	95°51'31"	25.00'	41.83'	27.70'

CENTERLINE CURVE DATA

CURVE	DELTA	RADIUS	LENGTH	TANGENT
CL1	28°30'50"	1600.00'	796.26'	406.56'

TANGENT DATA



TANGENT	BEARING	DISTANCE
T1	S65°30'35"E	119.11'
T2	S65°30'35"E	115.66'

LEGEND

- CENTERLINE OF STREET
- EXISTING CURB & GUTTER
- PROPOSED STANDARD CURB & GUTTER
- PROPOSED MOUNTABLE CURB & GUTTER
- PROPOSED WHEELCHAIR RAMP
- TRANSITION SECTION FROM FULL CROWN TO NO CROWN SECTION (MINIMUM 50' TRANSITION) SEE CITY STD. DWG. 2501
- PROPOSED MANHOLE
- PROPOSED STREET LIGHT LOCATION
- EXISTING WATER VALVES
- EXISTING MANHOLE
- PROPOSED WATER VALVE
- PROPOSED STORM INLET
- PROPOSED FIRE HYDRANT
- PROPOSED DERERRED SIDEWALK
- PROPOSED SIDEWALK
- SAWCUT, REMOVE & REPLACE EXISTING PAVEMENT

CITY OF ALBUQUERQUE
PUBLIC WORKS DEPARTMENT
TRANSPORTATION DEVELOPMENT


LOS PADRES PLACE PAVING PLAN & PROFILE
WILLOW WOOD UNIT 6 SUBDIVISION

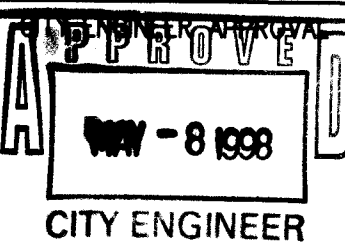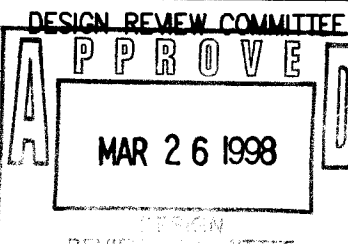


City Project No.
4604.96

Zone Map No.
L-21-Z

Sheet 6 Of 11
13

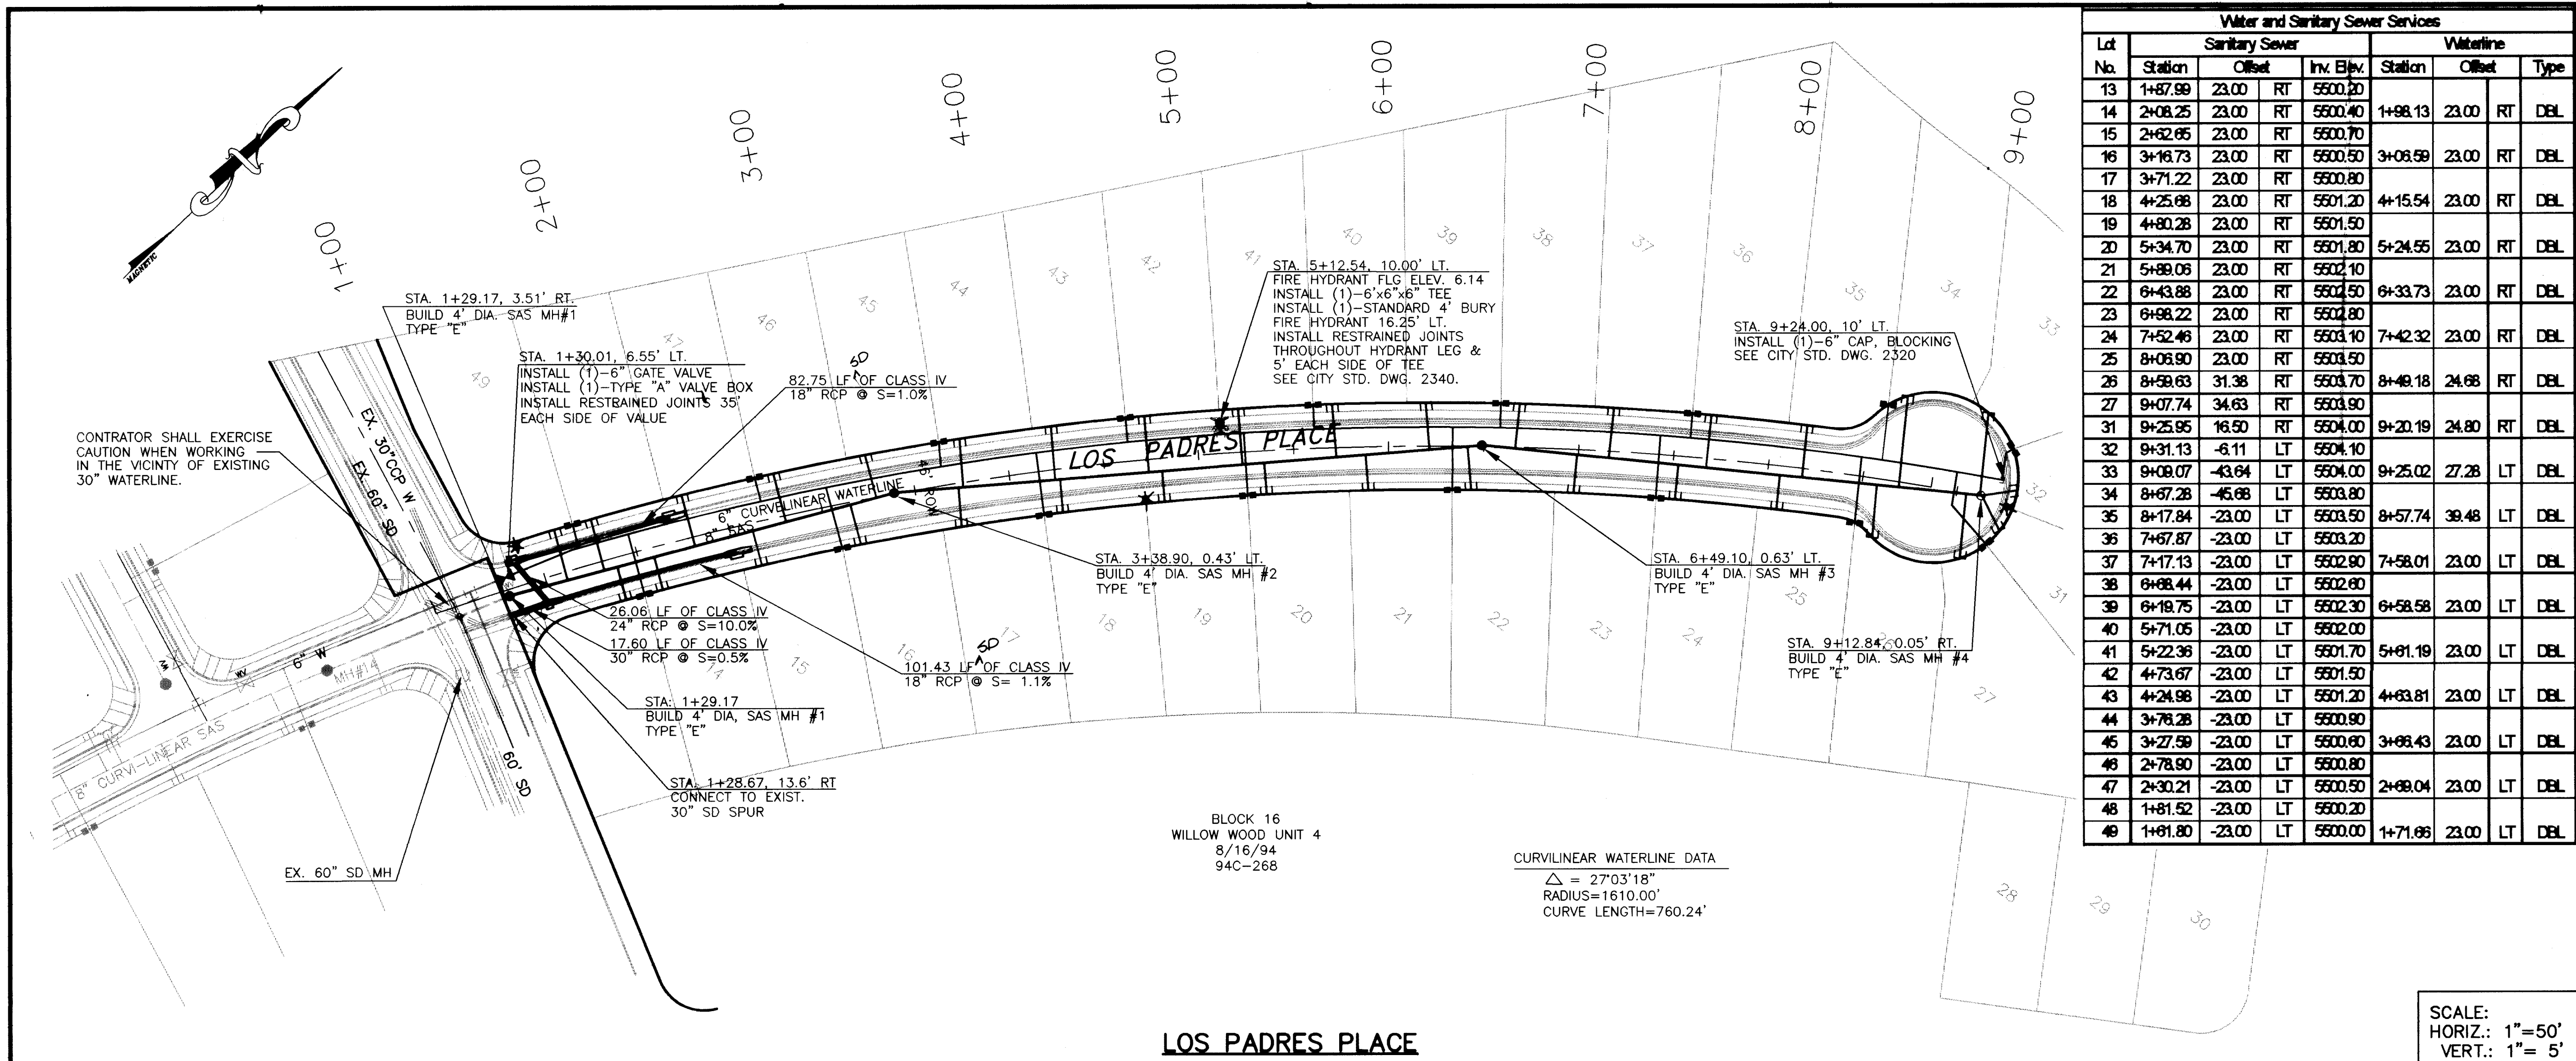

Water and Sanitary Sewer Services									
Lot No.	Sanitary Sewer			Waterline			Station	Offset	Type
	Station	Offset	Inv. Elev.	Station	Offset	Inv. Elev.			
13	1+87.99	23.00	RT	5500.20	1+98.13	23.00	RT	DEL	
14	2+08.25	23.00	RT	5500.40					
15	2+62.65	23.00	RT	5500.70					
16	3+16.73	23.00	RT	5500.50	3+08.59	23.00	RT	DEL	
17	3+71.22	23.00	RT	5500.80					
18	4+25.98	23.00	RT	5501.20	4+15.54	23.00	RT	DEL	
19	4+80.28	23.00	RT	5501.50					
20	5+34.70	23.00	RT	5501.80	5+24.55	23.00	RT	DEL	
21	5+89.08	23.00	RT	5502.10					
22	6+43.88	23.00	RT	5502.50	6+33.73	23.00	RT	DEL	
23	6+98.22	23.00	RT	5502.80					
24	7+52.49	23.00	RT	5503.10	7+42.32	23.00	RT	DEL	
25	8+06.90	23.00	RT	5503.50					
26	8+59.63	31.38	RT	5503.70	8+49.18	24.68	RT	DEL	
27	9+07.74	34.63	RT	5503.90					
31	9+25.95	16.50	RT	5504.00	9+20.19	24.80	RT	DEL	
32	9+31.13	-6.11	LT	5504.10					
33	9+08.07	-43.64	LT	5504.00	9+25.02	27.28	LT	DEL	
34	8+57.28	-45.68	LT	5503.80					
35	8+17.84	-23.00	LT	5503.50	8+57.74	39.48	LT	DEL	
36	7+67.87	-23.00	LT	5503.20					
37	7+17.13	-23.00	LT	5502.90	7+58.01	23.00	LT	DEL	
38	6+68.44	-23.00	LT	5502.60					
39	6+19.75	-23.00	LT	5502.30	6+58.58	23.00	LT	DEL	
40	5+71.05	-23.00	LT	5502.00					
41	5+22.36	-23.00	LT	5501.70	5+91.19	23.00	LT	DEL	
42	4+73.67	-23.00	LT	5501.50					
43	4+24.98	-23.00	LT	5501.20	4+93.81	23.00	LT	DEL	
44	3+76.28	-23.00	LT	5500.90					
45	3+27.59	-23.00	LT	5500.60	3+93.43	23.00	LT	DEL	
46	2+78.80	-23.00	LT	5500.80					
47	2+30.21	-23.00	LT	5500.50	2+98.04	23.00	LT	DEL	
48	1+81.52	-23.00	LT	5500.20					
49	1+81.80	-23.00	LT	5500.00	1+71.66	23.00	LT	DEL	

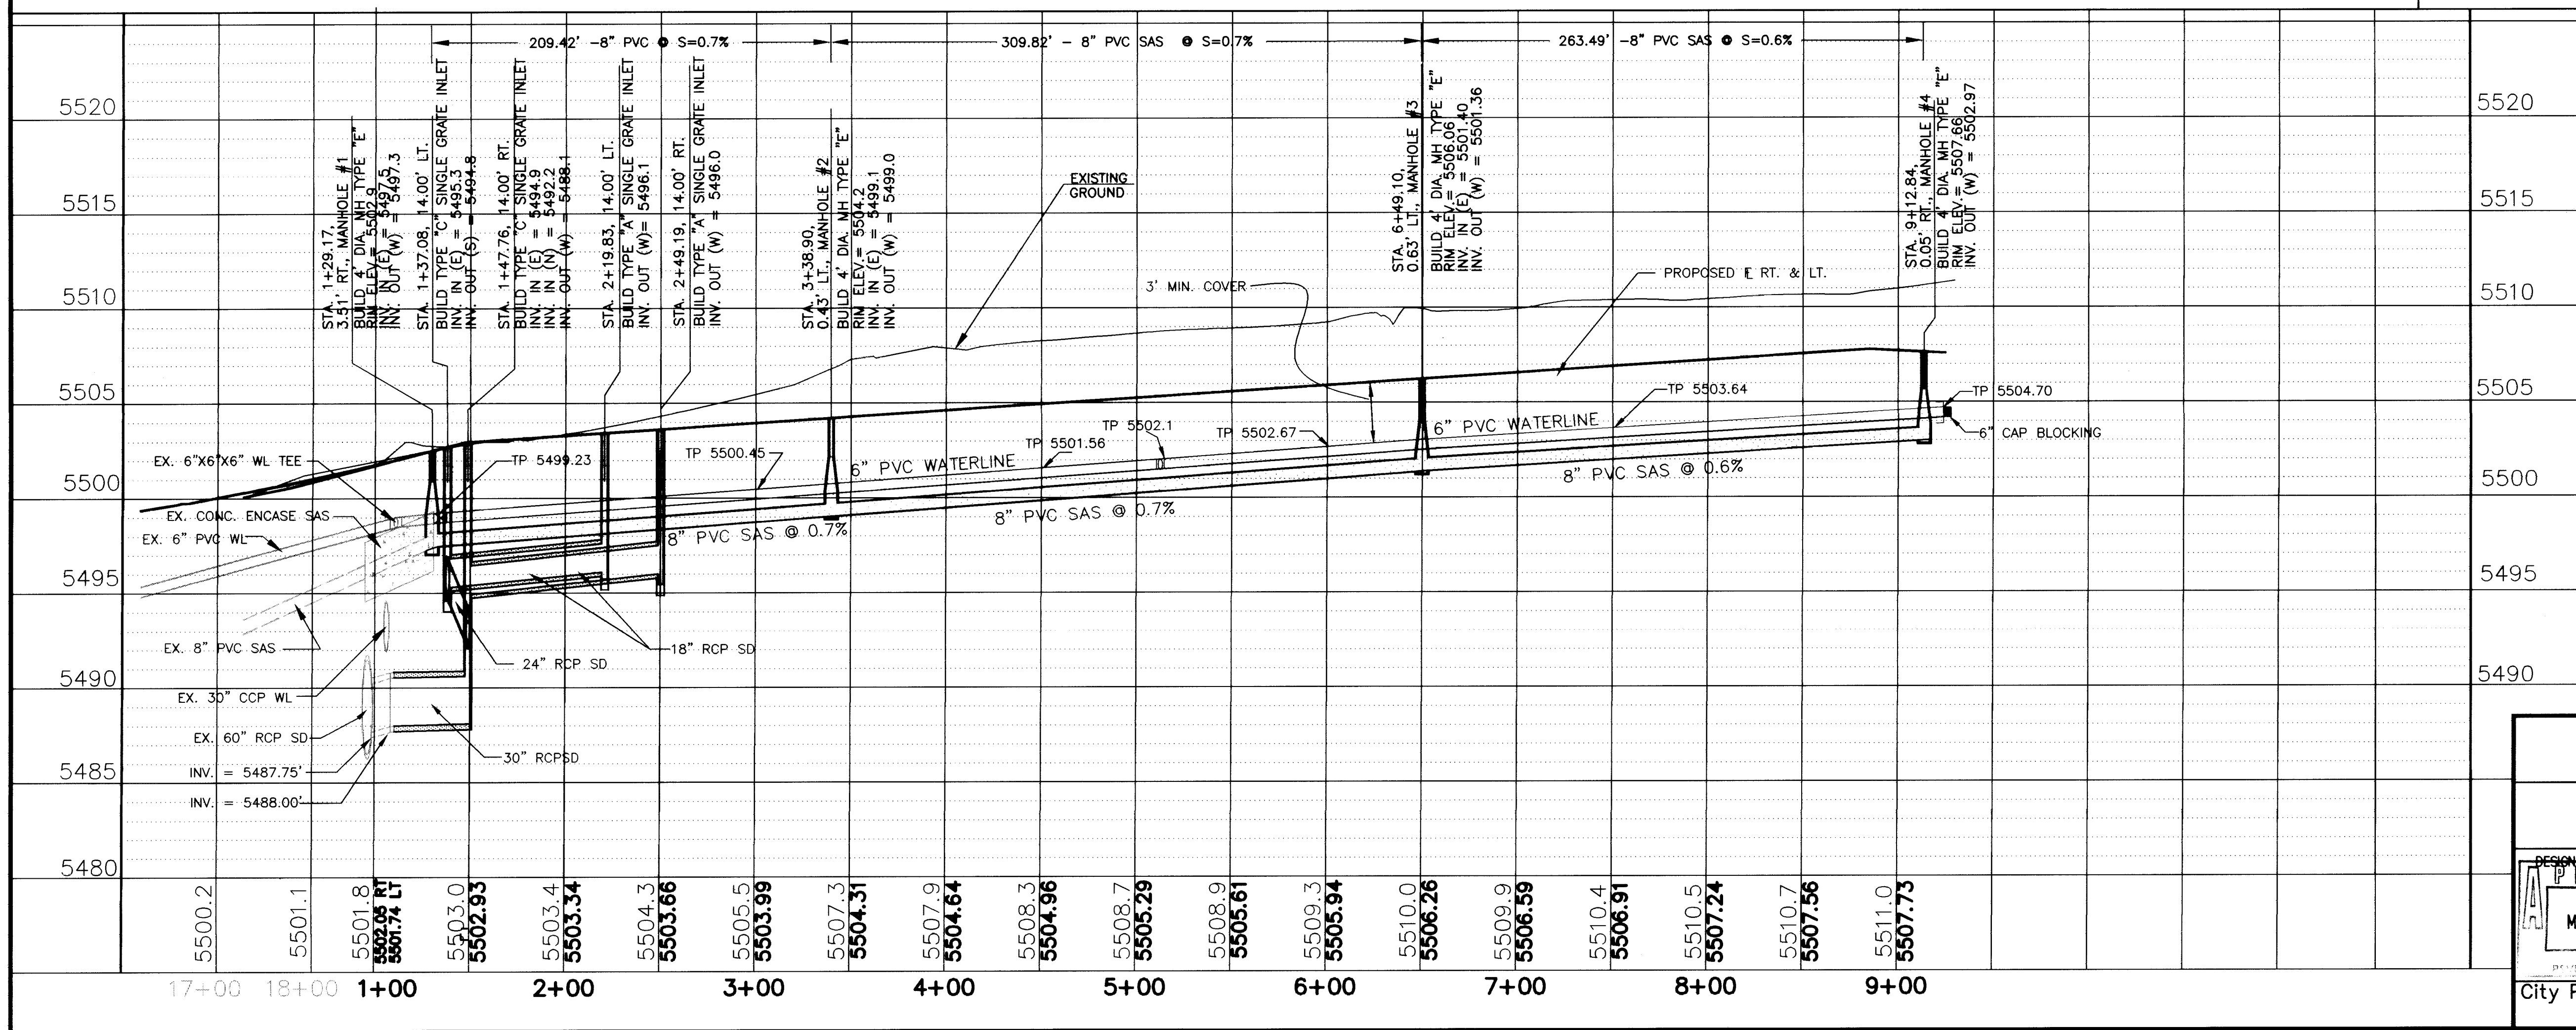

UTILITY NOTES

- STATIONING ALONG C. OF STREET UNLESS OTHERWISE NOTED.
- SANITARY SEWER LINE LENGTHS COMPUTED FROM MH C. TO MH C.
- SLOPES ARE COMPUTED INVERT TO INVERT. MH RIM ELEVATIONS GIVEN ARE APPROXIMATE. CONTRACTOR SHALL ADJUST ALL RIMS TO FINAL GRADE.
- CONTRACTOR IS RESPONSIBLE FOR COORDINATION WITH UTILITY COMPANIES.
- CONTRACTOR SHALL VERIFY ALL EXISTING UTILITIES AND UTILITY CONNECTIONS PRIOR TO BEGINNING CONSTRUCTION. SHOULD A CONFLICT EXIST OR DESIGN REVISIONS BE REQUIRED FOR ANY REASON, THE CONTRACTOR SHALL NOTIFY THE ENGINEER AND ALLOW SUFFICIENT TIME FOR DESIGN REVISIONS SO AS TO NOT DELAY THE CONSTRUCTION SCHEDULE.

LEGEND

- W ——— EXISTING WATERLINE
- SD ——— EXISTING STORM DRAIN
- SAS ——— EXISTING SANITARY SEWER
- ——— EXISTING MANHOLE
- ★ ——— EXISTING FIRE HYDRANT
- EXISTING GATE VALVE
- W ——— PROPOSED WATERLINE
- SD ——— PROPOSED STORM DRAIN
- SAS ——— PROPOSED SANITARY SEWER
- ——— PROPOSED MANHOLE
- ★ ——— PROPOSED FIRE HYDRANT
- PROPOSED GATE VALVE
- PROPOSED CAP OR PLUG
- PROPOSED SINGLE METER, WATER SERVICE LINE
- PROPOSED DOUBLE METER, WATER SERVICE LINES
- PROPOSED SANITARY SEWER SERVICE LINE
- + + + PROPOSED CROSS, TEE, OR ELBOW
- ★ ——— STREET LIGHT

AS BUILT INFORMATION

CONTRACTOR	DATE

BENCH MARKS

THE STATION MARK IS A STANDARD ACS BRASS TABLET, STAMPED "1-121 RESET 1974", LOCATED 7.8 MILES EAST OF DOWNTOWN ALBUQUERQUE, AT THE INTERSECTION OF CENTRAL AVE. AND JUAN TABO BLVD. THE STATION IS ON THE MEDIAN STRIP OF CENTRAL AVE., 81' WEST OF THE CENTERLINE OF JUAN TABO BLVD. AND FLUSH WITH THE CURB. 3-D. ELEV. 5534.63

SURVEY INFORMATION

NO.	DATE	BY

ENGINEER'S SEAL

NO.	DATE	REMARKS	BY

DESIGNED BY	DATE
DRAWN BY	DATE
CHECKED BY	DATE

CITY OF ALBUQUERQUE
PUBLIC WORKS DEPARTMENT
TRANSPORTATION DEVELOPMENT

LOS PADRES PLACE UTILITY PLAN & PROFILE
WILLOW WOOD UNIT 6 SUBDIVISION

APPROVED
MAR 26 1998
DESIGN ENGINEER

APPROVED
MAR 26 1998
CITY ENGINEER


City Project No.
4604.96

Zone Map No.
L-21-Z


Sheet 7 Of 13

ut-lospad.dwg 11-20-97 8:33:18 am EST

SCANNED BY LASON

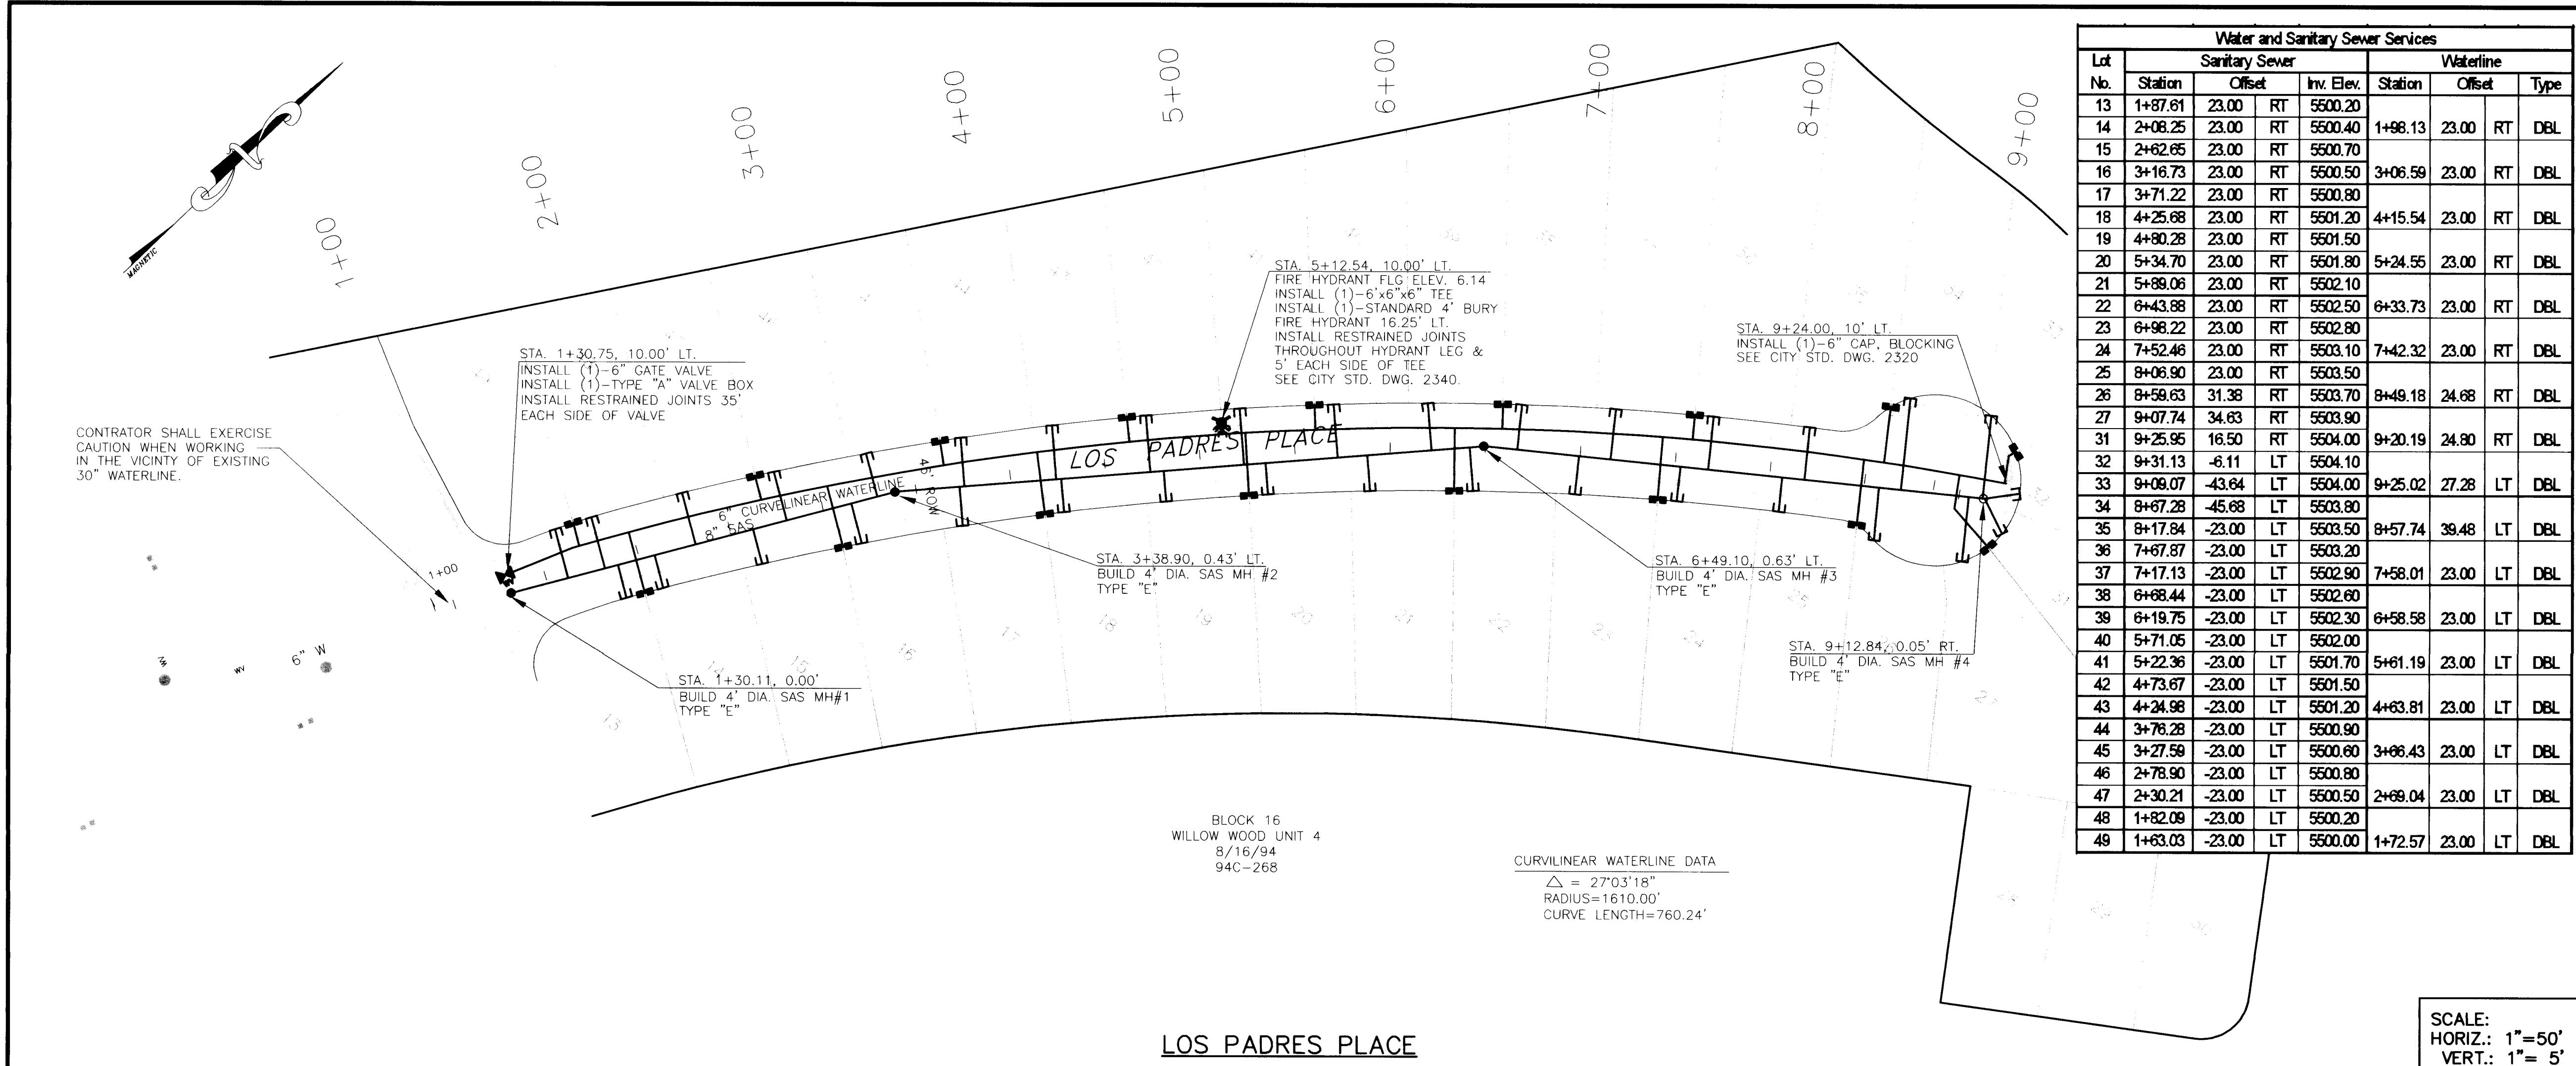

Water and Sanitary Sewer Services									
Lot No.	Sanitary Sewer			Waterline			Station	Offset	Type
	Station	Offset	Inv. Elev.	Station	Offset	Inv. Elev.			
13	1+87.61	23.00	RT	5500.20			1+88.13	23.00	RT DBL
14	2+08.25	23.00	RT	5500.40					
15	2+62.65	23.00	RT	5500.70					
16	3+16.73	23.00	RT	5500.50			3+06.59	23.00	RT DBL
17	3+71.22	23.00	RT	5500.80					
18	4+25.68	23.00	RT	5501.20			4+15.54	23.00	RT DBL
19	4+80.28	23.00	RT	5501.50					
20	5+34.70	23.00	RT	5501.80			5+24.55	23.00	RT DBL
21	5+89.06	23.00	RT	5502.10					
22	6+43.98	23.00	RT	5502.50			6+33.73	23.00	RT DBL
23	6+98.22	23.00	RT	5502.80					
24	7+52.46	23.00	RT	5503.10			7+42.32	23.00	RT DBL
25	8+06.90	23.00	RT	5503.50					
26	8+58.63	31.38	RT	5503.70			8+49.18	24.68	RT DBL
27	9+07.74	34.83	RT	5503.90					
31	9+25.95	16.50	RT	5504.00			9+20.19	24.80	RT DBL
32	9+31.13	-6.11	LT	5504.10					
33	9+08.07	-43.64	LT	5504.00			9+25.02	27.28	LT DBL
34	8+67.28	-45.68	LT	5503.80					
35	8+17.84	-23.00	LT	5503.50			8+57.74	38.48	LT DBL
36	7+67.87	-23.00	LT	5503.20					
37	7+17.13	-23.00	LT	5502.90			7+58.01	23.00	LT DBL
38	6+68.44	-23.00	LT	5502.60					
39	6+19.75	-23.00	LT	5502.30			6+58.58	23.00	LT DBL
40	5+71.05	-23.00	LT	5502.00					
41	5+22.36	-23.00	LT	5501.70			5+61.19	23.00	LT DBL
42	4+73.67	-23.00	LT	5501.50					
43	4+24.98	-23.00	LT	5501.20			4+63.81	23.00	LT DBL
44	3+76.28	-23.00	LT	5500.90					
45	3+27.59	-23.00	LT	5500.60			3+86.43	23.00	LT DBL
46	2+78.90	-23.00	LT	5500.80					
47	2+30.21	-23.00	LT	5500.50			2+88.04	23.00	LT DBL
48	1+82.09	-23.00	LT	5500.20					
49	1+63.03	-23.00	LT	5500.00			1+72.57	23.00	LT DBL

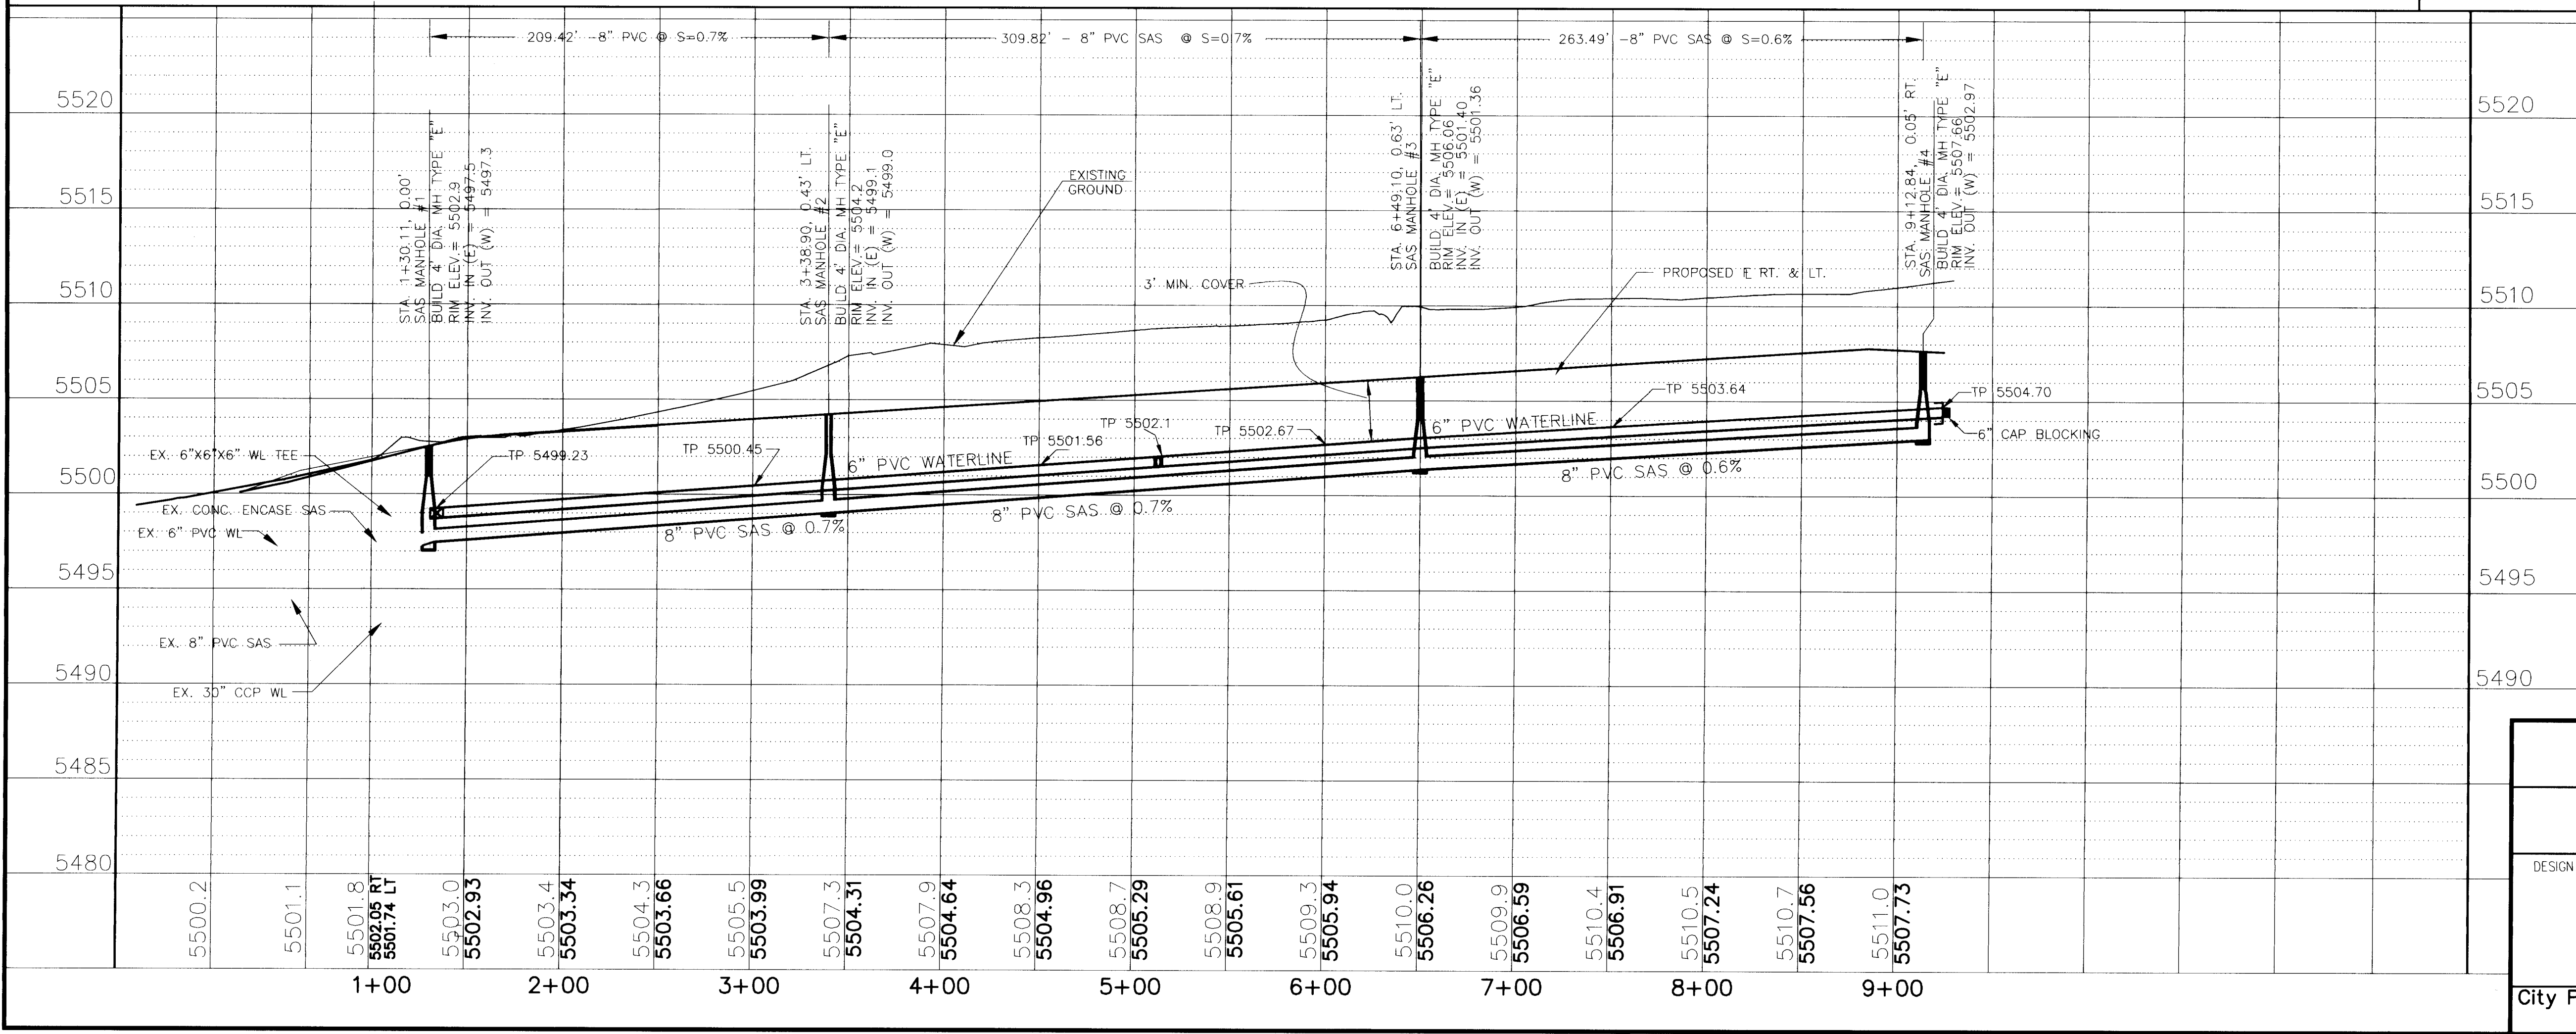

UTILITY NOTES

- STATIONING ALONG C OF STREET UNLESS OTHERWISE NOTED.
- SANITARY SEWER LINE LENGTHS COMPUTED FROM MH C TO MH C.
- SLOPES ARE COMPUTED INVERT TO INVERT. MH RIM ELEVATIONS GIVEN ARE APPROXIMATE. CONTRACTOR SHALL ADJUST ALL RIMS TO FINAL GRADE.
- CONTRACTOR IS RESPONSIBLE FOR COORDINATION WITH UTILITY COMPANIES.
- CONTRACTOR SHALL VERIFY ALL EXISTING UTILITIES AND UTILITY CONNECTIONS PRIOR TO BEGINNING CONSTRUCTION. SHOULD A CONFLICT EXIST OR DESIGN REVISIONS BE REQUIRED FOR ANY REASON, THE CONTRACTOR SHALL NOTIFY THE ENGINEER AND ALLOW SUFFICIENT TIME FOR DESIGN REVISIONS SO AS TO NOT DELAY THE CONSTRUCTION SCHEDULE.

LEGEND

EXISTING WATERLINE
EXISTING STORM DRAIN
EXISTING SANITARY SEWER
EXISTING MANHOLE
EXISTING FIRE HYDRANT
EXISTING GATE VALVE
PROPOSED WATERLINE
PROPOSED STORM DRAIN
PROPOSED SANITARY SEWER
PROPOSED MANHOLE
PROPOSED FIRE HYDRANT
PROPOSED GATE VALVE
PROPOSED CAP OR PLUG
PROPOSED SINGLE METER, WATER SERVICE LINE
PROPOSED DOUBLE METER, WATER SERVICE LINES
PROPOSED SANITARY SEWER SERVICE LINE
PROPOSED CROSS, TEE, OR ELBOW

AS BUILT INFORMATION		BENCH MARKS		SURVEY INFORMATION		ENGINEER'S SEAL	
CONTRACTOR	WORK	STATION MARK IS A STANDARD ACS BRASS TABLET, STAMPED "1-L21 RESET 1974", LOCATED 7.8 MILES EAST OF DOWNTOWN ALBUQUERQUE, AT THE INTERSECTION OF CENTRAL AVE. AND JUAN TABO BLVD. THE STATION IS ON THE MEDIAN STRIP OF CENTRAL AVE., 81' WEST OF CENTERLINE OF JUAN TABO BLVD. AND FLUSH WITH THE CURB. SLD ELEV. 5534.63	DATE	DATE	DATE	DATE	DATE
NO.	NO.	NO.	NO.	NO.	NO.	NO.	NO.


CITY OF ALBUQUERQUE
PUBLIC WORKS DEPARTMENT
TRANSPORTATION DEVELOPMENT

LOS PADRES PLACE UTILITY PLAN & PROFILE
WILLOW WOOD UNIT 6 SUBDIVISION

DESIGN REVIEW COMMITTEE	CITY ENGINEER APPROVAL	MO./DAY/YR.	MO./DAY/YR.


City Project No. 4604.96 Zone Map No. L-21-Z Sheet 7a Of 11

SCANNED BY LASON

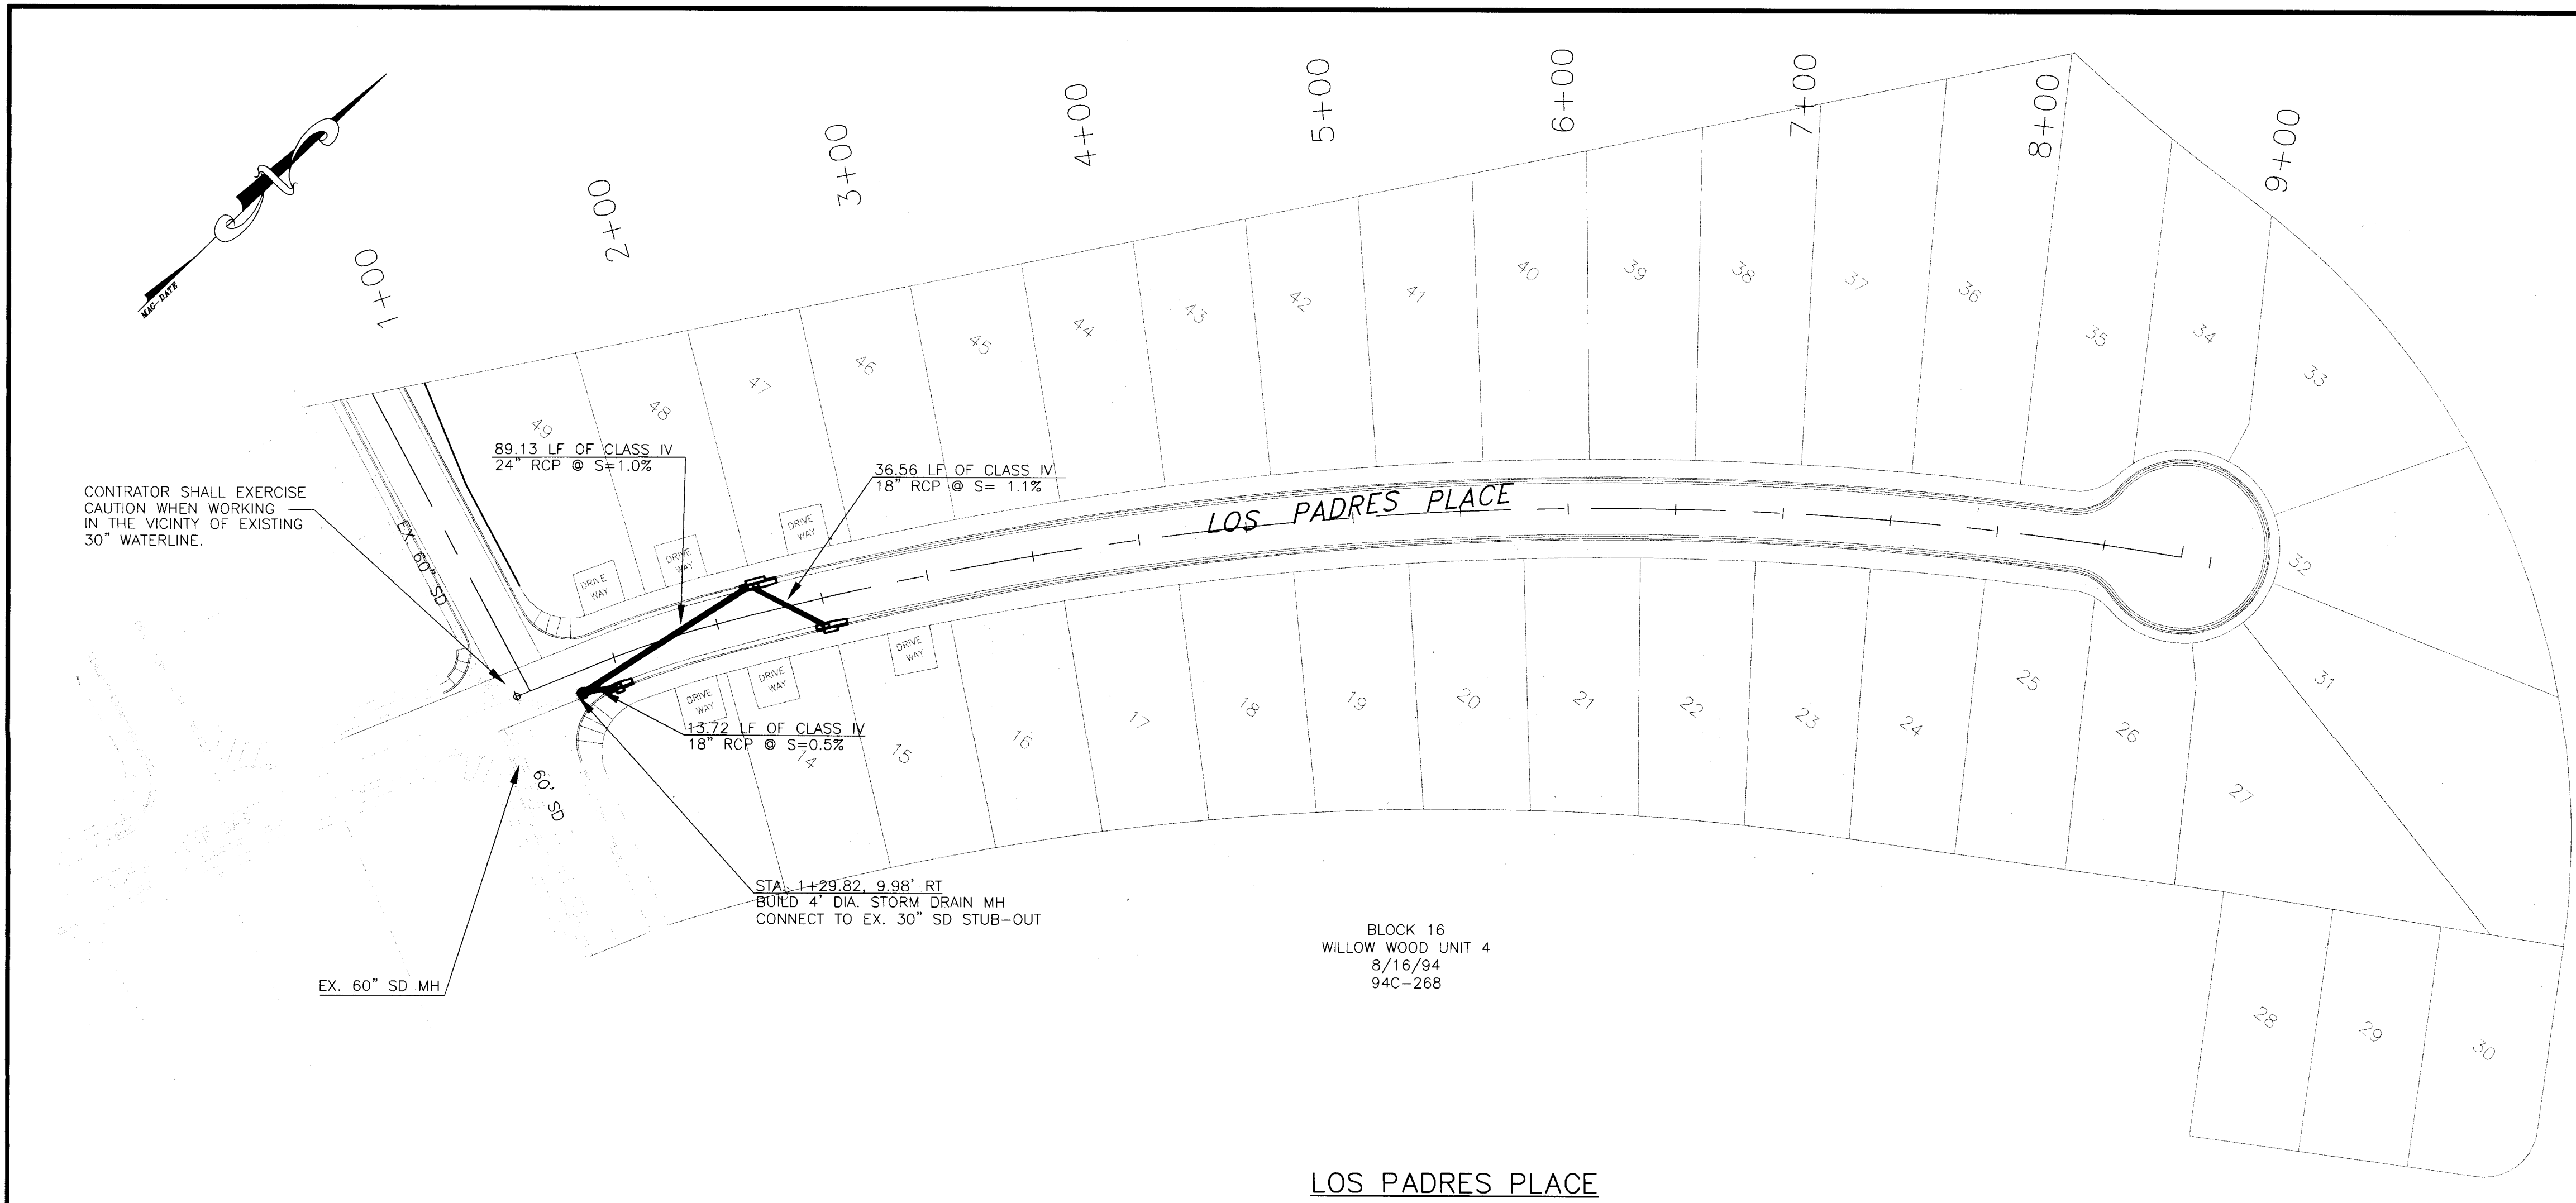

LOS PADRES PLACE

SCALE:
HORIZ.: 1"=50'
VERT.: 1"= 5'

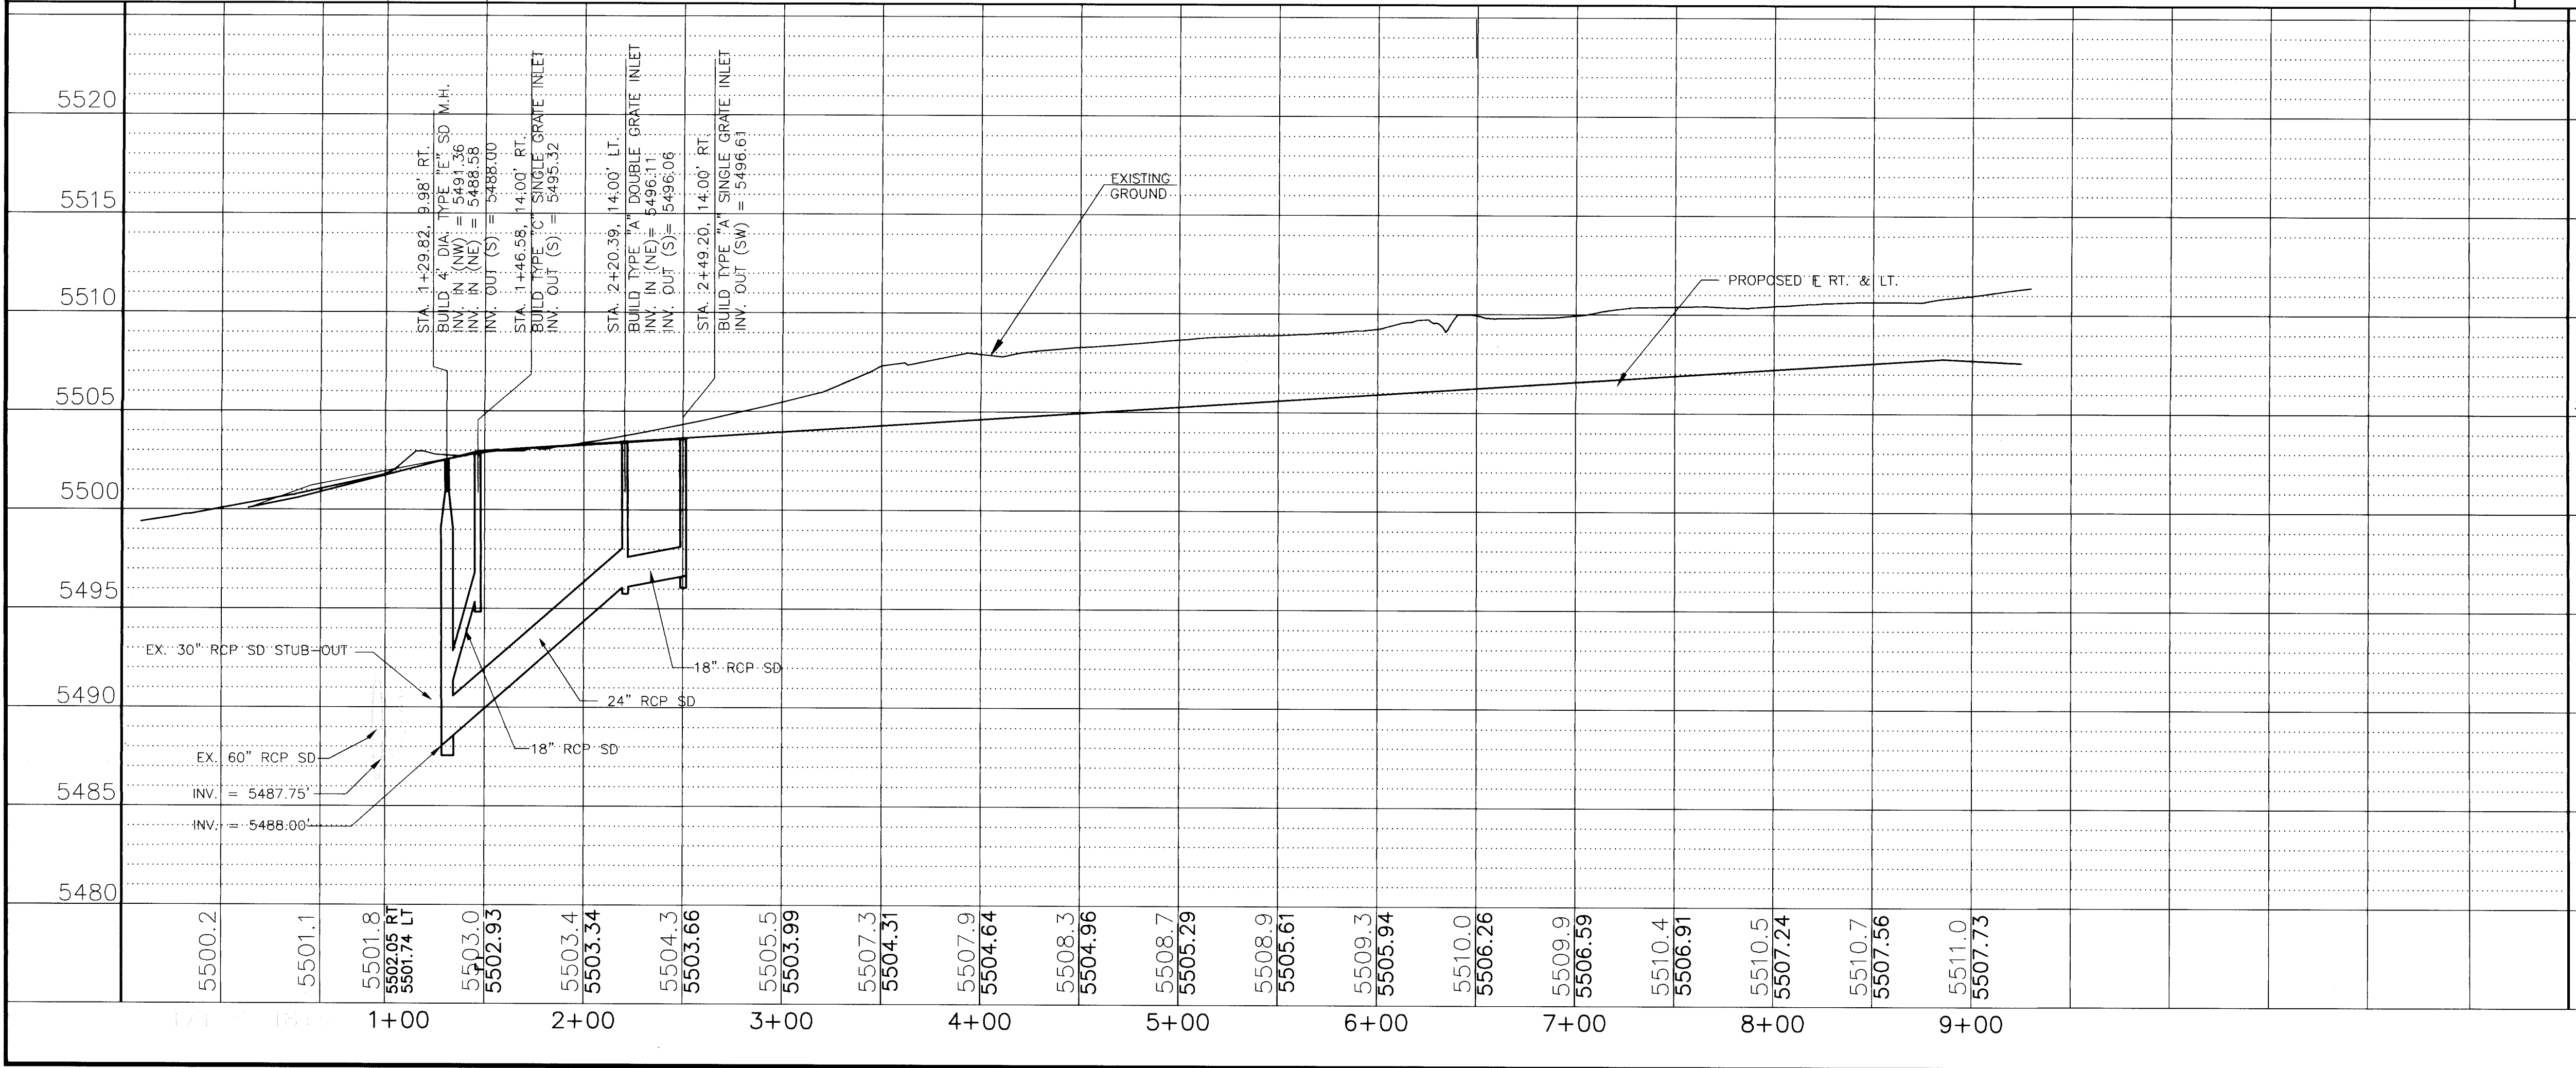


- UTILITY NOTES
- 1.) STATIONING ALONG C OF STREET UNLESS OTHERWISE NOTED.
 - 2.) SANITARY SEWER LINE LENGTHS COMPUTED FROM MH C TO MH C.
 - 3.) SLOPES ARE COMPUTED INVERT TO INVERT. MH RIM ELEVATIONS GIVEN ARE APPROXIMATE. CONTRACTOR SHALL ADJUST ALL RIMS TO FINAL GRADE.
 - 4.) CONTRACTOR IS RESPONSIBLE FOR COORDINATION WITH UTILITY COMPANIES.
 - 5.) CONTRACTOR SHALL VERIFY ALL EXISTING UTILITIES AND UTILITY CONNECTIONS PRIOR TO BEGINNING CONSTRUCTION. SHOULD A CONFLICT EXIST OR DESIGN REVISIONS BE REQUIRED FOR ANY REASON, THE CONTRACTOR SHALL NOTIFY THE ENGINEER AND ALLOW SUFFICIENT TIME FOR DESIGN REVISIONS SO AS TO NOT DELAY THE CONSTRUCTION SCHEDULE.

- LEGEND
- EXISTING WATERLINE
 - EXISTING STORM DRAIN
 - EXISTING SANITARY SEWER
 - EXISTING MANHOLE
 - EXISTING FIRE HYDRANT
 - EXISTING GATE VALVE
 - PROPOSED WATERLINE
 - PROPOSED STORM DRAIN
 - PROPOSED SANITARY SEWER
 - PROPOSED MANHOLE
 - PROPOSED FIRE HYDRANT
 - PROPOSED GATE VALVE
 - PROPOSED CAP OR PLUG
 - PROPOSED SINGLE METER, WATER SERVICE LINE
 - PROPOSED DOUBLE METER, WATER SERVICE LINES
 - PROPOSED SANITARY SEWER SERVICE LINE
 - PROPOSED CROSS, TEE, OR ELBOW

AS BUILT INFORMATION		BENCH MARKS		SURVEY INFORMATION		ENGINEER'S SEAL	
CONTRACTOR	WORK	THE STATION MARK IS A STANDARD ACS BRASS TABLET.	DATE	NO.	BY		DESIGN
STAMPED BY	DATE	STAMPED "L-21" RESET 1974", LOCATED 7.8 MILES EAST OF DOWNTOWN ALBUQUERQUE, AT THE INTERSECTION OF CENTRAL AVE. AND JUAN TABO BLVD. THE STATION IS ON THE MEDIAN STRIP OF CENTRAL AVE., 81' WEST OF CENTERLINE OF JUAN TABO BLVD. AND FLUSH WITH THE CURB. S.D. ELEV. 5534.63	DATE	NO.	BY		
ACCEPTANCE BY	DATE						
FIELD CATION BY	DATE						
DRAWN BY	DATE						DATE
CHECKED BY	DATE						DATE
RECORDED BY	DATE						DATE
NO.							

CITY OF ALBUQUERQUE PUBLIC WORKS DEPARTMENT TRANSPORTATION DEVELOPMENT			
LOS PADRES PLACE STORM DRAIN PLAN & PROFILE WILLOW WOOD UNIT 6 SUBDIVISION			
DESIGN REVIEW COMMITTEE	CITY ENGINEER APPROVAL	MO./DAY/YR.	MO./DAY/YR.
City Project No. 4604.96	Zone Map No. L-21-Z	Sheet 7b	Of 11

30+00 31+00 32+00 33+00 34+00 35+00 36+00 37+00

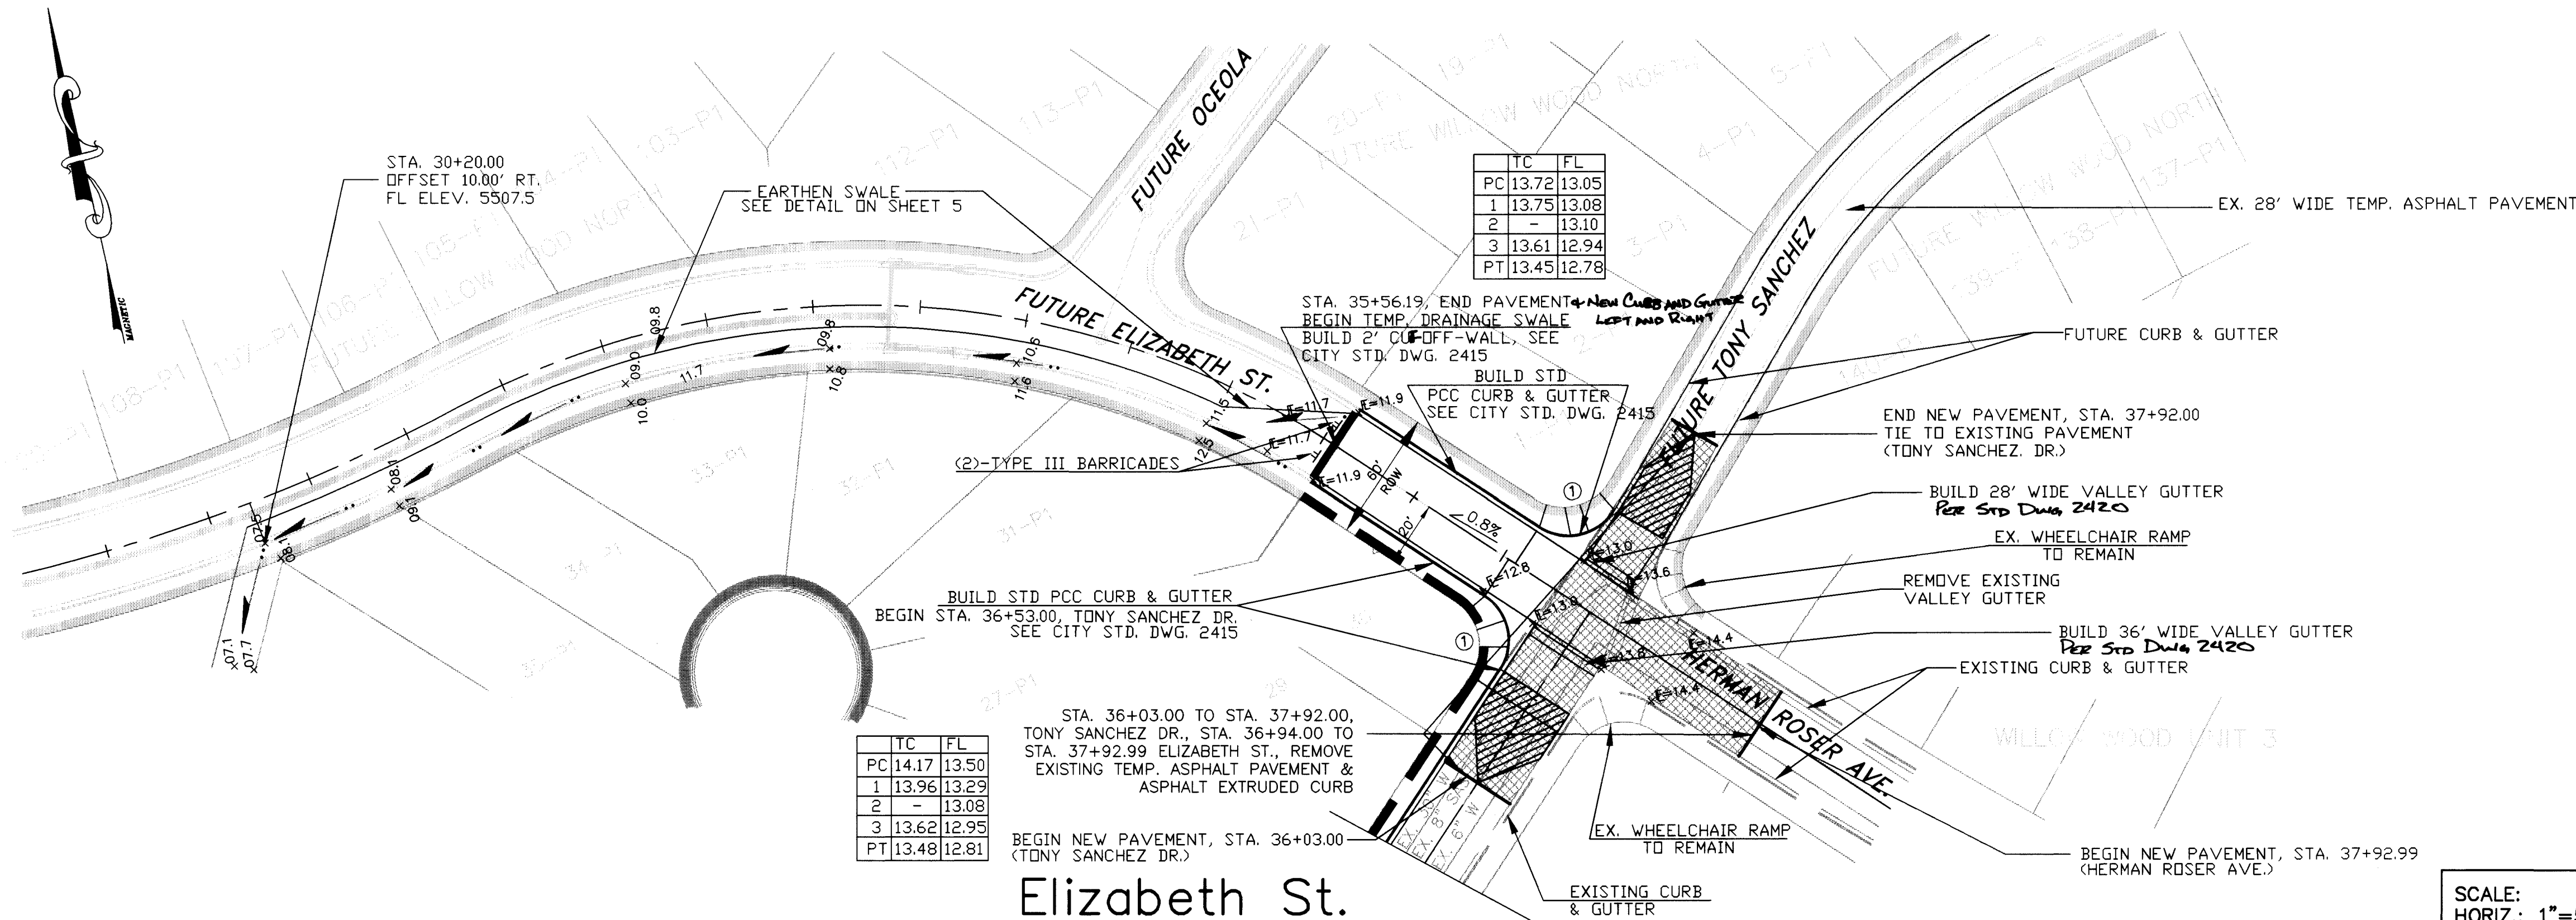

Elizabeth St.

SCALE:
HORIZ.: 1"=50'
VERT.: 1"= 5'

UTILITY NOTES

- 1.) STATIONING ALONG C. OF STREET UNLESS OTHERWISE NOTED.
- 2.) SANITARY SEWER LINE LENGTHS COMPUTED FROM MH C. TO MH C.
- 3.) SLOPES ARE COMPUTED INVERT TO INVERT. MH RIM ELEVATIONS GIVEN ARE APPROXIMATE. CONTRACTOR SHALL ADJUST ALL RIMS TO FINAL GRADE.
- 4.) CONTRACTOR IS RESPONSIBLE FOR COORDINATION WITH UTILITY COMPANIES.
- 5.) CONTRACTOR SHALL VERIFY ALL EXISTING UTILITIES AND UTILITY CONNECTIONS PRIOR TO BEGINNING CONSTRUCTION. SHOULD A CONFLICT EXIST OR DESIGN REVISIONS BE REQUIRED FOR ANY REASON, THE CONTRACTOR SHALL NOTIFY THE ENGINEER AND ALLOW SUFFICIENT TIME FOR DESIGN REVISIONS SO AS TO NOT DELAY THE CONSTRUCTION SCHEDULE.

GENERAL NOTES:

1. ALL STATION AND OFFSET DIMENSIONS ARE BASED ON CENTERLINE OF RIGHT-OF-WAY.
2. ALL ELEVATIONS ARE FLOWLINE UNLESS OTHERWISE NOTED.
3. ALL SIDEWALKS TO BE CONSTRUCTED IN THIS PROJECT ARE SHOWN AS SOLID
4. ALL SIDEWALKS TO BE CONSTRUCTED BY OTHERS ARE SHOWN AS DASHED LINES.

KEYED NOTES



- ① CONSTRUCT WHEELCHAIR RAMPS PER COA DWG. 2441, TYPE II.

LEGEND

- W --- EXISTING WATERLINE
- SD --- EXISTING STORM DRAIN
- SAS --- EXISTING SANITARY SEWER
- MH --- EXISTING MANHOLE
- FH --- EXISTING FIRE HYDRANT
- GV --- EXISTING GATE VALVE
- W --- PROPOSED WATERLINE
- SD --- PROPOSED STORM DRAIN
- SAS --- PROPOSED SANITARY SEWER
- MH --- PROPOSED MANHOLE
- FH --- PROPOSED FIRE HYDRANT
- GV --- PROPOSED GATE VALVE
- CP --- PROPOSED CAP OR PLUG
- SM --- PROPOSED SINGLE METER, WATER SERVICE LINE
- DSM --- PROPOSED DOUBLE METER, WATER SERVICE LINES
- SSS --- PROPOSED SANITARY SEWER SERVICE LINE
- + + --- PROPOSED CROSS, TEE, OR ELBOW
- FUTURE SIDEWALK
- PROPOSED DEFERRED 4' SIDEWALK
- SAW CUT, REMOVE AND REPLACE EX. PAVEMENT

CITY OF ALBUQUERQUE PUBLIC WORKS DEPARTMENT TRANSPORTATION DEVELOPMENT			
ELIZABETH PAVING & UTILITY PLAN WILLOW WOOD UNIT 6 SUBDIVISION			
DESIGN REVIEW COMMITTEE		ENGINEER APPROVAL	
APPROVED	APPROVED	NO. / DAY / YR.	NO. / DAY / YR.
DESIGNED BY	CITY ENGINEER	DESIGNED BY	DATE
DRAWN BY	DATE	DRAWN BY	DATE
CHECKED BY	DATE	CHECKED BY	DATE


City Project No. 4604.96 Zone Map No. L-21-Z Sheet 8 Of 13

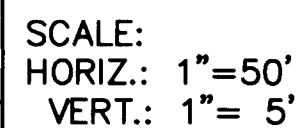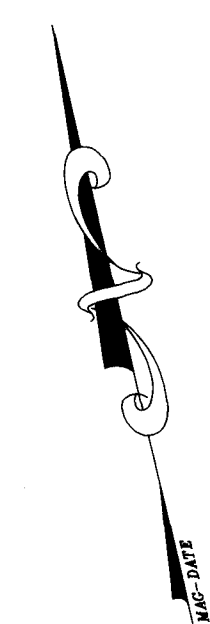

- ### LEGEND

- | | |
|---|---|
| — W — | EXISTING WATERLINE |
| — SAS — | EXISTING STORM DRAIN |
| — SAS — | EXISTING SANITARY SEWER |
| ○ | EXISTING MANHOLE |
|  | EXISTING FIRE HYDRANT |
|  | EXISTING GATE VALVE |
| W | PROPOSED WATERLINE |
| SD | PROPOSED STORM DRAIN |
| SAS | PROPOSED SANITARY SEWER |
| ⊙ | PROPOSED MANHOLE |
|  | PROPOSED FIRE HYDRANT |
|  | PROPOSED GATE VALVE |
| —] | PROPOSED CAP OR PLUG |
| — ■ | PROPOSED SINGLE METER,
WATER SERVICE LINE |
| — ■■ | PROPOSED DOUBLE METER,
WATER SERVICE LINES |
| —] | PROPOSED SANITARY SEWER
SERVICE LINE |
| + + ~ | PROPOSED CROSS, TEE, OR
ELBOW |

[illegible]

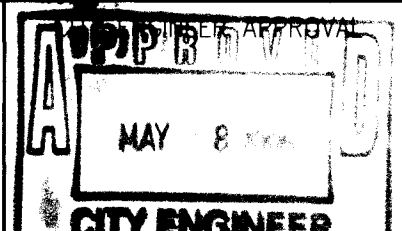CITY OF ALBUQUERQUE PUBLIC WORKS DEPARTMENT TRANSPORTATION DEVELOPMENT			
ELIZABETH PAVING & UTILITY PLAN WILLOW WOOD UNIT 6 SUBDIVISION			
DESIGN REVIEW COMMITTEE		MO./DAY/YR.	MO./DAY/YR.
City Project No. 4604.96	Zone Map No. L-21-Z	Sheet 8b	Of 11 13

SCANNED BY
BY LASON

30+00

31+00

32+00



33+00

34+00

35+00


36+00

37+00

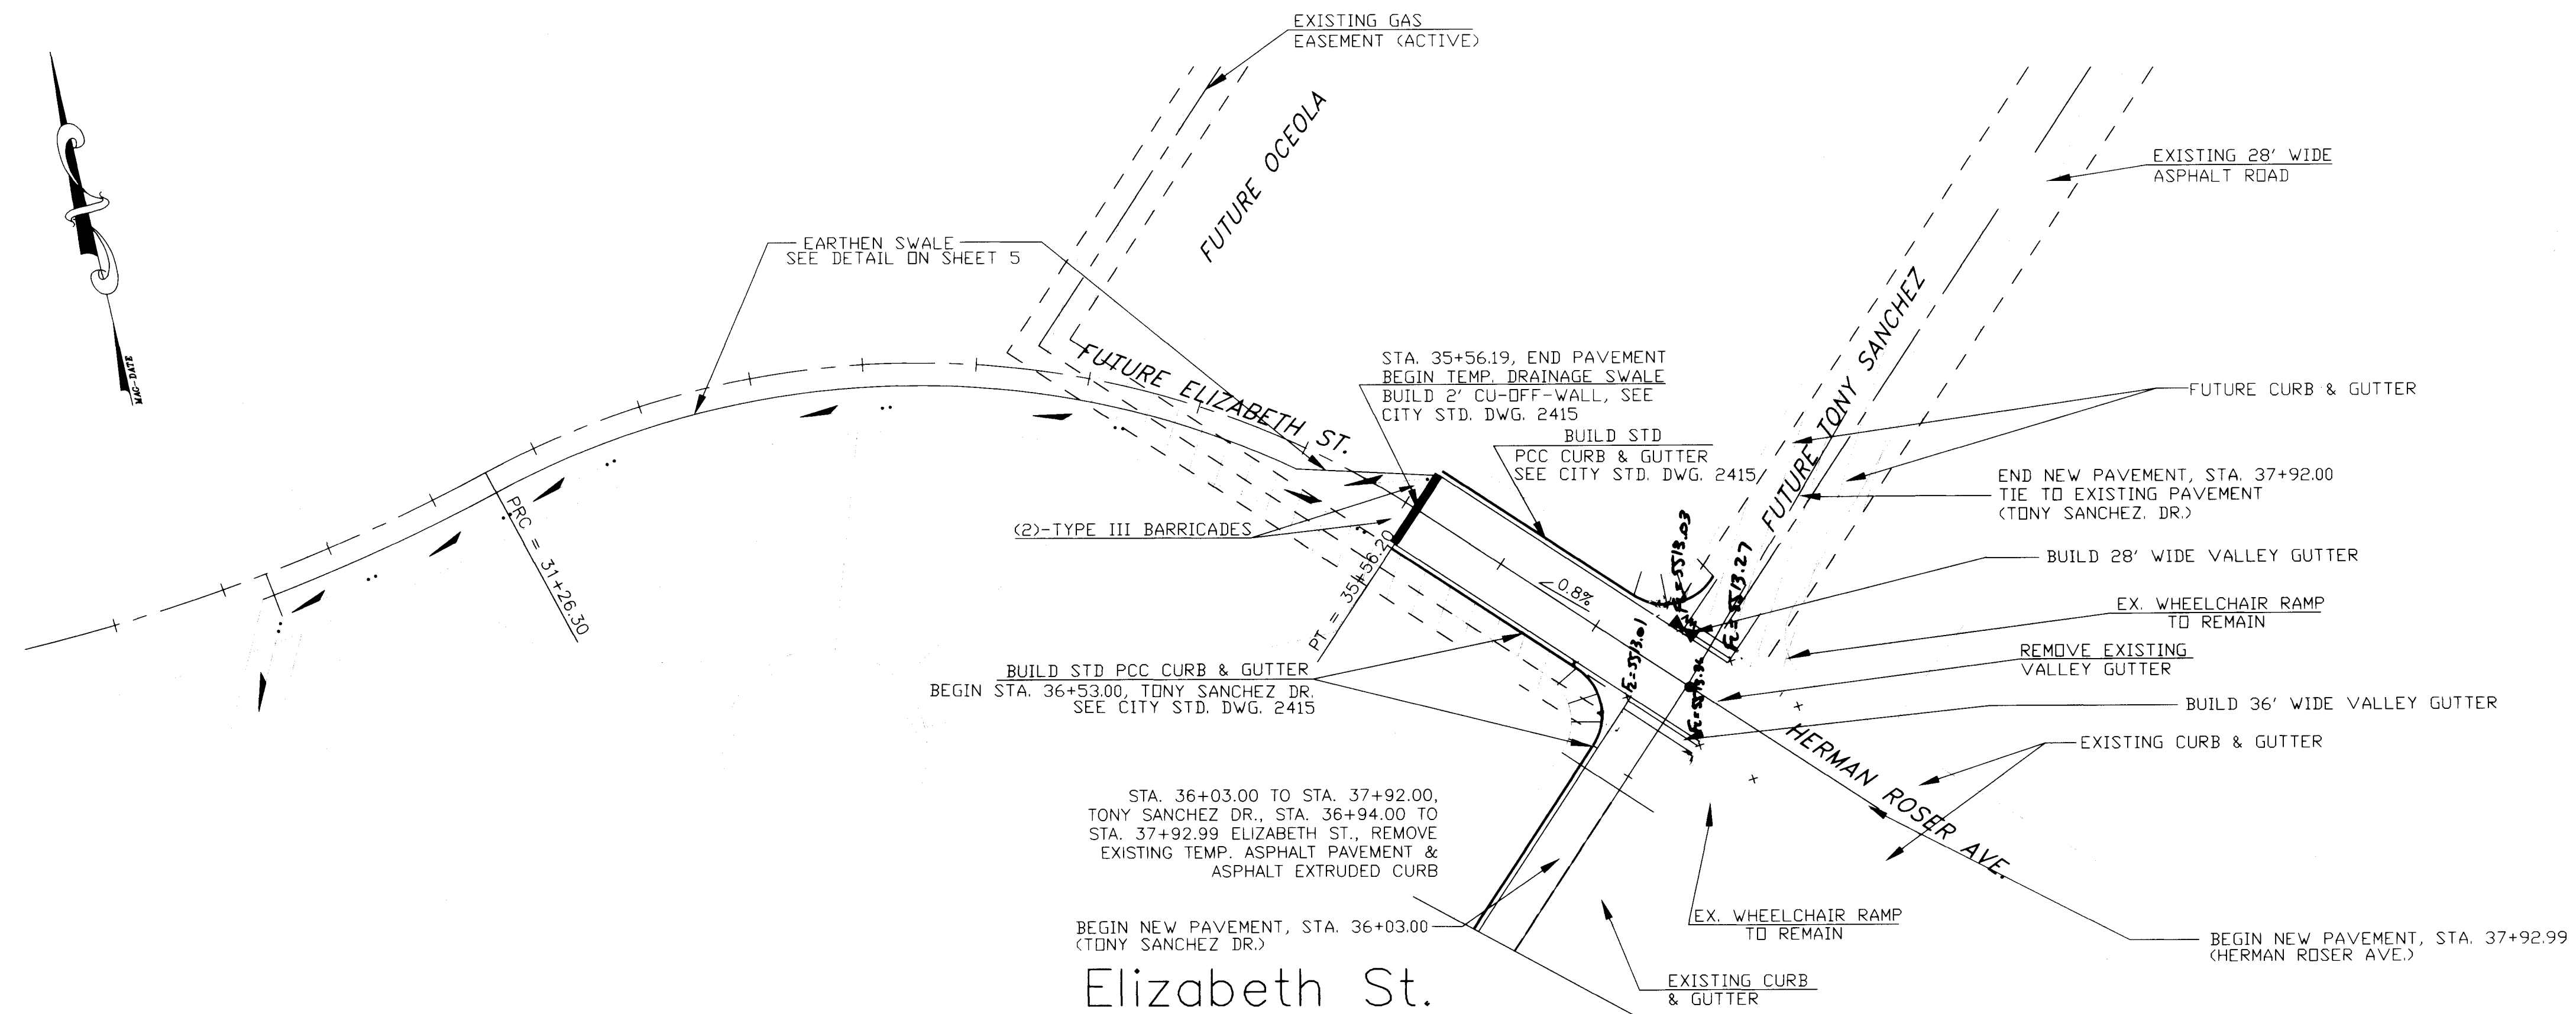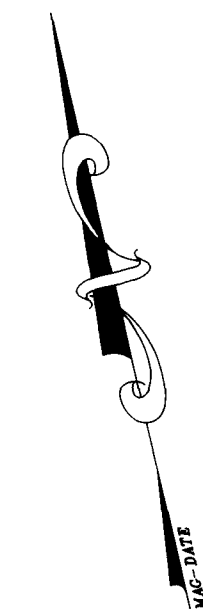

Elizabeth St.

SCALE:
HORIZ.: 1"=50'
VERT.: 1"= 5'

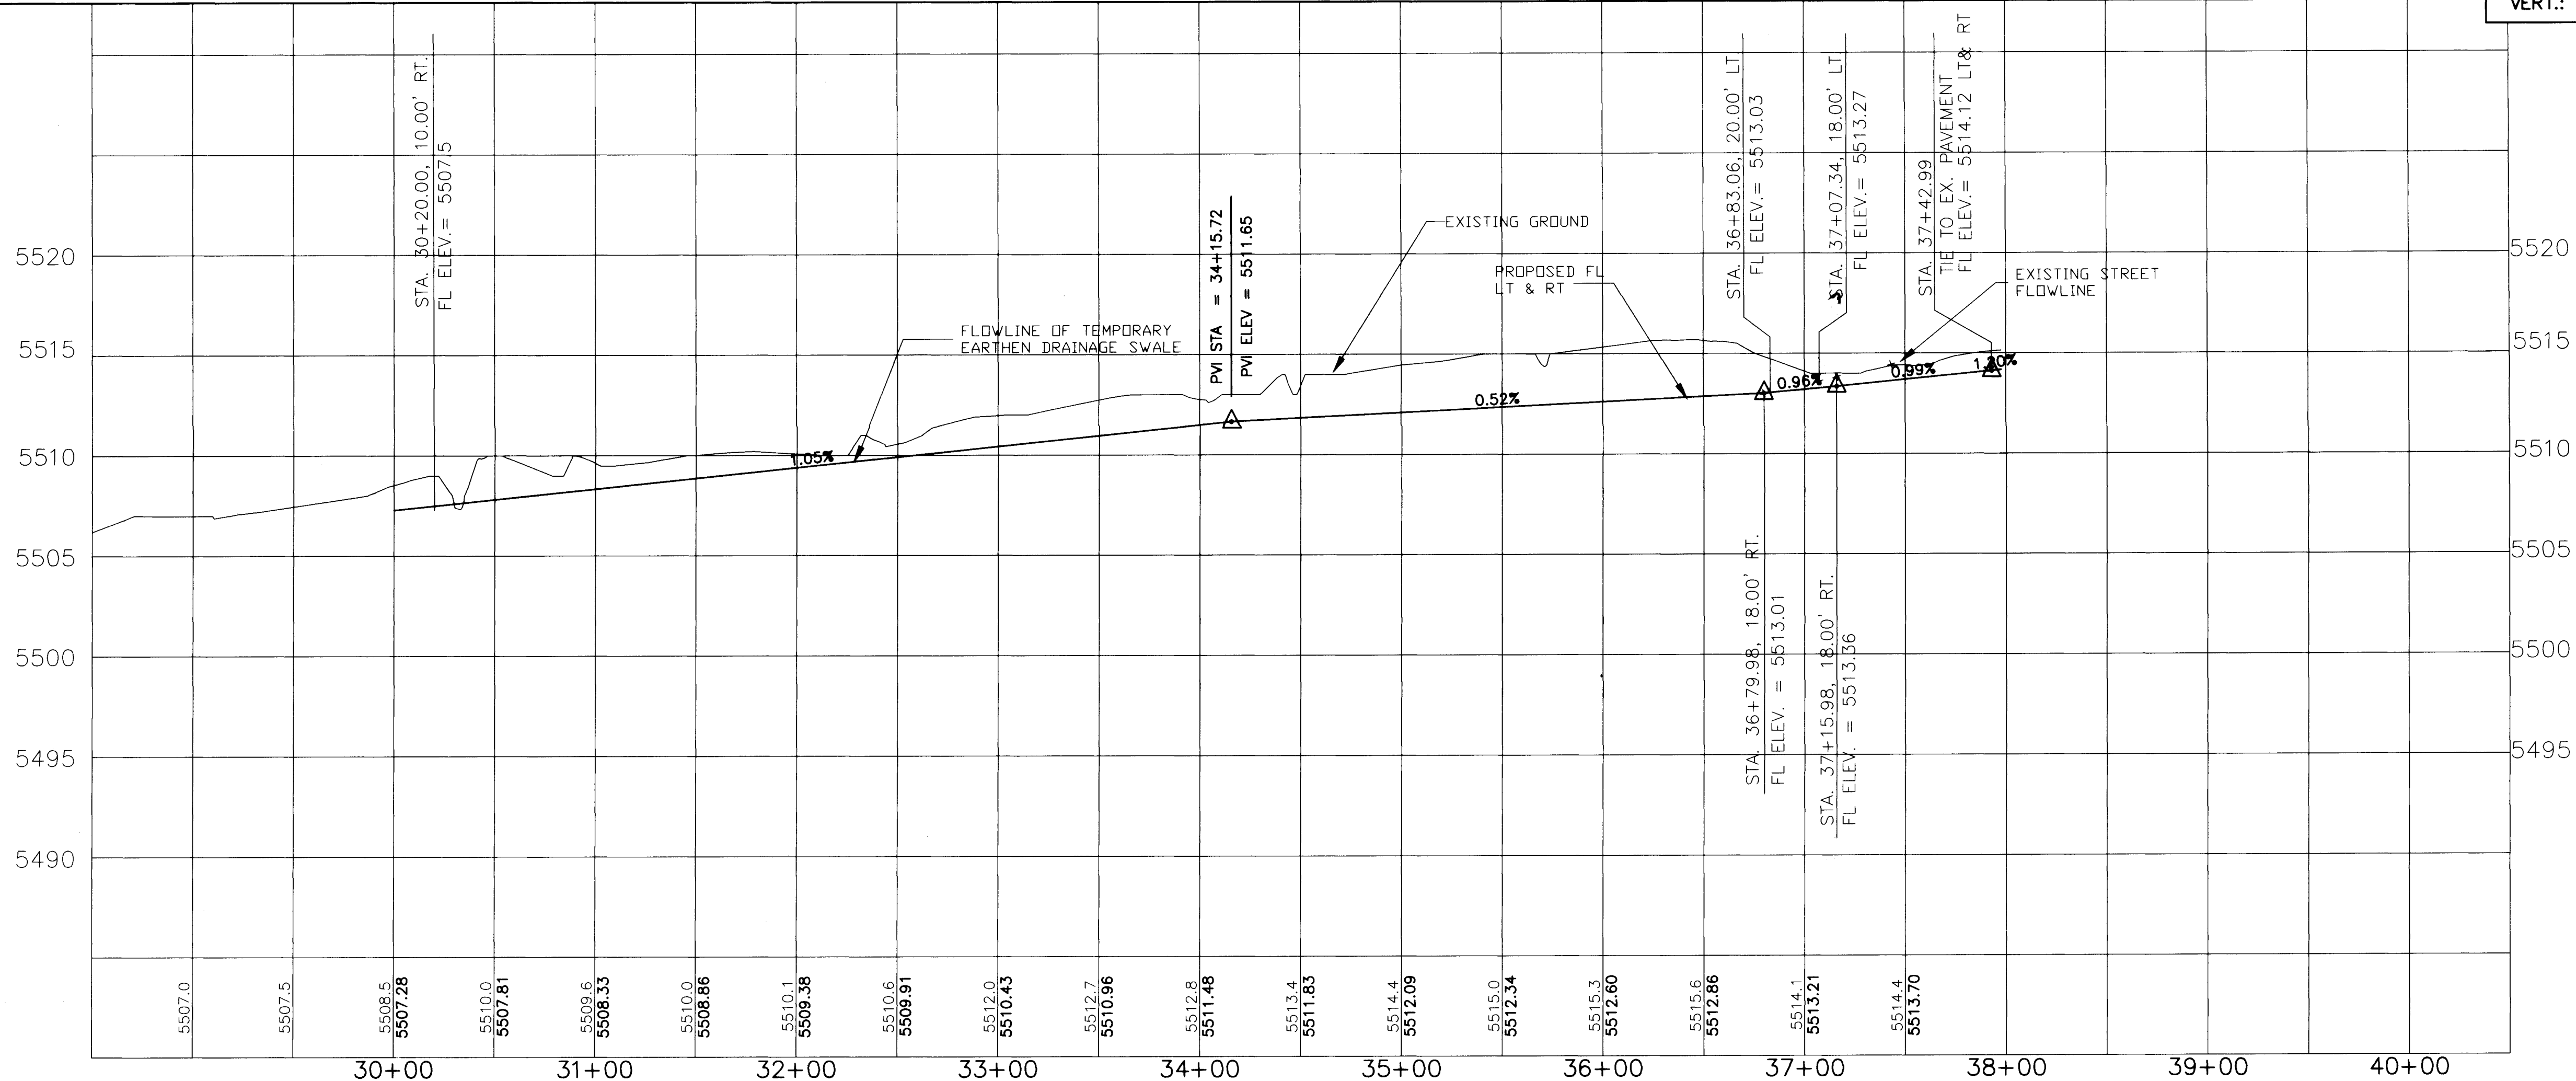

UTILITY NOTES

- 1.) STATIONING ALONG C OF STREET UNLESS OTHERWISE NOTED.
- 2.) SANITARY SEWER LINE LENGTHS COMPUTED FROM MH C TO MH C.
- 3.) SLOPES ARE COMPUTED INVERT TO INVERT. MH RIM ELEVATIONS GIVEN ARE APPROXIMATE. CONTRACTOR SHALL ADJUST ALL RIMS TO FINAL GRADE.
- 4.) CONTRACTOR IS RESPONSIBLE FOR COORDINATION WITH UTILITY COMPANIES.
- 5.) CONTRACTOR SHALL VERIFY ALL EXISTING UTILITIES AND UTILITY CONNECTIONS PRIOR TO BEGINNING CONSTRUCTION. SHOULD A CONFLICT EXIST OR DESIGN REVISIONS BE REQUIRED FOR ANY REASON, THE CONTRACTOR SHALL NOTIFY THE ENGINEER AND ALLOW SUFFICIENT TIME FOR DESIGN REVISIONS SO AS TO NOT DELAY THE CONSTRUCTION SCHEDULE.

GENERAL NOTES:

1. ALL STATION AND OFFSET DIMENSIONS ARE BASED ON CENTERLINE OF RIGHT-OF-WAY.
2. ALL ELEVATIONS ARE FLOWLINE UNLESS OTHERWISE NOTED.
3. ALL SIDEWALKS TO BE CONSTRUCTED IN THIS PROJECT ARE SHOWN AS SOLID
4. ALL SIDEWALKS TO BE CONSTRUCTED BY OTHERS ARE SHOWN AS DASHED DILUTED LINES.

KEYED NOTES

- ① CONSTRUCT WHEELCHAIR RAMPS PER COA DWG. 2441, TYPE II.

LEGEND


- | | |
|---------|--|
| — W — | EXISTING WATERLINE |
| — SAS — | EXISTING STORM DRAIN |
| o | EXISTING SANITARY SEWER |
| o | EXISTING MANHOLE |
| o | EXISTING FIRE HYDRANT |
| o | EXISTING GATE VALVE |
| W | PROPOSED WATERLINE |
| SD | PROPOSED STORM DRAIN |
| SAS | PROPOSED SANITARY SEWER |
| o | PROPOSED MANHOLE |
| o | PROPOSED FIRE HYDRANT |
| o | PROPOSED GATE VALVE |
| — | PROPOSED CAP OR PLUG |
| — | PROPOSED SINGLE METER, WATER SERVICE LINE |
| — | PROPOSED DOUBLE METER, WATER SERVICE LINES |
| — | PROPOSED SANITARY SEWER SERVICE LINE |
| + + + | PROPOSED CROSS, TEE, OR ELBOW |

AS BUILT INFORMATION	
CONTRACTOR	
INSPECTED BY	
DATE	
ACCEPTANCE BY	
DATE	
VERIFICATION BY	
DATE	
DRAMING	
DATE	
MICRO-FILM INFORMATION	
RECORDED BY	
DATE	
NO.	

BENCH MARKS	
THE STATION MARK IS A STANDARD ACS BRASS TABLET, STAMPED "1-L21 RESET 1974", LOCATED 7.8 MILES EAST OF DOWNTOWN ALBUQUERQUE, AT THE INTERSECTION OF CENTRAL AVE. AND JUAN TABO BLVD. THE STATION IS ON THE MEDIAN STRIP OF CENTRAL AVE., 81' WEST OF CENTERLINE OF JUAN TABO BLVD. AND FLUSH WITH THE CURB. SLD ELEV. 5534.63	

SURVEY INFORMATION	
FIELD NOTES	
DATE	
BY	
NO.	


ENGINEER'S SEAL	
NO. DATE	BY
DESIGNED BY	DATE
DRAWN BY	DATE
CHECKED BY	DATE

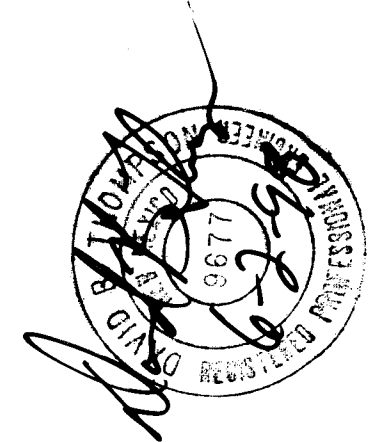

CITY OF ALBUQUERQUE
PUBLIC WORKS DEPARTMENT
TRANSPORTATION DEVELOPMENT

ELIZABETH PAVING PLAN
WILLOW WOOD UNIT 6 SUBDIVISION

DESIGN REVIEW COMMITTEE

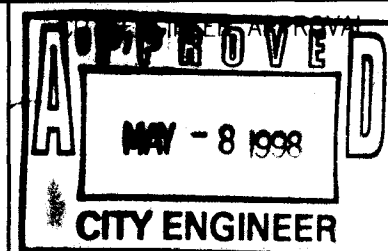

MO./DAY/YR.





MO./DAY/YR.

City Project No.
4604.96

Zone Map No.
L-21-Z

Sheet 8a Of 13

SCANNED BY
BY LASON

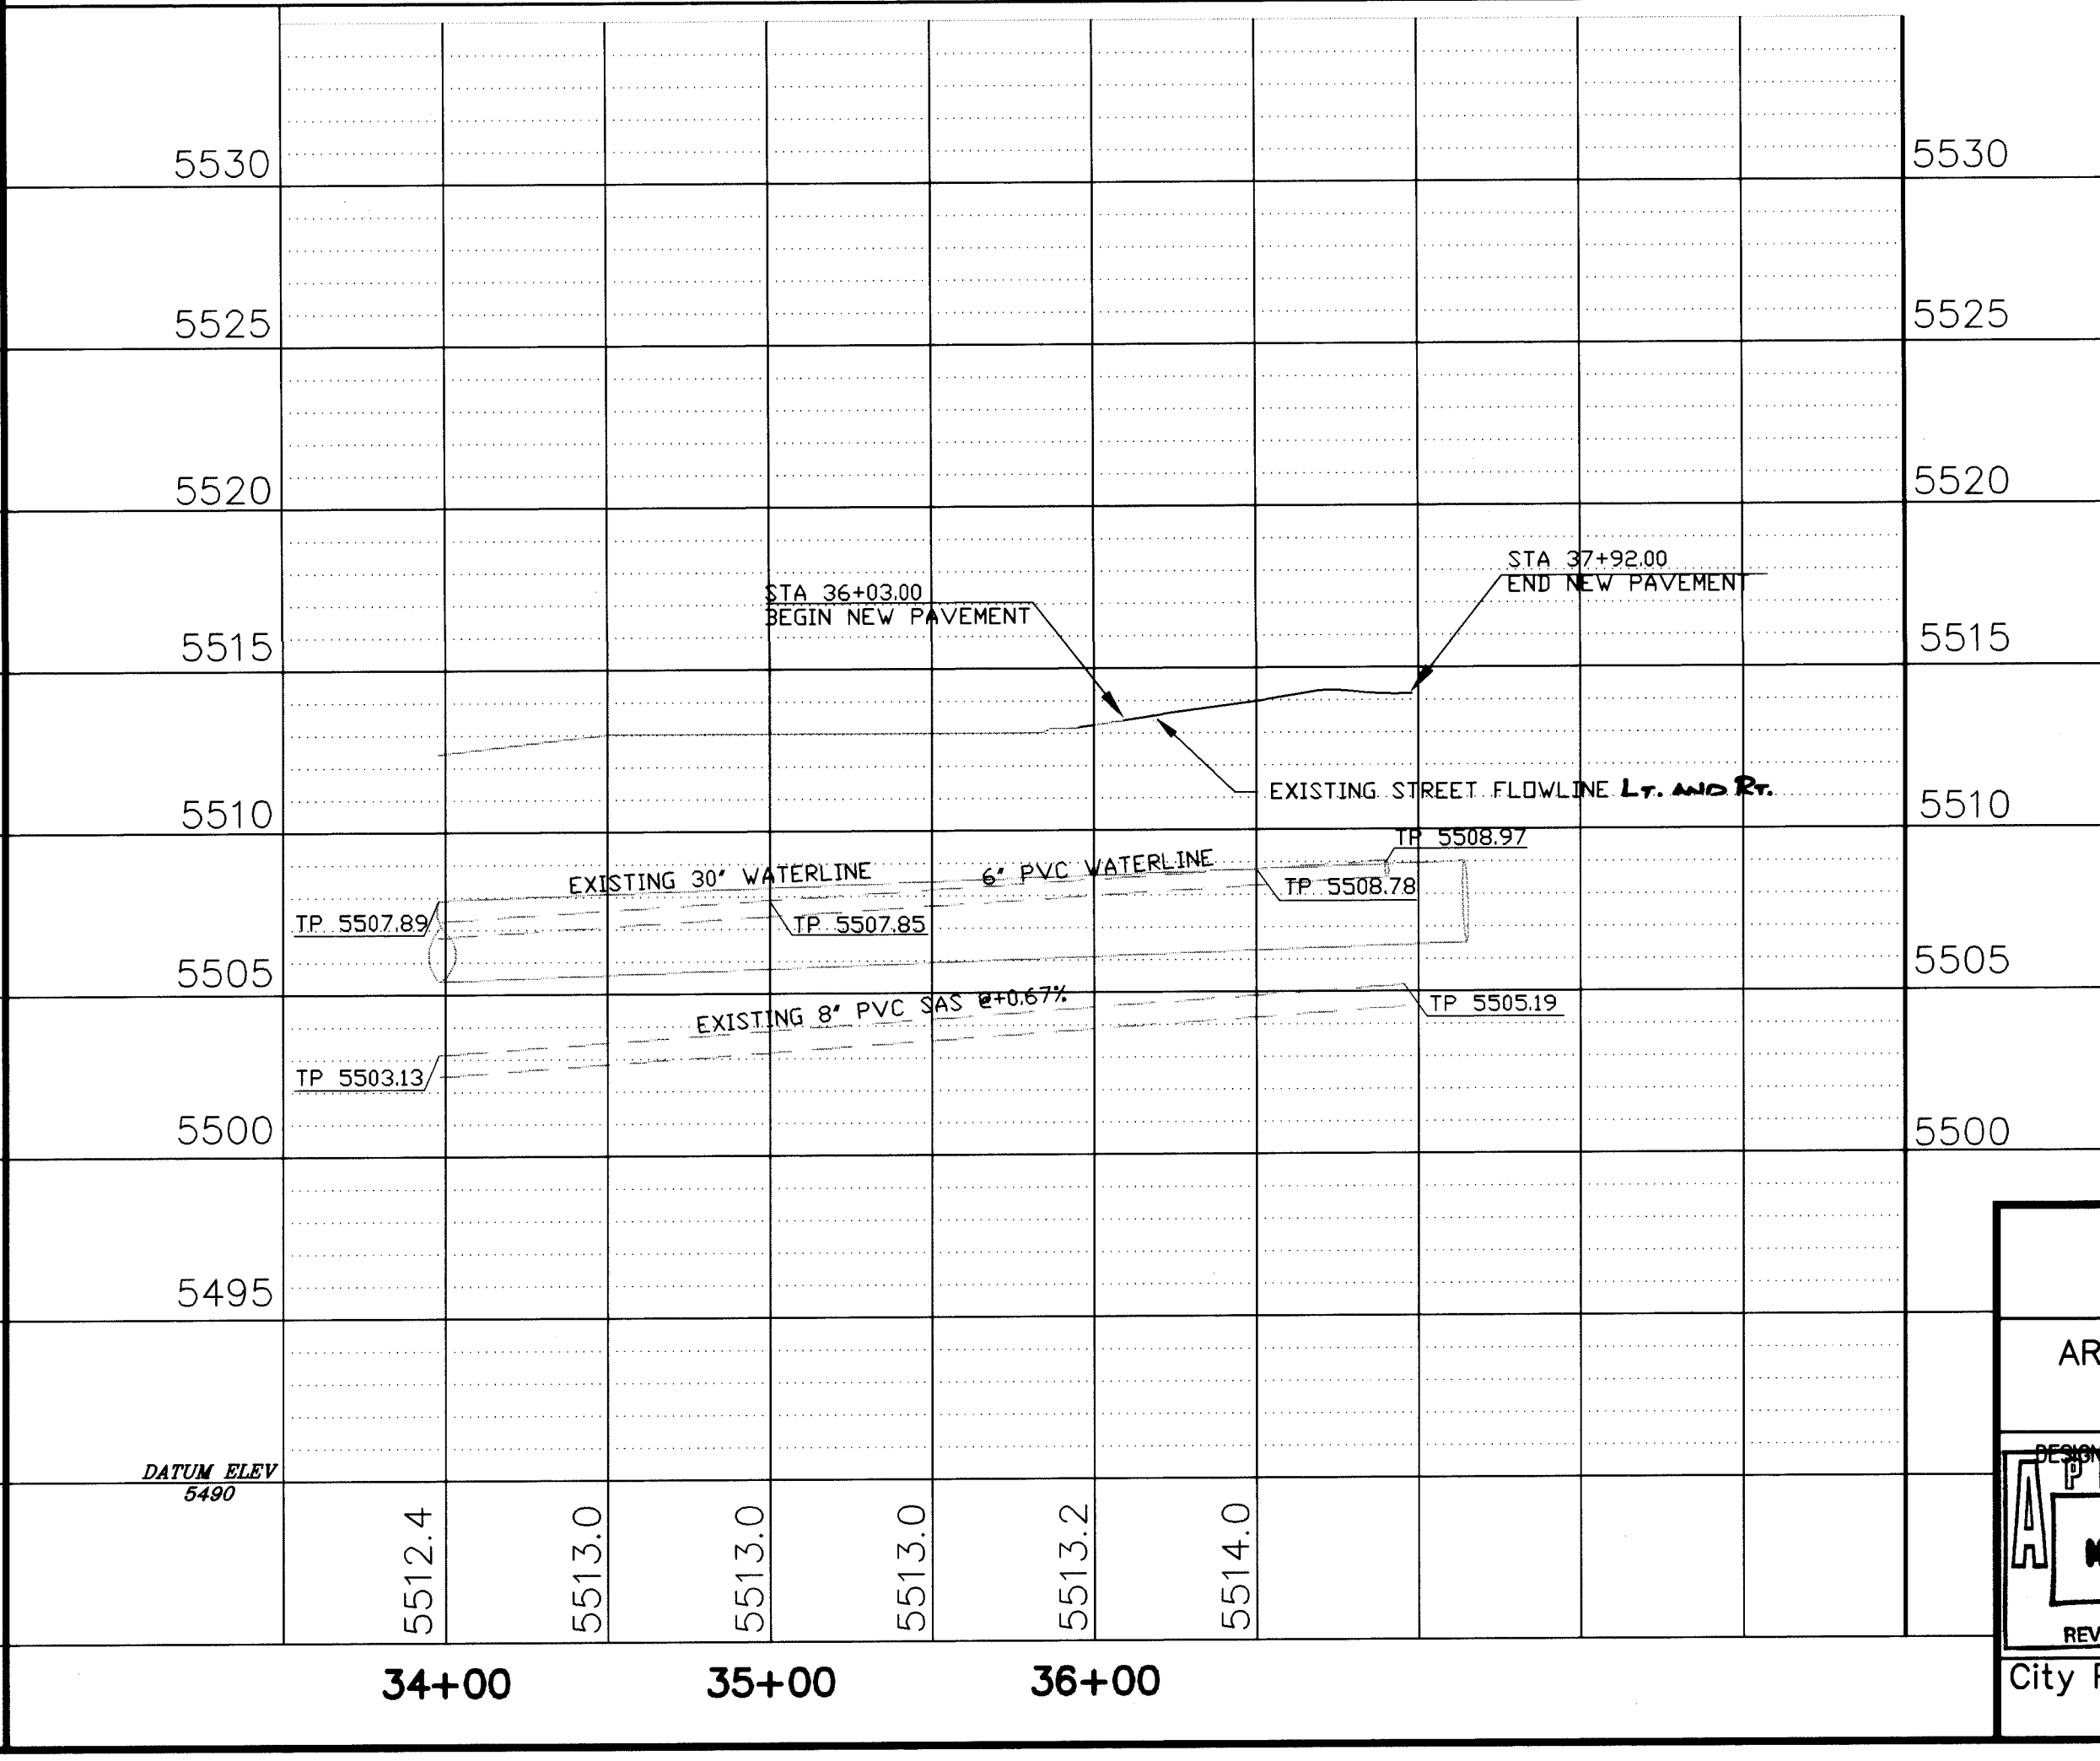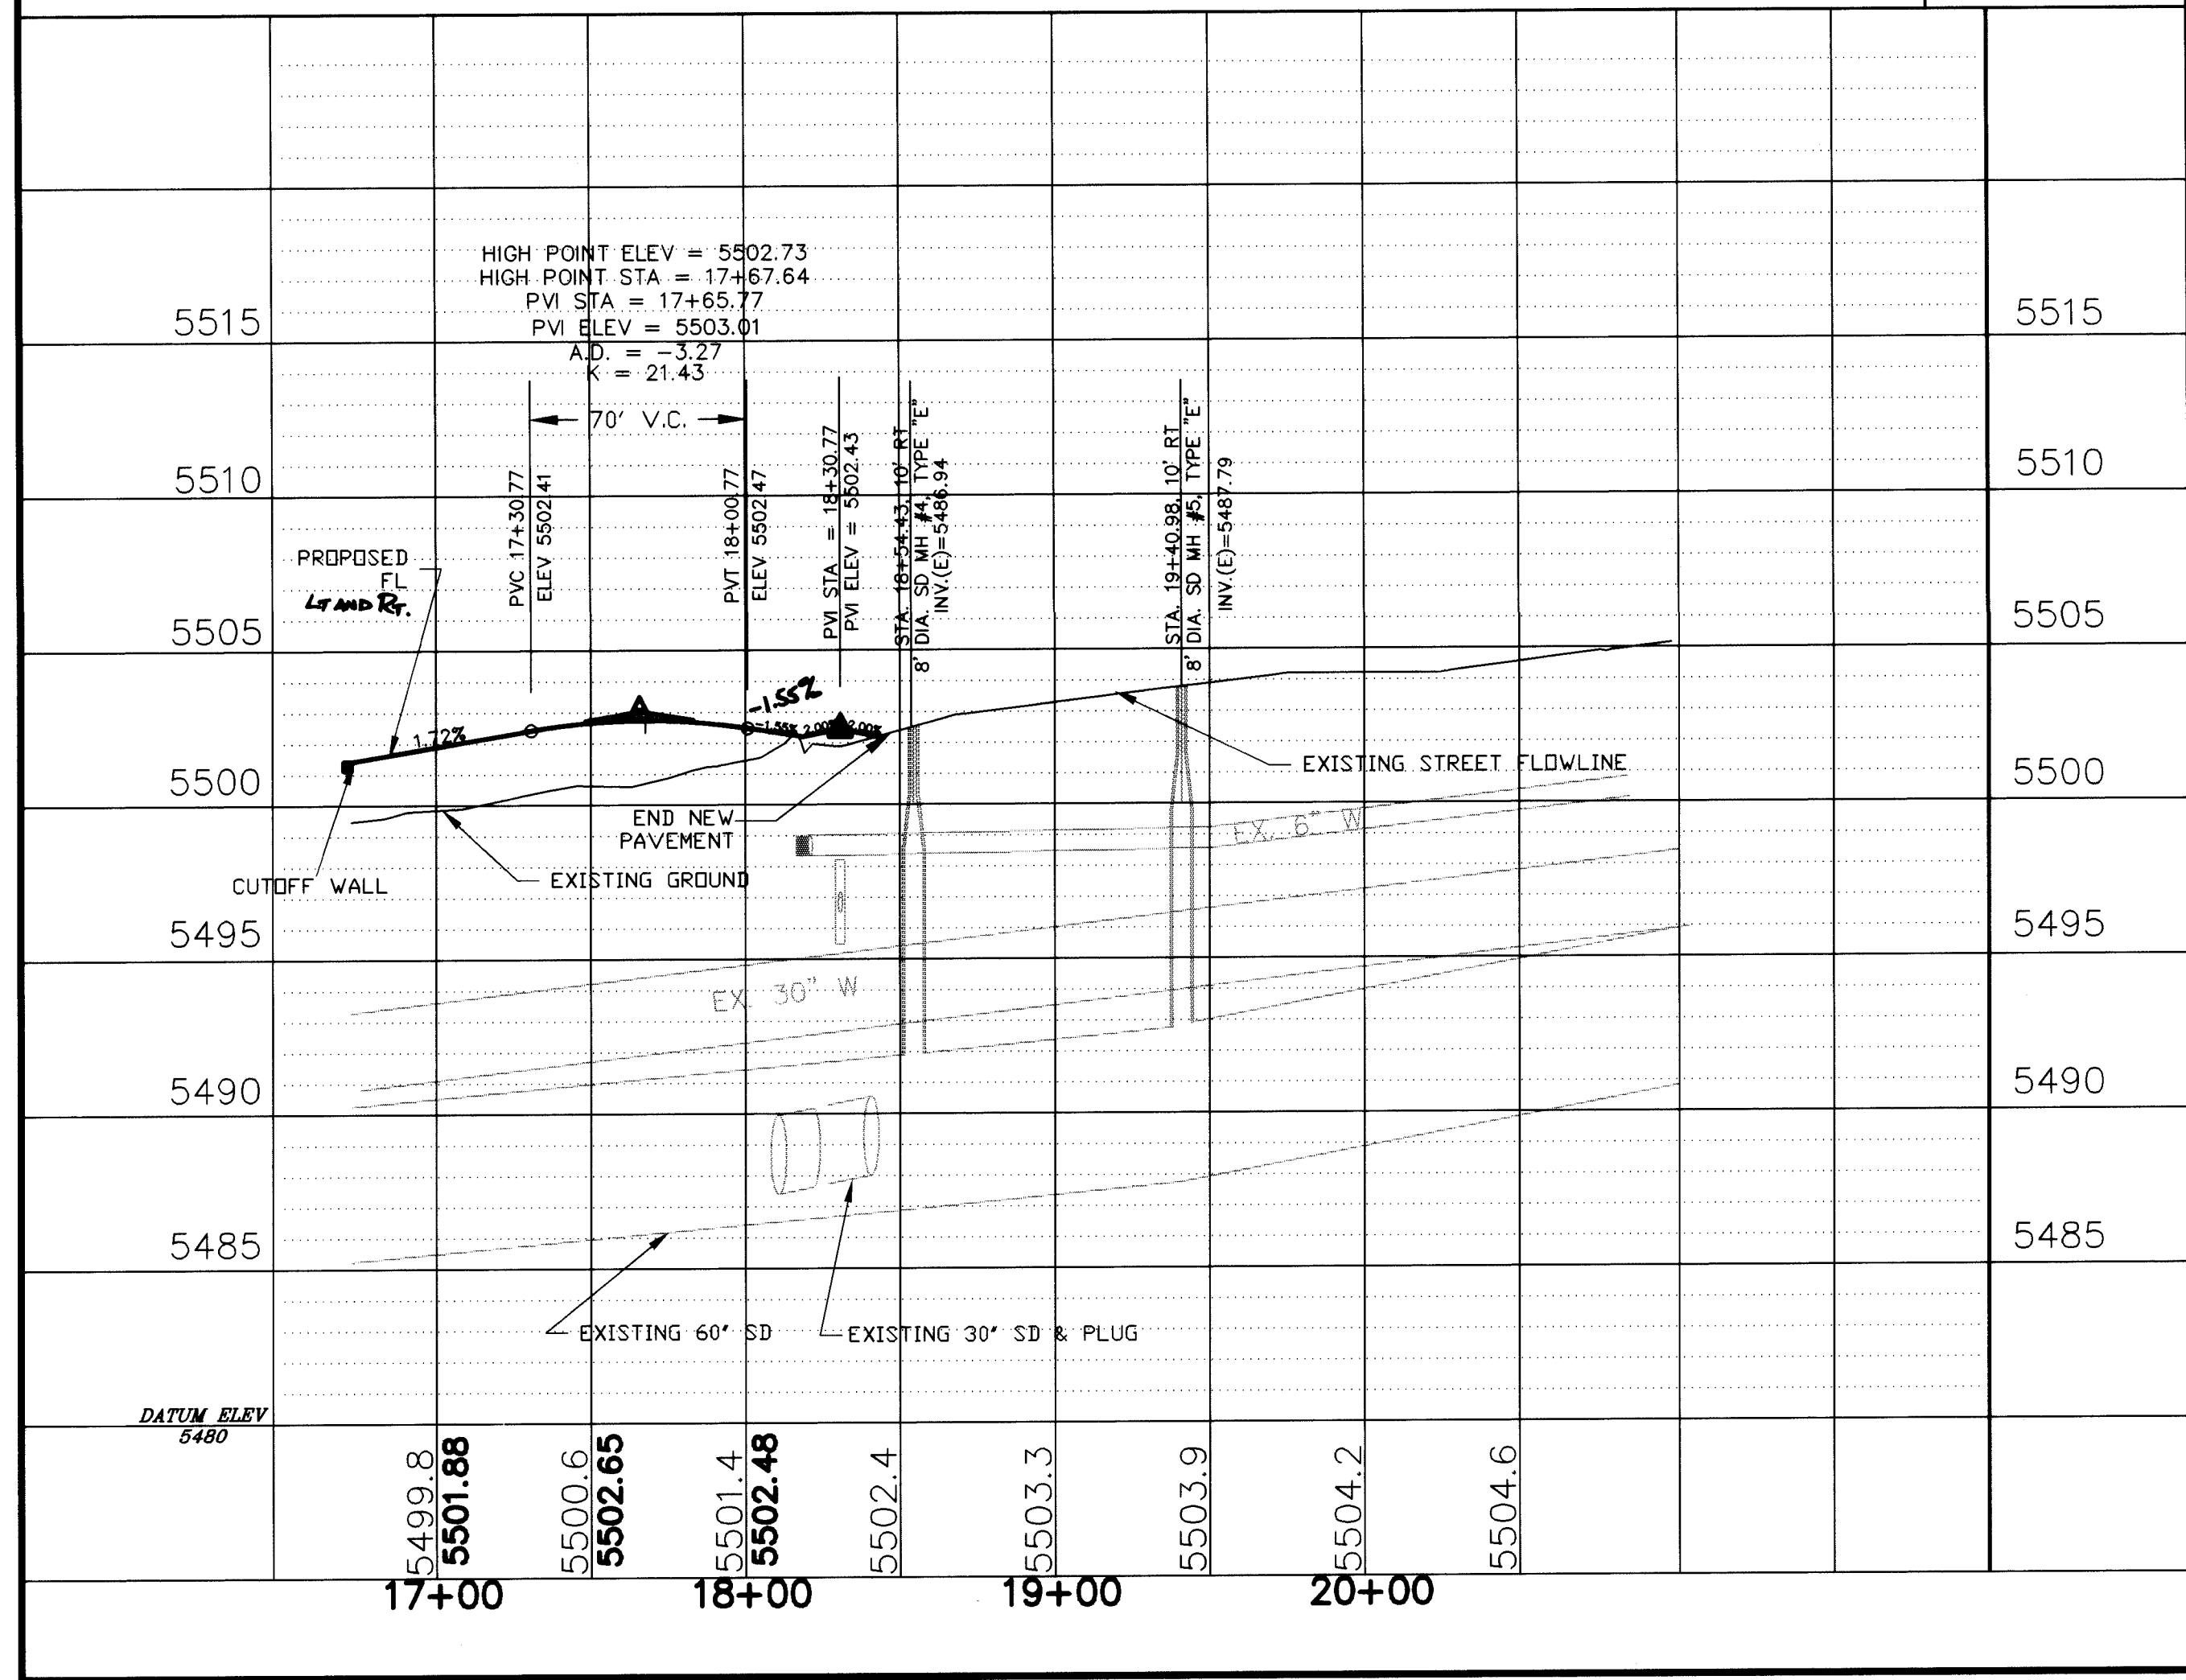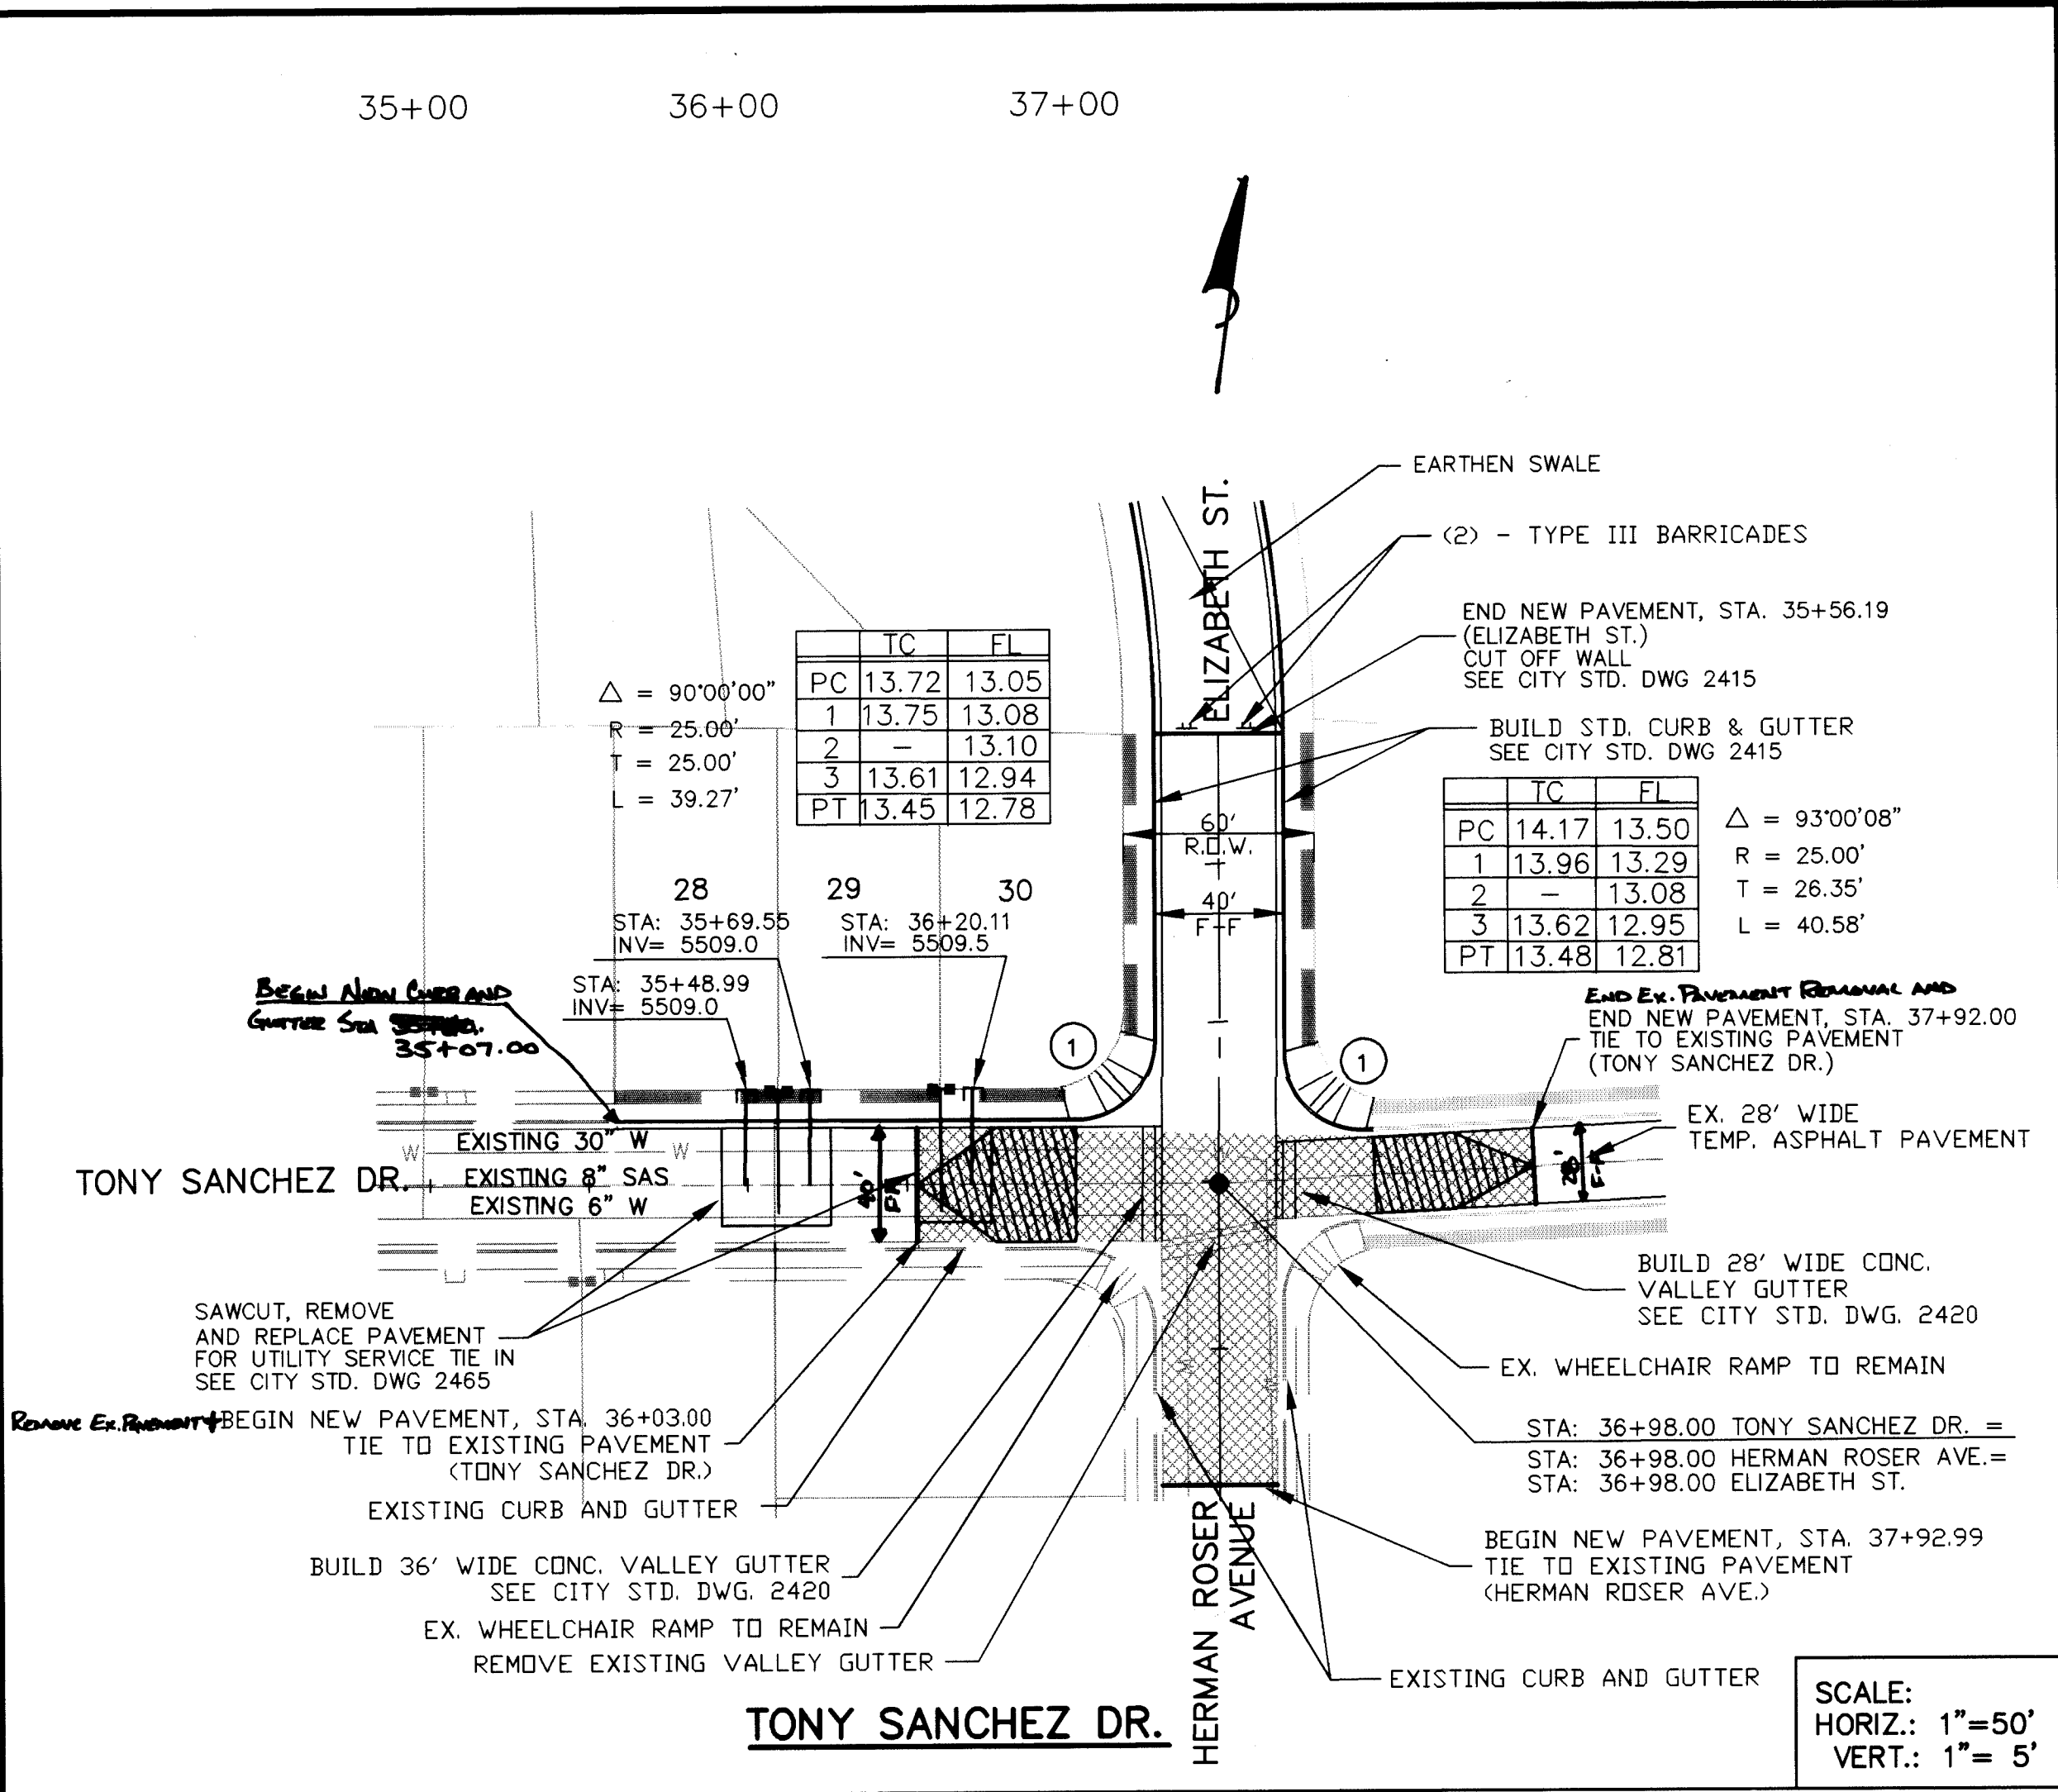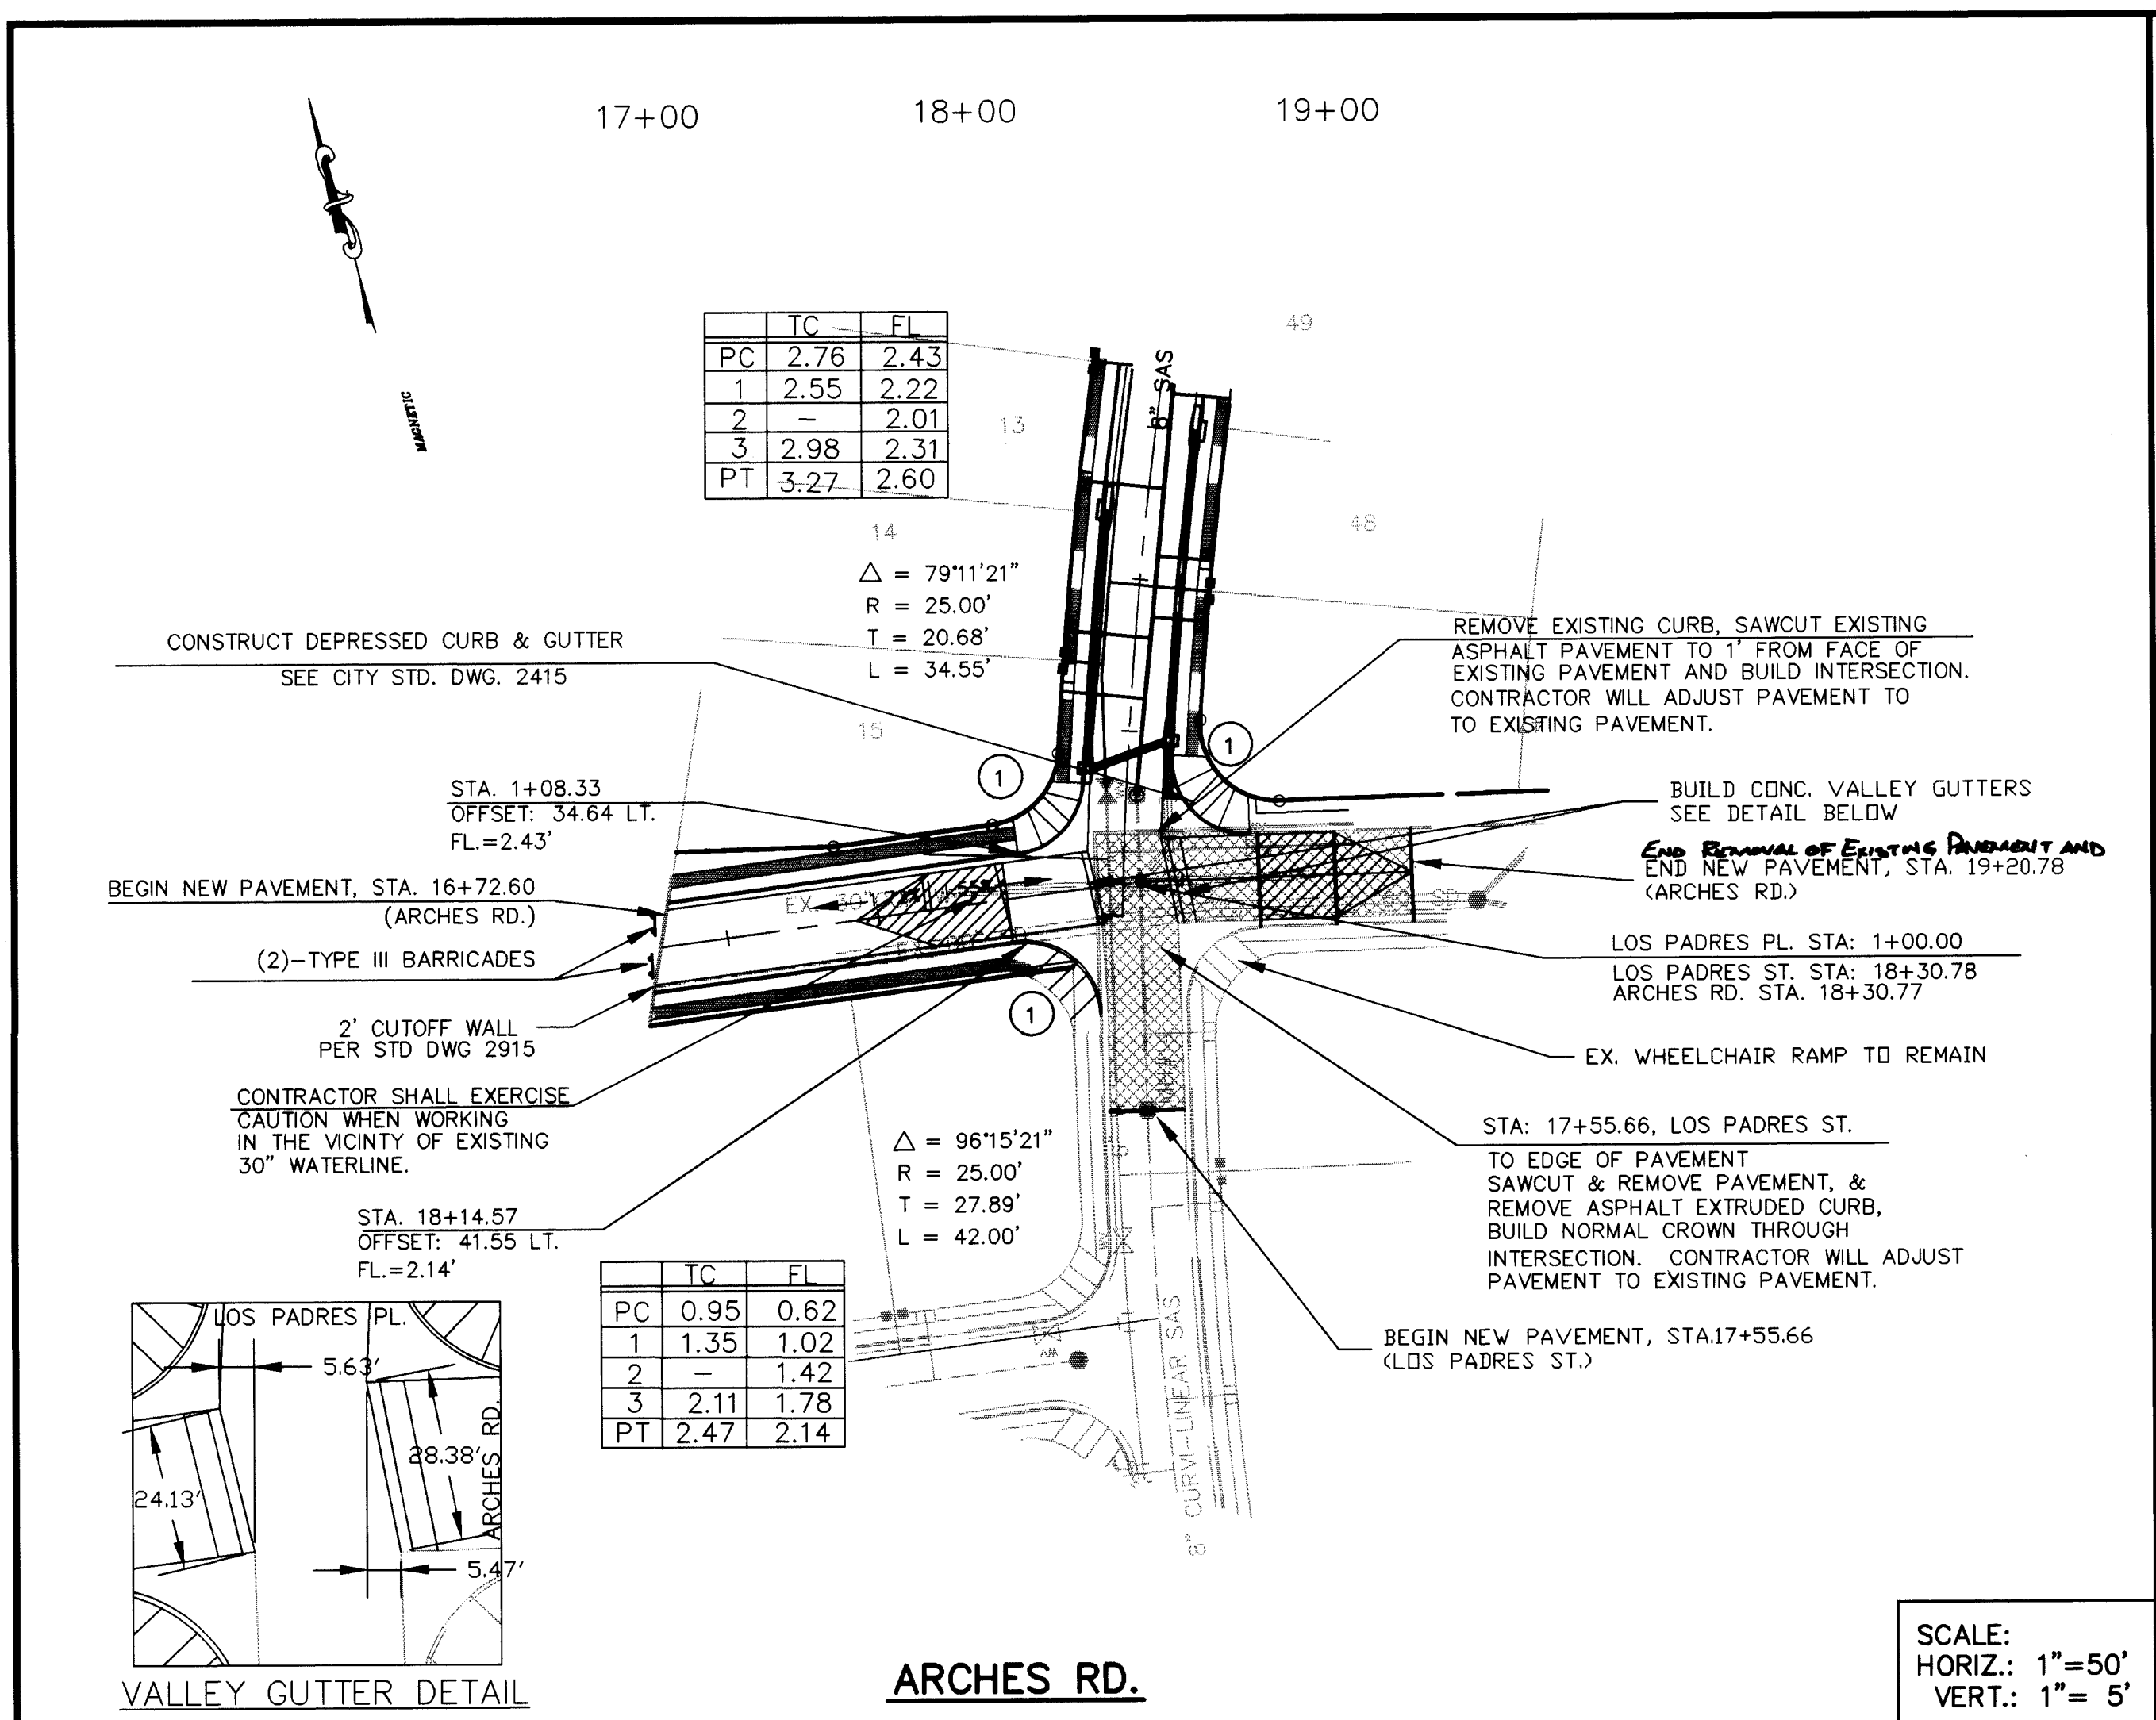

UTILITY NOTES

- STATIONING ALONG C OF STREET UNLESS OTHERWISE NOTED.
- SANITARY SEWER LINE LENGTHS COMPUTED FROM MH C TO MH C.
- SLOPES ARE COMPUTED INVERT TO INVERT. MH RIM ELEVATIONS GIVEN ARE APPROXIMATE. CONTRACTOR SHALL ADJUST ALL RIMS TO FINAL GRADE.
- CONTRACTOR IS RESPONSIBLE FOR COORDINATION WITH UTILITY COMPANIES.
- CONTRACTOR SHALL VERIFY ALL EXISTING UTILITIES AND UTILITY CONNECTIONS PRIOR TO BEGINNING CONSTRUCTION. SHOULD A CONFLICT EXIST OR DESIGN REVISIONS BE REQUIRED FOR ANY REASON, THE CONTRACTOR SHALL NOTIFY THE ENGINEER AND ALLOW SUFFICIENT TIME FOR DESIGN REVISIONS SO AS TO NOT DELAY THE CONSTRUCTION SCHEDULE.

KEYED NOTES

- CONSTRUCT WHEELCHAIR RAMPS PER COA DWG. 2441, TYPE II.

LEGEND

W	EXISTING WATERLINE
SD	EXISTING STORM DRAIN
SAS	EXISTING SANITARY SEWER
MH	EXISTING MANHOLE
W	EXISTING FIRE HYDRANT
W	EXISTING GATE VALVE
W	PROPOSED WATERLINE
SD	PROPOSED STORM DRAIN
SAS	PROPOSED SANITARY SEWER
MH	PROPOSED MANHOLE
W	PROPOSED FIRE HYDRANT
W	PROPOSED GATE VALVE
W	PROPOSED CAP OR PLUG
W	PROPOSED SINGLE METER, WATER SERVICE LINE
W	PROPOSED DOUBLE METER, WATER SERVICE LINES
W	PROPOSED SANITARY SEWER SERVICE LINE
W	PROPOSED CROSS, TEE, OR ELBOW
W	FUTURE CURB AND GUTTER
W	SAWCUT, REMOVE & REPLACE EXISTING PAVEMENT

AS BUILT INFORMATION

CONTRACTOR	WORK	DATE

BENCH MARKS

THE STATION MARK IS A STANDARD ACS BRASS TABLET, STAMPED "1-121 RESET 1974", LOCATED 7.8 MILES EAST OF DOWNTOWN ALBUQUERQUE, AT THE INTERSECTION OF CENTRAL AVE. AND JUAN TABO BLVD. THE STATION IS ON THE MEDIAN STRIP OF CENTRAL AVE., 81' WEST OF CENTERLINE OF JUAN TABO BLVD. AND FLUSH WITH THE CURB. SLD ELEV. 5534.63

SURVEY INFORMATION

DATE	BY

ENGINEER'S SEAL

NO.	DATE	REMARKS

CITY OF ALBUQUERQUE
PUBLIC WORKS DEPARTMENT
TRANSPORTATION DEVELOPMENT
ARCHES RD. & TONY SANCHEZ DR. PAVING & UTILITY PLAN
WILLOW WOOD UNIT 6 SUBDIVISION

APPROVED
MAR 26 1998
DESIGN REVIEW COMMITTEE




APPROVED
MAR 26 1998
CITY ENGINEER

MO./DAY/YR.	MO./DAY/YR.

City Project No.	Zone Map No.	Sheet	Of
4604.96	L-21-Z	9	13

tonarc.dwg 12-31-97 8:59:37 am EST

SCANNED BY LASON

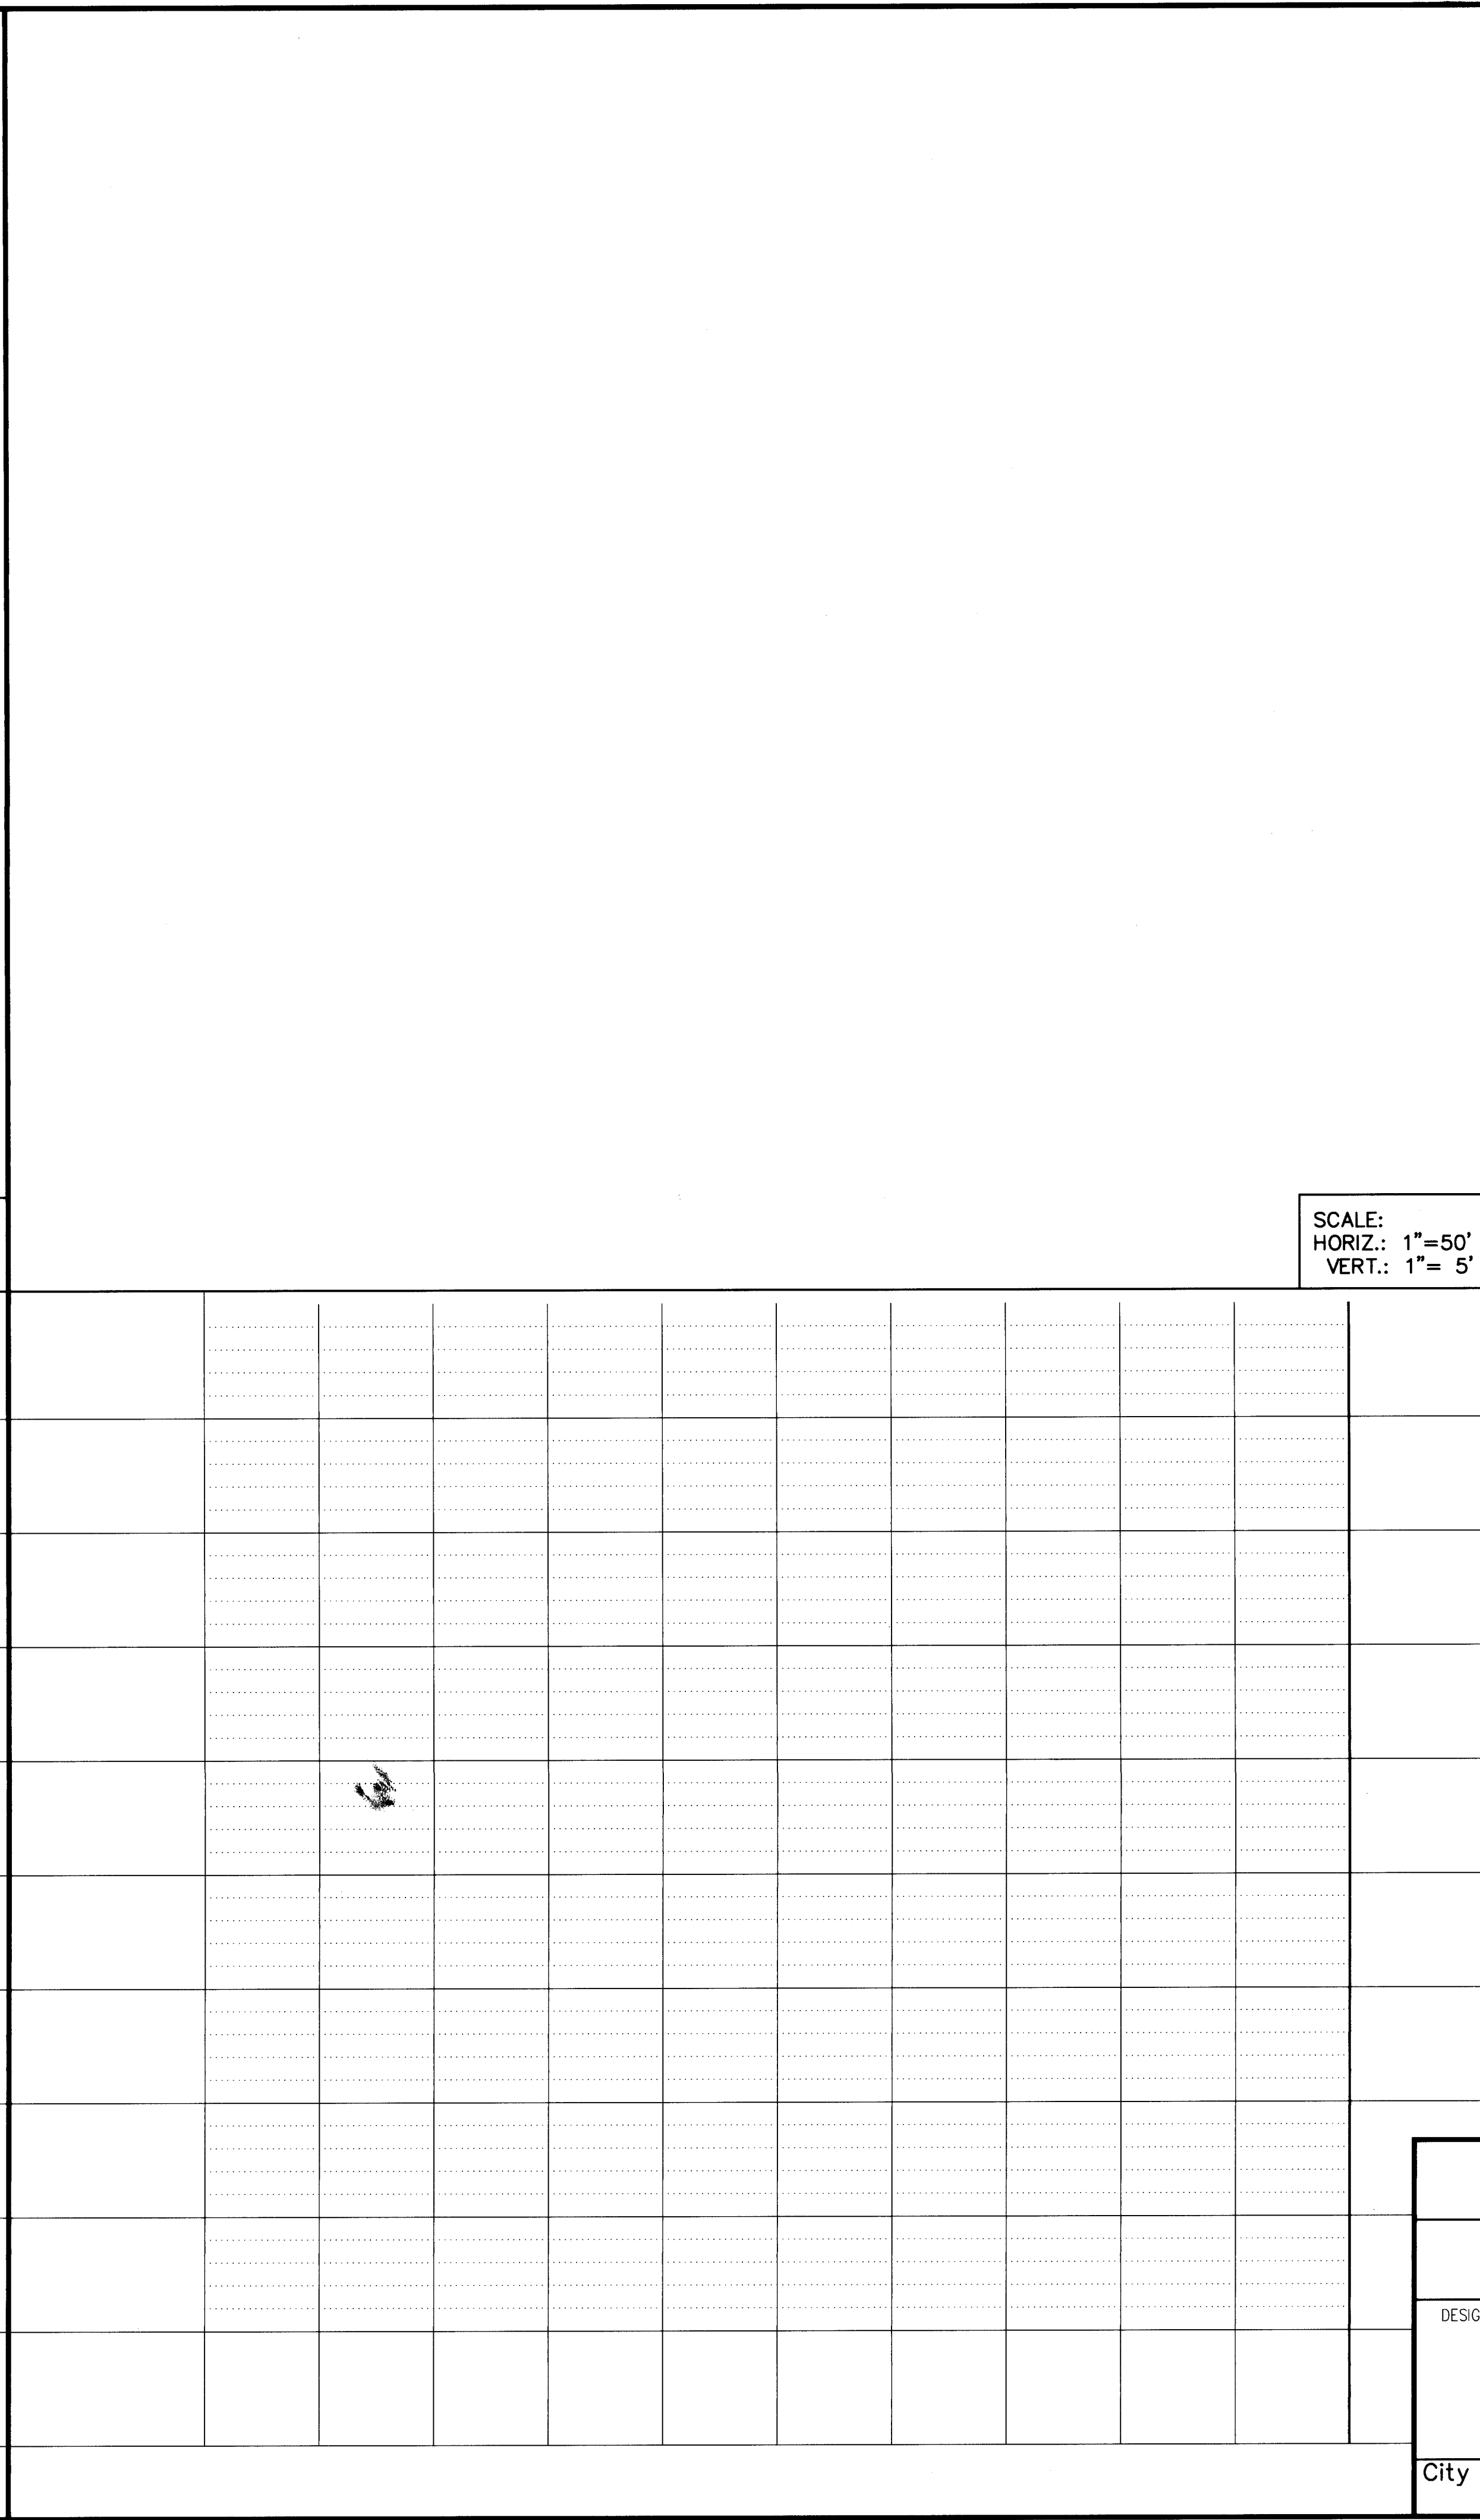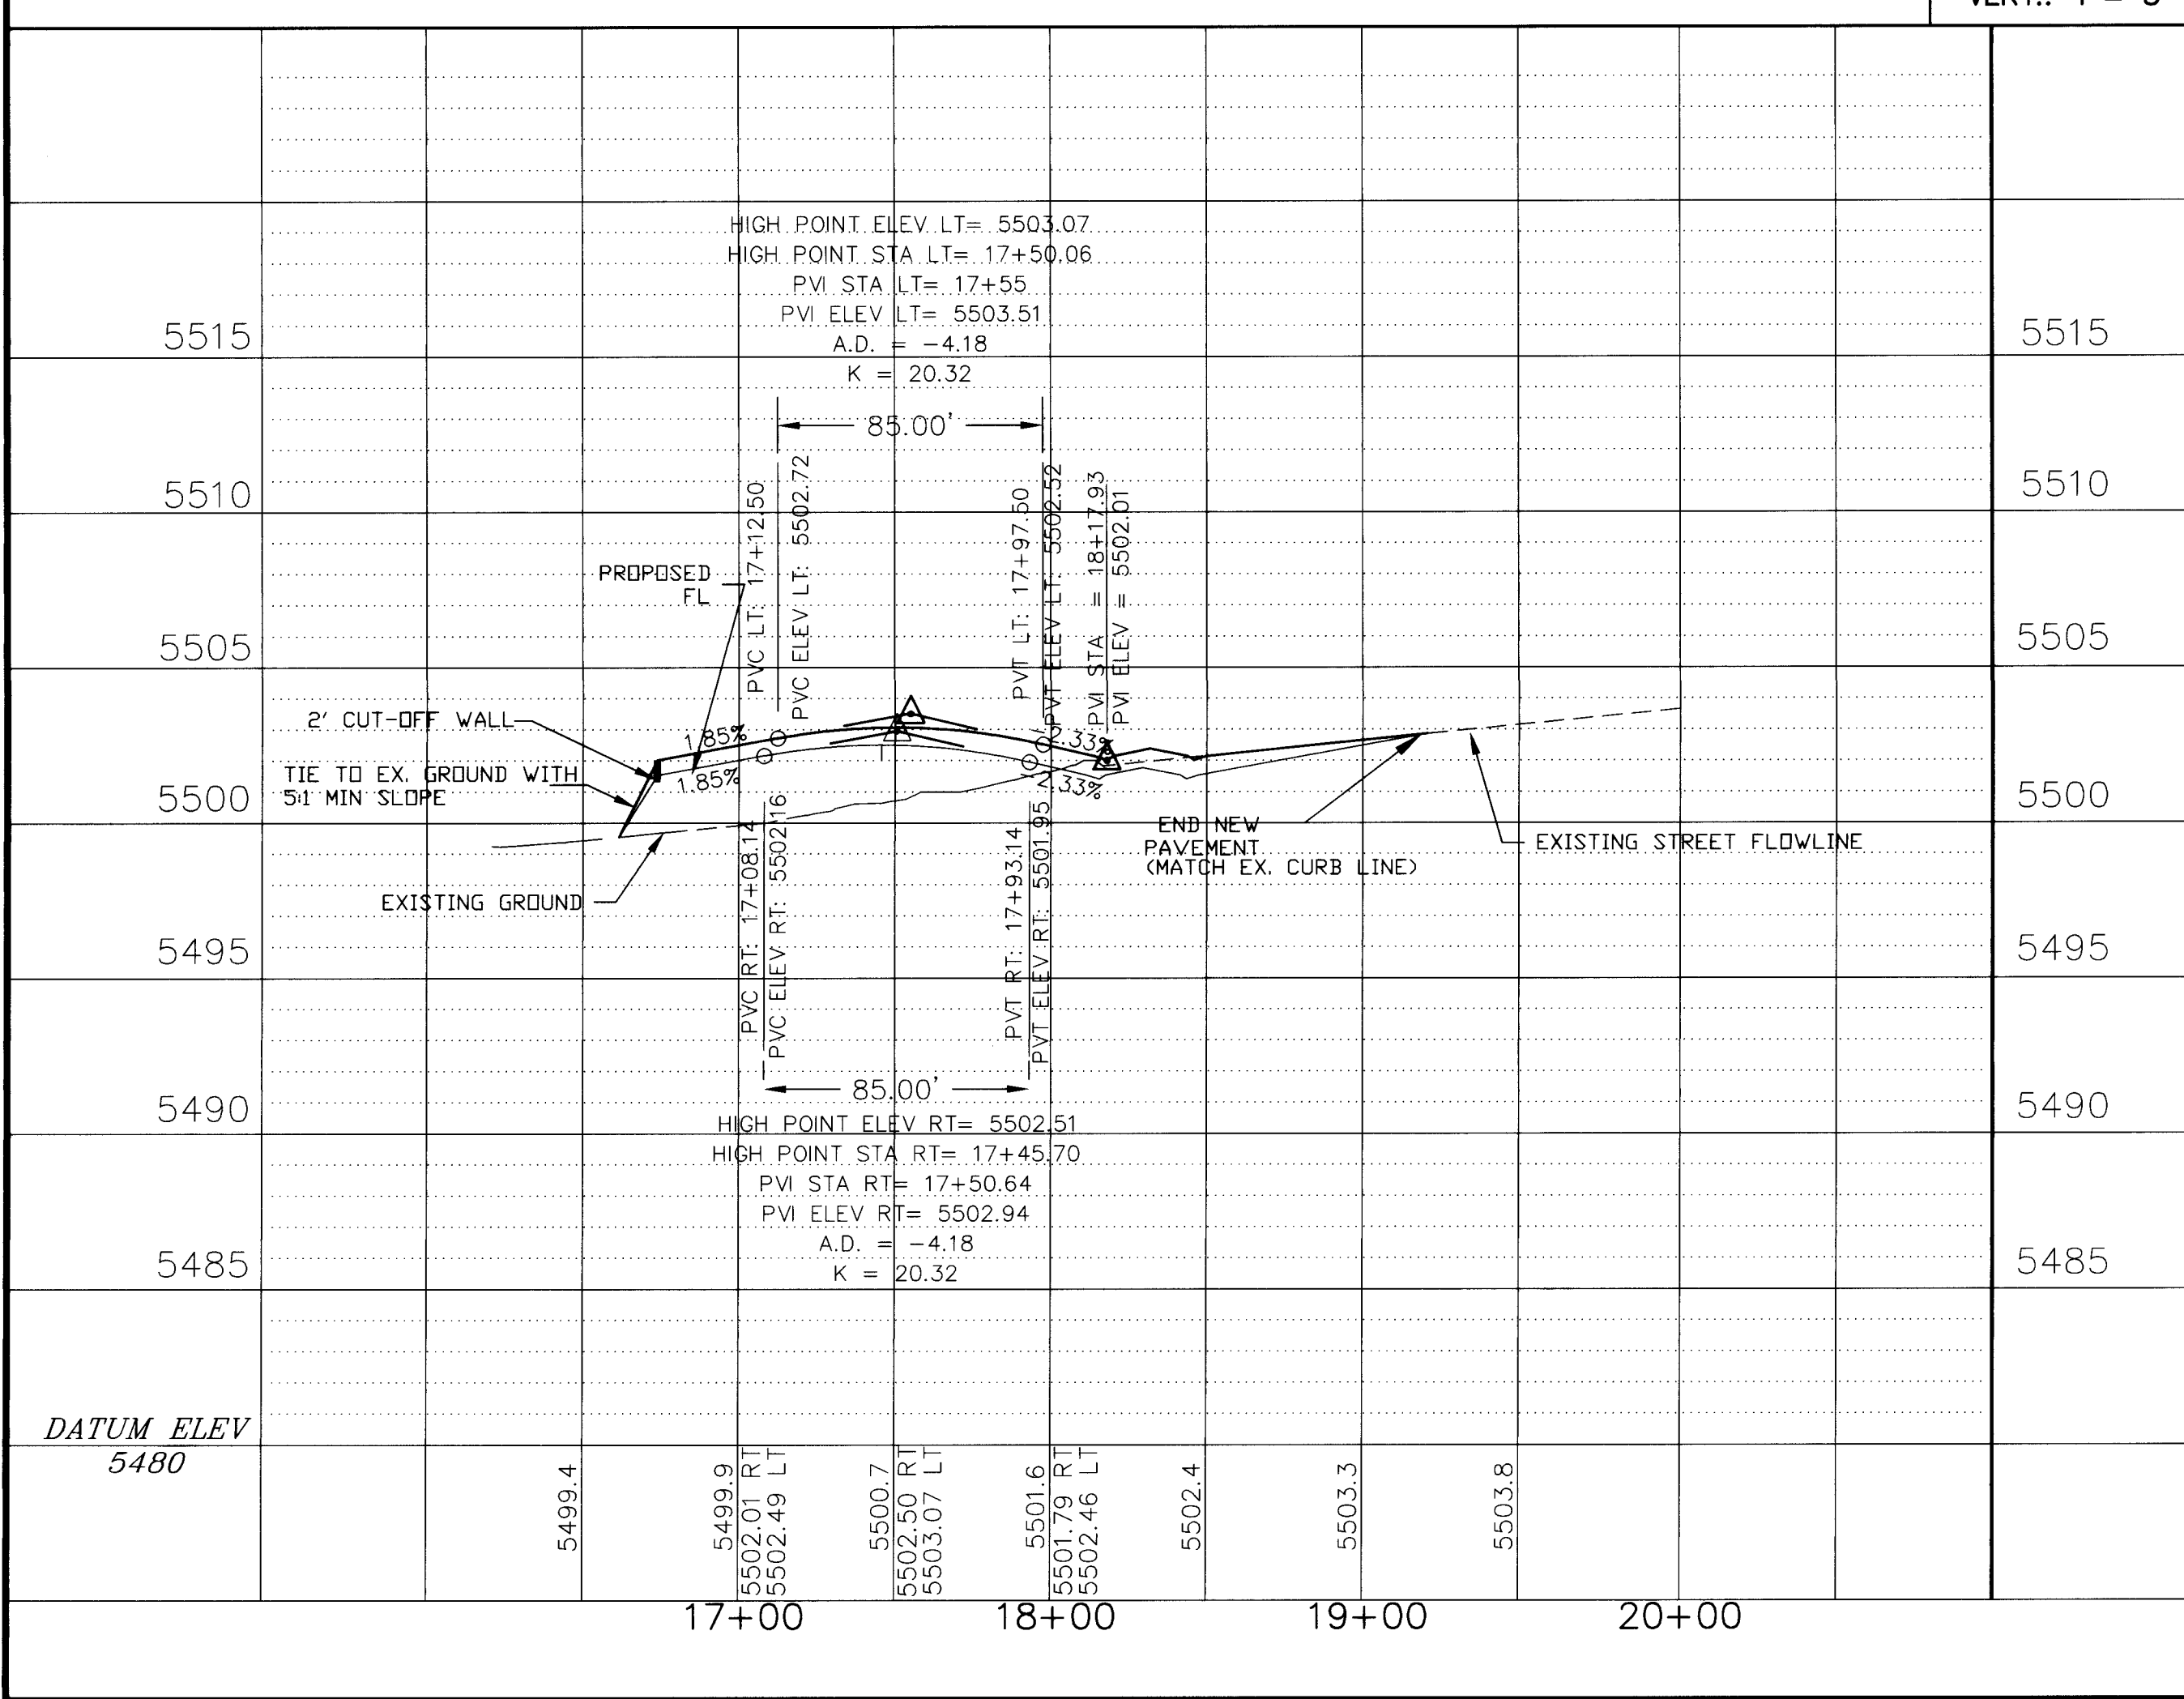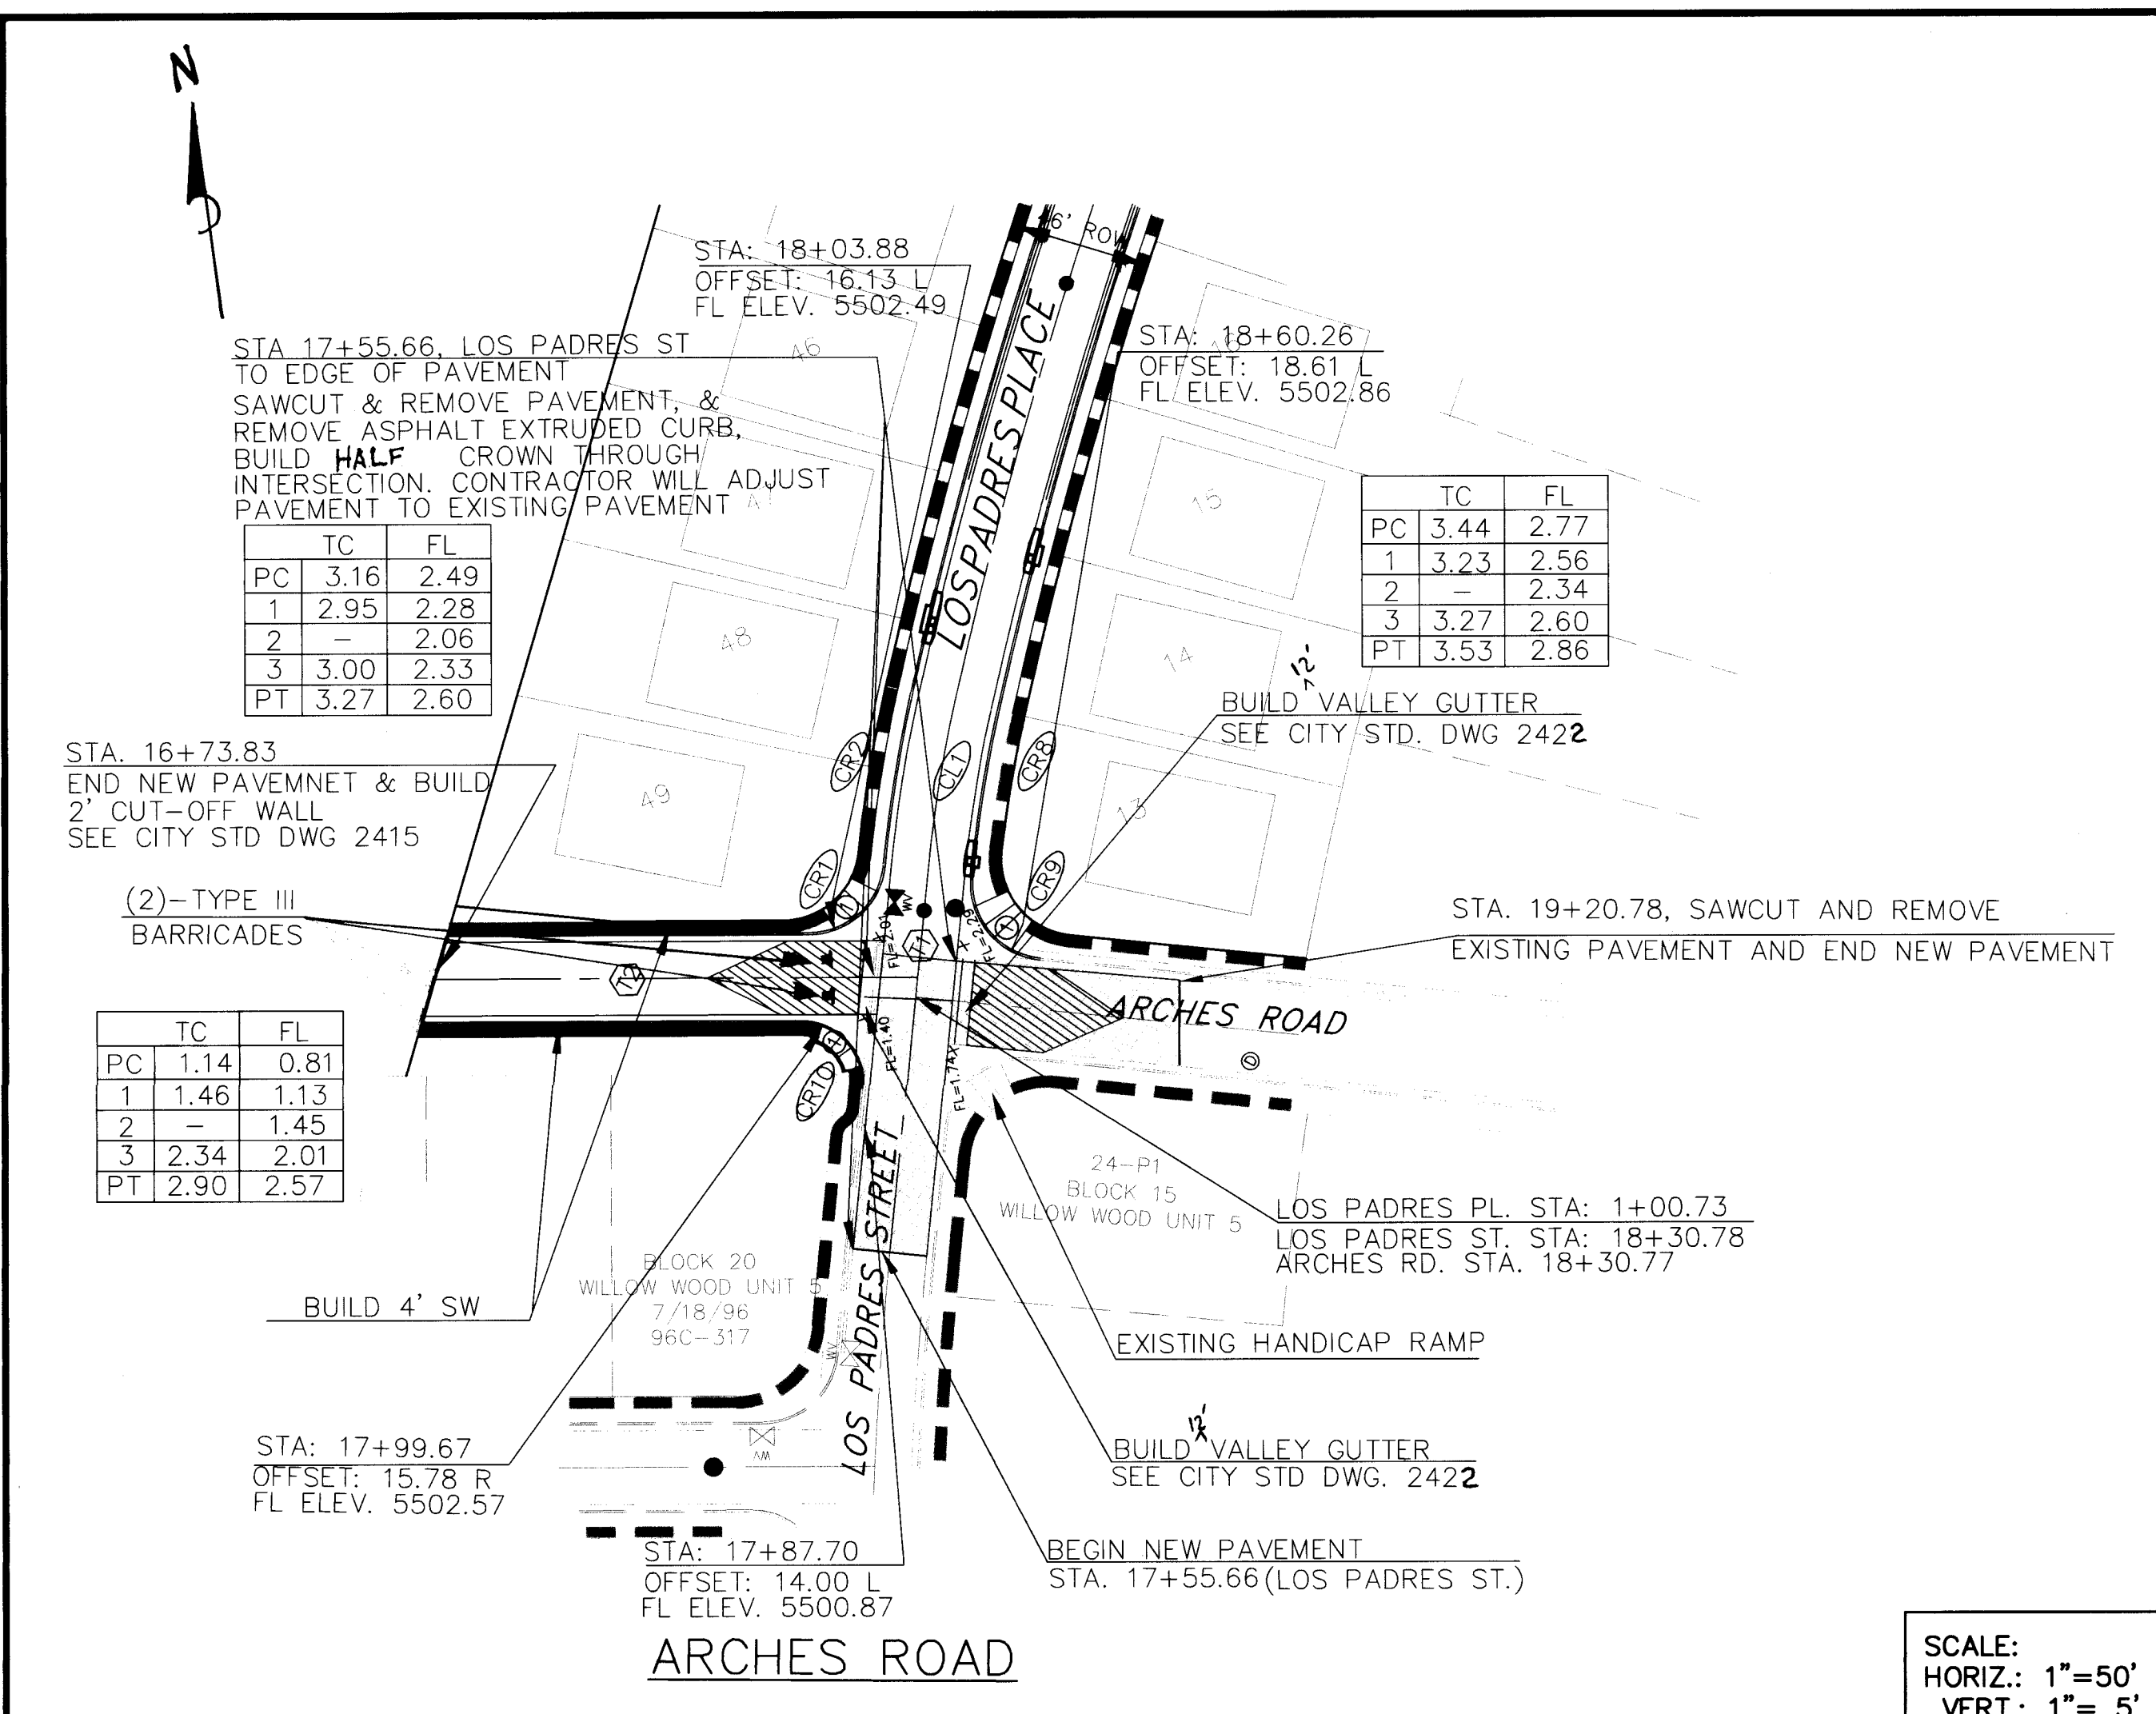

UTILITY NOTES

- STATIONING ALONG C OF STREET UNLESS OTHERWISE NOTED.
- SANITARY SEWER LINE LENGTHS COMPUTED FROM MH C TO MH C.
- SLOPES ARE COMPUTED INVERT TO INVERT. MH RIM ELEVATIONS GIVEN ARE APPROXIMATE. CONTRACTOR SHALL ADJUST ALL RIMS TO FINAL GRADE.
- CONTRACTOR IS RESPONSIBLE FOR COORDINATION WITH UTILITY COMPANIES.
- CONTRACTOR SHALL VERIFY ALL EXISTING UTILITIES AND UTILITY CONNECTIONS PRIOR TO BEGINNING CONSTRUCTION. SHOULD A CONFLICT EXIST OR DESIGN REVISIONS BE REQUIRED FOR ANY REASON, THE CONTRACTOR SHALL NOTIFY THE ENGINEER AND ALLOW SUFFICIENT TIME FOR DESIGN REVISIONS SO AS TO NOT DELAY THE CONSTRUCTION SCHEDULE.

KEYED NOTES

- CONSTRUCT WHEELCHAIR RAMPS PER COA DWG. 2441, TYPE II.

LEGEND

W	EXISTING WATERLINE
SD	EXISTING STORM DRAIN
SAS	EXISTING SANITARY SEWER
●	EXISTING MANHOLE
⊕	EXISTING FIRE HYDRANT
—	EXISTING GATE VALVE
—	PROPOSED WATERLINE
—	PROPOSED STORM DRAIN
—	PROPOSED SANITARY SEWER
●	PROPOSED MANHOLE
⊕	PROPOSED FIRE HYDRANT
—	PROPOSED GATE VALVE
—	PROPOSED CAP OR PLUG
—	PROPOSED SINGLE METER, WATER SERVICE LINE
—	PROPOSED DOUBLE METER, WATER SERVICE LINES
—	PROPOSED SANITARY SEWER SERVICE LINE
+	PROPOSED CROSS, TEE, OR ELBOW
—	FUTURE CURB AND GUTTER
—	SAWCUT, REMOVE & REPLACE EXISTING PAVEMENT

AS BUILT INFORMATION

CONTRACTOR	NO.

BENCH MARKS

THE STATION MARK IS A STANDARD ACS BRASS TABLET, STAMPED "1-L21 RESET 1974", LOCATED 7.8 MILES EAST OF DOWNTOWN ALBUQUERQUE, AT THE INTERSECTION OF CENTRAL AVE. AND JUAN TABO BLVD. THE STATION IS ON THE MEDIAN STRIP OF CENTRAL AVE., 81' WEST OF CENTERLINE OF JUAN TABO BLVD. AND FLUSH WITH THE CURB. S.D. ELEV. 5534.63

SURVEY INFORMATION

DATE	BY	NO.

ENGINEER'S SEAL

[Signature]
6/19/98
SHEET 9a REPLACES SHEET 9
NO. DATE
REMARKS
DESIGN
DATE
DRAWN BY
CHECKED BY

CITY OF ALBUQUERQUE
PUBLIC WORKS DEPARTMENT
TRANSPORTATION DEVELOPMENT


ARCHES RD. PAVING PLAN AND PROFILE
WILLOW WOOD UNIT 6 SUBDIVISION

DESIGN REVIEW COMMITTEE	CITY ENGINEER APPROVAL	MO./DAY/YR.	MO./DAY/YR.

City Project No. 4604.96 Zone Map No. L-21-Z Sheet 9a Of 11


UTILITY DWG. (A-3)-98-0009-07-01

SCANNED BY
BY LASON

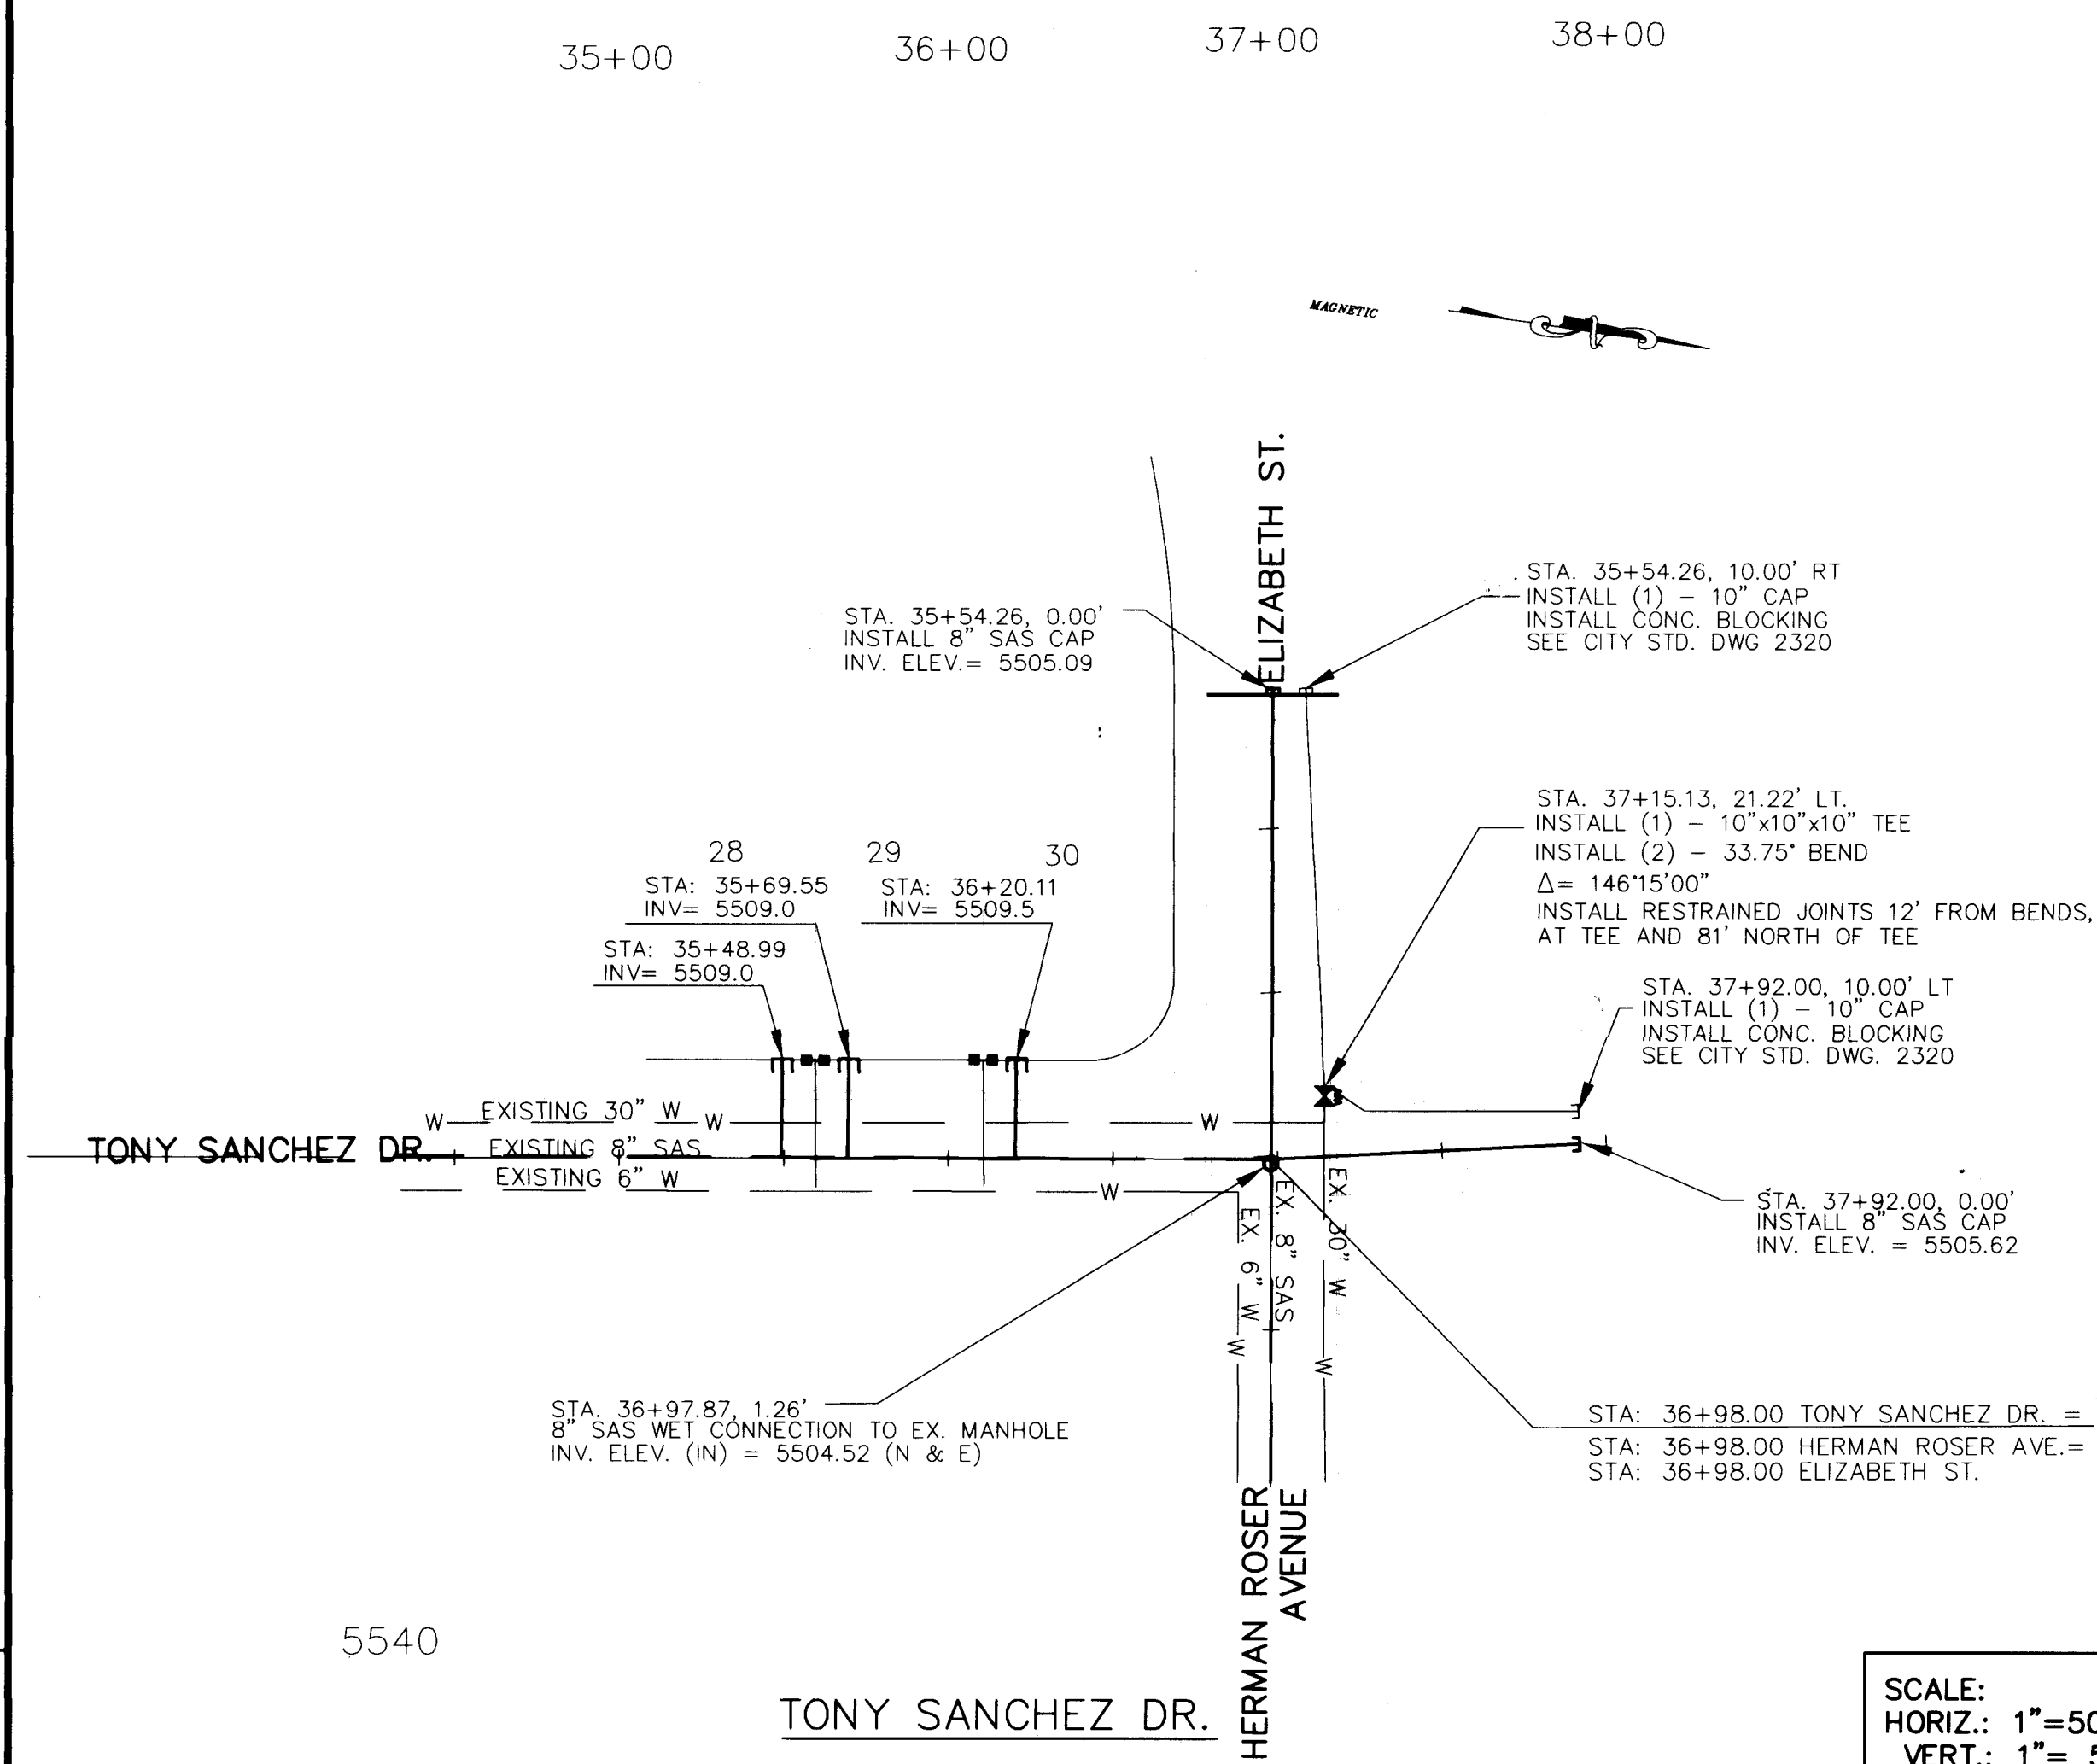







- ### UTILITY NOTES
- STATIONING ALONG C. OF STREET UNLESS OTHERWISE NOTED.
 - SANITARY SEWER LINE LENGTHS COMPUTED FROM MH C. TO MH C.
 - SLOPES ARE COMPUTED INVERT TO INVERT. MH RIM ELEVATIONS GIVEN ARE APPROXIMATE. CONTRACTOR SHALL ADJUST ALL RIMS TO FINAL GRADE.
 - CONTRACTOR IS RESPONSIBLE FOR COORDINATION WITH UTILITY COMPANIES.
 - CONTRACTOR SHALL VERIFY ALL EXISTING UTILITIES AND UTILITY CONNECTIONS PRIOR TO BEGINNING CONSTRUCTION. SHOULD A CONFLICT EXIST OR DESIGN REVISIONS BE REQUIRED FOR ANY REASON, THE CONTRACTOR SHALL NOTIFY THE ENGINEER AND ALLOW SUFFICIENT TIME FOR DESIGN REVISIONS SO AS TO NOT DELAY THE CONSTRUCTION SCHEDULE.
- ### KEYED NOTES
- CONSTRUCT WHEELCHAIR RAMPS PER COA DWG. 2441, TYPE II.

- ### LEGEND
- W — EXISTING WATERLINE
 - SD — EXISTING STORM DRAIN
 - SAS — EXISTING SANITARY SEWER
 - — EXISTING MANHOLE
 - ⊕ — EXISTING FIRE HYDRANT
 - W — EXISTING GATE VALVE
 - W — PROPOSED WATERLINE
 - SD — PROPOSED STORM DRAIN
 - SAS — PROPOSED SANITARY SEWER
 - — PROPOSED MANHOLE
 - ⊕ — PROPOSED FIRE HYDRANT
 - |— PROPOSED GATE VALVE
 - |— PROPOSED CAP OR PLUG
 - |— PROPOSED SINGLE METER, WATER SERVICE LINE
 - |— PROPOSED DOUBLE METER, WATER SERVICE LINES
 - |— PROPOSED SANITARY SEWER SERVICE LINE
 - + + + PROPOSED CROSS, TEE, OR ELBOW
 - + + + FUTURE CURB AND GUTTER
 - SAWCUT, REMOVE & REPLACE EXISTING PAVEMENT

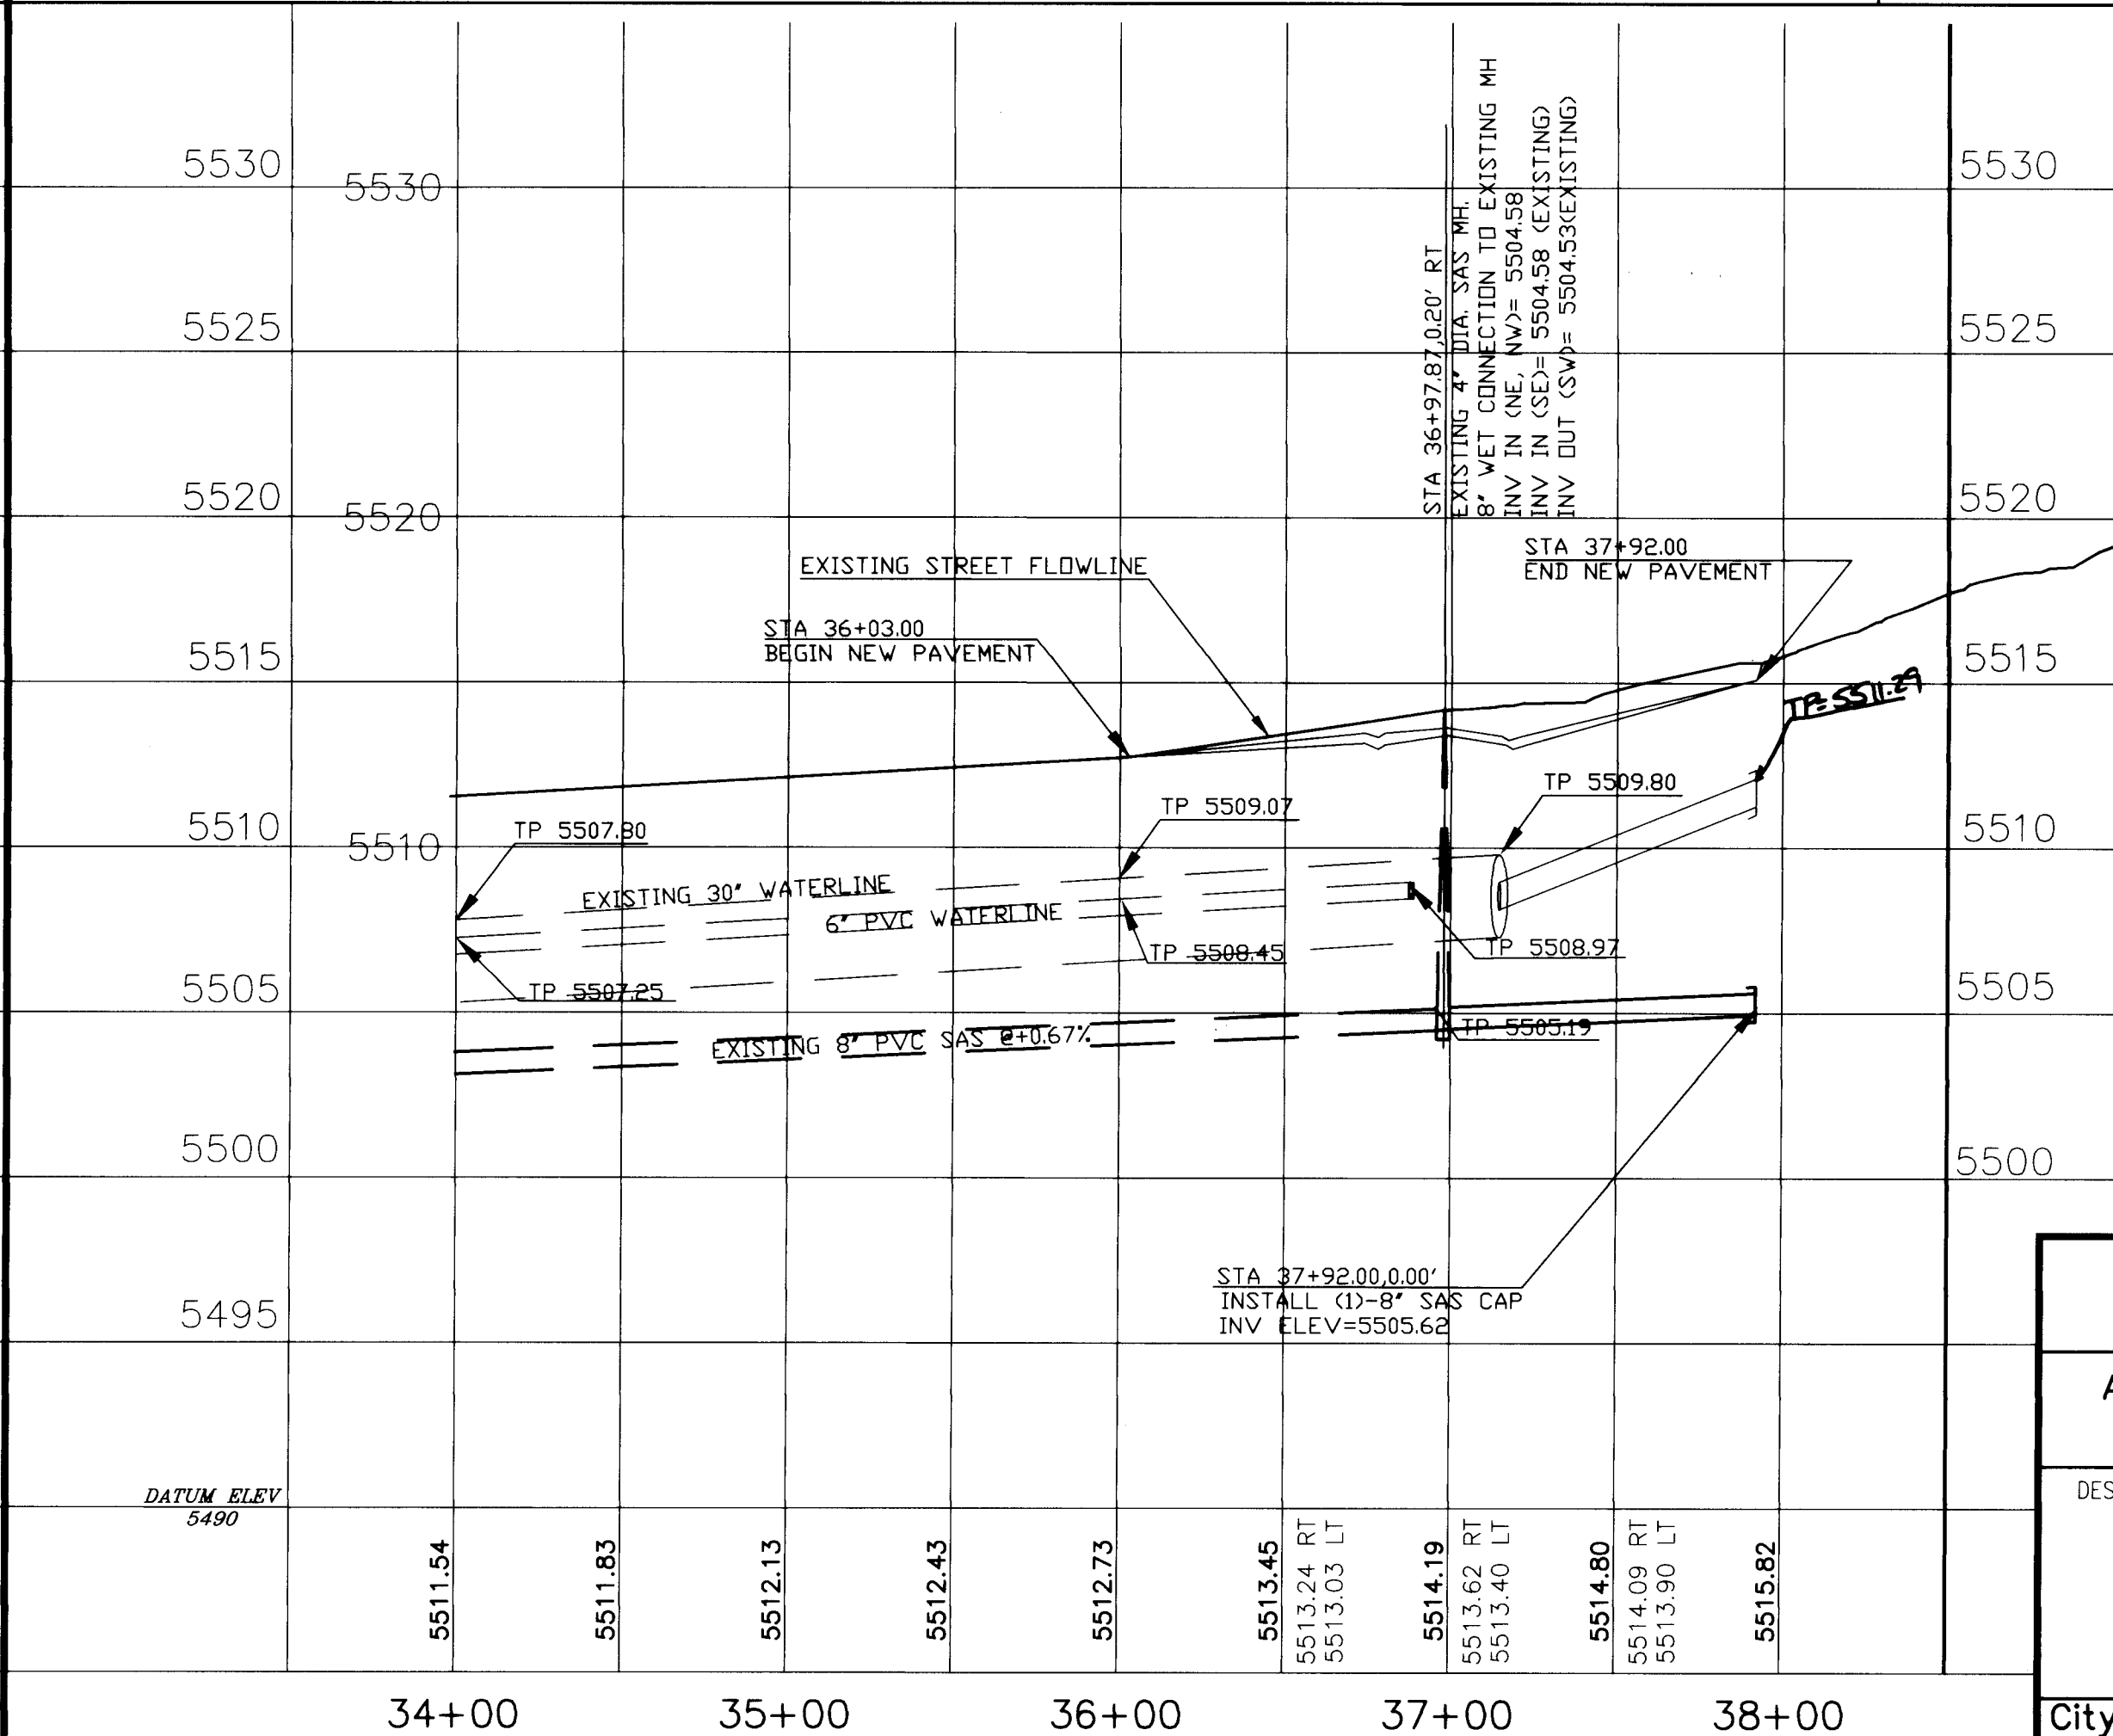

CITY OF ALBUQUERQUE PUBLIC WORKS DEPARTMENT TRANSPORTATION DEVELOPMENT			
ARCHES RD. & TONY SANCHEZ DR. PAVING & UTILITY PLAN WILLOW WOOD UNIT 6 SUBDIVISION			
DESIGN REVIEW COMMITTEE	APPROVED CITY ENGINEER NOV - 8 1999	MO./DAY/YR.	MO./DAY/YR.
City Project No. 4604.96	Zone Map No. L-21-Z	Sheet 9b	Of 13

SCANNED BY
BY LASON

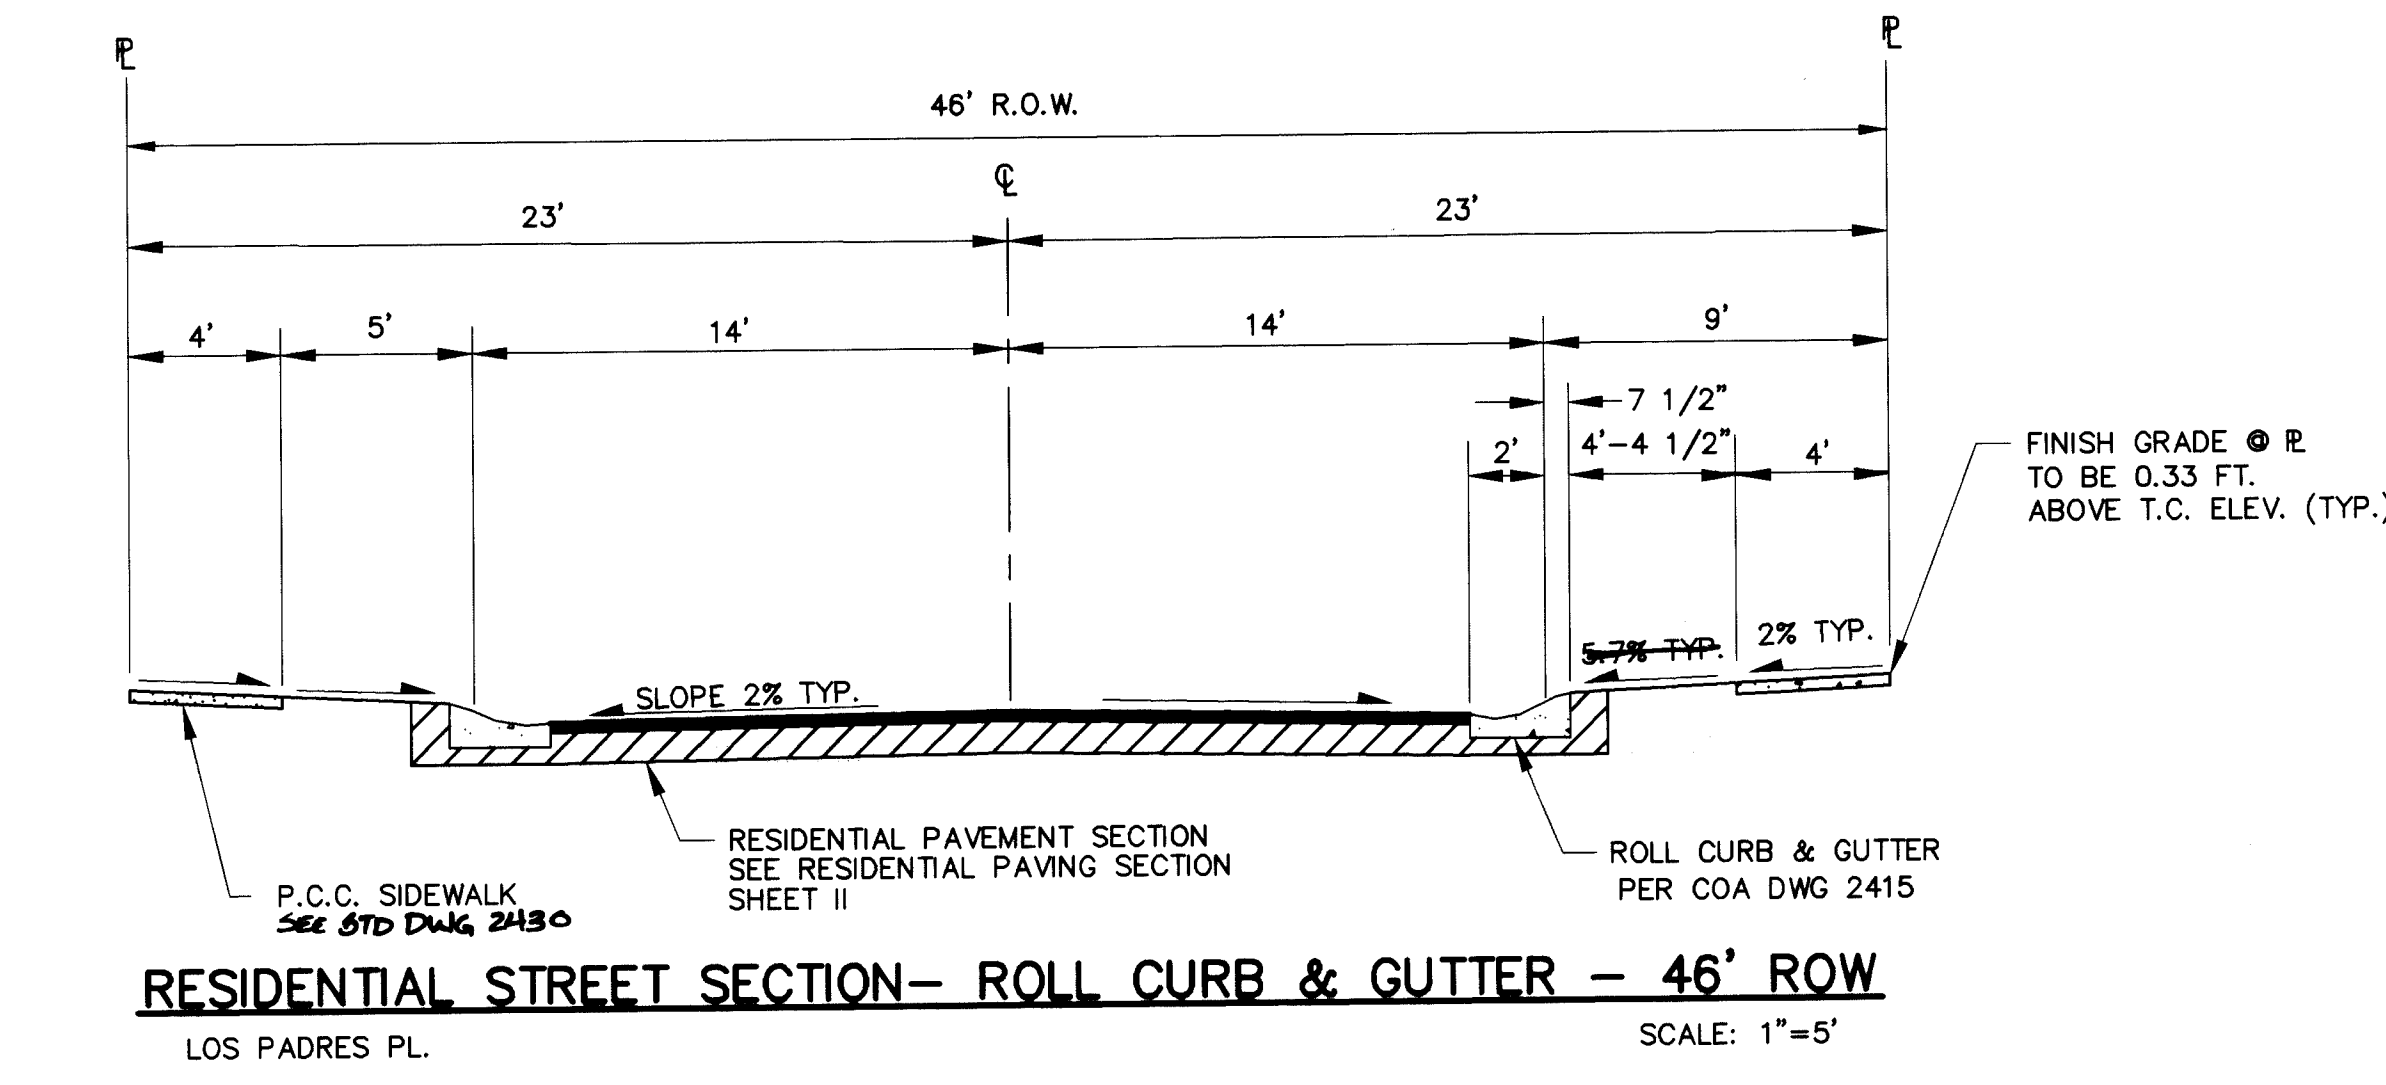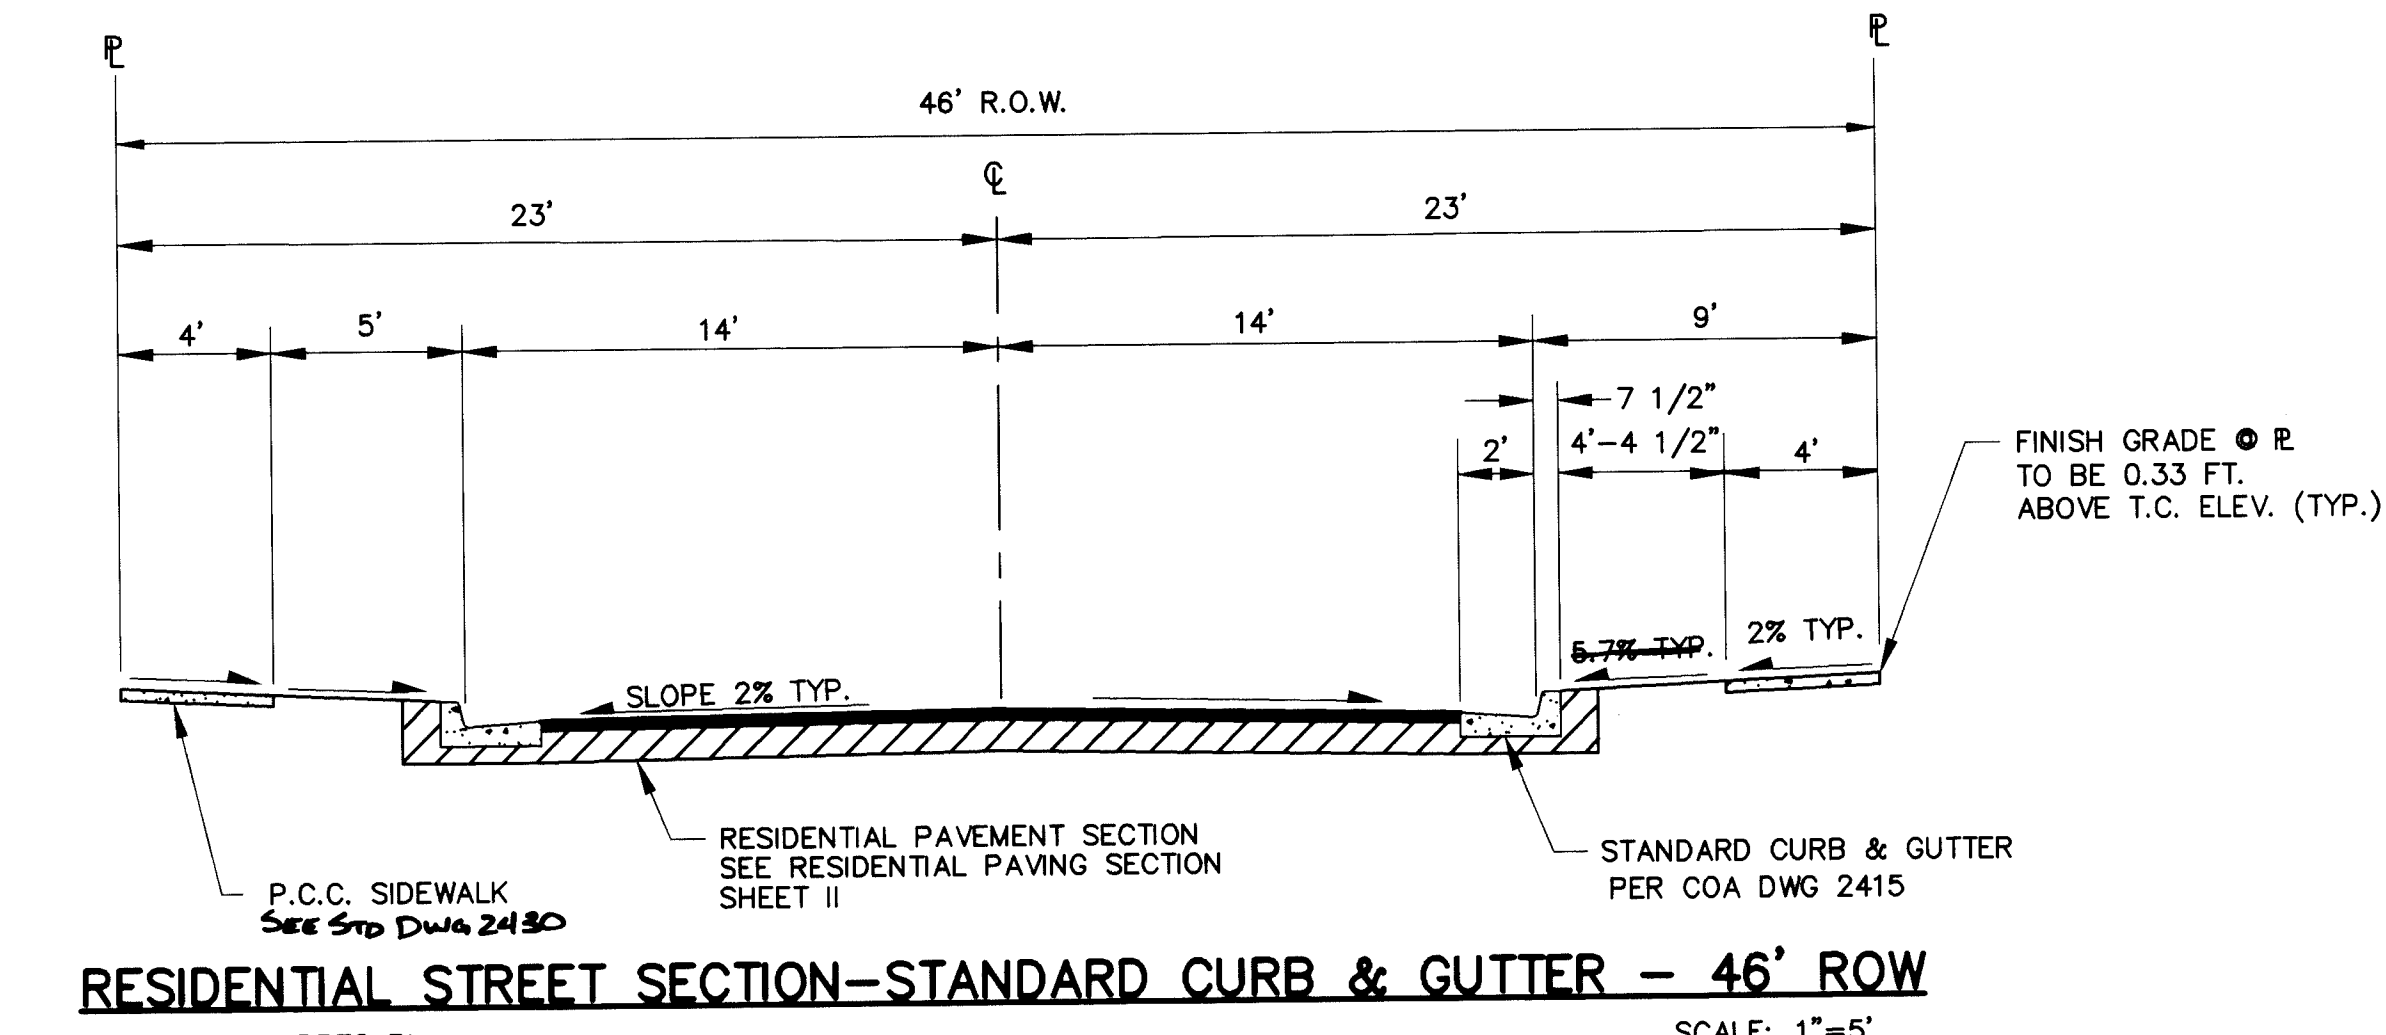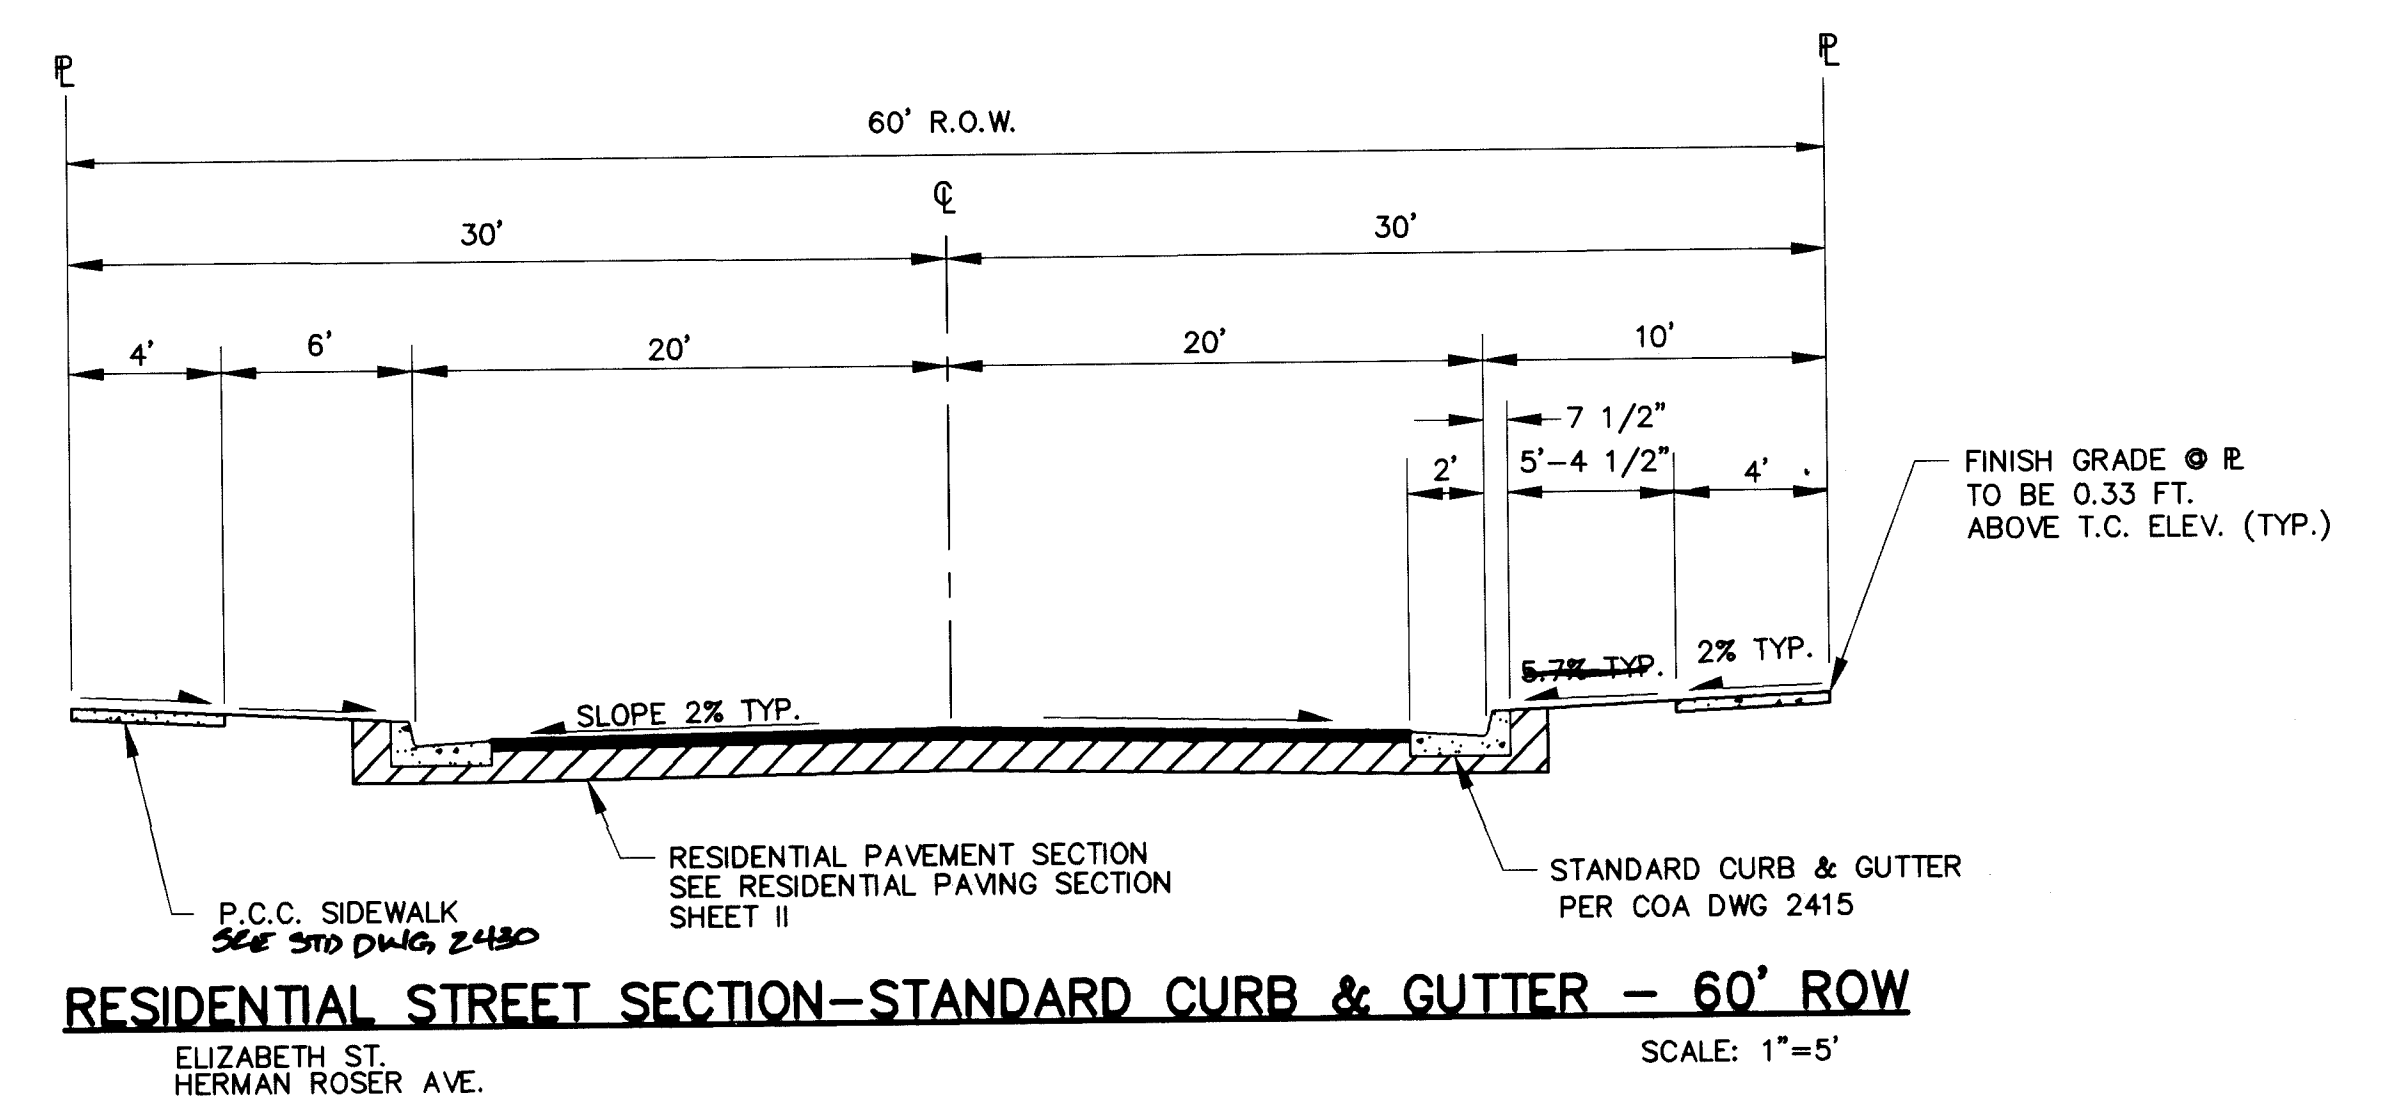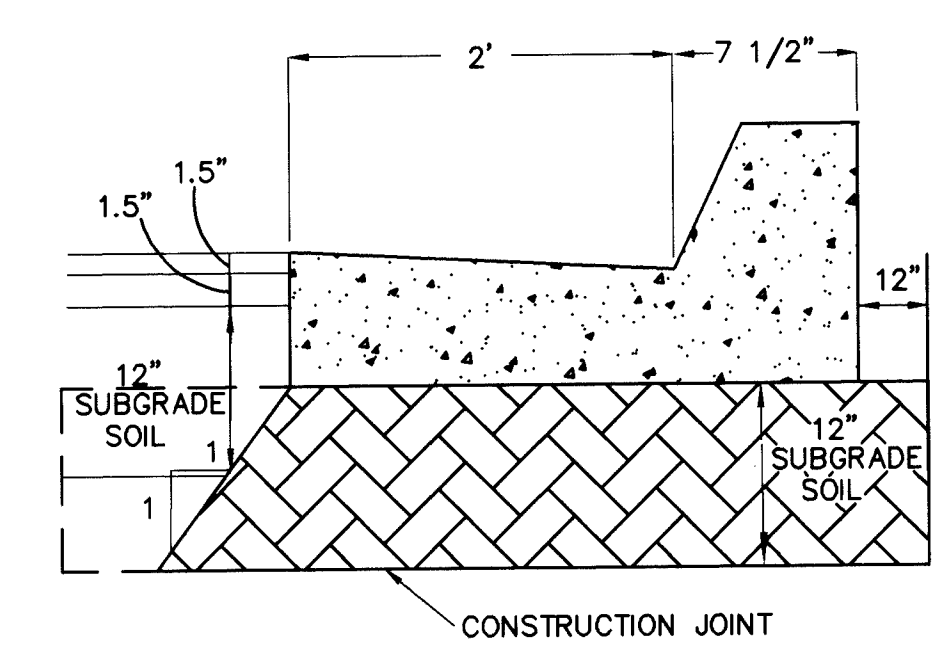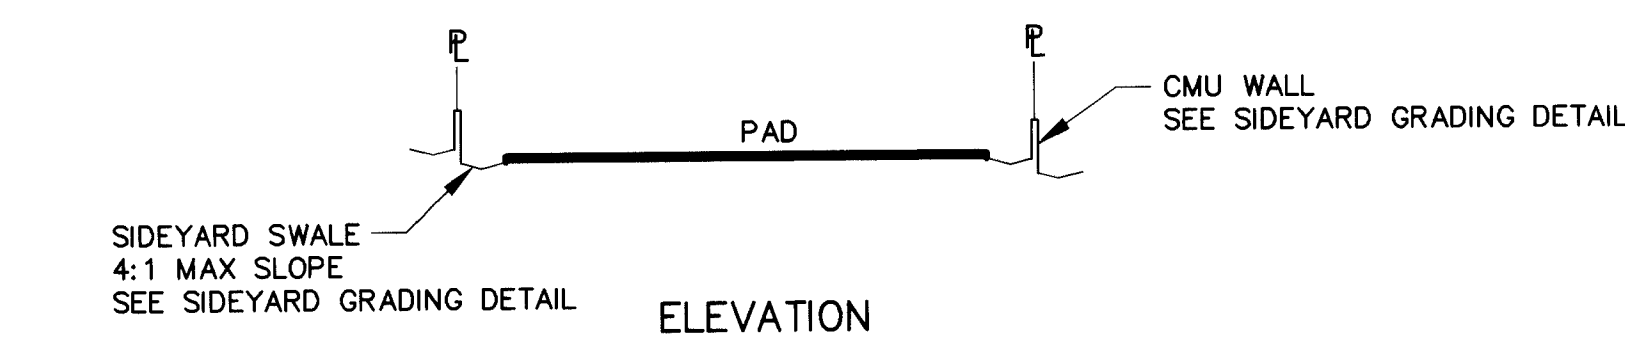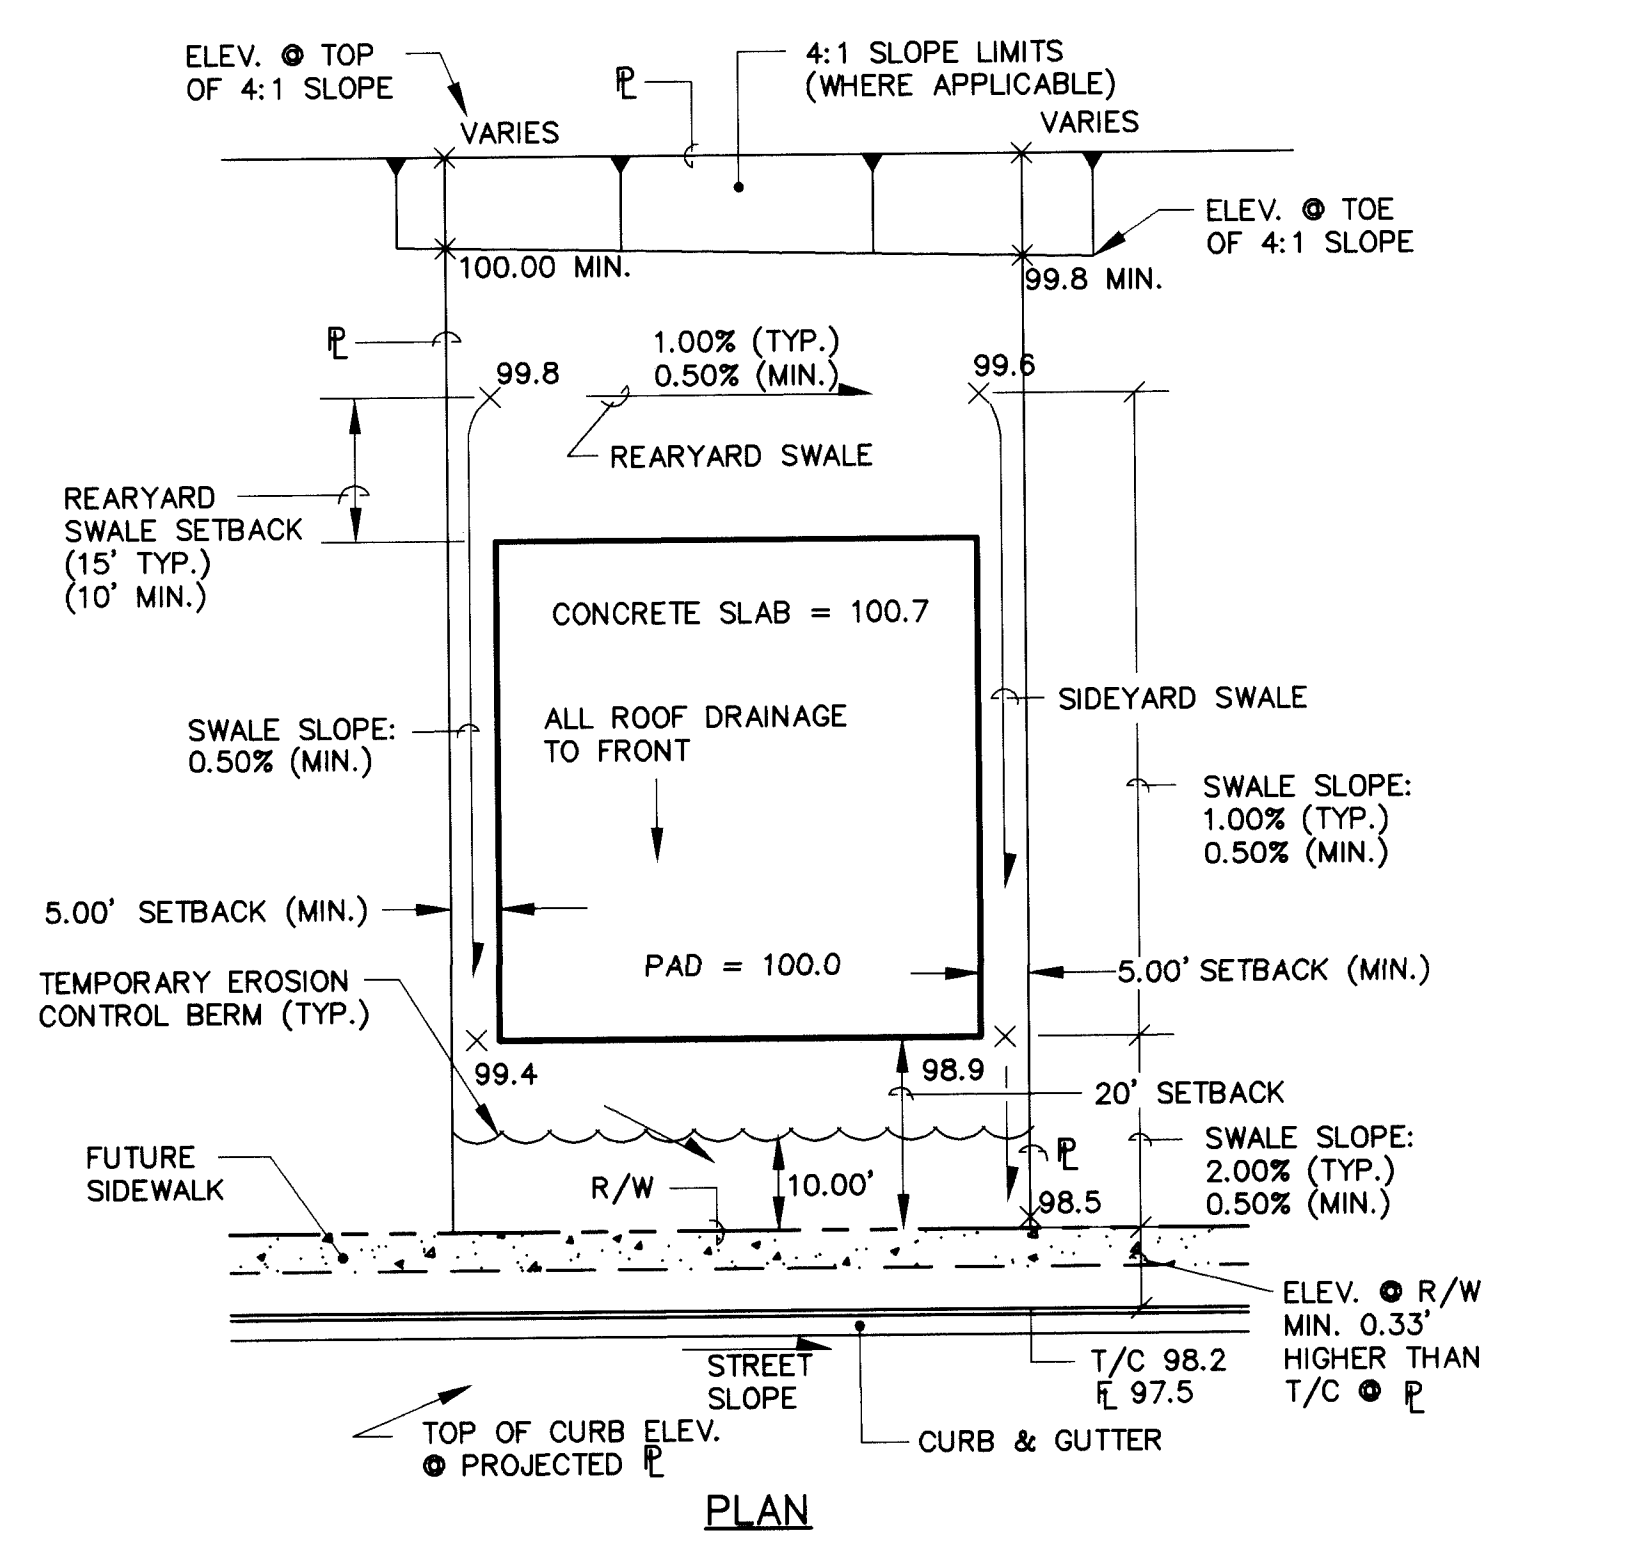

LOT GRADING GENERAL NOTES:

1. LOT GRADING SHALL MEET THE SITE GRADING AND DRAINAGE CRITERIA FOR PROPOSED CONSTRUCTION AS SET FORTH BY THE DEPARTMENT OF HOUSING AND URBAN DEVELOPMENT - FEDERAL HOUSING ADMINISTRATION IN CIRCULAR LETTER NO. 91-1, OFFICE OF THE MANAGER, ALBUQUERQUE, NEW MEXICO, DATED 1/25/91.
2. ELEVATION OF HIGHPOINT OF REARYARD SWALE SHALL BE MIN. OF 6" BELOW PAD ELEVATION.
3. FINISHED FLOOR ELEVATIONS (NOT SHOWN) SHALL BE 8" ABOVE PAD ELEVATIONS (SHOWN).
4. FRONT YARD SIDEWALK SLOPE SHALL NOT EXCEED 10%.
5. DRIVEWAY SLOPE SHALL NOT EXCEED 14%. IF DRIVEWAY IS USED AS SIDEWALK, MAX-SLOPE SHALL NOT EXCEED 10%.
6. SLOPES SHALL NOT EXCEED 4:1.
7. THE CONTRACTOR MUST OBTAIN A TOPSOIL DISTURBANCE PERMIT FROM THE ENVIRONMENTAL HEALTH DIVISION PRIOR TO COMMENCING CONSTRUCTION.
8. THE CONTRACTOR IS TO REFER TO EARTHWORK SPECIFICATIONS AS NOTED IN THE SOILS REPORT SUPPLIED BY CURB INC.
9. THE CONTRACTOR SHALL CONFORM TO ALL CITY, COUNTY, STATE AND FEDERAL DUST CONTROL MEASURES AND REQUIREMENTS AND WILL BE RESPONSIBLE FOR PREPARING AND OBTAINING ALL NECESSARY APPLICATIONS AND APPROVALS.
10. THE CONTRACTOR SHALL ENSURE THAT NO SOIL ERODES FROM THE CONSTRUCTION SITE. EROSION CONTROL MEASURES ARE INTENDED TO CONTROL MINOR FLOWS AND PROHIBIT THE RELEASE OF SEDIMENT INTO ADJACENT STREETS AND PROPERTY. EROSION CONTROL AND DIVERSION BERMS SHALL BE CONSTRUCTED IN ACCORDANCE WITH THE DETAIL SHOWN ON THIS SHEET, AT LOCATIONS SHOWN ON THE GRADING PLAN.
11. THE CONTRACTOR IS RESPONSIBLE FOR MAINTAINING TEMPORARY BERMS THROUGHOUT THE CONSTRUCTION PHASE. THE OWNER WILL MAINTAIN BERMS AFTER COMPLETION AND ACCEPTANCE OF CONSTRUCTION.
12. TEMPORARY EROSION CONTROL BERMS LOCATED ON INDIVIDUAL LOTS SHALL REMAIN IN PLACE UNTIL THE CONSTRUCTION OF EACH RESPECTIVE BUILDING IS COMPLETE, ON A LOT BY LOT BASIS.
13. THE TOLERANCES FOR ROUGH GRADING SHALL CONFORM TO THE FOLLOWING:
PAD SUBGRADE: +/- 0.2'
STREET SUBGRADE: +/- 0.2'
ALL OTHER AREAS: +/- 0.5'
14. BACKYARD DRAINS TO BE PROVIDED AS DESIGNATED.

15. THE CONTRACTOR IS FULLY RESPONSIBLE FOR FIELD VERIFYING ALL EXISTING UTILITIES AND NOTIFY THE ENGINEER IMMEDIATELY OF ANY DISCREPANCIES. CAUTION SHALL BE EXERCISED WHEN WORKING IN THE VICINITY OF EXISTING UTILITIES. ANY DAMAGE TO EXISTING UTILITIES RESULTING FROM CONSTRUCTION ACTIVITIES WILL BE REPAIRED BY THE CONTRACTOR AT THE CONTRACTOR'S EXPENSE.
 16. GRADE ELEVATIONS, WHERE NOTED, ARE FOR TOP OF STANDARD CURB UNLESS OTHERWISE SPECIFIED.
 17. CONTRACTOR IS RESPONSIBLE FOR REPAIR AND/OR REPLACEMENT OF ALL UTILITY CONDUITS AND EXISTING LINES.
 18. ANY DAMAGE TO THE EXISTING FACILITIES (CURB AND GUTTER, PAVEMENT, CONDUITS, LANDSCAPING, UTILITY LINES, ETC.) DURING CONSTRUCTION SHALL BE REPLACED AT THE CONTRACTOR'S EXPENSE.
 19. THE CONTRACTOR SHALL REVEGETATE AND RE-ESTABLISH ALL AREAS WHICH ARE DISTURBED BY SITE GRADING AND ARE NOT TO RECEIVE PERMANENT SURFACE TREATMENTS. SPECIFICATIONS FOR SEEDING SHALL BE PER CITY OF ALBUQUERQUE STANDARD SPECIFICATIONS FOR PUBLIC WORKS CONSTRUCTION, LATEST EDITION, SECTION 1011, NATIVE SEEDING CLASS A.
- OPERATION SHALL CONSIST OF PROTECTION OF SITE, PREPARATION OF SEEDBED, MULCHING, FERTILIZATION, AND THE PROVISION OF MATERIALS, LABOR, AND EQUIPMENT NECESSARY TO PERFORM THE OPERATION. THE SEED MIX SHALL BE AS DENOTED IN THE LIST BELOW.

SEED TYPE	LBS. PLS PER ACRE
GRASSES	
INDIAN RICE(10%) GRASS	15 LBS.
GALLETA GRASS(30%) 'VIVA'	3.5 LBS.
SIDE OATS(20%) GRAMA	2 LBS.
SAND(10%) DROPSIDE	1 LB.
BLUE GRAMA(30%) 'HACHITA'	2 LBS.
WILD FLOWERS	
TAHOKA DAISY	1 LB.
YELLOW CONEFLOWER	1 LB.
GALLARDIA	1 LB.

AVID ENGINEERING, INC.
Civil • Structural • Transportation
5801 Osuna Rd. NE - Suite 200
Albuquerque, NM 87109 - (505) 881-5357

CITY OF ALBUQUERQUE PUBLIC WORKS DEPARTMENT TRANSPORTATION DEVELOPMENT			
DETAILS WILLOW WOOD, UNIT 6			
DESIGN REVIEW COMMITTEE APPROVE MAR 26 1998	CITY ENGINEER APPROVAL APPROVE MAY - 8 1998 CITY ENGINEER	NO./DAY/YR. NO./DAY/YR.	NO./DAY/YR. NO./DAY/YR.
City Project No. 4604.96	Zone Map No. L-21-Z	Sheet 10 Of 13	



* NOTE: SOIL NOT HAVING THE MINIMUM R-VALUE OF 50, SHALL BE REMOVED TO DEPTH OF 2' AND REPLACED, BY THE CONTRACTOR, WITH SUITABLE MATERIAL OR A PAVEMENT SECTION SHALL BE DESIGNED BY CONSULTANT ACCOMMODATING THE EXISTING R-VALUE PER COA SPECIFICATIONS.



SCALE: $3/4" = 1'-0"$

- ## GENERAL NOTES FOR RETAINING WALL
1. REINFORCEMENT CLEARANCE IN ALL CMU = 2-3/4" MAX.
 2. REINFORCEMENT CLEARANCE IN ALL CONCRETE = 2" MIN., UNLESS OTHERWISE NOTED.
 3. 1/2" FELT EXPANSION JOINT TO BE PROVIDED EVERY 16 FT. IN CMU AND CONCRETE AND AT TRANSITIONS IN SECTIONS.
 4. ALL CMU RETAINING WALL CELLS CONTAINING REINFORCEMENT SHALL BE FILLED WITH CONCRETE.
 5. ALL FOOTING COMPACTION SHALL BE 95% MODIFIED PROCTOR PER ASTM D-1557.
 6. TWO (2) WORKING DAYS BEFORE CONSTRUCTION, CONTRACTOR SHALL NOTIFY LINE LOCATING SERVICE, 765-1234, FOR UTILITY LOCATIONS. CONTRACTOR SHALL COORDINATE ANY ADJUSTMENTS TO UTILITIES WITH THE UTILITIES COMPANIES.
 7. DUR--O--WALL 9 GA. DIAG. EVERY OTHER COURSE MAY BE USED AS AN ALTERNATIVE TO BOND BEAMS.
 8. MOISTURE BARRIER COATING SHALL BE APPLIED TO ALL BURIED CMU SURFACES.
 9. BACK FILLING AGAINST REINFORCED CONCRETE MASONRY RETAINING WALL SHOULD NOT BE PERMITTED UNTIL AT LEAST 7 DAYS AFTER PLACING THE CORE FILL GROUT. WHERE HEAVY EQUIPMENT IS USED IN BACK FILLING WALLS DESIGNED TO RESIST EARTH PRESSURE ONLY, SUCH EQUIPMENT SHOULD NOT APPROACH CLOSER TO THE TOP OF THE WALL THAN A DISTANCE EQUAL TO THE HEIGHT OF THE WALL. CARE SHOULD ALSO BE TAKEN TO AVOID EXERTING LARGE IMPACT FORCES ON THE WALL AS COULD BE CAUSED BY A LARGE MASS OF MOVING EARTH.
 10. INSPECTION OF WALLS DURING CONSTRUCTION BY THE ENGINEER IS REQUIRED FOR ACCEPTANCE.

MATERIALS

CONCRETE: $f_c = 4000$ PSI
GROUT: $f_c = 2500$ PSI
MORTAR: 1800 PSI (TYPE S)
MASONRY: $f_m = 1500$ PSI
REINFORCING: GRADE 60

AVID ENGINEERING, INC.
Civil • Structural • Transportation
5801 Osuna Rd. NE - Suite 200
Albuquerque, NM 87109 - (505) 881-5357

CITY OF ALBUQUERQUE
PUBLIC WORKS DEPARTMENT
TRANSPORTATION DEVELOPMENT

WALL DETAILS
WILLOW WOOD UNIT 6 SUBDIVISION

DESIGN REVIEW COMMITTEE		CITY ENGINEER		MO./DAY/YR.		MO./DAY/YR.	
							
DESIGN REVIEW COMMITTEE		CITY ENGINEER					
City Project No. 4604.96		Zone Map No. L-21-Z		Sheet 11 Of 11		1/13	

