
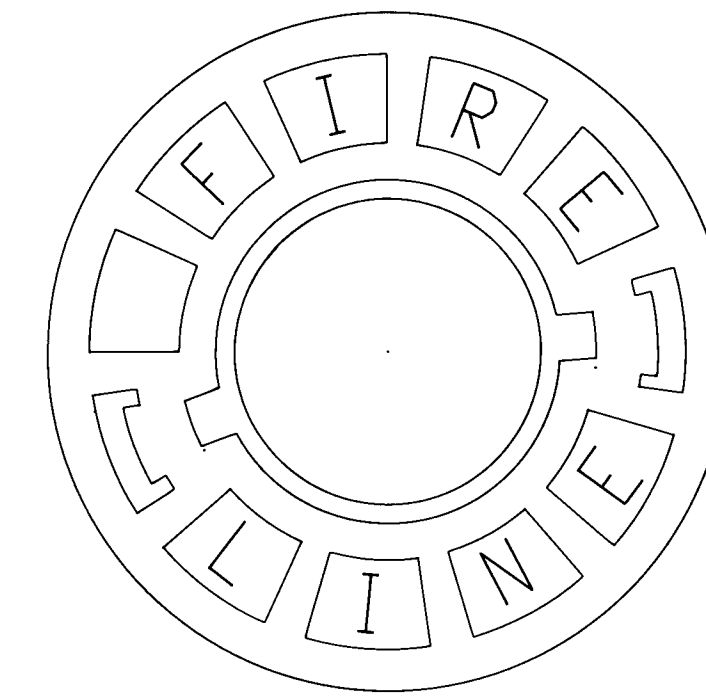


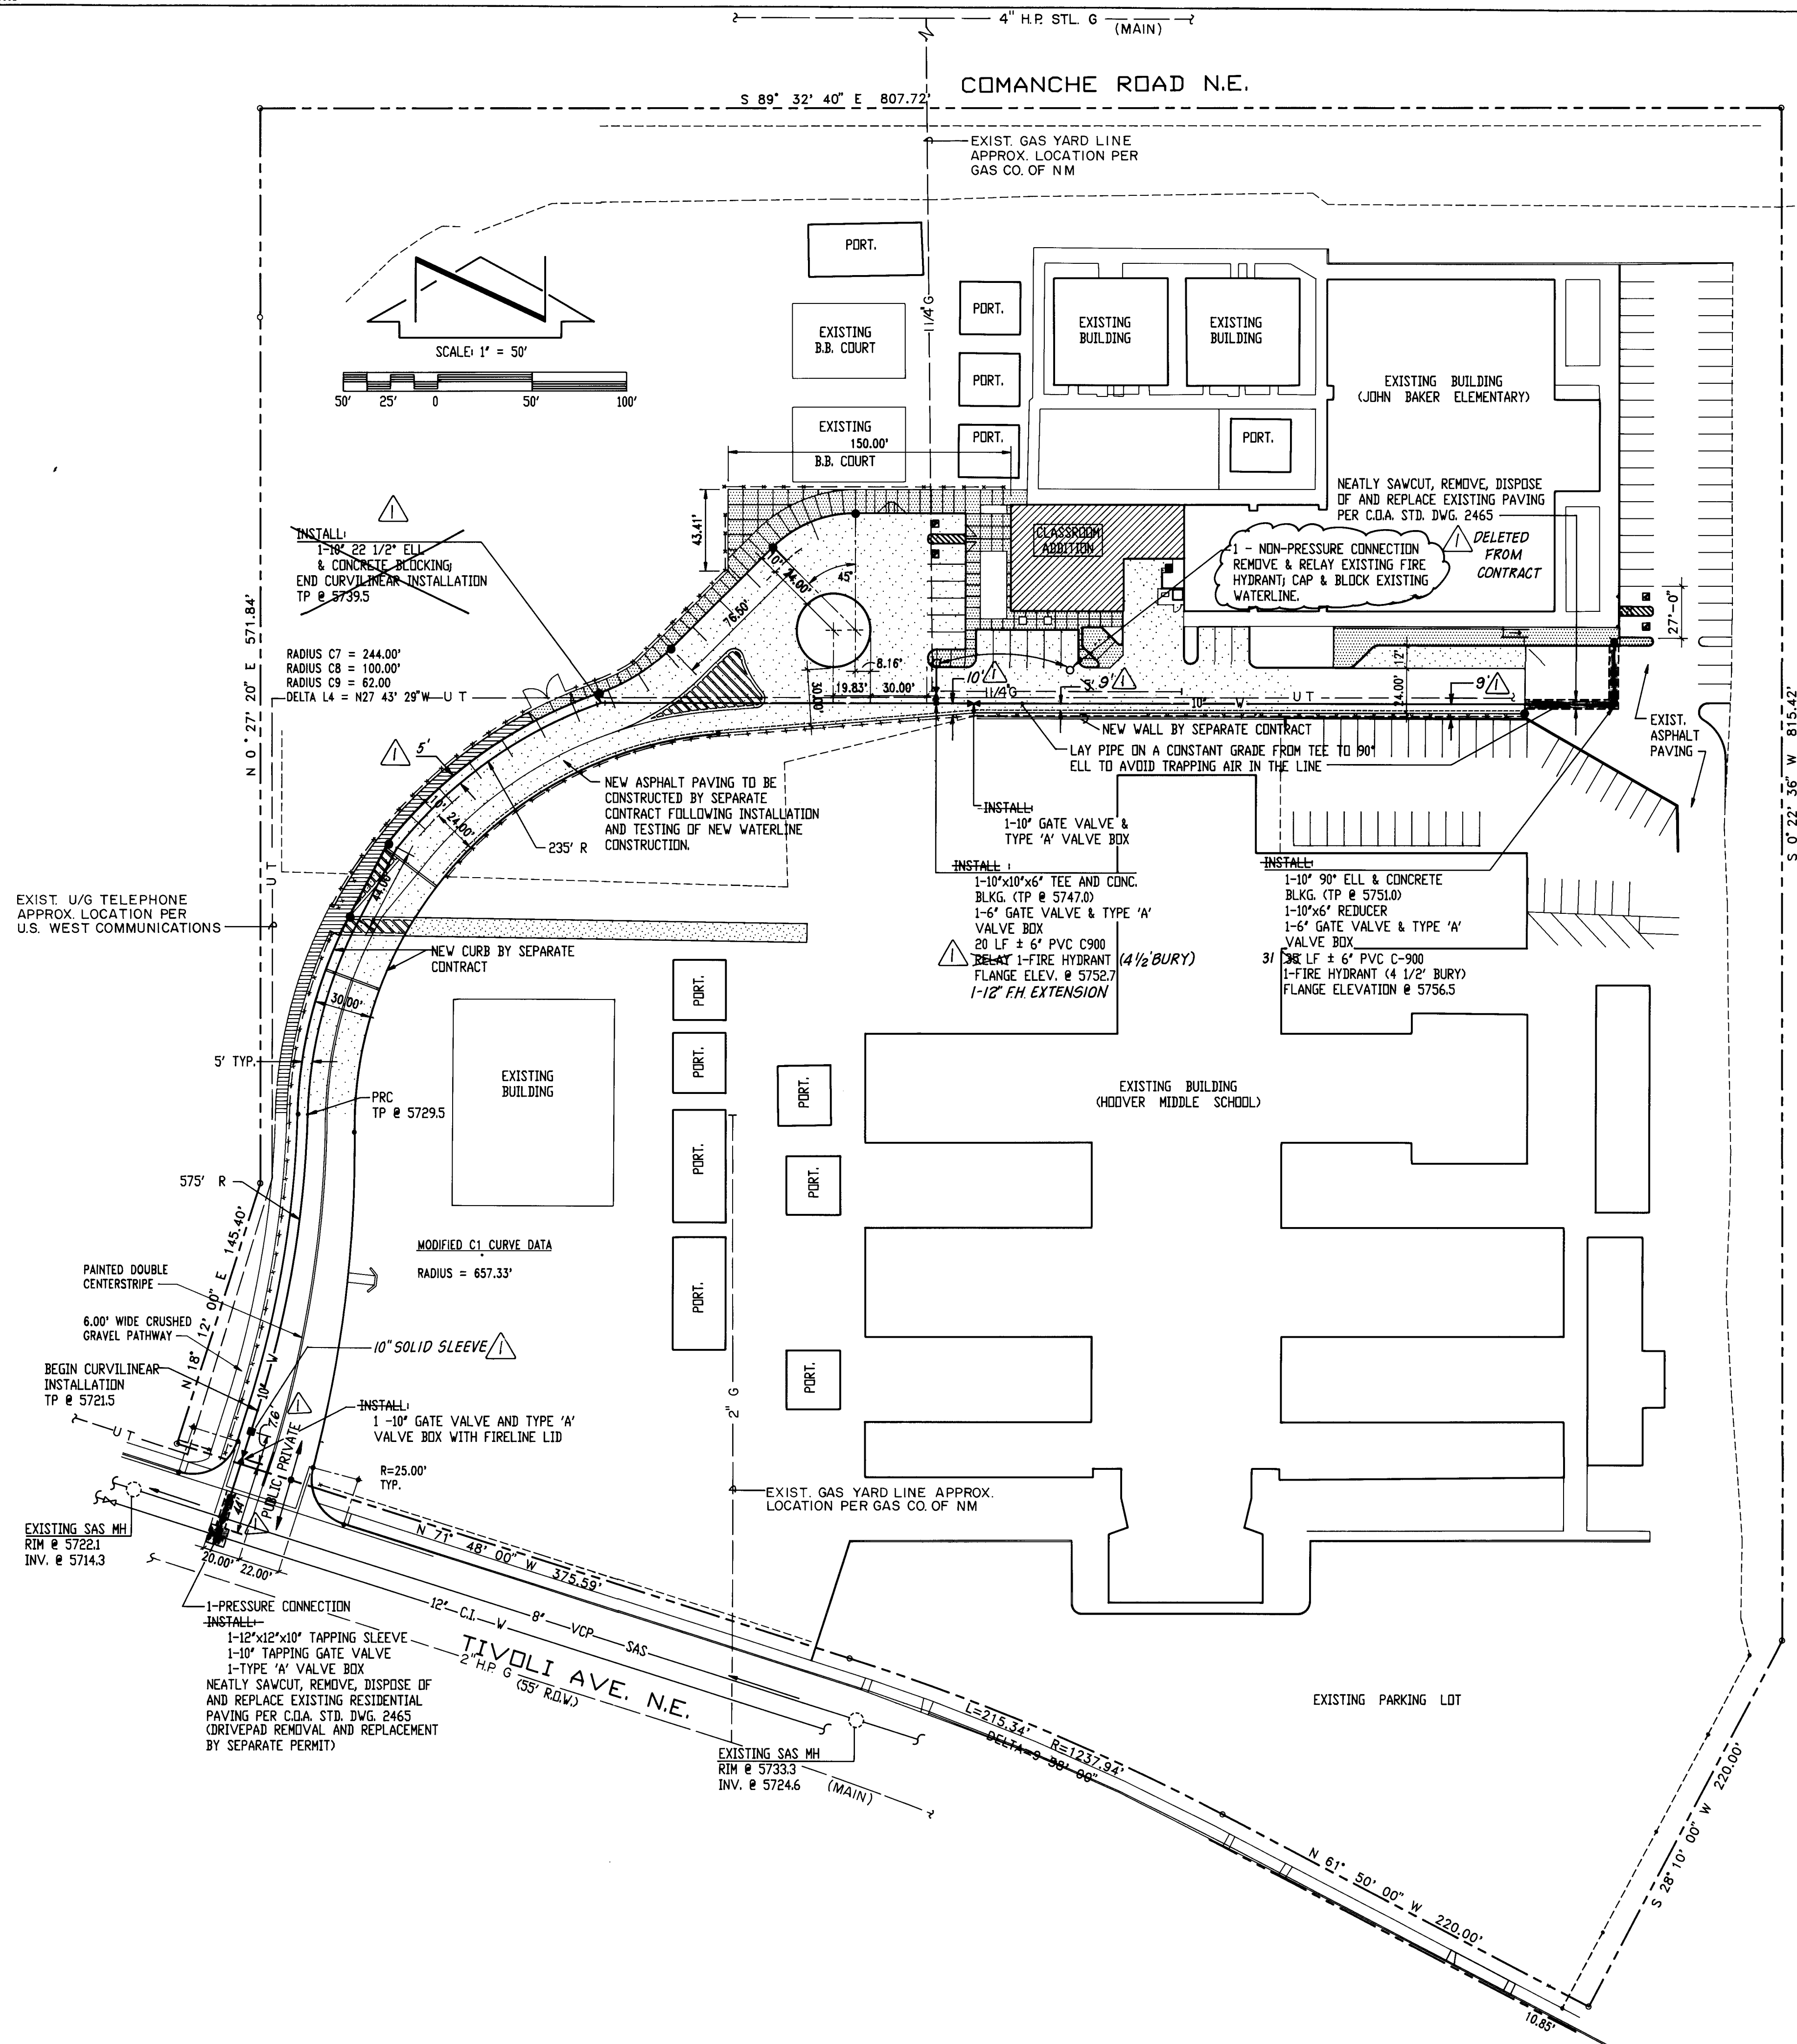


FIRELINE VALVE BOX LID

NO SCALE

NOTES:

- THE INSTALLATION OF THE PRIVATE FIRELINE INSIDE THE SCHOOL SITE REQUIRES INSPECTION BY MECHANICAL SECTION, CODE ADMINISTRATION (764-1636). THE CONTRACTOR SHALL COORDINATE ALL INSPECTION AND TESTING OF THE PRIVATE FIRELINE WITH THE MECHANICAL SECTION.
- THE TENTATIVE SCHEDULE FOR THE WORK SPECIFIED HEREON IS AS FOLLOWS:
 - COMMENCE JUNE 10, 1993
 - COMPLETION - JUNE 25, 1993

THIS SCHEDULE SUBJECT TO MODIFICATION AND MUST BE COORDINATED WITH THE BUILDING CONTRACTOR, KCS, INC., 8904 WASHINGTON N.E., ALBUQUERQUE, NM 87113, (505) 821-2428.

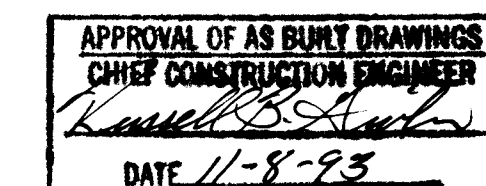

RECORD DRAWING

I, Jeffrey G. Mortensen, Registered Professional Engineer in the State of New Mexico, do hereby certify that this "as-built" information was obtained by me or under my supervision and represents the "as-built" conditions of this project, and is true and correct to the best of my knowledge and belief. All vertical and horizontal dimensions should be field verified prior to future projects.



RECORD DRAWING

26 4612.900193

VICINITY MAP				AS BUILT INFORMATION									
SCALE: 1" = 800' (APPROX.) NOTES: - WATER MAIN SHALL BE PVC C-900 PIPE OR AS APPROVED BY THE CITY OF ALBUQUERQUE CITY ENGINEER. DUCTILE IRON IS AN ACCEPTABLE PIPE MATERIAL IN LIEU OF PVC. - WATER LINE SHALL HAVE A MINIMUM COVER OF 4'0" (TOP OF CURB TO TOP OF PIPE). - ELECTRONIC MARKER DISCS (EMD) SHALL BE INSTALLED IN ACCORDANCE WITH THE STANDARD SPECIFICATION. - IN ACCORDANCE WITH SECTION 801 OF THE STANDARD SPECIFICATIONS, METALLIZED DETECTABLE WARNING TAPE SHALL BE INSTALLED 18" ABOVE ALL PVC PIPE INSTALLED ON THIS PROJECT. - VALVE STEM AND FIRE HYDRANT EXTENSIONS SHALL BE PROVIDED IN ACCORDANCE WITH THE STANDARD SPECIFICATIONS. THE COST OF EACH EXTENSION SHALL BE CONSIDERED INCIDENTAL TO CONSTRUCTION THEREFORE NO SEPARATE PAYMENT WILL BE MADE. - JOINT RESTRAINT SHALL BE CONSIDERED INCIDENTAL TO WATERLINE CONSTRUCTION THEREFORE NO SEPARATE PAYMENT WILL BE MADE. - PRIVATE WATERLINE CONNECTIONS MUST BE COORDINATED WITH MR. KEITH RUTHERFORD, PLUMBING, MAINTENANCE AND OPERATIONS, ALBUQUERQUE PUBLIC SCHOOLS (765-5950). A MINIMUM OF 48 HOURS PRIOR TO RELOCATION OF EXISTING FIRE HYDRANT. - FIRE HYDRANTS SHALL BE INSTALLED IN ACCORDANCE WITH C.O.A. STANDARD DWG. 2340. - ALL WORK MUST BE CLOSELY COORDINATED WITH THE GENERAL CONTRACTOR FOR THE CLASSROOM ADDITION FOR EFFICIENT AND EXPEDITIOUS COMPLETION OF BOTH PROJECTS. ALL COORDINATION AND SCHEDULING SHALL BE CONSIDERED INCIDENTAL TO CONSTRUCTION THEREFORE NO SEPARATE PAYMENT WILL BE MADE. - THREE (3) WORKING DAYS PRIOR TO BEGINNING CONSTRUCTION THE CONTRACTOR SHALL SUBMIT TO THE CONSTRUCTION COORDINATION DIVISION A DETAILED CONSTRUCTION SCHEDULE. TWO (2) WORKING DAYS PRIOR TO CONSTRUCTION THE CONTRACTOR SHALL OBTAIN A BARRICADE PERMIT FROM THE CONSTRUCTION COORDINATION DIVISION. CONTRACTOR SHALL NOTIFY BARRICADE ENGINEER (768-2551) PRIOR TO OCCUPYING AN INTERSECTION. CONTRACTOR MUST REFER TO SECTION 19 OF THE STANDARD SPECIFICATION FOR TRAFFIC CONTROL. - ALL STREET STRIPING ALTERED OR DESTROYED SHALL BE REPLACED IN KIND BY CONTRACTOR TO LOCATION AND IN KIND AS EXISTING OR AS INDICATED BY THIS PLAN SET. - CAUTION: THESE DRAWINGS DO NOT INCLUDE NECESSARY COMPONENTS FOR CONSTRUCTION SAFETY WHICH SHALL REMAIN THE RESPONSIBILITY OF THE CONTRACTOR.				CONTRACTOR CARA, INC. WORKED BY J.M.A. DATE 08/93 INSPECTED BY G.M. DATE 08/93 ACCEPTANCE BY G.M. DATE 08/93 VERIFICATION BY G.M. DATE 08/93 DRAWING BY G.M. DATE 08/93 RECORDED BY NO DATE									
STATION IS A STANDARD AS-BUILT TABLET STAMPED "1-622" SET IN TOP OF A CONCRETE POST FLUSH WITH THE GROUND. STATION IS LOCATED ON THE SOUTH SIDE OF COMANCHE ROAD N.E. ABOUT 150 FEET EAST OF THE JUNCTION WITH CHELWOOD. ELEVATION = 5750.35 FEET (M.S.L.D.)				ENGINEER'S SEAL JEFFREY G. MORTENSEN, REGISTERED PROFESSIONAL ENGINEER, NEW MEXICO, LICENSE NO. 8547, DATE 07-16-93									
DESIGNED BY J.G.M. DATE 01-1993 DRAWN BY ACAD DATE 01-1993 CHECKED BY J.G.M. DATE 01-1993				REVISIONS <table border="1"> <thead> <tr> <th>NO.</th> <th>DATE</th> <th>REMARKS</th> </tr> </thead> <tbody> <tr> <td> </td> <td> </td> <td> </td> </tr> </tbody> </table>				NO.	DATE	REMARKS			
NO.	DATE	REMARKS											
APPROVED FOR CONSTRUCTION CITY ENGINEER DATE				AS-BUILT & CERTIFY 09/93									
CITY OF ALBUQUERQUE PUBLIC WORKS DEPARTMENT ENGINEERING GROUP													
TITLE: JOHN BAKER ELEMENTARY SCHOOL PRIVATE FIRELINE IMPROVEMENTS													
APPROVALS		ENGINEER		DATE		APPROVALS							
DRG CHAIRMAN		3-2-93		WATER		R.W. Kane 2-11-93							
TRANSPORTATION		2-11-93		WASTE WATER		R.W. Kane 2-11-93							
HYDROLOGY		2-1-93		CODE ADMIN.		2-1-93							
PROJECT NO.		4612.90		MAP NO.		G-22							
SHEET		IB		OF		I							