


CITY OF ALBUQUERQUE, NEW MEXICO
PUBLIC WORKS DEPARTMENT

CONSTRUCTION PLANS
FOR

TINNIN SHOPPING CENTER ACCESS IMPROVEMENTS

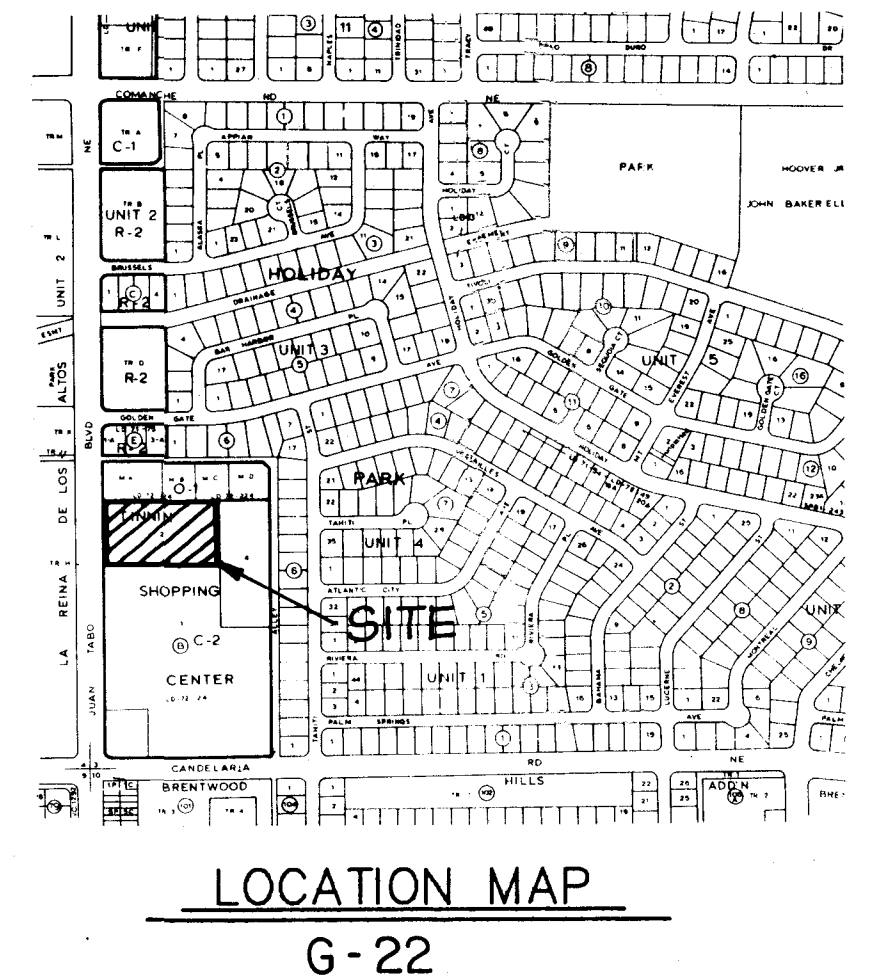

NOTES

ALL WORK DETAILED ON THESE PLANS TO BE PERFORMED UNDER CONTRACT SHALL, EXCEPT AS OTHERWISE STATED OR PROVIDED FOR HEREON, BE CONSTRUCTED IN ACCORDANCE WITH THE C.O.A. STANDARD SPECIFICATIONS FOR PUBLIC WORKS CONSTRUCTION, 1986 EDITION (REFERRED HEREIN AS THE STANDARD SPECIFICATIONS).

TWO (2) WORKING DAYS PRIOR TO ANY EXCAVATION, CONTRACTOR MUST CONTACT LINE LOCATING SERVICE, 260-1990, FOR LOCATION OF EXISTING UTILITIES.

PRIOR TO CONSTRUCTION, THE CONTRACTOR SHALL EXCAVATE AND VERIFY THE HORIZONTAL AND VERTICAL LOCATIONS OF ALL OBSTRUCTIONS. SHOULD A CONFLICT EXIST, THE CONTRACTOR SHALL NOTIFY THE ENGINEER OR SURVEYOR SO THAT THE CONFLICT CAN BE RESOLVED WITH MINIMUM AMOUNT OF DELAY.

IT WILL BE AT THE CONTRACTOR'S COST AND RESPONSIBILITY TO COORDINATE WITH PNM THE SUPPORT OF EXISTING POWER POLES AND GUY WIRES DURING THE PROPOSED TRENCHING AND INSTALLATION. OTHER METHODS CAN BE UTILIZED TO SUPPORT THE POWER POLES AND GUY WIRES BUT MUST BE APPROVED BY PNM.

INDEX





<u>SHEET NO.</u>	<u>DESCRIPTION</u>
1	TITLE SHEET
2	DECELERATION LANE

1 2 3 4 5 6 7 8 9 10 11 12 13 14 15
26 4616.90 0193

APPROVAL OF AS BUILT DRAWINGS
CHIEF CONSTRUCTION ENGINEER
Richard B. Rola
DATE 7-9-93

SCANNED BY
BY LASON

REV	SHEETS	CITY ENGINEER	DATE	USER	DEPT.	DATE	USER	DEPT.
		<i>Richard B. Rola</i>	5/6/93					
				WILSON & COMPANY 6611 GULTON CT ALBUQUERQUE, NEW MEXICO 87109 (505) 345-5345		APPROVED FOR CONSTRUCTION <i>Richard B. Rola</i> 5/6/93 SHEET NO. 1 OF 2		
				PROJECT No. 4616.90				

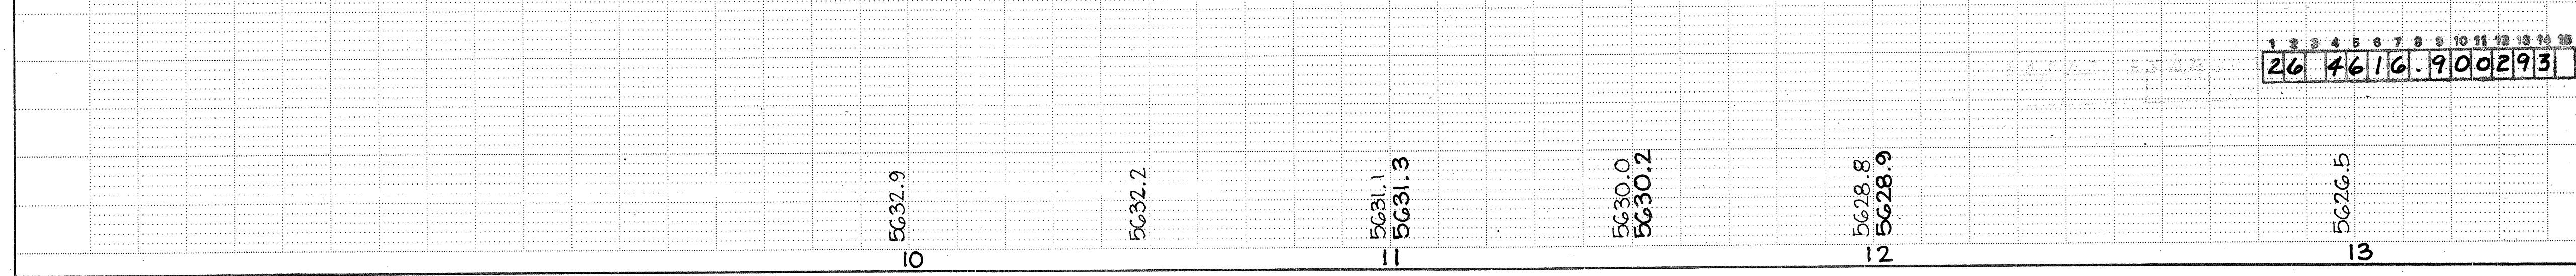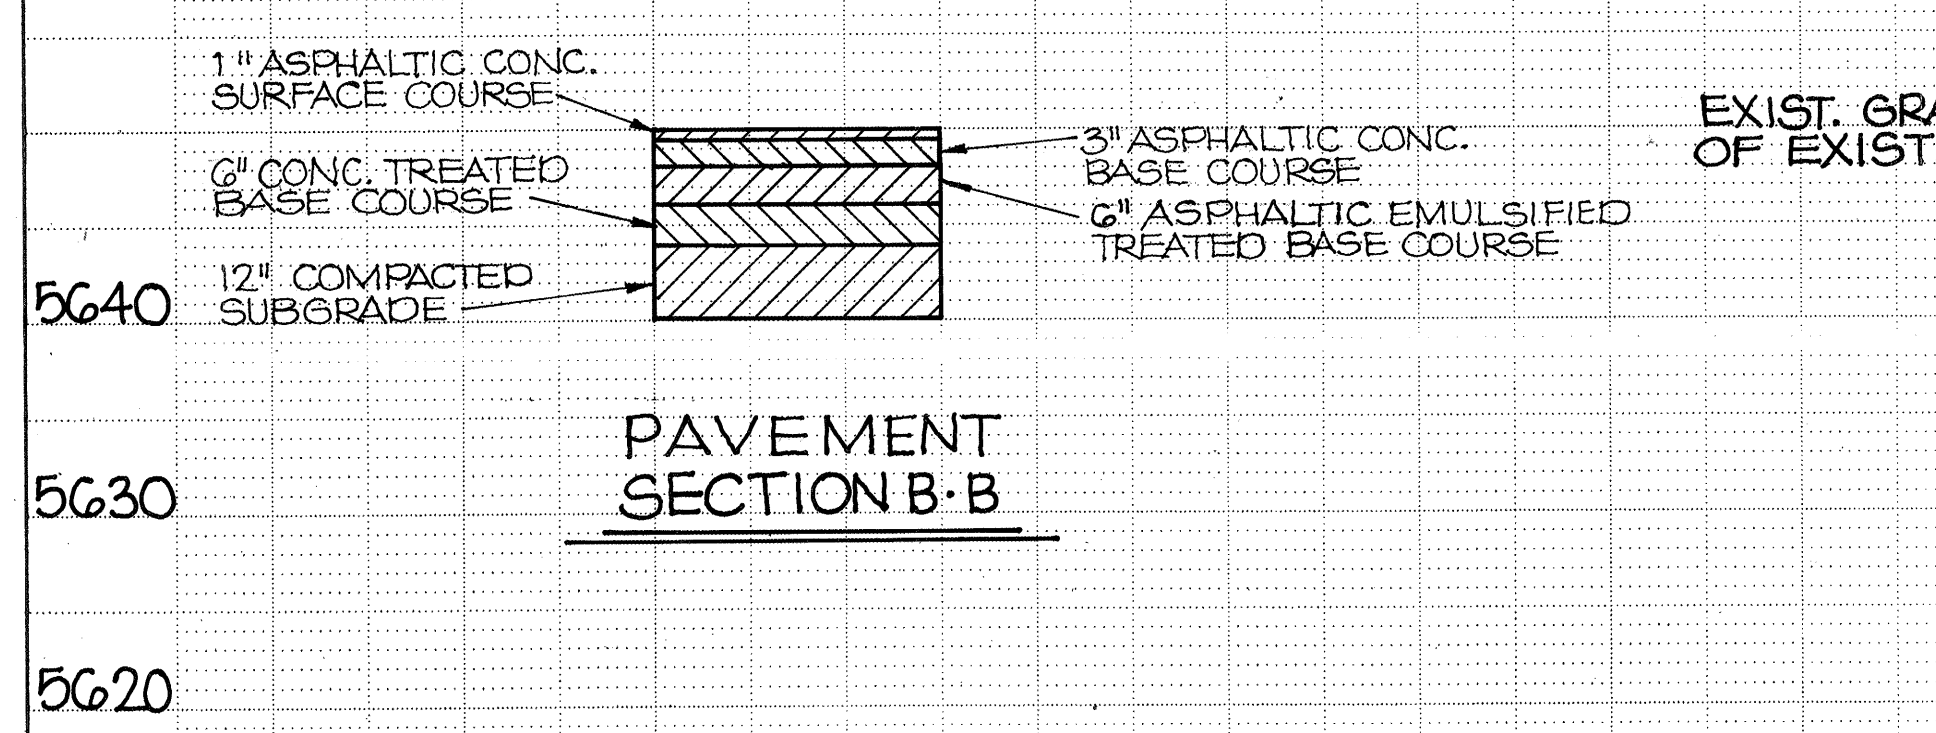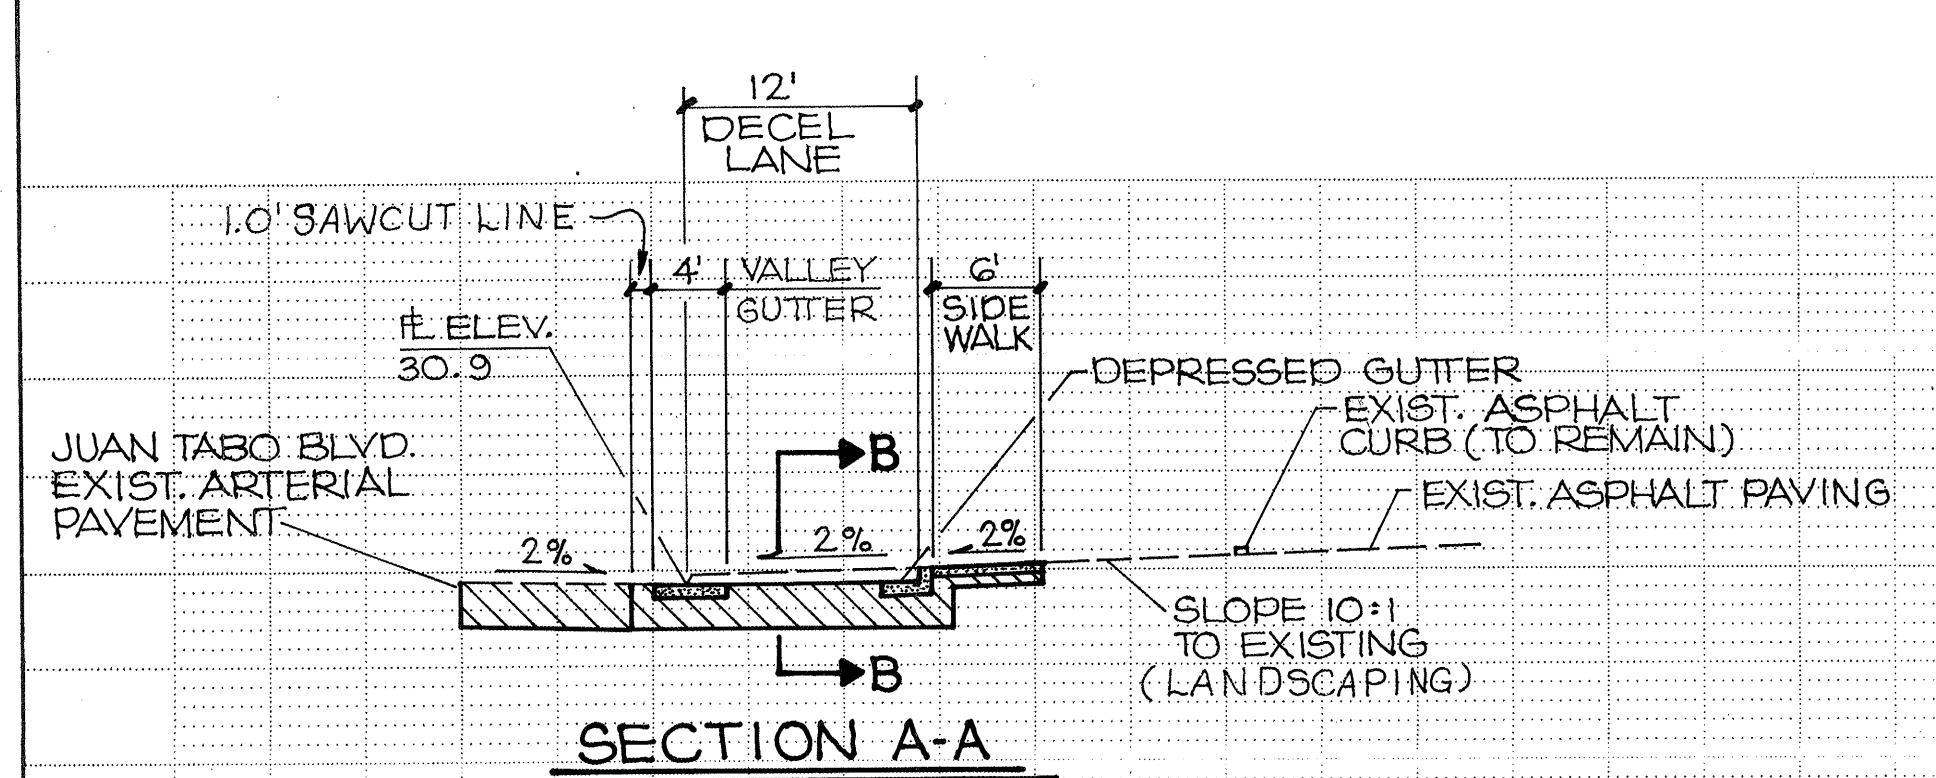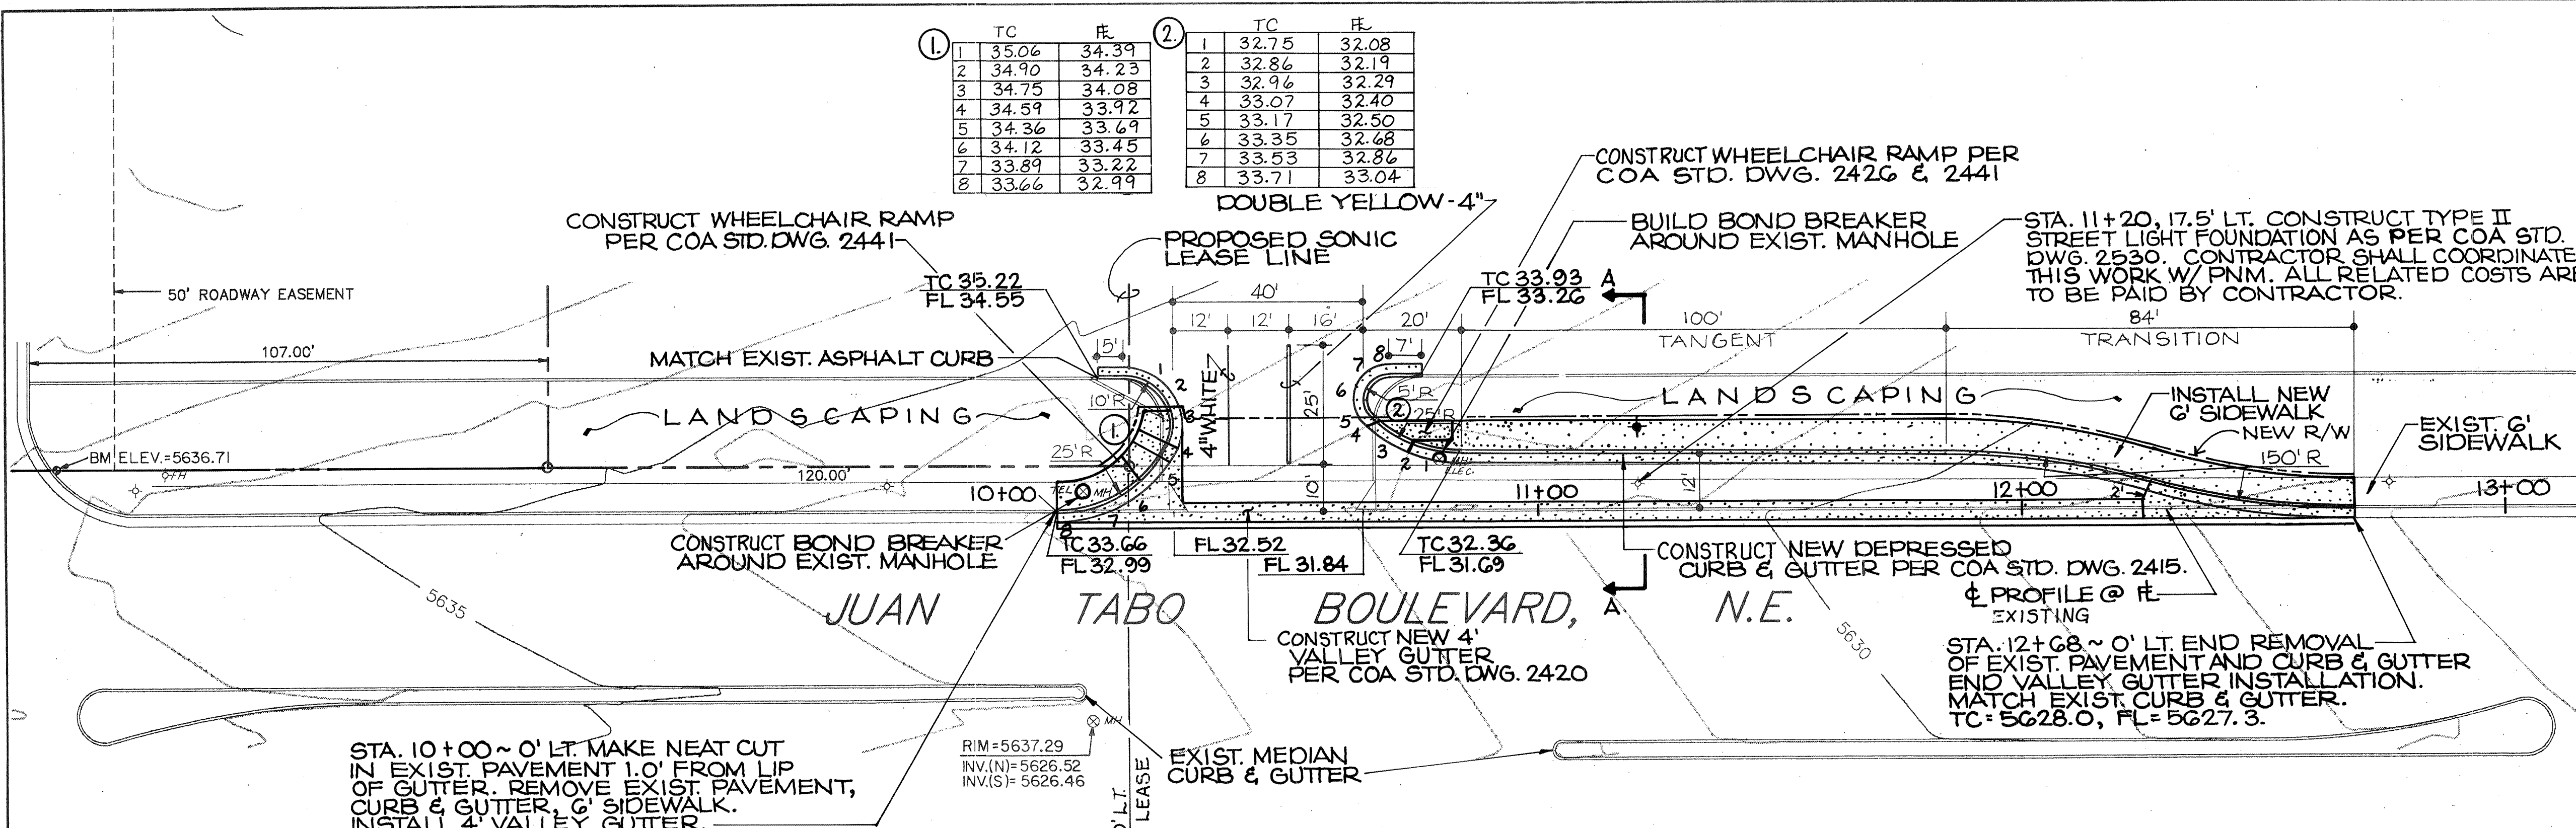

①	TC	FL	②	TC	FL
1	35.06	34.39	1	32.75	32.08
2	34.90	34.23	2	32.86	32.19
3	34.75	34.08	3	32.96	32.29
4	34.59	33.92	4	33.07	32.40
5	34.36	33.69	5	33.17	32.50
6	34.12	33.45	6	33.35	32.68
7	33.89	33.22	7	33.53	32.86
8	33.66	32.99	8	33.71	33.04

LEGEND	
✦	LIGHT POLE
✦ FH	FIRE HYDRANT
⊗ MH	MANHOLE
---	BOUNDARY LINE
==	STANDARD CONCRETE CURB & GUTTER
---	ASPHALT CURB & GUTTER
---	PROPOSED CONCRETE

NOTES

ALL WORK DETAILED ON THESE PLANS TO BE PERFORMED UNDER CONTRACT SHALL, EXCEPT AS OTHERWISE STATED OR PROVIDED FOR HEREON, BE CONSTRUCTED IN ACCORDANCE WITH THE COA STANDARD SPECIFICATIONS FOR PUBLIC WORKS CONSTRUCTION, 1986 EDITION (REFERRED TO HEREIN AS THE STANDARD SPECIFICATIONS).

TWO (2) WORKING DAYS PRIOR TO ANY EXCAVATION, CONTRACTOR MUST CONTACT LINE LOCATING SERVICE, 260-1990, FOR LOCATION OF EXISTING UTILITIES.

PRIOR TO CONSTRUCTION, THE CONTRACTOR SHALL EXCAVATE AND VERIFY THE HORIZONTAL AND VERTICAL LOCATIONS OF ALL OBSTRUCTIONS. SHOULD A CONFLICT EXIST, THE CONTRACTOR SHALL NOTIFY THE ENGINEER OR SURVEYOR SO THAT THE CONFLICT CAN BE RESOLVED WITH MINIMUM AMOUNT OF DELAY.

TRAFFIC CONTROL

THREE (3) WORKING DAYS PRIOR TO BEGINNING CONSTRUCTION, THE CONTRACTOR SHALL SUBMIT TO THE CONSTRUCTION CO-ORDINATION DIVISION A DETAILED CONSTRUCTION SCHEDULE. TWO (2) WORKING DAYS PRIOR TO CONSTRUCTION, THE CONTRACTOR SHALL OBTAIN A BARRICADING PERMIT. CONTRACTOR SHALL NOTIFY BARRICADE ENGINEER (768-2551) PRIOR TO OCCUPYING AN INTERSECTION. SEE SECTION 19 OF THE SPECIFICATIONS.

ALL STREET STRIPING ALTERED OR DESTROYED SHALL BE REPLACED IN KIND BY CONTRACTOR IN LOCATION AND IN KIND AS EXISTING OR AS INDICATED BY THIS PLAN SET.

AS BUILT INFORMATION	
CONTRACTOR	Surfacing
WORK	DATE
INSPECTOR'S	DATE
FIELD	DATE
VERIFICATION BY	DATE
CONTRACTED BY	DATE
MICRO-FILM INFORMATION	
RECORDED BY	DATE
NO.	

BENCH MARKS	
BENCH MARK LOCATED AT THE	DATE
INTERSECTION OF THE SITE	1/93
PRIVATE DRIVE W/ JUAN TABO NE	
(S.E. CORNER)	
ELEV. = 5636.71	

SURVEY INFORMATION	
FIELD NOTES	DATE
BY	1/93
WILSON & CO.	
NO.	

ENGINEER'S SEAL	

REVISIONS	
NO.	DATE
1	1/93
2	1/93
3	1/93

DESIGNED BY	TDS	DATE	1/93
DRAWN BY	RL	DATE	1/93
CHECKED BY	SJM	DATE	1/93

CITY OF ALBUQUERQUE
PUBLIC WORKS DEPARTMENT

**JUAN TABO BLVD.
DECELERATION LANE**

APPROVALS	ENGINEER	DATE	APPROVALS	ENGINEER	DATE
DRC CHAIRMAN	<i>B. G. Goolsby</i>	2-25-93	WATER	NIA RWK	2-18-93
TRANSPORTATION	<i>M. B. B.</i>	1-18-93	WASTE WATER	NIA RWK	2-18-93
HYDROLOGY	<i>Frank J. J.</i>	2-22-93			

PROJECT NO.	4616.90	MAP NO.		SHEET	1	OF	1
-------------	---------	---------	--	-------	---	----	---