




THE ONLY KNOWN U.G. UTILITIES IN THIS EASEMENT ARE
SERVICE LINES OF SEWER, WATER & GAS TO D.U. ON LOT
65A2B6. CHECK WITH OWNER AND UTILITY COMPANIES
PRIOR TO TRENCHING.


NOTE:
LOCATE EXISTING WATER &
SEWER SERVICE LINES FOR
D.U. ON LOT 65A2B6 AND
RE-CONNECT TO THE NEW
SERVICE LOCATIONS.

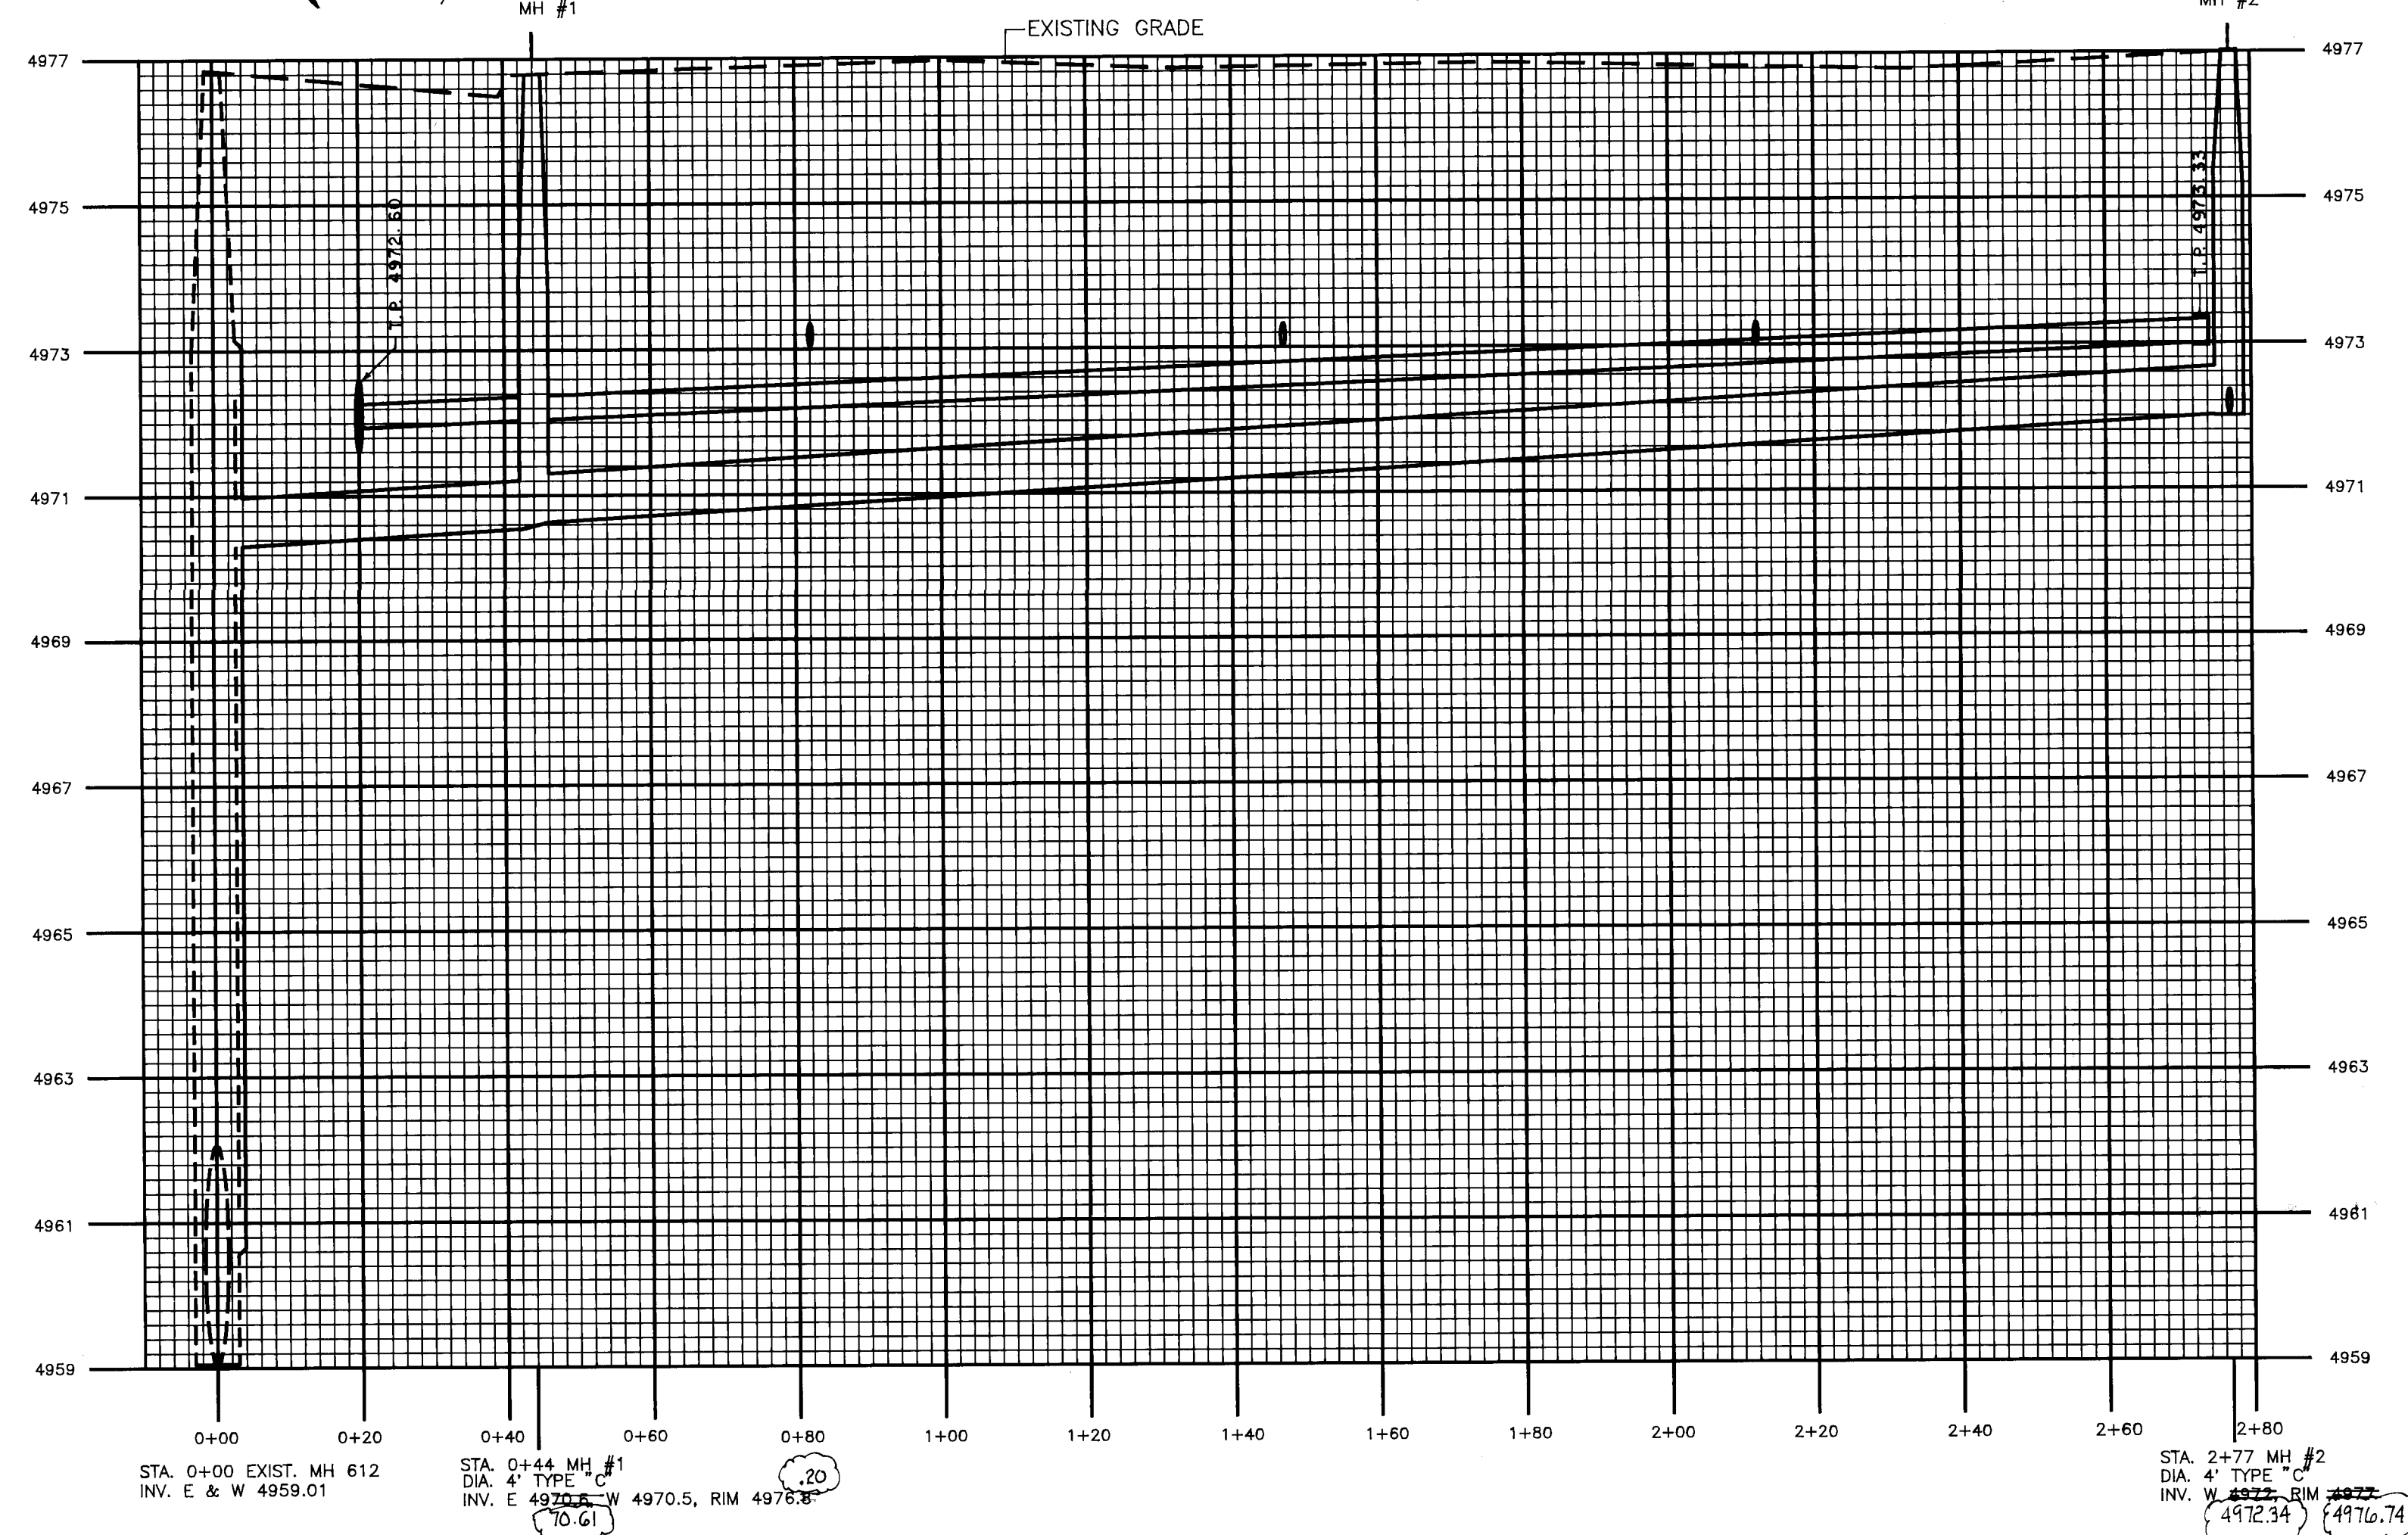

1. ALL WORK DETAILED ON THESE PLANS TO BE PERFORMED UNDER CONTRACT SHALL, EXCEPT AS OTHERWISE STATED OR PROVIDED FOR HEREON, BE CONSTRUCTED IN ACCORDANCE WITH THE NEW MEXICO STANDARD SPECIFICATIONS FOR PUBLIC WORKS CONSTRUCTION - 1986 EDITION (REFERRED TO HEREIN AS THE STANDARD SPECIFICATIONS) AS AMENDED/UPDATED # 4.
2. TWO (2) WORKING DAYS PRIOR TO ANY EXCAVATION, THE CONTRACTOR MUST CONTACT "NEW MEXICO ONE CALL SYSTEM", 260-1990, FOR LOCATION OF UTILITIES.
3. PRIOR TO CONSTRUCTION THE CONTRACTOR SHALL EXCAVATE AND VERIFY THE HORIZONTAL AND VERTICAL LOCATIONS OF ALL OBSTRUCTIONS. SHOULD A CONFLICT EXIST, THE CONTRACTOR SHALL NOTIFY THE ENGINEER OR SURVEYOR SO THAT THE CONFLICT CAN BE RESOLVED WITH MINIMUM AMOUNT OF DELAY.
4. ALL UTILITIES AND UTILITY SERVICE LINES SHALL BE INSTALLED PRIOR TO PAVING.
5. CONTACT WATER SYSTEMS DIVISION (857-8238) 3 WORKING DAYS PRIOR TO NEEDING VALVES SHUT OFF OR TURNED ON. ONLY WATER SYSTEM PERSONNEL ARE TO OPERATE VALVES.
6. THREE (3) WORKING DAYS PRIOR TO BEGINNING CONSTRUCTION THE CONTRACTOR SHALL SUBMIT TO THE CONSTRUCTION CO-ORDINATION DIVISION A DETAILED CONSTRUCTION SCHEDULE. TWO (2) WORKING DAYS PRIOR TO CONSTRUCTION THE CONTRACTOR SHALL OBTAIN A BARRICADING PERMIT FROM THE CONSTRUCTION CO-ORDINATION DIVISION. THE CONTRACTOR SHALL NOTIFY BARRICADE ENGINEER (768-2551) PRIOR TO OCCUPYING AN INTERSECTION. SEE SECTION 19 OF THE SPECIFICATIONS.

ALL STREET STRIPING ALTERED OR DESTROYED SHALL BE REPLACED IN KIND BY CONTRACTOR TO LOCATION AND IN KIND AS EXISTING OR AS INDICATED BY THIS PLAN SET.

ENGINEER'S SEAL		SURVEY INFORMATION		BENCH MARKS		AS BUILT INFORMATION	
					13-E 14 S.W. QUAD. OF SOLAR RD. & 4TH ST., N.W.		CONTRACTOR TLC Company, Inc.
					ACS 1 3/4" ALUM. CAP STAMPED "ACS BM 13-E 14"		STAMPED BY C.O.A. DATE 10/19/94
					TOP OF CONCRETE BASE OF TRAFFIC LIGHT STANCHION		INSPECTOR'S FIELD DANCE BY M.S. DATE 10/19/94
					EL. 4879.32		VERIFICATION BY C.O.A. DATE 10/19/94
							DRAWINGS CHECKED BY DATE
							MICRO-FILM INFORMATION
							RECORDED BY DATE
							NO.

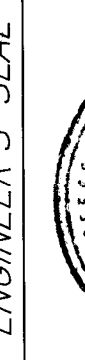

REGISTERED PROFESSIONAL ENGINEER
STATE OF NEW MEXICO
NO. 2934
J. C. CARROLL, INC.

DESIGNED BY C. A. C.

DRAWN BY L. S. C.

DATE 8/15/93

DATE 4/15/93

C. J. 3/13/93

1	2	3	4	5	6	7	8	9	10	11	12	13	14
26		4	6	4	3		9	0	0	1	9	4	

APPROVAL OF AS BUILT DRAWINGS
CHIEF CONSTRUCTION ENGINEER
[Signature]
DATE 11-2-94

**APPROVED FOR
CONSTRUCTION**
Robert B. Ryja 6/29/94
CITY ENGINEER DATE

CITY OF ALBUQUERQUE
MUNICIPAL DEVELOPMENT DEPARTMENT
ENGINEERING DIVISION

TITLE:
WATER & SEWER SERVICE LANDS OF RAMBOW

APPROVALS	ENGINEER	DATE	APPROVALS	ENGINEER	DATE
D.R.C. Chairman	<i>D.R.C. Chairman</i>	5-20-93	WATER	<i>R.W. Kane</i>	5-3-9
Transportation	<i>R.W. Kane</i>	5-3-9	WASTE WATER	<i>R.W. Kane</i>	5-3-9
Hydrology	<i>B.M. Kane</i>	5/2/93			

DRAWING NO. 4643.90	MAP NO. E-14	SHEET 1 OF 1
------------------------	-----------------	--------------