




1. CONTRACTOR SHALL CONTACT THE PROPERTY OWNER REGARDING THE EXISTING LANDSCAPING IRRIGATION SYSTEM AND PROVIDE ANY RELOCATION OF SPRINKLER LINES AND SPRINKLER HEADS REQUIRED FOR CONSTRUCTION.
2. CONTRACTOR SHALL REMOVE AND REPLACE GRASS SOD ON WEST AND SOUTHWEST SIDE OF NEW DEFLECTION WALL AS REQUIRED FOR CONSTRUCTION.
3. PAVEMENT REPLACEMENT SHALL CONSIST OF 6" SUBGRADE PREPARATION (95% COMPACTION), 4" SUBBASE (95% COMPACTION), 4" ASPHALT BASE COURSE (1800# STABILITY), AND 1" ASPHALT CONCRETE SURFACE COURSE (1800# STABILITY).
4. ALL WORK DETAILED ON THIS PLAN TO BE PERFORMED UNDER CONTRACT SHALL, UNLESS OTHERWISE STATED OR PROVIDED FOR HEREON, BE CONSTRUCTED IN ACCORDANCE WITH THE CITY OF ALBUQUERQUE STANDARD SPECIFICATIONS FOR PUBLIC WORKS CONSTRUCTION 1986 AS AMENDED WITH UPDATE NO. 4.

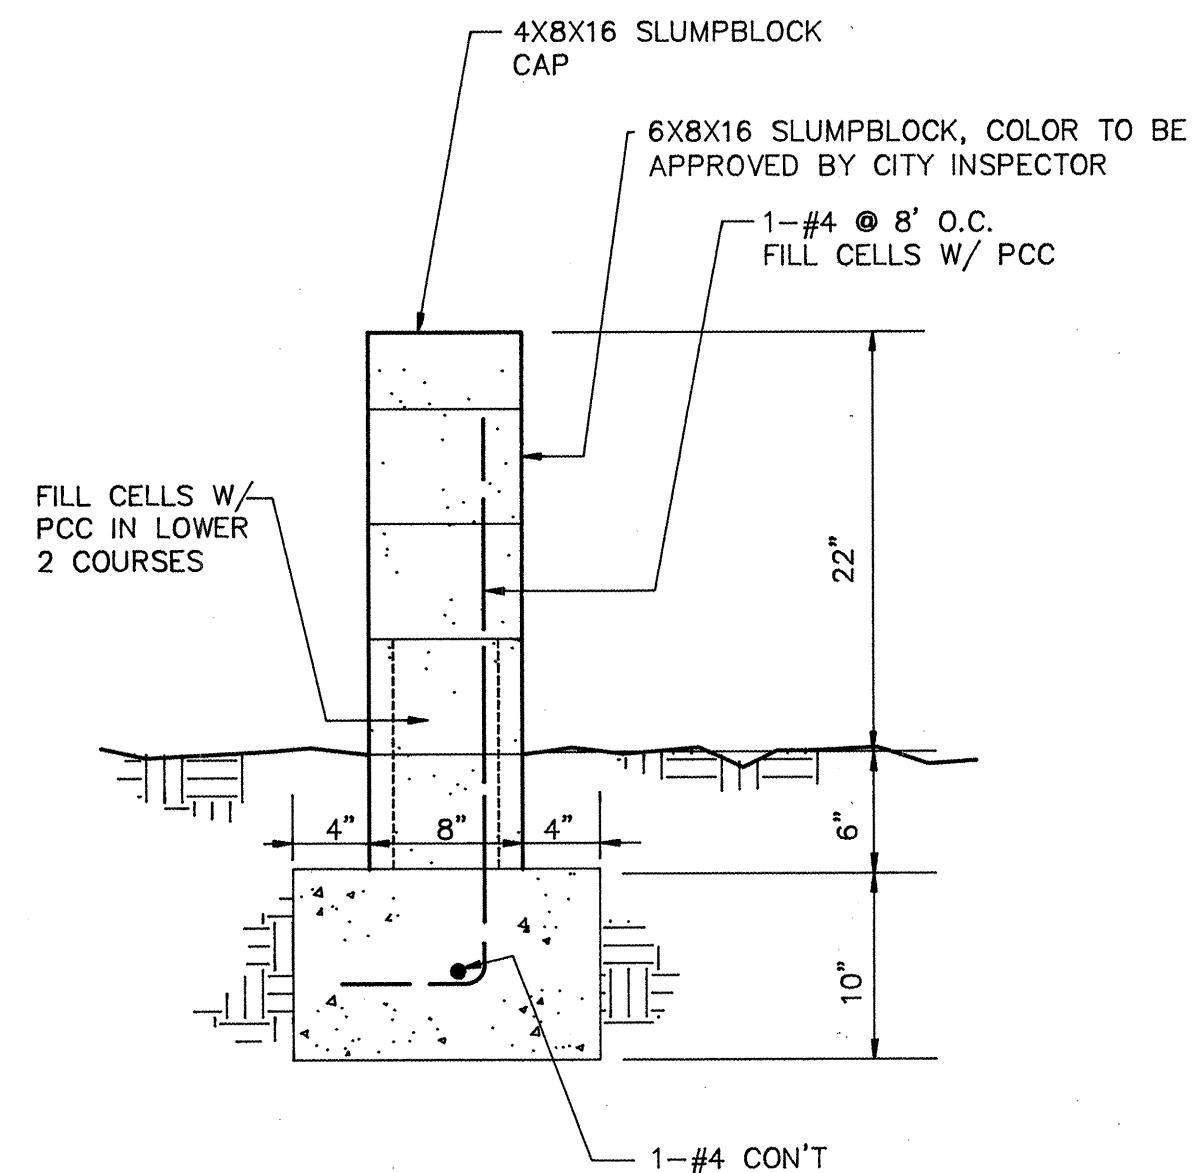


SCALE: 1"=1'-0"

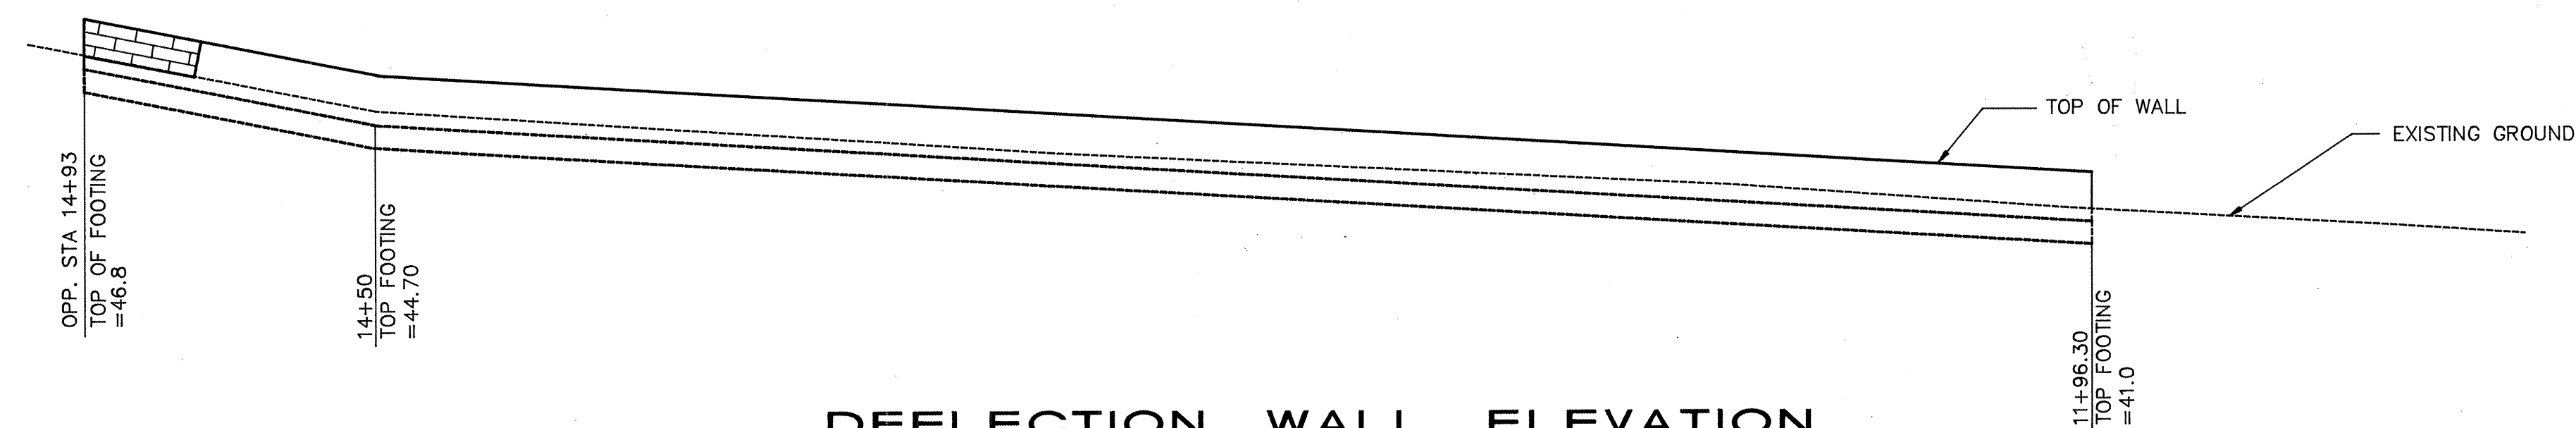

SCALES: 1"=20' HORIZ.
1"=5' VERT.

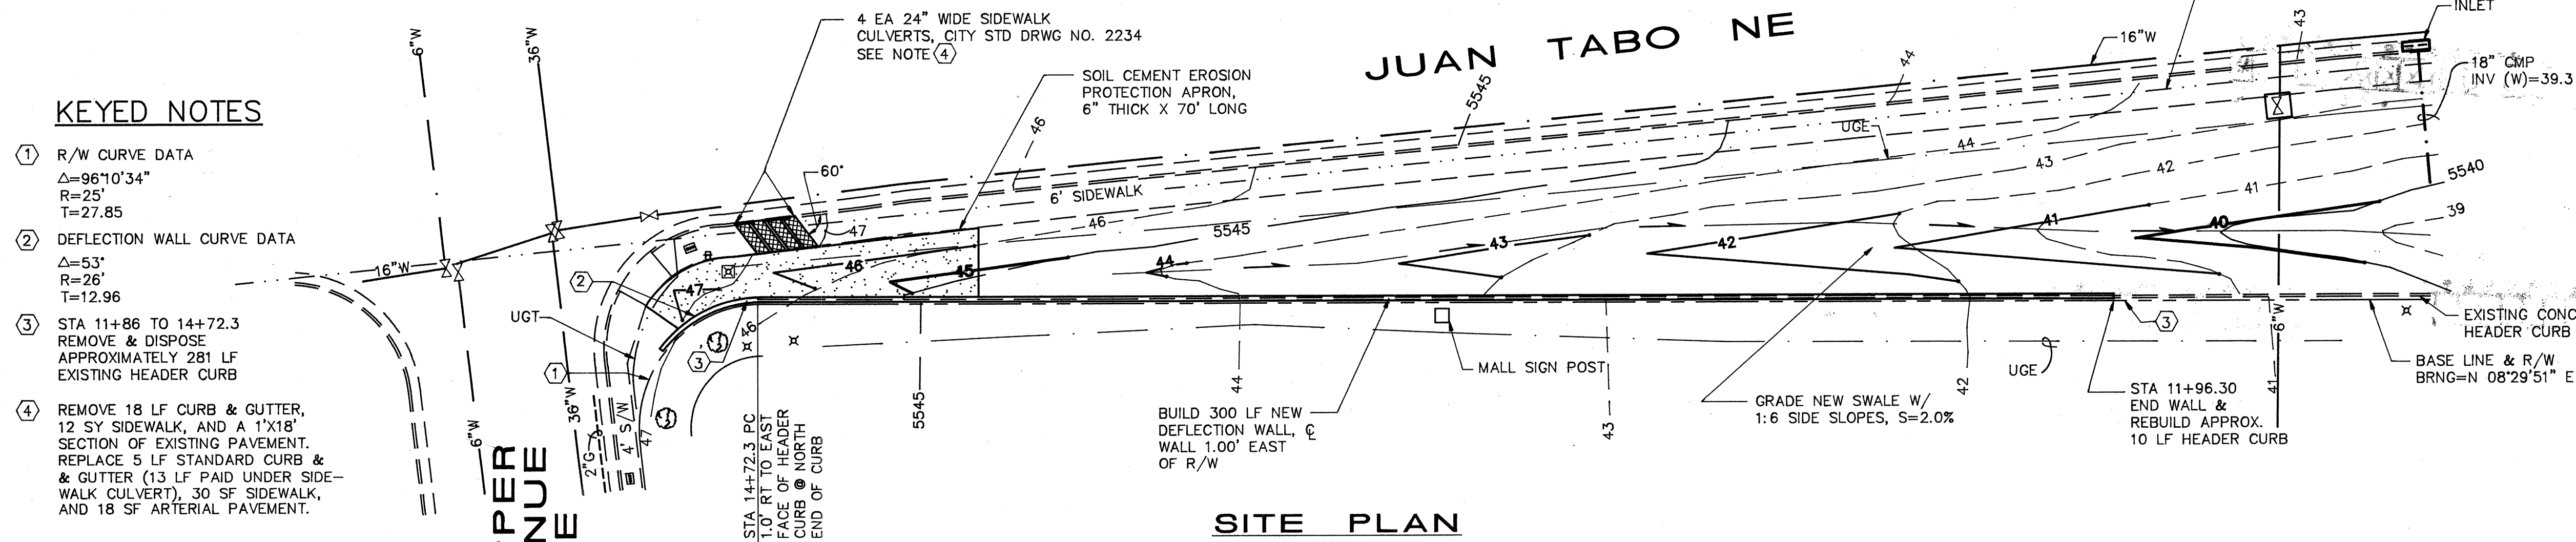

SCALE: 1"=20'

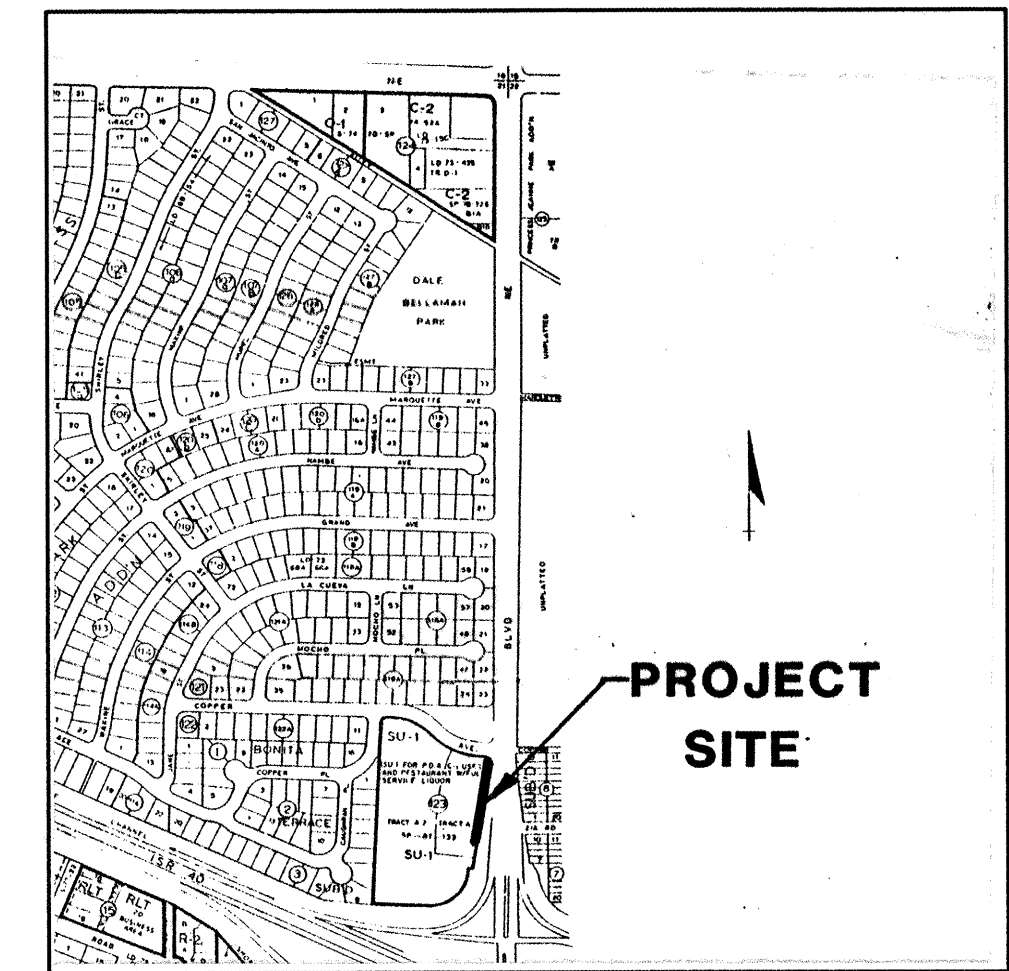

K-21-Z

VICINITY MAP

$$1'' = 750' \pm$$

APPROVALS		ENGINEER		DATE	
BY WATER		N/A RWK		6-2-91	
		N/A RWK		6-2-91	
SHEET		1		OF 1	

69113GRD.DWG

5/26/93

CITY OF ALBUQUERQUE
PUBLIC WORKS DEPARTMENT
ENGINEERING GROUP

TITLE: COPPER/JUAN TABO
DRAINAGE DEFLECTION WALL

APPROVALS	ENGINEER	DATE	APPROVALS	ENGINEER	DATE
DRC CHAIRMAN	<i>B. J. Gumbly</i>	6-18-93	WATER	<i>N/A RWK</i>	6-2-93
TRANSPORTATION	<i>Robert</i>	6-10-93	WASTE WATER	<i>N/A RWK</i>	6-2-93
HYDROLOGY	<i>CAM</i>	6-1-93			

PROJECT NO. 4655.90	MAP NO. K-21	SHEET 1 OF 1
-------------------------------	------------------------	----------------------------

APPROVAL OF AS BUILT DRAWINGS
CHIEF CONSTRUCTION ENGINEER
Russell B. Smith
DATE *4-8-97*

APPROVED FOR
CONSTRUCTION
Richard B. Ral
CITY ENGINEER DATE