

CONSTRUCTION PLANS FOR

SUN TERRACE AT PEPPERTREE


DRAINAGE, GRADING, PAVING, AND UTILITY
IMPROVEMENTS

SHEET INDEX

1. TITLE SHEET
2. PLAT
3. OVERALL PAVING PLAN
4. OVERALL UTILITY PLAN
5. GRADING PLAN
6. MIMOSA CT./BALSA CT. - PLAN & PROFILE
7. MIMOSA CT./BALSA CT. - UTILITIES
8. GRADING DETAILS
9. WALL DETAILS


RECORD DRAWING CERTIFICATION

I, Rick Beltramo, a registered professional engineer in the state of New Mexico, having directed the collection of as-built survey information, and having collected construction information from the city inspector, the surveyor and the contractor, do hereby certify that record drawing information shown is true and correct to the best of my knowledge. This certification does not address construction methods, techniques, performance, or compliance to plan specifications.

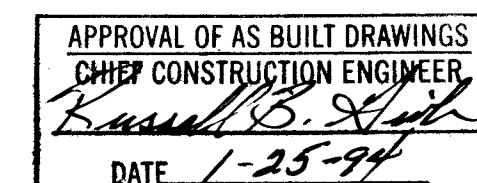

GRADING CERTIFICATION

I, Rick Beltramo, having conducted a site inspection and directed the collection of as-built survey information, certify the site grading and drainage improvements are substantially complete and in accordance with the approved drainage reports and approved construction plans. This certification does not address construction methods, techniques, performance, or compliance to plan specifications.

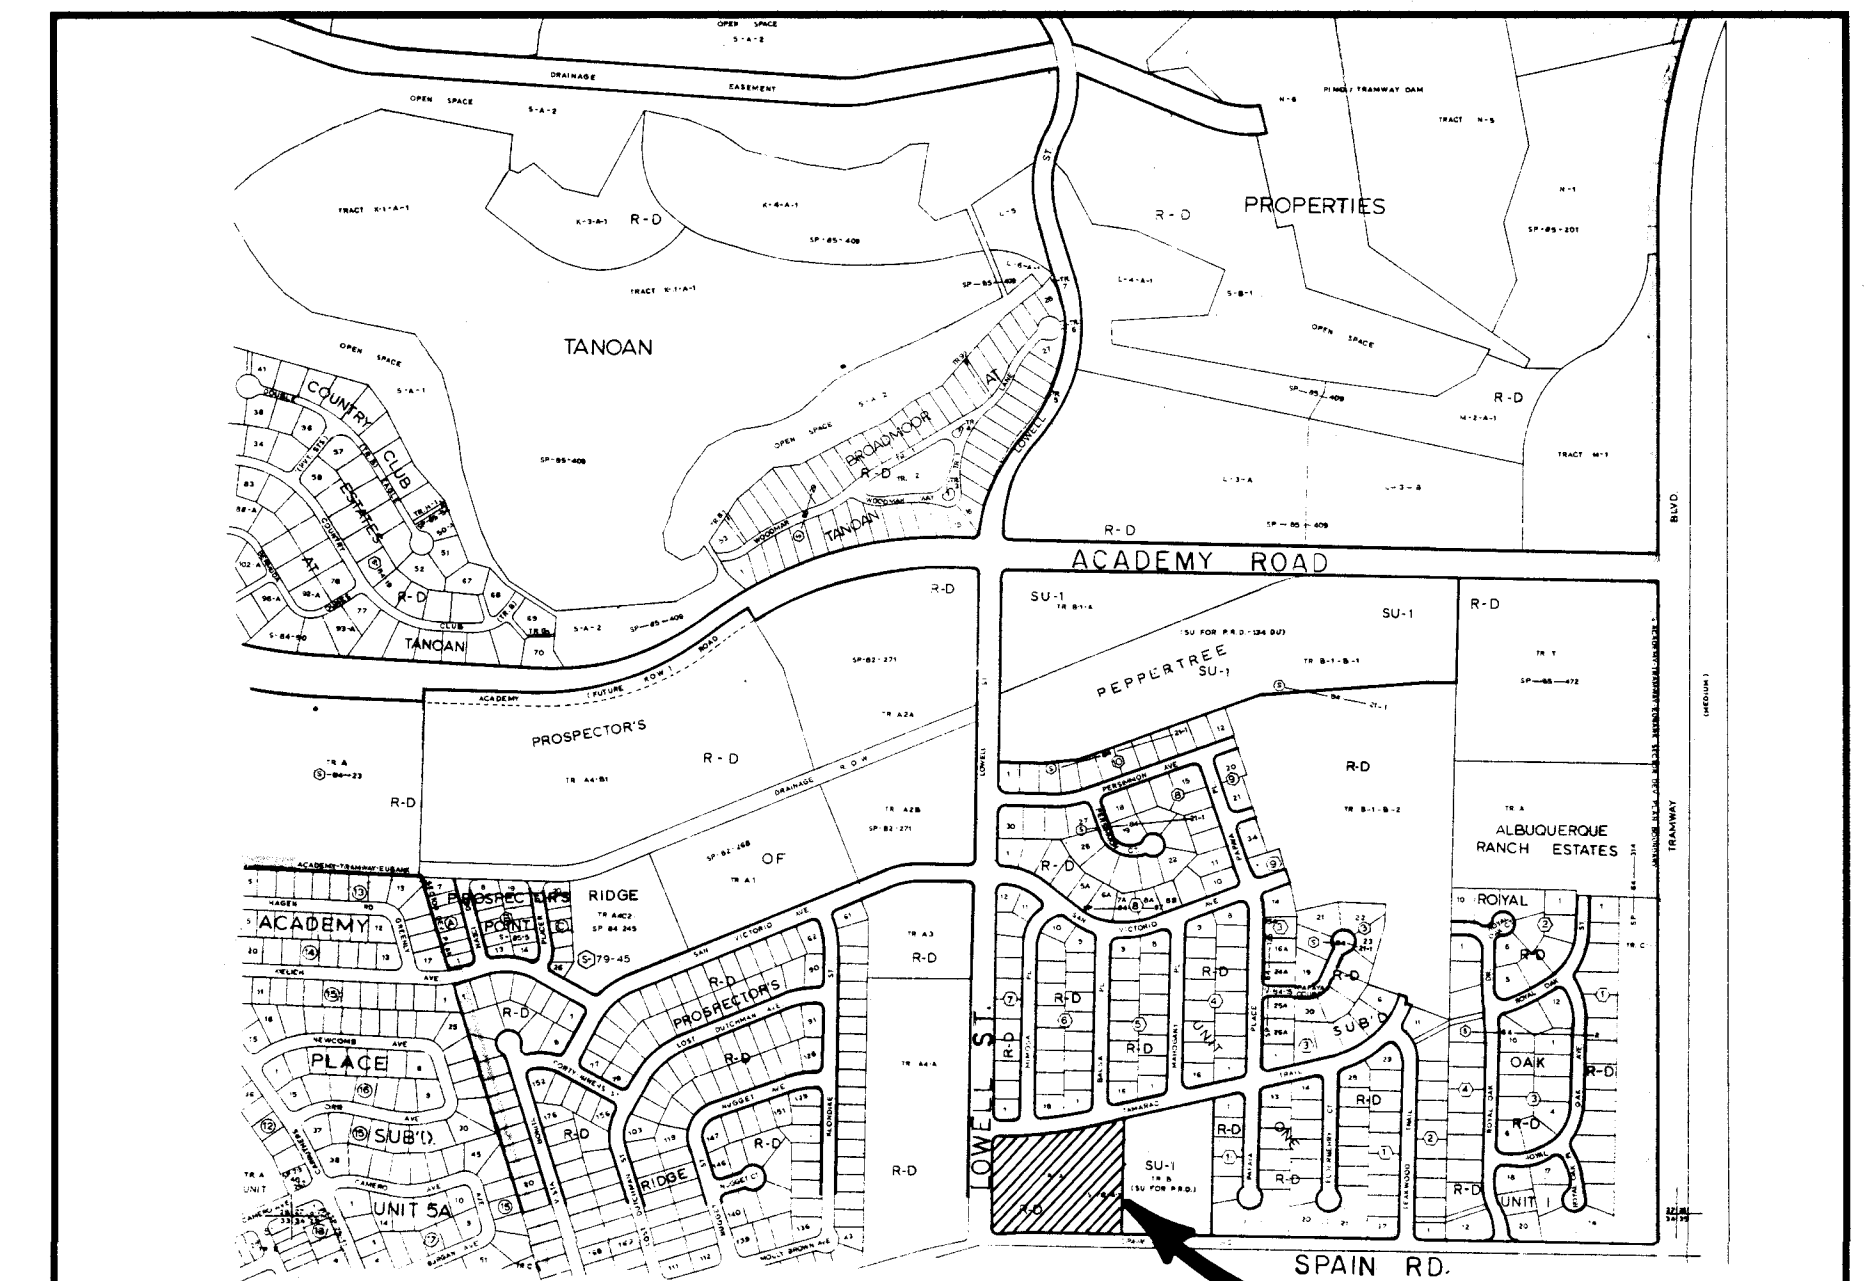

LOCATION MAP
ZONE ATLAS MAP E-22-Z


GENERAL NOTES

1. ALL WORK DETAILED ON THESE PLANS TO BE PERFORMED UNDER CONTRACT, AND UNLESS STATED OTHERWISE OR PROVIDED FOR HEREON, SHALL BE CONSTRUCTED IN ACCORDANCE WITH THE CITY OF ALBUQUERQUE STANDARD SPECIFICATIONS, PUBLIC WORKS CONSTRUCTION, 1986 EDITION NO. 4.
2. TWO WORKING DAYS PRIOR TO ANY EXCAVATION, THE CONTRACTOR MUST CONTACT NEW MEXICO ONE CALL, 260-1990, FOR LOCATION OF EXISTING UTILITIES.
3. PRIOR TO CONSTRUCTION, THE CONTRACTOR SHALL EXCAVATE AND VERIFY THE HORIZONTAL AND VERTICAL LOCATIONS OF EXISTING UTILITIES BEING CONNECTED TO AND ALL POTENTIAL OBSTRUCTIONS. SHOULD A CONFLICT EXIST, THE CONTRACTOR SHALL NOTIFY THE ENGINEER SO THAT THE CONFLICT CAN BE RESOLVED WITH A MINIMUM AMOUNT OF DELAY.
4. ALL WORK ON THIS PROJECT SHALL BE PERFORMED IN ACCORDANCE WITH APPLICABLE FEDERAL, STATE AND LOCAL LAWS, RULES, AND REGULATIONS CONCERNING SAFETY AND HEALTH.
5. CONTRACTOR SHALL MAINTAIN ACCESS TO ADJACENT PROPERTIES DURING CONSTRUCTION.
6. ALL GAS, ELECTRIC, TELEPHONE LINES, CABLES AND APPURTENANCES ENCOUNTERED DURING CONSTRUCTION THAT REQUIRE RELOCATION SHALL BE DONE BY THE RESPONSIBLE UTILITY. THE CONTRACTOR SHALL BE RESPONSIBLE FOR COORDINATION OF ALL NECESSARY UTILITY ADJUSTMENTS.
7. IT SHALL BE THE CONTRACTOR'S RESPONSIBILITY TO PROTECT AND MAINTAIN IN SERVICE ALL EXISTING UTILITIES.
8. THE CONTRACTOR SHALL BE REQUIRED TO CONFINE HIS WORK WITHIN THE CONSTRUCTION LIMITS AND/OR PUBLIC RIGHT-OF-WAY OR EASEMENTS TO PRESERVE EXISTING VEGETATION AND PRIVATE PROPERTY. OVERNIGHT PARKING OF EQUIPMENT AND/OR STORAGE OF MATERIALS IS NOT ALLOWED EXCEPT BY PERMISSION OF PROPERTY OWNER. RESTORATION OF PRIVATE IMPROVEMENTS WILL BE AT THE CONTRACTOR'S EXPENSE.
9. A DISPOSAL SITE FOR ALL EXCESS EXCAVATION MATERIAL, ASPHALTIC PAVING, CONCRETE CURBS AND SIDEWALKS, ETC. SHALL BE OBTAINED BY THE CONTRACTOR IN COMPLIANCE WITH APPLICABLE ENVIRONMENTAL REGULATIONS AND APPROVED BY THE FIELD ENGINEER. ALL COSTS INCURRED IN OBTAINING A DISPOSAL SITE AND HAUL THERE TO SHALL BE CONSIDERED INCIDENTAL TO THE PROJECT AND NO SEPARATE MEASUREMENT OR PAYMENT SHALL BE MADE.
10. WHEN ABUTTING EXISTING PAVEMENT TO NEW, SAWCUT EXISTING PAVEMENT TO A STRAIGHT EDGE AND AT A RIGHT ANGLE, OR AS APPROVED BY THE PROJECT ENGINEER. REMOVAL OF BROKEN OR CRACKED PAVEMENT WILL ALSO BE REQUIRED.
11. THREE (3) WORKING DAYS PRIOR TO BEGINNING CONSTRUCTION, THE CONTRACTOR SHALL SUBMIT TO THE CONSTRUCTION COORDINATION DIVISION A DETAILED CONSTRUCTION SCHEDULE. TWO (2) WORKING DAYS PRIOR TO CONSTRUCTION, THE CONTRACTOR SHALL OBTAIN A BARRICADING PERMIT FROM THE CONSTRUCTION COORDINATION DIVISION. CONTRACTOR SHALL NOTIFY BARRICADE ENGINEER (768-2551) PRIOR TO OCCUPYING AN INTERSECTION. SEE SECTION 19 OF THE SPECIFICATIONS.
12. ALL FINAL BACKFILL FOR TRENCHES SHALL BE COMPACTED TO A MINIMUM 90% MAXIMUM DENSITY PER ASTM D-1557 AND AS DIRECTED BY SECTION 701.14.2 AND STANDARD DRAWING NUMBER 2315.
13. CONTRACTOR SHALL SUBMIT A REVEGETATION PLAN TO ENGINEER FOR PRIOR APPROVAL.

1 2 3 4 5 6 7 8 9 10 11 12 13 14 15
26 4663.90 0194

REV.	SHEETS	CITY ENGINEER	DATE	USER DEPARTMENT	DATE	USER DEPARTMENT	DATE
APPROVAL OF REVISIONS							

PLANS PREPARED UNDER DIRECTION OF: 	AVID ENGINEERING, INC. Civil • Structural • Transportation 6100 Seagull St. NE - Suite 102 Albuquerque, NM 87109 - (505) 881-5357 SCANNED BY BY TASON	APPROVED FOR CONSTRUCTION
DATE: _____	PROJECT NO. 4663.90	SHEET 1 OF 9

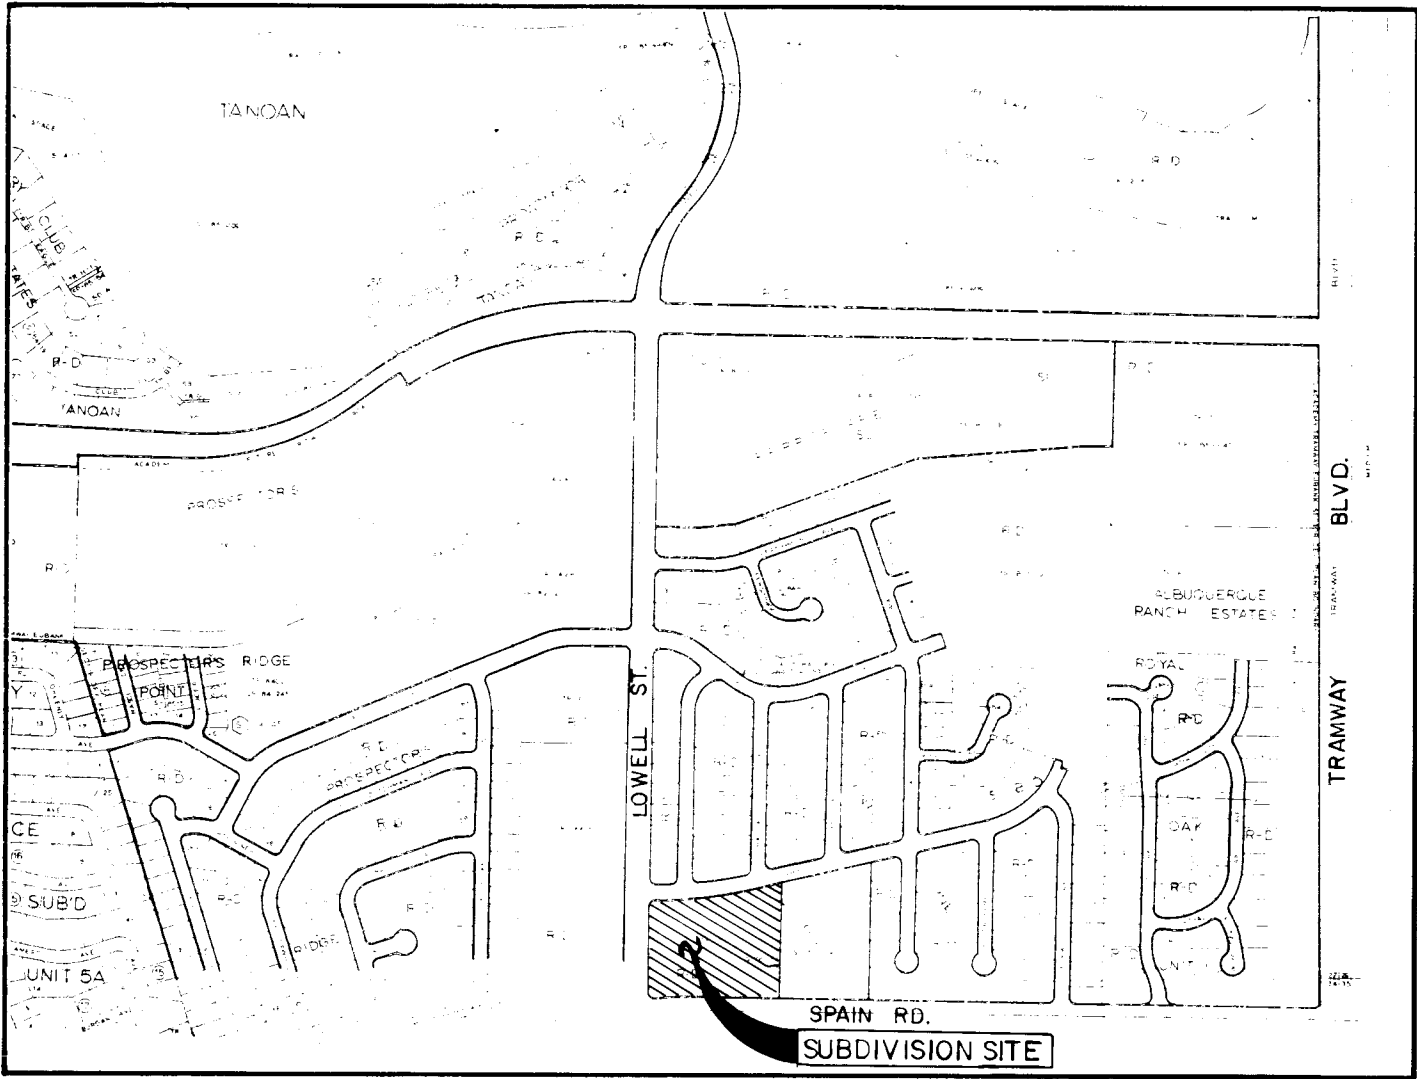

VICINITY MAP
ZONE ATLAS MAP NO. E-22-Z

SUBDIVISION DATA

1. DRB Case No. 93-11
2. Zone Atlas Index No.: E-22-Z
3. Number of Lots Plotted: 23 Lots.
4. Gross Replat Acreage: 4.6387 Ac.±
5. Total mileage of street created 0.0970 miles.
6. Date of Survey: January, 1993.

NOTES

- 1.) Bearings are grid bearings based on New Mexico State Plane Bear System (Central Zone).
- 2.) Distances are ground distances.
- 3.) ● Denotes boundary points to be set, 5/8" rebar w/cap stamped "NMPM 11462".
- 4.) ● Denotes found 1/2" rebar.
- 5.) ▲ Denotes found centerline monumentation.
- 6.) Unless otherwise located, centerline monumentation will be installed at all centerline p.c.'s, p.t.'s, angle points and street intersections. Monumentation will consist of a stamped four inch (4") aluminum disk stamped "centerline monument PLS 11462", hereon marked ▲.
- 7.) All lots to have a 10' Public Utility Easement (P.U.E.) along the front Lot Line, to be granted by this plat.
- 8.) Plat shows all easements of record.
- 9.) All Lots marked "P1" shall meet the Off-Street parking criteria of the City of Albuquerque Comprehensive Zoning Code.

PURPOSE OF PLAT

1. The purpose of this plat is to subdivide Tract A, Peppertree Subdivision, Unit One into Sun Terrace At Peppertree Subdivision, containing 23 Lots.
2. To vacate portions of utility easements, Vacation Action V-93-25
3. Dedicate new public street rights-of-way
4. Grant new public utility easements (P.U.E.).

DESCRIPTION

A certain tract of land situate within projected Section 27, Township 11 North, Range 4 East, New Mexico Principal Meridian, City of Albuquerque, Bernalillo County, New Mexico, comprising all of Tract A, Unit One, Peppertree Subdivision as the same is shown and designated on the plat entitled "PEPPERTREE SUBDIVISION UNIT ONE", as filed for record in the Office of the County Clerk of Bernalillo County, New Mexico on January 19, 1983, in Volume C20, Folio 147, and being more particularly described by grid bearings and ground distances as follows:

Beginning at a point on the southerly right-of-way line of Tamarac Trail NE and the northerly boundary line of said Tract A, being the northwest corner of the tract herein described, from whence the City of Albuquerque Control Monument "3-E22A" bears N03°27'04"W a distance of 1037.09 feet;
Thence following along said right-of-way and boundary line 363.52 feet along a curve to the left, having a radius of 1552.10 feet, a delta of 132°59' and a chord bearing N83°15'43"E a distance of 362.68 feet to point, a 5/8" rebar;
Thence continuing along said right-of-way and boundary line N76°33'09"E a distance of 126.16 feet to a point being the northeast corner of the tract herein described;
Thence leaving said right-of-way line and following the easterly boundary line of said Tract A S00°23'25"W a distance of 448.17 feet to a point on the northerly right-of-way line of Spain Road NE, being the southeast corner of the tract herein described;
Thence following along said right-of-way line and the southerly boundary line of said Tract A N89°36'35"W a distance of 312.54 feet to a point;
Thence continuing along said right-of-way and boundary line S14°35' feet along a curve to the left, having a radius of 1593.00 feet, a delta of 05°55'58" and a chord bearing S87°25'26"W a distance of 164.88 feet to a point, being the southwest corner of the tract herein described;
Thence following along said right-of-way line 41.68 feet along a curve to the right, having a radius of 25.00 feet, a delta of 85°30'51" and a chord bearing N47°47'08"W a distance of 37.02 feet to a point on the easterly right-of-way line of Lowell Street NE and the westerly boundary line of said Tract A;
Thence following along said right-of-way and boundary line N00°01'42"W a distance of 331.66 feet to a point;
Thence leaving said right-of-way line 39.27 feet along a curve to the right, having a radius of 25.00 feet, a delta of 90°00'00" and a chord bearing N44°58'16"E a distance of 33.36 feet to the point and place of beginning, containing 4.6387 acres more or less.

OWNER'S FREE CONSENT AND DEDICATION

The Subdivision Plat hereon described is with the free consent and in accordance with the desires of the undersigned owner and/or proprietor thereof. Said owner and/or proprietor does hereby dedicate all public street right-of-ways to the City of Albuquerque in fee simple, and do also hereby grant all easements shown on this plat. Electrical Power and Communication easements are reserved for buried distribution lines, conduits, and pipes for underground utilities and other related equipment where shown or indicated, and including the right of ingress and egress for construction and maintenance, and the right to trim interfering trees and shrubs.

Robert D. Taichert 3/22/93
Date Helen Jane Taichert 3/22/93
Date

John P. Eastham 3/12/93
Date Sondra L. Eastham 3/12/93
Date

STATE OF NEW MEXICO)) SS
COUNTY OF BERNALILLO))
On this 22nd day of March, 1993, the foregoing instrument was acknowledged before me.

My Commission Expires 19 Nov 1993
Notary Public

PUBLIC UTILITY EASEMENTS

PUBLIC UTILITY EASEMENTS granted by this plat are ten (10) feet wide and are for the common joint use of:

- 1.) The Public Service Company of New Mexico for the installation, maintenance and service of overhead and underground electrical lines, transformers, poles and any other equipment, fixtures, structures and related facilities reasonably necessary to provide electrical service.
- 2.) The Gas Company of New Mexico for installation, maintenance and service of natural gas lines, valves and other equipment and facilities reasonably necessary to provide natural gas.
- 3.) U.S. West for the installation, maintenance and service of all buried and aerial communication lines and other related equipment and facilities reasonably necessary to provide communications services, including but not limited to above ground pedestals and closures.
- 4.) Jones Intercable for the installation, maintenance and service of such lines, cable and other related equipment and facilities reasonably necessary to provide cable television service.

Included is the right to build, rebuild, construct, reconstruct, locate, relocate, change, remove, modify, renew, operate, and maintain facilities for the purposes described above, together with free access to, from, and over said easements including sufficient working area space for electrical transformers, with the right and privilege to trim and remove trees, shrubs or bushes which interfere with the purposes set forth herein. No building, sign, pool (above ground or subsurface), hot tub, concrete or wood deck, or other structure shall be erected or constructed on said easements, nor shall any well be drilled or operated thereon. Property owners shall be solely responsible for correcting any violations of National Electrical Safety Code caused by construction of pools, decking, or any structures adjacent to, within, or near easements shown on this plat.

Plat of
**SUN TERRACE AT
PEPPERTREE SUBDIVISION**

Within Sec. 27, T.11N., R.4E. N.M.P.M.
Albuquerque, New Mexico

MARCH, 1993

APPROVED AND ACCEPTED BY

Planning Director, City of Albuquerque, N.M. Date
City Engineering Div., City of Albuquerque, N.M. Date
Albuquerque Metropolitan Arroyo Flood Control Authority Date
Traffic Div., City of Albuquerque, N.M. Date
Robert W. Kane 4-13-93
Water Utilities Dept., City of Albuquerque, N.M. Date
Parks and Recreation Dept., City of Albuquerque, N.M. Date
Neil Clute 08/25/93
City Surveyor, City of Albuquerque, N.M. Date
Property Management, City of Albuquerque, N.M. Date
County Treasurer, Bernalillo County, N.M. Date
Gas Company of New Mexico Date
U.S. West Telecommunications Date
Public Service Company of New Mexico Date
Jones Intercable, Inc. Date

SURVEYOR'S CERTIFICATION

I, Ruan S. Bacigalupa, a duly qualified Registered Professional Land Surveyor under the laws of the State of New Mexico, do hereby certify that this plat was prepared by me or under my supervision, from an actual field survey performed in January, 1993 and meets the minimum requirements for monumentation and surveys of the Albuquerque Subdivision Ordinance, and further, meets the Minimum Standards for Land Surveying in the State of New Mexico (Effective November 1, 1989), and is true and correct to the best of my knowledge and belief.

Ruan S. Bacigalupa 3/17/93
Date Ruan S. Bacigalupa, N.M.P.S., 11462

2129.07



AVID ENGINEERING, INC.
Civil • Structural • Transportation
6100 Seagull St. NE - Suite 102
Albuquerque, NM 87109 - (505) 881-5357

SHEET 1 OF 2

ACS ALUM. CAP
3-E22A
X = 423,379.14
Y = 1,509,592.78
NMPM (CENTRAL ZONE)
ΔK = -0°08'51"
GROUND TO GRID = 0.9996250
NAD 1927

ACS TABLET
5-E22A
X = 421,794.50
Y = 1,509,057.65
NMPM (CENTRAL ZONE)
ΔK = -0°09'02"
GROUND TO GRID = 0.9996280
NAD 1927

SCANNED BY
EVLASON

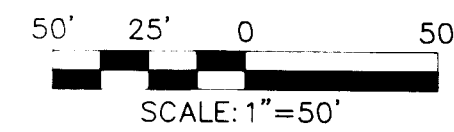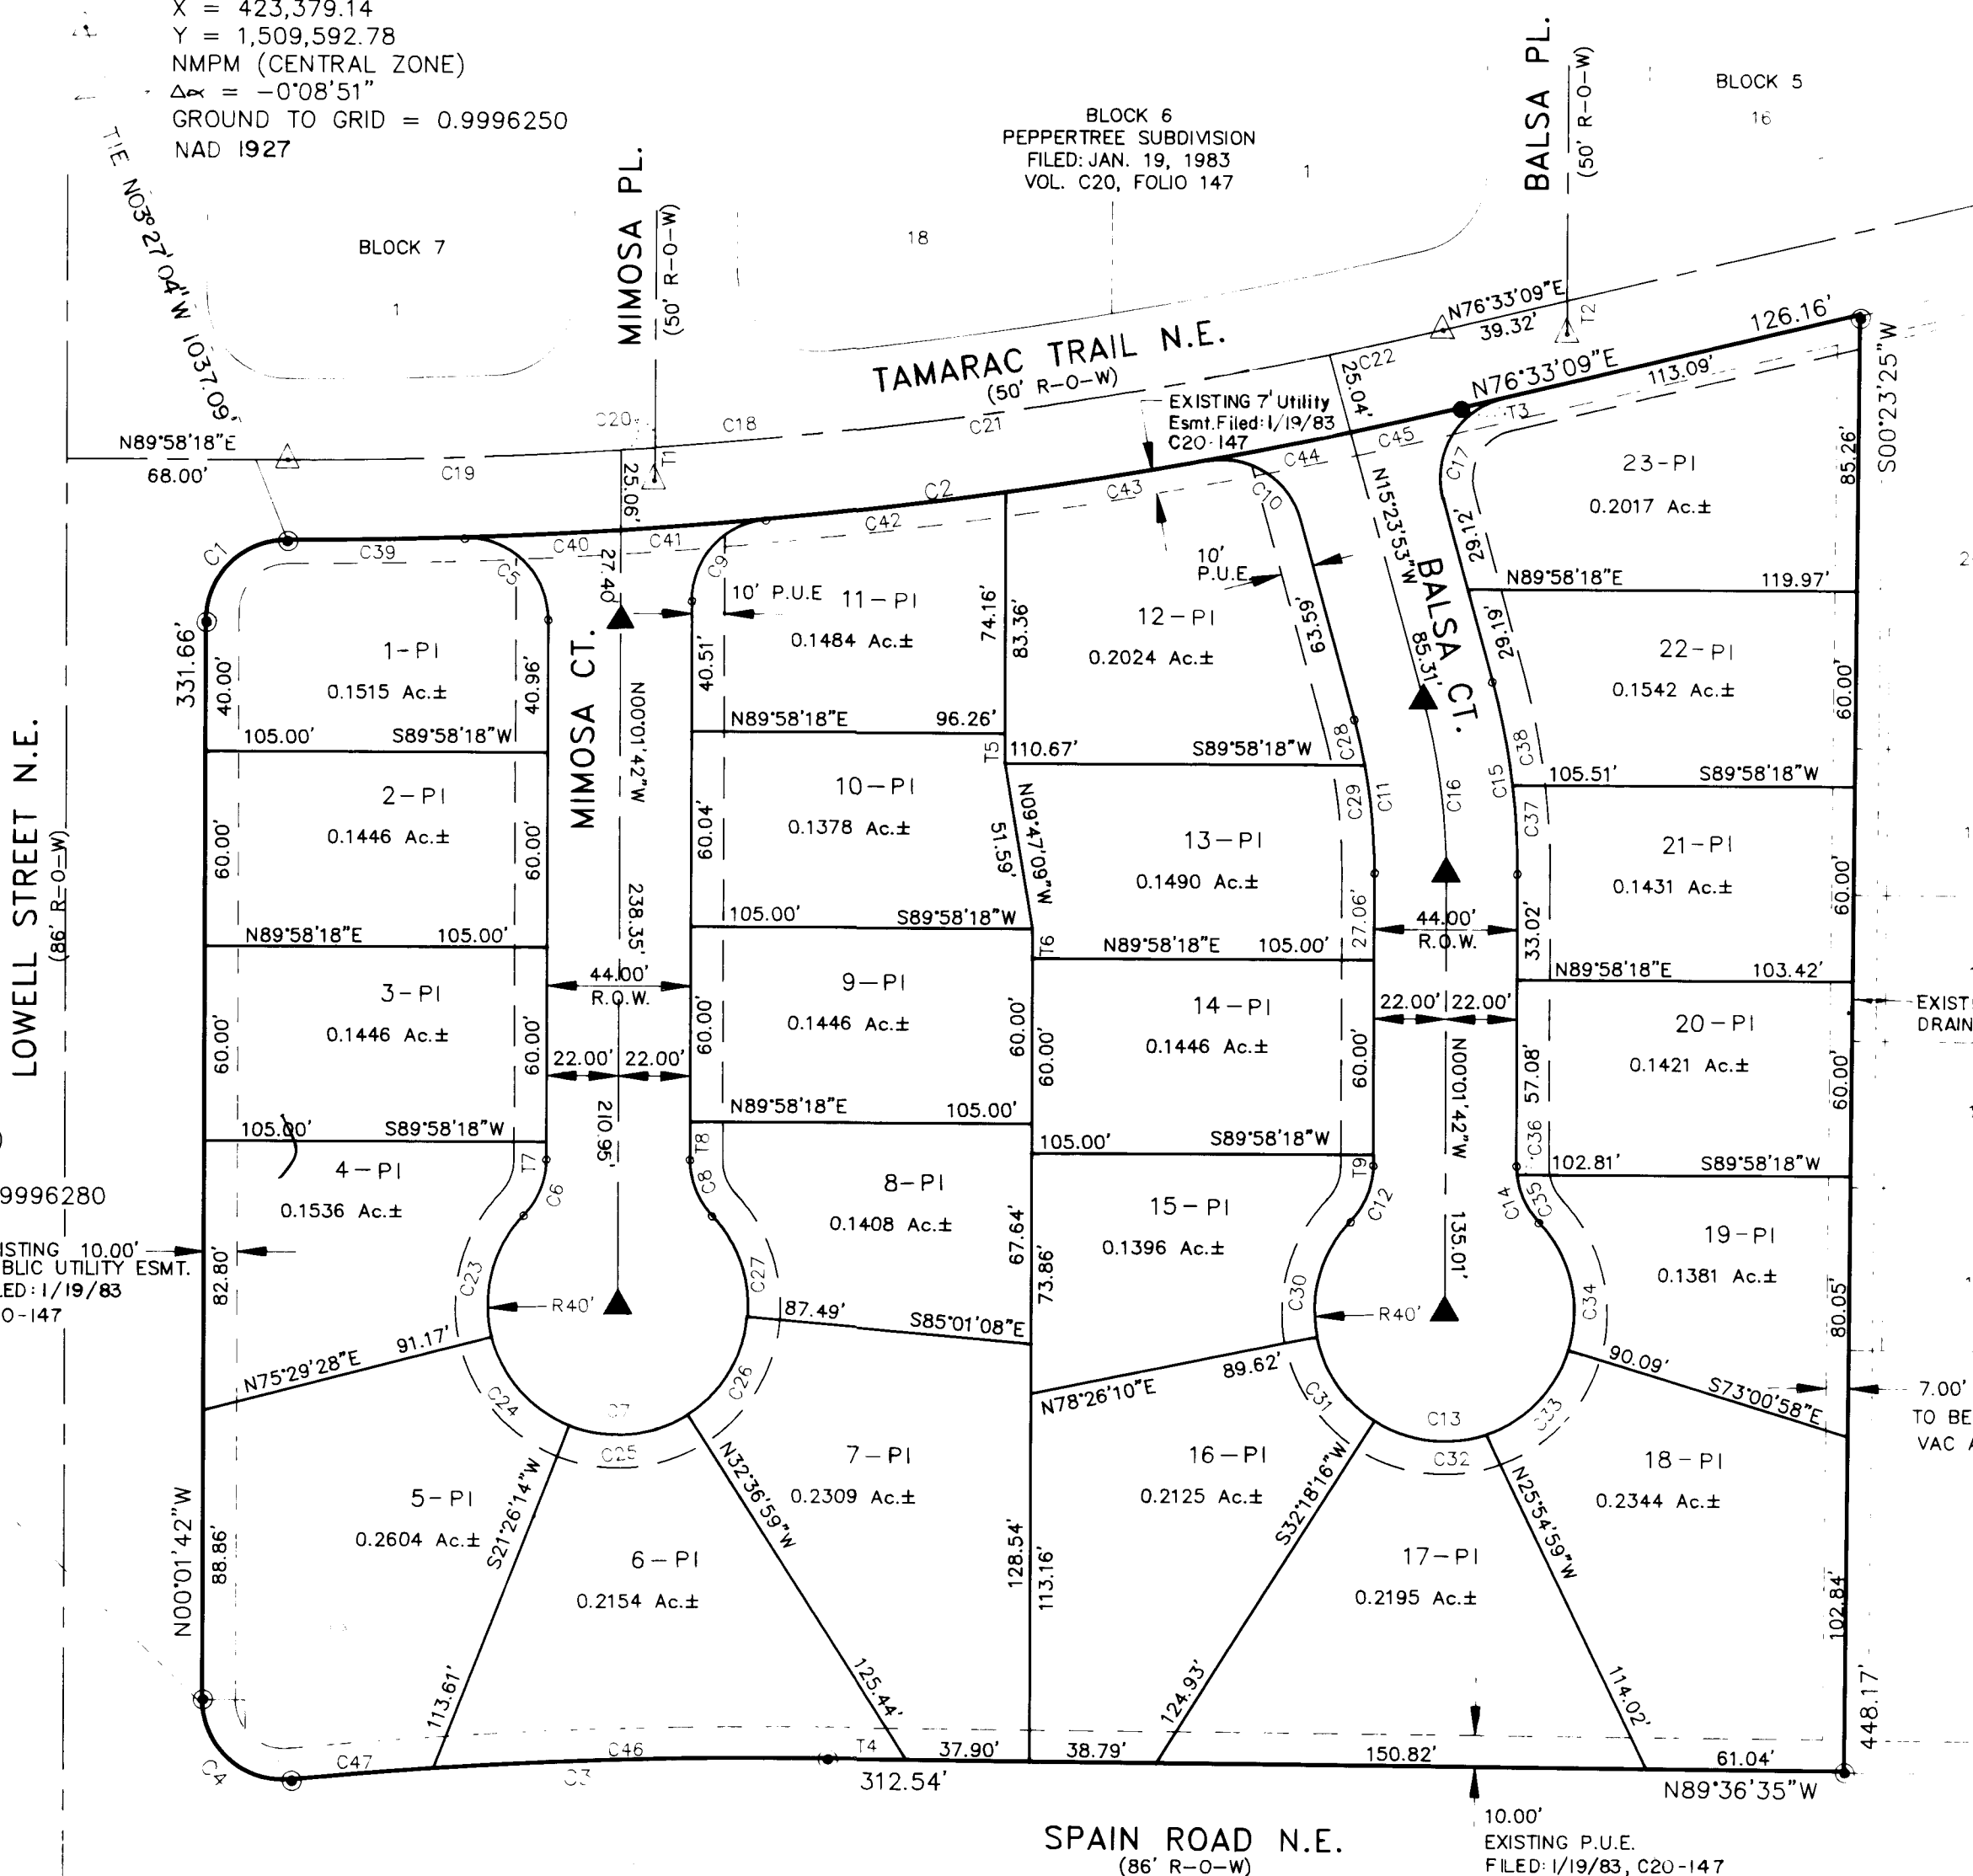

THE PARK AT PEPPERTREE
FILED: MAY 27, 1986
VOL. C30, FOLIO 117

PNM EASEMENT RELEASE APPROVAL

Public Service Company of New Mexico does hereby release, waive, quitclaim and discharge its right, title and interest in the power and communications easements (granted by prior plat, replat or document) shown to be vacated on this plat.

PUBLIC SERVICE COMPANY OF NEW MEXICO

By _____

STATE OF NEW MEXICO)) SS
COUNTY OF BERNALILLO))

The foregoing instrument was acknowledged before me this _____ day of _____, 1993, by _____ of the Public Service Company of New Mexico, a New Mexico corporation, on behalf of said corporation.

Notary Public _____ My Commission Expires _____

LEGEND

- ROADWAY CENTERLINE
- SUBDIVISION BOUNDARIES
- EXISTING PUBLIC UTILITY EASEMENT
- NEW PUBLIC UTILITY EASEMENT TO BE DEDICATED
- BOUNDARY POINT TO BE SET THIS SURVEY
- BOUNDARY CORNER FOUND
- CITY OF ALBUQUERQUE CENTERLINE MONUMENT SET THIS SURVEY
- CITY OF ALBUQUERQUE CENTERLINE MONUMENT FOUND

2129.06

AVID ENGINEERING, INC.
Civil • Structural • Transportation
6100 Seagull St. NE - Suite 102
Albuquerque, NM 87109 - (505) 881-5357

SHEET 2 OF 2

CURVE DATA

CURVE	RADIUS	LENGTH	TANGENT	CHORD	BEARING	DELTA
C1	25.00'	39.21'	15.00'	35.36'	N 44°58'18" E	92°00'00"
C2	1552.10'	363.52'	182.51'	362.68'	S 83°15'43" W	132°59'00"
C3	1593.00'	164.88'	82.55'	164.88'	S 87°25'26" W	76°55'58"
C4	25.00'	41.68'	27.53'	37.02'	N 47°47'08" W	85°30'51"
C5	25.00'	40.14'	26.94'	35.97'	N 46°01'43" W	77°59'55"
C6	25.00'	19.36'	10.22'	15.61'	C 21°49'01" W	43°41'29"
C7	40.00'	186.63'	41.67'	57.65'	N 89°58'18" E	267°02'54"
C8	25.00'	19.76'	10.62'	15.61'	S 21°52'26" E	43°41'29"
C9	25.00'	16.44'	21.74'	33.64'	N 42°16'14" E	94°04'44"
C10	25.00'	37.11'	12.45'	37.81'	N 57°56'59" W	65°57'12"
C11	178.30'	47.71'	14.21'	47.61'	C 17°42'48" E	160°02'11"
C12	25.00'	19.76'	10.62'	15.61'	N 42°16'14" E	43°41'29"
C13	40.00'	186.63'	41.67'	57.65'	N 89°58'18" E	267°02'54"
C14	25.00'	19.36'	10.22'	15.61'	C 21°49'01" W	43°41'29"
C15	222.00'	54.55'	29.46'	59.37'	N 77°47'46" E	160°02'11"
C16	200.00'	19.76'	10.62'	15.61'	N 42°16'14" E	43°41'29"
C17	25.00'	16.44'	21.74'	33.64'	N 42°16'14" E	94°04'44"
C18	1527.10'	35.46'	17.67'	35.46'	N 83°15'43" W	132°59'00"
C19	1527.10'	35.46'	17.67'	35.46'	N 83°15'43" W	132°59'00"
C20	1527.10'	35.46'	17.67'	35.46'	N 83°15'43" W	132°59'00"
C21	1527.10'	35.46'	17.67'	35.46'	N 83°15'43" W	132°59'00"
C22	1527.10'	35.46'	17.67'	35.46'	N 83°15'43" W	132°59'00"
C23	40.00'	40.61'	22.20'	35.46'	N 47°47'08" E	85°30'51"
C24	40.00'	37.74'	20.46'	36.35'	C 41°30'51" E	84°00'00"

CURVE DATA (CONT.)


CURVE	RADIUS	LENGTH	TANGENT	CHORD	BEARING	DELTA
C25	40.00'	37.74'	20.46'	36.35'	N 84°24'38" E	54°03'11"
C26	40.00'	36.59'	19.68'	35.32'	S 31°10'56" W	52°24'09"
C27	40.00'	34.00'	18.10'	32.99'	N 19°22'09" W	44°42'01"
C28	178.30'	34.62'	11.31'	34.62'	N 13°02'45" W	04°42'16"
C29	178.30'	33.11'	10.39'	33.09'	S 05°21'59" W	10°39'54"
C30	40.00'	38.66'	20.92'	37.08'	N 16°02'48" E	55°13'35"
C31	40.00'	32.20'	17.03'	31.34'	N 34°37'47" W	46°07'54"
C32	40.00'	35.63'	19.10'	34.47'	N 83°12'56" W	51°02'24"
C33	40.00'	37.42'	20.50'	36.49'	N 44°07'27" E	47°16'53"
C34	40.00'	42.38'	23.42'	40.42'	N 13°22'04" W	60°42'11"
C35	40.00'	16.14'	8.36'	15.86'	N 25°13'19" E	36°59'41"
C36	40.00'	21.02'	11.46'	20.92'	N 03°22'35" W	06°41'46"
C37	40.00'	22.53'	12.51'	22.53'	S 03°53'03" E	36°59'41"
C38	40.00'	22.53'	12.51'	22.53'	N 11°16'16" W	36°59'41"
C39	40.00'	54.14'	27.50'	54.14'	N 88°58'20" E	01°59'55"
C40	40.00'	47.93'	24.73'	47.93'	S 87°05'18" W	31°46'10"
C41	40.00'	44.58'	24.78'	44.58'	N 55°22'17" E	01°59'55"
C42	40.00'	74.16'	37.46'	74.16'	N 35°19'55" E	02°44'14"
C43	40.00'	62.73'	31.36'	62.73'	N 61°19'22" W	10°16'53"
C44	40.00'	44.98'	22.43'	44.98'	N 64°40'36" W	11°39'32"
C45	40.00'	34.83'	17.41'	34.83'	N 88°12'24" E	01°59'55"
C46	1593.00'	164.88'	82.55'	164.88'	N 83°15'43" W	132°59'00"
C47	1593.00'	43.53'	21.27'	43.53'	S 85°14'25" W	31°33'57"

TANGENT DATA

LINE	DIRECTION	DISTANCE
T1	S 83°15'43" W	13.00'
T2	S 03°11'39" W	12.00'
T3	S 76°33'03" W	12.00'
T4	S 89°36'35" E	23.99'
T5	N 30°14'49" W	9.20'
T6	N 30°14'49" W	9.20'
T7	N 00°01'42" E	5.11'
T8	S 00°01'42" E	11.61'
T9	N 00°01'42" W	1.14'

NOTES CONT.

10. City of Albuquerque water and sanitary sewer services to lots 1-P1 to 23-P1 must be verified and coordinated with Public Works Department, City of Albuquerque.

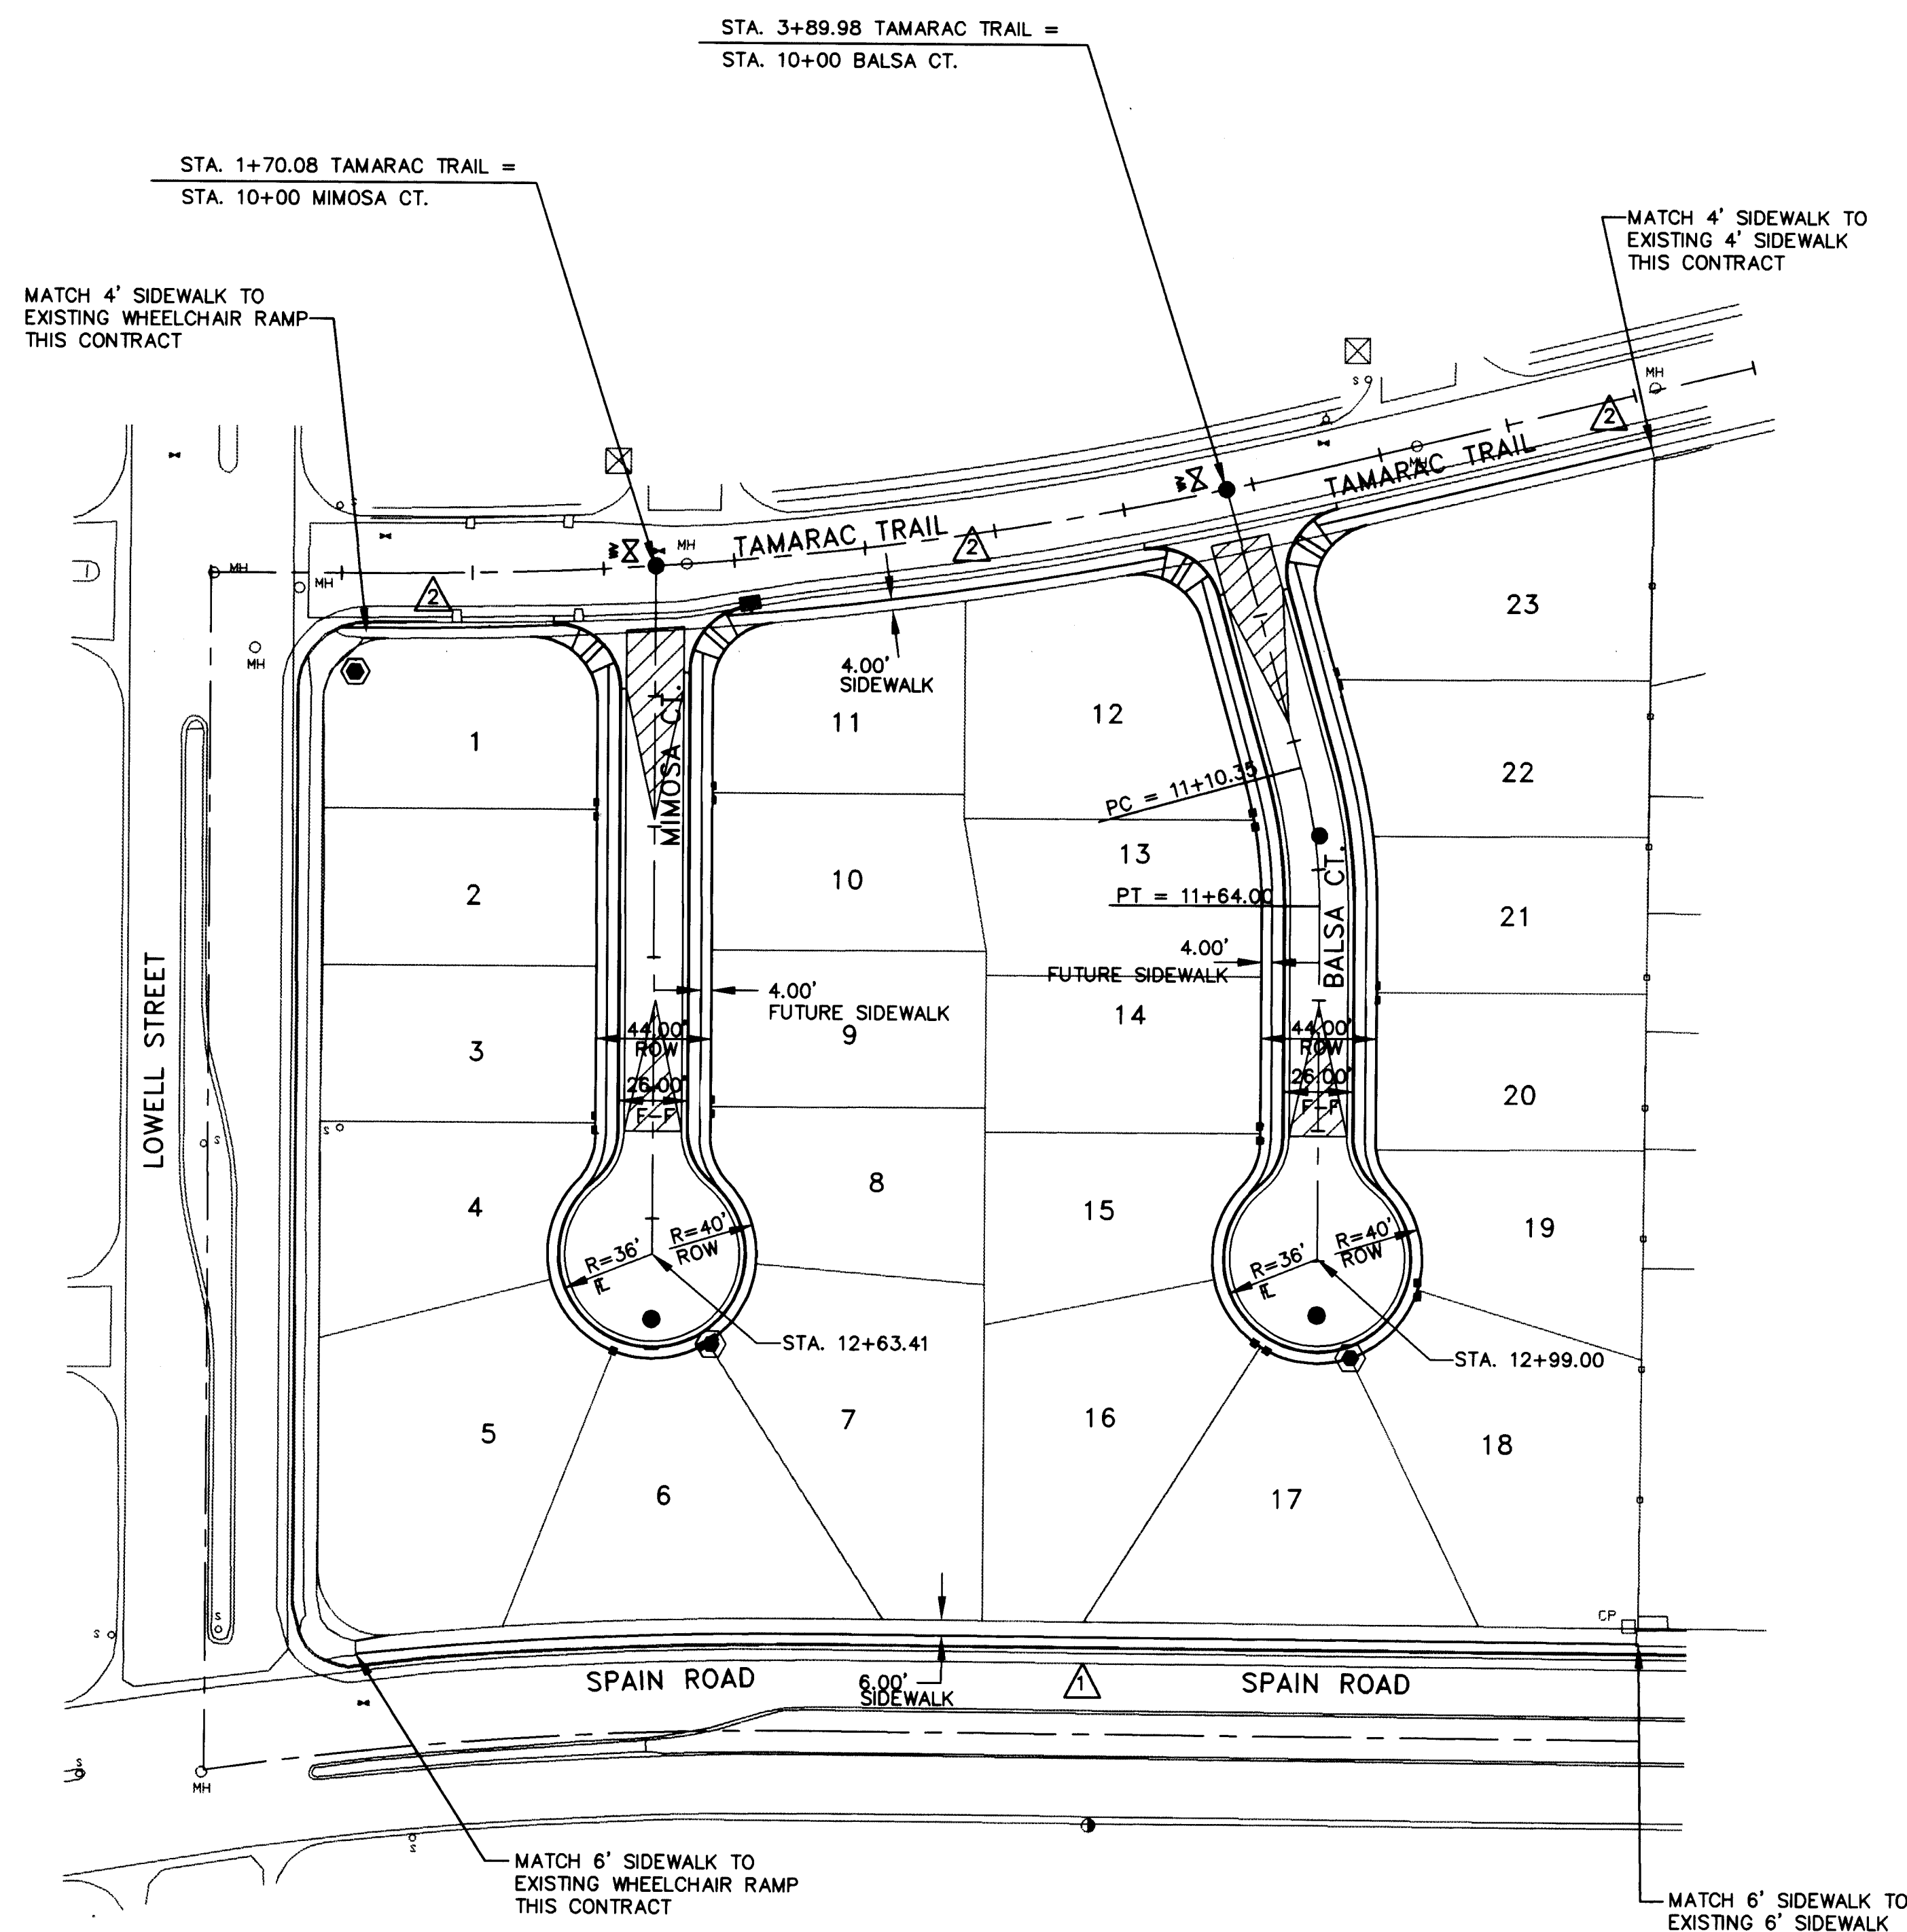

RECORD DRAWING CERTIFICATION

I, Rick Beltramo, a registered professional engineer in the state of New Mexico, having directed the collection of as-built survey information, and having collected construction information from the city inspector, the surveyor and the contractor, do hereby certify that record drawing information shown is true and correct to the best of my knowledge. This certification does not address construction methods, techniques, performance, or compliance to plan specifications.

SCANNED BY
BY LASON

GENERAL NOTES

- ALL STATIONING AND OFFSET DIMENSIONS ARE BASED ON CENTERLINE OF RIGHT-OF-WAY.

KEYED NOTES:

- CONSTRUCT 6' SIDEWALK
- CONSTRUCT 4' SIDEWALK

LEGEND

- CENTERLINE OF STREET
- EXISTING CURB & GUTTER
- PROPOSED ASPHALT CURB
- PROPOSED STANDARD CURB & GUTTER
- PROPOSED MOUNTABLE CURB & GUTTER
- PROPOSED WHEELCHAIR RAMP
- PROPOSED CONCRETE VALLEY GUTTER
- TRANSITION FROM CROWN TO NO CROWN
- PROPOSED SANITARY SEWER MANHOLE
- EXISTING STREET LIGHT LOCATION
- PROPOSED STREET LIGHT LOCATION
- EXISTING VALVES
- EXISTING MANHOLE
- EXISTING TYPE "B" STORM INLET
- PROPOSED TYPE "B" STORM INLET

AVID ENGINEERING, INC.
Civil • Structural • Transportation
6100 Seagull St. NE - Suite 102
Albuquerque, NM 87109 - (505) 881-5357

26 4663.900394

CITY OF ALBUQUERQUE
PUBLIC WORKS DEPARTMENT
ENGINEERING GROUP

TITLE: SUN TERRACE AT PEPPERTREE
OVERALL PAVING PLAN

APPROVALS	ENGINEER	DATE	APPROVALS	ENGINEER	DATE
D.R.C. Chair	<i>[Signature]</i>	5-13-93	Water	<i>[Signature]</i>	4-26-93
Transportation	<i>[Signature]</i>	4-29-93	Waste Water	<i>[Signature]</i>	4-26-93
Hydrology	<i>[Signature]</i>	4-29-93			

DRAWING NO.	MAP NO.	SHEET OF
4663.90	E-22-Z	3 OF 9

AS BUILT INFORMATION

CONTRACTOR: SPAIN RD. CO. DATE: 9/3

WORK: SPAIN RD. CO. DATE: 9/3

INSPECTOR'S: SPAIN RD. CO. DATE: 9/3

FIELD: SPAIN RD. CO. DATE: 9/3

VERIFICATION: SPAIN RD. CO. DATE: 9/3

CORRECTION: SPAIN RD. CO. DATE: 9/3

RECORDED: SPAIN RD. CO. DATE: 9/3

NO.

NO.

BENCH MARKS

THE STATION IS LOCATED 0.4 MILES NE OF DOWNTOWN ALBUQUERQUE

REACH THE STATION FROM THE INTERSECTION OF TRAMWAY BLVD. AND

SPAIN RD., GO WEST ON SPAIN RD. AND TRAVEL 0.5 MILES TO LOWELL

TURN NORTH AND TRAVEL 0.25 MILES TO SAN VICTORIO. THE STATION IS

IN THE LOWELL MEDIAN NOSE NORTH OF THE INTERSECTION APPROXIMATELY

40.3' NORTH OF THE CENTERLINE OF SAN VICTORIO. THE STATION IS A

3 1/4" ALUMINUM CAP SET FLUSH IN THE TOP OF THE CURB AND IS

STAMPED "ACS 3-E22A 1985. SLD 1929 ELEVATION = 5891.17

NO.

NO.

ENGINEER'S SEAL

DATE

DATE


DATE

DATE
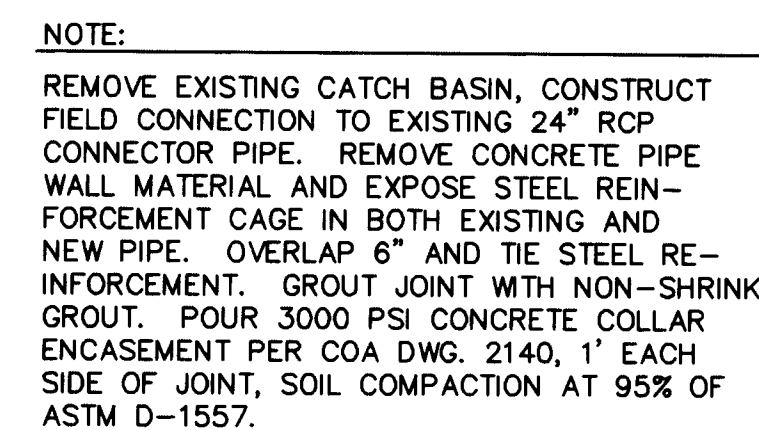

SCALE:
HORIZ. 1" = 50'
VERT. 1" = 5'

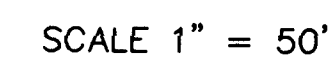

— W —	EXISTING WATERLINE
— SD —	EXISTING STORM DRAIN
— SAS —	EXISTING SANITARY SEWER
	EXISTING MANHOLE
	EXISTING FIRE HYDRANT
	EXISTING GATE VALVE
— W —	PROPOSED WATERLINE
— SD —	PROPOSED STORM DRAIN
— SAS —	PROPOSED SANITARY SEWER
	PROPOSED MANHOLE
	PROPOSED FIRE HYDRANT
	PROPOSED GATE VALVE
	PROPOSED CAP OR PLUG
	PROPOSED SINGLE METER, WATER SERVICE LINE
	PROPOSED DOUBLE METER, WATER SERVICE LINES
	PROPOSED SANITARY SEWER SERVICE LINE
	PROPOSED CROSS, TEE, OR ELBOW
	PNM UTILITY CONDUIT
	EXISTING TYPE "B" STORM INLET
	PROPOSED TYPE "B" STORM INLET

AVID ENGINEERING, INC.
Civil • Structural • Transportation
6100 Seagull St. NE - Suite 102
Albuquerque, NM 87109 - (505) 881-5357

26 4663.900494

I, Rick Beltramo, a registered professional engineer in the state of New Mexico, having directed the collection of as-built survey information, and having collected construction information from the city inspector, the surveyor and the contractor, do hereby certify that record drawing information shown is true and correct to the best of my knowledge. This certification does not address construction methods, techniques, performance, or compliance to plan specifications.

SCANNED BY
BY LASON

[illegible]

WATER & SANITARY SEWER SERVICES					
LOT NUMBER	WL STATION & OFFSET	WL TYPE	SAS STATION & OFFSET	SAS LENGTH	INV. OF PIPE AT PLUG
1	STA. 10+93.41, 10'RT.	DOUBLE	STA. 10+52.45, 0.00	22.00	71.14
2			STA. 11+03.41, 0.00	22.00	71.39
3	STA. 12+13.41, 10'RT.	DOUBLE	STA. 11+63.41, 0.00	22.00	71.69
4			STA. 12+23.41, 0.00	22.49	72.05
5	STA. 12+88.84, 10'RT.	SINGLE	STA. 12+83.41, 0.00	34.64	72.71
6	STA. 12+93.84, 10'RT.	DOUBLE	STA. 12+88.41, 0.00	15.49	73.04
7			STA. 12+76.90, 0.00	37.66	73.19
8	STA. 12+06.90, 10'RT.	DOUBLE	STA. 12+16.90, 0.00	22.00	72.86
9			STA. 11+56.90, 0.00	22.00	72.56
10	STA. 10+86.86, 10'RT.	DOUBLE	STA. 10+96.86, 0.00	22.00	72.26
11			STA. 10+46.36, 0.00	22.00	72.01

WATER & SANITARY SEWER SERVICES					
LOT NUMBER	WL STATION & OFFSET	WL TYPE	SAS STATION & OFFSET	SAS LENGTH	INV. OF PIPE AT PLUG
12	STA. 11+26.77, 10'RT.	DOUBLE	STA. 10+46.76, 0.00	22.00	78.81
13			STA. 11+41.04, 1.33' LT	23.50	79.37
14	STA. 12+51.06, 10'RT.	DOUBLE	STA. 12+01.06, 0.00	22.00	79.76
15			STA. 12+61.06, 0.00	22.99	80.15
16	STA. 13+14.80, 10'RT.	DOUBLE	STA. 13+17.00, 0.00	35.72	80.50
17			STA. 13+20.70, 0.00	20.45	80.73
18	STA. 13+10.70, 10'RT.	DOUBLE	STA. 13+20.70, 0.00	33.60	81.35
19			STA. 12+67.01, 0.00	25.59	80.98
20	STA. 11+97.01, 10'RT.	DOUBLE	STA. 12+07.01, 0.00	22.00	80.46
21			STA. 11+47.01, 0.72' LT.	21.35	80.17
22	STA. 10+81.16, 10'RT.	DOUBLE	STA. 10+91.16, 0.00	22.00	79.88
23			STA. 10+52.04, 0.00	22.00	79.69

UTILITY NOTES

- STATIONING ALONG C of STREET UNLESS OTHERWISE NOTED.
- SANITARY SEWER LINE LENGTHS COMPUTED FROM MH C to MH C.
- SLOPES ARE COMPUTED INVERT TO INVERT. MH RIM ELEVATIONS GIVEN ARE APPROXIMATE. CONTRACTOR SHALL ADJUST ALL RIMS TO FINAL GRADE.
- CONTRACTOR IS RESPONSIBLE FOR COORDINATION WITH UTILITY COMPANIES.
- CONTRACTOR SHALL VERIFY ALL EXISTING UTILITIES AND UTILITY CONNECTIONS PRIOR TO BEGINNING CONSTRUCTION. SHOULD A CONFLICT EXIST OR DESIGN REVISIONS BE REQUIRED FOR ANY REASON, THE CONTRACTOR SHALL NOTIFY THE ENGINEER AND ALLOW SUFFICIENT TIME FOR DESIGN REVISIONS SO AS TO NOT DELAY THE CONSTRUCTION SCHEDULE.

BALSA CT. WATERLINE CURVE DATA

$$\Delta = 15^{\circ}22'11''$$
$$R = 190.00'$$
$$T = 25.64'$$
$$L = 50.97'$$

LEGEND

- W — EXISTING WATERLINE
- SD — EXISTING STORM DRAIN
- SAS — EXISTING SANITARY SEWER
- ⊙ — EXISTING MANHOLE
- ⊗ — EXISTING FIRE HYDRANT
- ⊗ — EXISTING GATE VALVE
- W — PROPOSED WATERLINE
- SD — PROPOSED STORM DRAIN
- SAS — PROPOSED SANITARY SEWER
- — PROPOSED MANHOLE
- ⊗ — PROPOSED FIRE HYDRANT
- ⊗ — PROPOSED GATE VALVE
- — PROPOSED CAP OR PLUG
- — PROPOSED SINGLE METER, WATER SERVICE LINE
- — PROPOSED DOUBLE METER, WATER SERVICE LINES
- — PROPOSED SANITARY SEWER SERVICE LINE
- + + — PROPOSED CROSS, TEE, OR ELBOW
- — PNM UTILITY CONDUIT
- — EXISTING TYPE "B" STORM INLET
- — PROPOSED TYPE "B" STORM INLET

26 4663.900793





AVID ENGINEERING, INC.
Civil • Structural • Transportation
6100 Seagull St. NE - Suite 102
Albuquerque, NM 87109 - (505) 881-5357

CITY OF ALBUQUERQUE
PUBLIC WORKS DEPARTMENT
ENGINEERING GROUP

APPROVALS				APPROVALS			
ENGINEER	DATE	ENGINEER	DATE	ENGINEER	DATE	ENGINEER	DATE
D.R.C. Chair	5-13-93	Water	4-26-93	D.R.C. Chair	4-26-93	Water	4-26-93
Transportation	4-29-93	Waste Water	4-26-93	Transportation	4-29-93	Waste Water	4-26-93
Hydrology	4-29-93			Hydrology	4-29-93		

SCANNED BY
BY LASON

DRAWING NO.	MAP NO.	SHEET	OF
4663.90	E-22-Z	7	9

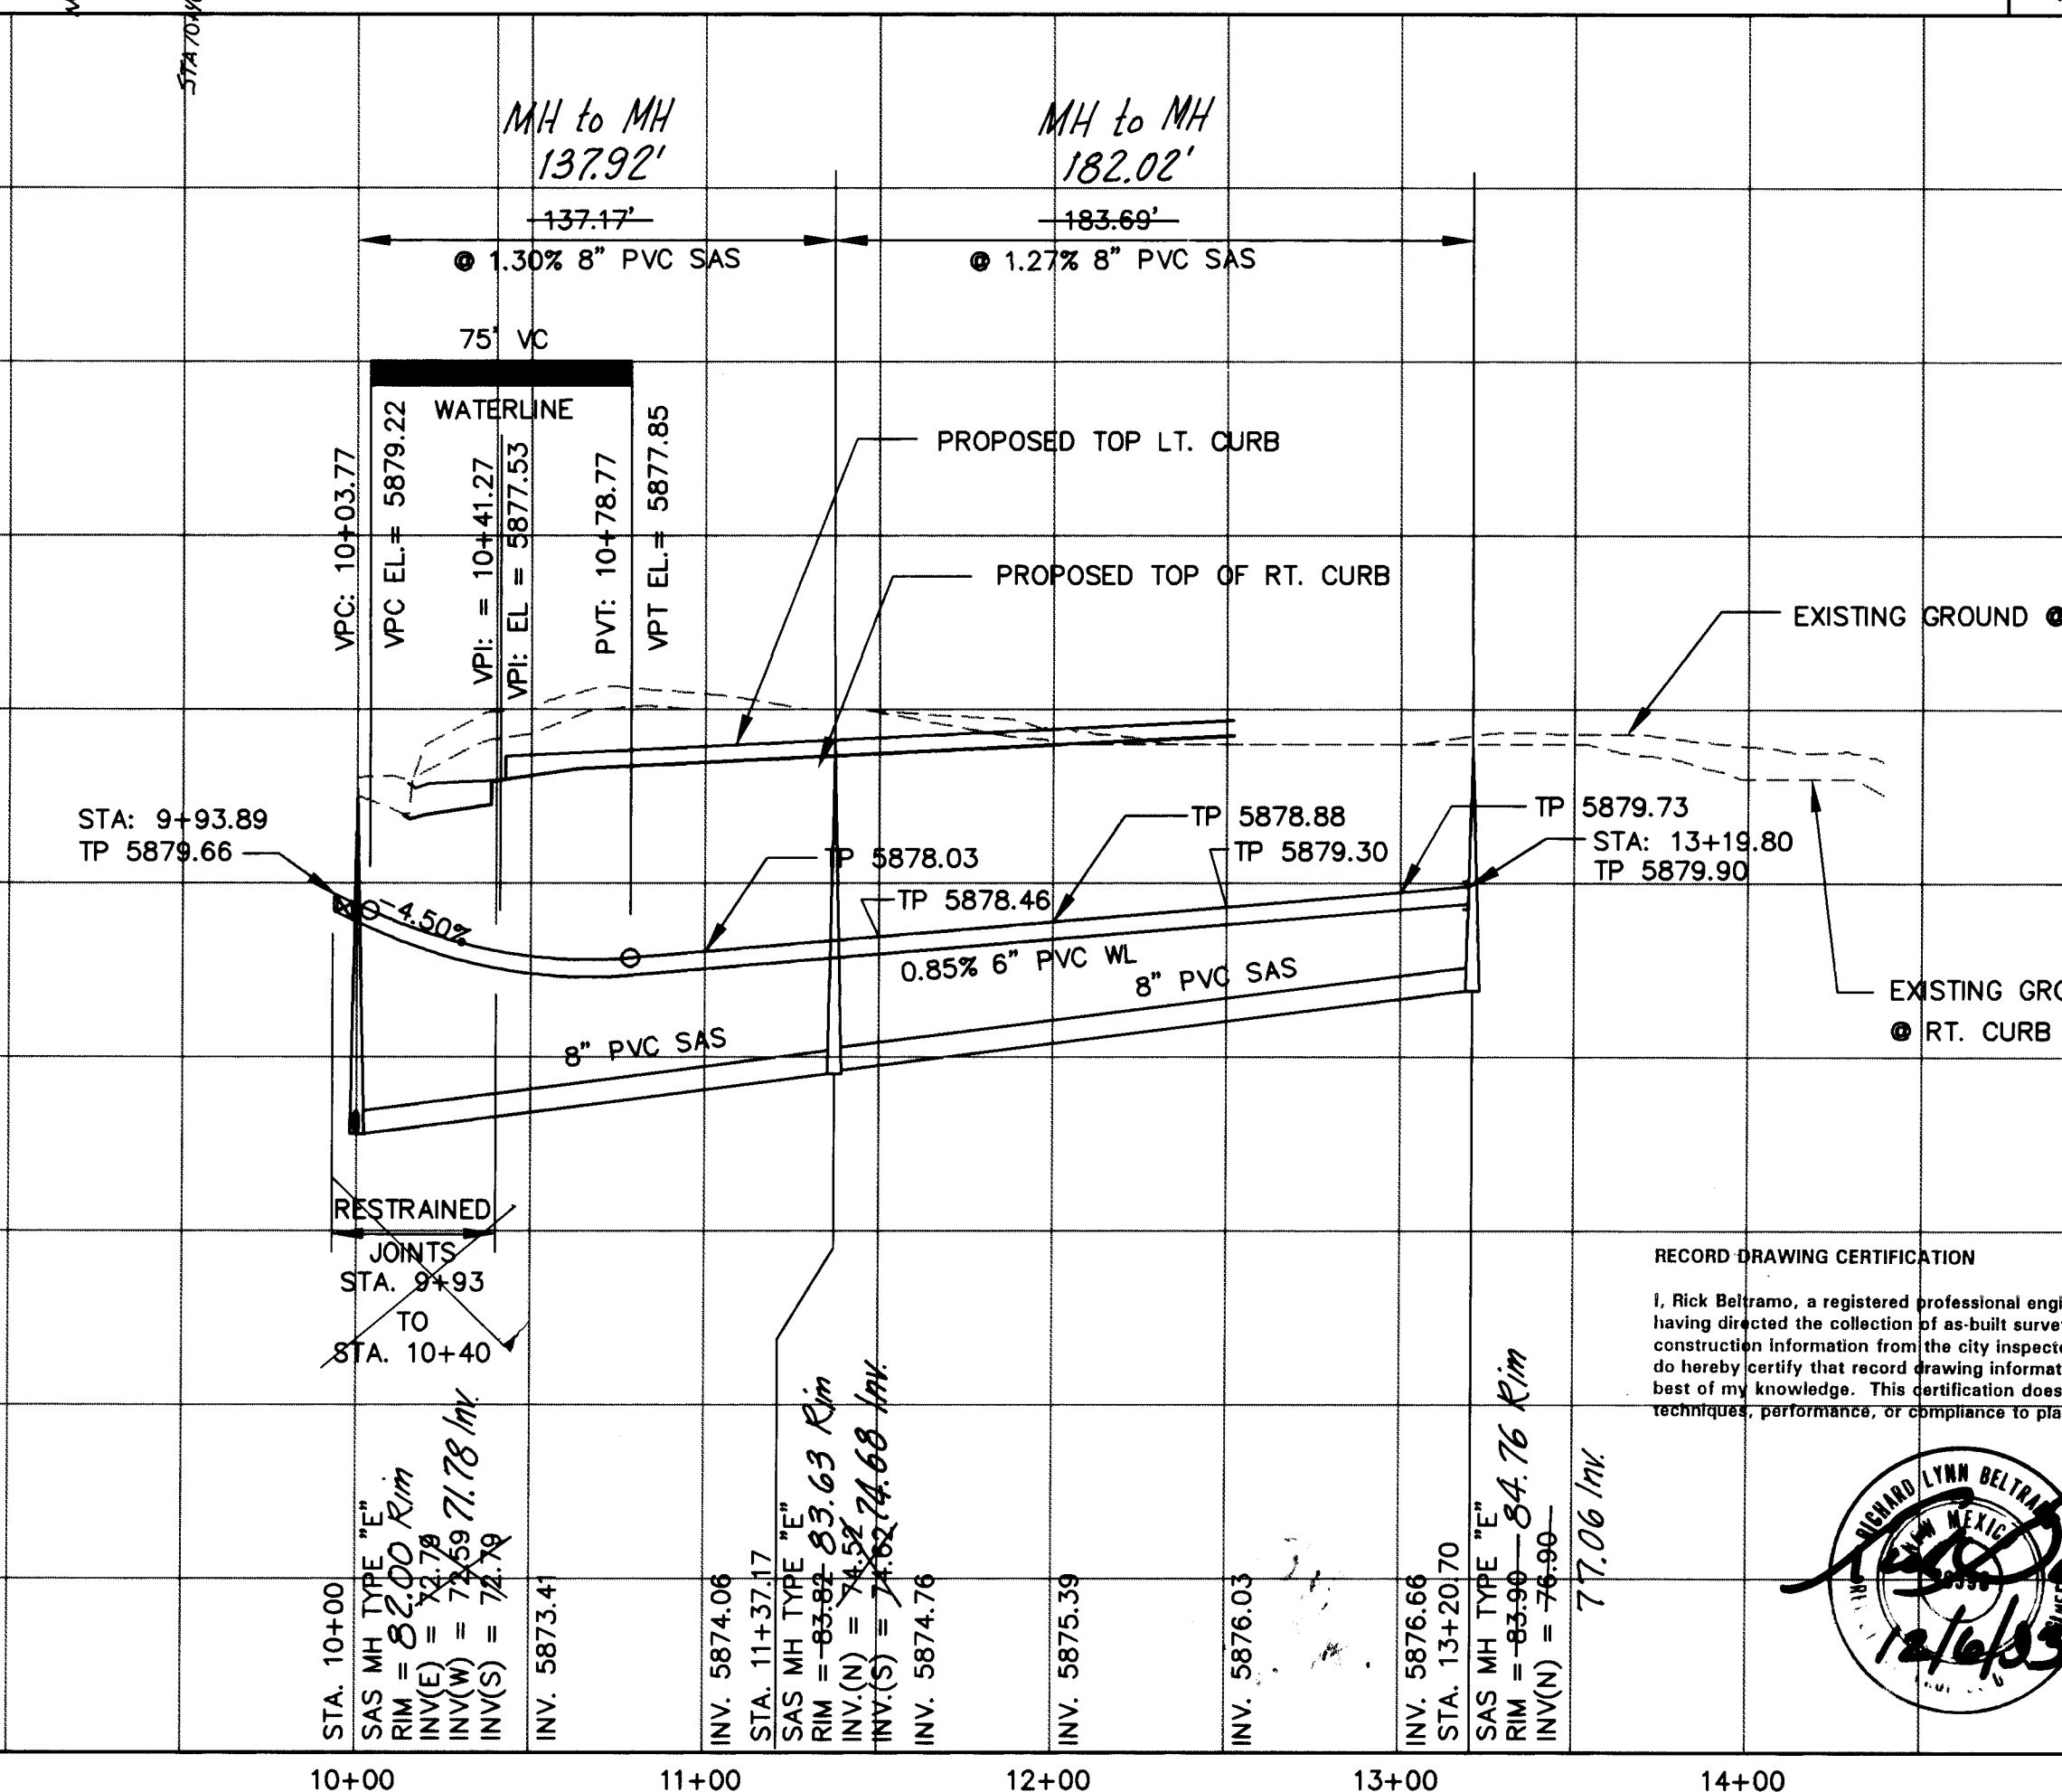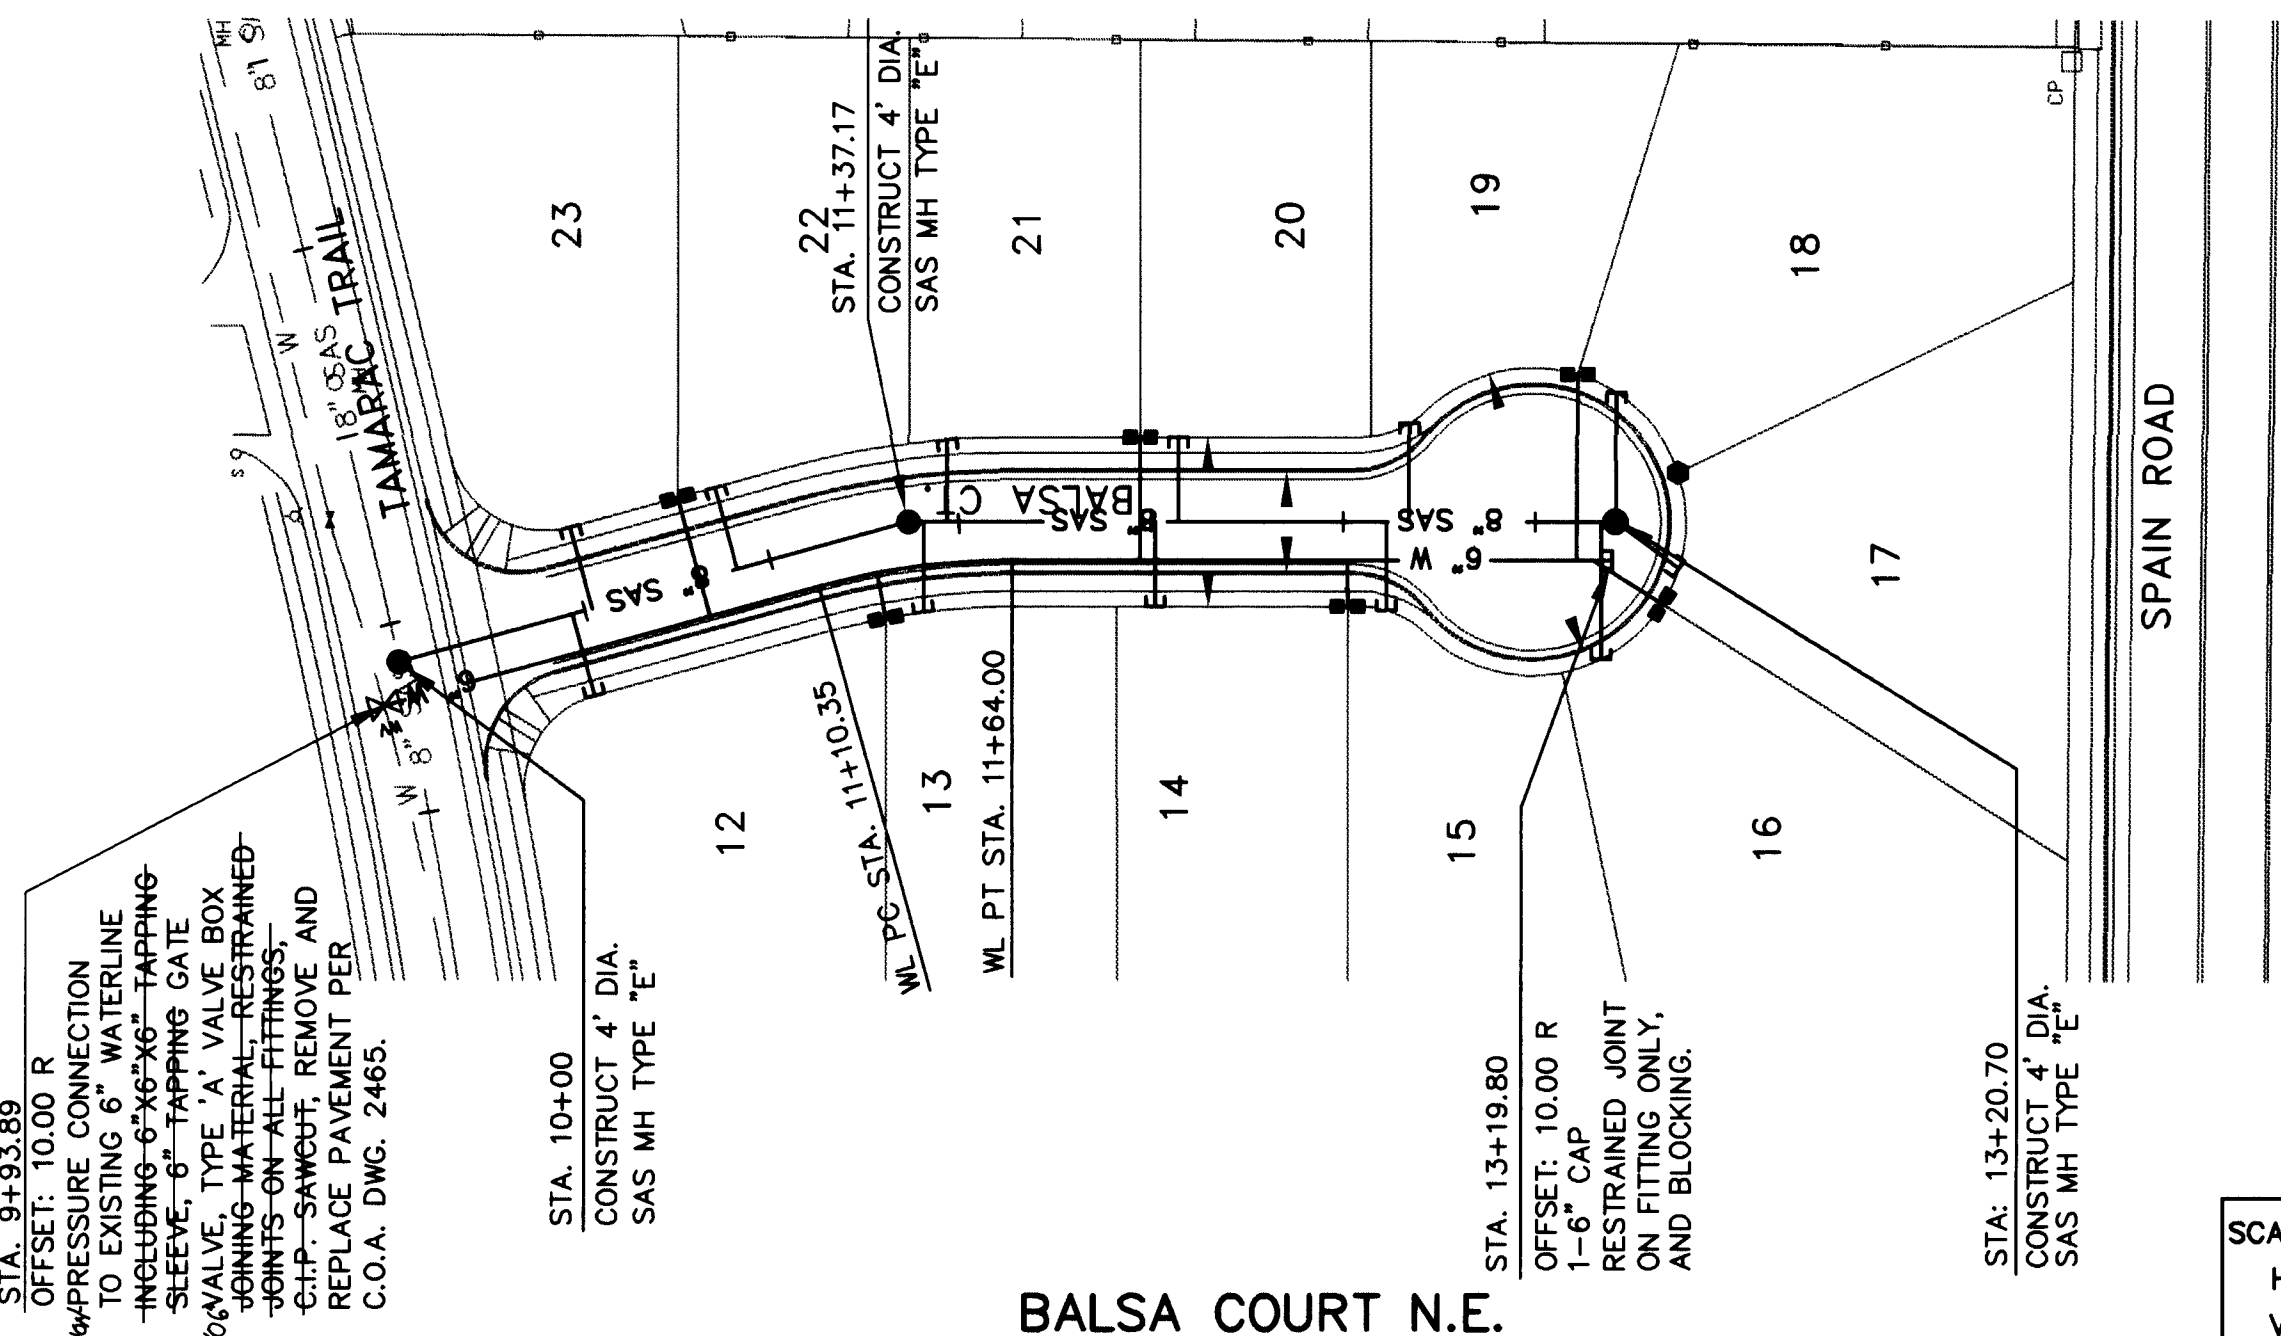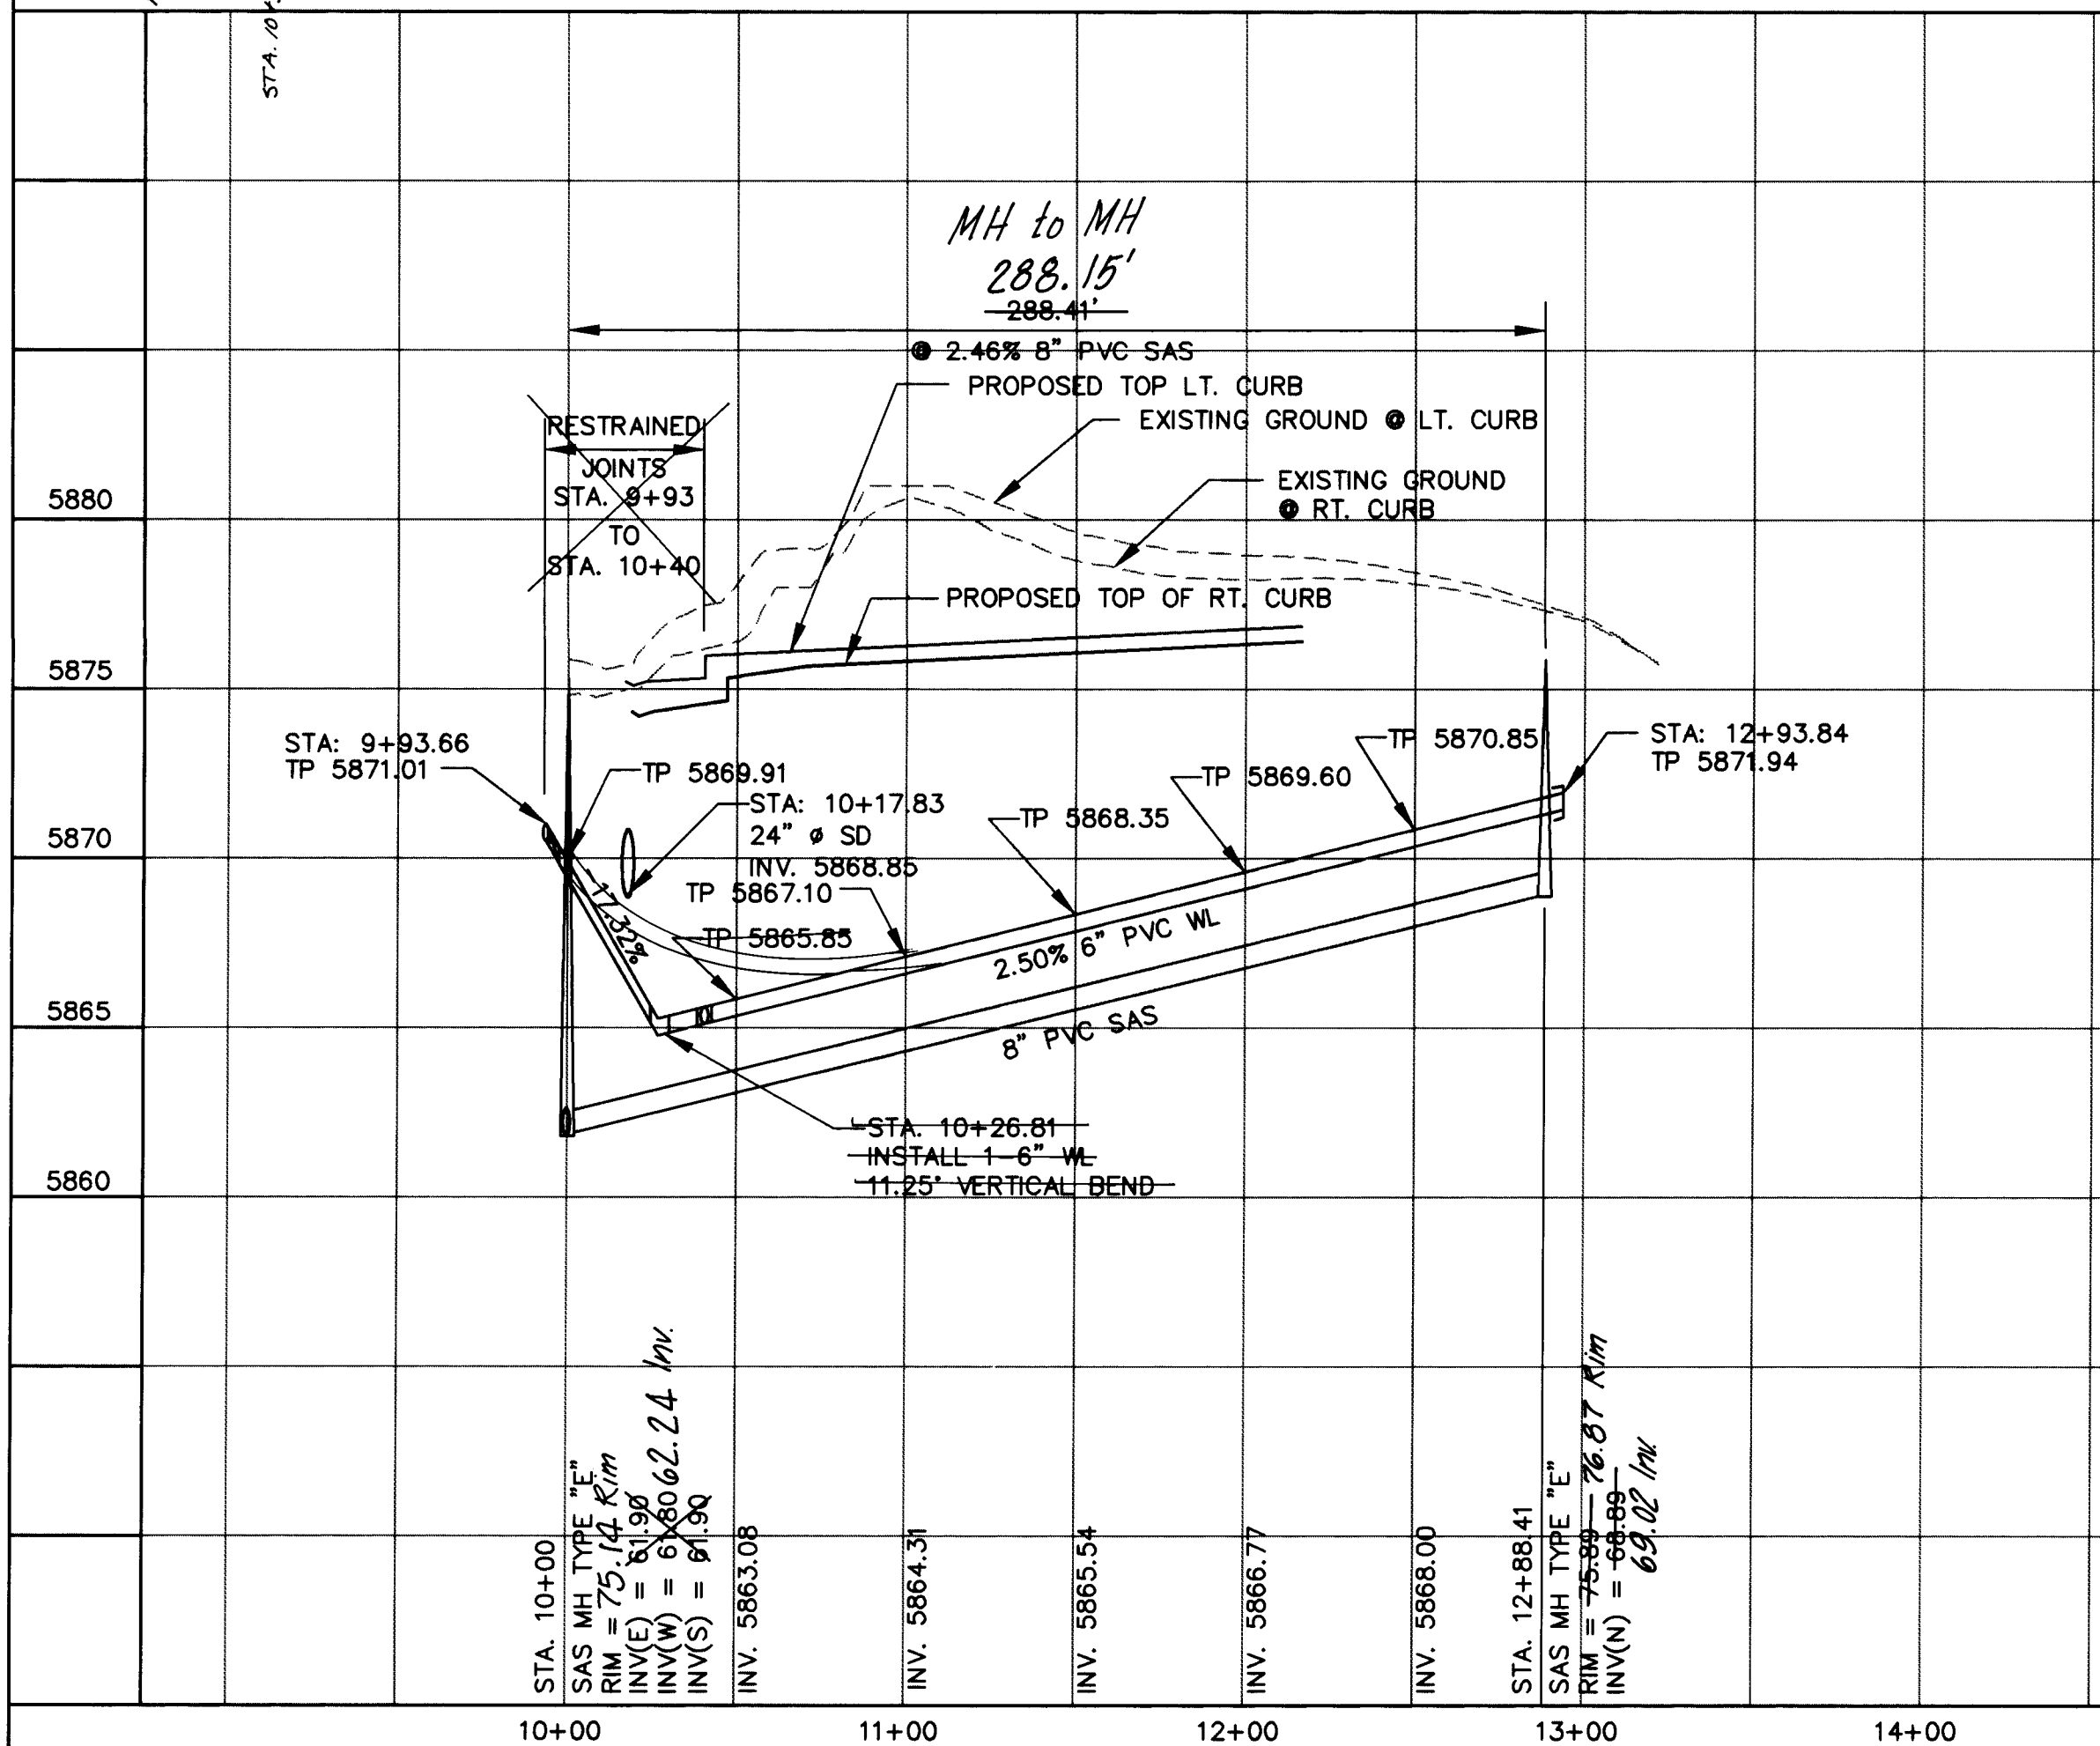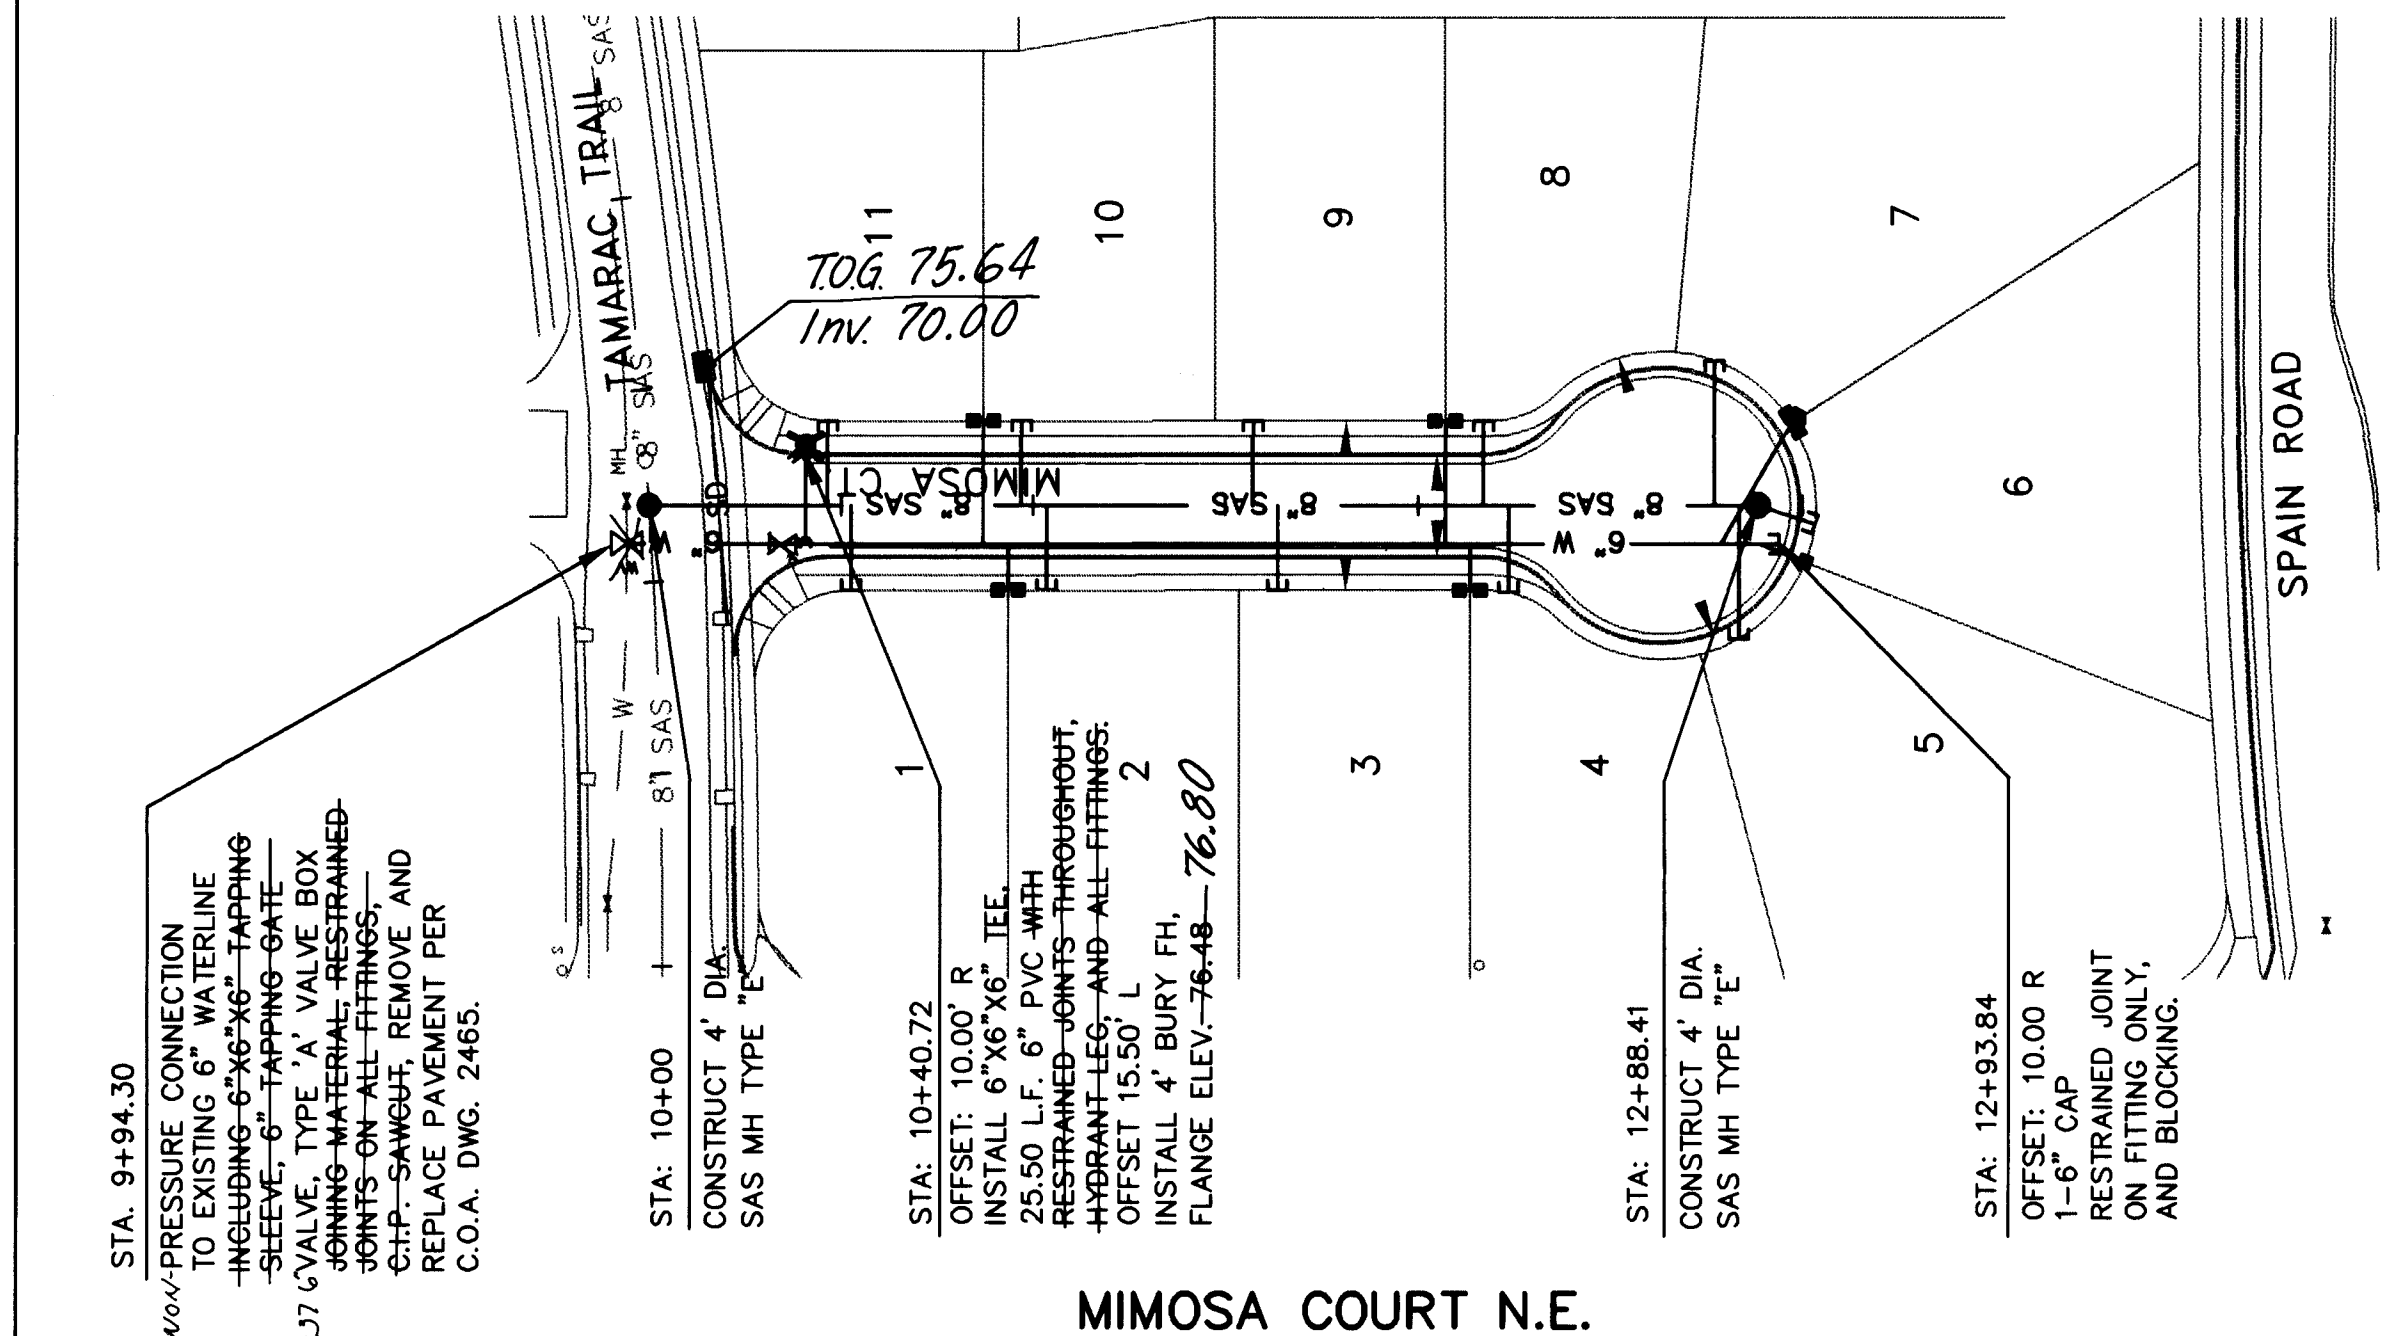

RECORD DRAWING CERTIFICATION
I, Rick Belmont, a registered professional engineer in the state of New Mexico, having directed the collection of as-built survey information, and having collected construction information from the city inspector, the surveyor and the contractor, do hereby certify that record drawing information shown is true and correct to the best of my knowledge. This certification does not address construction methods, technique, performance, or compliance to plan specifications.

[Signature]
12/6/93

RESIDENTIAL STREET SECTION (1/4 CROWN)
1"=5'

RESIDENTIAL PAVING SECTION
NTS

TYPICAL LOT GRADING DETAIL

SCALE: 1"=20'

1 KEYSTONE BLOCK SLOPE PROTECTION DETAILS

C.M.U. GARDEN WALL SIDEYARD DETAIL

LOT GRADING GENERAL NOTES:

1. LOT GRADING SHALL MEET THE SITE GRADING AND DRAINAGE CRITERIA FOR PROPOSED CONSTRUCTION AS SET FORTH BY THE DEPARTMENT OF HOUSING AND URBAN DEVELOPMENT - FEDERAL HOUSING ADMINISTRATION IN CIRCULAR LETTER NO. 91-1, OFFICE OF THE MANAGER, ALBUQUERQUE, NEW MEXICO, DATED 1/25/91.
2. ELEVATION OF HIGHPOINT OF REARYARD SWALE SHALL BE MIN. OF 6' BELOW PAD ELEVATION.
3. FINISHED FLOOR ELEVATIONS (NOT SHOWN) SHALL BE 8' ABOVE PAD ELEVATIONS (SHOWN).
4. FRONT YARD SIDEWALK SLOPE SHALL NOT EXCEED 10%.
5. DRIVEWAY SLOPE SHALL NOT EXCEED 14%. IF DRIVEWAY IS USED AS SIDEWALK, MAX-SLOPE SHALL NOT EXCEED 10%.
6. SLOPES SHALL NOT EXCEED 4:1, UNLESS OTHERWISE NOTED.
7. THE CONTRACTOR MUST OBTAIN A TOPSOIL DISTURBANCE PERMIT FROM THE ENVIRONMENTAL HEALTH DIVISION PRIOR TO CONSTRUCTION.
8. THE CONTRACTOR IS TO COMPLY WITH EARTHWORK SPECIFICATIONS AS NOTED IN THE SOILS REPORT SUPPLIED BY THE OWNER.
9. THE CONTRACTOR SHALL CONFORM TO ALL CITY, COUNTY, STATE AND FEDERAL DUST CONTROL MEASURES AND REQUIREMENTS AND WILL BE RESPONSIBLE FOR PREPARING AND OBTAINING ALL NECESSARY APPLICATIONS AND APPROVALS.
10. THE CONTRACTOR SHALL ENSURE THAT NO SOIL ERODES FROM THE CONSTRUCTION SITE. EROSION CONTROL MEASURES ARE INTENDED TO CONTROL MINOR FLOWS AND PROHIBIT THE RELEASE OF SEDIMENT INTO ADJACENT STREETS AND PROPERTY. TEMPORARY EROSION CONTROL SHALL BE CONSTRUCTED IN ACCORDANCE WITH THE DETAIL SHOWN ON THE GRADING PLAN, AT LOCATIONS SHOWN ON THE GRADING PLAN.
11. THE CONTRACTOR IS RESPONSIBLE FOR MAINTAINING TEMPORARY BERMS THROUGHOUT THE CONSTRUCTION PHASE. THE OWNER WILL MAINTAIN BERMS AFTER COMPLETION AND ACCEPTANCE OF CONSTRUCTION.
12. TEMPORARY EROSION CONTROL BERMS LOCATED ON INDIVIDUAL LOTS SHALL REMAIN IN PLACE UNTIL THE CONSTRUCTION OF EACH RESPECTIVE BUILDING IS COMPLETE, ON A LOT BY LOT BASIS.

13. THE TOLERANCES FOR ROUGH GRADING SHALL CONFORM TO THE FOLLOWING:

PAD SUBGRADE:	+/- 0.1
STREET SUBGRADE:	+/- 0.1
ALL OTHER AREAS:	+/- 0.3

14. BACKYARD DRAINS TO BE PROVIDED AS DESIGNATED ON WALL DETAILS.

15. THE CONTRACTOR IS FULLY RESPONSIBLE FOR FIELD VERIFYING ALL EXISTING UTILITIES AND SHALL NOTIFY THE ENGINEER IMMEDIATELY OF ANY DISCREPANCIES. NOTIFICATION SHALL BE IN A TIMELY MANNER TO ALLOW FOR COORDINATION AND RESOLUTION SO THAT NO DELAY IN THE CONSTRUCTION SCHEDULE OCCURS.

16. CAUTION SHALL BE EXERCISED WHEN WORKING IN THE VICINITY OF EXISTING UTILITIES. ANY DAMAGE TO EXISTING UTILITIES RESULTING FROM CONSTRUCTION ACTIVITIES WILL BE REPAIRED BY THE CONTRACTOR AT THE CONTRACTOR'S EXPENSE.



GRADING CERTIFICATION

I, Rick Beltramo, having conducted a site inspection and directed the collection of as-built survey information, certify the site grading and drainage improvements are substantially complete and in accordance with the approved drainage reports and approved construction plans. This certification does not address construction methods, techniques, performance, or compliance to plan specifications.

17. GRADE ELEVATIONS, WHERE NOTED, ARE FOR TOP OF CURB UNLESS OTHERWISE SPECIFIED.

18. ANY DAMAGE TO THE EXISTING FACILITIES (CURB AND GUTTER, PAVEMENT, CONDUITS, LANDSCAPING, UTILITY LINES, ETC.) DURING CONSTRUCTION SHALL BE REPLACED AT THE CONTRACTORS EXPENSE.

19. THE CONTRACTOR SHALL REVEGETATE AND RE-ESTABLISH ALL AREAS WHICH ARE DISTURBED BY SITE GRADING AND ARE NOT TO RECEIVE PERMANENT SURFACE TREATMENTS. SPECIFICATIONS FOR SEEDING SHALL BE PER CITY OF ALBUQUERQUE STANDARD SPECIFICATIONS FOR PUBLIC WORKS CONSTRUCTION, LATEST EDITION, SECTION 1011, NATIVE SEEDING CLASS A.

OPERATION SHALL CONSIST OF PROTECTION OF SITE, PREPARATION OF SEEDBED, MULCHING, FERTILIZATION, AND THE PROVISION OF MATERIALS, LABOR, AND EQUIPMENT NECESSARY TO PERFORM THE OPERATION. THE SEED MIX SHALL BE AS DENOTED IN THE LIST BELOW.

[illegible]

GRASSES

INDIAN RICE GRASS	1.5 LBS.
GALLETA GRASS 'VITA'	3.5 LBS.
SIDE OATS GRAMA	2 LBS.
SAND DROPSEED	1 LB.
BLUE GRAMA 'HATCHITA'	2 LBS.

WILD FLOWERS

TAHOKA DAISY	1 LB.
YELLOW CONEFLOWER	1 LB.
GALLARDIA	1 LB.

20. THE CONTRACTOR SHALL SUPPLY AN AS-BUILT SURVEY FOR GRADING CERTIFICATION.

21. THE CONTRACTOR SHALL DISPOSE
ALL EXCESS MATERIAL AT AN ACCEPTABLE
LOCATION.

22. THE CONTRACTOR IS RESPONSIBLE FOR ALL COORDINATION WITH UTILITY COMPANIES AND OTHER CONTRACTORS. NO TIME EXTENSIONS WILL BE ALLOWED FOR CONFLICTS WITH UTILITY COMPANIES AND OTHER CONTRACTORS.

AVID ENGINEERING, INC.
Civil • Structural • Transportation
6100 Seagull St. NE - Suite 102
Albuquerque, NM 87109 - (505) 881-5357

26 4663.900894

8'-0" RETAINING WALL BACKYARD DETAIL


RECORD DRAWING CERTIFICATION

I, Rick Beltramo, a registered professional engineer in the state of New Mexico, having directed the collection of as-built survey information, and having collected construction information from the city inspector, the surveyor and the contractor, do hereby certify that record drawing information shown is true and correct to the best of my knowledge. This certification does not address construction methods, techniques, performance, or compliance to plan specifications.




SCANNED BY
BY LASON

CITY OF ALBUQUERQUE PUBLIC WORKS DEPARTMENT ENGINEERING GROUP					
TITLE: SUN TERRACE AT PEPPERTREE GRADING DETAILS					
APPROVALS	ENGINEER	DATE	APPROVALS	ENGINEER	DATE
D.R.C. Chair	<i>B. E. Anderson</i>	5-17-93	Water	<i>NIA ROW</i>	4-26-93
Transportation	<i>NIA ROW</i>	4-24-93	Waste Water	<i>NIA ROW</i>	4-26-93
Highway	<i>J. P. Martin</i>	4-29-93			
DRAWING NO.		4663.90	MAP NO.		F-22-7
			SHEET		OF 9

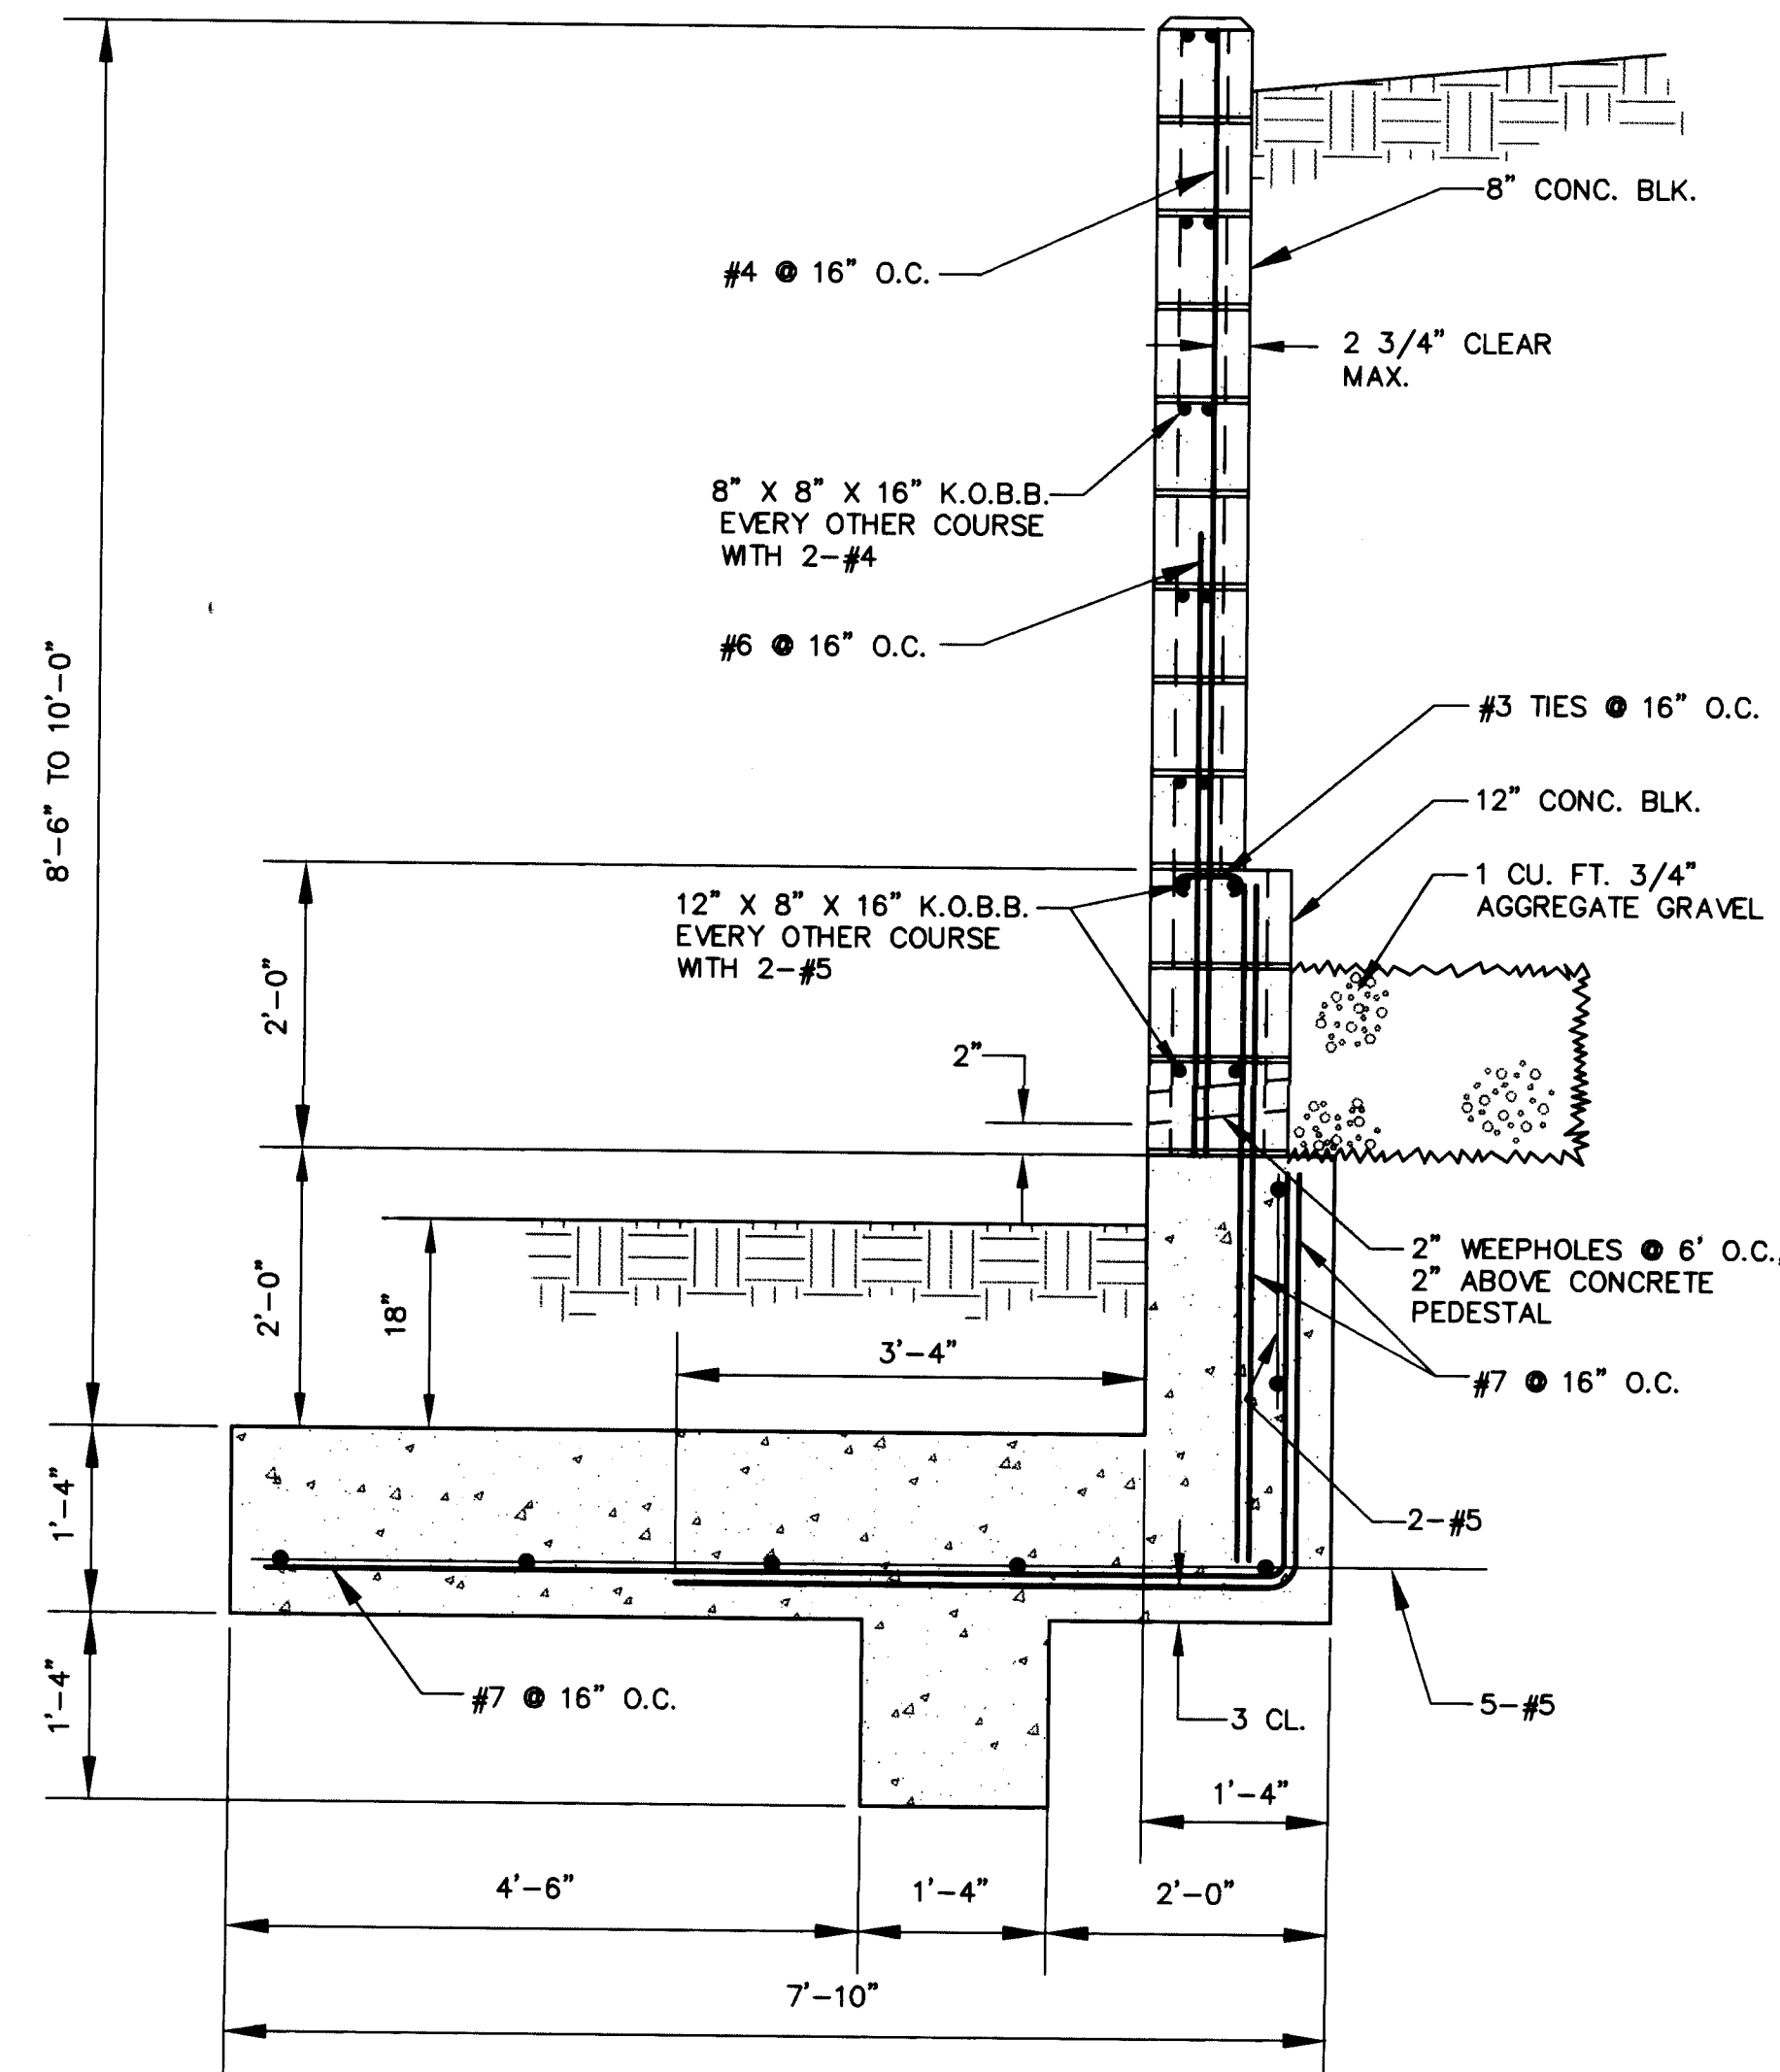

6'-6" TO 8'-0" HIGH CMU RETAINING WALL

NTS

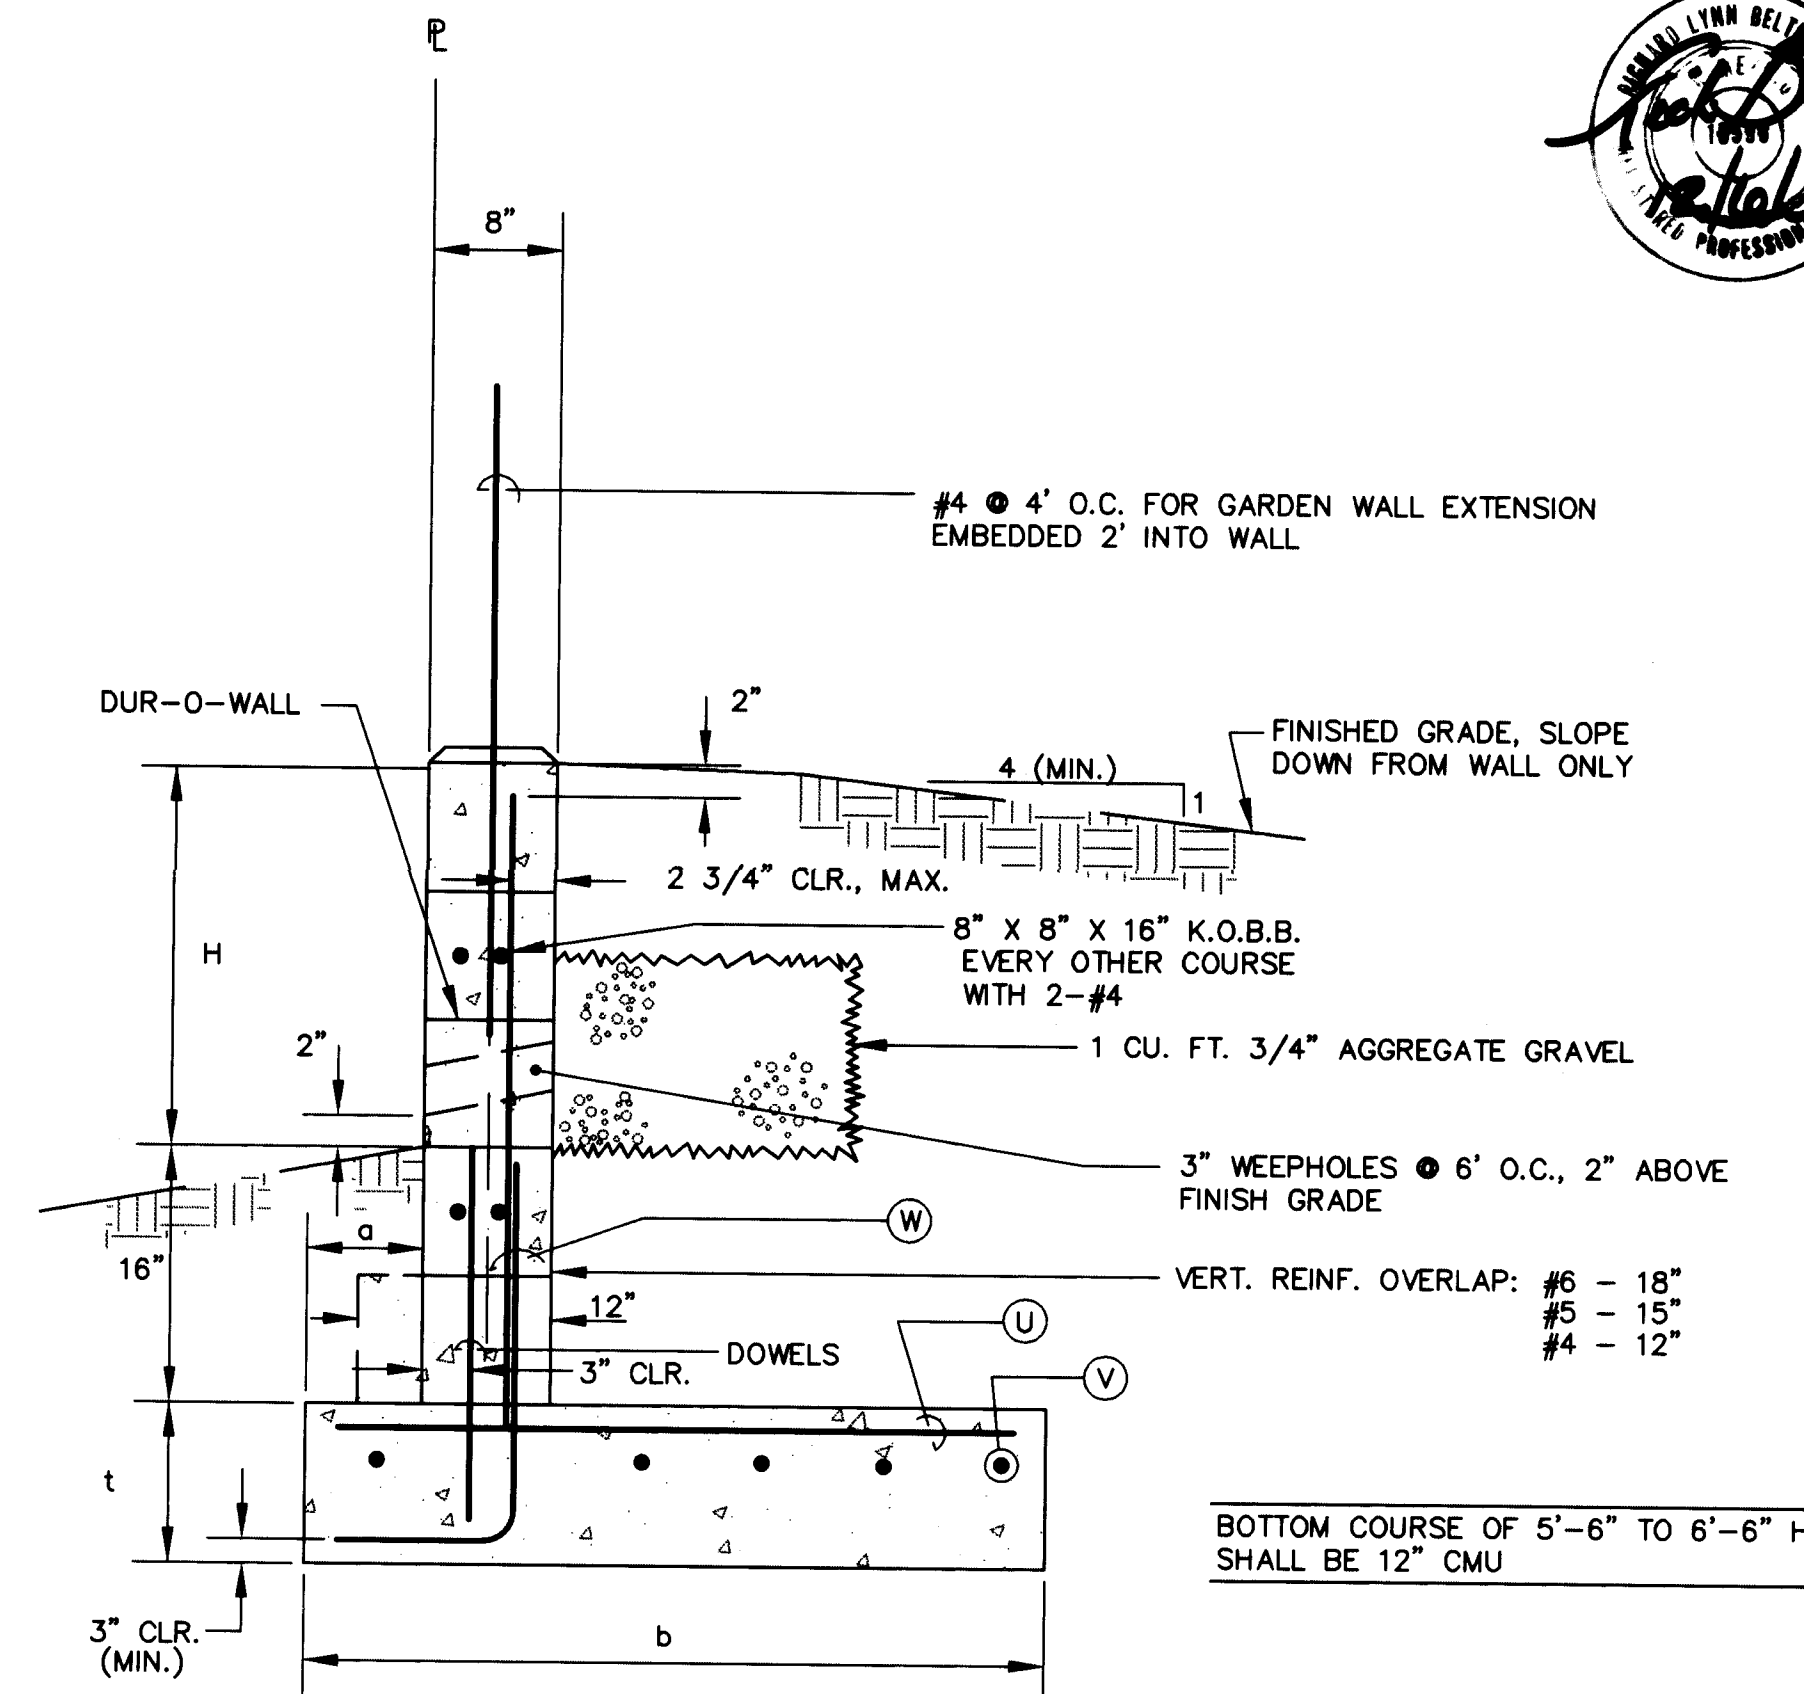

CMU RETAINING

NTS


H	a	b	t	U	V	W	DOWELS
1'-6" - 2'-6"	12"	3'-4"	10"	#5 @ 10"	#4 @ 12"	#4 @ 8"	-
2'-6" - 3'-6"	12"	3'-10"	10"	#4 @ 8"	#4 @ 12"	#5 @ 8"	#4 @ 24"
3'-6" - 4'-6"	12"	4'-4"	10"	#5 @ 6"	#4 @ 12"	#5 @ 8"	#4 @ 16"
4'-6" - 5'-6"	12"	4'-8"	10"	#5 @ 6"	#4 @ 10"	#5 @ 8"	#4 @ 16"
5'-6" - 6'-6"	15"	5'-6"	12"	#5 @ 6"	#4 @ 8"	#6 @ 8"	#4 @ 8"

GRADING CERTIFICATION

I, Rick Beltramo, having conducted a site inspection and directed the collection of as-built survey information, certify the site grading and drainage improvements are substantially complete and in accordance with the approved drainage reports and approved construction plans. This certification does not address construction methods, techniques, performance, or compliance to plan specifications.




TURN 1 CMU BLOCK TO PROVIDE DRAINAGE OPENING THRU WALL AT LOCATIONS PER GRADING PLAN

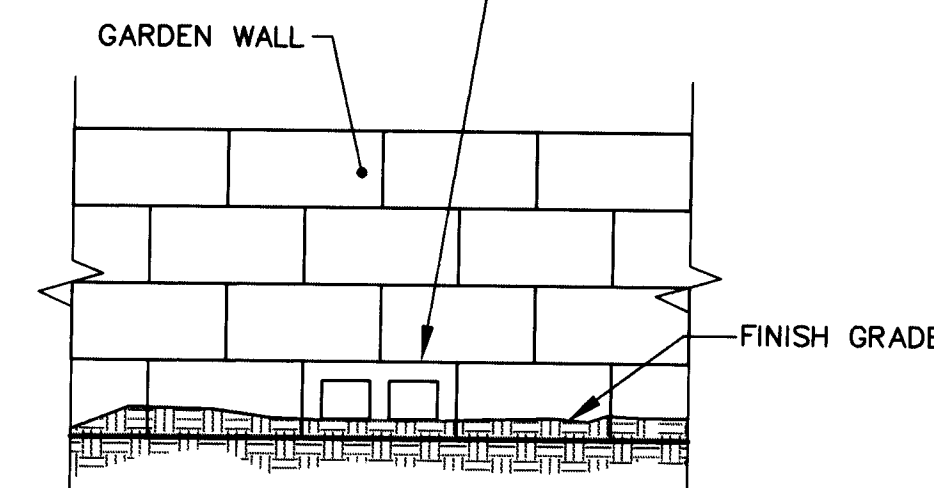


CMU WALL DRAIN DETAIL

NTS

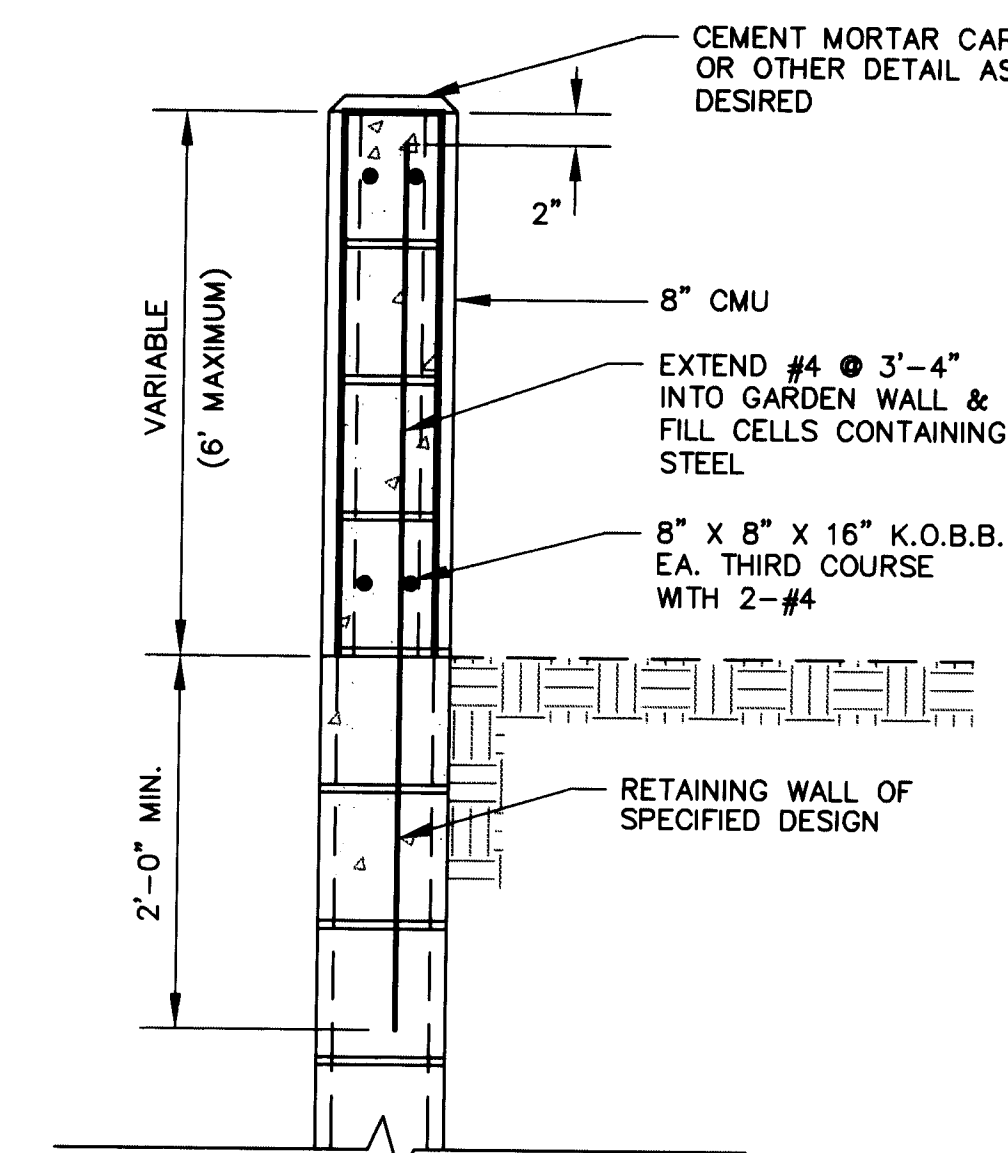

GARDEN WALL EXTENSION

NTS

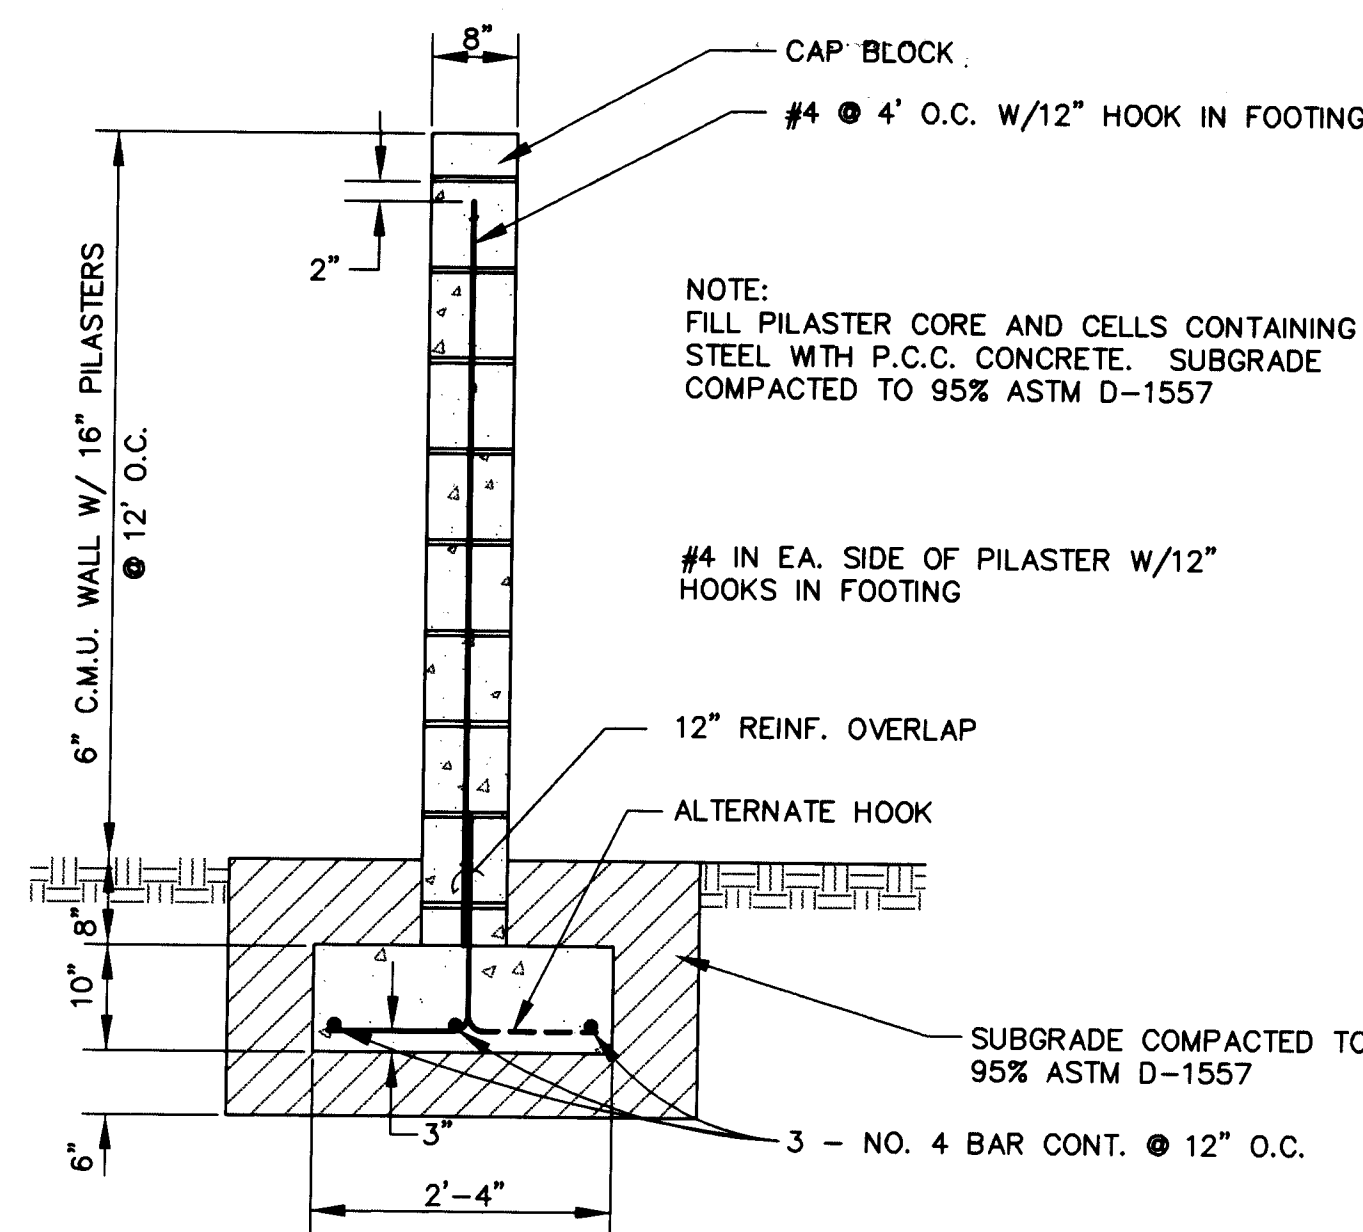

CMU WALL

NTS

RECORD DRAWING CERTIFICATION

I, Rick Beltramo, a registered professional engineer in the state of New Mexico, having directed the collection of as-built survey information, and having collected construction information from the city inspector, the surveyor and the contractor, do hereby certify that record drawing information shown is true and correct to the best of my knowledge. This certification does not address construction methods, techniques, performance, or compliance to plan specifications.



GENERAL NOTES FOR RETAINING WALL

- REINFORCE CLEARANCE IN ALL CMU = 2-3/4" MAX.
- REINFORCE CLEARANCE IN ALL CONCRETE = 2" MIN., UNLESS OTHERWISE NOTED.
- REINFORCE STEEL YIELD STRENGTH = 60 KSI.
- CONCRETE COMP. STRENGTH @ 28 DAYS = 4000 PSI.
- 1/2" FELT EXPANSION JOINT TO BE PROVIDED EVERY 16 FT. IN CMU AND CONCRETE AND AT TRANSITIONS IN SECTIONS.
- USE DUR-O-WALL 9 GA. DIAG. EVERY OTHER COURSE, ON 1'-6" TO 6'-6" CMU RETAINING WALL.
- ALL CMU RETAINING WALL CELLS SHALL BE FILLED WITH CONCRETE.
- ALL FOOTING COMPACTION SHALL BE 95% MODIFIED PROCTOR PER ASTM D-1557.
- TWO (2) WORKING DAYS BEFORE CONSTRUCTION, CONTRACTOR SHALL NOTIFY LINE LOCATING SERVICE, 765-1234, FOR UTILITY LOCATIONS. CONTRACTOR SHALL COORDINATE ANY ADJUSTMENTS TO UTILITIES WITH THE UTILITIES COMPANIES.
- KNOCK OUT BOND BEAMS TO BE INSTALLED EVERY OTHER COURSE UNLESS OTHERWISE NOTED.
- MOISTURE BARRIER COATING SHALL BE APPLIED TO ALL BURIED CMU SURFACES.
- BACK FILLING AGAINST REINFORCED CONCRETE MASONRY RETAINING WALL SHOULD NOT BE PERMITTED UNTIL AT LEAST 7 DAYS AFTER PLACING THE CORE FILL CONCRETE OR GROUT. WHERE HEAVY EQUIPMENT IS USED IN BACK FILLING WALLS DESIGNED TO RESIST EARTH PRESSURE ONLY, SUCH EQUIPMENT SHOULD NOT APPROACH CLOSER TO THE TOP OF THE WALL THAN A DISTANCE EQUAL TO THE HEIGHT OF THE WALL. CARE SHOULD ALSO BE TAKEN TO AVOID EXERTING LARGE IMPACT FORCES ON THE WALL AS COULD BE CAUSED BY A LARGE MASS OF MOVING EARTH.

AVID ENGINEERING, INC.
Civil • Structural • Transportation

6100 Seagull St. NE - Suite 102
Albuquerque, NM 87109 - (505) 881-5357

26 4663.900994



CITY OF ALBUQUERQUE
PUBLIC WORKS DEPARTMENT
ENGINEERING GROUP

TITLE: SUN TERRACE AT PEPPERTREE
WALL DETAILS

APPROVALS	ENGINEER	DATE	APPROVALS	ENGINEER	DATE
D.R.C. Chair	<i>[Signature]</i>	5-13-93	Water	<i>[Signature]</i>	4-26-93
Transportation	<i>[Signature]</i>	4-29-93	Waste Water	<i>[Signature]</i>	4-26-93
Hydrology	<i>[Signature]</i>	4-29-93			

DRAWING NO.	MAP NO.	SHEET OF
4663.90	E-22-Z	9 OF 9

SCANNED BY LASON

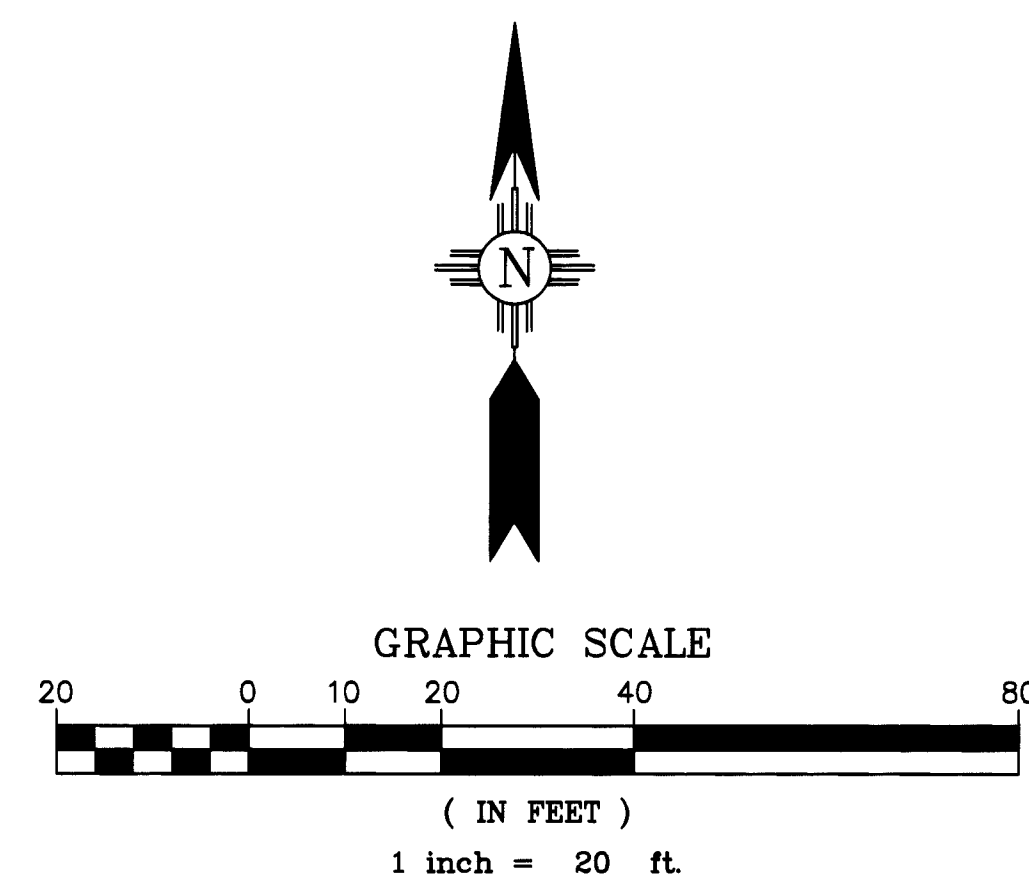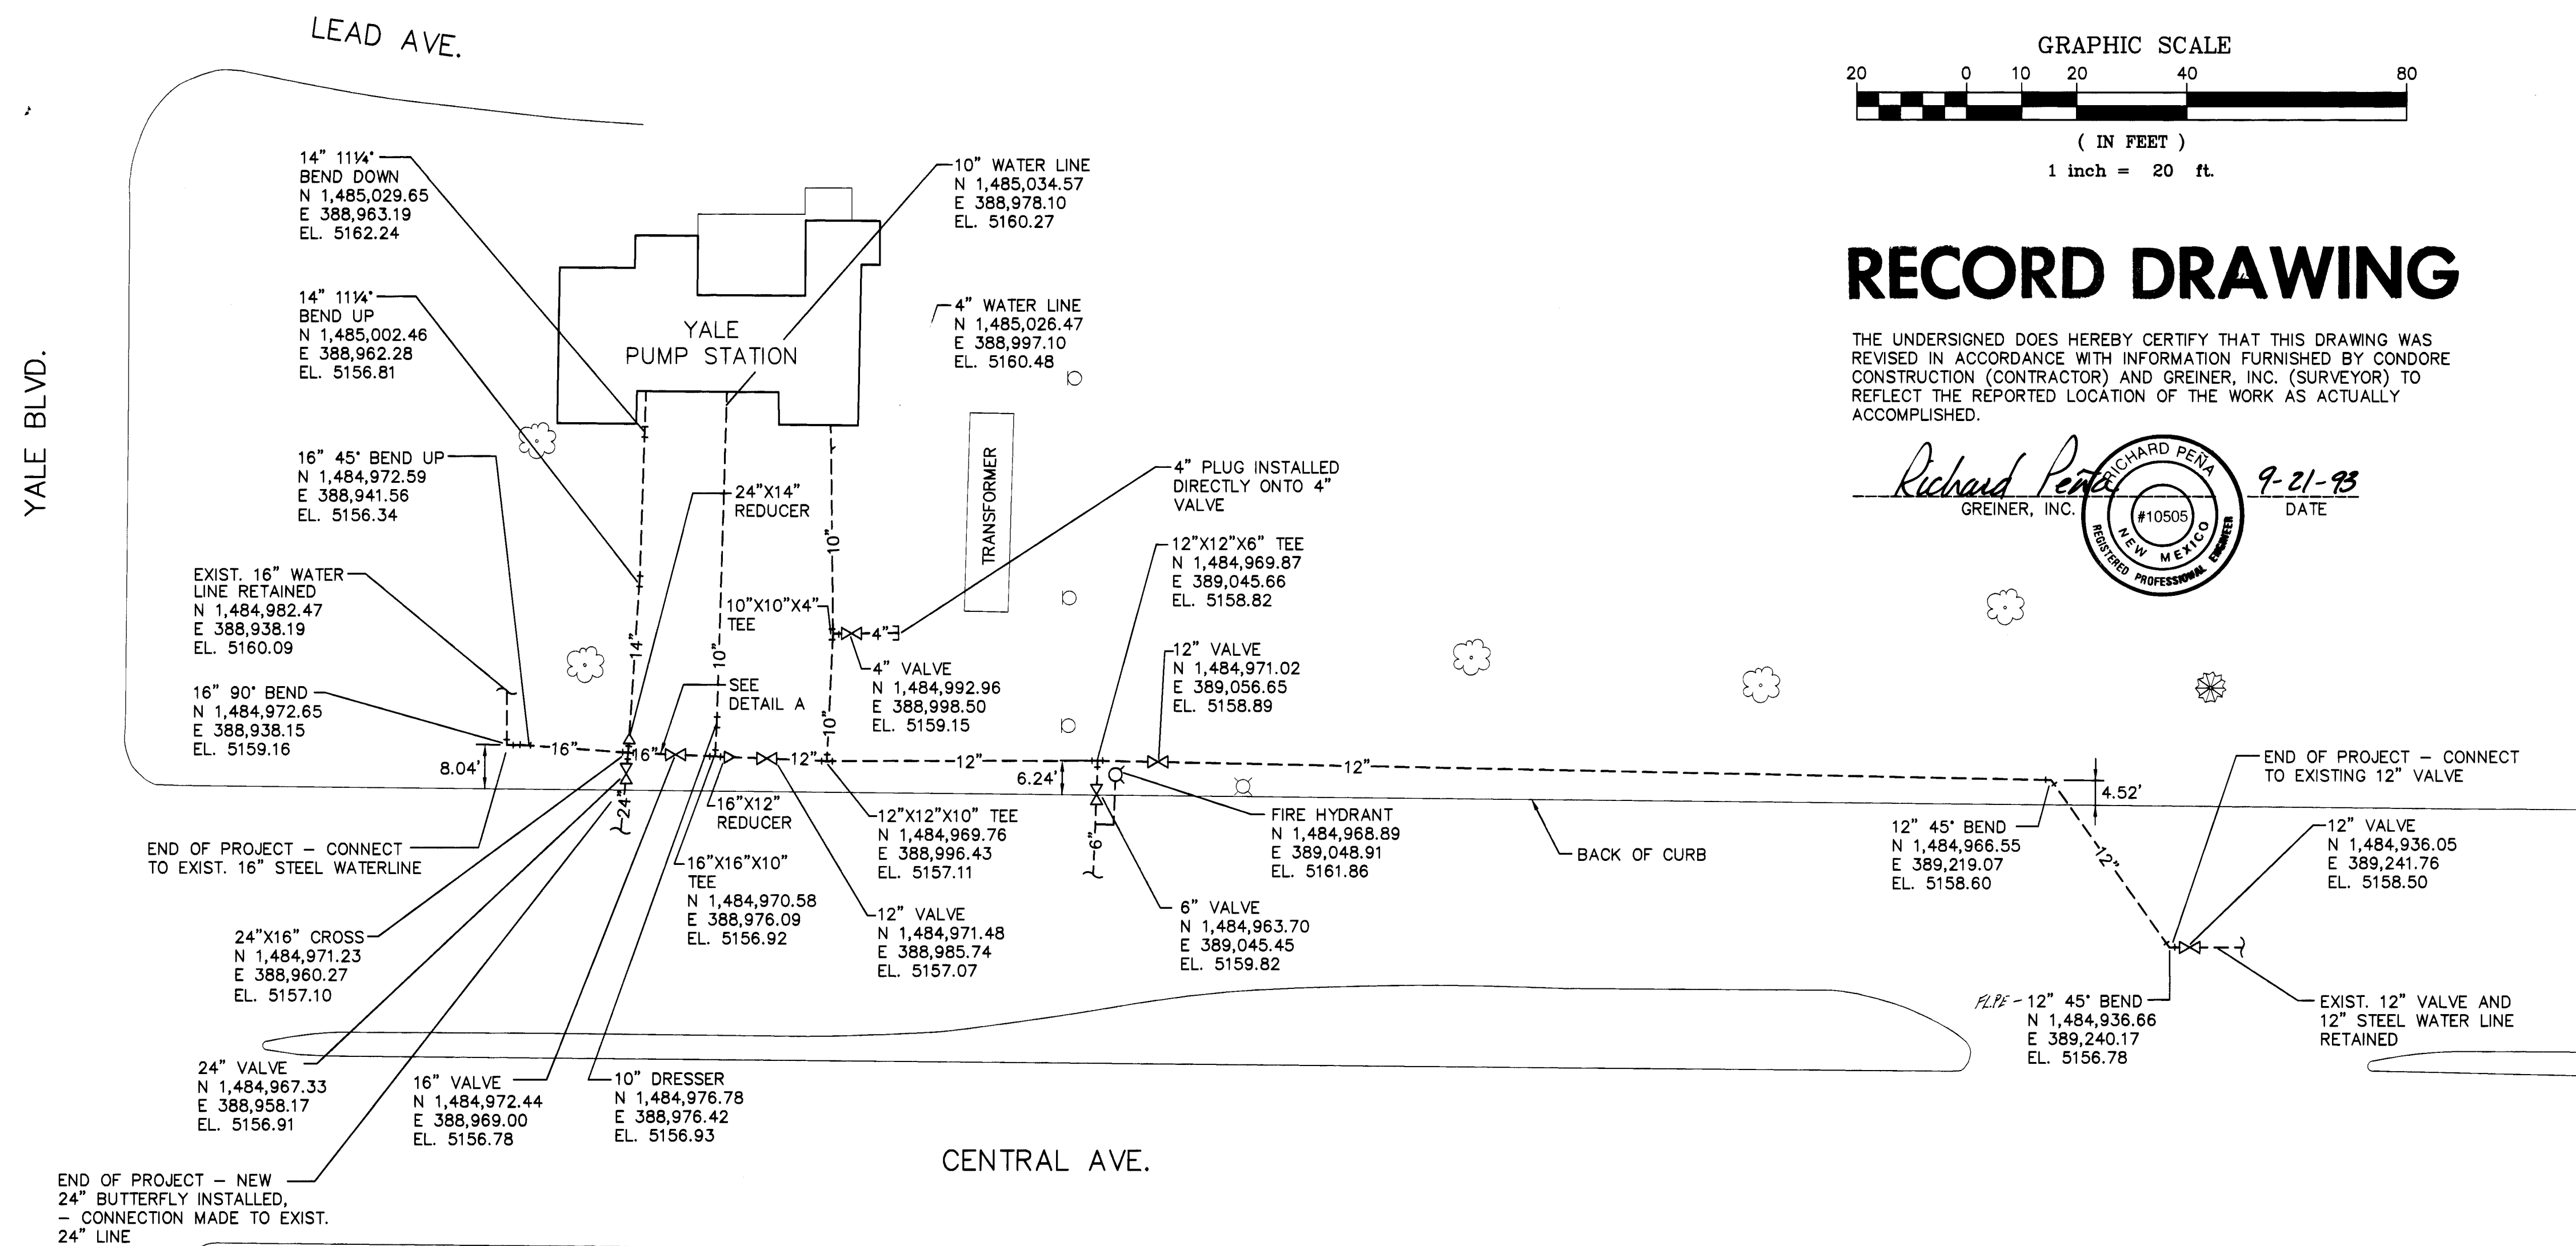

THE UNDERSIGNED DOES HEREBY CERTIFY THAT THIS DRAWING WAS
REVISED IN ACCORDANCE WITH INFORMATION FURNISHED BY CONDORE
CONSTRUCTION (CONTRACTOR) AND GREINER, INC. (SURVEYOR) TO
REFLECT THE REPORTED LOCATION OF THE WORK AS ACTUALLY
ACCOMPLISHED.

NOTES:

1. THE STATE PLANE COORDINATES SHOWN AT ALL BENDS AND FITTINGS ARE INITIATED FROM ACS STATIONS "16-K-16" AND "6-K-15". BEARINGS SHOWN ARE GRID BEARINGS, DISTANCES ARE GROUND DISTANCES. (USE ACS STATION ELEVATIONS FOR BENCHMARKS).
2. ALL EXISTING STEEL WATER LINES BETWEEN THE PUMP STATION AND CENTRAL AVENUE WERE REMOVED AND DISPOSED OF IN THIS PROJECT.
3. THIS RECORD DRAWING WAS COMPLETED UNDER A/E CONTRACT NO. 4335.

ENGINEER'S SEAL				SURVEY INFORMATION			BENCH MARKS		AS BUILT INFORMATION	
				FIELD NOTES						
				NO.	BY	DATE	ACS 16-K-16 1001			
				1909	W. MARQUIS	4/26/93	ELEV. 5160.668 FEET			
				1909	K. YOUNG	4/27/93				
			REMARKS	1909	K. YOUNG	4/29/93	ACS 6-K-15 1000			
			REVISIONS	1909	K. YOUNG	4/29/93	ELEV. 5160.768 FEET			
			DESIGN	1909	W. MARQUIS	5/3/93				
				1909	W. MARQUIS	5/4/93				
			DESIGNED BY:	1909	K. YOUNG	5/5/93				
			DRAWN BY:	1909	D. OTTANIEL	5/10/93				
			CHECKED BY:							
			DATE:							
			DATE:							
			PROJECT NO.							

RICHARD PENICK
NEW MEXICO
#10506
REGISTERED PROFESSIONAL ENGINEER

Greiner, Inc.

CITY OF ALBUQUERQUE
PUBLIC WORKS DEPARTMENT
ENGINEERING DIVISION

TITLE: YALE PUMP STATION
WATER LINE REPLACEMENT

APPROVALS	ENGINEER	DATE	APPROVALS	ENGINEER	DATE
DRC Chairman			Water		
Transportation			Waste Water		
Hydrology					

DRAWING NO.	4652.90	MAP NO.	K-16N	SHEET	1	OF	1
-------------	---------	---------	-------	-------	---	----	---

SCANNED BY
BY LASON