
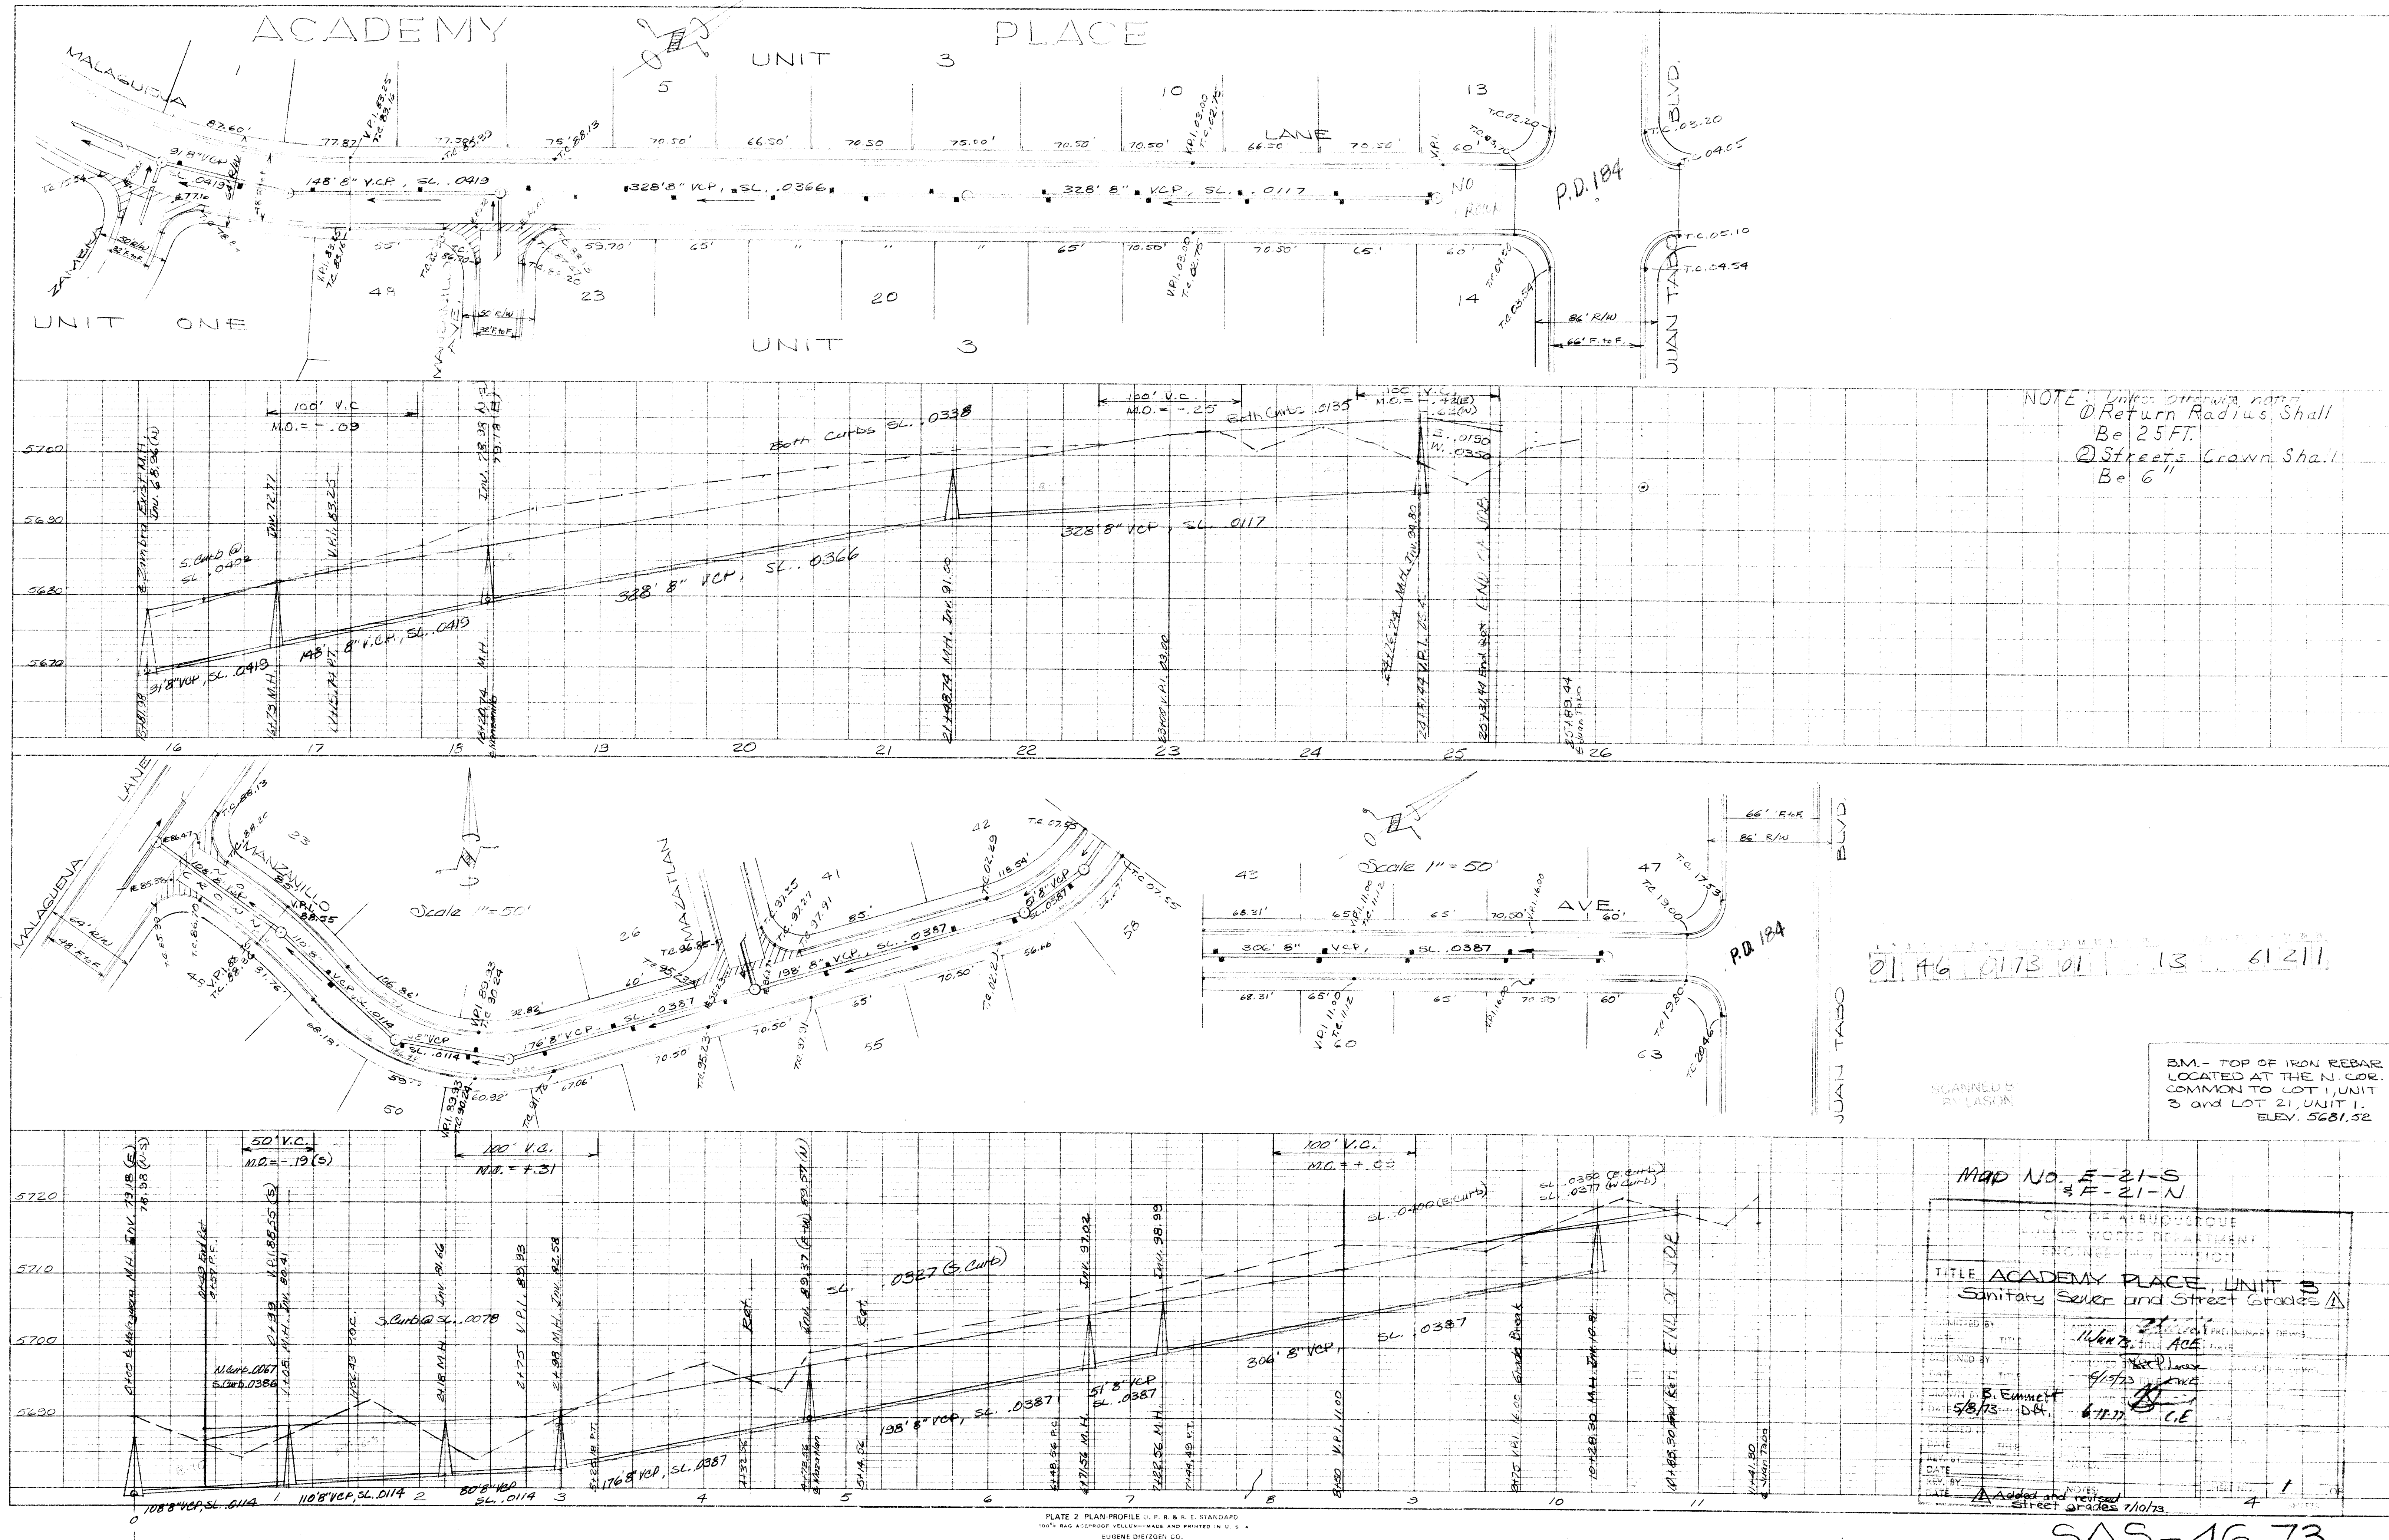


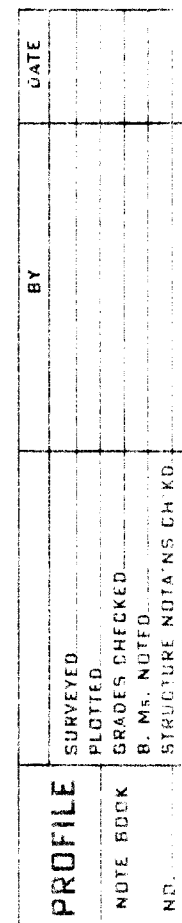

NOTE: Unless otherwise noted
 ① Return Radius Shall
 Be 25 FT.
 ② Streets Crown Shall
 Be 6"

B.M. - TOP OF IRON REBAR
LOCATED AT THE N. COR.
COMMON TO LOT 1, UNIT
3 and LOT 21, UNIT 1.
ELEV. 5681.52

MAD NO. E-21-S
F-21-N

CITY OF ALBUQUERQUE
PUBLIC WORKS DEPARTMENT
ENGINEERING DIVISION

TITLE ACADEMY PLACE, UNIT B
Sanitary Sewer and Street Grades **A**

DESIGNED BY _____
CHECKED BY _____
DATE _____
REV. BY _____
DATE _____
APPROVED BY _____
DATE _____

1/6/73 AOE
4/5/73 [Signature]
5/8/73 B. Emmett D.E.
6/1/73 C.E.









Added and revised
Street grades 7/10/73

SHEET NO. 1 OF 1

SAS-46-73

PLAN	DATE	BY	DATE	BY
NOTED				
REVISIONS				
NO.	DATE	BY	DATE	BY
1				

PROFILE	DATE	BY	DATE	BY
NOTED				
REVISIONS				
NO.	DATE	BY	DATE	BY
1				

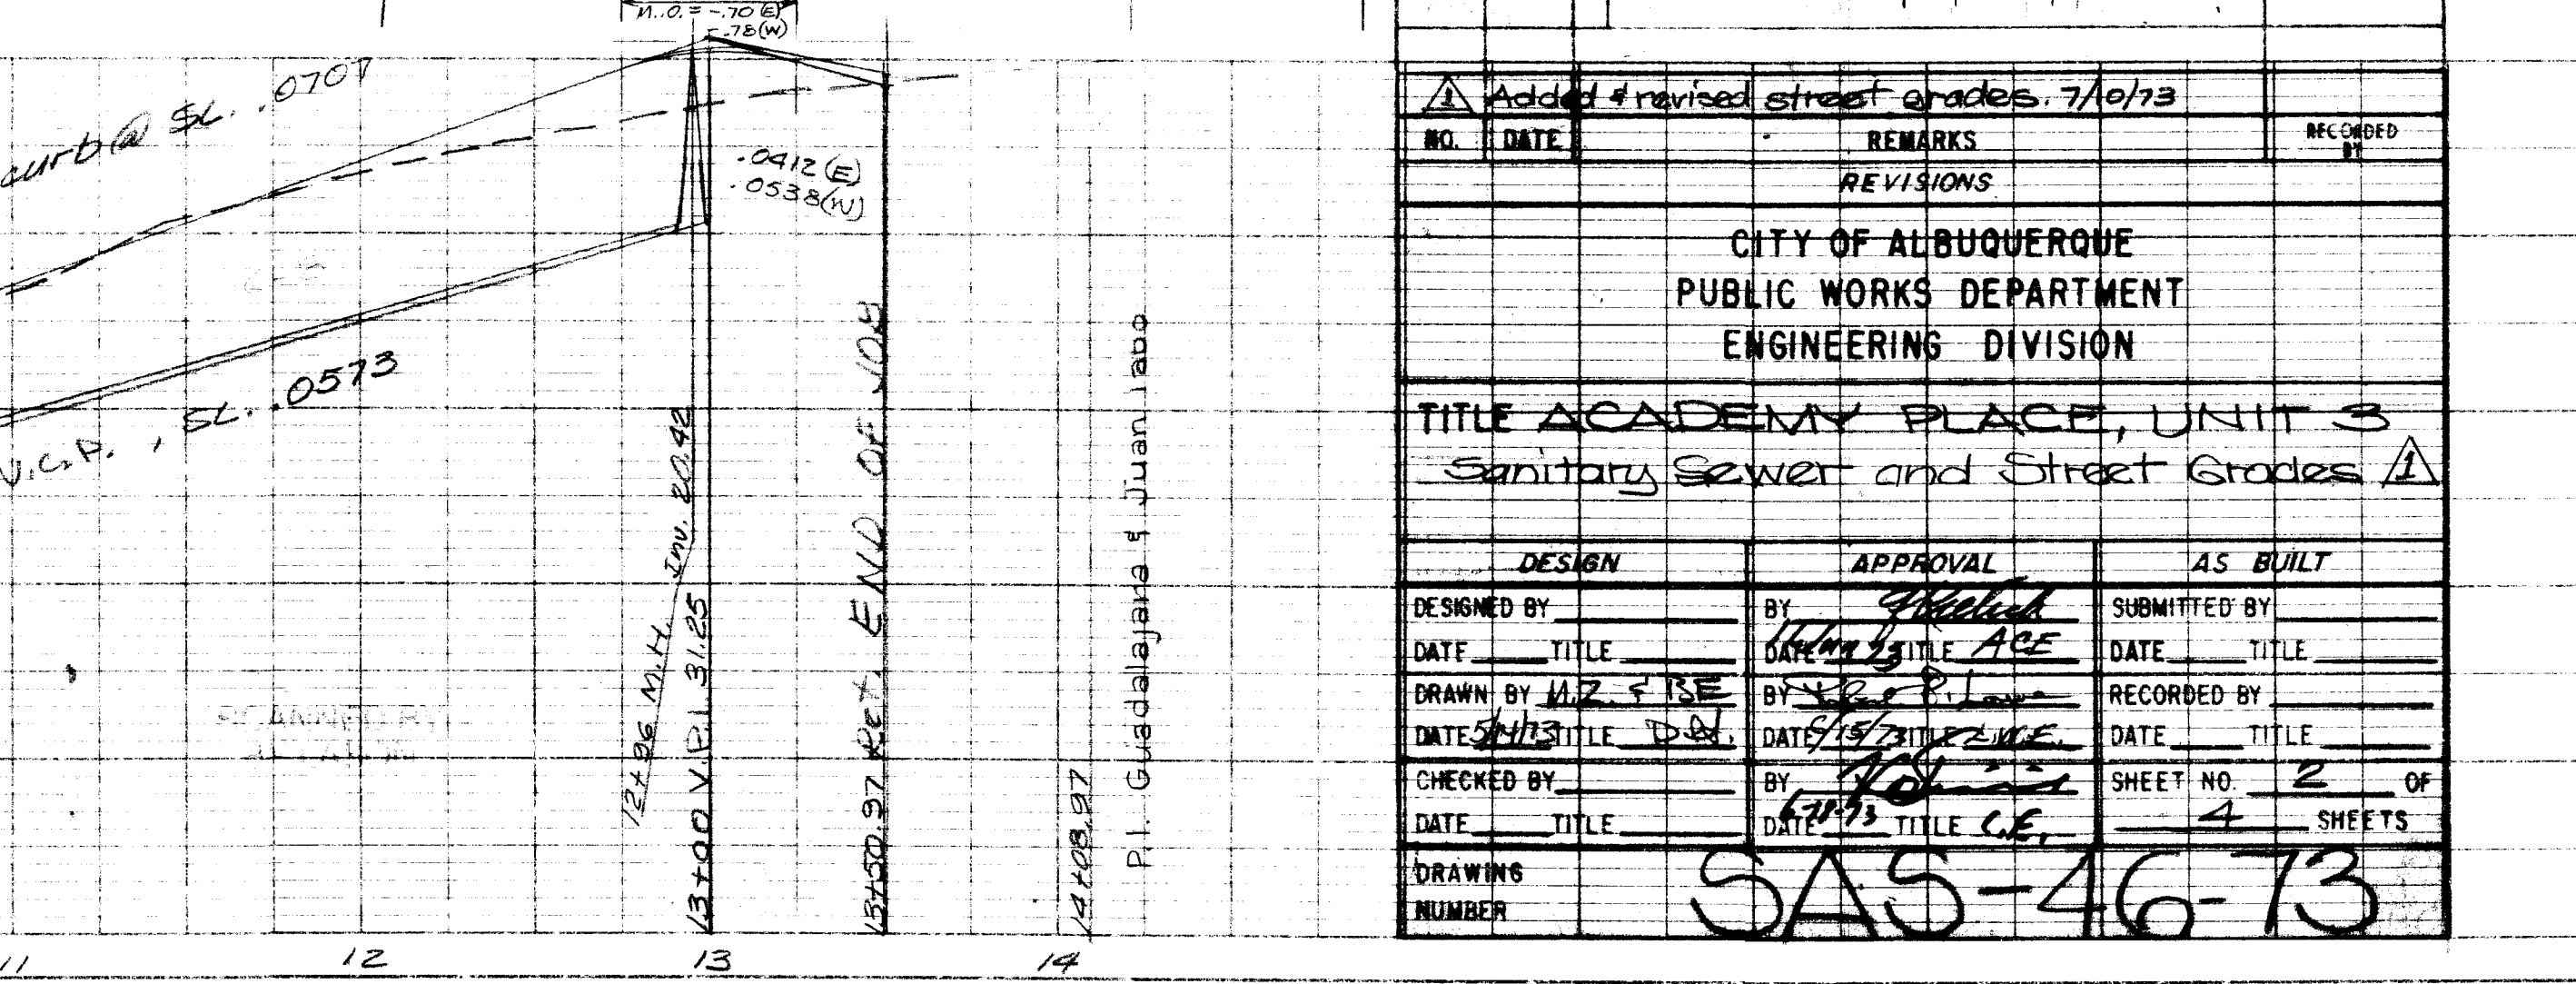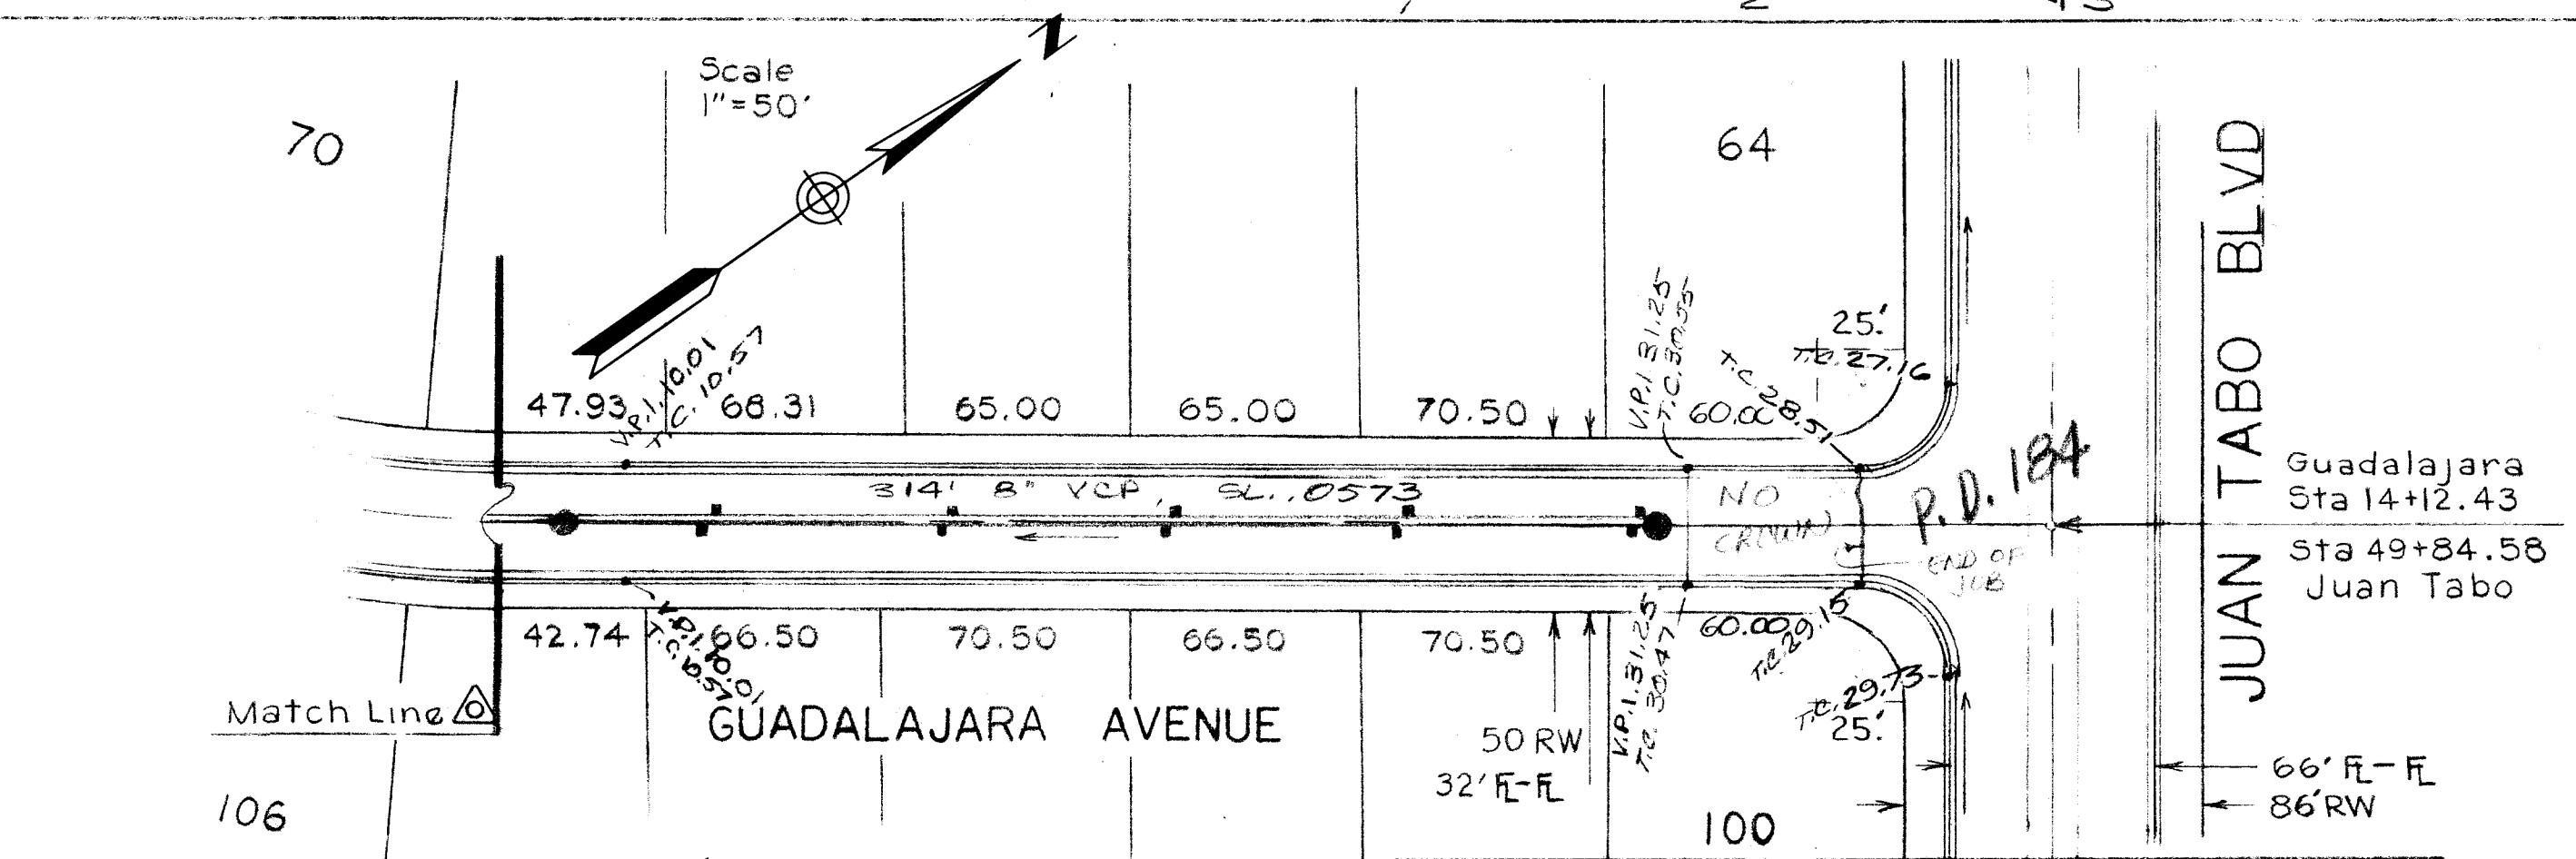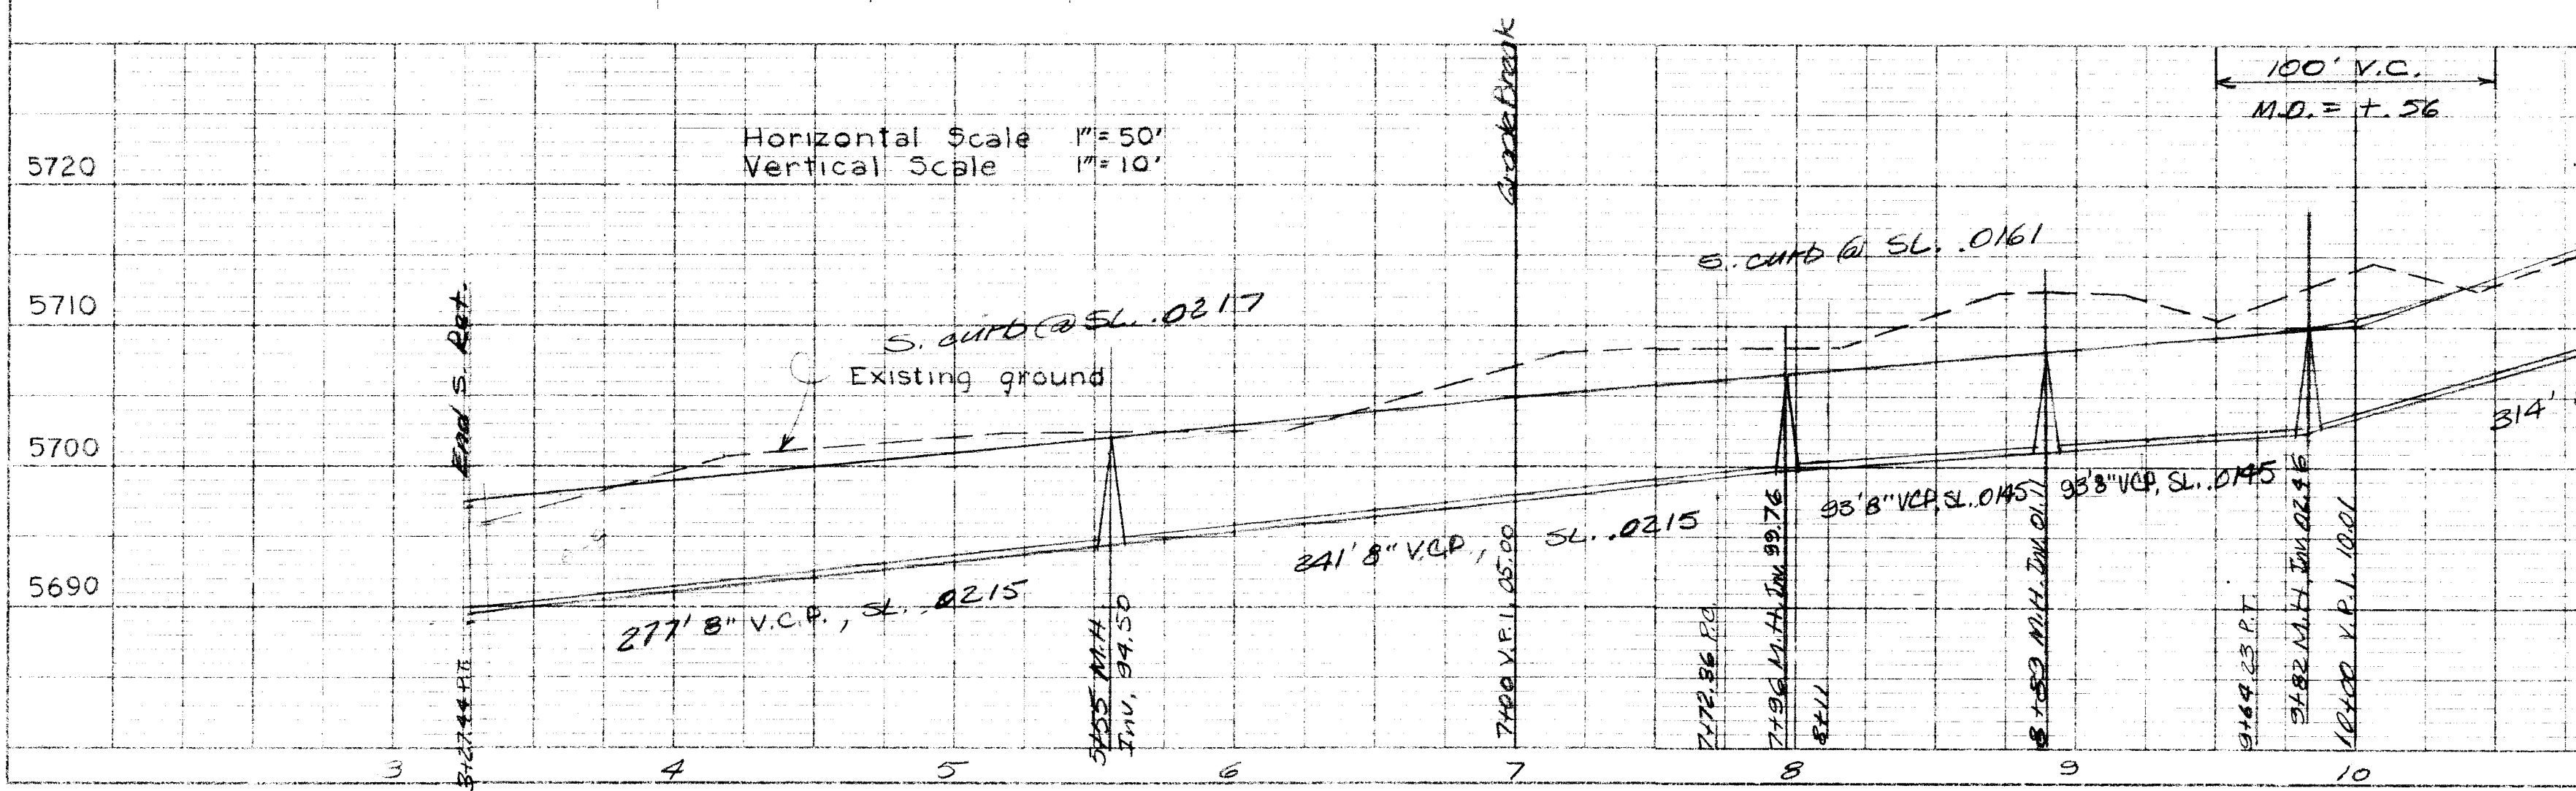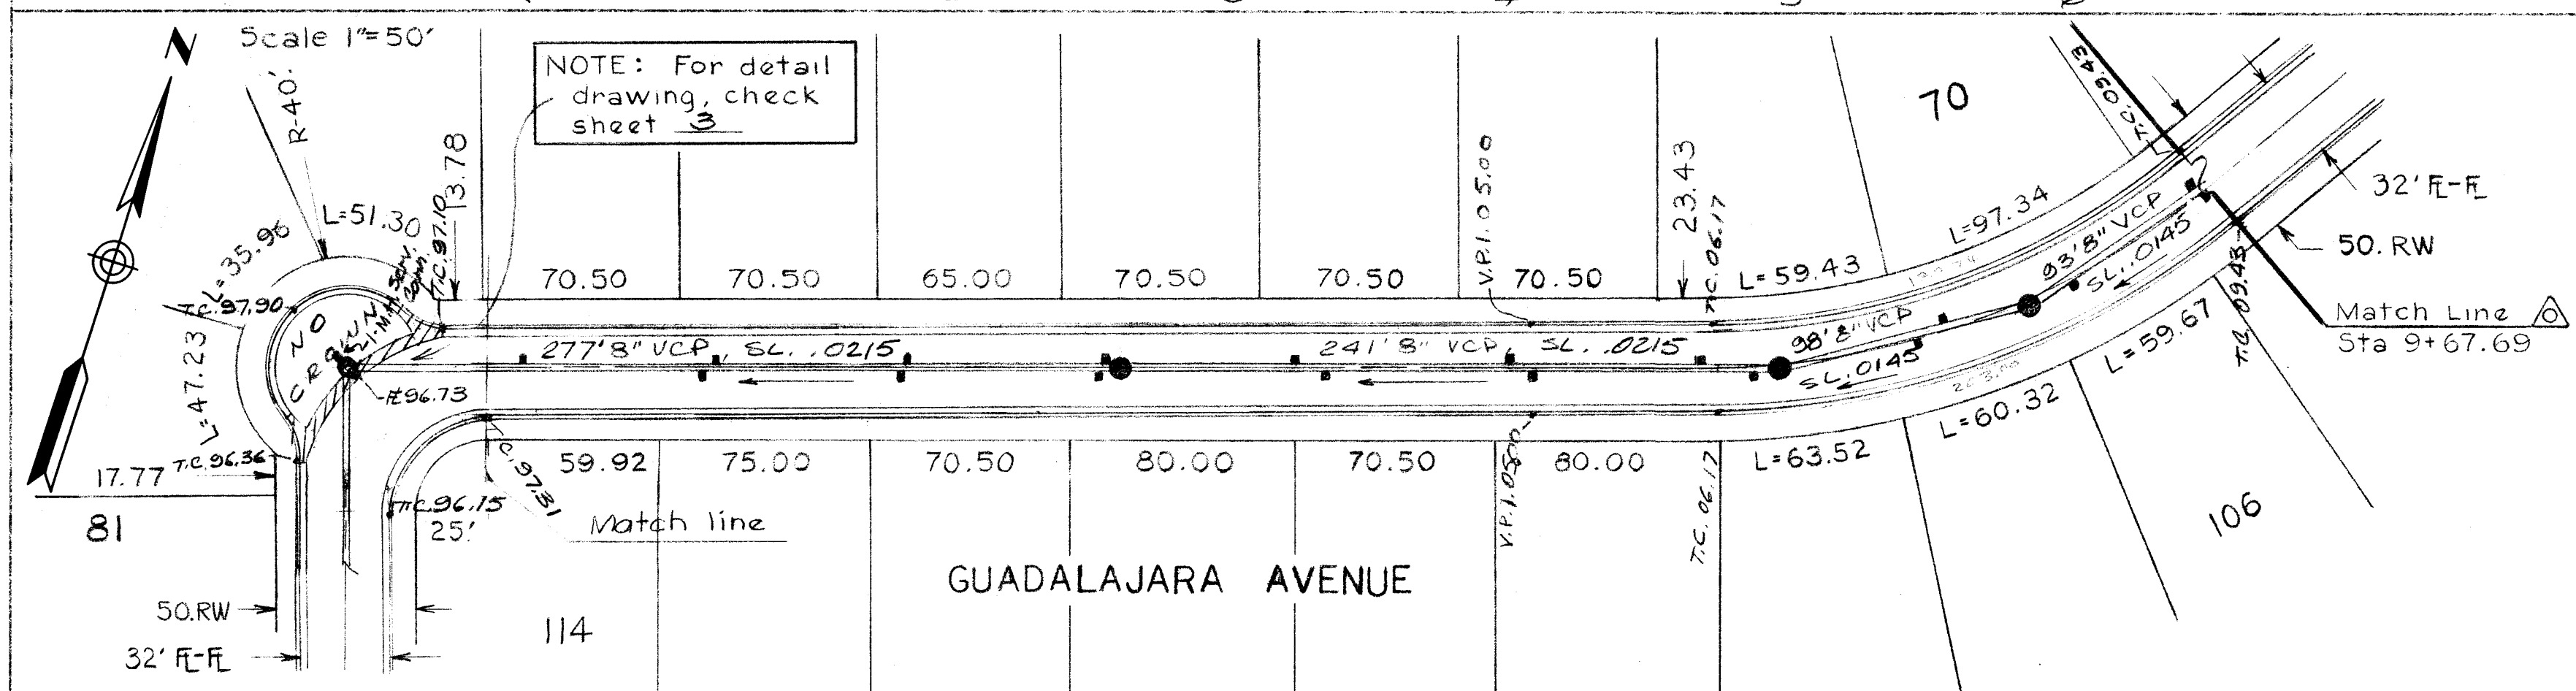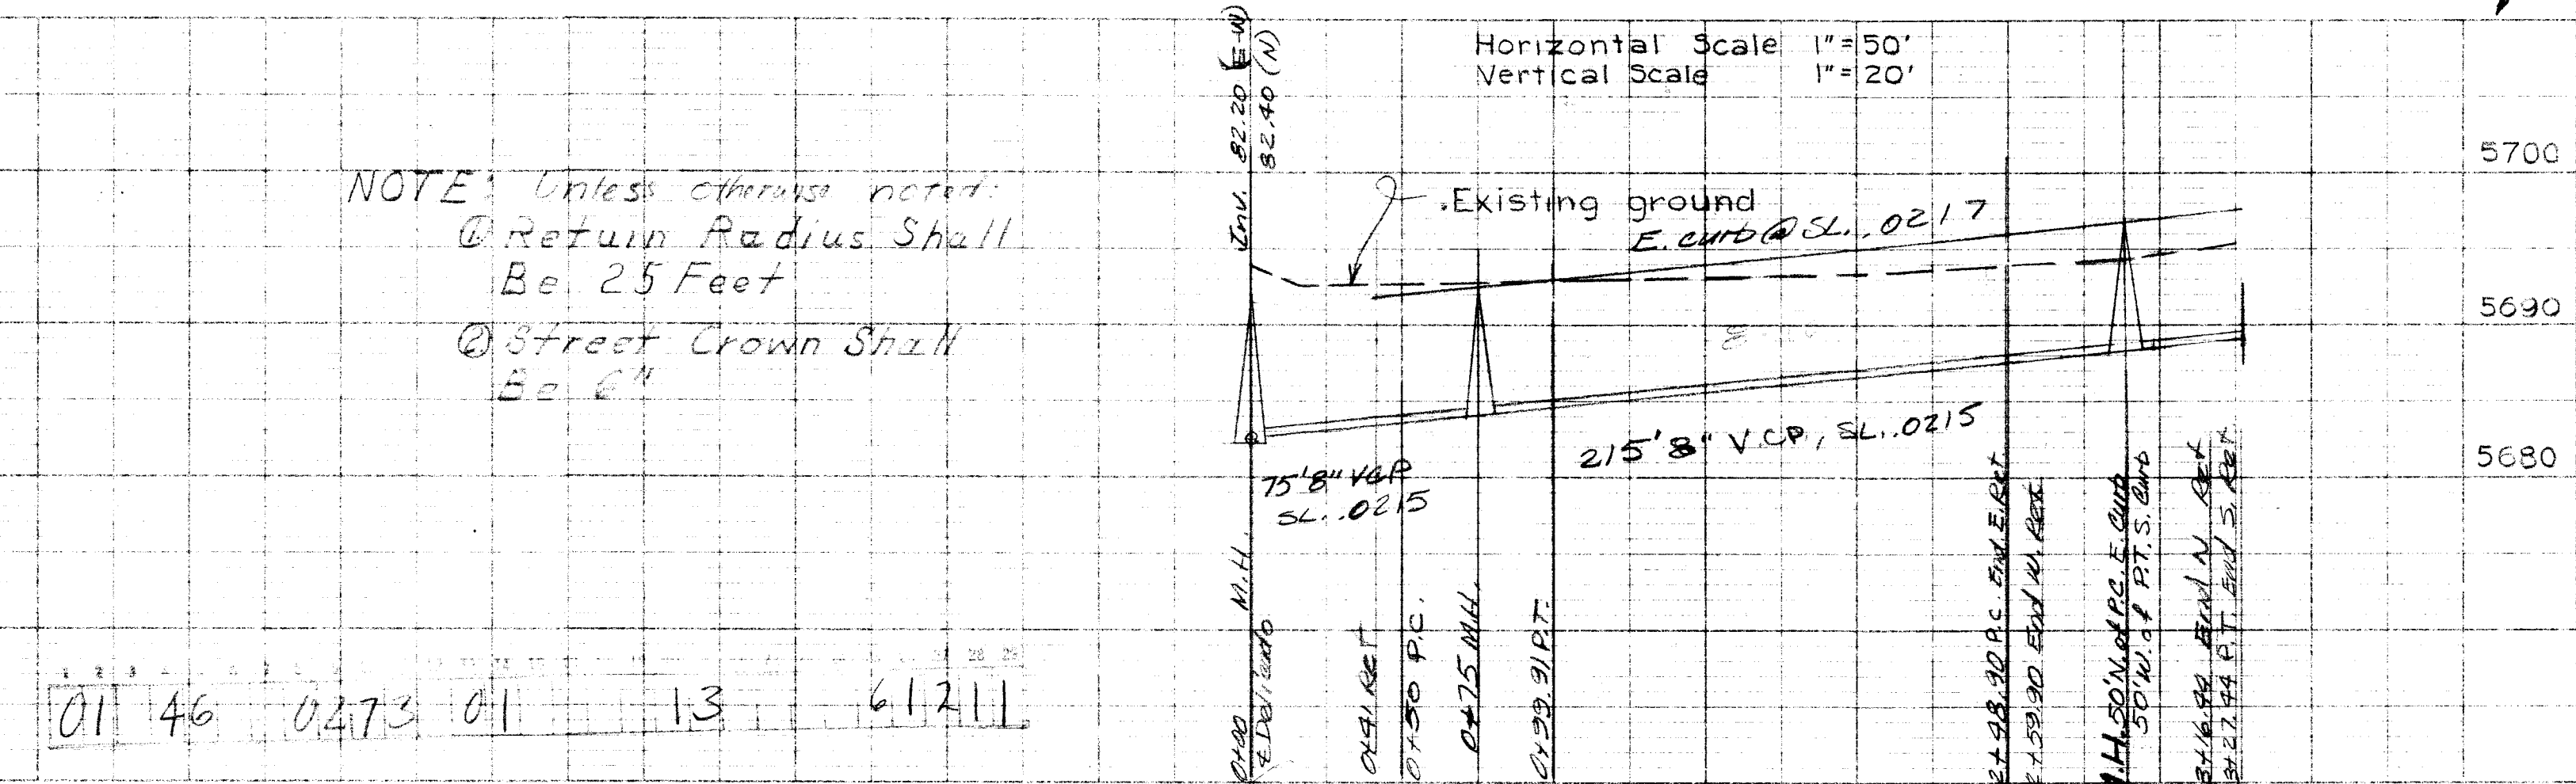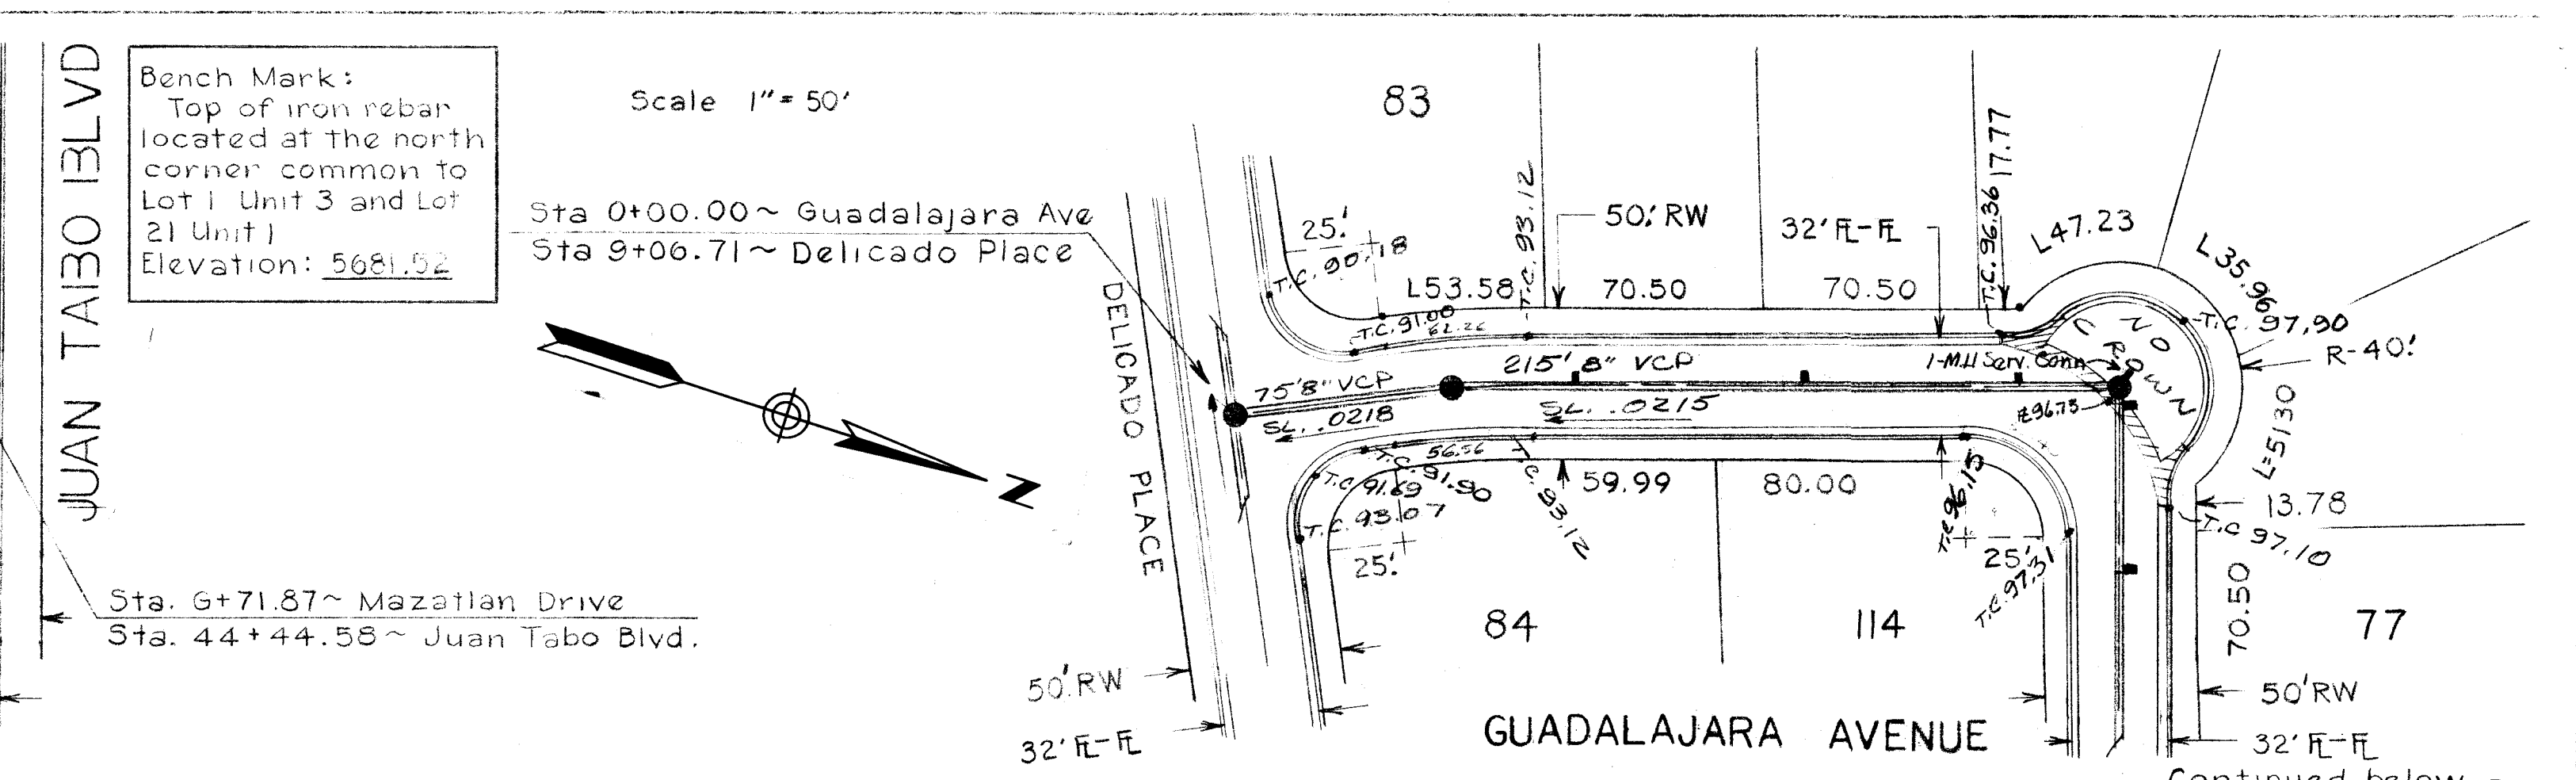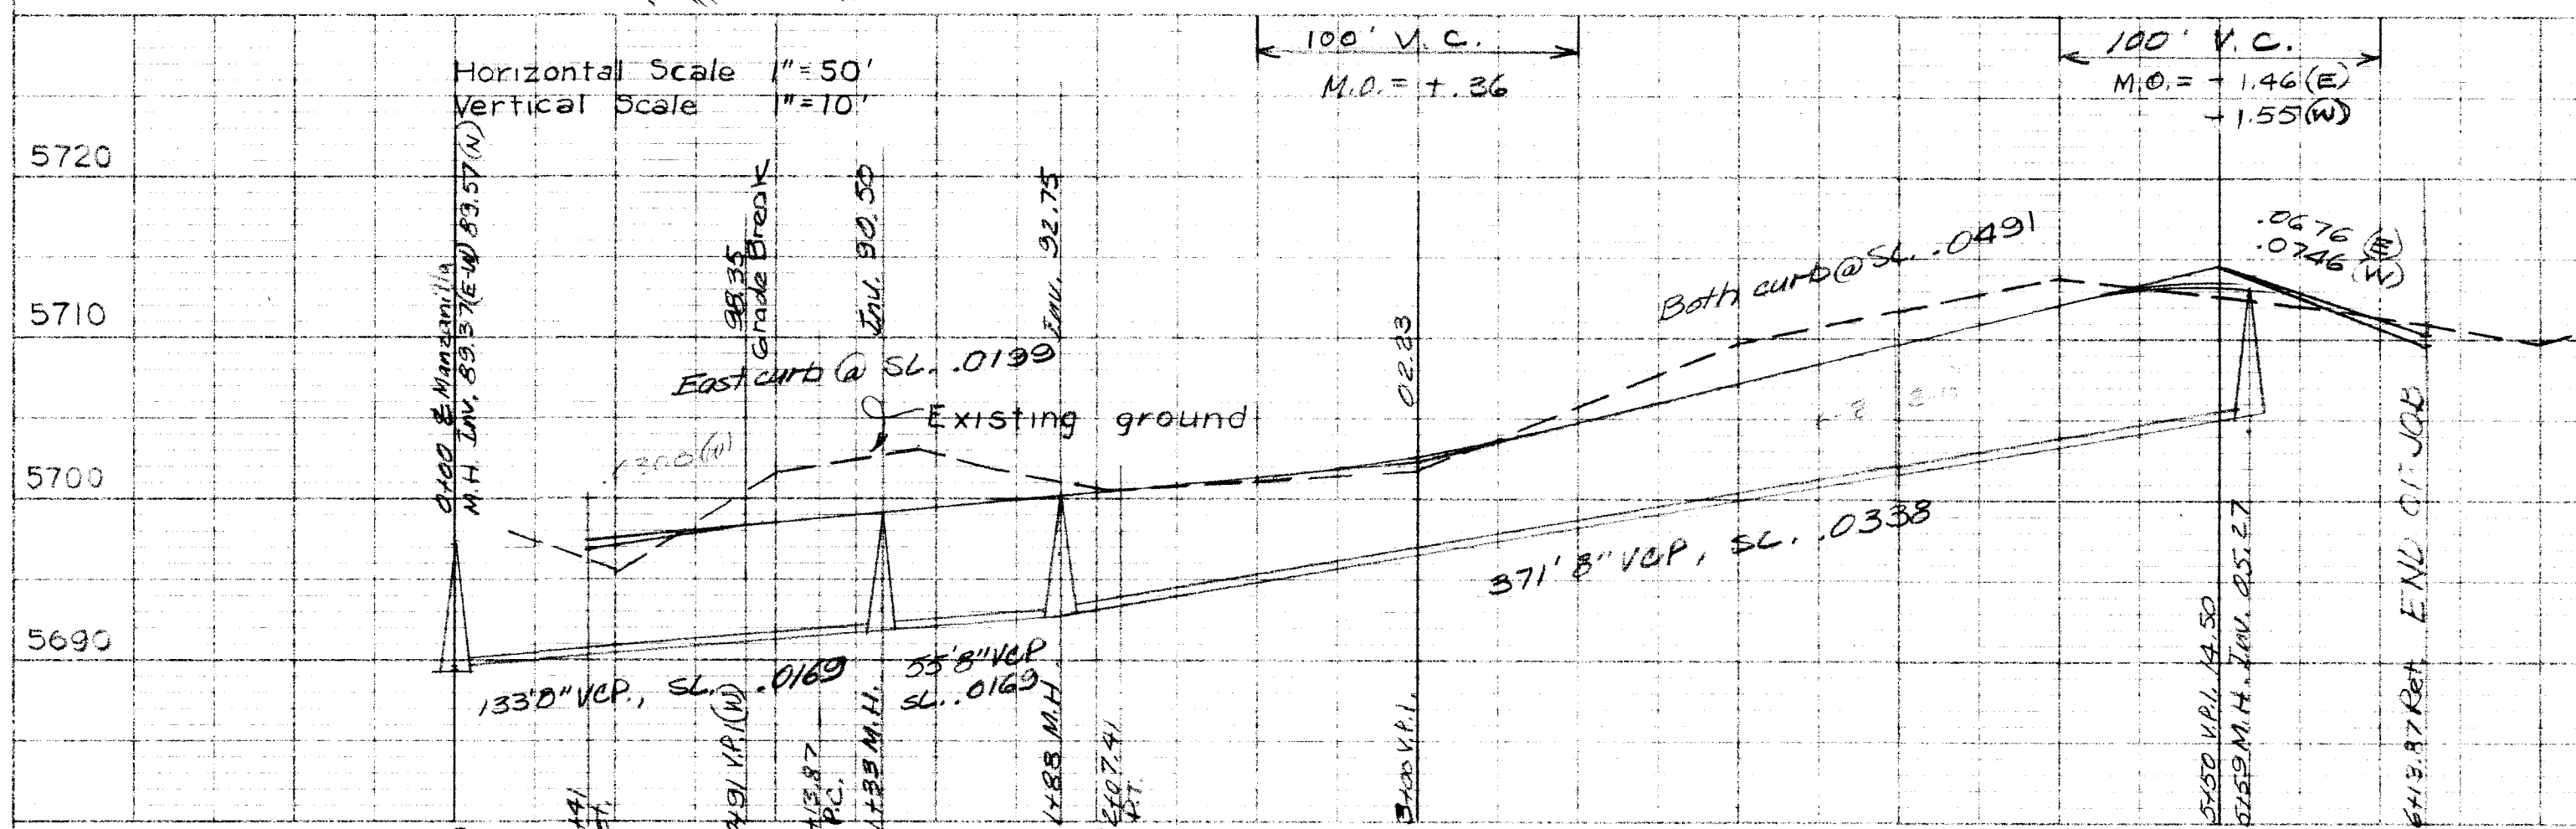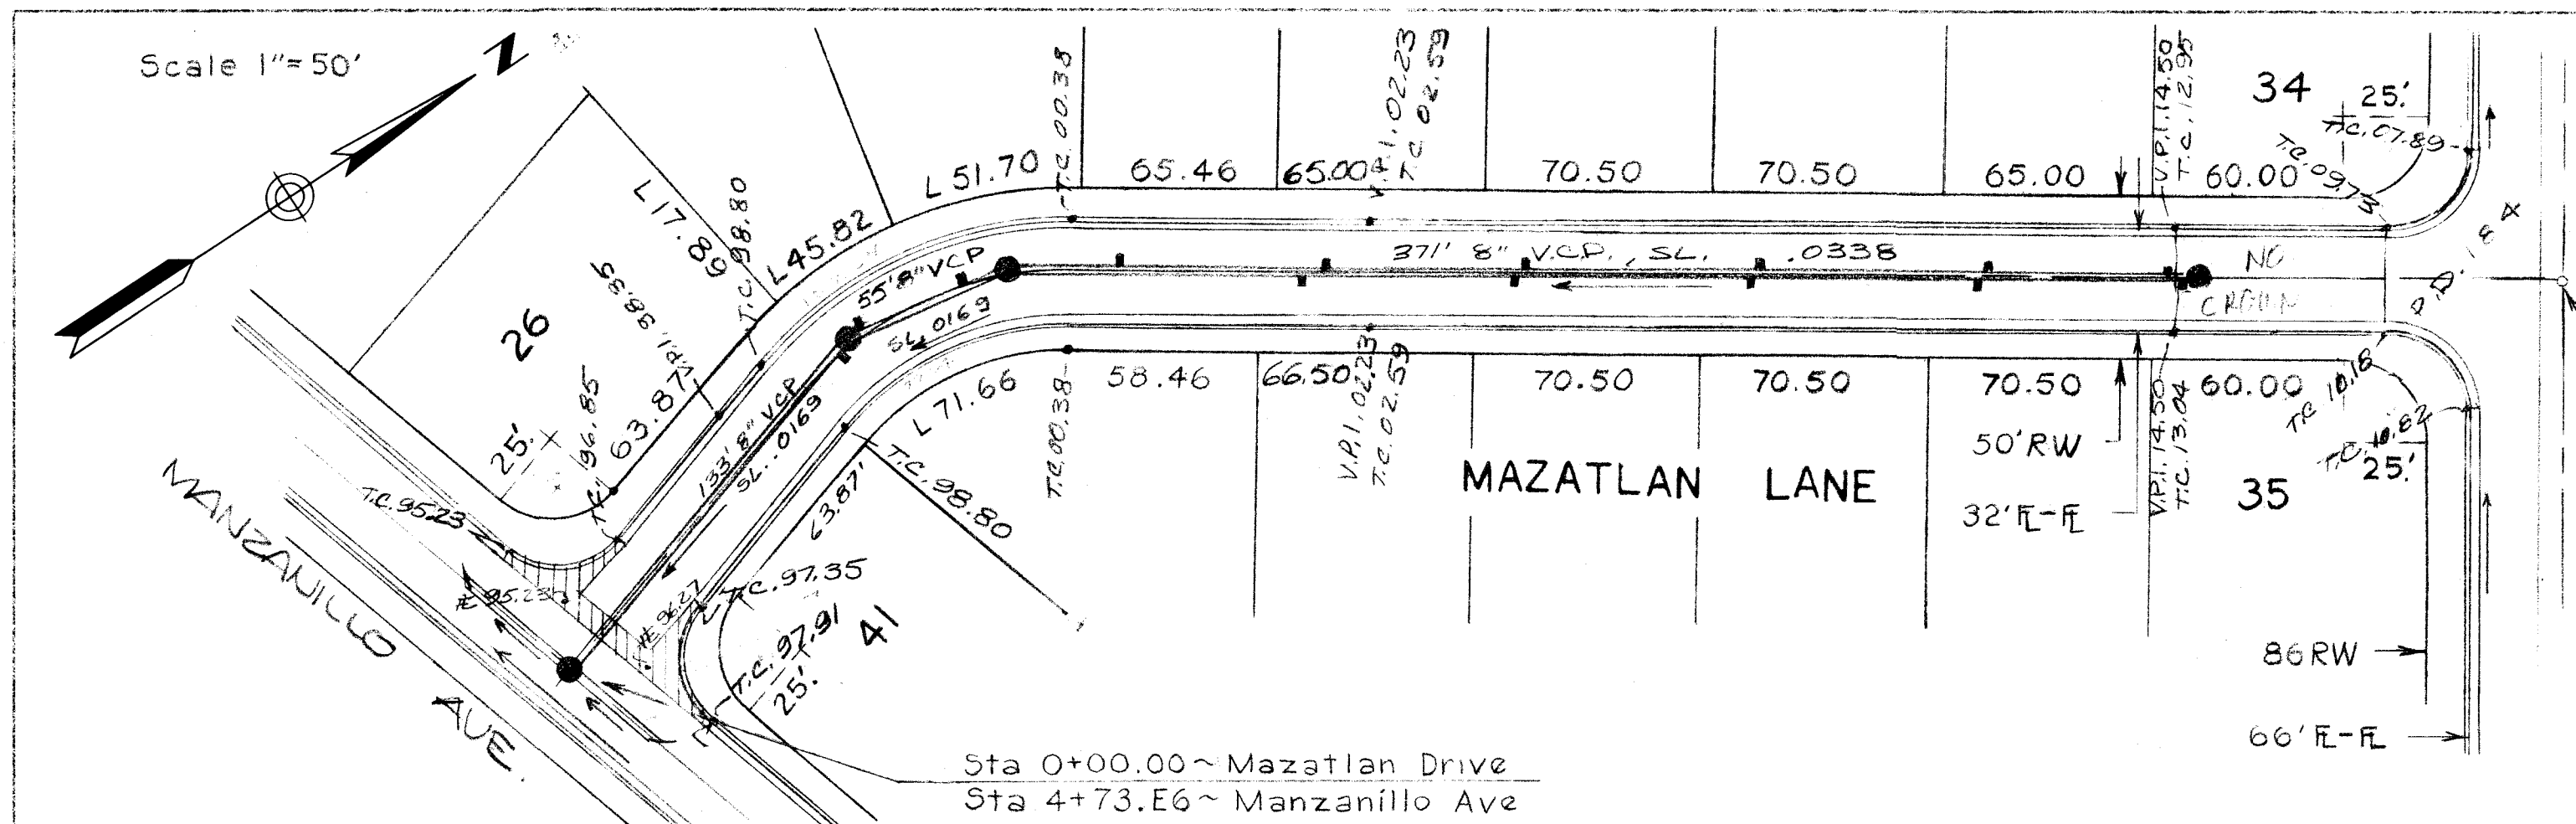


CITY OF ALBUQUERQUE PUBLIC WORKS DEPARTMENT ENGINEERING DIVISION			
TITLE ACADEMY PLACE, UNIT 3 Sanitary Sewer and Street Grades			
DESIGN	APPROVAL	AS BUILT	
DESIGNED BY: <u>W. F. R.</u>	BY: <u>W. F. R.</u>	SUBMITTED BY: <u>W. F. R.</u>	
DATE: <u>1/15/73</u>	DATE: <u>1/15/73</u>	DATE: <u>1/15/73</u>	
DRAWN BY: <u>W. F. R.</u>	BY: <u>W. F. R.</u>	RECORDED BY: <u>W. F. R.</u>	
DATE: <u>1/15/73</u>	DATE: <u>1/15/73</u>	DATE: <u>1/15/73</u>	
CHECKED BY: <u>W. F. R.</u>	BY: <u>W. F. R.</u>	SHEET NO. <u>2</u> OF <u>4</u>	
DATE: <u>1/15/73</u>	DATE: <u>1/15/73</u>		
DRAWING NUMBER: <u>SA5-46-73</u>			

PLATE 2 PLAN-PROFILE OF 14" & 18" STANDARD
100% R.C. AND 100% C.C. - MADE AND PRINTED IN U.S.A.
ENGINEERING CO.

Map No. E-21-S
F-21-N

PLAN	SURVEYED PLOTTER NOTE BOOK NO.	BY	DATE

PROFILE	SURVEYED PLOTTER NOTE BOOK NO.	BY	DATE

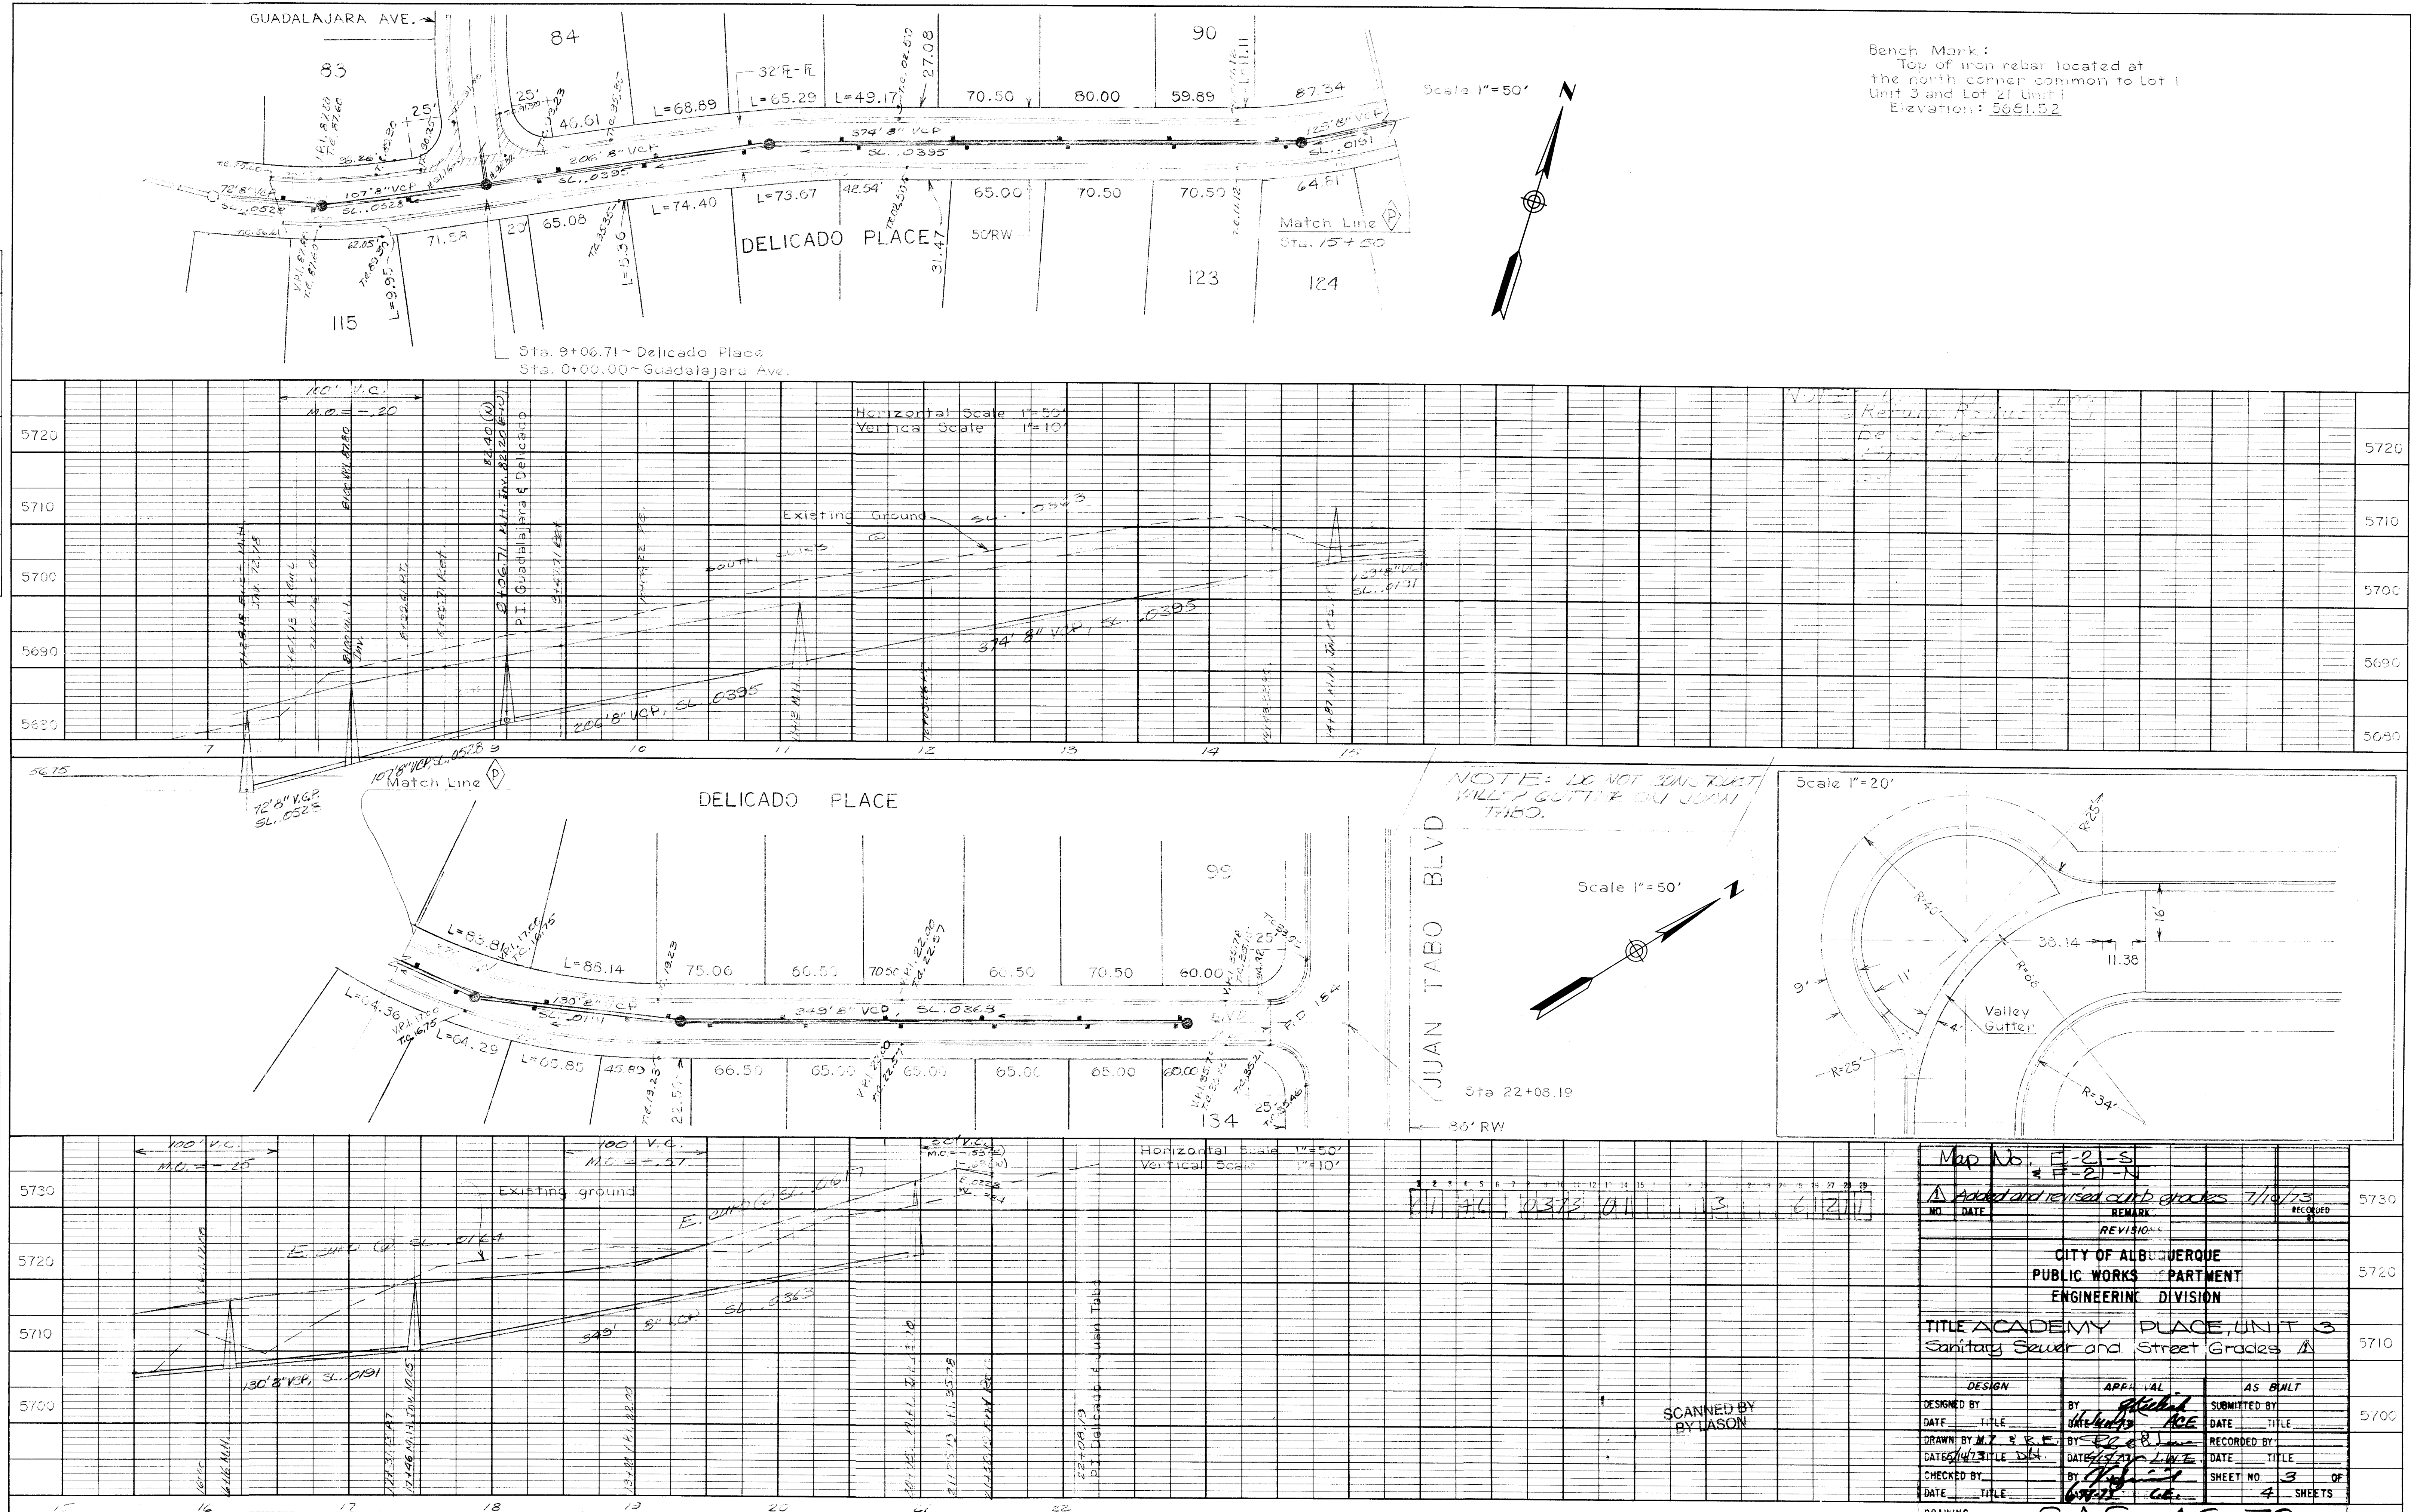

PLAN	DATE	BY	CHKD	APP'D
DESIGNED				
DRAWN				
CHECKED				
APPROVED				
NOTED				
REVISIONS				
NO.				

PROFILE	DATE	BY	CHKD	APP'D
DESIGNED				
DRAWN				
CHECKED				
APPROVED				
NOTED				
REVISIONS				
NO.				

NO.	DATE	REVISIONS	RECORDED
1			
2			
