THE MEADOWS ON RIO GRANDE UNIT TWO

ALBUQUERQUE, NEW MEXICO

AUGUST 1993

GENERAL NOTES

- 1. All work detailed on these plans to be performed under contract shall, except as otherwise stated or provided for hereon, be constructed in accordance with the City of Albuquerque Standard Specifications for Public Works Construction 1986 Edition as amended with Update No. 4.
- 2. Prior to construction, the Contractor shall excavate & verify the horizontal and vertical locations of all obstructions. Should a conflict exist, the Contractor shall notify the Engineer so that the conflict can be resolved with minimum delay.
- 3. Two (2) working days prior to any excavation, Contractor must contact Line Locating Service @ 260—1990 for location of existing utilities.
- Contractor shall support all existing, underground utility lines which become exposed during construction. Payment for supporting work shall be incidental to water line and/or sewerline costs.
- 5. All water line stationing refers to survey centerline stationing.
- 6. Contractor shall conduct his operations in a manner which will minimize interference with local traffic. Contractor shall comply with all applicable laws, ordinances, rules, regulations, and orders of any public body having juris—diction for the safety of persons or property, and to protect them from damage, injury, or loss. Contractor shall erect and maintain, as required by the conditions and progress of the work, all necessary safeguards for safety continuously and not limited to normal working hours, throughout the duration of the project. Contractor shall adhere to Section 19 of the General Conditions of the City of Albuquerque Standard Specifications for Public Works Construction, 1986.
- 7. The Contractor agrees that he shall assume the sole and complete responsibility for the job site conditions during the course of construction of this project, including safety of all persons and property; that this requirement shall apply continuously and not be limited to normal working hours; and that the Contractor shall defend, indemnify, and hold harmless the Owner & Engineer from any and all liability real or alleged, in connection with the performance of work on this project, excepting liability arising from the sole negligence of the Owner or Engineer.
- 8. Proposed waterline materials shall be either PVC pipe meeting AWWA C900 requirements (6"-12") or ductile iron pipe, thickness class 50 (6"-16").
- 9. There are existing walls located adjacent to this project. Any walls damaged or removed by the Contractor during the construction activities shall be reinstalled or replaced by the Contractor to an equal or better condition at no additional cost to the Owner.
- 10. TRAFFIC CONTROL: Three (3) working days prior to beginning construction the Contractor shall submit to the Construction Co—ordination Division a detailed construction schedule. Two (2) working days prior to construction the Contractor shall obtain a barricading permit from the Construction Co—ordination Division. Contractor shall notify Barricade Engineer (768—2551) prior to occupying an intersection. See section 19 of the specifications. All Street striping altered or destroyed shall be replaced by Contractor to location and in kind as existing at no additional cost to the Owner.

- 11. The Contractor shall promptly clean up any material excavated within the public right—of—way so that the excavated material is not susceptible to being washed down the street.
- 12. Contractor shall assist the Engineer/Inspector in the recording of data on all utility lines and accessories as required by the City of Albuquerque for the preparation of record drawings. Contractor shall not cover utility lines and accessories until all data has been recorded.
- 13. Existing curb and gutter not to be removed under the contract which is damaged or displaced by the Contractor shall be removed and replaced by the Contractor at his expense.
- 14. All work on this project shall be performed in accordance with applicable federal, state, and local laws, rules, and regulations concerning construction safety and health.
- 15. All fittings on waterlines shall have restrained joints as noted on the plans.
- 16. The Contractor is responsible for protecting and maintaining all existing monumentation controls. In the event of in—advertent destruction or alteration, the Contractor must immediately notify the City Chief Surveyor.
- 17. PNM will provide at no cost to the City or the Contractor the required personnel for inspection or observation deemed necessary by PNM while the Contractor is exposing PNM's cables. However, the Contractor shall be charged the total cost associated with repairs to any damaged cables or for any cost associated with supporting or relocating the poles and cables during construction.
- 18. WARNING—EXISTING UTILITY LINE LOCATIONS are shown in an approximate manner only, and such lines may exist where none are shown. The location of any such existing lines is based upon information provided by the utility company, the Owner, or by others, and the information may be incomplete or may be obsolete by the time construction commences.

The Engineer has undertaken no field verification of the location, depth, size, or type of existing underground utility lines, makes no representation pertaining thereto, and assumes no responsibility or liability therefor. The Contractor shall inform itself of the location of any utility line in or near the area of the work in advance of and during excavation work. The Contractor is fully responsible for any and all damage caused by its failure to locate, identify, and preserve any and all existing utilities. The Contractor shall comply with State statutes, municipal and local ordinances, rules and regulations pertaining to the location of these lines and facilities, in planning and conducting excavation, whether by calling or notifying the utilities, complying with "Blue Stakes" procedures, or otherwise.

INDEX TO DRAWINGS


eet Tit

- 1. VICINITY MAP & GENERAL NOTES
- 2. SUBDIVISION PLAT
- 3. SUBDIVISION PLAT
- 4. GRADING & DRAINAGE PLAN & DETAILS
- 5. PAVING & UTILITY MASTERPLAN

PAVING, WATER AND SANITARY SEWER


- PLAN AND PROFILE

 6. VIA CADIZ COURT
- 7. VIA GRANADA COURT

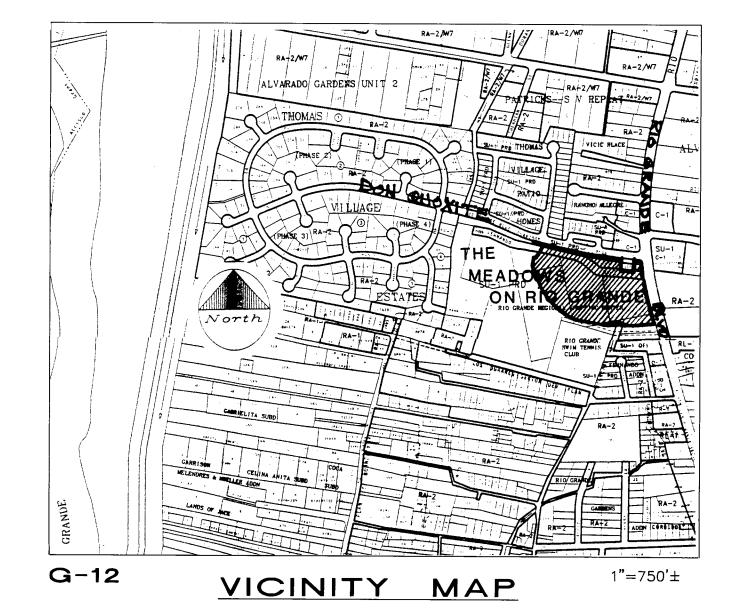

PREPARED BY: ISAACSON & ARFMAN, P.A. 128 Monroe Street, NE Albuquerque, NM 87108

26-4677.910194

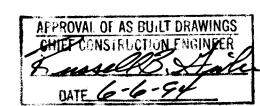

ANNELLE'S

4.25.94

SURVEYOR'S CERTIFICATION

"I, Timothy Aldrich, a duly qualified Registered Professional Land Surveyor under the laws of the State of New Mexico, do hereby certify that the 'as-built' information shown on these drawings was obtained from field construction and 'as-built' surveys performed by me or under my supervision, that the 'as-built' information shown on these drawings was added by me or under my supervision, and that this 'as-built' information is true and correct to the best of my knowledge and belief." Aldrich Land Surveying is not responsible for any of the design concepts, calculations, engineering, or intent of the record drawings.

REV. SHEETS CITY ENGINEER DATE USER DEPARTMENT DATE

ISAACSON & ARFMAN, P.A.

Consulting Engineering Associates
128 Monroe Street N.E.

Albuquerque

New Mexico

PROJECT NO.

4677.91

Total Consulting Engineering Associates
18 Morroe Street N.E.

Albuquerque

PROJECT NO.

SHEET

OF

1 7

(G-12)VICINITY MAP

SUBDIVISION DATA / NOTES 1. PLAT WAS COMPILED USING EXISTING RECORD AND ACTUAL FIELD SURVEY.

2. ALL CORNERS OF THE SUBDIVISION WERE SET WITH A NO. 5 REBAR AND YELLOW PLASTIC CAP MARKED "PS 7719" UNLESS OTHERWISE INDICATED.

- 3. BEARINGS ARE STATE PLANE GRID BEARINGS, CENTRAL ZONE.
- 4. DISTANCES ARE GROUND DISTANCES.
- ALL BOUNDARY DISTANCES & BEARINGS SHOWN ARE BOTH FIELD & RECORD.
- 6. PLAT SHOWS ALL EASEMENTS OF RECORD.
- 7. GROSS ACREAGE: 9.6788 ACRES
- 8. NUMBER OF EXISTING TRACTS: 1
- 9. NUMBER OF TRACTS/LOTS CREATED: 39 LOTS
- 10. THIS PLAT DEDICATES 0.290 MILES OF STREETS TO THE CITY OF ALBUQUERQUE.
- 11. BASIS OF BEARINGS: CITY OF ALBUQUERQUE PUBLISHED TIE BETWEEN ACS "7-H13B" AND "3-G12" HAVING A GRID AZIMUTH 167'37'30" NM STATE PLANE COORDINATES (CENTRAL ZONE).

12. CITY STANDARD UTILITY NOTE II: "CITY OF ALBUQUERQUE WATER AND SANITARY SEWER SERVICE TO THE MEADOWS ON RIO GRANDE SUBDIVISION MUST BE VERIFIED AND COORDINATED WITH THE PUBLIC WORKS DEPARTMENT, CITY OF ALBUQUERQUE."

13. CENTERLINE (IN LIEU OF R/W MONUMENTATION) TO BE INSTALLED AT ALL CENTERLINE PC'S, PT'S, ANGLE POINTS AND STREET INTERSECTIONS PRIOR TO ACCEPTANCE OF SUBDIVISION STREET IMPROVEMENTS AND WILL CONSIST OF A STANDARD FOUR-INCH (4") ALUMINUM ALLOY CAP STAMPED "CENTERLINE MONUMENTATION, PLS#7719".

CERTIFICATION (FIELD SURVEY)

, TIMOTHY ALDRICH, L.S. NO. 7719, HEREBY CERTIFY THAT THE BOUNDARY SURVEY SHOWN HEREON WAS PREPARED BY ME OR UNDER MY SUPERVISION AND IS TRUE AND CORRECT TO THE PERTURY KNOWLEDGE AND BELIEF.



CERTIFICATION (PLAT PREPARATION) I, THOMAS O. ISAACSON, A REGISTERED PROFESSIONAL ENGINEER AND LAND SURVEYOR UNDER THE LAWS OF THE STATE OF NEW MEXICO.

DO HEREBY CERTIFY THAT THIS PLAT WAS PREPARED BY ME OR UNDER MY SUPERVISION; SHOWS ALL EASEMENTS OF RECORD AND MEETS THE MINIMUM REQUIREMENTS OF MONUMENTATION AND SURVEYS OF THE ALBUQUERQUE SUBDIVISION ORDINANCE, AND IS TRUE TO THE BEST OF MY KNOWLEDGE AND BELIEF. THIS BOUNDARY USED FOR THE PREPARATION OF THIS PLAT WAS ACCOMPLISHED BY TIMOTHY ALDRICH, L.S. NO. 7719, SEE CERTIFICATION THIS PLAT.

ISAACSON & ARFMAN, P.A.

THOMAS O. ISAACSON N.M.P.E. & L.S. #3895

CURVE

6-46

3

9 10 11

29

4 15

C66

C67

C68

C69

C70

184.86

481.27

157.21

132.01

96.65

264'47'56"

56'23'23'

36°01'51'

11'19'28"

38*47'11'

40.00

489.00

250.00

489.00

195.00

BY LASON

DATE

LEGAL DESCRIPTION

A CERTAIN TRACT OF LAND SITUATE WITHIN THE TOWN OF ALBUQUERQUE GRANT WITHIN SECTION 1 (PROJECTED SECTION) TOWNSHIP 10 NORTH, RANGE 2 EAST, NEW MEXICO PRINCIPAL MERIDIAN, BERNALILLÓ COUNTY, ALBUQUERQUE, NEW MEXICO, BEING AND COMPRISING "TRACT C, THE MEADOWS ON RIO GRANDE, UNIT ONE, ALBUQUERQUE, NEW MEXICO". AS THE SAME IS SHOWN AND DESIGNATED ON THE PLAT FILED IN THE OFFICE OF THE COUNTY CLERK OF BERNALILLO COUNTY, NEW MEXICO ON JULY 8, 1993, IN VOLUME 93C, FOLIO 194 AND BEING MORE PARTICULARLY DESCRIBED BY NEW MEXICO STATE PLANE GRID BEARINGS (CENTRAL ZONE) AND GROUND DISTANCES AS FOLLOWS:

BEGINNING AT THE NORTHEAST CORNER OF THE TRACT HEREIN DESCRIBED, A POINT ON A CURVE ON THE SOUTHERLY RIGHT-OF-WAY LINE OF DON QUIXOTE DRIVE, N.W., WHENCE THE CITY OF ALBUQUERQUE CONTROL MONUMENT "3-G12" (HAVING NEW MEXICO STATE PLANE COORDINATES, CENTRAL ZONE VALUES OF X=372,889.43 AND Y=1,498,606.10) BEARS N 5'13'45" E, A DISTANCE OF 212.96 FEET AND FROM SAID POINT OF BEGINNING RUNNING THENCE ALONG THE NORTHERLY BOUNDARY OF THE TRACT HEREIN DESCRIBED AND ALSO ALONG SAID RIGHT-OF-WAY.

36.70 FEET ALONG THE ARC OF A CURVE TO THE RIGHT HAVING A RADIUS OF 25.00 FEET AND A CHORD BEARING S 49°25'52" E, A DISTANCE OF 33.49 FEET TO A POINT OF REVERSE CURVATURE ON THE WESTERLY RIGHT-OF-WAY LINE OF RIO GRANDE BOULEVARD, N.W., THENCE RUNNING ALONG THE EASTERLY BOUNDARY OF THE TRACT HEREIN DESCRIBED AND ALSO ALONG SAID RIGHT-OF-WAY LINE.

346.17 FEET ALONG THE ARC OF A CURVE TO THE LEFT HAVING A RADIUS OF 2907.78 FEET AND A CHORD BEARING S 10°47'07" E, A DISTANCE OF 345.96 FEET TO A POINT OF TANGENCY; THENCE,

S 13'47'11" E, A DISTANCE OF 111.51 FEET TO A POINT OF CURVATURE: THENCE.

38.24 FEET ALONG THE ARC OF A CURVE TO THE RIGHT HAVING A RADIUS OF 25.00 FEET AND A CHORD BEARING S 30°02'06" W, A DISTANCE OF 34.62 FEET TO A POINT ON THE NORTHERLY RIGHT-OF-WAY LINE OF DON FERNANDO ROAD N.W.; THENCE.

S 73°51'24" W, A DISTANCE OF 53.91 FEET TO A POINT OF CURVATURE; THENCE, 80.52 FEET ALONG THE ARC OF A CURVE TO THE RIGHT HAVING A RADIUS OF 300.00

FEET AND A CHORD BEARING OF S 81°32'44" W. A DISTANCE OF 80.28 FEET TO A POINT OF TANGENCY: THENCE.

S 89"14'04" W, A DISTANCE OF 152.69 FEET TO A POINT OF CURVATURE; THENCE,

594.91 FEET ALONG THE ARC OF A CURVE TO THE RIGHT HAVING A RADIUS OF 627.00 FEET AND A CHORD BEARING OF N 63°35'02" W, A DISTANCE OF 572.84 FEET TO A POINT OF COMPOUND CURVATURE; THENCE,

42.69 FEET ALONG THE ARC OF A CURVE TO THE RIGHT HAVING A RADIUS OF 25.00 FEET AND A CHORD BEARING OF N 12'30'53" E, A DISTANCE OF 37.69 FEET TO A POINT; THENCE,


N 35°20'02" W, A DISTANCE OF 46.32 FEET TO A POINT OF CURVATURE; THENCE, (CONTINUED SHEET 2 OF 3)


DISCLOSURE STATEMENT

THE INTENT OF THIS PLAT IS TO SUBDIVIDE THE SUBJECT TRACT INTO RESIDENTIAL LOTS. TO DEDICATE PUBLIC RIGHT-OF-WAY AND TO GRANT THOSE EASEMENTS NECESSARY TO SERVE THE RESIDENTIAL DEVELOPMENT.

FREE CONSENT / DEDICATION

THE UNDERSIGNED OWNERS AND PROPRIETORS OF THE PROPERTY DESCRIBED HEREON DO HEREBY CONSENT TO THE PLATTING OF SAID PROPERTY AS SHOWN HEREON AND DO HEREBY DEDICATE IN FEE SIMPLE WITH WARRANTY COVENANTS THE RIGHTS-OF-WAY FOR PUBLIC THOROUGHFARE AS INDICATED TO THE CITY OF ALBUQUERQUE, AND GRANT THOSE EASEMENTS AS SHOWN HEREON IN ACCORDANCE WITH THEIR APPLICABLE DEDICATION AS SHOWN HEREON AND THE SAME IS WITH THE FREE CONSENT AND IN ACCORDANCE WITH THEIR DESIRES AND DO HEREBY REPRESENT THAT THE UNDERSIGNED INDIVIDUALS ARE AUTHORIZED TO SO ACT.

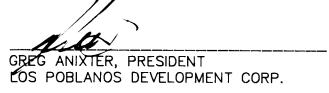

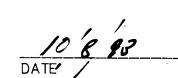

PLAT OF THE MEADOWS ON RIO GRANDE. UNIT TWO

BEING A REPLAT OF TRACT "C" THE MEADOWS ON RIO GRANDE, UNIT ONE

ALBUQUERQUE, **NEW MEXICO** OCTOBER, 1993

APPROVALS DRB NO: PUBLIC SERVICE COMPANY OF NEW MEXICO DATE GAS COMPANY OF NEW MEXICO DATE U.S. WEST COMMUNICATIONS DATE JONES INTERCABLE DATE CITY SURVEYOR, ENGR. DIV., P.W.D. DATE TRAFFIC ENGINEERING, TRANS. DEV. DIV., P.W.D. DATE PARKS & RECREATION DEPARTMENT DATE UTILITY DEVELOPMENT DIV., P.W.D. DATE REAL PROPERTY DIVISION, P.W.D. DATE A.M.A.F.C.A. DATE CITY ENGINEER, PUBLIC WORKS DEPT. DATE

APPROVAL AND CONDITIONAL ACCEPTANCE AS SPECIFIED BY THE ALBUQUER-QUE SUBDIVISION ORDINANCE, ARTICLE XI OF THE REVISED ORDINANCES OF ALBUQUERQUE, N.M.


CITY PLANNER, ALBUQUERQUE PLANNING DIVISION

ACKNOWLEDGEMENT

STATE OF NEW MEXICO)

COUNTY OF BERNALILLO)

ON THIS 8th DAY OF October GOING INSTRUMENT WAS ACKNOWLEDGED BEFORE ME, A NOTARY PUBLIC. BY GREG ANIXTER, PRESIDENT OF LOS POBLANOS DEVELOPMENT CORP.. A NEW MEXICO CORPORATION, ON BEHALF OF SAID CORPORATION. MY COMMISSION EXPIRES: 3/8/97

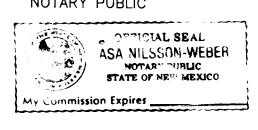

COURSE TABLE

LINE	BEARING	DISTANCE
L1	S 7°28'30" W	33.44
L2	S 10°55′53" W	56.50
L3	S 82°32'14" E	1.16
L4	S 73°51'24" W	53.91
L5	N 35°20'01" W	46.32
L6	S 88°57'01" E	39.78
L7	N 88*57'01" W	36.93
L8	S 82°32'14" E	9.95
L9	N 82'32'16" W	11.59
L10	S 61°25'55" W	2.71
L11	N 17*32'56" E	34.50
L12	S 17°32′56″ W	26.40
L13	S 4°10'41" W	4.01
L14	S 75°27'04" E	9.26
L15	S 84°53'01" E	10.10
L16	S 82°32'14" E	3.57
L17	S 73°51'24" W	8.96
L18	S 75°27'04" E	70.54
L19	S 84°53'01" E	70.78

PLAT OF THE MEADOWS ON RIO GRANDE. UNIT TWO

BEING A REPLAT OF TRACT "C" THE MEADOWS ON RIO GRANDE, UNIT ONE

ALBUQUERQUE, NEW MEXICO OCTOBER, 1993

DELTA

RADIUS

CURVE TABLE

		DELIA	MADIOS
C1	39.85	9119'38"	25.00
C2	149.34	13*38'47"	627.00
C3	75.23	8'14'30"	
C4			523.00
	31.53	7215'23"	25.00
C5	81.06	23*27'26"	198.00
C6	33.06	75*45'43"	25.00
C7	102.87	515'44"	1120.04
C8			
	39.19	81214"	273.70
C9	36.70	84'06'45"	25.00
C10	346.17	6°49'16"	2907.78
C11	38.24	87'38'35"	25.00
C12			
	80.52	15*22'40"	300.00
C13	594.91	54*21'48"	627.00
C14	42.69	97*50'03"	25.00
C15	35.43	81"12'38"	25.00
C16	48.71		
		5*27'05"	512.00
C17	62.37	6*58'46"	512.00
C18	72.37	8'05'54"	512.00
C19	67.37	7*32'20"	512.00
C20	67.37	7'32'20"	
	+		512.00
C21	67.37	7*32'20"	512.00
C22	67.37	7'32'20"	512.00
C23	8.12	0.54.32"	512.00
C24	18.50	42*23'26"	
			25.00
C25	18.37	26"18'32"	40.00
C26	41.90	60'00'49"	40.00
C27	32.16	46*04'05"	40.00
C28	34.27	49'05'00"	+
C29		+	40.00
	34.85	49*54'47"	40.00
C30	23.33	33°24'42"	40.00
C31	18.50	42*24'30"	25.00
C32	5.30	0'39'06"	466.00
C33	79.68		
		9*47'48"	466.00
C34	80.62	9*54'45"	466.00
C35	78.74	9*40'51"	466.00
C36	79.68	9*47'48"	466.00
C37	79.88	9'49'17"	
C38	 		466.00
	43.95	100'43'25"	25.00
C39	74.87	18 ' 53'53"	227.00
C40	67.89	17'08'06"	227.00
C41	18.50	42*23'58"	25.00
C42	39.59	56'42'49"	
	 		40.00
C43	31.85	45'37'43"	40.00
C44	31.54	45"11'03"	40.00
C45	54.56	78'09'27"	40.00
C46	27.31	39.06.54"	
C47			40.00
<u> </u>	18.50	42'23'58"	25.00
C48	47.61	9' 59'32"	273.00
C49	55.59	11*40'02"	272.92
C50	68.49	14*22'24"	273.00
C51			
	40.06	91°48′43″	25.00
C52	44.89	5*31'08"	466.00
C53	60.04	20*00'04"	172.00
C54	56.39	18'47'07"	172.00
C55	37.17	85°10'34"	
			25.00
C56	41.37	94*49'26"	25.00
C57	20.27	5"19'39"	218.00
C58	66.49	17*28'31"	218.00
C59	60.81	15'59'01"	
C60			218.00
 	52.21	5*50'34"	512.00
C61	38.62	88°30'44"	25.00
C62	10.12	1'06'30"	523.00
C63	26.83	1*22'22"	1120.04
C64			
	29.80	2'43'23"	627.00
C65	184.86	264'47'56"	40.00
Cee	40400	00.441-48	

LEGAL DESCRIPTION (continued)

39.85 FEET ALONG THE ARC OF A CURVE TO THE RIGHT HAVING A RADIUS OF 25.00 FEET AND A CHORD BEARING OF N 72*54'16" W, A DISTANCE OF 35.76 FEET TO A POINT OF COMPOUND CURVATURE; THENCE,

149.34 FEET ALONG THE ARC OF A CURVE TO THE RIGHT HAVING A RADIUS OF 627.00 FEET AND A CHORD BEARING OF N 20°25'04" W, A DISTANCE OF 148.98 FEET TO A POINT OF REVERSE CURVATURE; THENCE.

75.23 FEET ALONG THE ARC OF A CURVE TO THE LEFT HAVING A RADIUS OF 523.00 FEET AND A CHORD BEARING OF N 17'42'56" W, A DISTANCE OF 75.17 FEET TO A POINT OF REVERSE CURVATURE: THENCE.

31.53 FEET ALONG THE ARC OF A CURVE TO THE RIGHT HAVING A RADIUS OF 25.00 FEET AND A CHORD BEARING N 14'17'31" E, A DISTANCE OF 29.48 FEET AND LEAVING THE NORTHERLY RIGHT-OF-WAY LINE OF DON FERNANDO ROAD N.W. AND TO A POINT OF REVERSE CURVATURE AND BEING A POINT ON THE EASTERLY RIGHT-OF-WAY LINE OF DON PEDRO DRIVE N.W.: THENCE.

81.06 FEET ALONG THE ARC OF A CURVE TO THE LEFT HAVING A RADIUS OF 198.00 FEET AND A CHORD BEARING OF N 38'41'29" E, A DISTANCE OF 80.50 FEET TO A POINT OF REVERSE CURVATURE; THENCE,

33.06 FEET ALONG THE ARC OF A CURVE TO THE RIGHT HAVING A RADIUS OF 25.00 FEET AND A CHORD BEARING N 64'50'38" E. A DISTANCE OF 30.70 FEET TO A POINT ON THE SOUTHERLY RIGHT-OF-WAY LINE OF DON QUIXOTE DRIVE N.W.; THENCE,

S 77.16'30" E, A DISTANCE OF 305.40 FEET TO A POINT OF CURVATURE; THENCE,

102.87 FEET ALONG THE ARC OF A CURVE TO THE LEFT HAVING A RADIUS OF 1120.05 FEET AND A CHORD BEARING S 79°54'22" E, A DISTANCE OF 102.83 FEET TO A POINT OF TANGENCY; THENCE,

S 82'32'14" E, A DISTANCE OF 213.57 FEET TO A POINT, THENCE LEAVING THE SAID SOUTHERLY RIGHT-OF-WAY LINE OF DON QUIXOTE DRIVE, N.W. AND RUNNING THENCE ALONG THE WESTERLY BOUNDARY OF M.R.G.C.D. TRACT 111-B, MAP NO. 34,

S 10'55'53" W, A DISTANCE OF 56.50 FEET TO THE SOUTHWEST CORNER OF SAID M.R.G.C.D. TRACT 111-B; THENCE.

S 07'28'30" W, A DISTANCE OF 33.44 FEET TO A POINT; THENCE,

S 83'46'59" E, A DISTANCE OF 92.02 FEET TO THE SOUTHEAST CORNER OF SAID M.R.G.C.D. TRACT 111-B; THENCE.

N 07'57'34" E, A DISTANCE OF 87.83 FEET TO A POINT ON THE SOUTHERLY RIGHT-OF-WAY LINE OF DON QUIXOTE DRIVE, N.W., THENCE RUNNING ALONG THE NORTHERLY BOUNDARY OF THE TRACT HEREIN DESCRIBED AND ALSO ALONG SAID RIGHT-OF-WAY LINE.

S 82'32'14" E, A DISTANCE OF 1.16 FEET TO A POINT OF CURVATURE; THENCE, 39.20 FEET ALONG THE ARC OF A CURVE TO THE LEFT HAVING A RADIUS OF 246.26 FEET AND A CHORD BEARING S 86'55'37" E, A DISTANCE OF 39.16 FEET TO THE POINT AND PLACE OF BEGINNING.

TRACT CONTAINS 9.6788 ACRES, MORE OR LESS.

PUBLIC UTILITY EASEMENTS PUBLIC UTILITY EASEMENTS SHOWN ON THIS PLAT ARE GRANTED FOR

THE COMMON AND JOINT USE OF:

- 1. THE PUBLIC SERVICE COMPANY OF NEW MEXICO FOR THE INSTALLATION, MAINTENANCE, AND SERVICE OF UNDERGROUND ELECTRICAL LINES, TRANSFORMERS, AND ANY OTHER EQUIPMENT, FIXTURES, STRUCTURES, AND RELATED FACILITIES REASONABLY NECESSARY TO PROVIDE ELEC-TRICAL SERVICE.
- 2. U.S. WEST FOR THE INSTALLATION, MAINTENANCE AND SERVICE OF ALL BURIED COMMUNICATION LINES AND OTHER RELATED EQUIPMENT AND FACILITIES REASEONABLY NECESSARY TO PROVIDE COMMUNICATION SERVICES, INCLUDING BUT NOT LIMITED TO ABOVE GROUND PEDESTALS AND CLOSURES.
- 3. JONES INTERCABLE FOR THE INSTALLATION, MAINTENANCE, AND SERVICE OF SUCH LINES, CABLE, AND OTHER RELATED EQUIPMENT AND FACILITIES REASONABLY NECESSARY TO PROVIDE CABLE TV SERVICE.
- 4. GAS COMPANY OF NEW MEXICO FOR THE INSTALLLATION, MAINTENANCE. AND SERVICE OF SUCH DISTRIBUTION AND SERVICE LINES AND FACILITIES REASONABLY NECESSARY TO PROVIDE GAS SERVICE.


INCLUDED IS THE RIGHT TO BUILD, REBUILD, CONSTRUCT, RECONSTRUCT, LOCATE, RELOCATE, CHANGE, REMOVE, MODIFY, RENEW, OPERATE, AND MAINTAIN FACILITIES FOR THE PURPOSES DESCRIBED ABOVE, TOGETHER WITH FREE ACCESS TO, FROM, AND OVER SAID EASEMENT, INCLUDING SUFFICIENT. WORKING AREA SPACE FOR ELECTRIC TRANSFORMERS, WITH THE RIGHT AND PRIVILEGE TO TRIM AND REMOVE TREES, SHRUBS, OR BUSHES WHICH INTER-FERE WITH THE PURPOSES SET FORTH HEREIN. NO BUILDING, SIGN, OR OTHER STRUCTURE SHALL BE ERECTED OR CONSTRUCTED ON SAID EASE-MENTS, NOR SHALL ANY WELL BE DRILLED OR OPERATED THEREON. PROPERTY OWNERS SHALL BE SOLELY RESPONSIBLE FOR CORRECTING ANY VIOLATIONS OF NATIONAL ELECTRICAL SAFETY CODE CAUSED BY CONSTRUC-TION OF POOLS, DECKING, OR ANY STRUCTURES ADJACENT TO OR NEAR EASEMENTS SHOWN ON THIS PLAT.


PRIVATE DRAINAGE FACILITY NOTES


A "FLAT LAND" DRAINAGE CONCEPT HAS BEEN APPROVED BY THE CITY OF ALBUQUERQUE AS FOUND IN CITY HYDROLOGY DRAINAGE FILE G13/D19, SHEETS 1 THROUGH 3, "THE MEADOWS ON RIO GRANDE, DRAINAGÉ AND GRADING PLAN." THE PLAN REQUIRES THE FOLLOWING IMPROVEMENTS:

- 1. INDIVIDUAL PROPERTY OWNERS ARE RESPONSIBLE FOR ACCEPTANCE OF PUBLIC STREET STORM WATER RUNOFF AND ASSURANCE OF NO CROSS-LOT DRAINAGE.
- 2. FLAT GRADING OF ALL LOTS WITHIN THE SUBDIVISION, WITH NO DISTURBANCE (INCREASE) TO APPROVED GRADES.
- 3. PERIMETER IMPERMIBLE SOLID WALLS ALONG THE REARS AND SIDE LOT LINES OF ALL LOTS (8" MINIMUM HEIGHT).


REFER TO "PRIVATE FACILITY DRAINAGE COVENANT" FILED IN THE COUNTY CLERK OFFICE IN BK. 93-18, PG. 1877-1880.

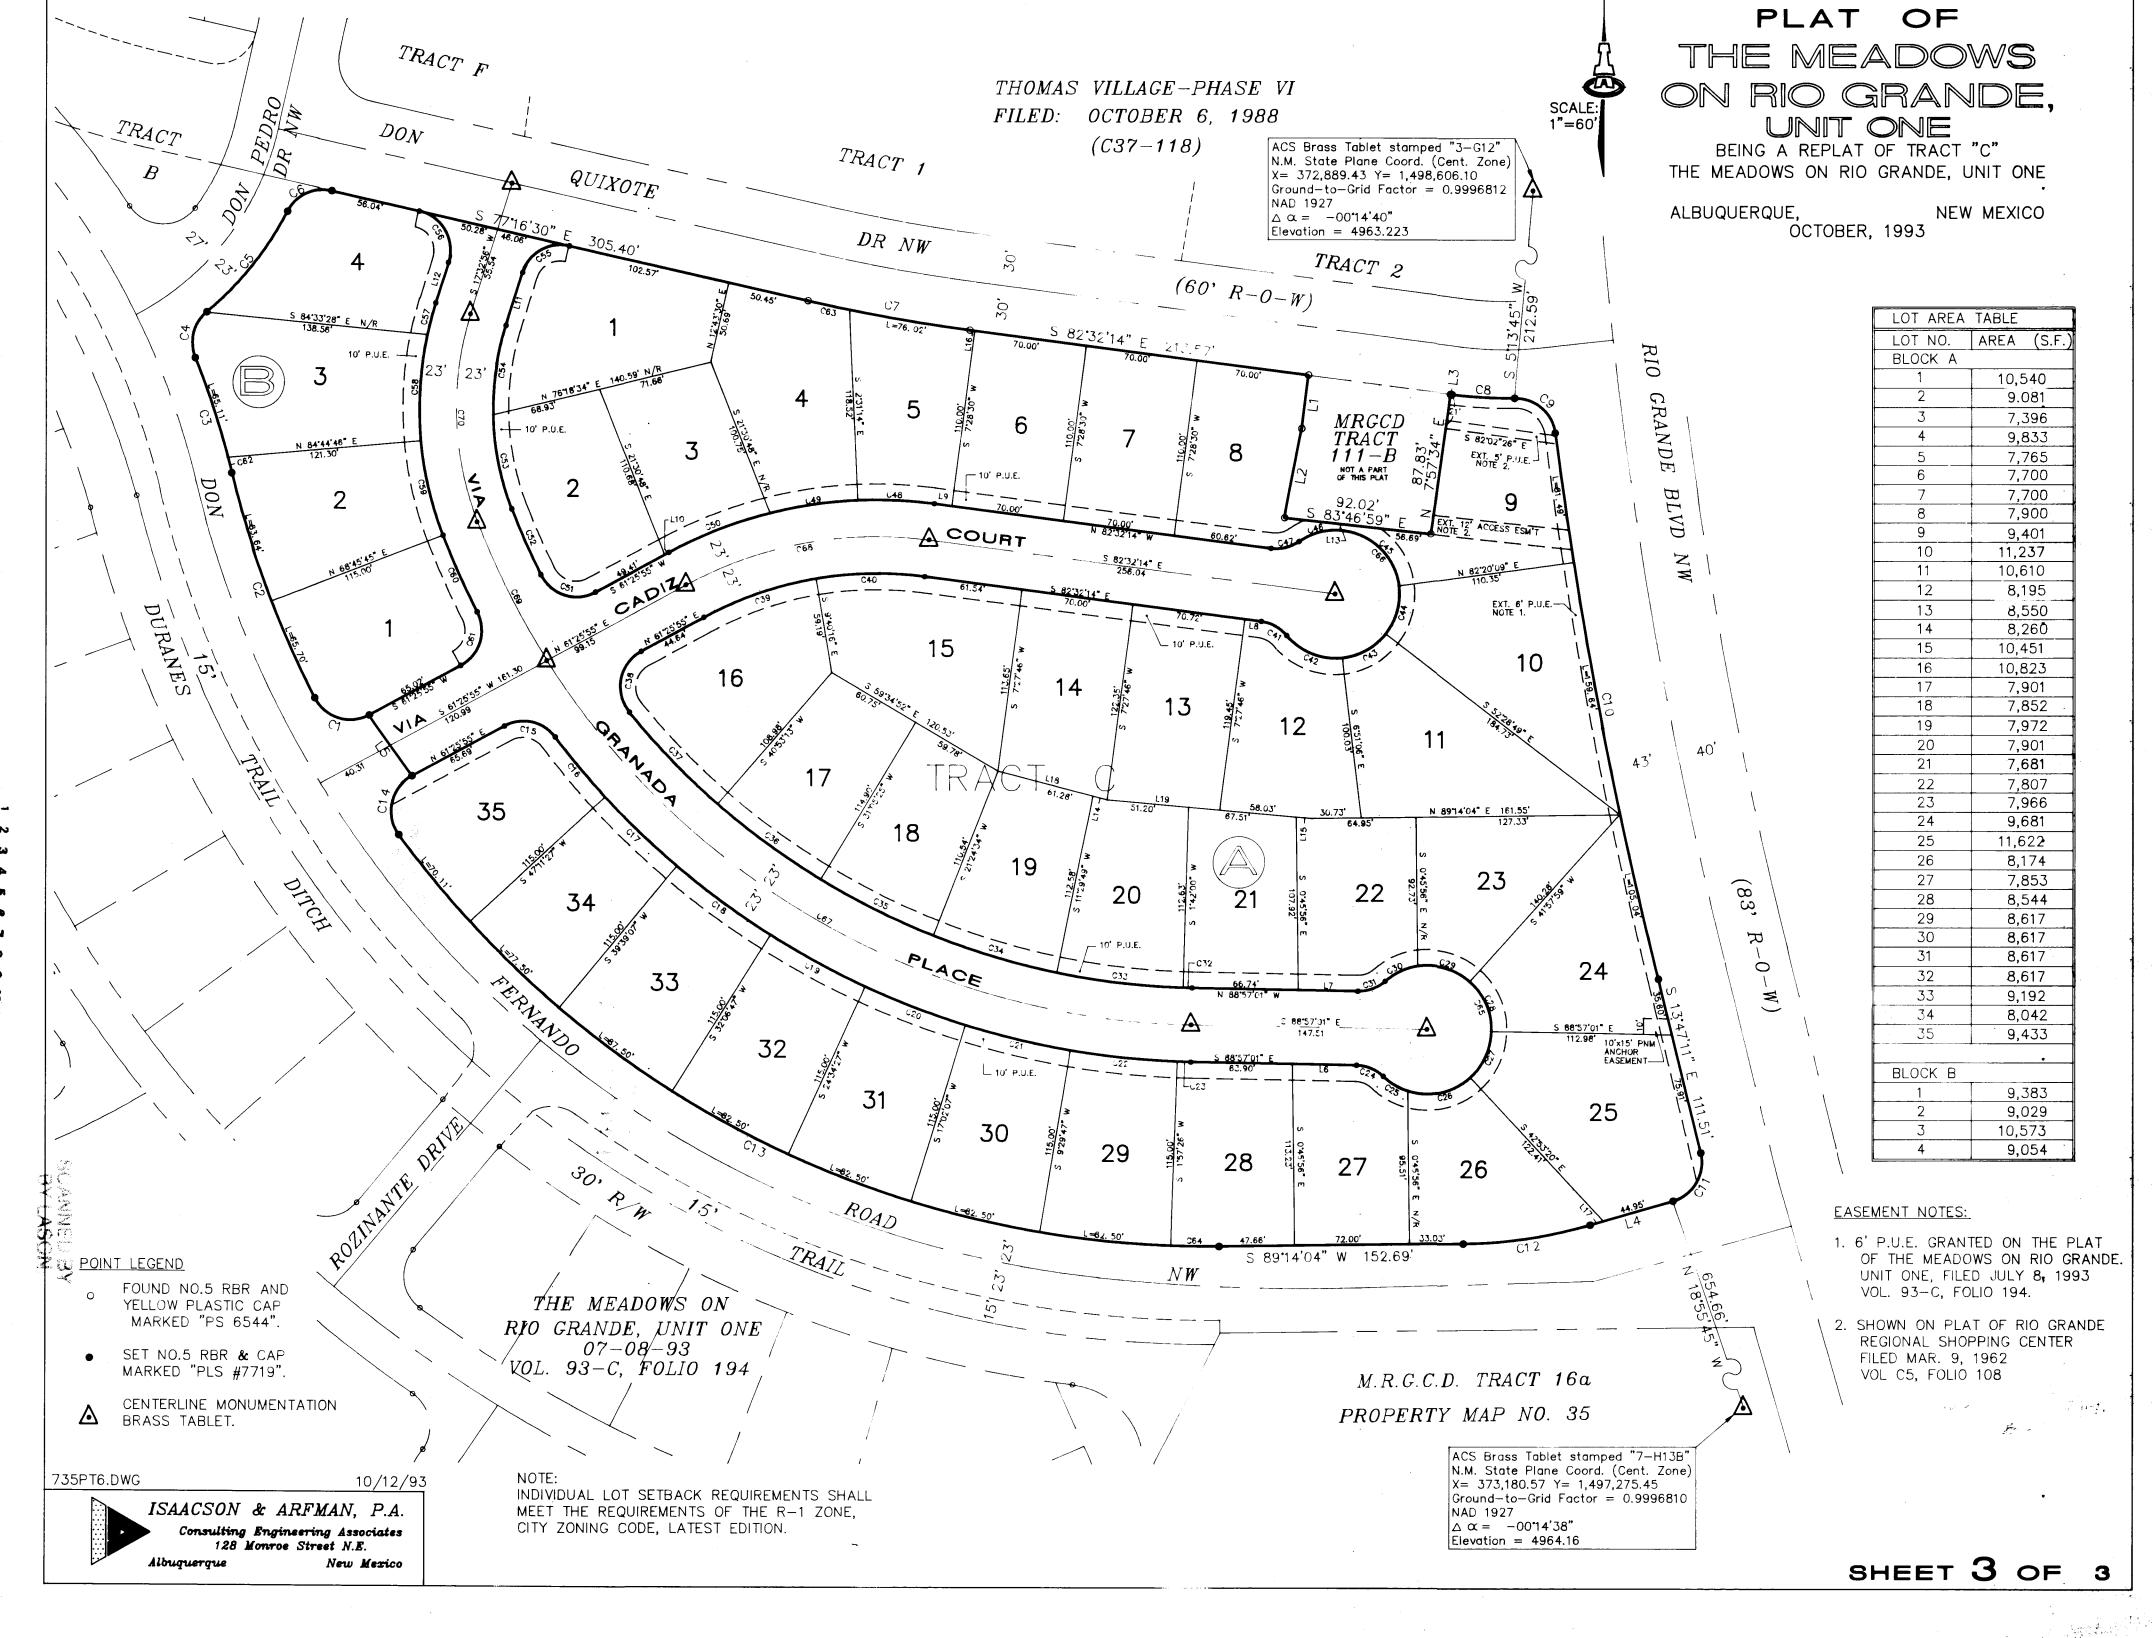

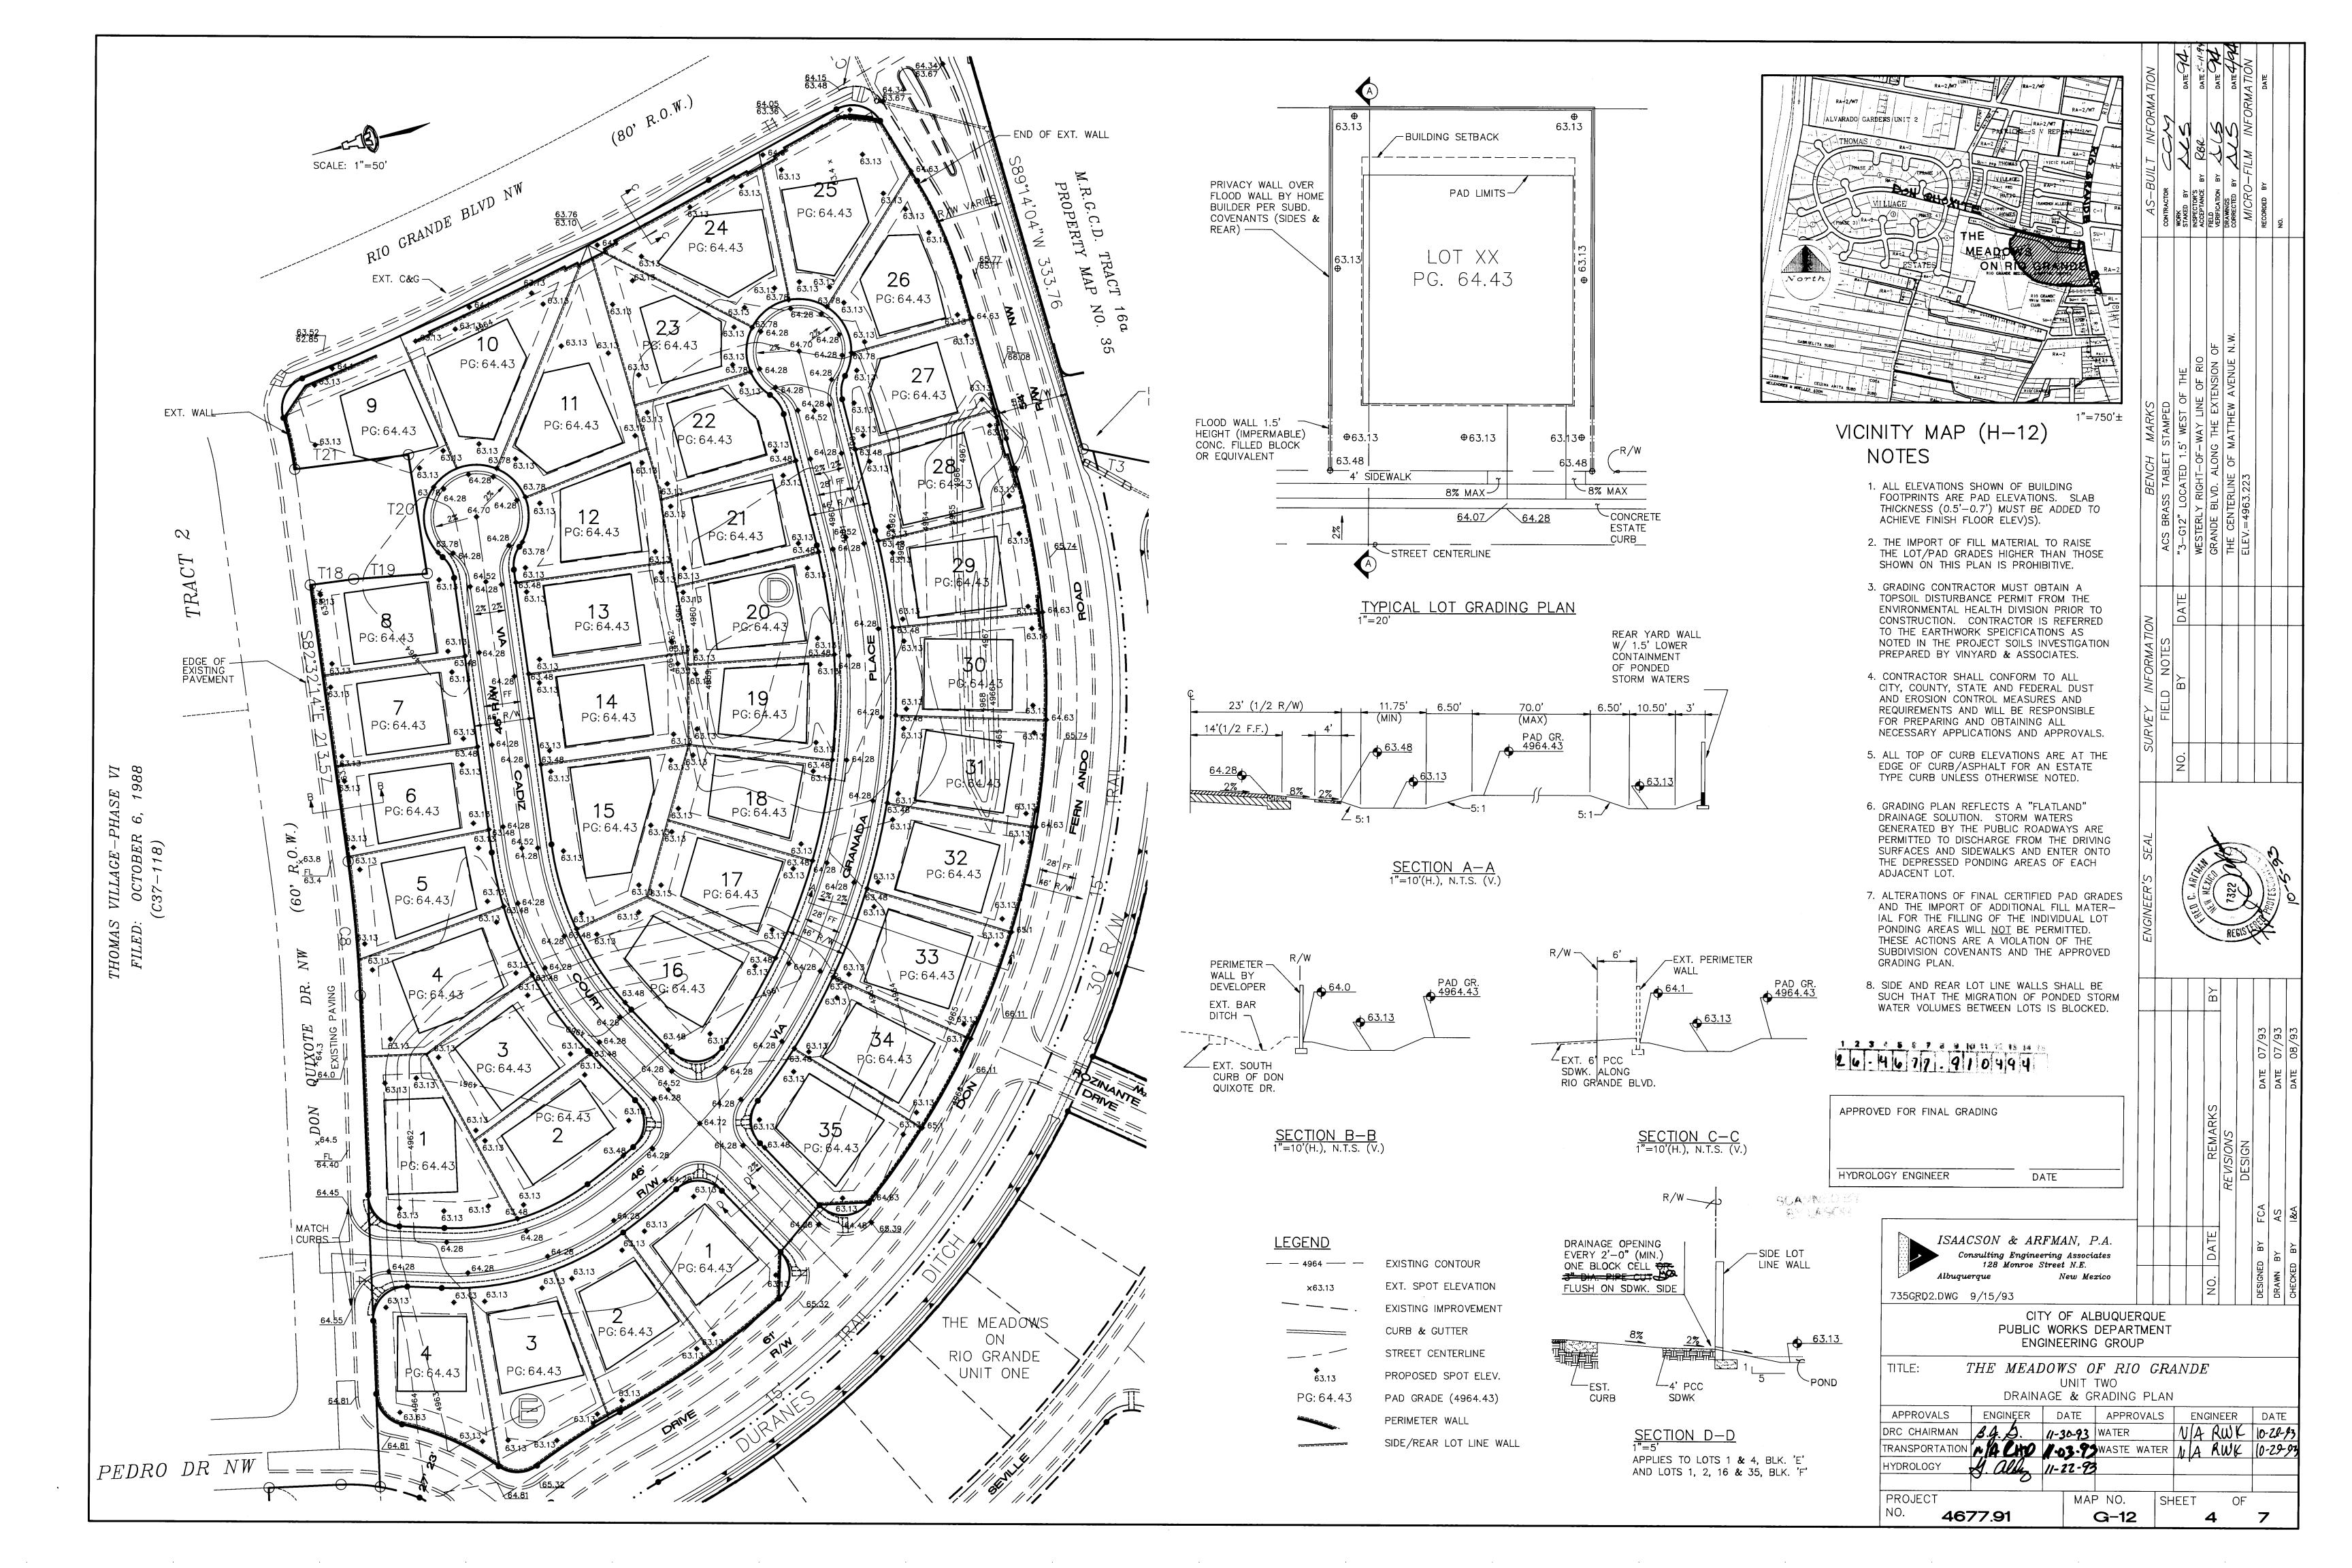

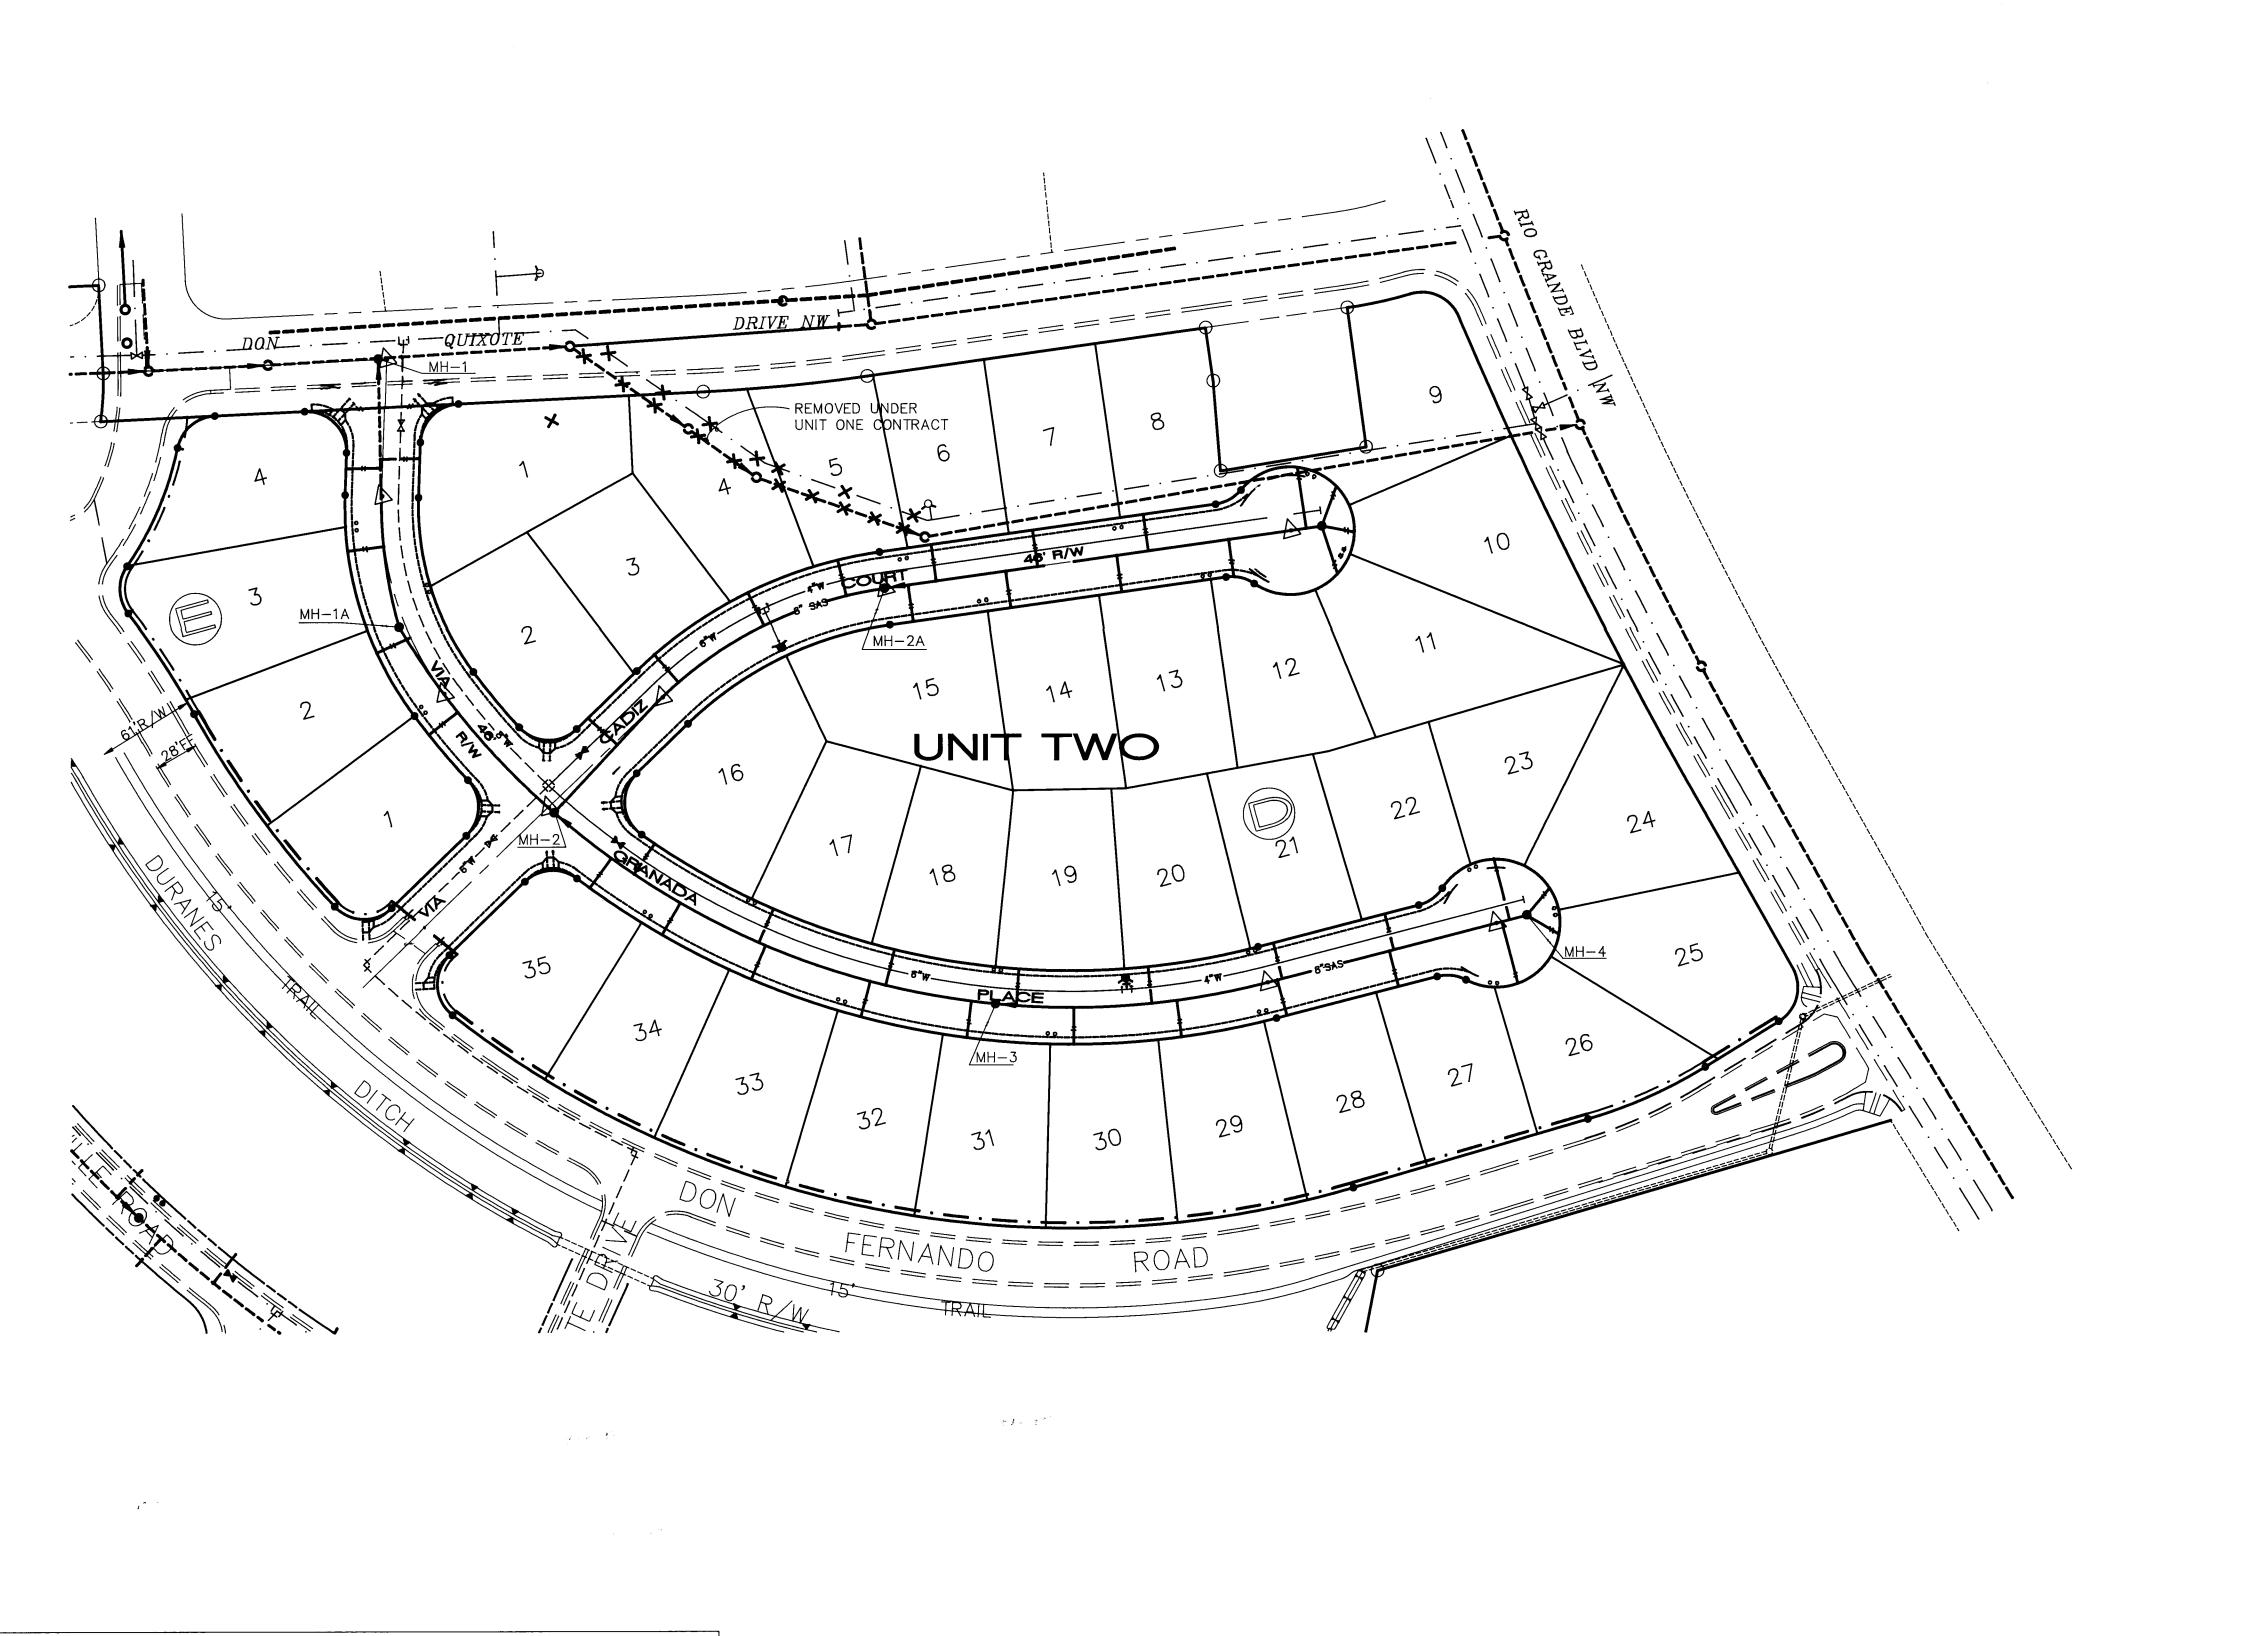

CONNECTION DESCRIPTION	ZONE MAP NO.	VALVE TO BE CLOSED	LOCATION	

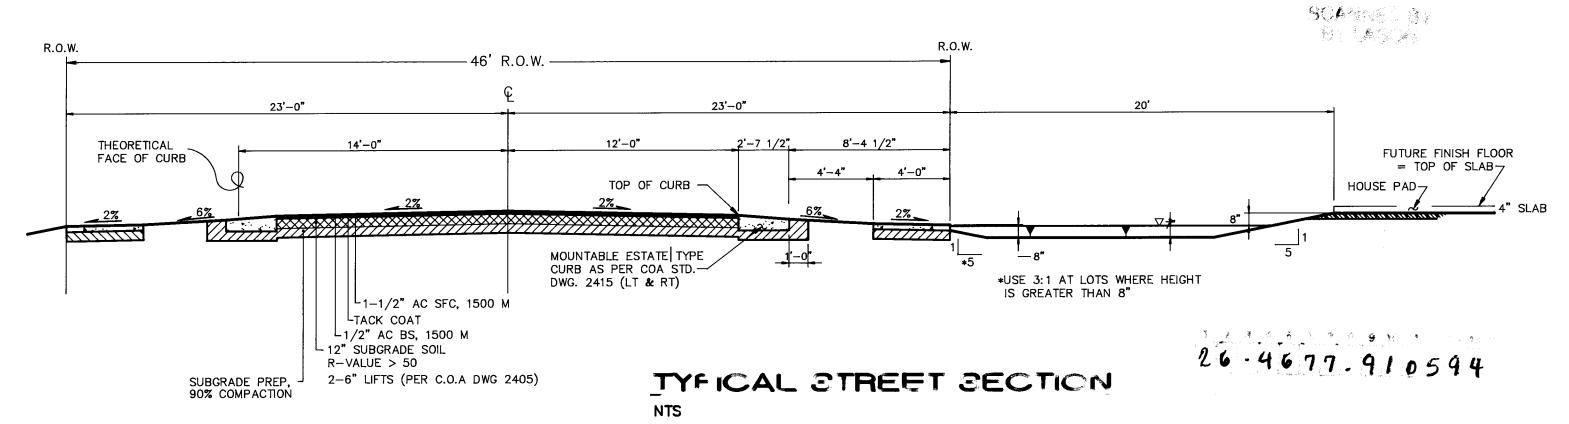

NOTES: SEE SHEET 16 OF 16 FOR STREET SECTIONS OF DON FERNANDO RD. UNLESS OTHERWISE SHOWN, ALL R.O.W. IS 46 FEET, PAVING WIDTH IS 28 FEET FACE-TO-FACE. LEGEND DURANES DITCH (RE-ALIGNED) PRV'T IRRIGATION LATERAL \mathbf{x} \mathbf{x} \mathbf{x} \mathbf{x} EXISTING WATER EXISTING SANITARY SEWER PROPOSED 6" WATER LINE UNLESS OTHERWISE NOTED PROPOSED SAS W/MANHOLE SAS SERVICE PROPOSED WATER VALVE FIRE HYDRANT & FITTINGS DOUBLE METER SETTING AT LOT LINE SINGLE METER SETTING AT LOT LINE PHASE LINE GAS LINE • • • • • • R.O.W. FUTURE R.O.W. CENTER LINE EDGE OF PAVEMENT

SCALE: 1"=60'

CITY OF ALBUQUERQUE PUBLIC WORKS DEPARTMENT ENGINEERING GROUP

TITLE: THE MEADOWS ON RIO GRANDE
PAVING AND UTILITY MASTER PLAN
PHASE II

APPROVALS ENGINEER DATE APPROVALS ENGINE

CURBING

EXITING DURANES DITCH

IRRIGATION LATERALS

PERIMETER WALL

STREET LIGHTS

 $\equiv X \equiv X$

		LUASE	. !!				
APPROVALS	ENGINEER	DATE	APPROV	ALS	ENGI	NEER	DATE
DRC CHAIRMAN	B.G. Doch	11-30-93	WATER		R.W.	Kane	10-29-93
TRANSPORTATION		1	.ASTE W	ATER	R.W.	Kane	10-29-93
HYDROLOGY	y all	11-22-93					
•	3						
PROJECT		MA	P NO.	SH	EET_	OF	-
NO. 467	7.91		G-12		5	7	7

