



CONSTRUCTION PLANS FOR
DESIGNATED U-3 AREA
WATERLINES FOR
KIRK LANE AND BUTLER LANE

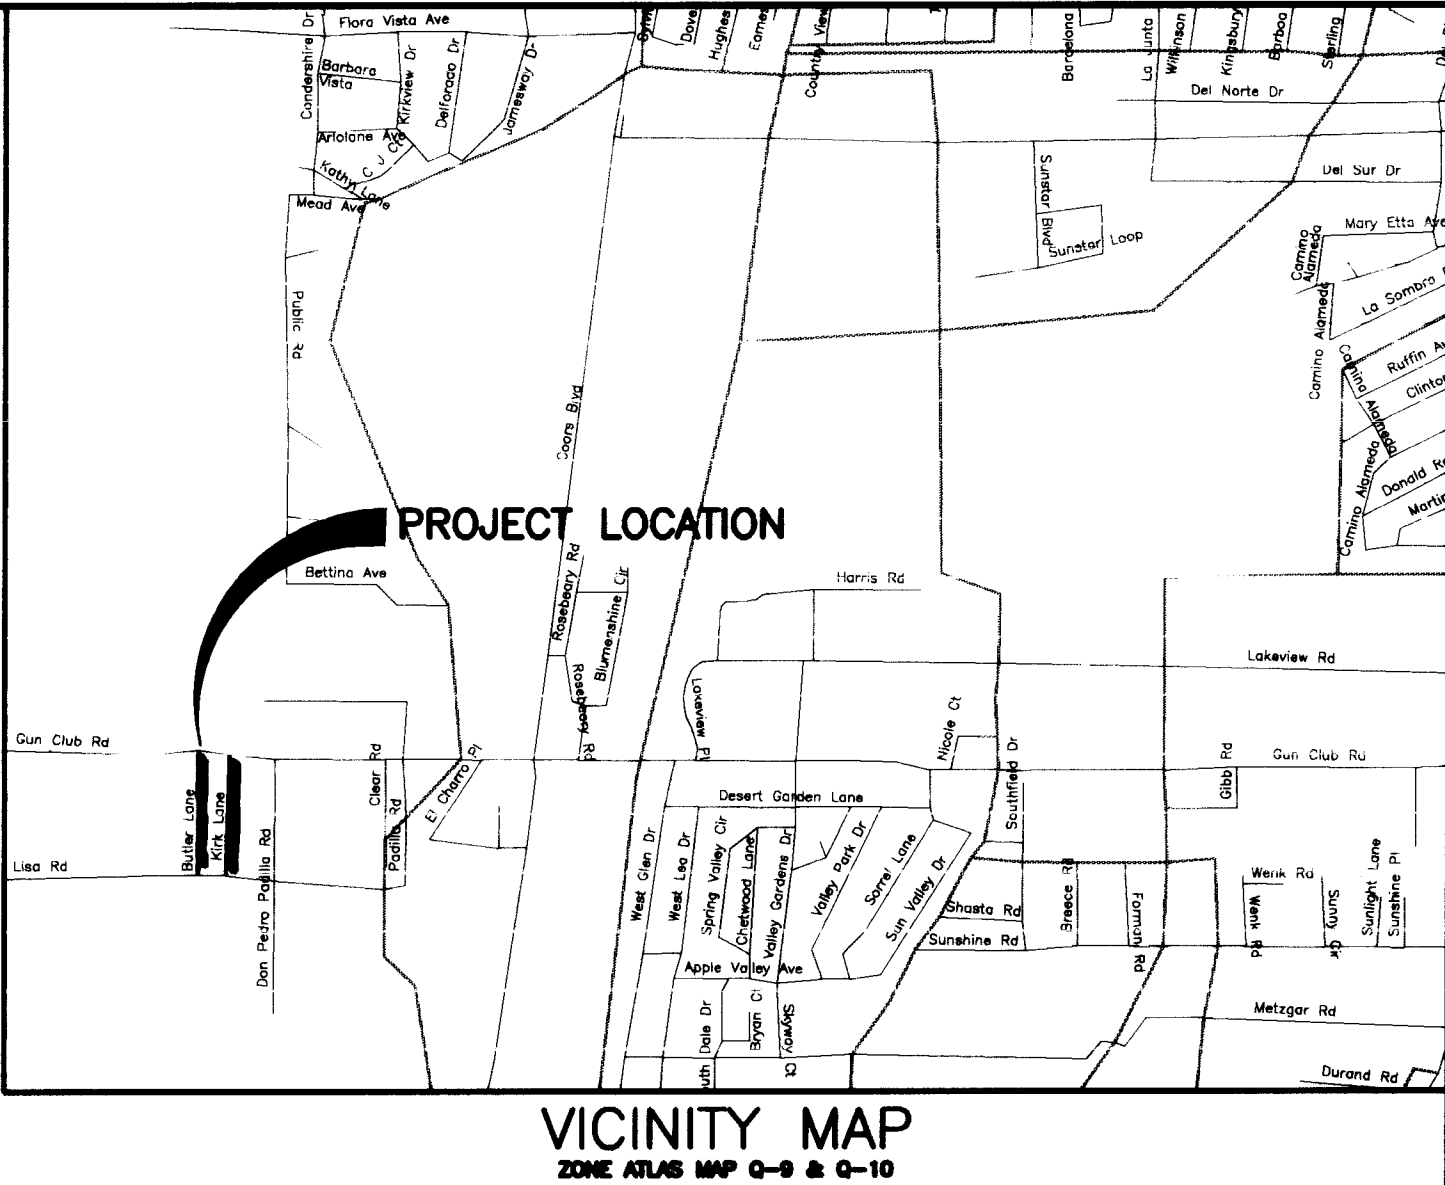

INDEX

SHEET NO.	SHEET TITLE
1	TITLE, LOCATION MAP AND INDEX OF DRAWINGS
2	KIRK LANE - STA. 9+92 TO STA. 20+80
3	BUTLER LANE - STA. 9+92 TO STA. 20+80

20-4686.93 0196

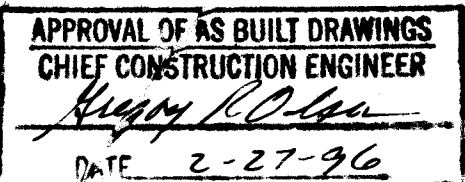

RECORD DRAWING
Drawing revised to reflect the
best information available. Do
not use without field verification.

REV.	SHEETS	CITY ENGR.	DATE	USER DEPT.	DATE	USER DEPT.	DATE
APPROVAL OF REVISIONS							



APPROVED FOR CONSTRUCTION	
BERNALILLO COUNTY	DATE
CITY OF ALBUQUERQUE	DATE



Gannett Fleming West, Inc.
ENGINEERS AND PLANNERS
4501 INDIAN SCHOOL ROAD N.E., SUITE 101
ALBUQUERQUE, NEW MEXICO 87110
TELEPHONE: (505)265-8468

PROJECT NO. 4686.93 SHEET 1 OF 3

DATE: 01-31-95
FILE: C:\ACAD\29290\GRAV\KIRK.WRI.DWG

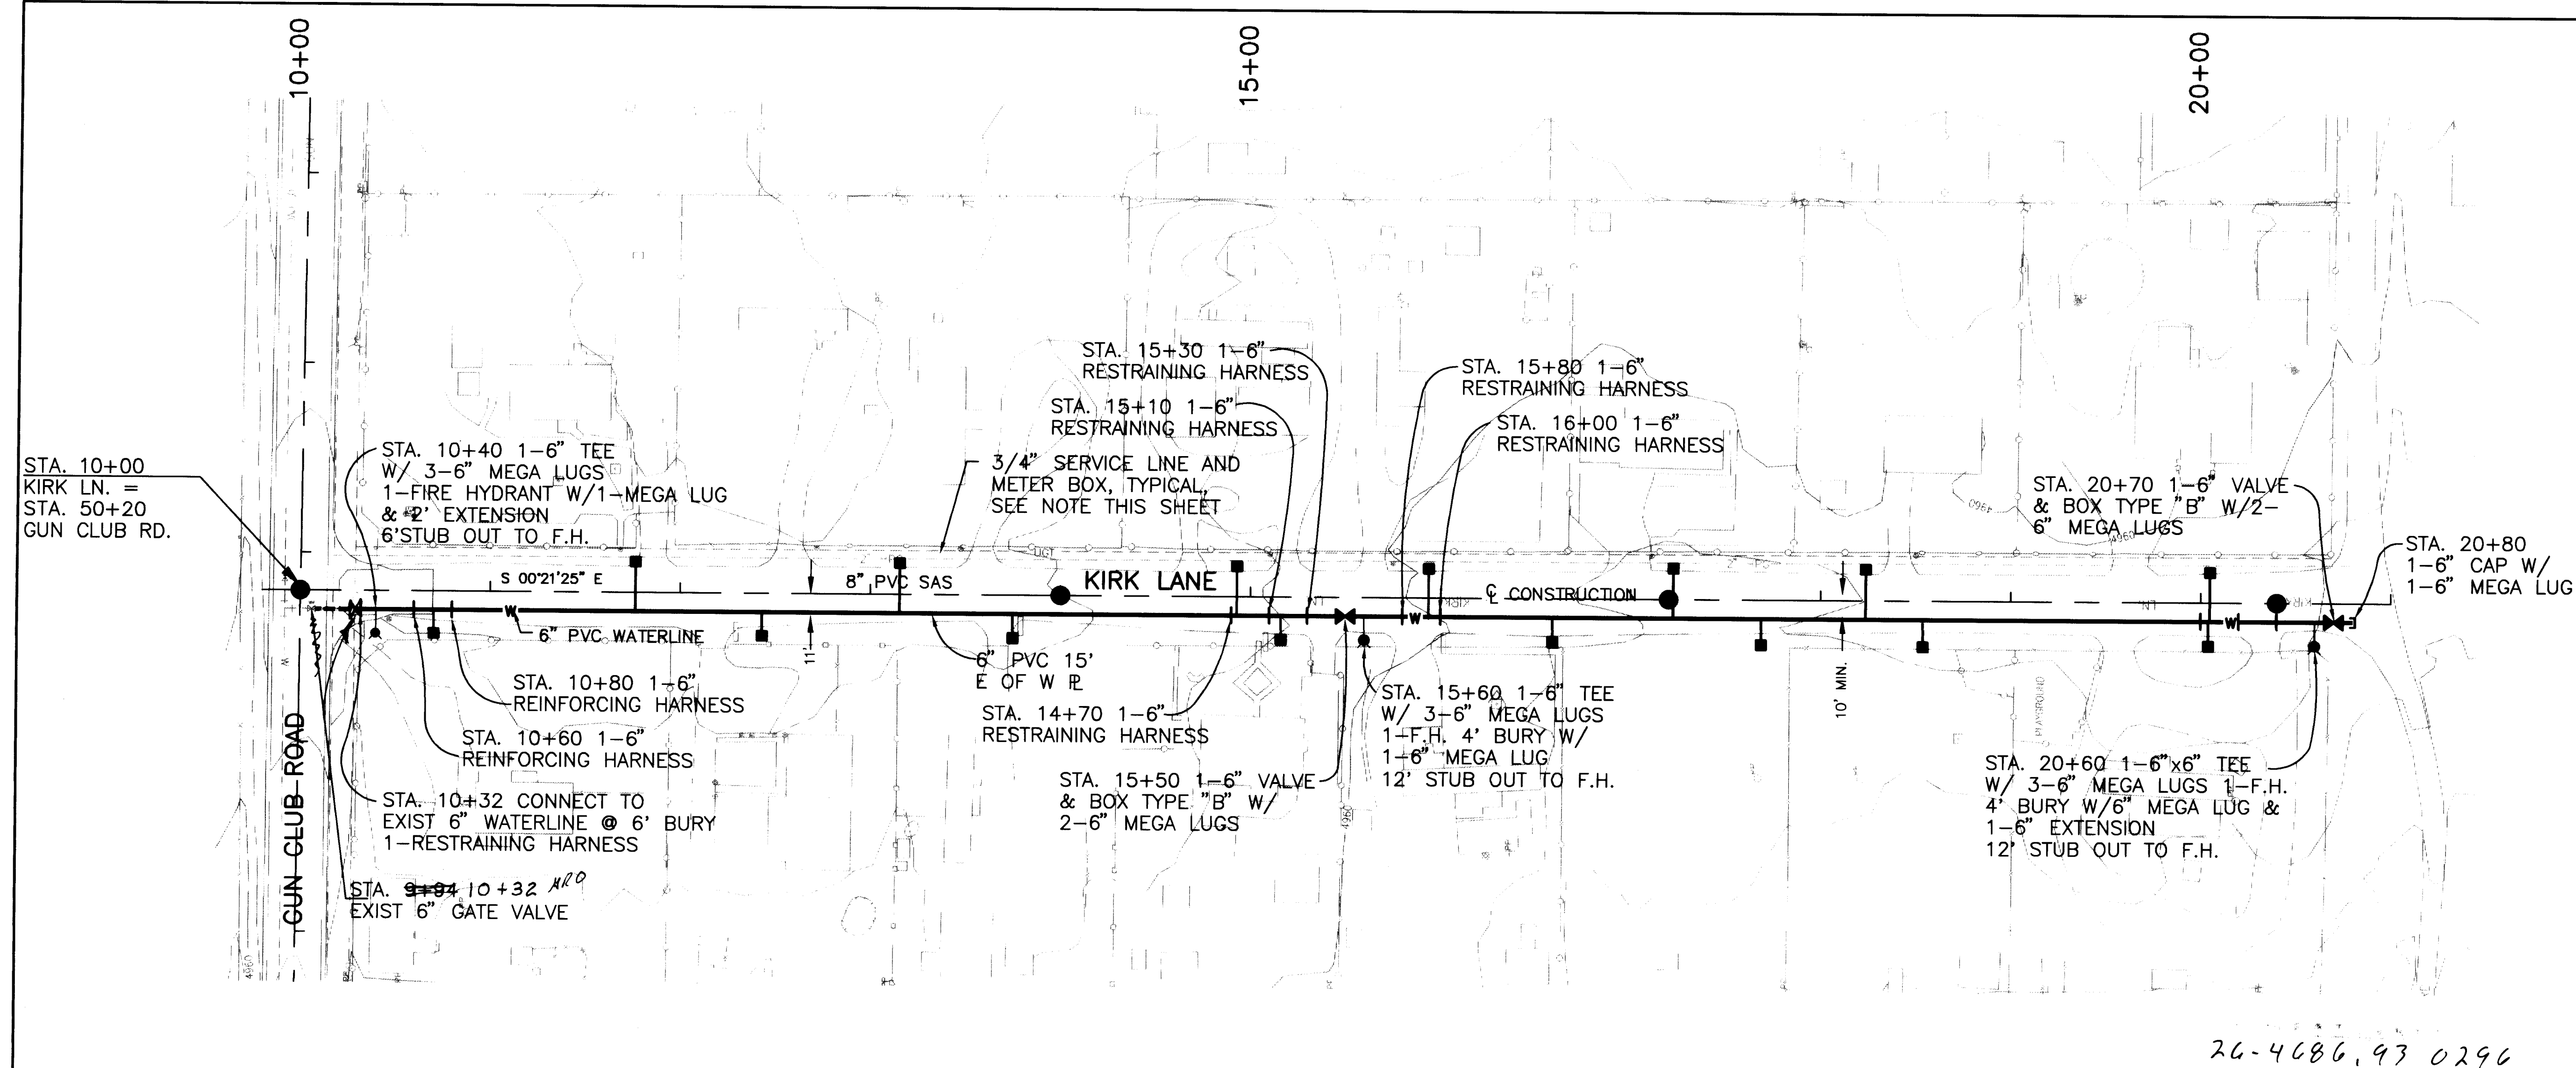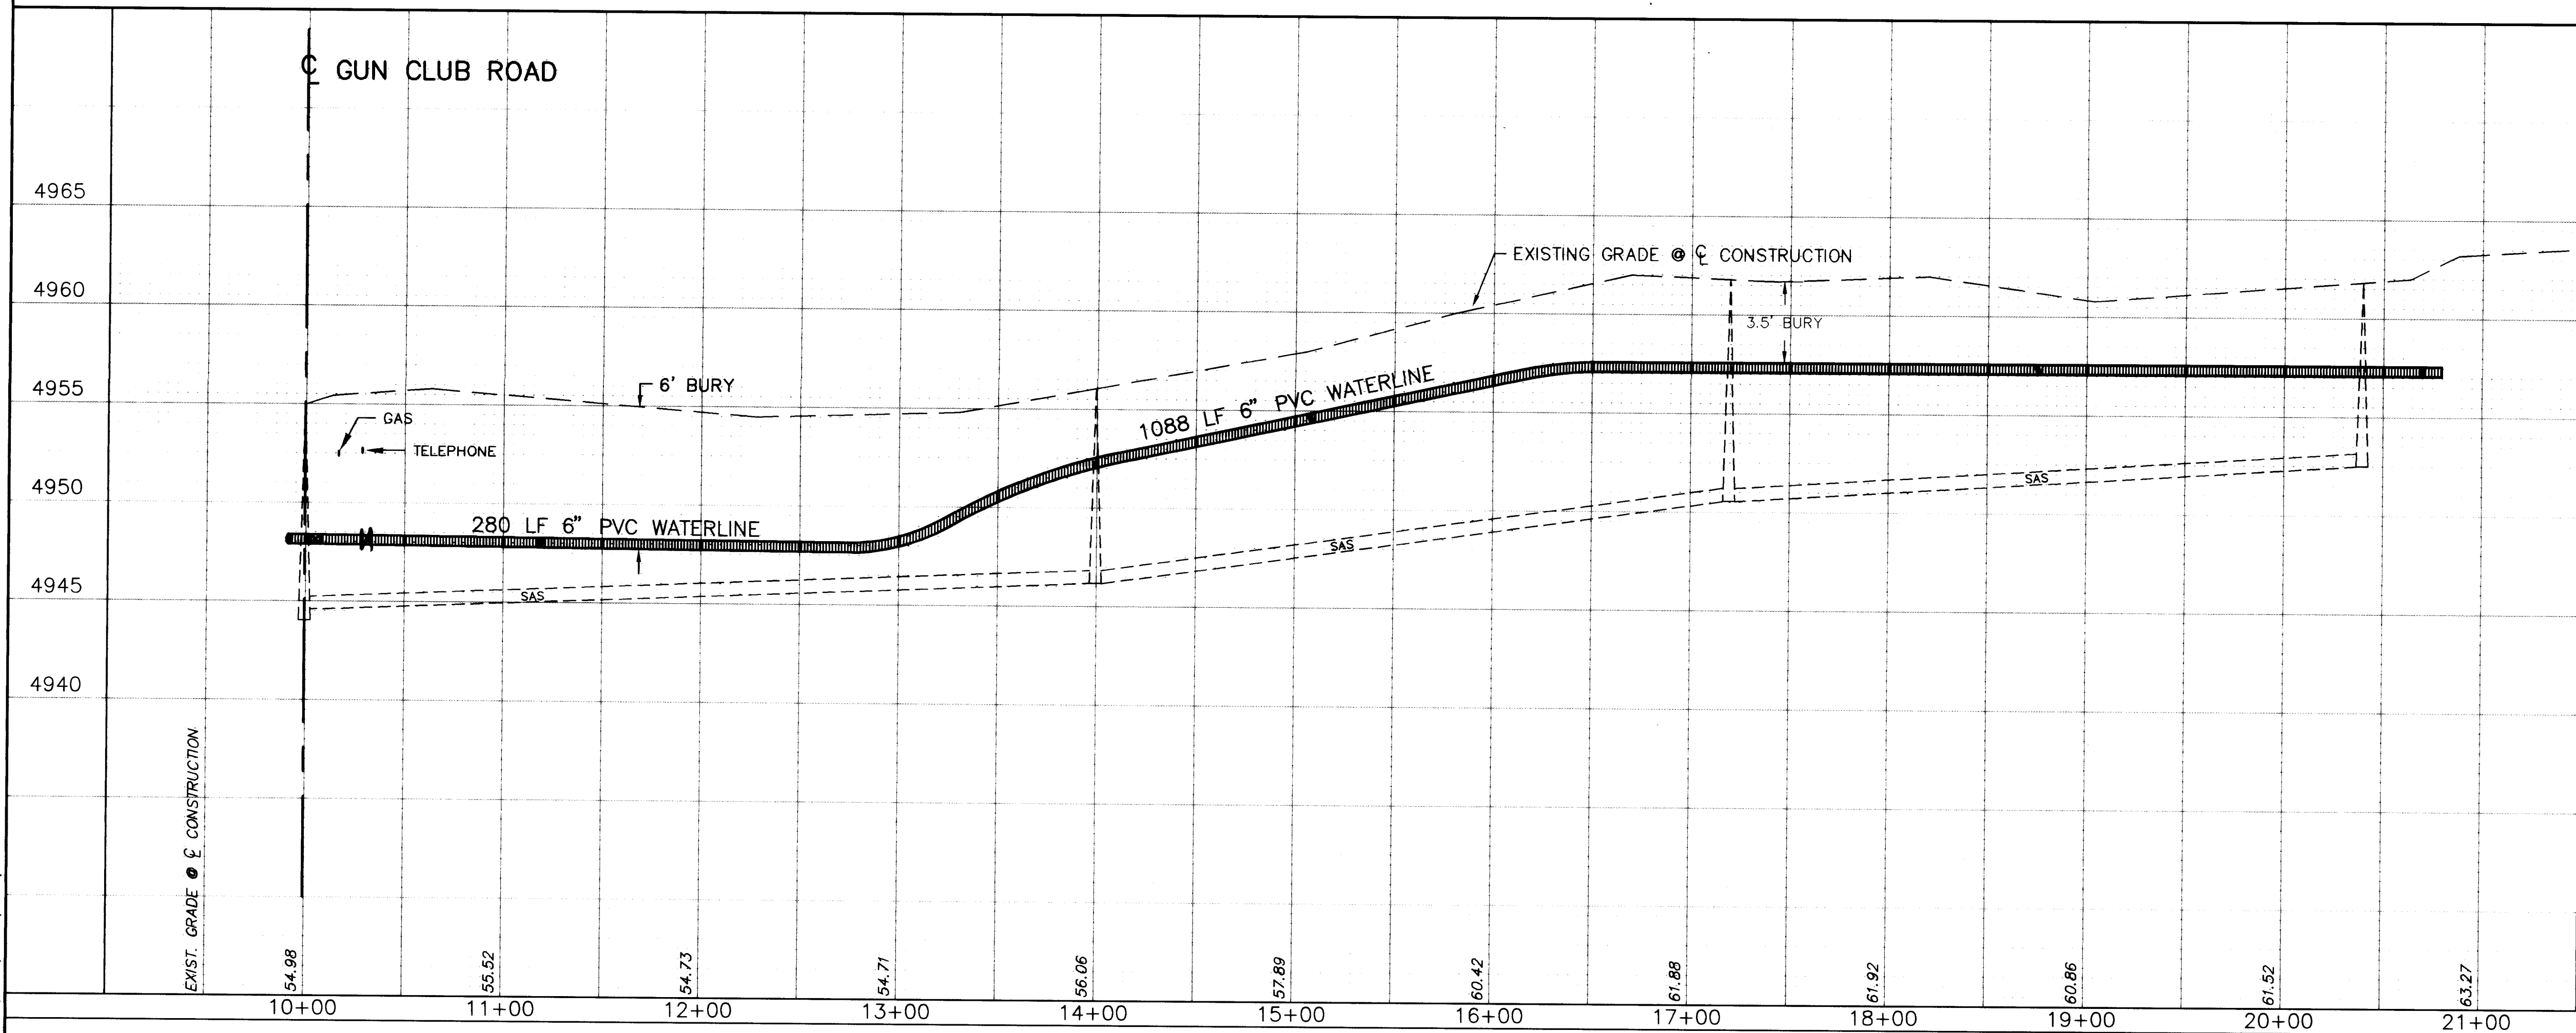

PLAN

SCALE: 1"=50'

PROFILE

SCALE: 1"=50' Horiz.
1"=5' Vert.

LENGTH OF RESTRAINED PIPE (FEET).

6" 90'	28'
6" 45'	12'
6" 22 1/2'	6'
6" 11-1/4'	3'
6" TEE*	37'
6" CAP	37'
6" VALVE	74'

* TEE BRANCH-EACH RUN OF PIPE SHALL BE MIN. 10' W/O JOINTS.

NOTE: ALL WATER SERVICES SHALL BE 3/4". LOCATION OF METER BOXES AND SERVICE LINES SHALL BE DETERMINED IN THE FIELD.

S = SINGLE SERVICE D = DOUBLE SERVICE

WATER SERVICE SCHEDULE	
LOCATION (STATION, OFFSET)	ADDRESS
STA. 11+78 (33')	4400 KIRK LANE S.W.
STA. 10+70 (11')	4401 KIRK LANE S.W.
STA. 13+15 (33')	4404 KIRK LANE S.W.
STA. 12+32 (11')	4405 KIRK LANE S.W.
STA. 13+15 (33')	4410 KIRK LANE S.W.
STA. 13+75 (11')	4409 KIRK LANE S.W.
STA. 14+90 (33')	4414 KIRK LANE S.W.
STA. 15+19 (11')	4413 KIRK LANE S.W.
STA. 15+95 (33')	4418 KIRK LANE S.W.
STA. 16+59 (11')	4415 KIRK LANE S.W.
STA. 17+25 (33')	4504 KIRK LANE S.W.
STA. 17+72 (11')	4505 KIRK LANE S.W.
STA. 18+25 (33')	4508 KIRK LANE S.W.
STA. 18+49 (11')	4447 KIRK LANE S.W.
STA. 20+05 (33')	4512 KIRK LANE S.W.
STA. 20+03 (11')	4449 KIRK LANE S.W.

ENGINEER'S SEAL

NO.	DATE	REVISIONS
1	1/95	WATERLINE ADDED
2	4/95	WATERLINE REVISED
3	1/96	REPLACED = AS-BUILT

DESIGNED BY: JE DATE: JAN. 1995
DRAWN BY: JTN DATE: JAN. 1995
CHECKED BY: JE DATE: JAN. 1995

CITY OF ALBUQUERQUE
PUBLIC WORKS DEPARTMENT
ENGINEERING DIVISION


TITLE:
DESIGNATED U-3 AREA WATERLINES
FOR KIRK LANE AND BUTLER LANE
KIRK LANE WATERLINE
STATION 9+92 TO STATION 20+80

APPROVALS	ENGINEER	DATE	APPROVALS	ENGINEER	DATE
DRC CHAIRMAN			WATER		
TRANSPORTATION			WASTE WATER		
HYDROLOGY					

PROJECT NO. 4686.93 MAP NO. Q-10 SHEET 2 OF 3



DATE: 01-23-96
FILE: L:\PROJECTS\28230\GRAV\ASBUTLW.DWG

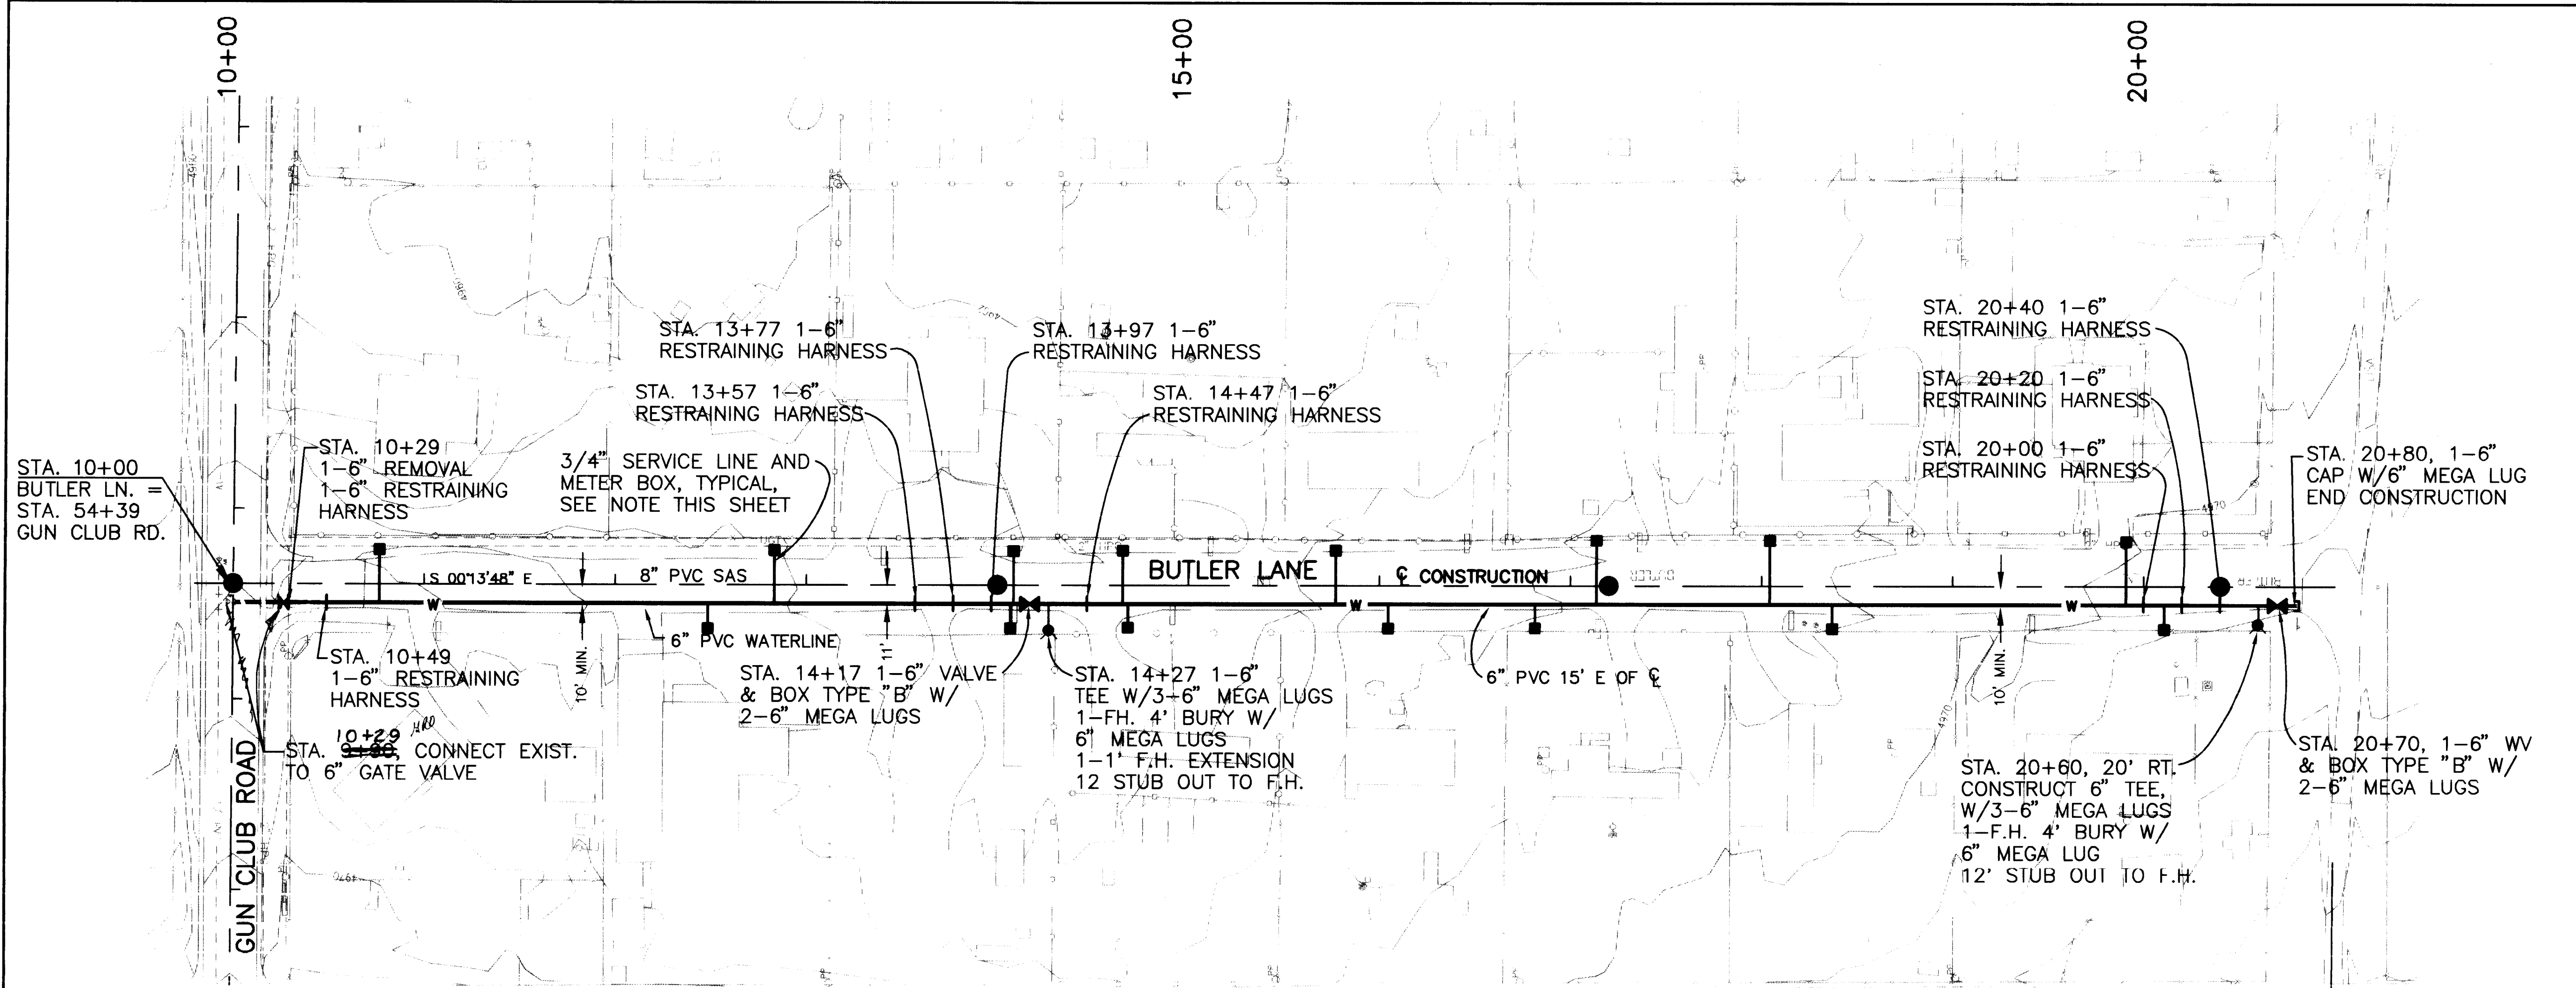

PLAN
SCALE: 1"=50'
PROFILE
SCALE: 1"=50' Horiz.
1"=5' Vert.

LENGTH OF RESTRAINED PIPE (FEET).

6" 90°	28'
6" 45°	12'
6" 2 1/2°	6'
6" 11-1/4°	3'
6" TEE	37'
6" CAP	37'
6" VALVE	74'

* TEE BRANCH-EACH RUN OF PIPE SHALL BE MIN. 10' W/O JOINTS.

NOTE: ALL WATER SERVICES SHALL BE 3/4". LOCATION OF METER BOXES AND SERVICE LINES SHALL BE DETERMINED IN THE FIELD.

S = SINGLE SERVICE
D = DOUBLE SERVICE

WATER SERVICE SCHEDULE

LOCATION (STATION, OFFSET)	ADDRESS
STA. 10+44 (33')	4400 BUTLER LANE S.W.
HOUSE SERVICED OFF OF GUN CLUB UNDER DIFFERENT W.O.	3302 BUTLER LANE S.W.
STA. 12+80 (33')	4404 BUTLER LANE S.W.
STA. 12+52 (11')	4405 BUTLER LANE S.W.
STA. 14+05 (33')	4408 BUTLER LANE S.W.
STA. 14+07 (11')	4409 BUTLER LANE S.W.
STA. 14+64 (33')	4412 BUTLER LANE S.W.
STA. 14+65 (11')	4413 BUTLER LANE S.W.
STA. 15+77 (33')	4500 BUTLER LANE S.W.
STA. 16+06 (11')	4415 BUTLER LANE S.W.
STA. 17+17 (33')	4504 BUTLER LANE S.W.
STA. 16+80 (11')	4505 BUTLER LANE S.W.
STA. 18+03 (33')	4510 BUTLER LANE S.W.
STA. 18+35 (11')	4509 BUTLER LANE S.W.
STA. 19+95 (33')	4512 BUTLER LANE S.W.
STA. 20+10 (11')	4513 BUTLER LANE S.W.

AS BUILT INFORMATION

CONTRACTOR: MCG, INC. DATE: 12/95
DESIGNED BY: W/1504 f. CO. DATE: 12/95
FIELD ACCEPTANCE BY: MCG & CO. DATE: 12/95
CORRECTED BY: GANNETT FLEMING WEST DATE: 01/96
RECORDED BY: DATE: NO.

SURVEY INFORMATION

DATE: BY: NO.

FIELD NOTES

ENGINEER'S SEAL

REVISIONS

NO.	DATE	REMARKS
1	1/96	REPLOTTED AS-BUILTS

DESIGNED BY: JE
DRAWN BY: JTN
CHECKED BY: JE

DATE: JAN. 1995
DATE: JAN. 1995
DATE: JAN. 1995

CITY OF ALBUQUERQUE
PUBLIC WORKS DEPARTMENT
ENGINEERING DIVISION

TITLE: DESIGNATED U-3 AREA
WATERLINES FOR KIRK LANE AND BUTLER LANE
BUTLER LANE WATERLINE
STATION 9+92 TO STATION 20+80

APPROVALS	ENGINEER	DATE	APPROVALS	ENGINEER	DATE
DRC CHAIRMAN			WATER		
TRANSPORTATION			WASTE WATER		
HYDROLOGY					

PROJECT NO. 4686.93

MAP NO. Q-10

SHEET 3 OF 3

2 3 4 5 6 7 8 9 10 11 12 13 14 15
24-4686.93 101792