


CITY OF ALBUQUERQUE, NEW MEXICO
PUBLIC WORKS DEPARTMENT
UTILITIES DIVISION

CONSTRUCTION PLANS
FOR
SOUTH VALLEY SEWER EXTENSIONS, PHASE IIA
LOS PADILLAS AREA
VACUUM COLLECTION SYSTEM
CITY PROJECT NO. 4687.91

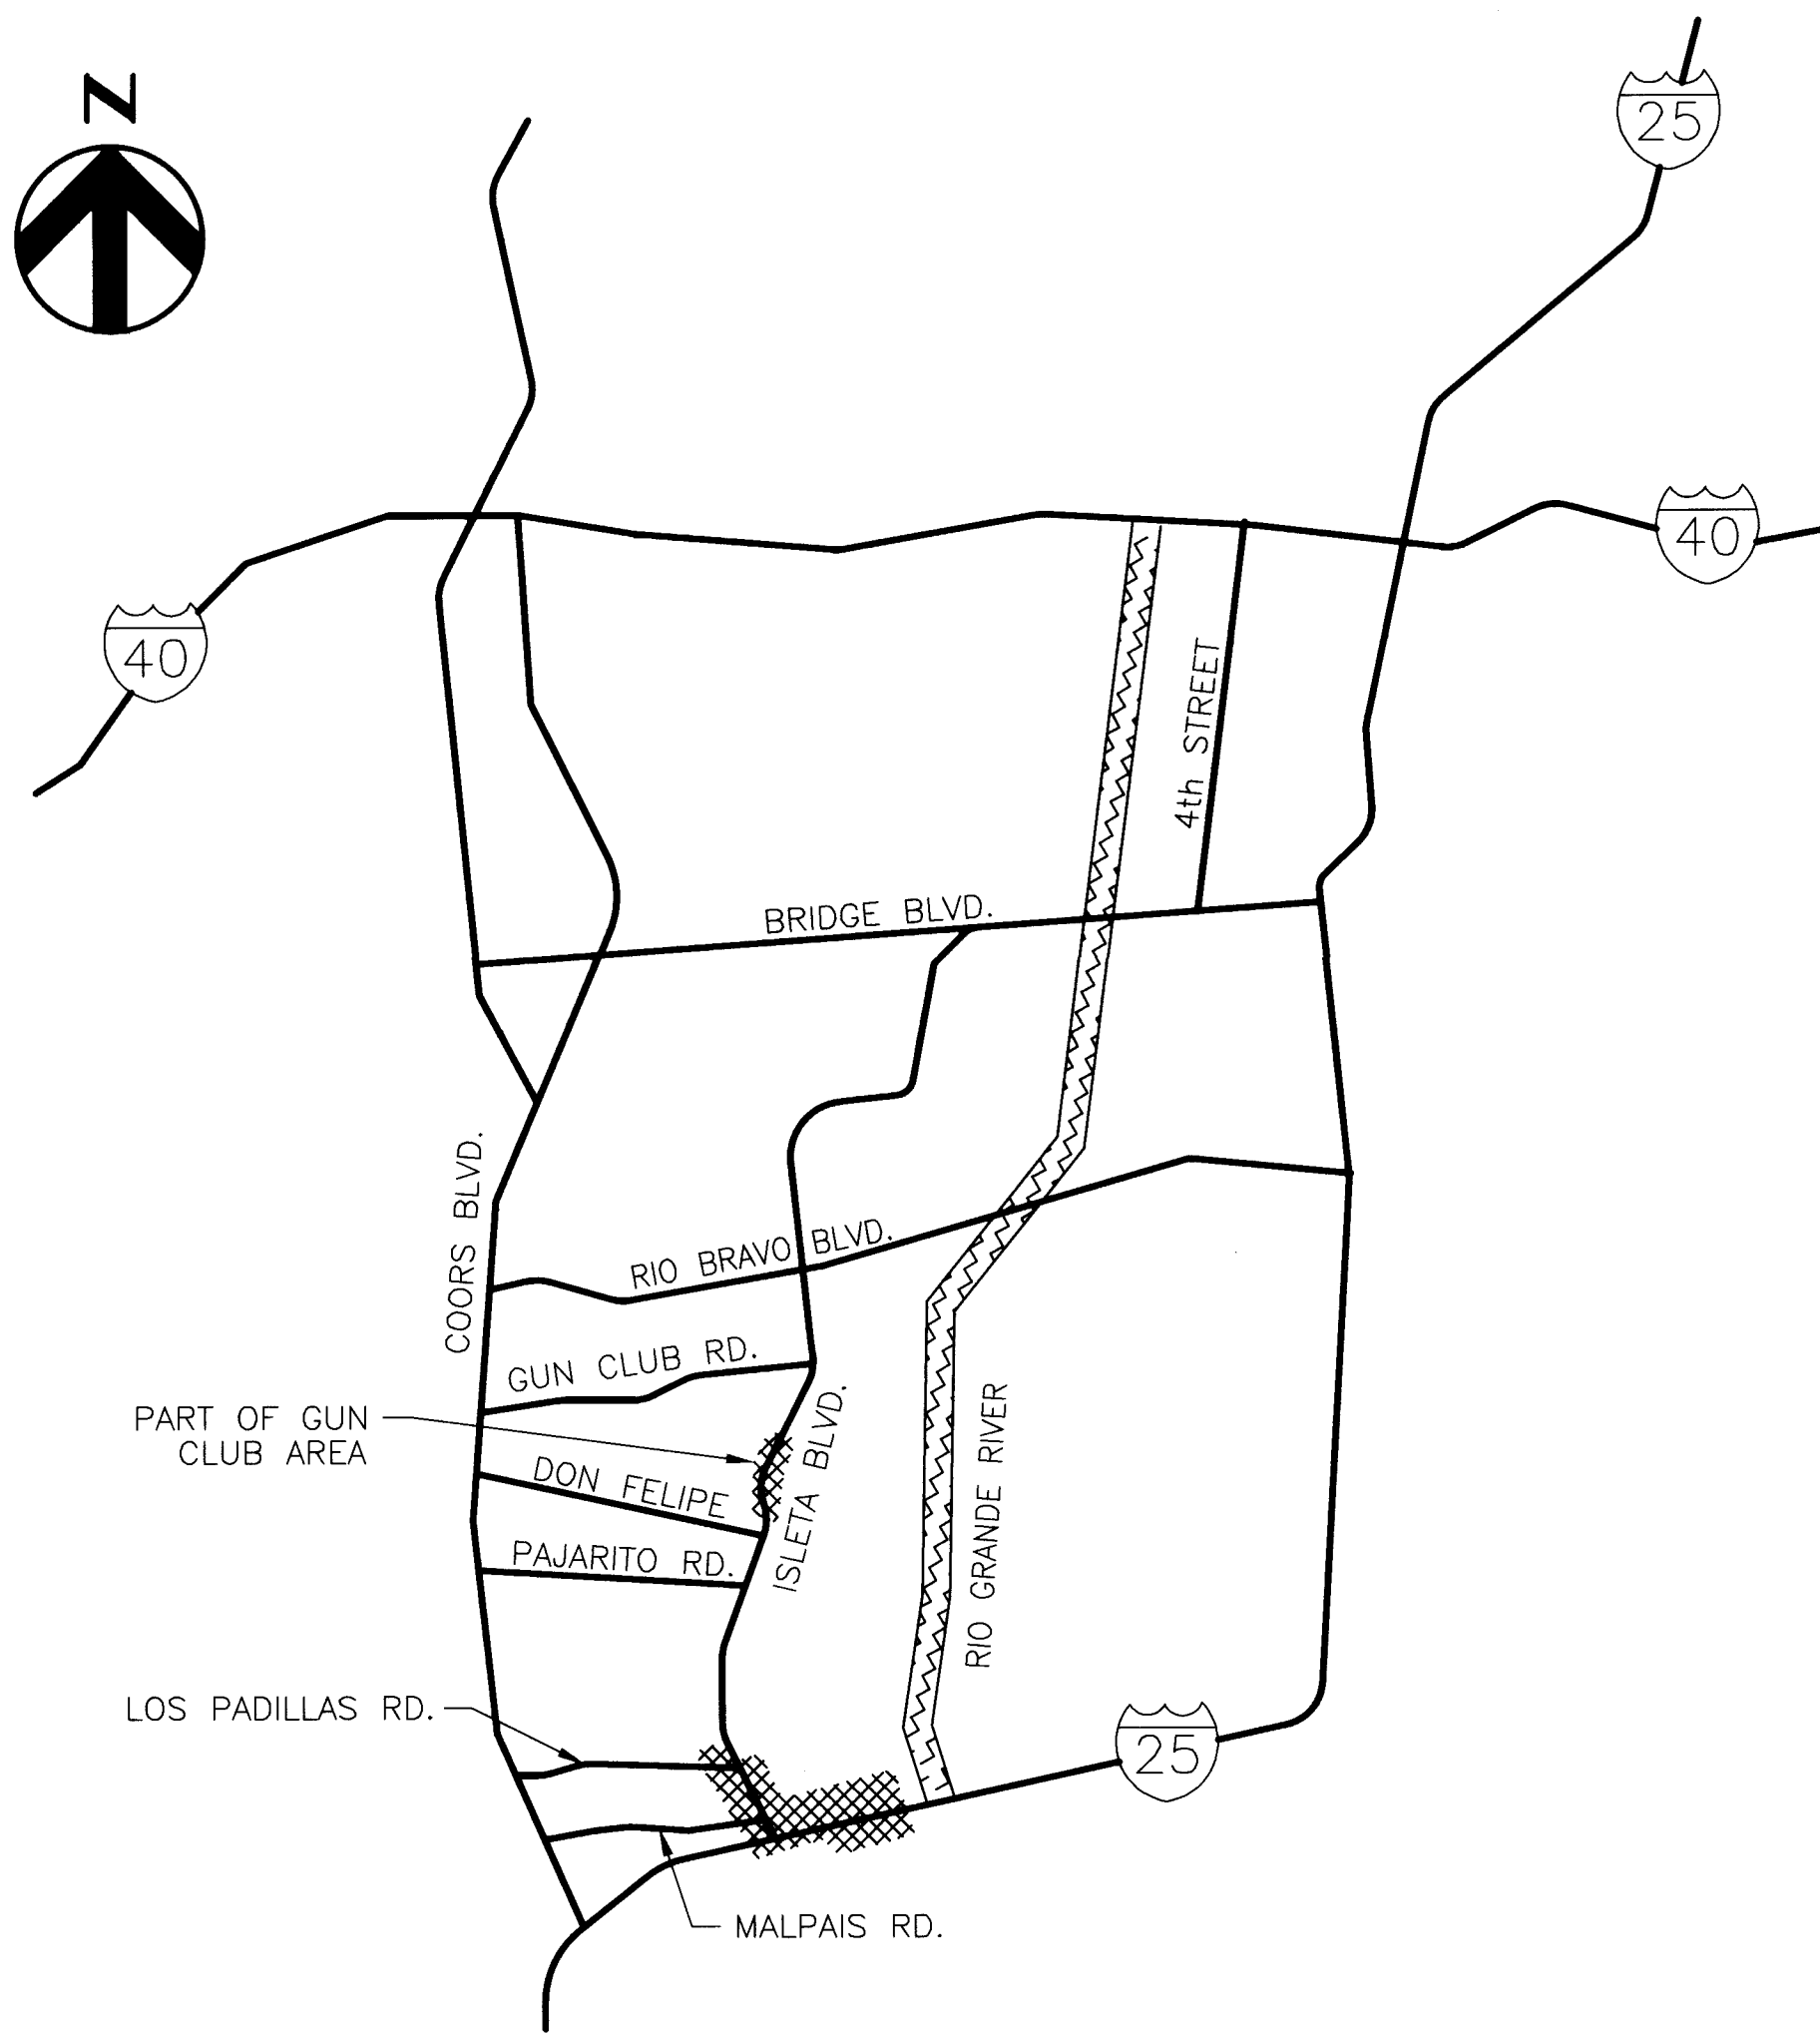

APPROVAL OF AS BUILT DRAWINGS
CHIEF CONSTRUCTION ENGINEER
Signature
DATE 11/18/96

"AS RECORDED"
From Information
provided by the
contractors
By *Signature* Date 7/24/96

26-4687.91 G3097

REVISIONS SHEET	CITY ENGINEER	DATE	USER DEPARTMENT	DATE	USER DEPARTMENT	DATE
APPROVAL OF REVISIONS						

APPROVED FOR CONSTRUCTION
Signature 12-19-94
BERNALILLO COUNTY
Signature 12/19/94
CITY OF ALBUQUERQUE




PROJECT NO. 4687.91
SHEET COVER
HDR Engineering, Inc.

38 sheets in this set 11/14/96

SOUTH VALLEY SEWER EXTENSIONS
LOS PADILLAS AREA - PHASE IIA
VACUUM COLLECTION SYSTEM

"AS RECORDED"
From Information
provided by the
contractors
By *[Signature]* Date *2/26/96*

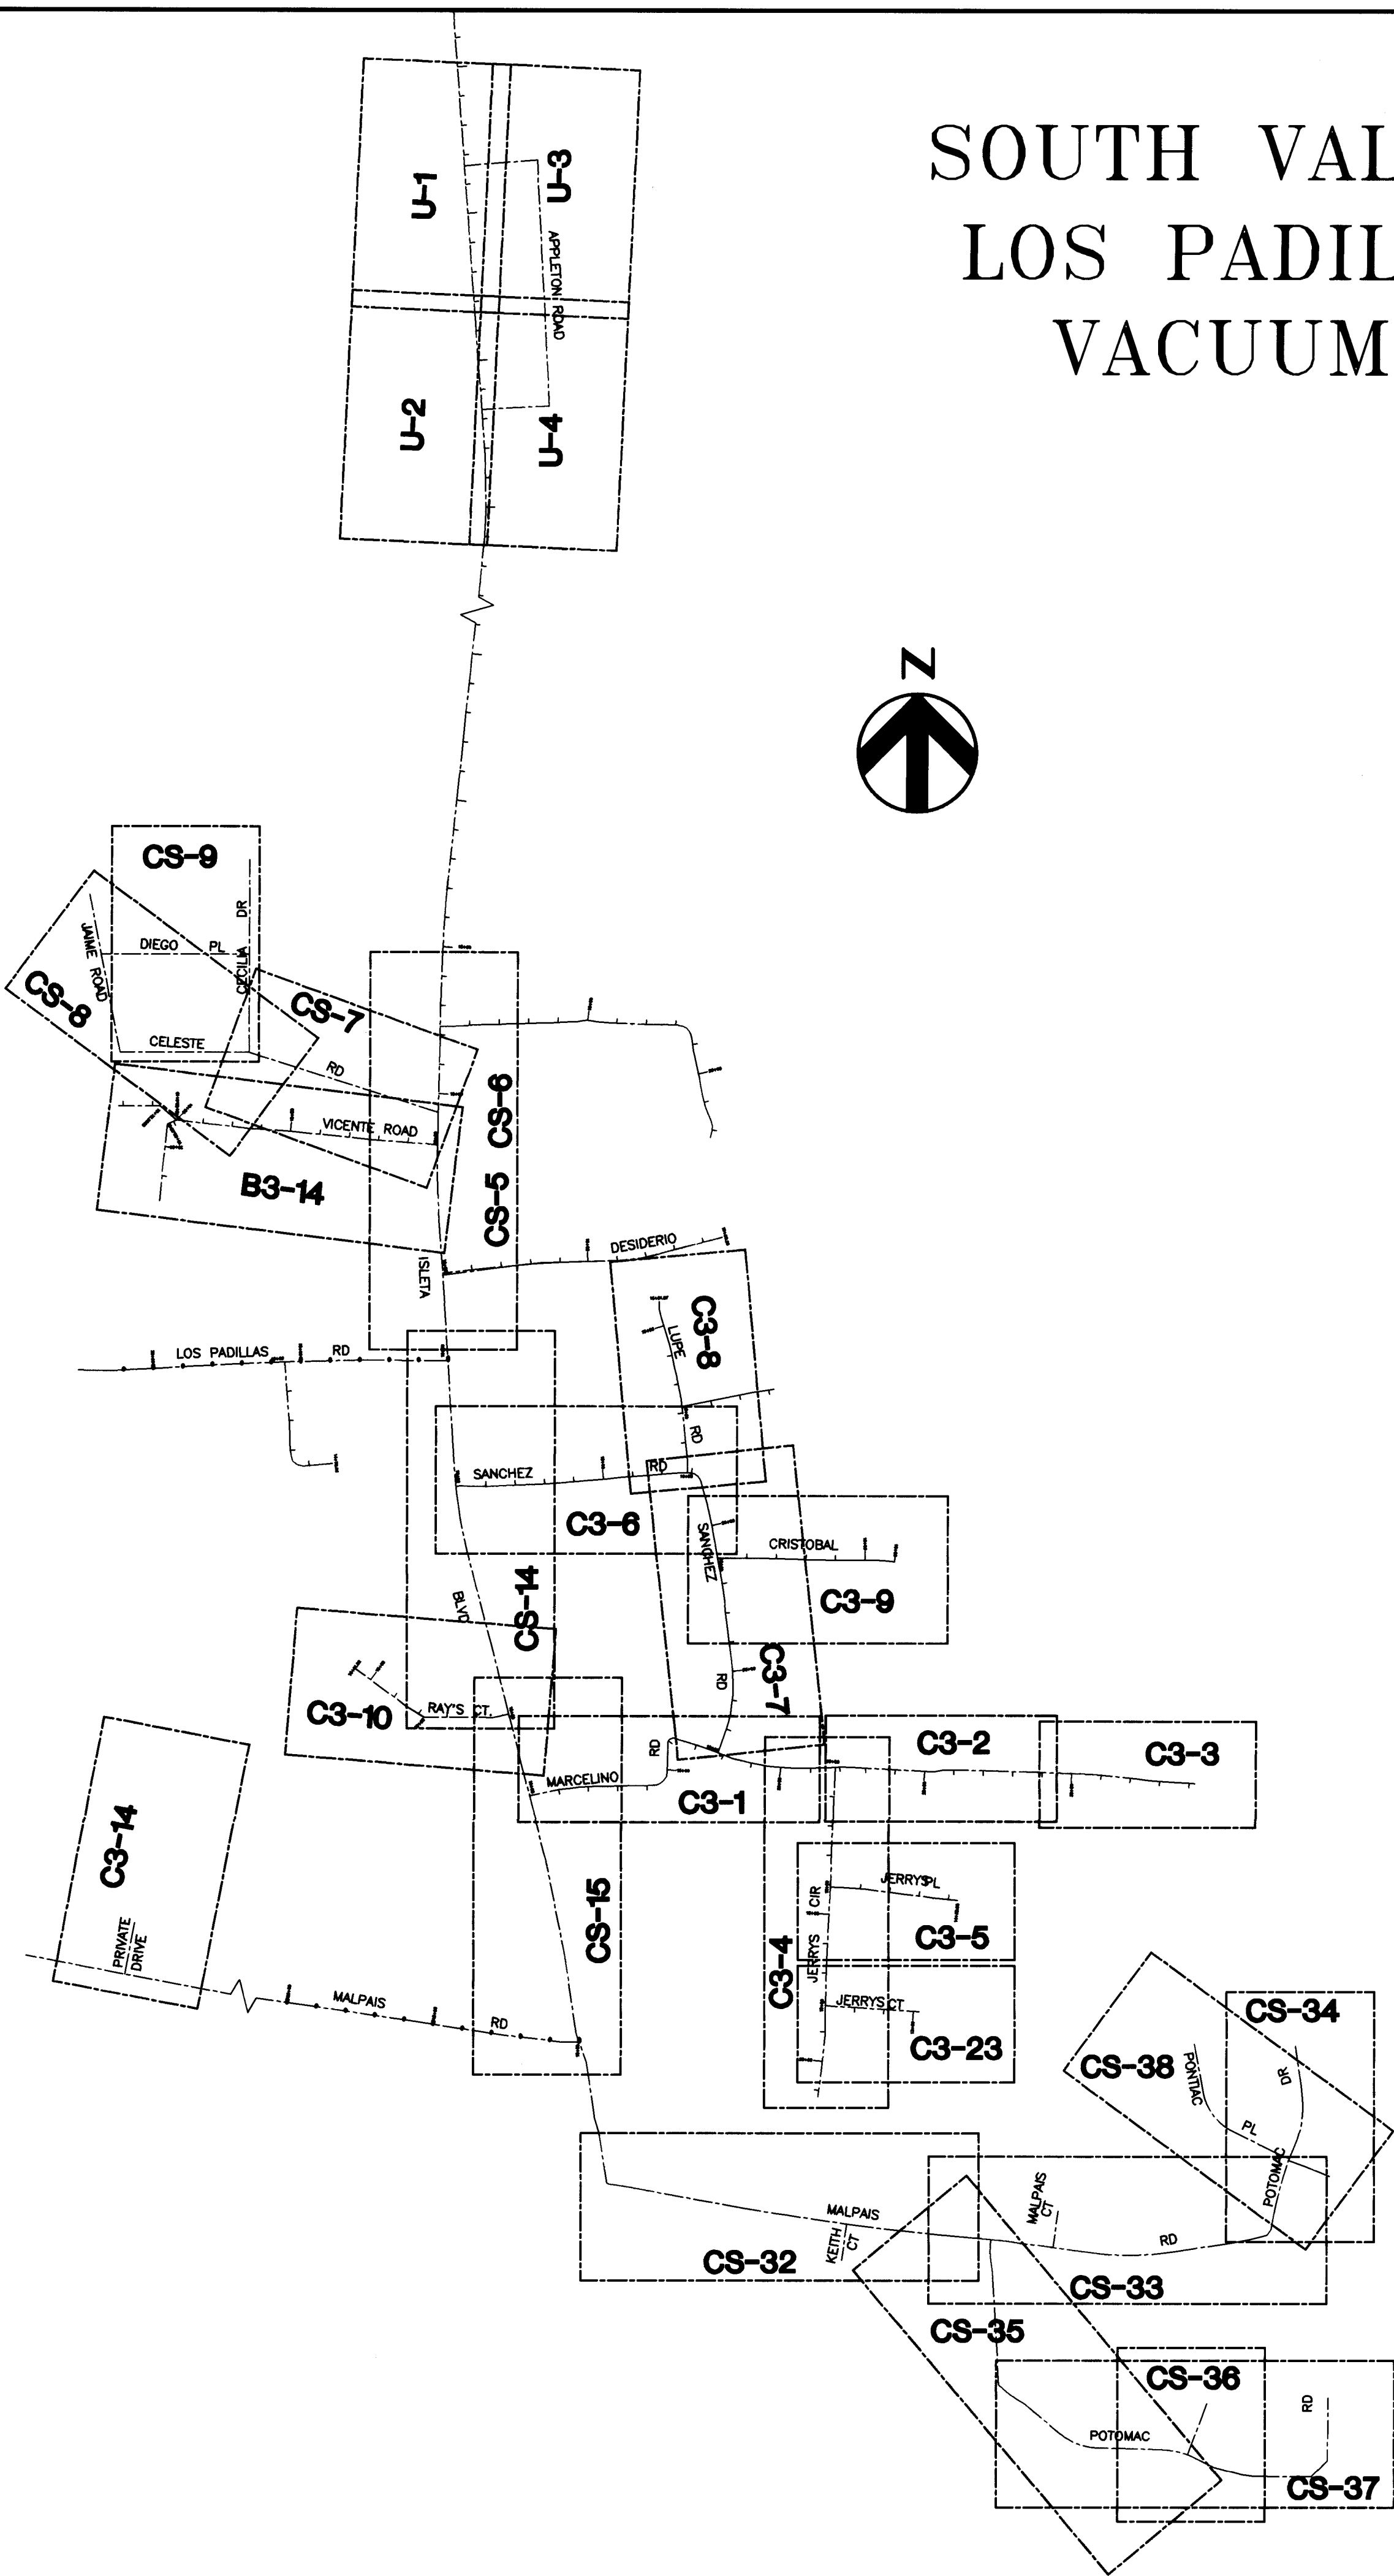

- Cover
- C3-1 SHEET INDEX
- C3-2 GENERAL NOTES
- G-2 OVERALL COLLECTION SYSTEM PLAN
- B3-14 VICENTE ROAD S.W.
- C3-1 MARCELINO ROAD (PART 1)
- C3-2 MARCELINO ROAD (PART 2)
- C3-3 MARCELINO ROAD (PART 3)
- C3-4 JERRY'S CIRCLE
- C3-5 JERRY'S PLACE
- C3-6 SANCHEZ ROAD (PART 1)
- C3-7 SANCHEZ ROAD (PART 2)
- C3-8 LUPE ROAD / ENTRADA
- C3-9 CRISTOBAL ROAD
- C3-10 RAY'S COURT
- C3-14 PRIVATE DRIVE C4
- C3-23 JERRY'S COURT
- CS-5 ISLETA BLVD. (EAST SIDE)
- CS-6 ISLETA BLVD. (WEST SIDE)
- CS-7 CELESTE ROAD
- CS-8 CELESTE ROAD / JAIME DRIVE
- CS-9 CECILIA DRIVE / DIEGO PLACE
- CS-14 ISLETA BLVD. (EAST SIDE)
- CS-15 ISLETA BLVD. (EAST SIDE)
- CS-32 MALPAIS ROAD / KEITH COURT
- CS-33 MALPAIS ROAD & MALPAIS COURT
- CS-34 POTOMAC DRIVE
- CS-35 POTOMAC ROAD
- CS-36 POTOMAC ROAD
- CS-37 POTOMAC ROAD
- CS-38 PONTIAC PLACE
- U1-U4 GUN CLUB CHANGE ORDER SHEETS
- 1, 2, 3 OF 3 STANDARD DETAIL SHEETS

AS BUILT INFORMATION			BENCH MARKS			SURVEY INFORMATION			ENGINEER'S SEAL			REVISIONS			DESIGN			
CONTRACTOR	TRAD	DATE 10/95	From centerline of Pajarito and Isleta, travel North 126° ± to the BM on the West side of the street. The BM is a standard ACS 3 1/4", aluminum cap rivetted to a pipe 0.25' above ground. Cap is stamped "5-R11, 1988".	DATE	BY	NO.	DATE	BY	NO.	DATE	BY	NO.	DATE	BY	NO.	DATE	BY	NO.
WORK ORDER	DATE 10/95	DATE 10/95																
ACCEPTANCE BY	WILSON & CO.	DATE 11/95																
DRAWINGS	DATE 11/95	DATE 11/95																
CONTRACTED BY	HDR ENGINEERING	DATE																
RECORDED BY	DATE																	
NO.																		

26-4687.9163197

HDR
HDR Engineering, Inc.


CITY OF ALBUQUERQUE
PUBLIC WORKS DEPARTMENT
ENGINEERING DEVELOPMENT GROUP

TITLE: SOUTHWEST VALLEY SEWER EXTENSIONS
LOS PADILLAS VACUUM COLLECTION SYSTEM - PHASE IIA
SHEET INDEX

APPROVALS	ENGINEER	DATE	APPROVALS	ENGINEER	DATE
DRC CHAIRMAN			WATER		
TRANSPORTATION			WASTE WATER		
HYDROLOGY					

PROJECT NO. 4687.91 MAP NO. SHEET G3-1 OF 2



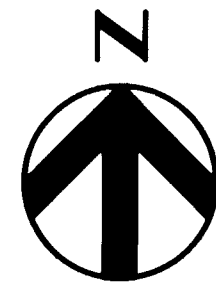

PLAN
SCALE: 1"=400'

"AS RECORDED"
From Information
provided by the
contractors
By *[Signature]* Date *2/24/96*

LEGEND

---	PHASE II
---	PHASE IIA
•	PIT
✕	VALVE
▼	REDUCER

--	--	

HDR
HDR Engineering, Inc.

CITY OF ALBUQUERQUE
PUBLIC WORKS DEPARTMENT
ENGINEERING DEVELOPMENT GROUP
TITLE: SOUTHWEST VALLEY SEWER EXTENSIONS
LOS PADILLAS VACUUM COLLECTION SYSTEM - PHASE IIA
OVERALL COLLECTION SYSTEM PLAN


APPROVALS	ENGINEER	DATE	APPROVALS	ENGINEER	DATE
DRC CHAIRMAN			WATER		
TRANSPORTATION			WASTE WATER		
HYDROLOGY					

PROJECT NO.	4678.91	MAP NO.		SHEET	OF
				G-2	


26-4687.91 16 2/97

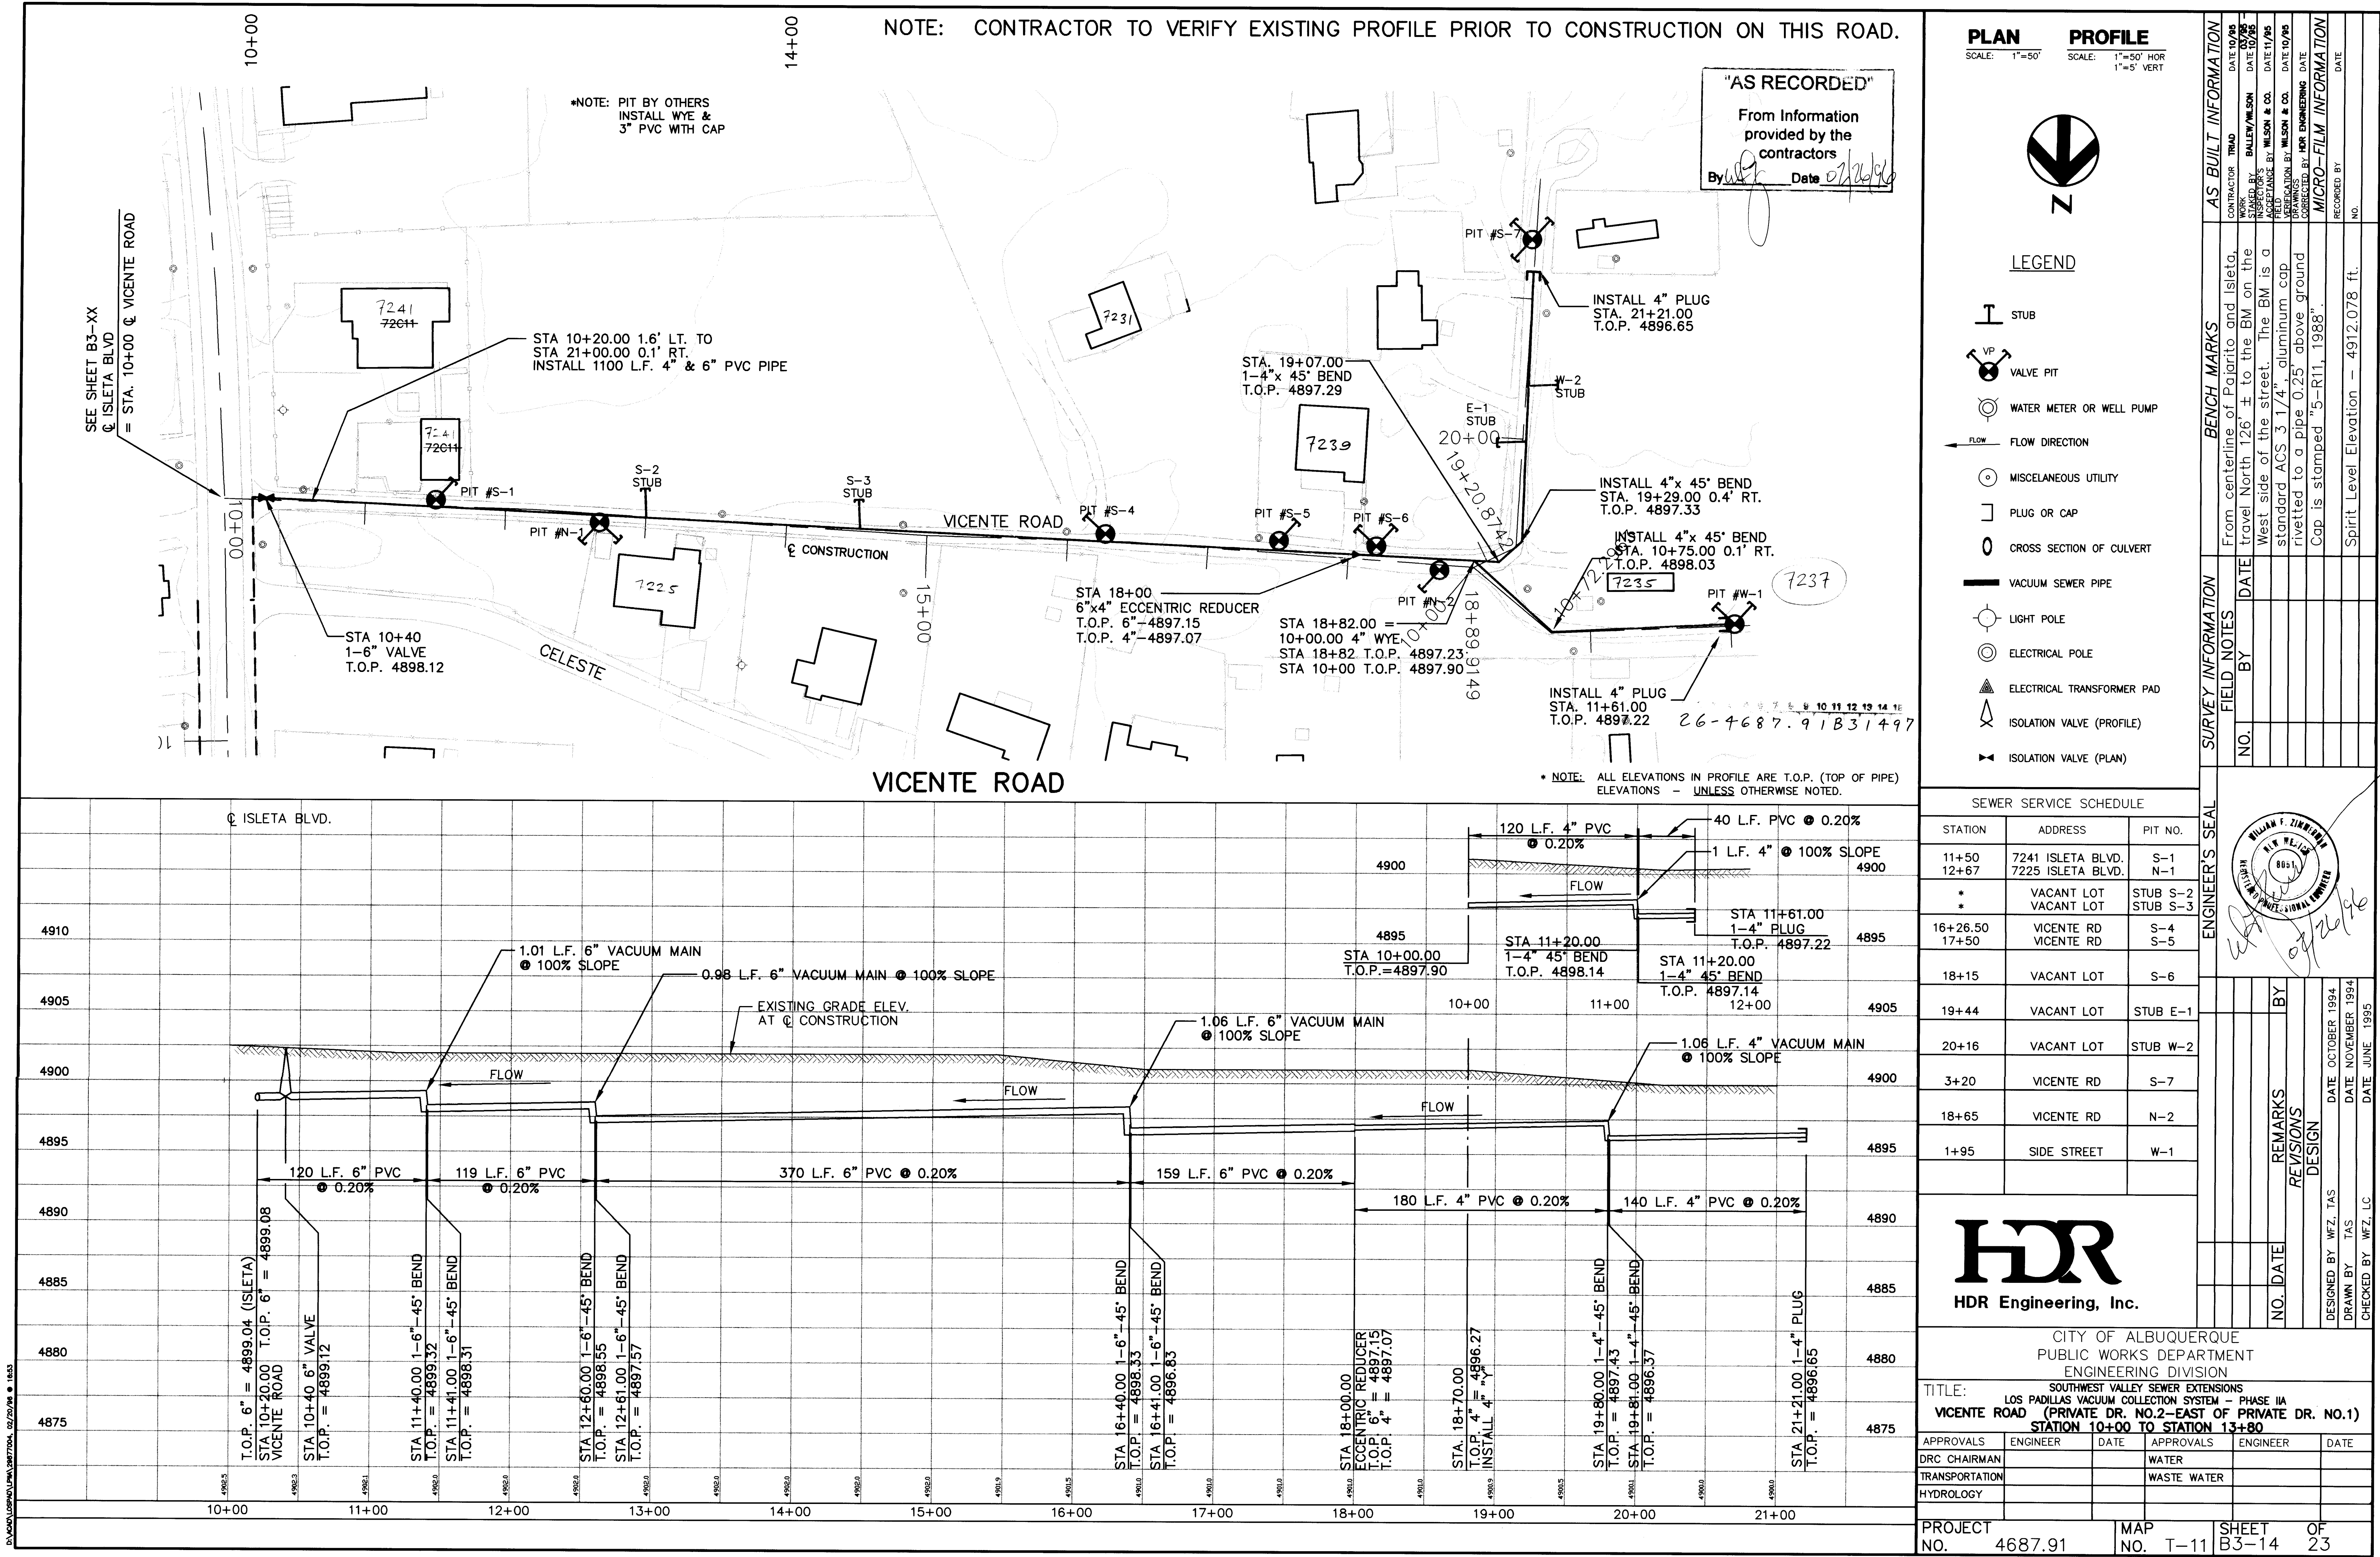

11A\29877019.dwg

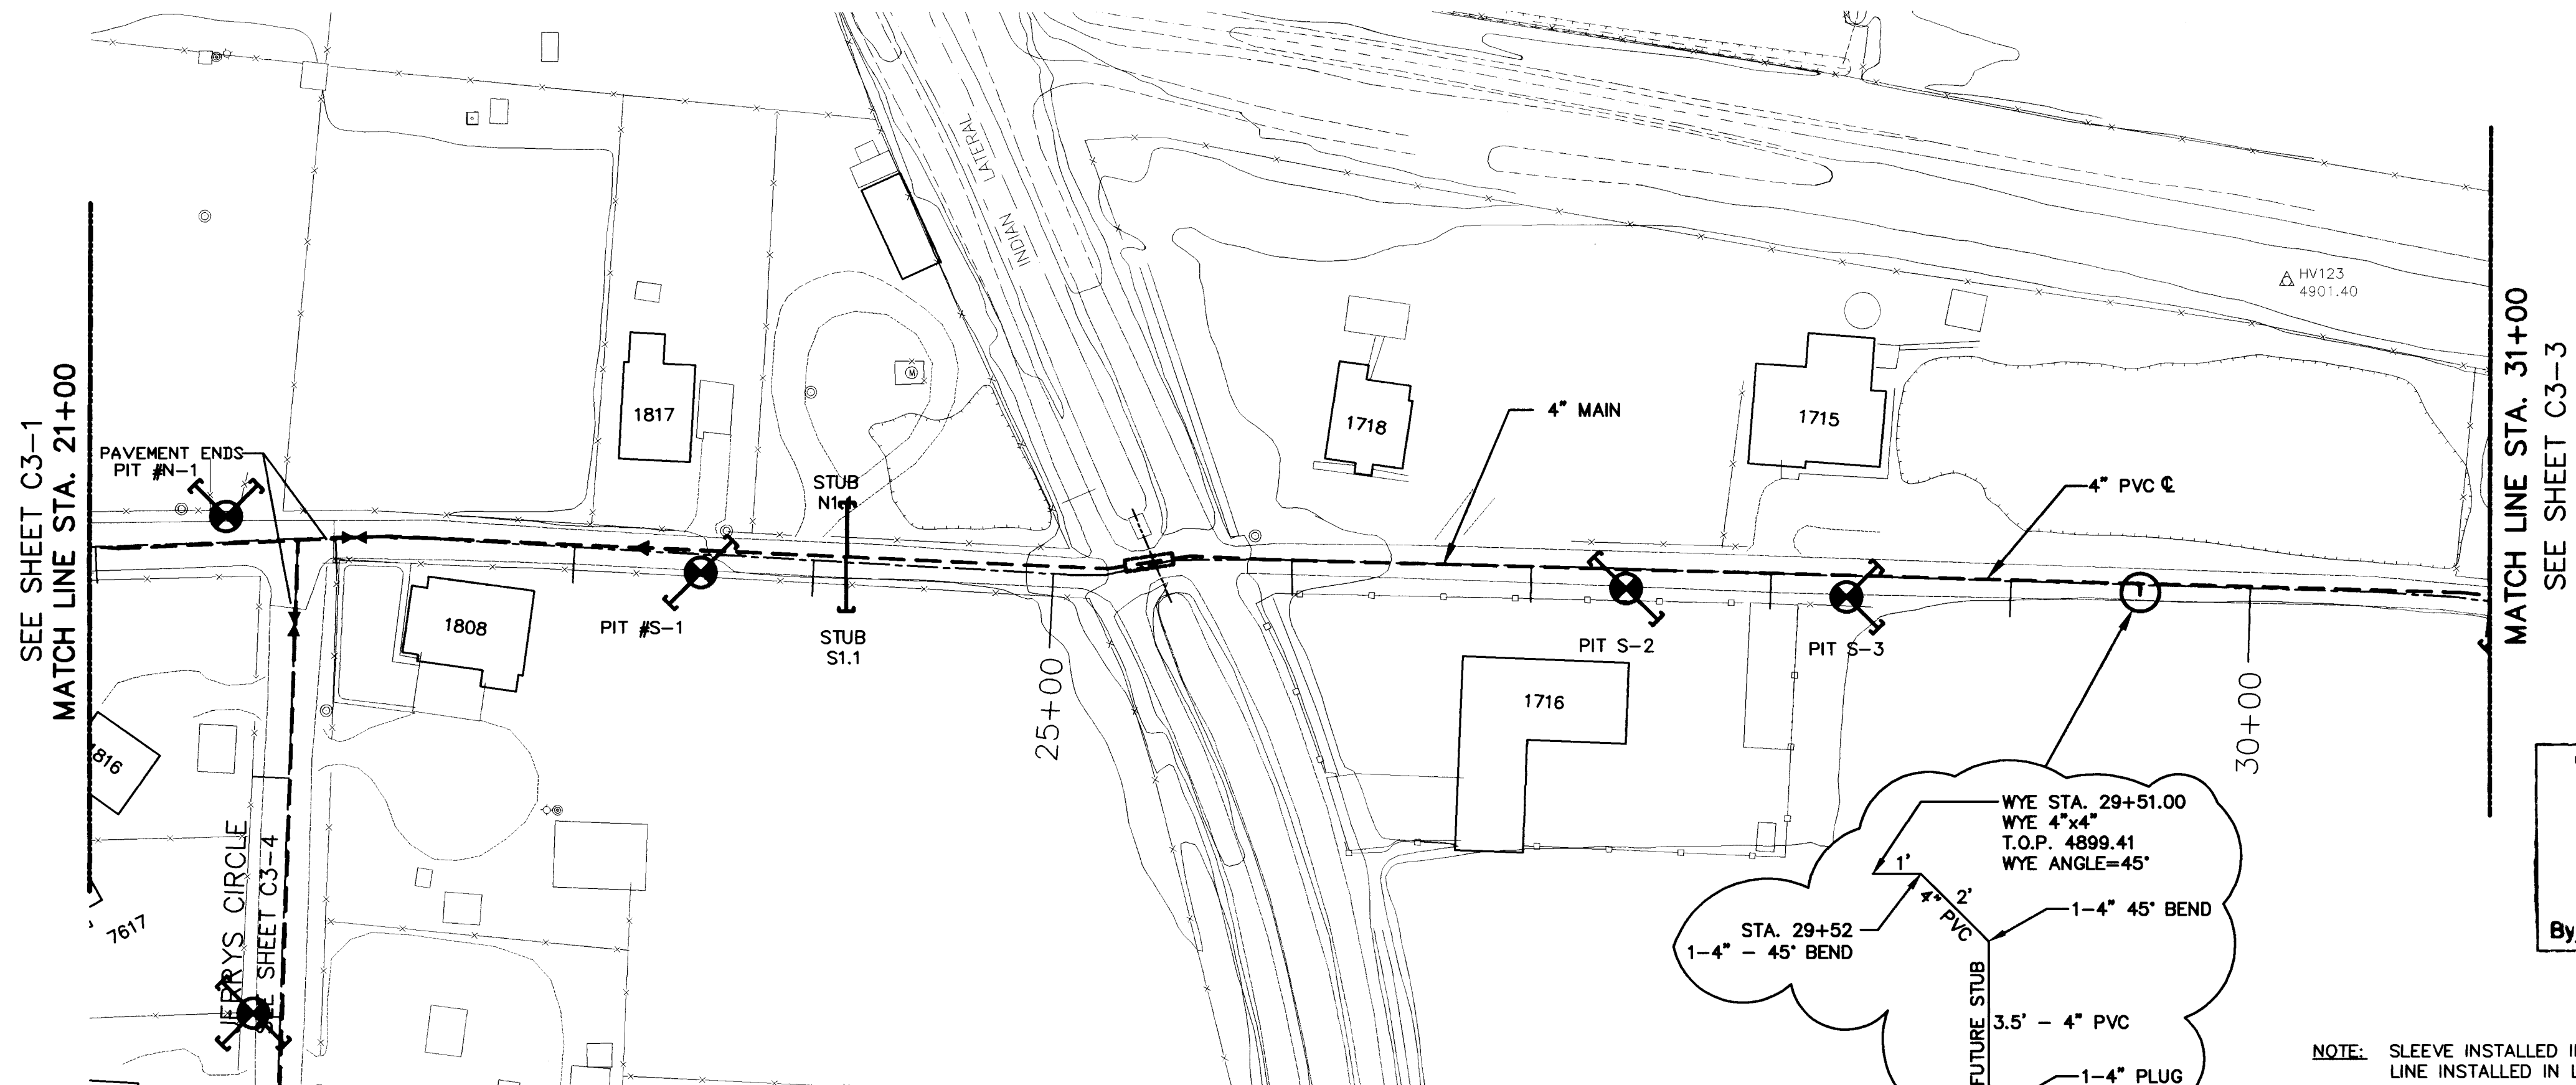

MARCELINO ROAD (PART 2)

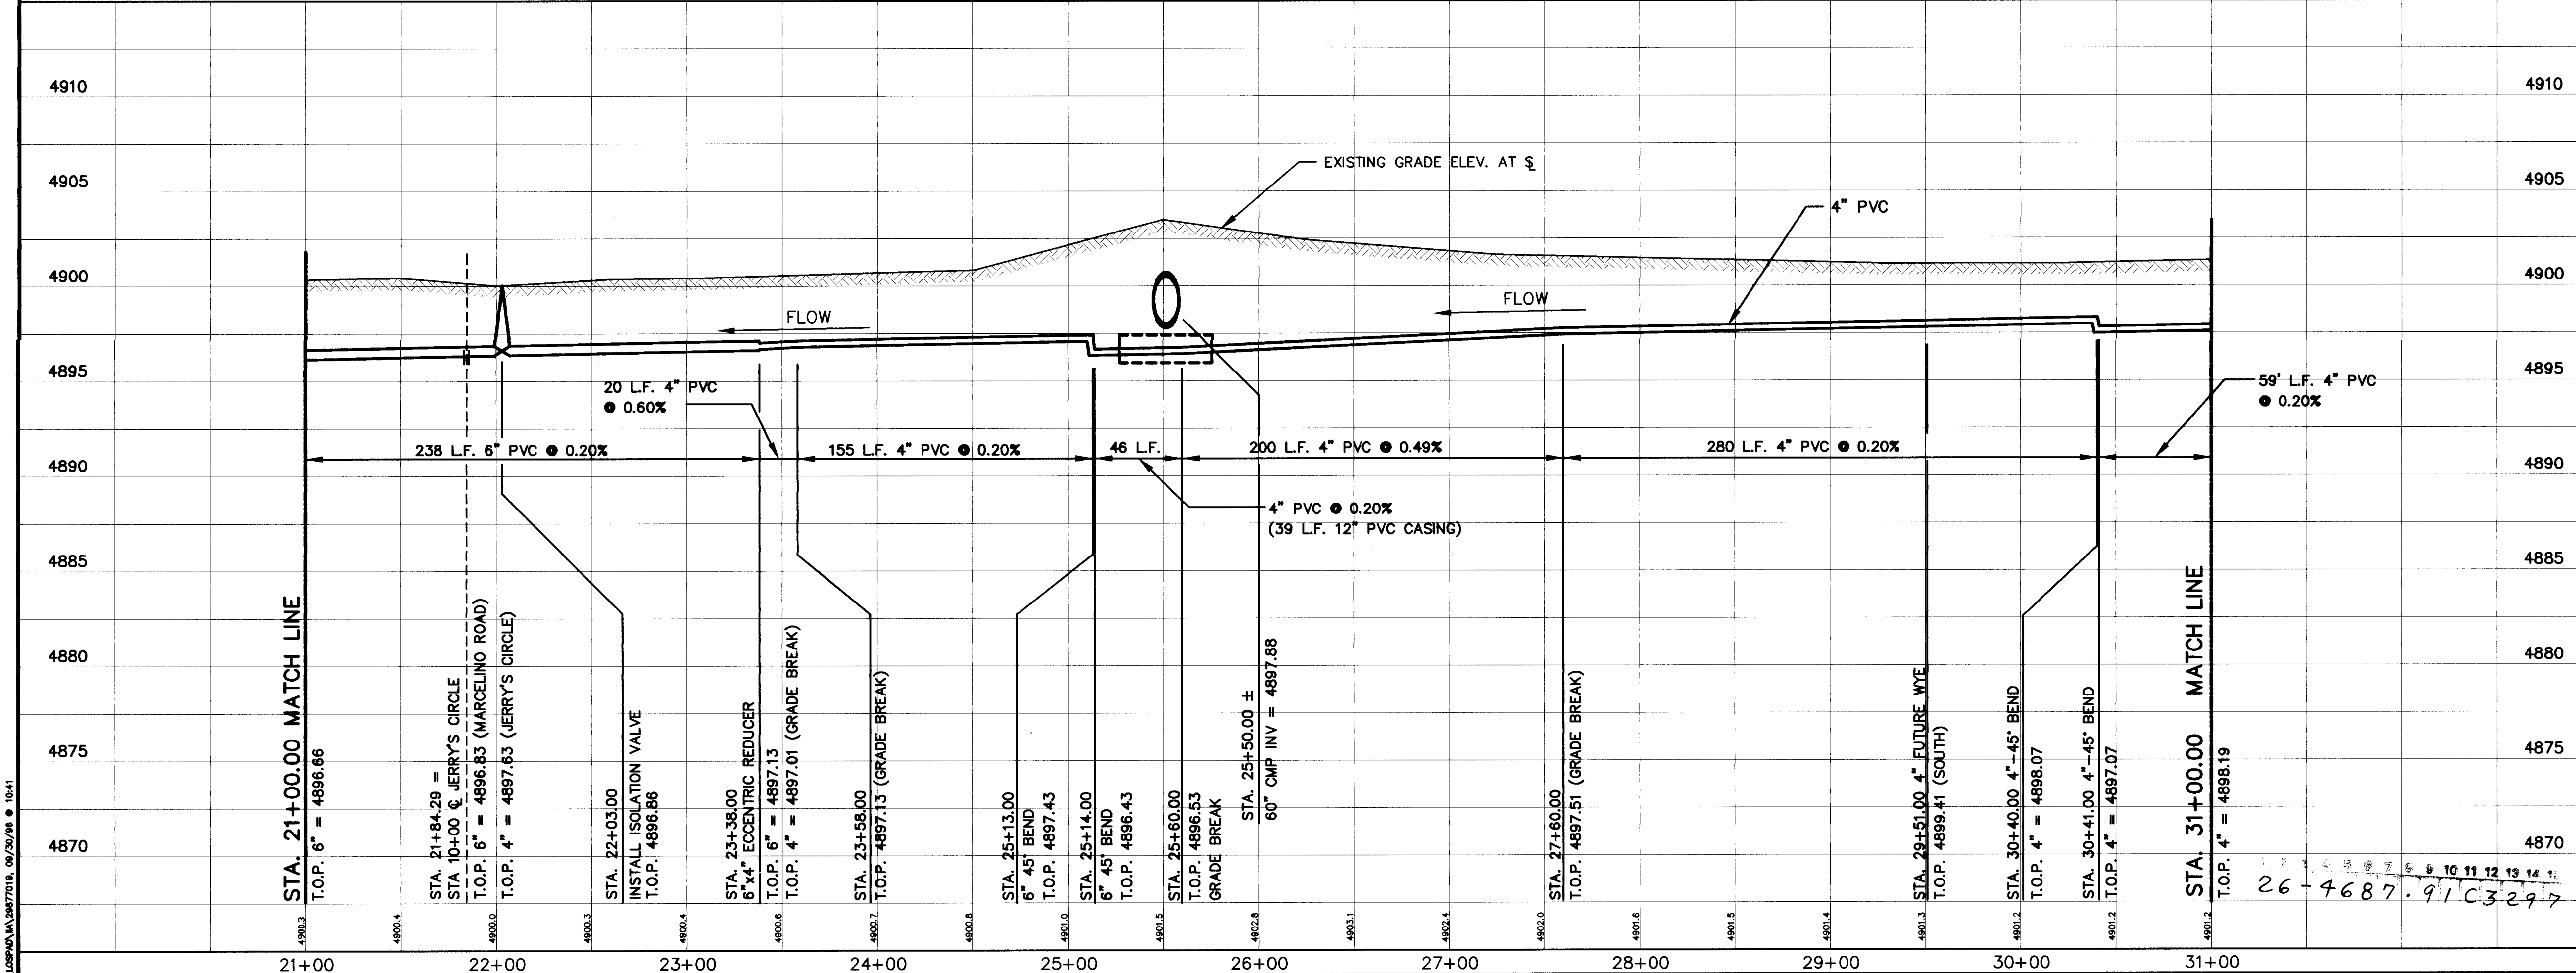

PLAN SCALE: 1"=50'
PROFILE SCALE: 1"=50' HOR
1"=5' VERT



LEGEND

- STUB
- VALVE PIT
- WATER METER OR WELL PUMP
- FLOW DIRECTION
- MISCELLANEOUS UTILITY
- PLUG OR CAP
- CROSS SECTION OF CULVERT
- VACUUM SEWER PIPE
- LIGHT POLE
- ELECTRICAL POLE
- ELECTRICAL TRANSFORMER PAD
- ISOLATION VALVE (PROFILE)
- ISOLATION VALVE (PLAN)

SEWER SERVICE SCHEDULE

STATION	ADDRESS	PIT NO.
23+53	1808 MARCELINO RD.	S-1
23+53	1817 MARCELINO RD.	S-1
24+13	VACANT LOT	STUB S-1.1
27+40	1716 MARCELINO RD.	S-2
27+40	1718 MARCELINO RD.	S-2
28+32	VACANT LOT	S-3
28+32	1715 MARCELINO RD.	S-3
21+55	VACANT LOT	N-1
24+13	VACANT LOT	STUB N-1.1

HDR
HDR Engineering, Inc.


CITY OF ALBUQUERQUE
PUBLIC WORKS DEPARTMENT
ENGINEERING DIVISION
TITLE: SOUTHWEST VALLEY SEWER EXTENSIONS
LOS PADILLAS VACUUM COLLECTION SYSTEM - PHASE IIA
MARCELINO ROAD (PART 2)
STATION 21+00 TO STATION 31+00

APPROVALS	ENGINEER	DATE	APPROVALS	ENGINEER	DATE
DRC CHAIRMAN			WATER		
TRANSPORTATION			WASTE WATER		
HYDROLOGY					

PROJECT NO. 4687.91 MAP NO. T-11 SHEET C3-2 OF 10

CONTRACTOR	TRAD	DATE	10/95
DESIGNED BY	BULLY/M/SON	DATE	10/95
CHECKED BY	WILSON & CO.	DATE	11/95
APPROVED BY	WILSON & CO.	DATE	10/95
CORRECTED BY	HOR ENGINEERING	DATE	
RECORDED BY		DATE	
NO.		DATE	

ENGINEER'S SEAL
WILLIAM F. ZIMMERMAN
REGISTERED PROFESSIONAL ENGINEER
STATE OF NEW MEXICO
NO. 8851
DATE OCTOBER 1994
DRAWN BY T.A.S.
CHECKED BY W.F.L.C.

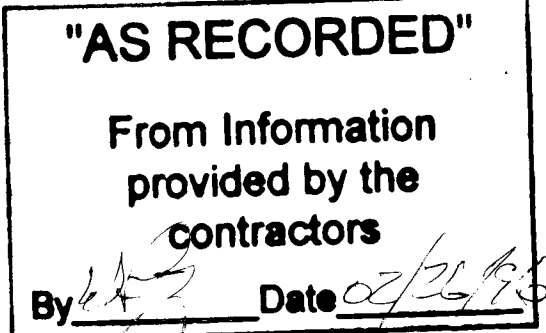

* NOTE: ALL ELEVATIONS IN PROFILE ARE T.O.P. (TOP OF PIPE)
ELEVATIONS - UNLESS OTHERWISE NOTED.



	STUB
	VALVE PIT
	WATER METER OR WELL PUMP
	FLOW DIRECTION
	MISCELLANEOUS UTILITY
	PLUG OR CAP
	CROSS SECTION OF CULVERT
	VACUUM SEWER PIPE
	LIGHT POLE
	ELECTRICAL POLE
	ELECTRICAL TRANSFORMER PAD
	ISOLATION VALVE (PROFILE)
	ISOLATION VALVE (PLAN)


A circular professional engineer seal for William F. Zimmerman, New Mexico, No. 8851. The seal features the text "WILLIAM F. ZIMMERMAN" at the top, "NEW MEXICO" in the center, and "REGISTERED PROFESSIONAL ENGINEER" at the bottom. The number "8851" is prominently displayed in the center. There are handwritten initials or a signature over the seal.


NO.	DATE	REMARKS	BY
REVISIONS			
DESIGN			
DESIGNED BY		WFZ, TAS	DATE OCTOBER 1994
DRAWN BY		TAS	DATE NOVEMBER 1994
CHECKED BY		WFZ, LC	DATE JUNE 1995

HDR
HDR Engineering, Inc.

APPROVALS	ENGINEER	DATE	APPROVALS	ENGINEER	DATE
DRC CHAIRMAN			WATER		
TRANSPORTATION			WASTE WATER		
HYDROLOGY					


PROJECT NO.	4687.91	MAP NO.	T-11	SHEET C3-5	OF 10
-------------	---------	---------	------	------------	-------

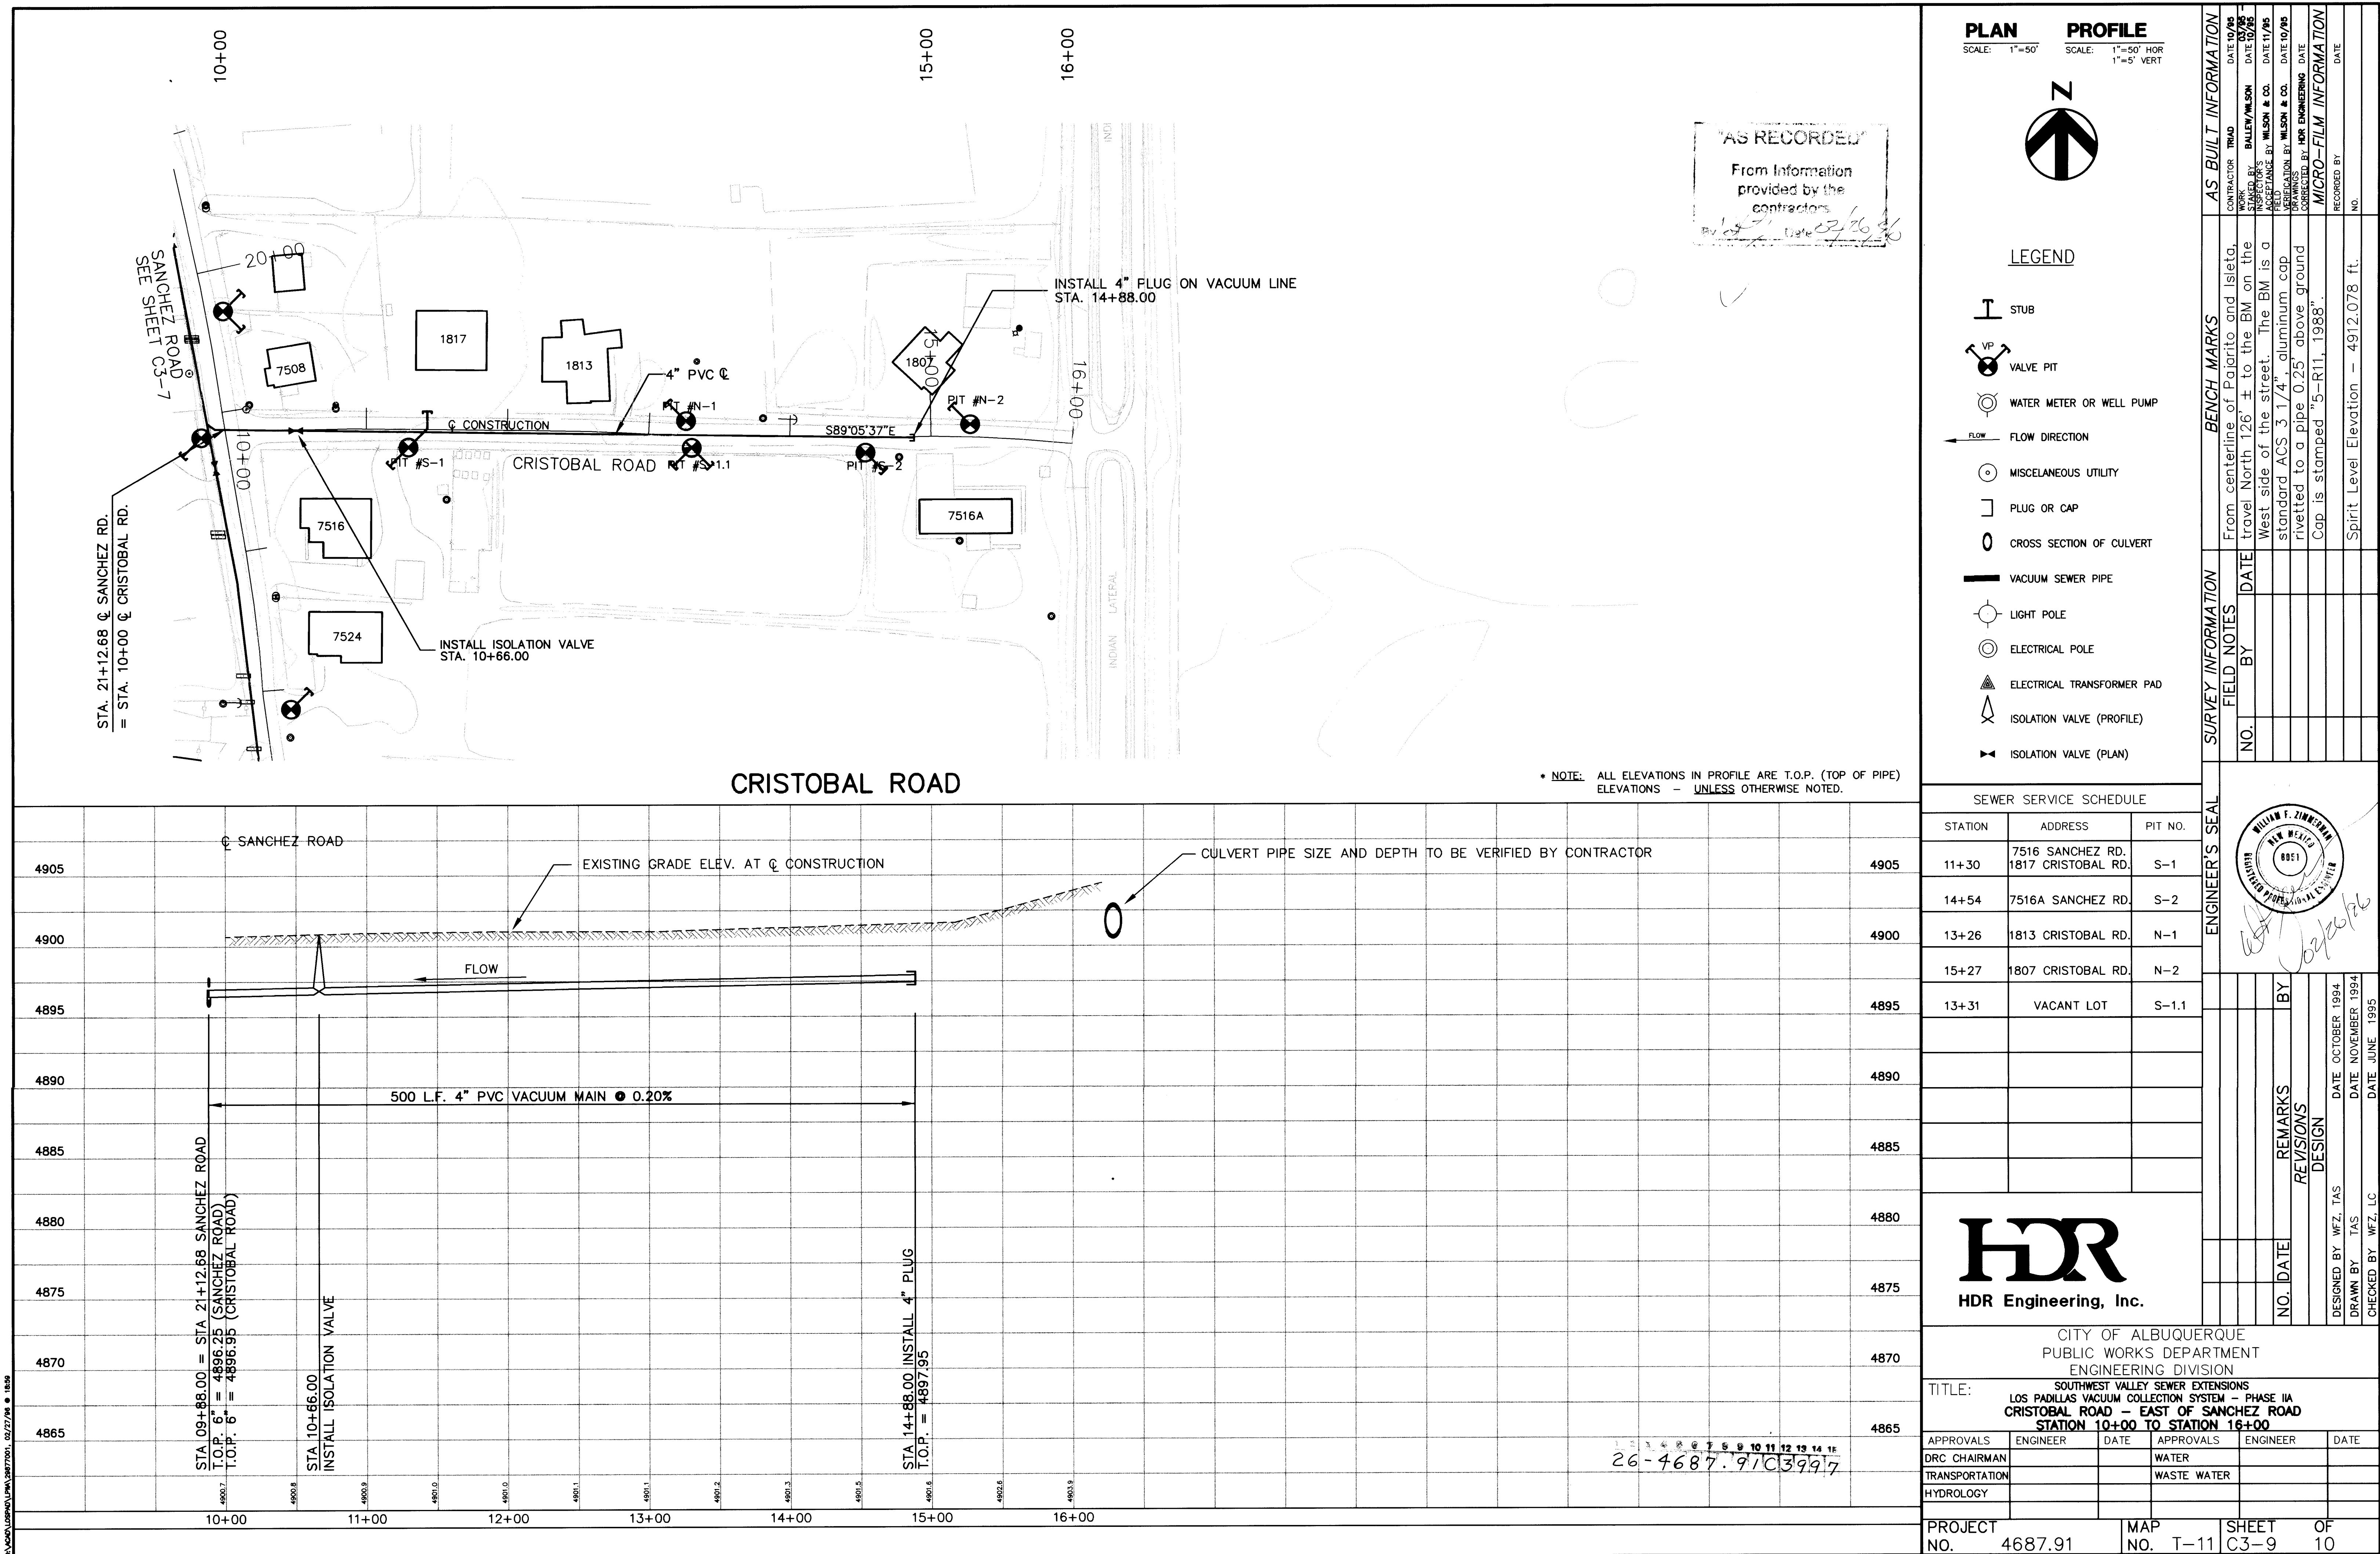

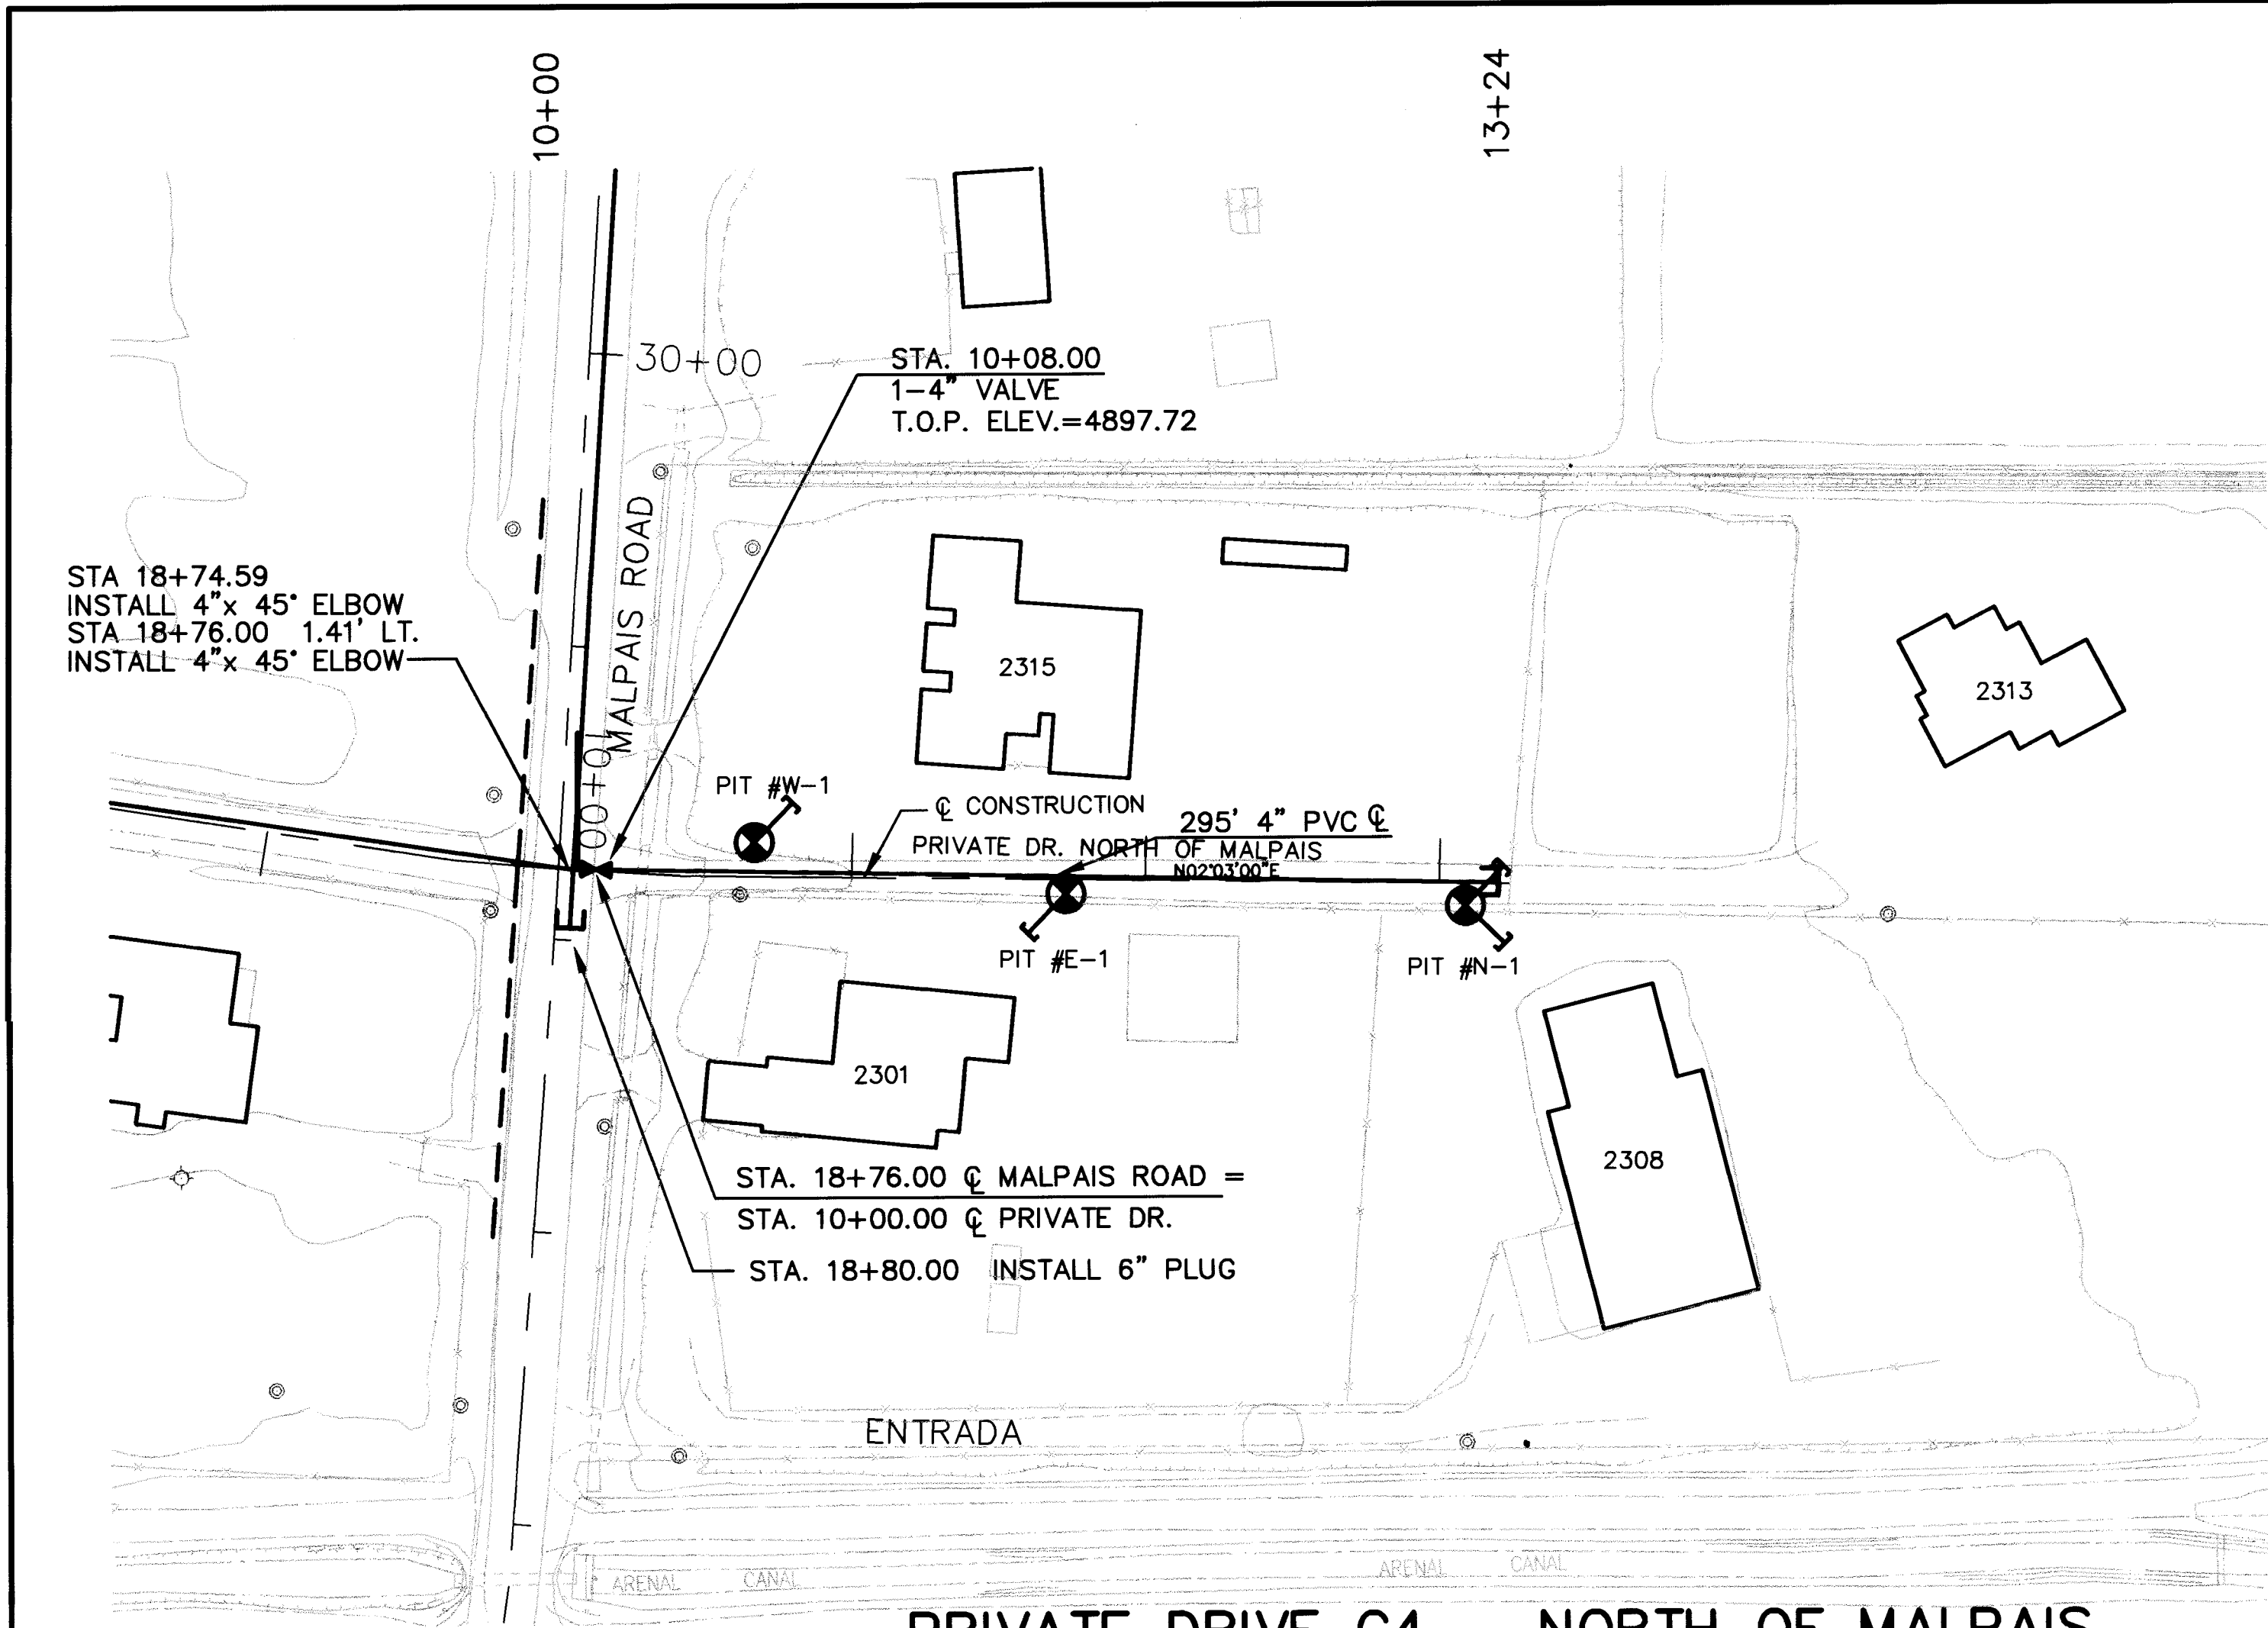

"AS RECORDED"
From Information
provided by the
contractors
By *W.F.Z.* Date *02/26/96*


PLAN SCALE: 1"=50'
PROFILE SCALE: 1"=50' HOR
1"=5' VERT

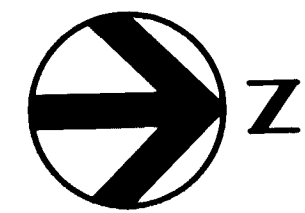

LEGEND

- STUB
- VALVE PIT
- WATER METER OR WELL PUMP
- FLOW DIRECTION
- MISCELLANEOUS UTILITY
- PLUG OR CAP
- CROSS SECTION OF CULVERT
- VACUUM SEWER PIPE
- LIGHT POLE
- ELECTRICAL POLE
- ELECTRICAL TRANSFORMER PAD
- ISOLATION VALVE (PROFILE)
- ISOLATION VALVE (PLAN)

* NOTE: ALL ELEVATIONS IN PROFILE ARE T.O.P. (TOP OF PIPE)
ELEVATIONS - UNLESS OTHERWISE NOTED.

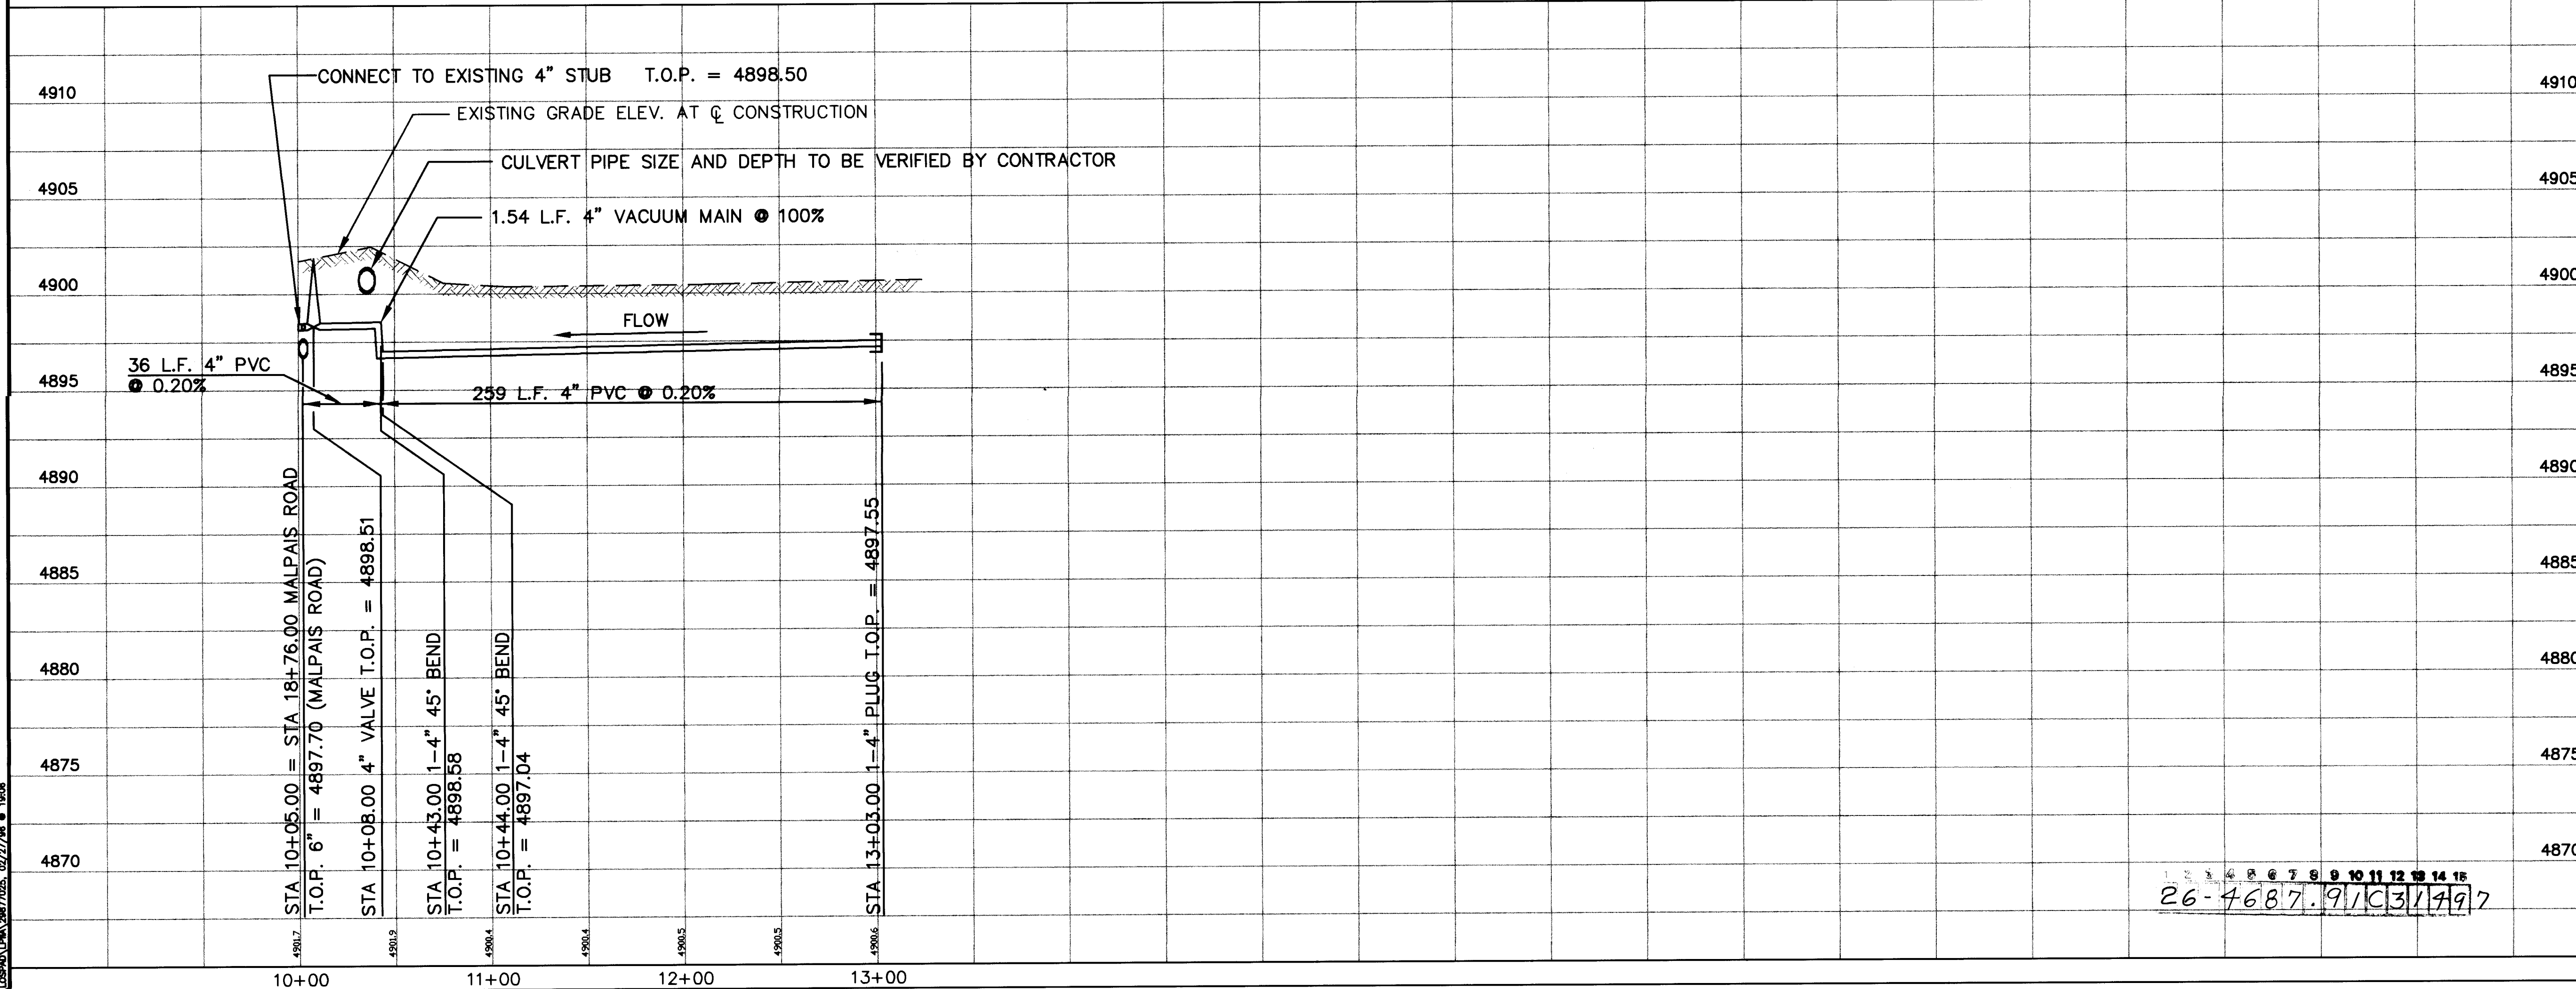

SEWER SERVICE SCHEDULE

STATION	ADDRESS	PIT NO.
10+74	2315 MALPAIS RD	W-1
11+74	2301 MALPAIS RD	E-1
13+02	2313 & 2315 MALPAIS RD	N-1

ENGINEER'S SEAL

REMARKS
REVISIONS
DESIGN

NO. DATE



DESIGNED BY W.F.Z. T.A.S. DATE OCTOBER 1994
DRAWN BY T.A.S. DATE NOVEMBER 1994
CHECKED BY W.F.Z. LC DATE JUNE 1995

HDR
HDR Engineering, Inc.

CITY OF ALBUQUERQUE PUBLIC WORKS DEPARTMENT ENGINEERING DIVISION					
TITLE: SOUTHWEST VALLEY SEWER EXTENSIONS LOS PADILLAS VACUUM COLLECTION SYSTEM - PHASE IIA PRIVATE DRIVE C4 - NORTH OF MALPAIS ROAD STATION 10+00 TO STATION 13+20					
APPROVALS	ENGINEER	DATE	APPROVALS	ENGINEER	DATE
DRC CHAIRMAN			WATER		
TRANSPORTATION			WASTE WATER		
HYDROLOGY					
PROJECT NO.	4687.91	MAP NO.	T-11	SHEET OF	C3-14 22

26-4687.91/C3/14/22

D:\ACAD\GSPAD\LP11A\29877043 02/27/94 © 2024

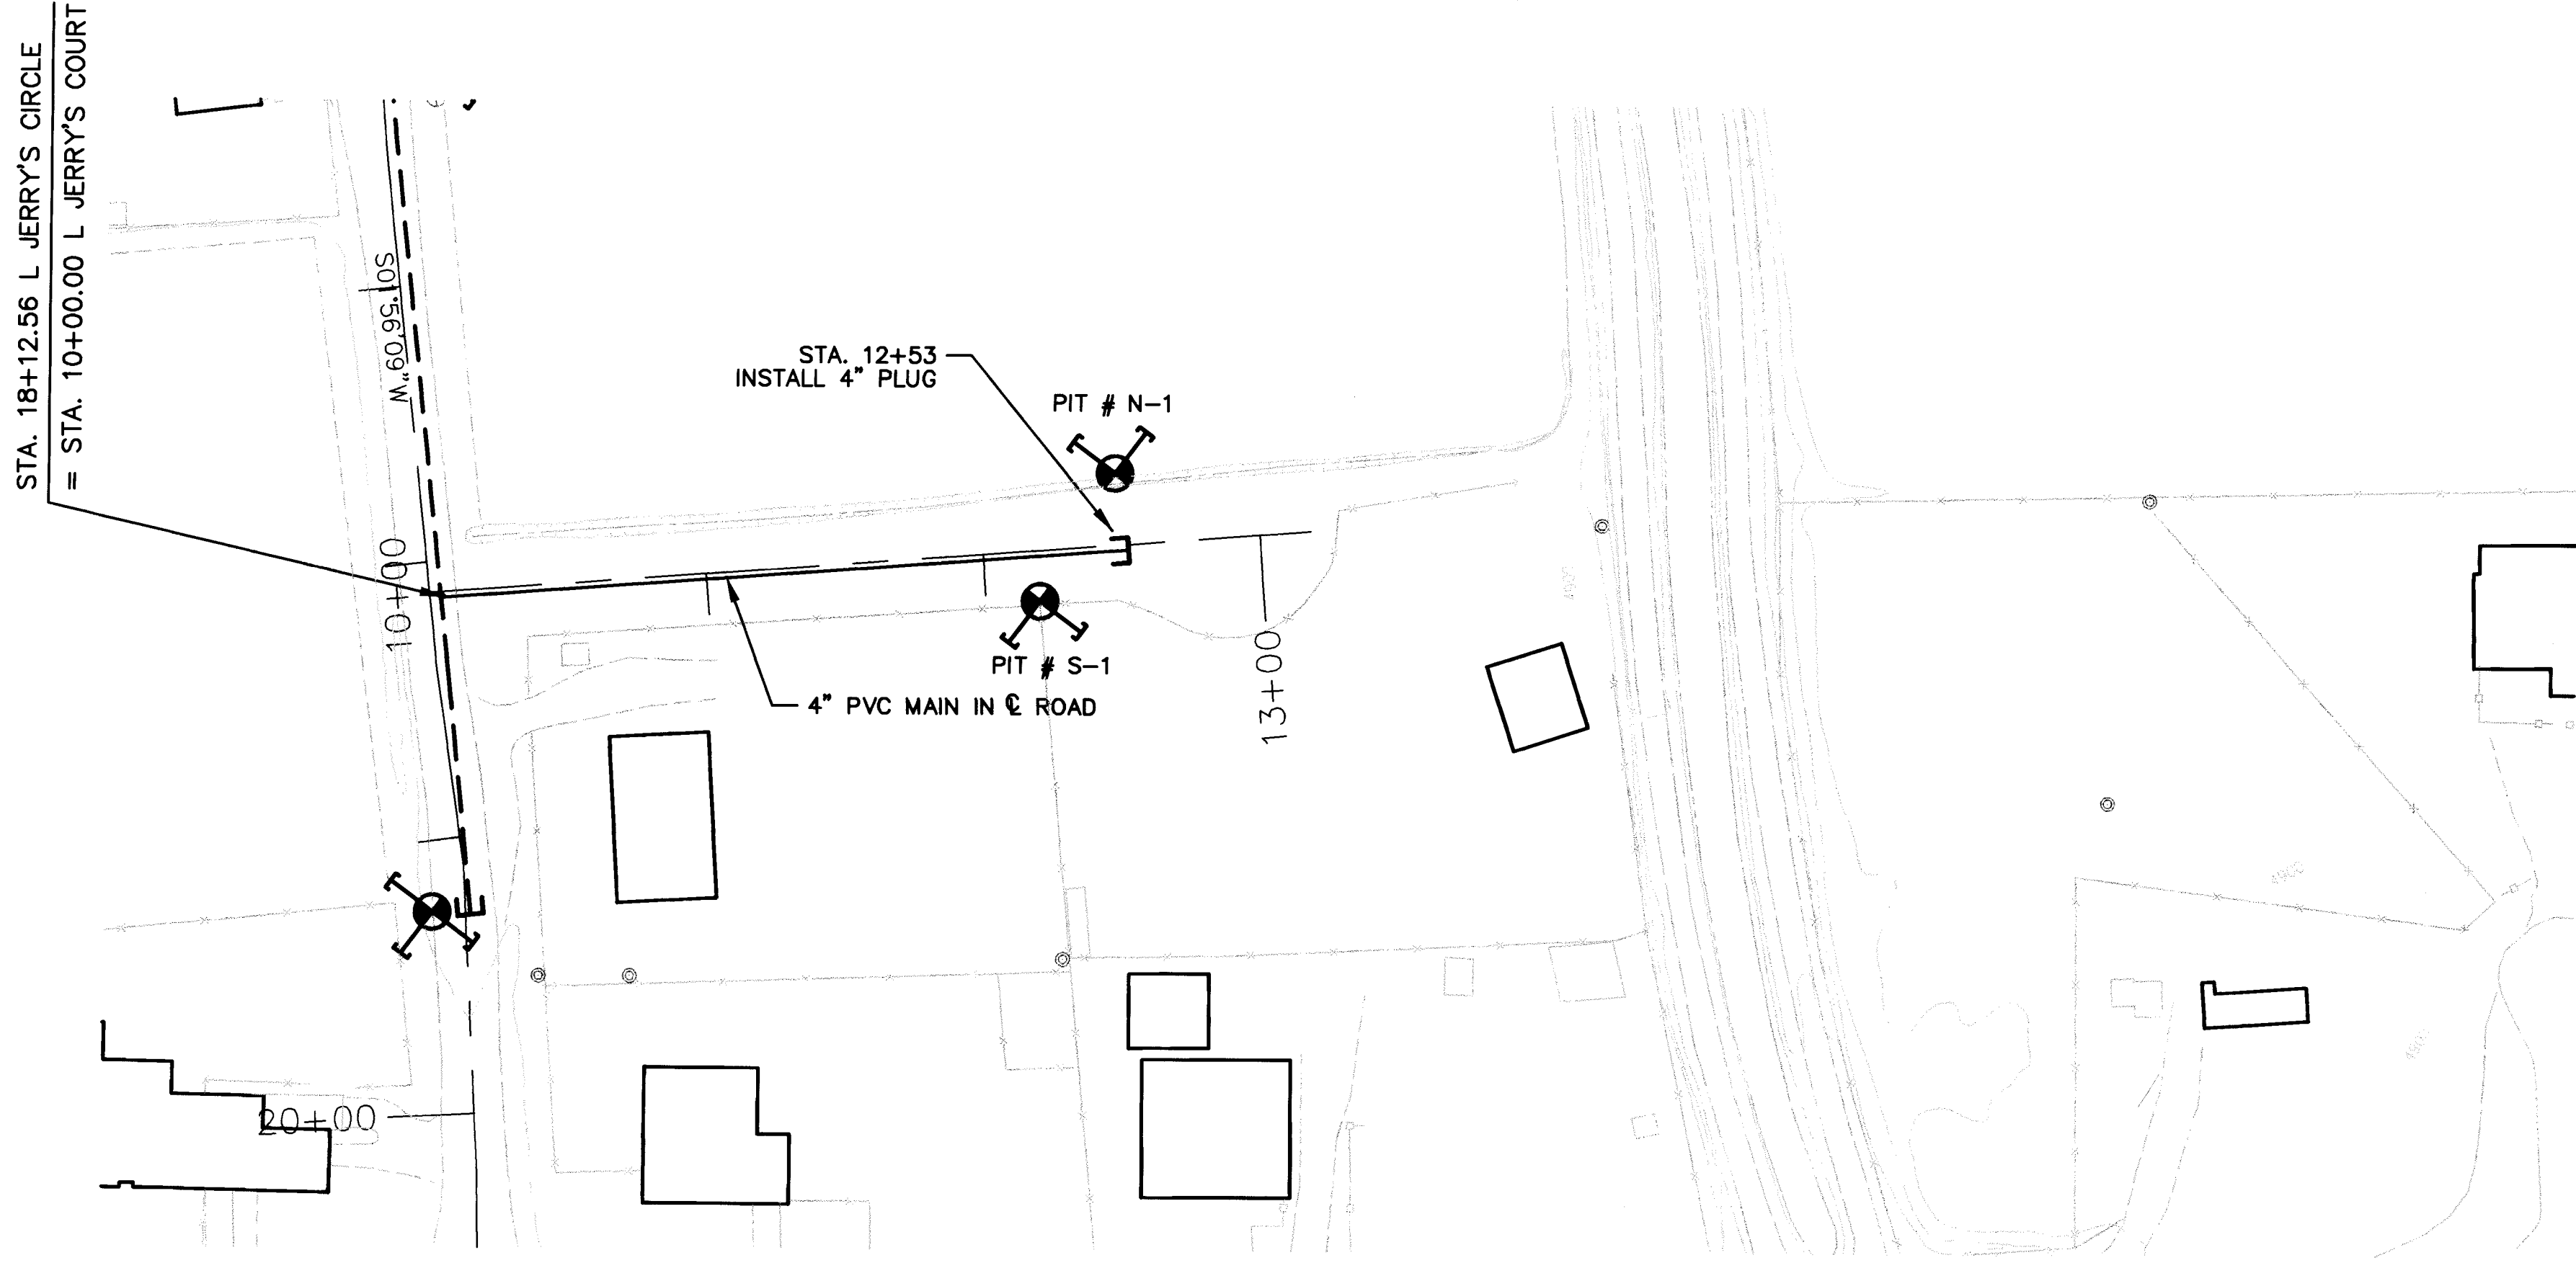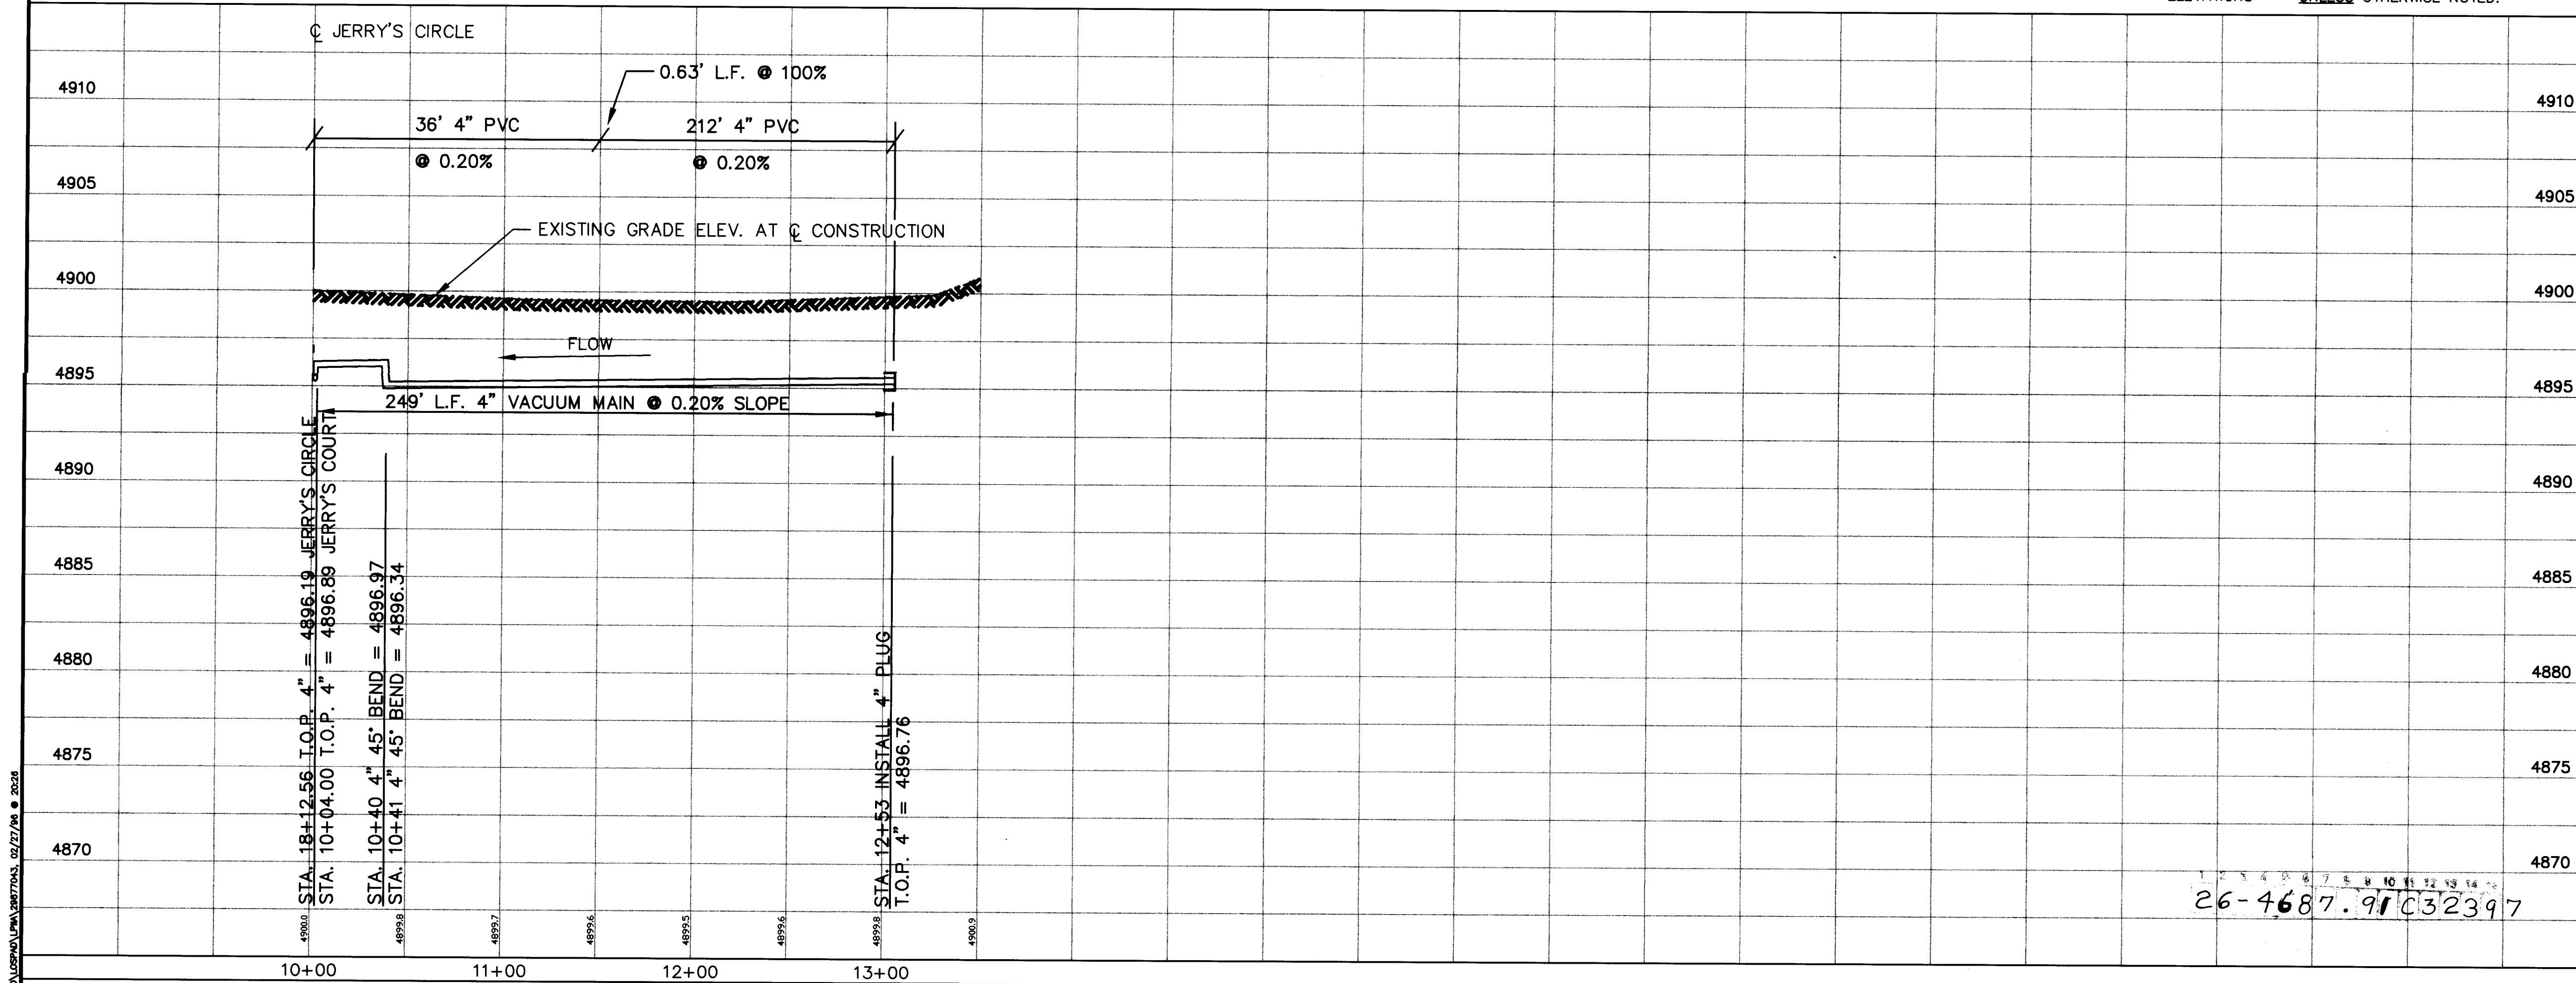

"AS RECORDED"
From Information
provided by the
contractors
By WJZ Date 2/26/94

PLAN SCALE: 1"=50'
PROFILE SCALE: 1"=50' HOR
1"=5' VERT



LEGEND

- STUB
- VALVE PIT
- WATER METER OR WELL PUMP
- FLOW DIRECTION
- MISCELLANEOUS UTILITY
- PLUG OR CAP
- CROSS SECTION OF CULVERT
- VACUUM SEWER PIPE
- LIGHT POLE
- ELECTRICAL POLE
- ELECTRICAL TRANSFORMER PAD
- ISOLATION VALVE (PROFILE)
- ISOLATION VALVE (PLAN)

* NOTE: ALL ELEVATIONS IN PROFILE ARE T.O.P. (TOP OF PIPE)
ELEVATIONS - UNLESS OTHERWISE NOTED.

SEWER SERVICE SCHEDULE

STATION	ADDRESS	PIT NO.
12+49	7628 JERRY'S CIR.	S-1
12+49	VACANT LOT	S-1
12+53	LOT 17 & 18	N-1

HDR
HDR Engineering, Inc.

CITY OF ALBUQUERQUE
PUBLIC WORKS DEPARTMENT
ENGINEERING DIVISION
TITLE: SOUTHWEST VALLEY SEWER EXTENSIONS
LOS PADILLAS VACUUM COLLECTION SYSTEM - PHASE IIA
JERRY'S COURT - EAST
STATION 10+00 TO STATION 13+20

APPROVALS	ENGINEER	DATE	APPROVALS	ENGINEER	DATE
DRC CHAIRMAN			WATER		
TRANSPORTATION			WASTE WATER		
HYDROLOGY					

PROJECT NO. 4687.91 MAP NO. T-11 SHEET OF C3-23 13

ENGINEER'S SEAL

DESIGNED BY WJZ, TAS
DRAWN BY TAS
CHECKED BY WJZ, LC

REMARKS
REVISIONS
DESIGN

DATE OCTOBER 1994
DATE NOVEMBER 1994
DATE JUNE 1995

NO. DATE


BY

WILLIAM F. ZIMMERMAN
REGISTERED PROFESSIONAL ENGINEER

SURVEY INFORMATION		BENCH MARKS		AS BUILT INFORMATION	
NO.	BY	DATE	From centerline of Pajarito and Isleta, travel North 126° ± to the BM on the West side of the street. The BM is a standard ACS 3 1/4" aluminum cap rivetted to a pipe 0.25' above ground. Cap is stamped "5-R11, 1988".	CONTRACTOR	DATE
				TRAD	10/95
				INSPECTOR'S	10/95
				STAKE BY	10/95
				FIELD	11/95
				VERIFICATION BY	10/95
				WILSON & CO.	10/95
				CORRECTED BY	
				HDR ENGINEERING	
				DATE	
				RECORDED BY	
				NO.	



D:\ACAD\05240\LDEN\07565B03 2008 02/27/98

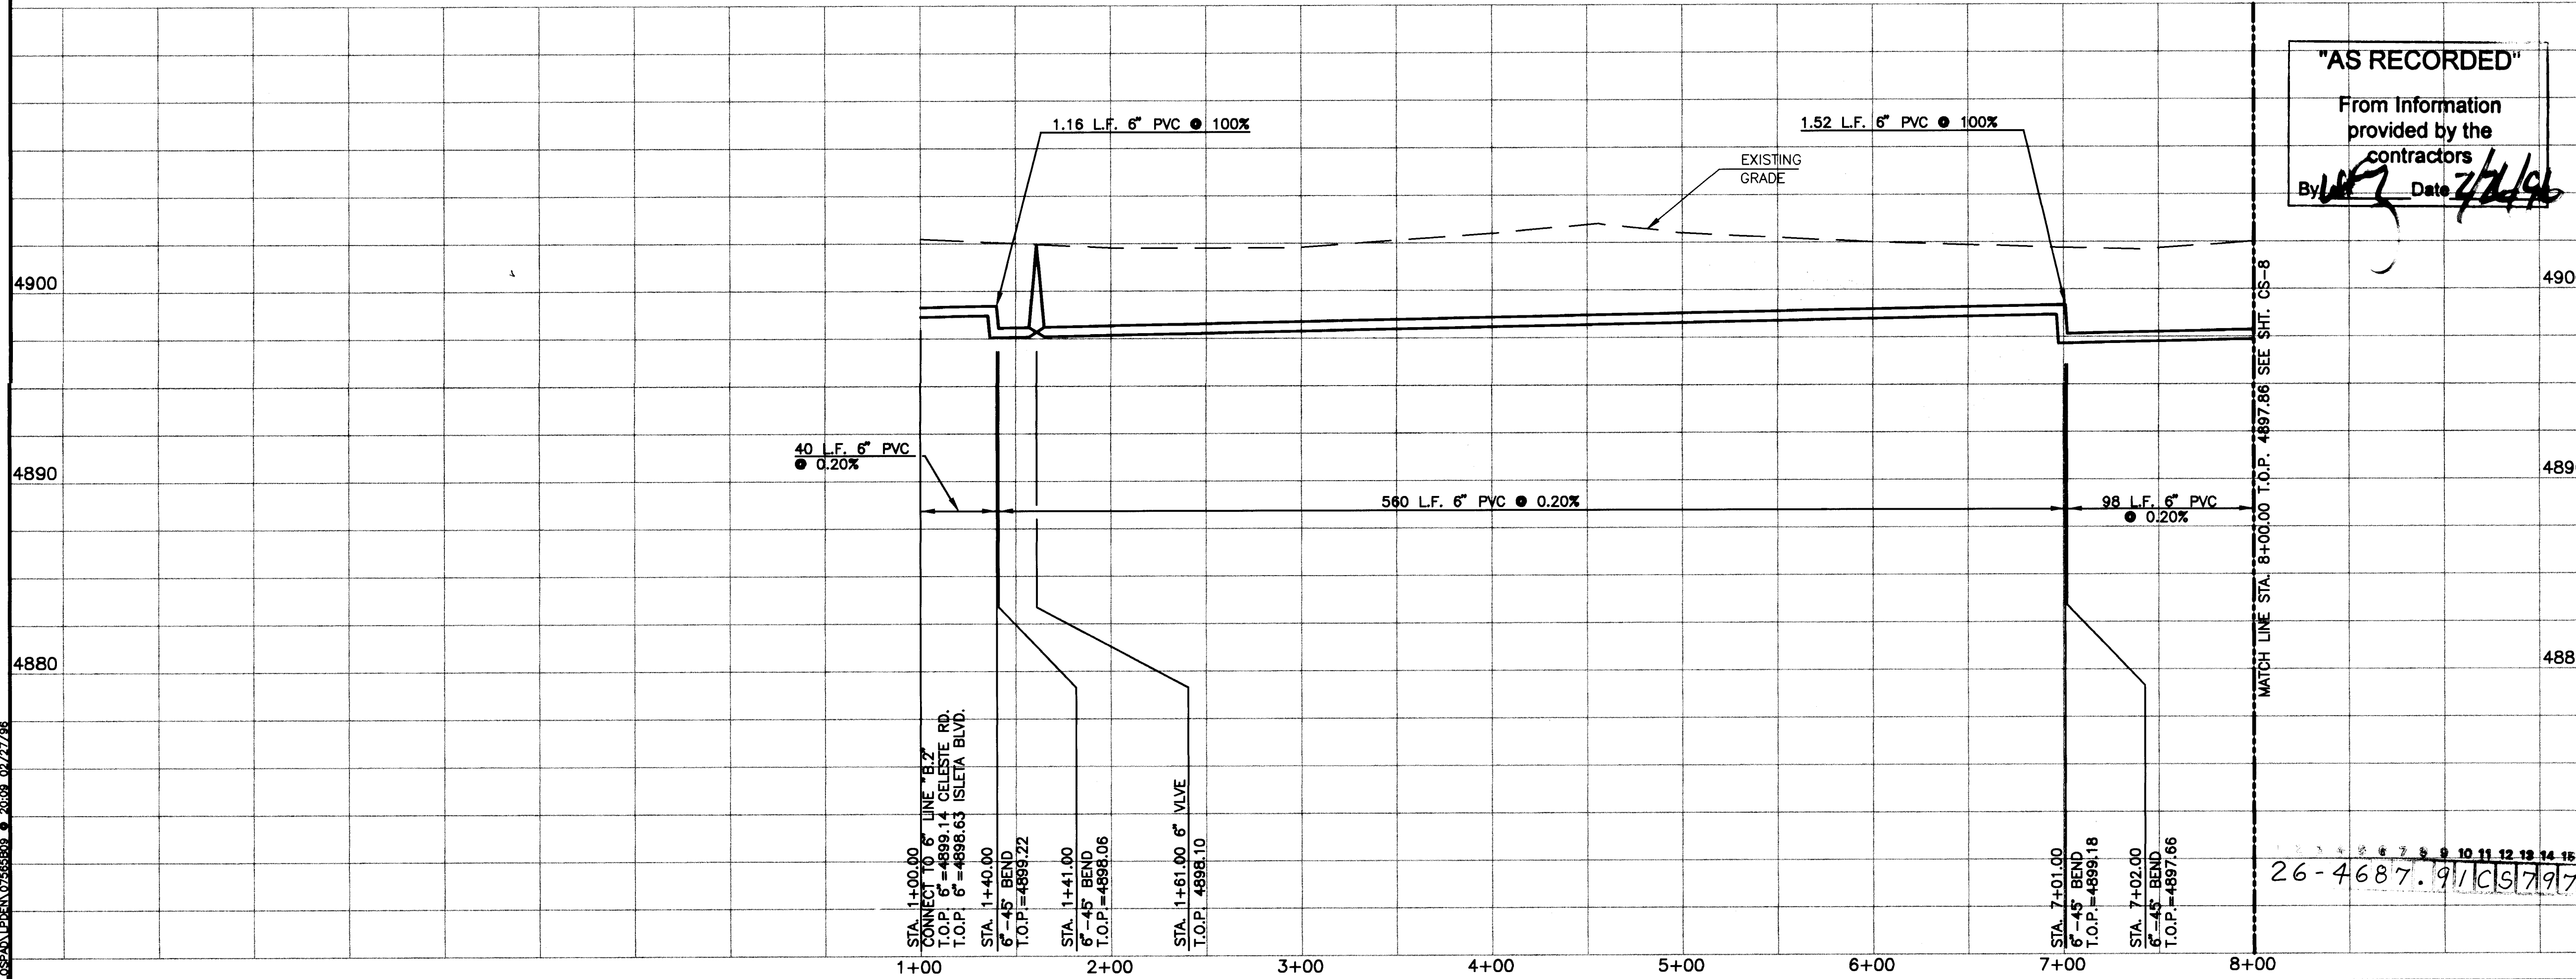


"AS RECORDED"

From information
provided by the
contractors

By *[Signature]* Date *3/2/96*

PLAN		PROFILE	
SCALE: 1"=50'		SCALE: 1"=50' HOR 1"=5' VERT	
LEGEND			
NEW EXIST. VACUUM SEWER MAIN (ADDITIONAL) VACUUM SEWER MAIN OR FORCE MAIN VACUUM SEWER DIVISION VALVE, SEE DETAIL IN CONTRACT DOCUMENTS BOOK OR FORCE MAIN ISOLATION VALVE, SEE DET. ON SHT. G-4 STUB 1" AIR RELEASE VALVE, SEE DETAIL IN CONTRACT DOCUMENTS BOOK DRAIN MANHOLE, SEE DETAIL ON SHEET G-4 30"-3" "AIRVAC" VALVE AND PIT, SEE NOTE 7 ON SHT. G-1 WATER LINE GAS LINE UNDERGROUND TELEPHONE LINE UNDERGROUND ELECTRICAL LINE OVERHEAD POWER POLE W/ GUY WIRE LARGE TREE BRUSH SIGN X 00.0 SPOT ELEVATION			
NOTES: 1) ALL LATERAL VACUUM MAIN CONNECTIONS SHALL BE CONSTRUCTED PER TYPICAL DETAIL SHOWN IN CONTRACT DOCUMENTS BOOK. REFER TO NOTES 1 AND 8 ON SHEET G-1 ABOUT STATIONING AND DETAILS AT THESE CONNECTIONS.			
SERVICE LOCATION TABLE			
STREET ADDRESS		STATION	PIT NO.
VACANT LOT		1+92	N-1
2121 CELESTE RD.		4+38	N-2
2125 CELESTE RD.		6+11	N-3
2129 CELESTE RD.		6+11	N-3
2124 CELESTE RD.		5+53	S-1
2128 CELESTE RD.		6+86	S-2
AS BUILT INFORMATION			
CONTRACTOR: TRAD			
DATE: 10/95			
WORK: BAILEY/WILSON			
DATE: 10/95			
DESIGNED BY: WILSON & CO.			
DATE: 11/95			
FIELD CHECKED BY: WILSON & CO.			
DATE: 10/95			
DRAWINGS CORRECTED BY: HDR ENGINEERING			
DATE:			
MICRO-FILM INFORMATION			
RECORDED BY:			
DATE:			
Spirit Level Elevation - 4912.078 ft.			
BENCH MARKS			
From centerline of Palmito and Isleta, travel North 126' ± to the BM on the West side of the street. The BM is a standard ACS 3 1/4" aluminum cap rivetted to a pipe 0.25' above ground. Cap is stamped "5-R11, 1988".			
SURVEY INFORMATION			
FIELD NOTES			
NO. BY DATE			
1. 10/95			
2. 11/95			
3. 10/95			
4. 10/95			
494. 10/9			

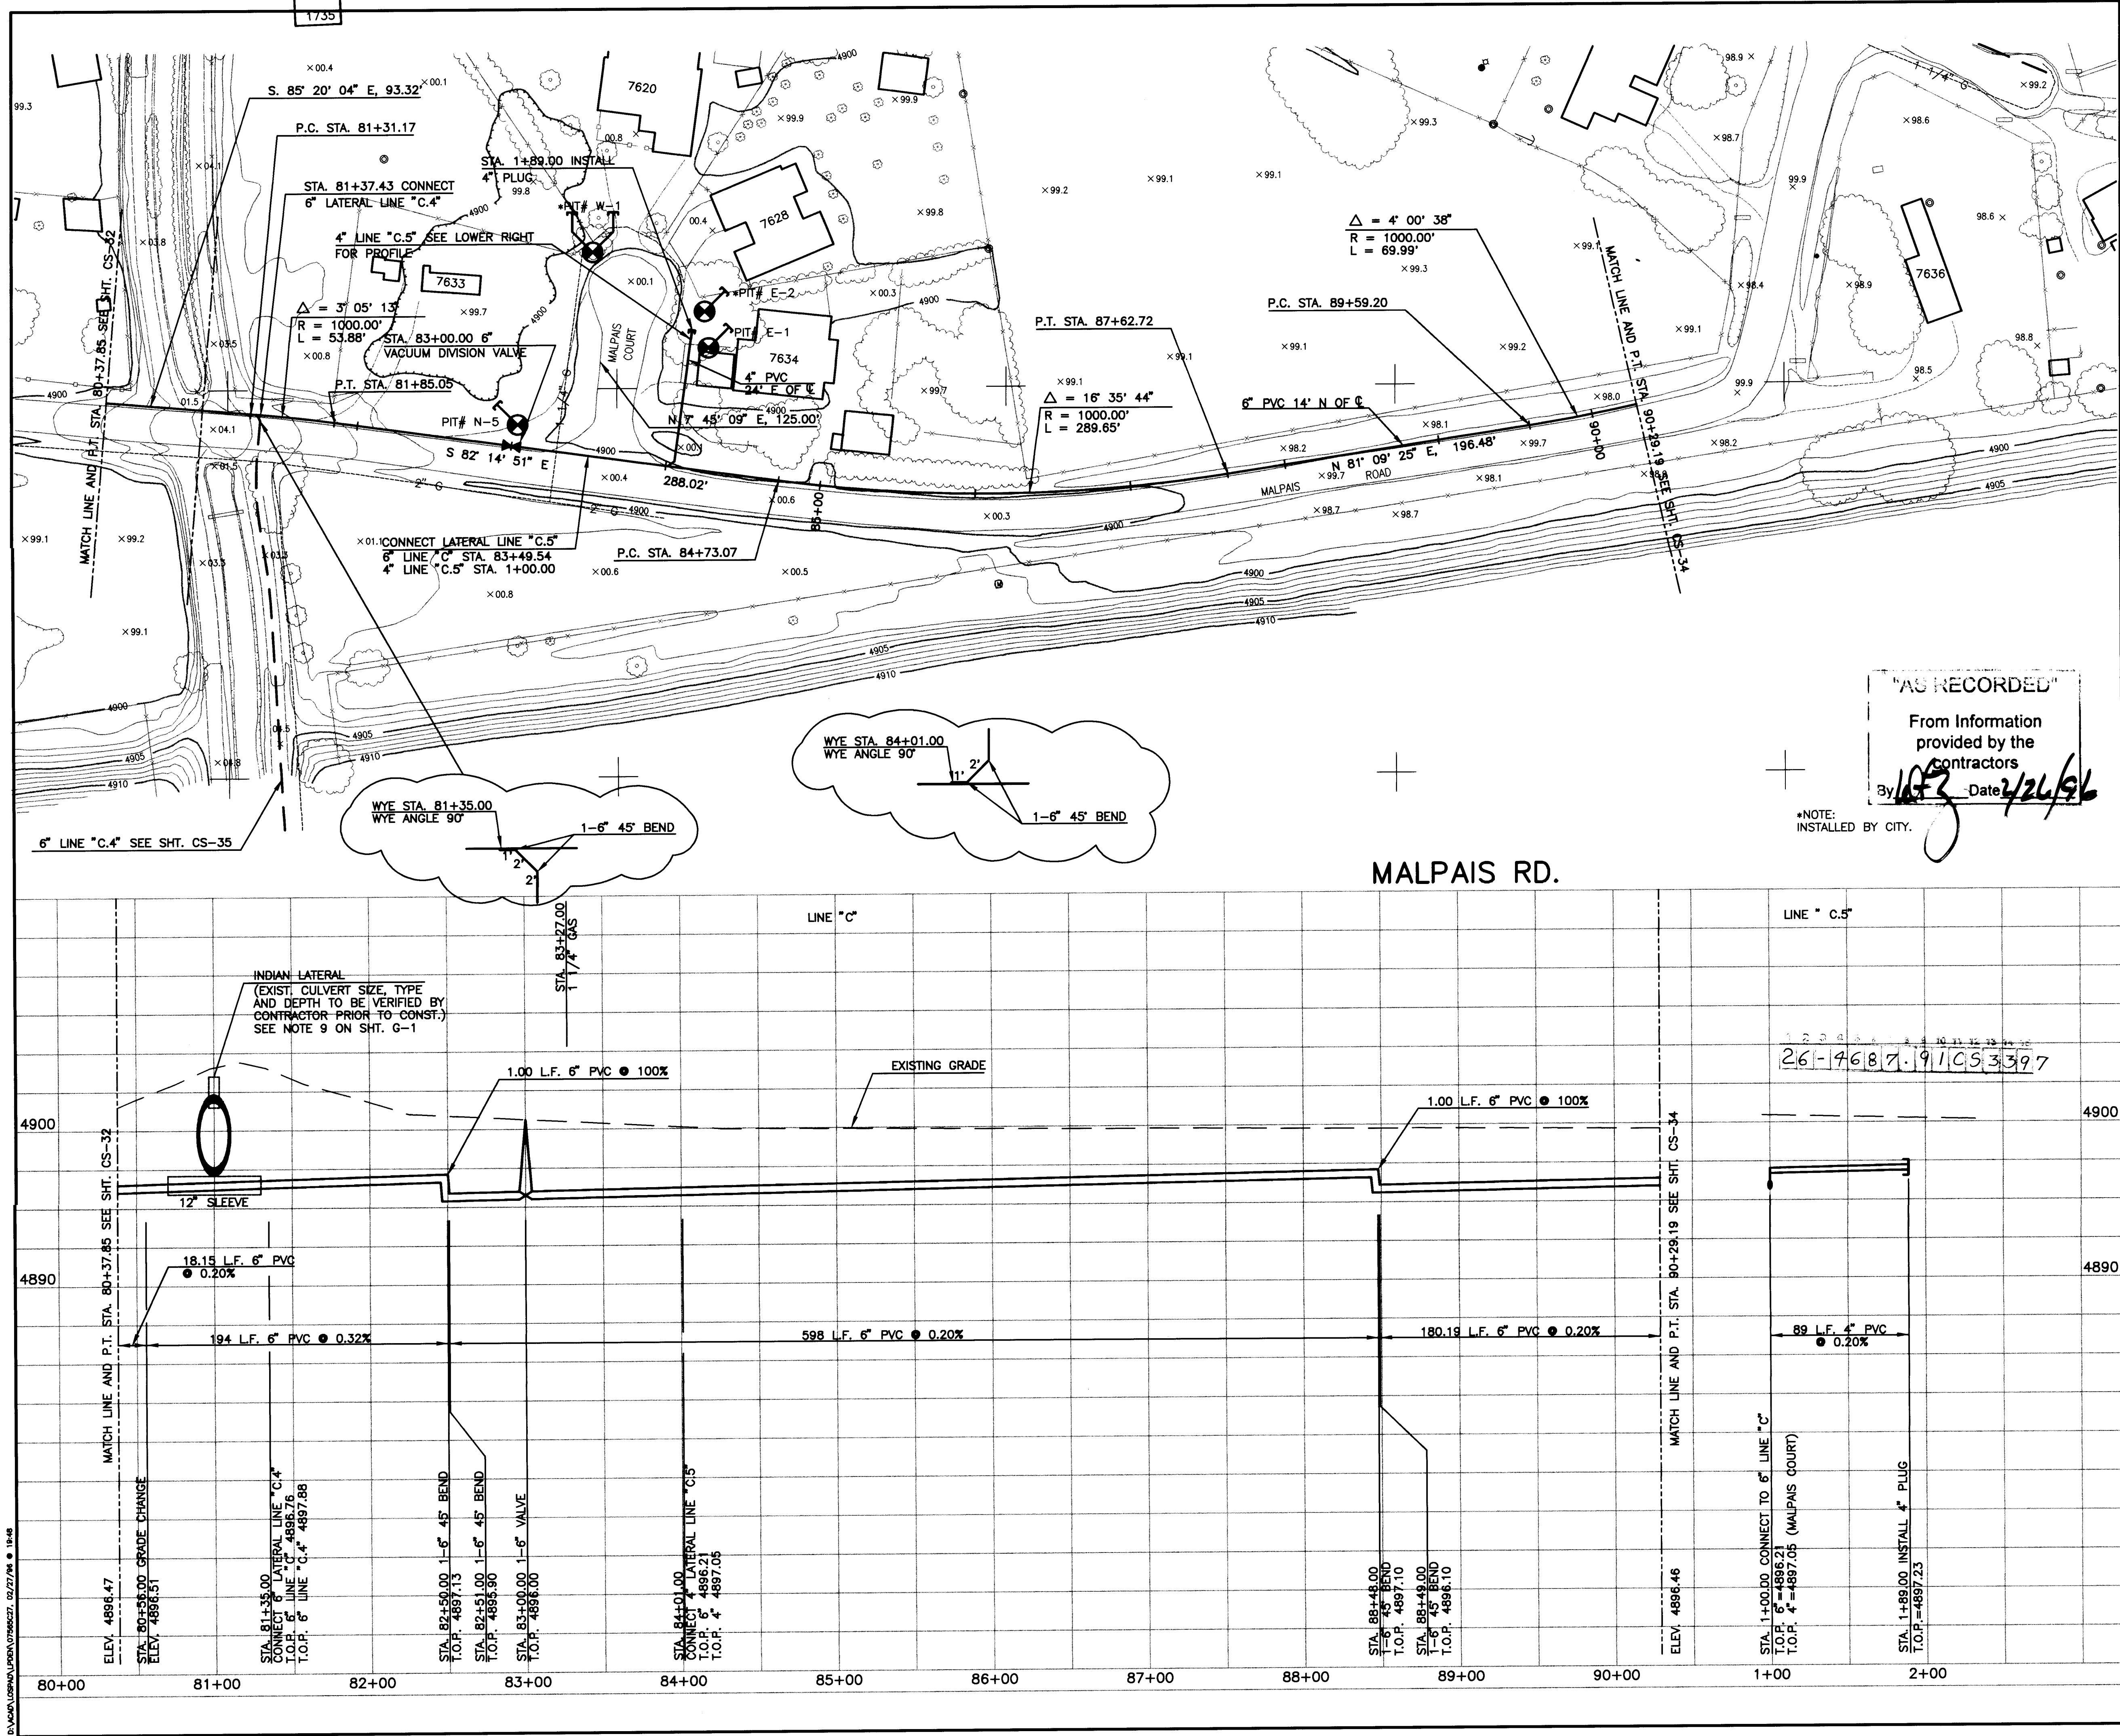

PLAN
SCALE: 1"=50'

PROFILE
SCALE: 1"=50' HOR
1"=5' VERT



LEGEND

- NEW
EXIST.
- VACUUM SEWER MAIN (ADDITIONAL)
VACUUM SEWER MAIN OR FORCE MAIN
VACUUM SEWER DIVISION VALVE, SEE DETAIL IN CONTRACT DOCUMENTS BOOK OR
FORCE MAIN ISOLATION VALVE, SEE DETAIL ON SHT. G-4
STUB
- 1" AIR RELEASE VALVE
SEE DETAIL IN CONTRACT DOCUMENTS BOOK
DRAIN MANHOLE SEE DETAIL ON SHEET G-4
30"-Ø "AIRRACT" VALVE AND PIT
SEE NOTE 7 ON SHT. G-1
- WATER LINE
GAS LINE
UNDERGROUND TELEPHONE LINE
UNDERGROUND ELECTRICAL LINE
OVERHEAD POWER POLE W/ GUY WIRE
LARGE TREE
BRUSH
SIGN
X 00.0 SPOT ELEVATION


NOTES:
1) ALL LATERAL VACUUM MAIN CONNECTIONS SHALL BE CONSTRUCTED PER TYPICAL DETAIL SHOWN IN CONTRACT DOCUMENTS BOOK. REFER TO NOTES 1 AND 6 ON SHEET G-1 ABOUT STATIONING AND DETAILS AT THESE CONNECTIONS.

SERVICE LOCATION TABLE

STREET ADDRESS	STATION	PIT NO.
7633 MALPAIS RD.	83+02	N-5
* 7628 MALPAIS CT.	2+02	E-2
* 7620 MALPAIS CT.	2+30	W-1
7634 MALPAIS CT.	1+79	E-1



CITY OF ALBUQUERQUE PUBLIC WORKS DEPARTMENT ENGINEERING GROUP					
TITLE: LOS PADILLAS AREA VACUUM COLLECTION SYSTEM AND FORCE MAIN - PHASE IIA MALPAIS ROAD LINE "C" STA. 80+37.85 TO 90+29.19/LINE "C.5" STA. 1+00 TO 2+25					
APPROVALS	ENGINEER	DATE	APPROVALS	ENGINEER	DATE
DRC CHAIRMAN			WATER		
TRANSPORTATION			WASTE WATER		
HYDROLOGY					
PROJECT NO.	4687.91	MAP NO.	U-12	SHEET	CS-33 OF

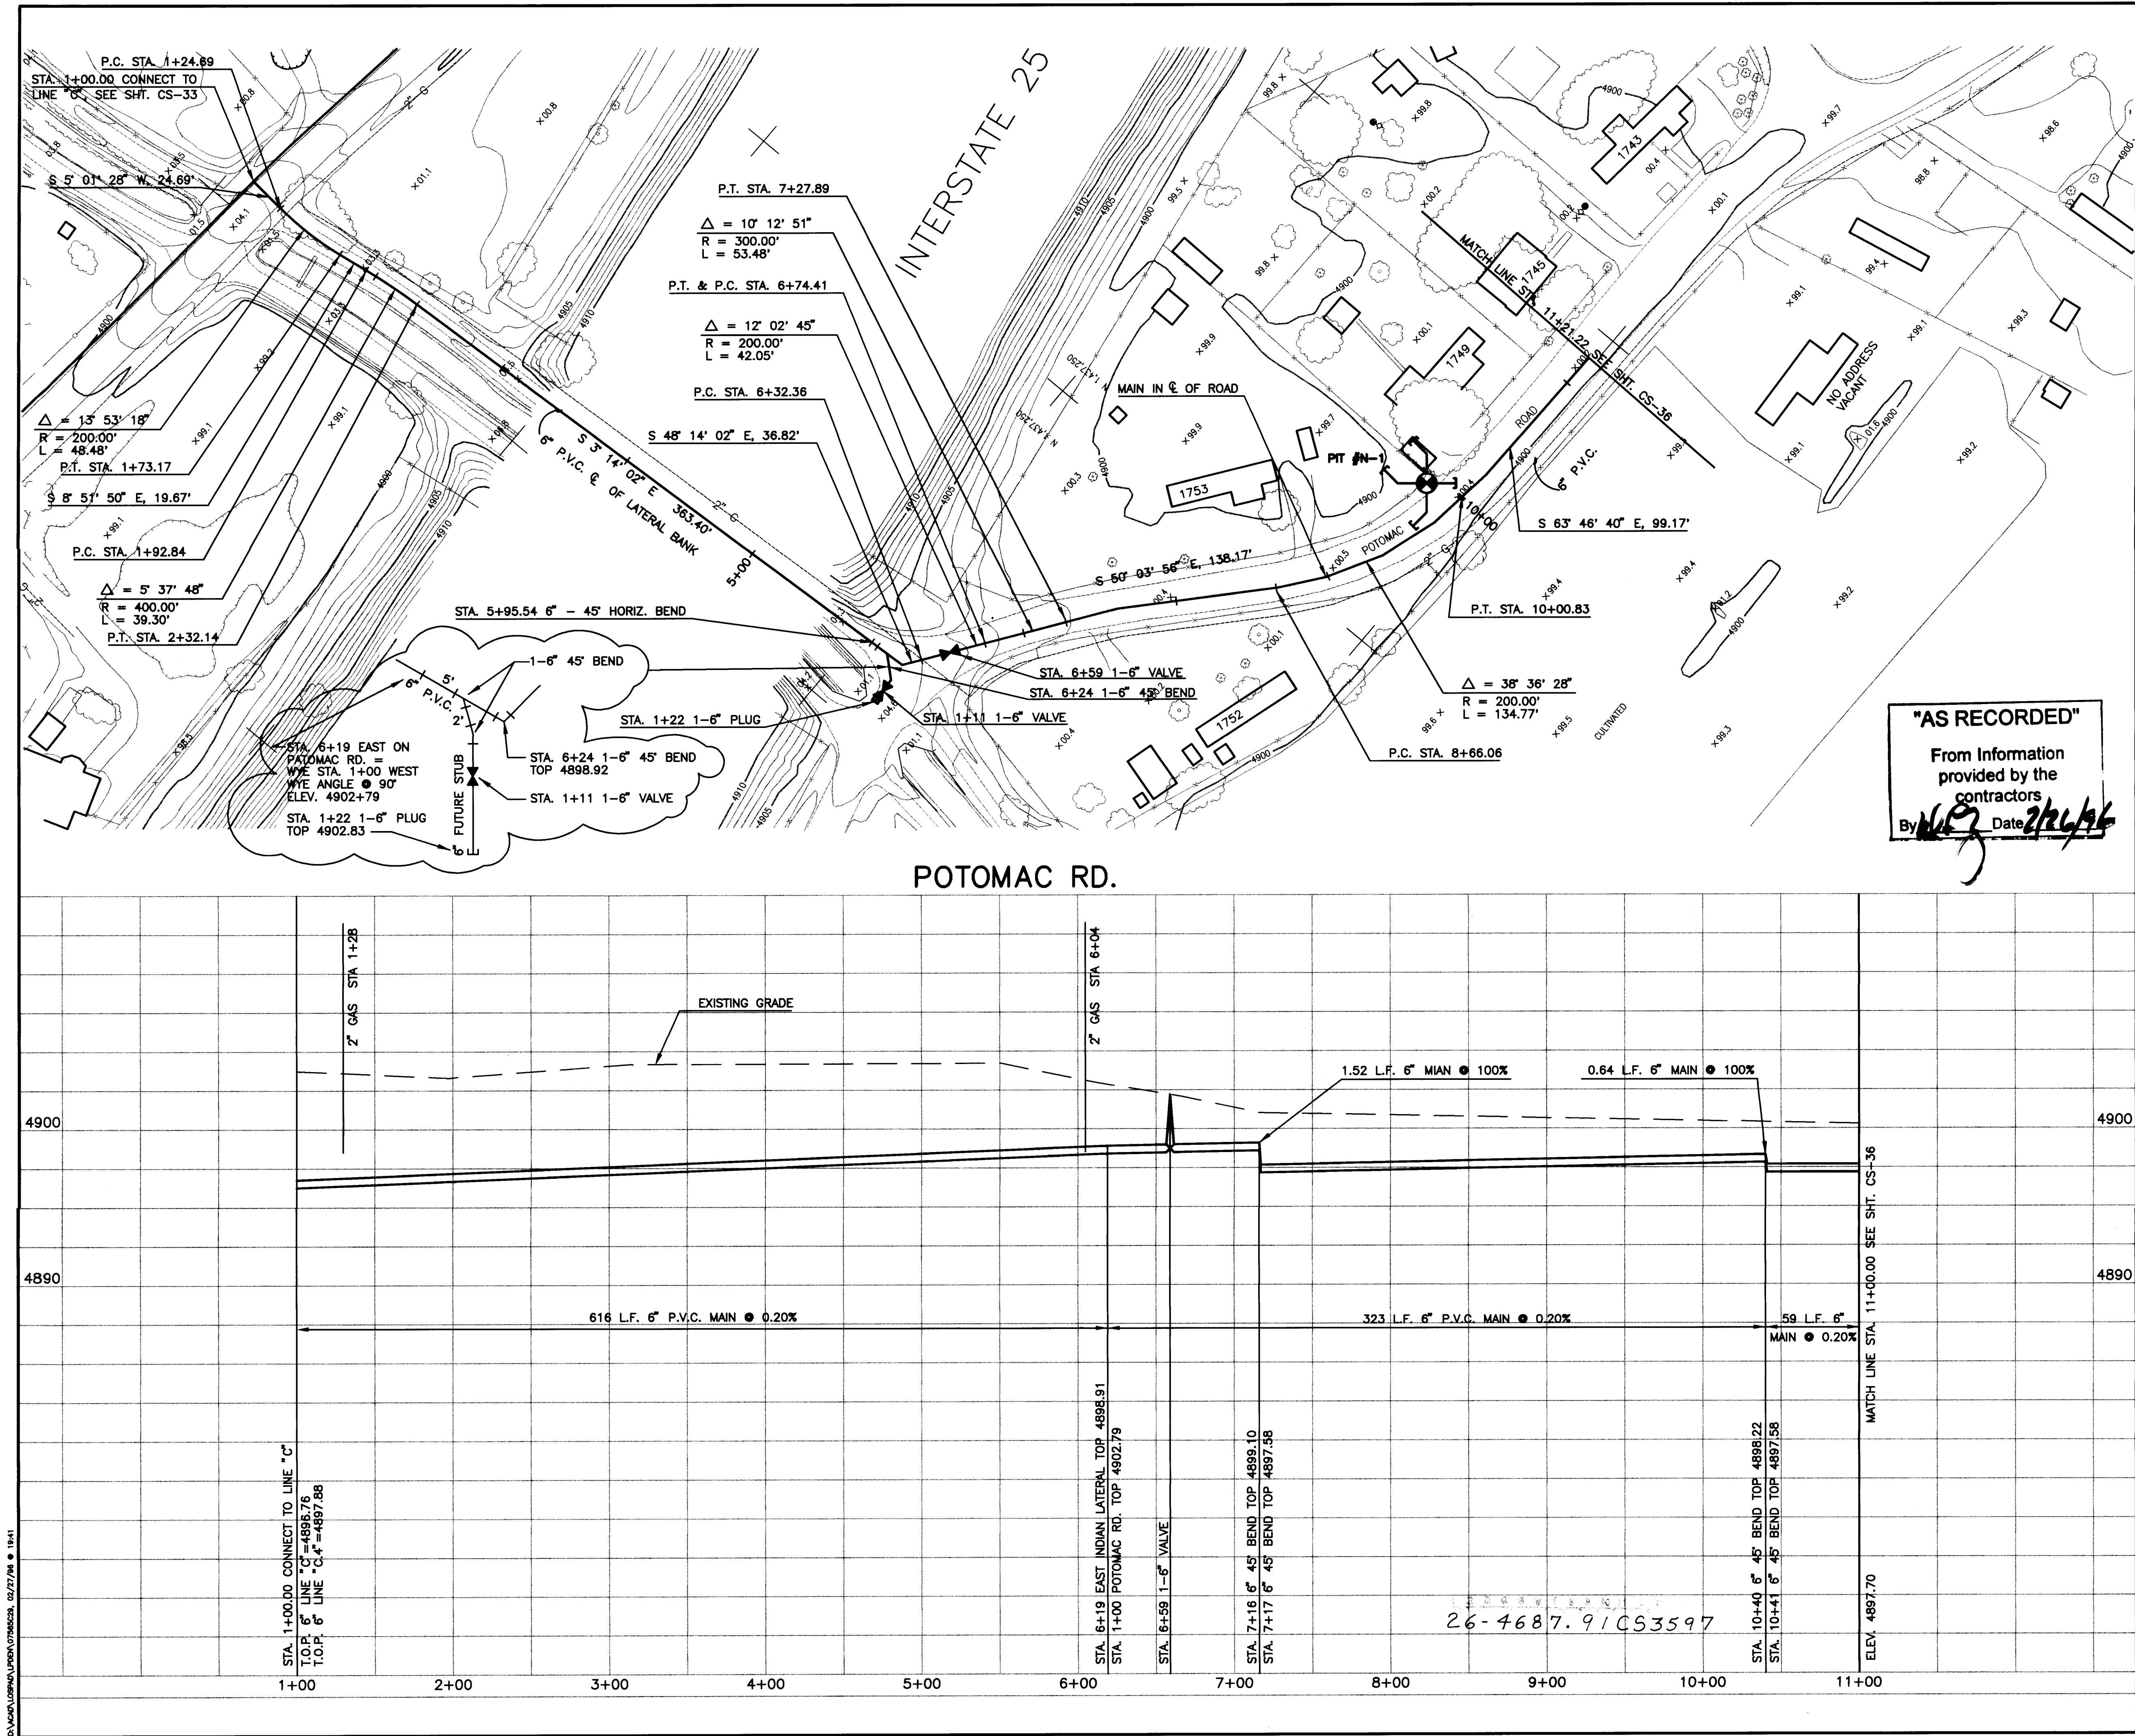

PLAN
SCALE: 1"=50'

PROFILE
SCALE: 1"=50' HOR
1"=5' VERT

LEGEND
NEW
EXIST.
VACUUM SEWER MAIN (ADDITIONAL)
VACUUM SEWER MAIN OR FORCE MAIN
VACUUM SEWER DIVISION VALVE, SEE DETAIL IN CONTRACT DOCUMENTS BOOK OR FORCE MAIN ISOLATION VALVE, SEE DET. ON SHT. G-4
STUB
1" AIR RELEASE VALVE, SEE DETAIL IN CONTRACT DOCUMENTS BOOK
DRAW MANHOLE, SEE DETAIL ON SHEET G-4
30"-3" "AIRVAC" VALVE AND PIT, SEE NOTE 7 ON SHT. G-1
WATER LINE
GAS LINE
UNDERGROUND TELEPHONE LINE
UNDERGROUND ELECTRICAL LINE
OVERHEAD POWER POLE W/ GUY WIRE
LARGE TREE
BRUSH
SIGN
X 00.0 SPOT ELEVATION

NOTES:
1) ALL LATERAL VACUUM MAIN CONNECTIONS SHALL BE CONSTRUCTED PER TYPICAL DETAIL SHOWN IN CONTRACT DOCUMENTS BOOK. REFER TO NOTES 1 AND 6 ON SHEET G-1 ABOUT STATIONING AND DETAILS AT THESE CONNECTIONS.

AS RECORDED
From information provided by the contractors
By *WLF* Date *2/26/96*

SERVICE LOCATION TABLE		
STREET ADDRESS	STATION	PIT NO.
1749 POTOMAC RD.	10+17	N-1
1753 POTOMAC RD.	10+17	N-1
1752 POTOMAC RD.	10+17	N-1
VACANT LOT	10+17	N-1

HDR
HDR Engineering, Inc.

CITY OF ALBUQUERQUE
PUBLIC WORKS DEPARTMENT
ENGINEERING GROUP

TITLE:
LOS PADILLAS AREA
VACUUM COLLECTION SYSTEM AND FORCE MAIN - PHASE IIA
STOMAC DRIVE
LINE "C.4" STA. 1+00 TO STA. 11+00


APPROVALS	ENGINEER	DATE	APPROVALS	ENGINEER	DATE
DRC CHAIRMAN			WATER		
TRANSPORTATION			WASTE WATER		
HYDROLOGY					

PROJECT NO. 4687.91
MAP NO. U-12
SHEET CS-35 OF

AS BUILT INFORMATION
CONTRACTOR: TRAD
DATE: 10/95
STATIONED BY: BAILEY/MASON
DATE: 10/95
FIELD ADJUSTMENT BY: WILSON & CO.
DATE: 11/95
DRAWINGS CORRECTED BY: WILSON & CO.
DATE: 11/95
MICRO-FILM INFORMATION
RECORDED BY: NO.
DATE:


SURVEY INFORMATION
FIELD NOTES
NO. BY DATE
From centerline of Potomac and Interstate 25, travel North 126° ± to the BM on the West side of the street. The BM is a standard ACS 3 1/4" aluminum cap rivetted to a pipe 0.25' above ground. Cap is stamped "5-R11, 1988".
Spirit Level Elevation - 4912.078 ft.

ENGINEER'S SEAL
BY: *WLF*
REMARKS
REVISIONS
DESIGN
DATE: DECEMBER 1993
DRAWN BY: TAS
CHECKED BY: WFL, LC
DATE: DECEMBER 1993
DATE: DECEMBER 1994

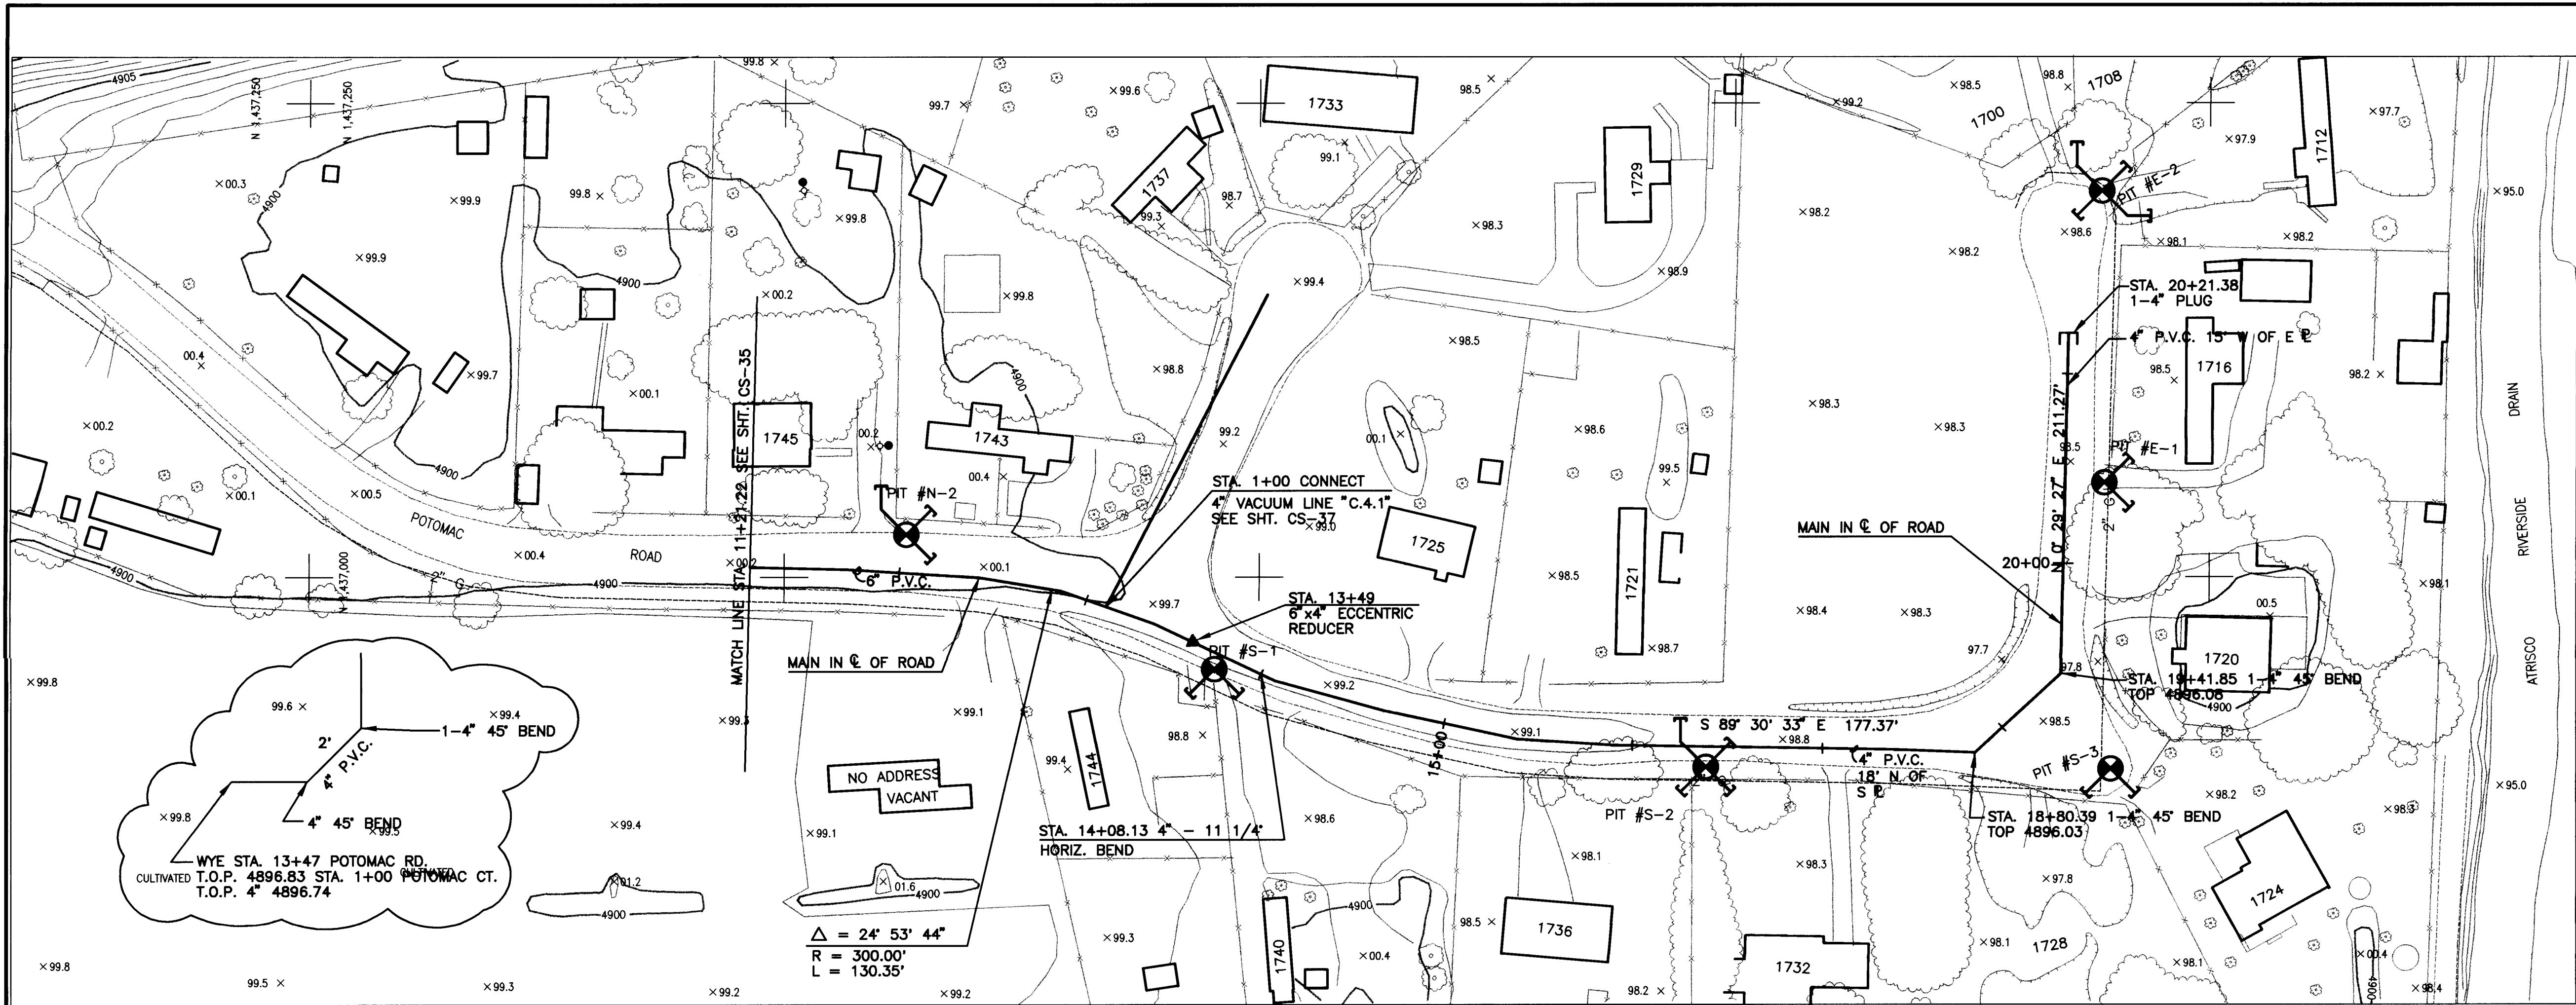

PLAN
SCALE: 1"=50'

PROFILE
SCALE: 1"=50' HOR
1"=5' VERT

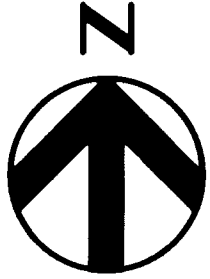

LEGEND

- NEW
EXIST.
- VACUUM SEWER MAIN (ADDITIONAL)
VACUUM SEWER MAIN OR FORCE MAIN
VACUUM SEWER DIVISION VALVE, SEE DETAIL IN CONTRACT DOCUMENTS BOOK OR FORCE MAIN ISOLATION VALVE, SEE DET. ON SHT. G-4
STUB
1" AIR RELEASE VALVE, SEE DETAIL IN CONTRACT DOCUMENTS BOOK
DRAIN MANHOLE, SEE DETAIL ON SHEET G-4
30"-3" "AIRVAC" VALVE AND PIT, SEE NOTE 7 ON SHT. G-1
- WATER LINE
--- GAS LINE
--- UNDERGROUND TELEPHONE LINE
--- UNDERGROUND ELECTRICAL LINE
--- OVERHEAD POWER POLE W/ GUY WIRE
--- LARGE TREE
--- BRUSH
--- SIGN
X 00.0 SPOT ELEVATION


NOTES:
1) ALL LATERAL VACUUM MAIN CONNECTIONS SHALL BE CONSTRUCTED PER TYPICAL DETAIL SHOWN IN CONTRACT DOCUMENTS BOOK. REFER TO NOTES 1 AND 6 ON SHEET G-1 ABOUT STATIONING AND DETAILS AT THESE CONNECTIONS.

POTOMAC RD.

"AS RECORDED"

From information provided by the contractors

By *[Signature]* Date *2/26/96*

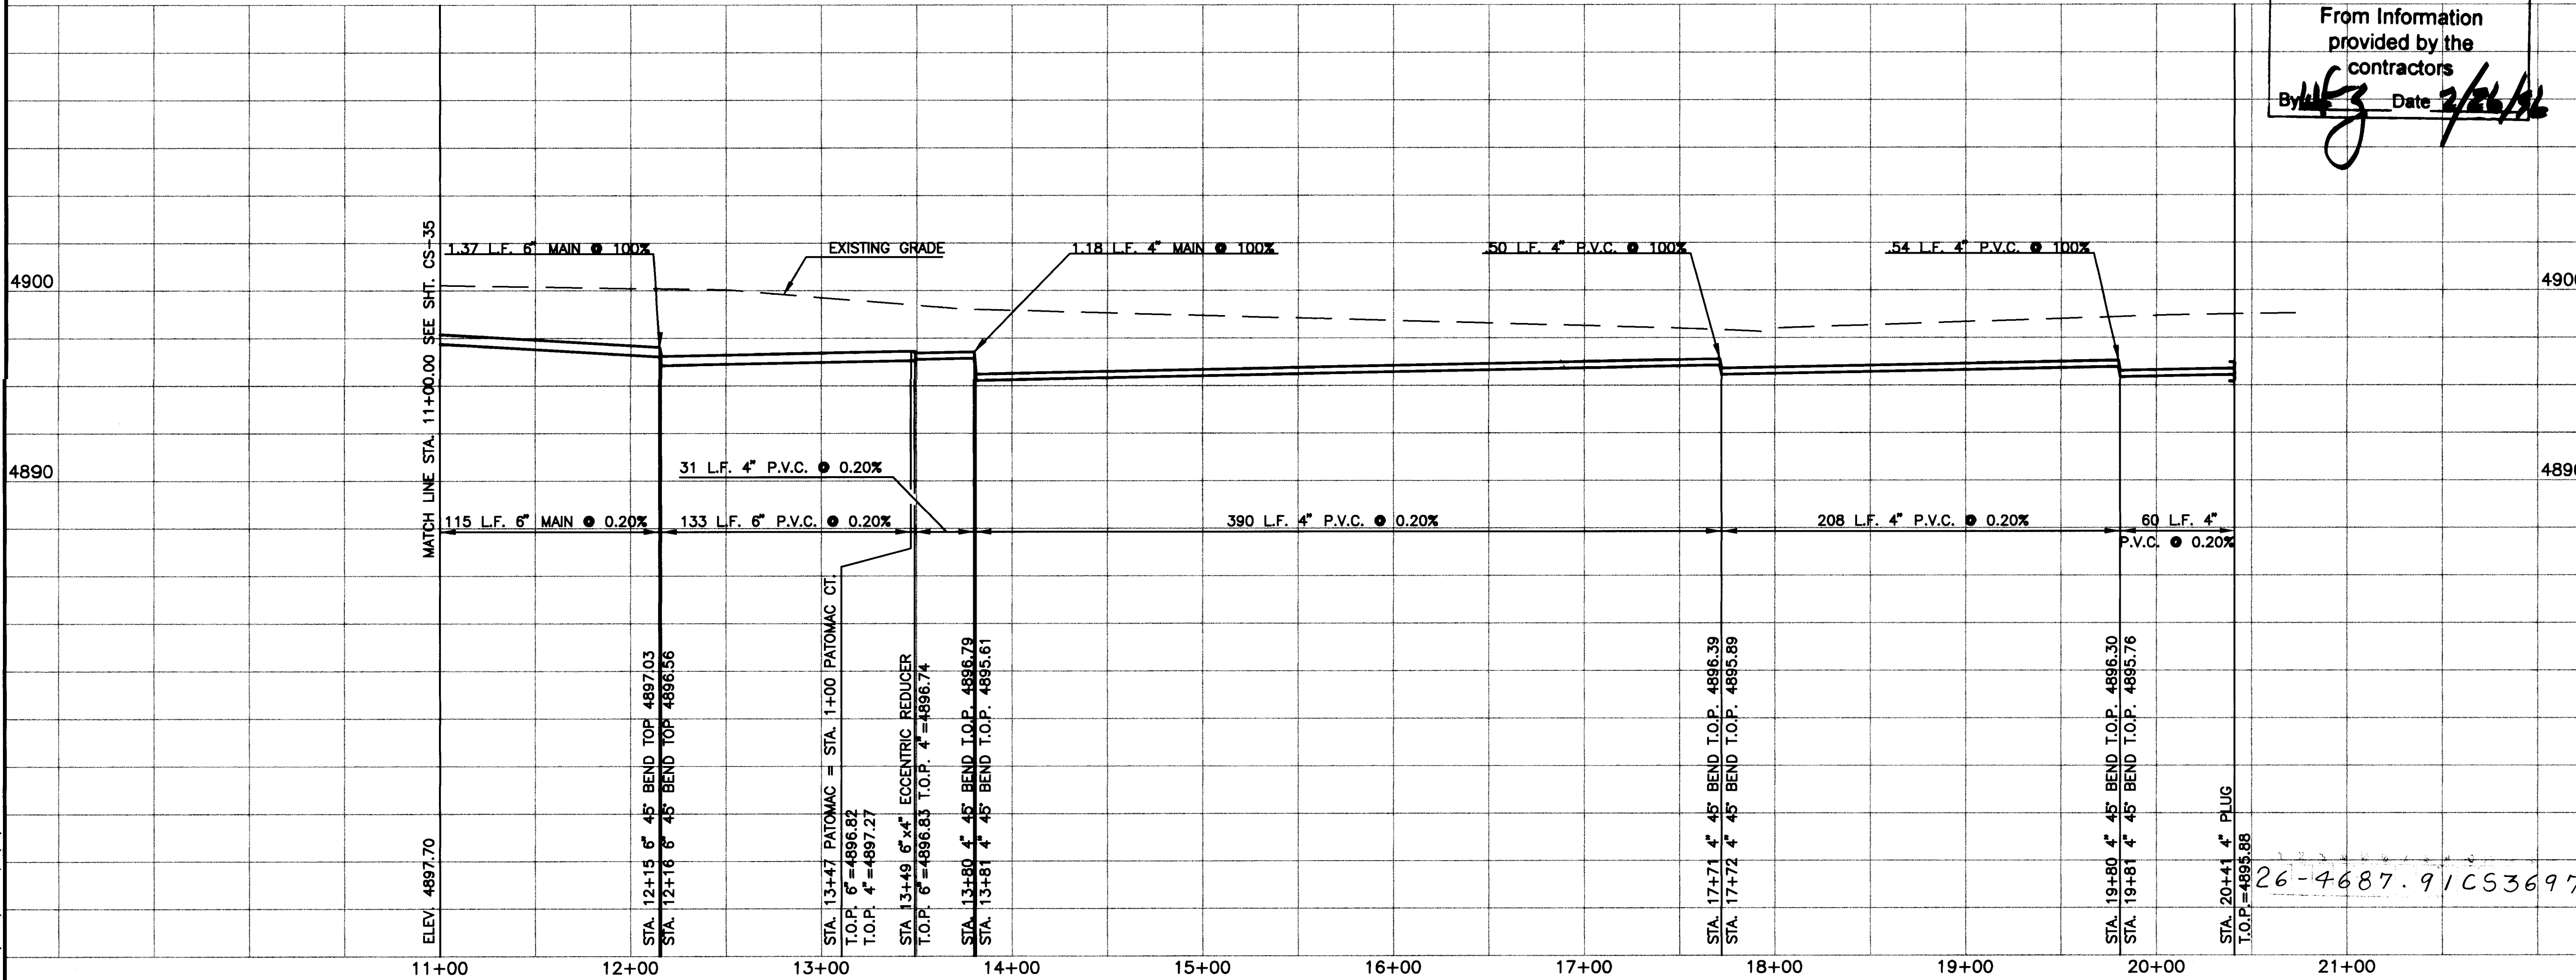

SERVICE LOCATION TABLE		
STREET ADDRESS	STATION	PIT NO.
1743 POTOMAC RD.	12+24	N-2
1745 POTOMAC RD.	12+24	N-2
1750 POTOMAC RD.	12+24	N-2
1740 POTOMAC RD.	14+06	S-1
1744 POTOMAC RD.	14+06	S-1
1721 POTOMAC RD.	16+59	S-2
1732 POTOMAC RD.	16+59	S-2
1736 POTOMAC RD.	16+59	S-2
VACANT LOT POTOMAC RD.	16+59	S-2
1724 POTOMAC RD.	18+82	S-3
1728 POTOMAC RD.	18+82	S-3
1716 POTOMAC RD.	19+88	E-1
1720 POTOMAC RD.	19+88	E-1
VACANT LOT POTOMAC RD.	21+50	E-2
1700 POTOMAC RD.	21+50	E-2
1708 POTOMAC RD.	21+50	E-2
1712 POTOMAC RD.	21+50	E-2

HDR
HDR Engineering, Inc.


CITY OF ALBUQUERQUE PUBLIC WORKS DEPARTMENT ENGINEERING GROUP		
TITLE: LOS PADILLAS AREA VACUUM COLLECTION SYSTEM AND FORCE MAIN - PHASE IIA POTOMAC ROAD LINE "C.4" STA. 11+00 TO STA. 20+30		
APPROVALS	ENGINEER	DATE
DRC CHAIRMAN	WATER	DATE
TRANSPORTATION	WASTE WATER	DATE
HYDROLOGY		DATE

PROJECT NO. 4687.91
MAP NO. U-12
SHEET CS-36 OF 36




REVISIONS	
NO.	DATE
1	DESIGN
2	REVISIONS
3	REVISIONS
4	REVISIONS
5	REVISIONS
6	REVISIONS
7	REVISIONS
8	REVISIONS
9	REVISIONS
10	REVISIONS

DESIGNED BY	WFL, TAS, DW	DATE	DECEMBER 1993
DRAWN BY	TAS	DATE	DECEMBER 1993
CHECKED BY	WFL, LC	DATE	DECEMBER 1994

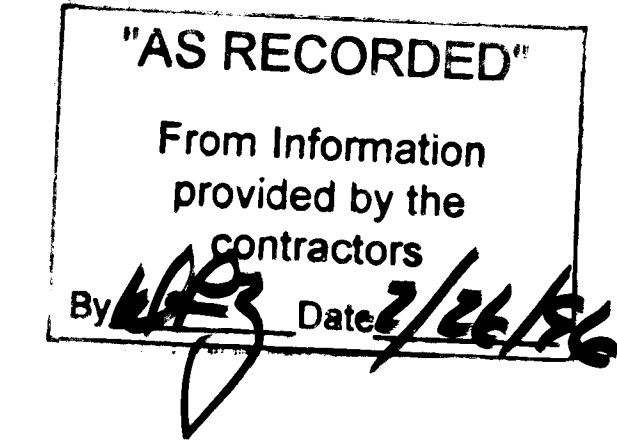

PROFILE

SCALE: 1"=50' HOR
1"=5' VERT

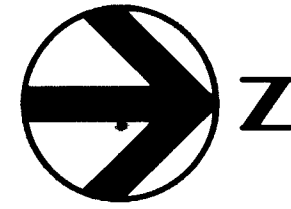

LEGEND

	<u>NEW</u>		<u>EXIST.</u>
			
			
			
			
			
			
			
			
			
			
			
			
			
			

NOTES:
1) ALL LATERAL VACUUM MAIN CONNECTIONS SHALL BE
CONSTRUCTED PER TYPICAL DETAIL SHOWN IN CONTRACT
DOCUMENTS BOOK. REFER TO NOTES 1 AND 6 ON SHEET G-1
ABOUT STATIONING AND DETAILS AT THESE CONNECTIONS.

SERVICE LOCATION TABLE		
STREET ADDRESS	STATION	PIT NO.
1725 POTOMAC RD.	3+28	E-1
1729 POTOMAC RD.	3+28	E-1
1733 POTOMAC RD.	3+28	E-1
1737 POTOMAC RD.	3+28	E-1

ENGINEER'S SEAL

[illegible]

HDR
HDR Engineering, Inc.


CITY OF ALBUQUERQUE
PUBLIC WORKS DEPARTMENT
ENGINEERING GROUP

TITLE: LOS PADILLAS AREA
VACUUM COLLECTION SYSTEM AND FORCE MAIN - PHASE IIA


LINE "C.4.1" STA. 1+00 TO STA. 2+85


APPROVALS	ENGINEER	DATE	APPROVALS	ENGINEER	DATE
DRC CHAIRMAN			WATER		
TRANSPORTATION			WASTE WATER		
HYDROLOGY					

PROJECT NO.	4687.91	MAP NO.	U-12	SHEET	CS-37	OF.
-------------	---------	---------	------	-------	-------	-----

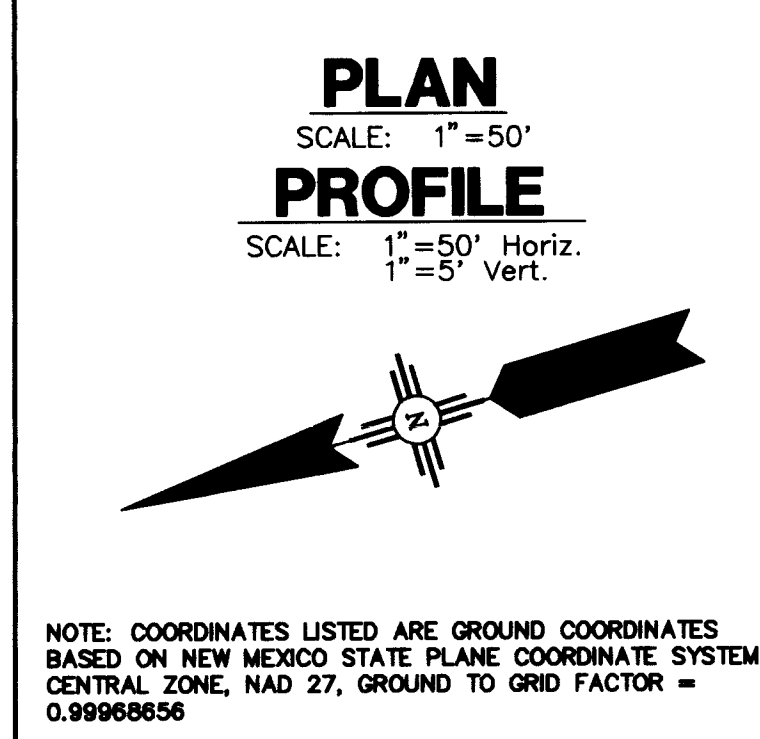


SURVEY INFORMATION		BENCH MARKS		AS BUILT INFORMATION	
FIELD NOTES					
NO.	BY	DATE			
			6-R11, CITY OF ALBUQUERQUE BENCH MARK, THE STATION IS A STANDARD ACS 3 7/8" ALUMINUM CAP RIVETED TO A PIPE 0.25' ABOVE THE GROUND AND IS STAMPED "6-R11,1988".	CONTRACTOR TRAID BUILDERS	DATE 12/95
			STATION IS LOCATED ON EAST SIDE OF ISLETA BLVD. AT INTERSECTION OF ISLETA BLVD. AND DON FELIPE RD.	SUPVISED BY TRAID BUILDERS	DATE 12/95
				CHECKED BY WILSON & COMPANY	DATE 12/95
				RECORDED BY GANNETT FLEMING WEST	DATE 12/95
				MICRO-FILM INFORMATION	
				RECORDED BY	DATE
				NO.	

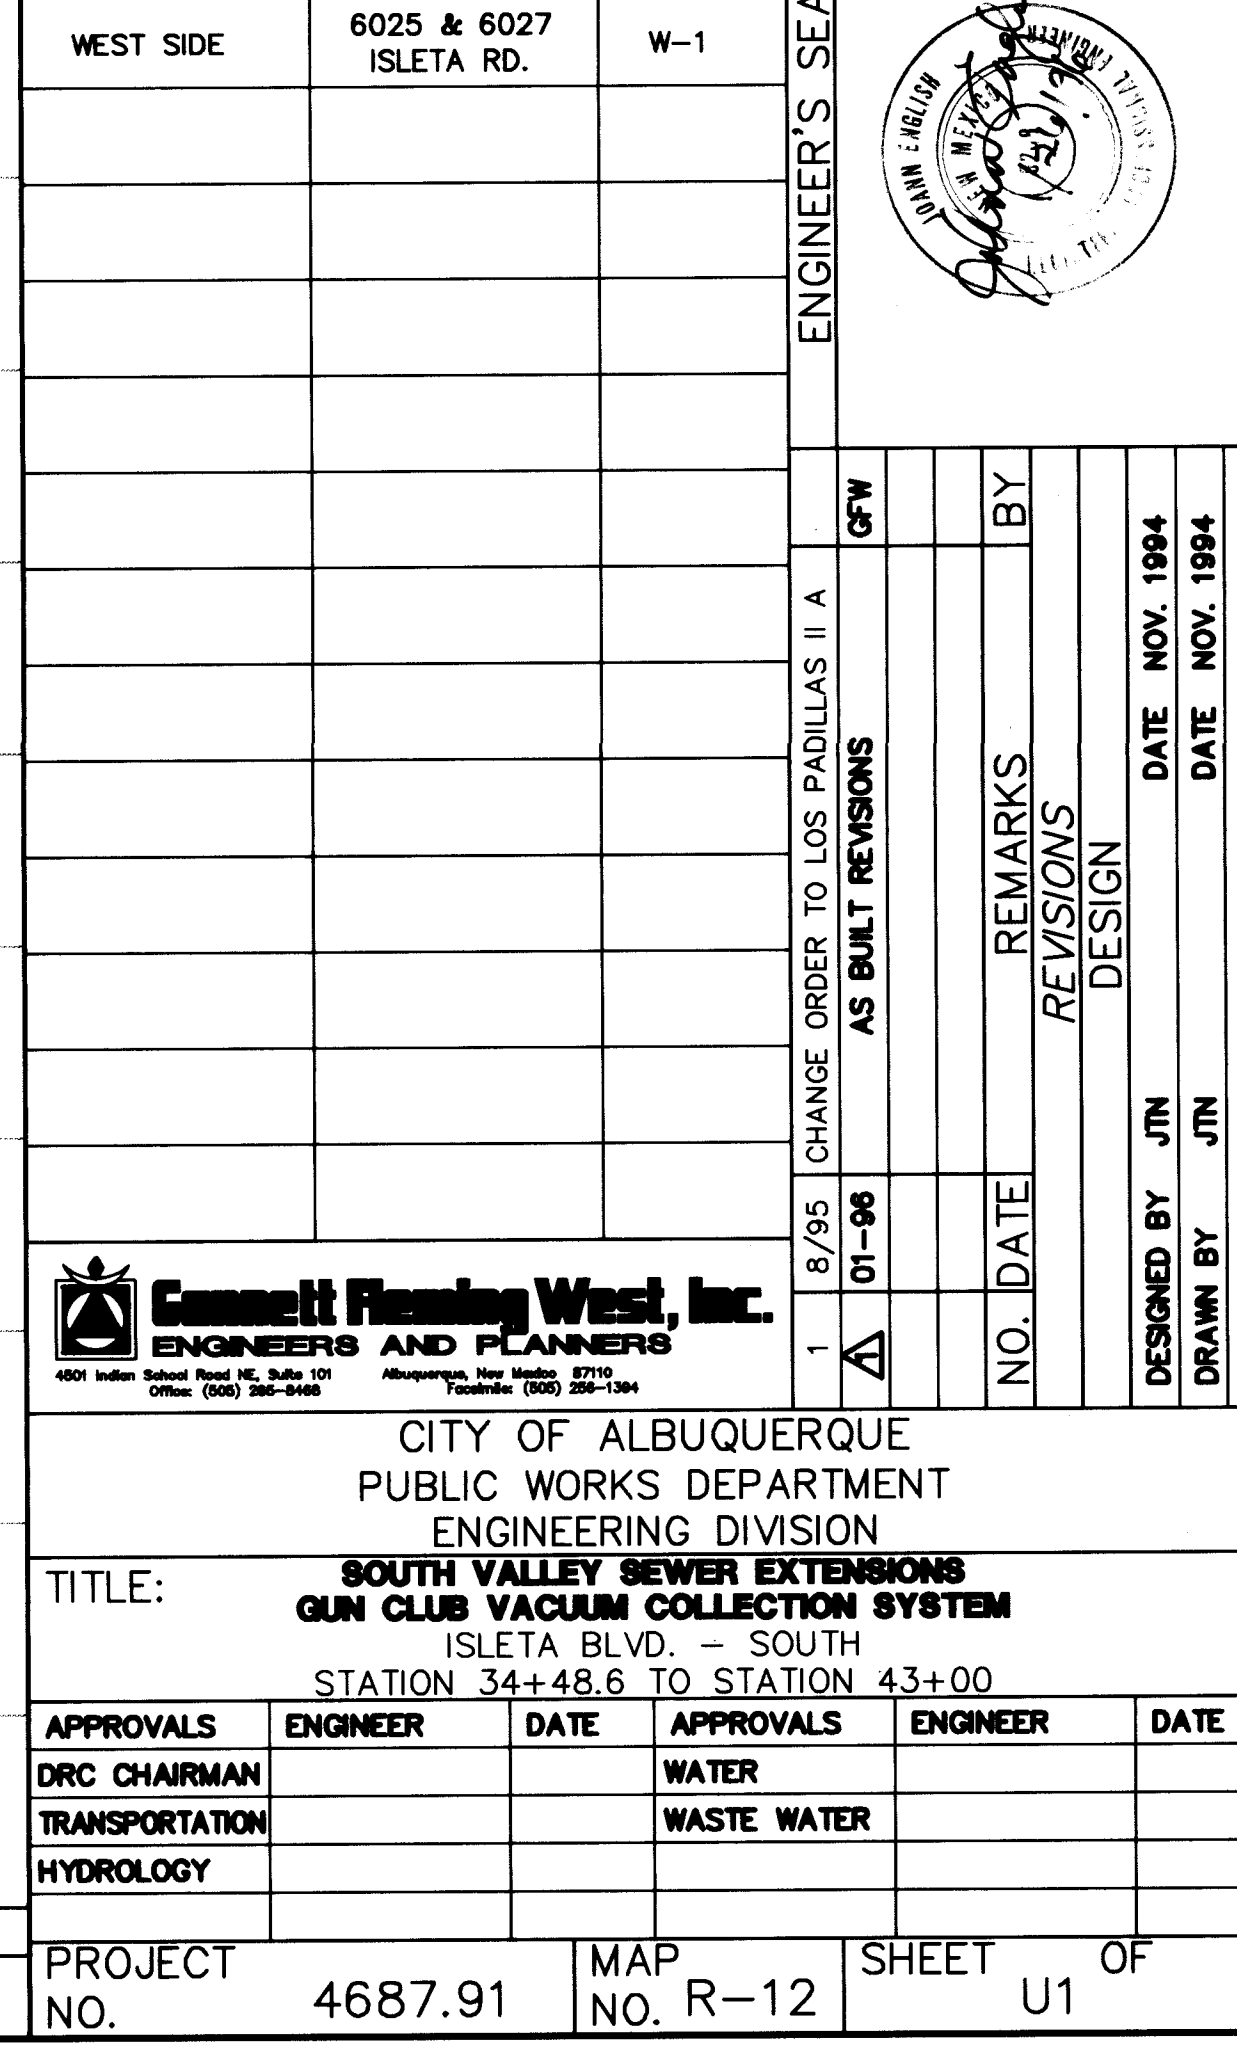

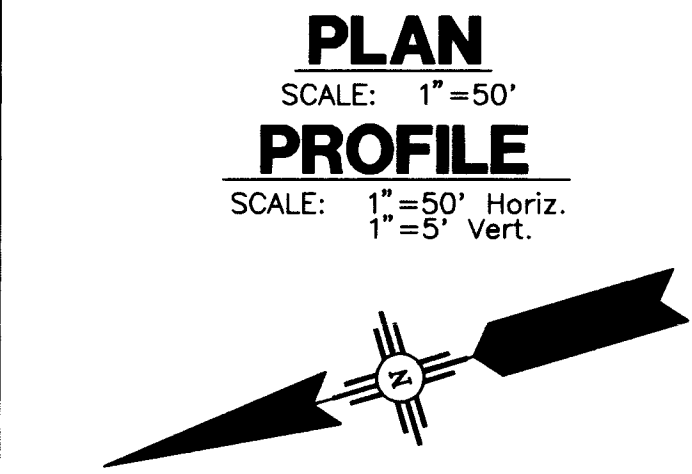

SEWER SERVICE SCHEDULE

RECORD DRAWING
Drawing revised to reflect the
best information available. Do
not use without field verification.

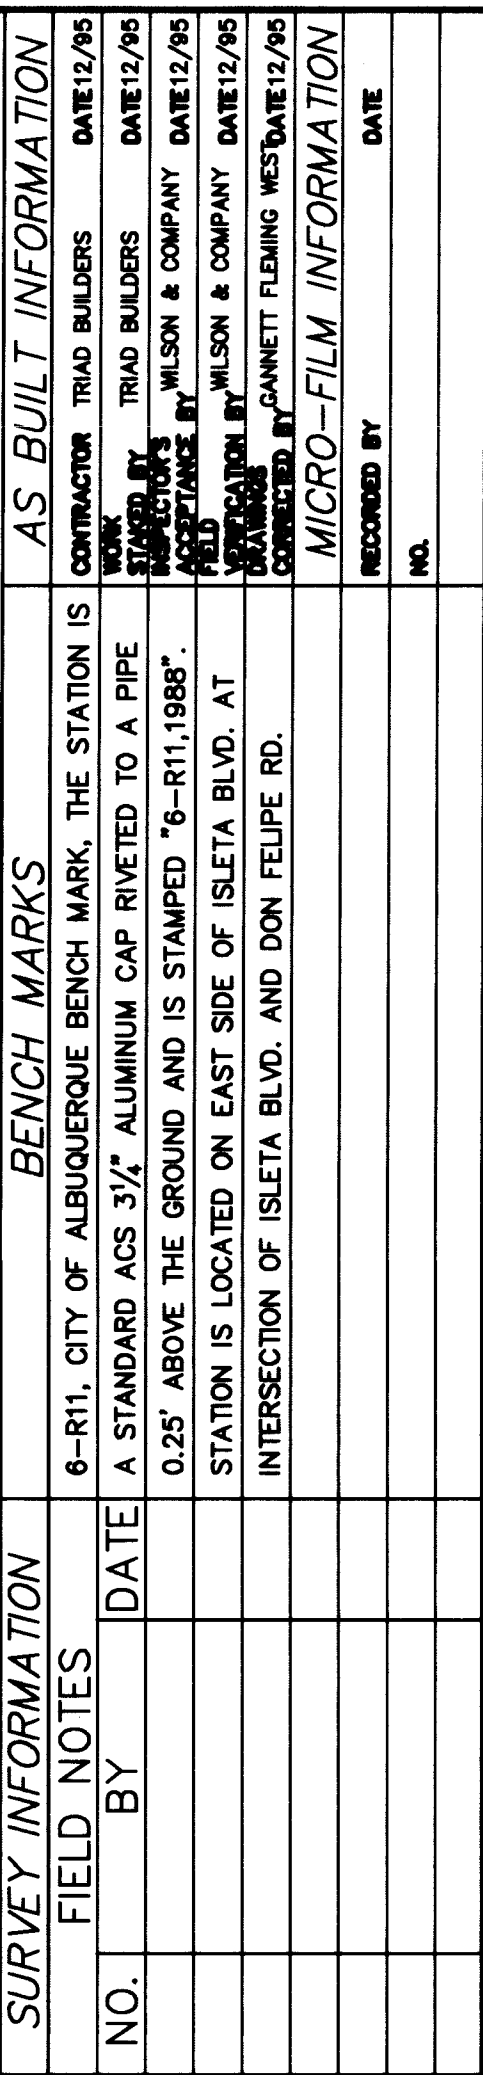

1	8/95	CHANGE ORDER TO LOS PADILLAS II A.	
NO.	DATE	REMARKS	BY
REVISIONS			
DESIGN			
DESIGNED BY		JTN	DATE NOV. 1994
DRAWN BY		JTN	DATE NOV. 1994
CHECKED BY		JE	DATE NOV. 1994


CITY OF ALBUQUERQUE
PUBLIC WORKS DEPARTMENT
ENGINEERING DIVISION

TITLE: **SOUTH VALLEY SEWER EX**
GUN CLUB VACUUM COLLECT
ISLETA BLVD. - SO
STATION 43+00 TO STATIC


APPROVALS	ENGINEER	DATE	APPROVAL
BIO-CHARMAN			WATER
TRANSPORTATION			WASTE W
HYDROLOGY			

PROJECT NO.	4687.91	MAP NO. R-12
-------------	---------	--------------

DATE: 03-01-96
FILE: L:\PROJECTS\29290\AS-BUILT\VAC2004

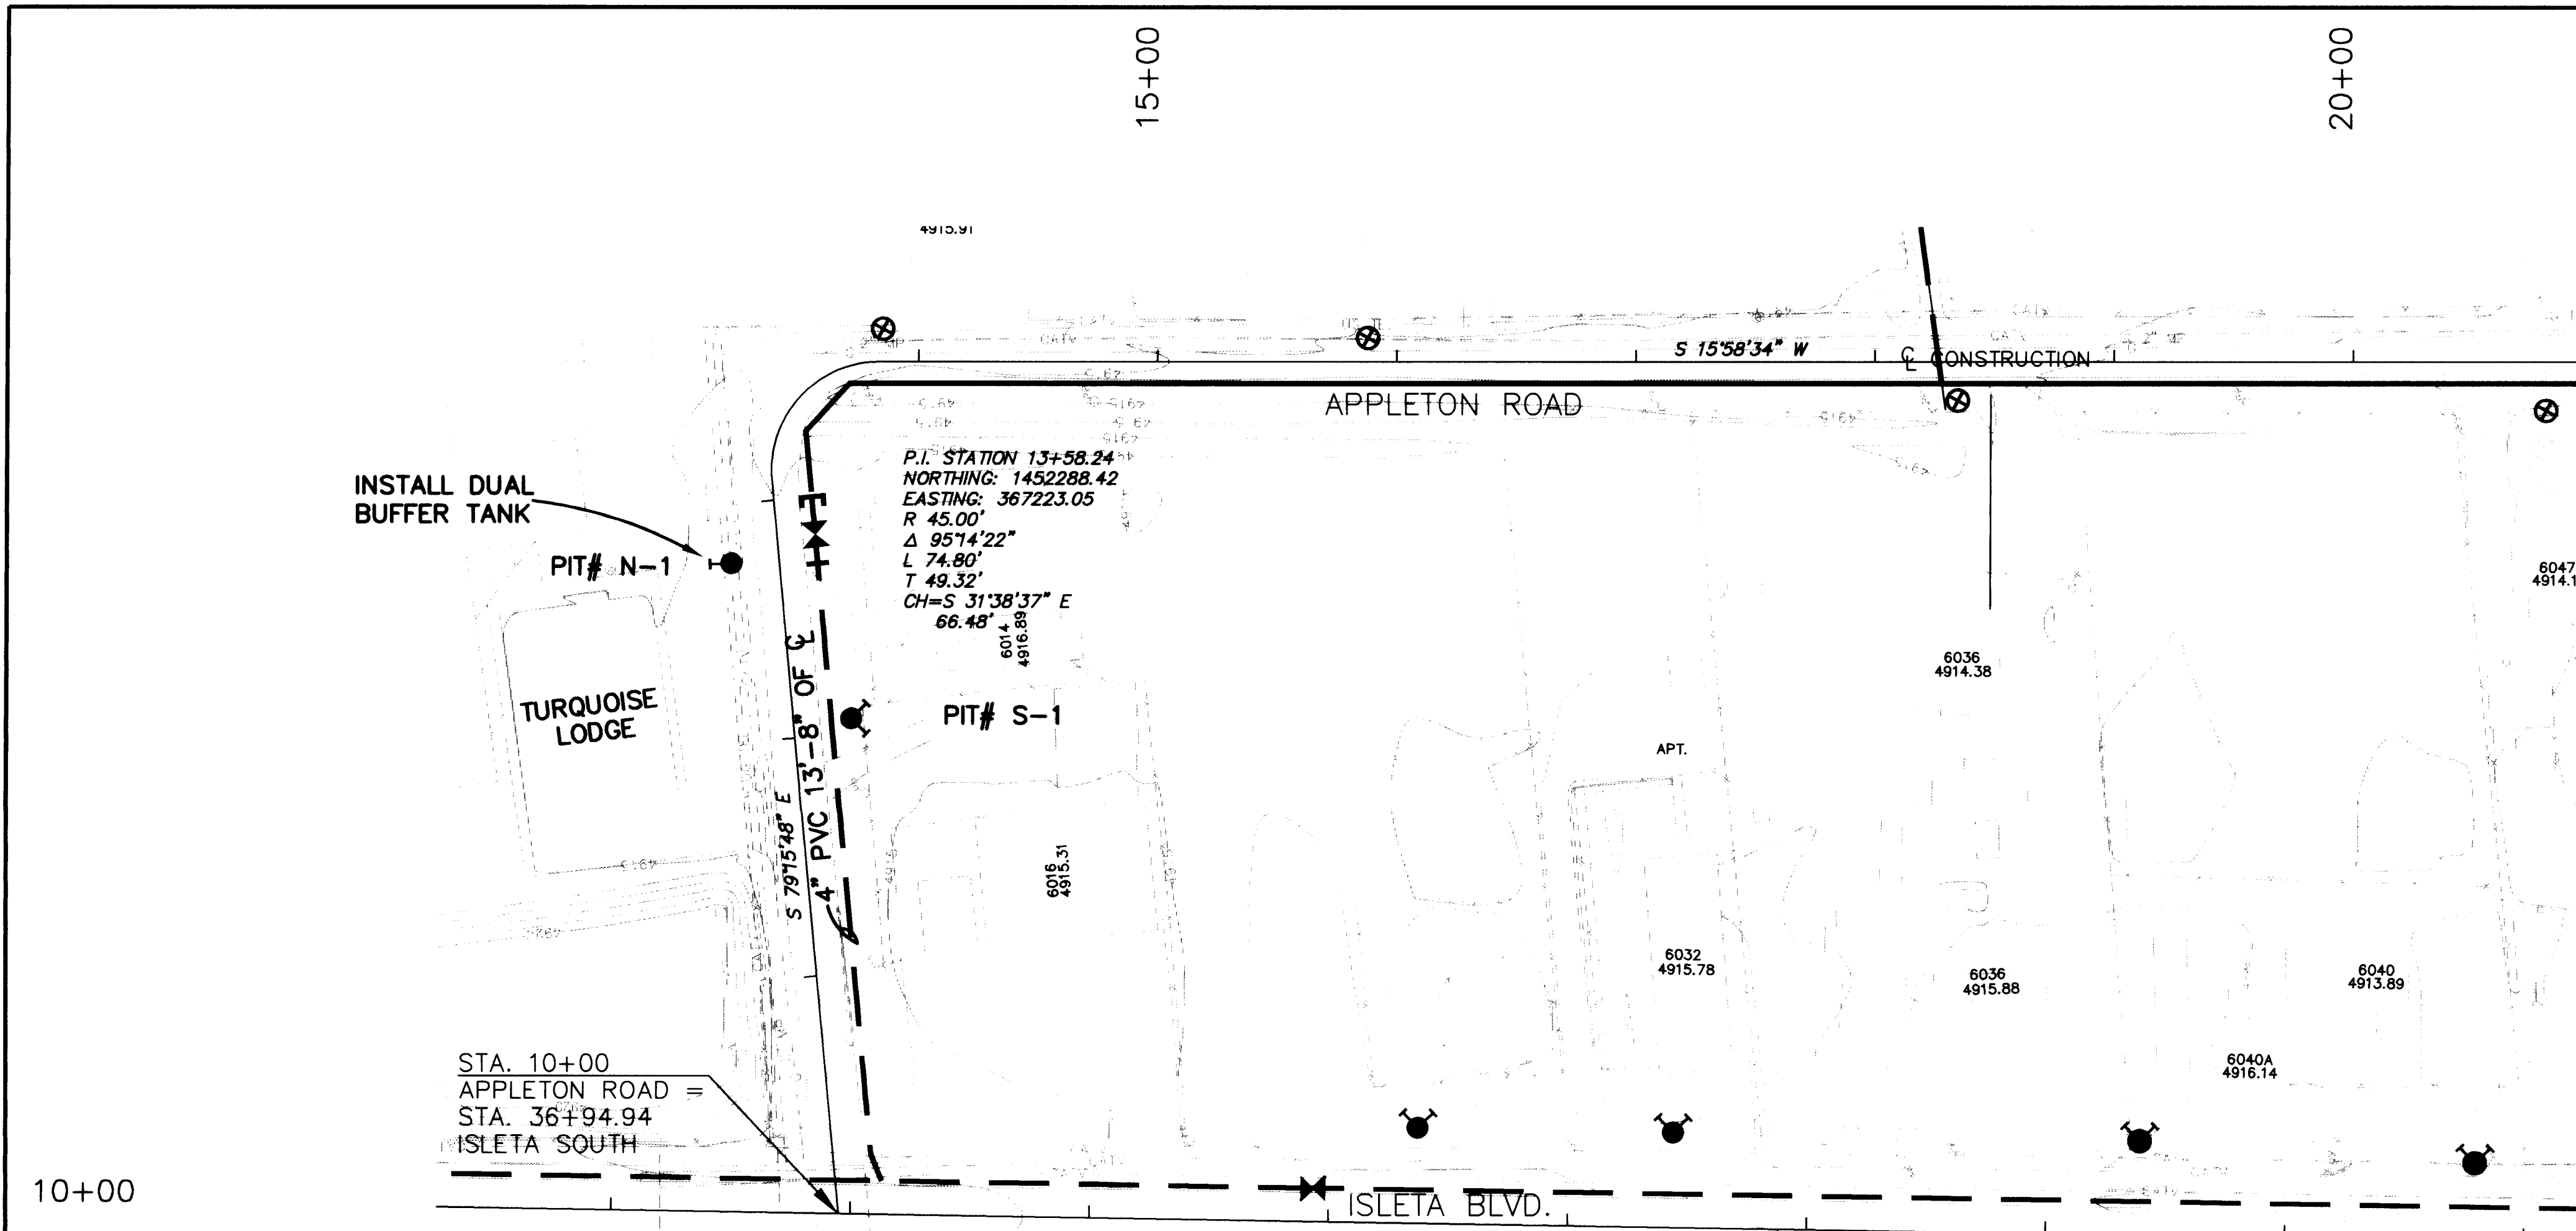

DATE: 01-11-96
FILE: L:\PROJECTS\20290\AS-BUILT\VAC2031.DWG

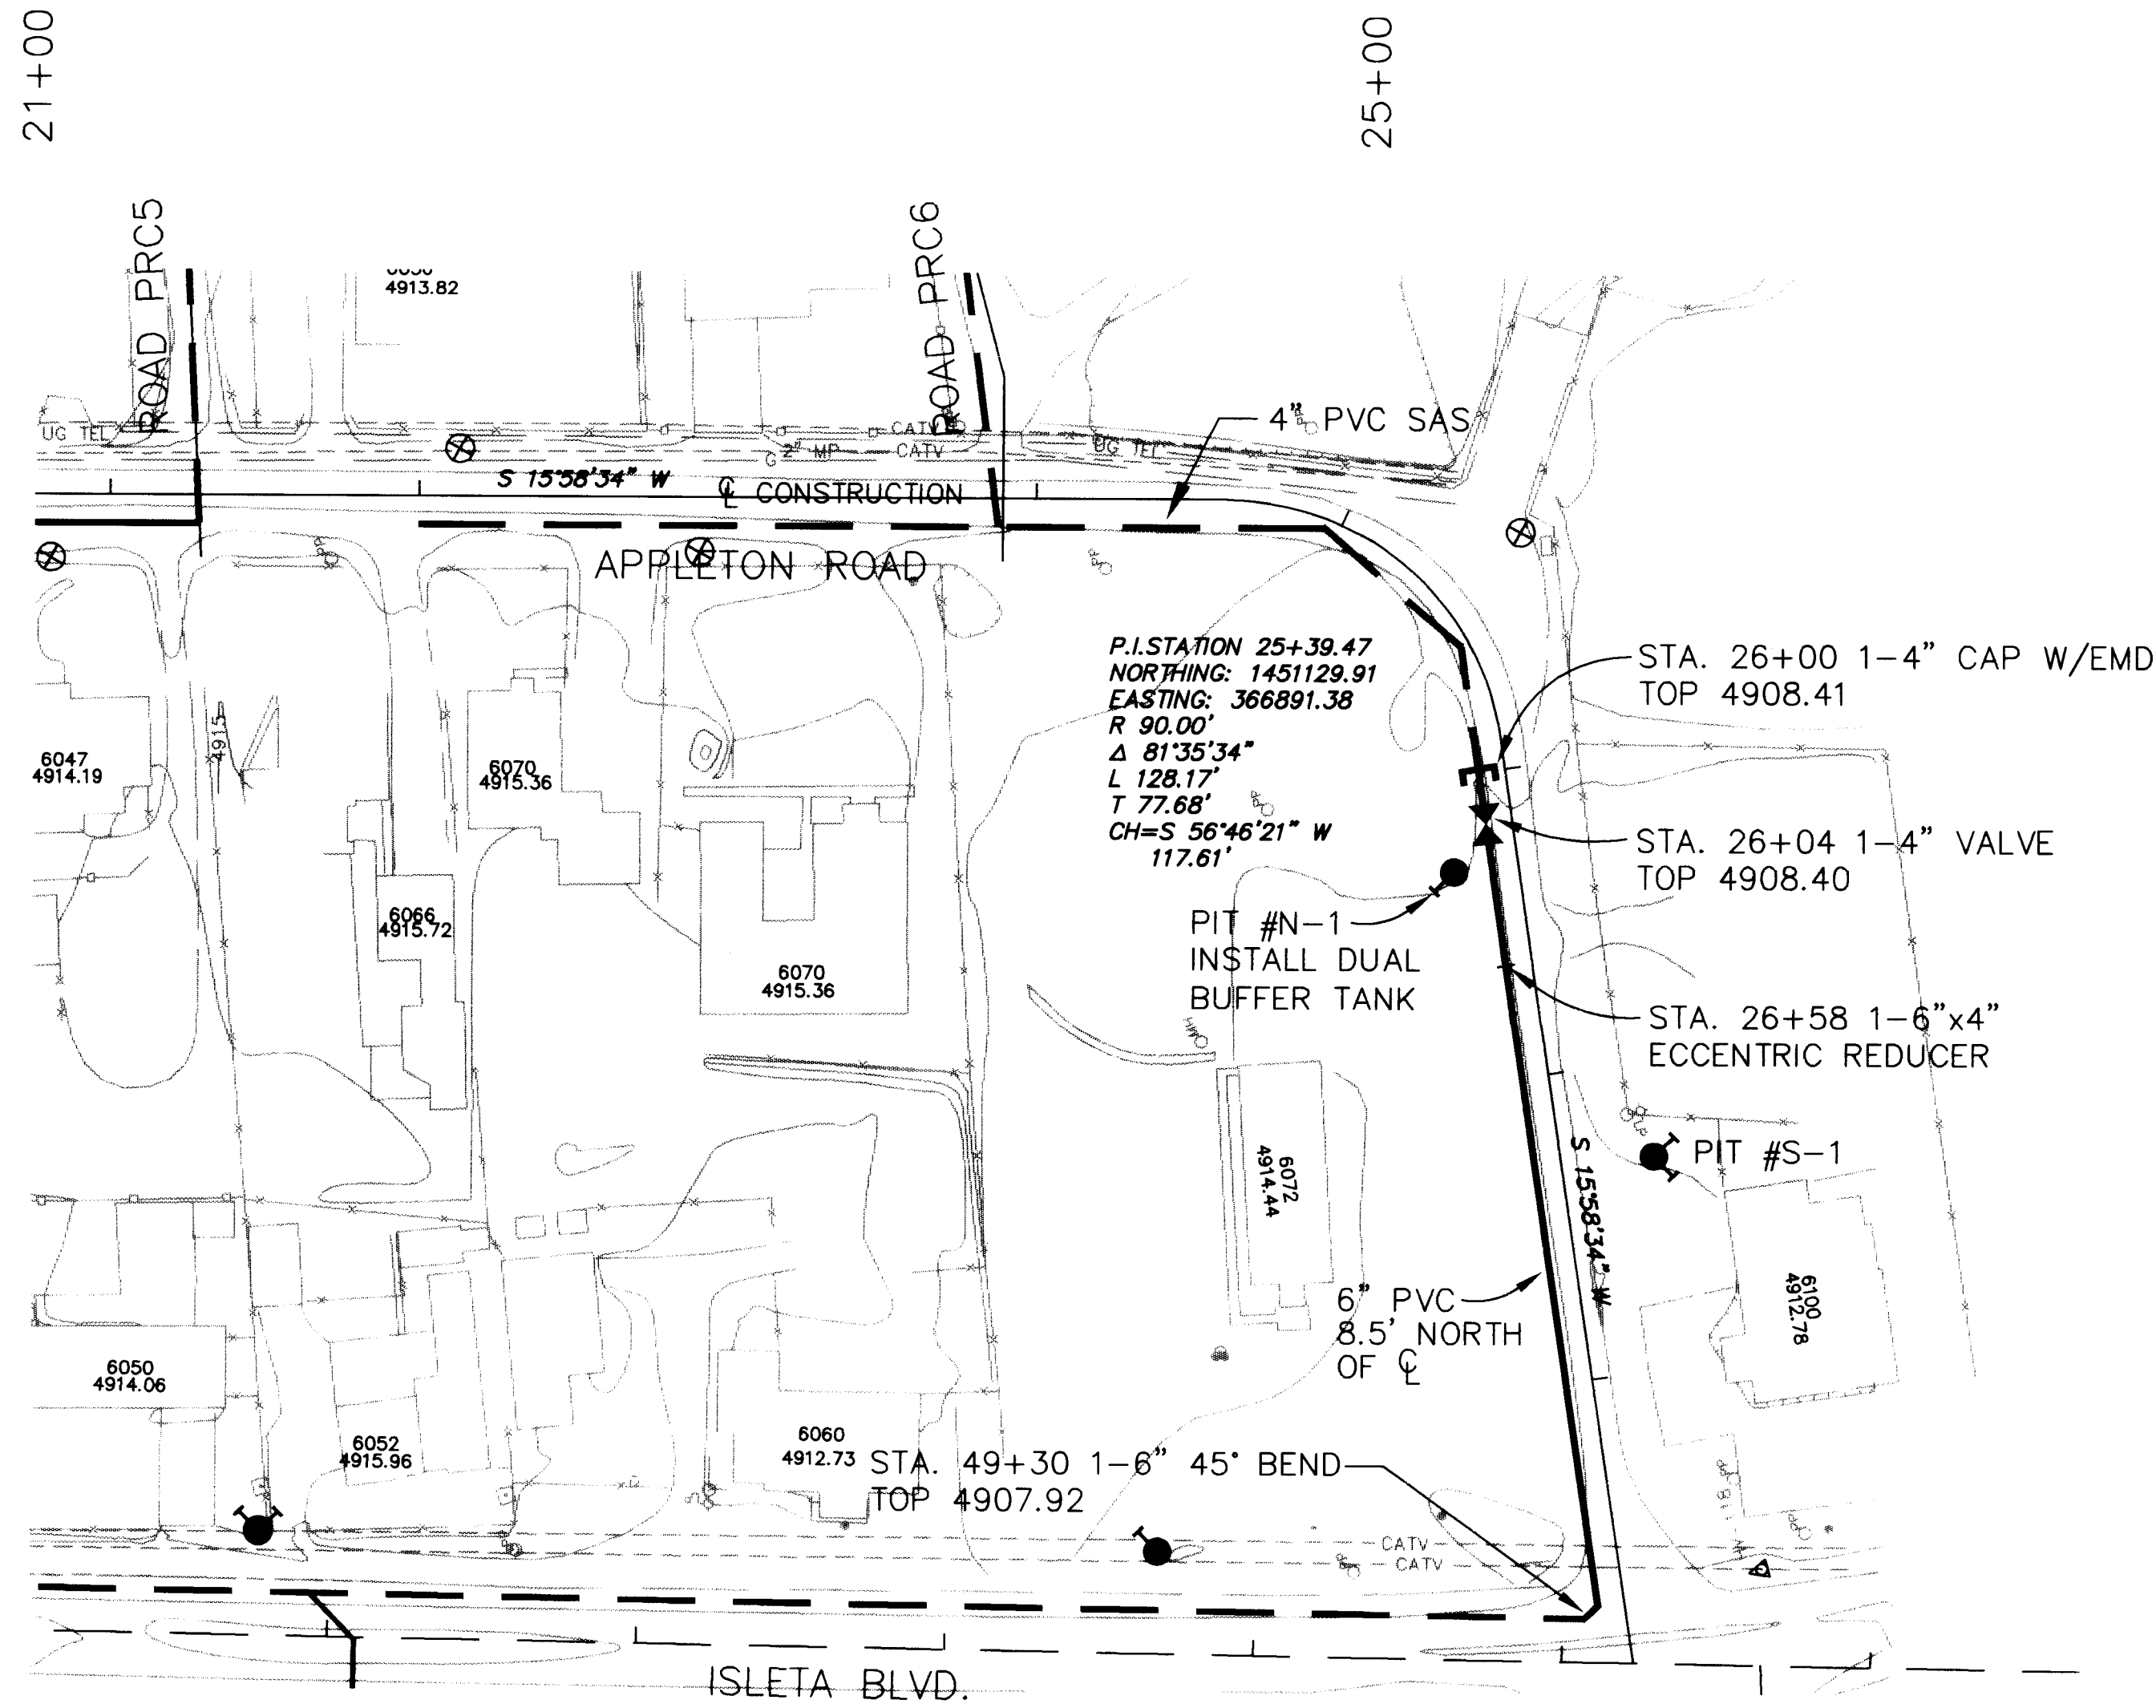

PLAN
SCALE: 1"=50'

PROFILE
SCALE: 1"=50' Horiz.
1"=5' Vert.

NOTE: COORDINATES LISTED ARE GROUND COORDINATES
BASED ON NEW MEXICO STATE PLANE COORDINATE SYSTEM,
CENTRAL ZONE, NAD 27, GROUND TO GRID FACTOR =
0.99968656

AS BUILT INFORMATION

CONTRACTOR: TRAD BUILDER
DATE: 12/95

STATION: 21+00 TO 28+77.3
DATE: 12/95

DESIGNED BY: JTN
DRAWN BY: JTN
CHECKED BY: JE
DATE: NOV. 1994
DATE: NOV. 1994
DATE: NOV. 1994

ENGINEER'S SEAL

1 8/95 CHANGE ORDER TO LOS PADILLAS II A

NO. DATE
REMARKS
REVISIONS
DESIGN

CITY OF ALBUQUERQUE
PUBLIC WORKS DEPARTMENT
ENGINEERING DIVISION

TITLE: SOUTHWEST VALLEY SEWER EXTENSIONS
GUN CLUB VACUUM COLLECTION SYSTEM
APPLETON ROAD-SOUTH
STATION 21+00 TO STATION 28+77.3

APPROVALS
ENGINEER
DATE

APPROVALS
ENGINEER
DATE






APPROVALS
DRC CHAIRMAN
TRANSPORTATION
HYDROLOGY

APPROVALS
WATER
WASTE WATER

PROJECT NO. 4687.91



MAP NO. R-11

SHEET U4 OF 4

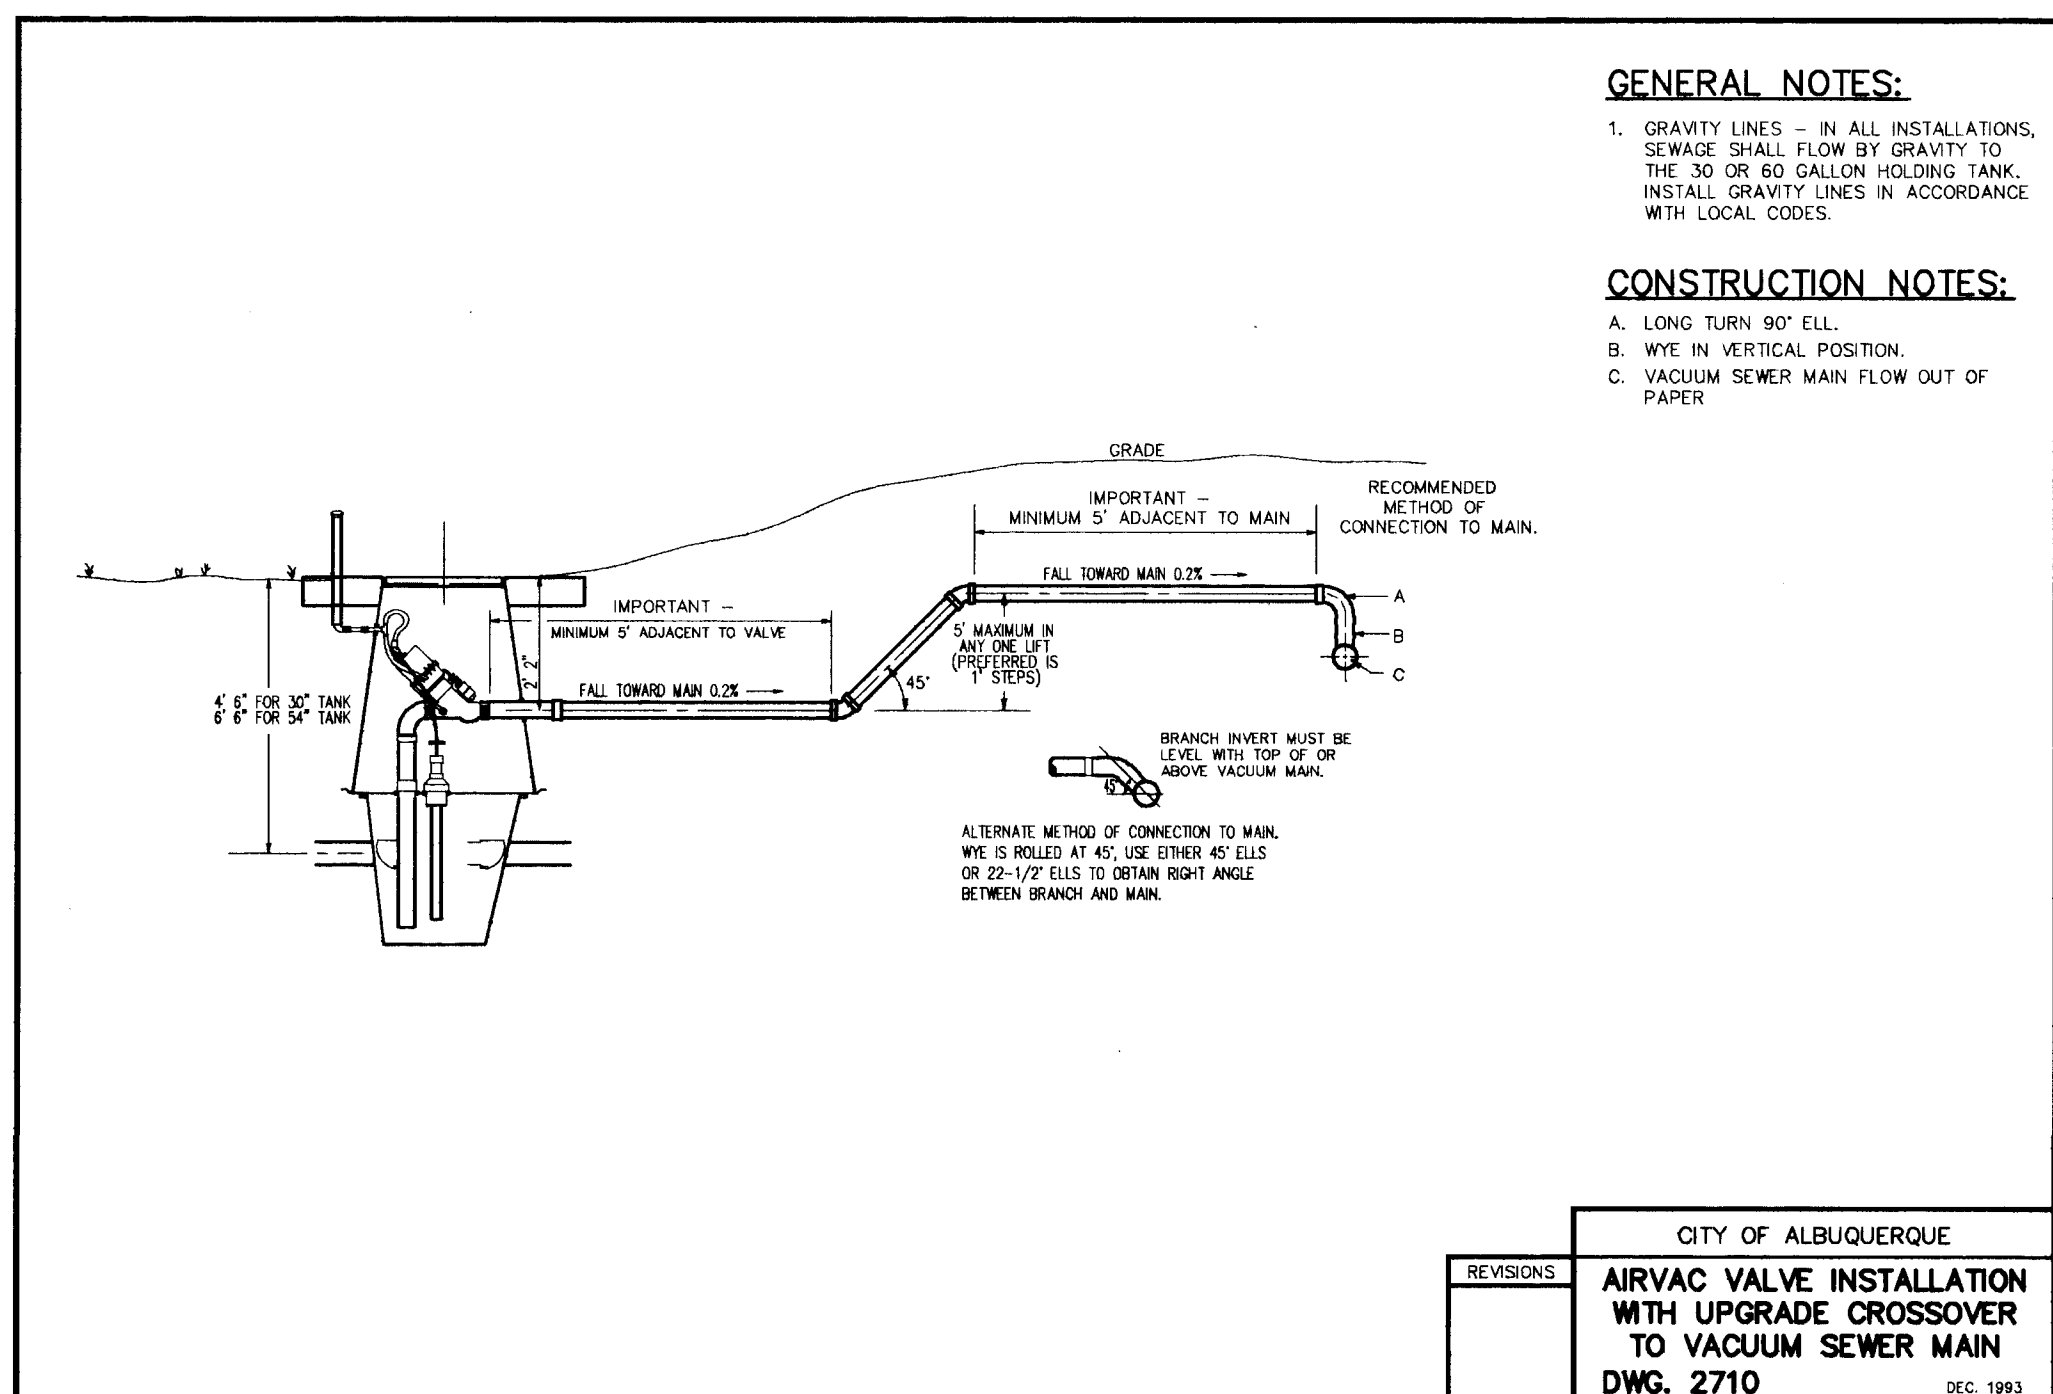
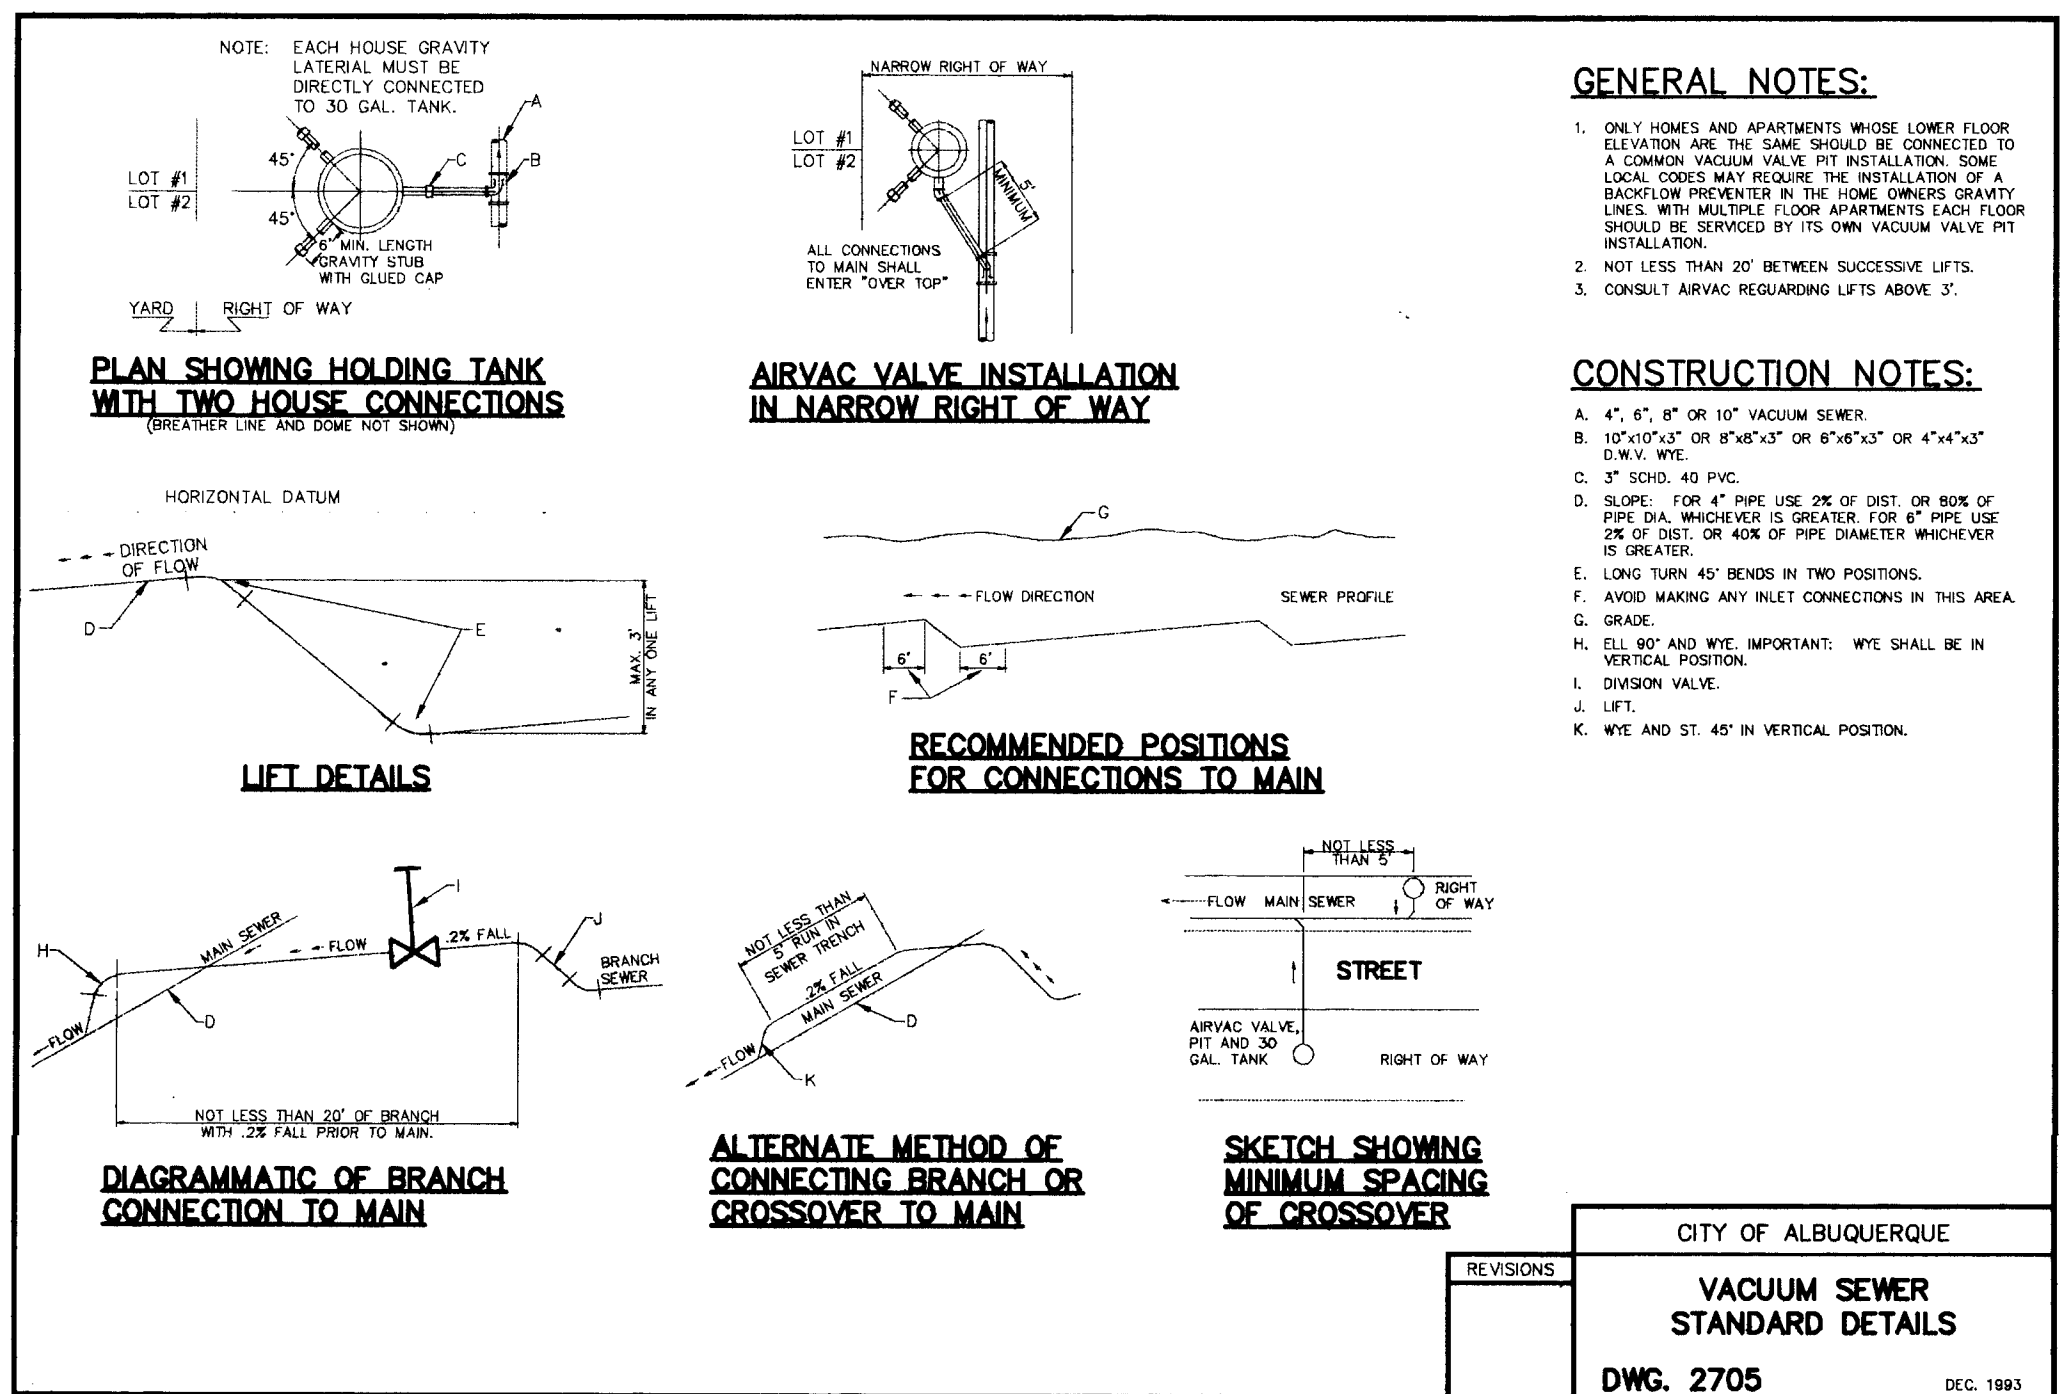
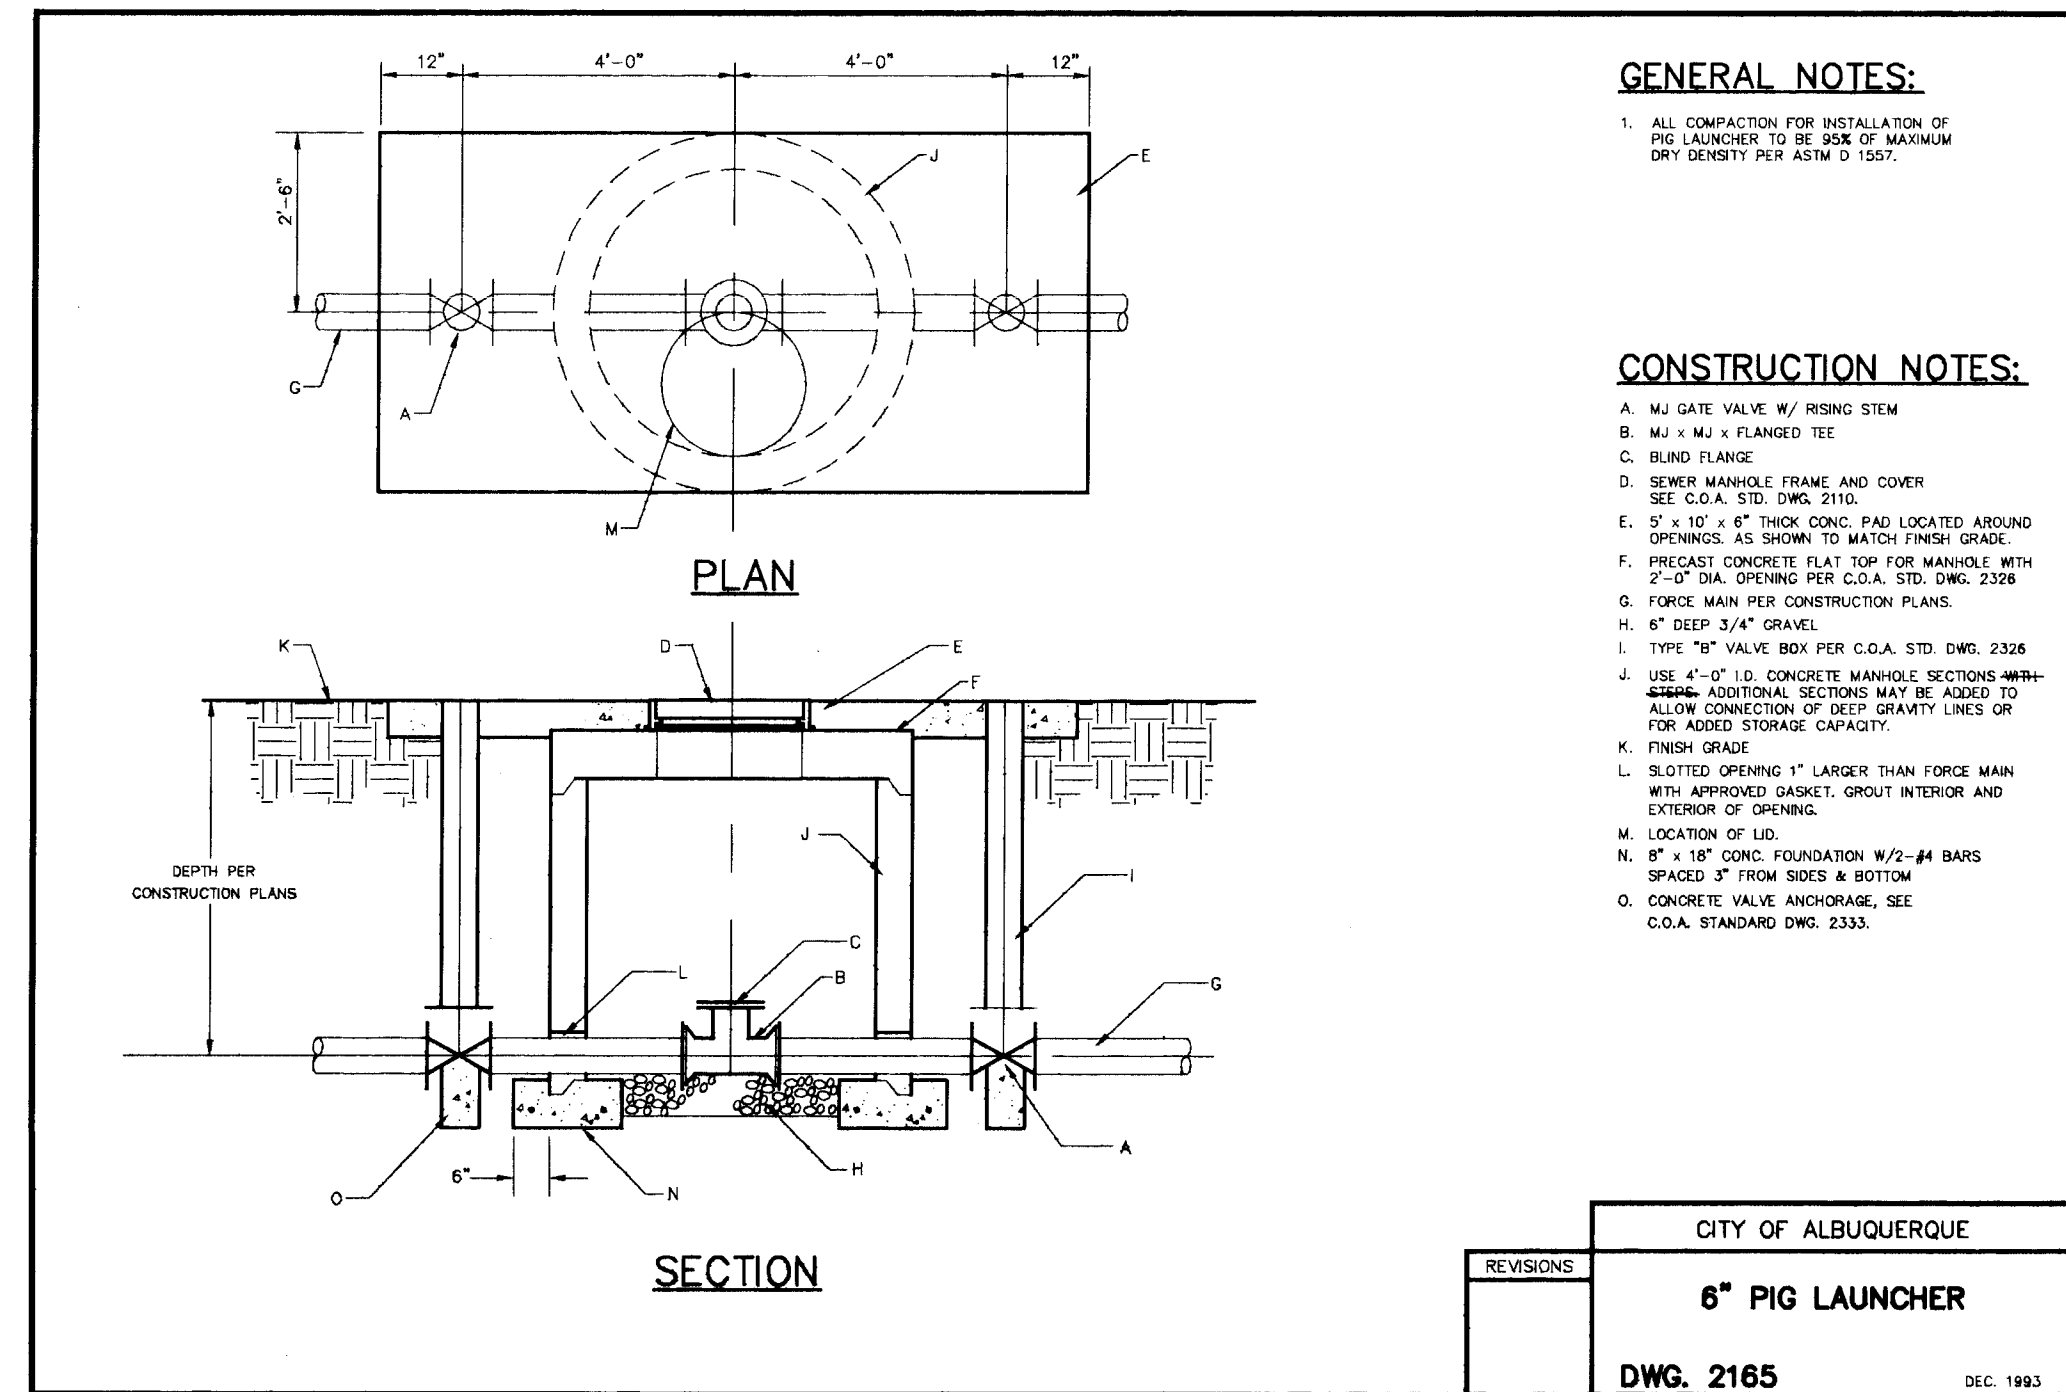
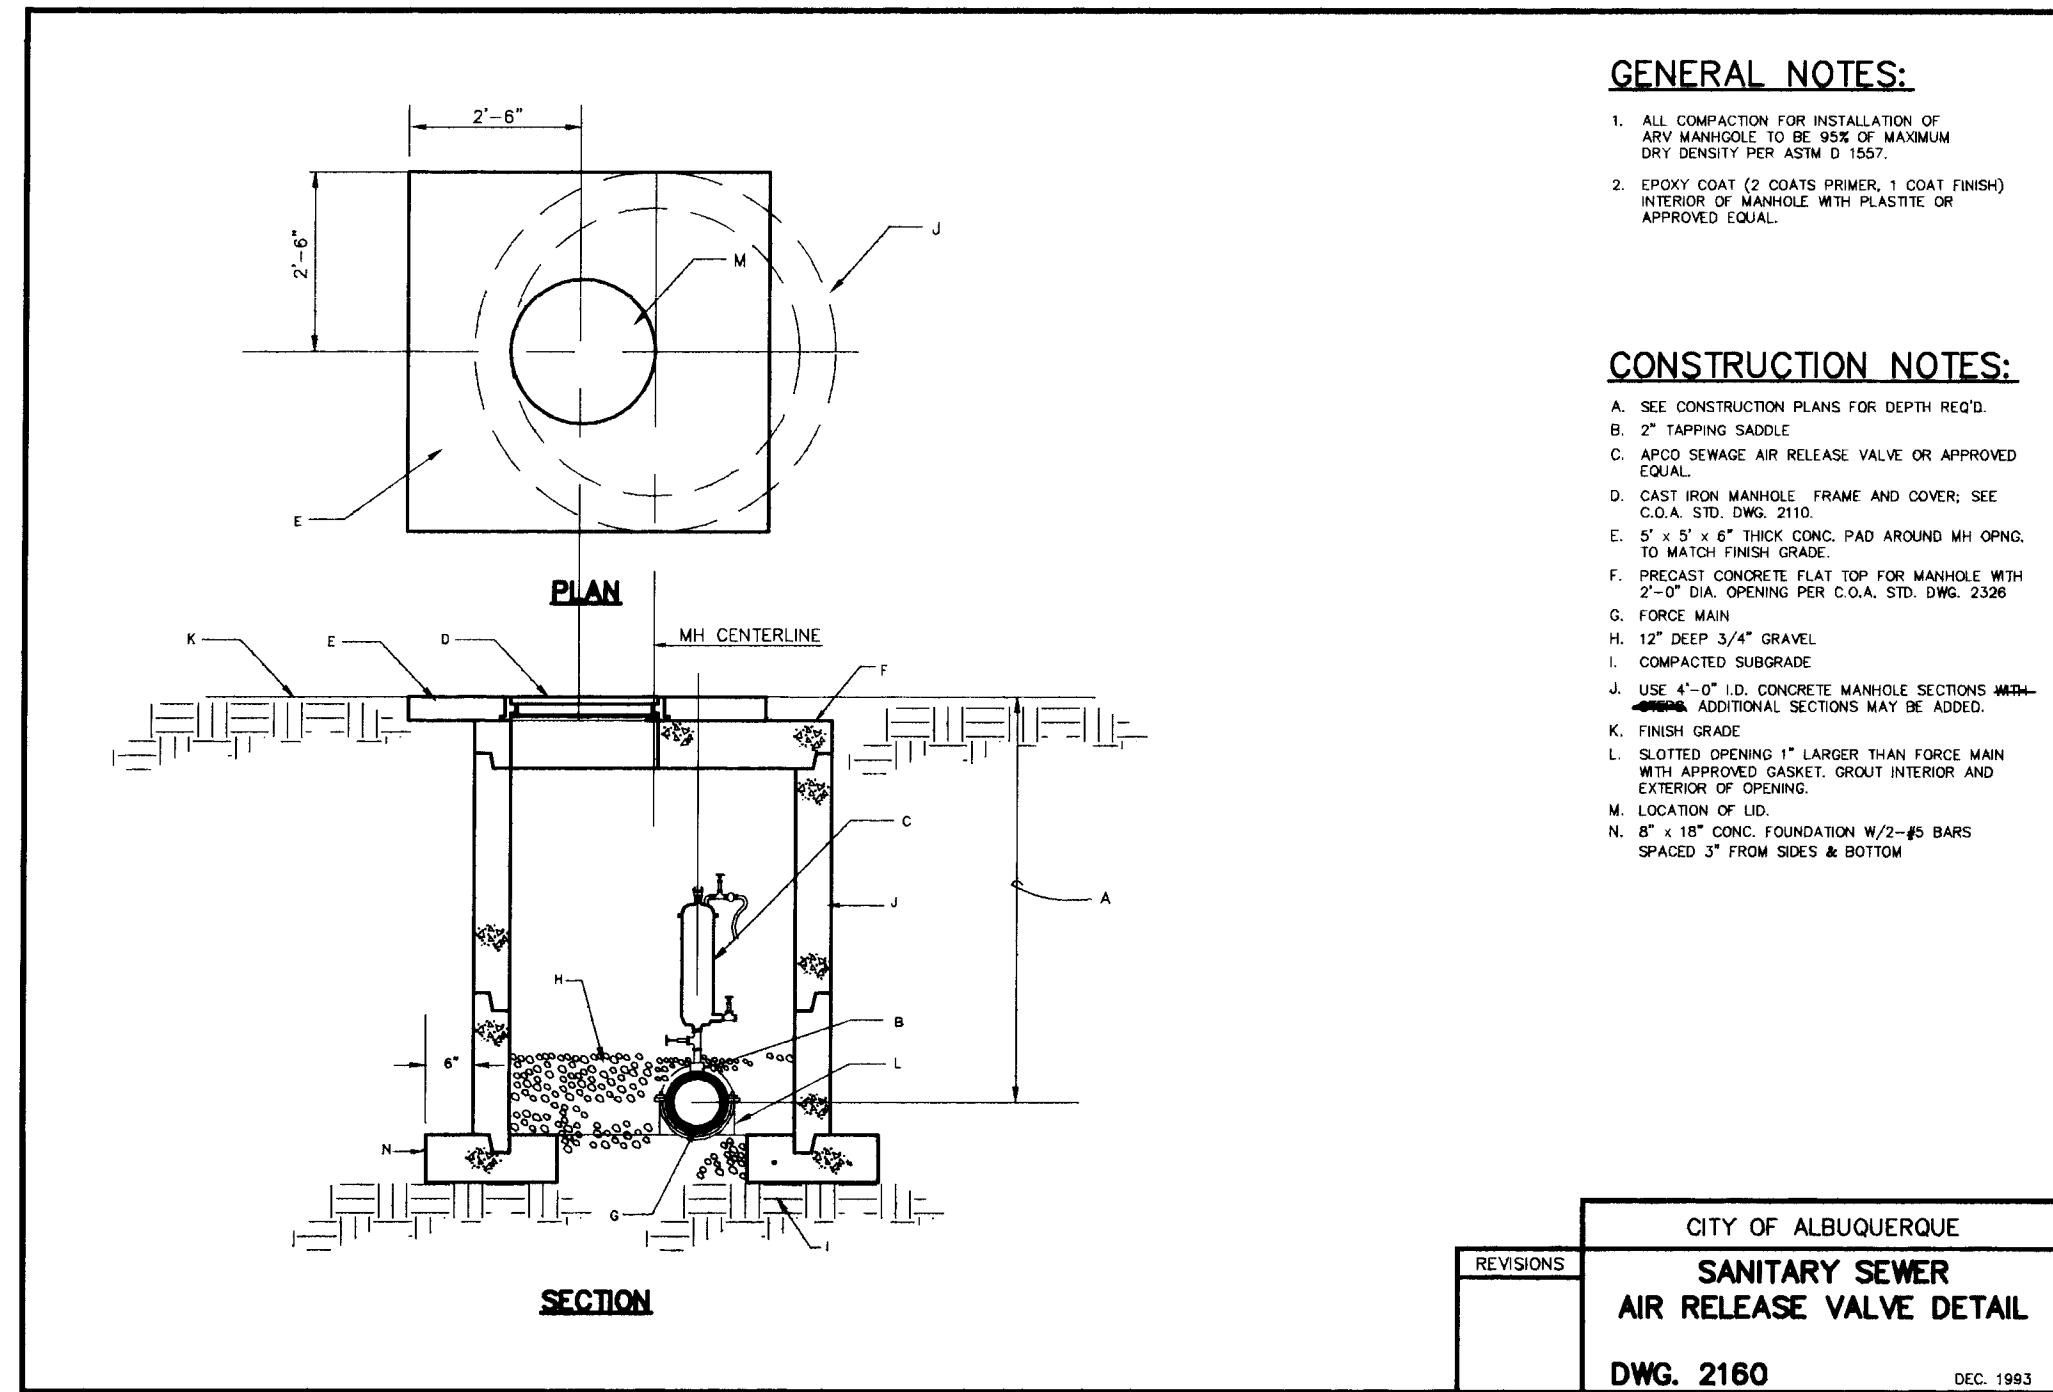
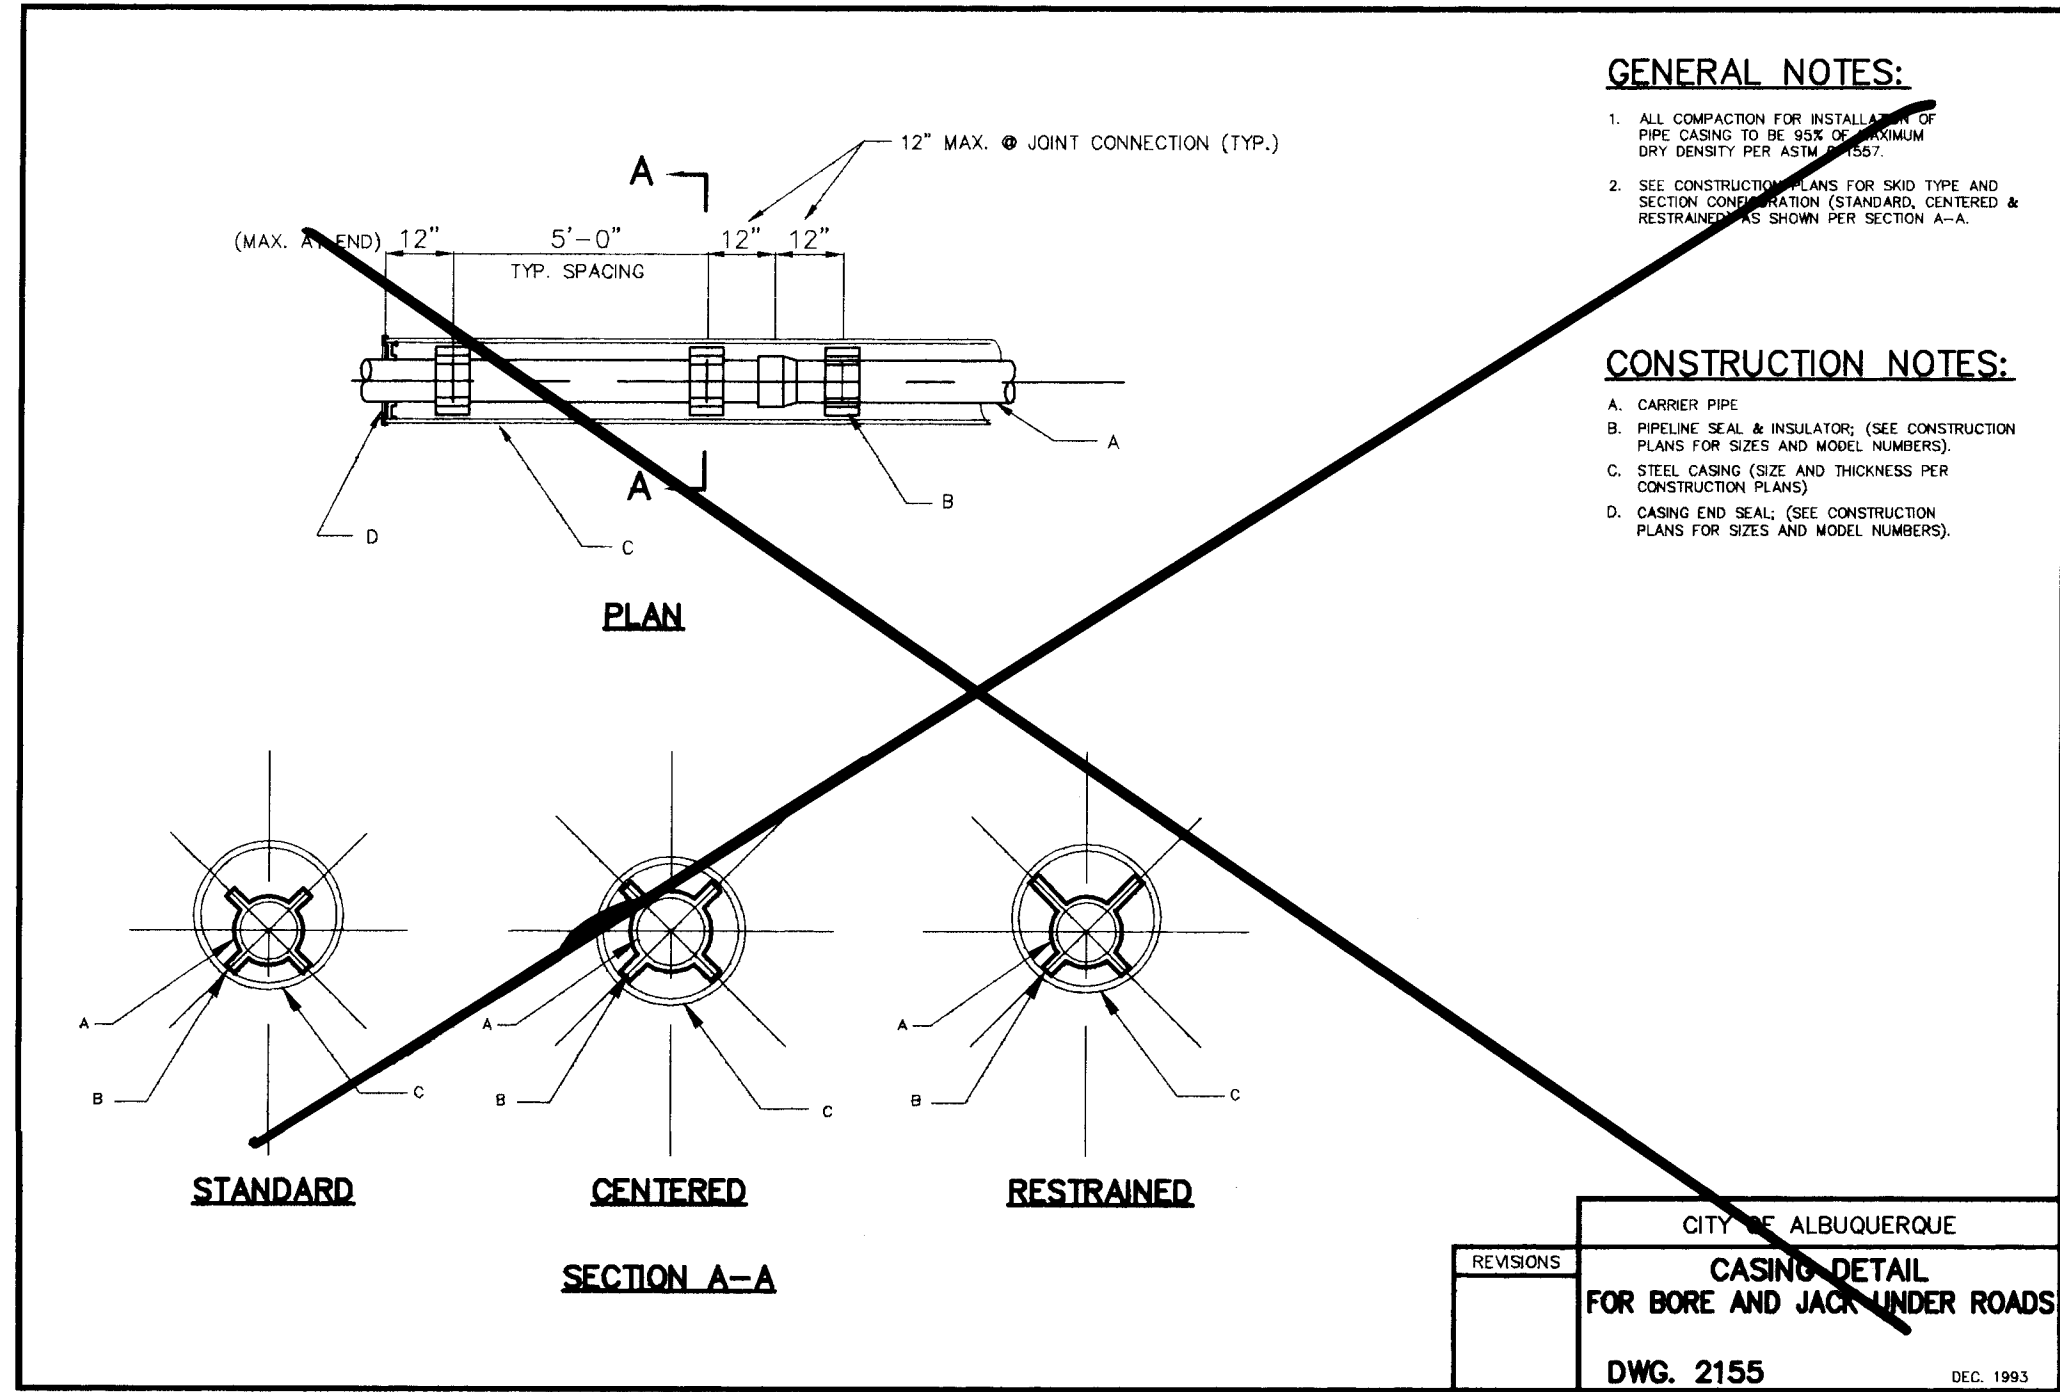


CITY OF ALBUQUERQUE PUBLIC WORKS DEPARTMENT ENGINEERING GROUP				
STANDARD DETAILS FOR VACUUM SEWER				
Design Review Committee	City Engineer Approval	Last Design Update	Mo./Day/Yr.	Mo./Day/Yr.
City Project No. 4687.91		MAP NO.		SHEET 1 OF 3

  WILSON
& COMPANY



CITY OF ALBUQUERQUE PUBLIC WORKS DEPARTMENT ENGINEERING GROUP			
STANDARD DETAILS FOR VACUUM SEWER			
Design Review Committee		City Engineer Approval	
		Last Design Update	Mo./Day/Yr.
City Project No. NO. 468791		MAP NO.	SHEET 2 OF 3

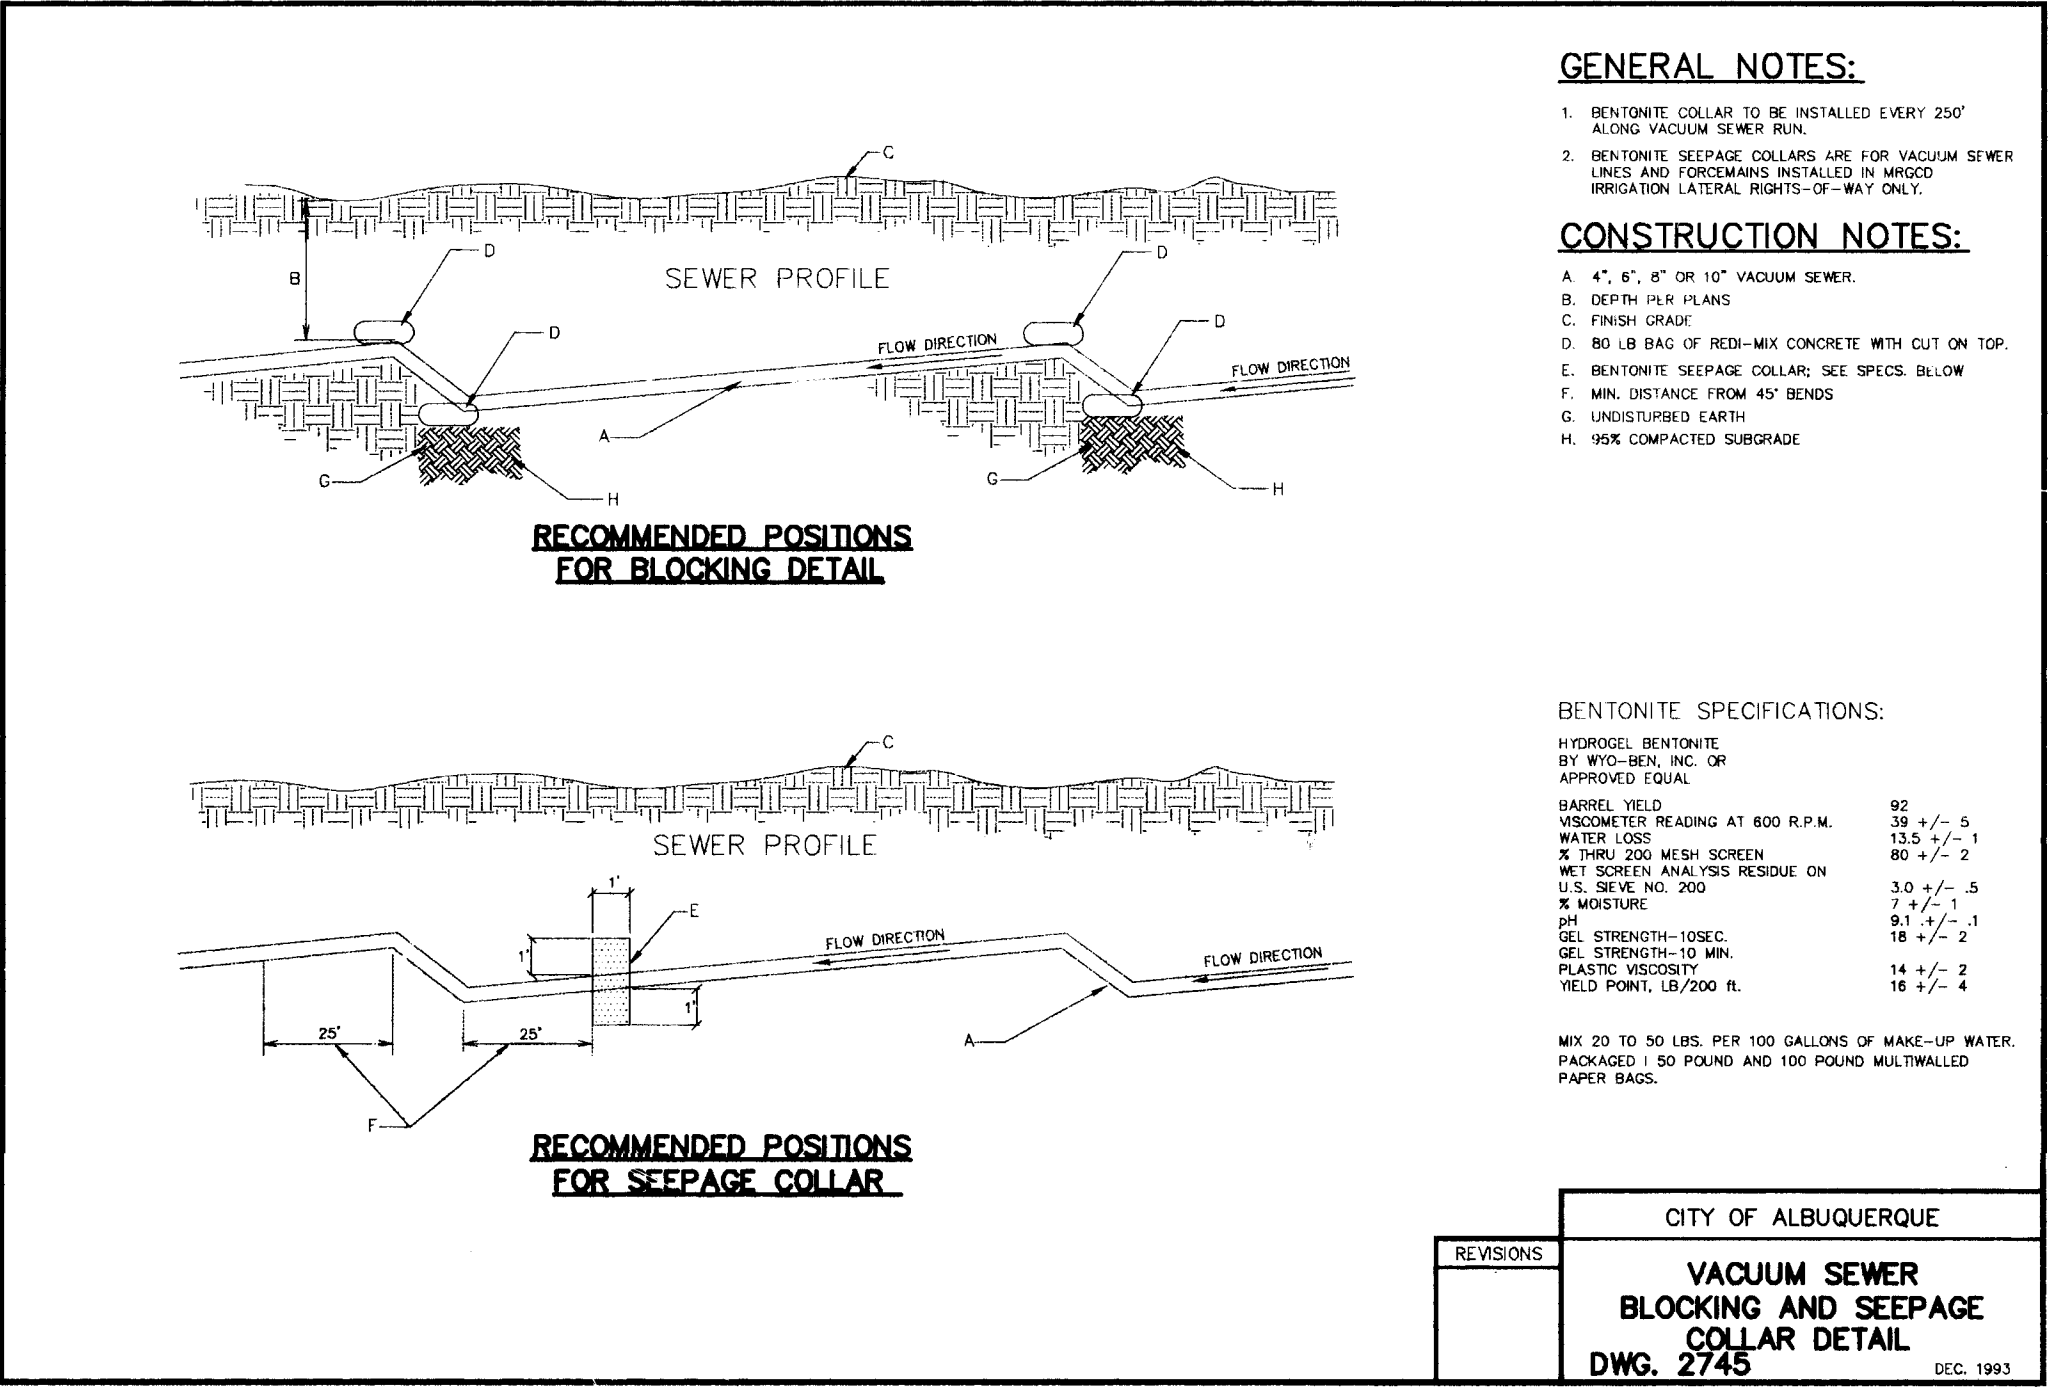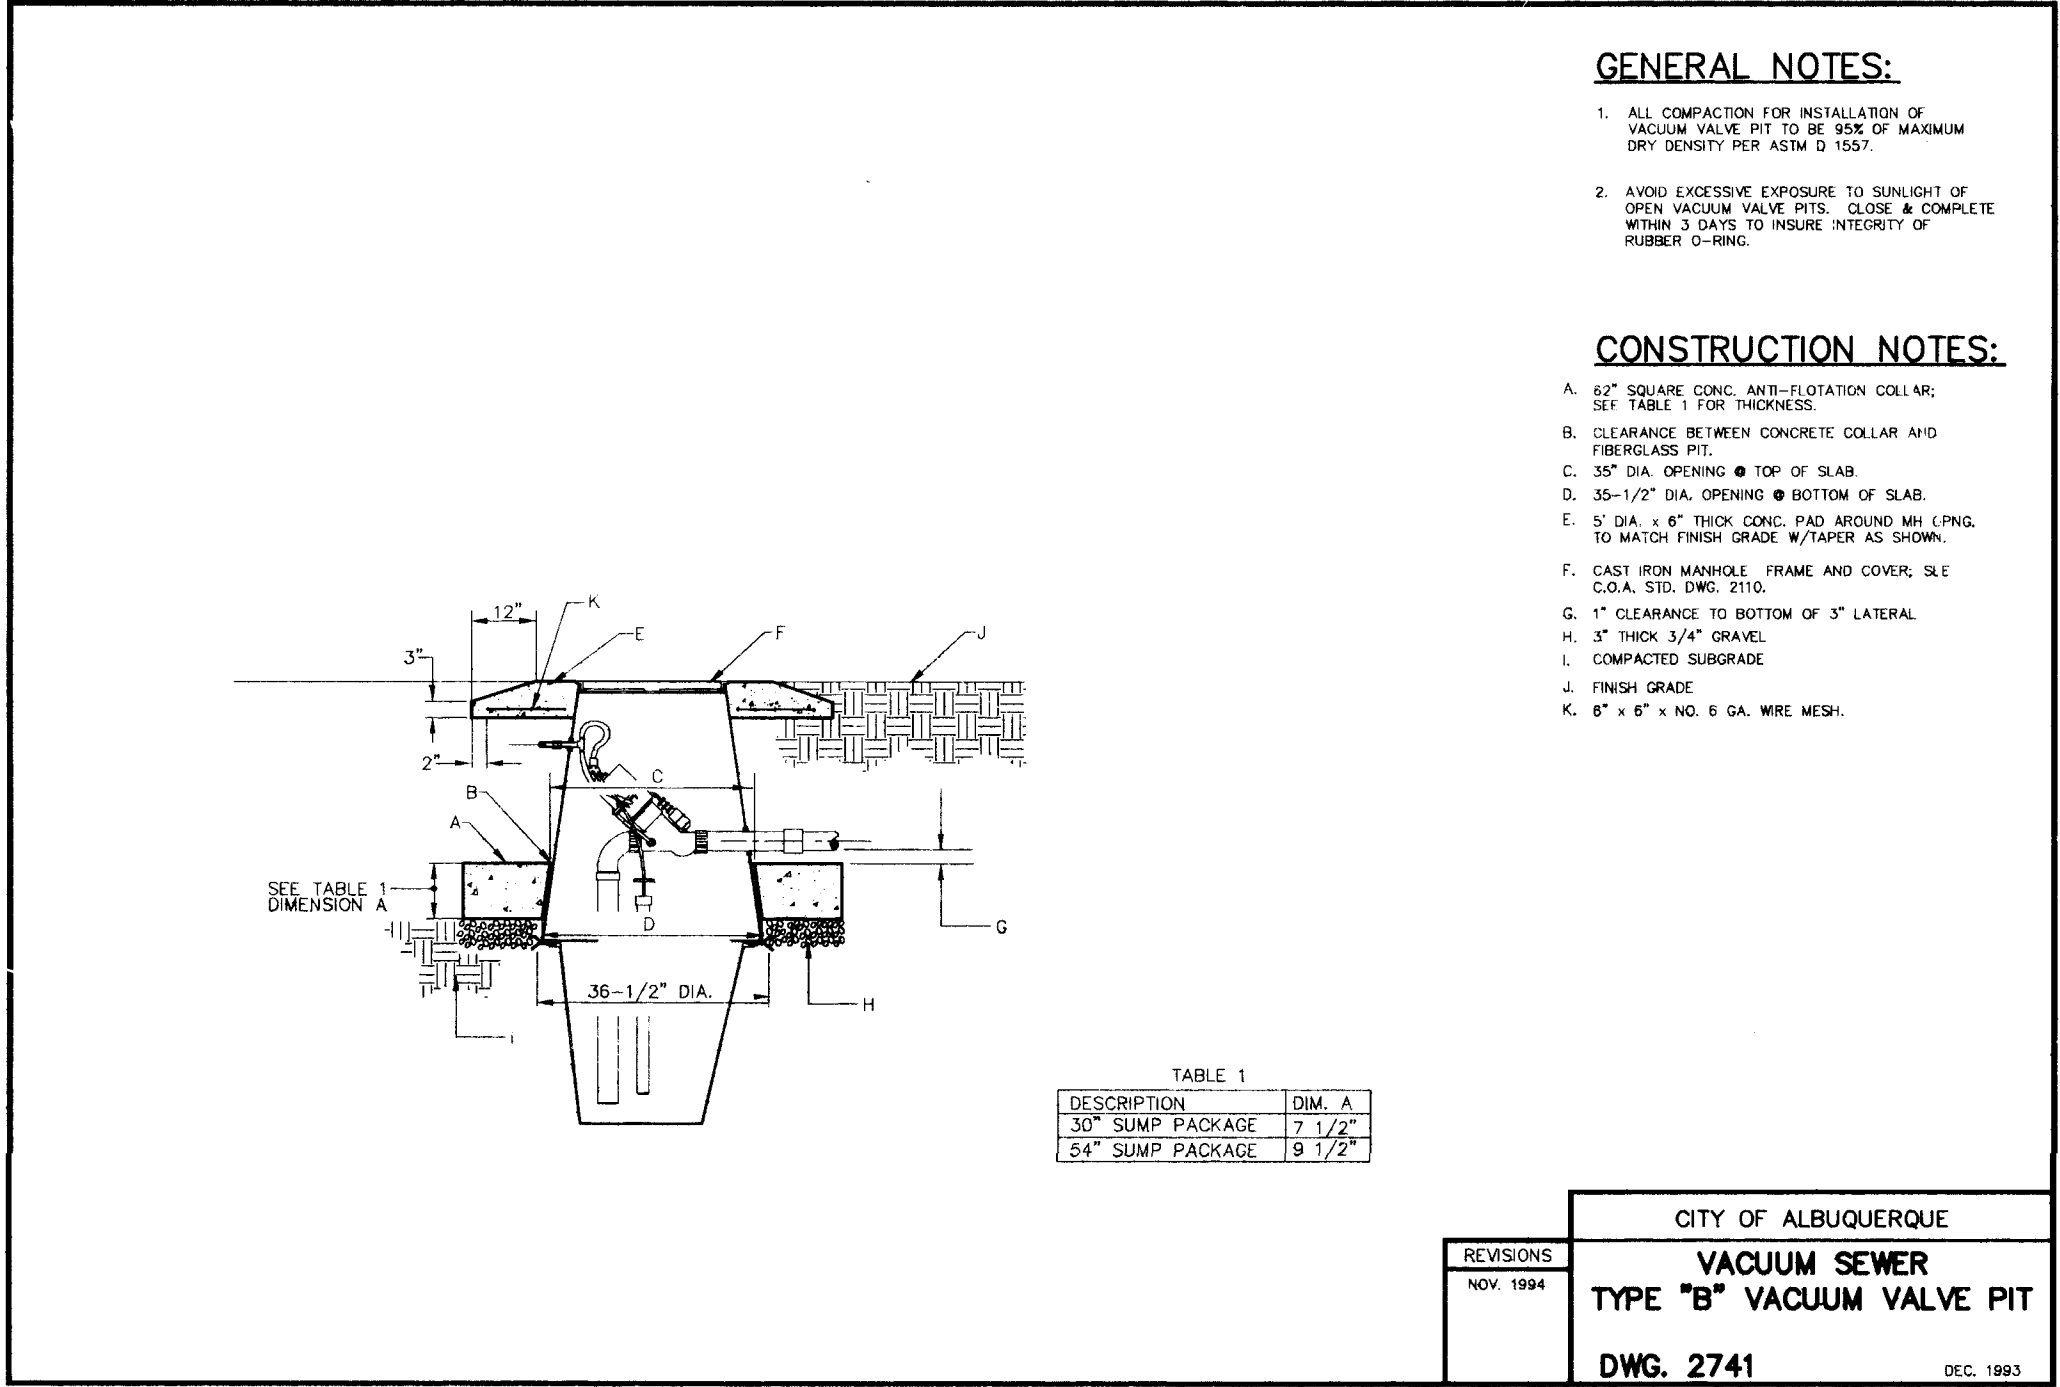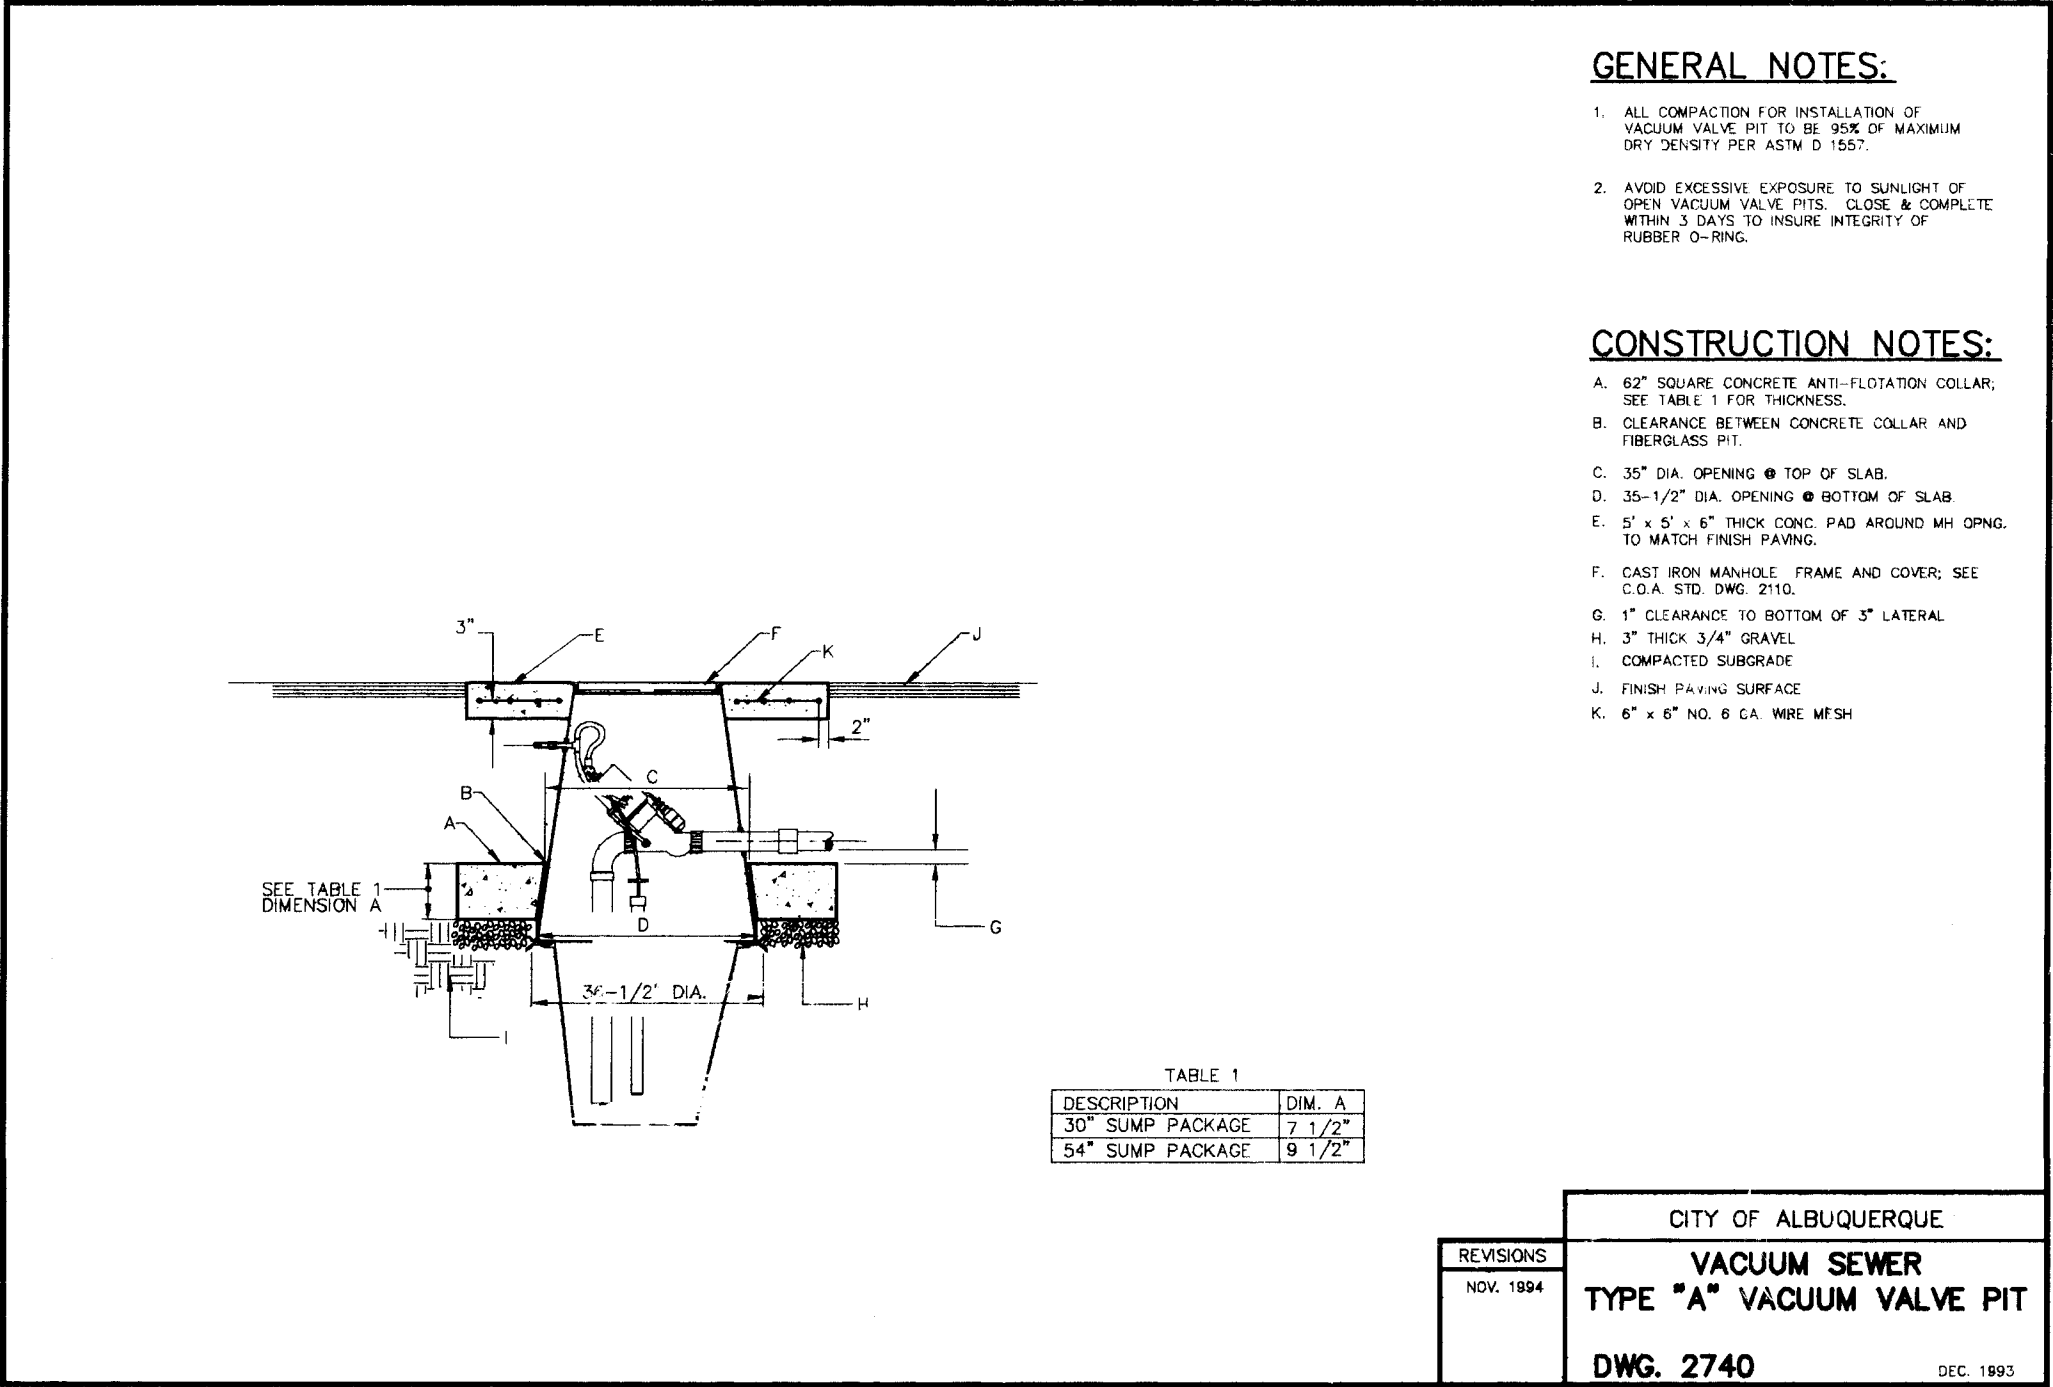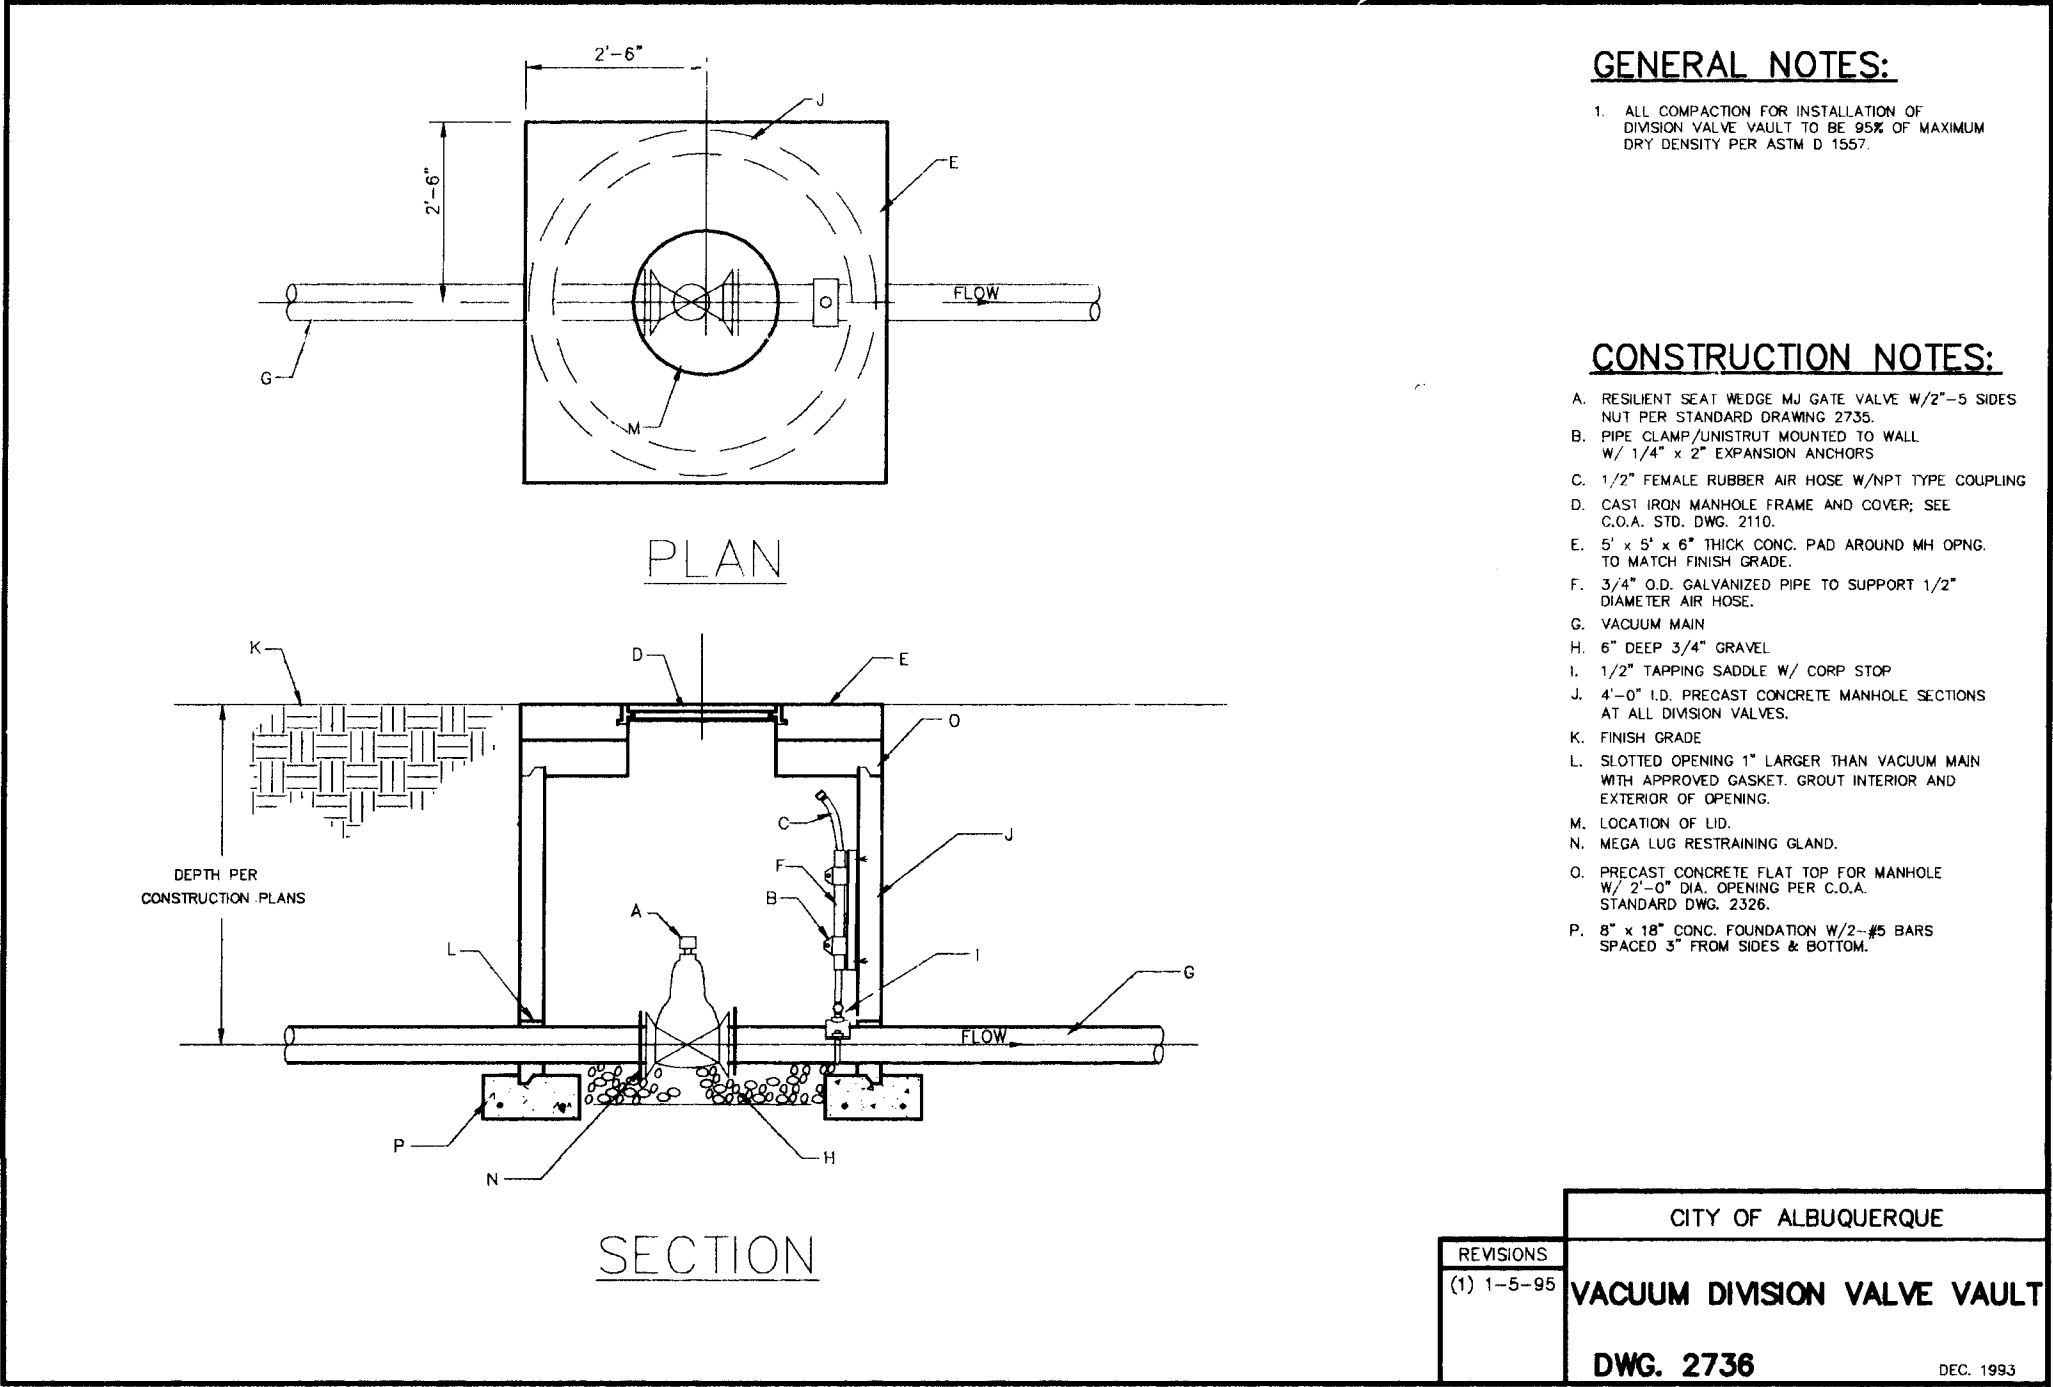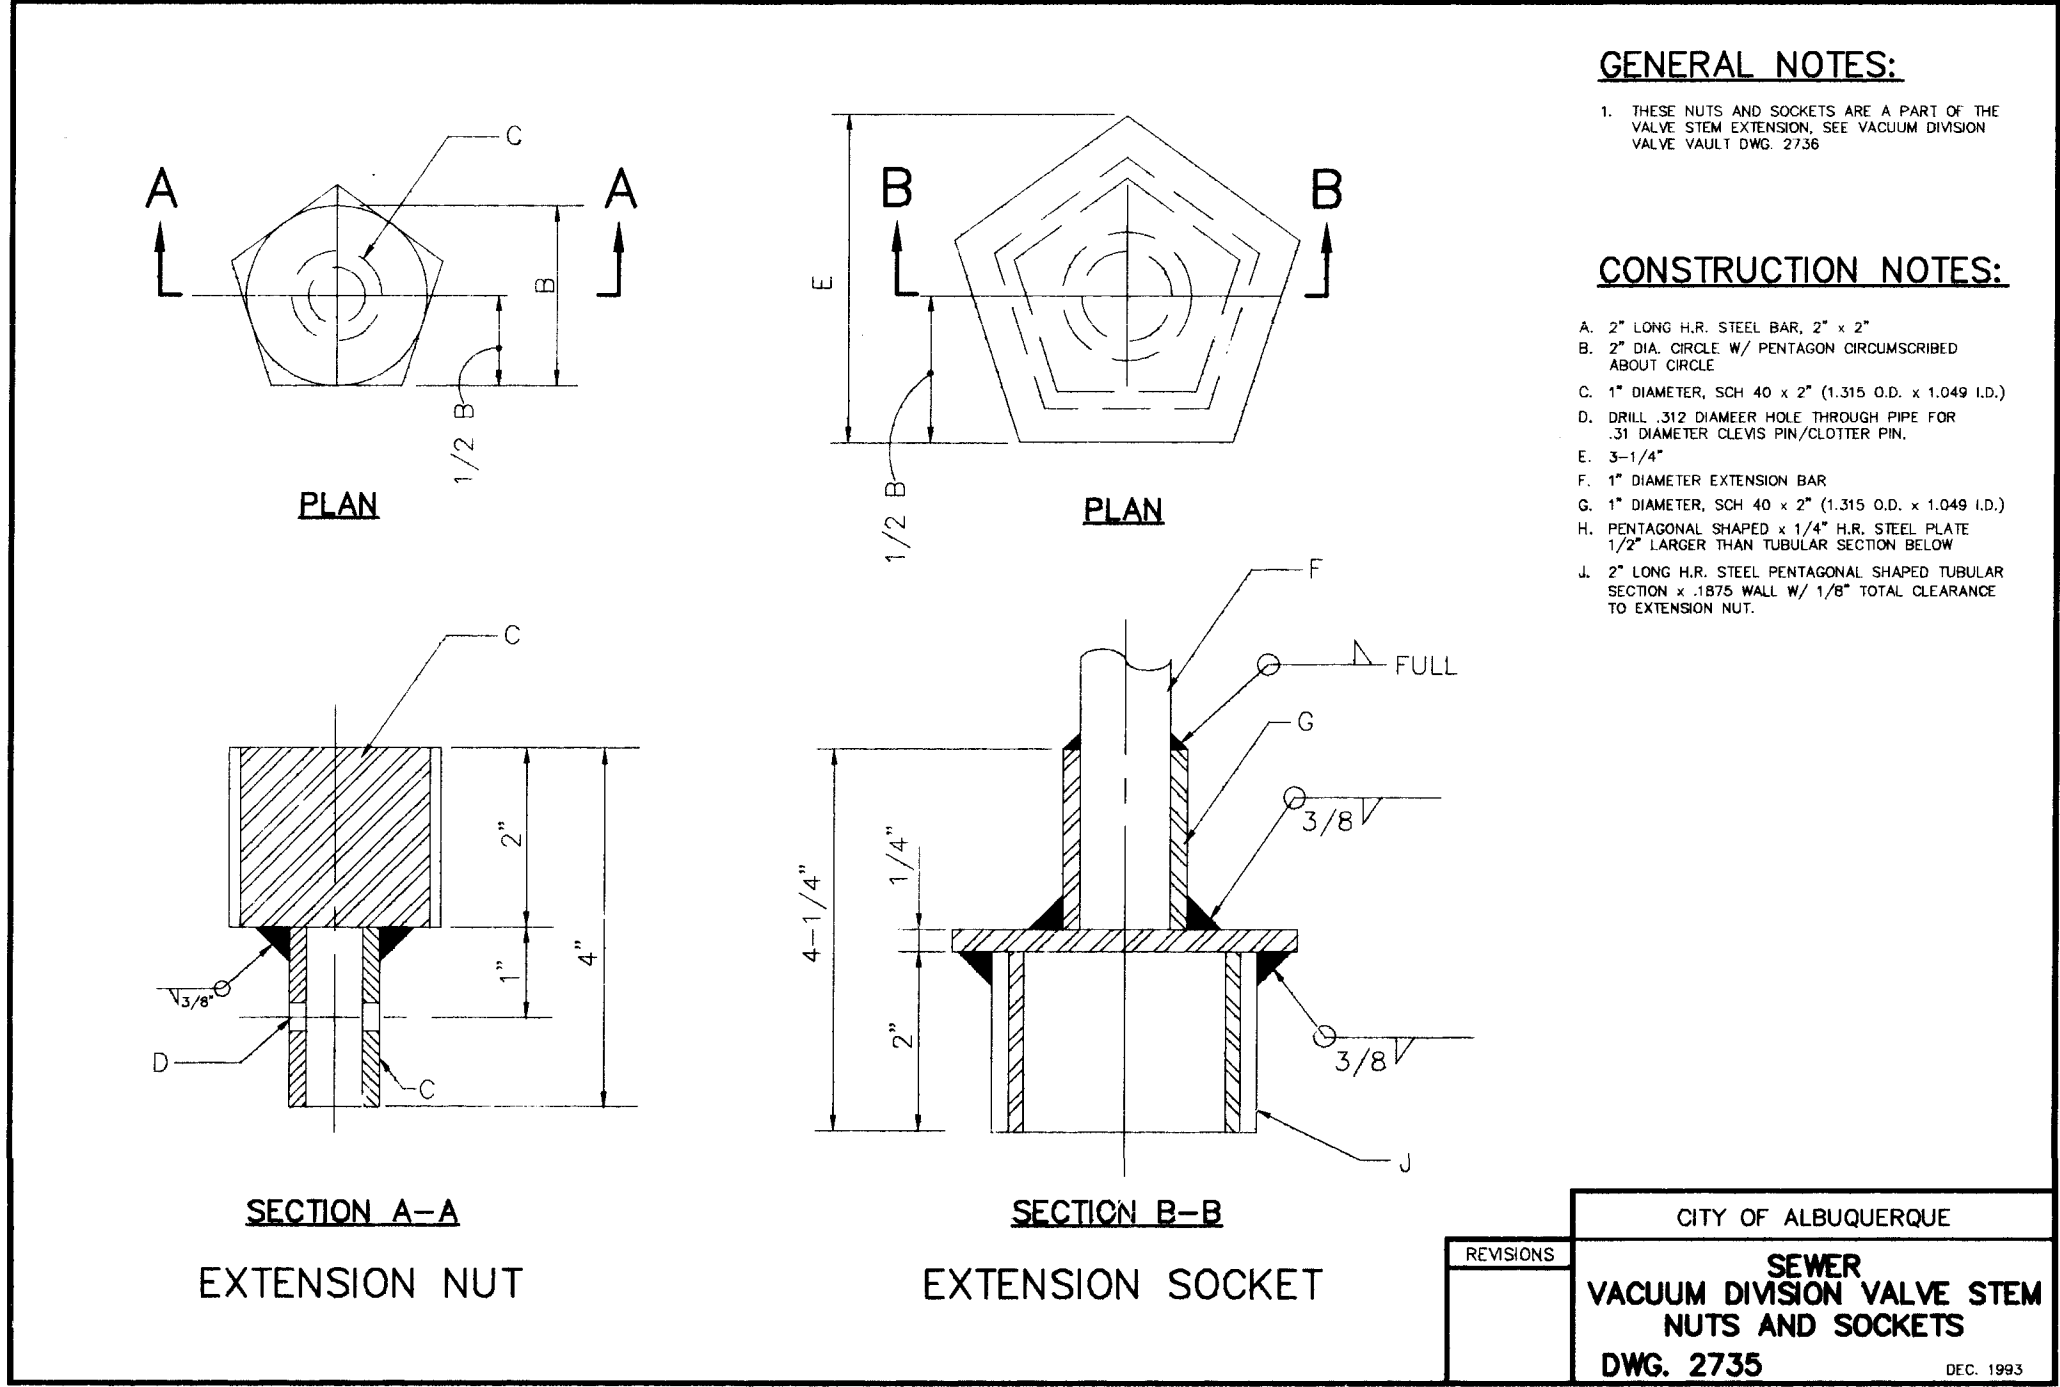

26-4687.91 0397

CITY OF ALBUQUERQUE PUBLIC WORKS DEPARTMENT ENGINEERING GROUP					
STANDARD DETAILS FOR VACUUM SEWER					
Design Review Committee	City Engineer Approval	Lost Design Update	Mo./Day/Yr.	Mo./Day/Yr.	
City Project No. NO. 4687.91		MAP NO.	SHEET 3 OF 3		